

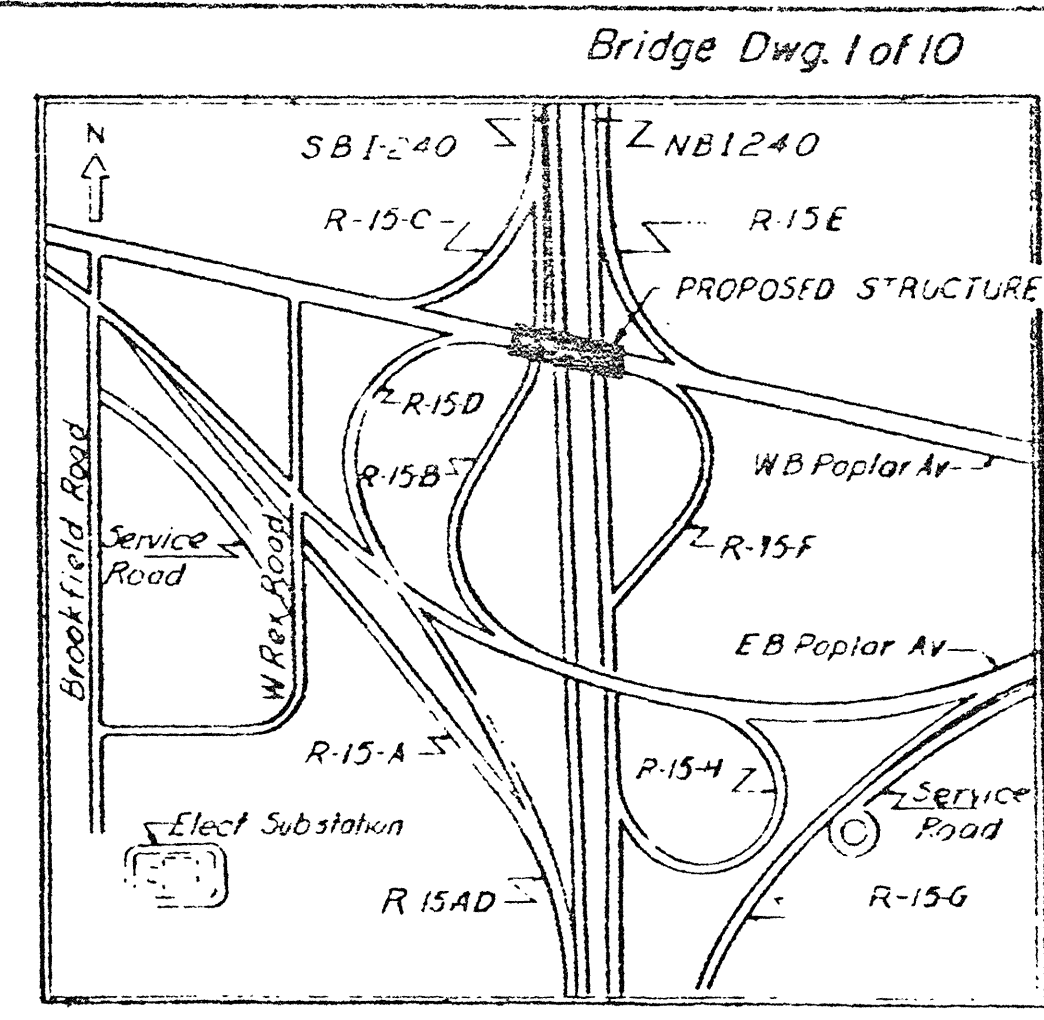
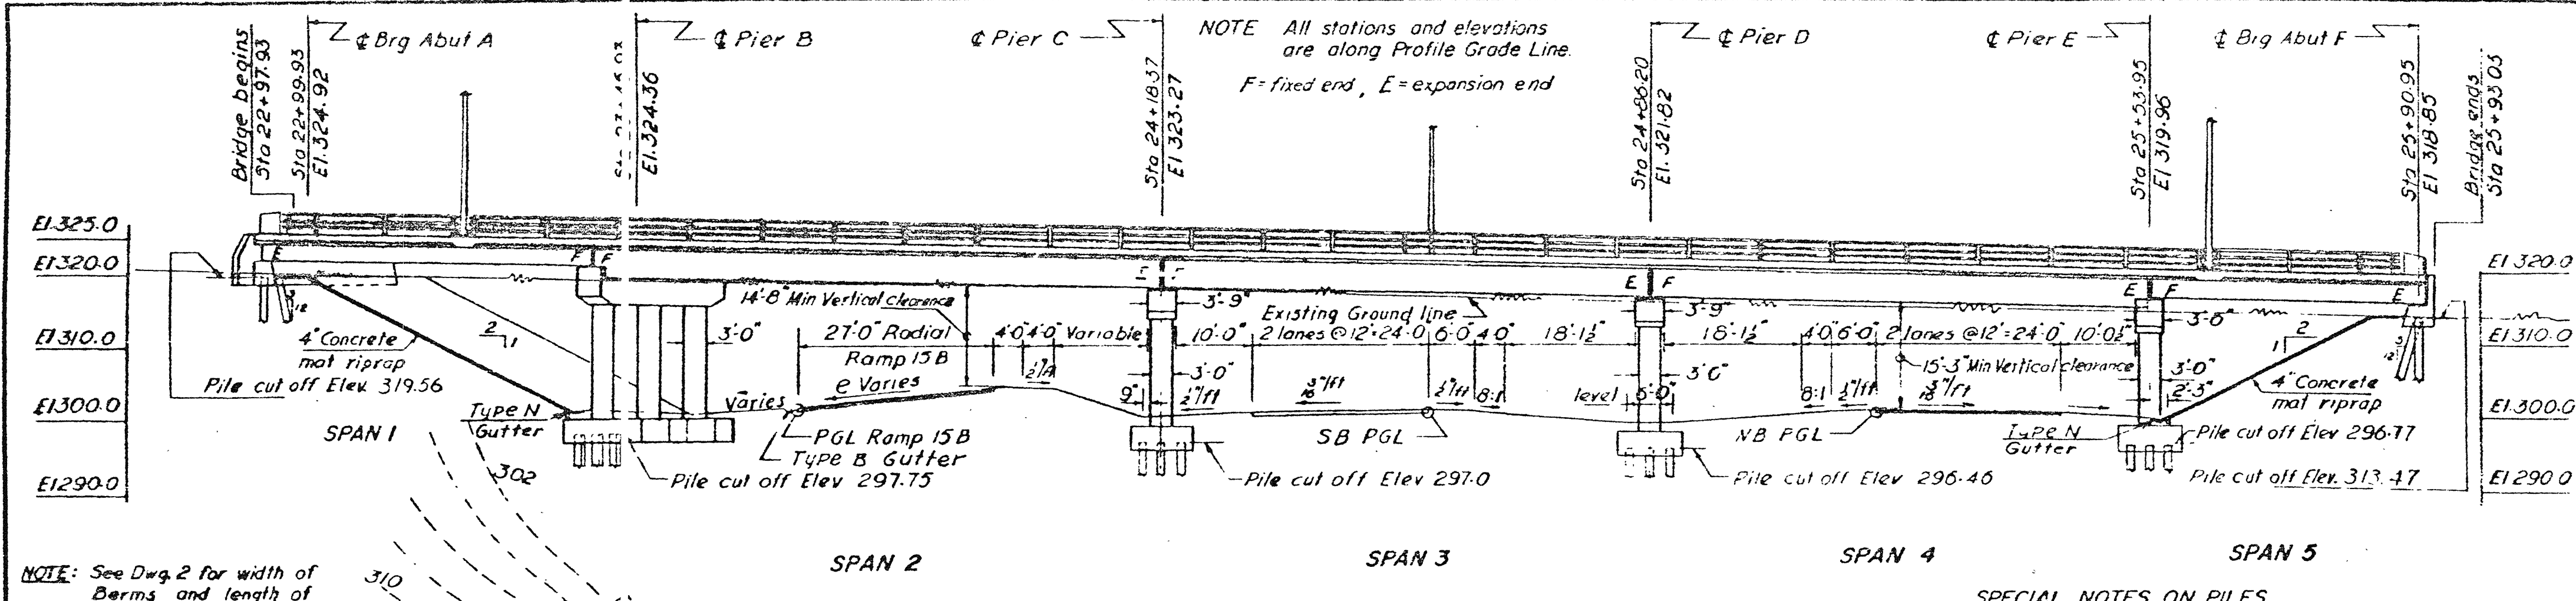


PUB. ROAD DIST. NO.	STATE	PROJECT NO.	FISCAL YEAR	SHEET NO.	TOTAL SHEETS
3	TENNESSEE	I-240-1 (17) 13	1968	172	334
REVISION 9-7-59					
REVISION 11-10-59			12-13-59		
11-23-59 - Realigning Span 5			2-16-62 - Reinf. Steel Quant.		


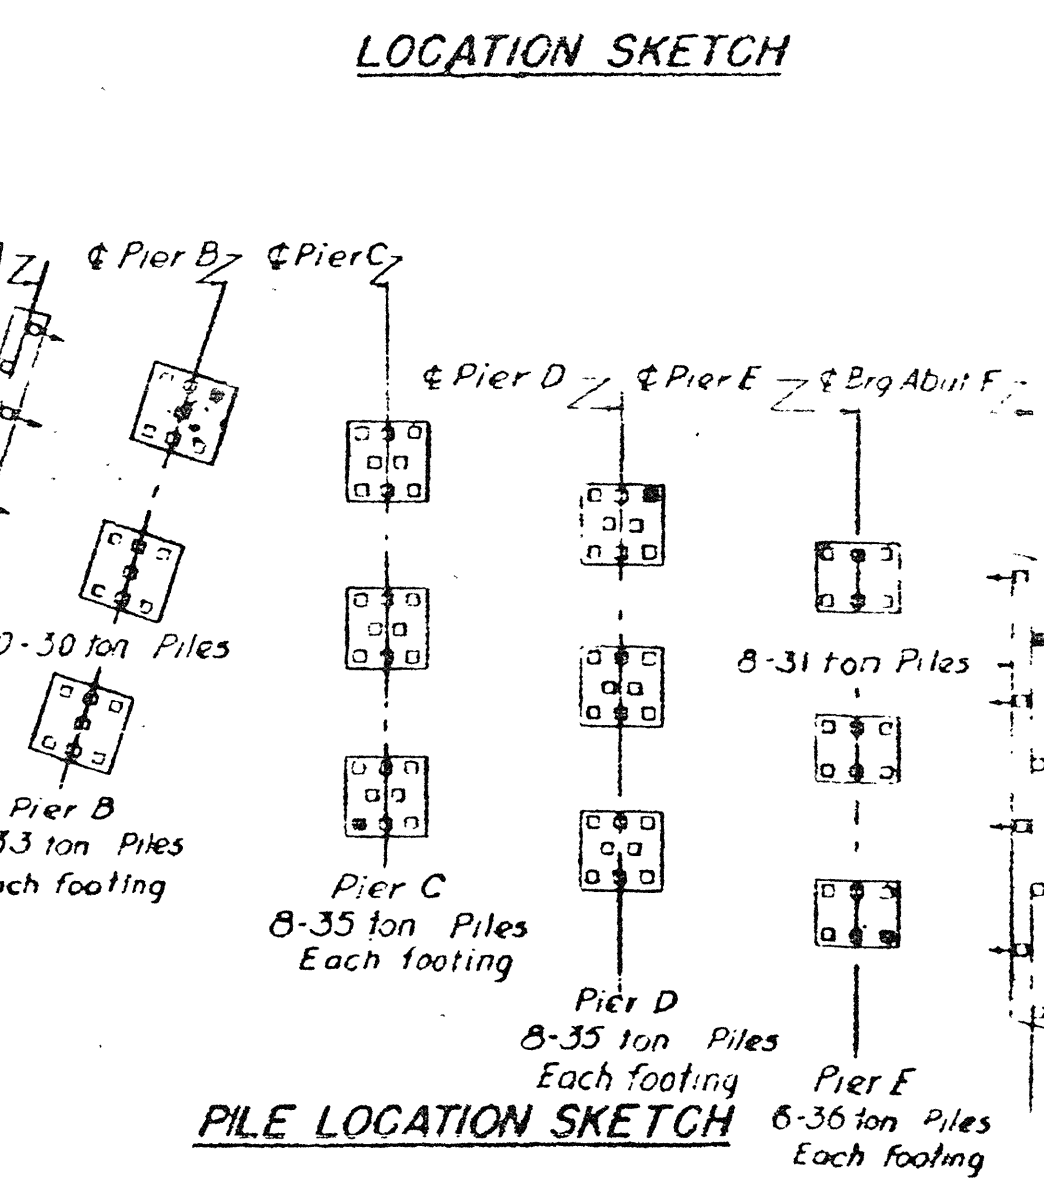


- GENERAL NOTES**
- SPECIFICATIONS - STANDARD ROAD & BRIDGE SPECIFICATIONS OF THE TENNESSEE DEPARTMENT OF HIGHWAYS & PUBLIC WORKS.
  - CAST IN PLACE CONCRETE - SHALL BE CLASS "A". ALL EXPOSED EDGES OF CONCRETE SHALL BE BROKEN WITH A 1 1/2 INCH TRIANGULAR CHAMFER ON SUBSTRUCTURE AND A 3/4 INCH TRIANGULAR CHAMFER ON SUPERSTRUCTURE.
  - REINFORCING STEEL - SEE SPECIFICATIONS. THE MINIMUM LAP FOR SPLICES OF MAIN REINFORCING STEEL SHALL BE 30 DIAMETERS, AND FOR OTHER STEEL 20 DIAMETERS, UNLESS OTHERWISE NOTED. ALL DIMENSIONS ARE TO THE CENTER OF BARS UNLESS OTHERWISE INDICATED. REINFORCING BAR HOOK AND BEND DIMENSIONS SHALL BE THOSE RECOMMENDED BY THE A.C.I. IN ITS "MANUAL OF STANDARD PRACTICE FOR DETAILING REINFORCED CONCRETE HIGHWAY STRUCTURES."

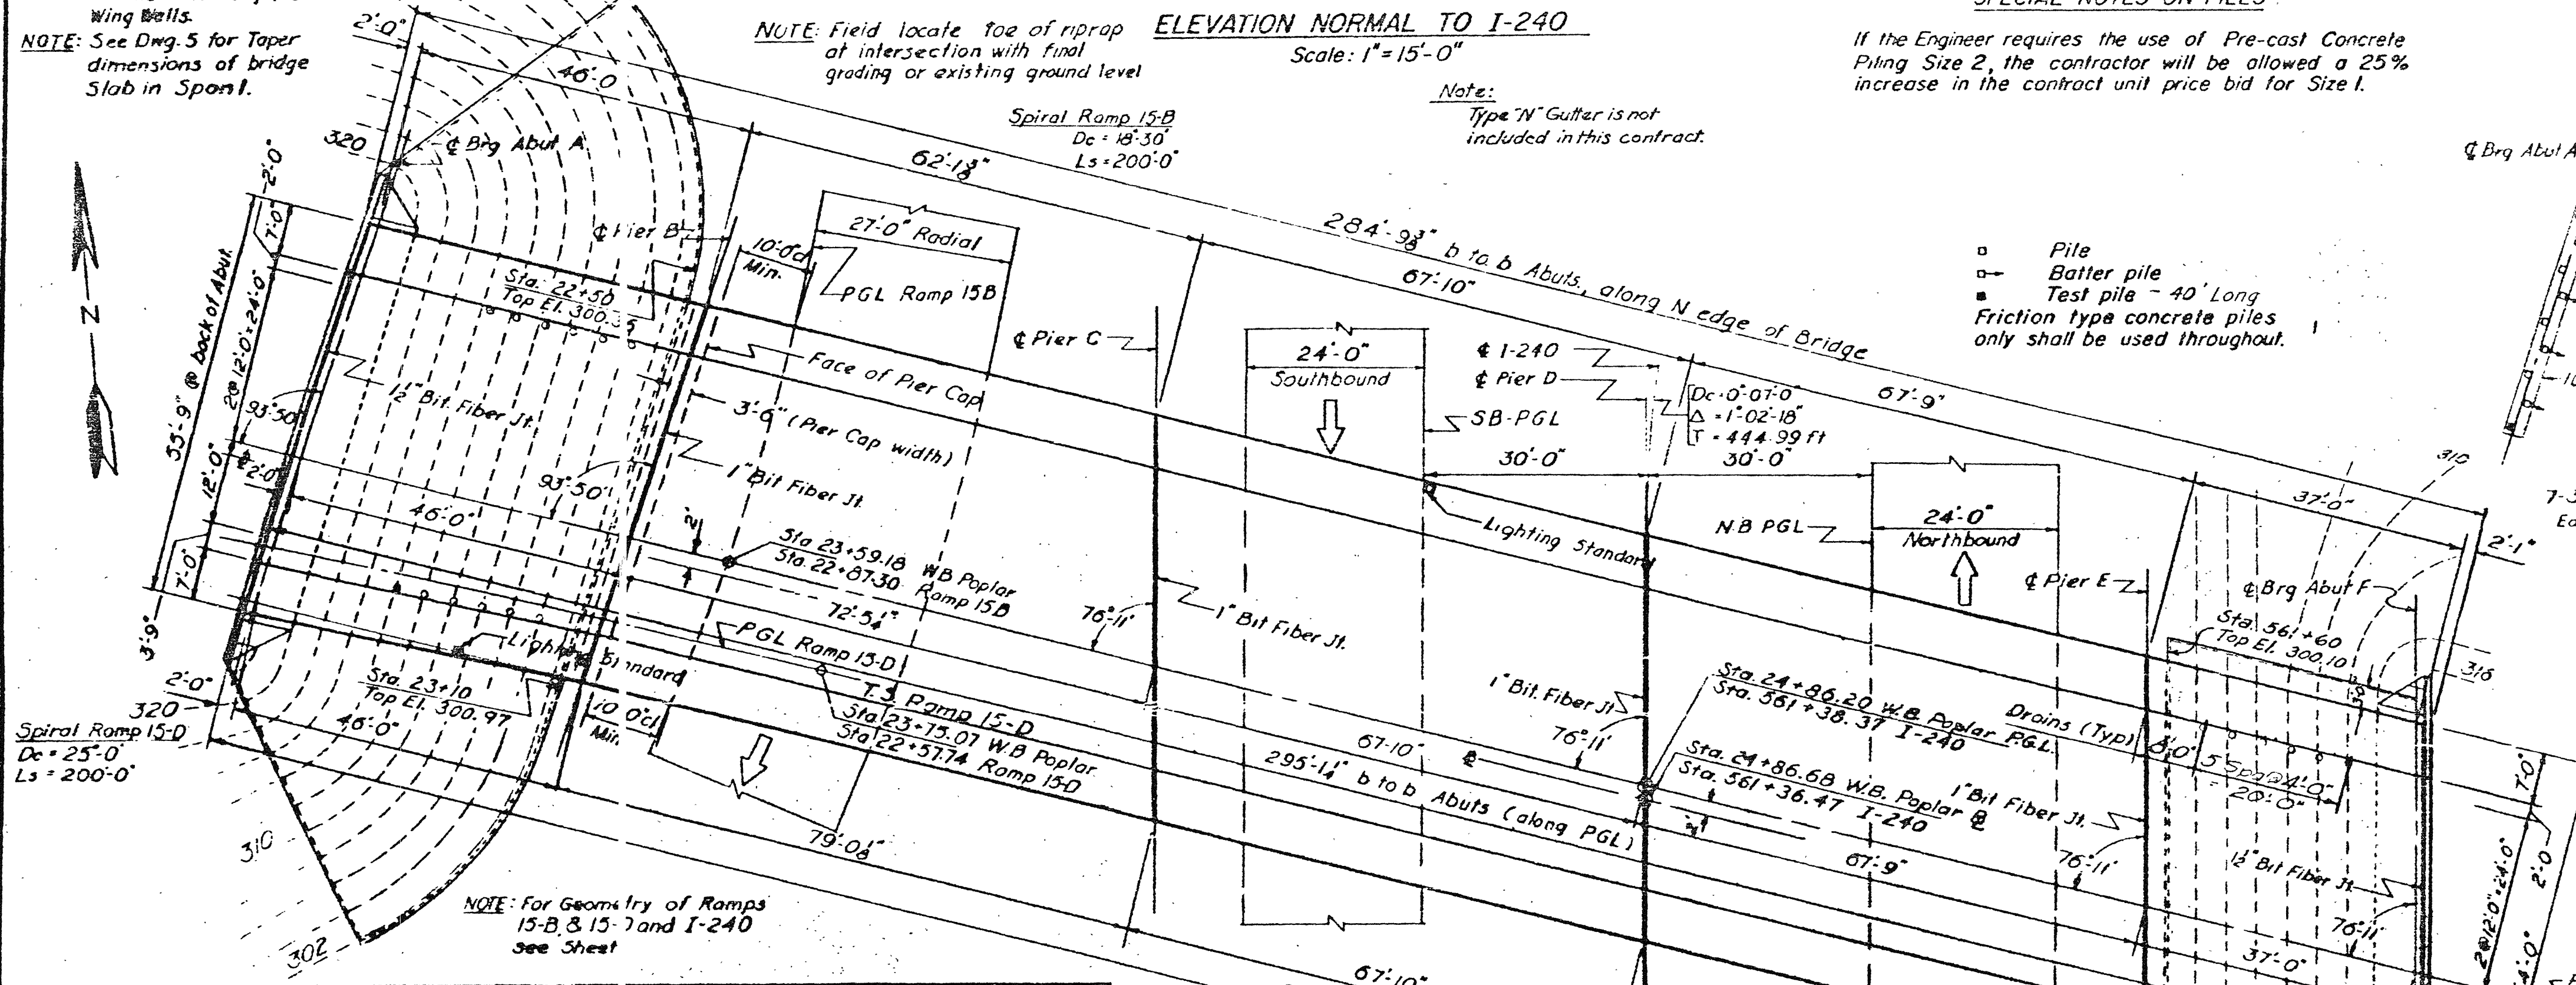

- REINFORCING BAR LOCATIONS SHALL BE SHIFTED SLIGHTLY TO ALLOW FOR PLACEMENT OF ANCHOR BOLTS FOR BEARINGS, HANDRAILS, AND LIGHT STANDARDS.
- ALL BARS SHALL HAVE A MINIMUM COVER OF 3 INCHES IN PIER FOOTINGS, 2 INCHES IN PIER CAPS, ABUTMENTS AND COLUMNS, AND 1 INCH IN SLABS, EXCEPT AS NOTED OTHERWISE ON DRAWINGS.
- FORMS & FINISH - SEE SPECIFICATIONS.
- FILL - ALL FILL SHALL BE PLACED AND COMPACTED BEFORE PILES ARE DRIVEN.
- PILES - SHALL BE OF CONCRETE AS SHOWN ON DWG. NO. F-2-118 MINIMUM BEARING CAPACITY OF PILES SHALL BE AS SHOWN ON THIS SHEET.
- PRESTRESSED BEAM CONCRETE - SEE SPECIAL PROVISIONS.
- PRESTRESSED BEAMS REINFORCEMENT - SEE SPECIAL PROVISIONS.
- NOTES ON DETAILING REINFORCING STEEL: STANDARD ABBREVIATIONS ARE USED THROUGHOUT. FF - FAR FACE; NF - NEAR FACE; EF - EACH FACE. EXAMPLE: 8-#5@12 3-HORIZONTAL; 3-LOCATION IN ABUTMENT-A; 2-THIRD BAR IN SERIES.
- PREFORMED BEARING PADS - SEE SPECIAL PROVISIONS.
- BEARING ELEVATIONS - AT LOCATIONS ON PIERS AND ABUTMENTS ARE GIVEN TO THE BOTTOM OF THE PRE-FORMED BEARING PADS. THESE ELEVATIONS MAY BE OBTAINED BY STEPPING THE PIER CAP OR ABUTMENT, OR OTHER APPROVED METHODS.

ITEM	Dry Excavation	Class A Concrete	Class B Concrete	Steel	Pre-cast Concrete	Test Piles	Steel 3-Rail Handrail	Lighting System
UNIT	Cu.Yds.	Cu.Yds.	Lbs.	Each	Lm. Ft.	Lm. Ft.	Lm. Ft.	Lump Sum
<b>SUPERSTRUCTURE</b>		47.74	88.310				574	
SPAN 1				13145-10				
SPAN 2				9 Variables				
SPAN 3				356-84				
SPAN 4				356-84				
SPAN 5				9136-10				
<b>SUBSTRUCTURE</b>								
ABUTMENT A	26	324	3230					
PIER B	48	695	11,270					
PIER C	60	665	10,390					
PIER D	60	661	10,380					
PIER E	47	634	11,090					
ABUTMENT F	18	317	3250					
<b>TOTAL</b>	259	807.0	137,920	22	15	2475	240	574 Lump Sum

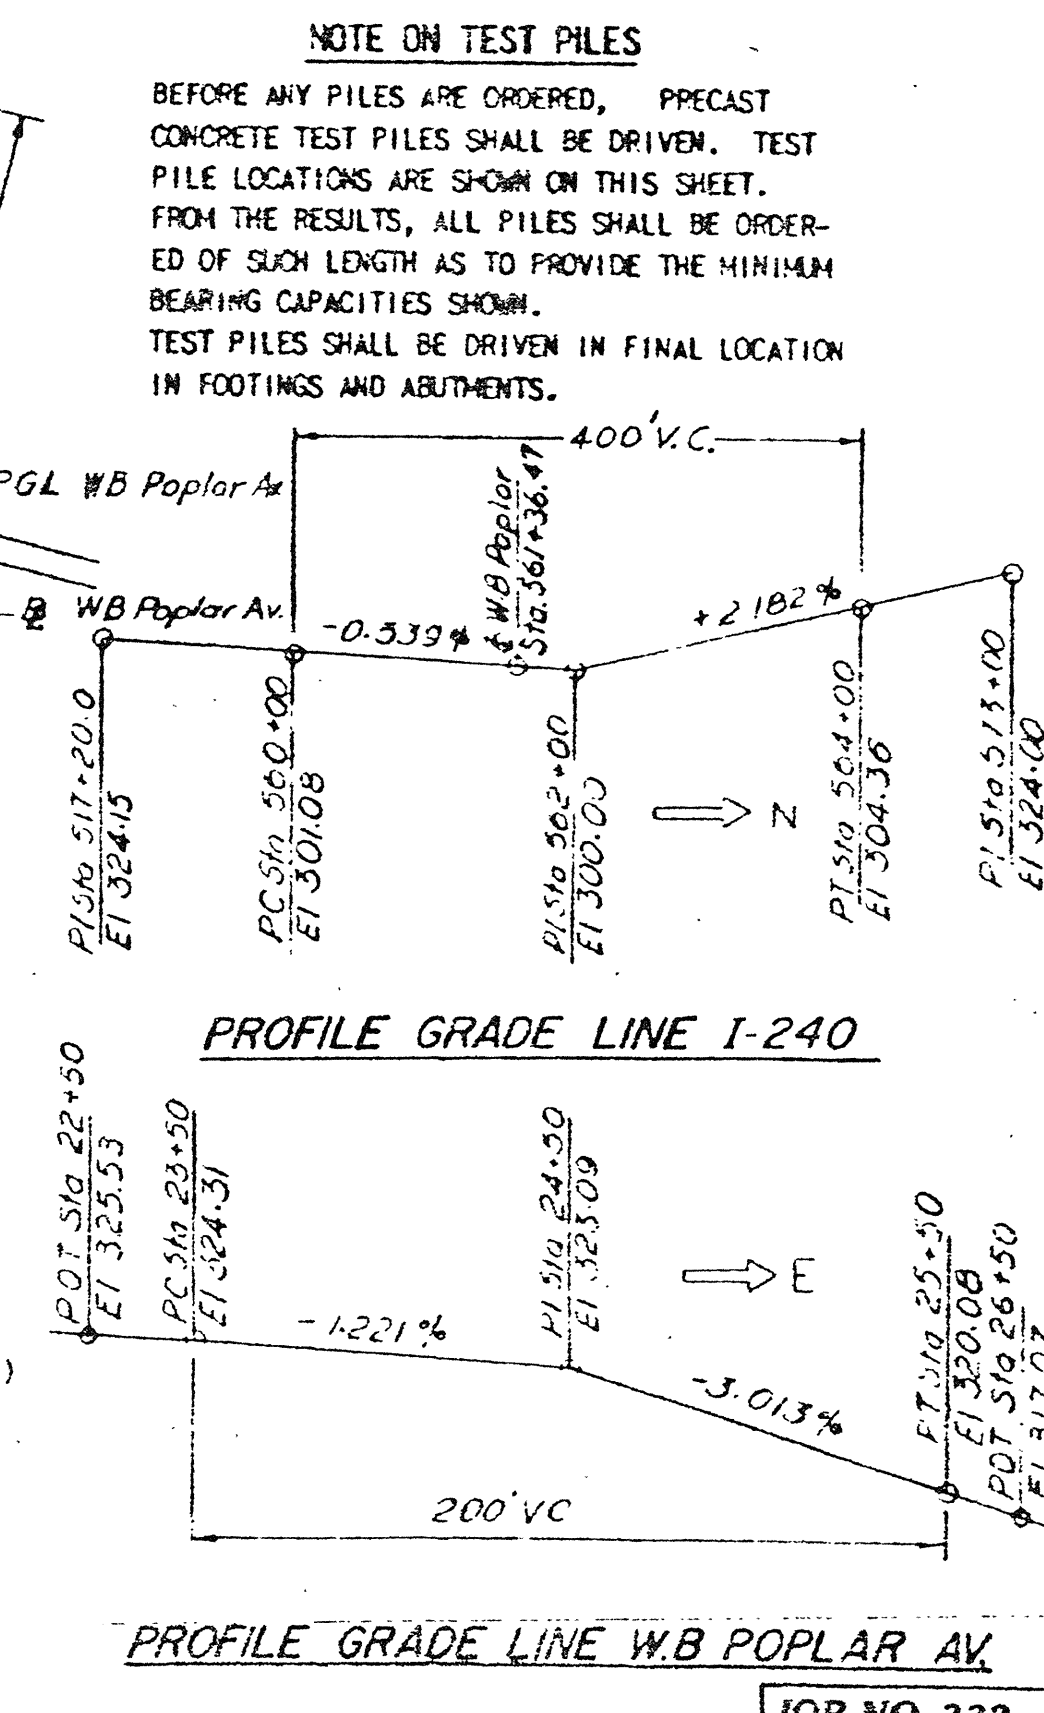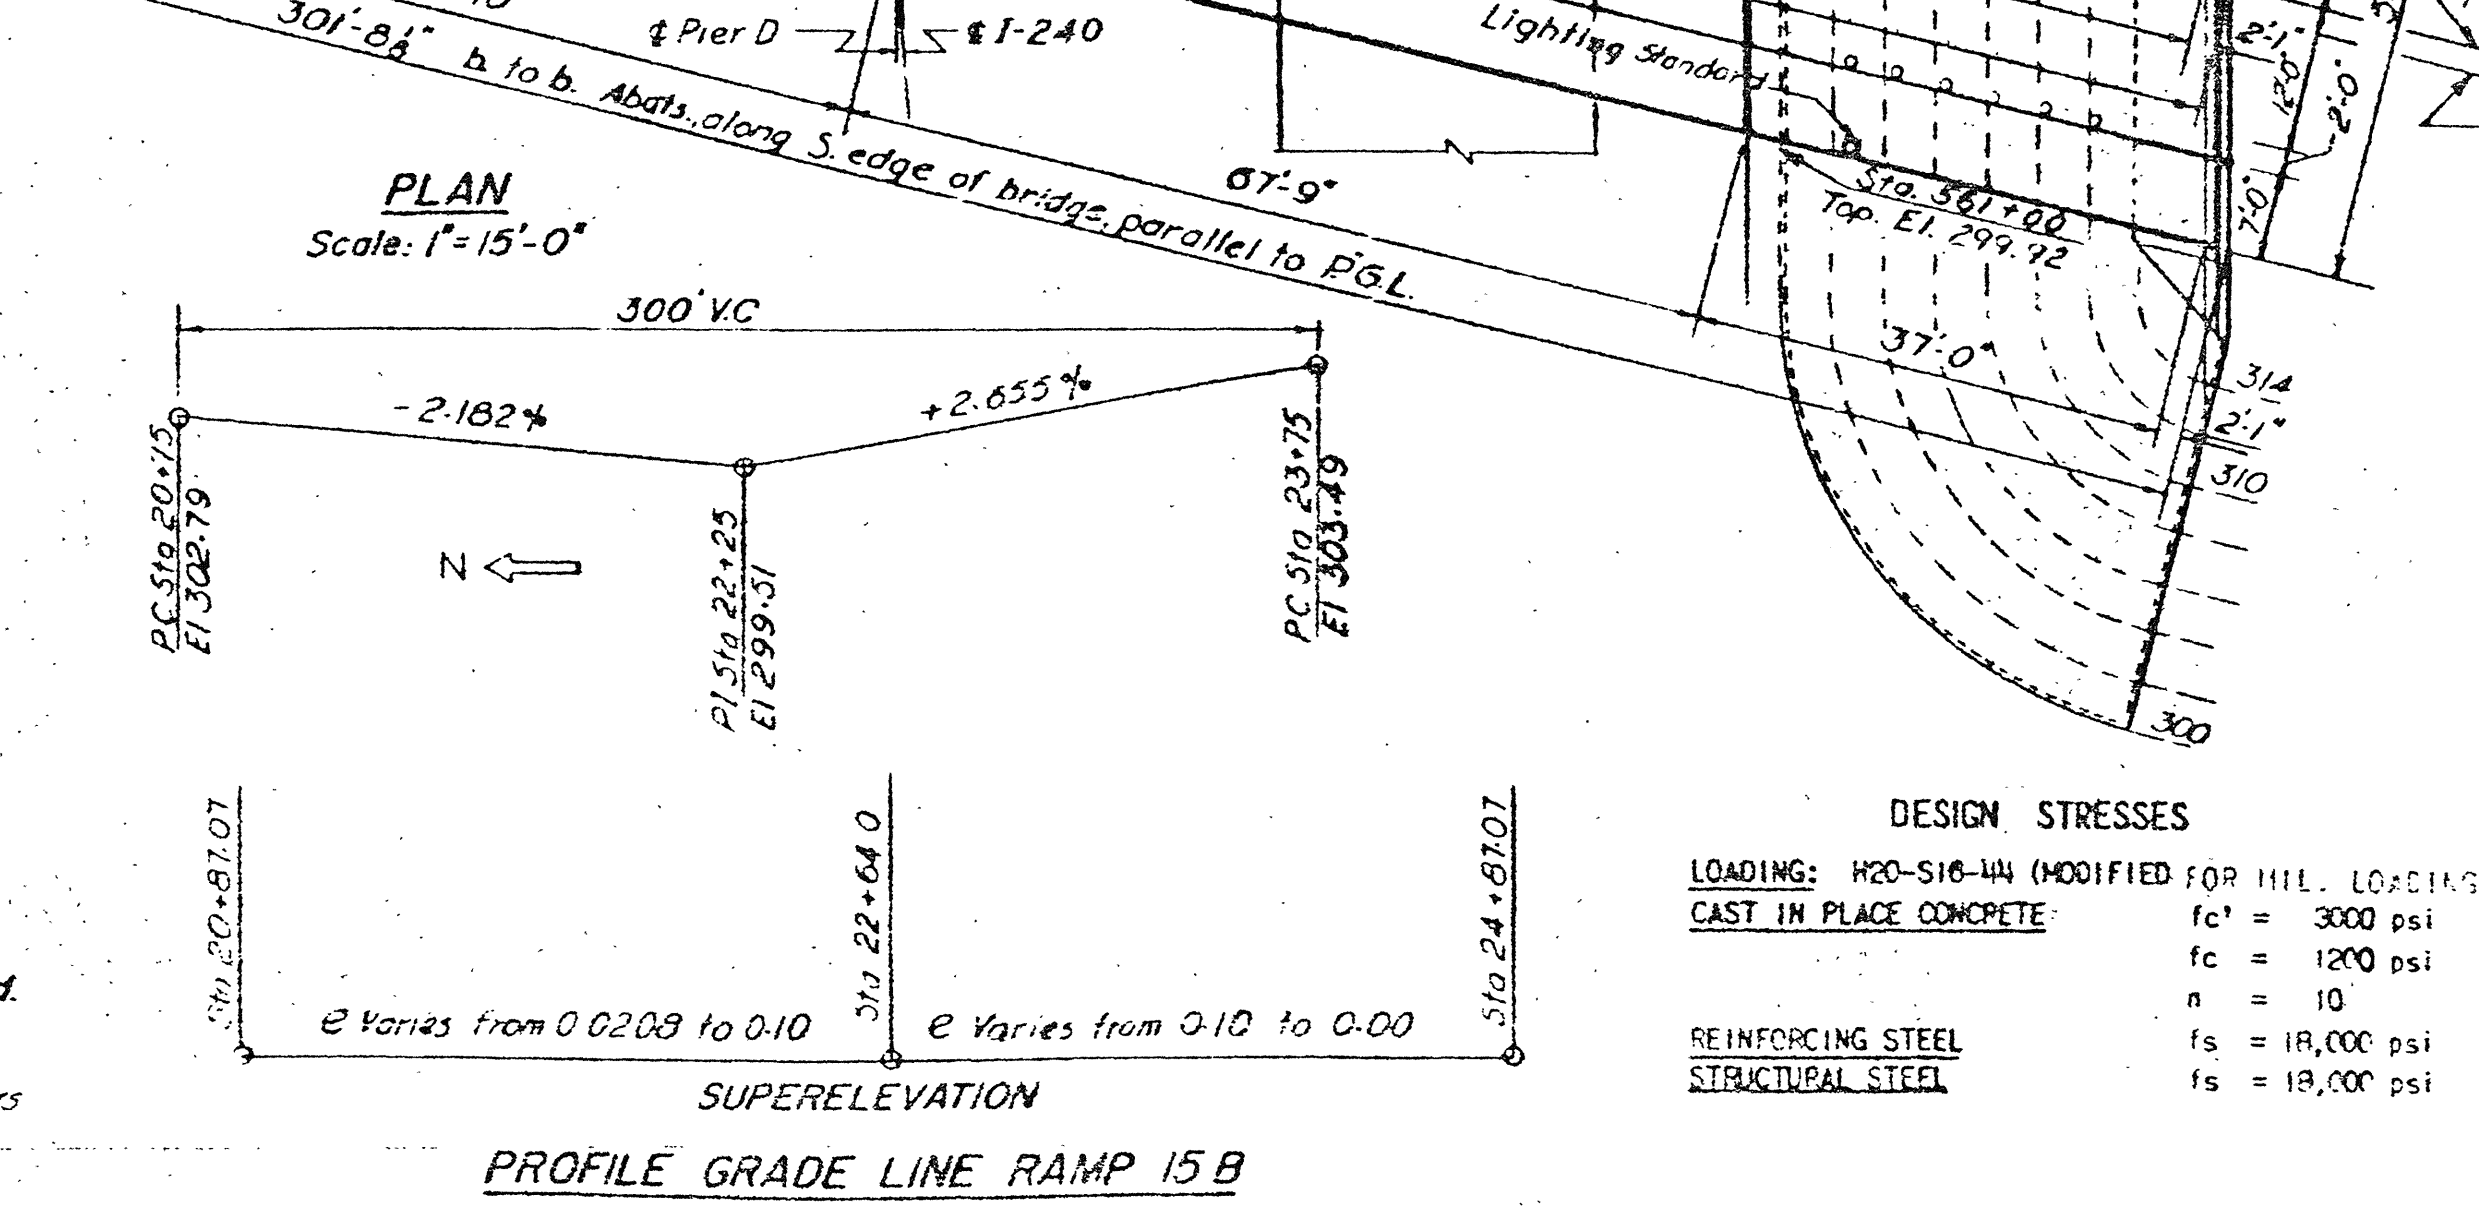

DRAWING	DWG. NO.
BRIDGE LAYOUT	1
ABUTMENTS A & F	2
PIERS B & E	3
PIERS C & D	4
SUPERSTRUCTURE - SLAB	5
SUPERSTRUCTURE - SLAB DETAILS	6
PRESTRESSED BEAMS - SPANS 1 & 5	7
PRESTRESSED BEAMS - SPANS 2, 3 & 4	8
PRESTRESSED BEAMS - SPAN 2	9
HANDRAIL AND LIGHTING DETAILS	10
STANDARD PILE DETAILS - STAND F-2-118 SHT. 3/16	
STANDARD 3 RAIL STEEL HANDRAIL	STD. G-10-100

- Payment for pref. brg. pads, anchor rods, items cast into the beams and threaded dowels, etc. is considered incidental to the contract unit price bid for furnish and place Prestressed Beams Type I & III. Required for bearings for this structure are 29.3 sq. ft. of 1/2 bearing pad & 6.11 sq. ft. of 1" bearing pad.
- All bituminous joint materials & transverse drains are considered incidental to the class A concrete for payment.
- The reinforcing steel includes 114 lbs. of WWF.
- The contractor shall furnish and install anchor bolts for light standards, conduits, condulets, hangers, pull boxes, grounding wire & auxiliary equipment.
- At the contractor's option cast in place concrete piles may be used at Piers B, C, D and E, instead of the precast piles shown. Cast in place piles shall be 4'-0" dia.

**Bridge 15 A**

STATE OF TENNESSEE  
DEPARTMENT OF HIGHWAYS AND PUBLIC WORKS  
PROJECT I-240-1 (17) 13 AMLBY CO.  
MEMPHIS CIRCUMFERENTIAL INTERSTATE HIGHWAY  
SOUTHEAST SECTION

HARLAND BARTHOLOMEW AND ASSOCIATED ENGINEERS  
CLARK AND DAILY ASSOCIATED ENGINEERS

**W.B. POPLAR AVENUE OVER I-240  
BRIDGE LAYOUT**

DATE: 11-10-58 As noted  
SCALE: AS NOTED  
DRAWN BY: V.P.  
CHECKED BY: G.N.  
APPROVED BY: B.C.C.  
JOB NO. 332  
11-10-58 As noted



PUB. ROAD DIV. NO.	STATE	PROJECT NO.	FISCAL YEAR	SHEET NO.	TOTAL SHEETS
3	TENNESSEE	1-240-1 (17) 13	1959	173	334


REVISION 11-10-59

NOTES  
1. See Bridge Dwg. 1 for General Notes, Design Stresses, and Pile Data.


**BILL OF STEEL**

Bar	Size	Abt. A	Abt. F	Length	Shape	Location
Ha1	#8	10	10	55'-3"	—	Seat
Ha2	#4	8	8	28'-6"	—	Parapt.
Ha3	#4	28	28	9'-3"	—	W.Wall
Ha4	#4	4	4	14'-0"	—	W.Wall
Va1	#4	58	60	13'-0"	⊓	Seat
Va2	#4	85	85	6'-1"	⊓	Parapt.
Va3	#5	26	26	10'-1"	⊓	W.Wall
Va4	#4	28	28	8'-2"	⊓	W.Wall
Va5	#4	85	85	2'-0"	⊓	Parapt.


\* 22-1"Øx1'-6" Anchor rods are req'd at Abuts=110°  
\* Not included in quantities this sheet. Considered incidental to the prestressed beams for payment.

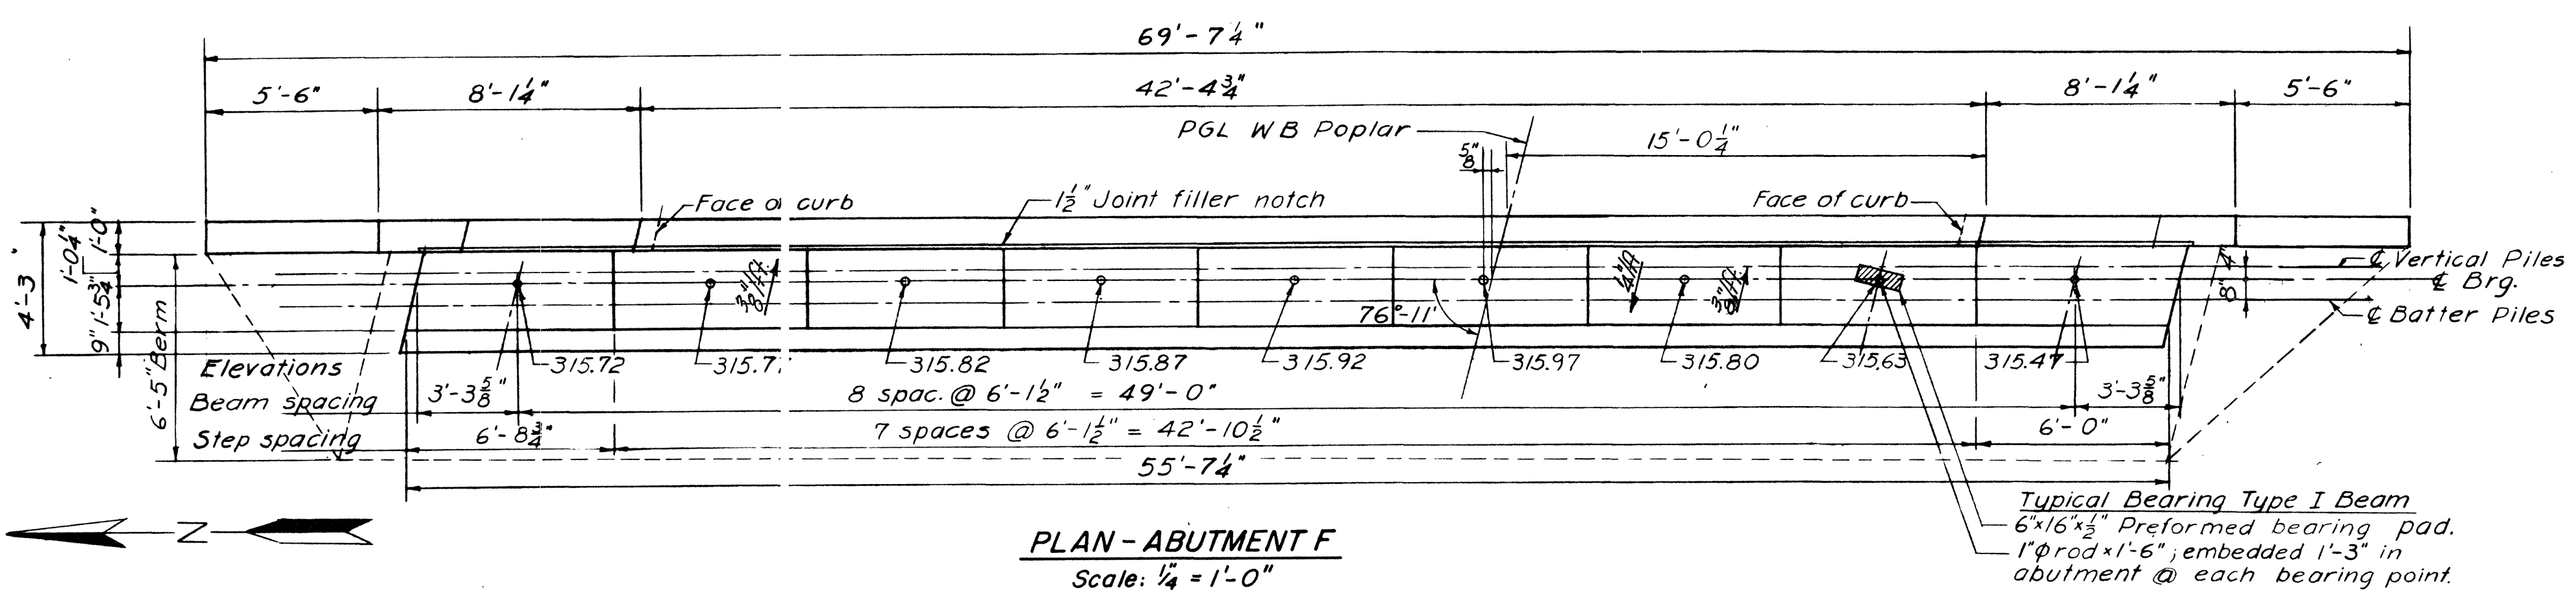


**PLAN - ABUTMENT F**  
Scale: 1/4" = 1'-0"

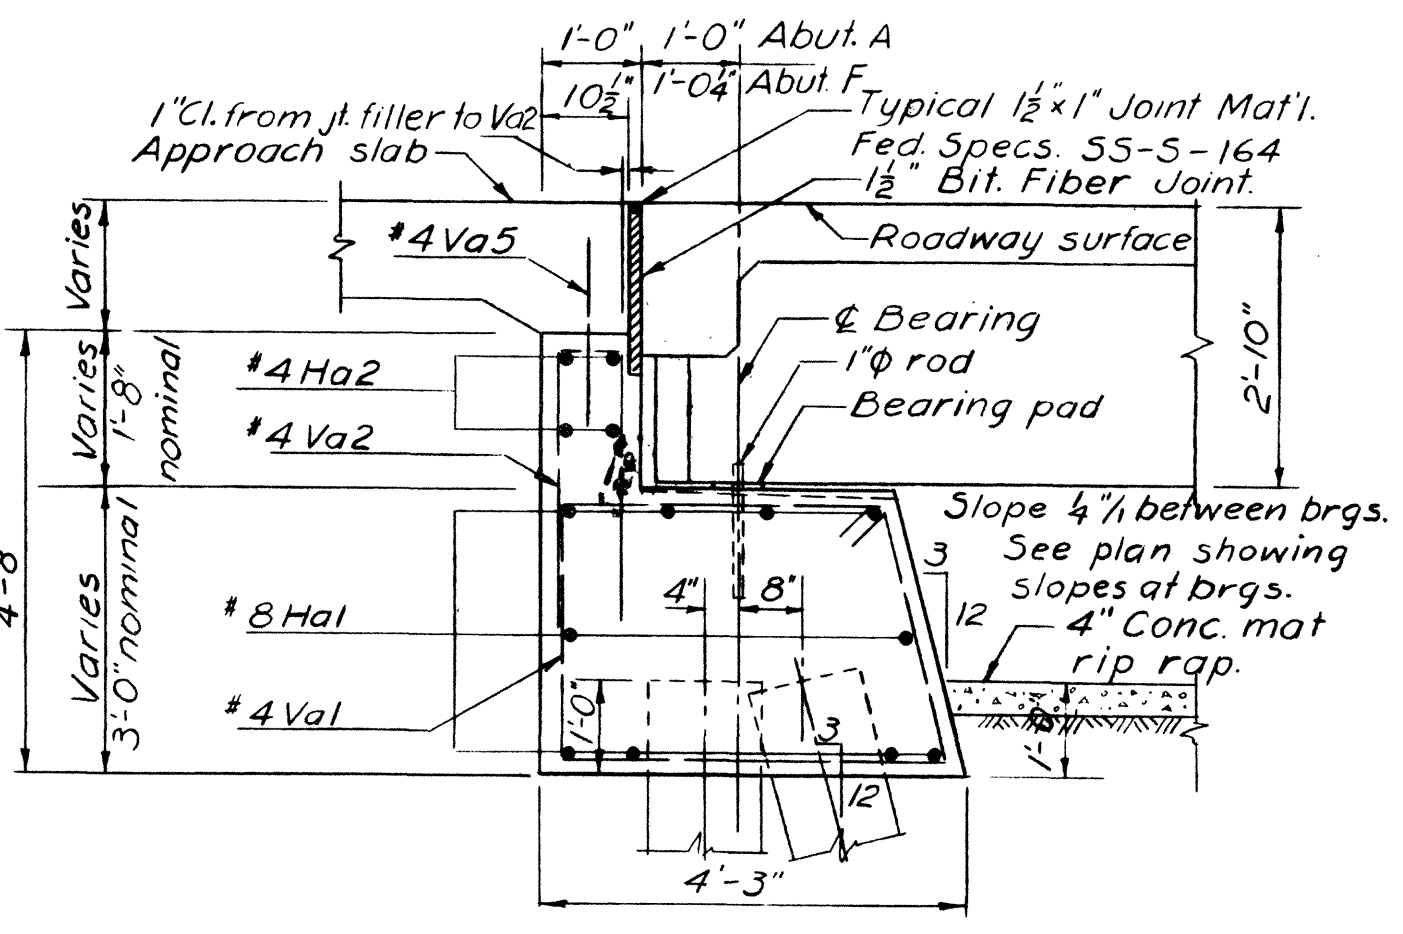

**SECTION A-A**  
Scale: 1/2" = 1'-0"

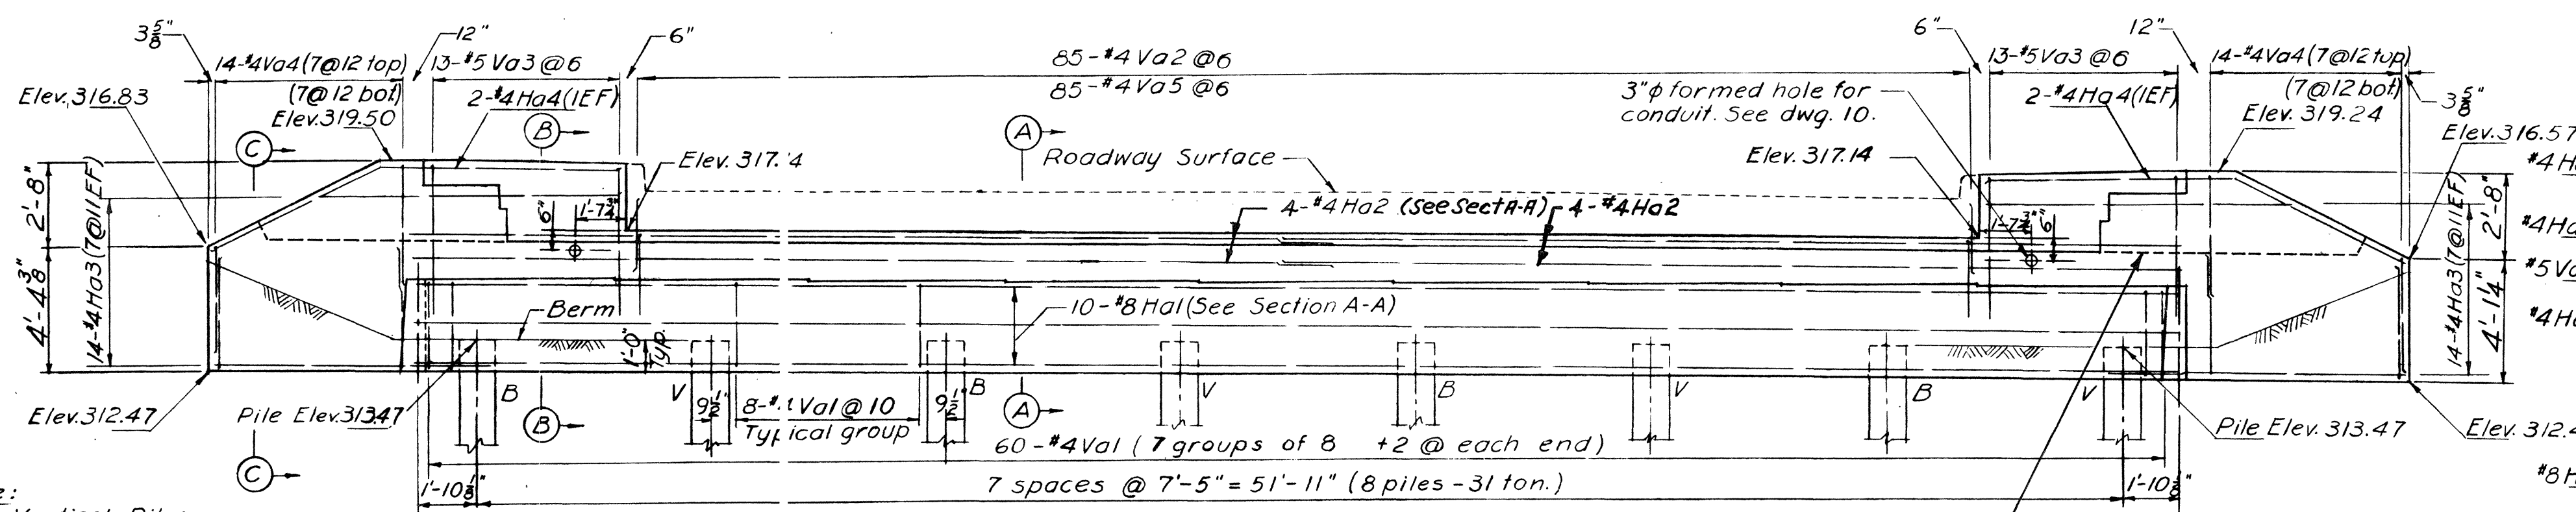


**ELEVATION - ABUTMENT F**  
Scale: 1/4" = 1'-0"

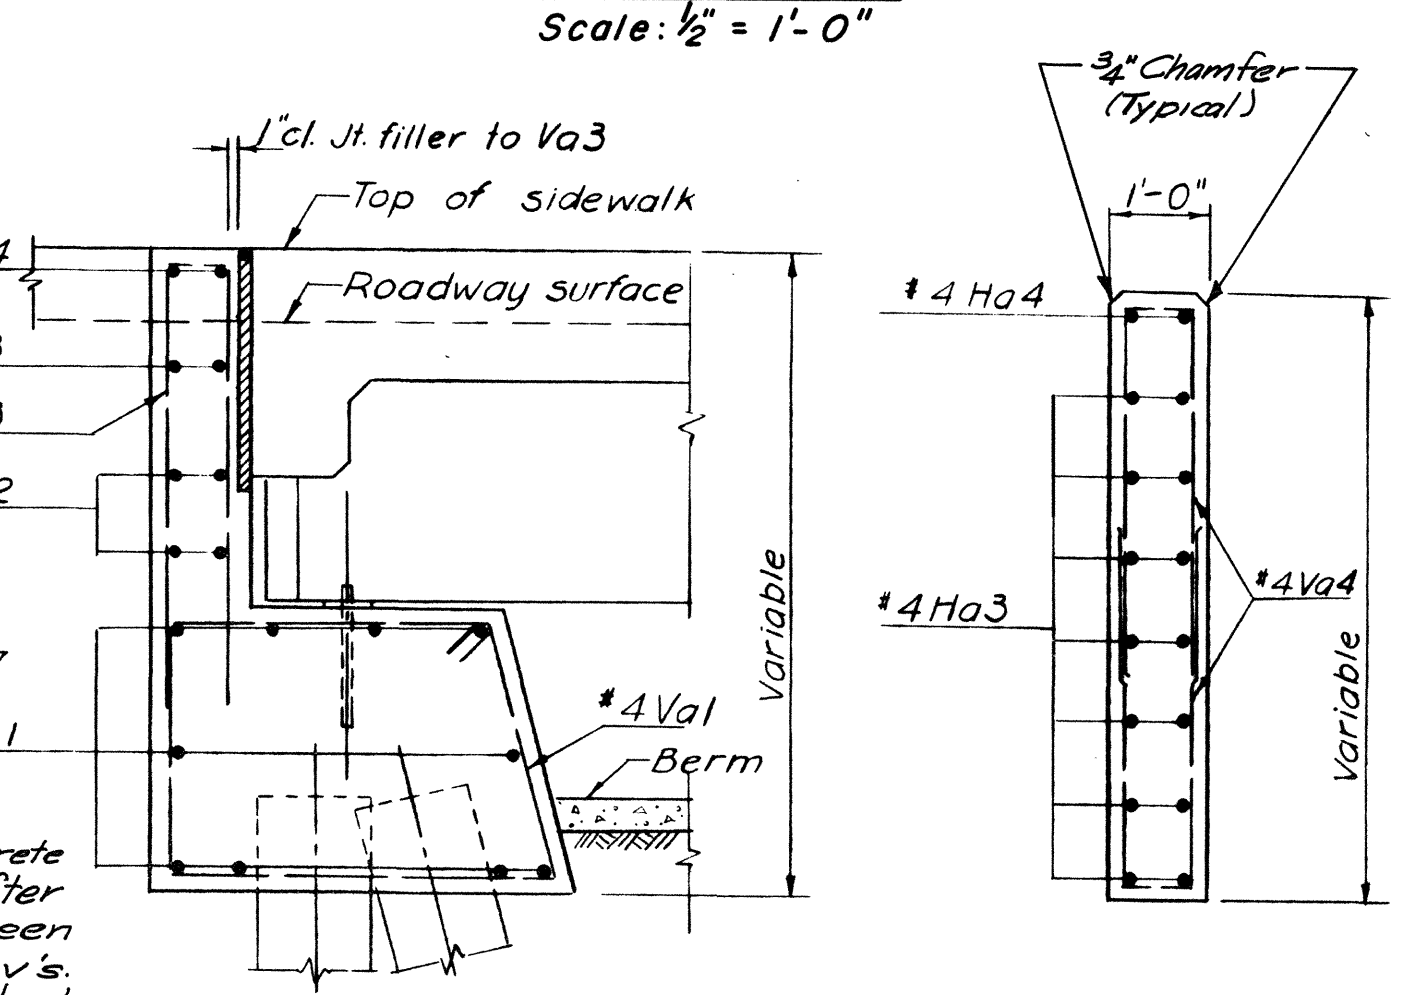


**SECTION B-B**  
Scale: 1/2" = 1'-0"


**SECTION C-C**  
Scale: 1/2" = 1'-0"

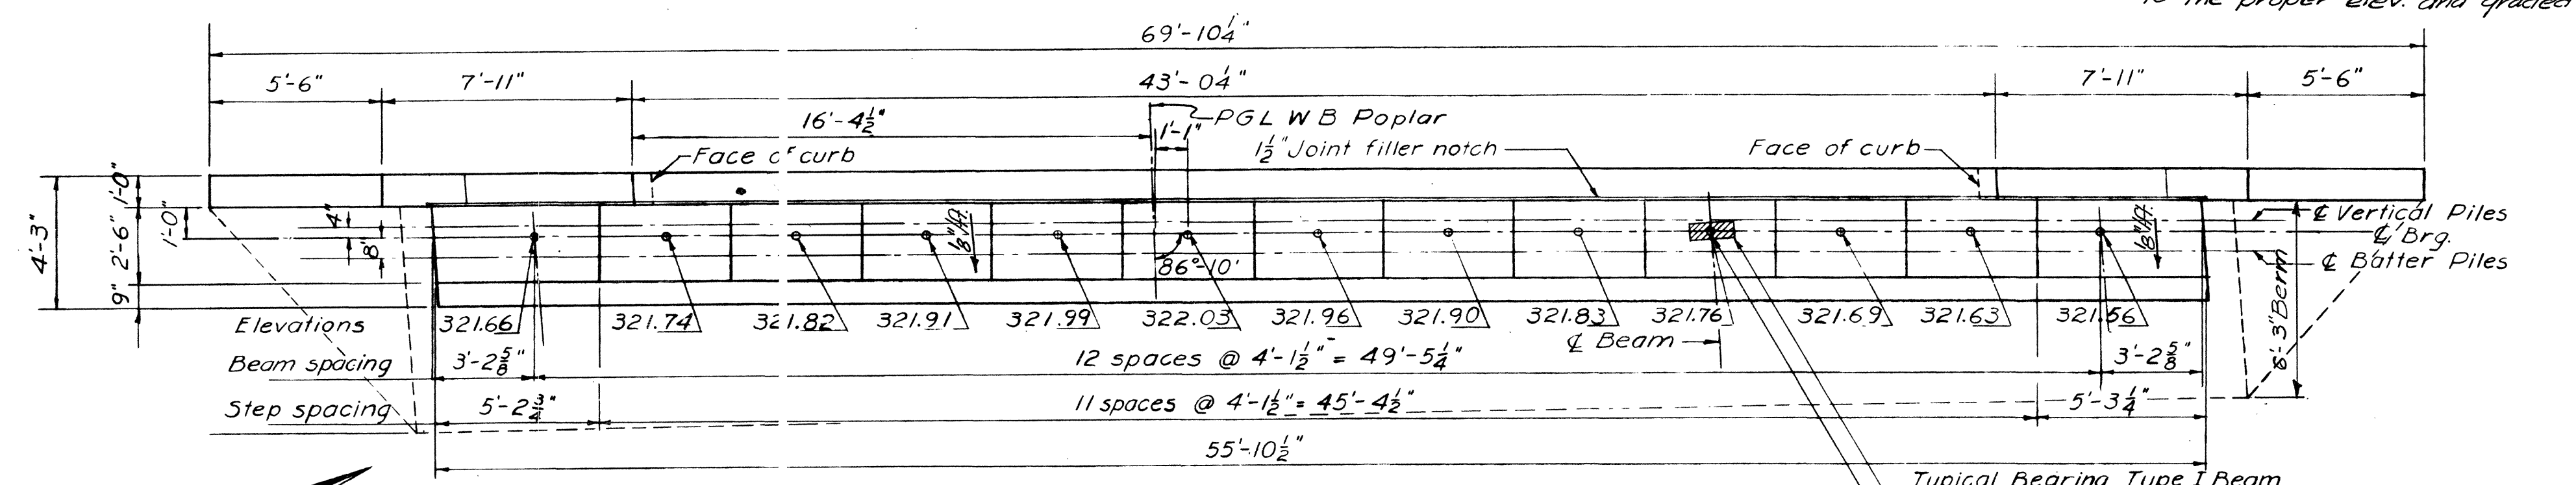

**PLAN - ABUTMENT A**  
Scale: 1/4" = 1'-0"

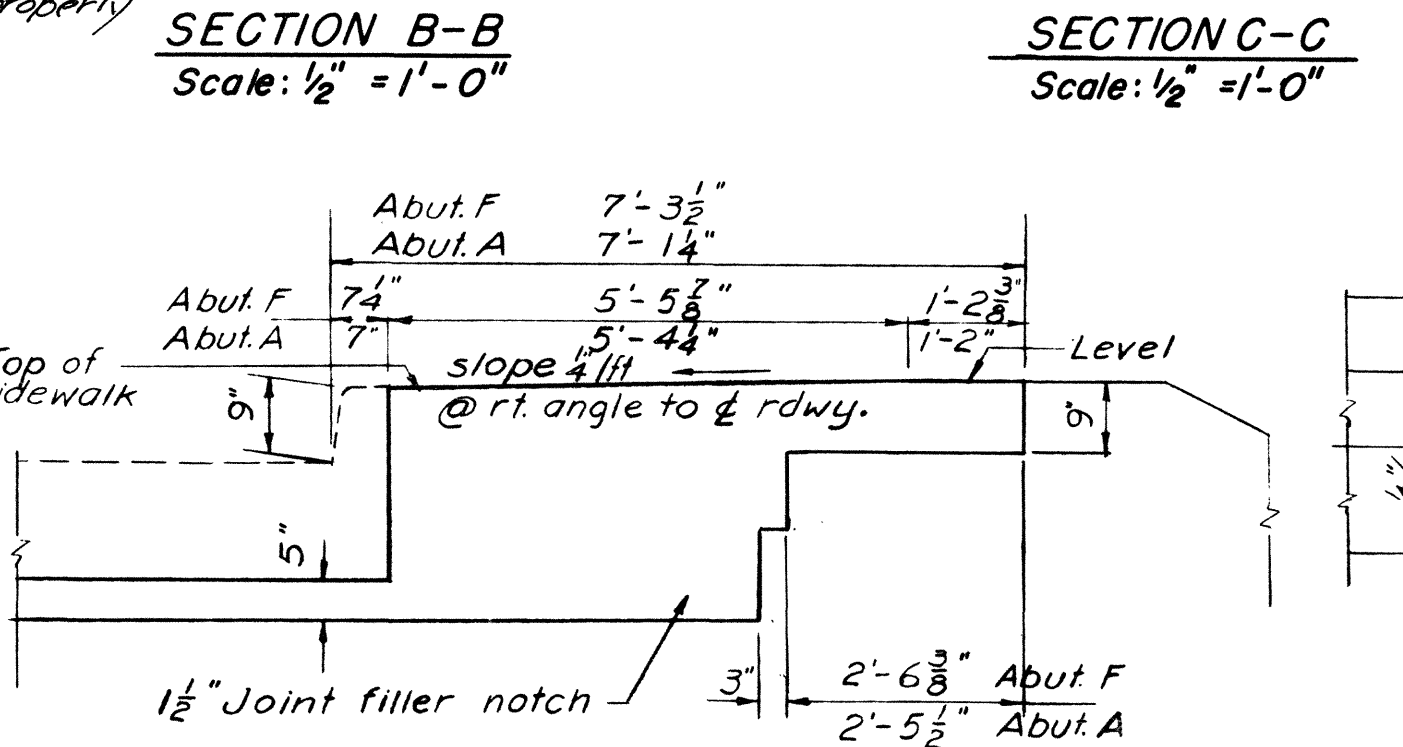


**JOINT FILLER NOTCH**  
Scale: 1/2" = 1'-0"

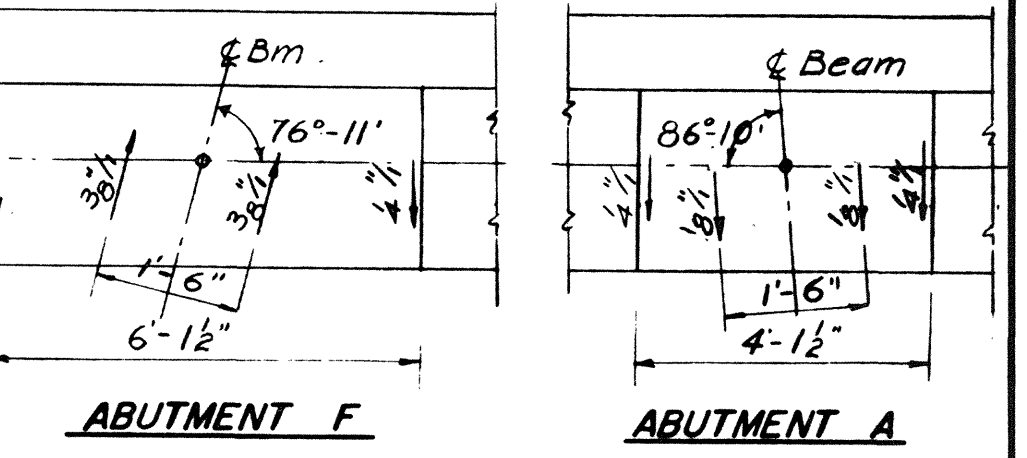


**PLAN SHOWING FINISH SLOPES ON BEARING SEATS**  
Scale: 3/8" = 1'-0"

**ESTIMATED QUANTITIES**

ITEM	UNIT	QUANTITY	
		ABT. A	ABT. F
Class A Concrete	Cu. Yds.	32.4	31.7
Steel Bar Reinforcing	Lbs.	3230	3250

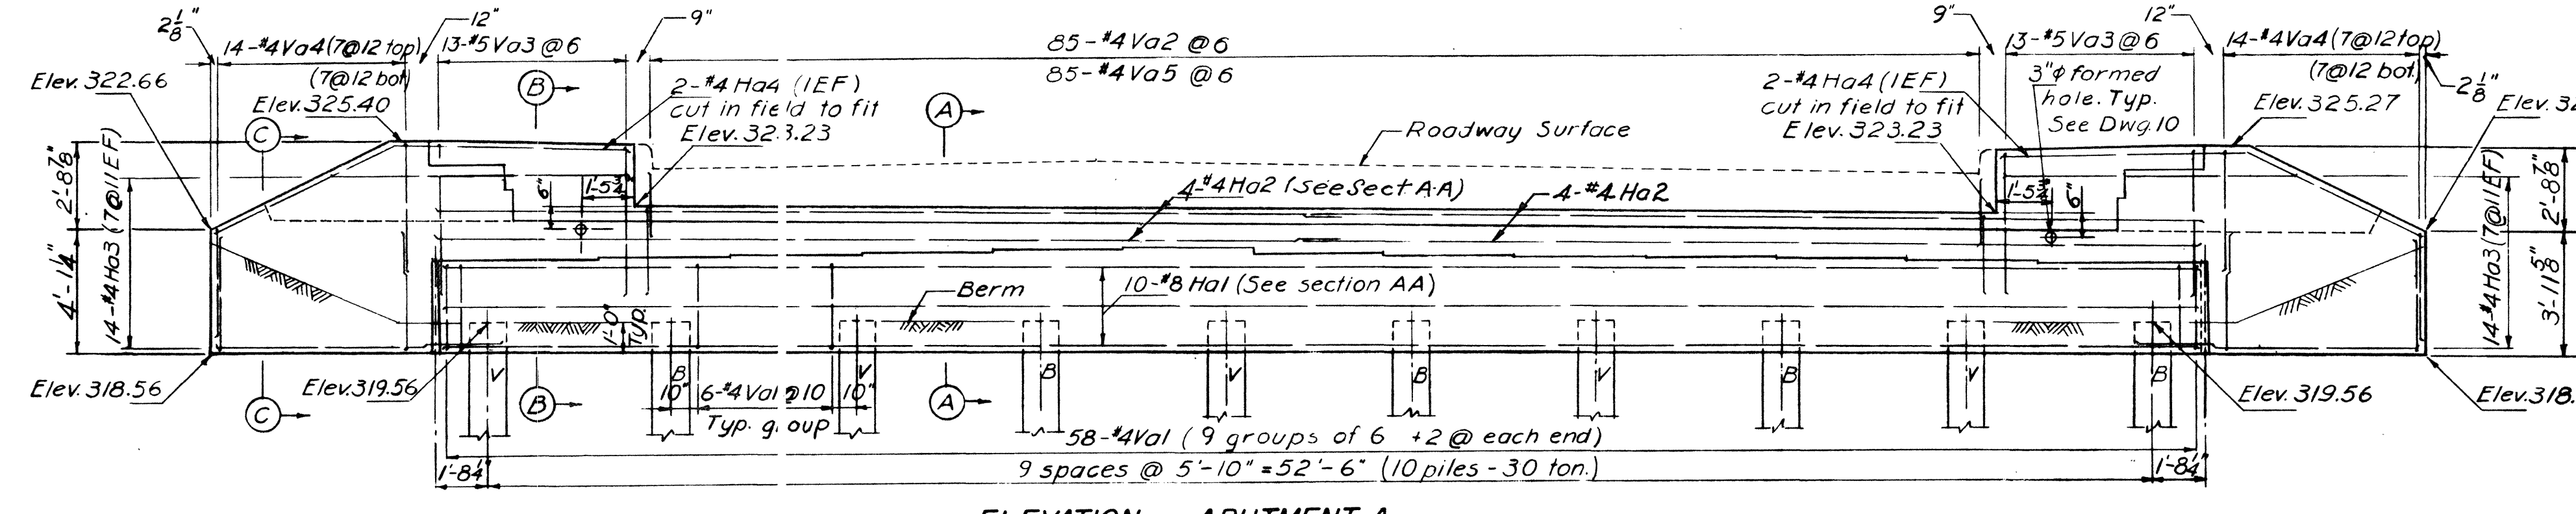

**ELEVATION - ABUTMENT A**  
Scale: 1/4" = 1'-0"

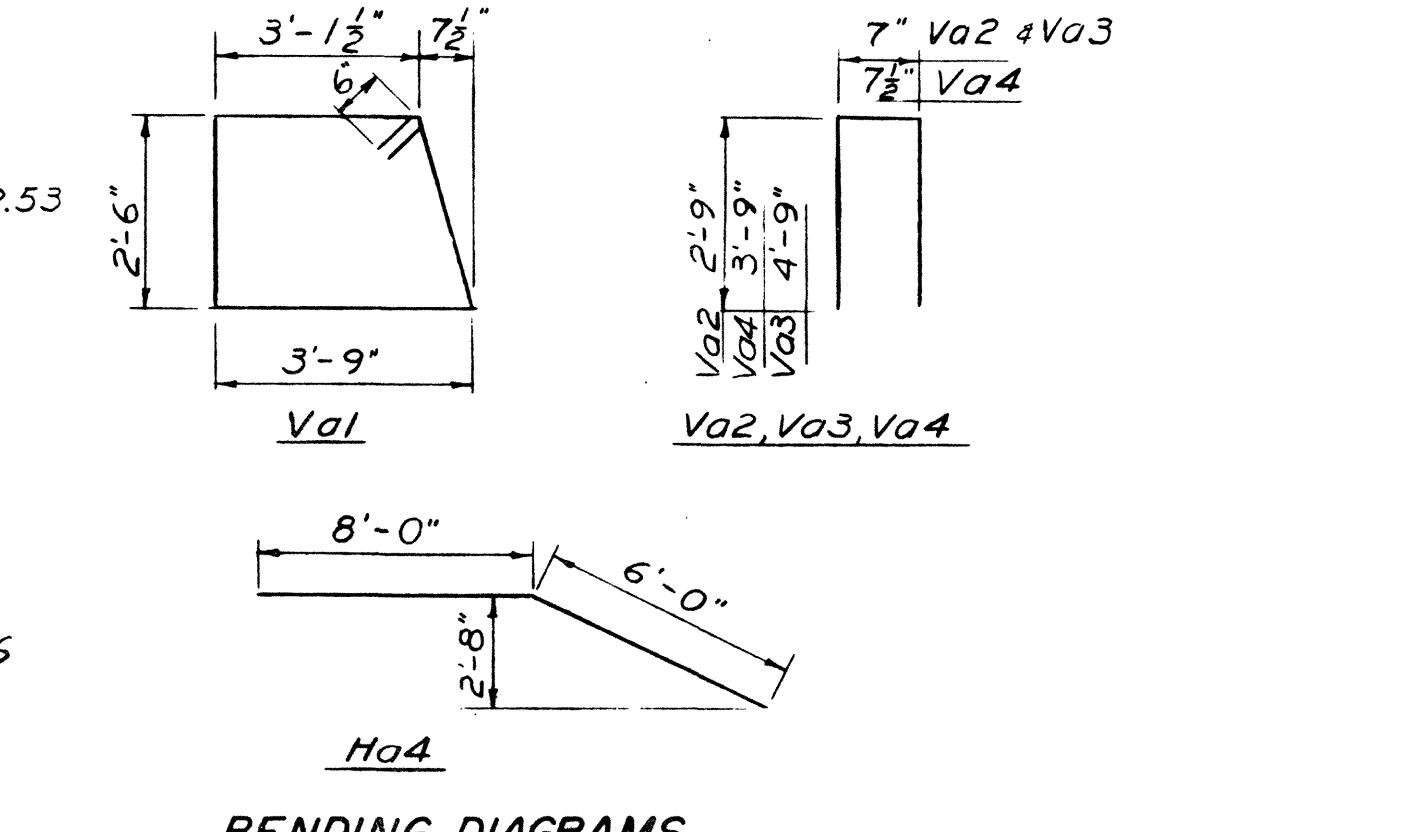

**BENDING DIAGRAMS**  
No Scale

Bridge 15 A

STATE OF TENNESSEE  
DEPARTMENT OF HIGHWAYS AND PUBLIC WORKS  
PROJECT 1-240-1 (17) 13 SHELLEY CO.  
MEMPHIS CIRCUMFERENTIAL INTERSTATE HIGHWAY  
SOUTHEAST SECTION

HARLAND BARTHOLOMEW AND ASSOCIATES, ENGINEERS  
CLARK AND DAILY ASSOCIATED ENGINEERS

**W.B. POPLAR AVENUE OVER I-240**  
**ABUTMENTS A & F**

DATE: 11-10-58 SCALE: AS NOTED DRAWN BY: W.G. CHECKED BY: G.N. IN CHARGE: B.C.C. H-11-18








PUB. ROADS DIV. NO.	STATE	PROJECT NO.	FISCAL YEAR	SHEET NO.	TOTAL SHEETS
3	TENNESSEE	I-240-1 (17) 13	1969	174	334

REVISION  
11-10-59  
12-18-59

REVISION  
2-16-62 Reinf. Steel Quant.


**NOTES**  
1. See Bridge Dwg. 1 for General Notes, Design Stresses, and Pile Data.  
2. Elevations at bearing locations on piers are given to the bottom of the neoprene bearing pads. These elevations may be obtained by stepping the pier cap, or using other approved methods.

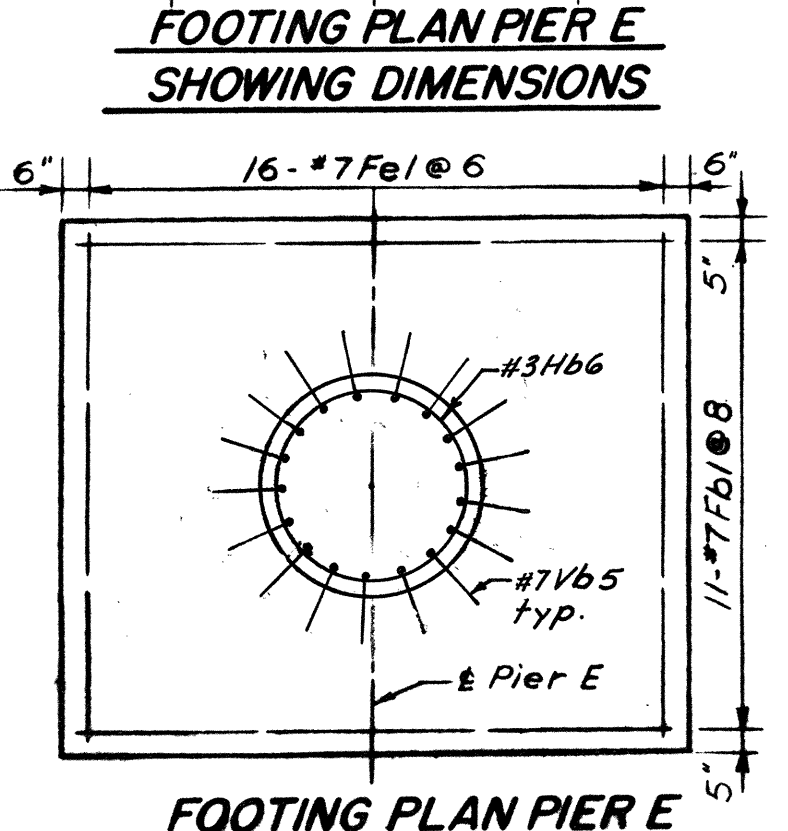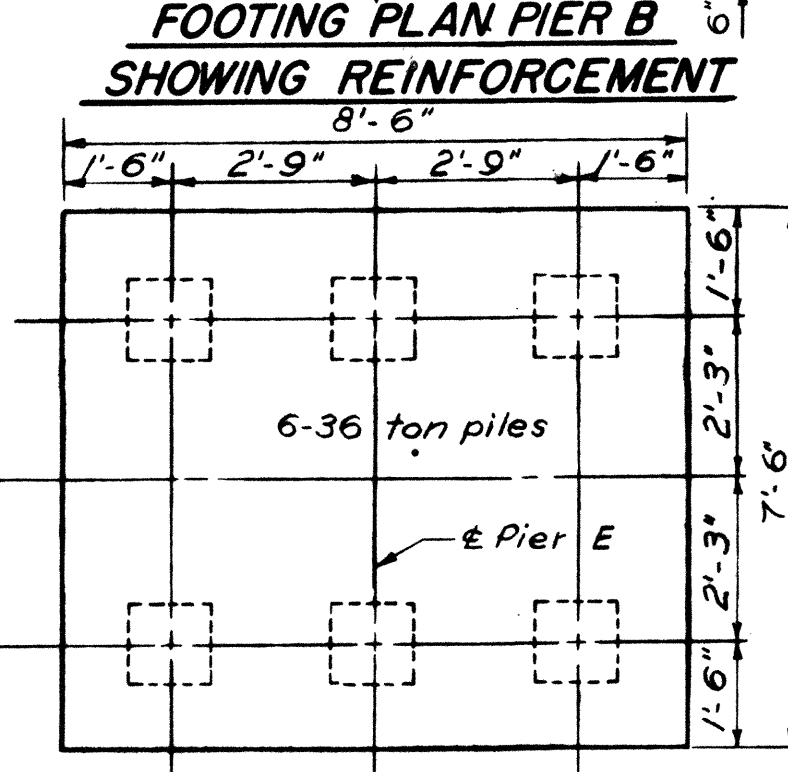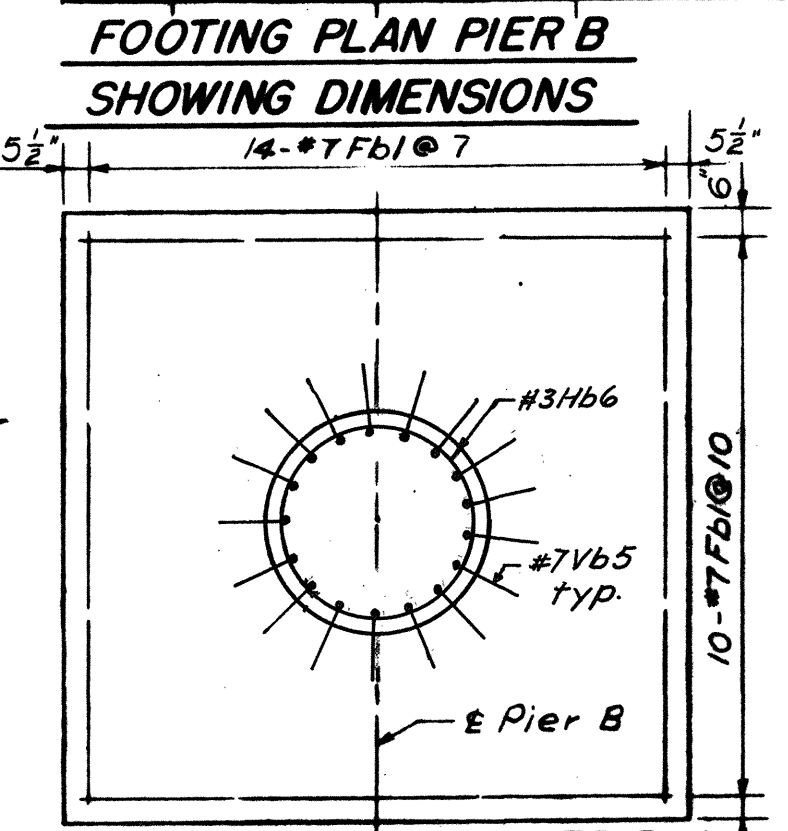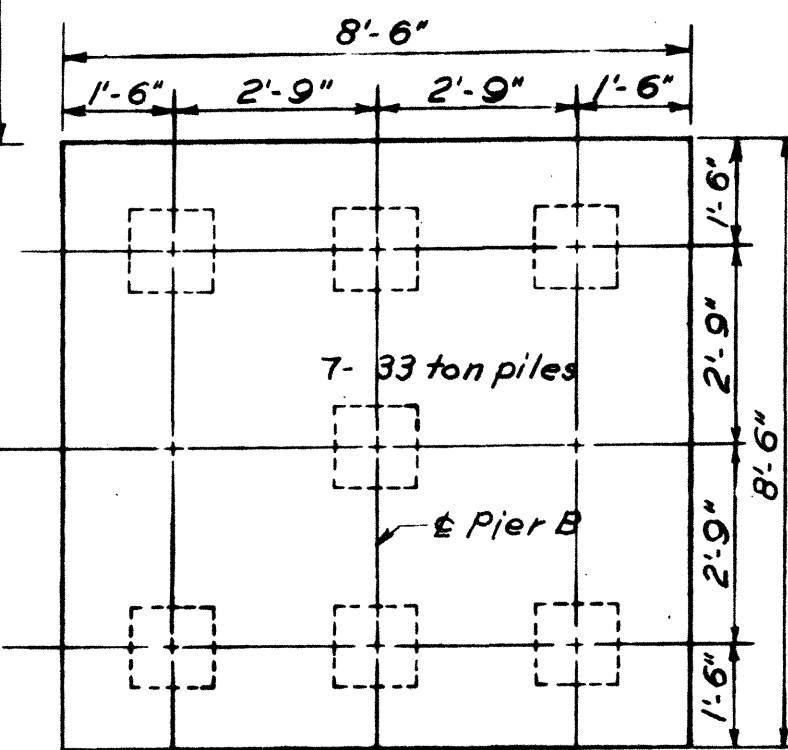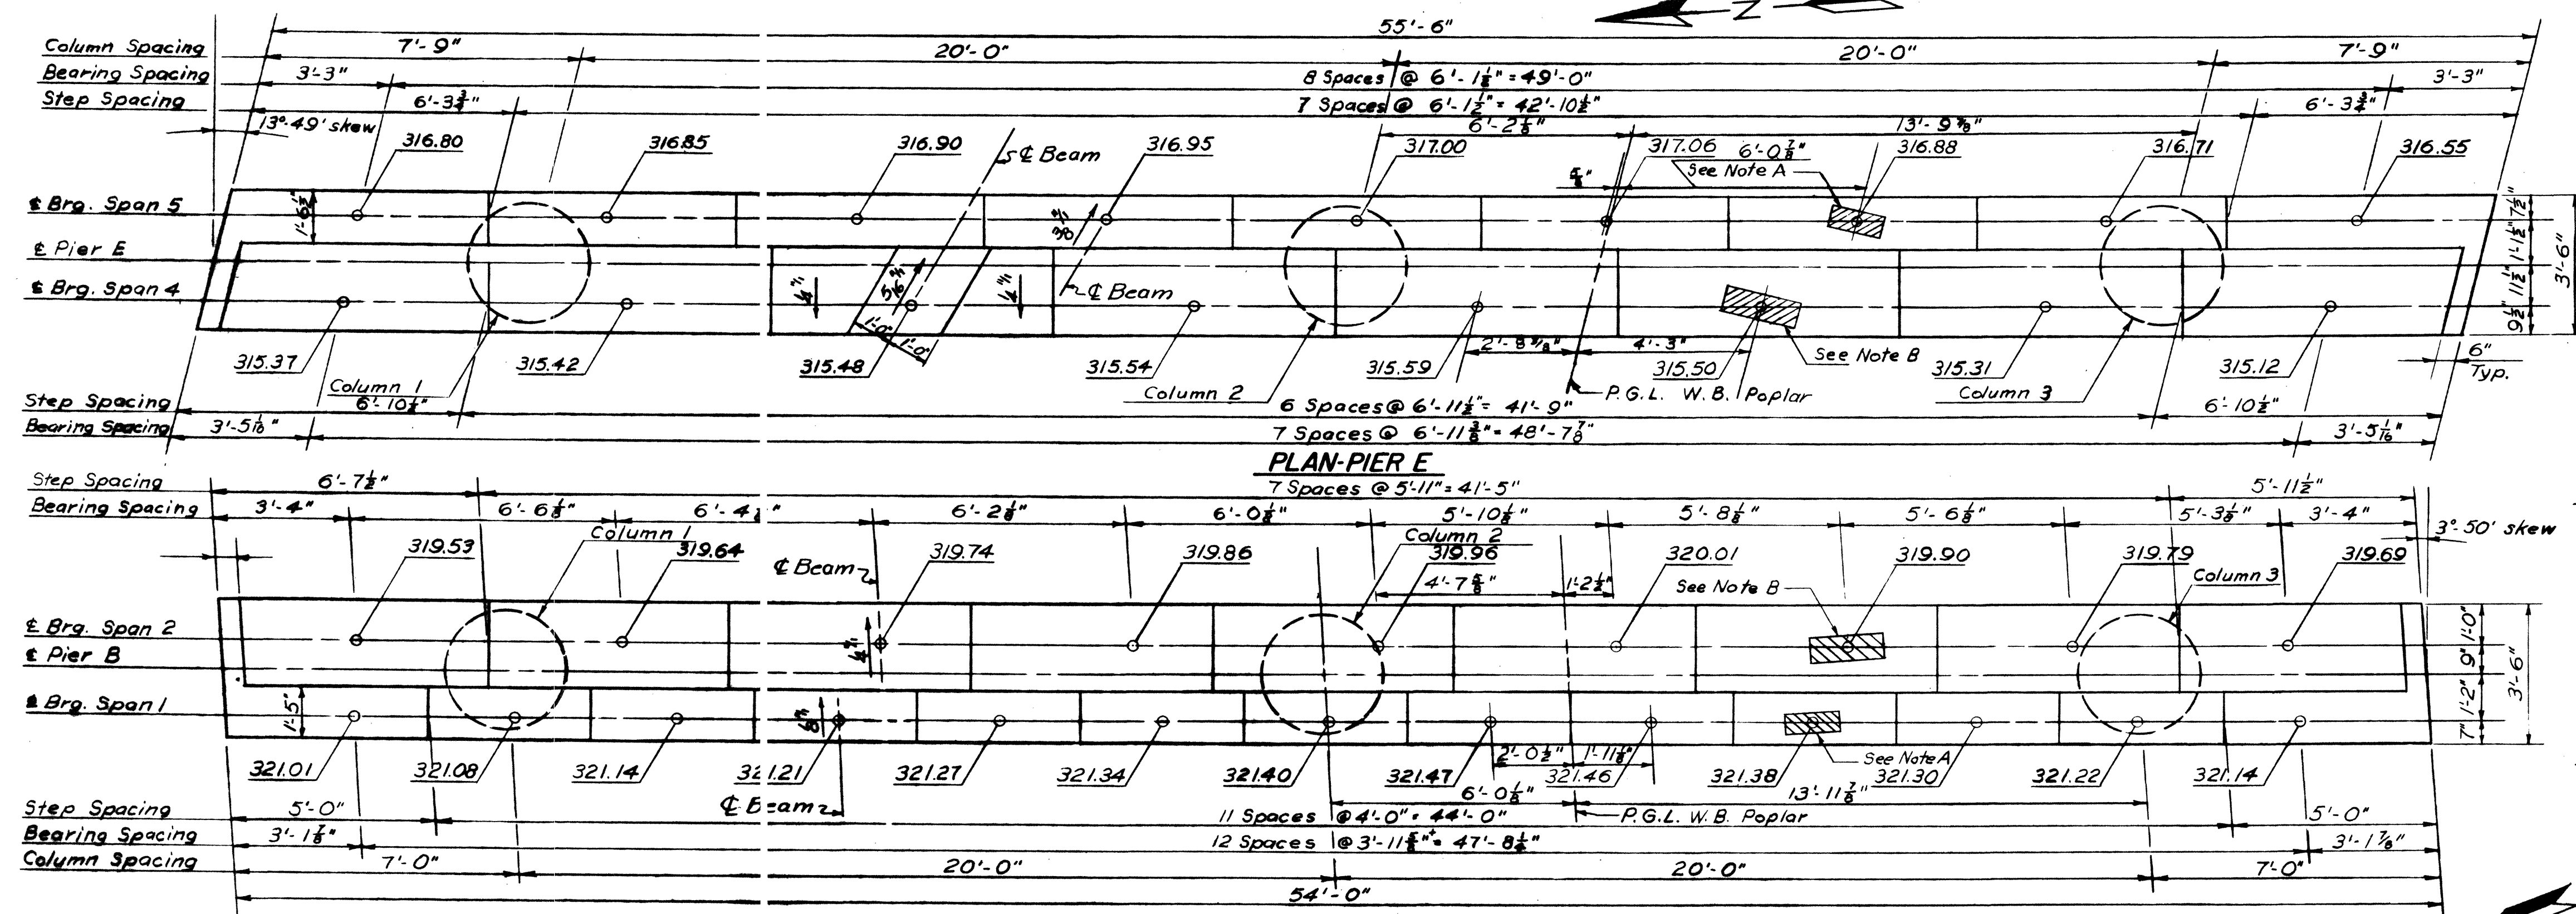

**BILL OF STEEL**

Bar	Pier B	Pier E	Size	Length	Shape	Location
Fb1	72	33	#7	8'-0"	—	Footing
Fel	—	48	#7	7'-0"	—	Footing
Hb1	6	—	#8	53'-8"	—	Cap
Hb2	11	—	#10	53'-8"	—	Cap
Hb3	6	—	#10	40'-0"	—	Cap
Hb4	6	—	#6	53'-8"	—	Cap
Hb5	4	—	#10	53'-8"	—	Cap
Hb6	57	45	#3	9'-0"	○	Column
He1	—	6	#8	55'-2"	—	Cap
He2	—	11	#10	55'-2"	—	Cap
He3	—	6	#10	40'-0"	—	Cap
He4	—	6	#6	55'-2"	—	Cap
He5	—	4	#10	55'-2"	—	Cap
Vb1	106	110	#4	6'-1"	□	Cap
Vb2	58	58	#5	13'-6"	□	Cap
Vb3	36	40	#5	7'-4"	□	Cap
Vb4	51	—	#7	18'-4"	—	Column
Vb5	51	51	#7	6'-0"	—	Col. Ftg.
Ve4	—	51	#7	14'-10"	—	Column

\* 39-1/2" x 1'-6" Anchor rods are req'd at Piers B & E = 190 lbs.  
\* Not included in quant. this sht. Considered incidental to prestressed beams for payment.

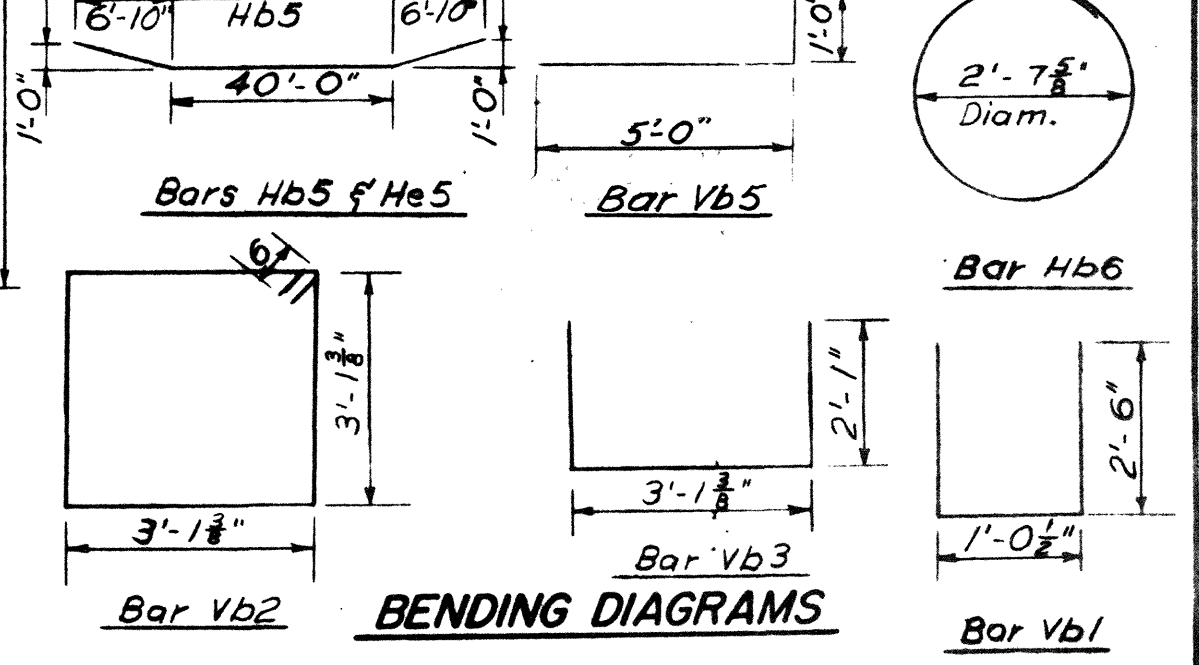

**ESTIMATED QUANTITIES**

ITEM	UNIT	QUANTITY
Class A Concrete	Cu. Yds.	69.5 63.4
Steel Bar Reinforcement	Lbs.	11,270 11,090

Bridge 15 A


STATE OF TENNESSEE  
DEPARTMENT OF HIGHWAYS AND PUBLIC WORKS  
PROJECT I-240-1 (17) B SHELBY CO.  
MEMPHIS CIRCUMFERENTIAL INTERSTATE HIGHWAY  
SOUTHEAST SECTION

HARLAND BARTHOLOMEW AND ASSOCIATES, ENGINEERS  
CLARK AND DAILY ASSOCIATED ENGINEERS

**WB. POPLAR OVER I - 240  
PIERS B & E**

DATE: 11-26-58 SCALE: AS SHOWN DRAWN BY: D. A. S. CHECKED BY: G. N. IN CHARGE: B. C. C. H-11-19

JOB NO. 332

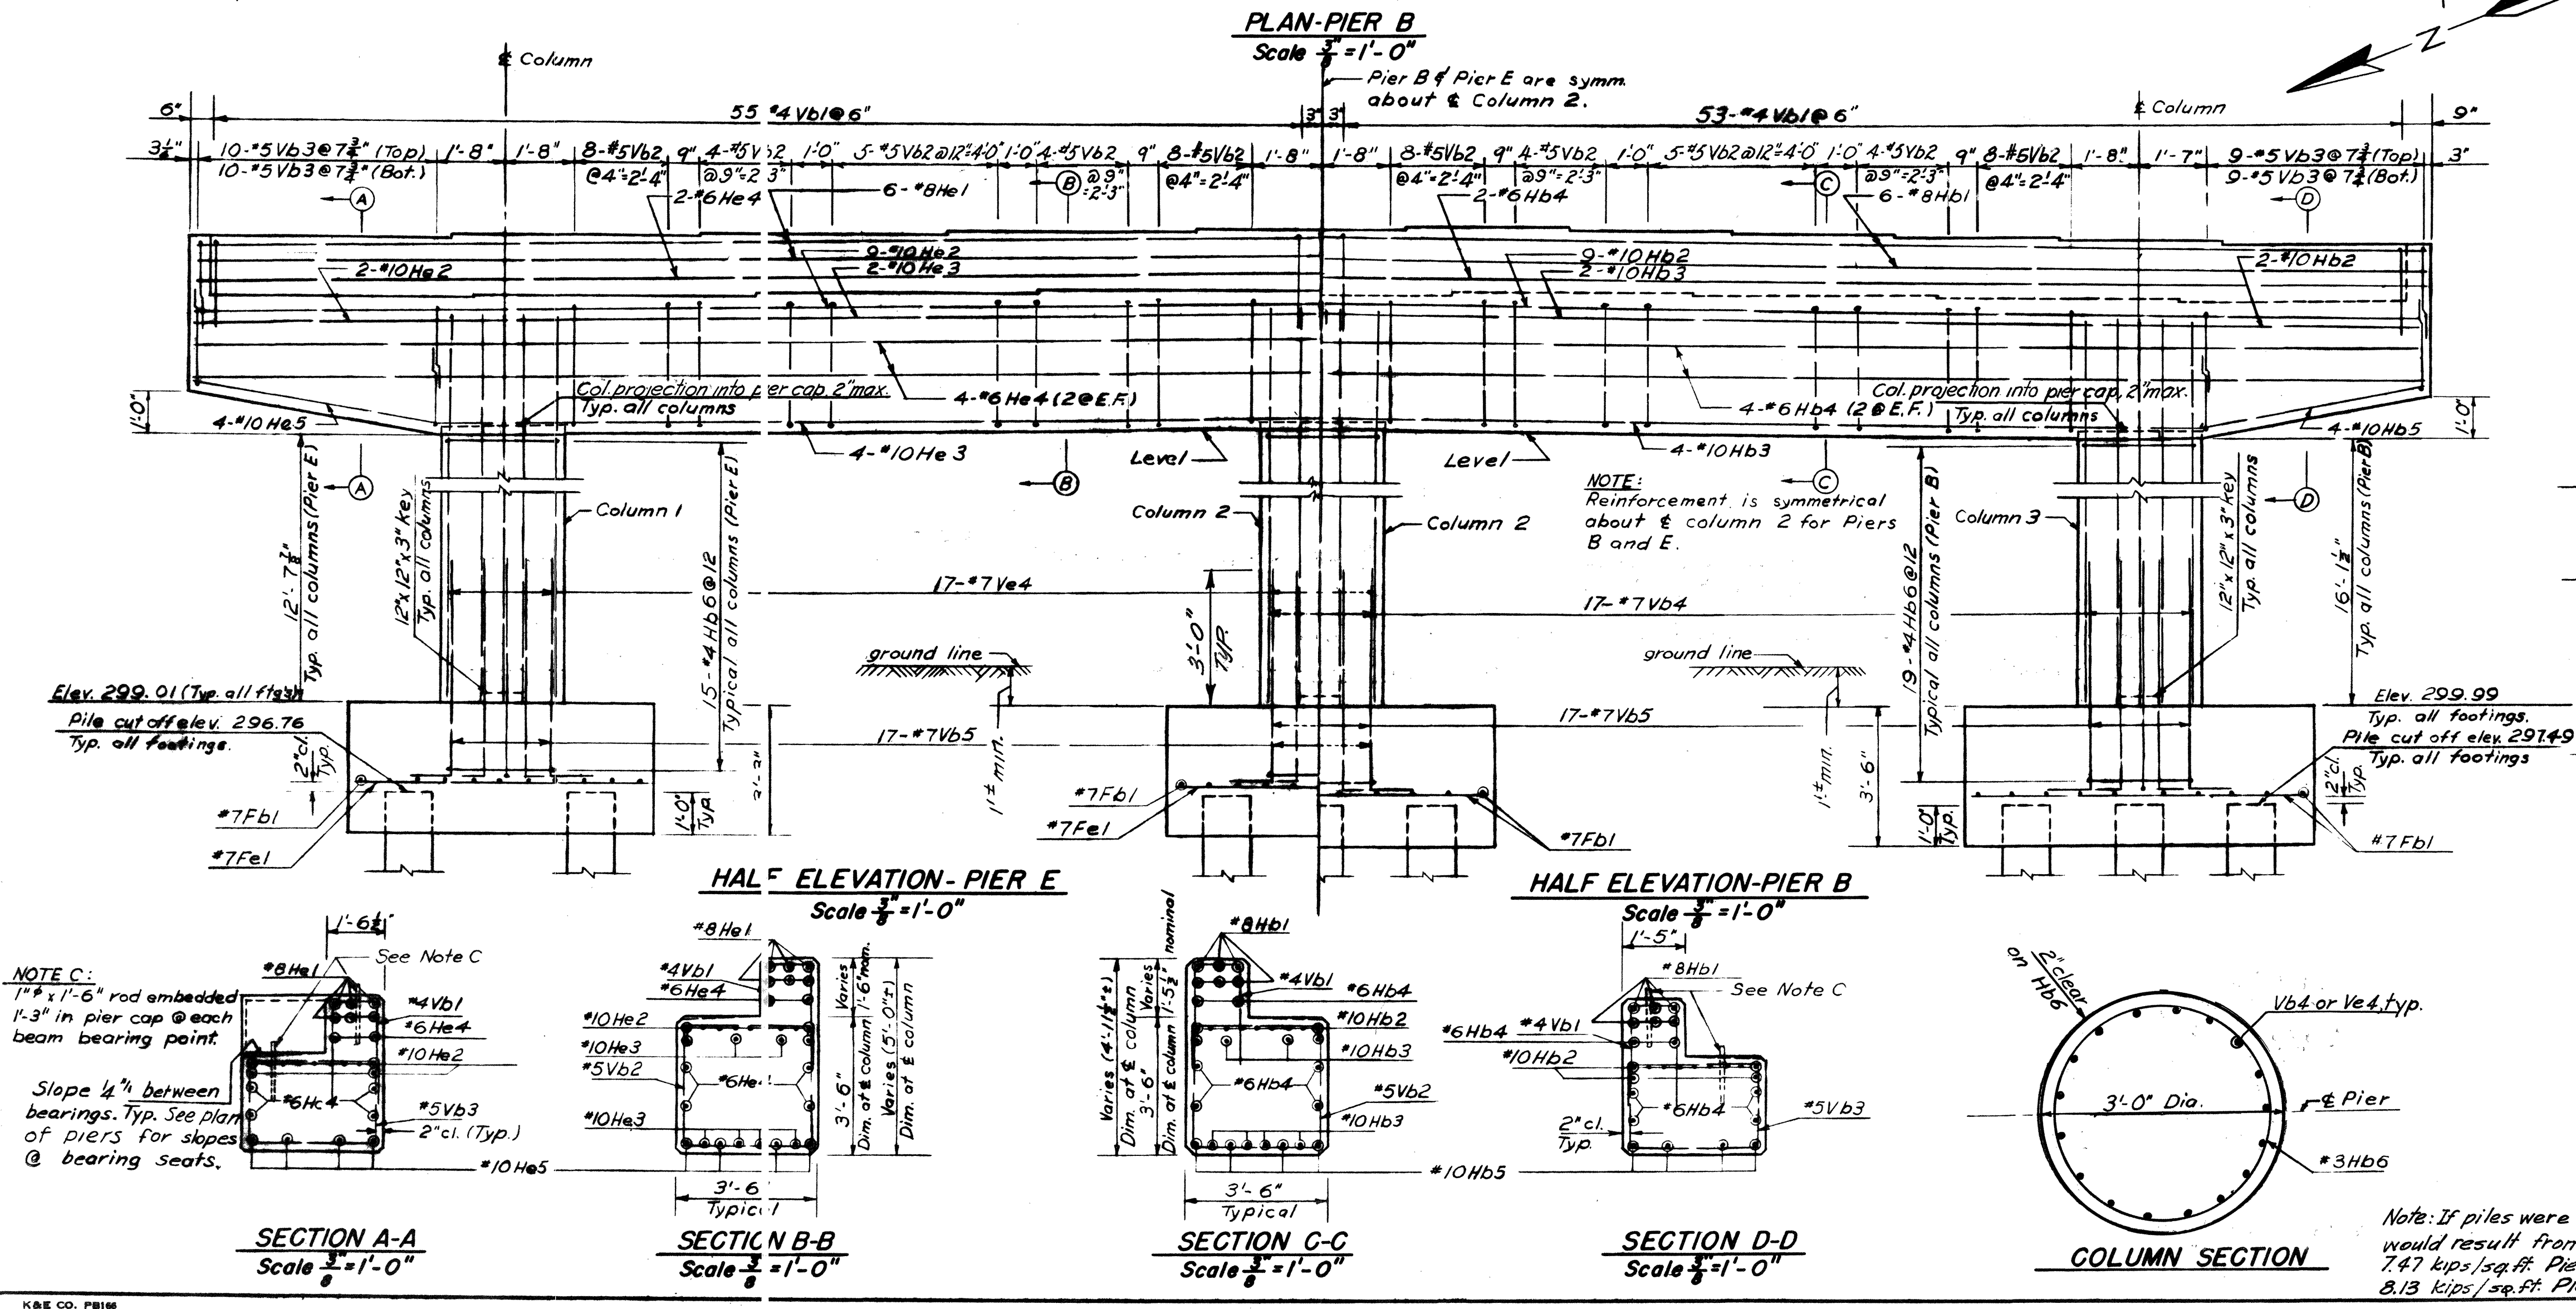




Note: If piles were omitted, the maximum soil pressure that would result from the design loads would be;  
7.47 kips/sq. ft. Pier B  
8.13 kips/sq. ft. Pier E



PUB. ROAD DIV. NO.	STATE	PROJECT NO.	FISCAL YEAR	SHEET NO.	TOTAL SHEETS
3	TENNESSEE	1-240-1 (17) 13	1959	175	334

REVISION	11-10-59
	12-18-59
REVISION	2-16-62 Reinf. Steel Quant.






**NOTES**  
1. See Bridge Dwg. 1 for General Notes, Design Stresses, and Pile Data.

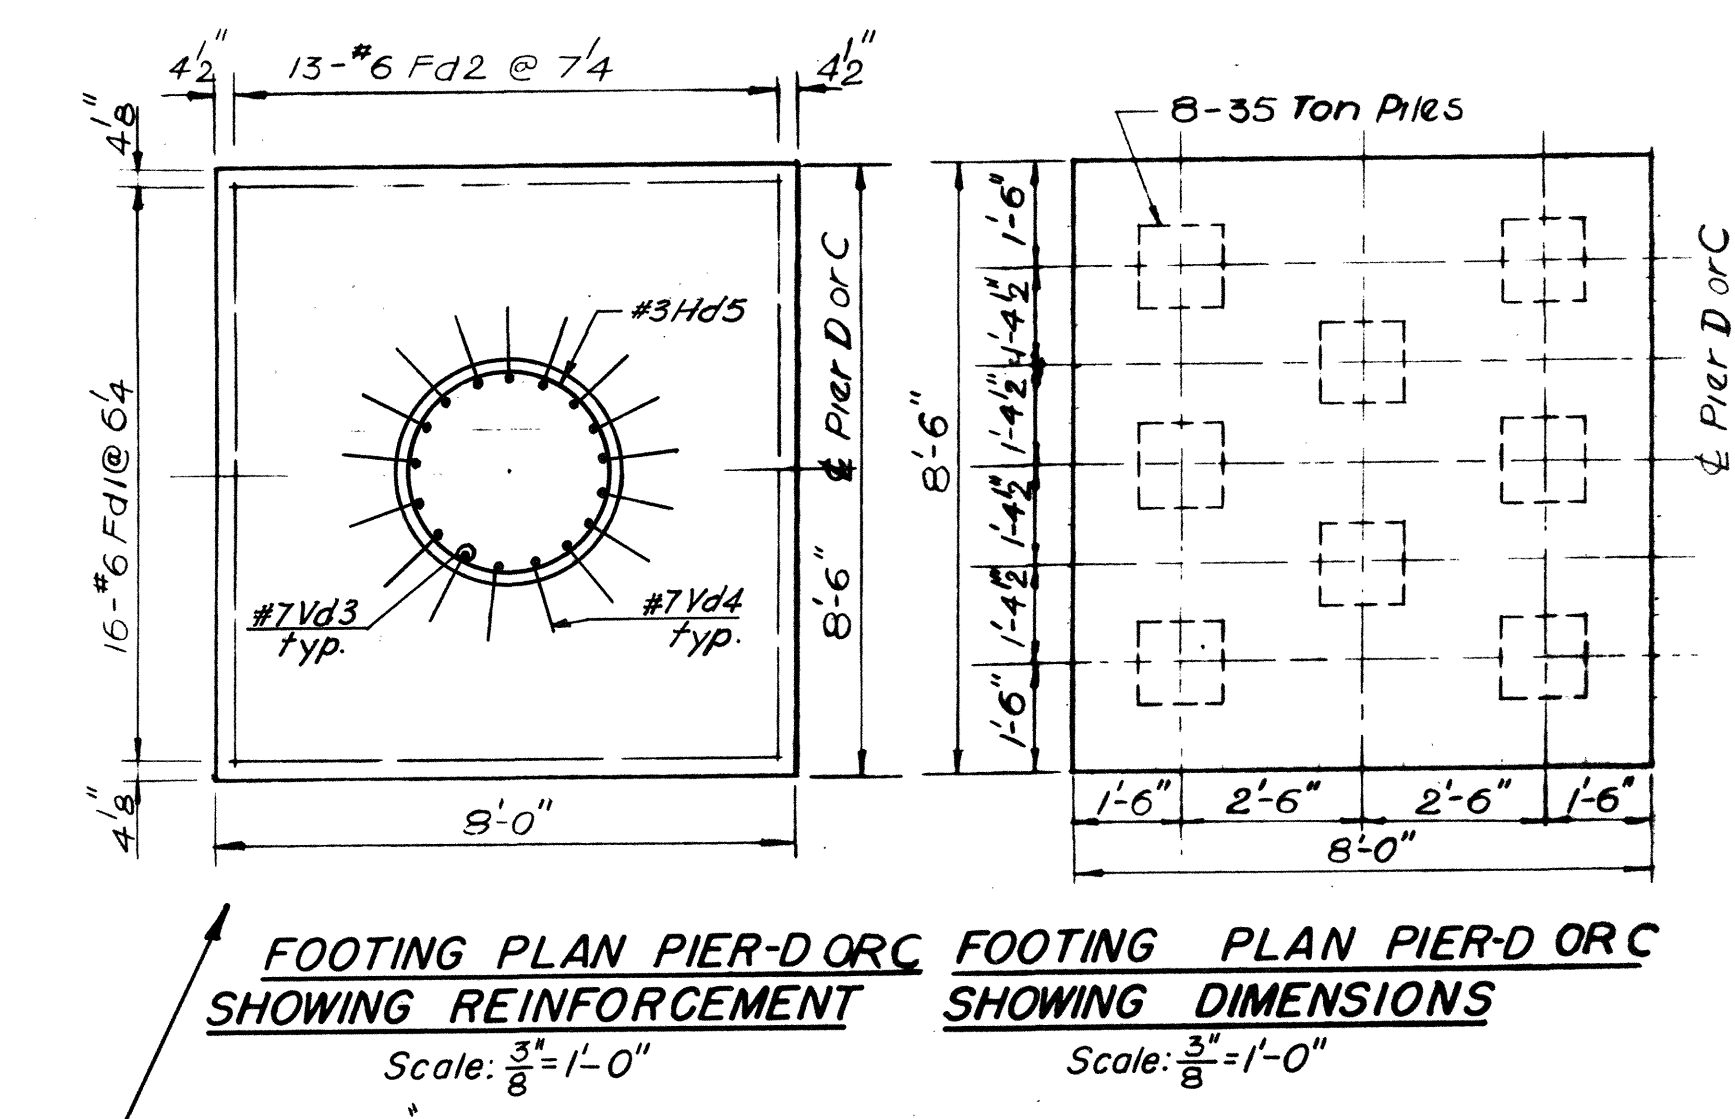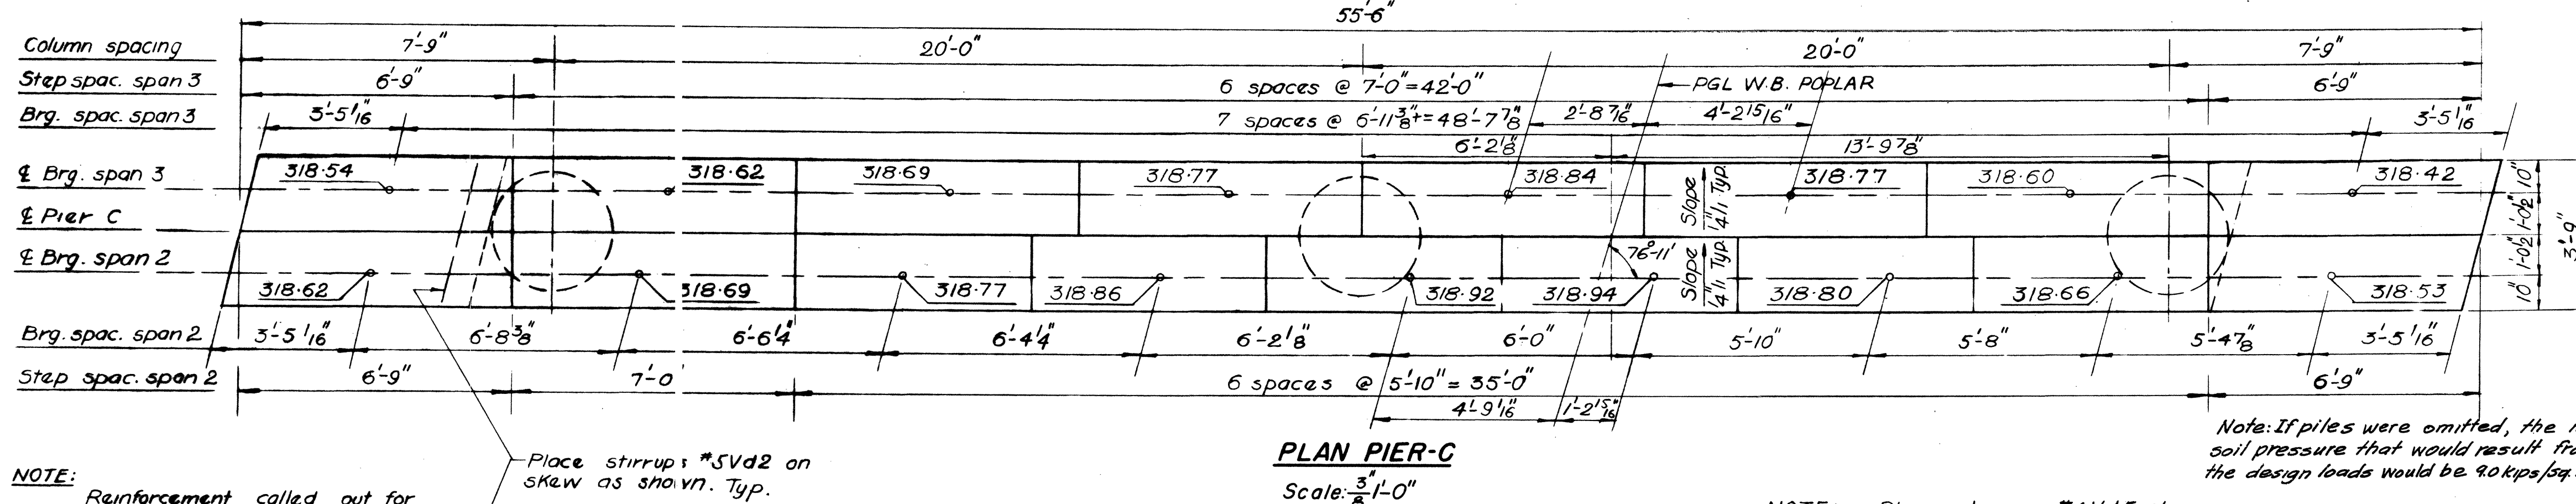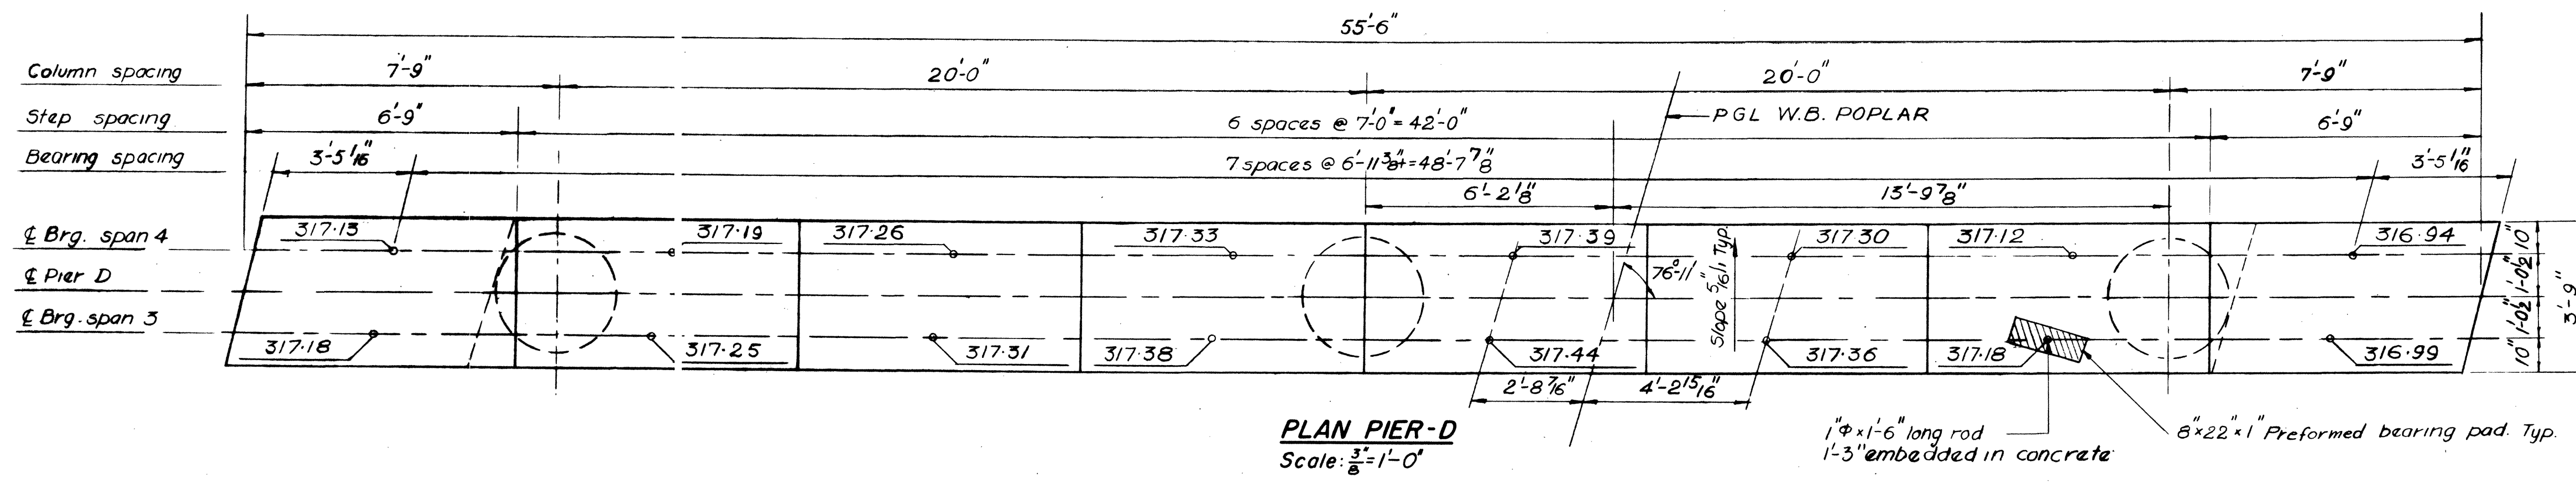

**NOTE:** Reinforcement called out for Pier C is identical for Pier D unless otherwise shown.

Place stirrups #5 Vd2 on skew as shown. Typ.

**NOTE:** Place stirrups #4 Vd5 along with stirrups #5 Vd1

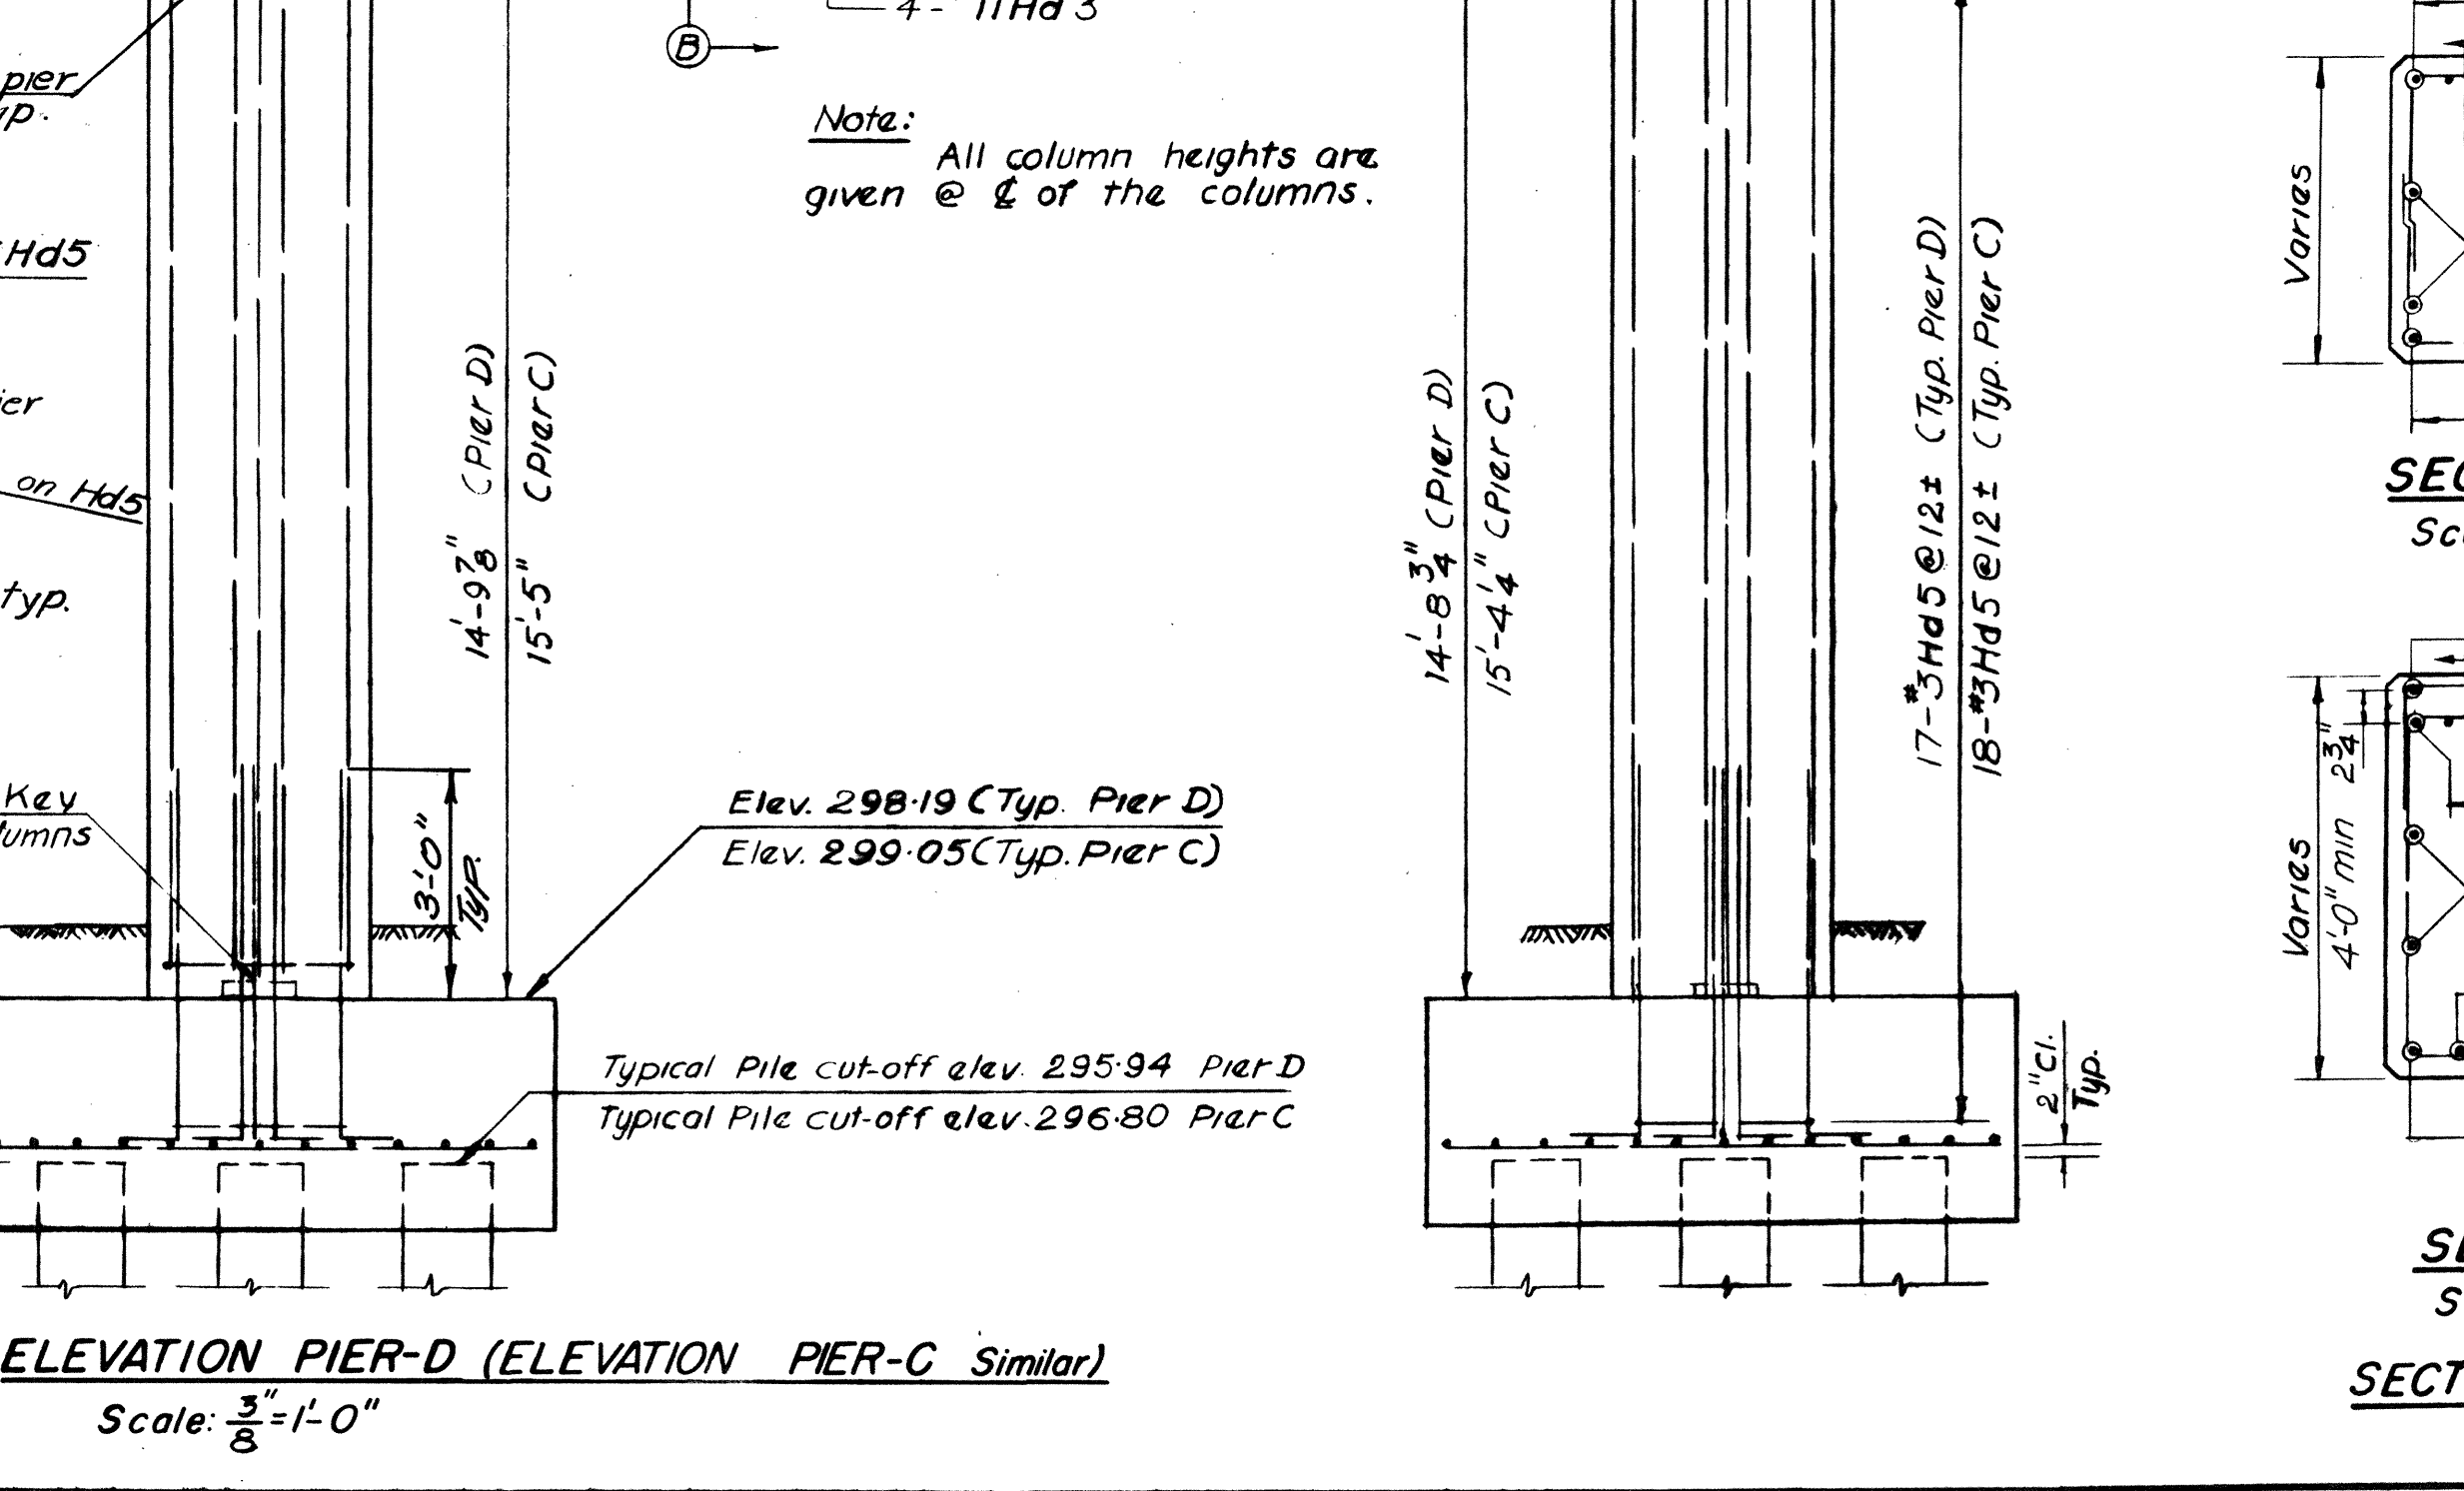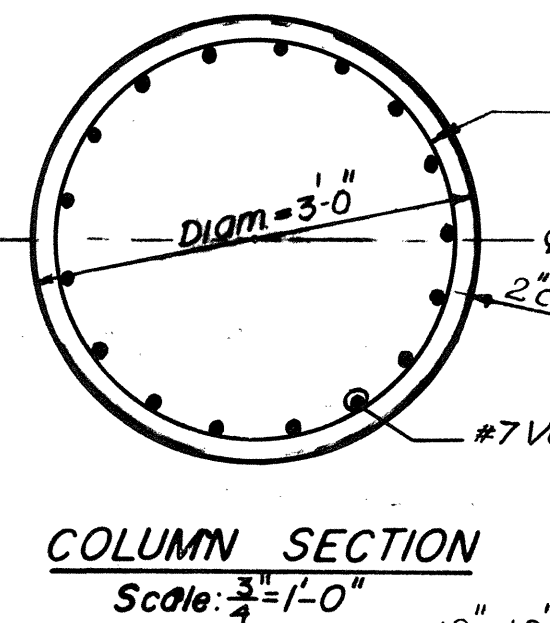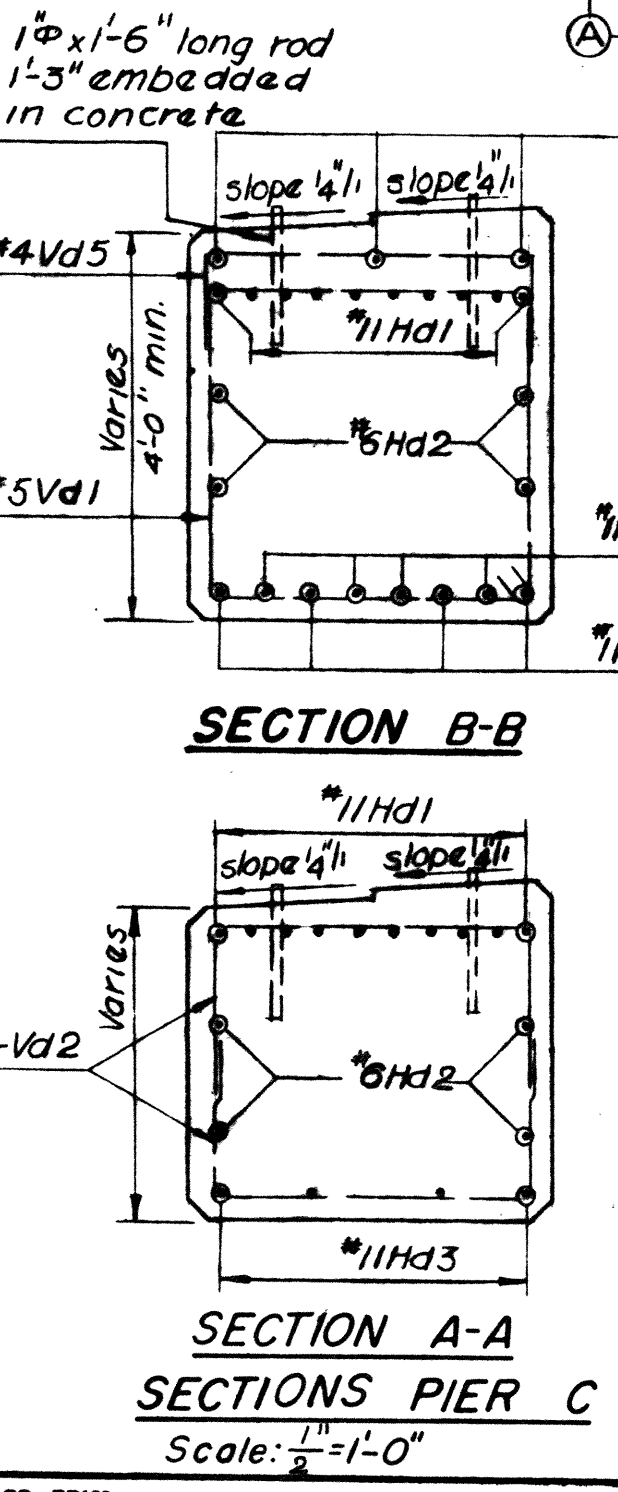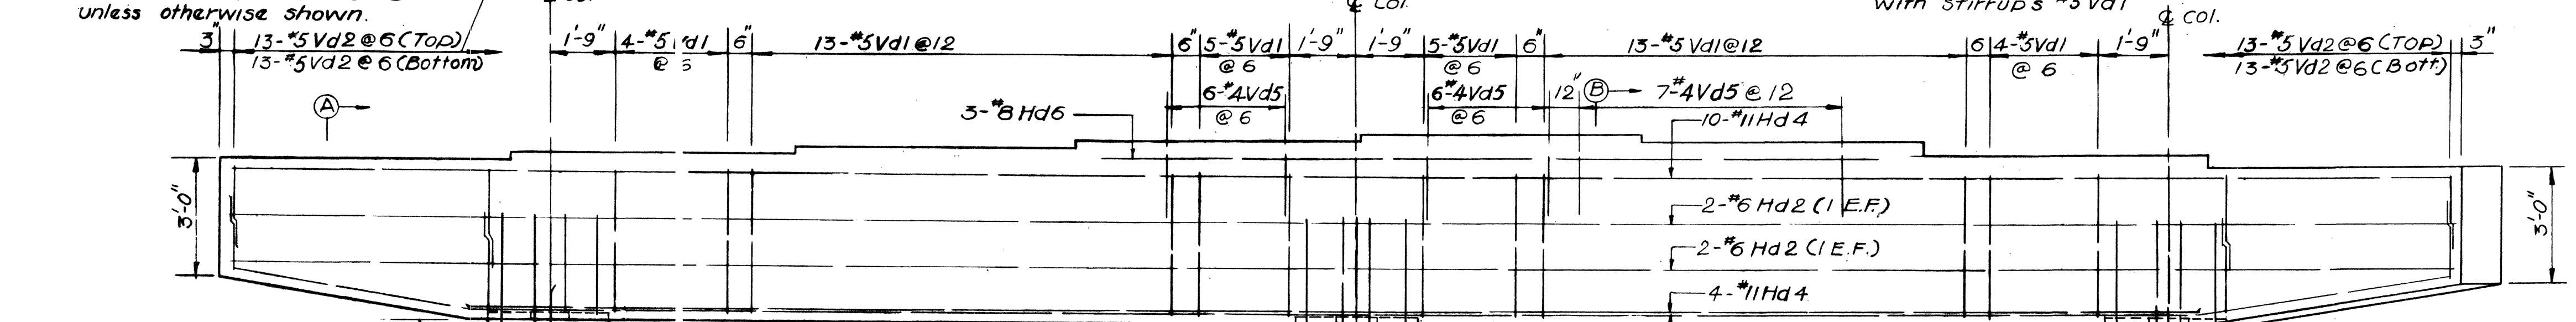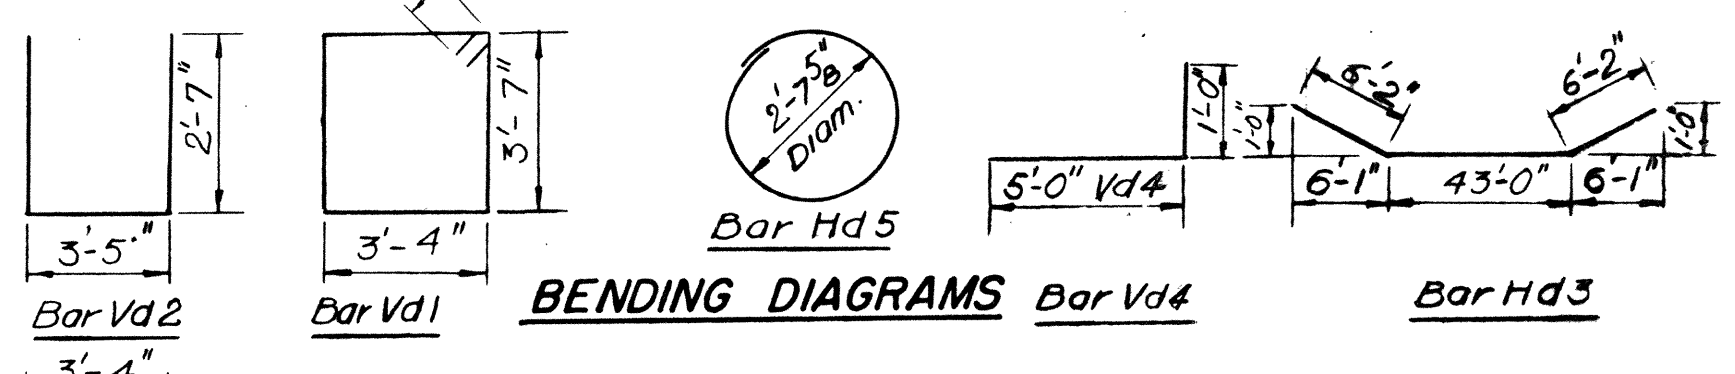

BILL OF STEEL					
Bar	NO	Size	Length	Shape	Location
Fd1	48	#6	7'-6"	—	Footing
Fd2	39	#6	8'-0"	—	Footing
Hd1	10	#11	55'-2"	—	Pier cap
Hd2	4	#6	55'-2"	—	Pier cap
Hd3	4	#11	55'-4"	—	Pier cap
Hd4	4	#11	45'-0"	—	Pier cap
Hd5	54	#5	9'-0"	○	Column
Hd6	3	#8	17'-0"	—	Pier cap
Vd1	44	#5	14'-10"	□	Pier cap
Vd2	52	#5	8'-7"	□	Pier cap
Vd3	51	#7	17'-8"	—	Column
Vd4	51	#7	6'-0"	—	Col. Ftg.
Vd5	19	#4	7'-4"	□	Pier cap

\* 33-1" x 1'-6" Anchor rods are reqd at Piers C & D - 160 lbs. Not included in qty. This sht. Considered incidental to prestressed beams for payment.

ESTIMATED QUANTITIES		
ITEM	UNIT	PIER C / PIER D
Class A Concrete	Cu. Yd.	66.5 / 66.1
Steel bar reinforcement	Lb.	10,390 / 10,380

Bridge 15 A

STATE OF TENNESSEE  
DEPARTMENT OF HIGHWAYS AND PUBLIC WORKS  
PROJECT 1-240-1 (17) 13 SHELBY CO.  
MEMPHIS CIRCUMFERENTIAL INTERSTATE HIGHWAY  
SOUTHEAST SECTION

HARLAND BARTHOLOMEW AND ASSOCIATES, ENGINEERS  
CLARK AND DAILY ASSOCIATED ENGINEERS







W.B. POPLAR AVENUE OVER I-240  
PIERS C & D



PUB. NO.	STATE	PROJECT NO.	FISCAL YEAR	SHEET NO.	TOTAL SHEETS
3	TENNESSEE	1-210-1 (17) 13	1953	176	334

REVISION 11-10-59  
2-16-62 Bill of Steel / Reinf. Steel Quant.


**NOTES**  
 1. See Bridge Dwg. 1 for General Notes, and Design Stresses.  
 2. A 3" diam. formed opening shall be provided through interior diaphragms for passage of lighting conduits.  
 3. See Dwg. 10 for details on anchors for handrail, anchors for lighting standards, pull-box locations, sleeves for conduit supports and buried conduits. See Dwg. 6 for details on drains and handrail and block reinforcements.

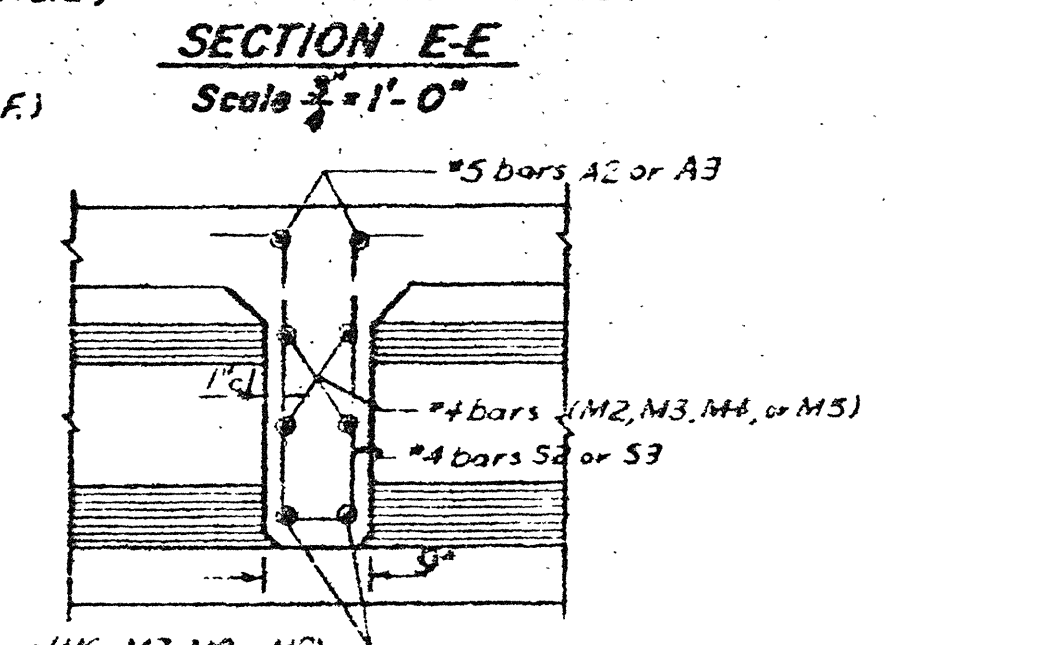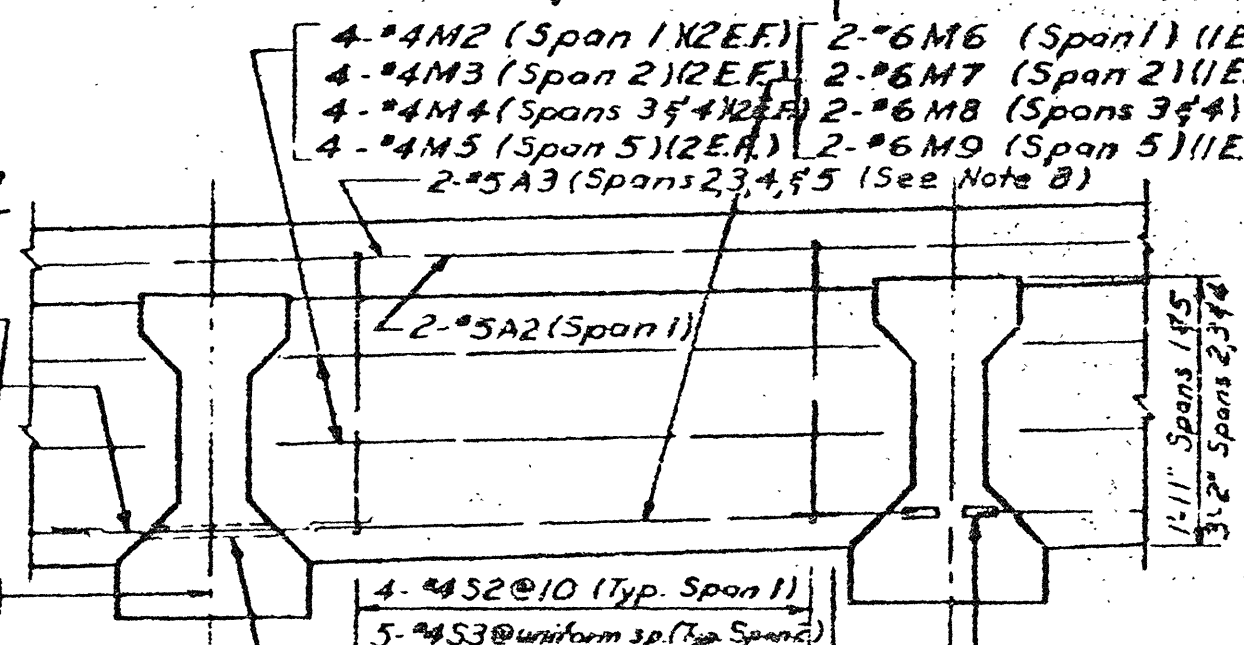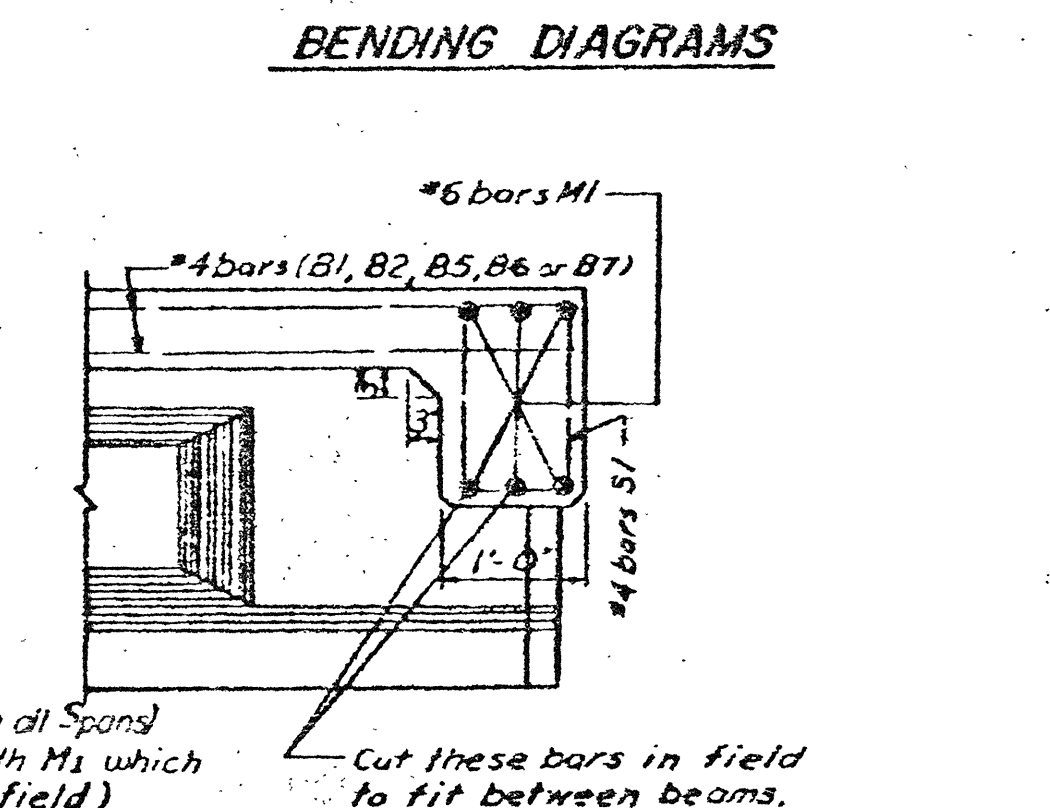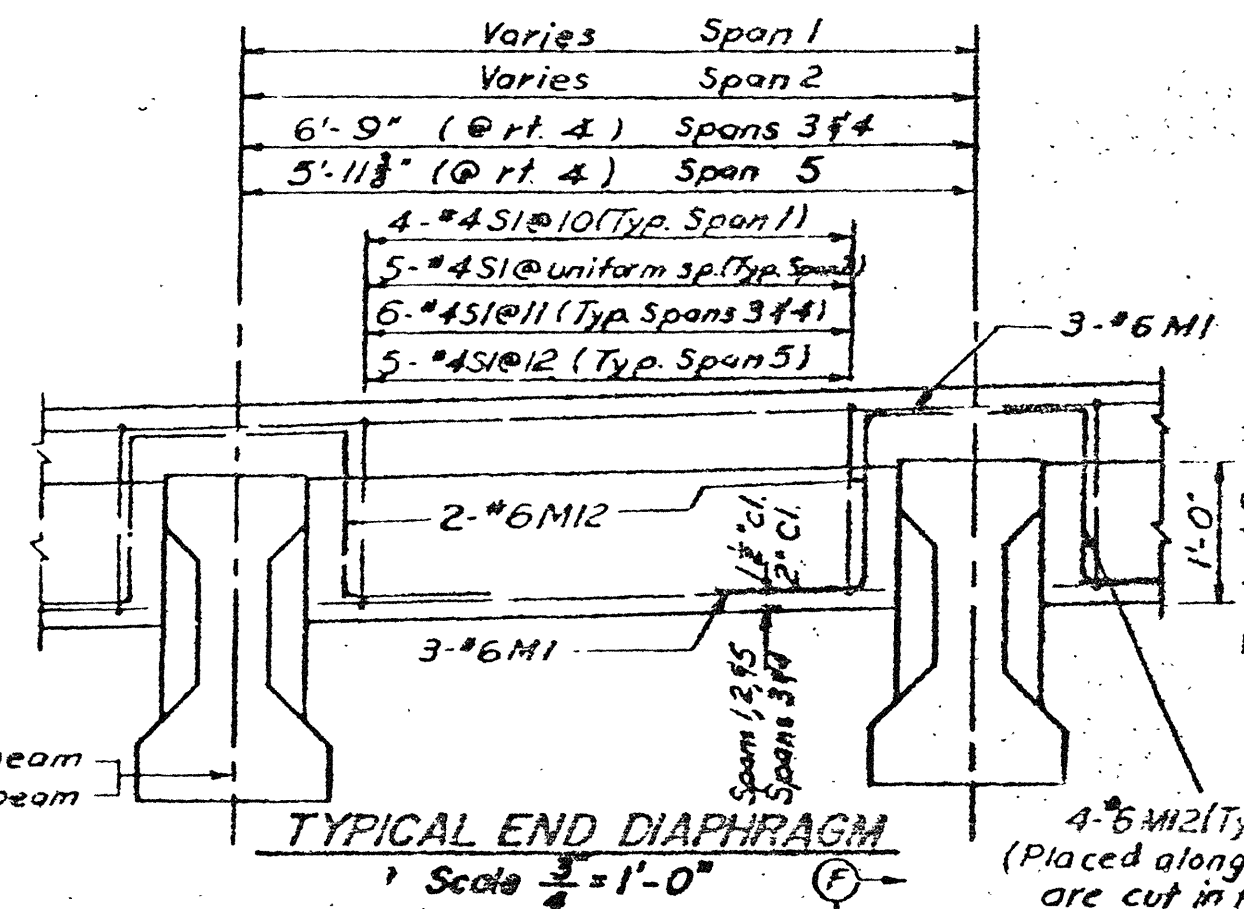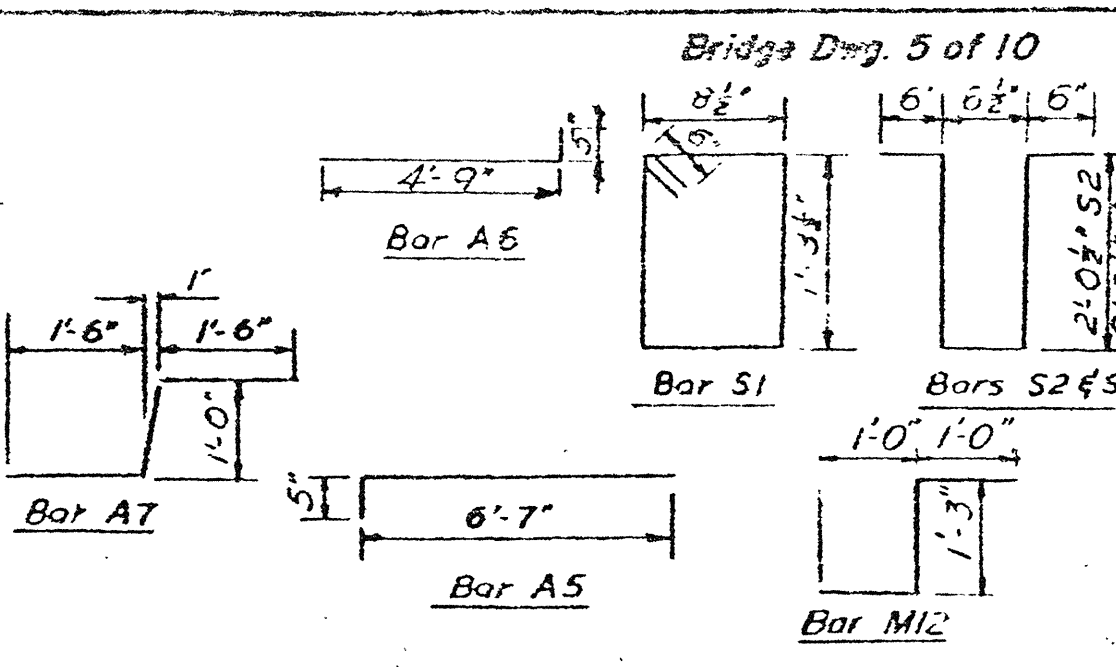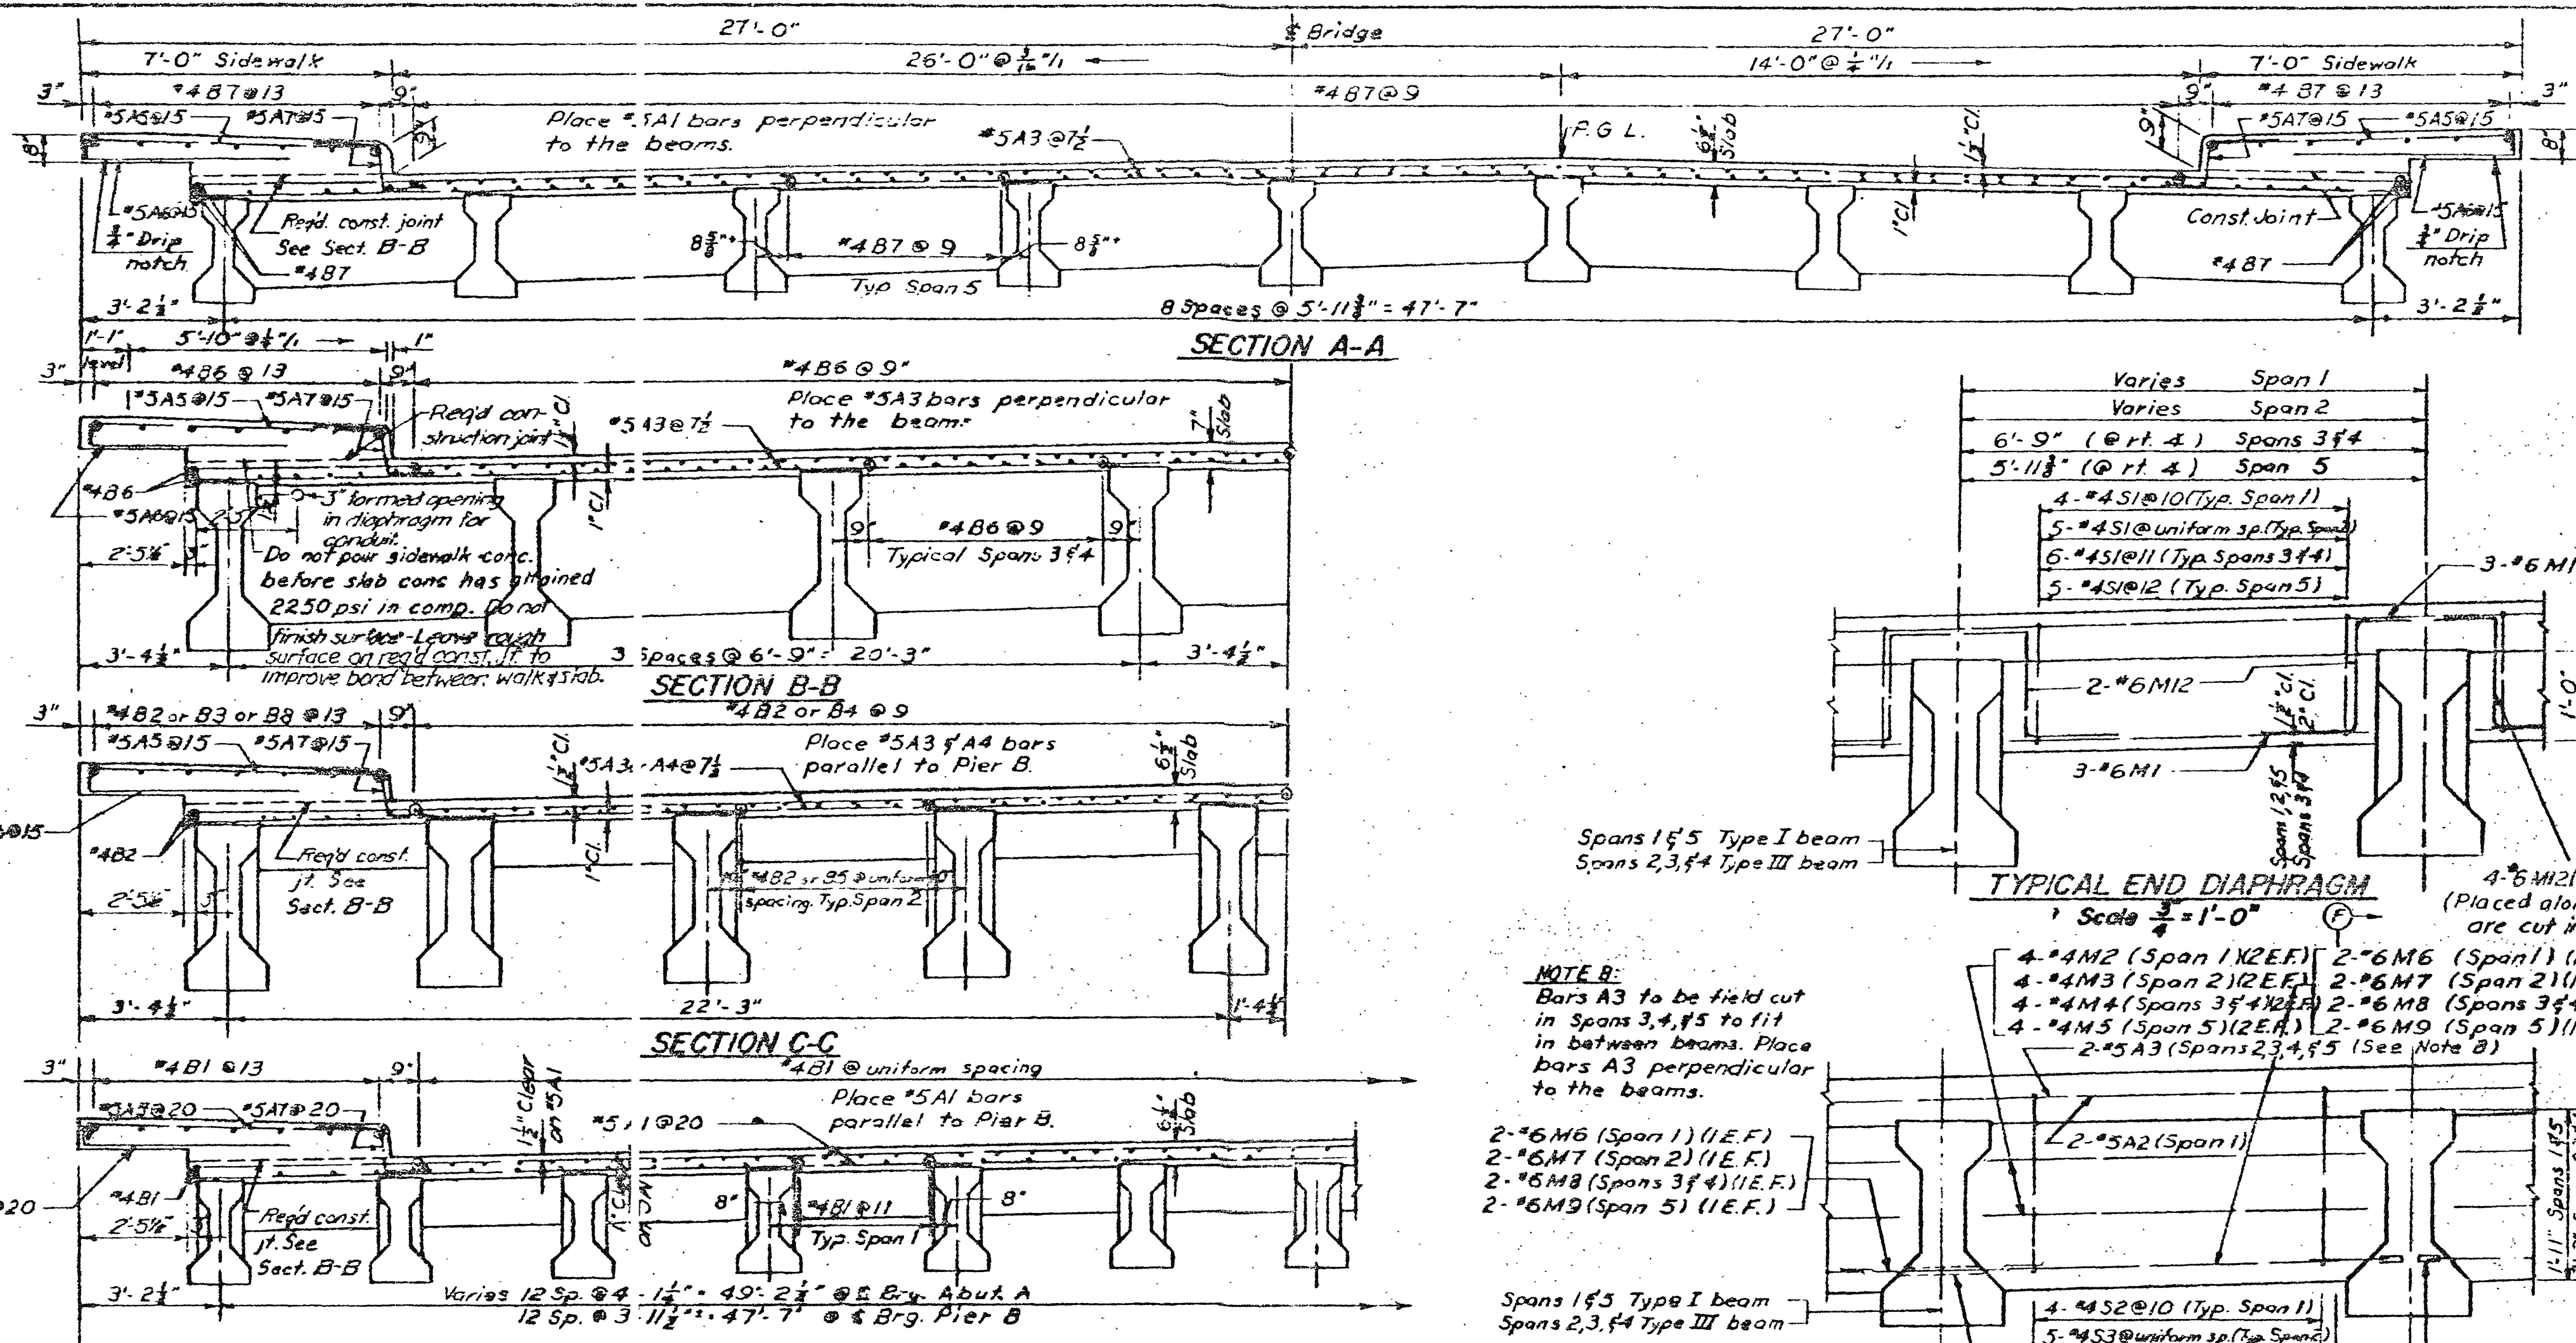

**BILL OF STEEL**

Bar	No.	Size	Length	Shape	Location
A1	216	#5	25'-11"		Slab
A2	2	#5	47'-2"		Int. Diaph
A3	730	#5	49'-10"		Slab
Set A4	2 Sets	#5	Varies		Slab
A5	454	#5	7'-0"		Sidewalk
A6	454	#5	5'-2"		Sidewalk
A7	454	#5	4'-0"		Sidewalk
B1	121	#4	46'-8"		Slab
B2	119	#4	40'-0"		Slab
Set B3	1 Set	#4	Varies		Sidewalk
Set B4	1 Set	#4	Varies		Slab
Set B5	1 Set	#4	Varies		Slab
B6	508	#4	34'-6"		Slab
B7	127	#4	37'-7"		Slab
Set B8	1 Set	#4	Varies		Sidewalk
M1	60	#6	49'-0"		End Diaph
M2	48	#4	3'-3"		Int. Diaph
M3	64	#4	4'-3"		Int. Diaph
M4	112	#4	5'-7"		Int. Diaph
M5	32	#4	5'-0"		Int. Diaph
M6	46	#6	3'-0"		Int. Diaph
M7	60	#6	3'-8"		Int. Diaph
M8	56	#6	5'-3"		Int. Diaph
M9	16	#6	4'-11"		Int. Diaph
M12	336	#6	3'-3"		End Diaph
S1	424	#4	5'-0"		End Diaph
S2	88	#4	5'-8"		Int. Diaph
S3	248	#4	8'-2"		Int. Diaph
3 x 3 - 1/10 WVF					360 sq. ft. Beam Cap

**NOTE:**  
Span 1 has a varying roadway width to allow for the spiral from Ramp 15-D on the South side of the bridge. The curb line on the North side is a straight line continuation of the curb line in the remaining spans. The curb line on the South side of span 1 shall be a straight line which tapers from a total curb to curb roadway width of 41'-8 1/2" @ the end of slab to 40'-0" @ the brg. Pier B. The width of sidewalk is 7'-0" constant throughout the bridge. The distance from the edge of bridge to fascia beam on either side in span 1 is 3'-2 1/2". See Dwg. 1 for location of T.S. on Ramp 15-D.

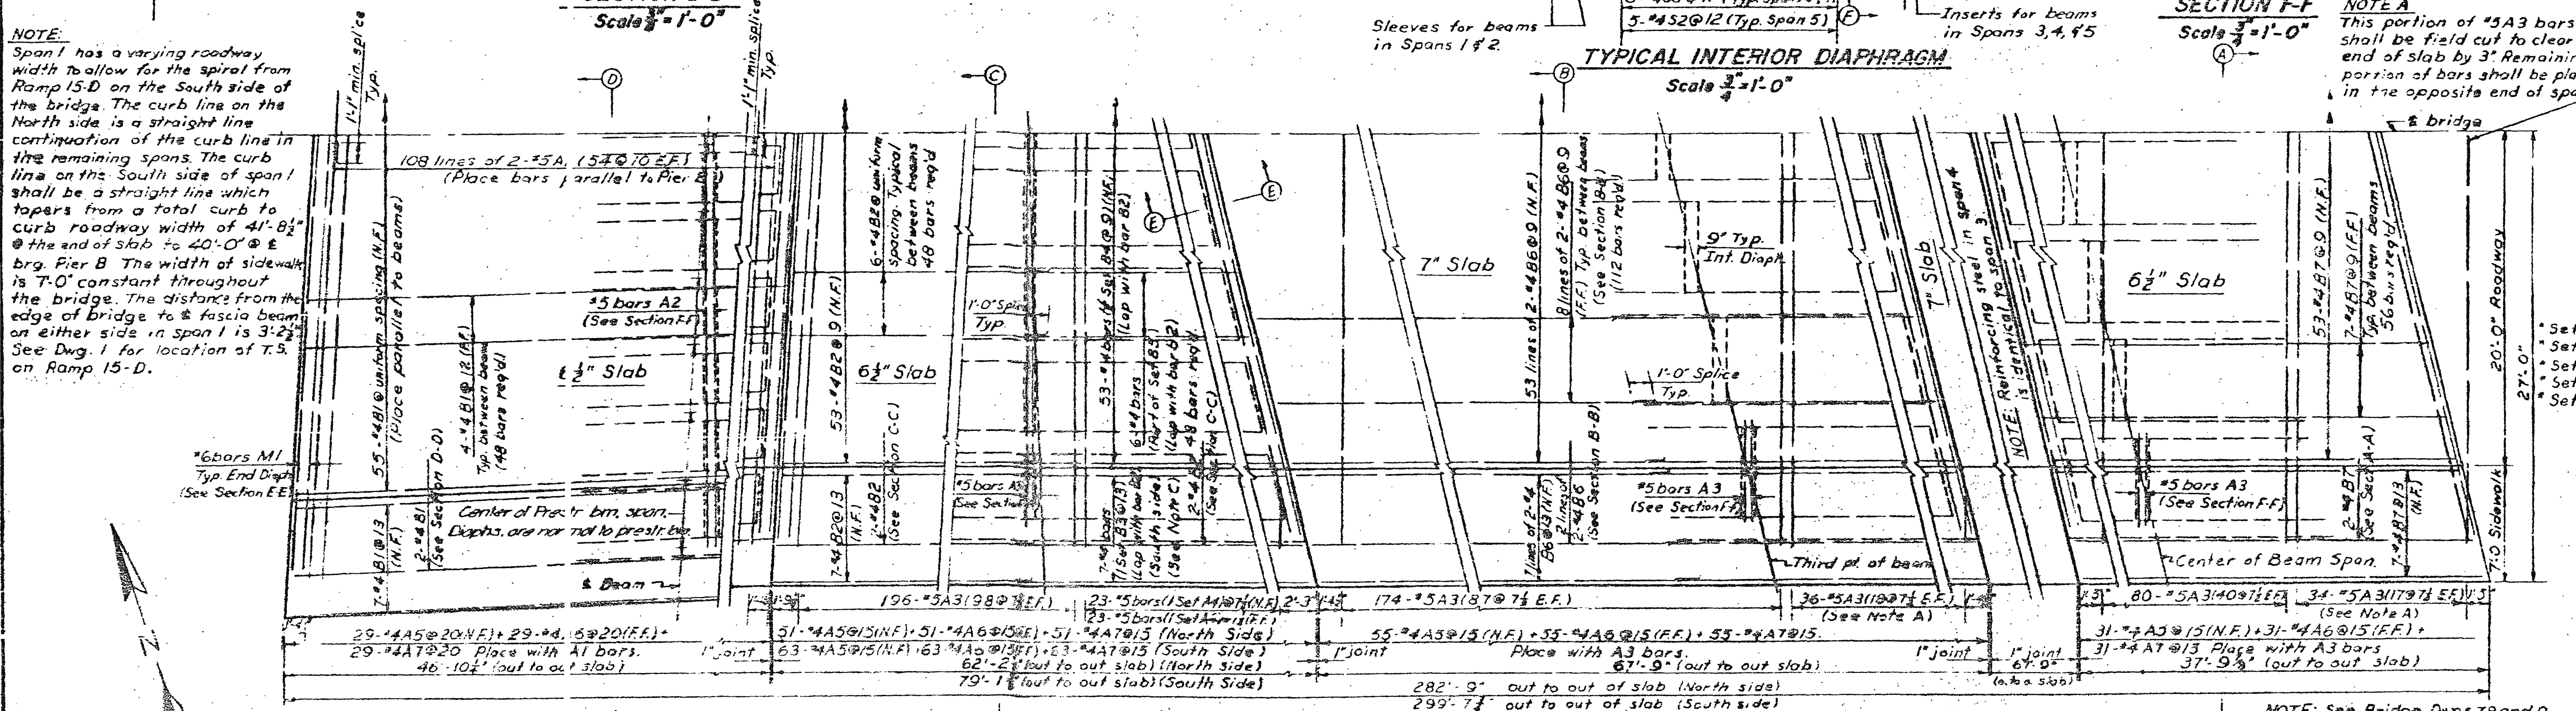

**NOTE:**  
Curb steel on South side is identical to North side except as noted.

PLAN-SPAN 1  
Scale 3/8" = 1'-0"

PLAN-SPAN 2  
Scale 3/8" = 1'-0"

PLAN-SPAN 3  
Scale 3/8" = 1'-0"

PLAN-SPAN 4  
Scale 3/8" = 1'-0"

PLAN-SPAN 5  
Scale 3/8" = 1'-0"

\*Set A4- 23 bars; varies from 4'-10" to 48'-10" in 2'-0" increments  
 \*Set B3- 7 bars; varies from 38'-4" to 39'-10" in 3" increments  
 \*Set B4- 53 bars; varies from 25'-1" to 35'-1" in 3" increments  
 \*Set B5- 48 bars; varies from 23'-8" to 35'-4" in 4" increments  
 \*Set B8- 7 bars; varies from 23'-4" to 24'-10" in 3" increments

**ESTIMATED QUANTITIES**

ITEM	UNIT	QUANTITY
Class A Concrete	Cu. Yds	472.4
Steel Bar Reinforcement *	Lbs.	88,710


\*Includes WVF reinforcement

STATE OF TENNESSEE  
 DEPARTMENT OF HIGHWAYS AND PUBLIC WORKS  
 MEMPHIS CIRCUMFERENTIAL INTERSTATE HIGHWAY  
 SOUTHEAST SECTION  
 HARLAND BARTHOLOMEW AND ASSOCIATES, ENGINEERS  
 CLARK AND DAILY ASSOCIATED ENGINEERS  
**W.B. POPLAR AVE. OVER I-240**  
**SUPERSTRUCTURE SLAB**


DATE: 11-13-59 As Shown SCALE: D.A.S. CHECKED BY: M.C.C.P. DRAWN BY: H.A.T. IN CHARGE: B.C.C. H-11-21



PUB. ROADS DIV. NO.	STATE	PROJECT NO.	FISCAL YEAR	SHEET NO.	TOTAL SHEETS
3	TENNESSEE	1-240-1 (17) 13	1958	177	334
REVISION 11-10-59					
REVISION 12-18-59					

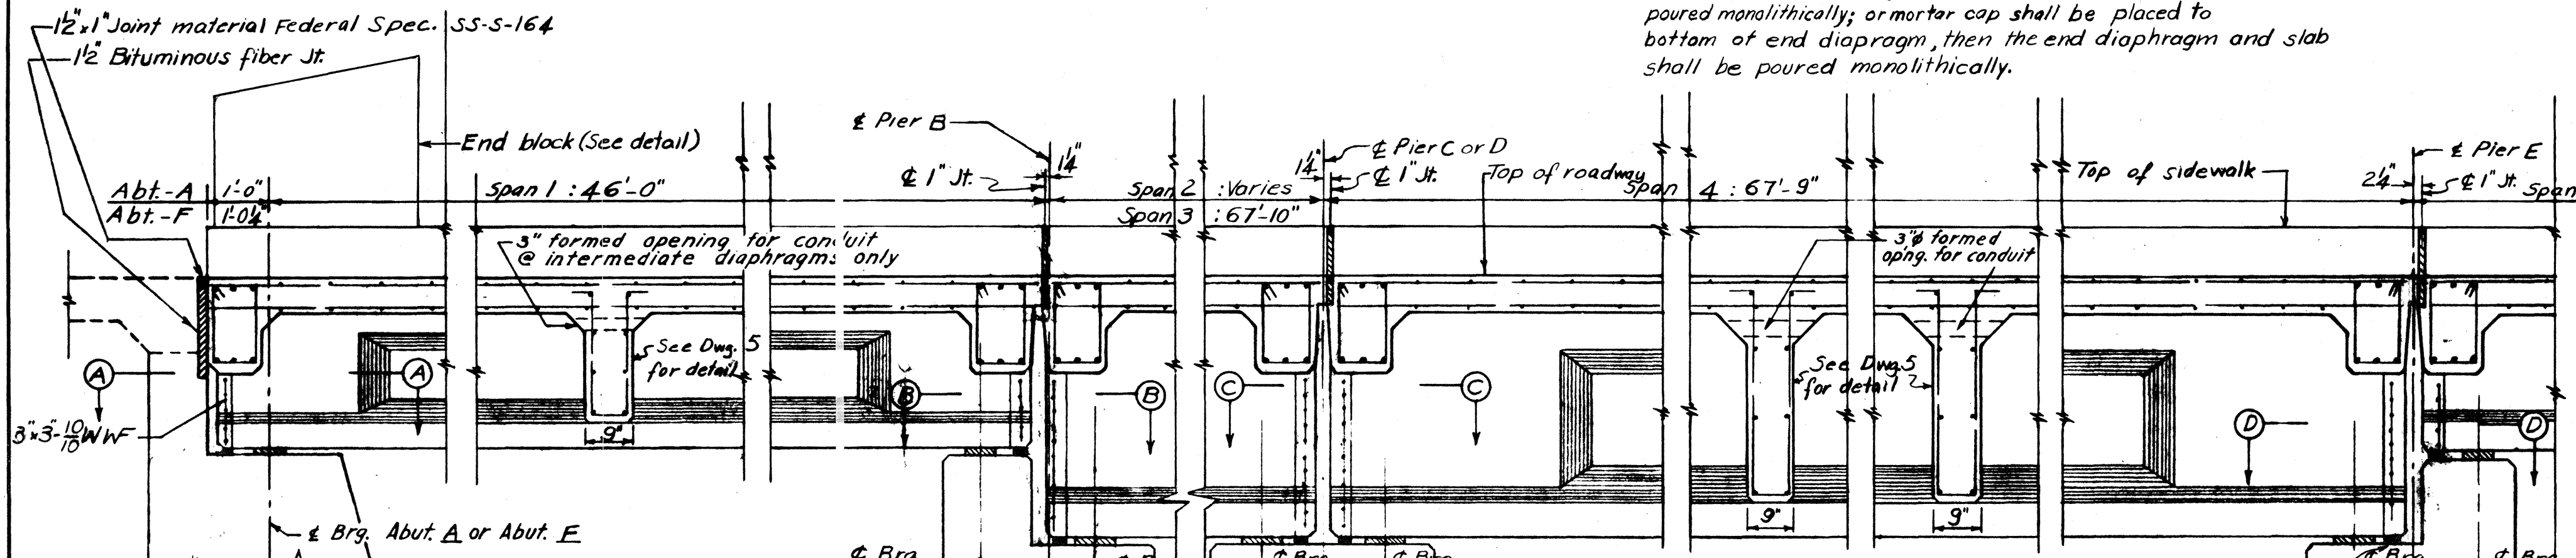

NOTE: Construction sequence on superstructure slab shall be one of the following: Mortar cap, end diaphragms and slab shall be poured monolithically; or mortar cap shall be placed to bottom of end diaphragm, then the end diaphragm and slab shall be poured monolithically.

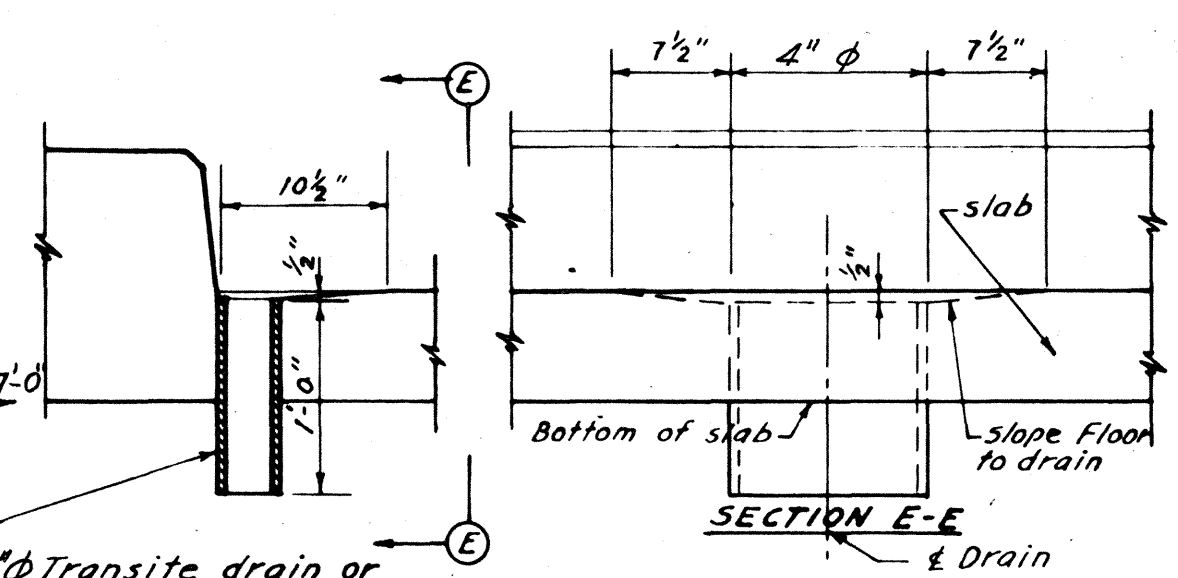


DRAIN DETAILS - 24 REQ'D  
Scale 1"=1'-0"

NOTE: See Bridge Dwg. 1, for drain location.

ABUTMENT A OR F

Abut-A	3'-6"
Abut-F	3'-6 1/2"
Abut-A	1'-0" 1'-0" 1'-6"
Abut-F	1'-0" 1'-0 1/4" 1'-6"

NOTE: 3 x 3-10 WWF in field cast mortar cap shall be anchored securely to splay 1 ends of prestress strands extending 3" minimum beyond the beam end.

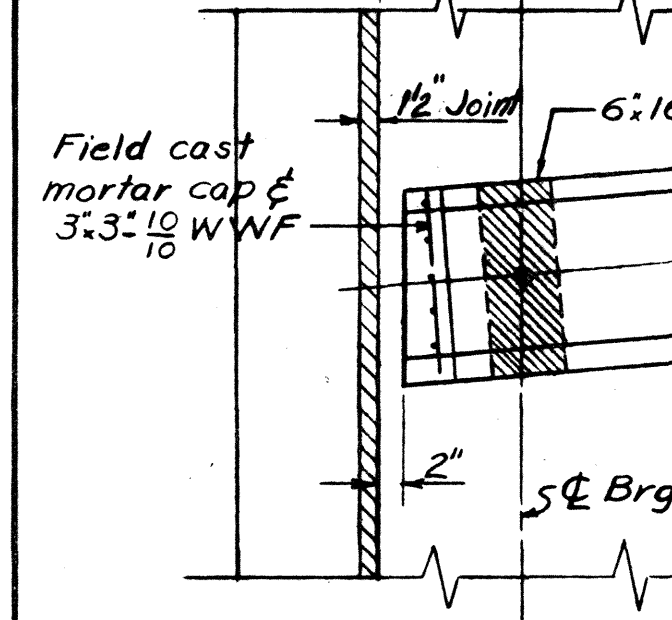

SECTION A-A

PIER-B

7'	1'-2"	9"	1'-0"
3'-5"	1'-9"	1'-9"	

PIER-C OR D


10'	1'-0 1/2"	1'-0 1/2"	10"
1'-10 1/2"	1'-10 1/2"	1'-10 1/2"	
3'-9"			

PIER-E


9 1/2"	11 1/2"	1'-1 1/2"	7 1/2"
1'-9"	1'-9"		
3'-6"			

SECTIONS PERPENDICULAR TO C OF PIERS & ABUTMENTS  
Scale: 1/2"=1'-0"


NOTE: Bit. Fib. Mat'l may be used as form for bottom of mortar cap and left in place. (Typical)

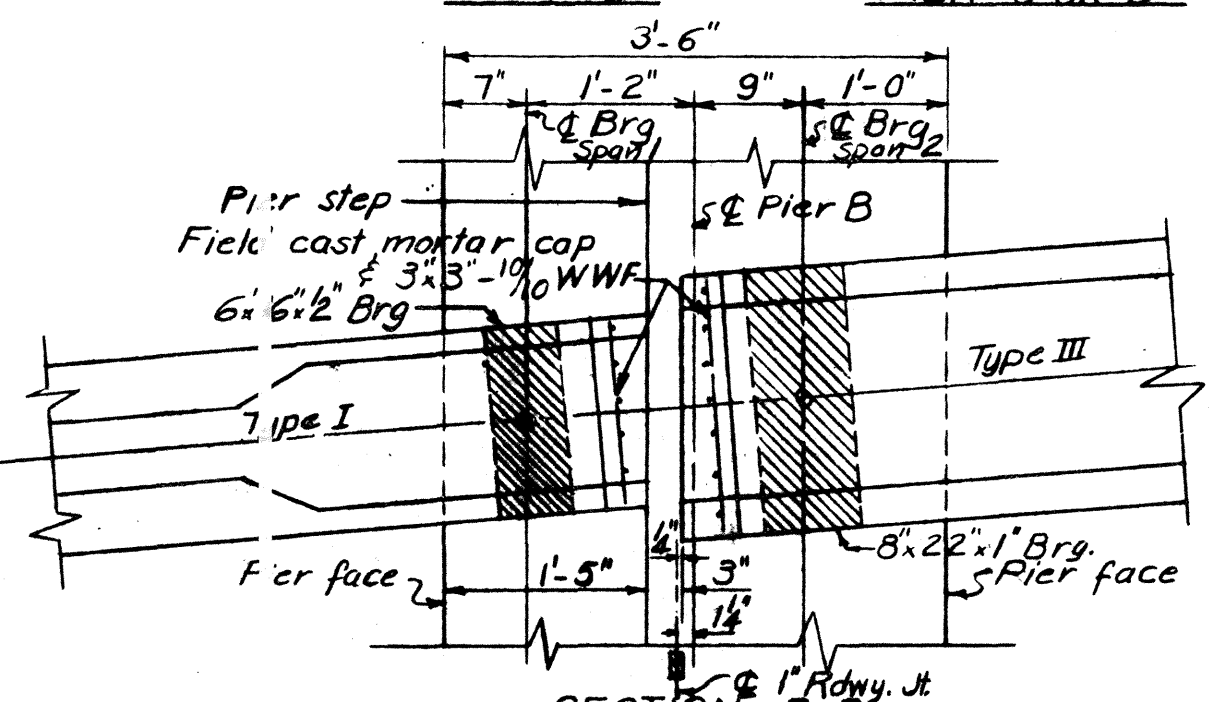

SECTION B-B

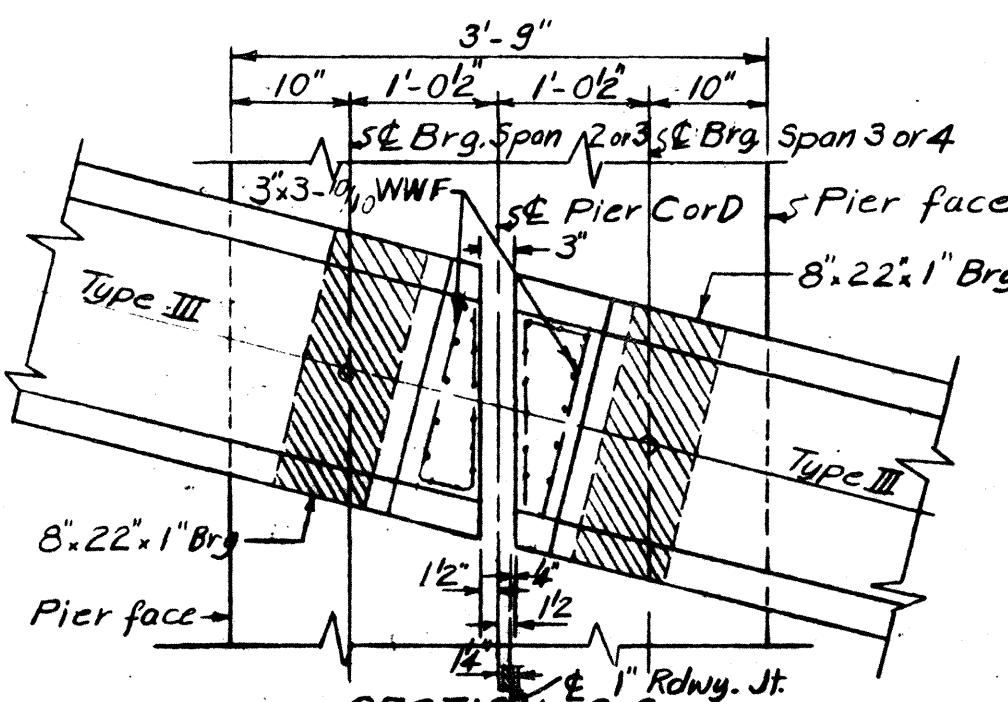


SECTION C-C

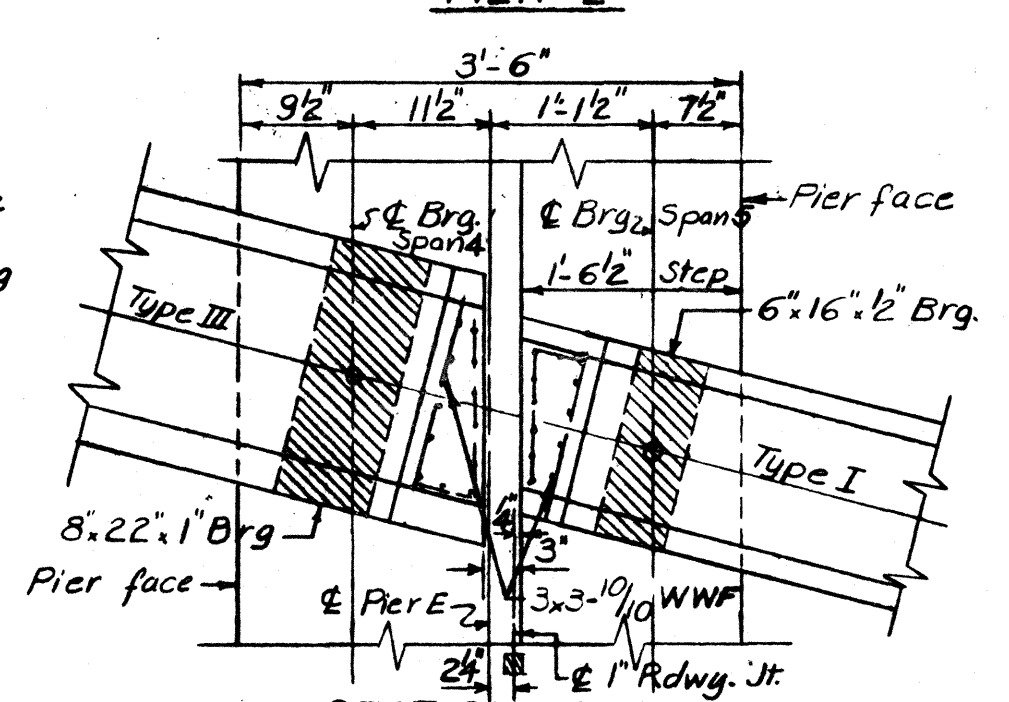

SECTION D-D

SECTIONS AT PIERS & ABUTMENTS  
Scale: 3/4"=1'-0"

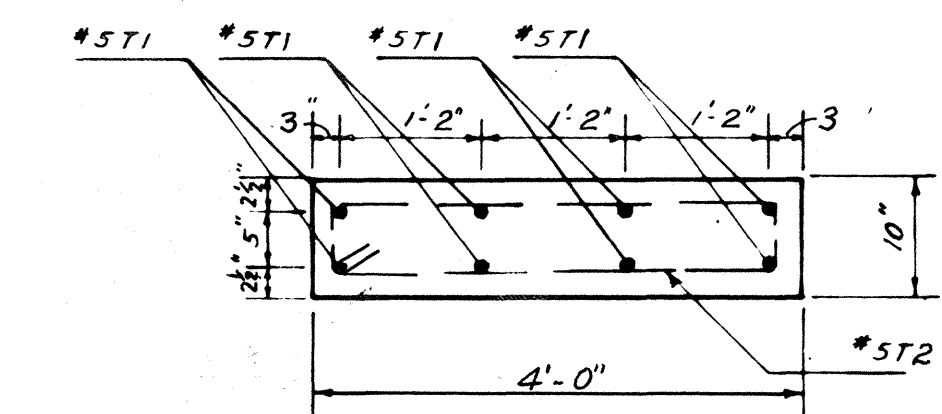


CAMBER NOTES

- Verify the calculated deflection at the E of one beam in each span due to the prestressing force and the dead load of the beam, by field elevations before forming the slab.
- If the center elevation of the beam checks calculated elevations within tolerable limits in the judgment of the engineer, the information shown below shall be used directly in forming the slab. This allows for vertical curve and the calculated deflections automatically.


Span	Beam	beam embedment e		slab thickness t	
		@ support	@ E span	@ support	@ E span
1	A	1 1/2"	3/4"	6"	5 3/4"
2	B1, B2 & B3	3/4"	1/2"	5 3/4"	6 1/4"
2	B4	3/4"	3/8"	5 3/4"	6 1/4"
2	B5 & B6	3/4"	3/8"	5 3/4"	6 1/4"
2	B7 & B8	1/2"	1/4"	6"	6 1/4"
2	B9	1/2"	3/8"	6"	6 1/4"
3 & 4	C	1/2"	1/4"	6 1/2"	6 3/4"
5	D	1/2"	1/4"	6"	5 3/4"

t and e are given at E of beam.

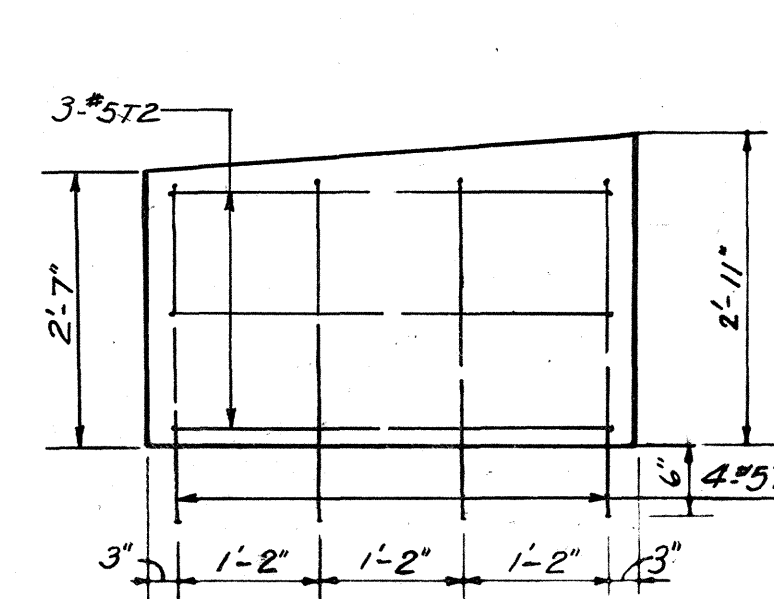


END BLOCK DETAILS


- If the field check of the center elevation of the beam results in an elevation beyond tolerable limits the following criteria shall be used in determining form heights for the slab.
  - Maximum embedment allowed shall be 1" and minimum embedment allowed shall be 0".
  - Maximum increase in slab thickness (ts) shall be 1/2" for cambering requirements. In any case the normal slab thickness will not be reduced for cambering requirements.
  - If the maximum slab thickness and the minimum embedment at the E of the beam will not result in the desired finished surface profile, fillets shall be used. Fillet details are subject to the approval of the engineer.

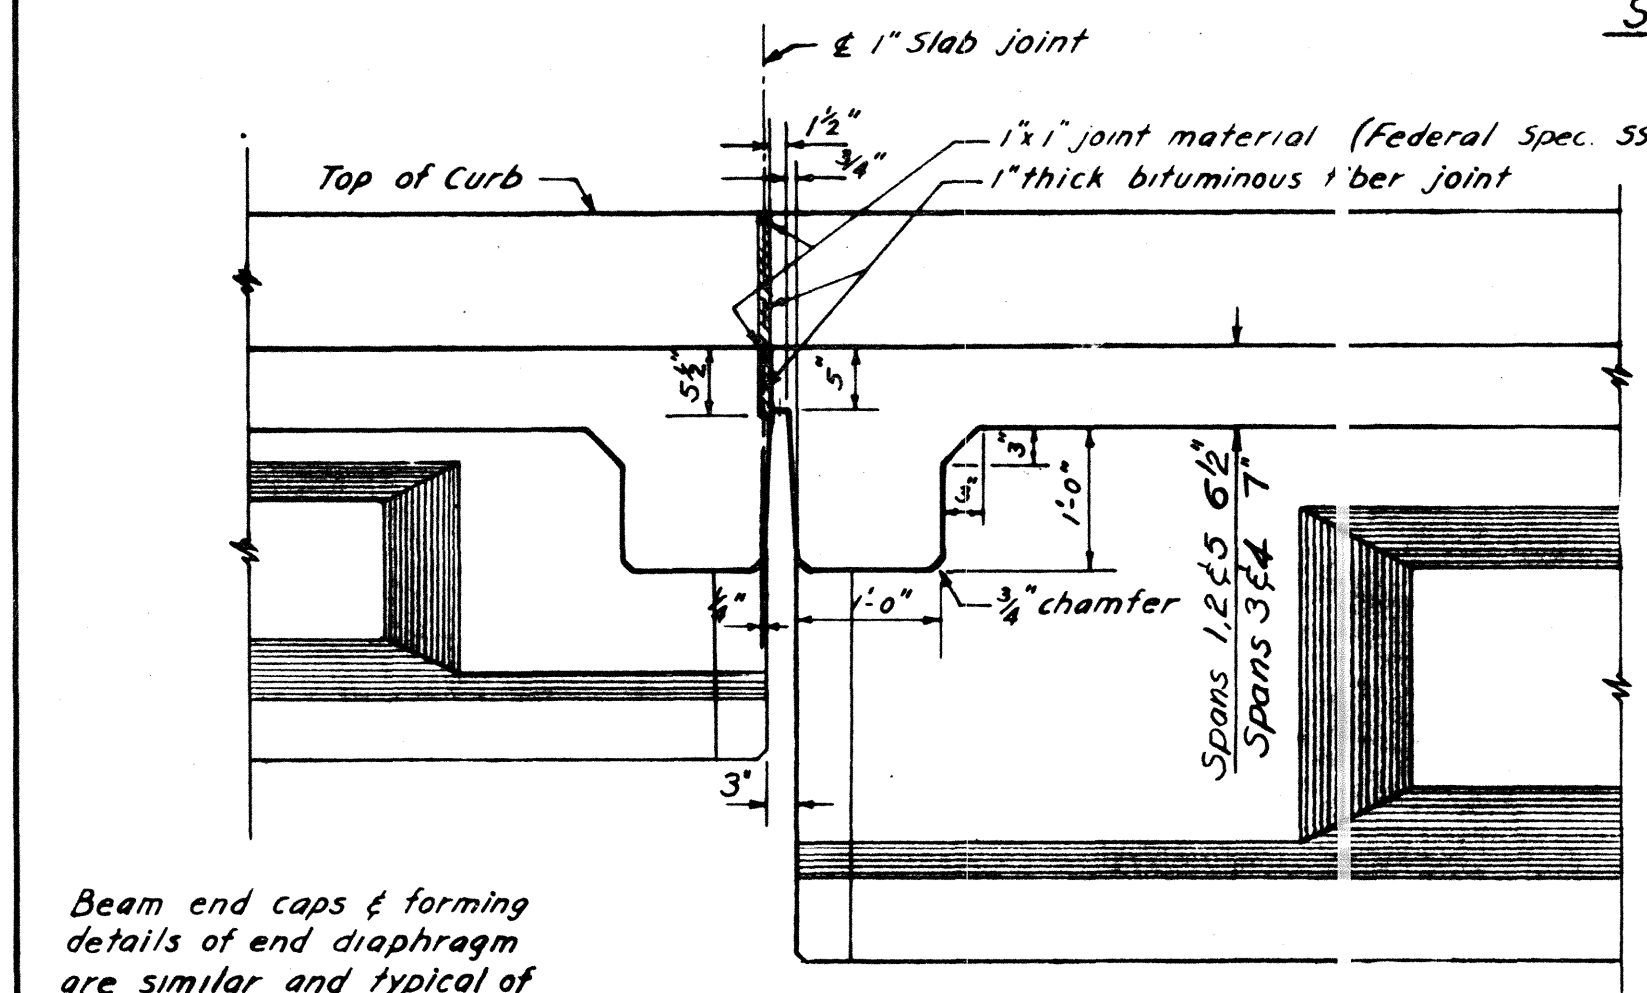

SECTION PERPENDICULAR TO C OF PIER  
Scale: 3/4"=1'-0"

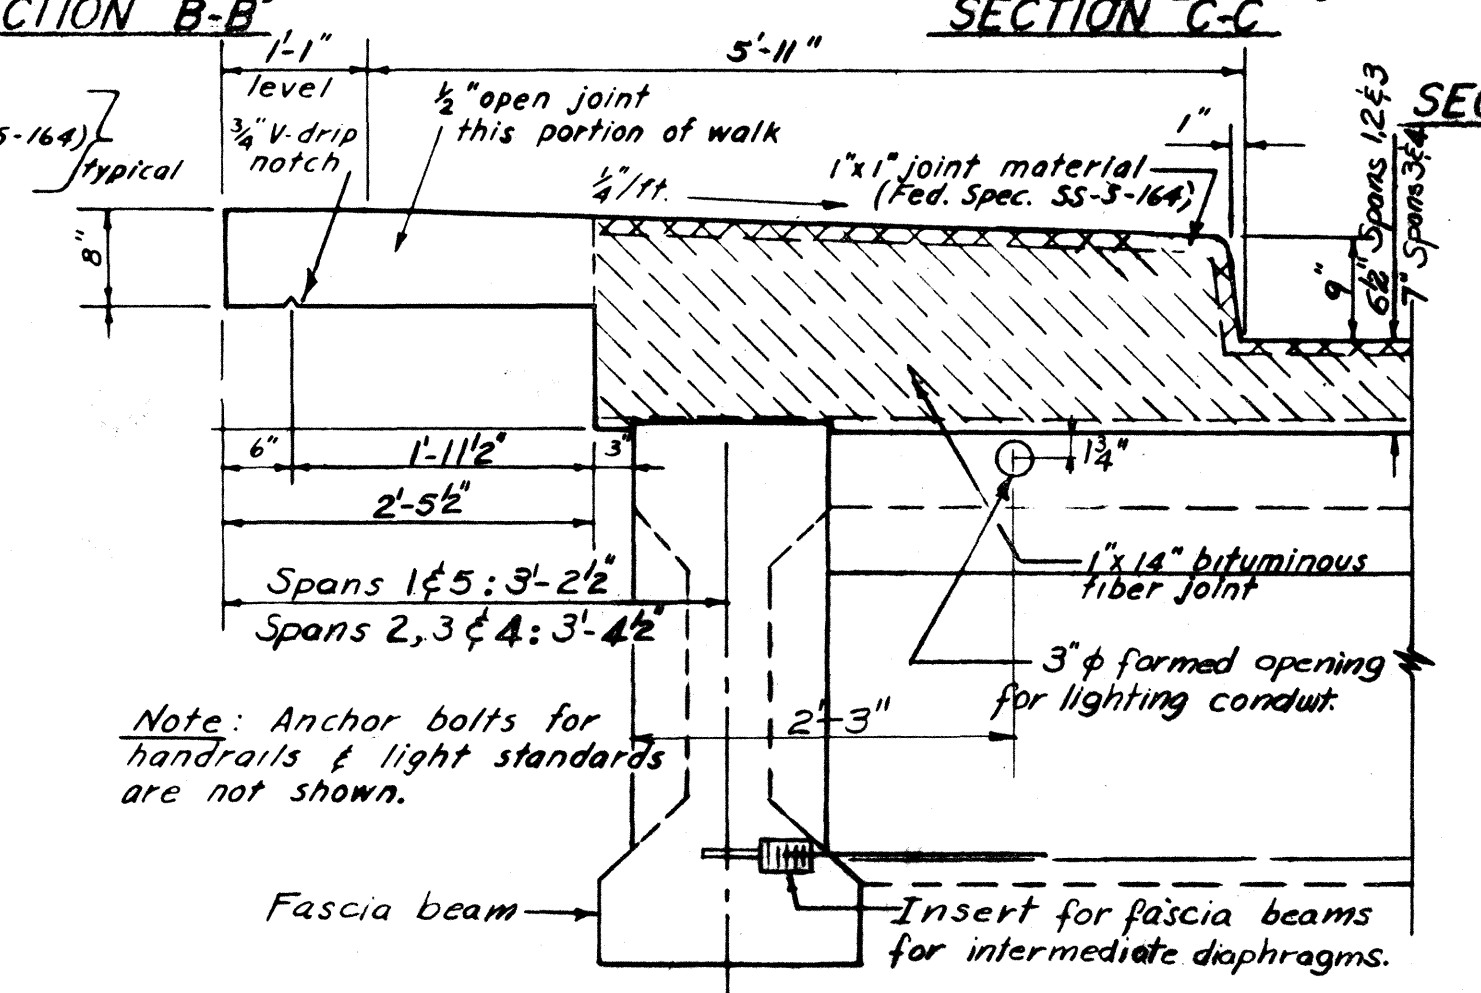


TYPICAL CURB SECTION  
Scale: 3/4"=1'-0"

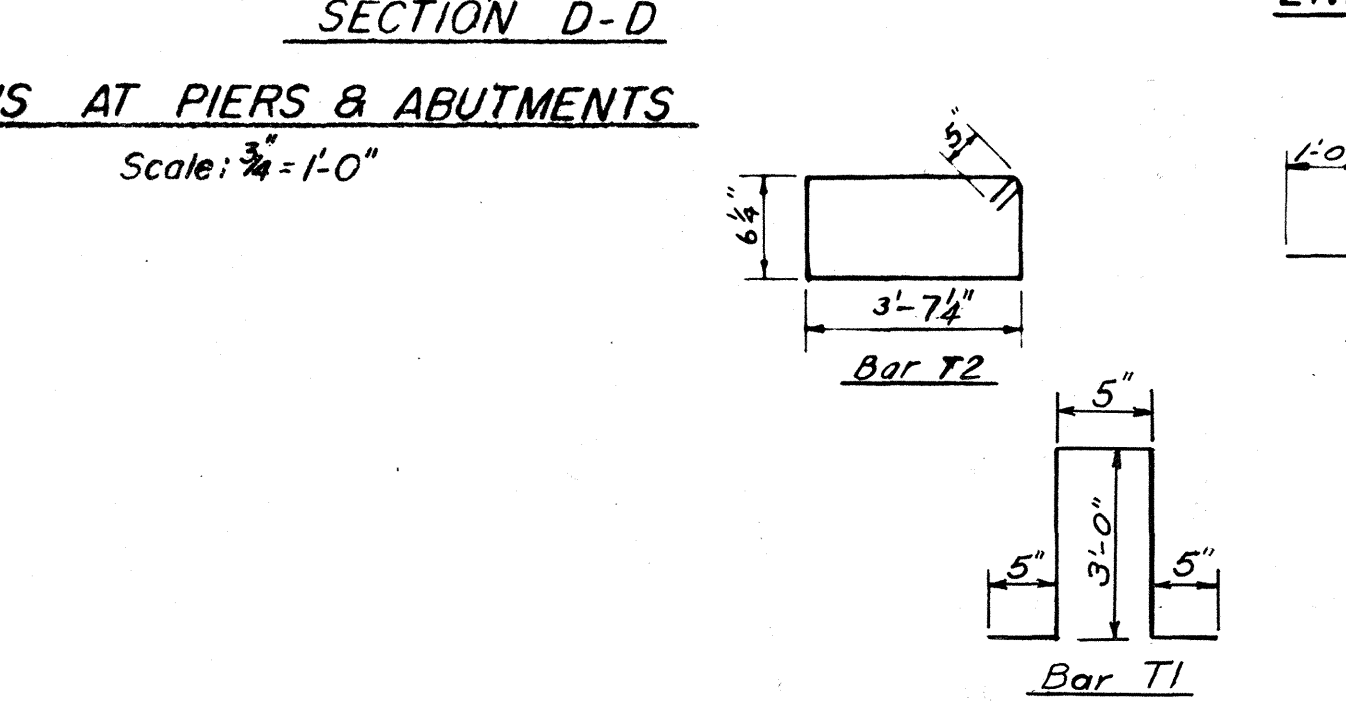


BENDING DIAGRAMS  
BILL OF STEEL

Bar	No.	Size	Length	Shape	Location
T1	16	#5	7'-3"	[Symbol]	End Block Slab
T2	12	#5	9'-1"	[Symbol]	End Block Slab
M10	30	#5	4'-6"	[Symbol]	Slab Thicken.
M11	6	#5	8'-1"	[Symbol]	Slab Thicken.

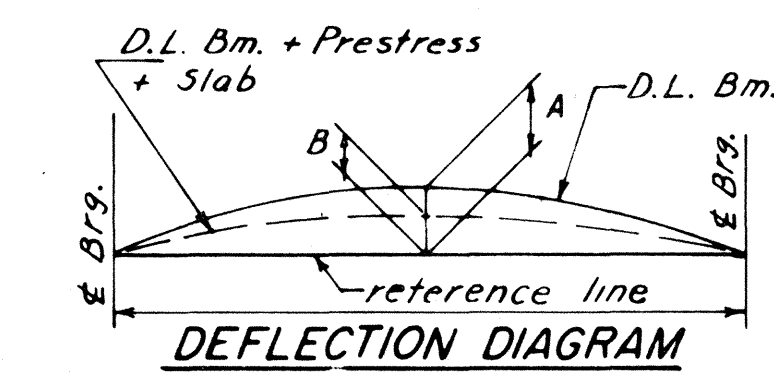


DEFLECTION DIAGRAM

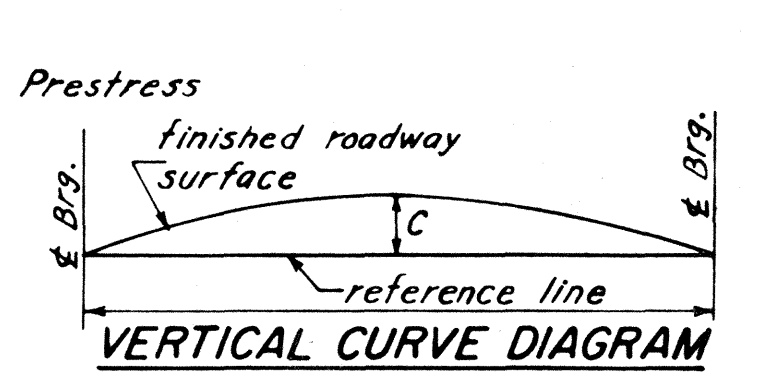

VERTICAL CURVE DIAGRAM

Span	Beam	Ainches	B inches
1	A	1 1/2"	4"
3 & 4	C	1 1/2"	5 1/2"
5	D	3/8"	3 1/2"
2	B1, B2 & B3	3/4"	1/2"
2	B4	3/4"	1/2"
2	B5 & B6	3/4"	1/2"
2	B7 & B8	1/2"	3/8"
2	B9	1/2"	3/8"

Beam	Span	C inches
A & D	1 & 5	0"
C	3 & 4	9 1/2"
B1, B2 & B3	2	3 1/4"
B4	2	1 1/4"
B5 & B6	2	5/8"
B7 & B8	2	3/16"
B9	2	1/2"

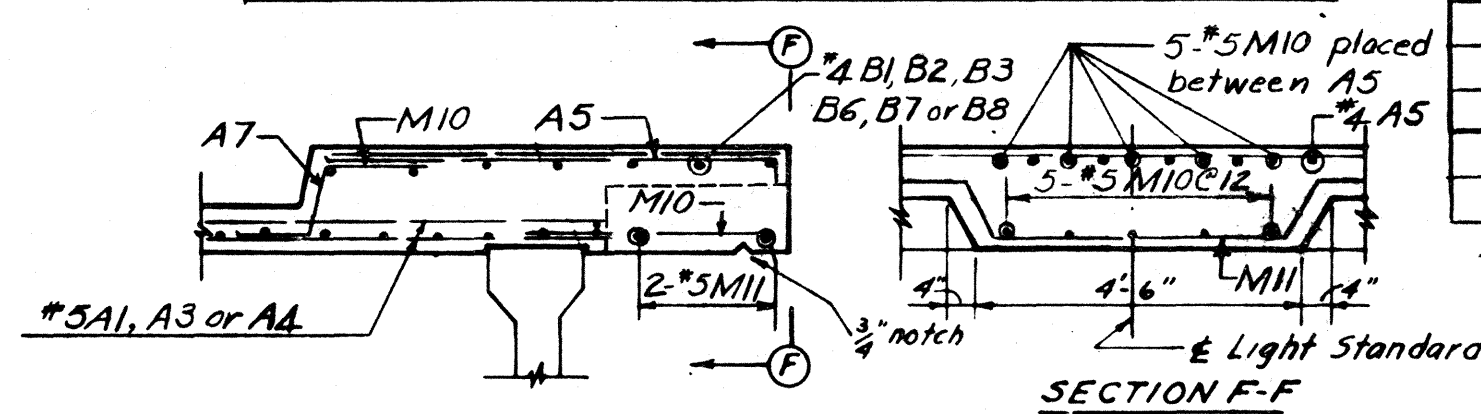

SLAB THICKENING DETAILS FOR LIGHT STANDARD  
Scale: 3/8"=1'-0"

All deflections are upward

STATE OF TENNESSEE  
DEPARTMENT OF HIGHWAYS AND PUBLIC WORKS  
PROJECT 1-240-1 (17) 13 SHEET NO.  
MEMPHIS CIRCUMFERENTIAL INTERSTATE HIGHWAY  
SOUTHEAST SECTION


HARLAND BARTHOLOMEW AND ASSOCIATES ENGINEERS  
CLARK AND DAILY ASSOCIATED ENGINEERS  
WB. POPLAR AVE. OVER I-240  
SUPERSTRUCTURE SLAB DETAILS

DATE	SCALE	DRAWN BY	CHECKED BY	IN CHARGE
11-26-58	As Noted	MAT	DAS	BCC





PUB. ROADS DIV. NO.	STATE	PROJECT NO.	FISCAL YEAR	SHEET NO.	TOTAL SHEETS
3	TENNESSEE	1-240-1 (17) 13	1989	178	334
REVISION					
5/23/60					
REVISION					

**PRETENSION DETAILS**

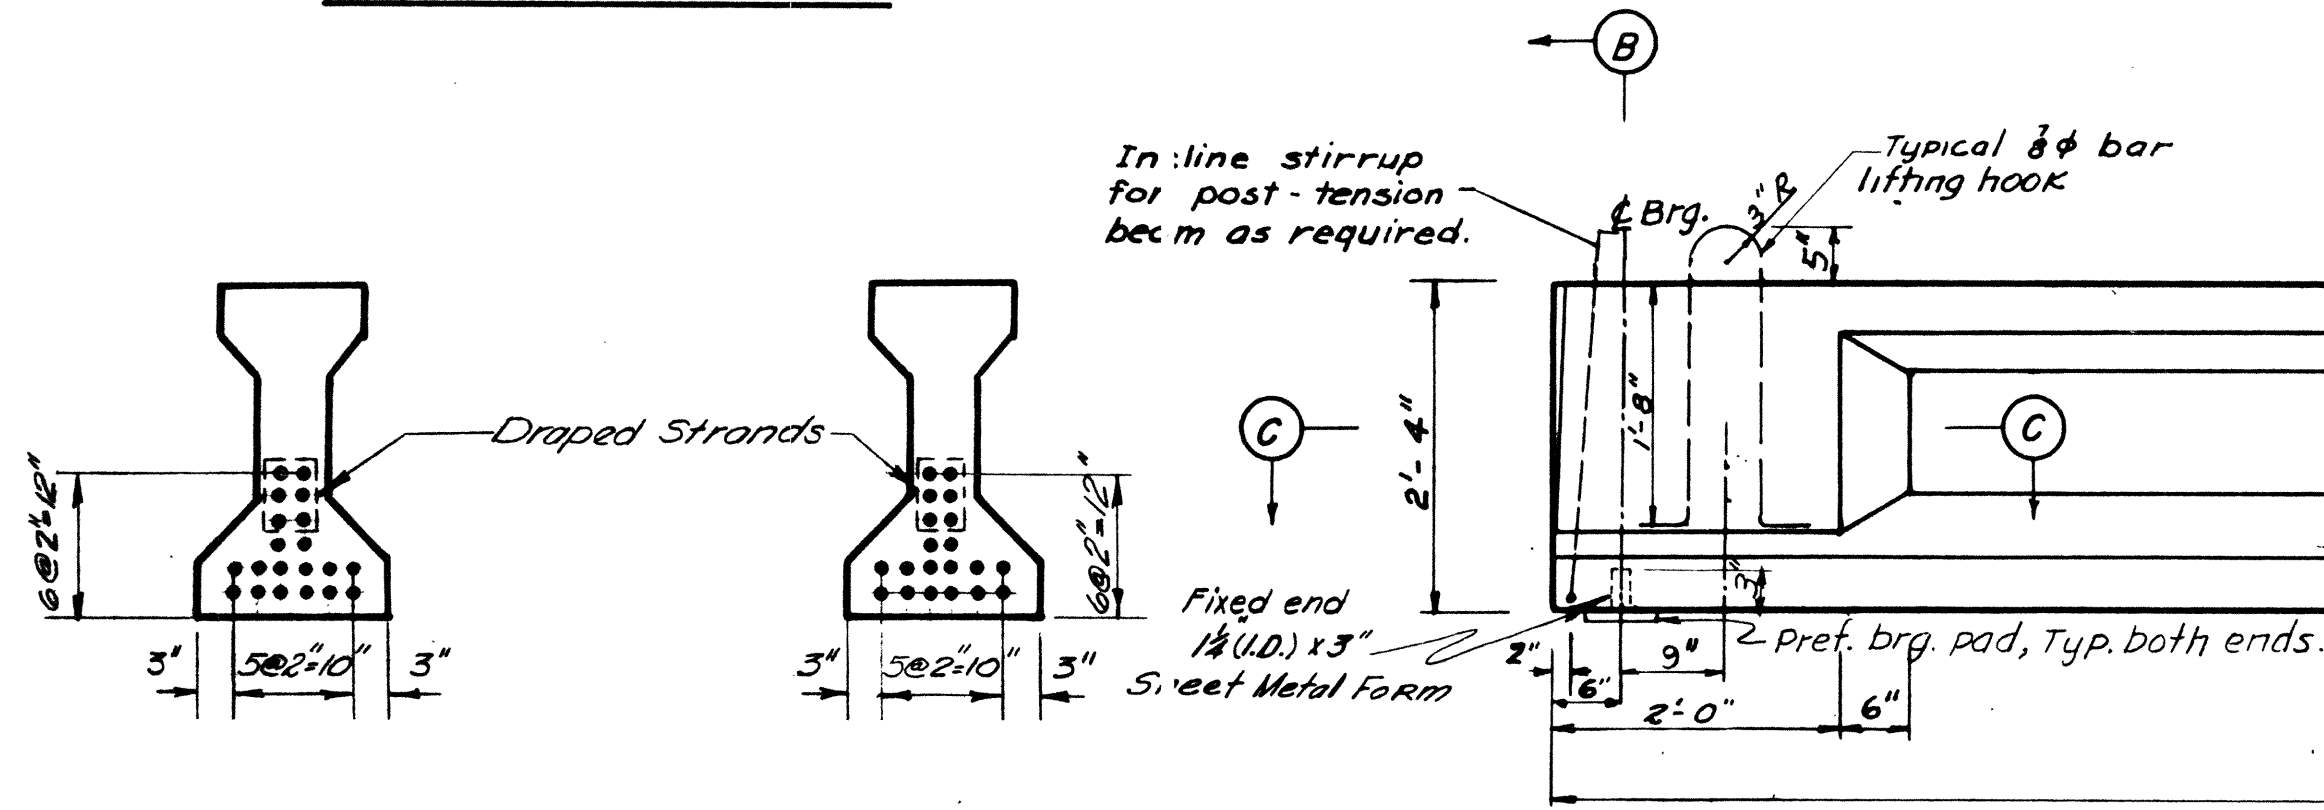

**SECTION A-A**  
BEAM A  
SCALE 3/4" = 1'-0"

**SECTION C-C**  
BEAM D  
SCALE 3/4" = 1'-0"

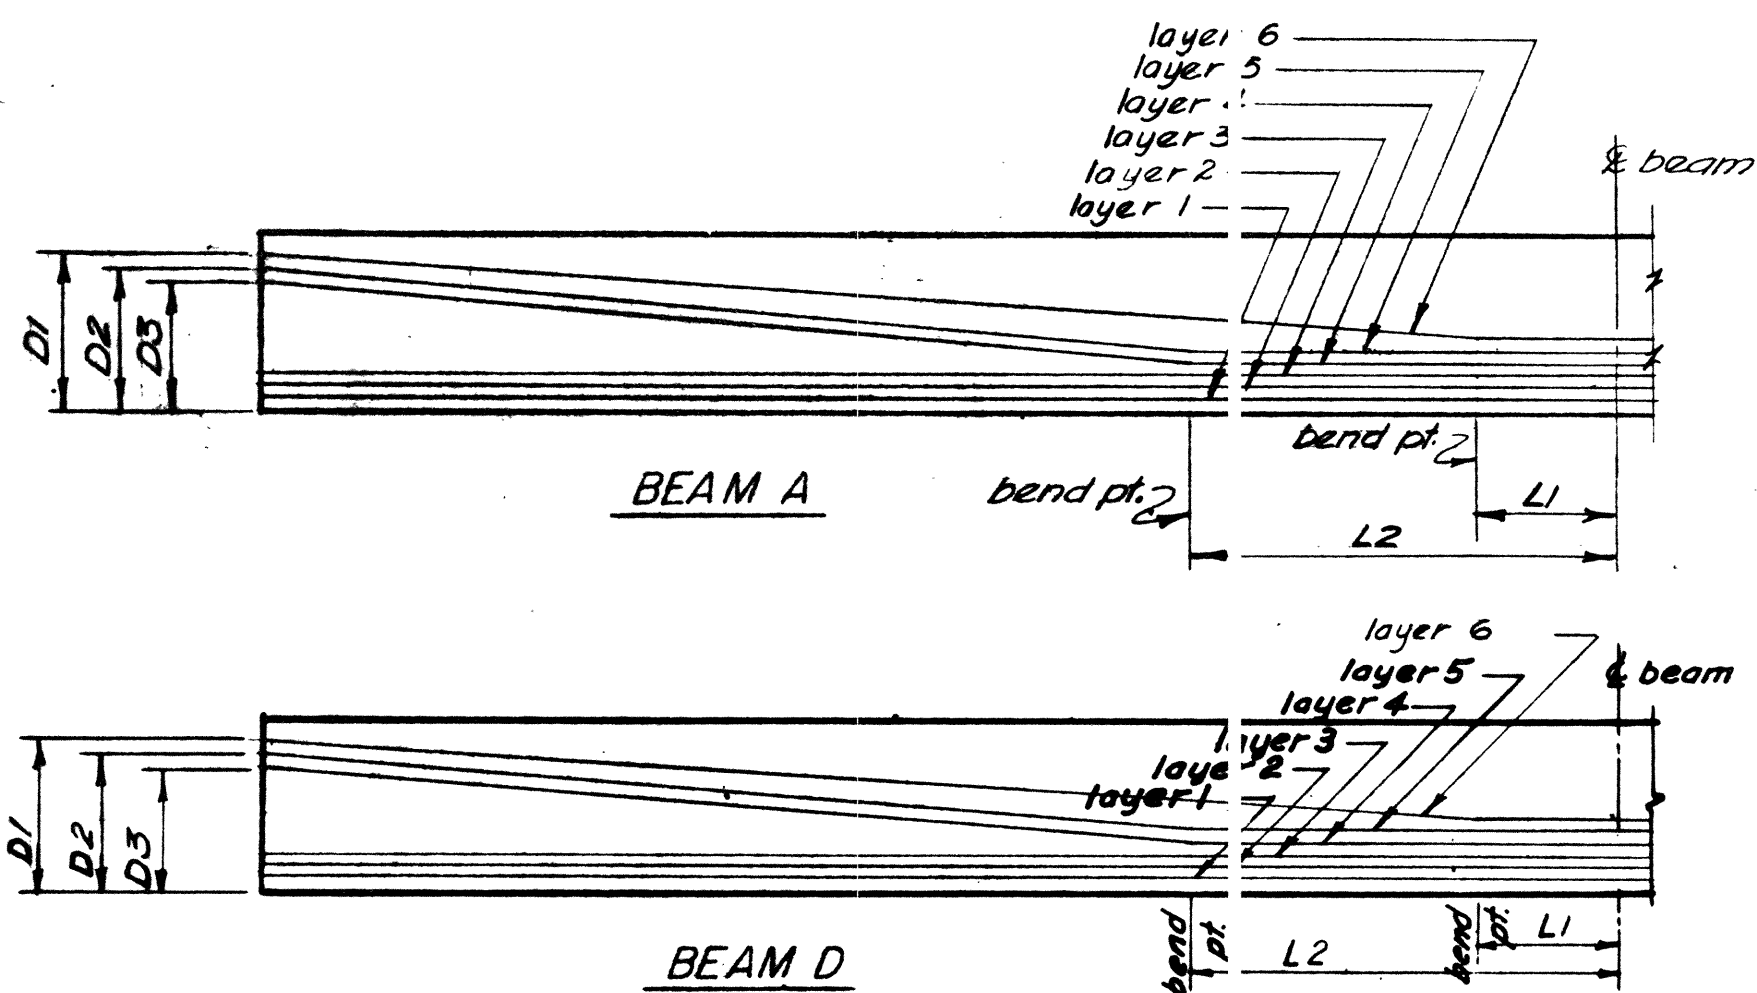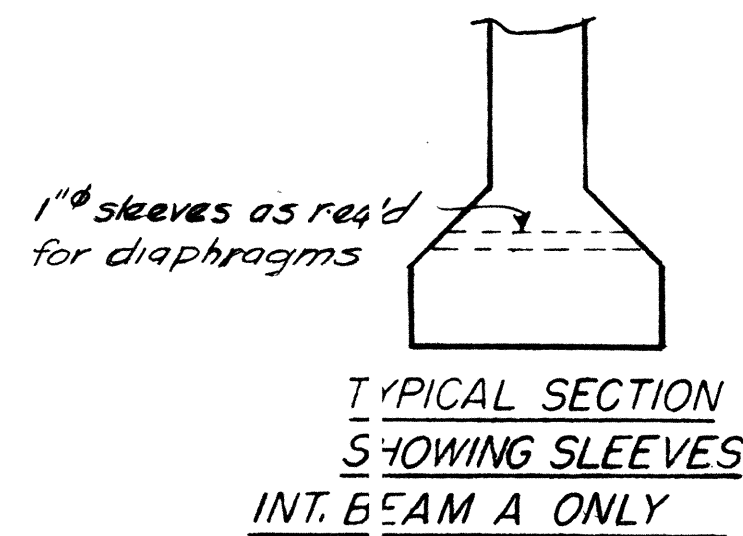


Beam	No. strands in layer	Total No. 1/2 strands	Prestress Force*	D1	D2	Dimensions	Beams Req'd.
	1 2 3 4 5 6					D3 L1 L2	
A	6 6 6 6 6 6	20	378,000 lbs	23"	21"	19" 2'-0" 6'-0"	13
D	6 6 6 6 6 6	20	355,000 lbs	23"	21"	19" 2'-0" 6'-0"	9

Total Initial Prestress Force in lbs.

**PRETENSION BEAM DATA**

⊕ straight ⊔ draped

**ELEVATION OF PRESTRESSED BEAMS-SPANS 1 & 5**

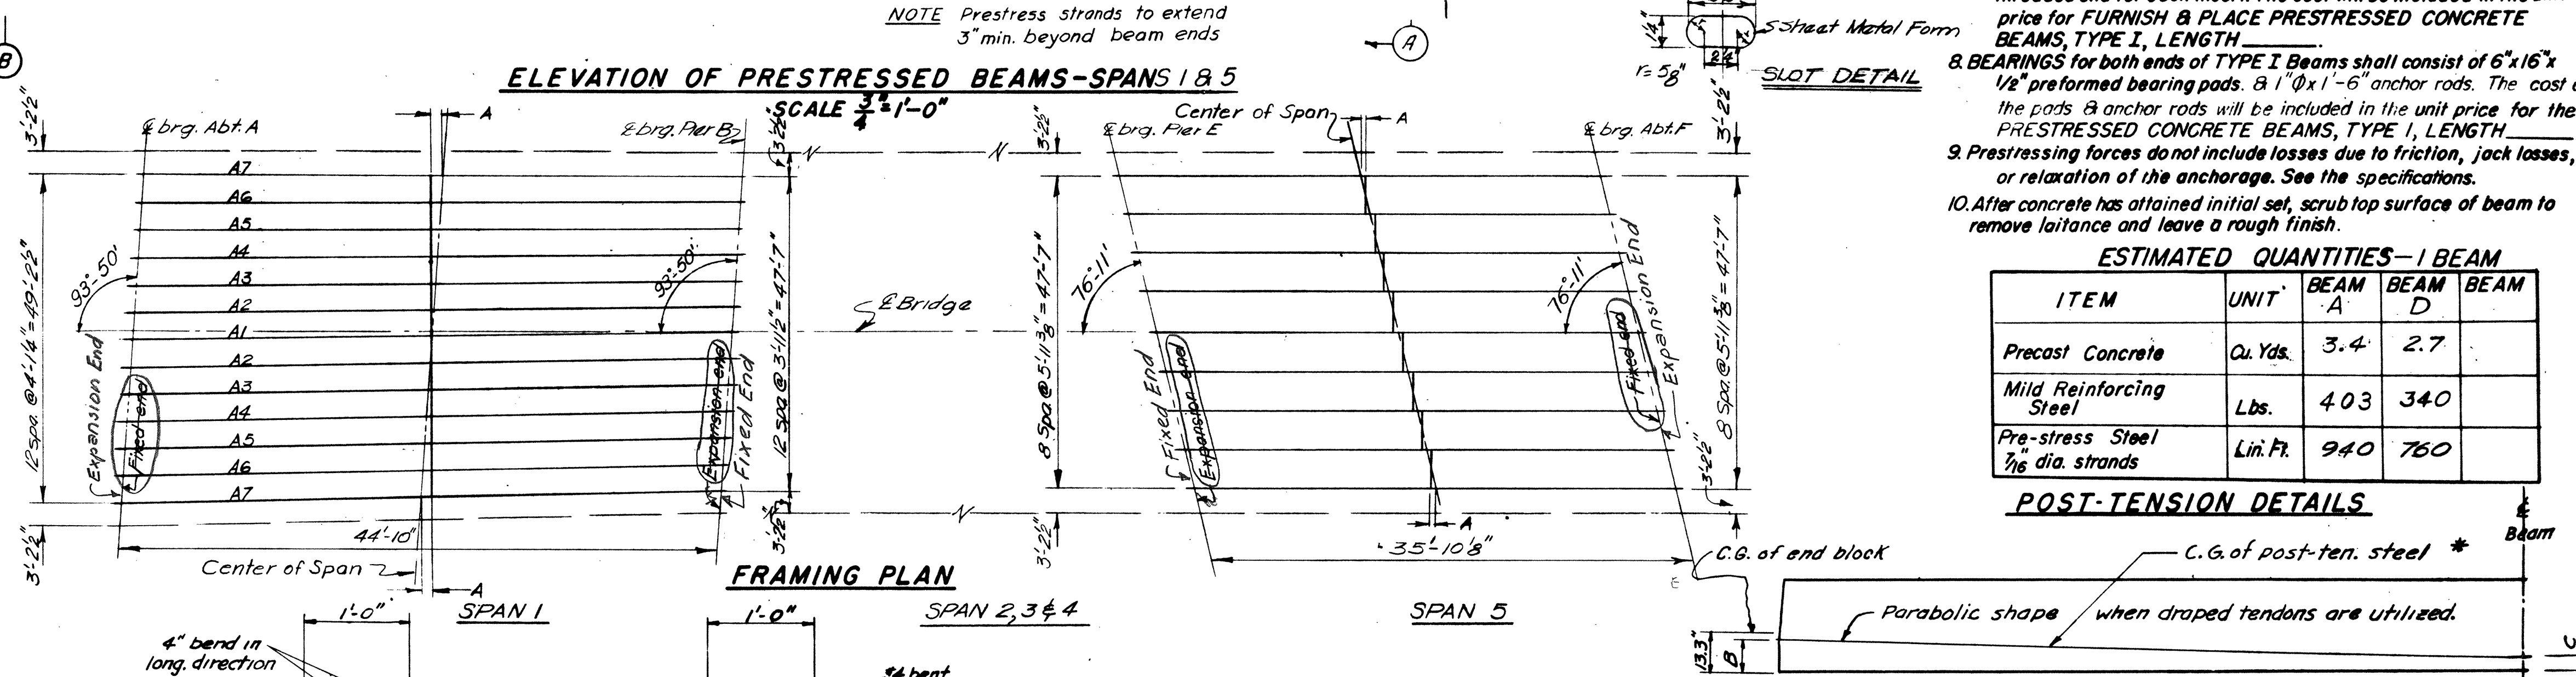

**FRAMING PLAN**

**TYPICAL SECTION**  
SCALE 1" = 1'-0"

**SECTION B-B**  
SCALE 1" = 1'-0"

**SECTION C-C**  
SCALE 1" = 1'-0"

**POST-TENSION BEAM DATA**

\* The C.G. of the post-tension steel may vary from the position shown above. The C.G. must approximate a parabola and all required design stress conditions must be satisfied. See the specifications.

**ESTIMATED QUANTITIES-1 BEAM**

ITEM	UNIT	BEAM A	BEAM D
Precast Concrete	Cu. Yds.	3.4	2.7
Mild Reinforcing Steel	Lbs.	403	340
Pre-stress Steel 1/2 dia. strands	Lin. Ft.	940	760

**POST-TENSION DETAILS**

Beam	Dimension B	Dimension C	Final Prestress force	Initial Prestress force
A	10 1/2"	5 3/8"	295,000 lbs	364,000 lbs
D	10 1/2"	5 3/8"	277,000 lbs	342,000 lbs

**BILL OF MATERIALS**

Item	Unit	Quantity
A Prestressed concrete beams Type I - Length 45'-10"	each	13
D Prestressed concrete beams Type I - Length 36'-10 1/2"	each	9

Beam	Distance from brg. in feet	Bending Mom. (ft.kips)			Shear @ brg. kips	Beam	Distance from brg. in feet	Bending Mom. (ft.kips)			Shear @ brg. kips
		2'-0"	15'-0"	20'-0"				2'-0"	11'-0"	16'-0"	
A	Dead Load (Beam)	12	64	72	72	D	Dead Load (Beam)	10	39	46	46
	S.D.L.*	15	80	89	90		S.D.L.*	19	75	82	88
	Live Load**	59	276	298	298		31.5	75	279	309	316

**TABLE OF BENDING MOMENTS & SHEARS**

\* Superimposed dead load includes slab, diaphragms, etc.  
\*\* Live load includes future wearing surface of 20' lbs/sq ft & impact.

Beam	Stirrup spacing for 1/2 beam spaces shown below start @ the beam end
A	15'-2" @ 4"; 11' @ 6"; 2 @ 11 1/2"; and 15' @ 1'-0" 59 stirrups required per beam.
D	10'-2" @ 4"; 10' @ 6"; 1 @ 11 1/2" and 12' @ 1'-0" 49 stirrups required per beam.

**STIRRUP SPACING**

Beam	Dimension A	Ext Int	No. of interior beam
A1	0'-0"	0	2
A2	0'-3 3/4"	0	2
A3	0'-6 1/2"	0	2
A4	0'-9 3/4"	0	2
A5	1'-1"	0	2
A6	1'-4 1/4"	0	2
A7	1'-7 1/2"	2	0
D	8'-3 3/4"	2	4

**DIAPHRAGM LOCATION**  
See framing plan.

Bridge 15 A

STATE OF TENNESSEE  
DEPARTMENT OF HIGHWAYS AND PUBLIC WORKS  
PROJECT 1-240-1 (17) 13 SHELBY CO.  
MEMPHIS CIRCUMFERENTIAL INTERSTATE HIGHWAY  
SOUTHEAST SECTION

HARLAND BARTHOLOMEW AND ASSOCIATES, ENGINEERS  
CLARK AND DAILY, ASSOCIATED ENGINEERS

W. B. POPLAR AVENUE OVER I-240  
**PRESTRESSED BEAMS-SPANS 1 & 5**


DATE	SCALE	DRAWN BY	CHECKED BY	IN CHARGE
11-8-58	As Noted	JWN	MAT	B.C.C.

JOB NO.332




PUB. ROAD DIV. NO.	STATE	PROJECT NO.	FISCAL YEAR	SHEET NO.	TOTAL SHEETS
3	TENNESSEE	1-210-1 (17) 13	1959	179	334
REVISION					
REVISION					

**PRETENSION DETAILS**

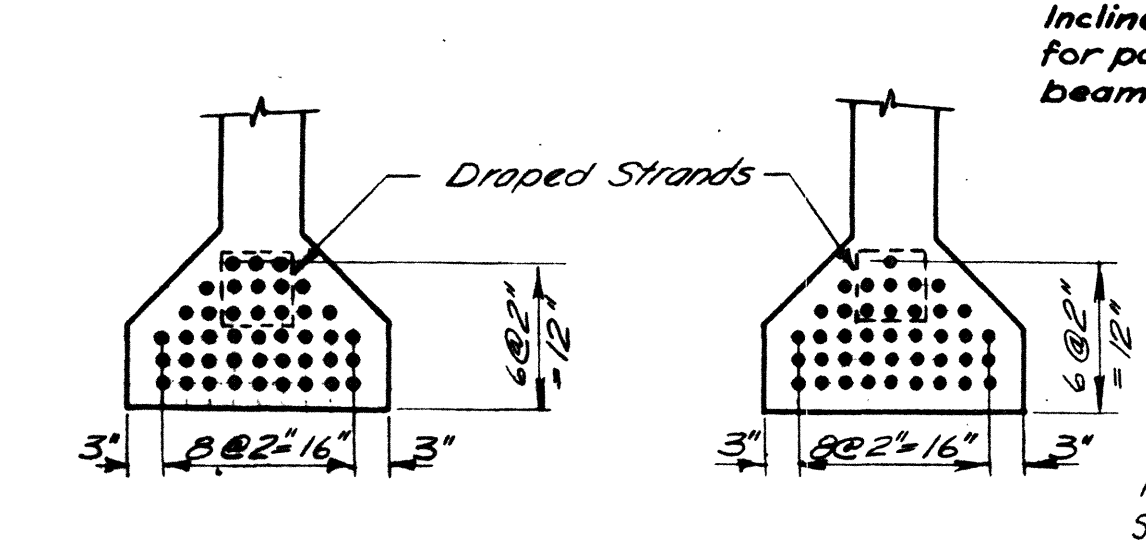


**SECTION (A) (A)**  
BEAM B1, B2  
SCALE 3/4" = 1'-0"

**SECTION (A) (A)**  
BEAM B3, B4  
SCALE 3/4" = 1'-0"

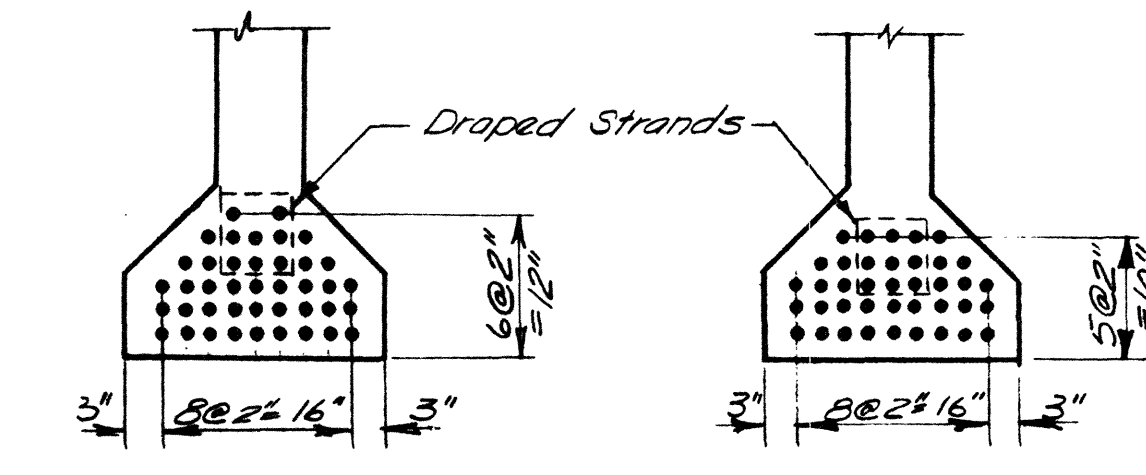


**SECTION (A) (A)**  
BEAM B3  
SCALE 3/4" = 1'-0"


**SECTION (A) (A)**  
BEAM C  
SCALE 3/4" = 1'-0"

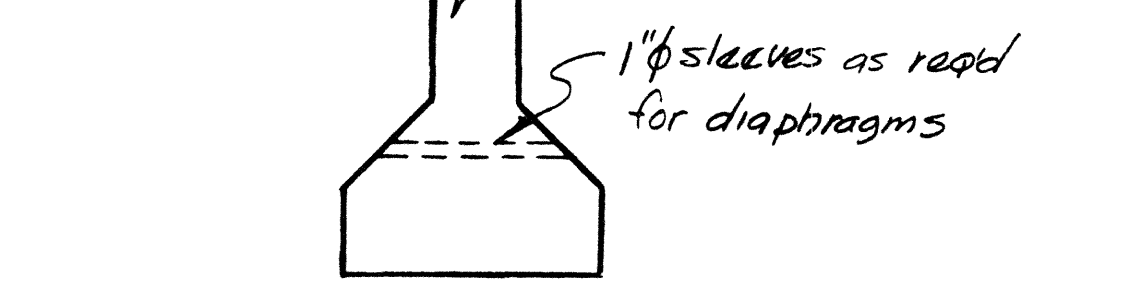

TYP SECTION SHOWING SLEEVES  
INTERIOR BEAM B ONLY

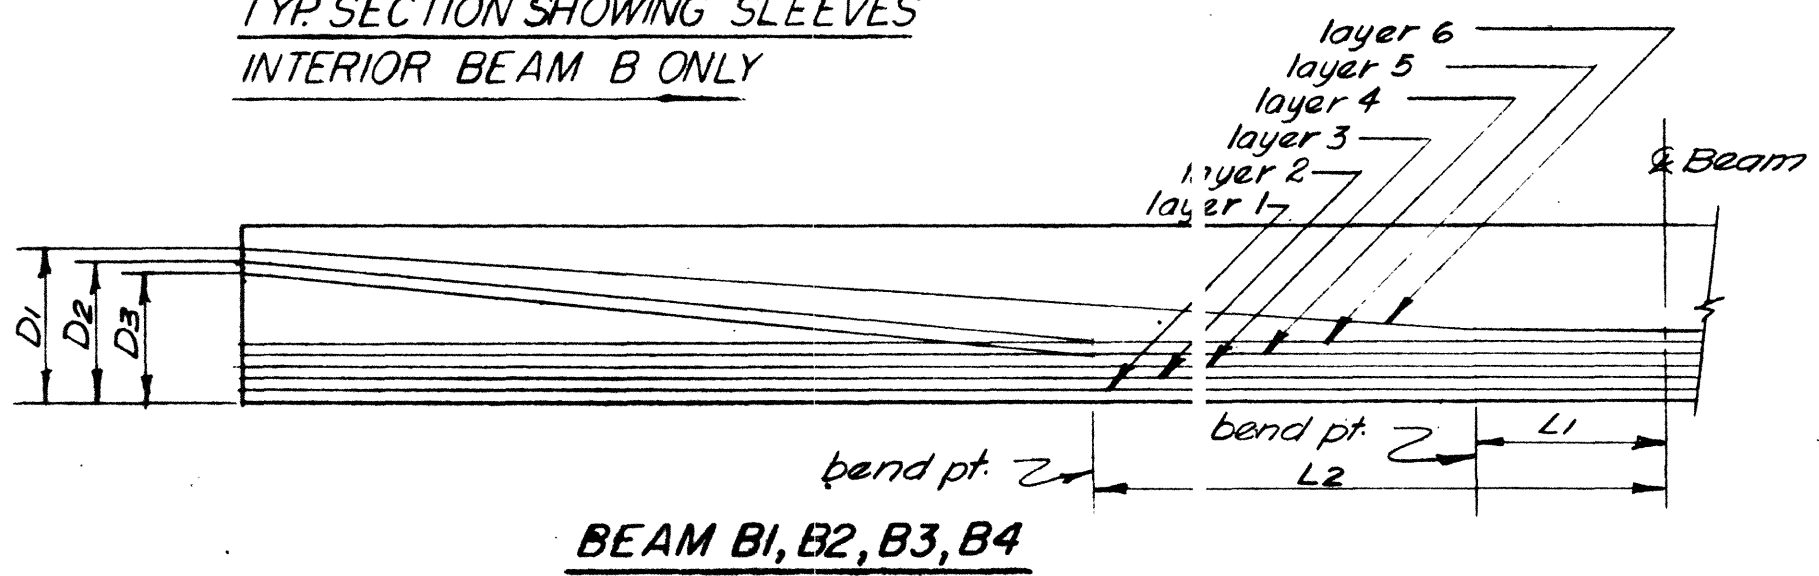

BEAM B1, B2, B3, B4

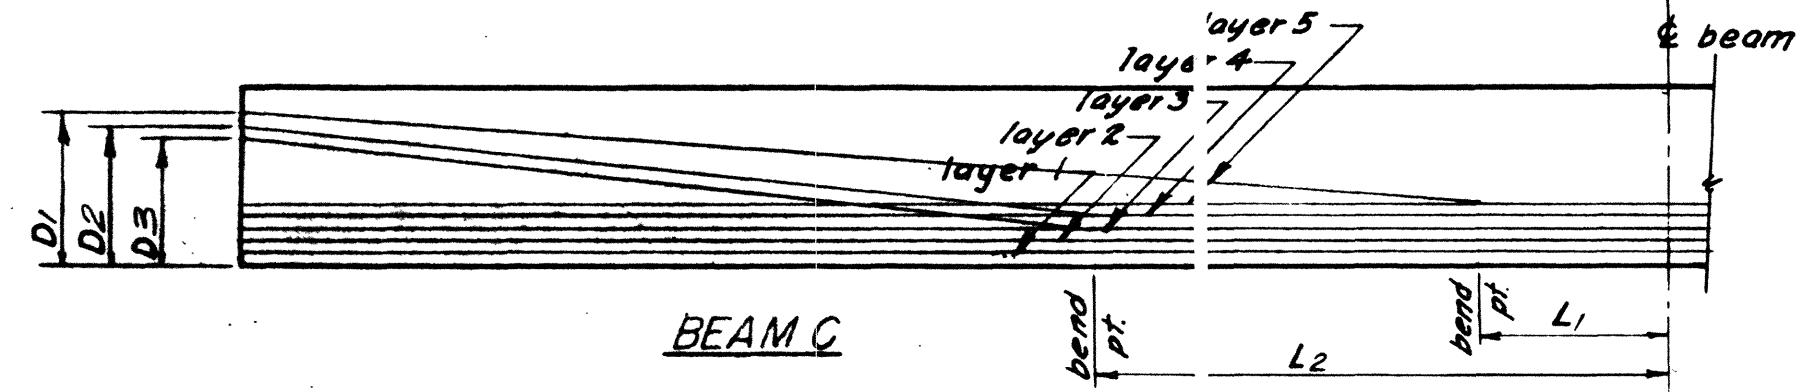


BEAM C

Beam	No. strands in layer	Total No. 1/2" strands	Prestress Force*	D1	D2	D3	D	L1	L2	Beams Req'd
B1	9 0 9 0 9 0 9 0	42	794,000 <sup>#</sup>	40	38	36	4'-0"	12'-0"		1
B2	9 0 9 0 9 0 9 0	42	780,000 <sup>#</sup>	40	38	36	4'-0"	12'-0"		1
B3	9 0 9 0 9 0 9 0	41	765,000 <sup>#</sup>	40	38	36	4'-0"	12'-0"		1
B4	9 0 9 0 9 0 9 0	40	742,000 <sup>#</sup>	40	38	36	4'-0"	12'-0"		1
C	9 0 9 0 9 0 9 0	39	731,000 <sup>#</sup>	40	38	36	4'-0"	12'-0"		16

\*Total Initial Prestress Force


**PRETENSION BEAM DATA**

straight draped

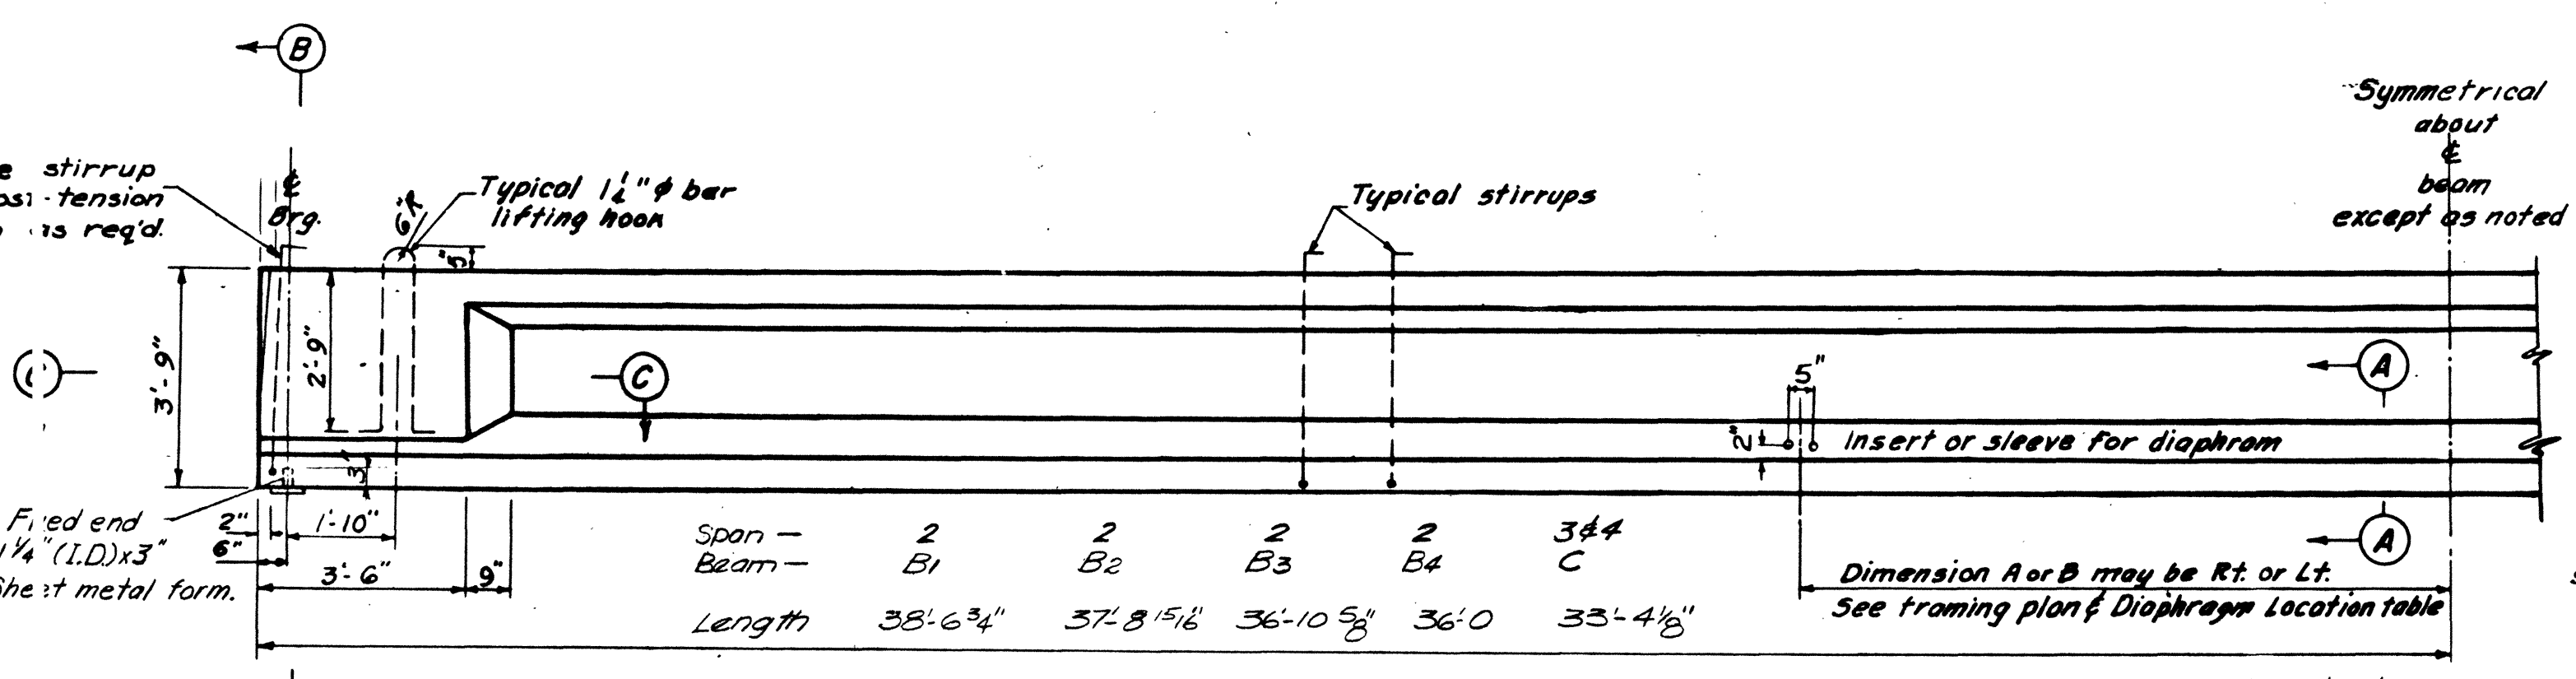


NOTE: Prestress strands to extend 3' min. beyond beam ends

**ELEVATION OF PRESTRESSED BEAMS - SPANS 2, 3 & 4**

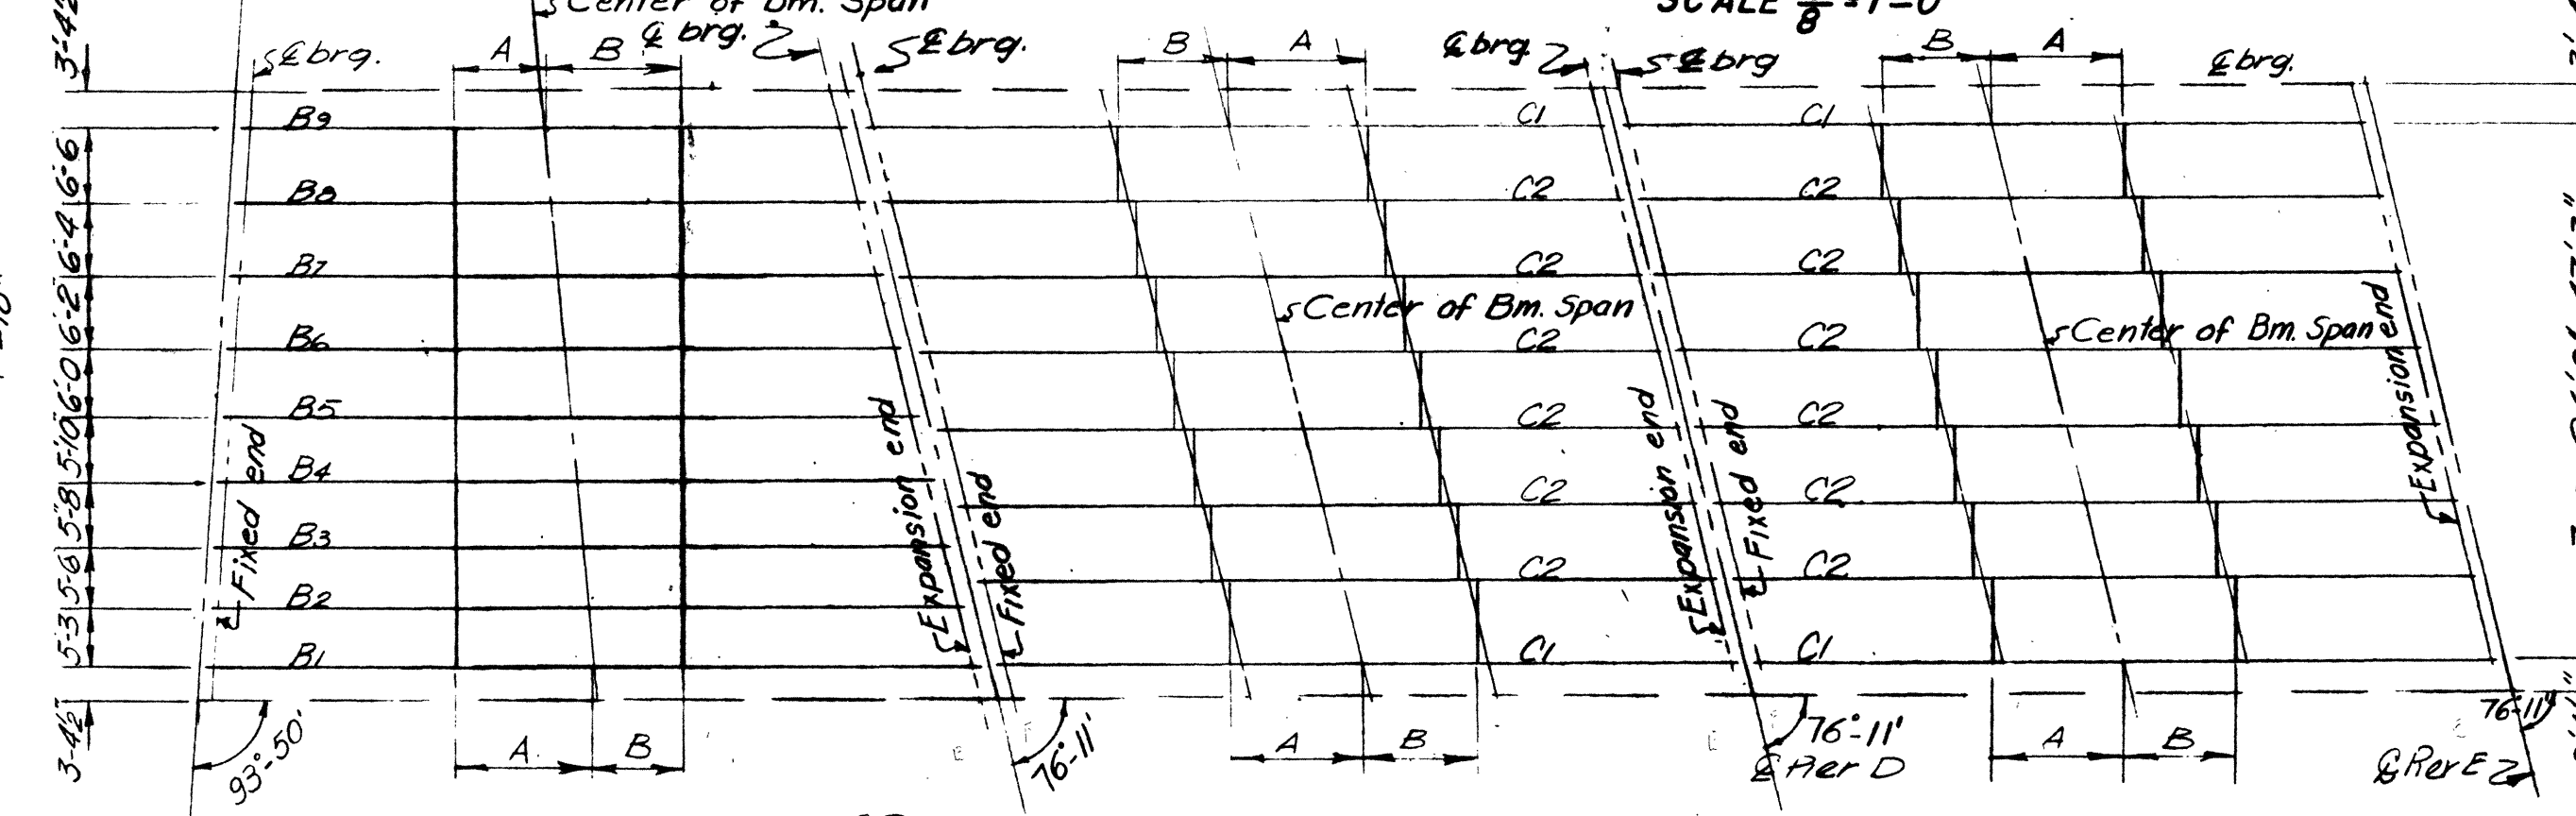

**FRAMING PLAN**

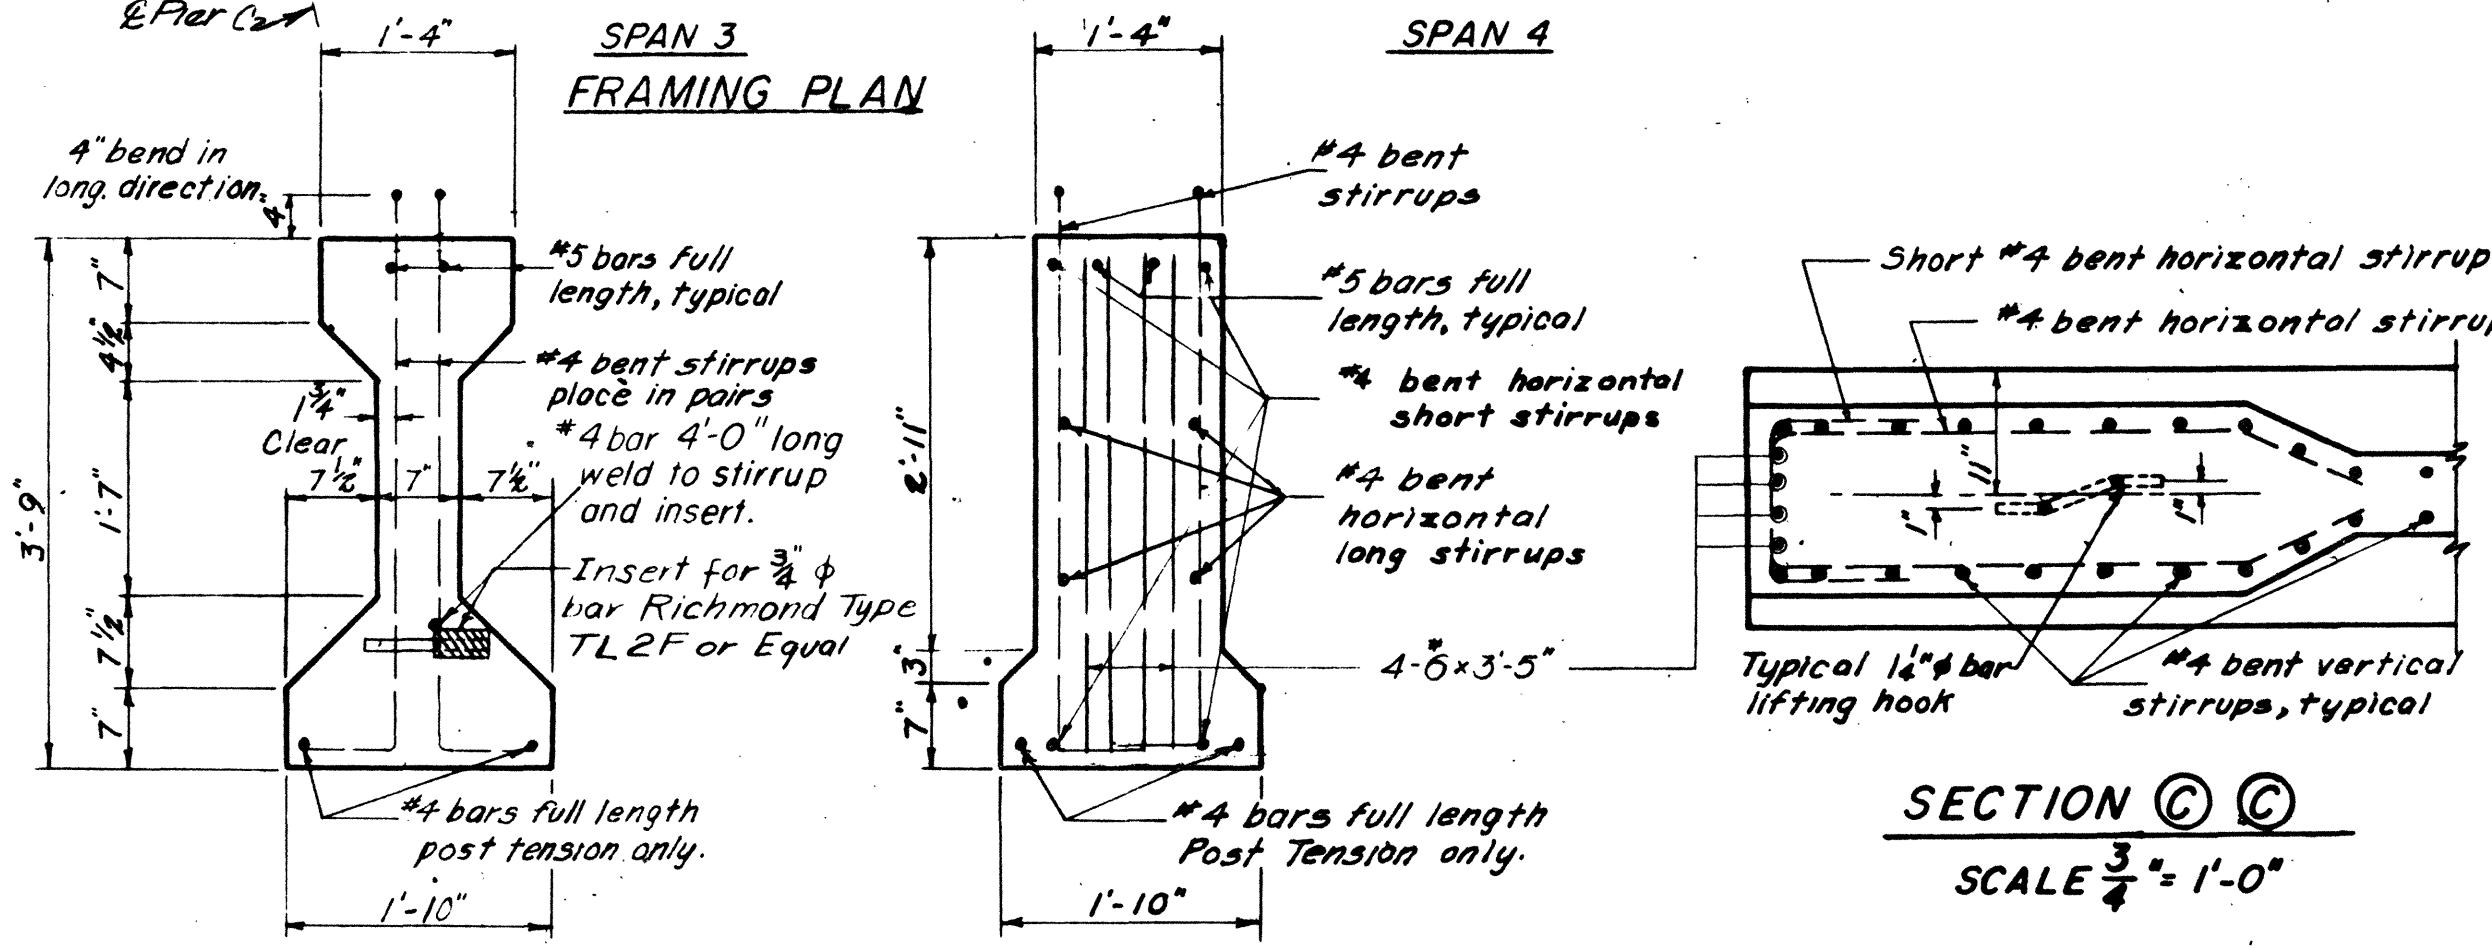

**TYPICAL SECTION**  
SCALE 3/4" = 1'-0"

**SECTION (B) (B)**  
SCALE 3/4" = 1'-0"


**ESTIMATED QUANTITIES - 1 BEAM**

ITEM	UNIT	BEAMS				
		B1	B2	B3	B4	C
Precast Concrete	Cu. Yd.	11.5	11.3	11.1	10.8	10.0
Mild Reinforcing Steel	Lbs.	910	890	890	860	820
Prestress Steel 1/2" dia. strands	Lbs.	3280	3210	3060	2920	2640

**GENERAL NOTES**

- The Contractor has the option of furnishing pretensioned, post-tensioned, or a combination beam. See the specifications.
- SPECIFICATIONS are the STANDARD ROAD AND BRIDGE SPECIFICATIONS OF THE TENNESSEE DEPARTMENT OF HIGHWAYS AND PUBLIC WORKS.
- LOADING: H20-S16-44 (Modified for Military Loading)
- REINFORCING STEEL: See specifications.
- FORMS & FINISH: See specifications
- All reinforcing steel, prestressing strands, lifting hooks, inserts, sleeves, or other items cast into the beam and all preformed bearing pads and 1" x 1'-6" Anchor Rods will be included for payment purposes in the Unit Price each under Furnish and Place Prestressed Concrete Beams (Type III)
- The Contractor shall provide a 3/4" dia. x 1'-6" long dowel with threaded end for each insert. The cost will be included in the unit price for FURNISH & PLACE PRESTRESSED CONCRETE BEAMS, TYPE III, LENGTH.
- BEARINGS for both ends of Type III beams consists only of a 8"x22"x1" pref. brg. pad & a 1" x 1'-6" anchor rod.
- Prestressing forces shown do not include losses due to friction, jack losses or relaxation of the anchorage. See the specifications.
- After concrete has attained initial set, scrub top surface of beam to remove laitance and leave a rough finish.

**POST-TENSION DETAILS**

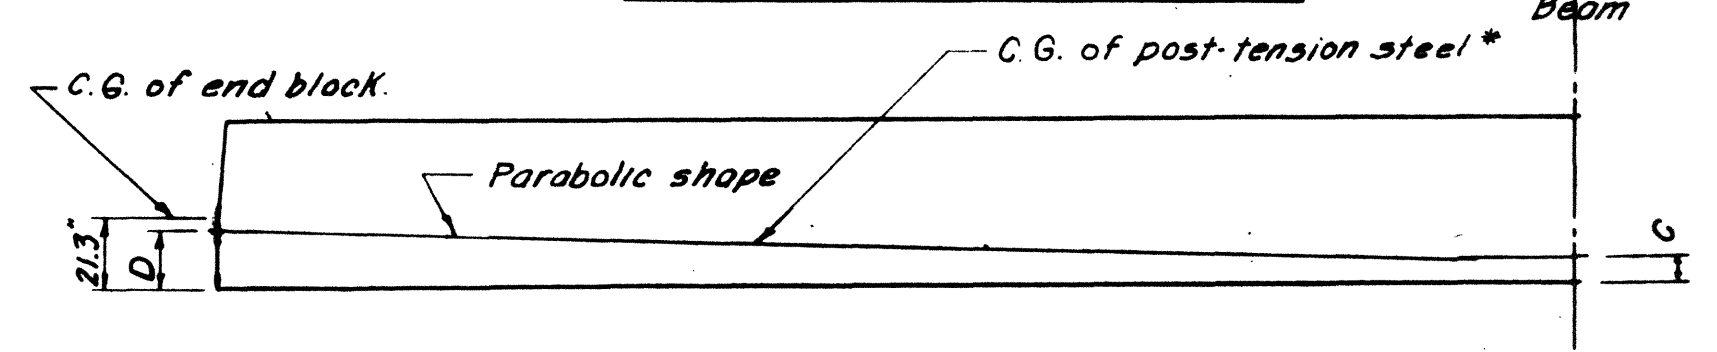

**POST-TENSION BEAM DATA**

\*The C.G. of the post-tension steel may vary from the position shown above. The C.G. must approximate a parabola and all required design stress conditions must be satisfied. See the specifications.

Beam	Dimension	Final Prestress force	Initial Prestress force
B1	6" x 1'-3"	620,000 <sup>#</sup>	765,000 <sup>#</sup>
B2	6" x 1'-3"	609,000 <sup>#</sup>	751,000 <sup>#</sup>
B3	5 3/4" x 1'-3"	597,000 <sup>#</sup>	736,000 <sup>#</sup>
B4	5 1/2" x 1'-3"	580,000 <sup>#</sup>	715,000 <sup>#</sup>
C	5 1/2" x 1'-3"	571,000 <sup>#</sup>	704,000 <sup>#</sup>

# = lbs.

**BILL OF MATERIALS**

Item	Unit	Quantity
B1 Prestressed concrete beams Type III (Length 77'-12")	each	1
B2 Prestressed concrete beams Type III (Length 75'-5 1/2")	each	1
B3 Prestressed concrete beams Type III (Length 73'-9 1/4")	each	1
B4 Prestressed concrete beams Type III (Length 72'-0")	each	1
C Prestressed concrete beams Type III (Length 66'-8 1/4")	each	16

Beam	Distance from & Brg. in feet	Bending Mom. (ft. kips)	Shear @ brg. kips	Beam	Distance from & brg. in feet	Bending Mom. (ft. kips)	Shear @ brg. kips
B1	Dead Load (Beam)	79 365 411 422	22.2	B4	Dead Load (Beam)	74 322 362 367	20.7
B1	S.D.L.*	65 301 340 349	17.8	B4	S.D.L.*	67 285 320 336	18.3
B1	Live Load	165 719 787 794	45.6	B4	Live Load	174 730 792 797	49.2
B2	Dead Load (Beam)	77 353 396 404	21.7	B3	Dead Load (Beam)	68 266 308 315	19.1
B2	S.D.L.*	66 300 336 343	17.9	B3	S.D.L.*	78 309 357 365	21.5
B2	Live Load	182 722 787 792	46.4	B3	Live Load	201 750 841 847	57.1

**TABLE OF BENDING MOMENTS & SHEARS**

\* Superimposed dead load, includes slab, diaphragm, etc.  
\*\* Live load includes future wearing surface of 20 lbs./sq. ft. & impact.

Beam	Stirrup spacing for 1/2 beam Spaces shown below start @ the beam end	Bm	Dimensions	No. of inserts	No. of sleeves
B1	10@2", 10@4", 13@6", 20@9", 30@1'-0"	B1	13'-5 1/2" x 9'-6 1/2"	4	—
B2	93 Stirrups required per beam.	B2	13'-0 3/4" x 9'-11 1/2"	—	4
B3	10@2", 10@4", 13@6", 10@9", and 20@1'-0"	B3	12'-6 3/4" x 10'-5 1/4"	—	4
B4	91 Stirrups required per beam.	B4	12'-0 1/4" x 10'-11 3/8"	—	4
C	83 Stirrups required per beam.	C1	11'-11 3/8" x 10'-3 3/8"	4	—
		C2	11'-11 3/8" x 10'-3 3/8"	—	B

**DIAPHRAGM LOCATION**

See Framing Plan.  
Bridge 15A

STATE OF TENNESSEE  
DEPARTMENT OF HIGHWAYS AND PUBLIC WORKS  
PROJECT 1-210-1 (17) IS SHELBY CO.  
MEMPHIS CIRCUMFERENTIAL INTERSTATE HIGHWAY  
SOUTHEAST SECTION

HARLAND BARTHOLOMEW AND ASSOCIATES, ENGINEERS  
CLARK AND DAILY, ASSOCIATED ENGINEERS


W.B. POPLAR AVENUE OVER I-240  
**PRESTRESSED BEAMS - SPANS 2, 3 & 4.**

DATE: 11-12-58 SCALE: As Noted DRAWN BY: JWN CHECKED BY: MAT IN CHARGE: B.C.C.  
JOB NO. 332  
Bridge Dwg 8 of 10




PUB. ROAD DIV. NO.	STATE	PROJECT NO.	FISCAL YEAR	SHEET NO.	TOTAL SHEETS
3	TENNESSEE	1-240-1 (17) 15	1959	180	334
REVISION					
REVISION					

**PRETENSION DETAILS**

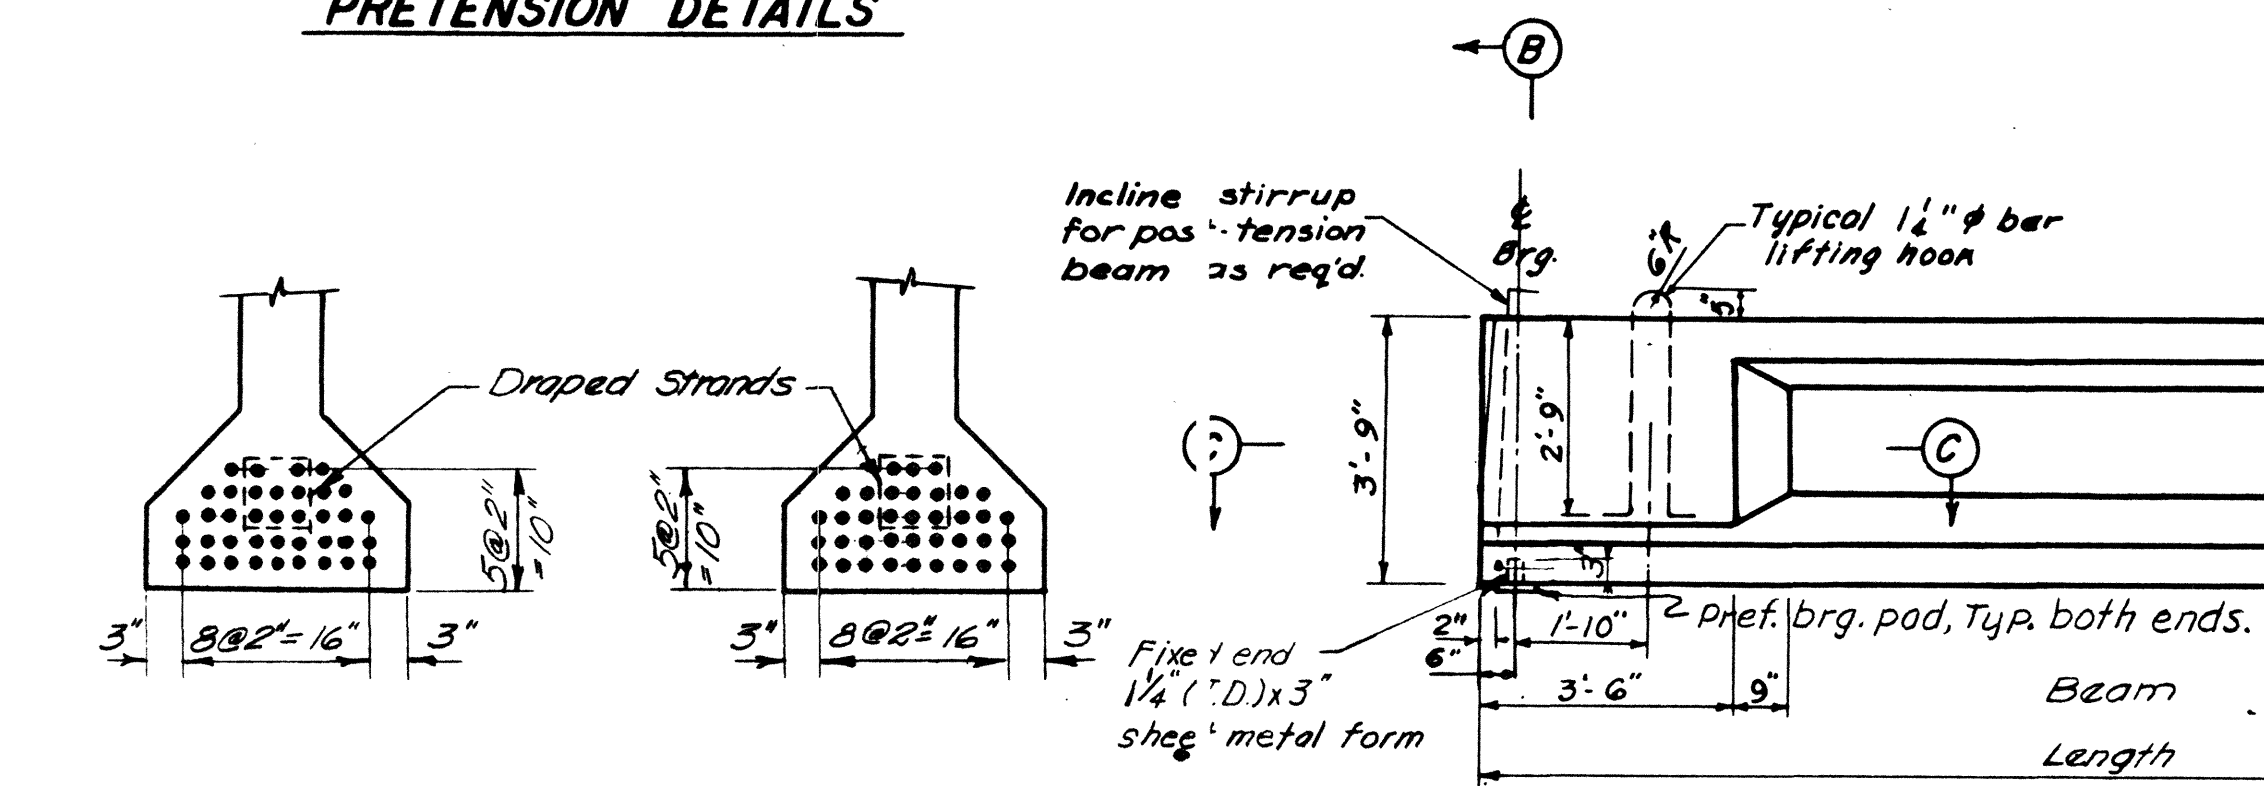


**SECTION (A) (A)**  
BEAM B5-B6  
SCALE 3/4" = 1'-0"

**SECTION (A) (A)**  
BEAM B7  
SCALE 3/4" = 1'-0"


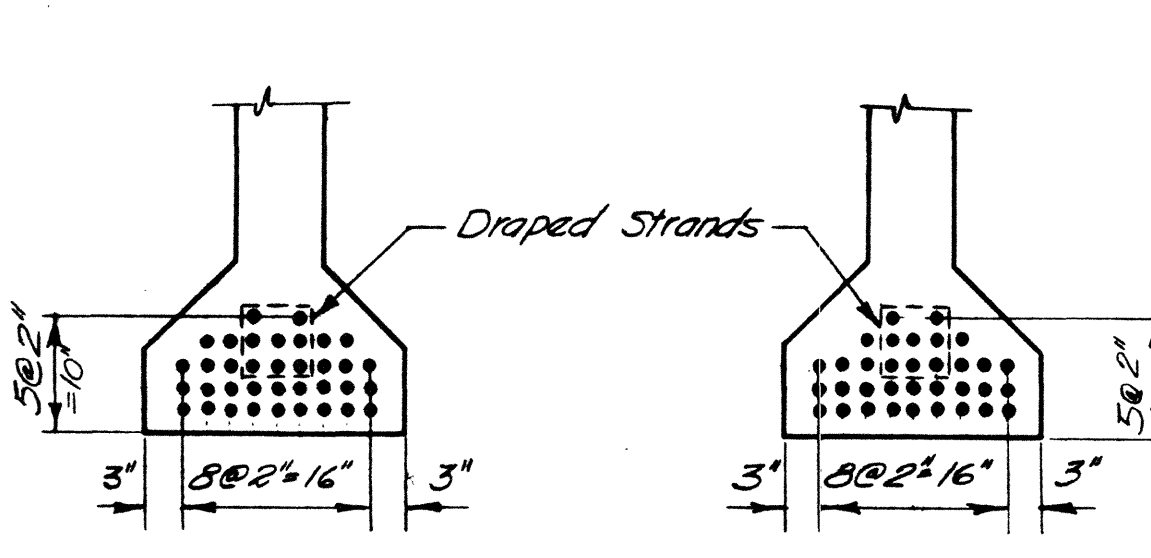


**SECTION (A) (A)**  
BEAM B8  
SCALE 3/4" = 1'-0"

**SECTION (A) (A)**  
BEAM B9  
SCALE 3/4" = 1'-0"

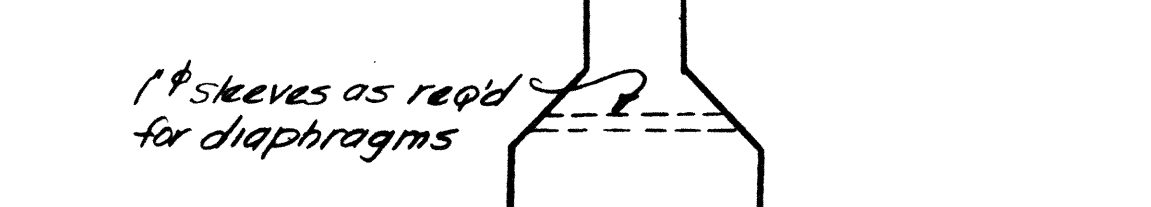

**SECTION (A) (A)**  
TYPICAL SECTION SHOWING SLEEVES INTERIOR BEAM B ONLY

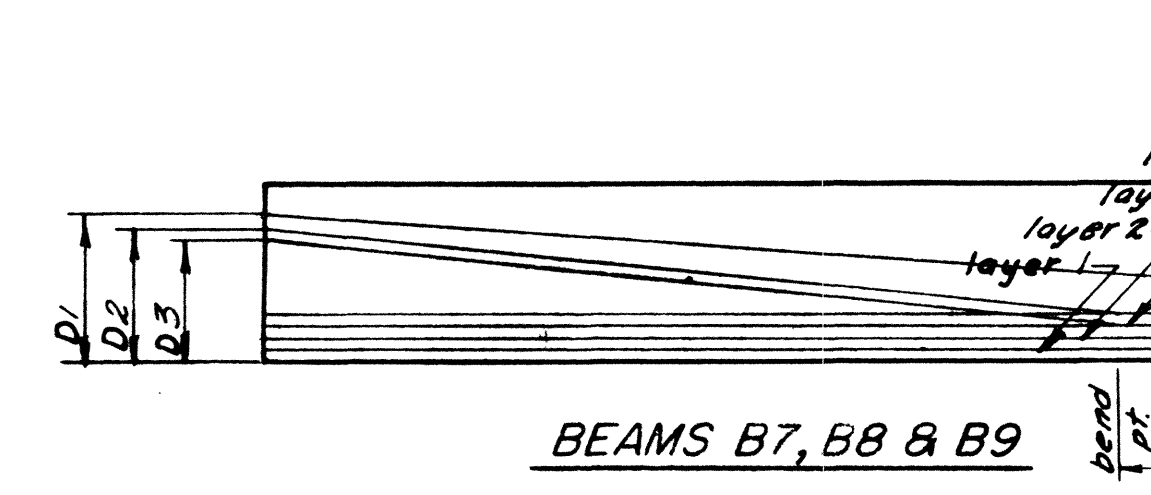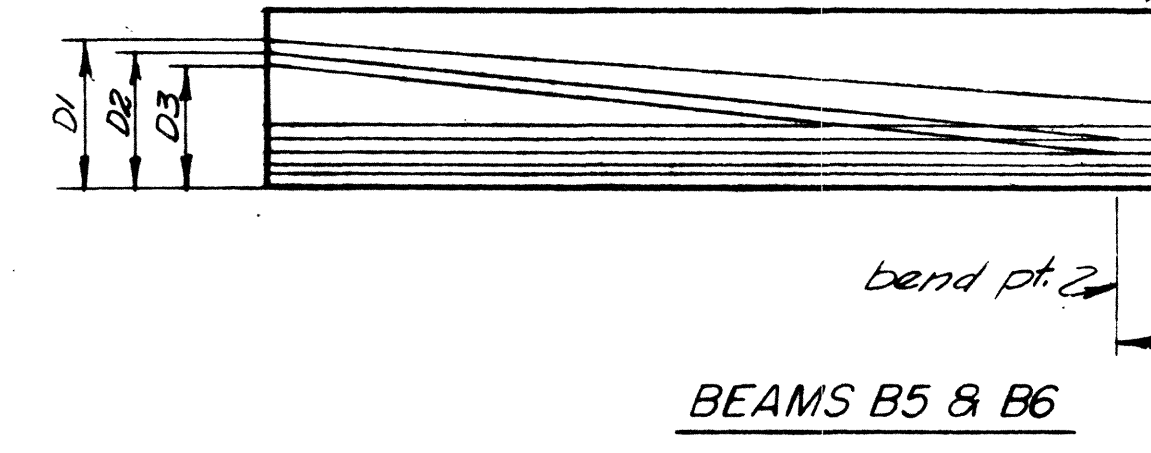


Beam	φ No. strands in layer	Total No. 1/16" strands	Prestress Force #	D1	D2	Dimensions	Beams Req'd.
B5	9/6 9/6 6/3 4/3 2/2	38	715,000#	40	36	4'-0" 12'-0"	1
B6	9/6 9/6 6/3 4/3 2/2	38	696,000#	40	36	4'-0" 12'-0"	1
B7	9/6 9/6 6/3 4/3 2/2	37	699,000#	40	36	4'-0" 12'-0"	1
B8	9/6 9/6 6/3 4/3 2/2	36	680,000#	40	36	4'-0" 12'-0"	1
B9	9/6 9/6 6/3 4/3 2/2	34	642,000#	40	36	4'-0" 12'-0"	1

\* Total Initial Prestress Force # = Lbs.


**PRETENSION BEAM DATA**

φ straight ▽ draped

**ELEVATION OF PRESTRESSED BEAMS - SPAN 2**

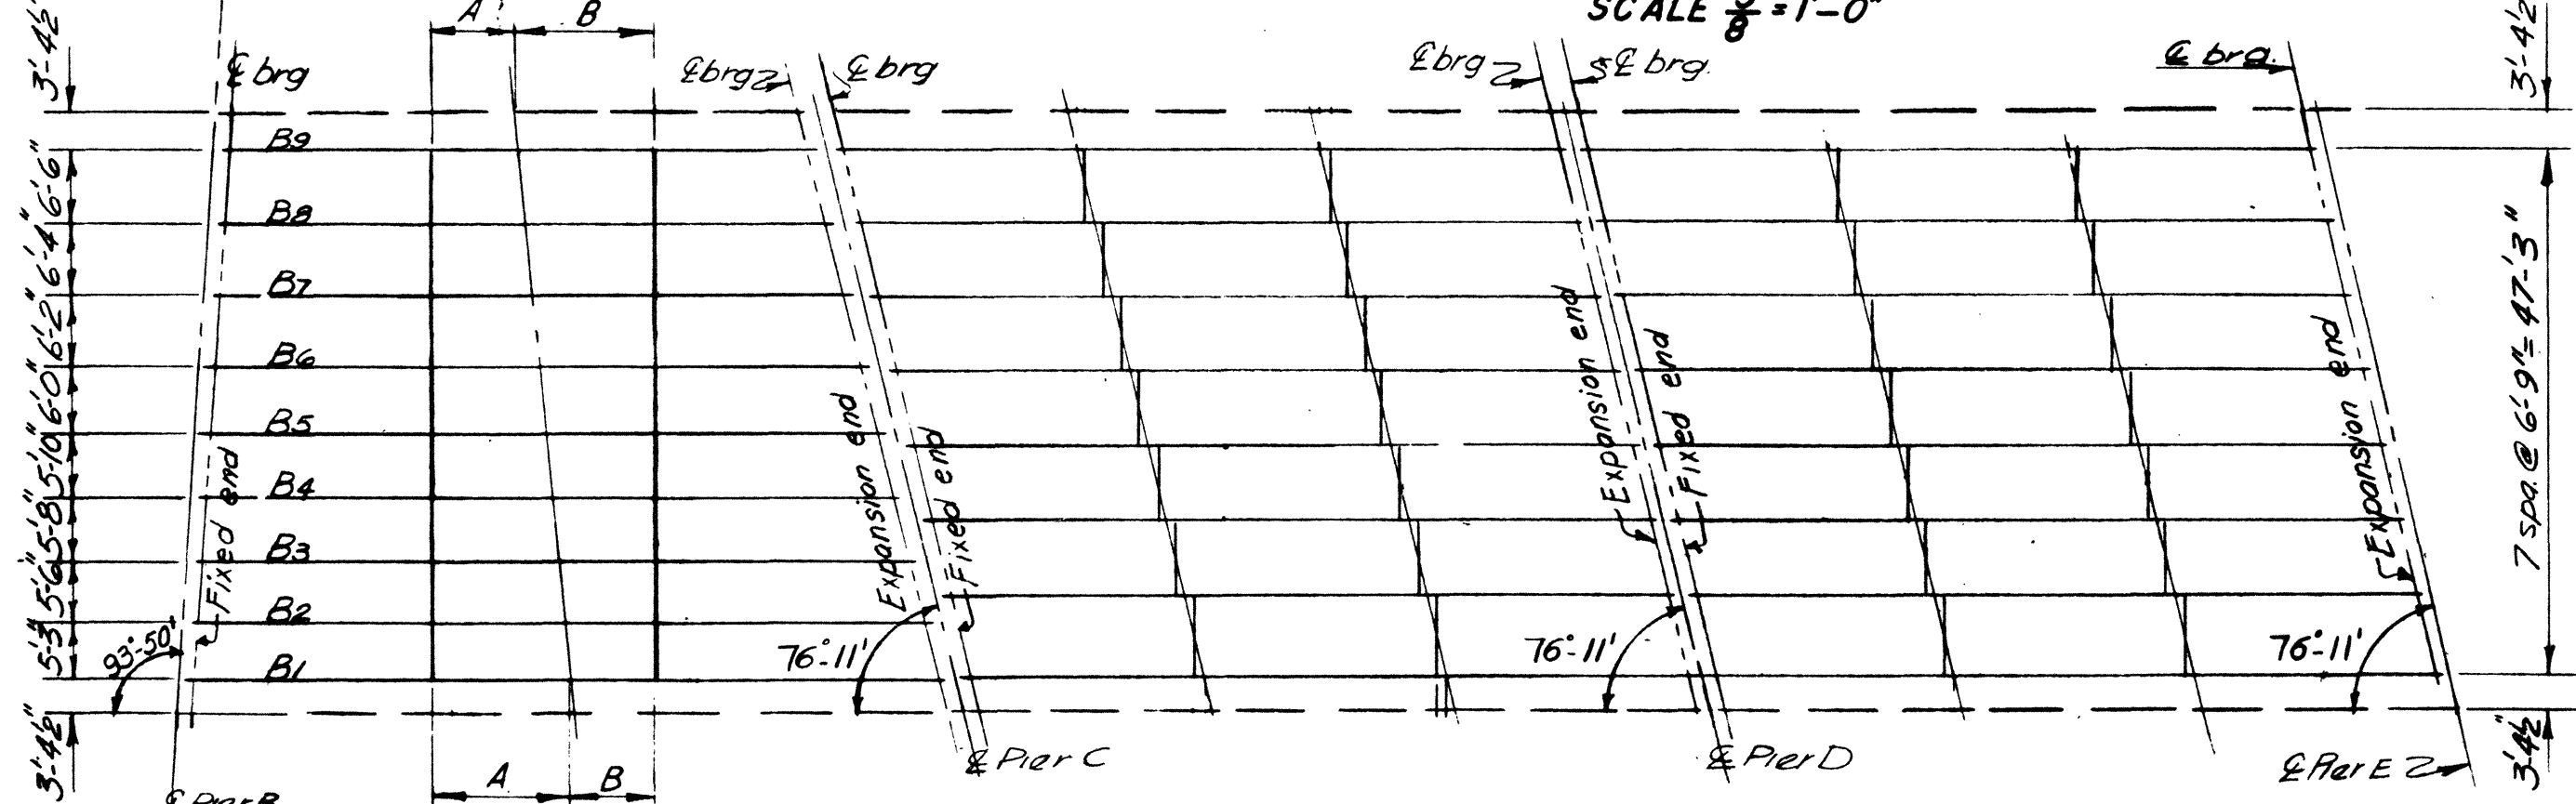

**FRAMING PLAN**

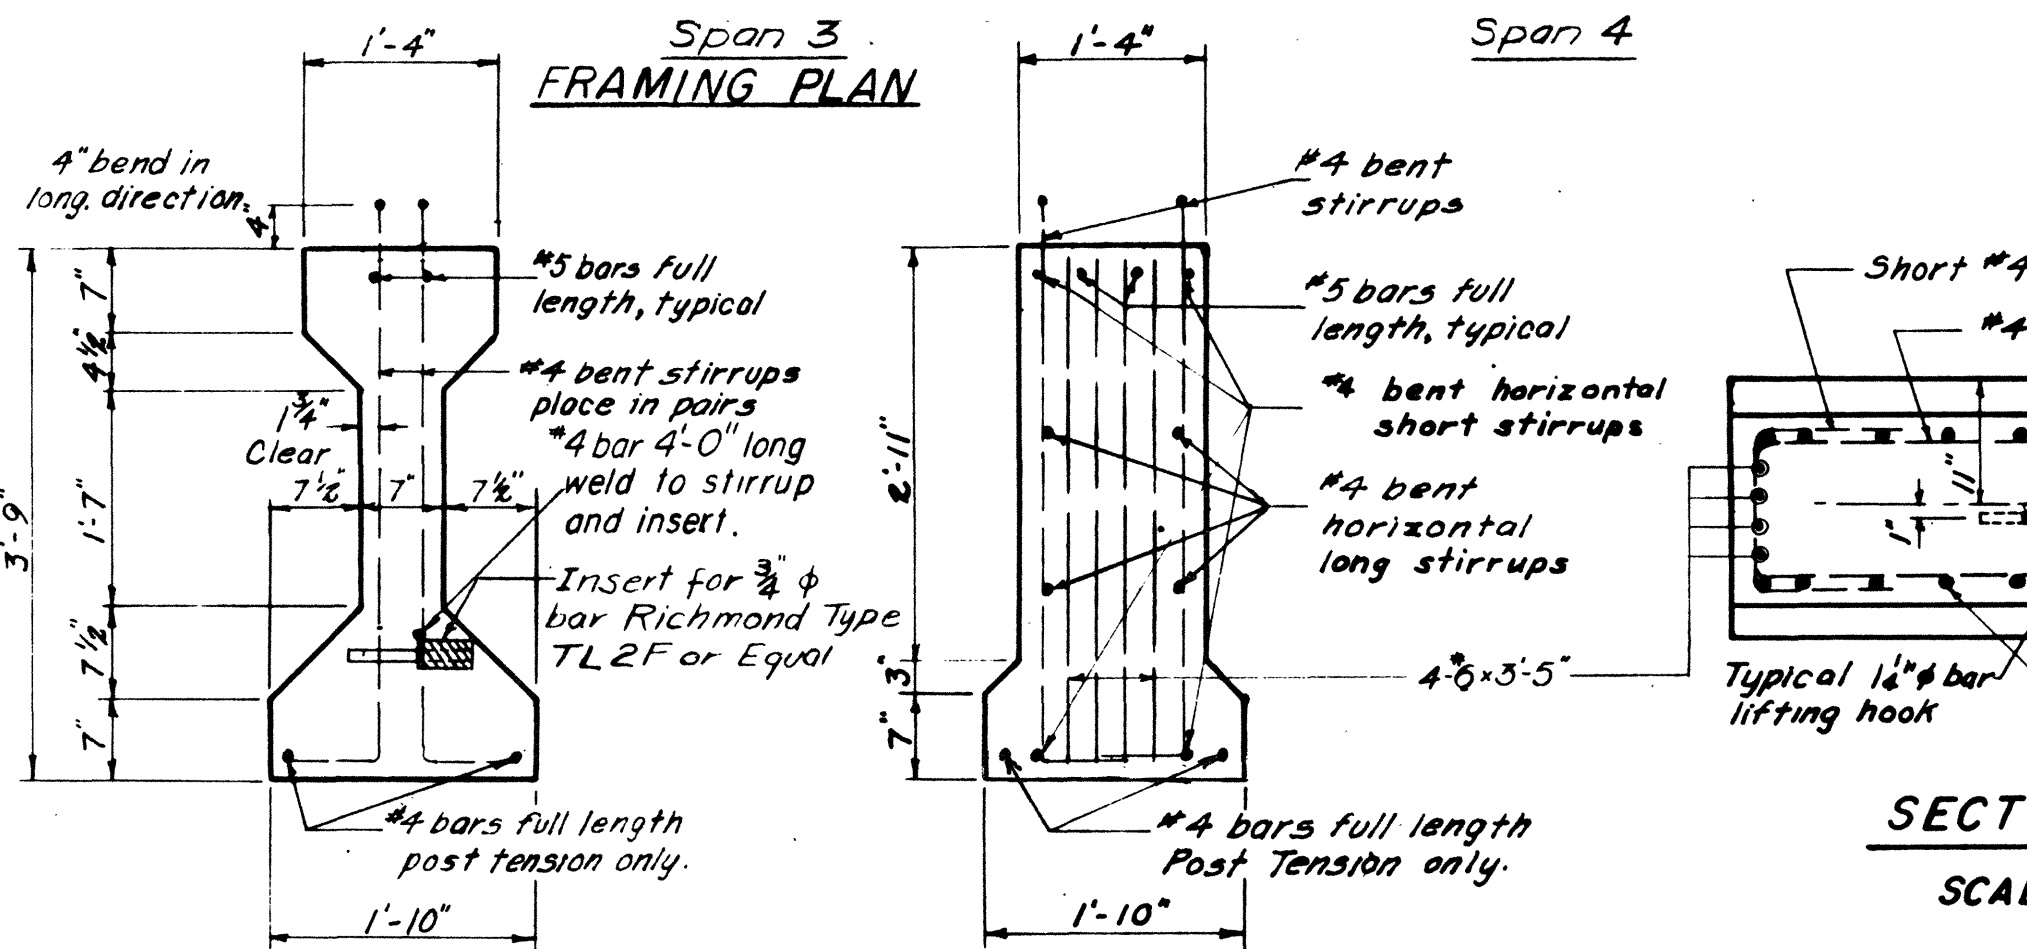

**TYPICAL SECTION**  
SCALE 3/4" = 1'-0"

**SECTION (B) (B)**  
SCALE 3/4" = 1'-0"

Beam	Distance from Brg. in feet	Bending Mom. (ft. kips)	Shear @ brg. KIPS	Beam	Distance from Brg. in feet	Bending Mom. (ft. kips)	Shear @ brg. KIPS
B5	Dead Load (Beam)	72 287 336 349	20.2	B7	Dead Load (Beam)	67 257 302 311	19.1
B5	S.D.L.*	68 271 317 329	18.4	B7	S.D.L.*	68 258 304 313	18.5
B5	Live Load	188 683 784 794	50.7	B7	Live Load	193 675 770 779	52.9
B6	Dead Load (Beam)	69 276 321 330	19.6	B8	Dead Load (Beam)	65 246 286 293	18.3
B6	S.D.L.*	68 260 302 321	18.5	B8	S.D.L.*	68 255 297 304	18.5
B6	Live Load	187 686 779 787	51.6	B8	Live Load	190 674 764 768	54.0
				B9	Dead Load (Beam)	63 235 271 274	17.9
				B9	S.D.L.*	67 248 285 290	18.2
				B9	Live Load	192 669 745 746	54.3


**TABLE OF BENDING MOMENTS & SHEARS**

\* Superimposed dead load, includes slab, diaphragm, etc.  
\*\* Live load includes future wearing surface of 20 lbs/sq ft & impact.

**ESTIMATED QUANTITIES - 1 BEAM**

ITEM	UNIT	BEAM B5	BEAM B6	BEAM B7	BEAM B8	BEAM B9
Precast Concrete	Cu. Yd.	10.5	10.3	10.0	9.7	9.4
Mild Reinforcing Steel	Lbs.	850	840	820	790	780
Prestress Steel 1/16" dia. strands	Lin. Ft.	2,710	2,640	2,490	2,370	2,160


**SLOT DETAIL**

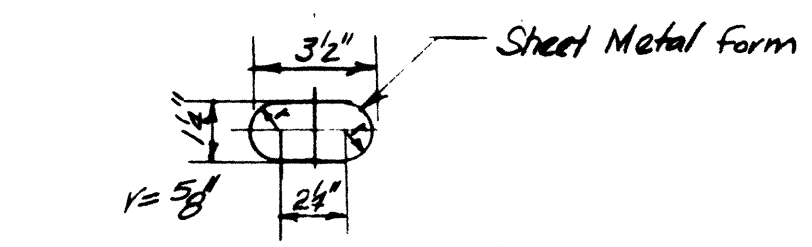

**GENERAL NOTES**

- The Contractor has the option of furnishing pretensioned, post-tensioned, or a combination beam. See the specifications.
- SPECIFICATIONS are the STANDARD ROAD AND BRIDGE SPECIFICATIONS OF THE TENNESSEE DEPARTMENT OF HIGHWAYS AND PUBLIC WORKS.
- LOADING: H20-S16-44 (Modified for Military Loading)
- REINFORCING STEEL: See specifications.
- FORMS & FINISH: See specifications
- All reinforcing steel, prestressing strands, lifting hooks, inserts, sleeves, or other items cast into the beam and all preformed bearing pads and 1" φ x 1'-6" Anchor Rods will be included for payment purposes in the Unit Price each under Furnish and Place Prestressed Concrete Beams (Type III)
- The Contractor shall provide a 3/8" dia. x 1'-6" long dowel with threaded end for each insert. The cost will be included in the unit price for FURNISH & PLACE PRESTRESSED CONCRETE BEAMS, TYPE III, LENGTH.
- BEARINGS for both ends of Type III beams consist only of a 8" x 22" x 1" pref. brg. pad & a 1" φ x 1'-6" anchor rod.
- Prestressing forces shown do not include losses due to friction, jacking losses or relaxation of the anchorage. See the specifications.
- After concrete has attained initial set, scrub top surface of beam to remove laitance and leave a rough finish.

**POST-TENSION DETAILS**

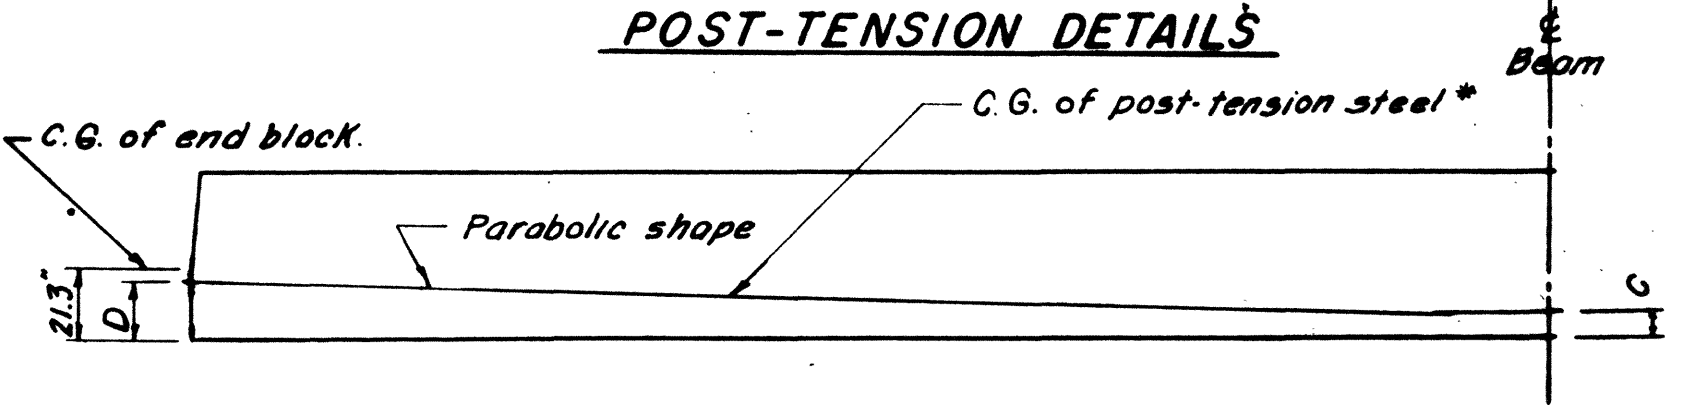

**POST-TENSION BEAM DATA**

\* The C.G. of the post-tension steel may vary from the position shown above. The C.G. must approximate a parabola and all required design stress conditions must be satisfied. See the specifications.

Beam	Dimension	Final Prestress force	Initial Prestress force
B5	5'3" 1'-3"	558,000#	687,000#
B6	5'3" 1'-3"	544,000#	670,000#
B7	5'4" 1'-3"	546,000#	673,000#
B8	5'3" 1'-3"	531,000#	655,000#
B9	5' 1'-3"	501,000#	618,000#

# = Lbs.

**BILL OF MATERIALS**

Item	Unit	Quantity
B5 Prestressed concrete beams Type III (Length 70'-2")	each	1
B6 Prestressed concrete beam Type III (Length 68'-3 1/2")	each	1
B7 Prestressed concrete beam Type III (Length 66'-4 3/8")	each	1
B8 Prestressed concrete beam Type III (Length 64'-4 1/2")	each	1
B9 Prestressed concrete beam Type III (Length 62'-4 1/4")	each	1

Bridge 15A

STATE OF TENNESSEE  
DEPARTMENT OF HIGHWAYS AND PUBLIC WORKS  
PROJECT 1-240-1 (17) SHELBY CO.  
MEMPHIS CIRCUMFERENTIAL INTERSTATE HIGHWAY  
SOUTHEAST SECTION  
HARLAND BARTHOLOMEW AND ASSOCIATES, ENGINEERS  
CLARK AND DAILY, ASSOCIATED ENGINEERS

**DIAPHRAGM LOCATION**

See framing plan.

**DIAPHRAGM LOCATION**

See framing plan.



PUB. ROAD DIV. NO.	STATE	PROJECT NO.	FISCAL YEAR	SHEET NO.	TOTAL SHEETS
3	TENNESSEE	1-240-1 (17) 13	1959	181	334
REVISION					
11-10-59					
REVISION					
12-18-59					
12-28-59					


NOTE: All handrail dimensions are given along the centerline of handrail posts.

**LEGEND**


- ⊠ Lighting Standard
- Pull Box
- End Block
- Expansion Joint in rail (See std. G-10-100)
- Post

**LIGHTING NOTES**

- PULLBOXES** shall be Thomas & Betts flanged cast iron junction boxes, size 8"x8"x6" Cat. No. 10904, or equal. They shall be made watertight with cover, gasket and Ever-dur hex head cap screws. Boxes shall be drilled and tapped for conduit sizes called out on the plans.
- CONDUIT** shall be galvanized rigid steel, sizes as shown. Conduit shall be secured to the structure with such materials as to prevent bi-metallic action. Connections to pull boxes shall be reinforced with bushing and locknut. Hangers and spacing shall be approved by the engineer.
- GROUNDING:** All lighting standards shall be grounded by means of #6 weatherproof ground wire attached at the upper end to one anchor bolt, extended down the face of closest abutment or pier, then attached at the lower end to a 3/4" φ x 8' ground rod. These items shall be furnished & installed under this contract.
- CONDULETS:** The contractor shall furnish condulets in addition to those called out on the plans as required to facilitate the wiring.

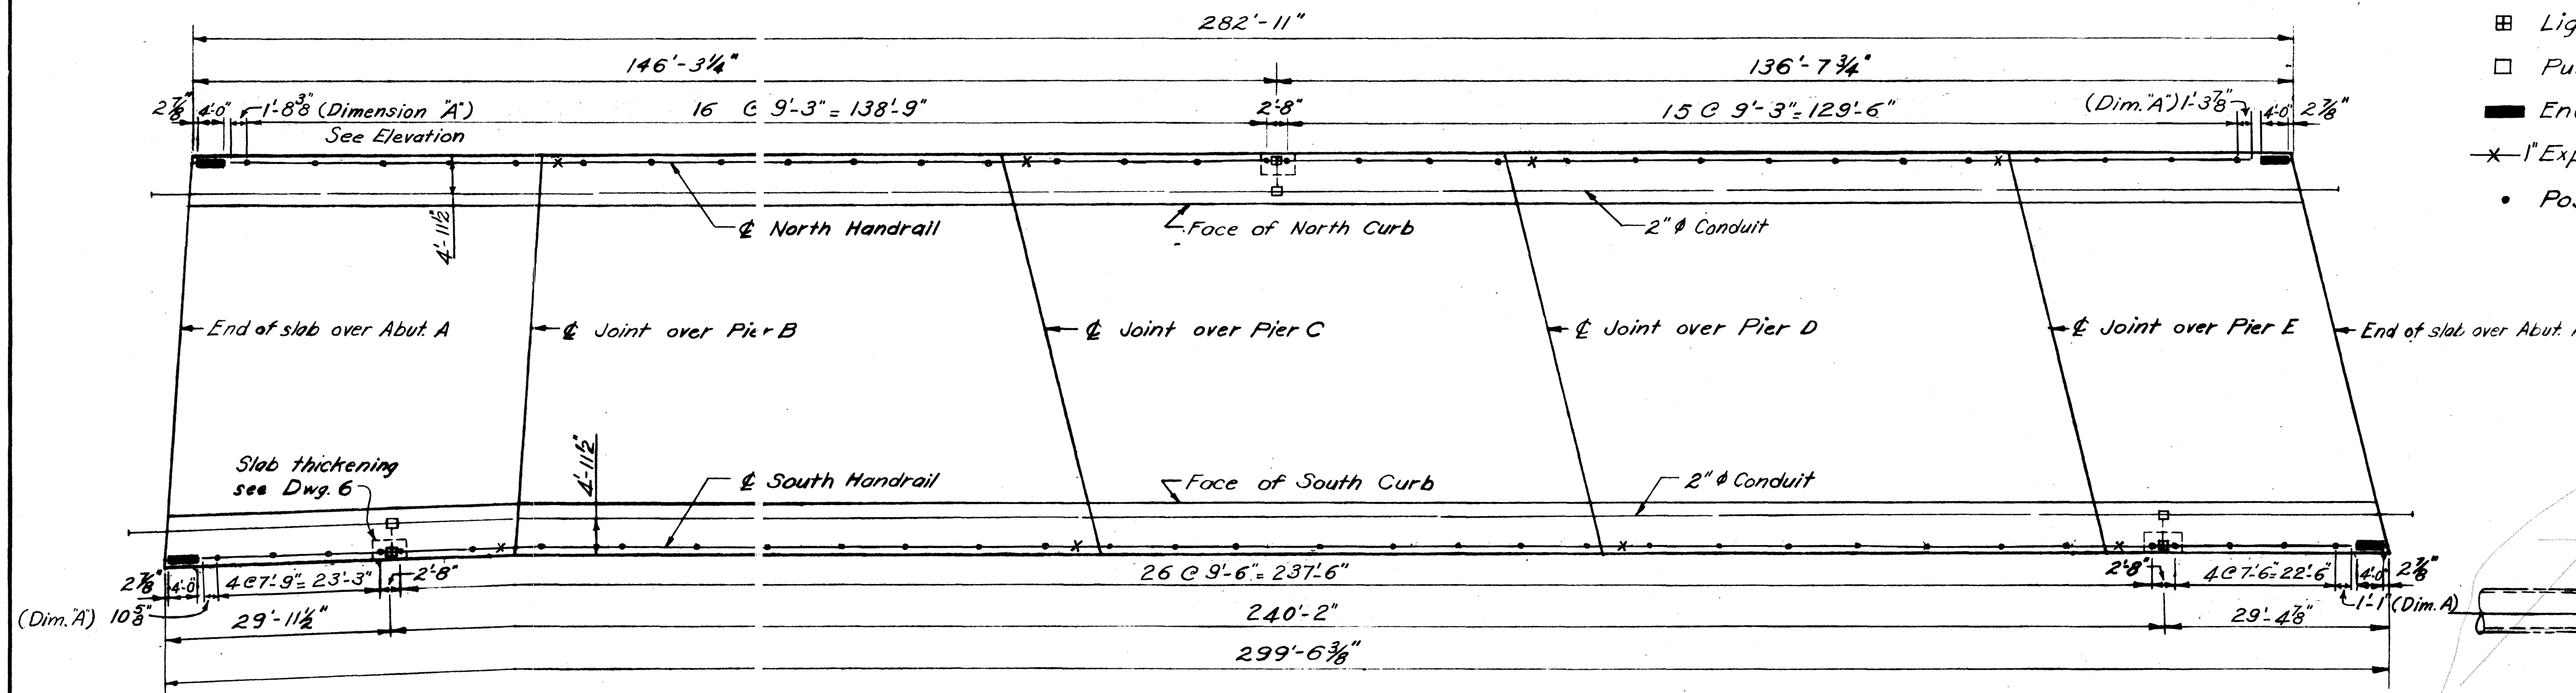

**PLAN OF HANDRAIL AND LIGHTING LAYOUT**

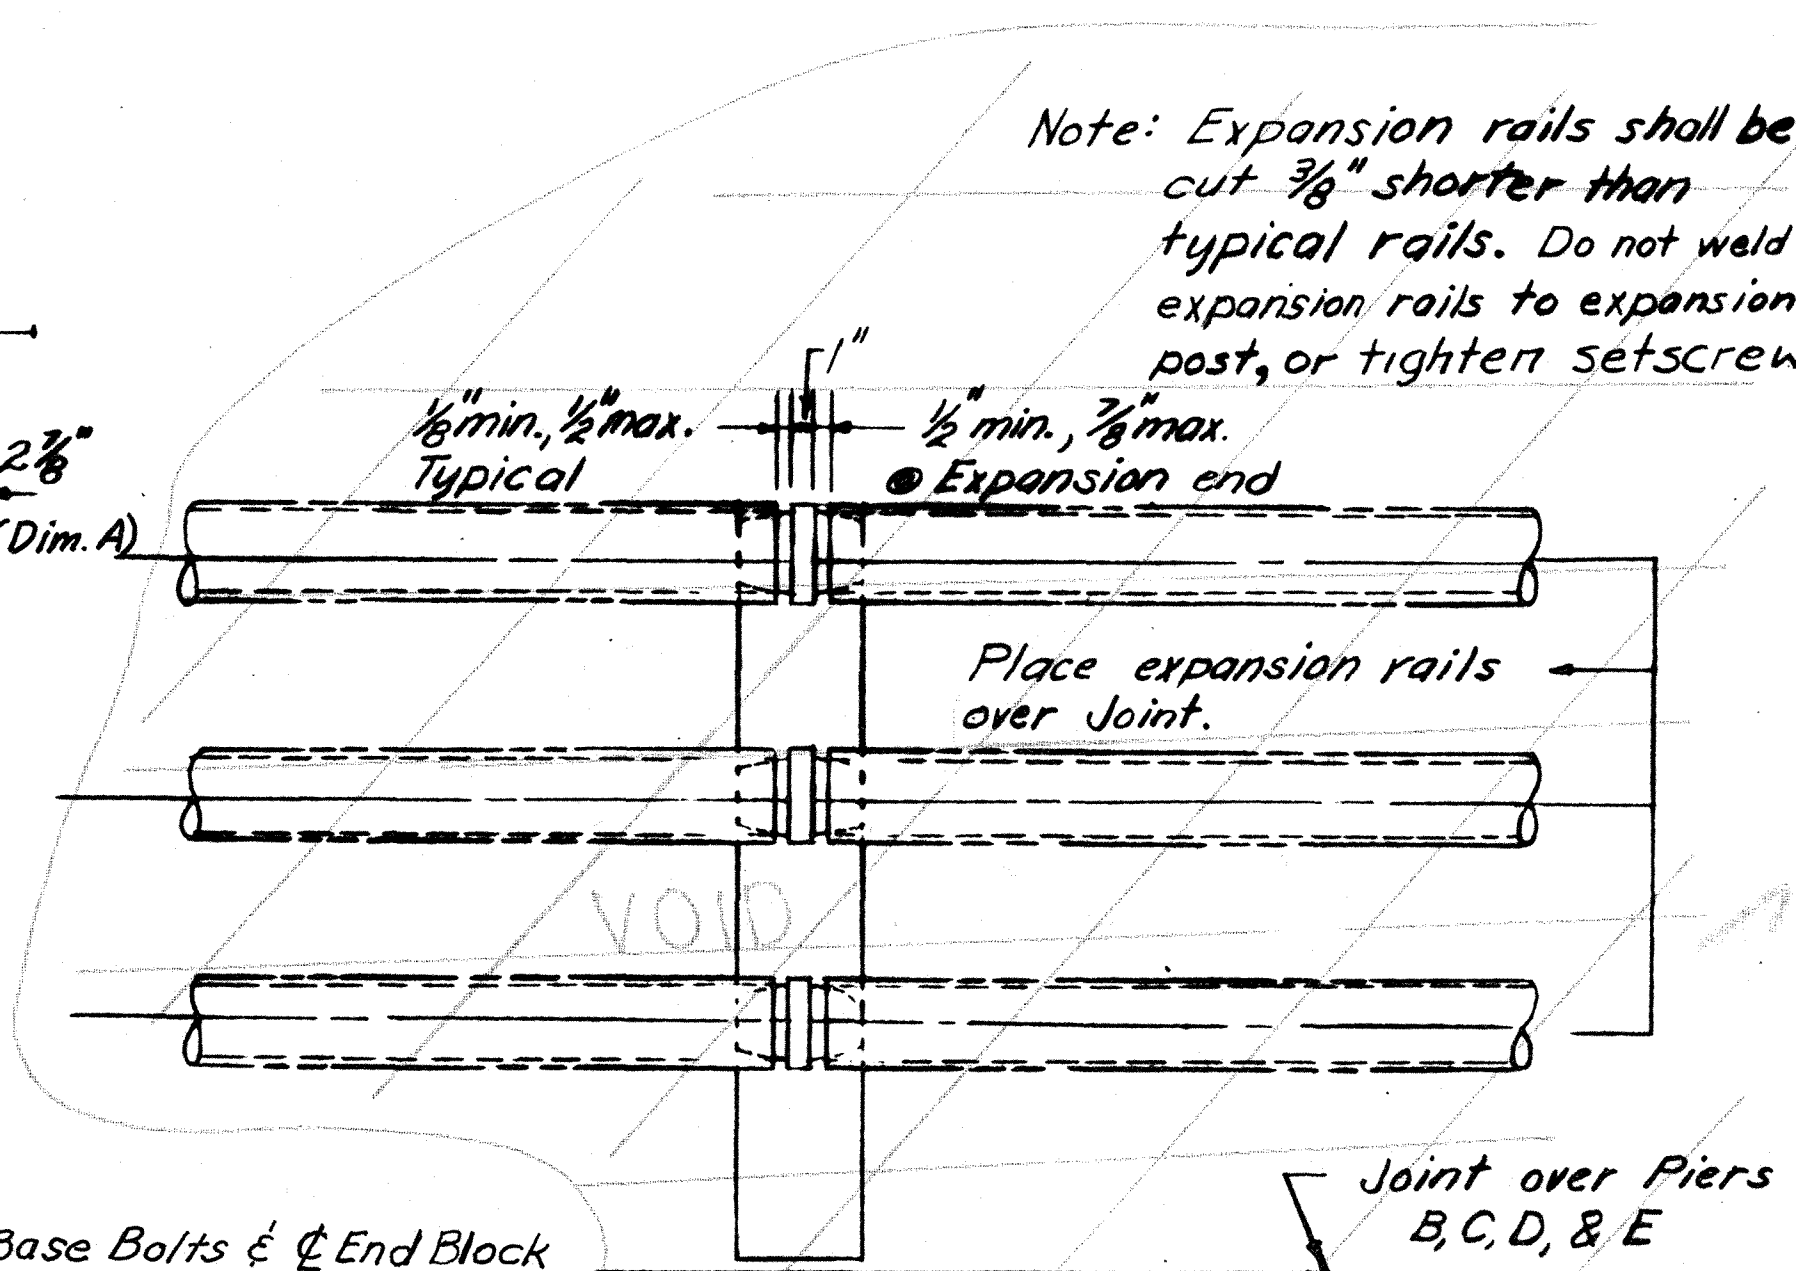

**DETAIL AT EXPANSION POST**

**HANDRAIL NOTES**

- HANDRAIL:** For details of handrail see Tennessee Dept. of Highways and Public Works, Std. Dwg. G-10-100, Sht. No. 318.
- END BLOCK CASTING:** At the option of the Contractor, the end block casting as detailed may be fabricated as a weldment. Based on field measurements and tolerances the Contractor may choose to weld the pipe rails directly to the aluminum anchor plate and omit the lugs as shown on the detail.

**BILL OF MATERIAL\***

ITEM	UNIT	QUANTITY
LIGHT STANDARDS	EACH	3
RECESSED FIXTURES	EACH	-
PULL BOXES	EACH	3
TEMPORARY FILLER (light std.)	EACH	3
FLEXIBLE CONDUIT	LIN. FT.	60
CONDUIT 1" φ	LIN. FT.	18
CONDUIT 2" φ	LIN. FT.	568

\* The Contractor shall furnish and install in addition to the above bill of materials, such incidental items as grounding wire, conduit caps, conduit hangers, etc., with no increase in compensation above the contract lump sum bid for FURNISH & INSTALL LIGHT STANDARDS, CONDUITS, PULL BOXES, & AUXILIARY EQUIPMENT. See the special provisions.


**SUMMARY OF QUANTITIES**

ITEM	UNIT	QUANTITY
3- RAIL STEEL HANDRAIL	Lin. Ft.	574
LIGHTING SYSTEM	Lump sum	1

NOTE: The Cost Per Lin. Ft. Of Rail Shall Include The Furnishing & Placing Of Bolts & Anchorages, All Galv. Parts And All Other Incidentals Necessary To Complete The Rail.


Bridge 15 A

STATE OF TENNESSEE	
DEPARTMENT OF HIGHWAYS AND PUBLIC WORKS	
PROJECT 1-240-1 (17) 13 SHELBY CO.	
MEMPHIS CIRCUMFERENTIAL INTERSTATE HIGHWAY	
SOUTHEAST SECTION	
HARLAND BARTHOLOMEW AND ASSOCIATES ENGINEERS	
CLARK AND DAILY ASSOCIATED ENGINEERS	
W.B. POPLAR OVER I-240	
HANDRAIL AND LIGHTING DETAILS	
DATE	SCALE
12-11-58	As Noted
DRAWN BY	CHECKED BY
F.V.M.	W.G.
IN CHARGE	B.C.C.
JOB NO. 332	
H-11-26	

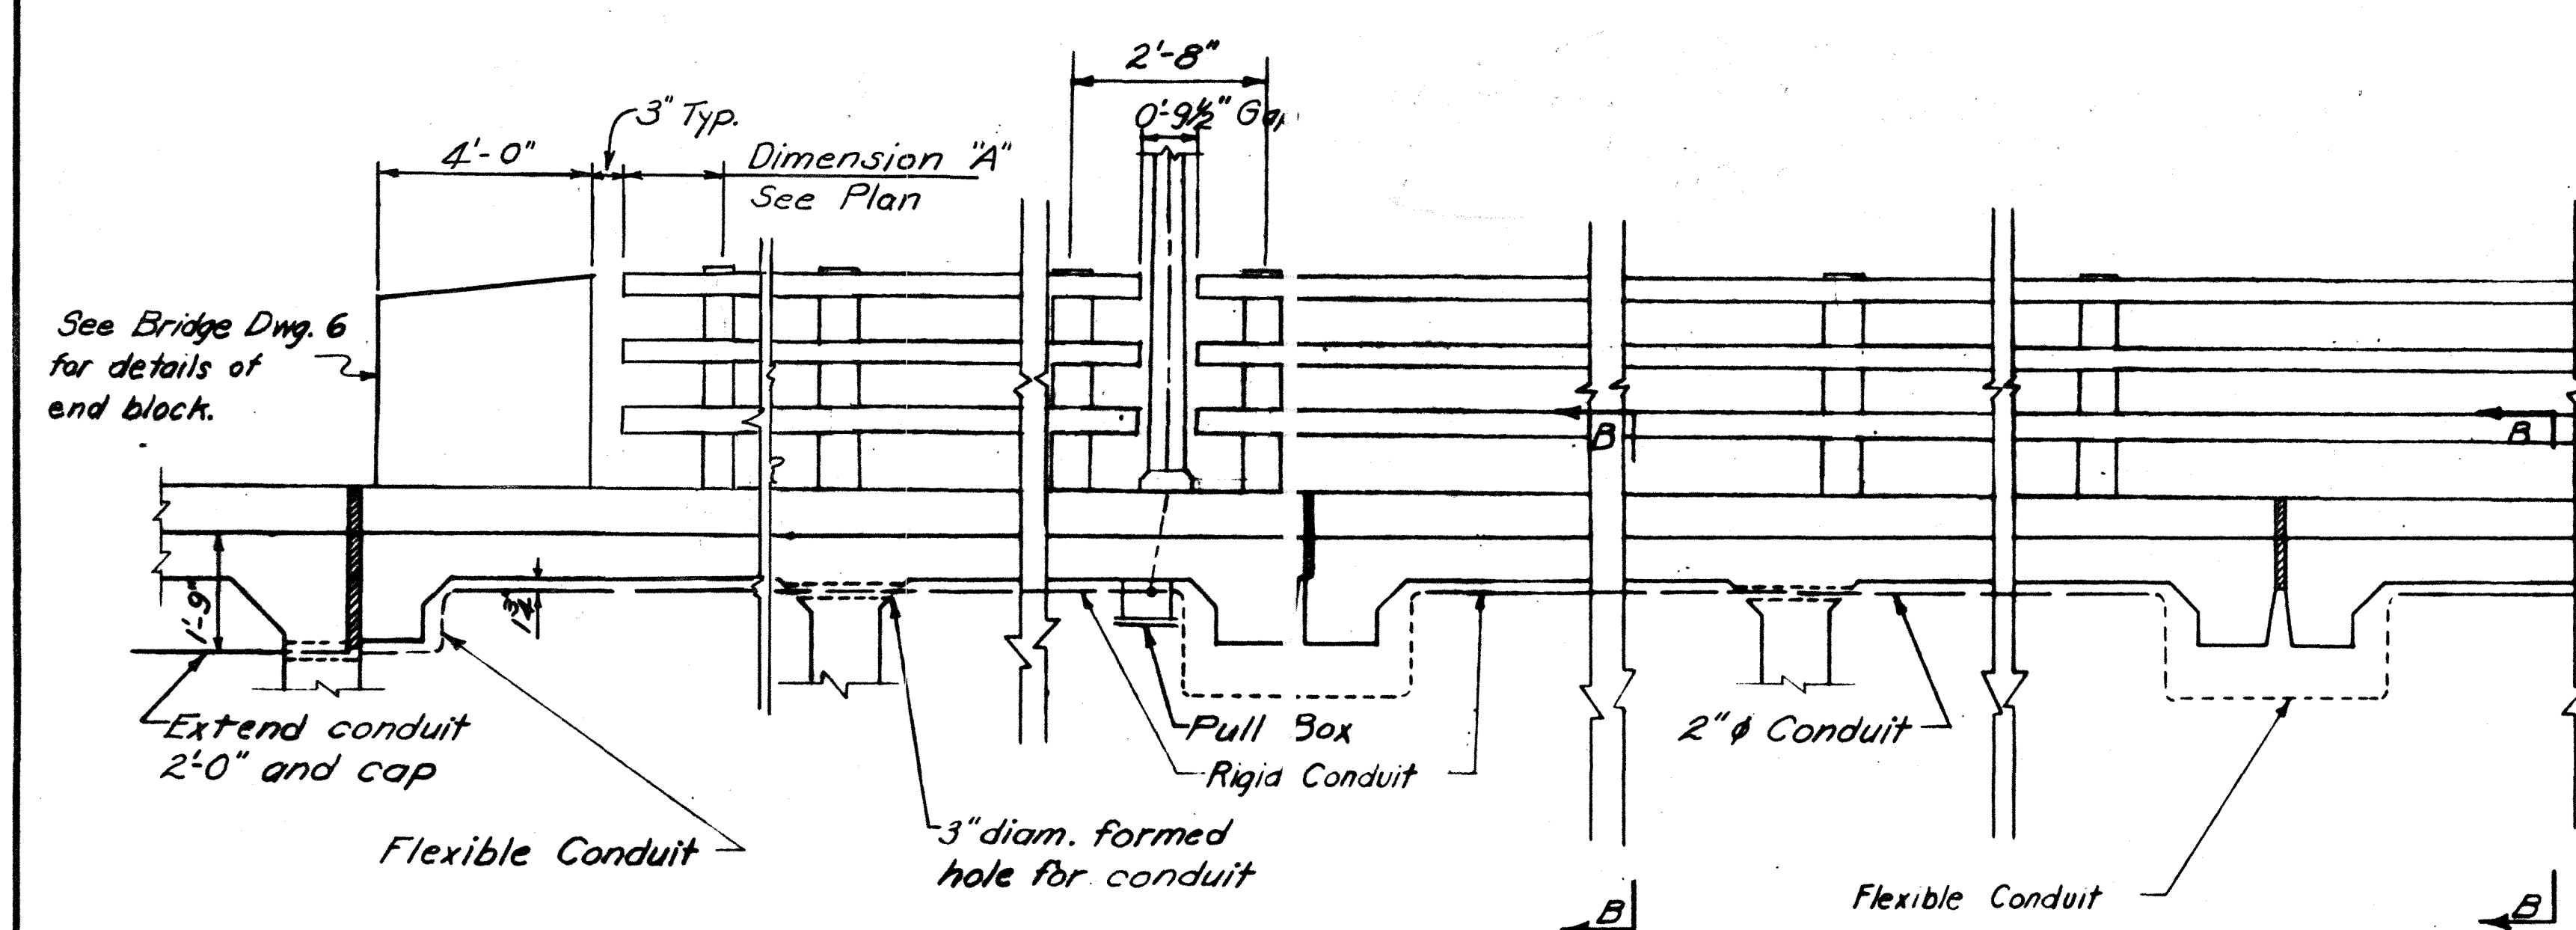


**LONGITUDINAL SECTION INSIDE FASCIA BEAM**

Identical wiring opposite side of Roadway

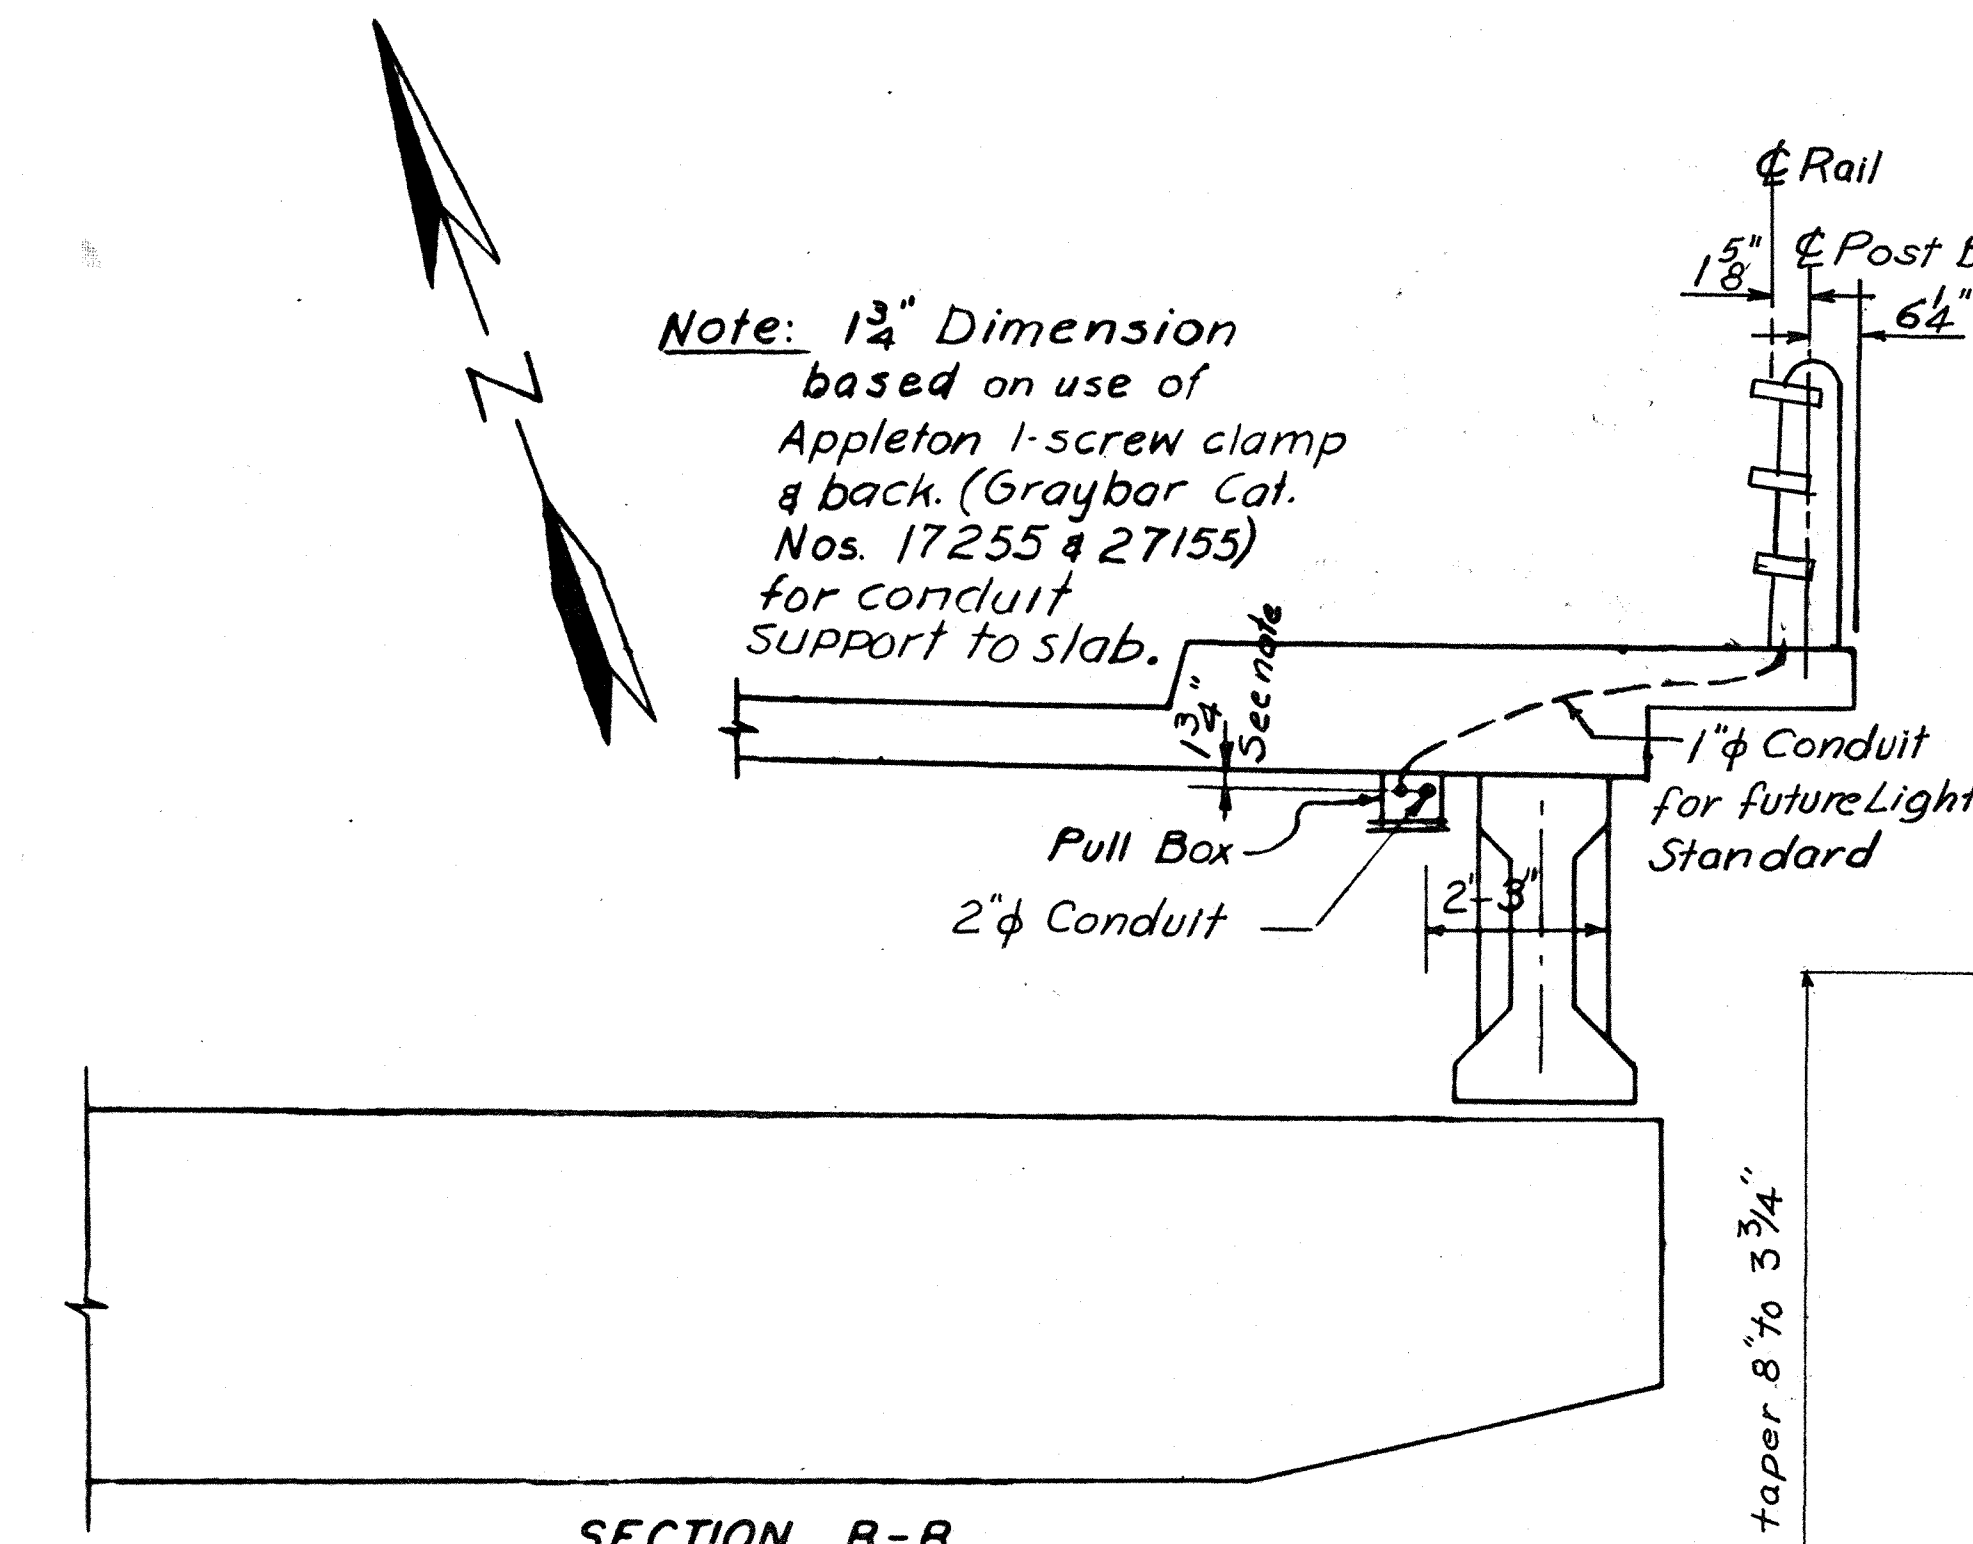


**SECTION B-B**

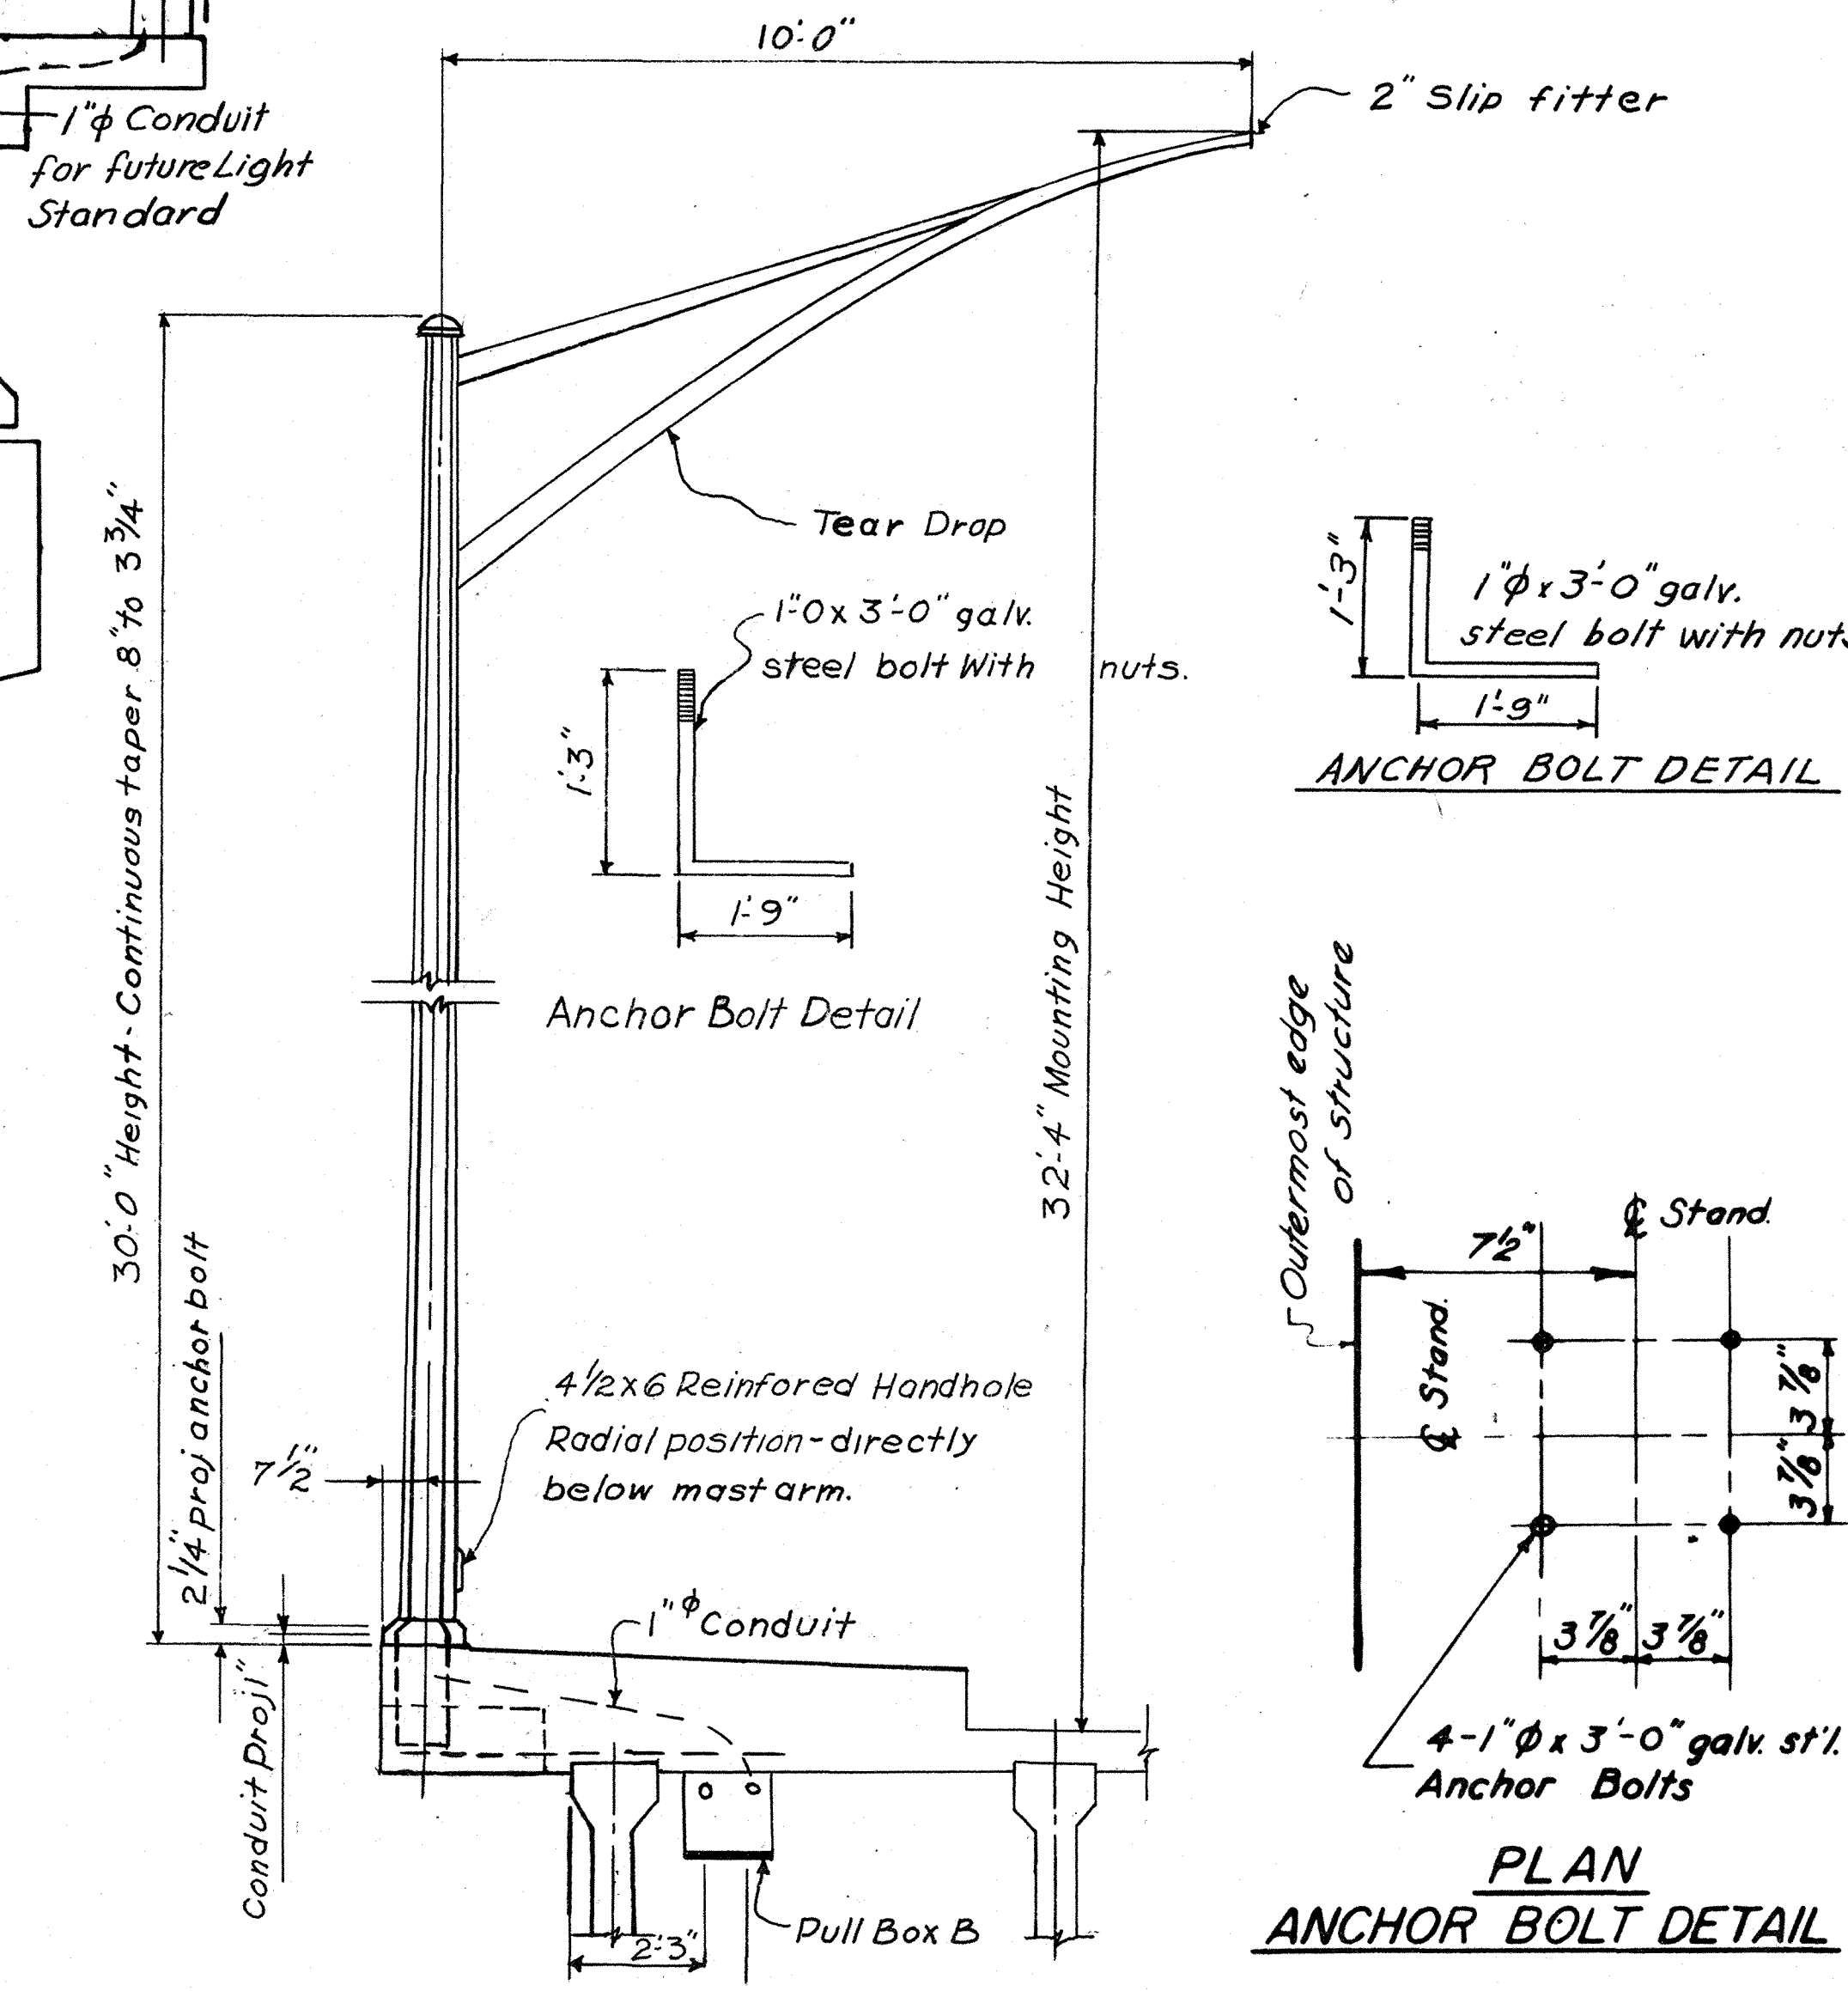

**ALUMINUM LIGHTING STANDARD**

Kerrigan Weldforged Lighting Standard Type 500K-30-10T, or equal.

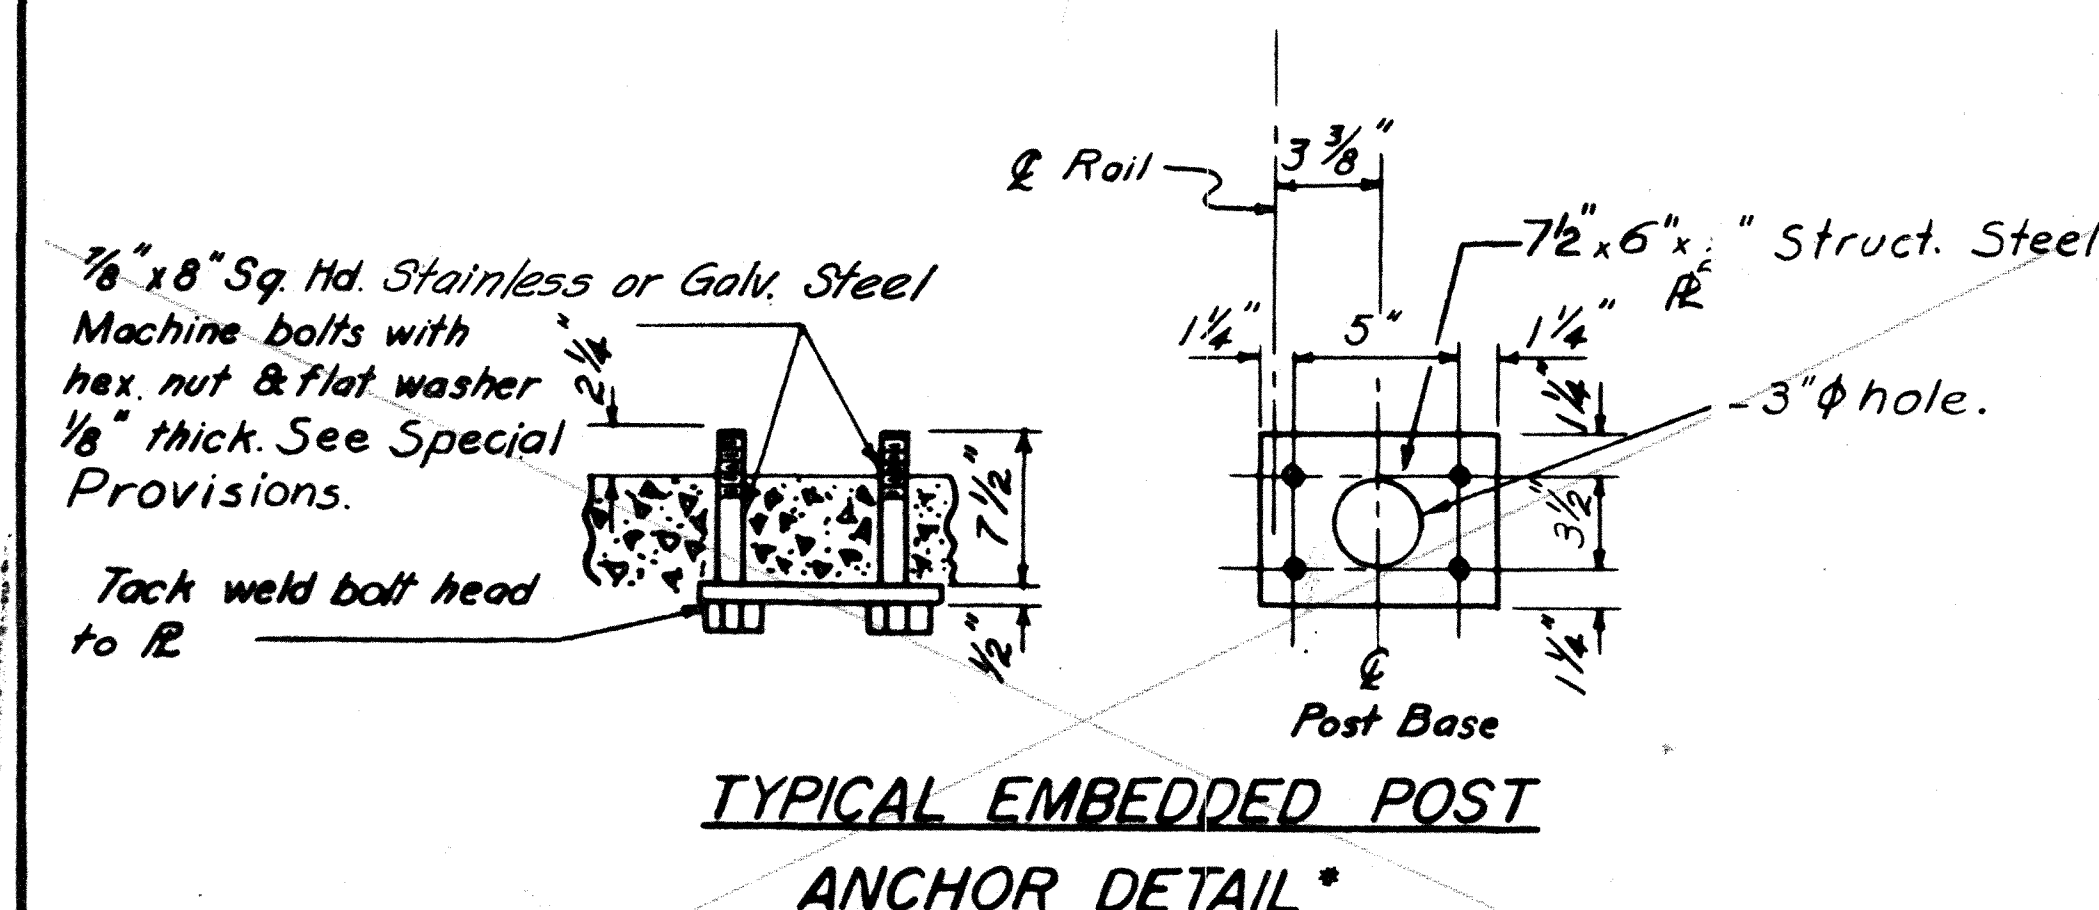

**TYPICAL EMBEDDED POST ANCHOR DETAIL\***

\* This detail supercedes the "Sketch Showing Anchorage of Aluminum Post in Curb" on State of Tennessee Dept. of Highways & Public Works, Stand. Dwg. F-10-47.