


TENNESSEE D.O.T.  
DESIGN DIVISION  
FILE NO.

TYPE	YEAR	PROJECT NO.	SHEET NO.
CONST.	2007	CM-098-3(14)	126
As built	2010		

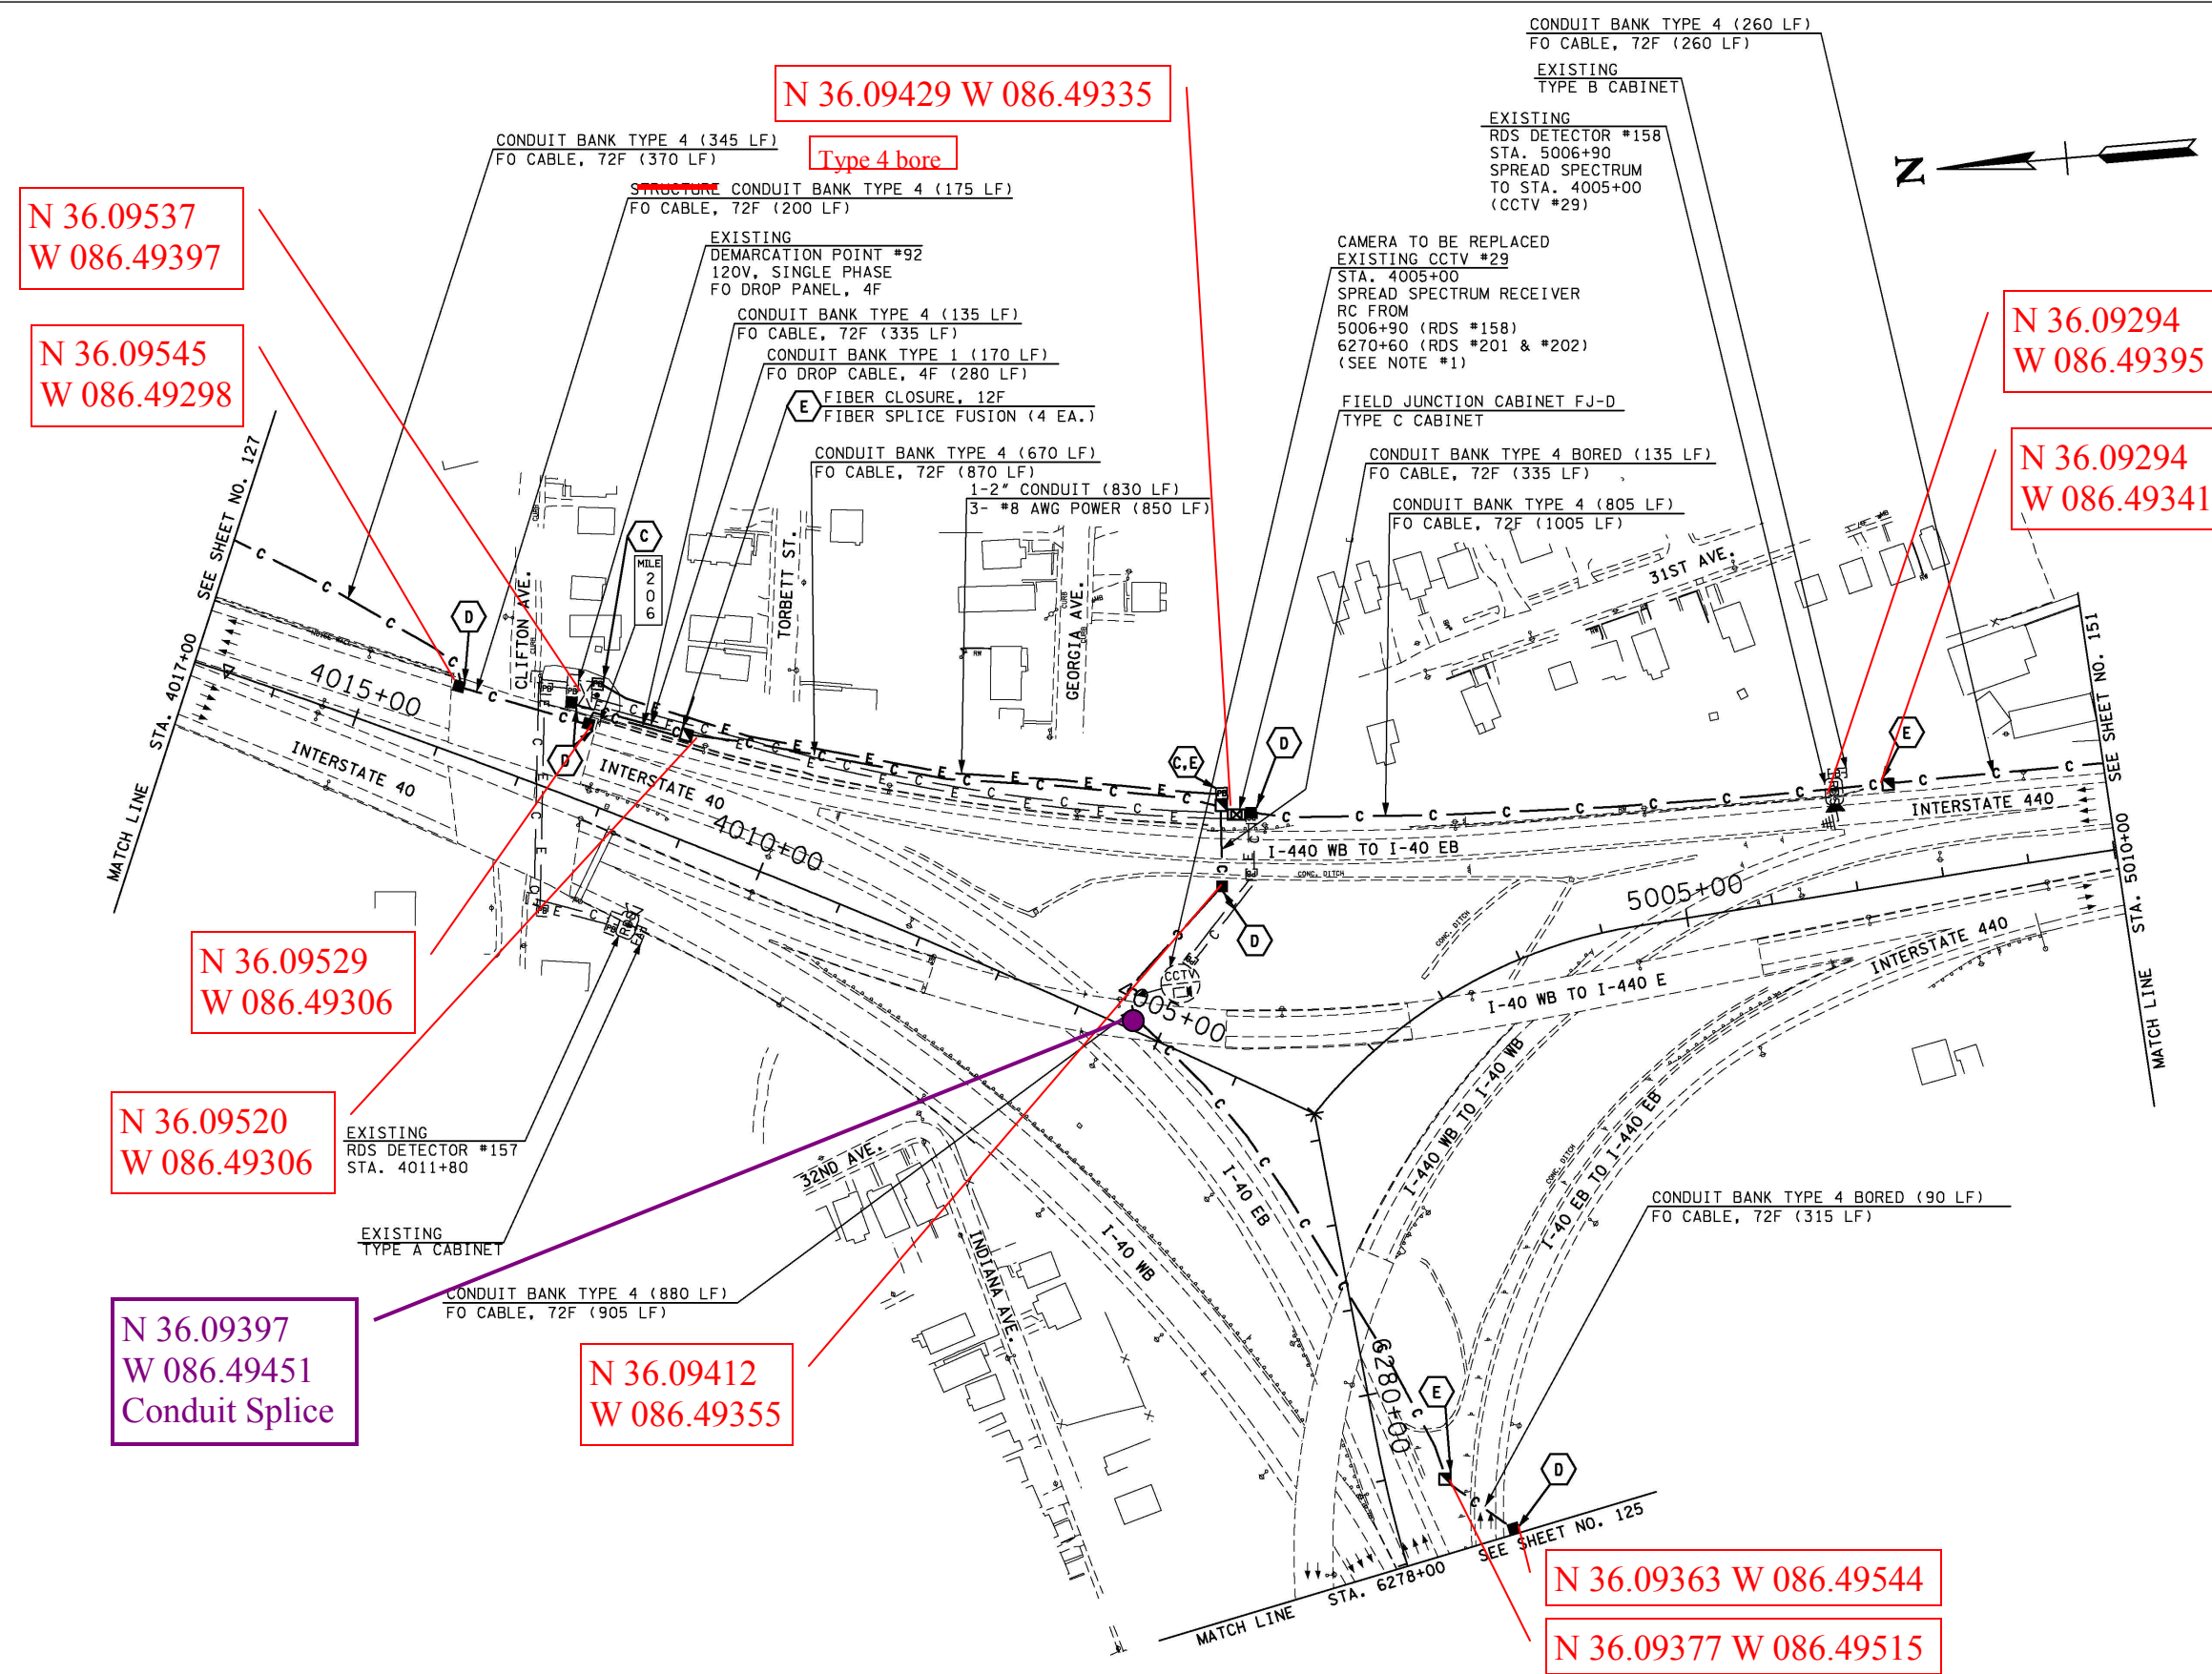

N 36.09537  
W 086.49397

N 36.09545  
W 086.49298

N 36.09429 W 086.49335

Type 4 bore

N 36.09294  
W 086.49395

N 36.09294  
W 086.49341

N 36.09529  
W 086.49306

N 36.09520  
W 086.49306

N 36.09397  
W 086.49451  
Conduit Splice

N 36.09412  
W 086.49355

N 36.09363 W 086.49544

N 36.09377 W 086.49515

NOTE: 1. CCTV #29 TO BE REPLACED WITH A NEW CCTV, BRACKETS, WIRING, AND CONTROL EQUIPMENT.

STATE OF TENNESSEE  
DEPARTMENT OF TRANSPORTATION  
ITS LAYOUT  
I-40/I-440  
STA. 6278+00 TO  
STA. 4017+00  
(I-40)  
TO STA. 5010+00  
(I-440)  
SCALE: 1"=100'

