


TYPE	YEAR	PROJECT NO.	SHEET NO.
CONST.	2007	CM-098-3(14)	159
As built	2010		

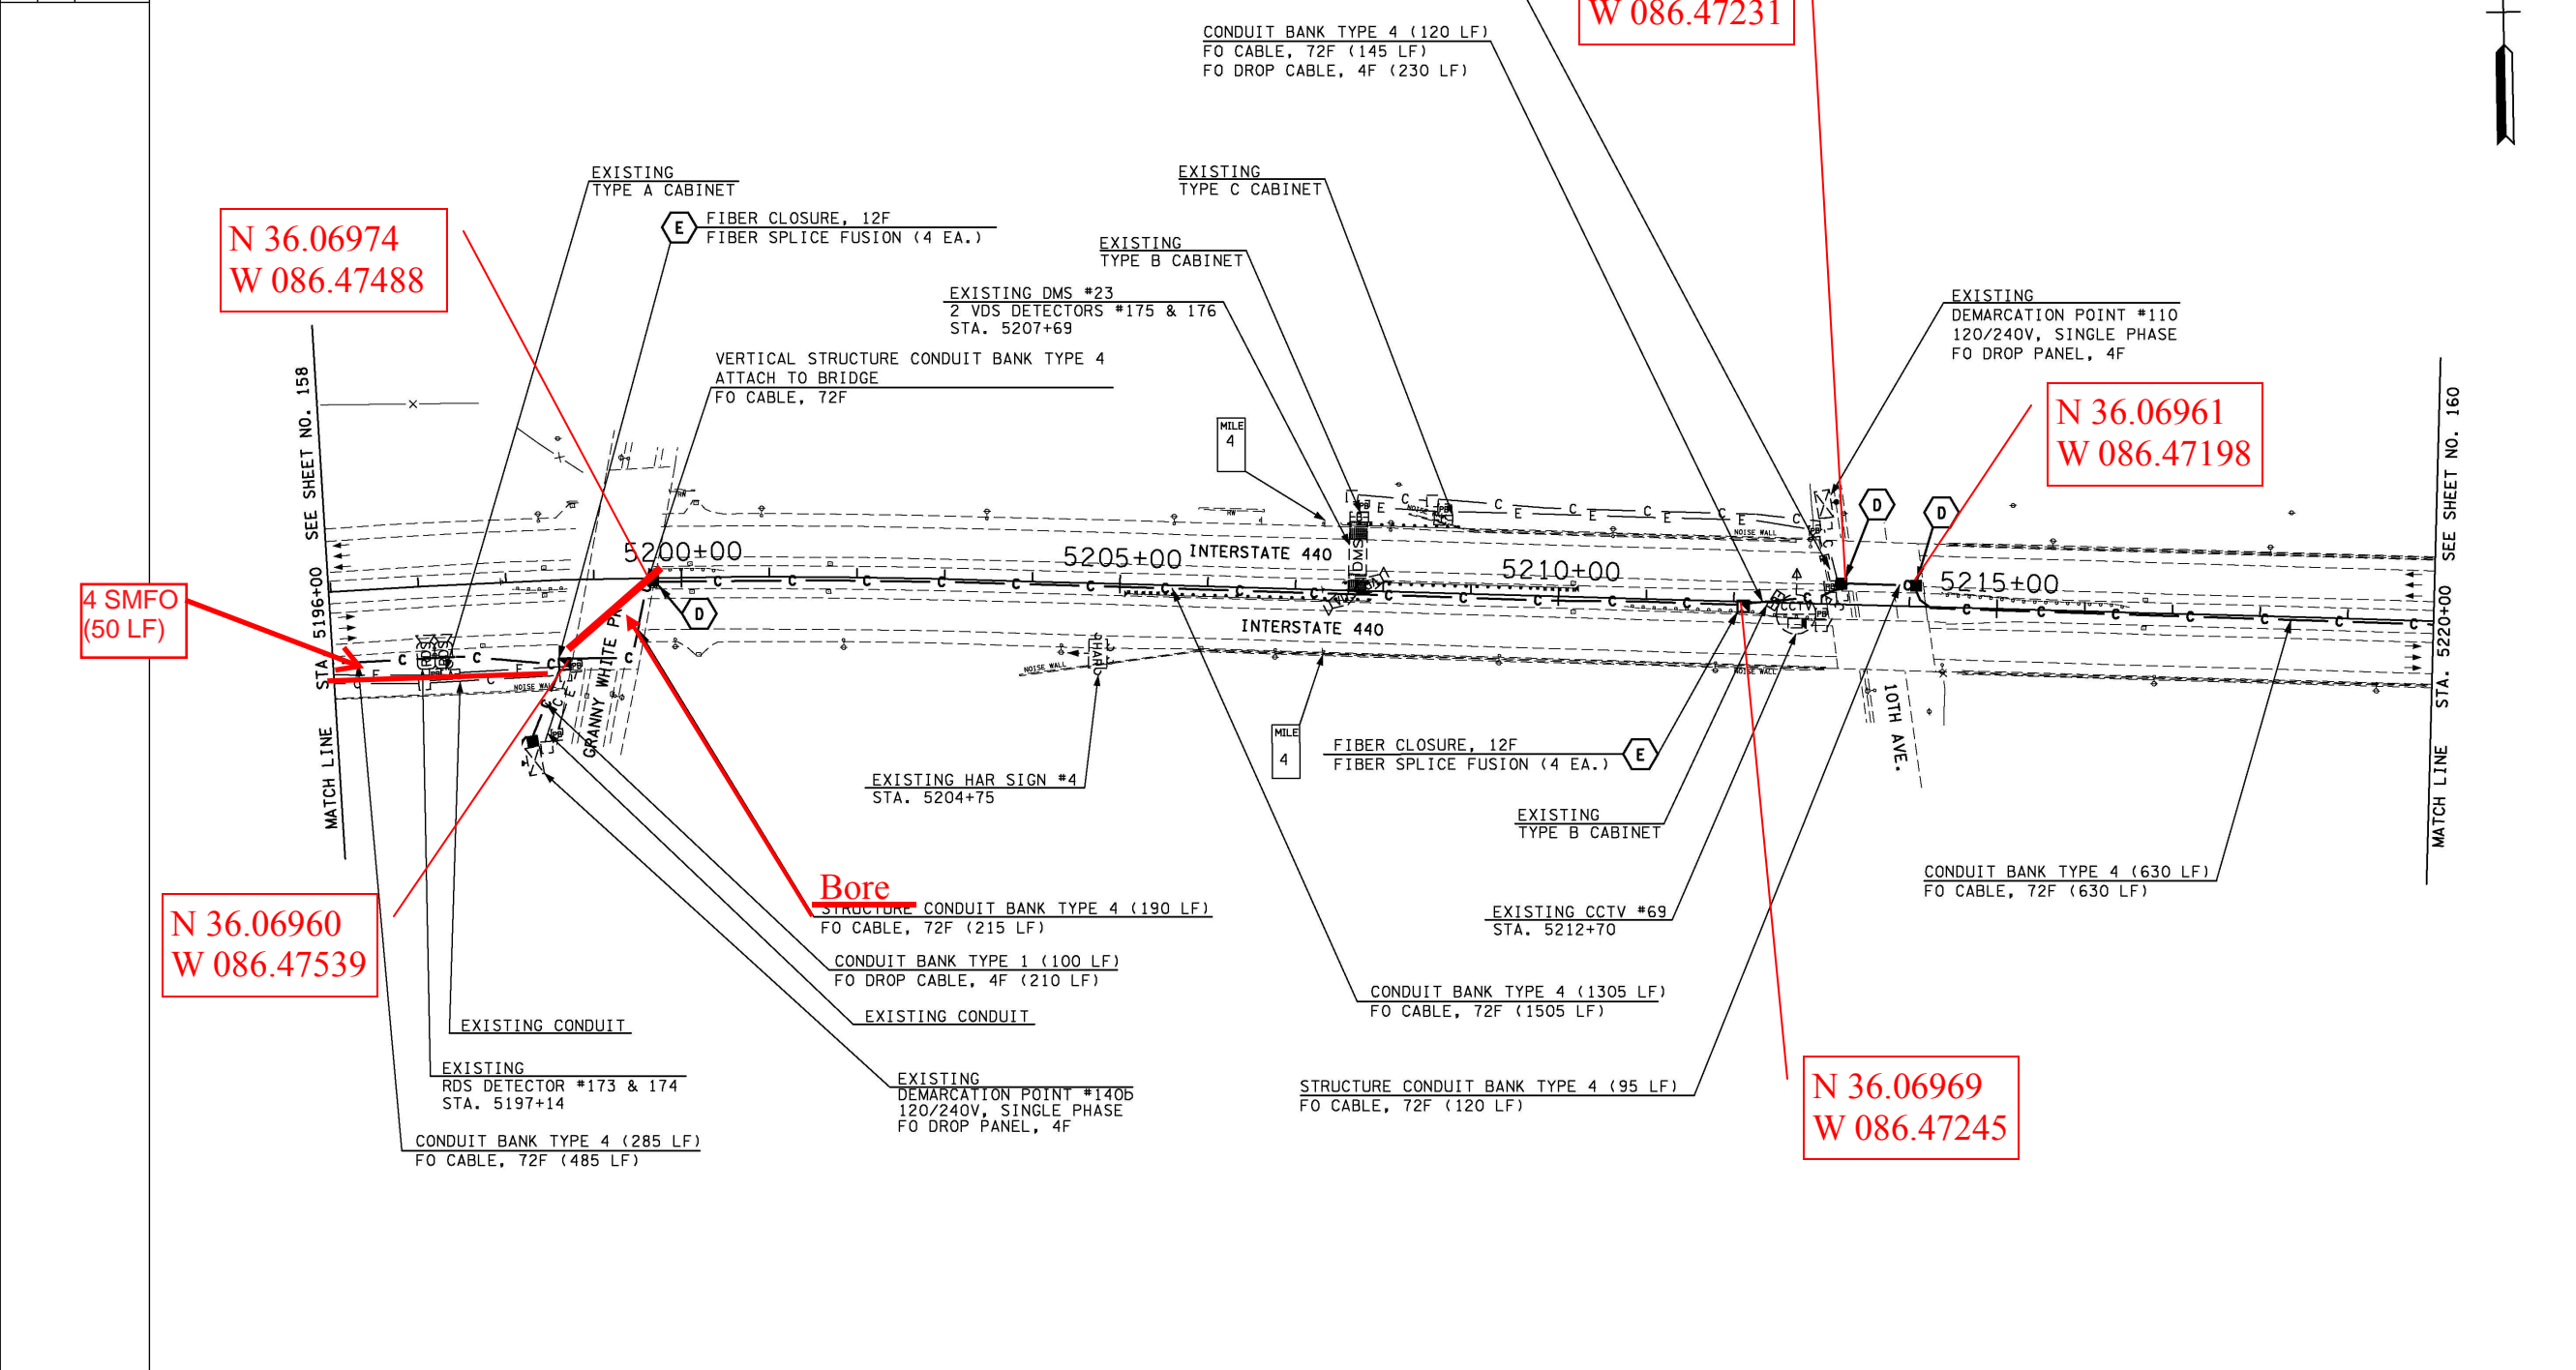

N 36.06974
W 086.47488

N 36.06965
W 086.47231

N 36.06961
W 086.47198

4 SMFO
(50 LF)

N 36.06960
W 086.47539

Bore
STRUCTURE CONDUIT BANK TYPE 4 (190 LF)
FO CABLE, 72F (215 LF)
CONDUIT BANK TYPE 1 (100 LF)
FO DROP CABLE, 4F (210 LF)

N 36.06969
W 086.47245

