
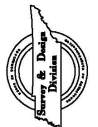
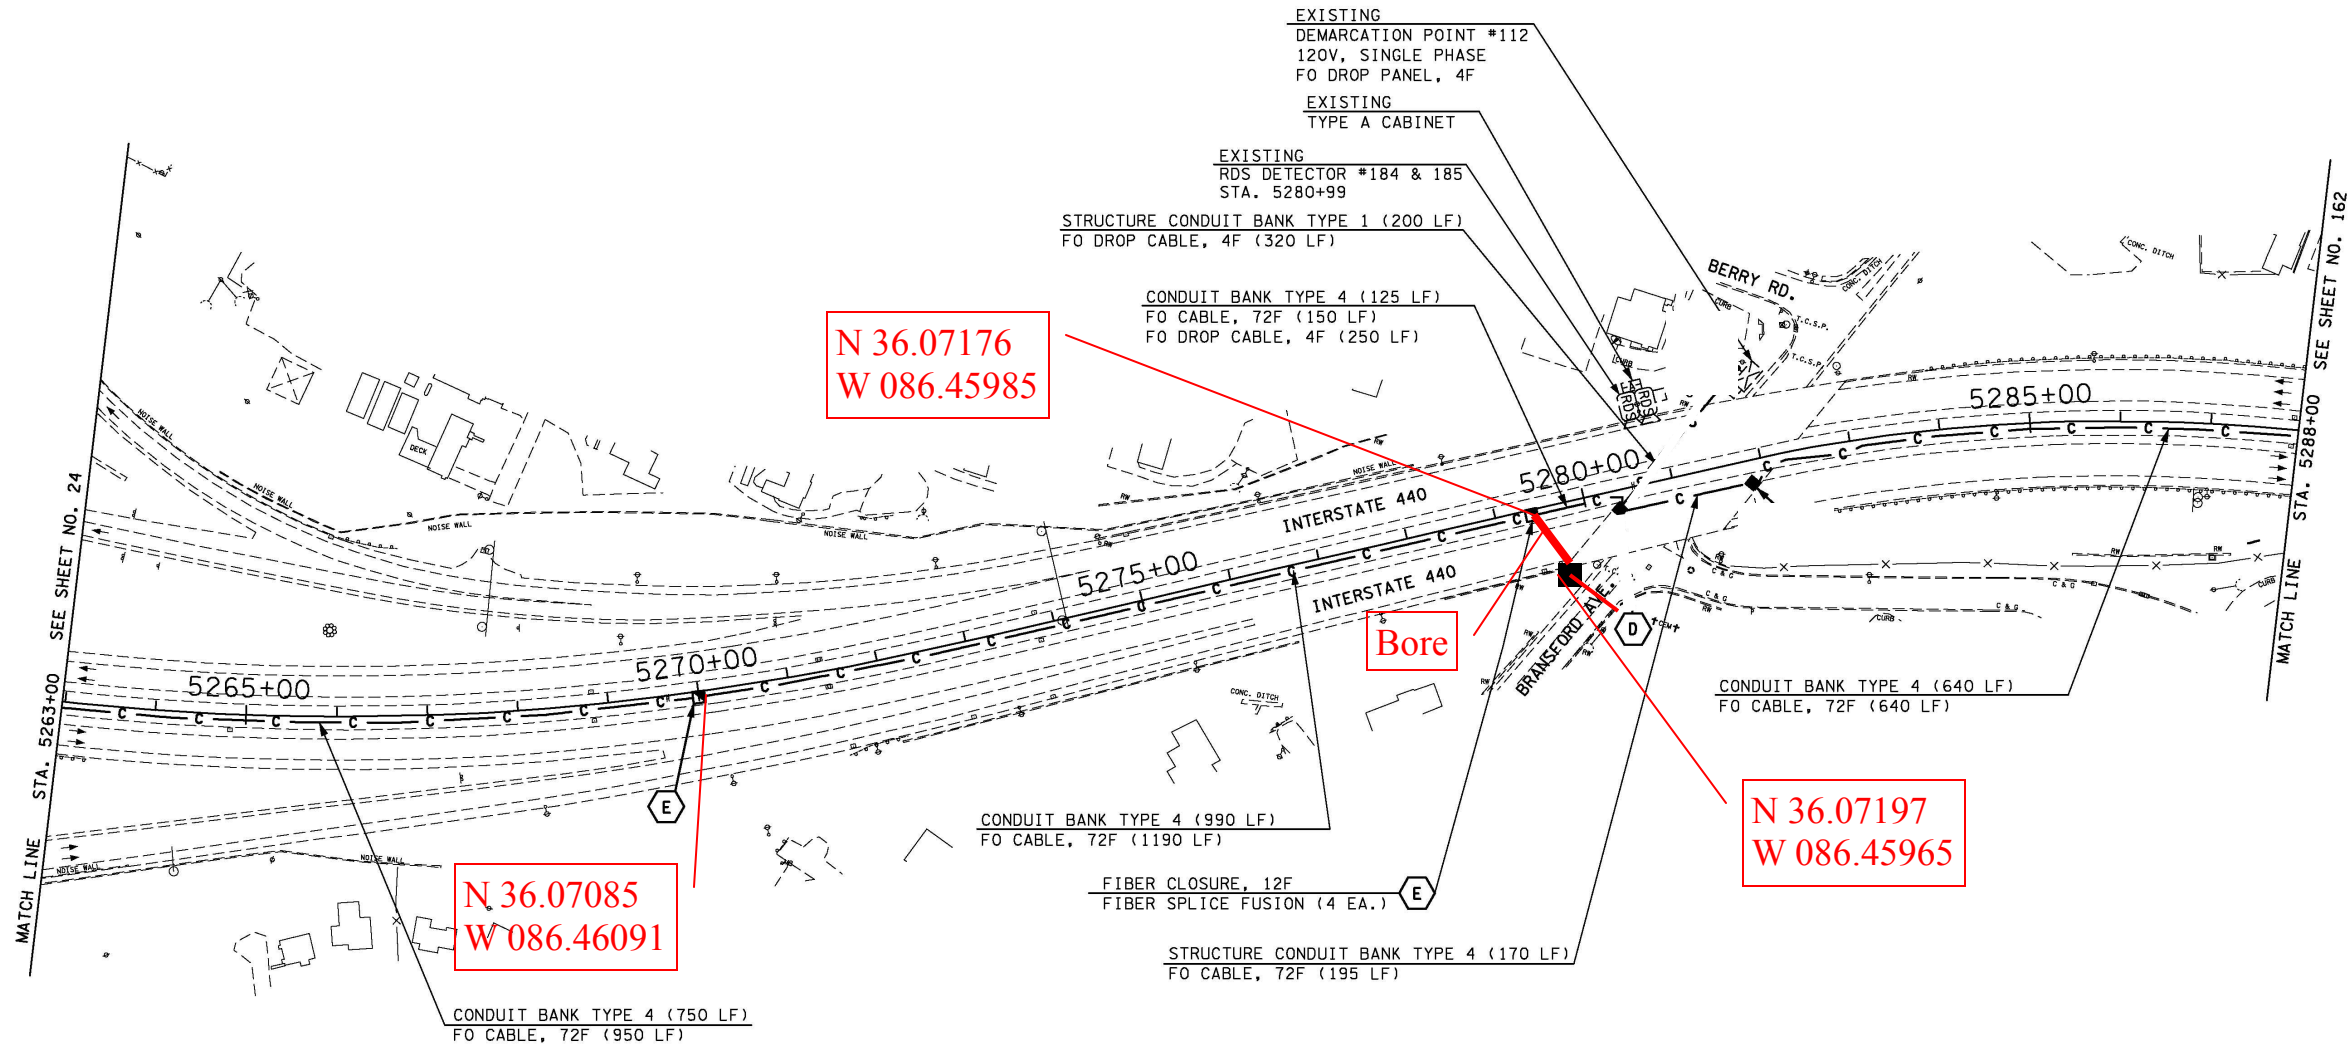


TYPE	YEAR	PROJECT NO.	SHEET NO.
CONST.	2007	CM-098-3(14)	161
As built	2010		

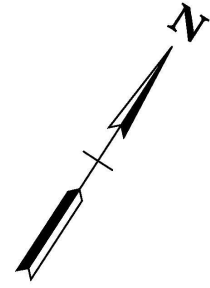

STATE OF TENNESSEE
DEPARTMENT OF TRANSPORTATION

ITS LAYOUT
I-440
STA. 5263+00 TO
STA. 5288+00
SCALE: 1"=100'