


TENNESSEE D.O.T.
 DESIGN DIVISION
 FILE NO.

TYPE	YEAR	PROJECT NO.	SHEET NO.
CONST.	2007	CM-098-3(14)	162
As built	2010		

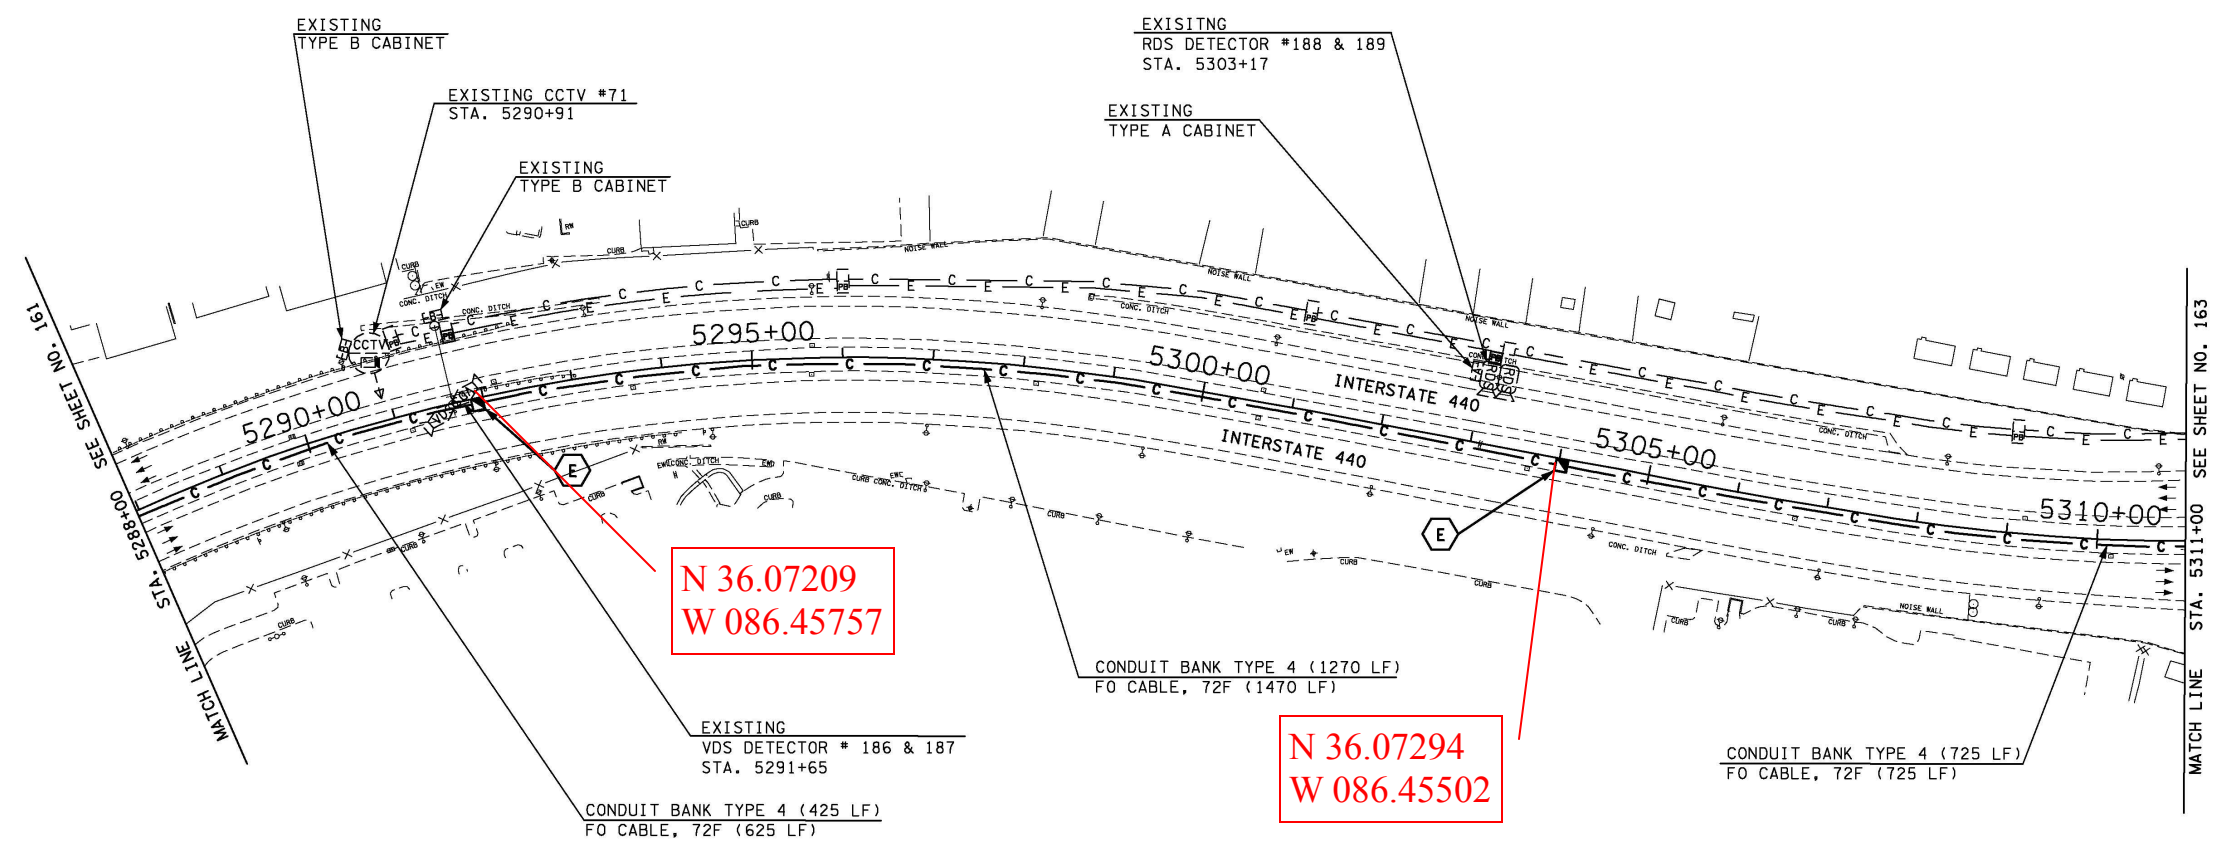

STATE OF TENNESSEE
 DEPARTMENT OF TRANSPORTATION

ITS LAYOUT
 I-440
 STA. 5288+00 TO
 STA. 5311+00
 SCALE: 1"=100'