


TYPE	YEAR	PROJECT NO.	SHEET NO.
CONST.	2007	CM-09B-3(14)	164
As built	2010		

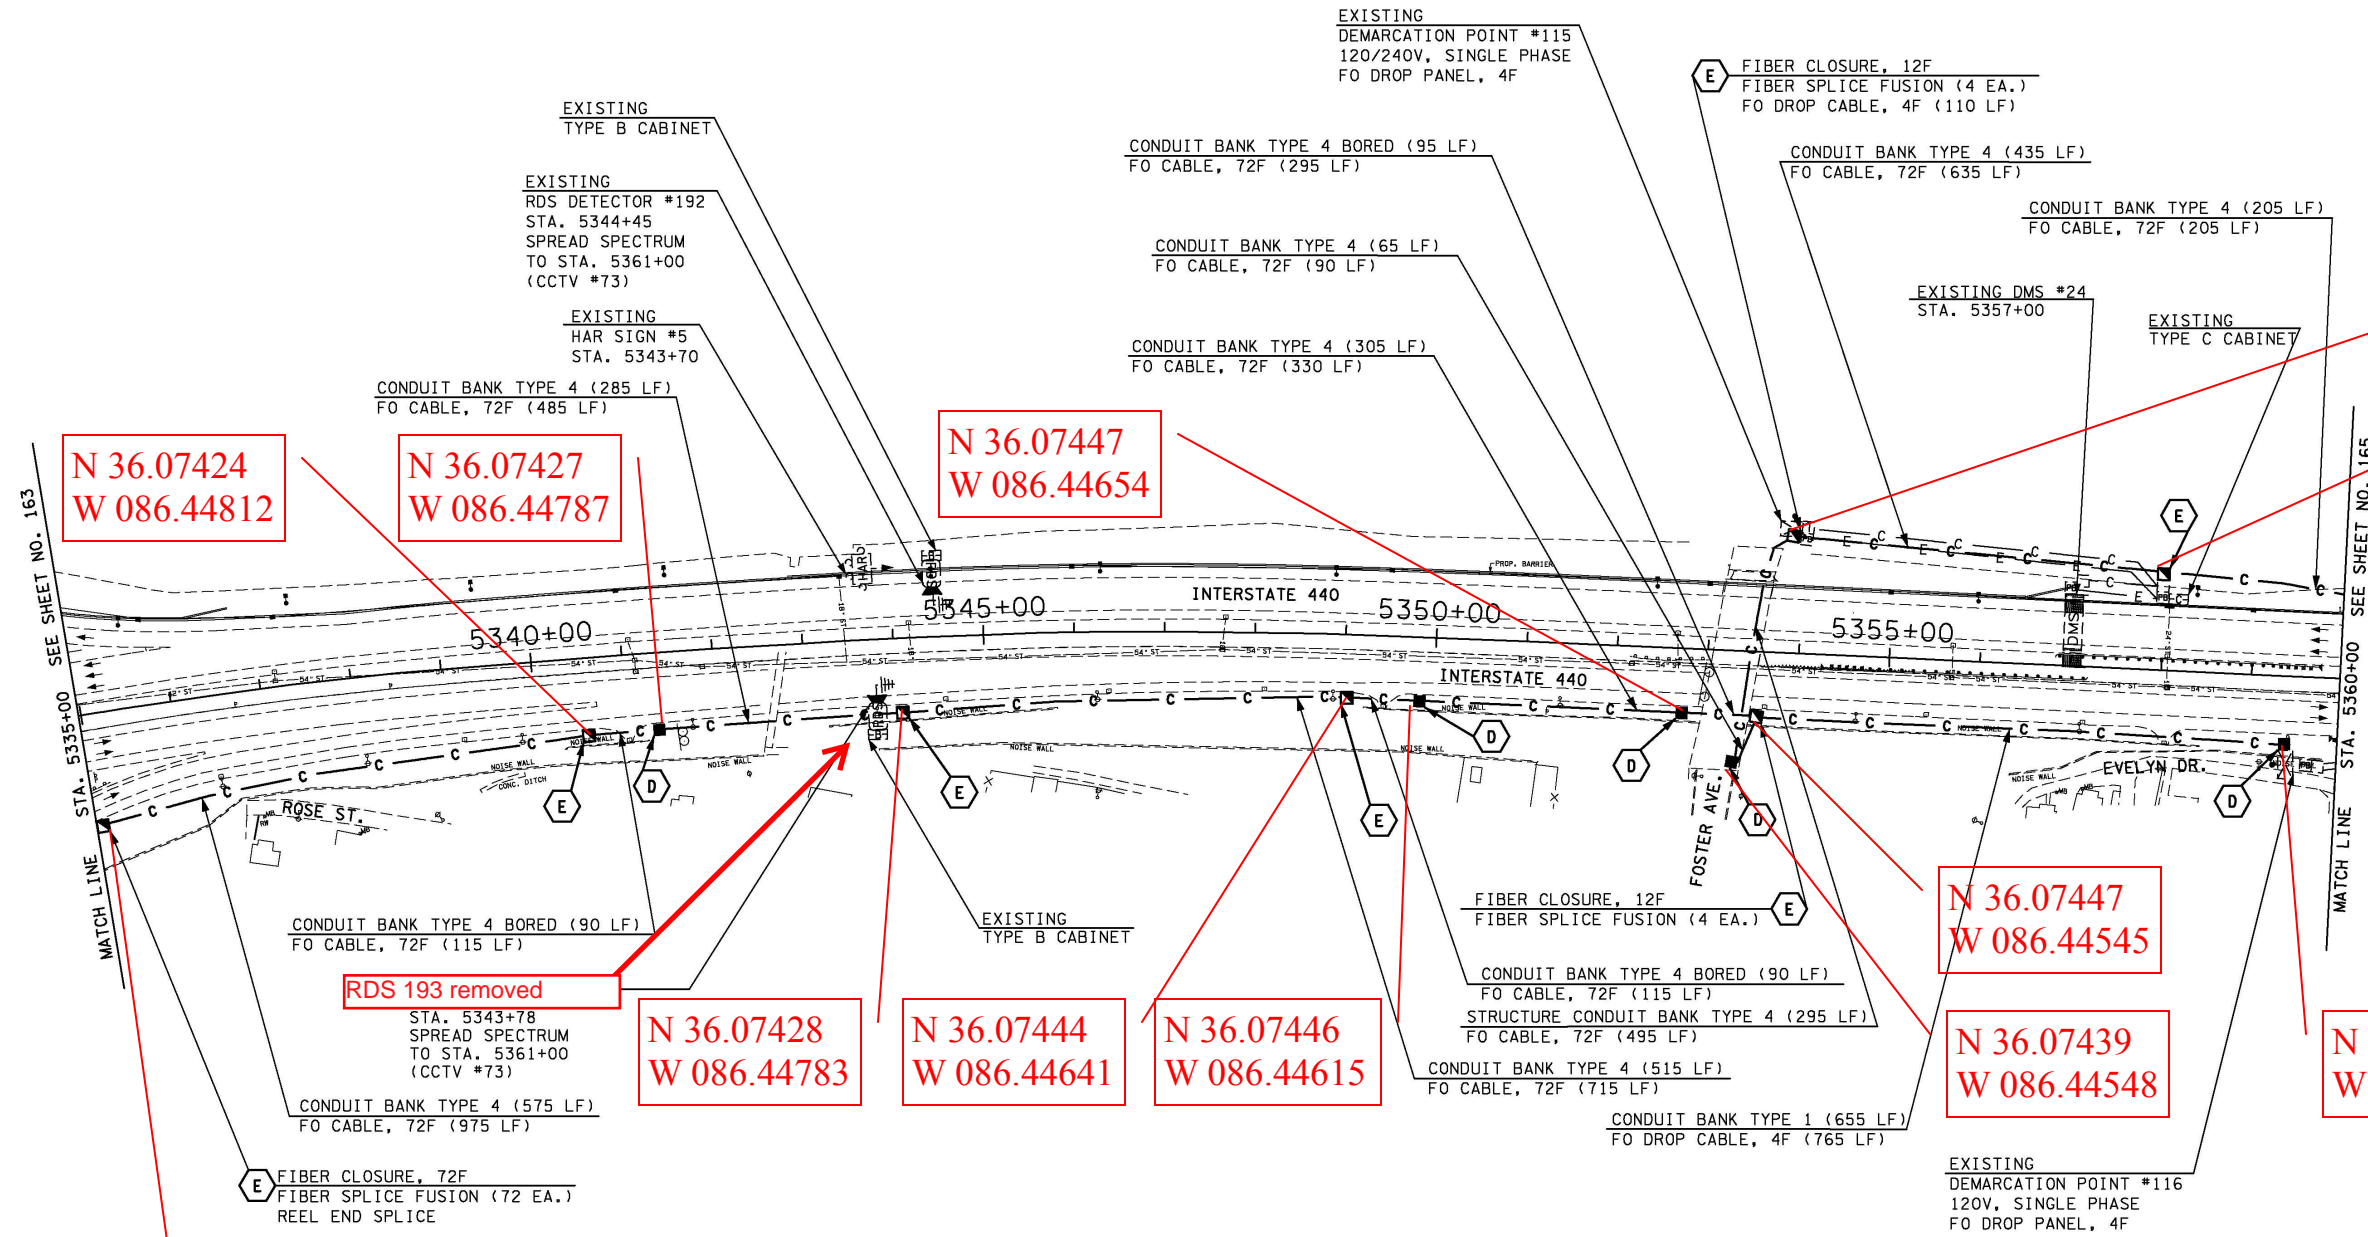

N 36.07424
W 086.44812

N 36.07427
W 086.44787

N 36.07447
W 086.44654

N 36.07470
W 086.44536

N 36.07472
W 086.44452

RDS 193 removed

N 36.07428
W 086.44783

N 36.07444
W 086.44641

N 36.07446
W 086.44615

N 36.07447
W 086.44545

N 36.07439
W 086.44548

N 36.07457
W 086.44465

N 36.07401
W 086.44909

