


TYPE	YEAR	PROJECT NO.	SHEET NO.
CONST.	2007	CM-098-3(14)	165
As built	2010		

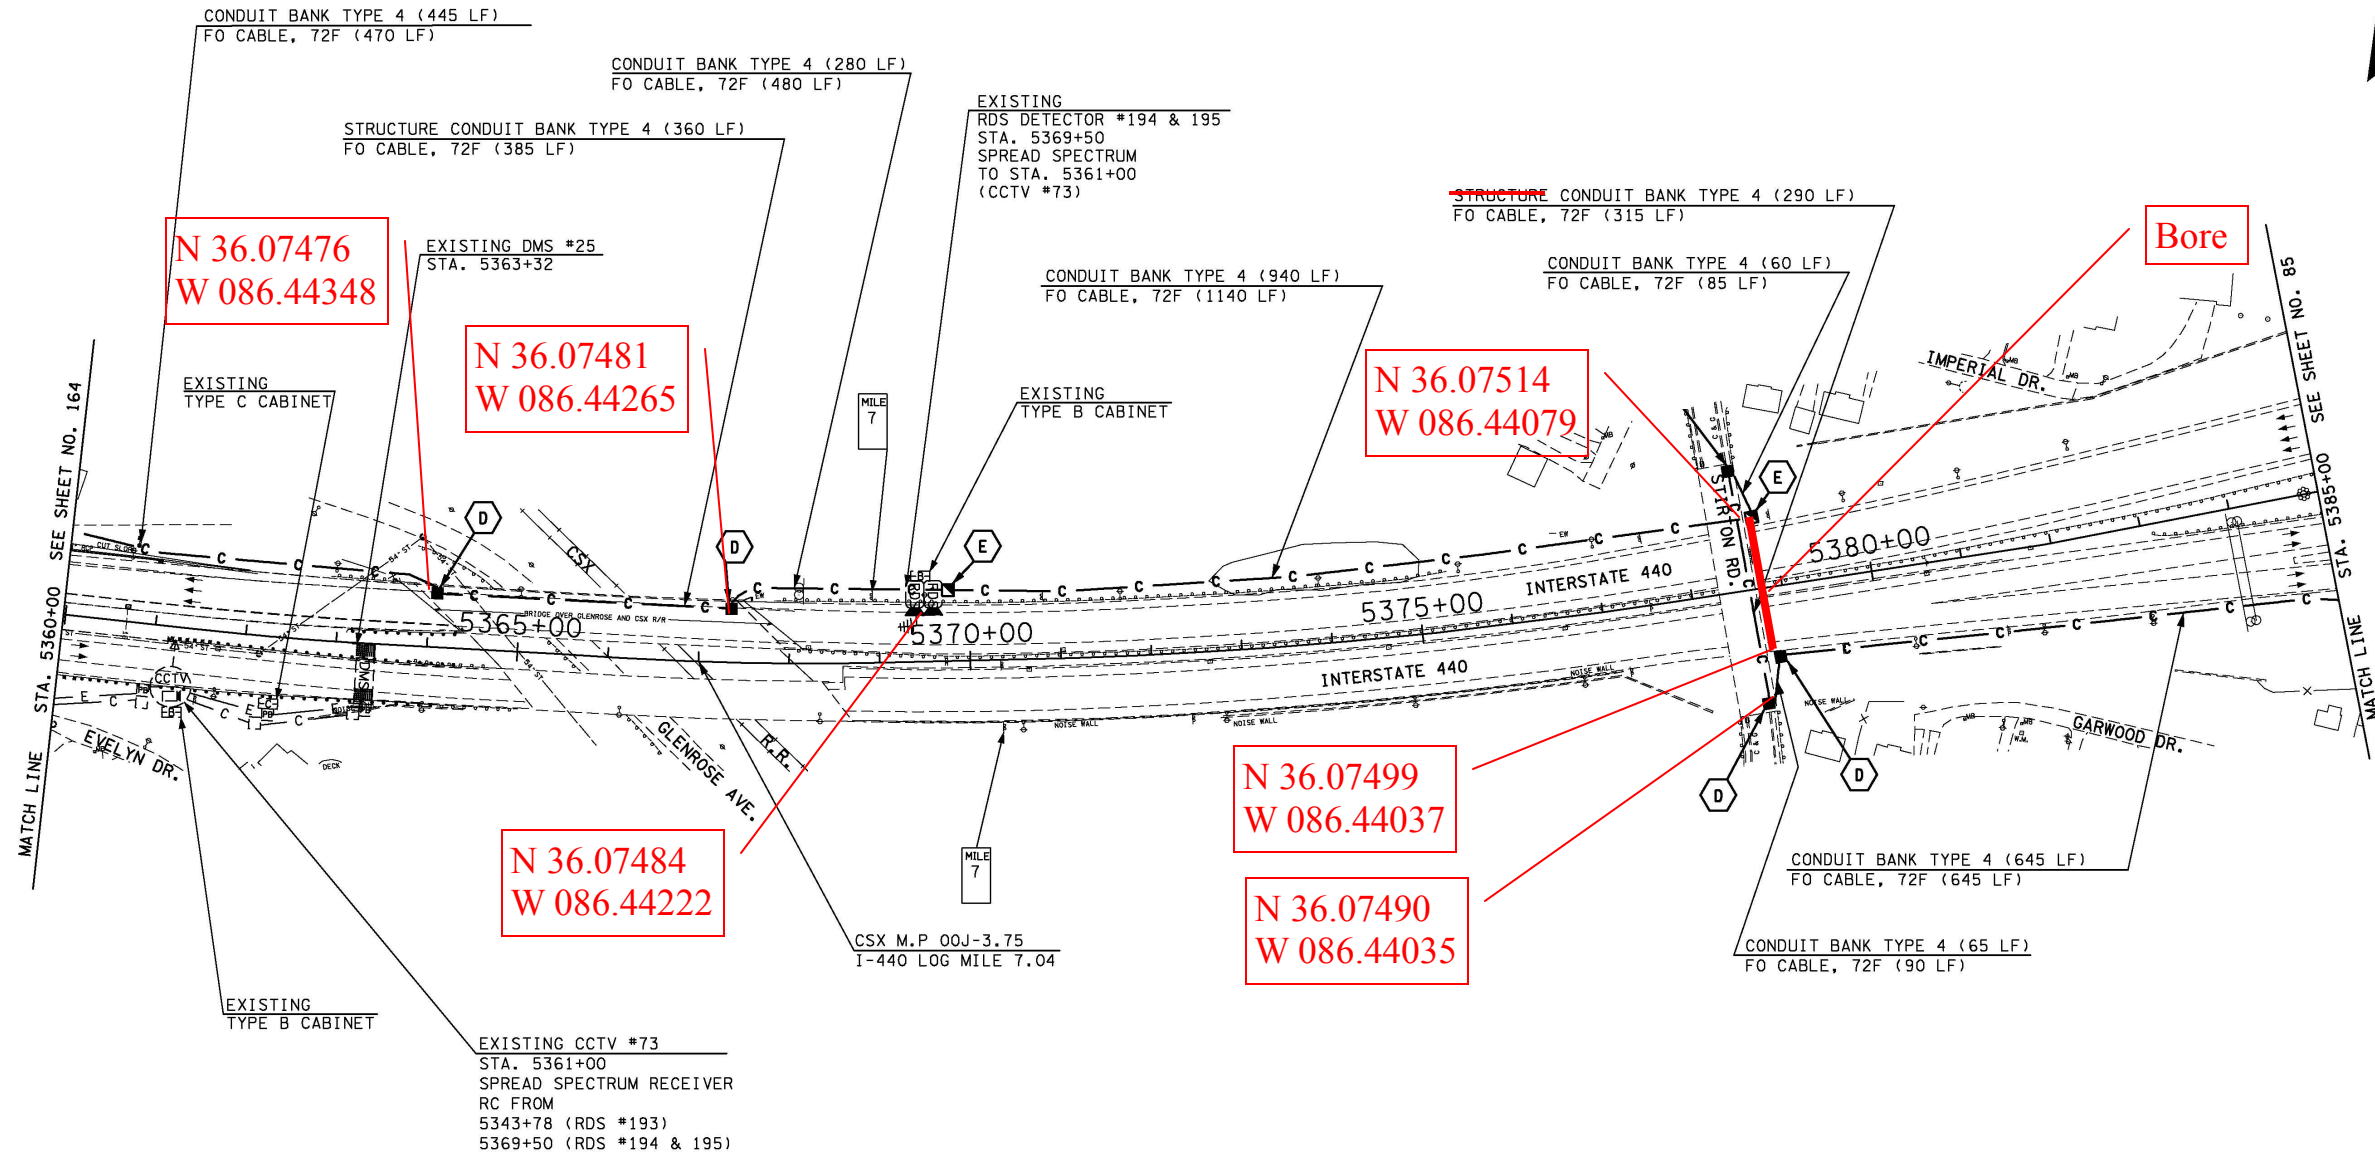

N 36.07476  
W 086.44348

N 36.07481  
W 086.44265

N 36.07514  
W 086.44079

N 36.07484  
W 086.44222

N 36.07499  
W 086.44037

N 36.07490  
W 086.44035

Bore

