
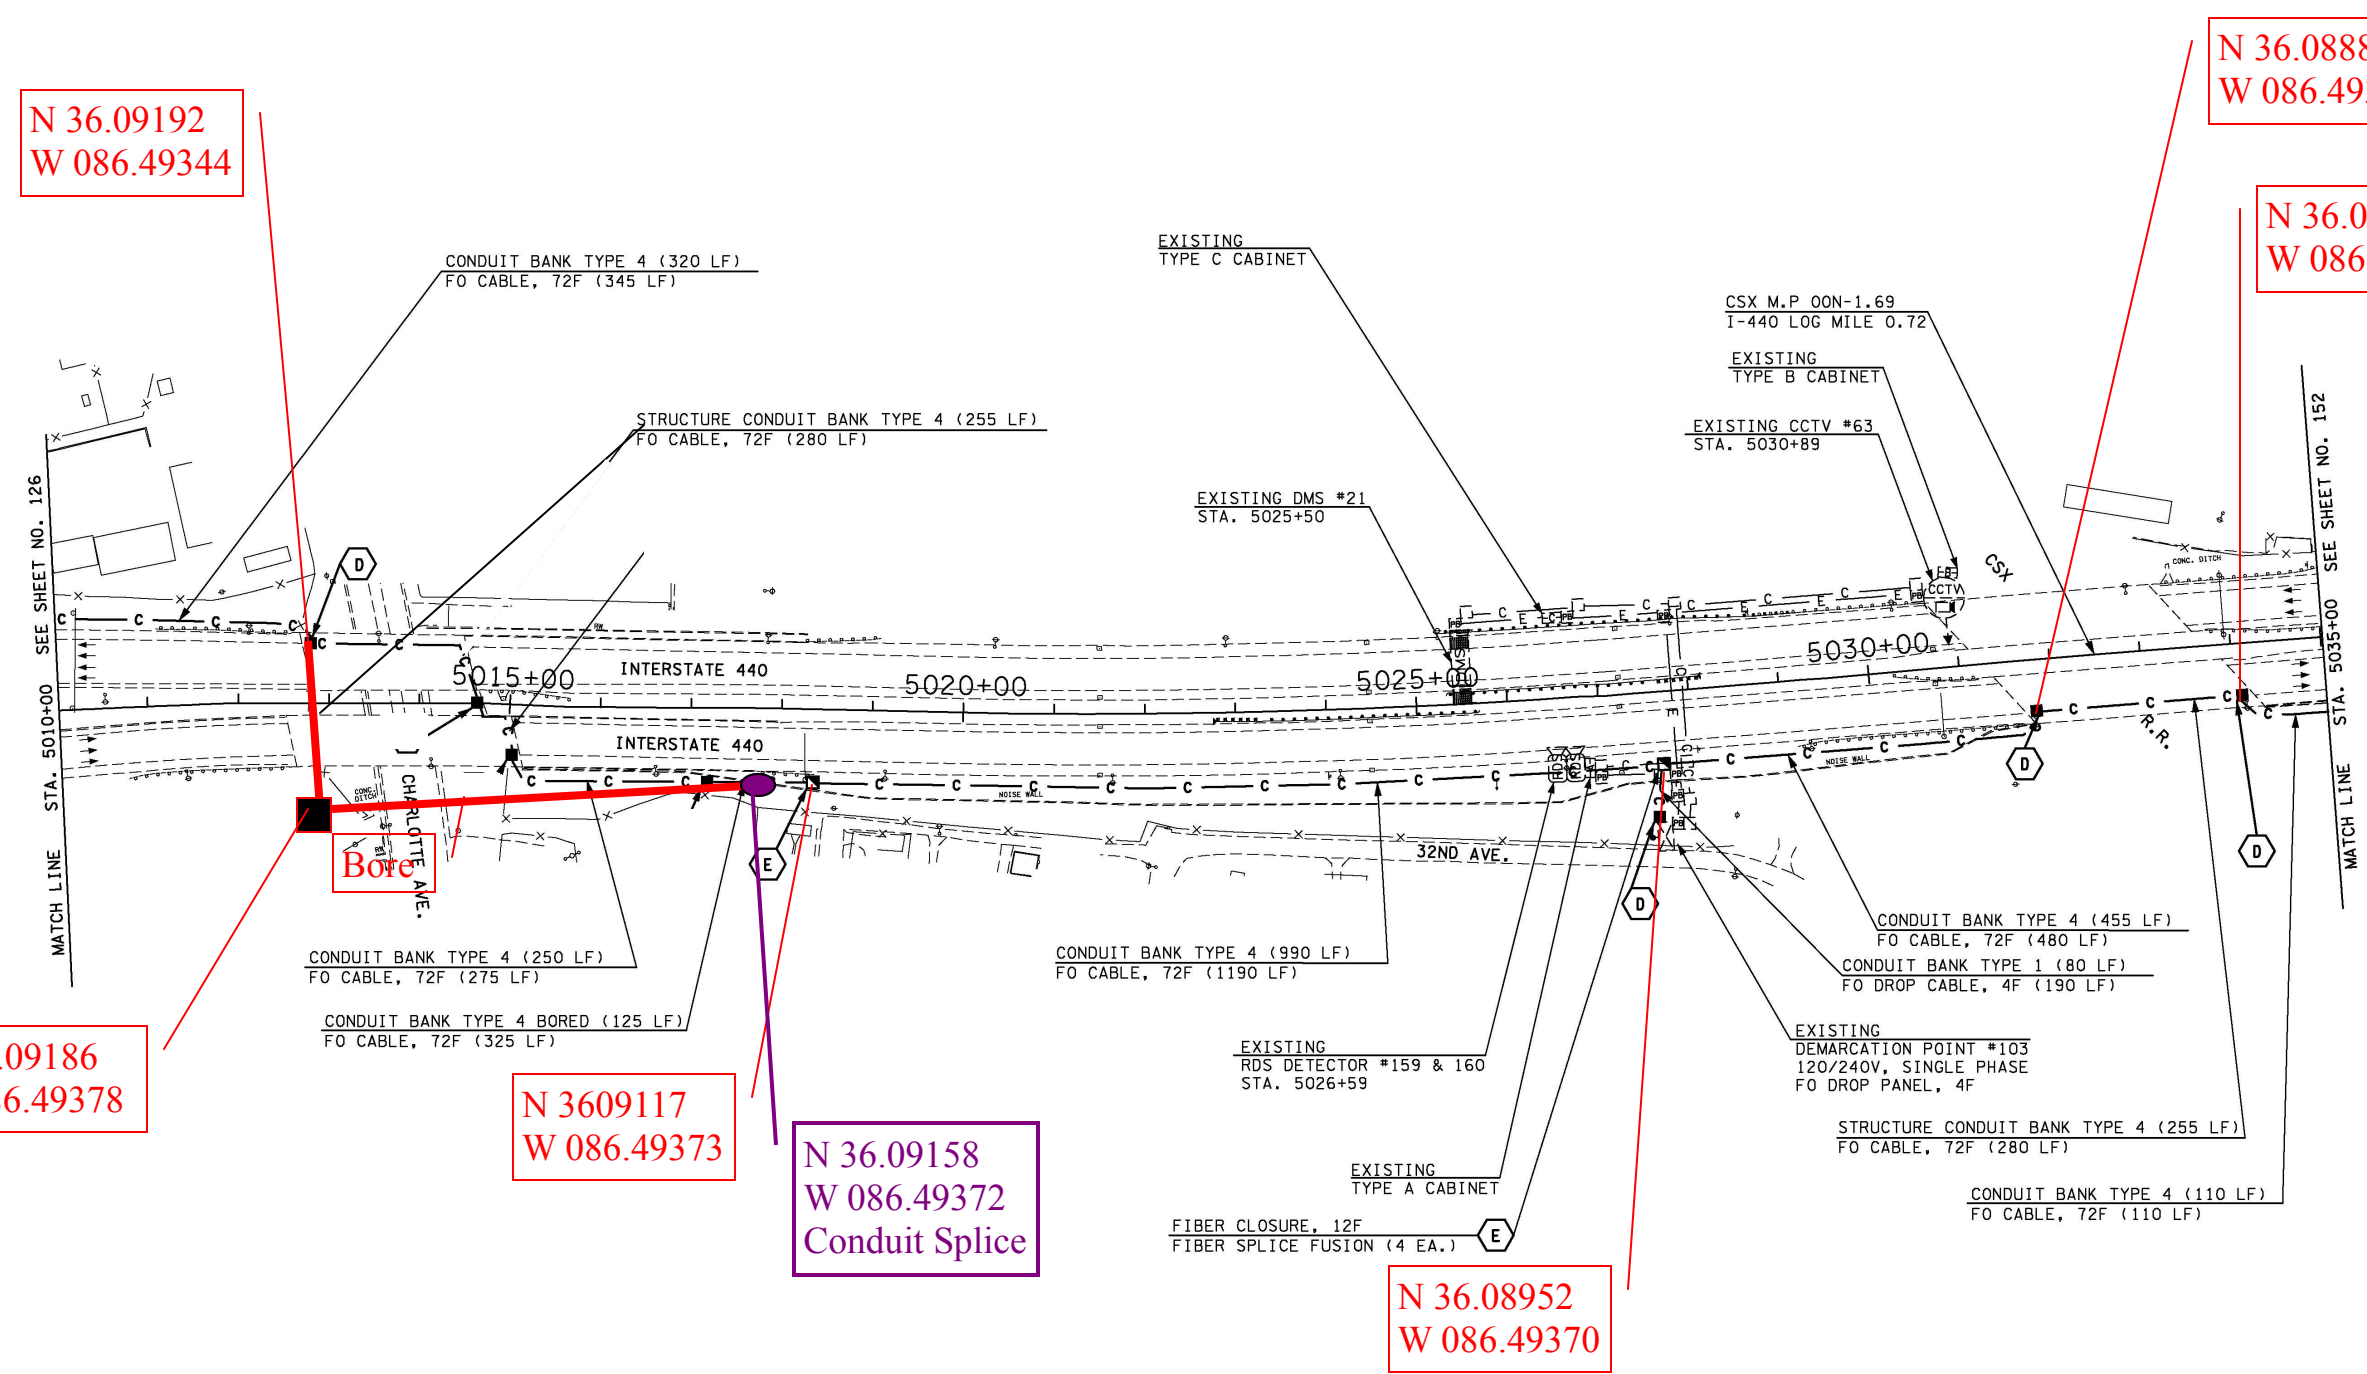


TYPE	YEAR	PROJECT NO.	SHEET NO.
CONST.	2007	CM-098-3(14)	151
As built	2010		

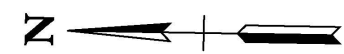

N 36.09192
W 086.49344

N 36.08883
W 086.49356

N 36.08833
W 086.49351

N 36.09186
W 086.49378

N 36.09117
W 086.49373

N 36.09158
W 086.49372
Conduit Splice

N 36.08952
W 086.49370

Bore



STATE OF TENNESSEE
DEPARTMENT OF TRANSPORTATION

ITS LAYOUT
I-440
STA. 5010+00 TO
STA. 5035+00
SCALE: 1"=100'