


TYPE	YEAR	PROJECT NO.	SHEET NO.
CONST.	2007	CM-098-3(14)	152
As built	2010		

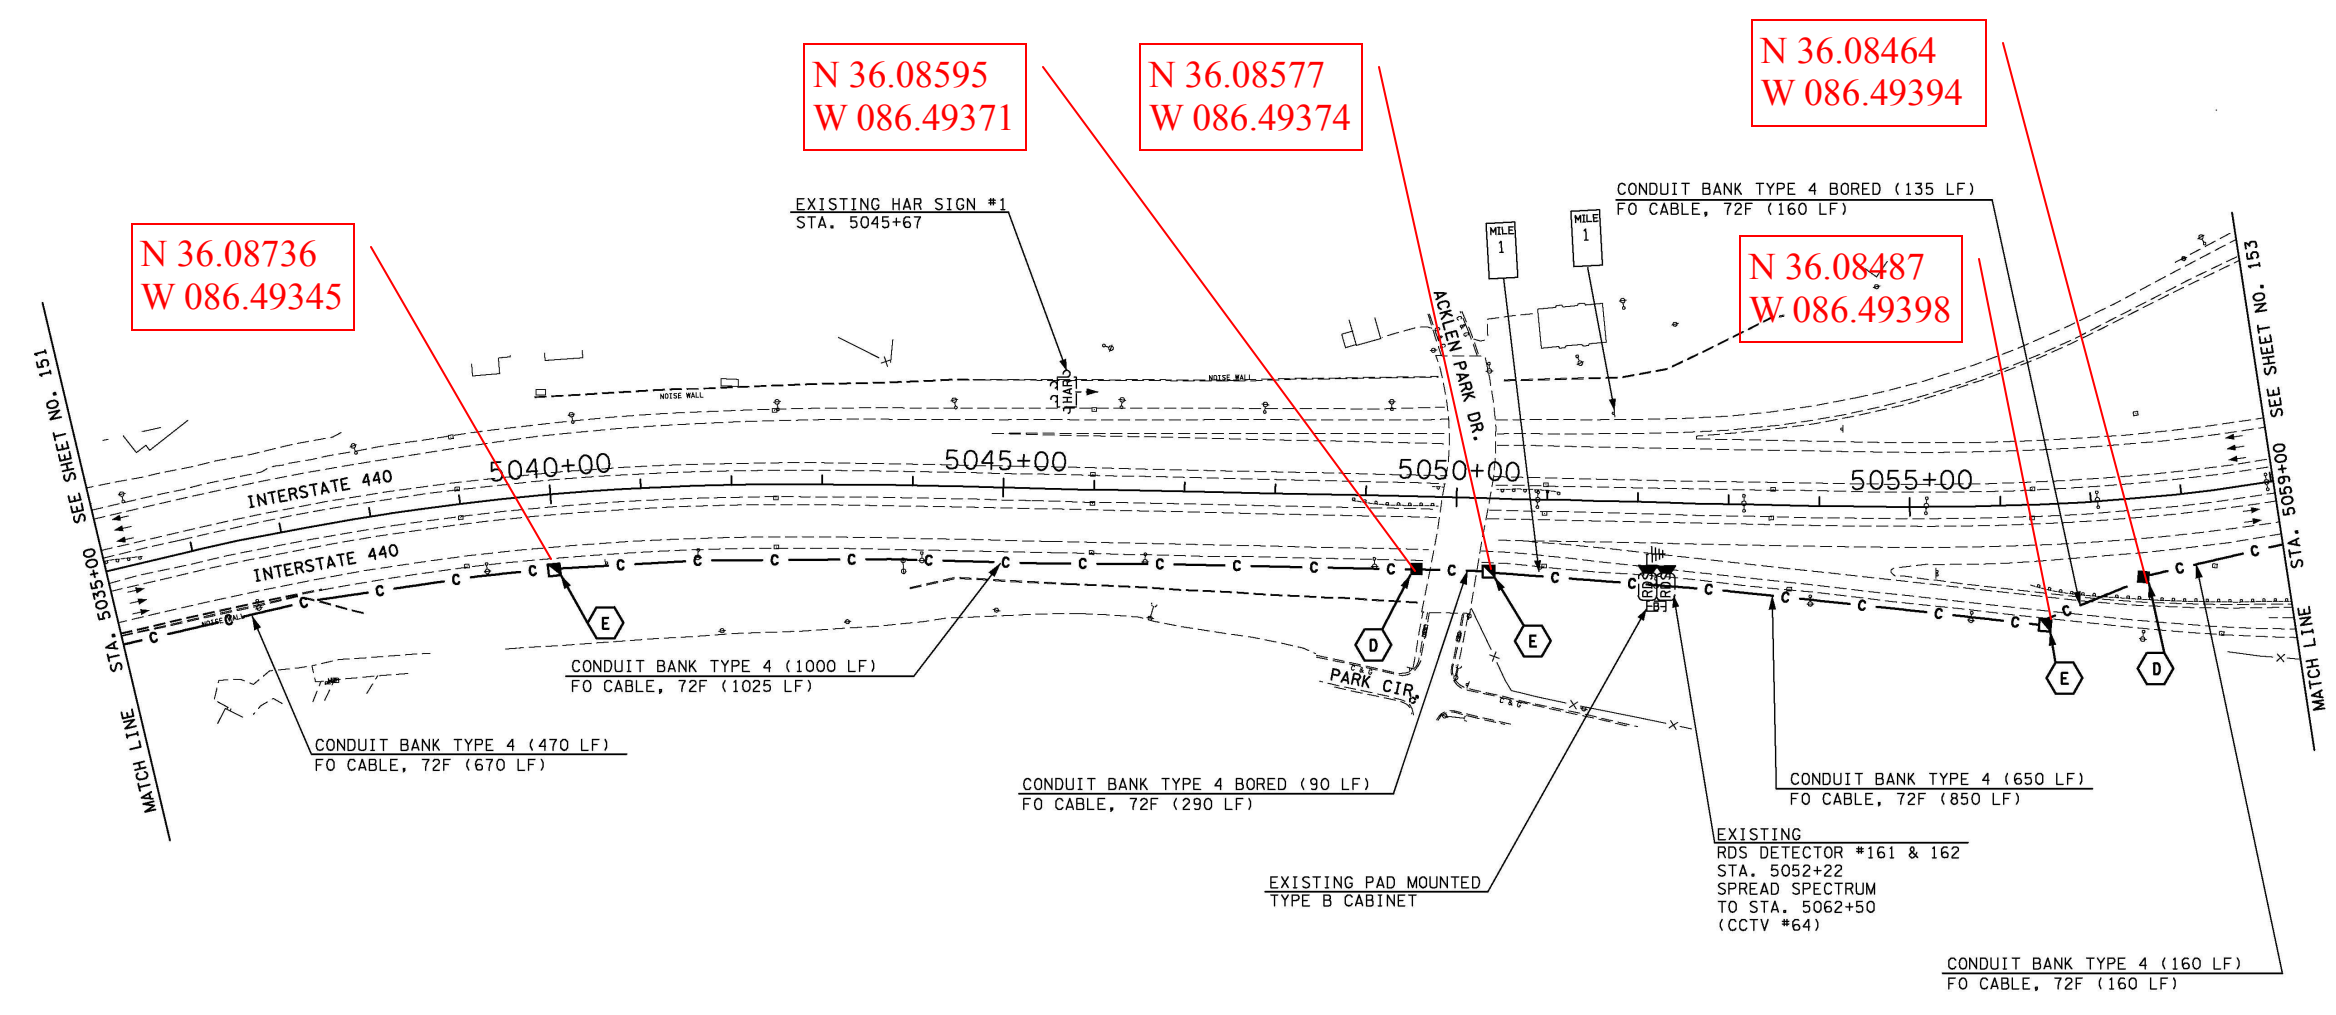

STATE OF TENNESSEE  
DEPARTMENT OF TRANSPORTATION

ITS LAYOUT  
I-440  
STA. 5035+00 TO  
STA. 5059+00  
SCALE: 1"=100'