
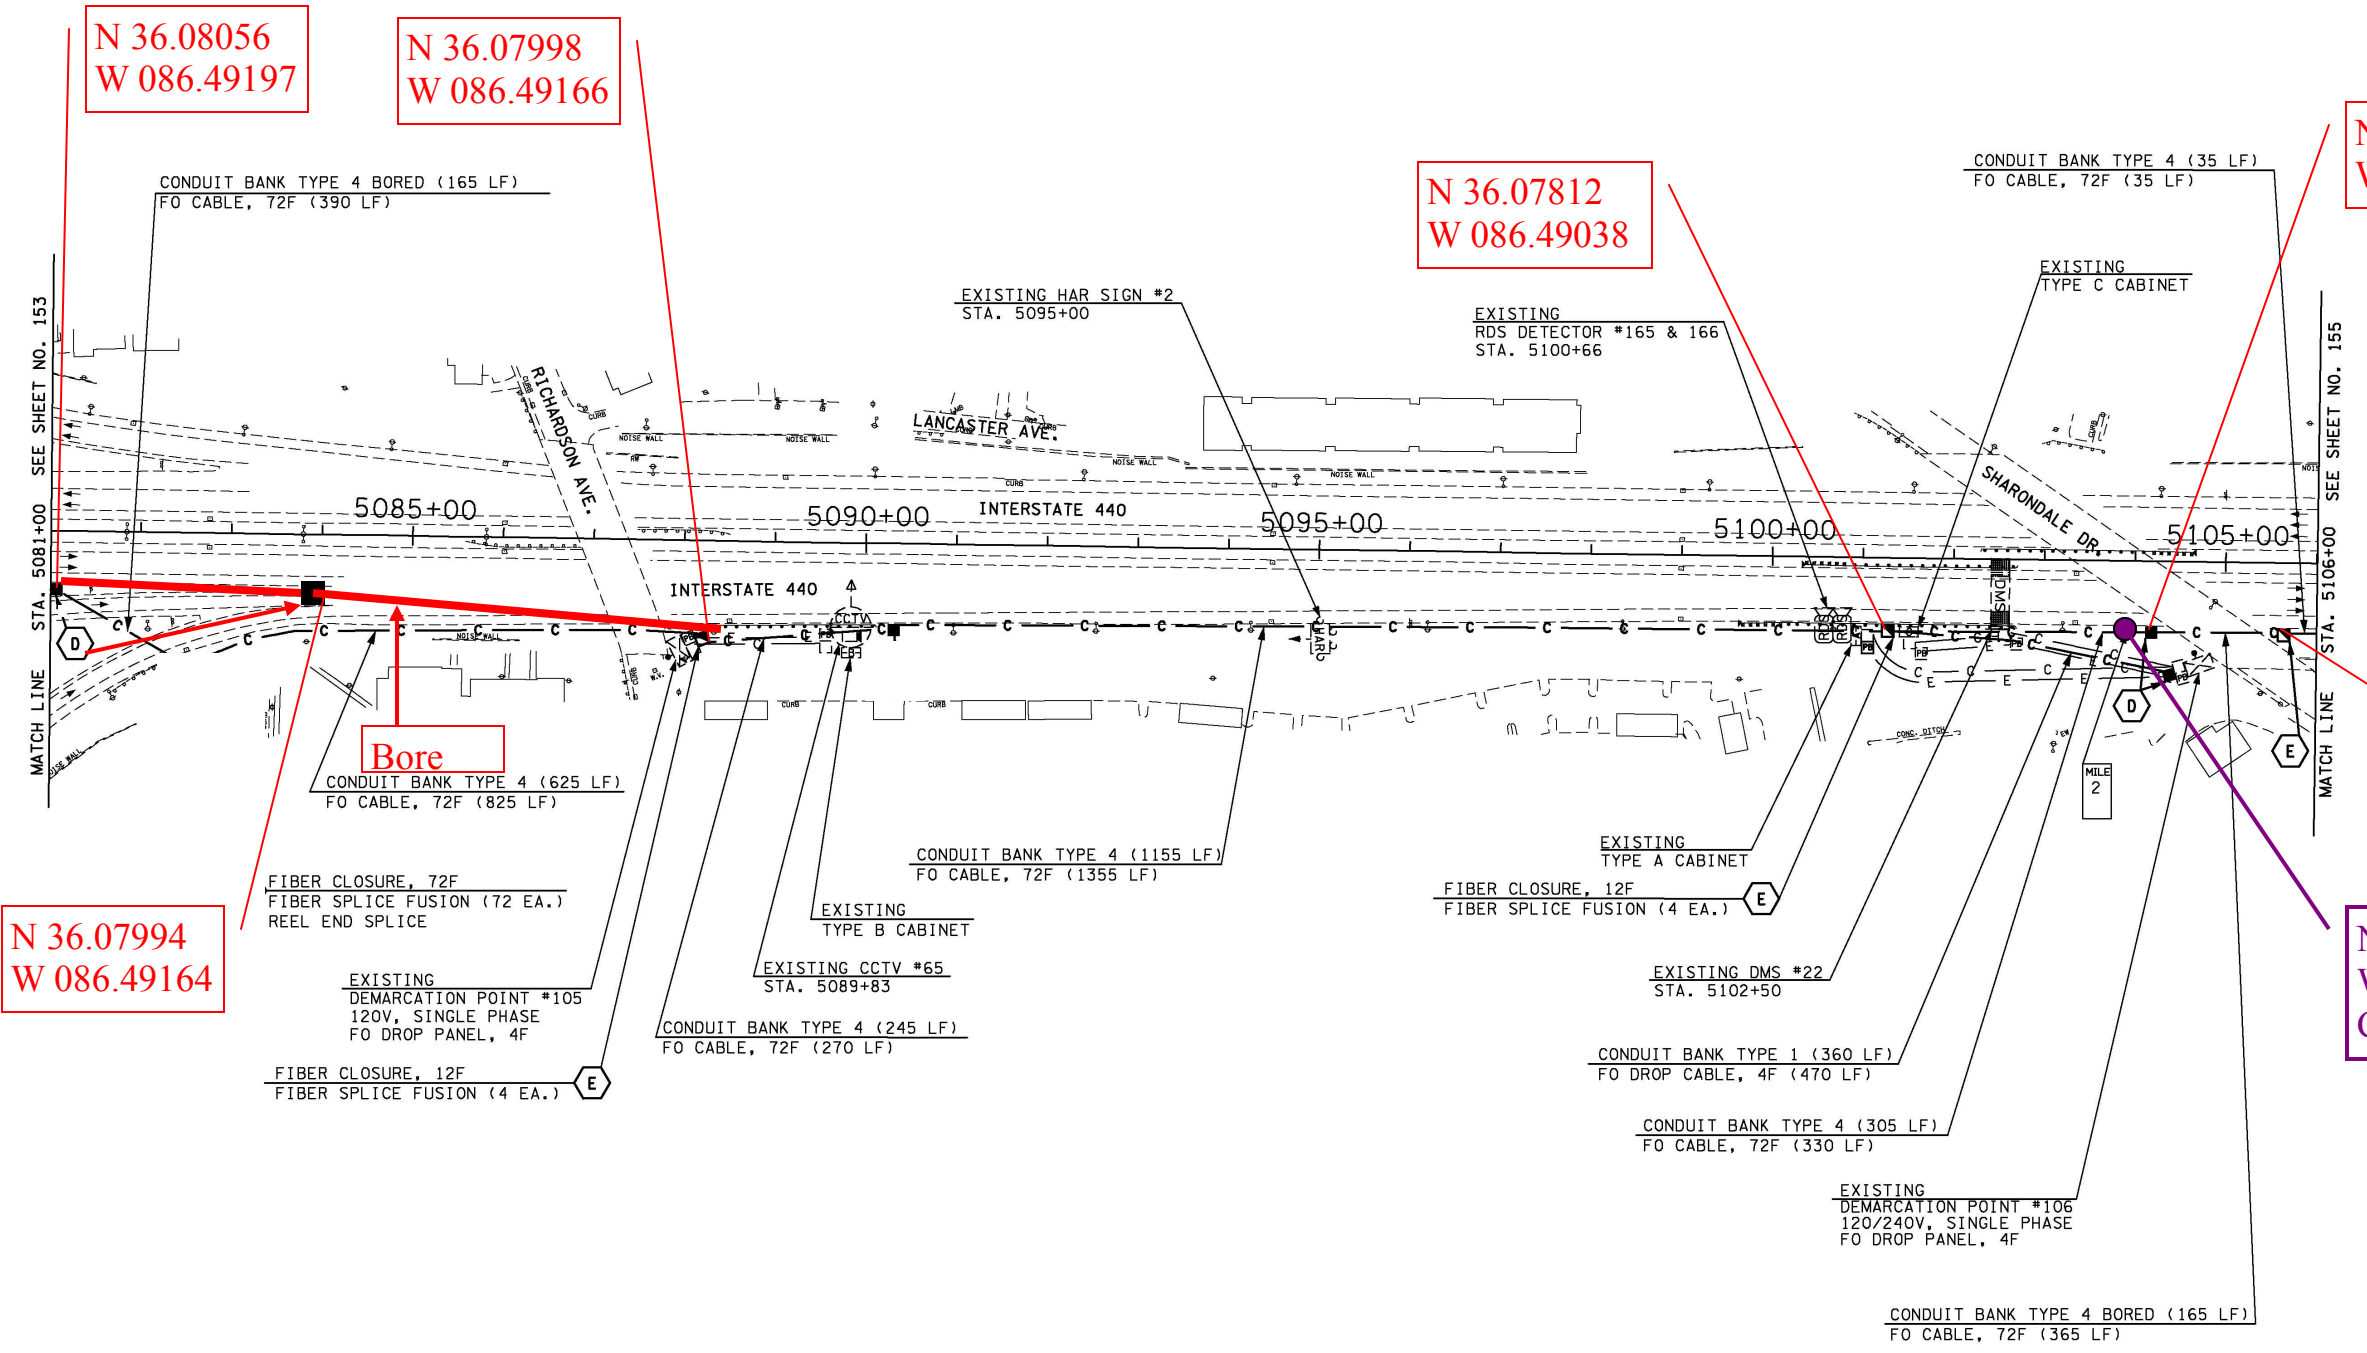


TYPE	YEAR	PROJECT NO.	SHEET NO.
CONST.	2007	CM-098-3(14)	154
As built	2010		

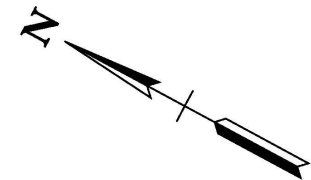

N 36.08056
W 086.49197

N 36.07998
W 086.49166

N 36.07812
W 086.49038

N 36.07778
W 086.49010

N 36.07739
W 086.48990

N 36.07994
W 086.49164

N 36.07789
W 086.49032
Conduit Splice

Bore



STATE OF TENNESSEE
DEPARTMENT OF TRANSPORTATION

ITS LAYOUT
I-440
STA. 5081+00 TO
STA. 5106+00

SCALE: 1"=100'