
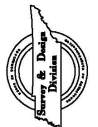
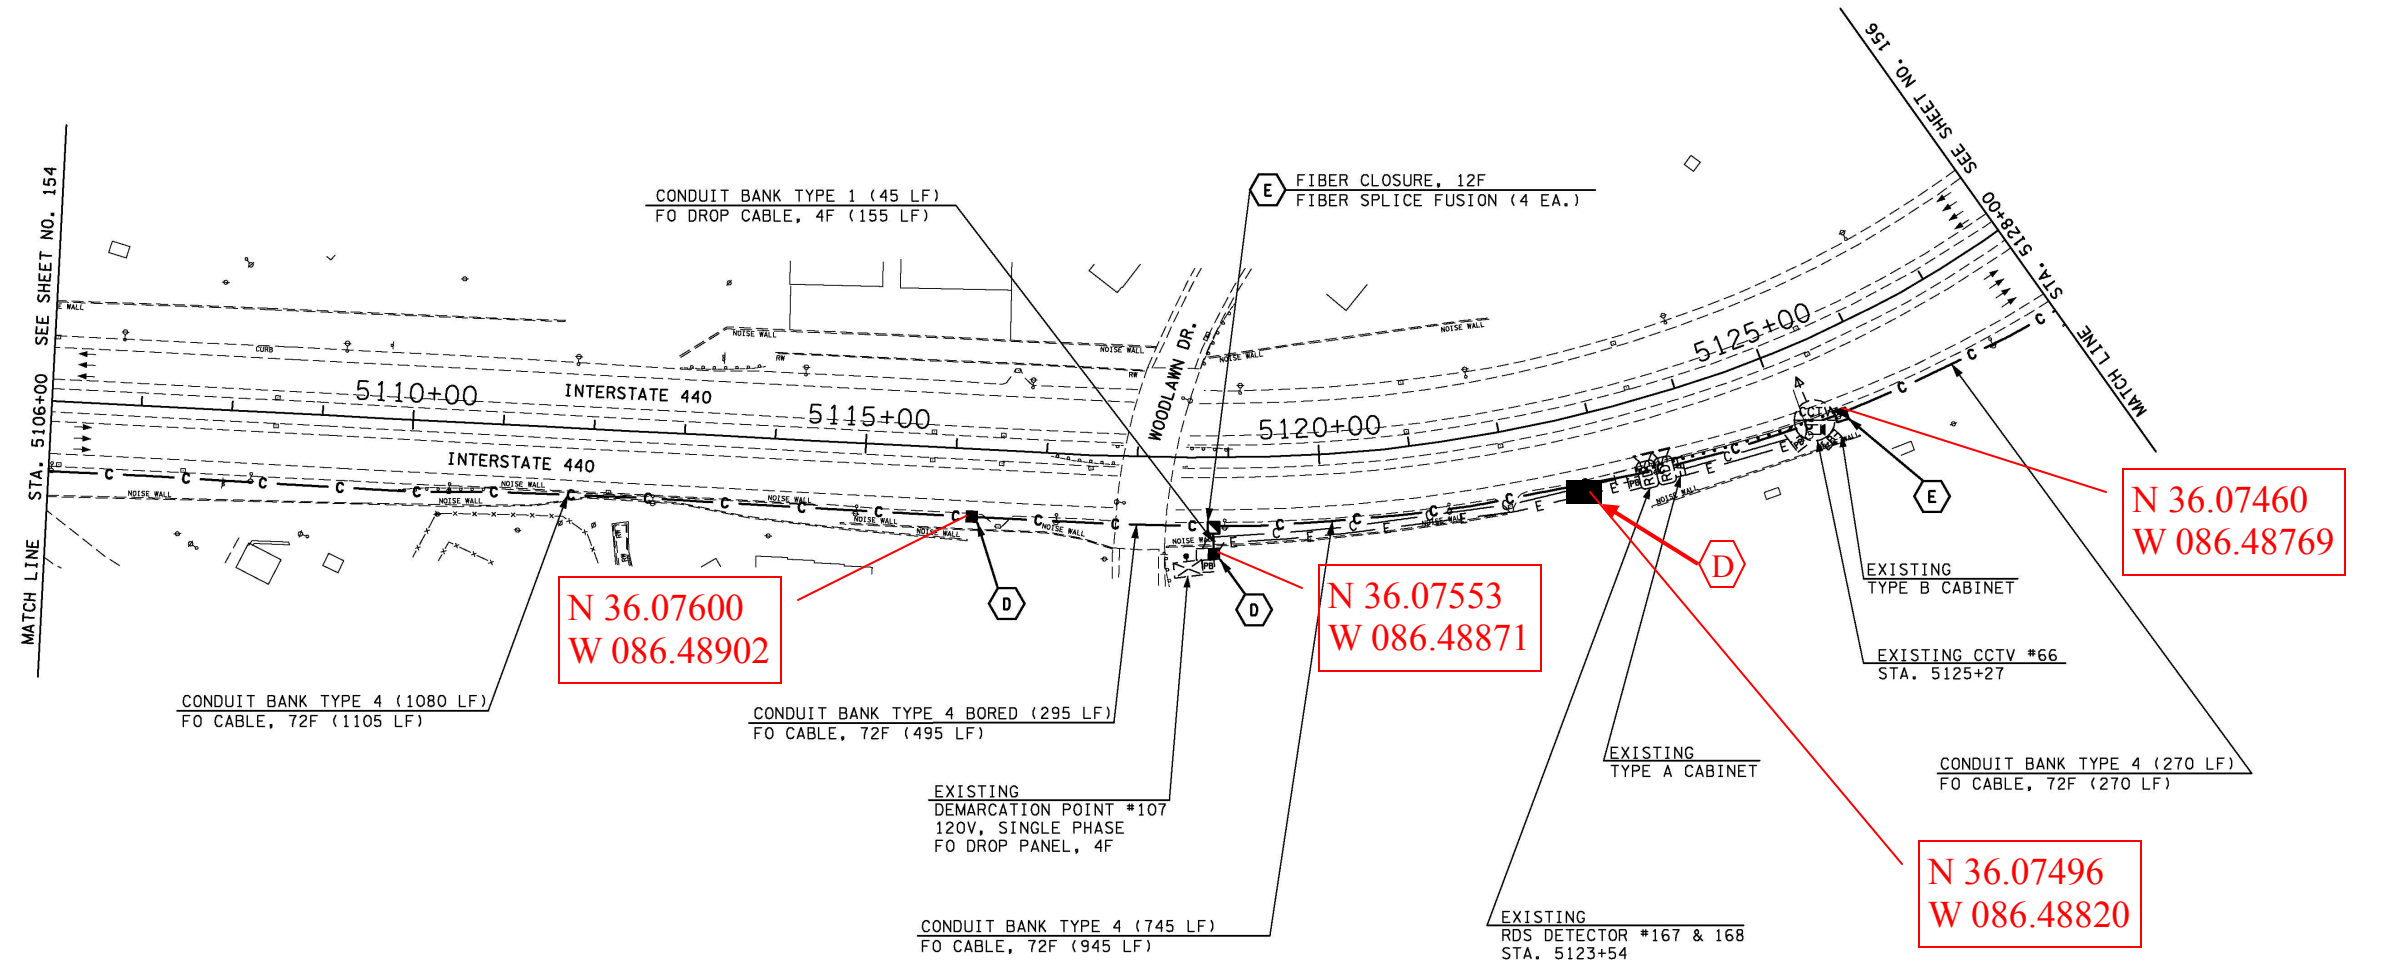


TYPE	YEAR	PROJECT NO.	SHEET NO.
CONST.	2007	CM-098-3(14)	155
As built	2010		

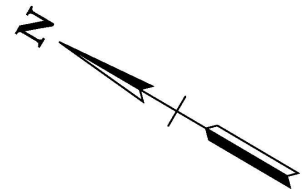

STATE OF TENNESSEE
DEPARTMENT OF TRANSPORTATION

ITS LAYOUT
I-440
STA. 5106+00 TO
STA. 5128+00
SCALE: 1"=100'