


TYPE	YEAR	PROJECT NO.	SHEET NO.
CONST.	2007	CM-098-3(14)	156
As built	2010		

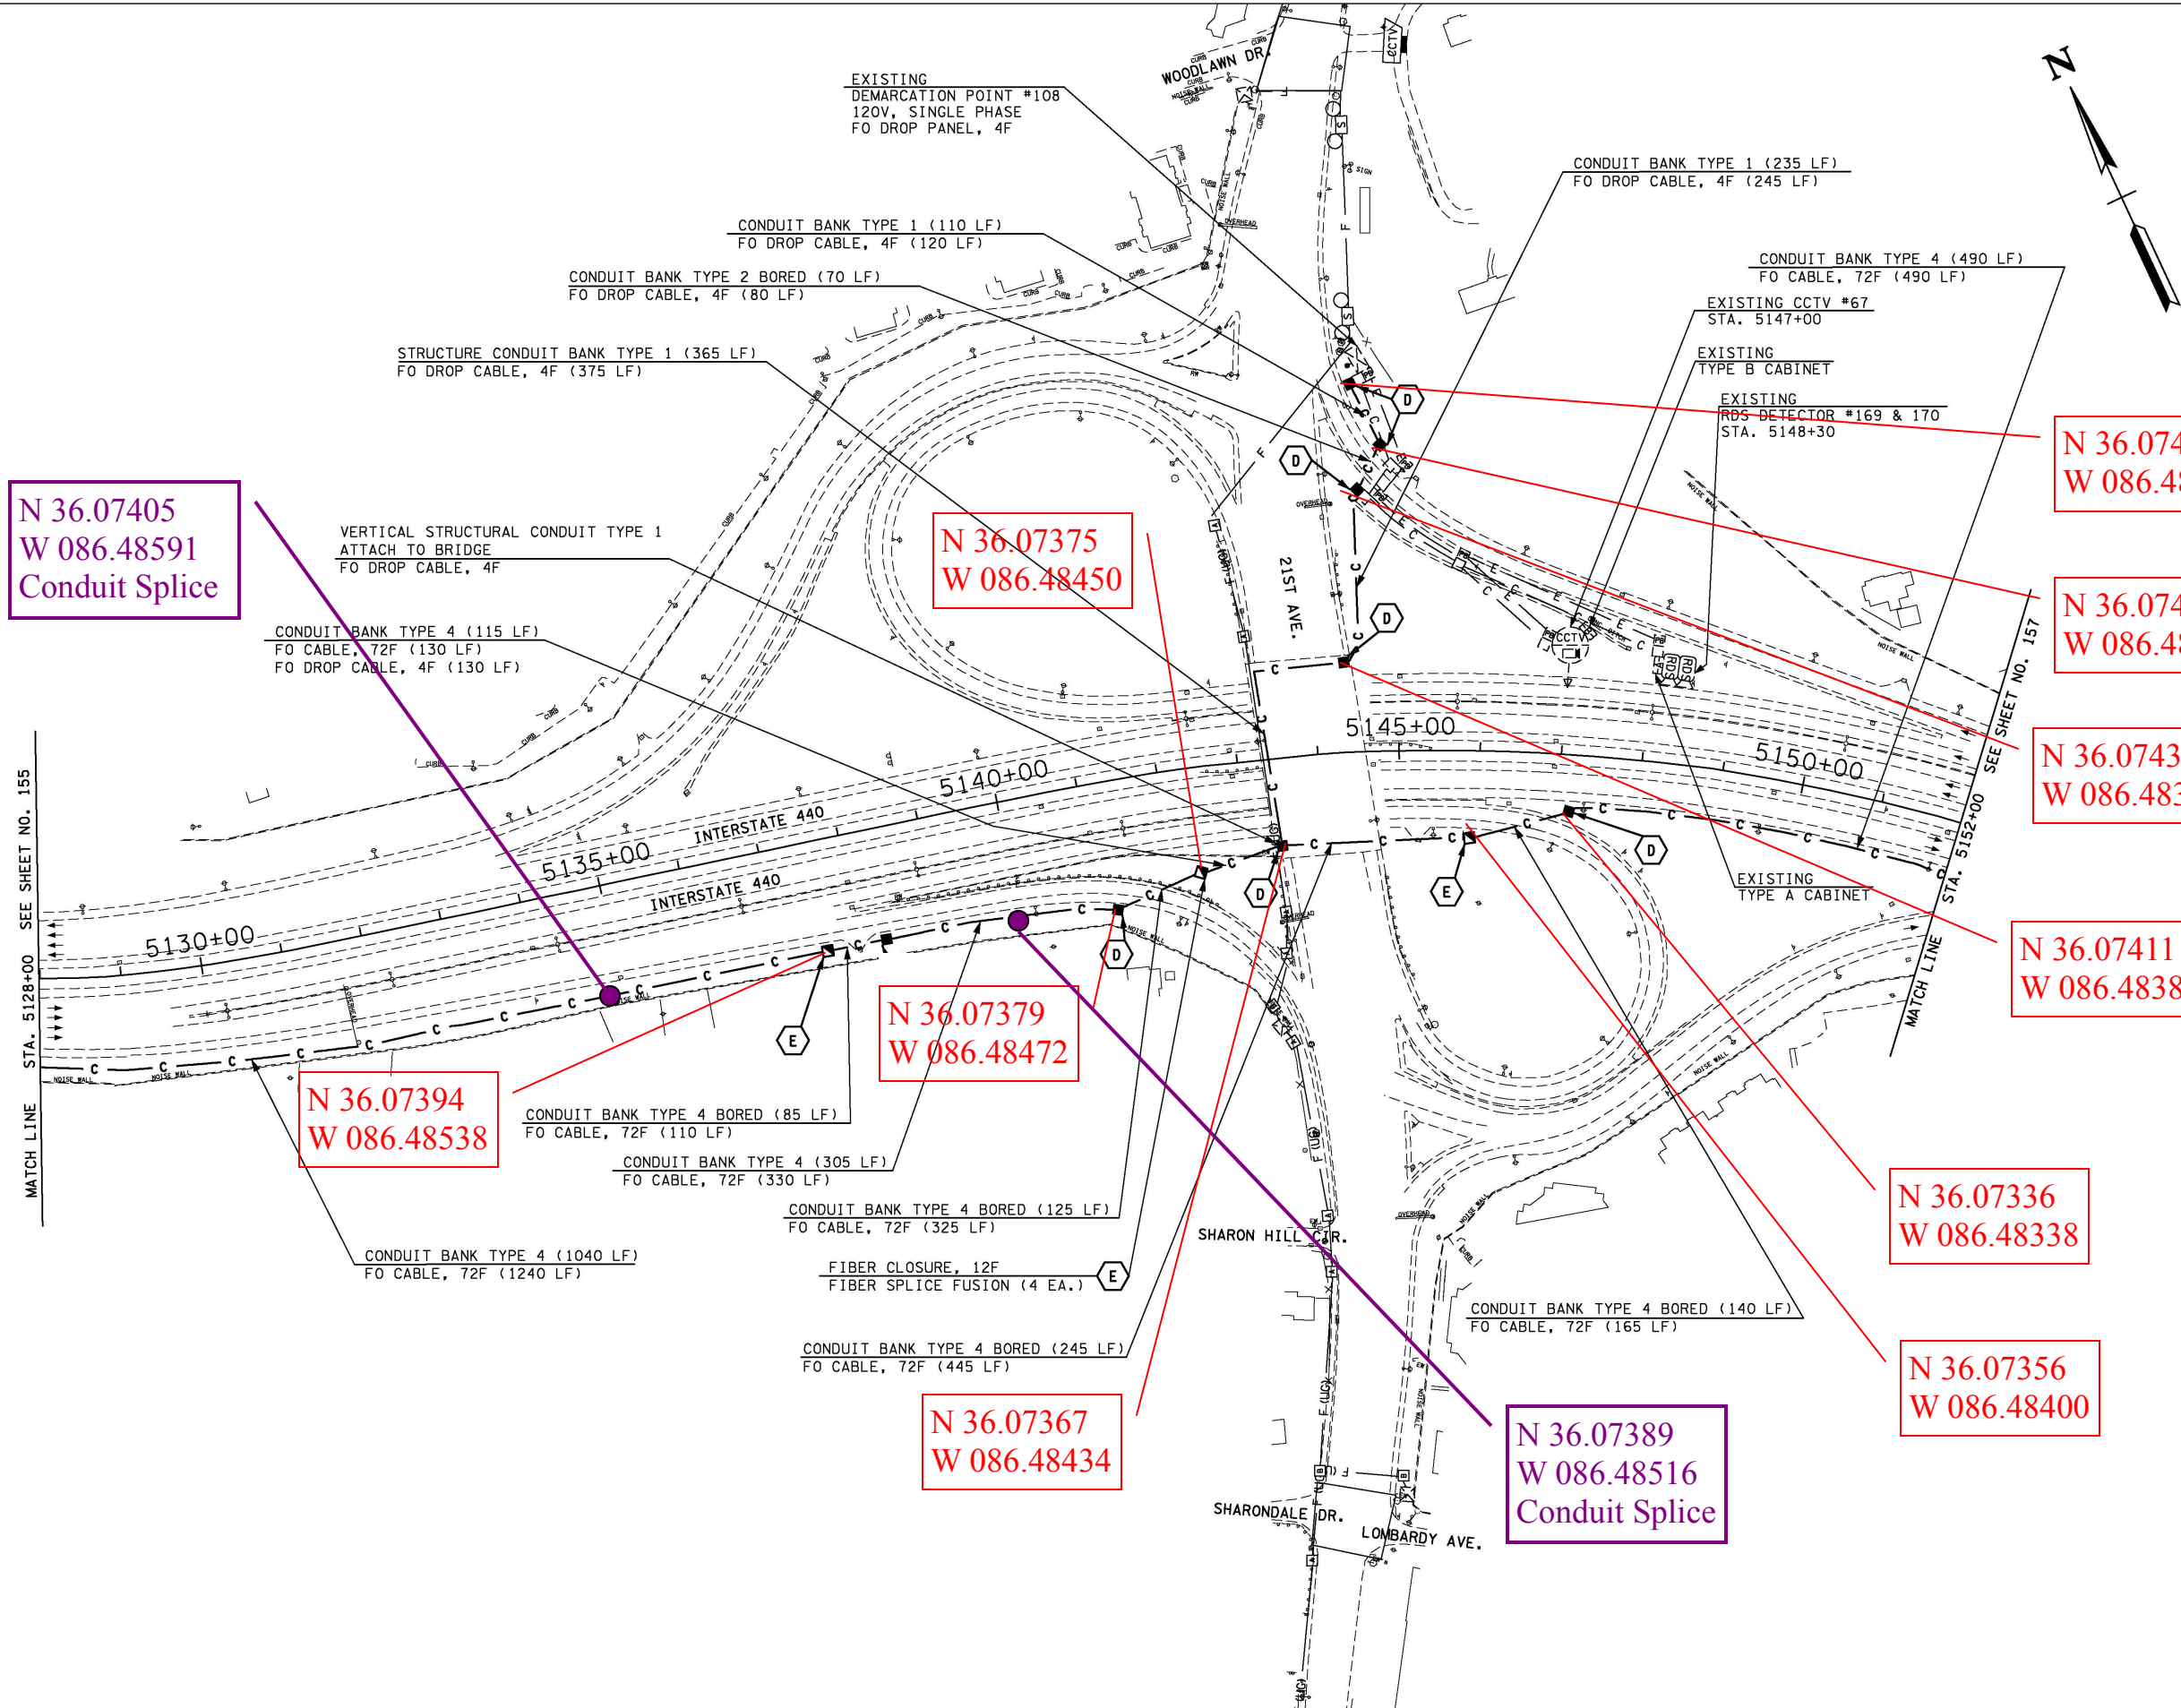

N 36.07405
W 086.48591
Conduit Splice

N 36.07375
W 086.48450

N 36.07463
W 086.48354

N 36.07442
W 086.48359

N 36.07430
W 086.48368

N 36.07411
W 086.48383

N 36.07394
W 086.48538

N 36.07379
W 086.48472

N 36.07336
W 086.48338

N 36.07367
W 086.48434

N 36.07389
W 086.48516
Conduit Splice

N 36.07356
W 086.48400

