


TYPE	YEAR	PROJECT NO.	SHEET NO.
CONST.	2007	CM-098-3(14)	157
As built	2010		

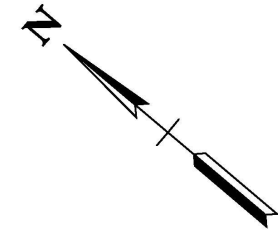

N 36.07291
W 086.48261

N 36.07309
W 086.48284


N 36.07132
W 086.48108

N 36.07101
W 086.48081

deleted and moved

N 36.07121
W 086.48093
Conduit Splice

N 36.07065
W 086.48054

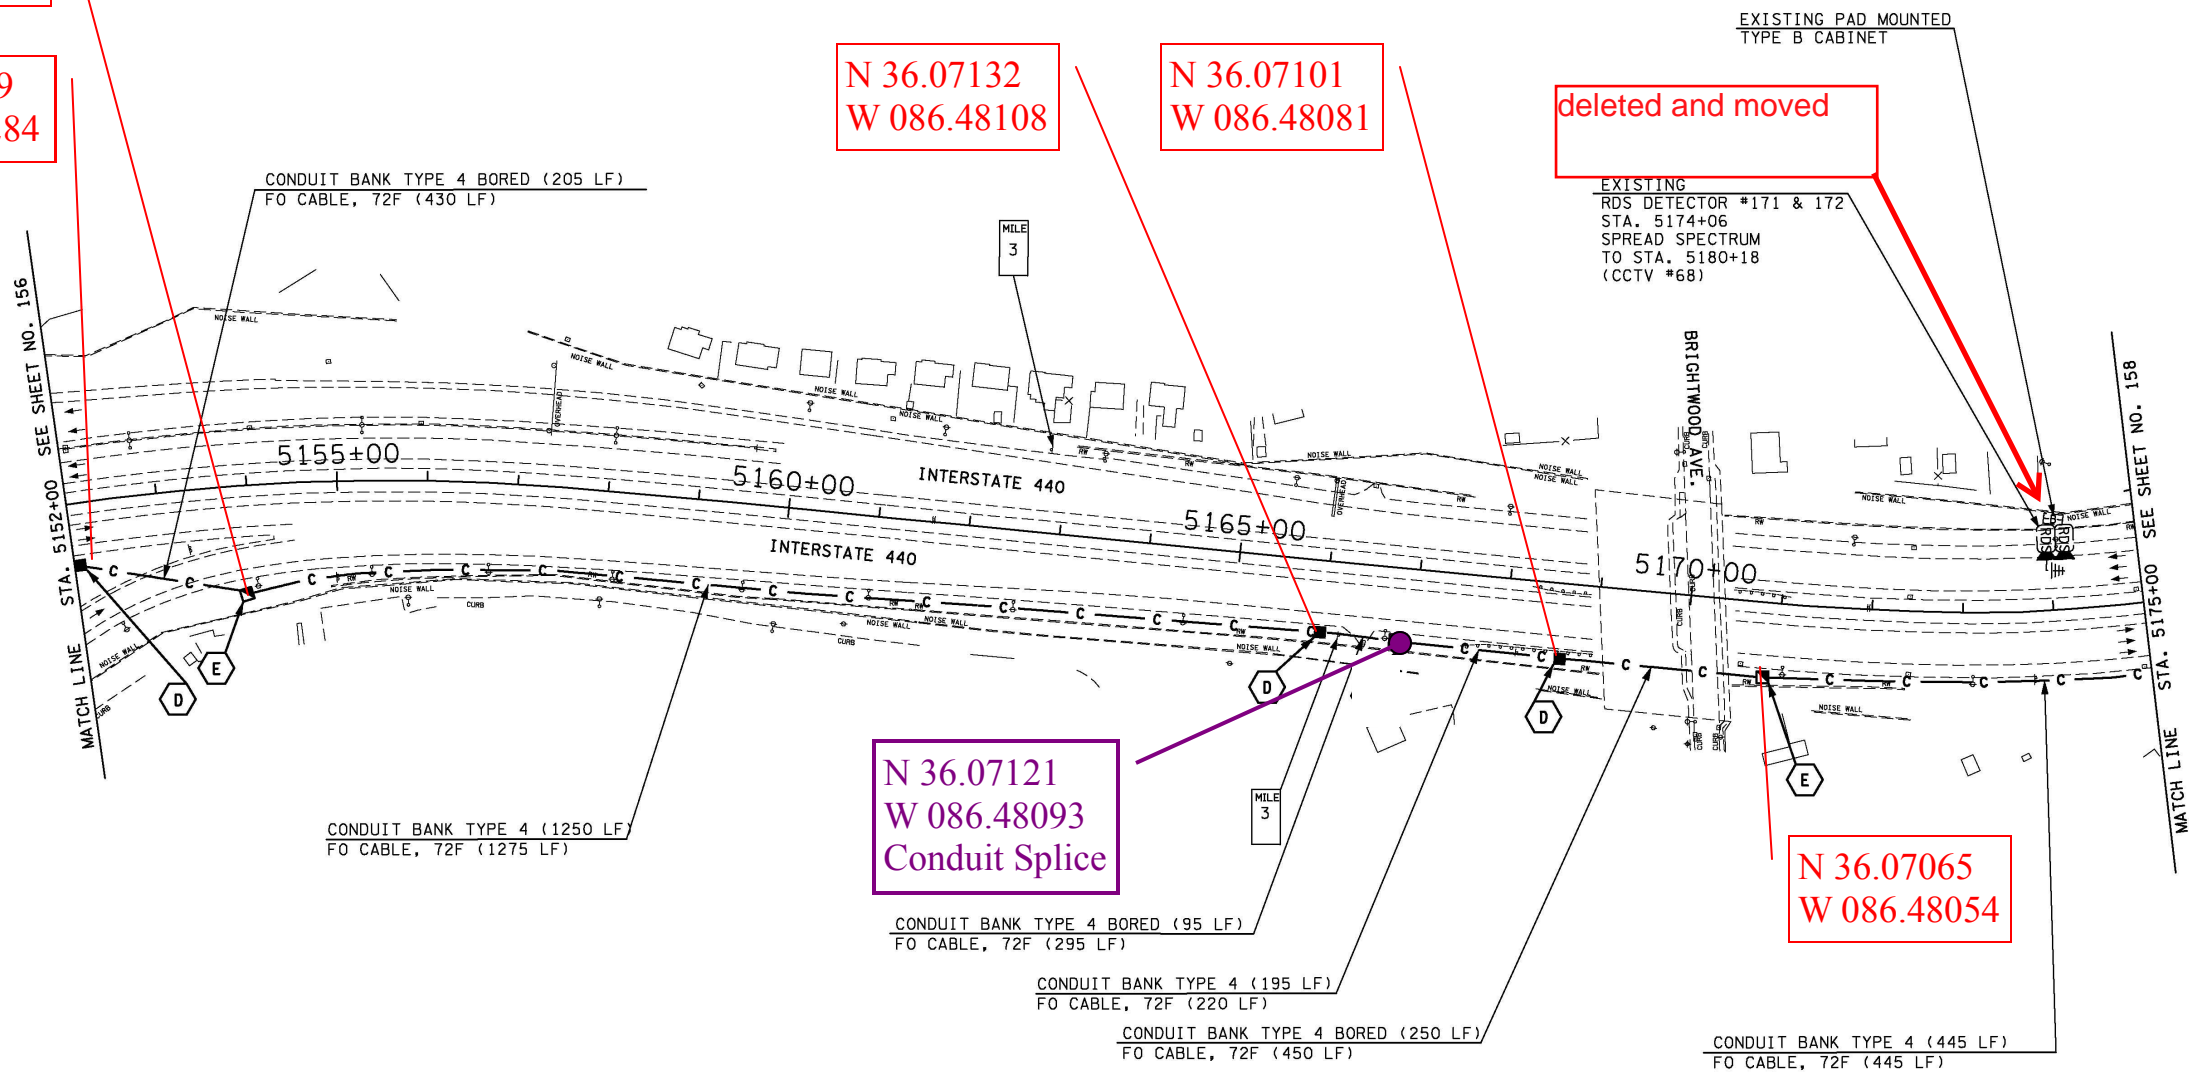

STATE OF TENNESSEE
DEPARTMENT OF TRANSPORTATION

ITS LAYOUT
I-440
STA. 5152+00 TO
STA. 5175+00
SCALE: 1"=100'