




PLAN

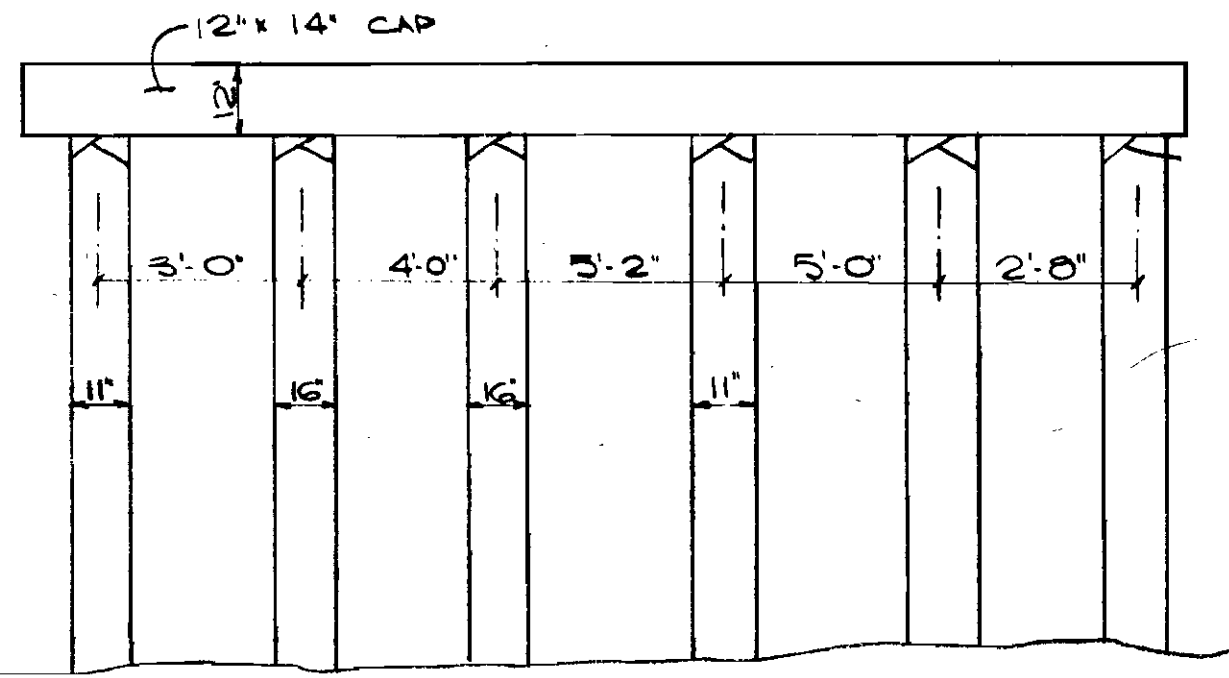

ELEVATION  
BENT # 2

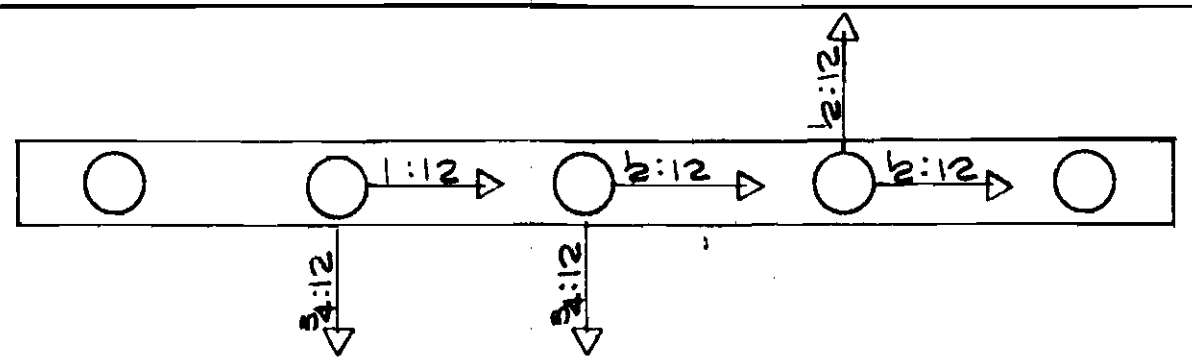

PLAN

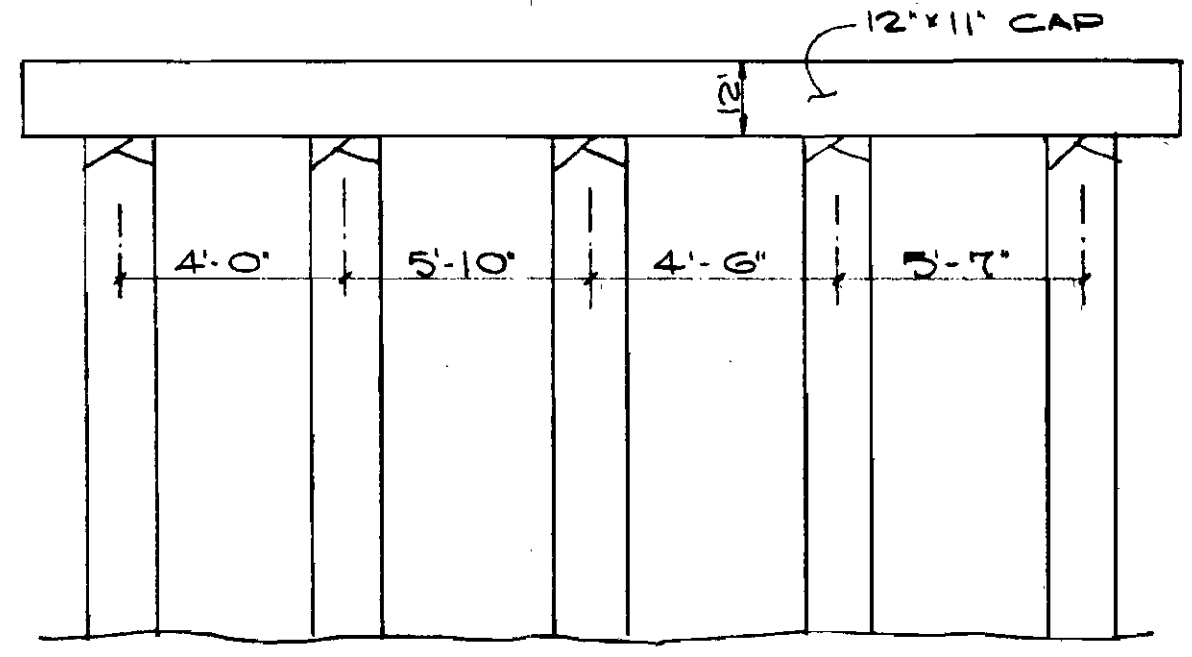


ELEVATION  
BENT # 2A

NOTES:  
 ARROWS IN PLAN INDICATE DIRECTION OF BATTER.  
 ALL CAPS & PILES TREATED TIMBER.  
 PILES COVERED WITH METAL FLASHING.  
 ALL PILES 12' EXCEPT AS NOTED


DRAWN BY: TRR

HARLAND BARTHOLOMEW AND ASSOCIATES  
 PLANNING ENGINEERING LANDSCAPE ARCHITECTURE  
 MEMPHIS, TENNESSEE

BENTS # 2 & # 2A
BRIDGE <u>09-1703-0.68</u>
OVER <u>REEDY CREEK</u>
<u>CARROLL</u> COUNTY

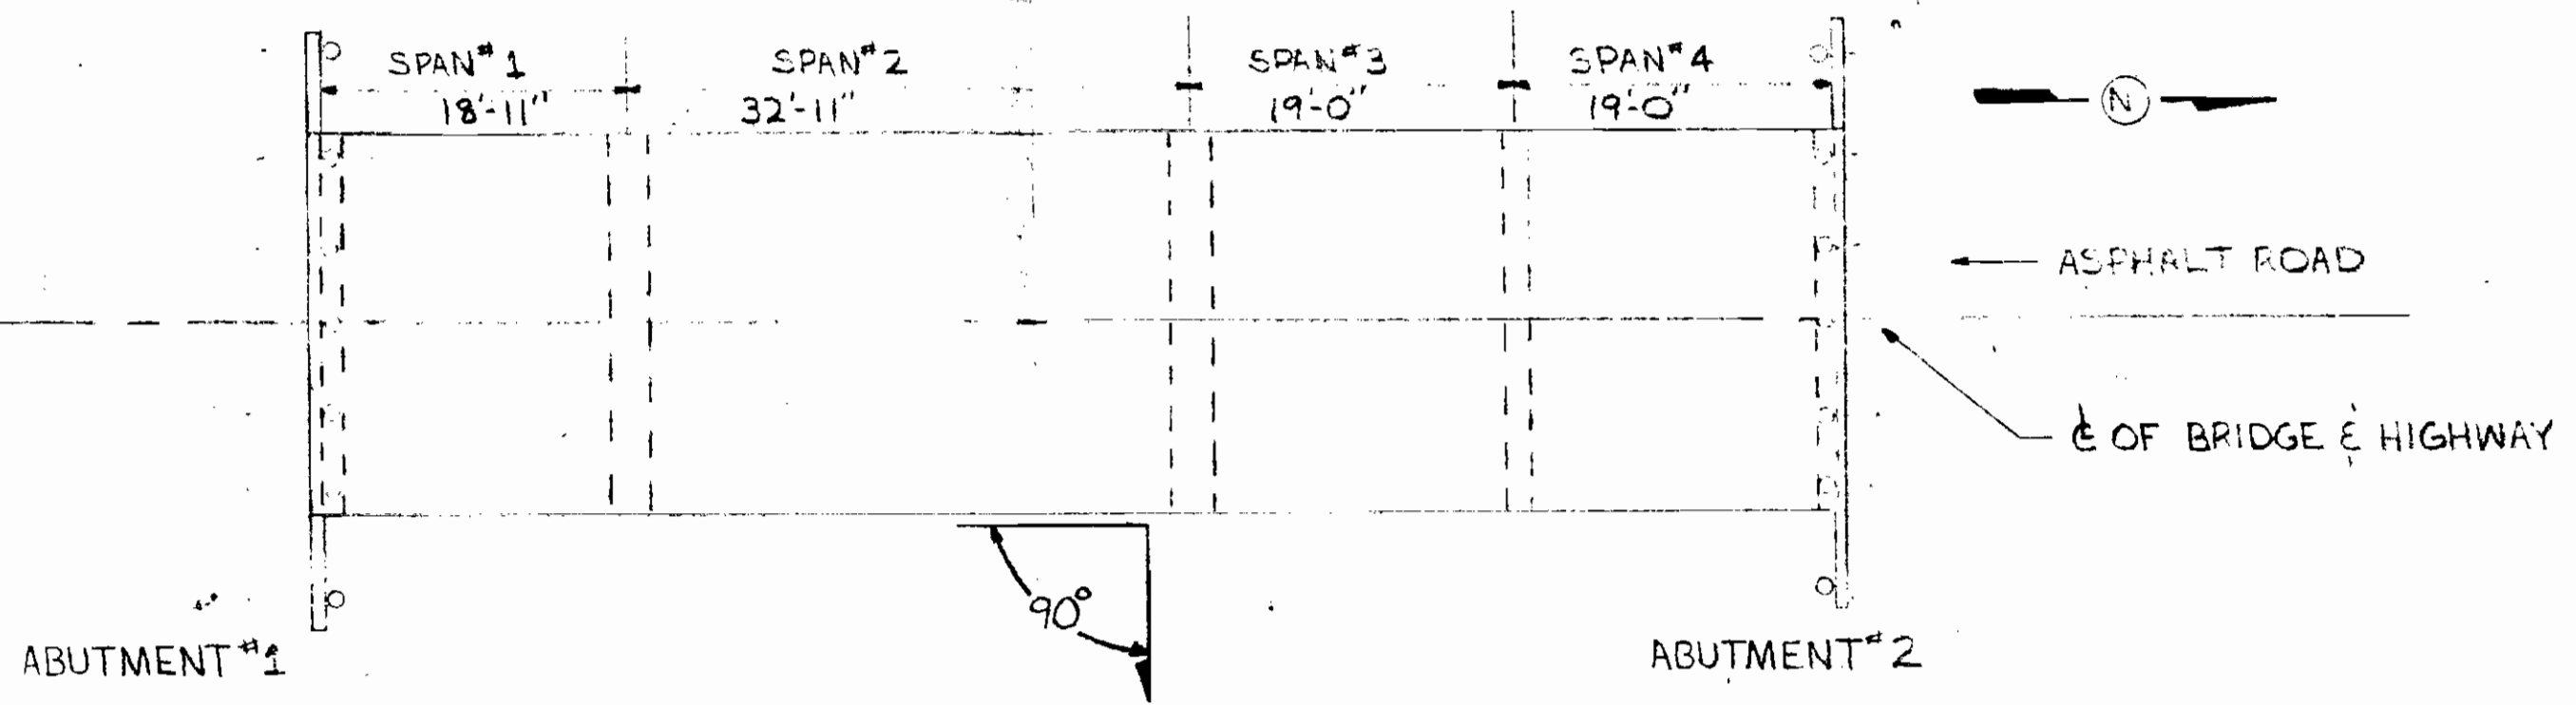

PLAN


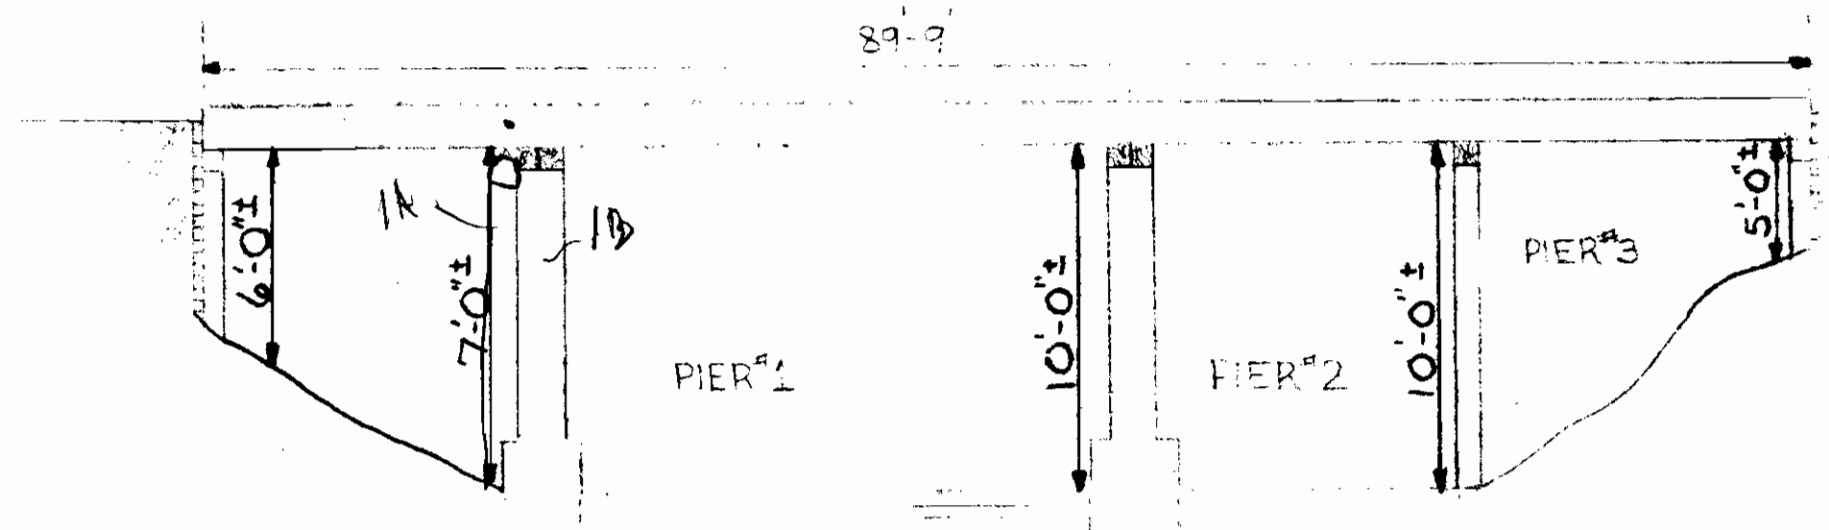


ELEVATION



STATE OF TENNESSEE  
DEPARTMENT OF TRANSPORTATION  
BUREAU OF HIGHWAYS

BRIDGE LAYOUT  
BRIDGE NO. 09-1703-0 & S  
OVER  
CARROLL COUNTY  
DRAWN BY DARRIN GIBSON  
SHEET 1 OF 4

2 1/2 X 8 BACKWALL

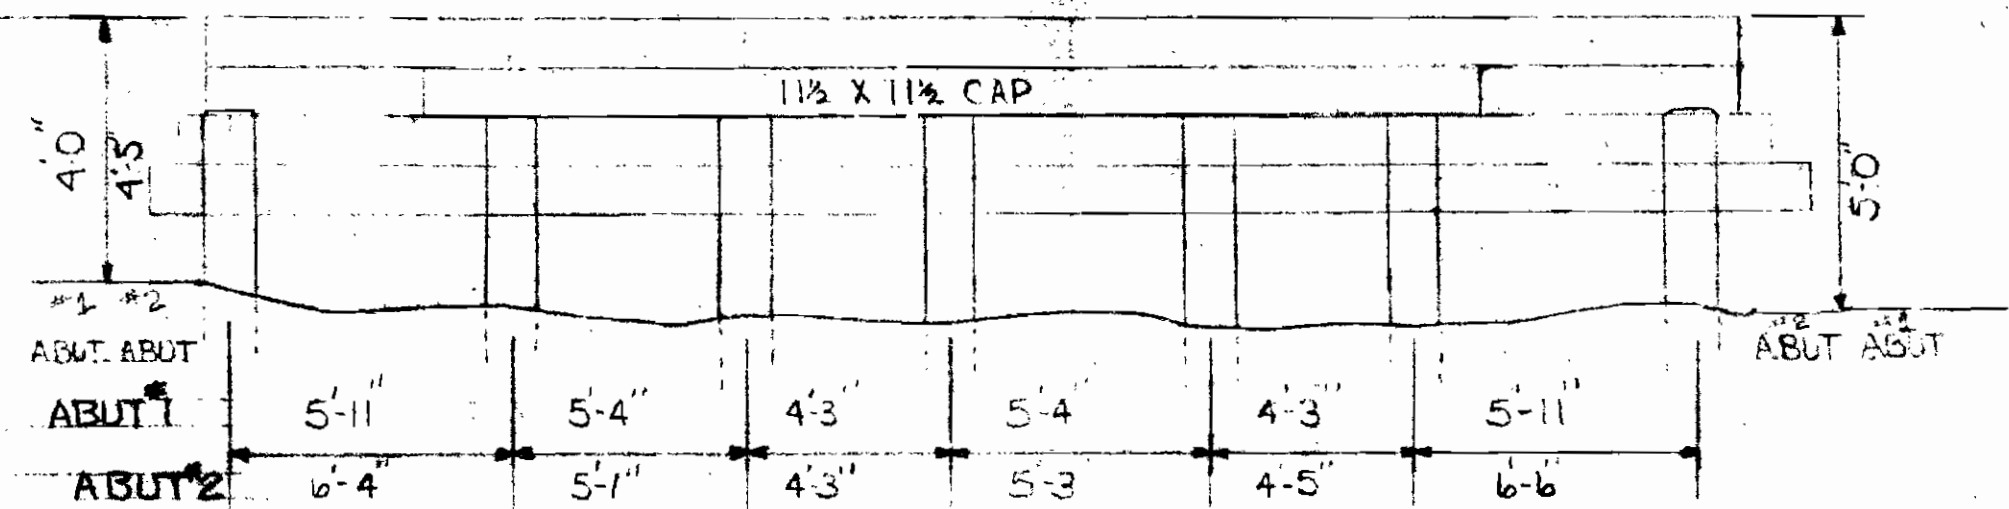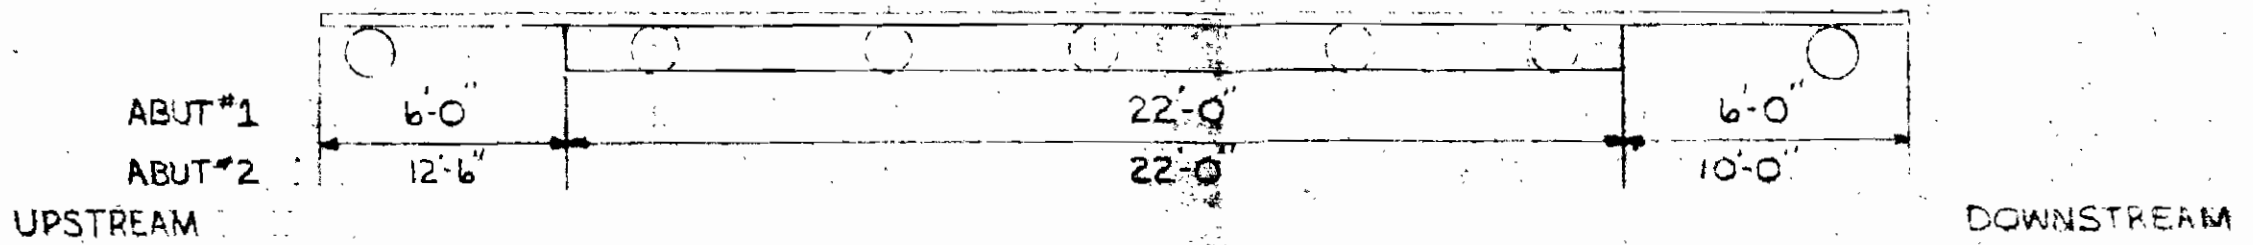

ABUTMENTS # 1 AND 2

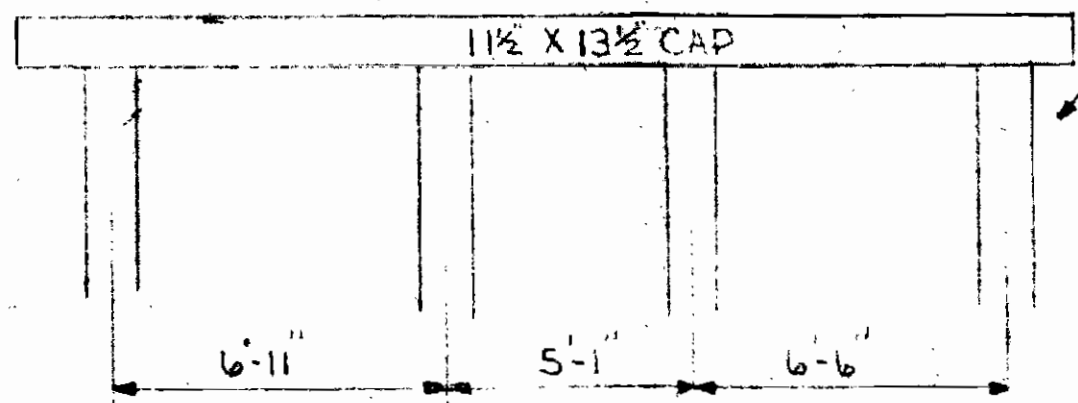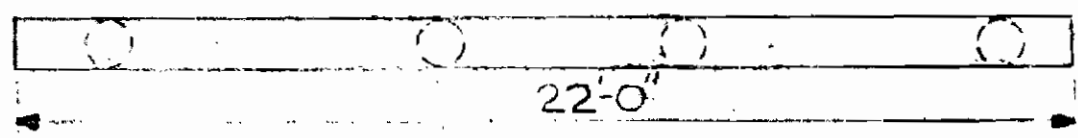



PIER #3

ALL PILES 1'-1" DIA.


CONTINENTAL ENGINEERING, INC.  
MEMPHIS, TENNESSEE

STATE OF TENNESSEE  
DEPARTMENT OF TRANSPORTATION  
BUREAU OF HIGHWAYS

SUBSTRUCTURE  
BRIDGE NO- 09-1703-068  
OVER  
CARROL COUNTY  
DRAWN BY: DARRIEN GIDEON  
SHEET 2 OF 4

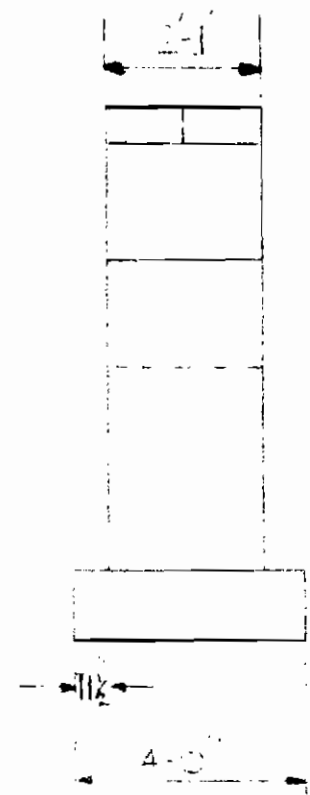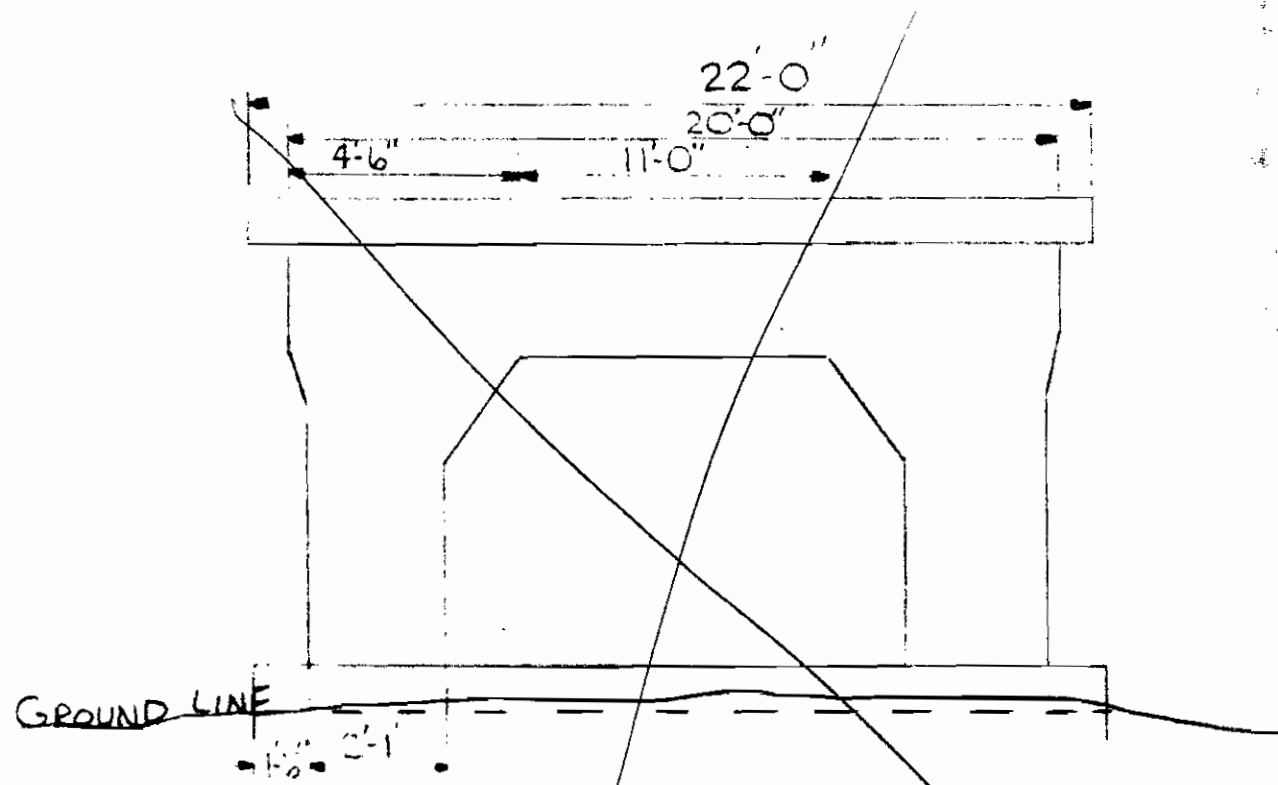

CONCRETE PIERS #1 AND #2

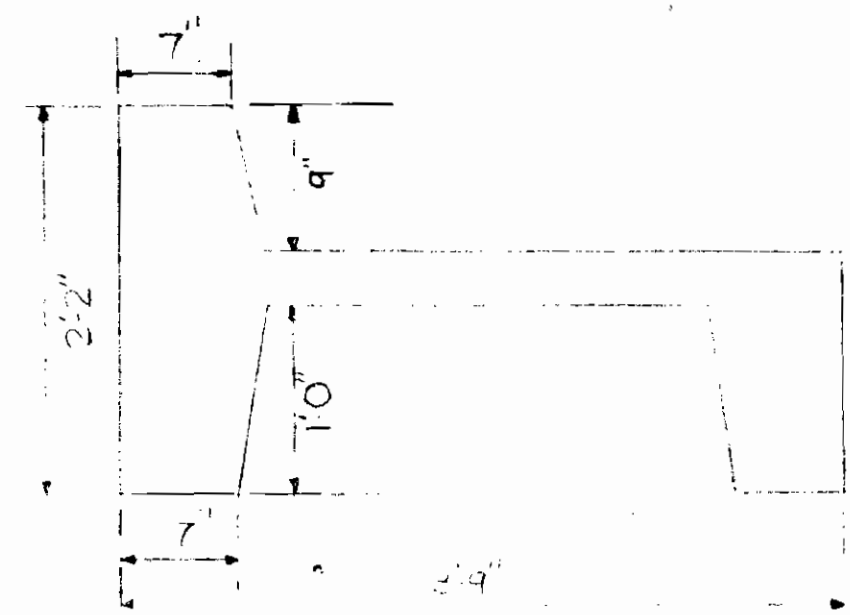

TYPICAL CURB UNIT




TYPICAL INTERIOR UNIT


STATE OF TENNESSEE  
DEPARTMENT OF TRANSPORTATION  
BUREAU OF HIGHWAYS

BRIDGE NO. 1  
A. 1  
1-1 (ROLL) UNIT  
DRAWN BY: D. S. C.  
SHEET 3 OF 4

**CONTINENTAL ENGINEERING, INC.**  
MEMPHIS, TENNESSEE

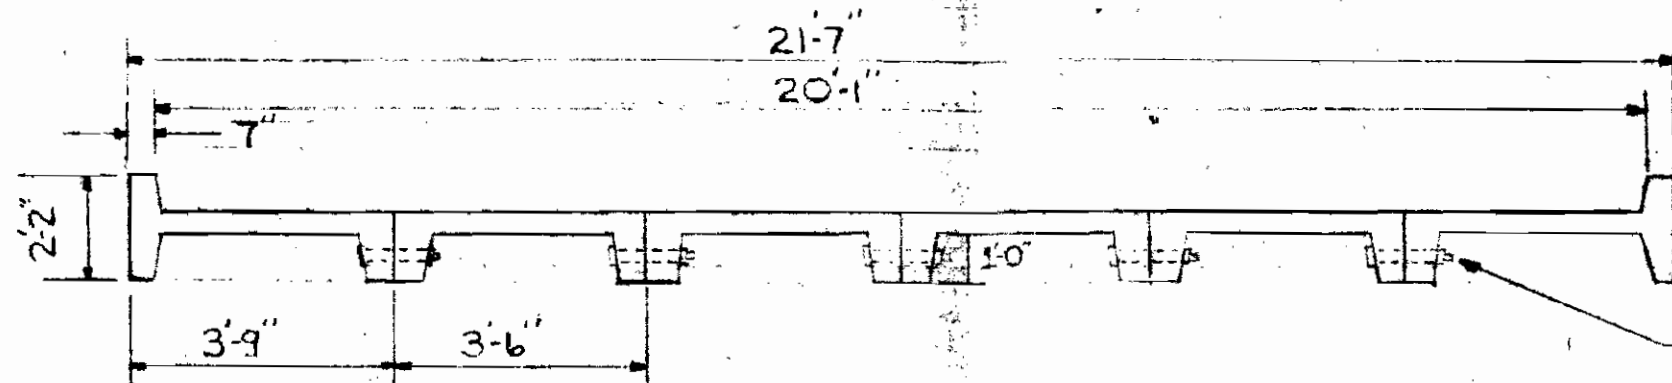

SECTION - SPANS #1, 3 AND 4

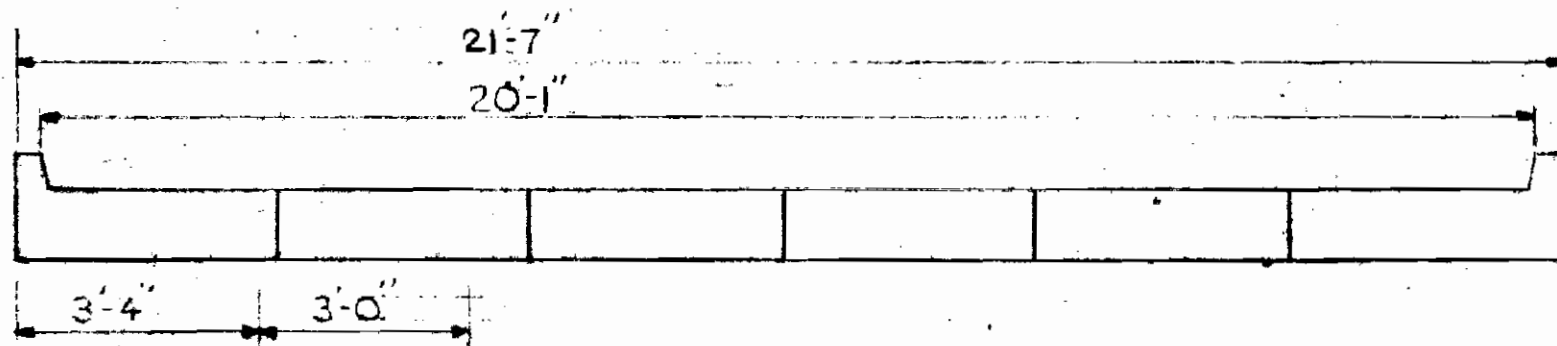

SECTION SPAN #2

STATE OF TENNESSEE  
 DEPARTMENT OF TRANSPORTATION  
 BUREAU OF HIGHWAYS

SECTION  
 BRIDGE NO. 07-113-01  
 OVER  
 CARROLL COUNTY  
 DRAWN BY DANIEL H. B.  
 SHEET 2 OF 2