

PLAN & ELEVATION
BRIDGE <u>24-1542</u> - <u>4.21</u>
OVER <u>BRANCH</u>
<u>FAYETTE</u> COUNTY

DRAWN BY: TRR
 HARLAND B. HOLOMEW AND ASSOCIATES
 PLANNING ENGINEERING LANDSCAPE ARCHITECTURE
 MEMPHIS, TENNESSEE

2:12
ABUT.#1

2:12
ABUT.#1

4:12
ABUT.#2

2:12
ABUT.#2

FILL SLOPE - ABUT.#2
(NO PILE OR BACKWALL EXTENSION)

PLAN
(ARROWS INDICATE DIRECTION OF BATTER)

12" x 12" TIMBER CAP

4 SPA. @ 6'-9" ±

3" x 8" TIMBER
BACKWALL

TOP OF PILE - ABUT.#2

3" x 8" TIMBER SHEETING
BETWEEN THESE PILES ONLY
(ABUT.#1)

INTERSECTION
OF FILL SLOPE AND
BACKWALL - ABUT.#2

NOTE: ALL SUBSTR. TREATED
TIMBER.
ALL PILES 12" NOM.

ELEVATION - ABUT.#1
(ABUT.#2 SIMILAR EXCEPT AS NOTED)

ABUTMENT #1 & #2


BRIDGE 24 - 1542 - 4.21

OVER BRANCH

FAYETTE COUNTY

DRAWN BY: TRR

HARLAND BARTHOLOMEW AND ASSOCIATES
PLANNING ENGINEERING LANDSCAPE ARCHITECTURE
MEMPHIS, TENNESSEE

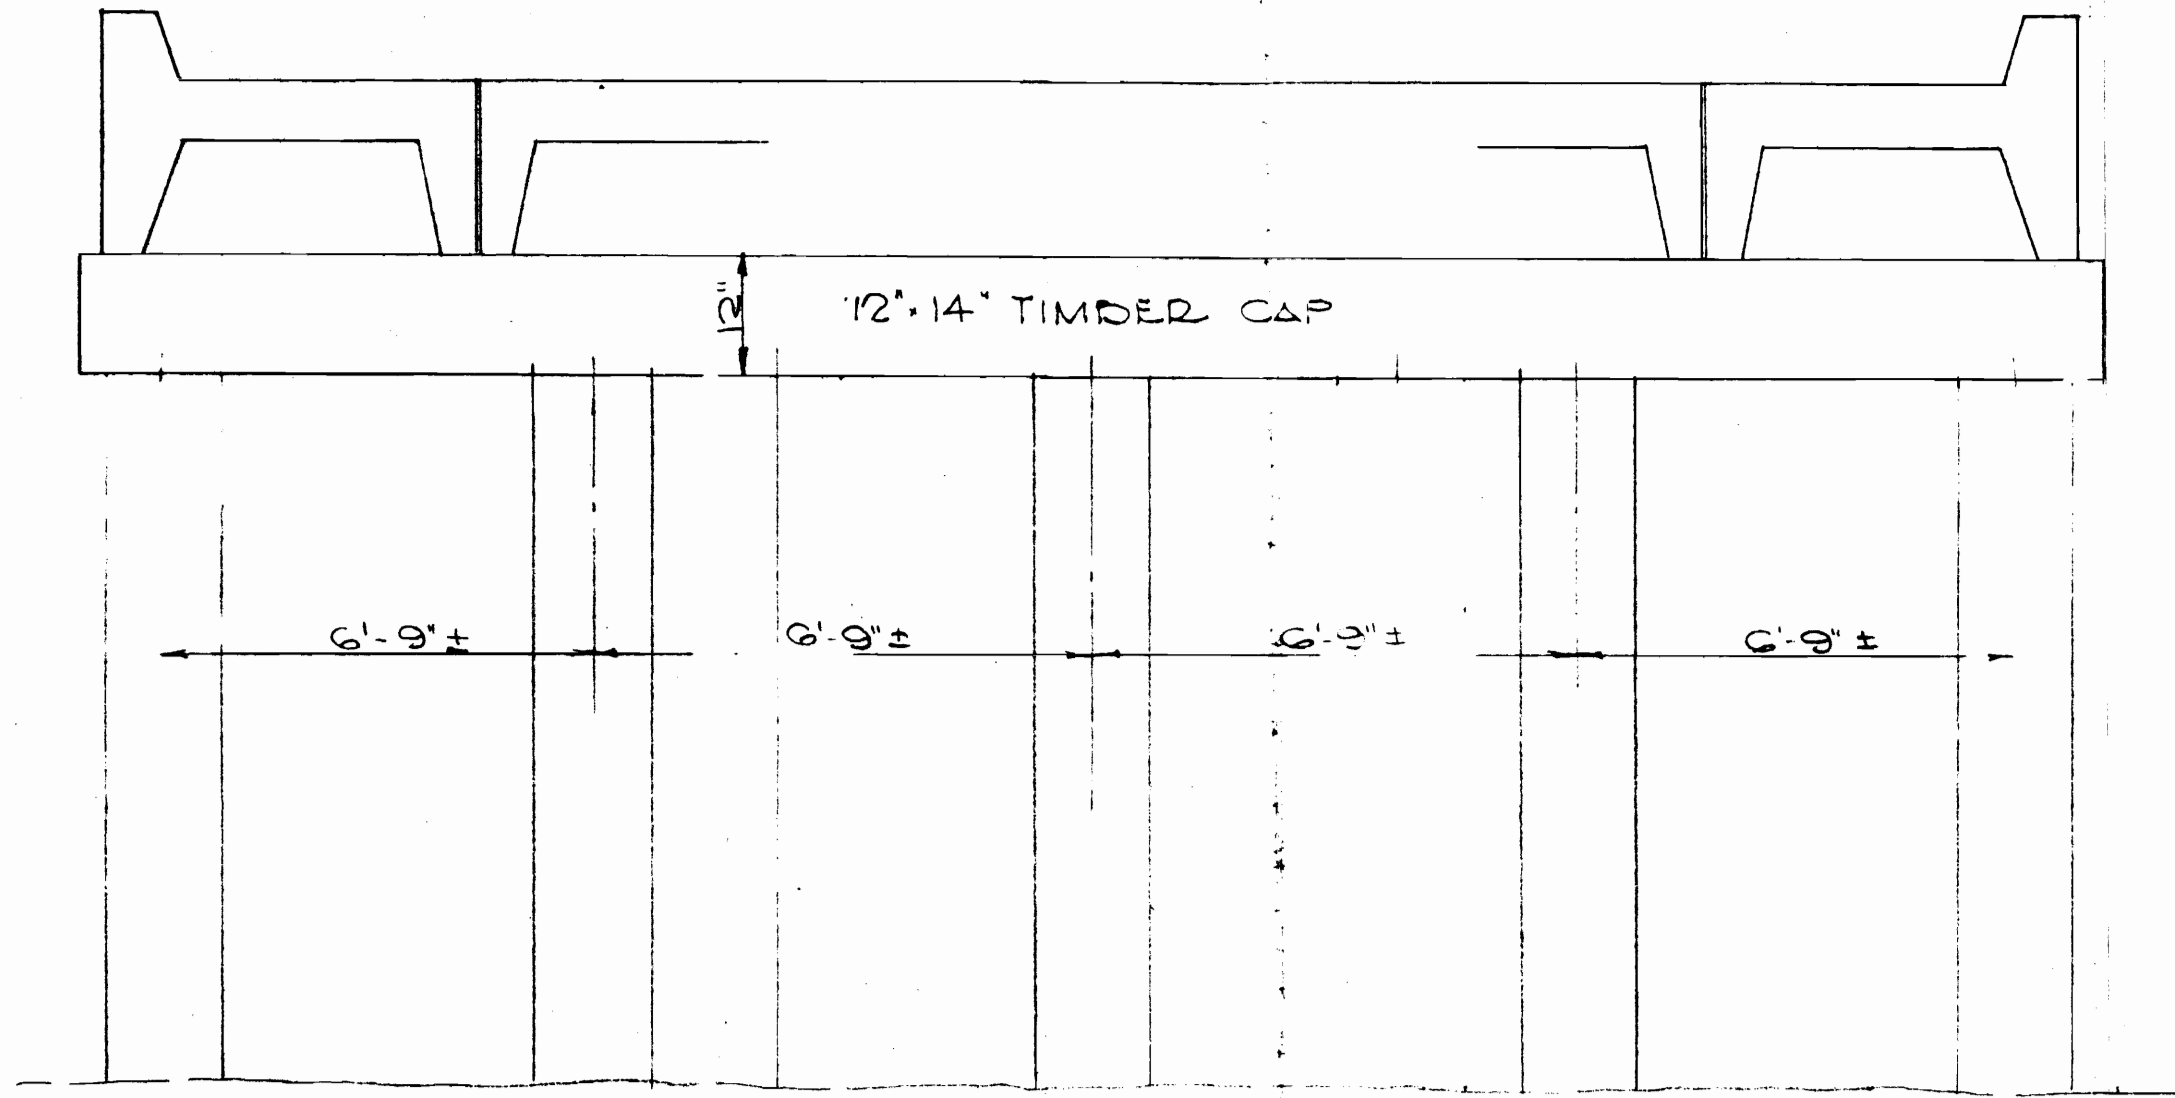

PIER ELEVATION

NOTE: ALL SUBSTR. TIMBER TREATED
 ALL PILES 12" φ NOM.
 ALL PILES VERTICAL

DRAWN BY: TRR

HARLAND BARTHOLOMEW AND ASSOCIATES
 PLANNING ENGINEERING LANDSCAPE ARCHITECTURE
 MEMPHIS, TENNESSEE

PIER # 1
BRIDGE <u>24 - 1542 - 421</u>
OVER <u>BRANCH</u>
<u>FAYETTE</u> COUNTY