

5758194003

STATE OF TENNESSEE
DEPARTMENT OF TRANSPORTATION
DIVISION OF STRUCTURES





LAYOUT SHEET

BRIDGE NO. 57 - 223 - 2.28
CROSSING: BRANCH

COUNTY: MADISON

DRAWN HARDIE
DATE 10 - 11 - 84

REVISION
DATE

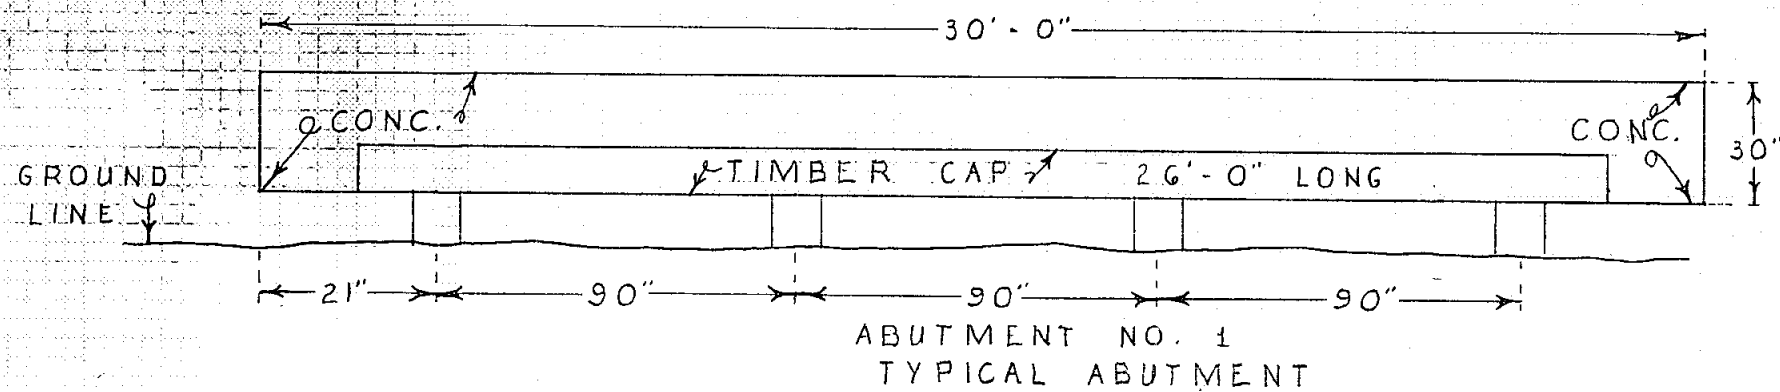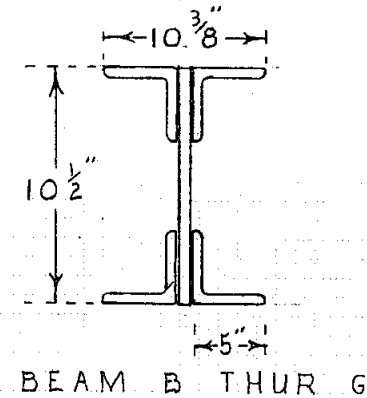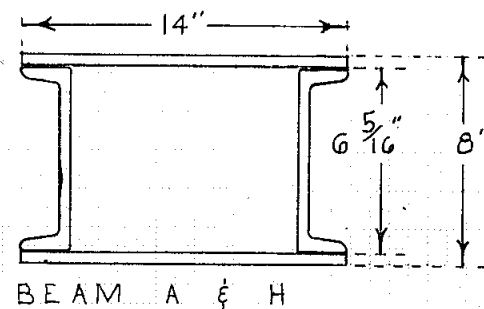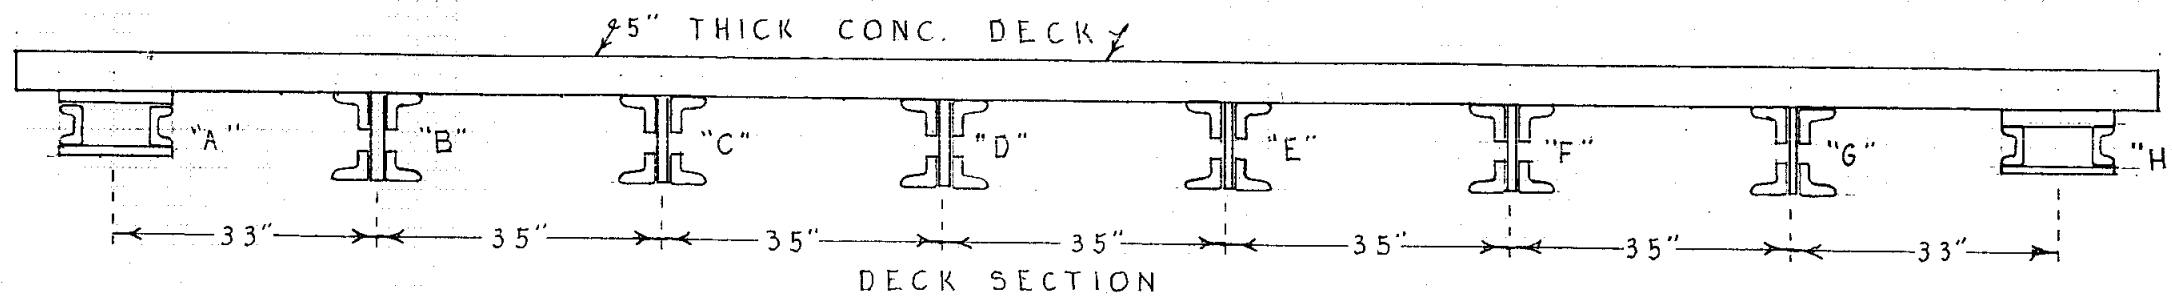

STATE OF TENNESSEE
DEPARTMENT OF TRANSPORTATION
DIVISION OF STRUCTURES

SUPERSTRUCTURE AND
SUBSTRUCTURE DETAIL

BRIDGE NO. 57 - 223 - 2.28
CROSSING: BRANCH

COUNTY: MADISON

DRAWN HARDEE
DATE 10 - 11 - 84

REVISION
DATE