


SHELBY COUNTY

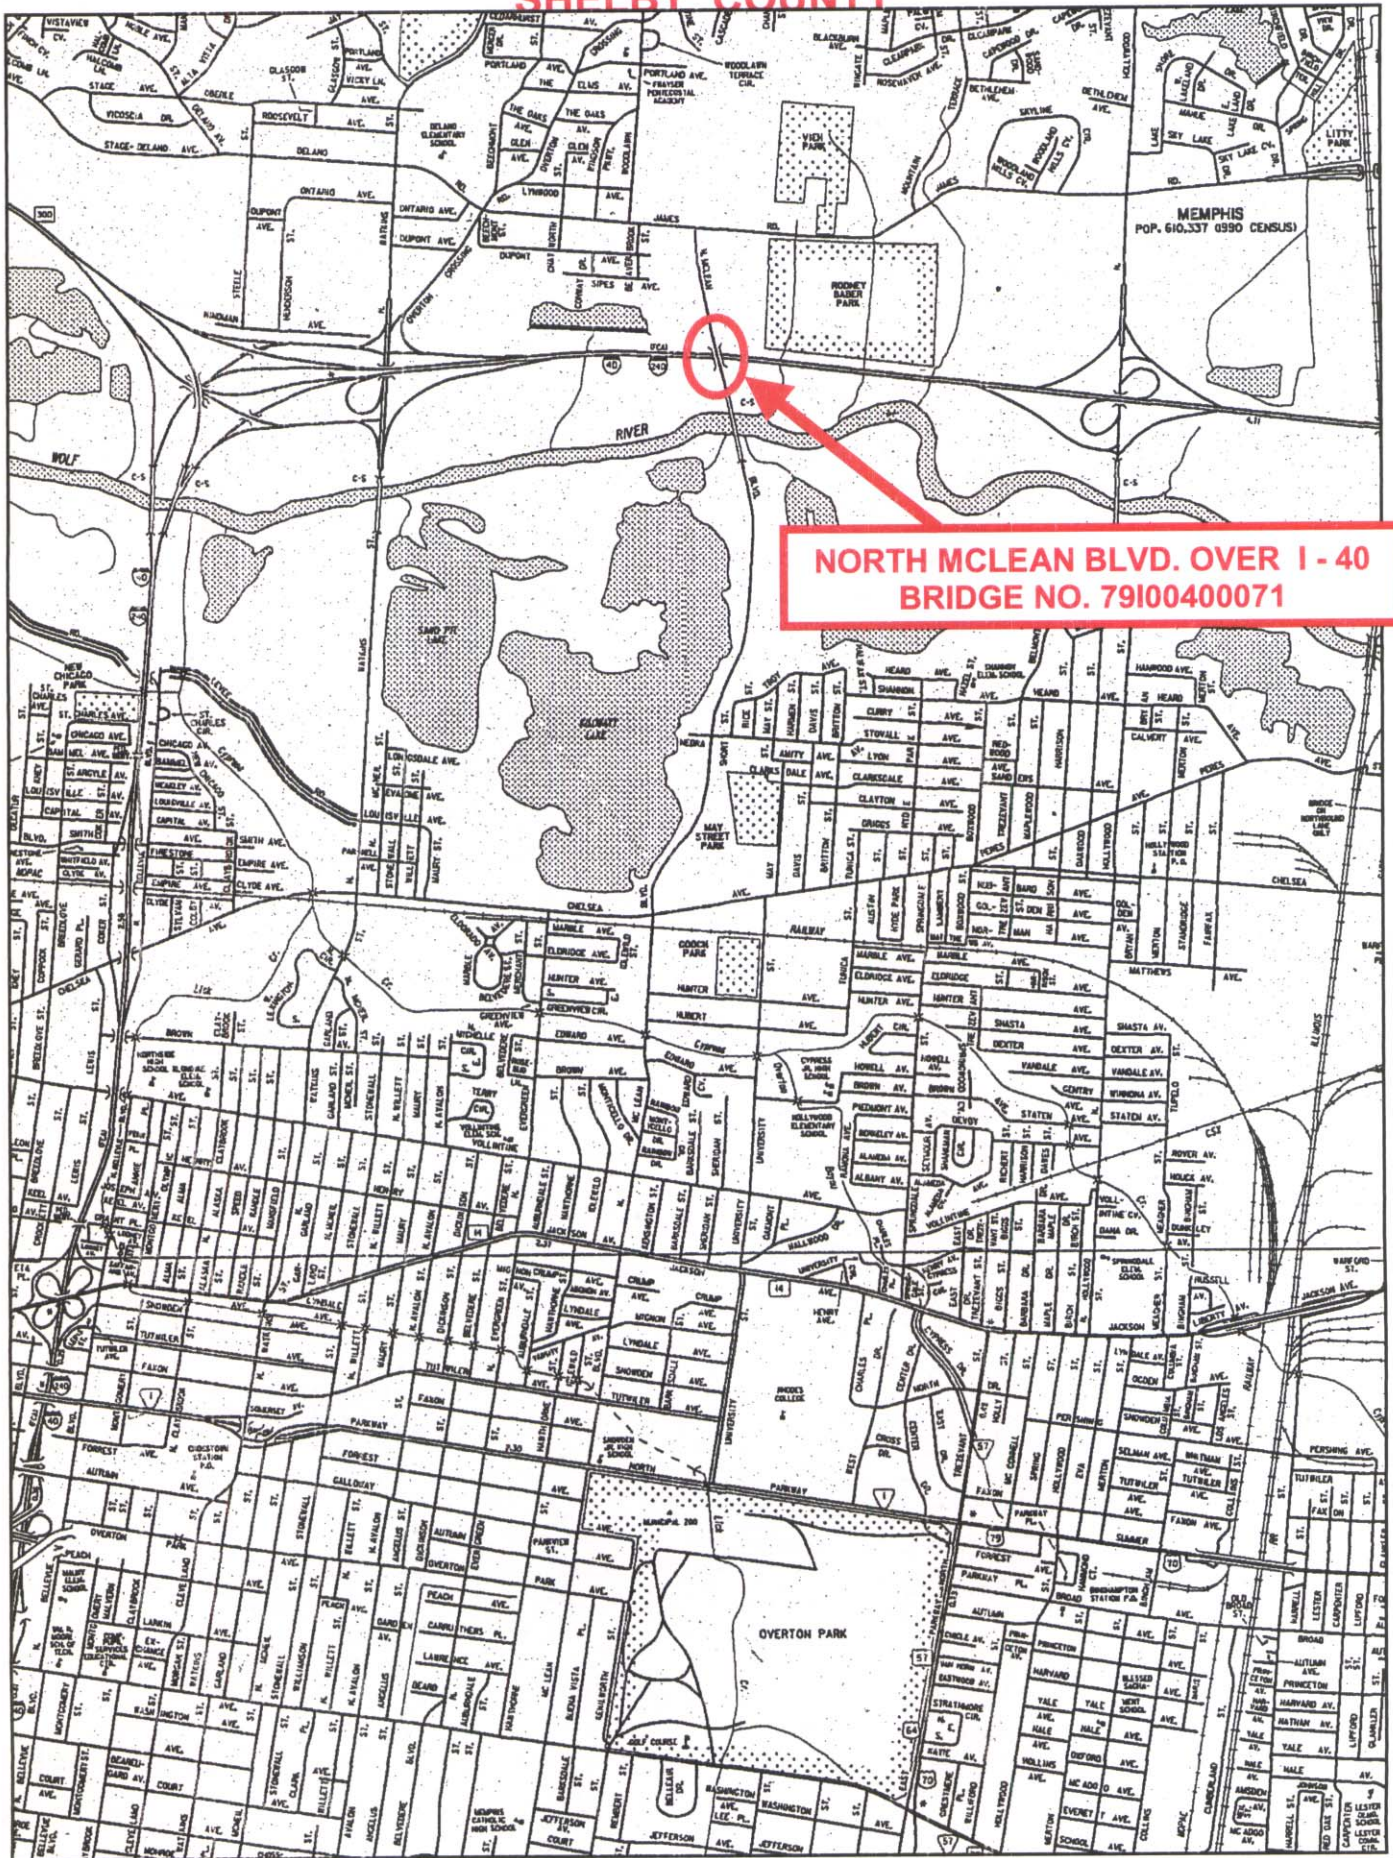

NORTH MCLEAN BLVD. OVER I - 40
BRIDGE NO. 79100400071

CONDITION

41 - Structure Open/Posted/Closed	A - Open, no restriction
58 - Deck	7 - GOOD CONDITION - some minor problems.
59 - Superstructure	7 - GOOD CONDITION - some minor problems.
60 - Substructure	5 - FAIR CONDITION - all primary structural elements are sound but may have minor section loss, cracking, spalling or scour.
61 - Channel/Channel Protection	N - Not applicable.
62 - Culverts	N - Not applicable. Used if structure is not a culvert.
521 - Overall Bridge Cond	F - Fair

Load Rating / Post

548 - Ratings Based On	AASHTOWare BrR (1.5" PMC)
505 - TDOT rating method	LRFR-RF - LOAD & RESISTANCE FACTOR RATING (RF) - HL93
65 - Inventory Rating Method	8 - Load and Resistance Factor Rating (LRFR) rating reported by rating factor (RF) method using HL-93 loadings
66 - Inventory Rating	35.96
NBI_066A	1.11
63 - Operating Rating Method	8 - Load and Resistance Factor Rating (LRFR) rating reported by rating factor (RF) method using HL-93 loadings
64 - Operating Rating	46.33
NBI_064A	1.43
516B - Single Unit Posting	
517B - Multi Unit Posting	
70 - Bridge Posting	5 - Equal to or above legal loads
534 - Posting Log Note	
552 - Posting Closure Comp	

Notes

Wearing Surf. thickness in load rating	1.50
ADTT used in Load rating	5000
547 - evaluation sheet note	

Load Rating Assumptions and QA Checklist - Consultant Calculations

Bridge ID	Bridge Location	
Load Rating Date	Inspection Date	Current ADTT Considered
Plans Set		
Consultant		
	Assumptions	QA
Dimensions match plans & field conditions	<div>REVIEWED By Rebecca Hayworth, P.E. at 2:40 pm, Feb 12, 2024</div>	
Cross section Checked		
Framing plan Checked		
Material Properties Checked		
Condition Assumed for Load rating		
Deterioration/Damage Captured		
Shear Considered		
Rails Distribution		
Asphalt Thickness (inches)	<div>PMC Overlay</div>	
Asphalt Considered Field Verified		
Distribution Factors Calc Method		
Impact Factor		
AASHTO Trucks & TDOT Trucks Rated		
Comments		

Page 1 of 1

Over/Under Pass No. 79 - 02819 - 0518

Bridge Number: 79I00400071

Maint.Resp.: 01 Co.Seq: 01

Barrels	Length	Width
---------	--------	-------

Comments:

Maintenance Completed: by/date

EXPLANATIONS AND COMMENTS:

Bridge Maintenance Recommendations

Page No. _____

Page 1 of 1

Bridge Location No.: **79 - I0040 - 0660**Over/Under Pass No.: **79 - 02819 - 0518**

Co. Route Log Mile

Bridge Number: **79I00400071**

Crossing:

Region: 04

Road Name:

District: 45 Spec. Case: 0

Road Name #2: MCLEAN BLVD.

Maint. Resp.: 01 Co. Seq: 01

Bridge Rating: FAIR

Inspection Cycle: 15

County: Shelby

@ ' x '
Barrels Length Width

Inspection Date: 9/11/01

City:

Comments:

Maintenance Completed
by/date**Maintenance Recommendations:**

228	APPROACH GUARDRAILS ARE SUBSTANDARD
226	GUARDRAIL TERMINALS AT APPROACH NO. 1 & 2 ARE SUBSTANDARD
230	REPAIR APPROACH GUARDRAILS AT APPROACH NO. <u>2</u>
154	REPAIR WINGS AT ABUTMENT NO. <u>1</u>
235	THE TERMINAL(S) FOR THE UNDERPASS APPR. GUARDRAIL IS/ARE SUBSTANDARD

COMPLETION NOTIFICATION: RETURN WITHIN 6 MONTHS OF INSPECTION DATE.

INITIAL AND DATE RECOMMENDATIONS WHEN COMPLETED.

MAINTENANCE ACTIVITIES ARE COMPLETED (DATE) _____ BY _____

MAINTENANCE ACTIVITIES ARE PARTIALLY COMPLETED (DATE) _____ BY _____

MAINTENANCE ACTIVITIES ARE INCOMPLETE, SCHEDULED FOR (DATE) _____

EXPLANATIONS AND COMMENTS:



STATE OF TENNESSEE
DEPARTMENT OF TRANSPORTATION

Bridge Condition Coding Form

Revised 09/12/2001

Bridge Number: 79I004000711
(Includes Item 5A)

Feature Intersected: N. MCLEAN BLVD / I40

County: 79
Route: 02819
Special Case: 0
County Sequence: 01
Log Mile: 5.18

CODE ONLY THOSE VALUES WHICH HAVE CHANGED

ITEM #	DESCRIPTION	VALUE	CONDITION CODING GUIDELINES (Values for Coding Items 58, 59, 60 and 62)
90	INSPECTION DATE	<u>09/11/2001</u> <u>8/11/2003</u>	N NOT APPLICABLE
10	MINIMUM V.C. OVER DECK (ROADWAY + SHOULDERS)	99 FT. 99 IN. _____ FT. _____ IN.	9 EXCELLENT CONDITION
520	MINIMUM V.C. OVER DECK (EXCLUDES SHOULDERS)	99 FT. 99 IN. _____ FT. _____ IN.	8 VERY GOOD CONDITION - NO PROBLEMS NOTED. 7 GOOD CONDITION - SOME MINOR PROBLEMS. 6 SATISFACTORY CONDITION - MINOR DETERIORATION OF STRUCTURAL ELEMENTS.
36	TRAFFIC SAFETY FEATURES		
	Br. Rail Trans. Appr. Rail Terminal SPEED LIMIT		5 FAIR CONDITION - ALL PRIMARY STRUCTURAL ELEMENTS ARE SOUND BUT MAY HAVE MINOR SECTION LOSS, CRACKING, SPALLING OR SCOUR.
	<u>1</u> 0 0 0 50		
41	STRC OPEN/CLOSED/POSTED	A A K P	4 POOR CONDITION - ADVANCED SECTION LOSS, DETERIORATION, SPALLING OR SCOUR.
58	DECK	7	3 SERIOUS CONDITION - LOSS OF SECTION, DETERIORATION, SPALLING OR SCOUR HAVE SERIOUSLY AFFECTED PRIMARY STRUCTURAL COMPONENTS. LOCAL FAILURES ARE POSSIBLE. FATIGUE CRACKS IN STEEL OR SHEAR CRACKS IN CONCRETE MAY BE PRESENT.
59	SUPERSTRUCTURE	7	
60	SUBSTRUCTURE	5	
61	CHANL/CHANL PROTECTION	N	2 CRITICAL CONDITION - ADVANCED DETERIORATION OF PRIMARY STRUCTURAL ELEMENTS. FATIGUE CRACKS IN STEEL OR SHEAR CRACKS IN CONCRETE MAY BE PRESENT OR SCOUR MAY HAVE REMOVED SUBSTRUCTURE SUPPORT. UNLESS CLOSELY MONITORED IT MAY BE NECESSARY TO CLOSE THE BRIDGE UNTIL CORRECTIVE ACTION IS TAKEN.
62	CULVERT AND RETAIN WALL	N	
71	WATERWAY ADEQUACY	N	
72	APPROACH RDWY ALIGNMENT (USE VALUES OF 3, 6, OR 8)	8	1 "IMMINENT" FAILURE CONDITION - MAJOR DETERIORATION OR SECTION LOSS PRESENT IN CRITICAL STRUCTURAL COMPONENTS OR OBVIOUS VERTICAL OR HORIZONTAL MOVEMENT AFFECTING STRUCTURAL STABILITY. BRIDGE IS CLOSED TO TRAFFIC BUT CORRECTIVE ACTION MAY PUT BACK IN LIGHT SERVICE.
521	OVERALL CONDITION (Circle One)		
	GOOD <u>FAIR</u> POOR CRITICAL		

TEAM LEADER SIGNATURE

8/11/2003
REVIEW DATE

0 FAILED CONDITION - OUT OF SERVICE AND BEYOND CORRECTIVE ACTION.



STATE OF TENNESSEE
DEPARTMENT OF TRANSPORTATION

Underpass Condition Coding Form

Revised 09/21/2001

Bridge Number: 79I004000712
(Includes Item 5A)

Feature Intersected: N. MCLEAN BLVD / I40

County: 79
Route: I0040
Special Case: 0
County Sequence: 01
Log Mile: 6.60

CODE ONLY THOSE VALUES WHICH HAVE CHANGED

ITEM #	DESCRIPTION	VALUE	UNDERPASS SAFETY FEATURES
90	INSPECTION DATE	<u>09/11/2001</u> <u>8/11/2003</u>	515 (A) TYPE UNDERPASS BARRIER Metal Barrier or Rail
10	MINIMUM V.C. OVER ROADWAY (ROADWAY + SHOULDERS)	16 FT. 11 IN. ____ FT. ____ IN.	Revised Barrier Type
520	MINIMUM V.C. OVER ROADWAY (EXCLUDES SHOULDERS)	16 FT. 11 IN. ____ FT. ____ IN.	(B) ADEQUACY OF BARRIER OR RAIL 1
47	TOTAL HORIZONTAL UNDERCLEARANCE	99 FT. 99 IN. <u>90</u> FT. <u>0</u> IN.	(C) ADEQUACY OF TRANSITIONS 1
54	MINIMUM VERTICAL UNDERCLEARANCE (EXCLUDES SHOULDERS)	Circle One: <u>H</u> R ____ FT. ____ IN.	(D) ADEQUACY OF TERMINALS 1
55	MINIMUM LATERAL UNDERCLEARANCE ON RIGHT SIDE Circle One: <u>H</u> R	<u>10</u> FT. <u>0</u> IN.	554 VERTICAL CLEARANCE LISTED ON HEIGHT POSTING 99 FT. 99 IN.
56	MINIMUM LATERAL UNDERCLEARANCE ON LEFT SIDE	<u>30</u> FT. <u>0</u> IN.	____ FT. ____ IN.
521	OVERALL CONDITION (Circle One) GOOD <u>FAIR</u> POOR CRITICAL	HEIGHT POSTED AT BOTH APPROACHES?	YES [] NO <input checked="" type="checkbox"/> N/A []

555 COMMENTS _____

TEAM LEADER SIGNATURE

8/11/2003
REVIEW DATE



STATE OF TENNESSEE
DEPARTMENT OF TRANSPORTATION

Bridge Condition Coding Form

Revised 06/15/2000

Bridge Number: 79I004000711
(Includes Item 5A)

Feature Intersected: N. MCLEAN BLVD / 140

County: 79

Route: 02819

Special Case: 0

County Sequence: 01

Log Mile: 5.18

CODE ONLY THOSE VALUES WHICH HAVE CHANGED

ITEM #	DESCRIPTION	VALUE	CONDITION CODING GUIDELINES (Values for Coding Items 58, 59, 60 and 62)
90	INSPECTION DATE	<u>01/19/2000</u> <u>9/11/2001</u>	N NOT APPLICABLE
10	MINIMUM V.C. OVER DECK (ROADWAY + SHOULDERS)	99 FT. 99 IN. ____ FT. ____ IN.	9 EXCELLENT CONDITION
520	MINIMUM V.C. OVER DECK (EXCLUDES SHOULDERS)	99 FT. 99 IN. ____ FT. ____ IN.	8 VERY GOOD CONDITION - NO PROBLEMS NOTED.
36	TRAFFIC SAFETY FEATURES		7 GOOD CONDITION - SOME MINOR PROBLEMS.
	Br. Rail Trans. Appr. Rail Appr. Rail Ends		6 SATISFACTORY CONDITION - MINOR DETERIORATION OF STRUCTURAL ELEMENTS.
	<u>0</u> <u>0</u> <u>0</u> <u>0</u>		5 FAIR CONDITION - ALL PRIMARY STRUCTURAL ELEMENTS ARE SOUND BUT MAY HAVE MINOR SECTION LOSS, CRACKING, SPALLING OR SCOUR.
41	STRC OPEN/CLOSED/POSTED A K P	A	4 POOR CONDITION - ADVANCED SECTION LOSS, DETERIORATION, SPALLING OR SCOUR.
58	DECK	<u>6</u> <u>7</u>	3 SERIOUS CONDITION - LOSS OF SECTION, DETERIORATION, SPALLING OR SCOUR HAVE SERIOUSLY AFFECTED PRIMARY STRUCTURAL COMPONENTS. LOCAL FAILURES ARE POSSIBLE. FATIGUE CRACKS IN STEEL OR SHEAR CRACKS IN CONCRETE MAY BE PRESENT.
59	SUPERSTRUCTURE	7	2 CRITICAL CONDITION - ADVANCED DETERIORATION OF PRIMARY STRUCTURAL ELEMENTS. FATIGUE CRACKS IN STEEL OR SHEAR CRACKS IN CONCRETE MAY BE PRESENT OR SCOUR MAY HAVE REMOVED SUBSTRUCTURE SUPPORT. UNLESS CLOSELY MONITORED IT MAY BE NECESSARY TO CLOSE THE BRIDGE UNTIL CORRECTIVE ACTION IS TAKEN.
60	SUBSTRUCTURE	5	1 "IMMINENT" FAILURE CONDITION - MAJOR DETERIORATION OR SECTION LOSS PRESENT IN CRITICAL STRUCTURAL COMPONENTS OR OBVIOUS VERTICAL OR HORIZONTAL MOVEMENT AFFECTING STRUCTURAL STABILITY. BRIDGE IS CLOSED TO TRAFFIC BUT CORRECTIVE ACTION MAY PUT BACK IN LIGHT SERVICE.
61	CHANL/CHANL PROTECTION	N	0 FAILED CONDITION - OUT OF SERVICE AND BEYOND CORRECTIVE ACTION.
62	CULVERT AND RETAIN WALL	N	
71	WATERWAY ADEQUACY	N	
72	APPROACH RDWY ALIGNMENT (USE VALUES OF 3, 6, OR 8)	8	
521	OVERALL CONDITION (Circle One)		
	GOOD <u>FAIR</u> POOR CRITICAL		

TEAM LEADER SIGNATURE

9/11/2001
REVIEW DATE



STATE OF TENNESSEE
DEPARTMENT OF TRANSPORTATION

Underpass Condition Coding Form

Revised 06/15/2000

Bridge Number: 79I004000712
(Includes Item 5A)

Feature Intersected: N. MCLEAN BLVD / I40

County: 79

Route: 10040

Special Case: 0

County Sequence: 01

Log Mile: 6.60

CODE ONLY THOSE VALUES WHICH HAVE CHANGED

ITEM #	DESCRIPTION	VALUE	UNDERPASS SAFETY FEATURES
90	INSPECTION DATE	<u>01/19/2000</u> <u>9/11/2001</u>	515 (A) TYPE UNDERPASS BARRIER Metal Barrier or Rail
10	MINIMUM V.C. OVER DECK (ROADWAY + SHOULDERS)	<u>16</u> FT. <u>11</u> IN.	
520	MINIMUM V.C. OVER DECK (EXCLUDES SHOULDERS)	<u>16</u> FT. <u>11</u> IN.	(B) ADEQUACY OF BARRIER OR RAIL <u>1</u>
47	TOTAL HORIZONTAL UNDERCLEARANCE	<u>90</u> FT. <u>0</u> IN.	(C) ADEQUACY OF TRANSITIONS <u>1</u>
54	MINIMUM VERTICAL UNDERCLEARANCE (EXCLUDES SHOULDERS) Circle One: <u>(H)</u> R	<u>16</u> FT. <u>11</u> IN.	(D) ADEQUACY OF TERMINALS <u>1</u>
55	MINIMUM LATERAL UNDERCLEARANCE ON RIGHT SIDE Circle One: <u>(H)</u> R	<u>10</u> FT. <u>0</u> IN.	554 VERTICAL CLEARANCE LISTED ON HEIGHT POSTING <u>99</u> FT. <u>99</u> IN.
56	MINIMUM LATERAL UNDERCLEARANCE ON LEFT SIDE	<u>30</u> FT. <u>0</u> IN.	<u> </u> FT. <u> </u> IN.
521	OVERALL CONDITION (Circle One) GOOD <u>FAIR</u> POOR CRITICAL		HEIGHT POSTED AT BOTH APPROACHES? YES <u>[]</u> NO <u>[X]</u> N/A <u>[]</u>

555 COMMENTS

TEAM LEADER SIGNATURE


REVIEW DATE

9/11/2001

Bridge Loc. No: 79 - I0040 - 06.60 Date: 08-11-03




VIEW ACROSS TOP OF DECK

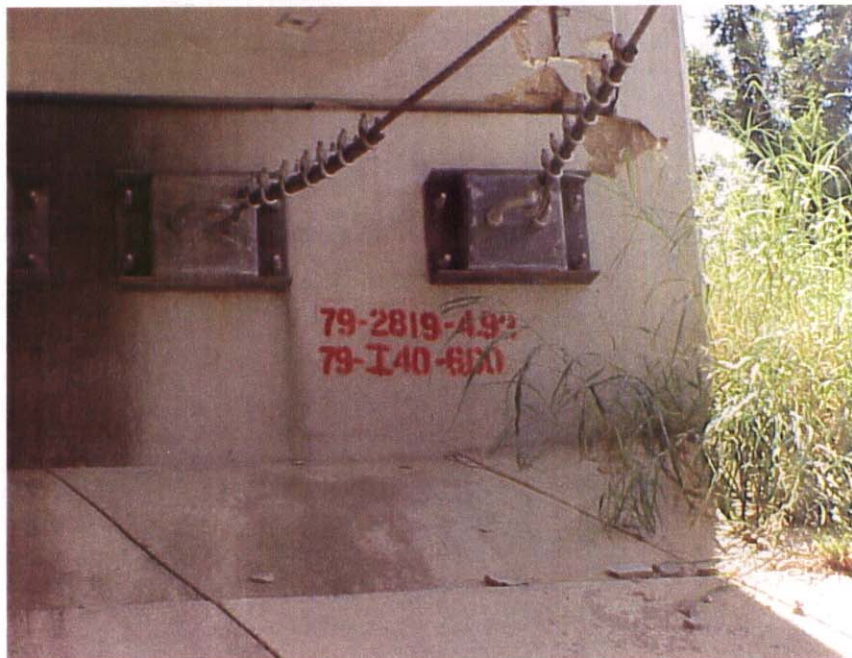


BRIDGE NO. ON ABUTMENT #1 CAP

Bridge Loc. No: 79 - I0040 - 06.60 Date: 08-11-03

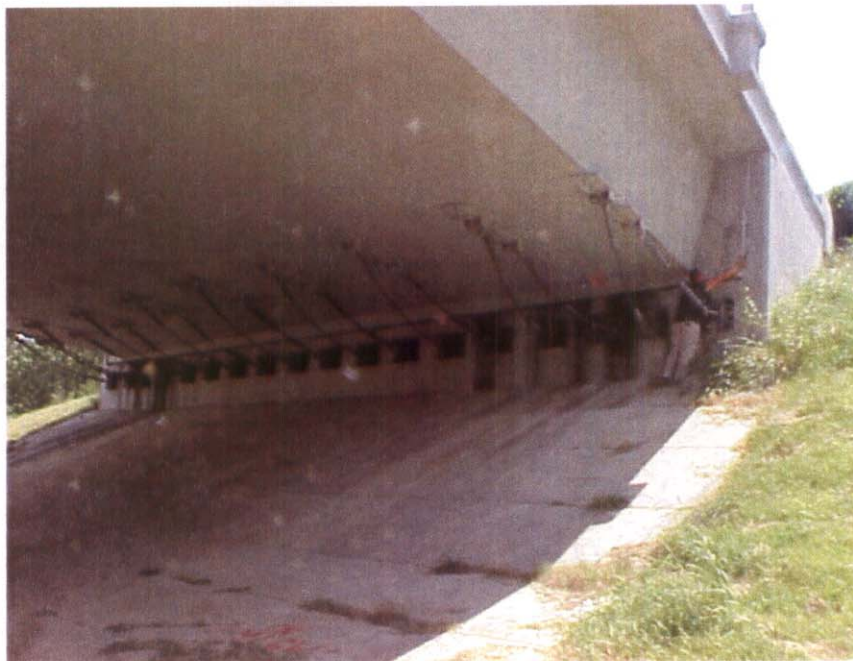


ABUTMENT #1 WITH EARTHQUAKE DEVICES

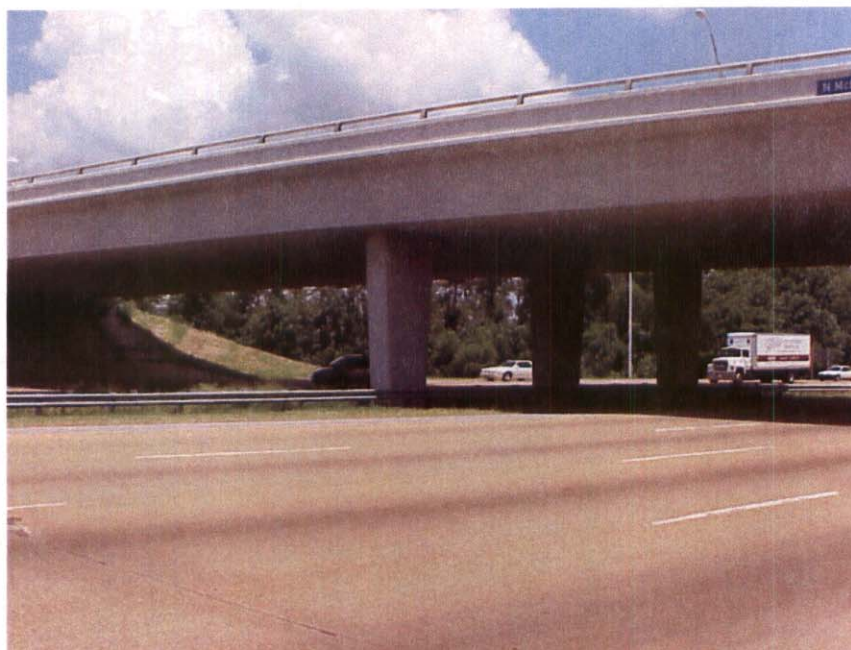

FRONT OF COLUMN BENT

Bridge Loc. No: 79 - I0040 - 06.60 Date: 08-11-03

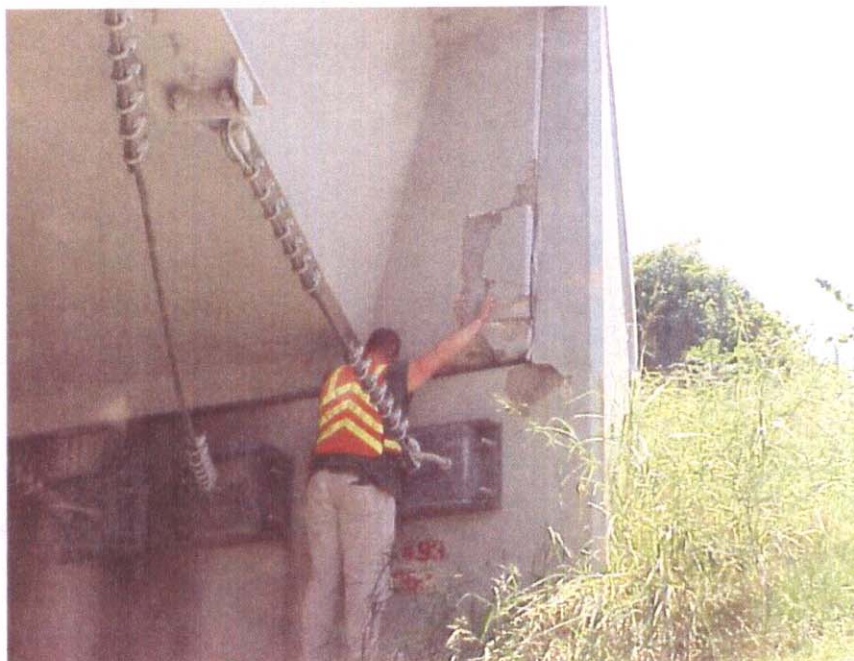

ABUTMENT #1, LEFT SIDE OF BACKWALL SPALLED TO STEEL



ABUTMENT #2 WITH EARTHQUAKE DEVICES

Bridge Loc. No: 79 - I0040 - 06.60 Date: 08-11-03



ELEVATION LEFT SIDE




ELEVATION RIGHT SIDE

Bridge Loc. No: 79 - I0040 - 06.60 Date: 08-11-03




ABUTMENT #1, RIGHT SIDE OF BACKWALL SPALLED TO STEEL

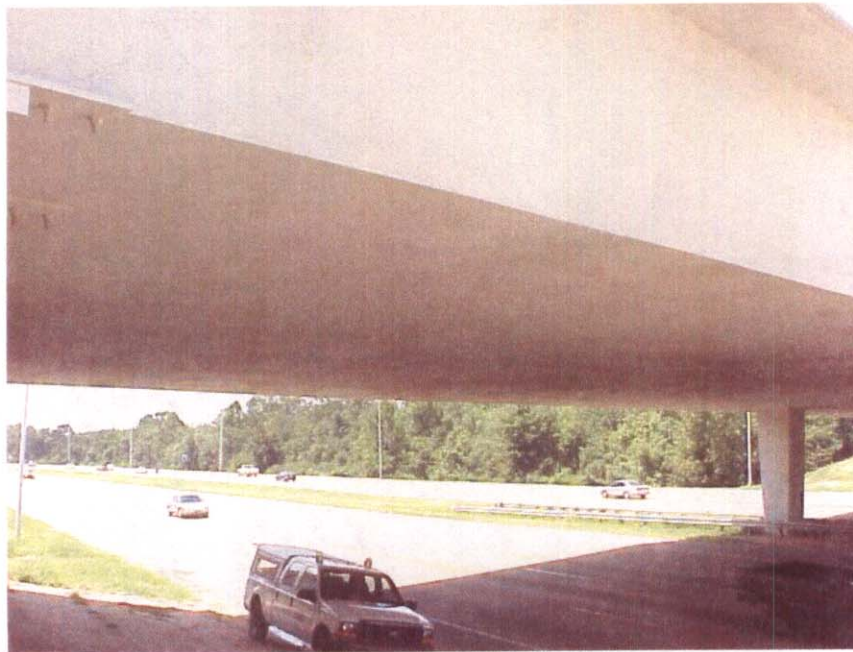

SPAN #1, BOTTOM OF DECK, TYPICAL OF SPAN #2

Bridge Loc. No: 79 - I0040 - 06.60 Date: 08-11-03

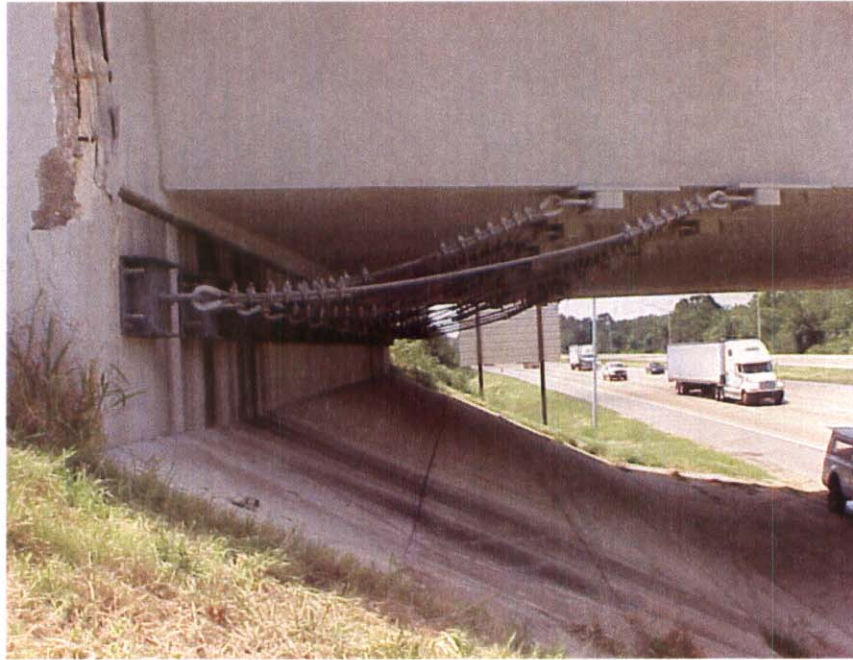

ABUTMENT #1 WITH EARTHQUAKE DEVICE



**APPROACH #1 WITH JOINT MATERIAL MISSING, TYPICAL OF
APPROACH #2**

Bridge Loc. No: 79 - I0040 - 06.60 Date: 08-11-03



**APPROACH #1 WITH JOINT MATERIAL MISSING, TYPICAL OF
APPROACH #2**



LOOKING AHEAD ON ROUTE

Bridge Loc. No: 79 - I0040 - 06.60

Date: 08-11-03



LOOKING BACK ON ROUTE

BRIDGE INSPECTION REPORT

AUG 11 2003

Form BIR 3.0
(Rev. 9-22-98)
DT-0069

Field Report No. 16 Date 8-11-03
Previous Report No. 15 Date 9-11-01
Plans: YES () NO ()

Bridge No. 79I00400071 Bridge Location No. 79 - I0040 - 0660 79 - 02819 - 0518
Eleven Digit No. Co. Route Log Mile OVER/UNDER PASS

_____ over _____
Road Name Crossing CITY
Year Constructed _____ County Shelby Maintenance District 45
Year Widened _____ Year Rehabilitated _____

FEATURES

Wearing Surface Concrete ☒ Timber () Asphalt () Depth _____ (in.)
Flared Width Yes () No ☒ Median Width Open () None () Closed ☒
Navigational Control Yes () No ☒ Bridge Skew 80L ° LT () RT ()
Structure Type (Main Span) CONC. BOX BEAM
Structure Type (Appr. Spans) _____
No. Main Spans 2 No. Approach Spans _____
Maximum Span Length 141.0 (**. ft.)
Total Length 282.0 (**. ft.)

Structure Name (If Named)

INSPECTORS

1. GREER
2. LOVE
3. ADAMS
4. BYRD
5. REEVES
6. _____
7. _____
8. _____

WIDTHS (*. ft.)

Deck Out-to-Out 70.0
Roadway Curb/Curb 68.0
Roadway Rail/Rail _____
Sidewalk Rt. 6.0 Lt. 6.0
*Approach Roadway 2 @ 26
*(Does Not Include Shoulders)
Approach Shoulder Rt. 6.0'
Lt. 6.0'

CLEARANCES

Min. Vertical Clearance over Deck _____ (ft.-in.)
Min. Vertical Under Clearance 16' 11" (ft.-in.)
Min. Lateral Under Clearance Rt. 10' (*. ft.)
Min. Lateral Under Clearance Lt. 30' (*. ft.)

FRACTURE CRITICAL: _____
(If Yes, Include BIR 3.9)

NBIS Bridge Length (<25 ft.) _____ (ft.-in.)

UNDERWATER INSPECTION

To Be Performed By: _____ Date _____
DOT FIELD TEAM () CONTRACT DIVERS () NONE REQUIRED ☒

Change in Structural Condition: Yes () No ☒ Major Repairs Made: Yes () No ☒

COMMENTS

N035 ° 11 ' 32.5 "
W089 ° 59 ' 35.7 "
G.P.S. Location

BRIDGE RATING: () ☒ () ()
GOOD FAIR POOR CRITICAL

Supervising Bridge Inspector: Career

Form BIR 3.1
(Rev. 9-22-98)
DT-0080

Bridge Location No. 79 - 10040 - 6.60 -
Co. Route Log Mile

Date AUG 11 2002

PERFORMANCE EVALUATION

Time of Day Inspected 1:45 Weather Conditions SUNNY 88°
Vehicles Observed ALL TYPES

LIVE LOAD BEHAVIOR

Substructure	YES	NO	Comments
Horiz./ Vert. Defl.	()	(X)	
Vibration	()	(X)	
Superstructure			
Horiz./ Vert. Defl.	()	(X)	
Vibration	()	(X)	

APPROACH

	Rating	Comments
Alignment	G F P C	
Sub SIDE WALK	G F P C	
Joints	G F P C	APPROACH #1 & 2 MATERIAL MISSING IN JOINT
Pavement	G F P C	
Embankment	G F P C	
Drains MEDIAN	G F P C	

TRAFFIC SAFETY FEATURES

	Rating	STANDARD/ SUB-STANDARD	Comments
Bridgerailing	G F P C	() (X)	
Transitions	G F P C	() (X)	
Guardrail	G F P C	() (X)	
Guardrail Terminal	G F P C	() (X)	

SIGNING

	YES	NO	NEEDED	Weight Limit Posted
Paddleboards	()	(X)	(X)	YES () NO (X)
Vertical Clearance (<14'-6")	()	(X)	()	Gross..... Tons
NARROW ()	()	(X)	()	2 Axle..... Tons
ONE LANE BRIDGE ()	()	(X)	()	3 or more Axles.. Tons

Other Signs or Plaques:

Comments Regarding any Problems with Signing:

TWO OVER HEAD SIGNS ON SPAN #2 RIGHT SIDE

Comments

G F P C

G F P C

~~G~~ F P C

G F P C

G F P C

~~G~~ F P C

G F P C

G F P C

✓ G F P C

G F P C

G F P C

~~G~~ F P C

CLEAN DRAINS ()

_____ CLEAN DRAINS ()

Bridge Location No. 79 - 10040 - 6.60 -
Co. Route Log Mile

Date _____

SUBSTRUCTURE

PILES TO BE
REPLACED

ABUTMENTS

	Rating	Comments	PILE(S)	ABUTMENT
Caps	G <u>F</u> P C			
Breastwall	G F P C			
Wings	G F <u>P</u> C	ABUT#1 RIGHT AND ABUT#2 LEFT SPALLING (154)		
Backwall	G F <u>P</u> C	SPAN #1 BACKWALL SPALLING AT ABUT#1 LEFT SIDE (171)		
Plumb	<u>G</u> F P C			
Footing	G F P C			
Piles	G F P C			
Embankment	<u>G</u> F P C			
Bearing	<u>G</u> F P C			
Slope Paving	<u>G</u> F P C			
Rip Rap	G F P C			
Earthquake Devices	<u>G</u> F P C			

PIERS

		PILE(S)	PIER
Caps	G F P C		
Columns	G F P C		
Plumb	G F P C		
Footings	G F P C		
Piles	G F P C		
Bearing	G F P C		
Web	G F P C		
Earthquake Devices	G F P C		

BENTS

		PILE(S)	BENT
Caps	G F P C		
Columns	<u>G</u> F P C		
Plumb	<u>G</u> F P C		
Footings	G F P C		
Piles	G F P C		
Bearing	G F P C		
Bracing	G F P C		
Earthquake Devices	G F P C		

Piles Need Replacement: NO (☒) YES ()

CUT VEGETATION NO (☒) YES ()

CLEAR DRIFT NO (☒) YES ()

RECOMMENDATIONS:

INSPECTION REPORT FOR UNDERPASS ROUTE

Form BIR 3.0A
(Rev. 9-22-98)
DT-1443

Field Report No. 16 Date _____
Previous Report No. 15 Date 9-11-01

Bridge No. 79100400071
Eleven Digit No.

Underpass Location No. 79 - 10040 - 0660 -
Co. Route Log Mile

-0- or - - -
Railroad/Walkway Co. Route Log Mile

over/
under 79 - 02819 - 0518
Co. Route Log Mile

County Shelby

Structure Name (If Named) _____

Year Constructed _____

Year Widened _____

Year Rehabilitated _____

GEOMETRIC FEATURES UNDER BRIDGE (*. * ft. unless otherwise noted)

Divided Highway LEFT RDWY (X) RIGHT RDWY () N.A. ()

Type of Wearing Surface CONCRETE () ASPHALT (X) GRAVEL ()

Width of Approach Traveled Roadway 50 ft. (Does Not Include Shoulders)

Width of Median if Divided Highway 65 ft.

Approach Shoulder Width 10 ft. Right 10 ft. Left

*Horizontal Clearance Under Bridge 90 ft. 0 IN.

*Distance Between Pier Protection
Guardrail and Substructure 0 ft. Right 4.0 ft. Left

*Width of Sidewalk Under Bridge N/A ft. Right N/A ft. Left

*Minimum Vertical Clearance: 16 ft. 11 in.

*Show on Sketch

2
BTWN.
B-1 & A-2

TRAFFIC SAFETY FEATURES FOR UNDERPASS ROUTE

	STANDARD	SUB-STANDARD	NON EXIST
Pier Protection Railing or Parapet	(G) F P C ()	(X)	()
Approach Guardrail Transitions	G F P C ()	()	(X)
Approach Guardrail	(G) F P C ()	(X)	()
Approach Guardrail Terminal	(G) F P C ()	(X)	()

SIGNING FOR UNDERPASS ROUTE

Paddleboards YES () NO (X) NEEDED ()
Vertical Clearance (<14'-6") YES () NO (X) NEEDED ()
Narrow Passage YES () NO (X) NEEDED ()
One Lane Passage YES () NO (X) NEEDED ()

Other Underpass Signs Needed

NONE

INSPECTORS

- BYRD
- REEVES
- _____
- _____
- _____
- _____

INSPECTION REPORT FOR UNDERPASS ROUTE

Form BIR 3.0A

(Rev. 9-22-98)

DT-1443

Field Report No. 16

Date _____

Previous Report No. 15Date 9-11-01Bridge No. 79100400071

Eleven Digit No.

Underpass Location No. 79 - 10040 - 0660 --0-
Railroad/Walkway

or

-
Co. Route Log Mileover/
under

Co. Route Log Mile

79 - 02819 - 0518

Co. Route Log Mile

County Shelby

Structure Name (If Named) _____

Year Constructed _____

Year Widened _____

Year Rehabilitated _____

GEOMETRIC FEATURES UNDER BRIDGE

(*. * ft. unless otherwise noted)

Divided Highway LEFT RDWY () RIGHT RDWY (X) N.A. ()

Type of Wearing Surface CONCRETE () ASPHALT (X) GRAVEL ()

Width of Approach Traveled Roadway 50 ft. (Does Not Include Shoulders)Width of Median if Divided Highway 65 ft.Approach Shoulder Width 10 ft. Right 10 ft. Left*Horizontal Clearance Under Bridge 90 ft. 0 IN.*Distance Between Pier Protection Guardrail and Substructure 0 ft. Right 4 ft. Left*Width of Sidewalk Under Bridge N/A ft. Right N/A ft. Left*Minimum Vertical Clearance: 17 ft. 8 in.

*Show on Sketch

①
BTWN.
A-1 & B-1**TRAFFIC SAFETY FEATURES FOR UNDERPASS ROUTE****STANDARD SUB-STANDARD NON EXIST**

Pier Protection Railing or Parapet (G) F P C () (X) ()

Approach Guardrail Transitions G F P C () () (X)

Approach Guardrail (G) F P C () (X) ()

Approach Guardrail Terminal (G) F P C () (X) ()

SIGNING FOR UNDERPASS ROUTE

Paddleboards YES () NO (X) NEEDED ()

Vertical Clearance (<14'-6") YES () NO (X) NEEDED ()

Narrow Passage YES () NO (X) NEEDED ()

One Lane Passage YES () NO (X) NEEDED ()

Other Underpass Signs Needed

NONE**INSPECTORS**

1. BYRD
2. REEVES
3. _____
4. _____
5. _____
6. _____

Form BIR 3.0A (Continued)

Page No. _____

(Rev. 9-22-98)

Date _____

DT-1443

Underpass Location No. 79 - 10040 - 0660 -

Other Signs or Plaques: @ SPAN #2 RT.

EXIT 2A	Co.	Route	Log Mile
51		WATKINS ST	
MILLINGTON 1 MILE		NEXT RIGHT	

Comments Regarding any Problems with Signing:

NONE

BRIDGE FEATURES (* * ft.)Bridge Skew 80.4°Structure Type (Main Span) Box Beam

No. Main Spans

2

Structure Type (Appr. Spans)

No. Appr. Spans

Maximum Span Length

141

(ft.)

Total Length

282

(ft.)

Width of Bridge Out-to-Out

20'

(ft.)

Right Angle to Centerline of Bridge)

Width of Bridge Along Skew

(ft.)

(If Unable to Measure at Right Angle to Centerline of Bridge)

Number of Lanes/Tracks on Bridge

BRIDGE CONDITION:

G (F) P C

Does Potential Exist for Elements from Bridge Falling on Roadway Beneath YES () NO (X)

Does Potential Exist Because of Deteriorated Condition or Failure of Major Member YES () NO (X)

Comment on any Conditions of Bridge that would Effect Roadway Beneath:

NONE

Note: If Underpass Route is Divided Highway, Use Two of These Forms, One for Each Roadway.

MINIMUM PICTURES REQUIRED

1. Elevation View of Bridge on Both Sides Showing Underpass
2. View Showing Both Approaches to Bridge
3. View Showing Safety Features
4. View Showing Any Problems

Inspection Team's Summary

Bridge Location No 79 - I0040 -06.60 -

Inspection Date 08-11-03

Bridge Rating FAIR

This two span concrete box beam bridge with concrete substructure is in fair condition. Substandard bridge rails, guardrails & terminals are present. Material missing in joints on approach #1 & #2. Abut. #1 Rt. & abutment #2 Lt. wings are spalling. Span #1 backwall is spalled to steel. Min. vertical under clearance is 16'11".

Carolyn Adams

INSPECTOR

CROSS SECTION: YES () NO (X) PONTIS: YES () NO (X)

AUG 11 2003

2003

79I00400071 79 I0040 0660 SKEW: 80L
BRIDGE NO.: CO. ROUTE L.M. L/R


Direction of Route



PLAN VIEW

REQUIRED DATA

1. F = FIXED
E = EXPANSION
2. S = SIMPLE
C = CONTINUOUS

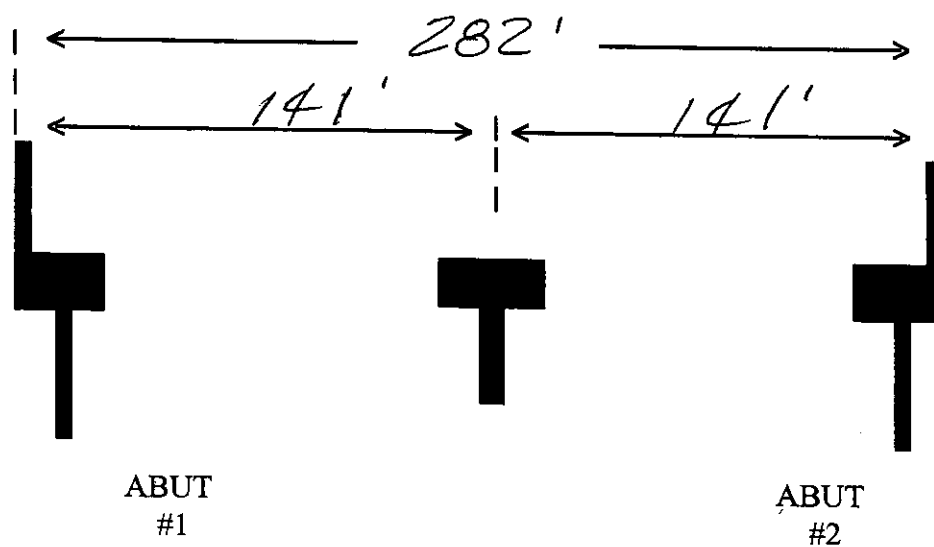


BRIDGE LOC. NO. 79 I0040 0660 -
CO. ROUTE L. M. L/R

DATE: 2003

RT.

LATERAL AND VERTICAL CLEARANCES


LT.

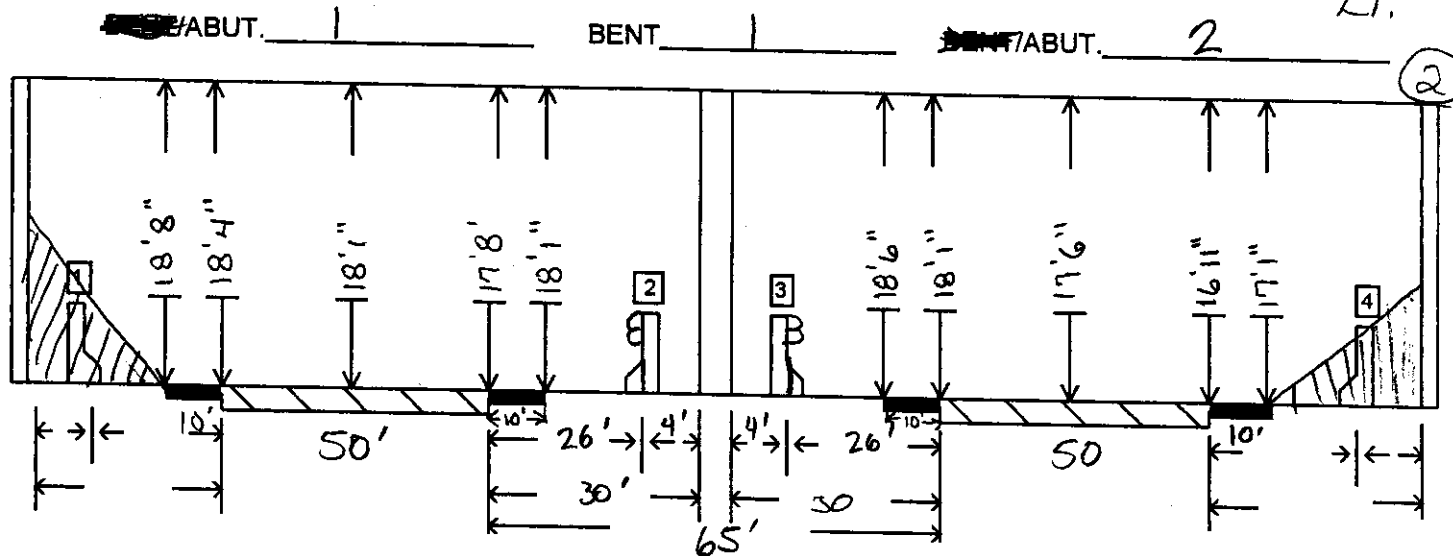

- | | | | | | | |
|-----------------------|---------|-------------------------------------|---------------|--------------------------|------|-------------------------------------|
| 1. RAIL/BARRIER TYPE: | W-SHAPE | <input type="checkbox"/> | CONC. BARRIER | <input type="checkbox"/> | NONE | <input checked="" type="checkbox"/> |
| 2. RAIL/BARRIER TYPE: | W-SHAPE | <input checked="" type="checkbox"/> | CONC. BARRIER | <input type="checkbox"/> | NONE | <input type="checkbox"/> |
| 3. RAIL/BARRIER TYPE: | W-SHAPE | <input checked="" type="checkbox"/> | CONC. BARRIER | <input type="checkbox"/> | NONE | <input type="checkbox"/> |
| 4. RAIL/BARRIER TYPE: | W-SHAPE | <input type="checkbox"/> | CONC. BARRIER | <input type="checkbox"/> | NONE | <input checked="" type="checkbox"/> |


BENT/ABUT. _____

BENT/ABUT. _____

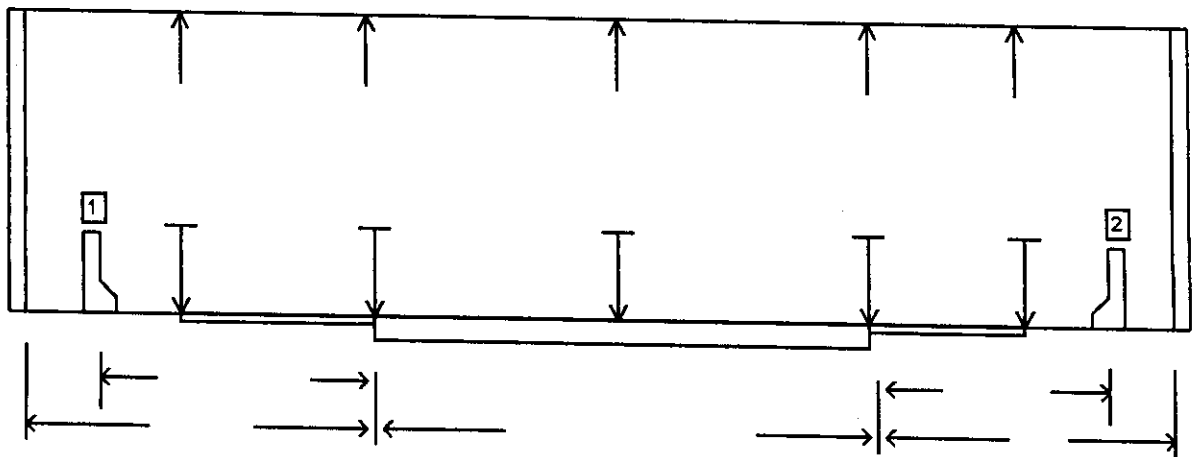

BENT/ABUT. _____


BENT/ABUT. _____

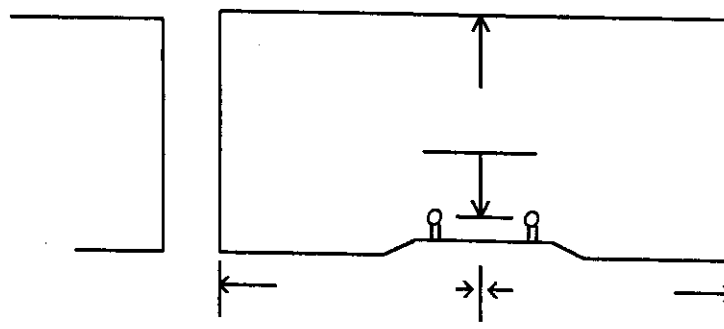

EXIT 2A
51
Millington
1 mile

EXIT 3
Wilmington
1 mile


BRIDGE NO.: 79I00400071 79 I0040 0660 - 80L DATE: _____
CO. ROUTE LOG MILE L/R SKEW

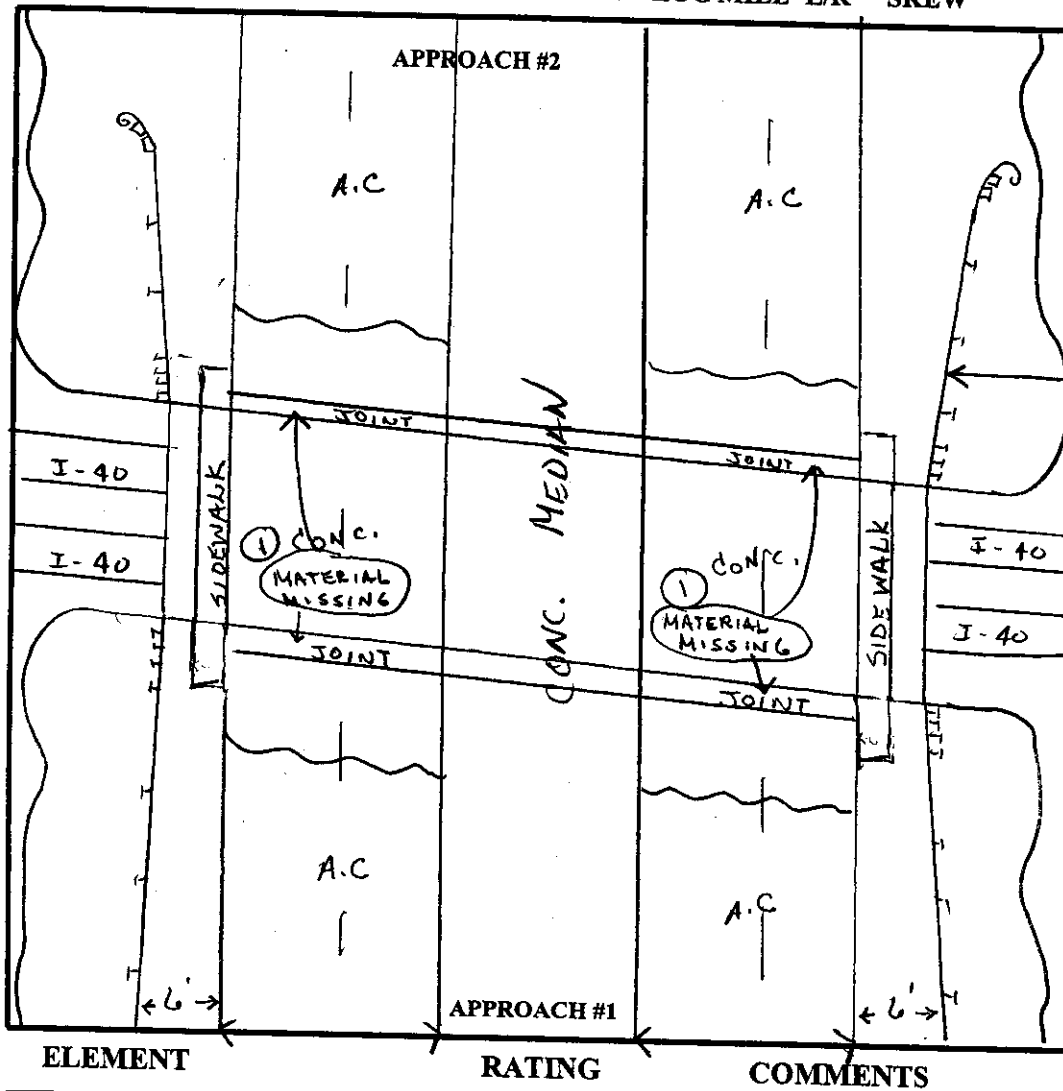

ALIGNMENT	(G) F P C	
APPROACH PAVEMENT	G (F) P C	APP # 1 & 2 - FINE CRACKS
APPROACH SLAB	G F P C	N/V
APPROACH GUARDRAIL	G (F) P C	
EMBANKMENT	(G) F P C	
DRAINS	G F P C	N/A
APPROACH JOINT	G F (P) C	APP # 1 & 2 - MATERIAL MISSING
SIDEWALK	(G) F P C	
CONC. MEDIAN	(G)	

BRIDGE NO. 79-2 40-6100 SK. 80° LT

SPAN NO. 1

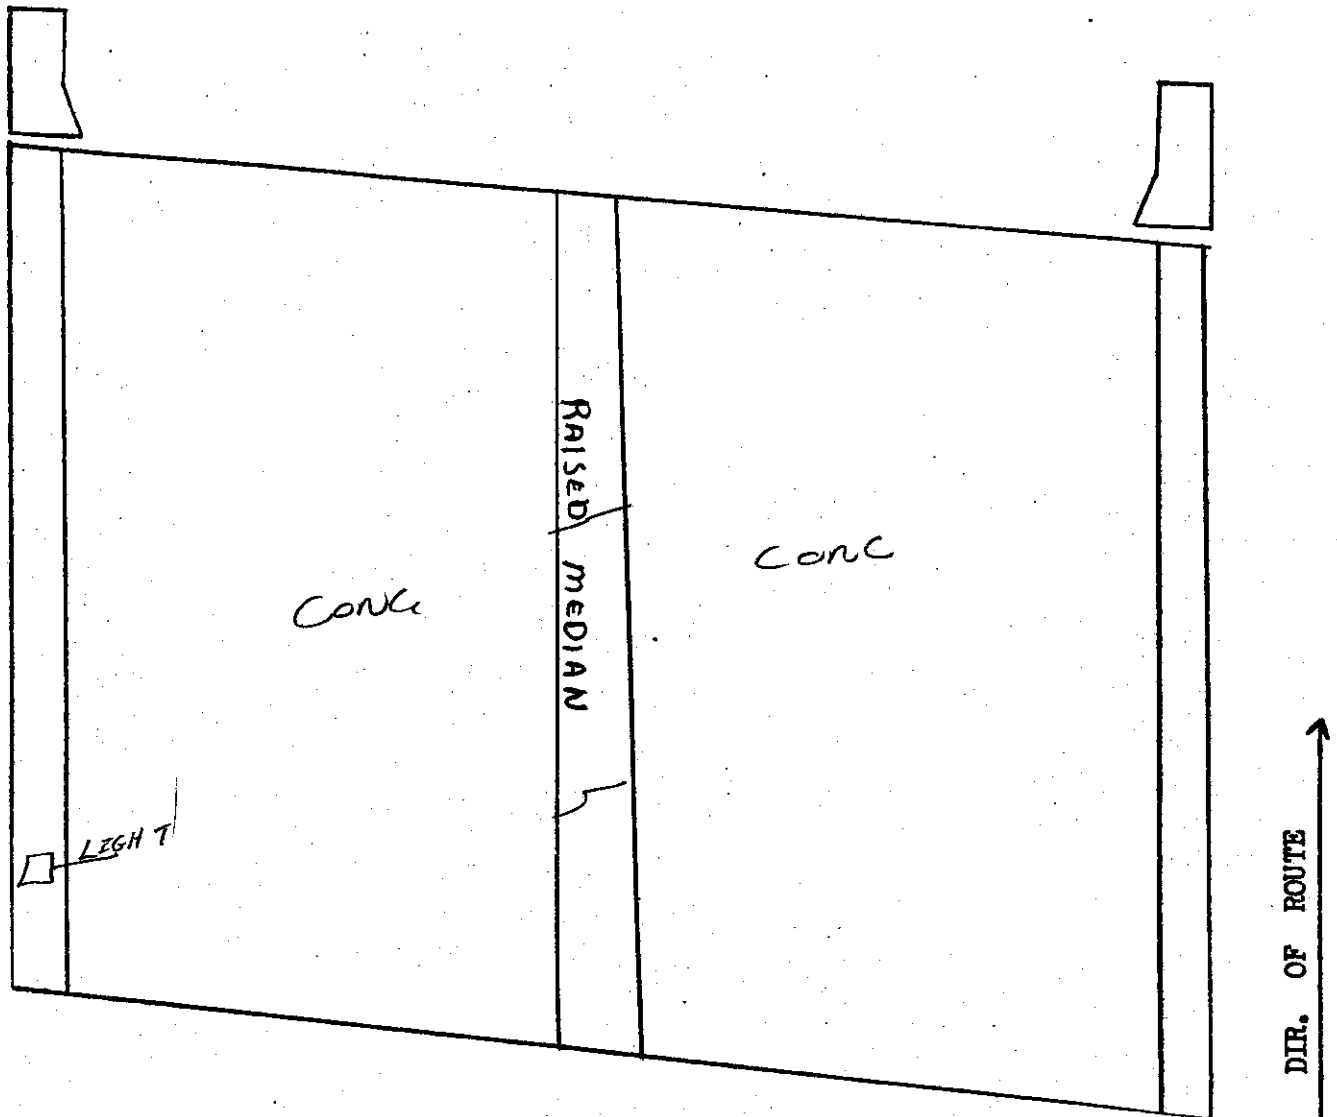

DECK (G) F P C

PARAPET (G) F P C

DRAINS G F P C

JOINTS G F P C

SEWAGE (G)


RAILS (G) F P C

CURB (G)


LIGHT (G) F P C
MEDIAN (G) F P C

NONE
CONT.

BRIDGE NO. 79-I-40-610 SK. 8004 SPAN NO. 1

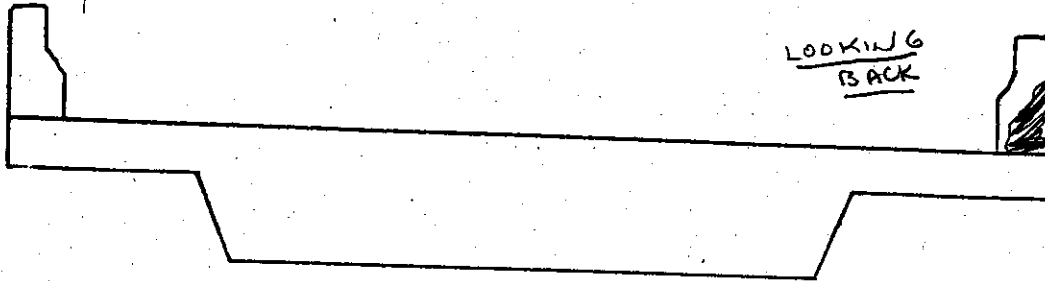

↑
DIR. ROUTE

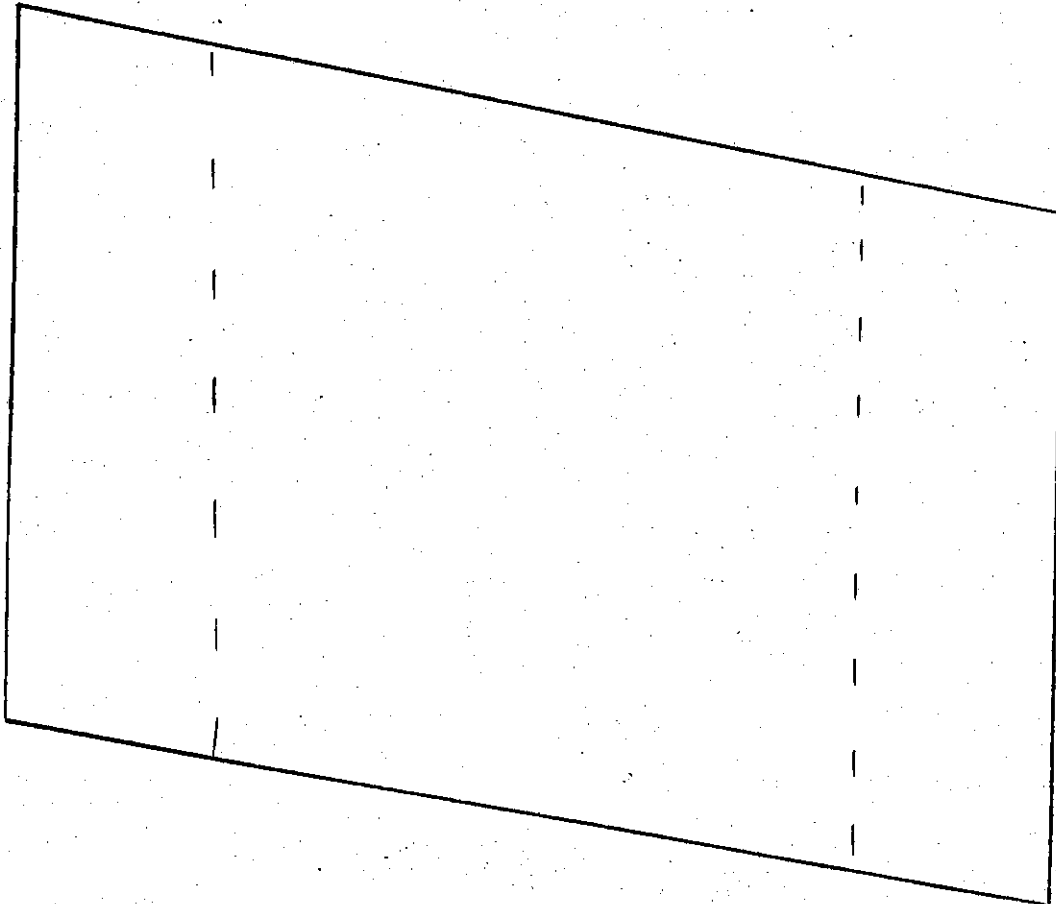


ELEMENT	RATING	COMMENTS
BOTTOM DECK	(G) F P C	
BACKWALL	G F (P) C	SEE (1)

BRIDGE NO. 79 E-40 -660 SK. 80° LT

SPAN NO 2

C.A.

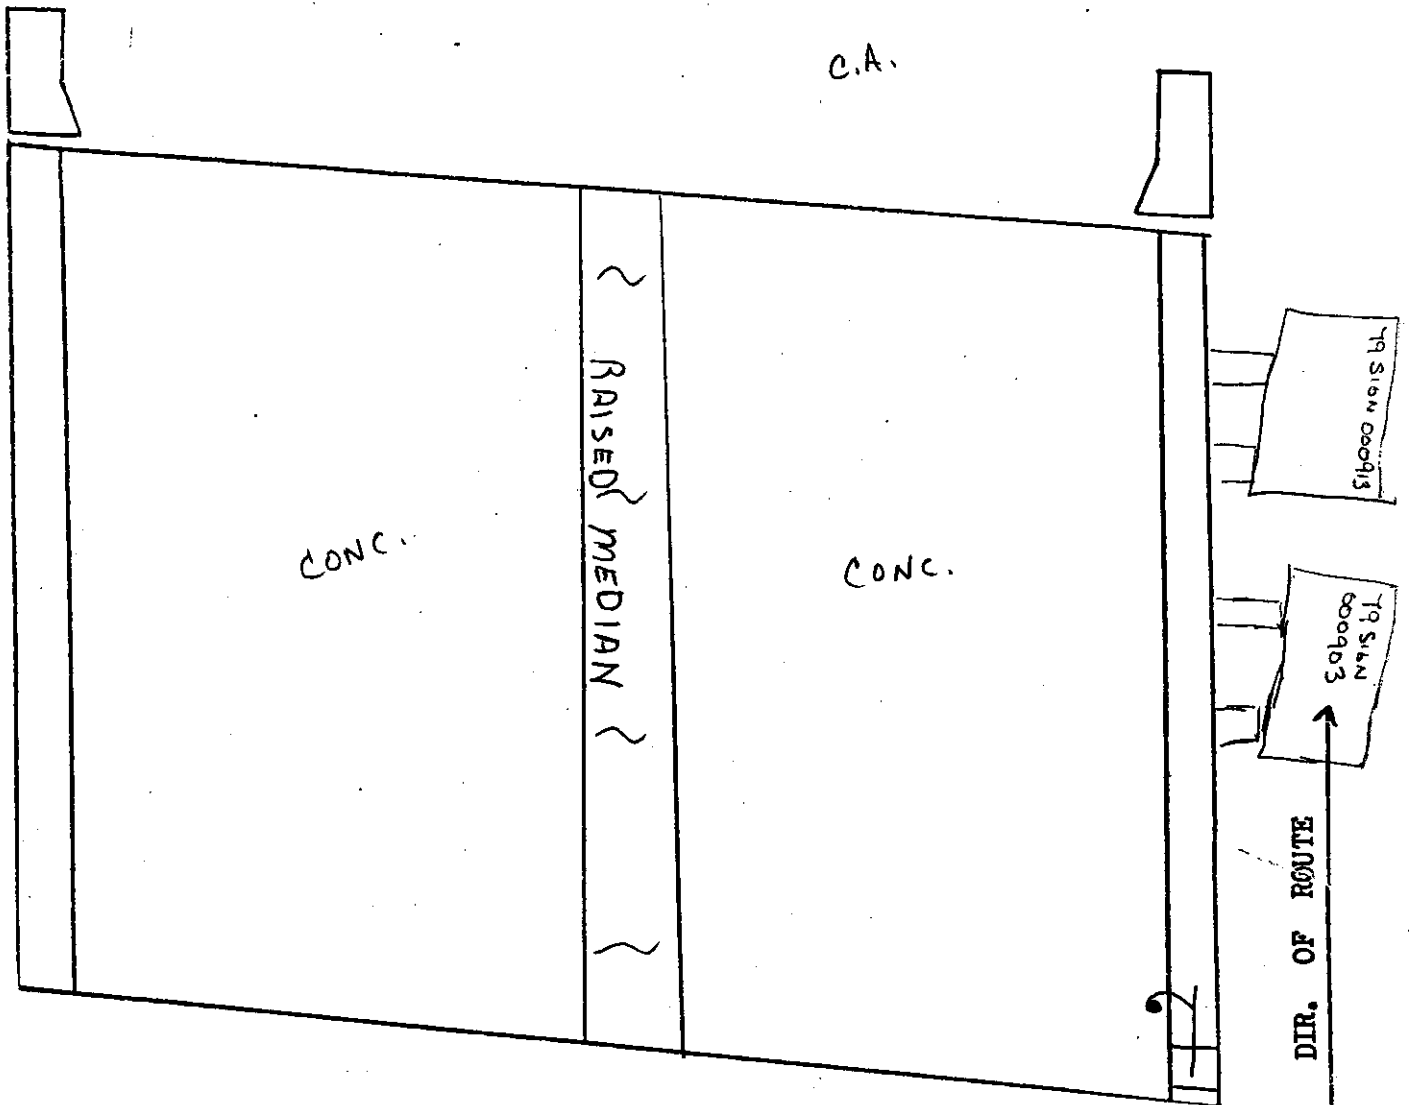

DECK

(G) F P C

PARAPET

(G) F P C

SIDEWALK
~~BRIDGE~~

(G) F P C

CURB
~~BRIDGE~~

(G) F P C

RAILS

(G) F P C

LIGHT
MEDIAN

(G) (F)

SIGNS


(G)

SCATTERED FINE CRACKS


BRIDGE NO. 79 E-40-610 SK. 8064 SPAN NO. 2

AUG 11 1963

DB

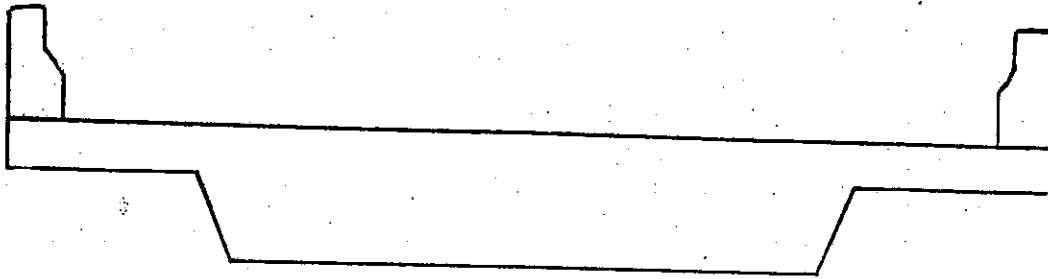

↑
DIR. ROUTE

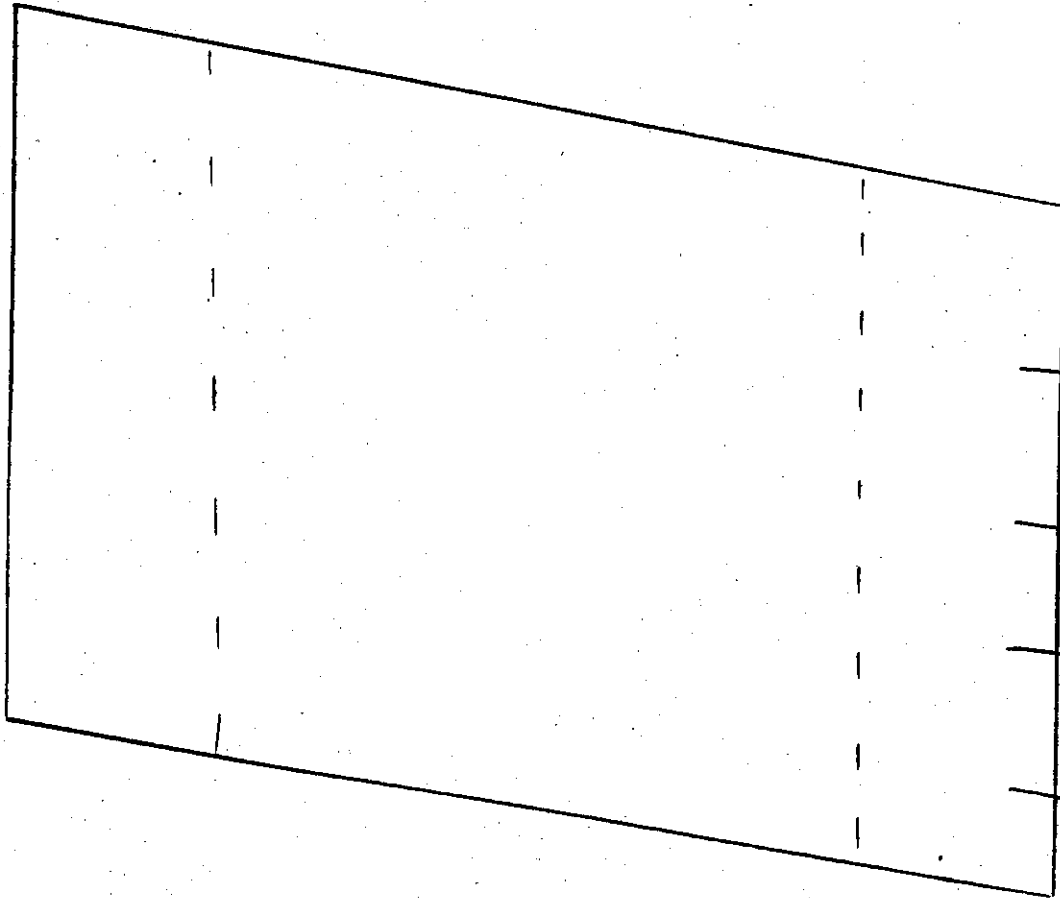


SIGNS

ELEMENT	RATING	COMMENTS
BOTTOM DECK	(G) F P C	
BACKWALL	(G) F P C	

BRIDGE NO. 79 E-40-6.60ABUT. NO. 1


AHC 11 1960

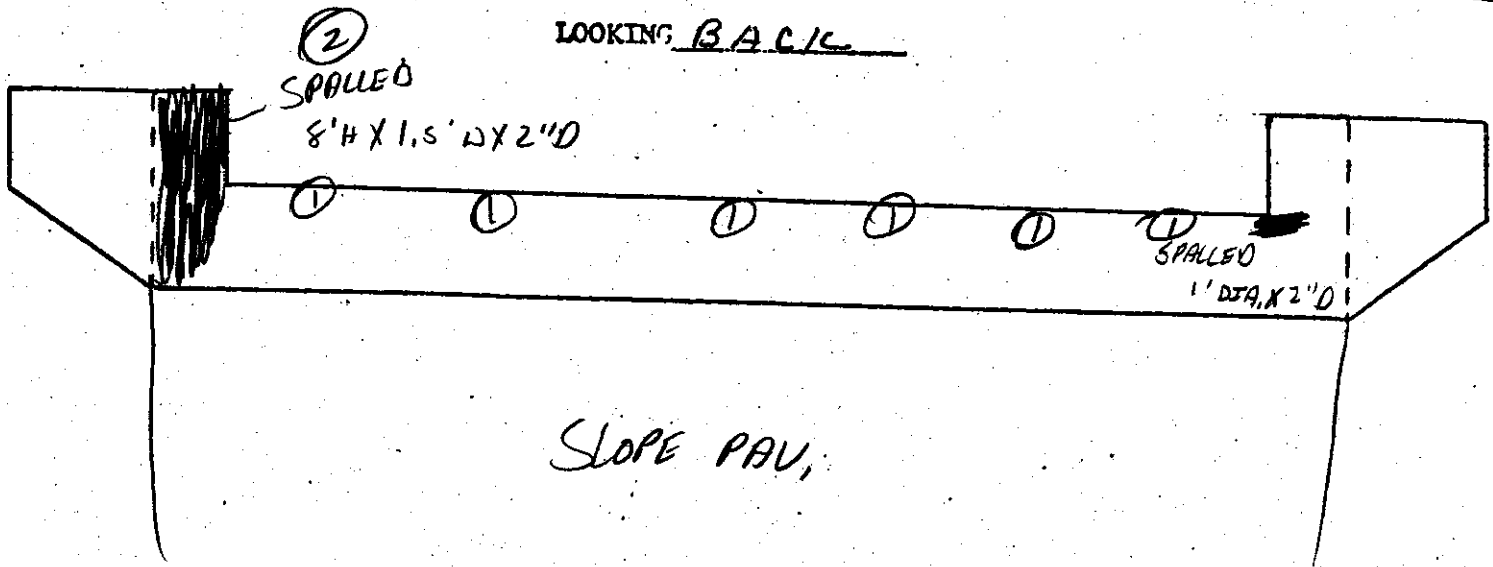


LEMENT	RATING	COMMENTS
BEARING	① G F P C	
PAINT	G F P C	
CAP	① G F P C	SPALLED
WINGS	G F ① P C	SEE ②
EMB.	① G F P C	
VEG.	① G F P C	
RIP-RAP	G F P C	
SLOPE PAV.	① G F P C	
ORIGINAL	① G F P C	①
EQ.		

BRIDGE NO 79-I-40-610

BENT NO 1 AUG 11, 1964

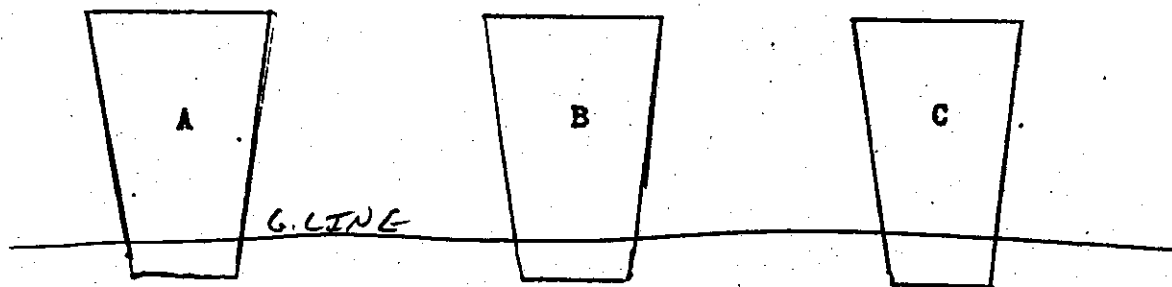


FRONT

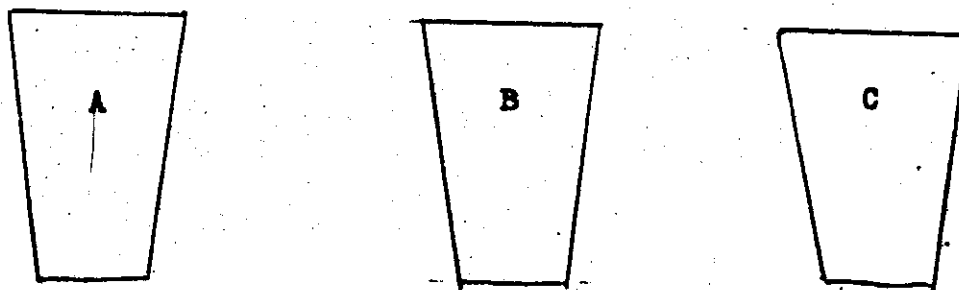

REAR

ELEMENT		RATING	COMMENT
ITEM	A	<u>G</u> F P C	
	B	<u>G</u> F P C	
	C	<u>G</u> F P C	

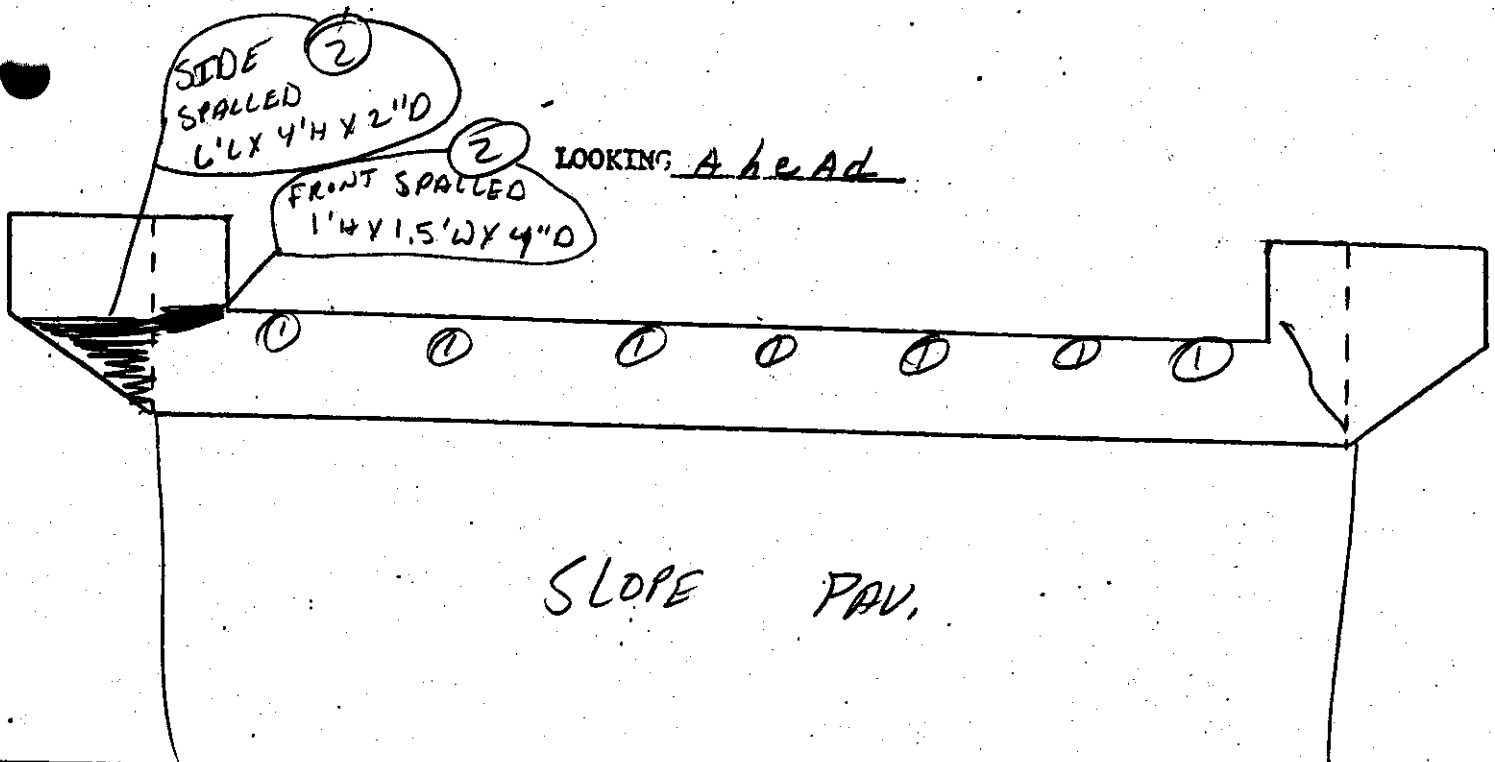BRIDGE NO. 79 I-40-6160ABUT. NO. 2 AUG 17 2002

ELEMENT	RATING	COMMENTS
BEARING	G F P C	
PAINT	G F P C	N/A
CAP	G F P C	
WINGS	G F P C	SEE ②
EMB.	G F P C	
VEG.	G F P C	LIGHT GROWTH
RIP-RAP	G F P C	N/A
SLOPE PAV.	G F P C	
BACKWALL	G F P C	①
E.A.		

Bridge Loc. No: 79 - I0040 - 06.60 Date: 09-11-01




LOOKING BACK ON ROUTE




BRIDGE NO.

Bridge Loc. No: 79 - I0040 - 06.60 Date: 09-11-01

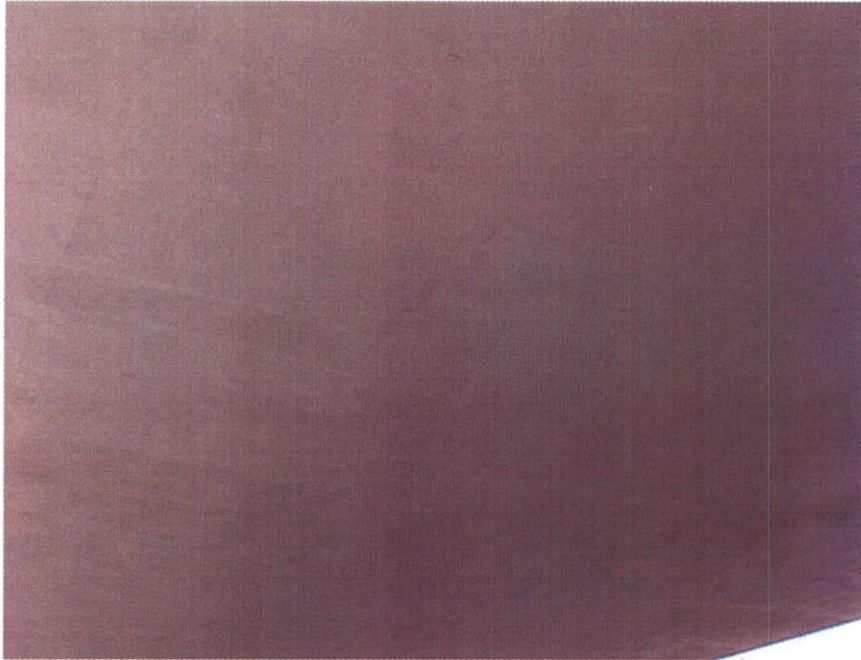

SPAN #1, BOTTOM OF DECK

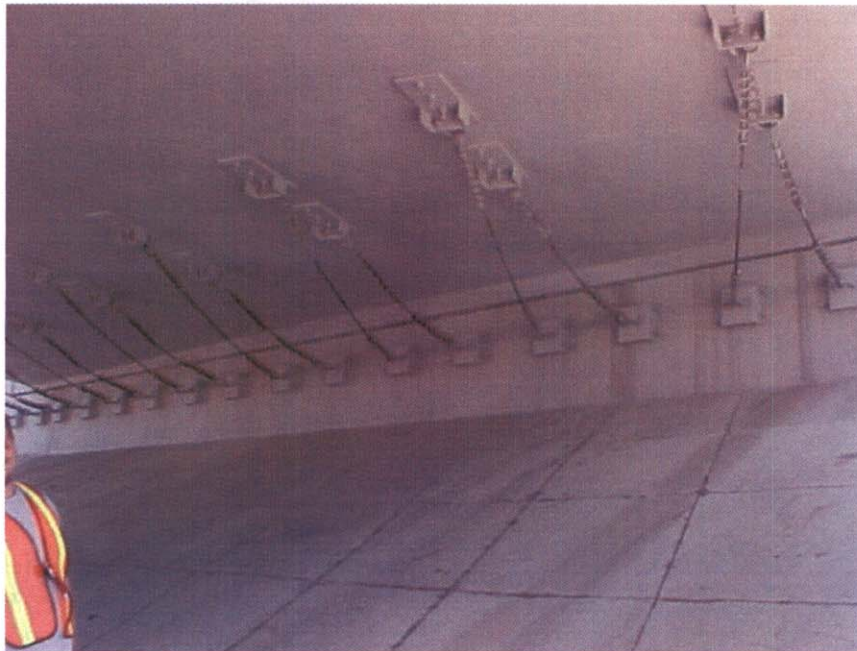

ABUTMENT #1

Bridge Loc. No: 79 - I0040 - 06.60 Date: 09-11-01



BENT #1




ELEVATION LEFT SIDE

Bridge Loc. No: 79 - I0040 - 06.60 Date: 09-11-01



ELEVATION RIGHT SIDE

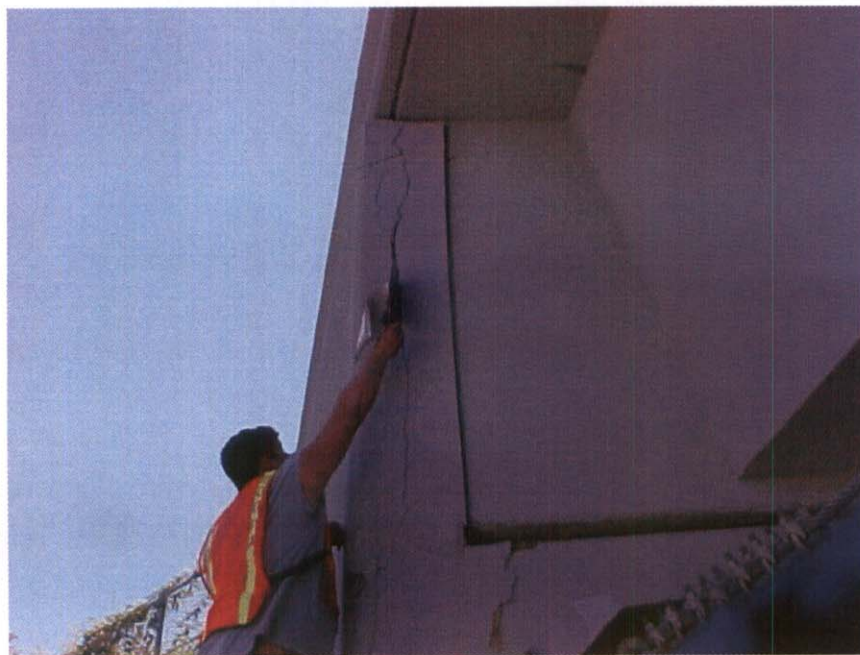

ABUTMENT #1, RIGHT WING CRACKING

Bridge Loc. No: 79 - I0040 - 06.60 Date: 09-11-01



LOOKING AHEAD ON ROUTE



VIEW ACROSS TOP OF DECK, LOOKING AHEAD

Bridge Loc. No: 79 - I0040 - 06.60

Date: 09-11-01



APPROACH #2, RIGHT GUARDRAIL HAS COLLISION DAMAGE

BRIDGE INSPECTION REPORT

Form BIR 3.0
(Rev. 9-22-98)
DT-0069

Field Report No. 15 Date 9-11-01
Previous Report No. 14 Date _____
Plans: YES ☒ NO ☐

Bridge No. 79I00400071 Bridge Location No. 79 - I0040 - 6.60 - 79 - 02819 - 0518
Eleven Digit No. Co. Route Log Mile OVER/UNDER PASS

_____ over -0-
Road Name Crossing Structure Name (If Named)
Year Constructed _____ County Shelby Maintenance District 45
Year Widened _____ Year Rehabilitated _____

FEATURES

Wearing Surface Concrete ☒ Timber ☐ Asphalt ☐ Depth _____ (in.)
Flared Width Yes ☐ No ☒ Median Width Open ☐ None ☒ Closed ☐
Navigational Control Yes ☐ No ☒ Bridge Skew 80L° LT ☐ RT ☐
Structure Type (Main Span) CONC. BOX BEAM
Structure Type (Appr.Spans) _____
No. Main Spans 2 No. Approach Spans _____
Maximum Span Length _____ (**. ft.)
Total Length 282.0 (**. ft.)

INSPECTORS

1. COLLINS
2. ADAMS
3. BYRD
4. REEVES
5. _____
6. _____
7. _____
8. _____

WIDTHS (ft.)

Deck Out-to-Out 70.0
Roadway Curb/Curb 68.0
Roadway Rail/Rail _____
Sidewalk Rt. 6.0 Lt. 6.0
*Approach Roadway 2 @ 26'
*(Does Not Include Shoulders)
Approach Shoulder Rt. N/A
Lt. N/A

CLEARANCES

Min. Vertical Clearance over Deck 5 (ft.-in.)
Min. Vertical Under Clearance 16'-11" (ft.-in.)
Min. Lateral Under Clearance Rt. 10 (ft.)
Min. Lateral Under Clearance Lt. 10 (ft.)

FRACTURE CRITICAL: N/A
(If Yes, Include BIR 3.9)

NBIS Bridge Length (<25 ft.) N/A (ft.-in.)

UNDERWATER INSPECTION

To Be Performed By: _____ Date _____

DOT FIELD TEAM ☐ CONTRACT DIVERS ☐ NONE REQUIRED ☒

Change in Structural Condition: Yes ☒ No ☐

Major Repairs Made: Yes ☐ No ☒

COMMENTS:

N 35°-11' - 32.5"
W 89°-59' - 35.7"

NEW TEXTURE COATING
NEW DECK &
SIDE WALKS

BRIDGE RATING: () ☒ () ()
GOOD FAIR POOR CRITICAL

Supervising Bridge Inspector: [Signature]

Form BIR 3.1
(Rev. 9-22-98)
DT-0080

Bridge Location No. 79 - 10040 - 6.60 -
Co. Route Log Mile

Date _____

PERFORMANCE EVALUATION

Time of Day Inspected 1.45 Weather Conditions CLEAR E 85°

Vehicles Observed ALL TYPES

LIVE LOAD BEHAVIOR

Substructure	YES	NO	Comments
Horiz./ Vert. Defl.	()	(X)	
Vibration	()	(X)	
Superstructure			
Horiz./ Vert. Defl.	()	(X)	
Vibration	()	(X)	

APPROACH

	Rating	Comments
Alignment	(G) F P C	
Slab	G F P C	N/A
Joints	(G) F P C	
Pavement	(G) F P C	
Embankment	(G) F P C	
Drains	G F P C	N/A

TRAFFIC SAFETY FEATURES

	Rating	STANDARD/ SUB-STANDARD	Comments
Bridgerailing	(G) F P C	(X) ()	
Transitions	(G) F P C	() (X)	
Guardrail	G F (P) C	() (X)	APP # 2 RT COLLISION DAMAGED (2301)
Guardrail Terminal	(G) F P C	() (X)	

SIGNING

	YES	NO	NEEDED	Weight Limit Posted
Paddleboards	()	(X)	()	YES () NO (X)
Vertical Clearance (<14'-6")	()	(X)	()	Gross..... Tons
NARROW ()	()	(X)	()	2 Axle..... Tons
ONE LANE BRIDGE ()	()	(X)	()	3 or more Axles.. Tons

Other Signs or Plaques: OVER HEAD ATTACHED TO SPAN #2 RT

Comments Regarding any Problems with Signing: 79-40-6.60 → NO NO.
NONE

Form BIR 3.2
(Rev. 9-22-98)
DT-0081

Bridge Location No. 79 - 10040 - 6.60 -
Co. Route Log Mile

SEP 11 2001

Date _____

DECK

	Rating	Comments
Wearing Surface	<u>G</u> F P C	
Deck - Structural Condition	<u>G</u> F P C	
Curbs	<u>G</u> F P C	
Median	<u>G</u> F P C	
Sidewalks	<u>G</u> F P C	
Parapet	<u>G</u> F P C	
Railing	<u>G</u> F P C	
Paint <u>SGN</u>	<u>G</u> F P C	
Drains	<u>G</u> F P C	
Lighting Standards	<u>G</u> F P C	
Utilities	<u>G</u> F P C	
Joint Leakage	G F P C	
Expansion Joints	G F P C	<u>CRACK DUCK</u>

SUPERSTRUCTURE

Bearing Devices	G F P C	
Beams <u>SOLID</u>	<u>G</u> F P C	
Girders	G F P C	
P C C S	G F P C	
BOLTS (PCCS)	G F P C	
Floor Beams	G F P C	
Stringers	G F P C	
Diaphragms	G F P C	
Bracing	G F P C	
Trusses - General	G F P C	
Portals	G F P C	
Bracing	G F P C	
Paint	G F P C	
Alignment of Members	<u>G</u> F P C	

TEXTURE COAT

Condition Rating	<u>G</u> F P C
Overall Appearance	<u>G</u> F P C
Staining Rating	<u>G</u> F P C

Fading	<u>G</u> F P C
Needs Spot Painting	YES () NO <u>()</u>
Needs Repainting	YES () NO <u>()</u>

Comments _____ Scaling Rating G F P C

RECOMMENDATIONS: _____ CLEAN SEAL JOINTS ()
_____ CLEAN DRAINS ()

SUBSTRUCTURE

PILES TO BE
REPLACED

ABUTMENTS

	Rating	Comments	PILE(S)	ABUTMENT
Caps	<u>G</u> F P C			
Breastwall	G F P C			
Wings	G F <u>P</u> C	<u>ABUT #1 RT SPALLING</u>	<u>(154)</u>	
Backwall	<u>G</u> F P C			
Plumb	<u>G</u> F P C			
Footing	G F P C			
Piles	G F P C			
Embankment	<u>G</u> F P C			
Bearing	<u>G</u> F P C			
Slope Paving	<u>G</u> F P C			
Rip Rap	G F P C			
Earthquake Devices	<u>G</u> F P C			

PIERS

			PILE(S)	PIER
Caps	G F P C			
Columns	G F P C			
Plumb	G F P C	<u>N/A</u>		
Footings	G F P C			
Piles	G F P C			
Bearing	G F P C			
Web	G F P C			
Earthquake Devices	G F P C			

BENTS

			PILE(S)	BENT
Caps	G F P C	<u>N/A</u>		
Columns <u>STEMS</u>	<u>G</u> F P C			
Plumb	<u>G</u> F P C			
Footings	G F P C			
Piles	G F P C			
Bearing	G F P C			
Bracing	G F P C			
Earthquake Devices	G F P C	<u>N/A</u>		

Piles Need Replacement: NO (X) YES ()

CUT VEGETATION NO (X) YES ()

CLEAR DRIFT NO (X) YES ()

RECOMMENDATIONS:

INSPECTION REPORT FOR UNDERPASS ROUTESEP 11 2001
Page No. _____

Form BIR 3.0A

(Rev. 9-22-98)

DT-1443

Field Report No. _____

Date _____

Previous Report No. _____

Date _____

Bridge No. 79100400071

Eleven Digit No.

Underpass Location No. 79 - 10040 - 0660 -

Co. Route Log Mile

-0-

or

-

-

over/
under

79 - 02819 - 0518

Railroad/Walkway

Co.

Route

Log Mile

Co.

Route

Log Mile

County Shelby

Structure Name (If Named) _____

Year Constructed _____

Year Widened _____

Year Rehabilitated _____

GEOMETRIC FEATURES UNDER BRIDGE (*. * ft. unless otherwise noted)

Divided Highway LEFT RDWY () RIGHT RDWY (X) N.A. ()

Type of Wearing Surface CONCRETE (X) ASPHALT () GRAVEL ()

Width of Approach Traveled Roadway 50' ft. (Does Not Include Shoulders)Width of Median if Divided Highway 65' ft.Approach Shoulder Width 10' ft. Right 10' ft. Left*Horizontal Clearance Under Bridge 90' ft. 0 IN.*Distance Between Pier Protection Guardrail and Substructure N/A ft. Right 4' ft. Left*Width of Sidewalk Under Bridge N/A ft. Right N/A ft. Left*Minimum Vertical Clearance: 16 ft. 11 in.

*Show on Sketch

TRAFFIC SAFETY FEATURES FOR UNDERPASS ROUTE**STANDARD SUB-STANDARD NON EXIST**

Pier Protection Railing or Parapet (G) F P C () (X) ()

Approach Guardrail Transitions G F P C () () (X)

Approach Guardrail (G) F P C () (X) ()

Approach Guardrail Terminal (G) F P C () (X) ()

SIGNING FOR UNDERPASS ROUTE

Paddleboards YES () NO (X) NEEDED ()

Vertical Clearance (<14'-6") YES () NO (X) NEEDED ()

Narrow Passage YES () NO (X) NEEDED ()

One Lane Passage YES () NO (X) NEEDED ()

Other Underpass Signs Needed _____

INSPECTORS

1. REBECC
2. BYRD
3. _____
4. _____
5. _____
6. _____

SEP 1 1998

INSPECTION REPORT FOR UNDERPASS ROUTE

Form BIR 3.0A
(Rev. 9-22-98)
DT-1443

Field Report No. _____ Date _____
Previous Report No. _____ Date _____

Bridge No. 79100400071
Eleven Digit No.

Underpass Location No. 79 - 10040 - 0660 -

-0- or - - -
Railroad/Walkway Co. Route Log Mile

over/
under
79 - 02819 - 0518
Co. Route Log Mile

County Shelby

Structure Name (If Named) _____

Year Constructed _____

Year Widened _____ Year Rehabilitated _____

GEOMETRIC FEATURES UNDER BRIDGE (*. * ft. unless otherwise noted)

Divided Highway LEFT RDWY ☒ RIGHT RDWY () N.A. ()

Type of Wearing Surface CONCRETE ☒ ASPHALT () GRAVEL ()

Width of Approach Traveled Roadway 50 ft. (Does Not Include Shoulders)

Width of Median if Divided Highway 65 ft.

Approach Shoulder Width 10' ft. Right 10' ft. Left

*Horizontal Clearance Under Bridge 90 ft. 0 in.

*Distance Between Pier Protection
Guardrail and Substructure N/A ft. Right 4.0' ft. Left

*Width of Sidewalk Under Bridge N/A ft. Right N/A ft. Left

*Minimum Vertical Clearance: 17 ft. 6 in.

*Show on Sketch

TRAFFIC SAFETY FEATURES FOR UNDERPASS ROUTE

					<u>STANDARD</u>	<u>SUB-STANDARD</u>	<u>NON EXIST</u>
Pier Protection Railing or Parapet	<u>G</u>	F	P	C	()	()	()
Approach Guardrail Transitions	G	F	P	C	()	()	()
Approach Guardrail	<u>G</u>	F	P	C	()	()	()
Approach Guardrail Terminal	<u>G</u>	F	P	C	()	()	()

SIGNING FOR UNDERPASS ROUTE

Paddleboards YES () NO ☒ NEEDED ()
Vertical Clearance (<14'-6") YES () NO ☒ NEEDED ()
Narrow Passage YES () NO ☒ NEEDED ()
One Lane Passage YES () NO ☒ NEEDED ()
Other Underpass Signs Needed _____

INSPECTORS

- RG-LVGS
- BYRD
- _____
- _____
- _____
- _____

Date _____

Underpass Location No. 79 - 10040 - 0660 -
Co. Route Log Mile

Other Signs or Plaques: _____

Comments Regarding any Problems with Signing:

Bridge Skew 20.5°
 Structure Type (Main Span) Box Beam No. Main Spans 2
 Structure Type (Appr. Spans) _____ No. Appr. Spans _____
 Maximum Span Length 141 (ft.) Total Length 282' (ft.)
 Width of Bridge Out-to-Out 20' (ft.) Right Angle to Centerline of Bridge _____
 Width of Bridge Along Skew _____ (ft.) (If Unable to Measure at Right
 Number of Lanes/Tracks on Bridge 4 Angle to Centerline of Bridge _____)

G ~~F~~ P C

Does Potential Exist for Elements from Bridge Falling on Roadway Beneath YES () NO (X)

Does Potential Exist Because of Deteriorated Condition or Failure of Major Member YES () NO (X)

Comment on any Conditions of Bridge that would Effect Roadway Beneath:

Note: If Underpass Route is Divided Highway, Use Two of These Forms, One for Each Roadway.

1. Elevation View of Bridge on Both Sides Showing Underpass
2. View Showing Both Approaches to Bridge
3. View Showing Safety Features
4. View Showing Any Problems

Inspection Team's Summary

Bridge Location No. 79 - 10040 - 6.60 -
Inspection Date ⁷⁹ 8/19 - 4.93
Bridge Rating FAIR

SEP 11 2001

THIS TWO SPAN CONCRETE SOLID DECK BRIDGE
WITH CONCRETE SUBSTRUCTURE IS IN FAIR
CONDITION. ALL TRAFFIC SAFETY FEATURES ARE
PRESENT. APP. # 2 AT GUARDRAIL HAS COLLISION
DAMAGE. ABUT # 1 RTWING IS CRACKING & SPALLING.
MIN. VERTICAL CLEARANCE IS 16'11"

Caroline Adams

Cross Section: yes () no (X)

Pontis: yes () no (X)

SEP 11 2007

BRIDGE NO. 79 I-40 6.60 SKEW _____
CO. ROUTE L. M. (LOG) km


Direction of Route



PLAN VIEW

REQUIRED DATA.

1. F = FIXED
E = EXPANSION
2. S = SIMPLE
C = CONTINUOUS

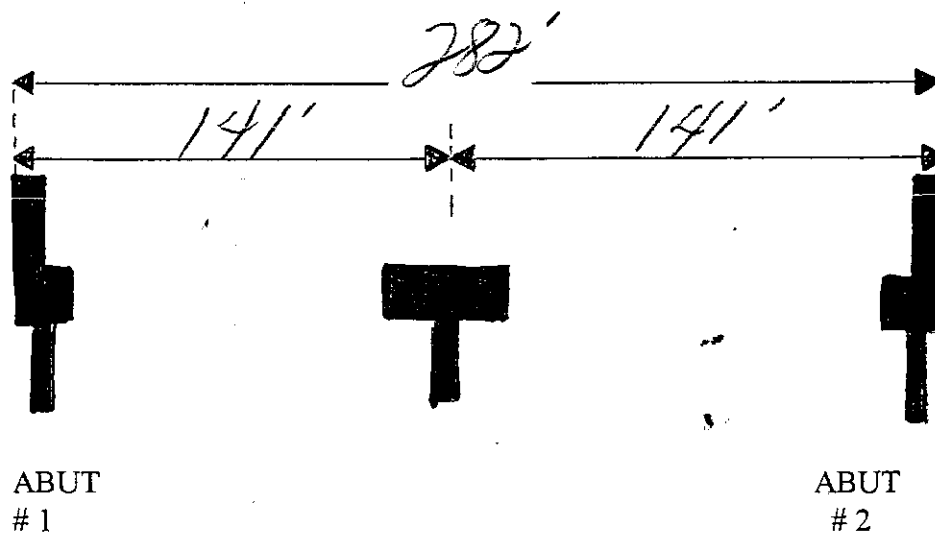


SEP 11 2001

BIR 3.10
Rev. 06/22/01
ET-1510

BRIDGE LOC. NO. 79 I0040 0660 -
CO. ROUTE L. M. L/R

DATE: _____


LATERAL AND VERTICAL CLEARANCES

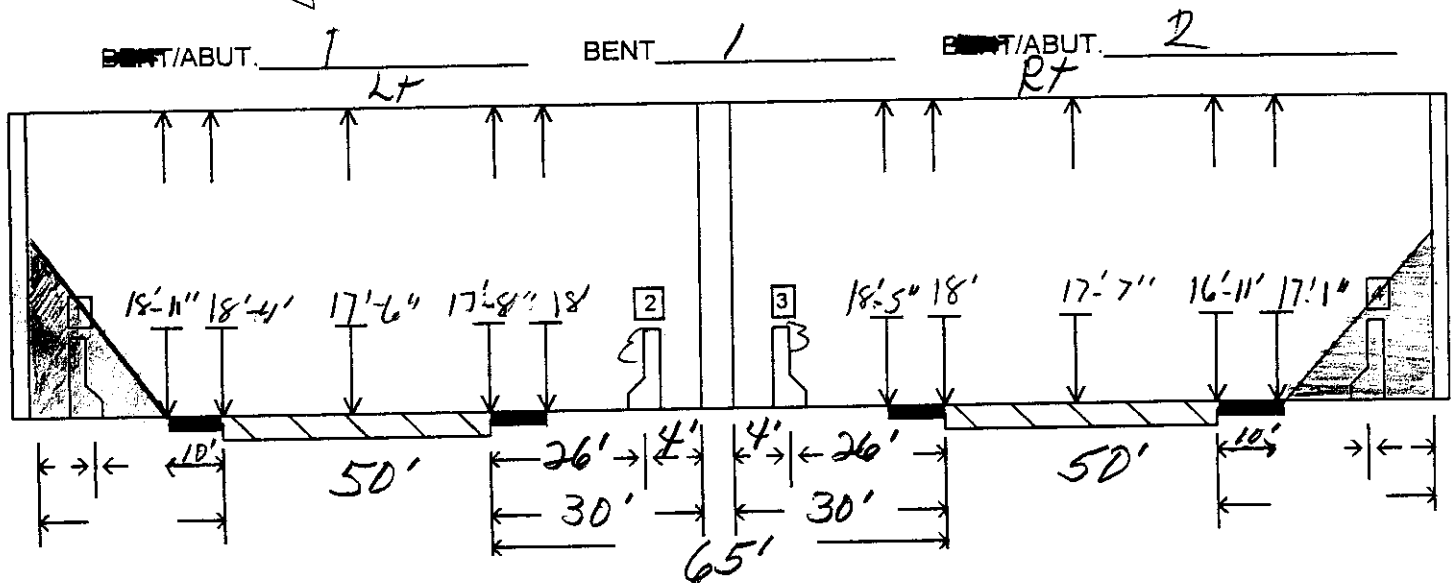

- | | | | | | | |
|-----------------------|---------|-----|---------------|-----|------|-----|
| 1. RAIL/BARRIER TYPE: | W-SHAPE | [] | CONC. BARRIER | [] | NONE | [] |
| 2. RAIL/BARRIER TYPE: | W-SHAPE | [] | CONC. BARRIER | [] | NONE | [] |
| 3. RAIL/BARRIER TYPE: | W-SHAPE | [] | CONC. BARRIER | [] | NONE | [] |
| 4. RAIL/BARRIER TYPE: | W-SHAPE | [] | CONC. BARRIER | [] | NONE | [] |


BENT/ABUT. _____

BENT/ABUT. _____

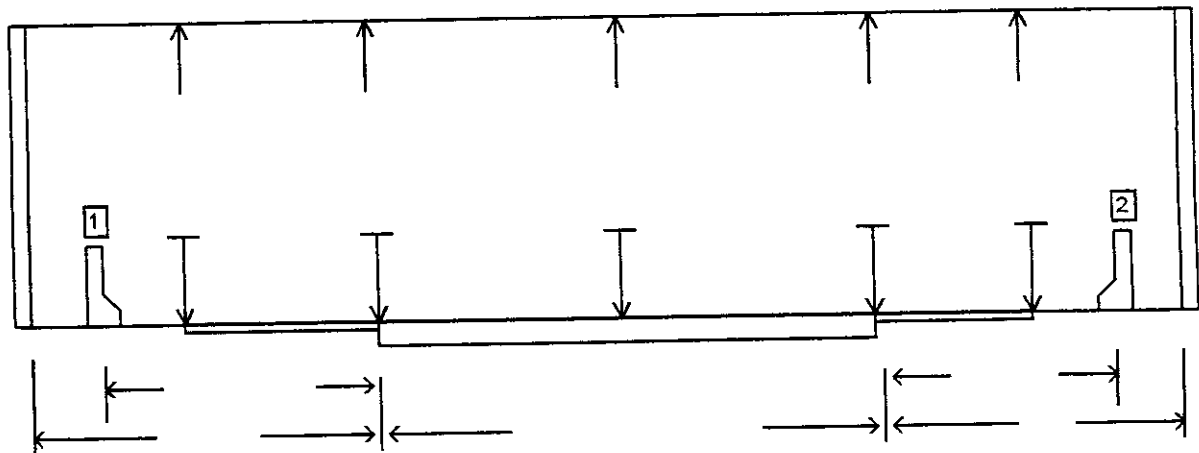

BENT/ABUT. _____


BENT/ABUT. _____

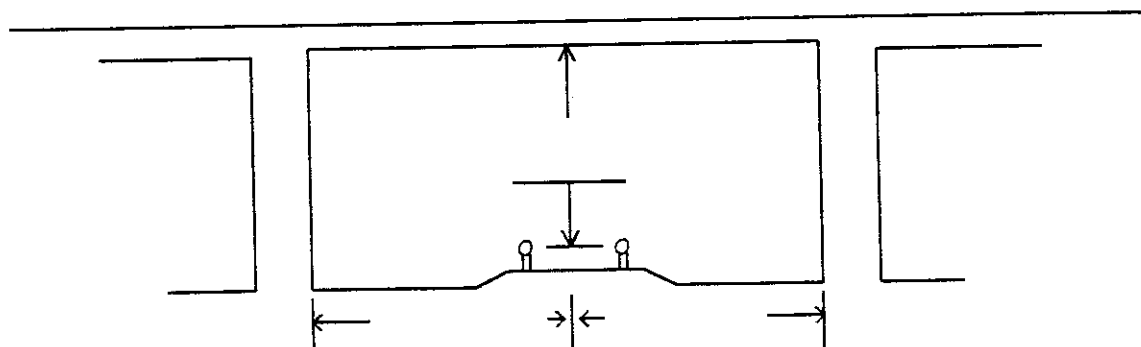

SEP 11 2004

BRIDGE NO.: 79I00400071 79 I0040 0660 - 80L DATE: _____

CO. ROUTE LOG MILE L/R SKEW

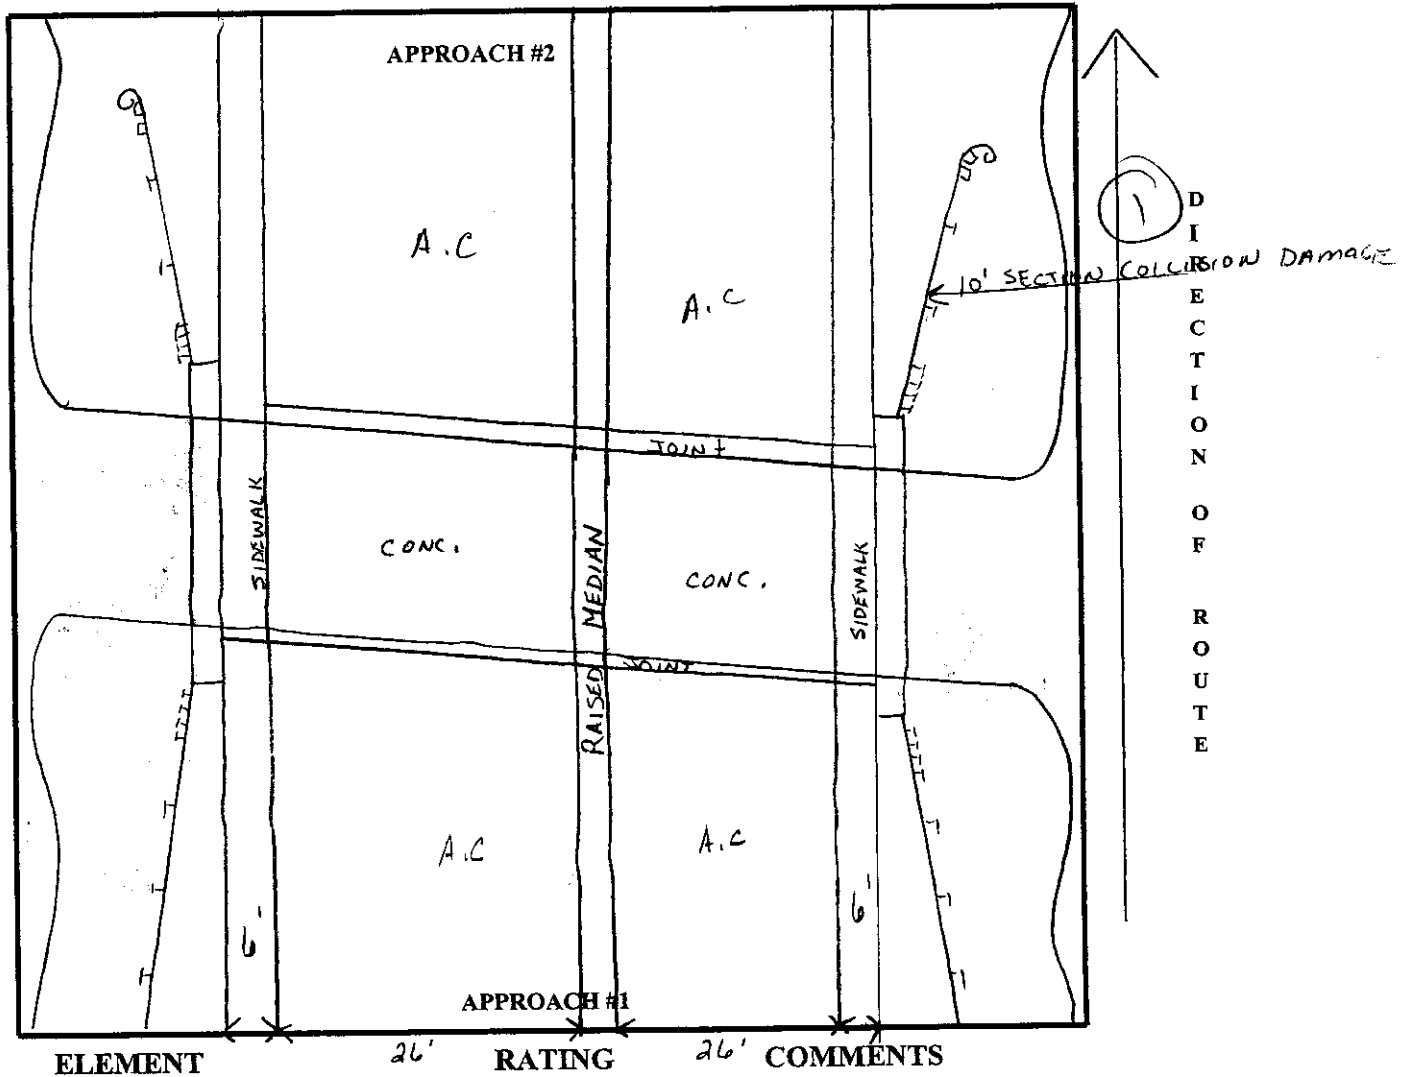

ALIGNMENT

(G) F P C

APPROACH PAVEMENT

(G) F P C

APPROACH SLAB

G F P C

APPROACH GUARDRAIL

G F (P) C

EMBANKMENT

(G) F P C

DRAINS

G F P C

APPROACH JOINT

(G) F P C

~~SEGS~~ MEDIAN

(G) F P C


N/V

APP. # 2 RT - SEE (L)

N/A

BRIDGE NO. 79-I-40-6160 SK. 80° LT

SEP 11 2001
SPAN NO 1

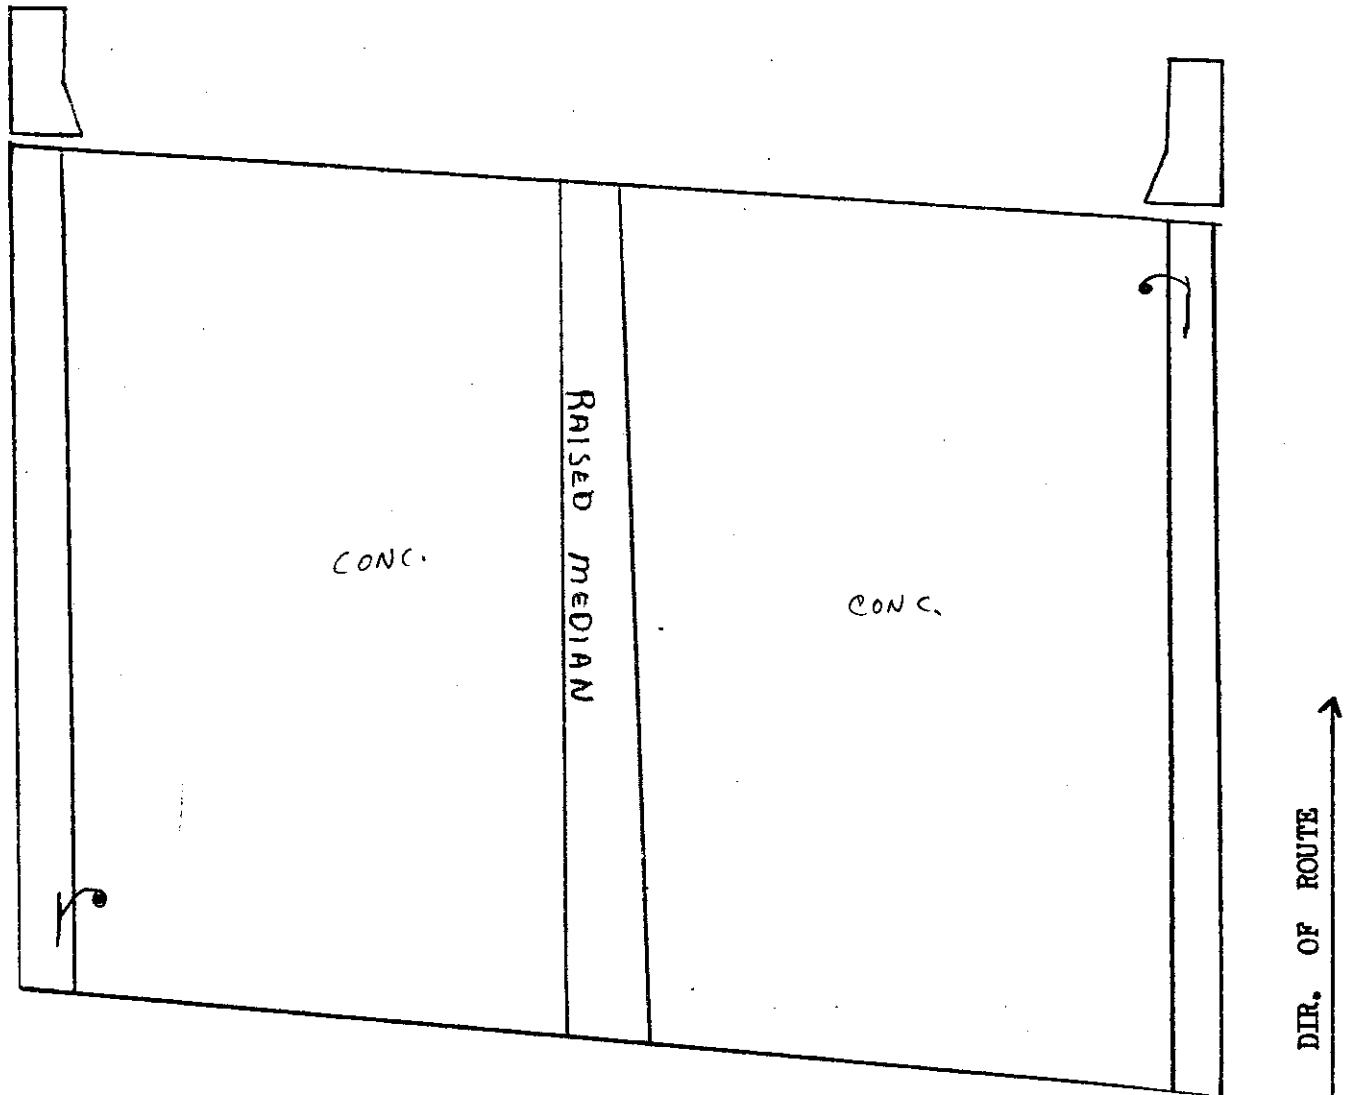

DECK (G) F P C

PARAPET (G) F P C

DRAINS G F P C

~~SCAFFOLD~~
LIGHT (G) F P C

RAILS (G) F P C

SIDEWALK (G)



MEDIAN (G)

CHASSIS (G)

N/A

SEP 11 2001

BRIDGE NO. 79-I-40-660 SK. 8004 SPAN NO. 1

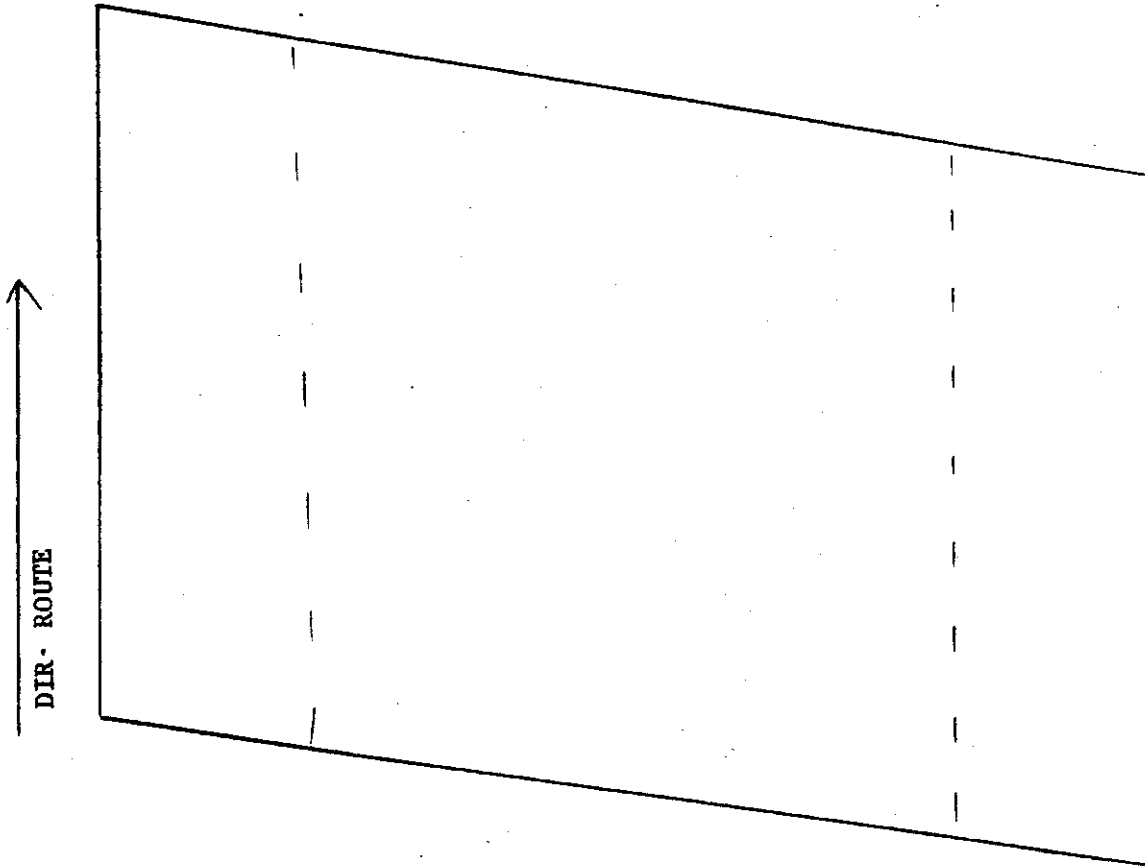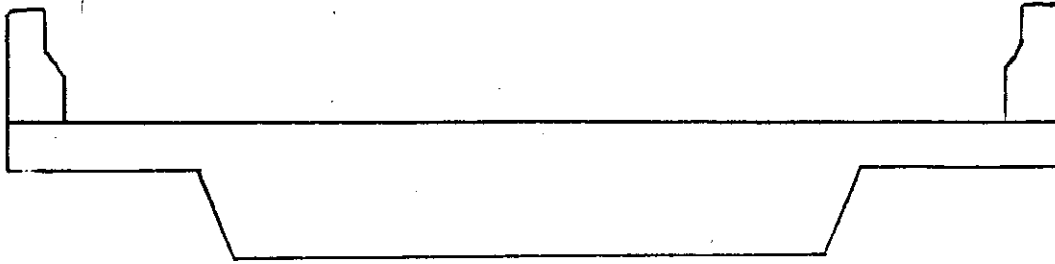


ELEMENT	RATING	COMMENTS
---------	--------	----------

BOTTOM DECK		
----------------	--	--

BOTTOM DECK	G F P C	
----------------	---------	--

BRIDGE NO. 79 E-40 -660 SK. 80° LT

SPAN NO. 2 SEP 3 2001

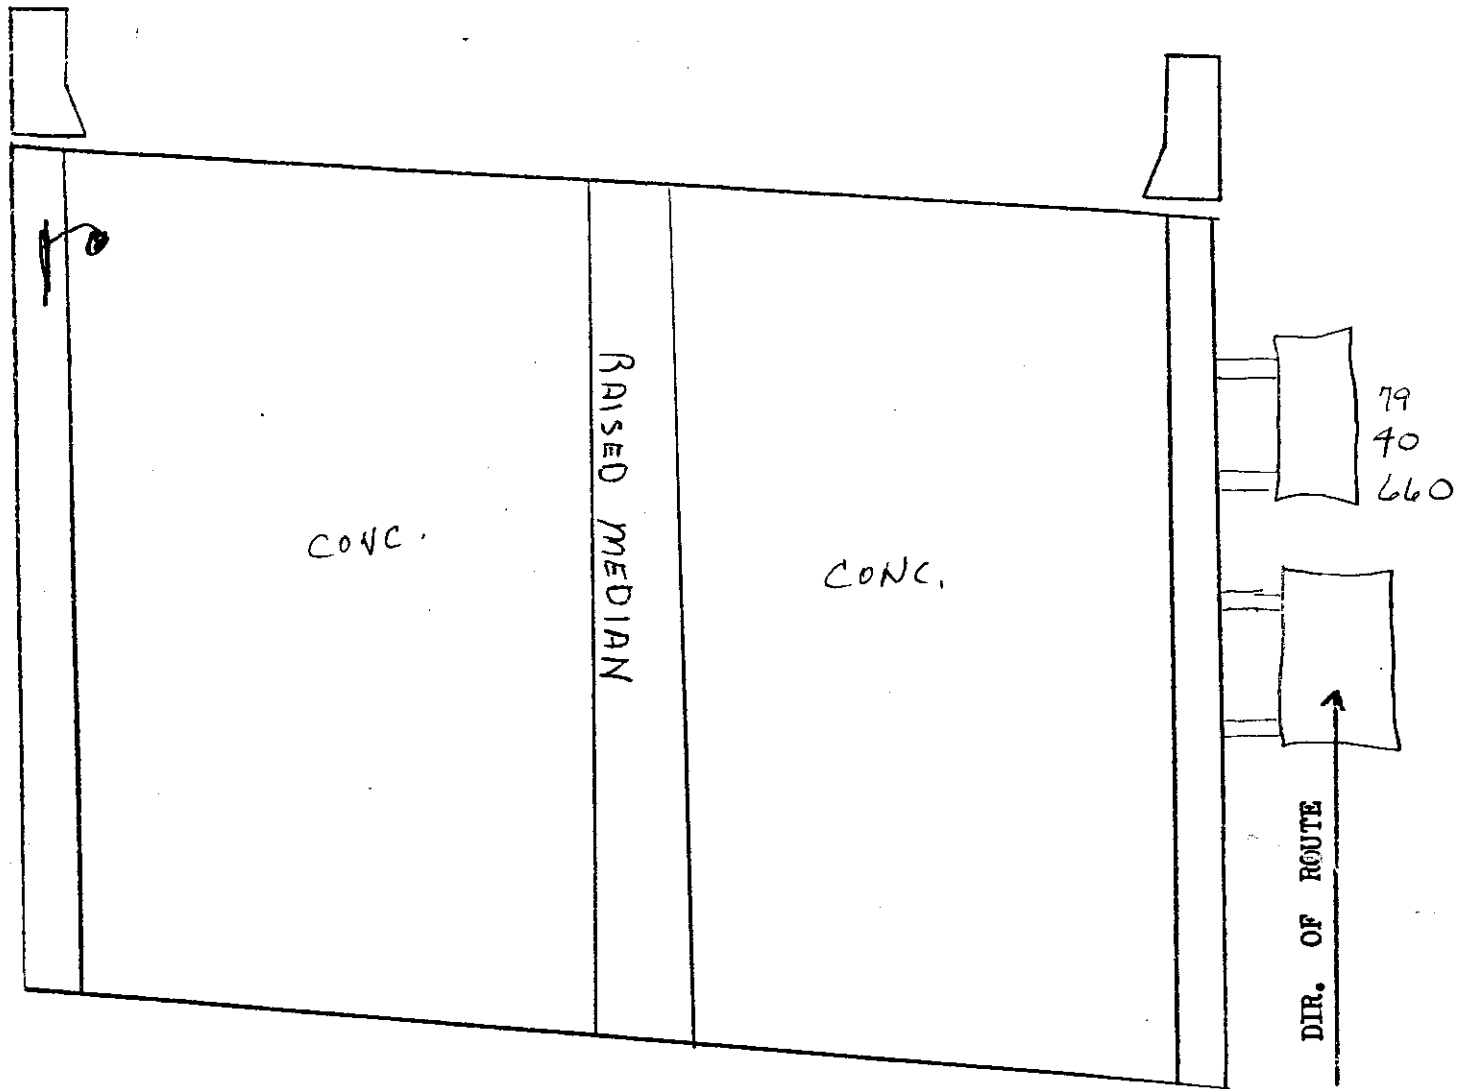

DECK (G) F P C

PARAPET (G) F P C

~~RAILS~~ (G) F P C

SIDEWALK

~~JOINTS~~ (G) F P C

SIGN (G)


RAILS (G) F P C

LIGHT (G)

MEDIAN (G)

CURB (G)


BRIDGE NO. 79 E 4th - 61st SK. 20267 SEP 11 2001 SPAN NO. 2

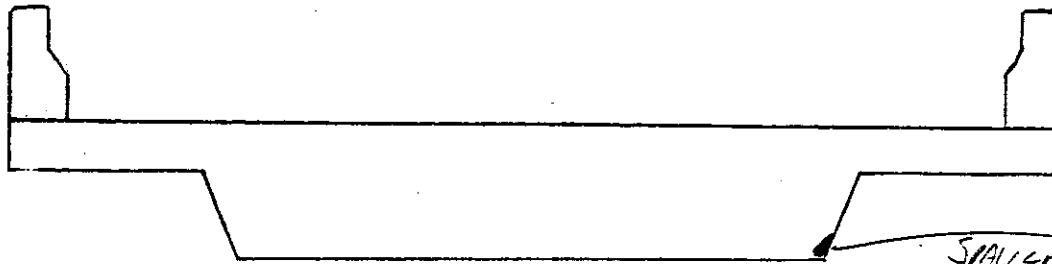

SPALLED AREA
 $\frac{2''}{L} \times \frac{3''}{W} \times \frac{1''}{D}$

①


↑
DIR. ROUTE

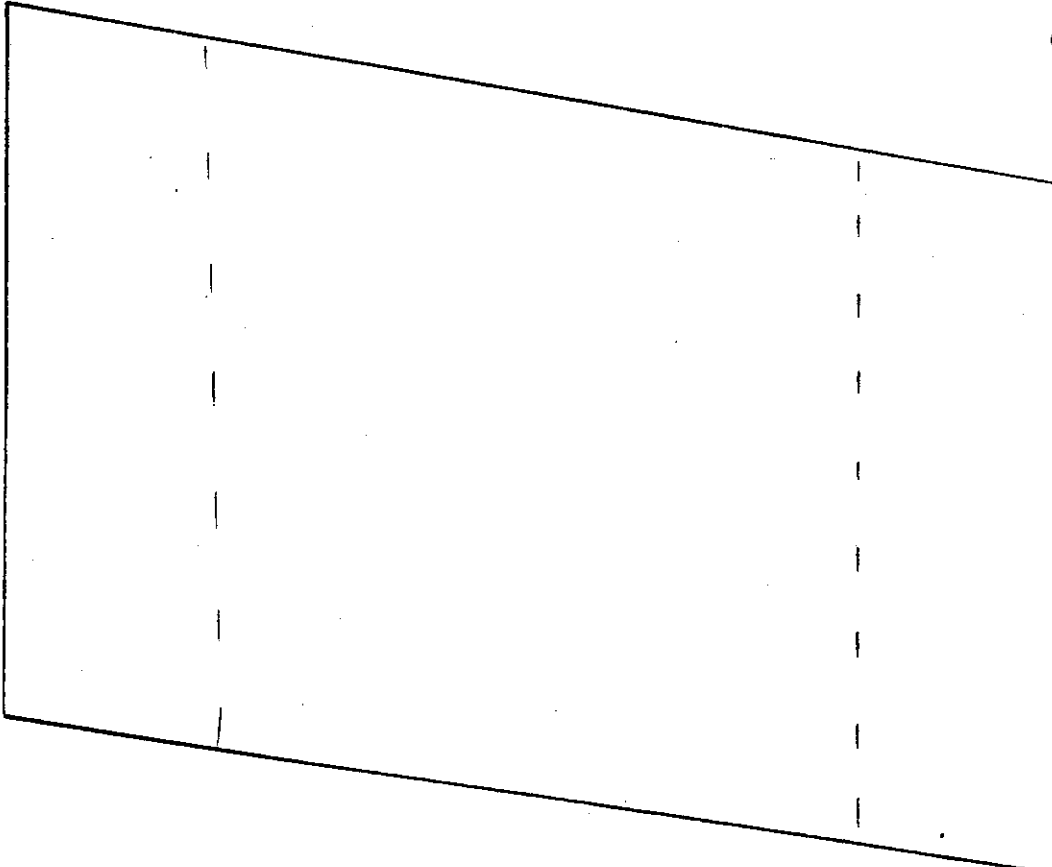


ELEMENT	RATING	COMMENTS
BOTTOM DECK	(G) P C	SEE ①
UTILITY	(G)	

BRIDGE NO. 79 I-40-6.60ABUT. NO. 7

SEP 11 2007

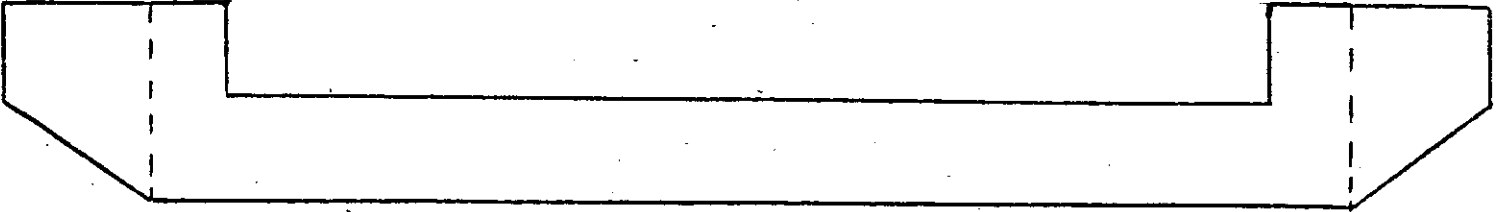LOOKING BACK

LEMENT	RATING	COMMENTS
BEARING	(G) F P C	
PAINT	(G) F P C	
CAP	(G) F P C	
WINGS	(G) F P C	SEE ①
EMB.	(G) F P C	
VEG.	(G) F P C	MODERATE GROWTH
RIP-RAP	G F P C	N/A
SLOPE PAV	(G) F P C	
BACKWALL	(G) F P C	
EARTH QUACK	(G)	

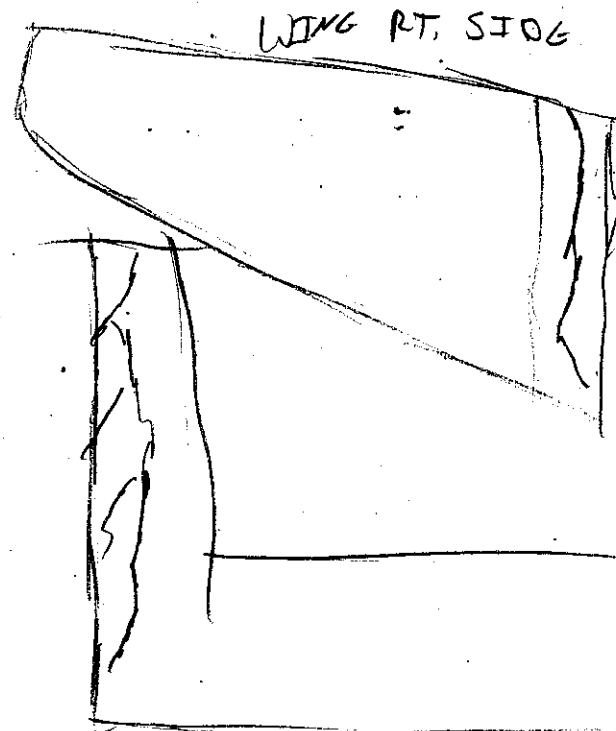




FRONT VIEW OF WING

① WING PATCHED - SPALLING
U/LP TO 1/2" OPEN CRACKS




BRIDGE NO 79-E-40-61e0

BENT NO 1

SEP 11 2001

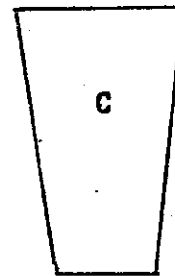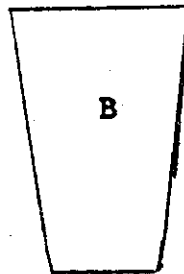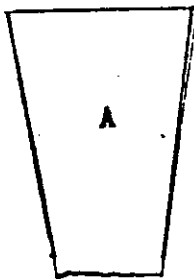

FRONT

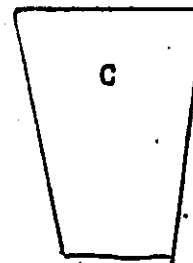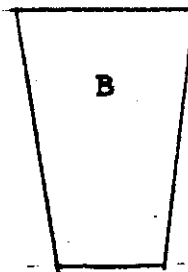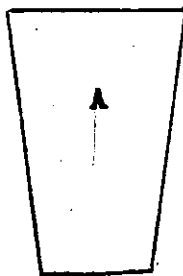

REAR


ELEMENT	RATING	COMMENT
STEM A	G F P C	
B	G F P C	
C	G F P C	

BRIDGE NO. 79 I-40-660

ABUT. NO. 2

SEP 1

LOOKING Ahead

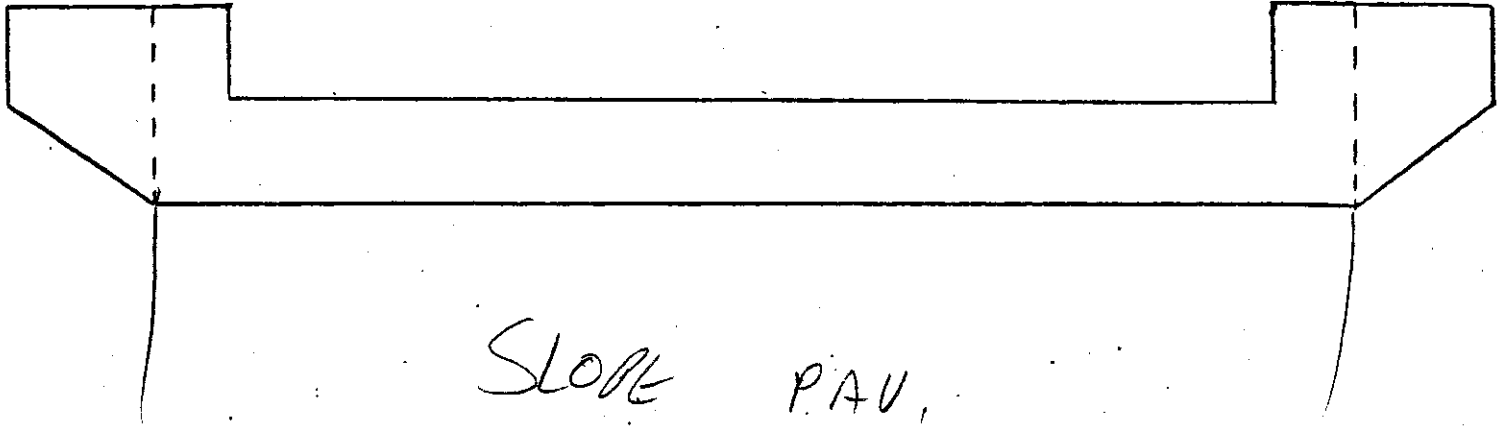

LEMENT	RATING	COMMENTS
BEARING	G F P C	
PAINT	G F P C	
CAP	G F P C	
WINGS	G F P C	SEG ①
EMB.	G F P C	
VEG.	G F P C	MODERATE GROWTH
RIP-RAP	G F P C	N/A
SLOPE PAV.	G F P C	
BACKWALL	G F P C	

LT. WING



PATCHED AREA
SPALLING

$$\frac{2'}{6} \times \frac{1'}{15} \times \frac{1'}{10}$$

①

ITEM	DESCRIPTION	UNIT	MCLEAN BLVD.	HIGHLAND STREET	TOTAL
209-08	TEMPORARY SILT FENCE	L.F.	50	50	100
307-03.16	BITUMINOUS PLANT MIX BASE (HOT MIX) GRADING B-M2	TON	20	20	40
403-01	BITUMINOUS MATERIAL FOR TACK COAT (TC)	TON	1	1	2
411-01.01	MINERAL AGGREGATE (ACS) GRADING D	TON	63	63	126
411-01.02	ASPHALT CEMENT (ACS) GRADING D	TON	4	4	8
415-01.02	COLD PLANING BITUMINOUS PAVEMENT	S.Y.	2022	2742	4764
604-04.02	APPLIED TEXTURE FINISH (EXISTING STRUCTURES)	S.Y.	3180	3264	6444
604-05.31	BRIDGE DECK GROOVING (MECHANICAL)	S.Y.	1504	1567	3071
604-10.05	CONCRETE	S.F.	30	45	75
604-10.14	REMOVE EXISTING WEARING SURFACE	L.S.	0.5	0.5	1
604-10.18	REINFORCING STEEL (REPAIRS)	LB.	820	-	820
604-10.20	HYDRODEMOLITION	S.Y.	1630	2045	3675
604-10.42	CONCRETE REPAIRS	C.F.	662	-	662
604-10.43	PENETRATING WATER REPELLENT CONCRETE SEAL	S.Y.	1180	1520	2700
604-10.44	EXPANSION JOINT REPAIR	L.F.	148	164	312
604-10.54	CONCRETE REPAIRS	S.F.	30	35	65
604-10.62	EPOXY INJECTION REPAIR (COMPLETE AND IN PLACE)	L.F.	-	140	140
617-02	BRIDGE DECK CRACK SEALING	L.F.	1796	1413	3209
617-05	SEALANT (HMWM)	GAL.	18	15	33
619-01	BRIDGE DECK OVERLAY (PMC)	S.Y.	1630	2045	3675
705-08.65	ENERGY ABSORBING TERMINAL (PORTABLE)	EACH	2	2	4
712-01	TRAFFIC CONTROL	L.S.	0.5	0.5	1
712-02.02	INTERCONNECTED PORTABLE BARRIER RAIL	L.F.	1350	1210	2560
712-04.01	FLEXIBLE DRUMS (CHANNELIZING)	EACH	158	158	316
712-05.03	WARNING LIGHTS (TYPE C)	EACH	82	82	164
712-06.10	NEW SIGNS (CONSTRUCTION)	S.F.	784	832	1616
712-06.01	VERTICAL PANELS	S.F.	44	44	88
712-06.16	SIGNS (CONSTRUCTION) (REDUCED SPEED WARNING)	EACH	2	2	4
712-08.03	FLASHING ARROW BOARD (TYPE C)	EACH	4	4	8
712-09.01	REMOVABLE PAVEMENT MARKING LINE (8" BARRIER LINE)	L.F.	7530	7240	14,770
713-16.03	CHANGEABLE MESSAGE SIGN	EACH	1	1	2
716-02.01	PAINTED PAVEMENT MARKING (LINE)	L.M.	0.6	0.5	1.1
717-01	MOBILIZATION	L.S.	0.5	0.5	1



BR-46-3

[illegible]

- ① INCLUDES THE COST OF ALL LABOR, MATERIALS AND EQUIPMENT TO FURNISHING AND INSTALLING THE TEMPORARY SILT FENCE, WHERE LOCATED BY THE ENGINEER, AND REMOVAL UPON PROJECT COMPLETION. SEE STD. DWG. EC-STR-3. THE ENGINEER MAY INCREASE, DECREASE OR ELIMINATE THE QUANTITY FOR THIS ITEM. SEE SUBSECTION 209.07 OF THE STANDARD SPECIFICATIONS FOR MAINTENANCE REPLACEMENT.
- ② INCLUDES COST OF LABOR AND MATERIALS TO PLACE ASPHALT MATERIAL AND ANY REQUIRED EXCAVATION FOR SHOULDER STRENGTHENING OR OTHER PURPOSES AS DIRECTED BY ENGINEER IN THE FIELD. THE QUANTITY MAY BE INCREASED, DECREASED, OR ELIMINATED BY THE ENGINEER.
- ③ INCLUDES ALL COSTS TO APPLY TEXTURE FINISH AS SHOWN IN THE DETAIL THIS DWG.
- ④ INCLUDES COST TO PERFORM BRIDGE DECK GROOVING WITHING 1'-0" OF THE TOE OF THE CURB FOR THE FULL LENGTH OF BRIDGE.
- ⑤ INCLUDES ALL COSTS TO PERFORM CONCRETE SPALL REPAIR USING CLASS "A" CONCRETE. FOR NOTES AND DETAILS SEE DWG. NO. BR-46-10.
- ⑥ INCLUDES ALL COSTS FOR REMOVING APPROXIMATELY 3" DEPTH OF EXISTING ASPHALT SURFACE FROM BRIDGE END TO BRIDGE END. FOR NOTES AND DETAILS, SEE TRAFFIC CONTROL SHEETS AND DWG. NO. BR-46-12.
- ⑦ INCLUDES COST OF ALL REINFORCING STEEL REQUIRED TO COMPLETE REPAIRS AS SHOWN ON THESE PLANS.
- ⑧ INCLUDES THE COST OF ALL LABOR, MATERIALS AND EQUIPMENT TO REMOVE AND DISPOSE OF ALL CONCRETE AND OTHER DEBRIS TO A MINIMUM 1/4" DEPTH BY HYDRODEMOLITION SUPPLEMENTED BY OTHER NECESSARY MEANS, INCLUDING VACUUMING, SHIELDING, CONTAINMENT, AND FILTRATION OF WASH WATER. FOR NOTES AND DETAILS, SEE DWG. NO. BR-46-8 AND SPECIAL PROVISION 604H.
- ⑨ INCLUDES ALL COSTS ASSOCIATED WITH REMOVING EXISTING MEDIAN AT MCLEAN STREET BRIDGE, CLEANING ALL EXPOSED REINFORCING STEEL, FORMING, HIGH EARLY STRENGTH CONCRETE AND ALL LABOR AND MATERIALS TO PERFORM REPAIRS AS SHOWN ON DWG. NO. BR-46-9. THIS ITEM WILL ALSO INCLUDE ALL COST ASSOCIATED WITH REMOVING AND REPLACING LIGHT SUPPORT AT MCLEAN STREET BRIDGE. FOR LOCATION, SE DWG. NO. BR-46-1.
- ⑩ INCLUDES ALL COSTS TO CLEAN AND COAT EXISTING SIDEWALKS AND MEDIANS AS SHOWN ON DETAILS DWG. NC. BR-46-9.
- ⑪ INCLUDES ALL COSTS TO REMOVE EXISTING EXPANSION JOINTS AND FURNISH AND INSTALL NEW POURED SEALANT JOINTS, INCLUDING CONCRETE REMOVAL, NEW CONCRETE, CLEANING EXPOSED REINFORCING STEEL AND ALL OTHER COMPONENTS NECESSARY FOR A COMPLETE INSTALLATION. SEE DWG. NO. BR-46-7 FOR NOTES AND DETAILS.
- ⑫ INCLUDES ALL COSTS TO PERFORM CONCRETE SPALL REPAIR USING CEMENTITIOUS PATCHING MATERIAL. FOR NOTES AND DETAILS, SEE DWG. NO. BR-46-10.
- ⑬ INCLUDES ALL COSTS ASSOCIATED WITH EPOXY INJECTED CRACK REPAIRS FOR LOCATIONS DETERMINED ON SITE BY ENGINEER. FOR NOTES AND DETAILS, SEE DWG. NO. BR-46-8.
- ⑭ INCLUDES ALL COSTS FOR INSTALLING DECK SEALER (HMWM) AT CONSTRUCTION JOINTS IN THE POLYMER MODIFIED CONCRETE DECK OVERLAY, INCLUDING DECK SURFACE PREPARATION, CLEANING, LABOR, SAND AND ALL MISCELLANEOUS MATERIALS REQUIRED TO SEAL THE JOINTS, ACCORDING TO MANUFACTURER'S SPECIFICATIONS. THIS ITEM DOES NOT INCLUDE THE COST FOR FURNISHING THE DECK SEALER (HMWM). SEE SPECIAL PROVISION 604CR.
- ⑮ INCLUDES ALL COSTS FOR FURNISHING THE SEALER MATERIAL (HMWM = HIGH MOLECULAR WEIGHT METHACRYLATE) FOR SEALING OVERLAY CONSTRUCTION JOINTS.
- ⑯ INCLUDES ALL COSTS ASSOCIATED WITH PLACING AND FINISHING OF POLYMER MODIFIED CONCRETE (PMC) OVERLAY. FOR NOTES AND DETAILS, SEE DWG. NO. BR-46-8, TN DOT STANDARD SPECIFICATION AND SPECIAL PROVISION 619A.
- ⑰ THIS ITEM SHALL BE A PORTABLE ENERGY ABSORBING TERMINAL MEETING THE REQUIREMENTS OF NCHRP 350 FOR TEST LEVEL 3. EXAMPLES WOULD BE A QUAD-GUARD OR A REACT 350. THE PAY ITEM WILL INCLUDE FURNISHING AND INSTALLING ALL COMPONENTS AS LISTED ON THE MANUFACTURER'S BILL OF MATERIALS. SHOP DRAWINGS OF THE PORTABLE ENERGY TERMINALS MUST BE SUBMITTED TO AND APPROVED BY THE DIVISION OF STRUCTURES PRIOR TO INSTALLATION.
- ⑱ INCLUDES ALL COSTS FOR FURNISHING INTERCONNECTED PORTABLE BARRIER RAIL FOR PHASE 1 & PHASE 2. PRICE BID SHALL INCLUDE ALL COSTS FOR RELOCATING AND REUSING THE INTERCONNECTED PORTABLE BARRIER RAIL FROM PHASE 1 TO PHASE 2.
- ⑲ INCLUDES ALL COSTS FOR FURNISHING AND INSTALLING VP-1L AND VP-1R VERTICAL PANELS MOUNTED ON THE INTERCONNECTED PORTABLE CONCRETE BARRIER RAIL (16 SIGNS VP-1L AND 16 SIGNS VP-1R). FOR NOTES AND DETAILS, SEE STD. DWG. NO. T-PBR-2. FOR LOCATIONS SEE SHEETS 6 & 7, TRAFFIC CONTROL PLAN.
- ⑳ INCLUDES ALL COSTS FOR FURNISHING, PLACING, REMOVING AND DISPOSAL OF REMOVABLE PAVEMENT MARKING. SEE TRAFFIC CONTROL SHEETS 6 & 7 AND DWG. NO. BR-46-10 FOR NOTES AND DETAILS.
- ㉑ MESSAGE BOARD SIGN TO BE LOCATED BY ENGINEER PRIOR TO I-40/I-240 INTERSECTIONS.

TN D.O.T. ENGINEERING SUPERVISOR M. LAWSON



SPECIFICATIONS: STANDARD ROAD AND BRIDGE SPECIFICATIONS OF THE TENNESSEE DEPARTMENT OF TRANSPORTATION. (MARCH 1, 1995 EDITION).

DESIGN SPECIFICATIONS: AASHTO 1992 EDITION WITH ADDENDA.

REINFORCING STEEL: SEE THE STANDARD SPECIFICATIONS.

CONCRETE: TO BE CLASS "A" CONCRETE IN ACCORDANCE WITH THE STANDARD SPECIFICATIONS.

SHOP DRAWINGS: SHALL BE SUBMITTED ACCORDING TO SPECIAL PROVISION NO. 105A, SHOP DRAWINGS SHALL BE SUBMITTED TO THE BRIDGE REPAIR OFFICE OF THE DIVISION OF STRUCTURES.

HIGH EARLY STRENGTH CONCRETE: THE MIX TO MEET THE REQUIREMENTS OF THE STANDARD SPECIFICATIONS CLASS "A", EXCEPT THE CEMENT CONTENT SHALL BE A MINIMUM OF 714 LBS. THE WATER-TO-CEMENT RATIO SHALL BE A MAXIMUM OF 0.40. NO FLY ASH REPLACEMENT WILL BE PERMITTED AND THE MINIMUM 28 DAY COMPRESSIVE STRENGTH SHALL BE 3,500 PSI.

BRIDGE DECK SURFACE FINISH: SHALL BE IN ACCORDANCE WITH METHOD (c) IN THE SUBSECTION 604.23 OF THE STANDARD SPECIFICATIONS.

CONCRETE CURING: ALL CONCRETE IN REPAIR AREAS SHALL BE CURED ACCORDING TO THE STANDARD SPECIFICATIONS.

NON-PAY ITEMS: ONLY ITEMS SHOWN ON THE PROPOSAL AS PAY ITEMS WILL BE PAID FOR. COMPENSATION FOR ALL LABOR, MATERIALS, TOOLS, EQUIPMENT, AND INCIDENTALS FOR THE ENTIRE CONTRACT SHALL BE INCLUDED IN THE PRICE FOR THE PAY ITEMS.

GRAOUTED BARS IN DRILLED HOLES: HORIZONTALLY DRILLED HOLES SHALL BE DRILLED 1/4" IN DIAMETER LARGER THAN THE BAR, CLEANED, PACKED WITH NON-SHRINK GROUT AND THE BAR ROTATED (NOT DRIVEN) TO ITS SEAT. VERTICALLY DRILLED HOLES SHALL BE DRILLED 1/4" IN DIAMETER LARGER THAN THE BAR, CLEANED, PACKED WITH EPOXY GROUT AND BAR DRIVEN TO ITS SEAT. ALL GROUTING MATERIAL SHALL BE APPROVED BY T.D.O.T. MATERIALS AND TESTS.

DEMOLITION: THE CONTRACTOR SHALL TAKE SPECIAL CARE TO PROTECT ANY PARTS OF THE STRUCTURE THAT ARE NOT TO BE REMOVED SPECIFICALLY. THE CONTRACTOR IS NOT ALLOWED TO USE TO USE A HYDRAULIC RAM MOUNTED ON A BACKHOE (COMMONLY CALLED A HOE RAM) OR OTHER SIMILARLY HEAVY EQUIPMENT FOR CONCRETE REMOVAL. PNEUMATIC HAMMERS MAY BE USED TO REMOVE UNSOUND CONCRETE, FOR PARTIAL DEPTH CONCRETE SLAB REMOVAL OR TO MAKE OUT OF THE RAM. MAXIMUM SIZE OF THE POUND CLAW SAWING OR CUTTING OF THE CONCRETE IS ACCEPTABLE SO LONG AS ANY SPECIFIED PROJECTION OF THE EXISTING REINFORCING STEEL IS MAINTAINED. ALL DEVICES PROPOSED FOR CONCRETE DEMOLITION SHALL MEET THE APPROVAL OF THE ENGINEER.

GROUT: GROUT SHALL BE A PORTLAND CEMENT TYPE IN ACCORDANCE WITH STANDARD SPECIFICATION 918.21-GROUT.

POLYMER MODIFIED CONCRETE: SEE THE STANDARD SPECIFICATIONS.

RIDEABILITY OF BRIDGE DECK: TO BE IN ACCORDANCE WITH ARTICLE 604-28 OF THE STANDARD SPECIFICATIONS.

COVER THE OVERLAY PROMPTLY WITH A SINGLE LAYER OF WET BURLAP. NEW BURLAP, EVEN WHEN PRESOAKED, CAN DRY OUT QUICKLY AND SHOULD BE AVOIDED OR PRESOAKED FOR SEVERAL DAYS. IT MAY REQUIRE THE BURLAP TO BE WET, LET DRY OUT, AND THIS PROCEDURE REPEATED SEVERAL TIMES TO ALLOW TOTAL ABSORPTION. USE WHITE VISQUEEN (PLASTIC) TO COVER THE WET BURLAP DURING THE OVERLAY IN HOT WEATHER.

PLACE THE WET BURLAP ON THE OVERLAY AS SOON AS POSSIBLE, CONSISTENTLY SPRAY A MIST OF WATER OVER THE BURLAP BEFORE IT IS COVERED WITH WHITE VISQUEEN (PLASTIC), HOWEVER, SPRAYING THE BURLAP WITH WATER BEFORE COVERING WITH WHITE VISQUEEN (PLASTIC) SHOULD NOT BE EXCESSIVE TO THE POINT THE WATER IS DAMAGING THE FRESH OVERLAY SURFACE.

THE WHITE VISQUEEN (PLASTIC) SHOULD BE PULLED, PLACED AND KEPT WITHIN TEN TO THIRTY FEET OF THE FRONT COVER OF BURLAP. THESE DISTANCES SHOULD BE ADJUSTED BASED ON THE WEATHER CONDITIONS AT THE TIME OF PLACEMENT. SECURE THE PLASTIC SO IT WILL NOT BLOW OFF THE BURLAP DURING THE WET CURE. MINIMIZING THE NUMBER OF SEAMS IN THE PLASTIC IS BEST SUITED FOR WRING AND EASIER TO SECURE.

SECURE THE PLASTIC BY USING THE RAILS, ROLLING OVER THE EDGES OF WET BURLAP ONTO THE PLASTIC, LAYING FOLDED WET BURLAP TRANSVERSELY ACROSS THE DECK OR BY KEEPING WATER ON THE SURFACE OF THE PLASTIC. SEAL THE PLASTIC TO AVOID THE WIND FROM PUFFING UP THE PLASTIC DURING THE WET CURE. EXERCISE CAUTION WHEN WETTING DOWN THE SURFACE OF THE PLASTIC SO AS NOT TO ALLOW THE WATER TO RUN INTO THE OVERLAY BEING PLACED.

DURING HOT SUMMER OVERLAYS, SOAKER HOSES SHOULD BE PLACED UNDER THE PLASTIC. THIS SHOULD BE DONE WHEN THE OVERLAY HAS SET LONG ENOUGH TO SUPPORT THE WEIGHT OF THE SOAKER HOSES AND AFTER THE OVERLAY PLACEMENT IS COMPLETED. USING THE COOLEST WATER POSSIBLE WILL GREATLY ENHANCE ALL THE PROCEDURES IN HOT WEATHER.

THE LATEX MODIFIED CONCRETE OVERLAYS SHALL BE POURED AT NIGHT (8:00 PM - 5:00 AM) UNLESS APPROVED OTHERWISE BY THE ENGINEER FOR THE BRIDGE INSPECTION AND REPAIR OFFICE.

THE CONTRACTOR SHALL USE THERMOPLASTIC PAVEMENT MARKING ON THE FINAL SURFACE, THE CONTRACTOR SHALL HAVE THE OPTION OF USING REFLECTORIZED PAINT INSTALLED TO PERMANENT STANDARDS AT THE END OF EACH DAY'S WORK AND THEN INSTALLING THE PERMANENT MARKING AFTER THE PAVING OPERATION IS COMPLETED. SHORT, UNMARKED SECTIONS SHALL NOT BE ALLOWED. THE TEMPORARY MARKINGS FOR THE FINAL SURFACE WILL NOT BE MEASURED AND PAID FOR DIRECTLY, BUT THE COST ARE TO BE INCLUDED IN THE PRICE BID FOR THE PERMANENT MARKINGS. THESE MARKINGS WILL BE MEASURED AND PAID FOR UNDER ITEM NO. 716-02.01, PLASTIC PAVEMENT MARKING (LINE) PER LIN. MI.

DESIGNED BY A.J. KHAIRI DATE MAR, 2000
 DRAWN BY K. KYZER DATE MAR, 2000
 SUPERVISED BY T. JOHNSON DATE MAR, 2000
 CHECKED BY T. JOHNSON DATE MAR, 2000

TN D.O.T. ENGINEERING SUPERVISOR M. LAWSON

ADVANCED WARNING SIGNS SHALL NOT BE DISPLAYED MORE THAN FORTY-EIGHT (48) HOURS BEFORE PHYSICAL CONSTRUCTION BEGINS. SIGNS MAY BE ERECTED UP TO ONE (1) WEEK BEFORE NEEDED, IF THE SIGN FACE IS FULLY COVERED.

IF THE CONTRACTOR MOVES OFF THE PROJECT, HE SHALL COVER OR REMOVE ALL UNNEEDED SIGNS AS DIRECTED BY THE ENGINEER. COST OF REMOVAL, COVERING AND REINSTALLING SIGNS SHALL NOT BE MEASURED AND PAID FOR SEPARATELY, BUT ALL COSTS SHALL BE INCLUDED IN THE ORIGINAL UNIT PRICE BID FOR ITEM NO. 712-06.10, NEW SIGNS (CONSTRUCTION), SQUARE FOOT.

A LONG TERM BUT SPORADIC USE WARNING SIGN, SUCH AS FLAGGER SIGNS, MAY REMAIN IN PLACE WHEN NOT REQUIRED PROVIDED THE SIGN FACE IS FULLY COVERED.

TRAFFIC CONTROL DEVICES SHALL NOT BE DISPLAYED OR ERECTED UNLESS RELATED CONDITIONS ARE PRESENT
NECESSITATING WARNING.

USE OF BARRICADES, PORTABLE BARRIER RAILS, VERTICAL PANELS AND DRUMS SHALL BE LIMITED TO THE IMMEDIATE AREAS OF CONSTRUCTION WHERE A HAZARD IS PRESENT. THESE DEVICES SHALL NOT BE STORED ALONG THE ROADWAY WITHIN THIRTY (30) FEET OF THE EDGE OF THE TRAVELED WAY BEFORE OR AFTER USE UNLESS PROTECTED BY GUARDRAIL, BRIDGE RAIL AND/OR BARRIERS INSTALLED FOR OTHER PURPOSES. THESE DEVICES SHALL BE REMOVED FROM THE CONSTRUCTION WORK ZONE WHEN THE ENGINEER DETERMINES THEY ARE NO LONGER NEEDED. WHERE THERE IS INSUFFICIENT RIGHT-OF-WAY TO PROVIDE FOR THIS THIRTY (30) FEET SETBACK, THE CONTRACTOR SHALL DETERMINE ALTERNATE LOCATIONS AND REQUEST THE ENGINEER'S APPROVAL TO USE THEM.

THE CONTRACTOR WILL NOT BE PERMITTED TO PARK ANY VEHICLES OR CONSTRUCTION EQUIPMENT DURING PERIODS OF INACTIVITY WITHIN THIRTY (30) FEET OF THE EDGE OF PAVEMENT WHEN THE LANE IS OPEN TO TRAFFIC, UNLESS PROTECTED BY GUARDRAIL, BRIDGE RAIL AND/OR BARRIERS INSTALLED FOR OTHER PURPOSES. PRIVATELY OWNED VEHICLES SHALL NOT BE ALLOWED TO BE PARKED WITHIN THIRTY (30) FEET OF AN OPEN TRAFFIC LANE AT ANY TIME UNLESS PROTECTED AS DESCRIBED ABOVE. WHERE THERE IS INSUFFICIENT RIGHT-OF-WAY TO PROVIDE FOR THIS THIRTY (30) FEET SETBACK, THE CONTRACTOR SHALL DETERMINE ALTERNATE LOCATIONS AND REQUEST THE ENGINEER'S APPROVAL TO USE THEM.

GUARDRAIL: CONTRACTOR SHALL NOT REMOVE ANY SECTIONS OF EXISTING GUARDRAIL TO REWORK SHOULDERS OR FLATTEN SLOPES UNTIL THE ENGINEER CONCURS IN THE NECESSITY OF REMOVAL DUE TO CONSTRUCTION REQUIREMENTS AND THE APPROPRIATE WARNING DEVICES ARE INSTALLED. THE PROPOSED GUARDRAIL, INCLUDING ANY ANCHOR SYSTEM SHALL BE INSTALLED QUICKLY TO MINIMIZE TRAFFIC EXPOSURE TO ANY HAZARD. NO PAYMENT WILL BE MADE FOR A SECTION OF PROPOSED GUARDRAIL, INCLUDING ANCHORS, UNTIL IT IS COMPLETELY IN PLACE.

ALL DETOUR AND CONSTRUCTION SIGNING SHALL BE IN STRICT ACCORDANCE WITH THE MANUAL ON UNIFORM TRAFFIC CONTROL DEVICES.

ALL DETOURS SHALL BE PAVED, STRIPED, SIGNED AND THE CHANNELIZING DEVICES ARE TO BE IN PLACE BEFORE BEING OPENED TO TRAFFIC.

THE LOCATIONS OF UTILITIES SHOWN WITHIN THESE PLANS ARE APPROXIMATE ONLY. EXACT LOCATIONS SHALL BE DETERMINED IN THE FIELD BY CONTACTING THE UTILITY COMPANIES INVOLVED.

UNLESS OTHERWISE NOTED, ALL UTILITY ADJUSTMENTS WILL BE PERFORMED BY THE UTILITY OR ITS REPRESENTATIVE. THE CONTRACTOR AND UTILITY OWNERS WILL BE REQUIRED TO CO-OPERATE WITH EACH OTHER IN ORDER TO EXPEDITE THE WORK REQUIRED BY THIS CONTRACT.

THE CONTRACTOR WILL PROVIDE ALL NECESSARY PROTECTIVE MEASURES TO SAFEGUARD EXISTING UTILITIES FROM DAMAGE DURING CONSTRUCTION OF THIS PROJECT. IN THE EVENT THAT SPECIAL EQUIPMENT IS REQUIRED TO WORK OVER AND AROUND THE UTILITIES, THE CONTRACTOR WILL BE REQUIRED TO FURNISH SUCH EQUIPMENT. THE COST OF PROTECTING UTILITIES FROM DAMAGE AND FURNISHING SPECIAL EQUIPMENT WILL BE INCLUDED IN THE PRICE BID FOR OTHER ITEMS OF CONSTRUCTION.

PRIOR TO SUBMITTING HIS BID THE CONTRACTOR WILL BE SOLELY RESPONSIBLE FOR CONTACTING OWNERS OF ALL AFFECTED UTILITIES IN ORDER TO DETERMINE THE EXTENT TO WHICH UTILITY RELOCATIONS AND/OR ADJUSTMENTS WILL HAVE UPON THE SCHEDULE OF THE WORK FOR THE PROJECT, WHILE SOME WORK MAY BE REQUIRED 'AROUND' UTILITY FACILITIES THAT WILL REMAIN IN PLACE, OTHER UTILITY FACILITIES MAY NEED TO BE ADJUSTED CONCURRENTLY WITH THE CONTRACTOR'S OPERATIONS. ADVANCE CLEAR CUTTING MAY BE REQUIRED BY THE ENGINEER AT ANY LOCATION WHERE CLEARING IS CALLED FOR IN THE SPECIFICATIONS AND CLEAR CUTTING IS NECESSARY FOR A UTILITY RELOCATION. ANY ADDITIONAL COST WILL BE INCLUDED IN THE UNIT PRICE BID FOR THE CLEARING ITEM SPECIFIED IN THE PLANS.

THE CONTRACTOR SHALL NOTIFY EACH INDIVIDUAL OWNER OF HIS PLAN OF OPERATION IN THE AREA OF UTILITIES. PRIOR TO COMMENCING THE WORK, THE CONTRACTOR SHALL CONTACT OWNERS AND REQUEST THEM TO PROPERLY LOCATE THEIR RESPECTIVE UTILITY ON THE GROUND. THIS NOTIFICATION SHALL BE GIVEN AT LEAST THREE (3) BUSINESS DAYS PRIOR TO COMMENCEMENT OF OPERATIONS AROUND THE UTILITY.

SOME UTILITIES CAN BE LOCATED BY CALLING THE TENNESSEE ONE CALL SYSTEM , INC., AT 1-800-351-1111.

UNLESS OTHERWISE NOTIFIED ALL UTILITY ADJUSTMENTS WILL BE PERFORMED BY THE UTILITY OR ITS REPRESENTATIVE. THE CONTRACTOR AND UTILITY OWNERS WILL BE REQUIRED TO COOPERATE WITH EACH OTHER IN ORDER TO EXPEDITE THE WORK REQUIRED BY THIS CONTRACT. ON CONTRACTS WHERE CONSTRUCTION STAKES, LINES AND GRADES ARE A CONTRACT ITEM, THE CONTRACTOR WILL BE REQUIRED TO PROVIDE RIGHT-OF-WAY OR SLOPE STAKES, DITCH OR STREAM BED GRADES, OR OTHER ESSENTIAL SLOPE STAKING TO PREVENT CONFLICTS WITH THE HIGHWAY CONSTRUCTION. FREQUENTLY THIS WILL BE REQUIRED AS THE FIRST ITEM OF WORK, AND AT ANY LOCATION OF THE PROJECT DIRECTED BY THE ENGINEER.

THE CONTRACTOR SHALL BE REQUIRED TO COLD PLANE AND PAVE IN THE DIRECTION OF TRAFFIC.

[illegible]


STATE OF TENNESSEE
DEPARTMENT OF TRANSPORTATION


GENERAL NOTES
MCLEAN BLVD. OVER I40
BRIDGE NO. 79-2819-4.93

**HIGHLAND STREET OVER I40
BRIDGE NO. 79-4186-2.11**

**SHELBY COUNTY
2000**

BR-46-4

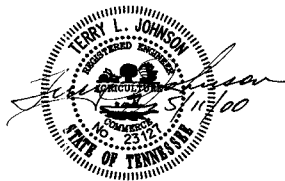

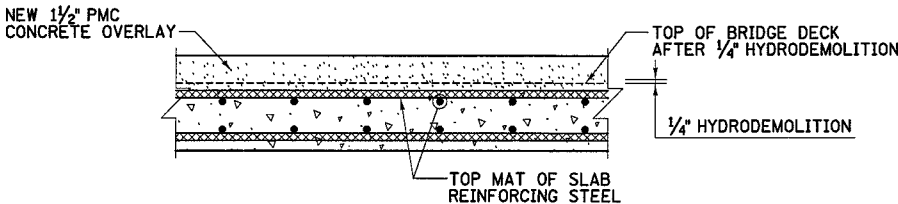

DETAIL SHOWING CONCRETE OVERLAY
N.T.S.


NOTES REGARDING POLYMER MODIFIED CONCRETE (PMC) OVERLAY

1. ALL COST ASSOCIATED WITH PLACEMENT AND FINISHING OF POLYMER MODIFIED CONCRETE (PMC) OVERLAY IN ACCORDANCE WITH STANDARD SPECIFICATIONS INCLUDING ANY TOOLS, LABOR, EQUIPMENT OR INCIDENTALS SHALL BE INCLUDED UNDER ITEM NO. 619-01 BRIDGE DECK OVERLAY (PMC), S.Y.


NOTES REGARDING HYDRODEMOLITION

1. THE REMOVAL OF TOP 1/4" OF BRIDGE DECK CONCRETE SHALL BE DONE USING HYDRODEMOLITION EQUIPMENT (SELF-PROPELLED MACHINE THAT UTILIZES HIGH WATER PRESSURE). ROTOMILLING OF EXISTING CONCRETE DECK PRIOR TO HYDRODEMOLITION WILL NOT BE ALLOWED. PNEUMATIC HAMMERS, 35 POUND CLASS MAXIMUM, MAY BE USED IN AREAS THAT ARE INACCESSIBLE OR INCONVENIENT TO THE SELF-PROPELLED MACHINE SUCH AS, BUT NOT LIMITED TO, AREAS NOT TO EXCEED ONE FOOT AWAY FROM CURBS OR PARAPETS.
2. PRIOR TO THE COMMENCEMENT OF THE REMOVAL OPERATION, THE HYDRODEMOLITION EQUIPMENT SHALL BE CALIBRATED ON AN AREA OF SOUND CONCRETE APPROXIMATELY 2 FT X 5 FT AS DIRECTED BY THE ENGINEER. THE REQUIRED DEPTH OF REMOVAL SHALL BE VERIFIED PERIODICALLY AND, IF NECESSARY, THE EQUIPMENT WILL BE RE-CALIBRATED TO INSURE THE REQUIRED DEPTH OF REMOVAL. THE CALIBRATION PROCESS WILL BE INCLUDED UNDER ITEM NO. 604-10.20 HYDRODEMOLITION, S.Y.
3. WASTE WATER FROM THE HYDRODEMOLITION PROCESS SHALL BE CONTROLLED AND FILTERED TO PRODUCE A VISIBLY CLEAR WATER PRIOR TO RELEASING IT TO SURROUNDING ENVIRONMENT. SEDIMENT BASINS AT THE END OF OR OUTSIDE OF THE STRUCTURE SHALL BE USED IF FURTHER FILTRATION IS REQUIRED TO PRODUCE VISIBLY CLEAR WATER. BRIDGE DECK DRAINS SHALL BE PLUGGED DURING HYDRODEMOLITION PROCESS.
4. AFTER HYDRODEMOLITION IS APPLIED, CLEANING OF THE BRIDGE DECK SHALL BE PERFORMED WITH A VACUUM SYSTEM CAPABLE OF REMOVING WET DEBRIS AND WATER. CLEANING SHALL BE DONE BEFORE DEBRIS AND WATER IS ALLOWED TO DRY ON DECK. ALL EXPOSED REINFORCING STEEL WHICH IS LEFT UNSUPPORTED BY HYDRODEMOLITION PROCESS SHALL BE ADEQUATELY SUPPORTED AND PROTECTED FROM BENDING BY VACUUM TRUCK OR ANY OTHER EQUIPMENT. ALL REINFORCING STEEL DAMAGED OR DISLODGED BY THESE OPERATIONS SHALL BE REPLACED WITH EPOXY COATED BARS OF THE SAME SIZE AT THE EXPENSE OF CONTRACTOR.
5. THE FINISH SURFACE SHALL MATCH EXISTING SURFACE SLOPE (NORMAL CROWN WITH 0.018 FOOT PER FOOT SLOPE).
6. ALL COSTS ASSOCIATED WITH HYDRODEMOLITION, INCLUDING ALL MATERIAL AND LABOR NECESSARY TO REMOVE AND DISPOSE OF ALL CONCRETE AND OTHER DEBRIS TO A 1/4" MINIMUM DEPTH, INCLUDING ROTOMILLING, VACUUMING, SHIELDING, CONTAINMENT, FILTRATION OF WASTE WATER, ADDITIONAL JACKHAMMERING, AND ALL OTHER ASPECTS OF WORK NECESSARY TO REMOVE TOP 1/4" MINIMUM OF BRIDGE DECK CONCRETE BY HYDRODEMOLITION SHALL BE INCLUDED UNDER ITEM NO. 604-10.20, HYDRODEMOLITION, S.Y.
7. SEE ALSO SPECIAL PROVISION 604H

HIGHLAND
MCLEAN

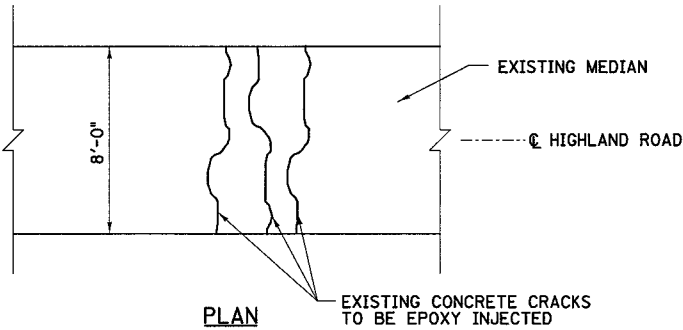

EPOXY INJECTION FOR
MEDIAN CRACK REPAIR

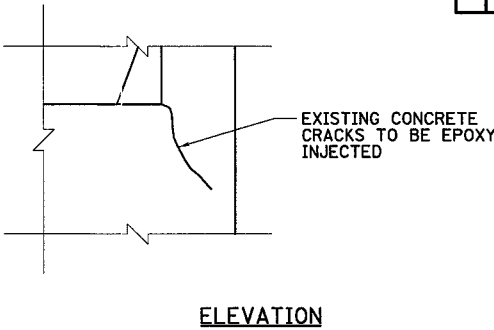

EPOXY INJECTION FOR
VERTICAL CRACKS

NOTES:

ALL CRACKS SMALLER THAN 1/4" SHALL BE INJECTED WITH AN APPROVED EPOXY RESIN ADHESIVE. ALL CRACKS 1/4" OR LARGER SHALL BE INJECTED WITH AN APPROVED EPOXY RESIN ADHESIVE OF THE GEL TYPE.

EXTREME CAUTION SHALL BE TAKEN WHEN SELECTING A PRESSURE NECESSARY TO COMPLETE THE EPOXY INJECTION CRACK REPAIR SO AS NOT TO DAMAGE THE STRUCTURE BY CAUSING ADDITIONAL CRACKING. IF ADDITIONAL DAMAGE OCCURS, THE CONTRACTOR SHALL BEAR FULL RESPONSIBILITY. ALL EPOXY INJECTION WORK SHALL MEET WITH THE FULL APPROVAL OF THE ENGINEER.

ALL EPOXY INJECTION CONTRACTORS AND/OR SUBCONTRACTORS SHALL BE APPROVED BY THE TENNESSEE DEPARTMENT OF TRANSPORTATION, DIVISION OF MATERIALS AND TESTS.

AFTER EPOXY INJECTION IS COMPLETE, ALL INJECTION PORTS SHALL BE REMOVED AND ALL EXCESS SEALING MATERIAL AND EPOXY SHALL BE REMOVED FLUSH WITH THE SURROUNDING CONCRETE SURFACES.

CRACK LOCATIONS SHOWN THIS SHEET ARE APPROXIMATE ONLY. THE ENGINEER FROM THE STRUCTURES DIVISION, BRIDGE INSPECTION AND REPAIR WILL MAKE EXACT CRACK LOCATIONS TO RECEIVE EPOXY INJECTION.

THE ENGINEER SHALL COLLECT RANDOM SAMPLES OF THE EPOXY RESIN FOR EVALUATION BY THE MATERIALS AND TEST DEPARTMENT, DEPARTMENT OF TRANSPORTATION, FOR VERIFICATION OF THE STRENGTH AND QUALITY OF THE MATERIAL.

IF THE CRACKS ARE NOT FULLY SEALED OR THE STRENGTH REQUIREMENTS ARE NOT MET, THEN REDUCTION IN PAYMENT DETERMINED BY THE ENGINEER WILL BE MADE TO THE CONTRACTORS BID PRICE OF ITEM NO. 604-10.62, EPOXY INJECTION REPAIRS (COMPLETE AND IN PLACE), L.F.

THE ENGINEER FROM THE STRUCTURES DEVISION, BRIDGE INSPECTION AND REPAIR OFFICE SHALL DESIGNATE FOUR (4) RANDOM LOCATIONS WHERE THE CRACKS HAVE BEEN EPOXY INJECTED FOR THE CONTRACTOR TO CORE. THE ONE (1) INCH DIAMETER CORES WILL BE IMMEDIATELY TURNED OVER TO THE ENGINEER FOR INSPECTION AND TO VERIFY FULL SEALING OF THE CRACKS. COST OF CORING SHALL BE INCLUDED IN ITEM NO. 604-10.62, EPOXY INJECTION REPAIRS (COMPLETE AND IN PLACE), L.F.

COST OF ALL LABOR AND MISCELLANEOUS MATERIALS NECESSARY TO COMPLETE THE EPOXY INJECTION REPAIRS TO EXISTING CONCRETE CRACKS SHALL BE INCLUDED UNDER ITEM NO. 604-10.62, EPOXY INJECTION REPAIRS (COMPLETE AND IN PLACE) L.F. ITEM NO. 604-10.62 SHALL BE BID SUCH THAT THIS ITEM MAY BE INCREASED, DECREASED, OR ELIMINATED AS DIRECTED BY THE ENGINEER.

HIGHLAND


STATE OF TENNESSEE
DEPARTMENT OF TRANSPORTATION

BRIDGE REPAIR DETAILS
MCLEAN BLVD. OVER I40
BRIDGE NO. 79-2819-4.93
HIGHLAND STREET OVER I40
BRIDGE NO. 79-4186-2.11


SHELBY COUNTY
2000



DESIGNED BY A.J. KHAIRI DATE MAR. 2000
DRAWN BY K. KYZER DATE MAR. 2000
SUPERVISED BY T. JOHNSON DATE MAR. 2000
CHECKED BY T. JOHNSON DATE MAR. 2000
TN D.O.T. ENGINEERING SUPERVISOR M. LAWSON

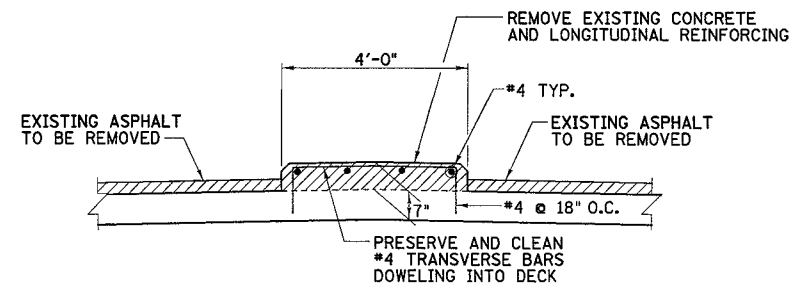

DEMOLITION

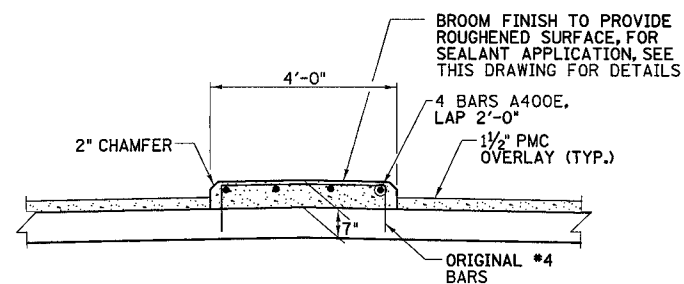

CONSTRUCTION

MEDIAN REPLACEMENT DETAILS

SCALE: 1/2" = 1'-0"

NOTE:



WHEN REMOVING THE EXISTING MEDIAN CONCRETE, CARE SHALL BE TAKEN SO AS NOT TO DAMAGE THE EXISTING TRANSVERSE REINFORCING STEEL DOWELING INTO THE SLAB. THE LONGITUDINAL STEEL SHALL BE REMOVED.

THE TRANSVERSE REINFORCING STEEL TO REMAIN SHALL BE CLEANED AND INCORPORATED INTO THE NEW MEDIAN.

THE COST OF REMOVING THE EXISTING MEDIAN CONCRETE, REMOVING EXISTING LONGITUDINAL REINFORCING STEEL, FORMING, HIGH EARLY STRENGTH CONCRETE AND ALL MATERIALS AND LABOR NECESSARY FOR THE MEDIAN REPLACEMENT SHOWN IN THESE DETAILS SHALL INCLUDED IN ITEM NO. 604-10.42, CONCRETE REPAIRS, C.F.

COST OF EPOXY COATED REINFORCING STEEL SHALL BE INCLUDED IN ITEM NO. 604-10.18, REINFORCING STEEL (REPAIRS), LB.


MCLEAN

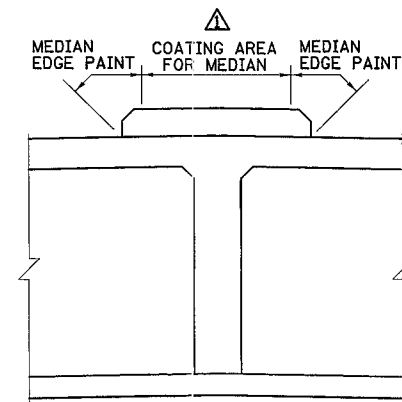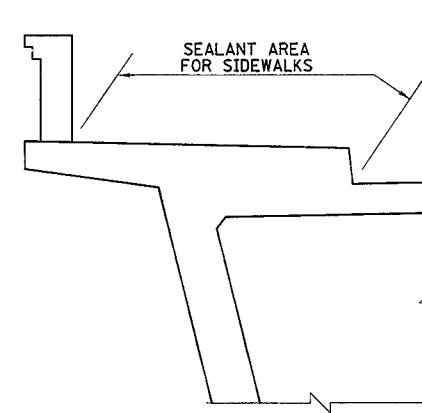

SEALANT COVERAGE DETAIL

NOTE:

DO NOT APPLY COATING TO AREAS TO RECEIVE YELLOW EDGE MARKING.

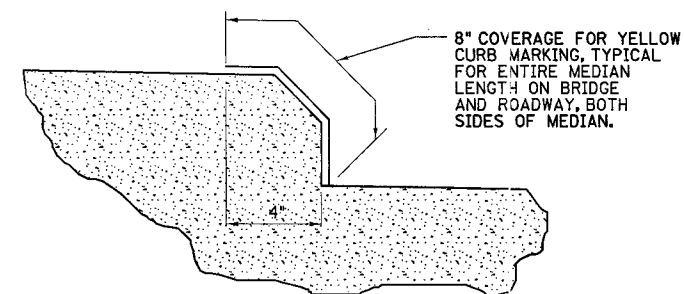

MEDIAN EDGE PAINT DETAIL

NOTES:

SAND BLAST OR WATER BLAST EXISTING SIDEWALK AND MEDIAN TO PROVIDE CLEAN AND ROUGHENED SURFACE BEFORE APPLYING SIDEWALK AND MEDIAN COATING, AND TO REMOVE YELLOW COATING ON MEDIAN EDGES.

THE NEW CONCRETE SURFACE OF THE MEDIAN SHALL RECEIVE A BROOM FINISH TO PROVIDE A ROUGHENED SURFACE BEFORE APPLYING COATING.

THE SIDEWALK AND MEDIAN COATING SHALL BE MASTER BUILDERS RE39. A FLEXIBLE, CEMENTITIOUS COATING FOR WATERPROOFING AND PROTECTION, APPLIED IN TWO COATS IN STRICT CONFORMANCE WITH THE MANUFACTURER'S WRITTEN INSTRUCTIONS.

ALL WORK SHALL MEET WITH THE FULL APPROVAL OF ENGINEER.

ALL COSTS ASSOCIATED WITH SAND OR WATER BLAST CLEANING, FURNISHING COATING MATERIALS, LABOR, AND ANY NECESSARY MATERIALS SHALL BE INCLUDED IN ITEM NO. 604-10.43, PENETRATING WATER REPELLENT CONCRETE SEAL, S.Y.

THE CONCRETE MEDIAN ON THE APPROACH ROADWAYS SHALL ALSO RECEIVE THE PREPARATION AND COATING.

HIGHLAND ROAD: APPROX. 1,500 L.F. ON ROADWAY APPROACHES
MCLEAN BLVD.: APPROX. 1,255 L.F. ON ROADWAY APPROACHES

ALL COSTS ASSOCIATED WITH MARKING THE MEDIAN EDGES SHALL BE PAID FOR UNDER ITEM NO. 716-02.01, PAINTED PAVEMENT MARKING (LINE), L.F. THE EDGE PAINTING BE MEASURED AT THE RATE OF TWO LINEAR FEET OF 4" LINE PER LINEAR FOOT OF MEDIAN EDGE.

MCLEAN

HIGHLAND

STATE OF TENNESSEE
DEPARTMENT OF TRANSPORTATION

BRIDGE REPAIR DETAILS

MCLEAN BLVD. OVER I40/I240
BRIDGE NO. 79-2819-4.93

HIGHLAND STREET OVER I40/I240
BRIDGE NO. 79-4186-2.11

SHELBY COUNTY
2000




DESIGNED BY: A.J. KHAIRI DATE: MAR. 2000
DRAWN BY: K. KYZER DATE: MAR. 2000
SUPERVISED BY: T. JOHNSON DATE: MAR. 2000
CHECKED BY: T. JOHNSON DATE: MAR. 2000

TN D.O.T. ENGINEERING SUPERVISOR: M. LAWSON

BR-46-9

■ DENOTES AREA OF EXISTING SPALLED CONCRETE

★ SAW CUT EXISTING CONCRETE 1" DEEP SO AS TO OBTAIN A RECTANGULAR AREA. ALL EXISTING REINFORCEMENT SHALL BE CAREFULLY PRESERVED AND BLAST CLEANED.

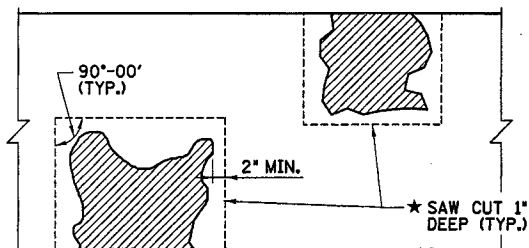

REMOVE ALL DETERIORATED CONCRETE TO A MIN. DEPTH OF 4" AND A MIN. 3/4" BEHIND THE EXISTING REINFORCING STEEL FOR REPAIR AREAS UNDER ITEM 604-10.05, CONCRETE, S.F.

EXISTING REINFORCING STEEL TO BE CLEANED AND REMAIN IN STRUCTURE

DENOTES AREA OF EXISTING SPALLED CONCRETE

EXISTING CONCRETE SURFACE

★ SAW CUT 1" DEEP (TYP.)

FORM NEW CONCRETE SURFACE FLUSH WITH ADJACENT CONCRETE SURFACE. PROVIDE A MIN. OF 1" COVER BY BENDING EXISTING REINFORCEMENT BACK BEHIND FINISHED SURFACE IF REQ'D.

REMOVE ALL DETERIORATED AND LOOSE CONCRETE TO A MIN. DEPTH OF 2" OR TO SOUND CONCRETE FOR CONCRETE REPAIR AREAS PAID FOR UNDER ITEM NO. 604-10.54, CONCRETE REPAIRS, S.F.

SPALL SURFACE REPAIR DETAILS

NOTES FOR ITEM NO. 604-10.54:

THE COST OF SAW CUTTING, REMOVING SPALLED OR CRACKED CONCRETE, BLAST CLEANING, PATCHING MATERIAL, LABOR AND ANY MISCELLANEOUS MATERIALS NECESSARY TO COMPLETE THE REPAIRS AS SHOWN SHALL BE INCLUDED IN ITEM NO. 604-10.54, CONCRETE REPAIRS, S.F.

PATCHING MATERIAL SHALL BE A POLYMER-MODIFIED CEMENTITIOUS STRUCTURAL PATCHING VERTICAL AND OVERHEAD MATERIAL. SEE T.D.O.T. QUALIFIED PRODUCTS LIST 13, SPEC. CATEGORY J, SUBLIST F FOR ACCEPTABLE PATCHING MATERIALS.

AFTER CONCRETE REMOVAL OF THE 2" DEPTH HAS TAKEN PLACE, THE ENGINEER SHALL HAVE THE OPTION TO REMOVE ADDITIONAL CONCRETE DEPTH AND SHALL DESIGNATE THIS AREA TO BE REPAIRED AND PAID FOR UNDER ITEM NO. 604-10.05 INSTEAD OF UNDER ITEM NO. 604-10.54.


ITEM NO. 604-10.54 SHALL BE BID SUCH THAT THIS ITEM MAY BE INCREASED, DECREASED, OR ELIMINATED AS DIRECTED BY THE ENGINEER.

☞ ALL AREAS TO BE REPAIRED ARE TO BE MARKED BY THE ENGINEER FROM THE BRIDGE INSPECTION AND REPAIR OFFICE.

NOTES FOR ITEM NO. 604-10.05:

COST OF CUTTING, REMOVING SPALLED OR CRACKED CONCRETE, BLAST CLEANING, CONCRETE, LABOR AND ANY MISCELLANEOUS MATERIALS NECESSARY TO COMPLETE THE REPAIRS AS SHOWN SHALL BE INCLUDED IN ITEM NO. 604-10.05, CONCRETE, S.F.


CONCRETE SHALL BE CLASS "A" CONCRETE, $f'_c = 3000$ PSI AT 28 DAY STRENGTH.

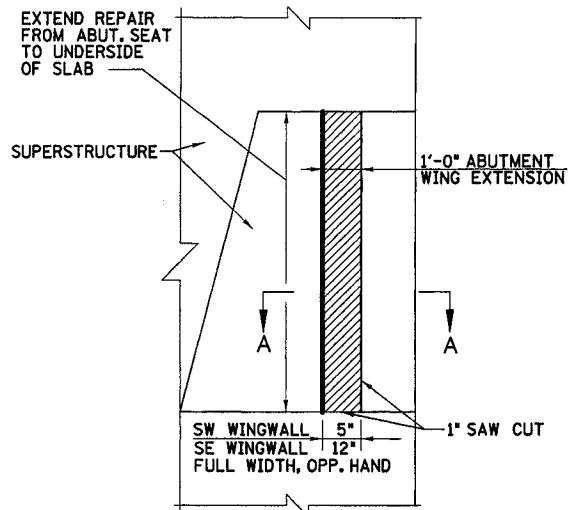

ELEVATION

NOTE:

THIS DETAIL SHOWS THE TYPICAL JOINT REPAIR BETWEEN THE SUPERSTRUCTURE AND WINGWALL ONLY. THERE WILL ALSO BE ADDITIONAL SPALL REPAIR IN THESE AREAS THAT WILL BE DELINEATED IN THE FIELD BY THE ENGINEER. PAYMENT WILL BE INCLUDED UNDER ITEM NO. 604-10.54, CONCRETE REPAIRS, S.F.

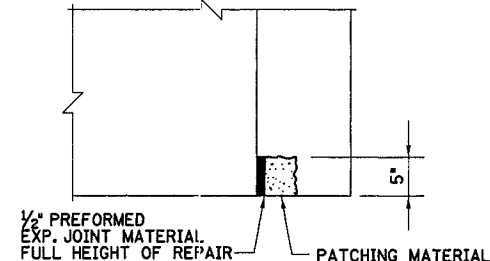


SECTION A-A

ABUTMENT WING EXTENSION REPAIR

SE AND SW CORNERS @ MCLEAN BLVD.

MCLEAN

EXISTING EPOXY INJECTED PORT TO BE REMOVED OR CUT OFF FLUSH WITH THE SURFACE

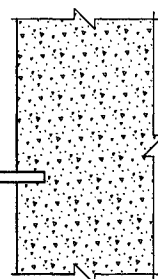

NOTE:


EXISTING EPOXY INJECTION PORTS PROTRUDING FROM THE SURFACE SHALL BE REMOVED FLUSH WITH OR BELOW THE CONCRETE SURFACE. ANY RESULTING HOLES SHALL BE PATCHED FLUSH WITH THE CONCRETE SURFACE WITH CEMENTITIOUS PATCHING MATERIAL.

CARE SHALL BE TAKEN TO NOT SPALL THE CONCRETE ADJACENT TO THE INJECTION PORT. ANY SPALLS CREATED BY THE CONTRACTOR SHALL BE REPAIRED IN ACCORDANCE WITH THE SPALL REPAIR DETAIL, INCLUDING 1" DEEP SAW CUTTING, AT NO COST TO THE STATE.

THE FINAL CONCRETE SURFACE, PRIOR TO TEXTURE COATING, SHALL BE SATISFACTORY TO THE ENGINEER.

ALL COSTS FOR LABOR AND MATERIALS FOR CUTTING OFF OR REMOVING APPROXIMATELY 14 EXISTING EPOXY INJECTION PORTS SHALL BE MEASURED AT THE QUANTITY OF 0.10 S.F. AND PAID FOR UNDER ITEM NO. 604-10.54, CONCRETE REPAIRS, S.F.

REMOVE EXISTING EPOXY INJECTION PORTS

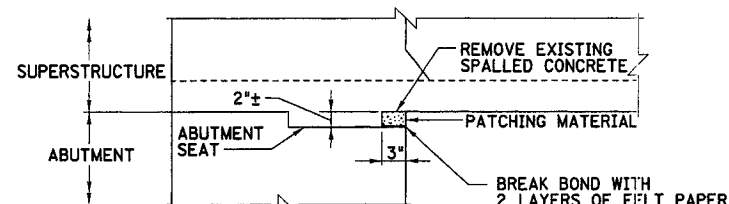

AREA MEASURED FOR SPALL REPAIR SHALL BE .167 FEET (2") TIMES THE LENGTH DESIGNATED IN THE FIELD BY THE ENGINEER. PAYMENT WILL BE INCLUDED IN ITEM NO. 604-10.54, CONCRETE REPAIRS, S.F.

SUPERSTRUCTURE BEARING SPALL REPAIR

HIGHLAND

STATE OF TENNESSEE
DEPARTMENT OF TRANSPORTATION

BRIDGE REPAIR DETAILS
MCLEAN BLVD. OVER I40
BRIDGE NO. 79-2819-4.93

HIGHLAND STREET OVER I40
BRIDGE NO. 79-4186-2.11

SHELBY COUNTY
2000



DESIGNED BY: A.J. KHAIRI
DRAWN BY: K. KYZER
SUPERVISED BY: T. JOHNSON
CHECKED BY: T. JOHNSON

DATE MAR. 2000
DATE MAR. 2000
DATE MAR. 2000
DATE MAR. 2000


TN D.O.T. ENGINEERING SUPERVISOR M. LAWSON

BR-46-10

[illegible]


CONTRACTOR SHALL CALL MEMPHIS GAS,
LIGHT AND WATER TO REMOVE, STORE AND
REINSTALL EXISTING LIGHT POLE AFTER
SUPPORT RECONSTRUCTION. EXISTING
WIRING AND CONDUIT TO BE REUSED.

EXISTING ANCHOR BOLTS AND REINF.
STEEL TO BE PRESERVED, CLEANED
AND INCORPORATED INTO NEW WORK.
CONTRACTOR SHALL MAINTAIN ANCHOR
BOLT SPACING TO MATCH EXISTING
LIGHT POLE.

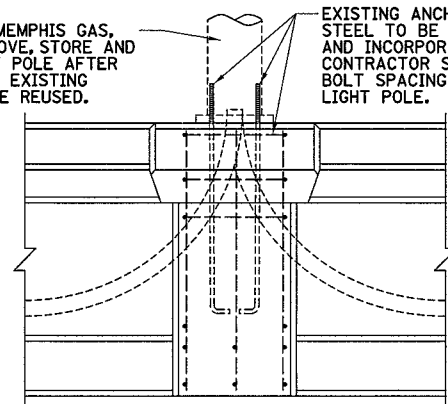ELEVATION

—RAIL SUPPORT ADJACENT TO LIGHT
SUPPORT NOT TO BE DISTURBED


—1" SAW CUT

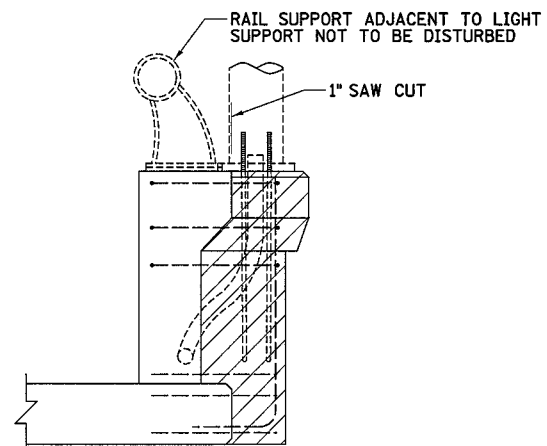

SECTION

DEMOLITION

SCALE: 1" = 1'-0"

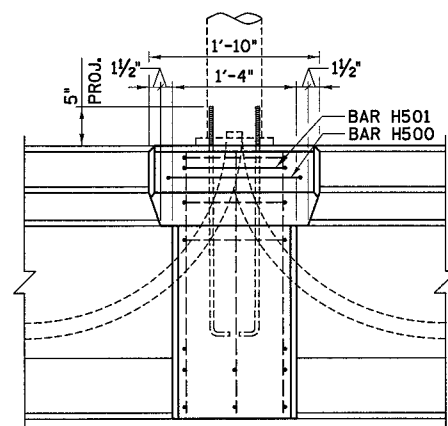ELEVATION


MEMPHIS GAS, LIGHTS AND WATER
TO REINSTALL ORIGINAL LIGHT POLE
AND RECONNECT ELECTRICAL WIRING

— LEVEL BEARING
(GROUT IF NECESSARY)

EPOXY GROUT H BARS -
WITH 9" EMBEDMENT

EXISTING
CONDUIT

MATCH EXISTING LOCATION	PROPOSED LOCATION
1	2
3	4
5	6
99	100

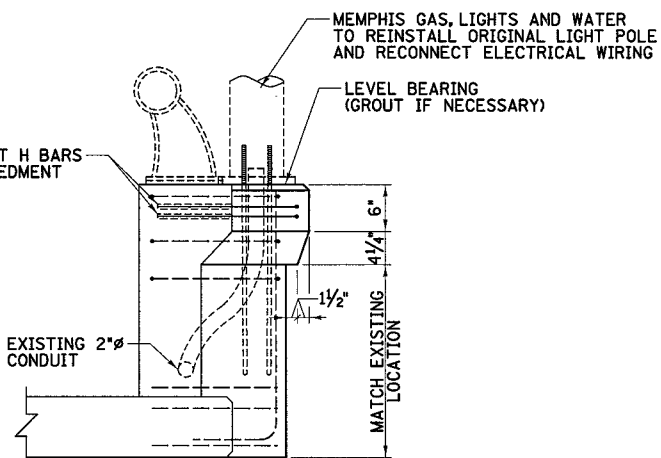

SECTION

REPLACE LIGHT SUPPORT

SCALE: 1" = 1'-0"

MCLEAN

NOTES:

WHEN REMOVING EXISTING DETERIORATED CONCRETE, CARE SHALL BE TAKEN SO AS NOT TO DAMAGE ANY EXISTING REINFORCING STEEL IN THE LIGHT SUPPORT.

ALL EXISTING REINFORCING STEEL TO REMAIN IN THE LIGHT SUPPORT IS TO BE CLEANED AND INCORPORATED IN WITH NEW REINFORCING STEEL.


COST OF REMOVING EXISTING DETERIORATED CONCRETE, FORMING, HIGH EARLY STRENGTH CONCRETE, AND ALL MATERIALS AND LABOR NECESSARY FOR REPAIRS AS SHOWN IN THESE DETAILS TO BE INCLUDED IN ITEM NO. 604-10.42, CONCRETE REPAIRS, C.F.

COST OF REINFORCING STEEL TO BE INCLUDED IN ITEM NO. 604-10.18, REINFORCING STEEL (REPAIRS), LBS.

ITEM NO. 604-10.42 SHALL BE BID SUCH THAT THESE ITEMS MAY BE INCREASED, DECREASED OR ELIMINATED BY THE ENGINEER.

BILL OF STEEL							
SLAB REINFORCEMENT							
BARS	SIZE	NO. REQ'D	BENDING DIMENSIONS				LENGTH
			A	B	C	D	
H500E	5	1	1'-5"	1'-6"			4'-5"
H501E	5	1	1'-1"	1'-6"			4'-1"
ALL BAR DIMENSIONS ARE OUT-TO-OUT.							

ALL BAR DIMENSIONS ARE OUT-TO-OUT.

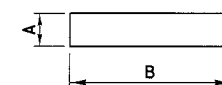

BARS H

DESIGNED BY A.J. KHARI DATE MAR. 2000
DRAWN BY K. KYZER DATE MAR. 2000
SUPERVISED BY T. JOHNSON DATE MAR. 2000
CHECKED BY T. JOHNSON DATE MAR. 2000

TN D.O.T. ENGINEERING SUPERVISOR M. LAWSON

STATE OF TENNESSEE
DEPARTMENT OF TRANSPORTATION

BRIDGE REPAIR DETAILS

MCLEAN BLVD. OVER I-40
BRIDGE NO. 79-2819-4.93

**SHELBY COUNTY
2000**

BR-46-11

ESTIMATED QUANTITIES

PROJECT NO.		YEAR		SHEET NO.	
79959-4152-04		1998		2	
REVISIONS					
NO.	DATE	BY	BRIEF DESCRIPTION		
1	4-6-98	BKE	REVISED QUANTITY & ADDED NOTE		
2	5-8-98	BKE	ADDED GENERAL NOTE		
3	5-15-98	BKE	ADDED GENERAL NOTE		

[illegible]

GENERAL NOTES

SPECIFICATIONS: STANDARD ROAD AND BRIDGE SPECIFICATIONS OF THE TENNESSEE DEPARTMENT OF TRANSPORTATION. (MARCH 1, 1995 EDITION)

DESIGN SPECIFICATIONS: AASHTO 1992 EDITION WITH ADDENDA.

STRUCTURAL STEEL: SHALL CONFORM TO AASHTO M270 GRADE 36 (ASTM A709 GRADE 36)
UNLESS OTHERWISE NOTED.

REINFORCING STEEL: SEE THE STANDARD SPECIFICATIONS.

GRAOUTED BARS IN DRILLED HOLES: HORIZONTALLY DRILLED HOLES SHALL BE DRILLED 1/2" IN DIAMETER LARGER THAN THE BAR, CLEANED, PACKED WITH NON-SHRINK GROUT AND BAR DRIVEN TO ITS SEAT. VERTICALLY DRILLED HOLES SHALL BE DRILLED 1/4" IN DIAMETER LARGER THAN THE BAR, CLEANED, PACKED WITH EPOXY GROUT AND BAR DRIVEN TO ITS SEAT. ALL GROUTING MATERIAL SHALL BE APPROVED BY T.D.O.T. MATERIALS AND TESTS.

SHOP DRAWINGS: SHALL BE SUBMITTED ACCORDING TO SPECIAL PROVISION NO. 105A. EXCEPT SHOP DRAWINGS SHALL BE SUBMITTED TO THE HEADQUARTERS BRIDGE INSPECTION AND REPAIR OFFICE IN LIEU OF THE DIVISION OF STRUCTURES.

BOLTS: SHALL BE HIGH TENSILE STRENGTH BOLTS (ASTM-A325), UNLESS OTHERWISE NOTED. SIZE TO BE AS NOTED ON PLANS. SEE AASHTO SPECIFICATIONS; ARTICLE 11.5.6 DIVISION 11. EXISTING CONTRACT SURFACES SHALL BE CLEANED TO SSPC-10 SPECIFICATIONS PRIOR TO ATTACHMENT OF NEW MEMBERS.

CONCRETE: TO BE CLASS 'A' CONCRETE IN ACCORDANCE WITH THE STANDARD SPECIFICATIONS.

CONCRETE CURING: ALL CONCRETE IN REPAIR AREAS SHALL BE CURED ACCORDING TO THE STANDARD SPECIFICATIONS.

WELDING: ANSI/AASHTO/AWS D1.5-88 BRIDGE WELDING CODE AND THE STANDARD SPECIFICATIONS.

SPECIAL NOTE TO CONTRACTOR: CONTRACTOR SHALL USE EXTREME CARE AND TAKE ANY MEASURE NECESSARY TO INSURE THAT NO DEBRIS IS DROPPED INTO THE STREAM. ANY DEBRIS WHICH IS ALLOWED TO DROP ON THE BANKS BELOW THE BRIDGE SHALL NOT BE ALLOWED TO ENTER THE STREAM AND SHALL BE REMOVED AND DISPOSED OF BY THE CONTRACTOR. COST OF REMOVING AND DISPOSING OF DEBRIS SHALL BE INCLUDED IN ITEMS BID ON.

NOTE: ALL STRUCTURAL STEEL FOR SEISMIC RESTRAINER AND LATERAL RESTRAINERS, EXCEPT FOR NON-CORROSIVE WIRE ROPE AND THIMBLES, SHALL BE FABRICATED BY AISC, SIMPLE SPAN BRIDGES CATEGORY, CERTIFIED SHOP.

CONST. WORK ZONE TRAFFIC CONTROL

ADVANCED WARNING SIGNS SHALL NOT BE DISPLAYED MORE THAN FORTY-EIGHT (48) HOURS BEFORE PHYSICAL CONSTRUCTION BEGINS. SIGNS MAY BE ERECTED UP TO ONE WEEK BEFORE NEEDED, IF SIGN FACE IS FULLY COVERED

IF THE CONTRACTOR MOVES OFF THE PROJECT, HE SHALL COVER OR REMOVE ALL UNNEEDED SIGNS AS DIRECTED BY THE ENGINEER. COSTS OF REMOVAL, COVERING, AND REINSTALLING SIGNS SHALL NOT BE MEASURED AND PAID FOR SEPERATELY, BUT ALL COSTS SHALL BE INCLUDED IN THE ORIGINAL UNIT PRICE BID FOR ITEM NO. 712-06, SIGNS (CONSTRUCTION) S.F. AND 712-06.10, NEW SIGNS (CONSTRUCTION) S.F.

A LONG TERM BUT SPORADIC USE WARNING SIGN, SUCH AS FLAGGER SIGNS MAY REMAIN IN PLACE WHEN NOT REQUIRED PROVIDED THE SIGN FACE IS FULLY COVERED.

TRAFFIC CONTROL DEVICES SHALL NOT BE DISPLAYED OR ERECTED UNLESS RELATED CONDITIONS ARE PRESENT NECESSITATING WARNING.

USE OF BARRICADES, PORTABLE BARRIER RAILS, VERTICAL PANELS, AND DRUMS SHALL BE LIMITED TO THE IMMEDIATE AREAS OF CONSTRUCTION WHERE A HAZARD IS PRESENT. THESE DEVICES SHALL NOT BE STORED ALONG THE ROADWAY WITHIN THIRTY (30) FEET OF THE EDGE OF THE TRAVELED WAY BEFORE OR AFTER USE UNLESS PROTECTED BY GUARDRAIL, BRIDGE RAIL, AND/OR BARRIERS INSTALLED FOR OTHER PURPOSES. THESE DEVICES SHALL BE REMOVED FROM THE CONSTRUCTION WORK ZONE WHEN THE ENGINEER DETERMINES THEY ARE NO LONGER NEEDED. WHERE THERE IS INSUFFICIENT RIGHT-OF-WAY TO PROVIDE FOR THIS THIRY (30) FEET SETBACK, THE ENGINEER SHALL APPROVE ALTERNATE LOCATIONS.

THE CONTRACTOR WILL NOT BE PERMITTED TO PARK ANY VEHICLES OR CONSTRUCTION EQUIPMENT DURING PERIODS OF INACTIVITY, WITHIN THIRTY (30) FEET OF THE EDGE OF PAVEMENT WHEN THE LANE IS OPEN TO TRAFFIC, UNLESS PROTECTED BY GUARDRAIL, BRIDGE RAIL, AND/OR BARRIERS INSTALLED FOR OTHER PURPOSES. PRIVATELY OWNED VEHICLES SHALL NOT BE ALLOWED TO BE PARKED WITHIN THIRTY (30) FEET OF AN OPEN TRAFFIC LANE AT ANY TIME UNLESS PROTECTED AS DESCRIBED ABOVE. WHERE THERE IS INSUFFICIENT RIGHT-OF-WAY TO PROVIDE FOR THIS THIRTY (30) FEET SETBACK, THE ENGINEER SHALL APPROVE ALTERNATE LOCATIONS.

GALVANIZING OF NEW STEEL

ALL NEW STEEL SHALL BE GALVANIZED TO ASTM A123 STANDARDS.

NOTE: ROADSIDE BANKS/SLOPES USED BY THE CONTRACTOR FOR WORK ACCESS, PARKING, AND ANY OTHER OPERATIONS THAT ARE DISTURBED BY HIS OPERATIONS SHALL BE REPAIRED BY REGRADING, RESEEDING, MULCHING OR WHATEVER MEANS ARE NECESSARY TO RESTORE THE BANKS/SLOPES TO THE ORIGINAL CONDITION. ALL RESTORATION WORK SHALL MEET THE FULL SATISFACTION OF THE ENGINEER. COST OF ALL RESTORATION WORK SHALL BE INCLUDED IN ITEMS BID ON.

DESIGNED BY	<u>BRIAN EGLI</u>	DATE	<u>01/1998</u>
DRAWN BY	<u>SCOTT C. NELSON</u>	DATE	<u>01/1998</u>
SUPERVISED BY	<u>M. LAWSON & T. CHRISTIANSON</u>	DATE	<u>01/1998</u>
CHECKED BY	<u>M. LAWSON & B. EGLI</u>	DATE	<u>02/1998</u>

STATE OF TENNESSEE
DEPARTMENT OF TRANSPORTATION
ESTIMATED QUANTITIES
AND
GENERAL NOTES
BRIDGE NO. 79-140-5.09 ()
BRIDGE NO. 79-2819-4.9 ()
BRIDGE NO. 79-140-7.60 ()
BRIDGE NO. 79-140-8.25 ()
BRIDGE NO. 79-4186-2.1 ()
BRIDGE NO. 79-140-9.50 ()
SHELBY COUNTY
1998

BR-33-29

LIST OF SPECIAL REVISIONS

*** DENOTES: CURRENT REVISION DATE, AS PER CONTRACT DOCUMENTS

NO.	LAST REV. DATE	REGARDING
105A	***	APPROVAL OF SHOP DRAWINGS


LIST OF REFERENCE DRAWINGS

DWG NO.	DRAWING
M-44-20, M-44-22, M-44-25, M-44-27 THRU 29 -- -- --	EXISTING BRIDGE DRAWINGS

LIST OF BRIDGE DRAWINGS

DRAWING NO.	LAST REV. DATE	DRAWING
BR-33-29	5-15-98	ESTIMATED QUANTITIES AND GENERAL NOTES
BR-33-32	5-15-98	SEISMIC RESTRAINER LAYOUT
BR-33-45	4-15-98	SEISMIC RESTRAINER DETAILS TYPE (20)
BR-33-46	4-15-98	SEISMIC RESTRAINER DETAILS TYPE (20) CONTINUED
BR-33-49	5-8-98	BOLT INSTALLATION

PROJECT NO.		YEAR	SHEET NO.
79959-4152-04		1998	
REVISIONS			
NO.	DATE	BY	BRIEF DESCRIPTION
1	4-6-98	BKE	REVISED LIST OF DRAWINGS
2	4-15-98	BKE	REVISED LIST OF DRAWINGS
3	5-8-98	BKE	REVISED LIST OF DRAWINGS
4	5-15-98	BKE	REVISED LIST OF DRAWINGS

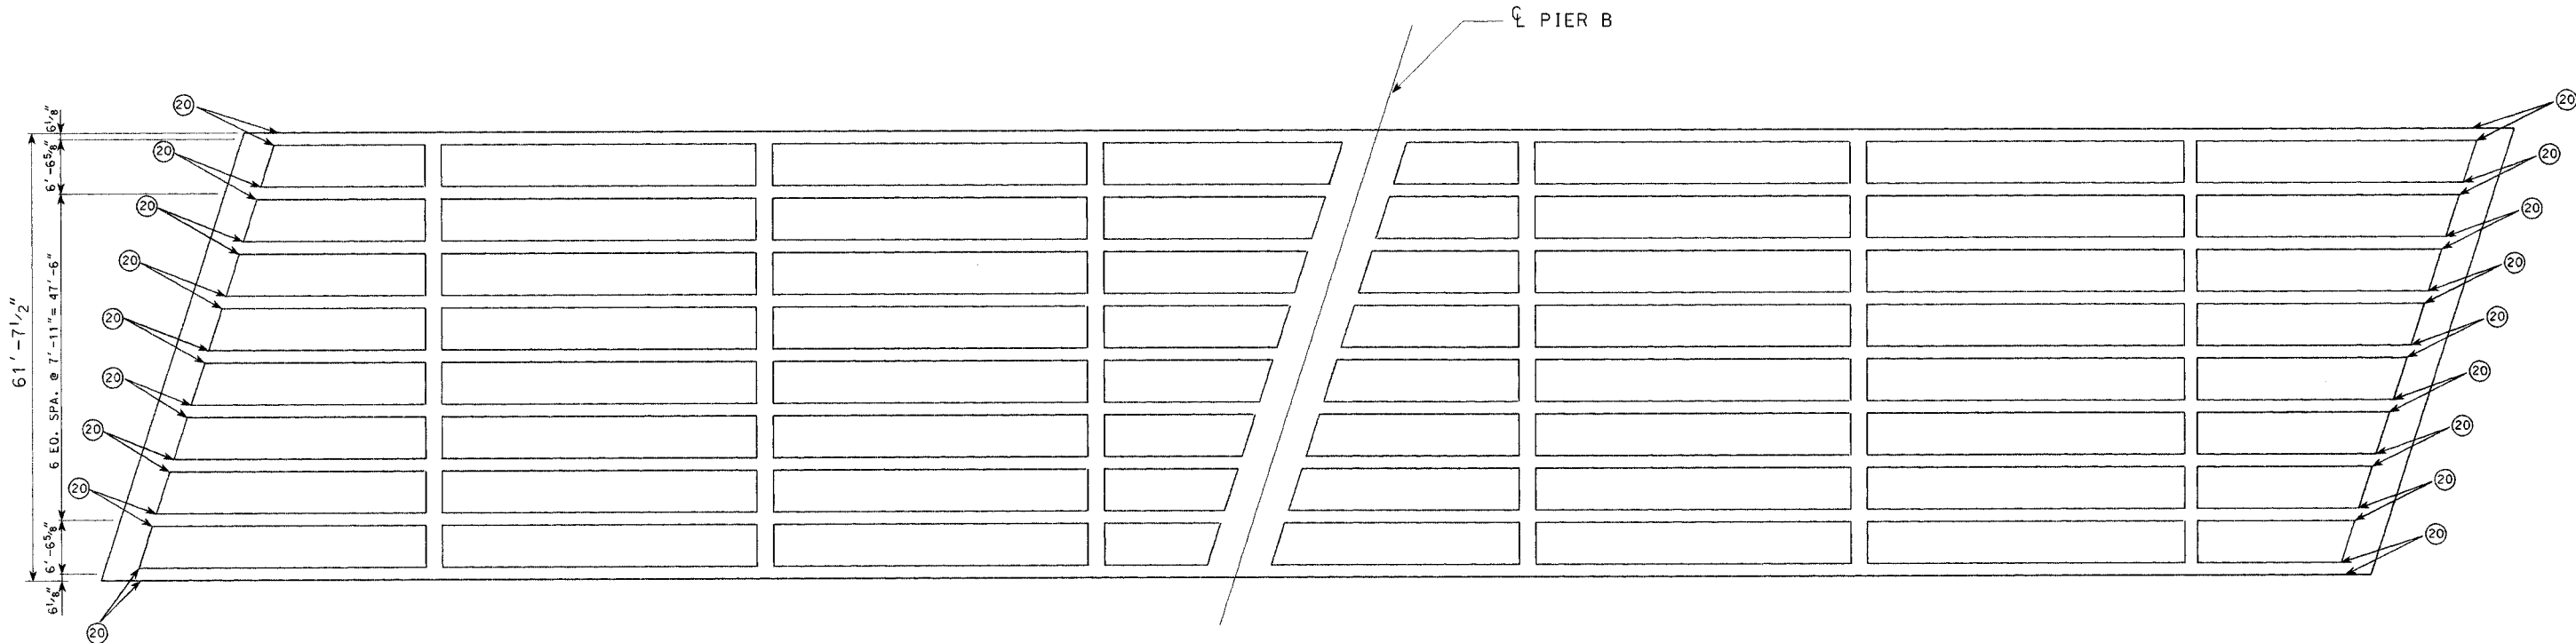

PLAN

NOTE: DIMENSIONS GIVEN ARE RADIAL
DIMENSIONS ARE MEASURED ALONG
BOTTOM OF BRIDGE.

GENERAL SCOPE OF WORK

- 1) PROVIDE WIRE ROPE SEISMIC RESTRAINTS AT
ABUTMENT (TYPE 20). REFER TO LEGEND AND
PLAN VIEW FOR DESCRIPTION AND LOCATION.

LEGEND

(20) DENOTES: SEISMIC RESTRAINT TYPE (20)
FOR DETAILS SEE BR-33-45 AND BR-33-46

BRIDGE NO. 79I00400071




STATE OF TENNESSEE
DEPARTMENT OF TRANSPORTATION
BUREAU OF HIGHWAYS

SEISMIC RESTRAINER LAYOUT
N. MCCLEAN BLVD OVER I-40
BRIDGE NO. 79-2819-4.93
SHELBY COUNTY
1998


DESIGNED BY: BRAM 02/91 DATE: SEPTEMBER 1997
DRAWN BY: SHARON MCCLENN DATE: SEPTEMBER 1997
SUPERVISED BY: T. CARROLL HUSON, JR. DATE: SEPTEMBER 1997
CHECKED BY: MICHAEL L. HUSON DATE: SEPTEMBER 1997

PROJECT NO.	YEAR	SHEET NO.	
79959-4152-04	1998		
REVISIONS			
NO.	DATE	BY	BRIEF DESCRIPTION
1	4-15-98	EKE	ADDED CUTS TO U-BOLTS

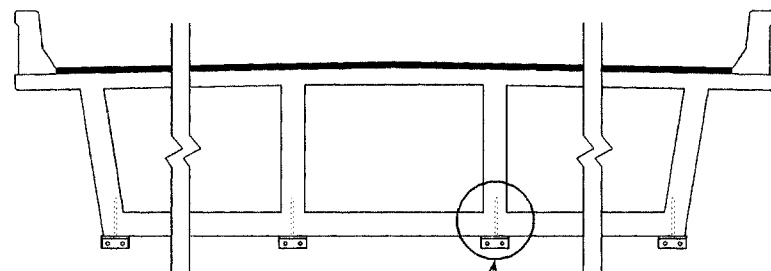


CROSS SECTION

SHOWING SEISMIC RESTRAINTS AT WEBS: TYPICAL AT BRIDGE NUMBERS:
(79-140-7.60 (8 CELLS), 79-2819-4.93 (8 CELLS) & 79-4186-2.11 (9 CELLS))

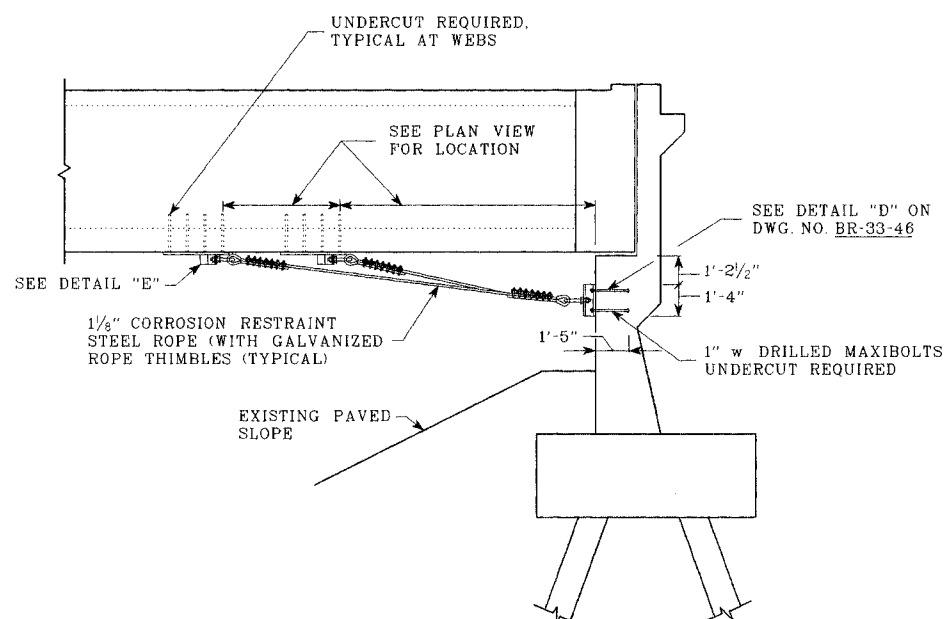

SEISMIC RESTRAINTS AT ABUTMENTS

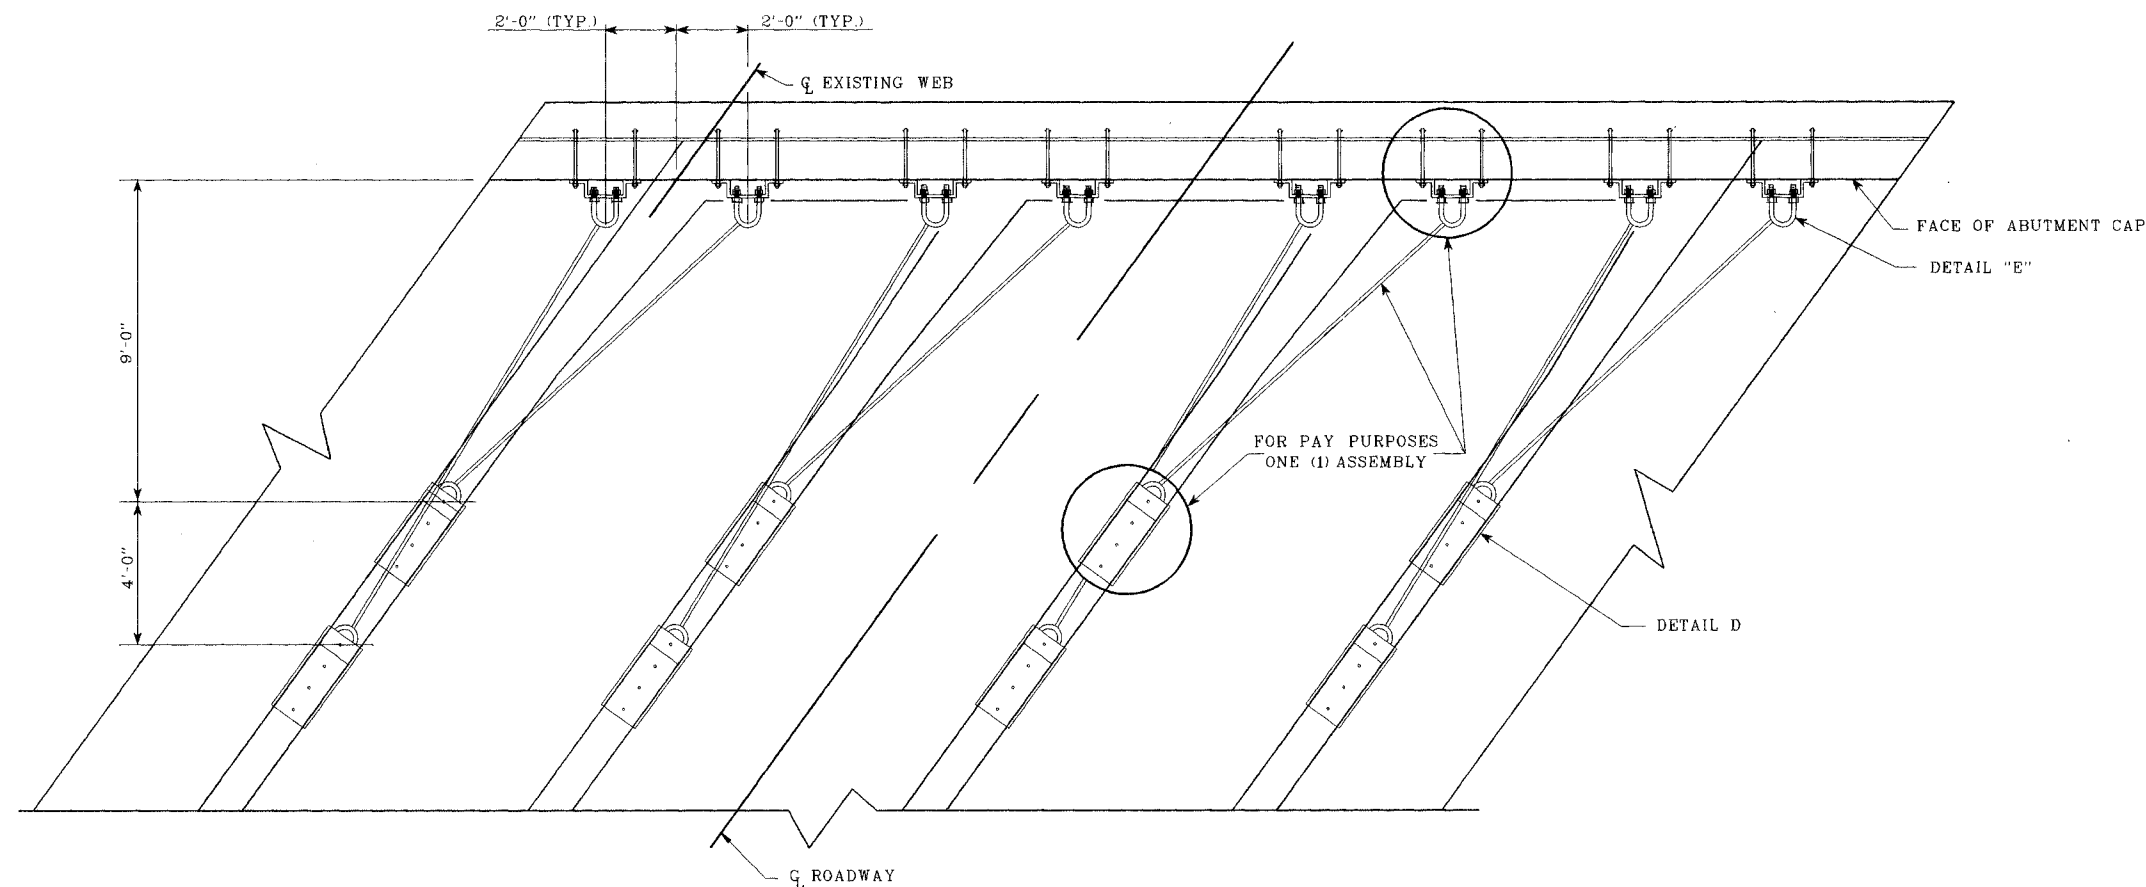

PLAN SHOWING SEISMIC RESTRAINTS LOCATIONS



NOTES:

THESE DETAILS ARE APPLICABLE FOR THE FOLLOWING BRIDGES:
79-140-7.60, 79-2819-4.93 & 79-4186-2.11

FOR ADDITIONAL SEISMIC DETAILS, SEE DWG. NO. BR-33-46.




STATE OF TENNESSEE
DEPARTMENT OF TRANSPORTATION
SEISMIC RESTRAINER DETAILS
TYPE (20)
SHELBY COUNTY
1998

DESIGNED BY Brian Egli DATE September, 1997
DRAWN BY Cory Haugins DATE December, 1997
SUPERVISED BY Mike Lawson, J. Christensen DATE December, 1997
CHECKED BY Mike Lawson, Brian Egli DATE February, 1998


SEISMIC RESTRAINT - BOX GIRDERS TYPE (20)

BR-33-45


PROJECT NO.	YEAR	SHEET NO.	
79959-4152-04	1998		
REVISIONS			
NO.	DATE	BY	BRIEF DESCRIPTION
1	5-8-98	B.K.E.	REVISED SHEET

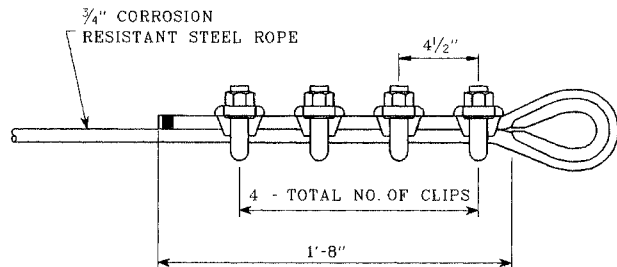

WIRE ROPE CLIPS

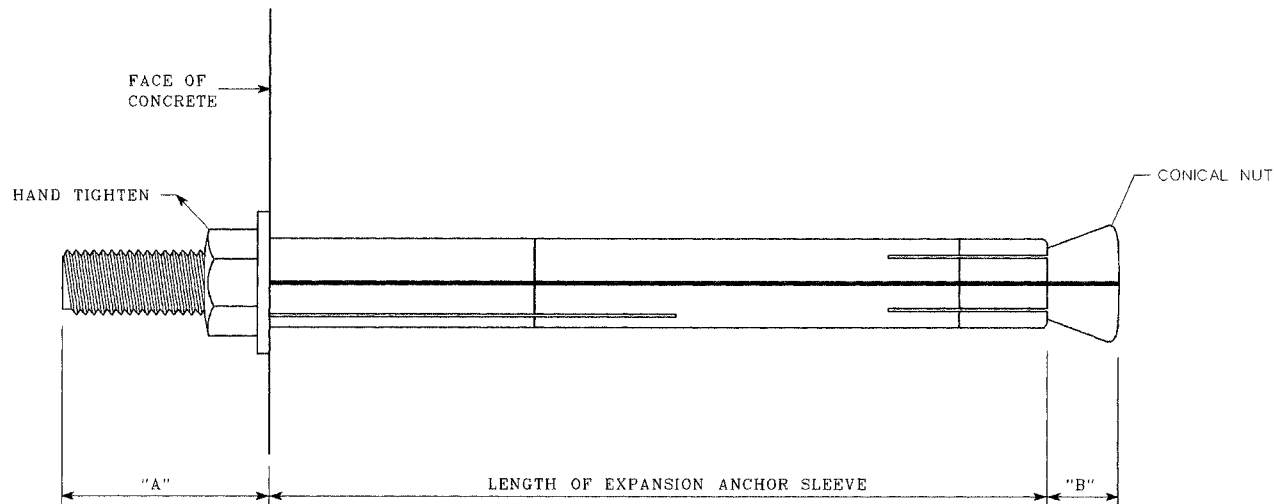

INITIAL POSITION

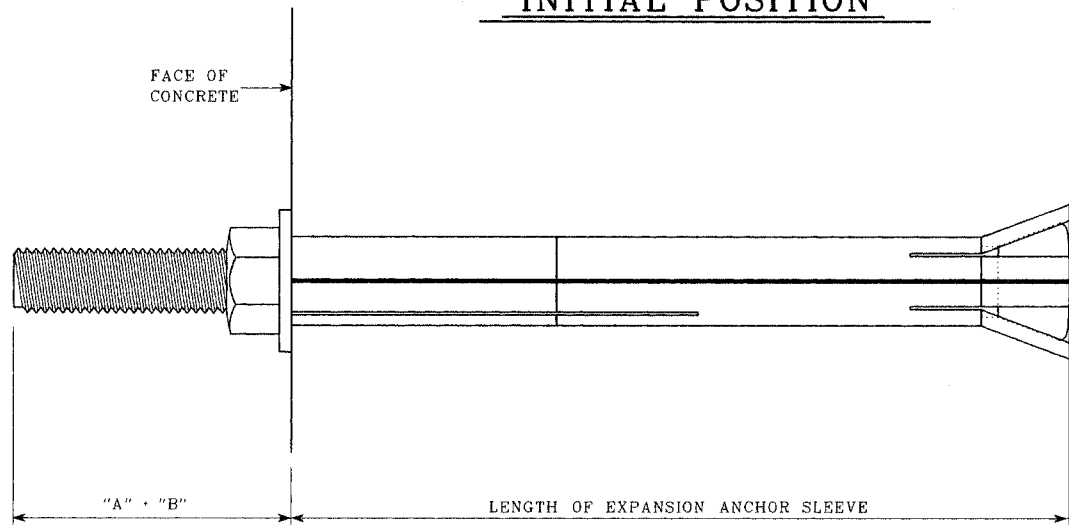

SET POSITION

PROCEDURE FOR INSTALLATION OF ANCHOR BOLTS:

(3/4" DIAMETER DRILLCO MAXI-BOLT OR WILLIAMS BOLTS)(UNDERCUTTING REQUIRED)

- LOCATE PLACEMENT OF EXISTING REBAR IN VICINITY OF ANCHORS WITH A REBAR LOCATING DEVICE AND MAKE NECESSARY CORRECTIONS IN LOCATIONS OF ANCHORS ON CONCRETE. ANCHOR LOCATION MAY VARY PLUS OR MINUS 3 INCHES IN ANY DIRECTION BUT THE HOLE SHALL BE DRILLED WITHIN 6 DEGREES OF PERPENDICULAR TO THE NOMINAL CONCRETE SURFACE. CUTTING OF REBAR WILL BE ALLOWED.
- HOLES SHALL BE DRILLED WITH A CARBIDE PERCUSSION DRILL BIT, A "REBAR EATER" BIT OR A DIAMOND CORE BIT.
- THE DRILL BIT DIAMETER AND HOLE DEPTHS ARE SPECIFIED AS FOLLOWS:
 - THE MAXIMUM DRILL BIT DIAMETER SHALL NOT EXCEED 1.172 INCH DIAMETER.
 - THE HOLE DEPTH SHALL NOT BE LESS THAN THE ANCHOR EMBEDMENT PLUS 1 1/2 INCHES BUT MAY EXCEED THE SPECIFIED HOLE DEPTH BY NOT MORE THAN 1 INCH.
- IF AN ANCHOR MUST BE RELOCATED AND A NEW HOLE DRILLED, THE OLD HOLE SHALL BE REPAIRED WITH A NON-SHRINKAGE PACK GROUT.
- UNDERCUT IN PRIMARY HOLE SHALL BE AS SPECIFIED BY THE MANUFACTURER OF THE UNDERCUTTING TOOL.
- CLEAN THE HOLE OF CONCRETE DUST AND DEBRIS USING OIL FREE COMPRESSED AIR OR BY VACUUMING. PLACE BEARING SLEEVE FLUSH WITH THE CONCRETE SURFACE.
- THE EXPANSION SLEEVE IS TO EXPAND INTO THE UNDERCUT CREATED BY THE UNDERCUTTING TOOL THEREFORE THE ANCHOR TUBE MUST TERMINATE AT THE BASE OF THE UNDERCUT SECTION.
- TO SET THE ANCHOR, IT IS NECESSARY TO DRAW THE CONICAL NUT OF THE STUD BOLT INTO THE ANCHOR SLEEVE. AFTER THE ASSEMBLY IS INSERTED INTO THE DRILLED HOLE, THE ANCHOR WILL BE CONSIDERED SET WHEN THE DIMENSION "A" (SEE ANCHOR SETTING DETAILS) HAS INCREASED BY AN AMOUNT EQUAL TO DIMENSION "B". AFTER THE STEEL PLATES ARE IN PLACE THE FINAL TENSION LOAD OF 28400 LBS. SHALL BE APPLIED. THE ANCHOR LOADS MAY BE APPLIED BY MANUAL TORQUING OR HYDRAULIC TENSIONING.
- BECAUSE OF CLOSE TOLERANCE BETWEEN CONICAL NUT O.D. AND HOLE I.D. IT MAY BE NECESSARY TO LIGHTLY HAMMER THE ANCHOR INTO THE HOLE. IF HAMMERING IS NECESSARY, STEPS SHALL BE EMPLOYED WHICH WILL PREVENT DAMAGE TO THE STUD BOLT THREADS.
- INSTALLATION PROCEDURES REQUIRED BY THE ANCHOR MANUFACTURER IN ADDITION TO THE INSTRUCTIONS LISTED ABOVE SHALL BE FOLLOWED.
- BENT PLATES SHALL BE ASTM A709 (GRADE 36) MATERIAL GALVANIZED TO ASTM A123 STANDARD.
- POSITION OF PLATE OR ANGLE ON BEAM:

ABUTMENTS: THE PLATE OR ANGLE SHALL BE POSITIONED ON THE BEAM WITH CABLE IN THE FULL EXTENDED POSITION AND PLATE OR ANGLE POSITION MARKED. THE PLATE OR ANGLE SHALL THEN BE SHIFTED TOWARD THE ABUTMENT 3" AND THE ANCHOR BOLT LOCATIONS MARKED THROUGH THE PLATE OR ANGLE ANCHOR HOLES.

BENTS (BEAM TO BEAM): AFTER ONE ANCHOR HAS BEEN ATTACHED THE ANGLE OF THE OTHER SHALL BE POSITIONED ON THE BEAM WITH CABLE IN THE FULL EXTENDED POSITION ANGLE POSITION MARKED. THE PLATE OR ANGLE SHALL THEN BE SHIFTED TOWARD THE BENT 3" AND THE ANCHOR BOLT LOCATIONS MARKED THROUGH THE ANGLE ANCHOR HOLE.

PROCEDURE FOR INSTALLATION OF ANCHOR BOLTS:

(3/4" HILTI BOLTS OR EQUAL)(NO UNDERCUTTING REQ'D)

- INSTALLATION TO BE IN ACCORDANCE WITH THE MANUFACTURERS RECOMMENDED PROCEDURES.




STATE OF TENNESSEE
DEPARTMENT OF TRANSPORTATION

BOLT INSTALLATION
SHELBY COUNTY
1998

DESIGNED BY Brian Egl DATE February, 1998
 DRAWN BY Cory Humphreys DATE March, 1998
 SUPERVISED BY Mike Lawson, J. Christenson DATE March, 1998
 CHECKED BY Mike Lawson, Brian Egl DATE April, 1998

ANCHOR SETTING DETAILS

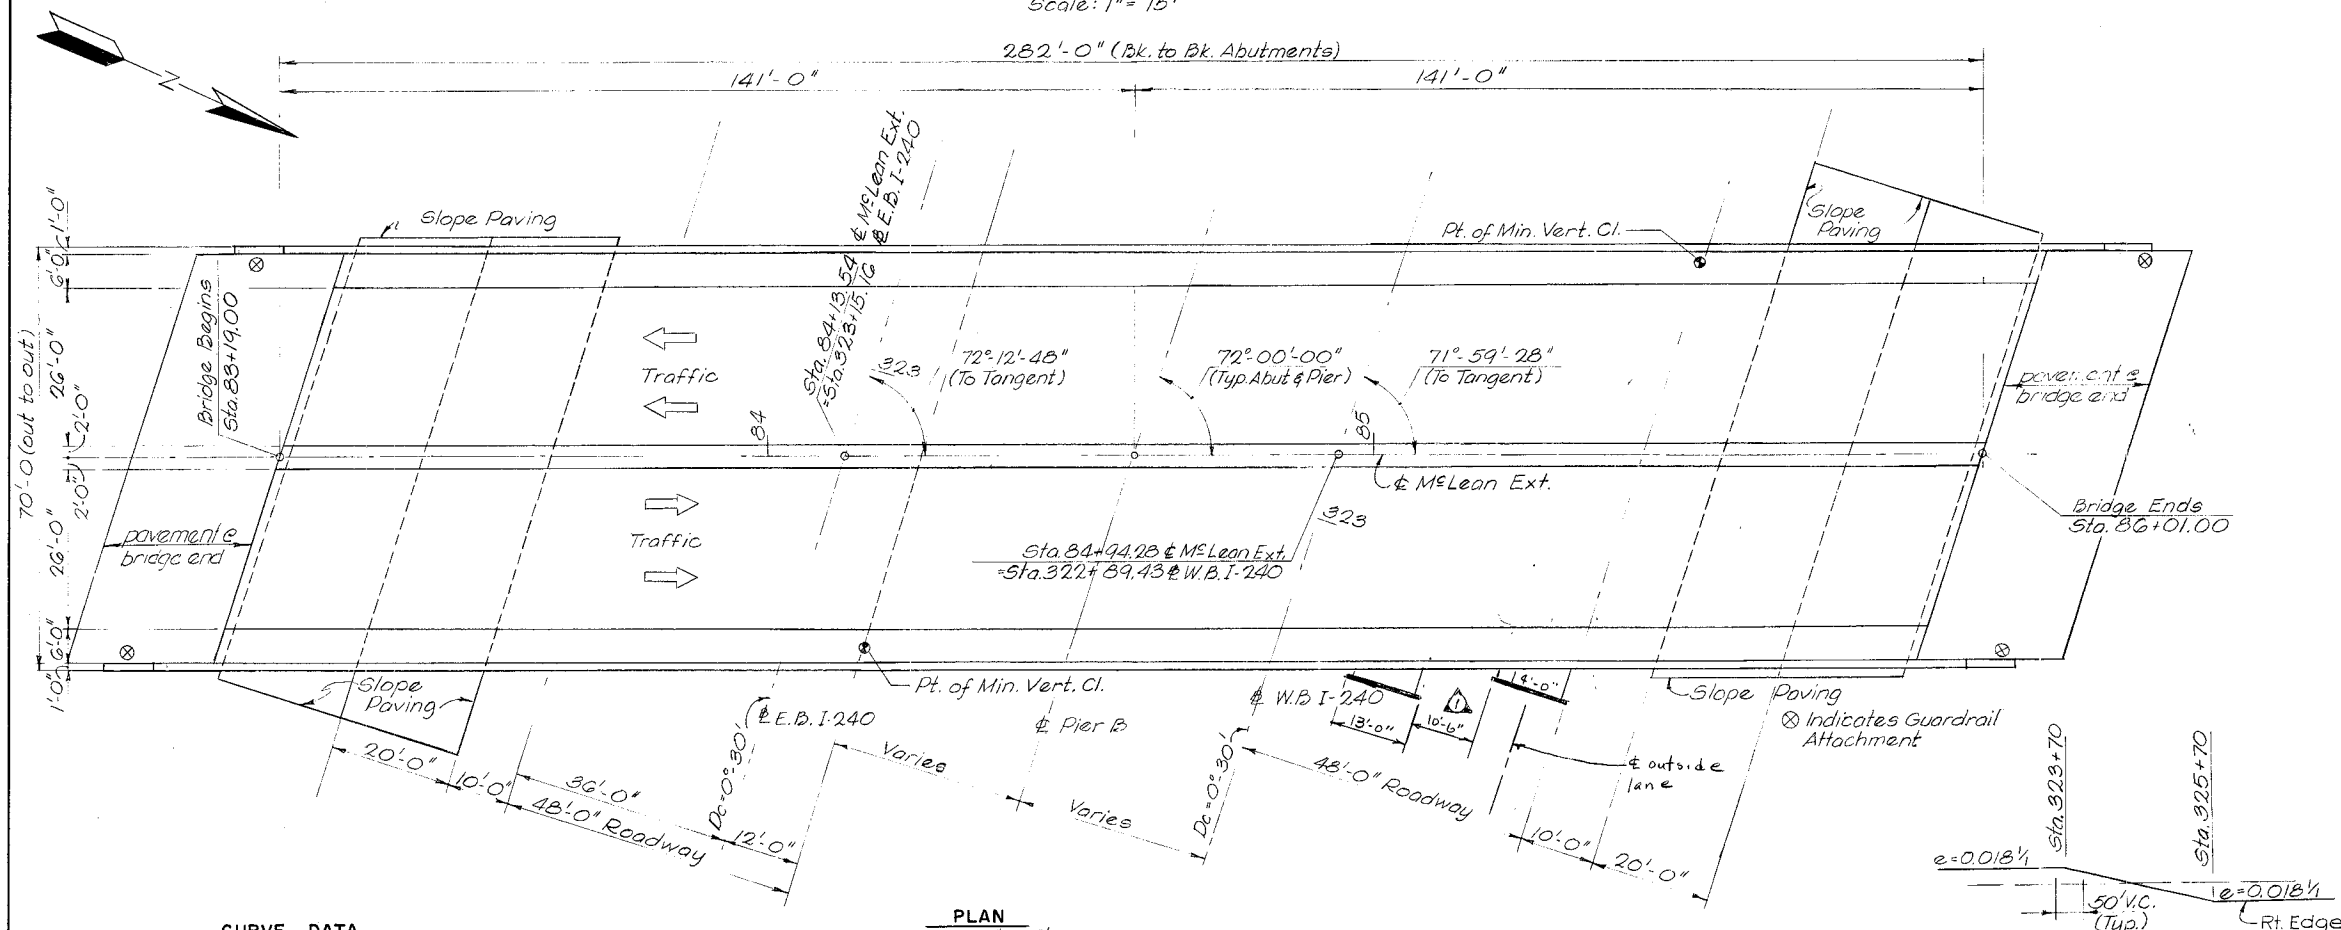[illegible]

INDEX OF DRAWINGS	
DWG. NO.	TITLE
M-44-20	Bridge Layout.
M-44-21	General Notes and Summary of Estimated Quantities.
M-44-22	Abutment A
M-44-23	Abutment A - Details
M-44-24	Pier B
M-44-25	Abutment C
M-44-26	Abutment C - Details
M-44-27	Typical Sections
M-44-28	Top Slab Plan
M-44-29	Bottom Slab Plan
M-44-30	Post Tensioning Details
M-44-31	Screed Elevations & Rail Post Spacing
M-44-32	Soil Boring
M-44-33	Wingpost, Rail & Light Standard Base Details
K-80-14	Reinforcement Bar Support Details
K-80-130	Preformed Elastic Joint Details
K-86-144	Reinf. Concrete Pavement at Bridge Ends
H-5-111	Standard Pile Details
K-28-154	Bridge Railing
K-85-150	Misc. Abutment & Drainage Details.

BRIDGE NO. 79I00400071

STATE OF TENNESSEE
DEPARTMENT OF TRANSPORTATION
BUREAU OF HIGHWAYS

BRIDGE 33C
McLEAN BLVD. EXT. OVER I-240

BRIDGE LAYOUT
STA. 323 + 00.00

SHELBY COUNTY

CORRECT _____
ENGINEER OF STRUCTURES

APPROVED _____
DIRECTOR OF HIGHWAYS


M-44-20

Bridge Deck Sealant	1912	Sq Yds.
---------------------	------	---------

Class "A" Grading D 964 Cu.Yds.


<u><u>CURVE DATA</u></u>	
<u>W.B. LANES</u>	<u>E.B. LANES</u>
P.I. STA. 313+06.24	P.I. STA. 313+76.42
$\Delta = 11^{\circ}-00'-23.0''$ RT.	$\Delta = 11^{\circ}-00'-23.0''$ RT.
Dc = $0^{\circ}-30'$	Dc = $0^{\circ}-30'$
R. = 11459.156'	R. = 11459.156'
Lc = 2201.278'	Lc = 2201.278'
T = 1104.036'	T = 1104.036'

PLAN
Scale: 1" = 15'

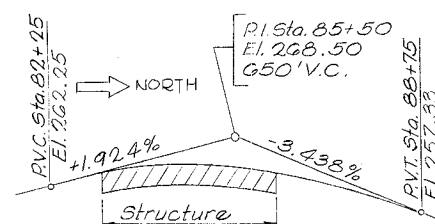


McLEAN BLVD. EXT.-F.G.
Not to Scale

I-240 W.B. - F.G.
Not to Scale

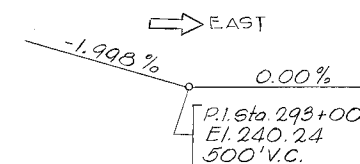

I-240 E.B.-F.G.
Not to Scale

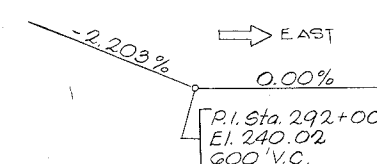

HARLAND BARTHOLOMEW AND ASSOCIATES
MEMPHIS, TENNESSEE

DESIGNED BY D. McCorkle DATE June '75
DRAWN BY J. Starr DATE June '75
SUPERVISED BY D. McCorkle DATE June '75
CHECKED BY F. Hoffman DATE Aug. '75


MICROFILM

1. SPECIFICATIONS: Standard Road and Bridge Specifications of the Tennessee Department of Highways (1968 Edition)
2. LOADING: HS-20-44.
3. DESIGN SPECIFICATIONS: 1973 AASHTO and Addenda.
4. CAST-IN-PLACE CONCRETE: To be class 'A', f'c 4000 psi for superstructure; f'c 3000 psi for substructure and parapets. See Special Provision Regarding Section 604 Concrete Structures.
5. REINFORCING STEEL: To be ASTM A615 Grade 60. Standard CRSI hook details apply unless otherwise noted on Bill of Steel. Bending dimensions shown are based on Grade 60 Steel. Spacing dimensions are center to center unless otherwise noted on detail drawings.
6. BRIDGE RAIL: Build bridge rail in accordance with Tenn. Std. Dwg. K-38-154 Modified for height as shown on Dwg. M-44-63
7. FINISHING CONCRETE SURFACES: Concrete finishing shall be in accordance with Section 604.22 of the Tennessee Standard Specifications except as modified by the Special Provision Regarding Section 604 Concrete Structures. A Textured Coated Finish shall be used in lieu of a Class 2 Finish. The color of the finish shall be similar to Federal Specification No. (See Detail) Federal Color Standard 595a, and a color sample shall be submitted to the Engineer of Structures for approval. All exposed concrete surfaces, including concrete parapets and wingposts, piers and abutments above grade (but not including bridge slab), shall receive a textured coat finish.
8. FOUNDATION NOTE: FRICTION PILES: After excavating to the proposed footing elevations a test pile shall be driven at each substructure at the location designated on Dwg. M-44-22 thru M-44-26. A load test will then be applied to the test pile on Bent 8. The load test shall be in accordance with Special Provision Regarding Load Test For Friction Piles. From the results of the load test the Engineer of Structures will determine final pile tip elevations. For pile design loads, cut-off elevations and pile tip elevations see table on Dwg. No. M-44-32.
9. Alternate Piles: The contractor may use piling of a different material or configuration from that shown on the plans provided the substitution meets minimum design standards and conforms to conditions established by the Special Provision No. 131, Regarding piling dated October 1, 1975.
11. LOADING TESTS: See Special Provision Regarding Load Test for Friction Piles
12. BRIDGE DECK SEALANT: The Bridge deck and reinforced approach slab shall be sealed in a future paving contract (1912 Sq. Yds. required.)

16 Bearing Devices: In view of the bearing device shown on these plans the contractor may submit other plans and design calculations of alternate bearing devices to the Engineer of Structures for approval. Bearing set elevations shall be adjusted to compensate for differences in bearing heights. The bearing shall be capable of providing the following minimum requirements under service loads: (Laminated pads - 50 durometer req'd, plain pads - 70 durometer req'd.)

RDL = 101.5"
RLL = 86.5"
Total Movement = 0.0598 ft.

(6) Quantities given are out-to-out of wingposts.


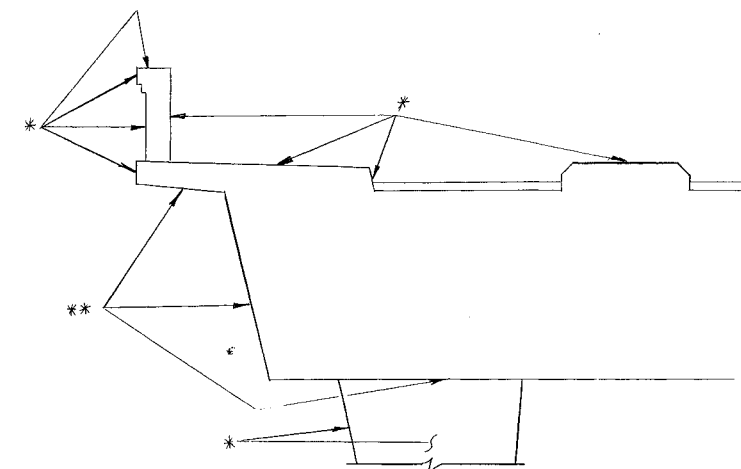


In addition to the above surfaces, all exposed surfaces of abutments, wingwalls, wingposts and slope paving, shall receive a Texture Coating Finish similar to White (Fed. Spec. No. 3788G).

Item NO.	SUMMARY OF ESTIMATED QUANTITIES															
	604-02.01	604-03.01	604-03.02	604-25.04	606-09.01	606-09.02	606-09.03	615-05.02	616-05	710-10	710-11	714-01.02	602-05.07	604-09.03	908-21.0	
Description	Dry Excavation (bridges)(1)	Class A Concrete (bridges)(7)	Steel Bar Reinforcement (bridges)	Textured Coated Finish	Test Piles (Precast Conc. Size 1) (2)	Loading Test (Precast Conc. Size 1) (2)	Precast Conc. Piles - Size 1 (2)	Post Tensioning	Conc. Parapet 11/2 Structural Tubing	C*Perf. C.M.P. (18ga)w/ferous Backfill (3)	C* C.M.P. underdrains (18 ga)	Structure Lighting (4)	Preformed Elastic Joint Sealer	Linseed Oil Treatment	Bearings	
Unit	Cu. Yds.	Cu. Yds.	Lbs.	Sq. Yds.	Lin. Ft.	Each	Lin. Ft.	Lump Sum	Lin. Ft.	Lin. Ft.	Lin. Ft.	Lump Sum.	Lin. Ft.	Sq. Yd.	Each	
Abutment A	495	197.9	14,603	465	25		1200			119.0	4.0			12	12	
Pier B	206	138.3	17,562	140	20	1	1480									
Abutment C	211	122.6	10,124	440	30		1170			101.0	4.0			12	12	
Paving at Br. ends		165.6	37,724	95			160							253		
Superstructure		1,392.3	203,870	3510				1	622.0			1	125.0	1629		
Total	912	2017.2	283,883	4650	75	1	3850	1	622.0	220.0	8.0	1	125.0	1944	24	

CORRECT _____
ENGINEER OF STRUCTURES


APPROVED _____
DIRECTOR OF HIGHWAY

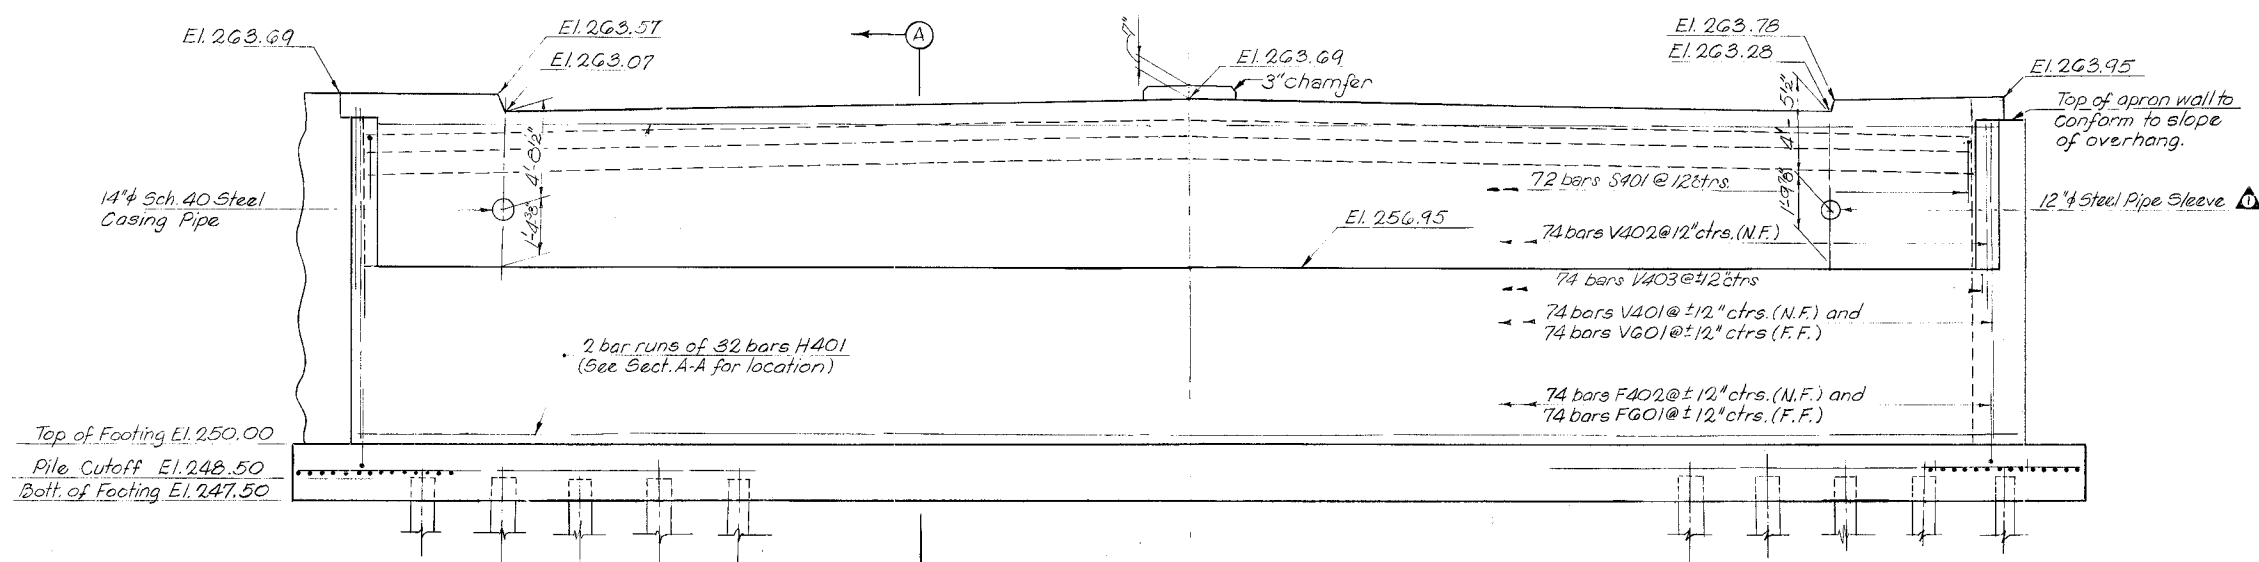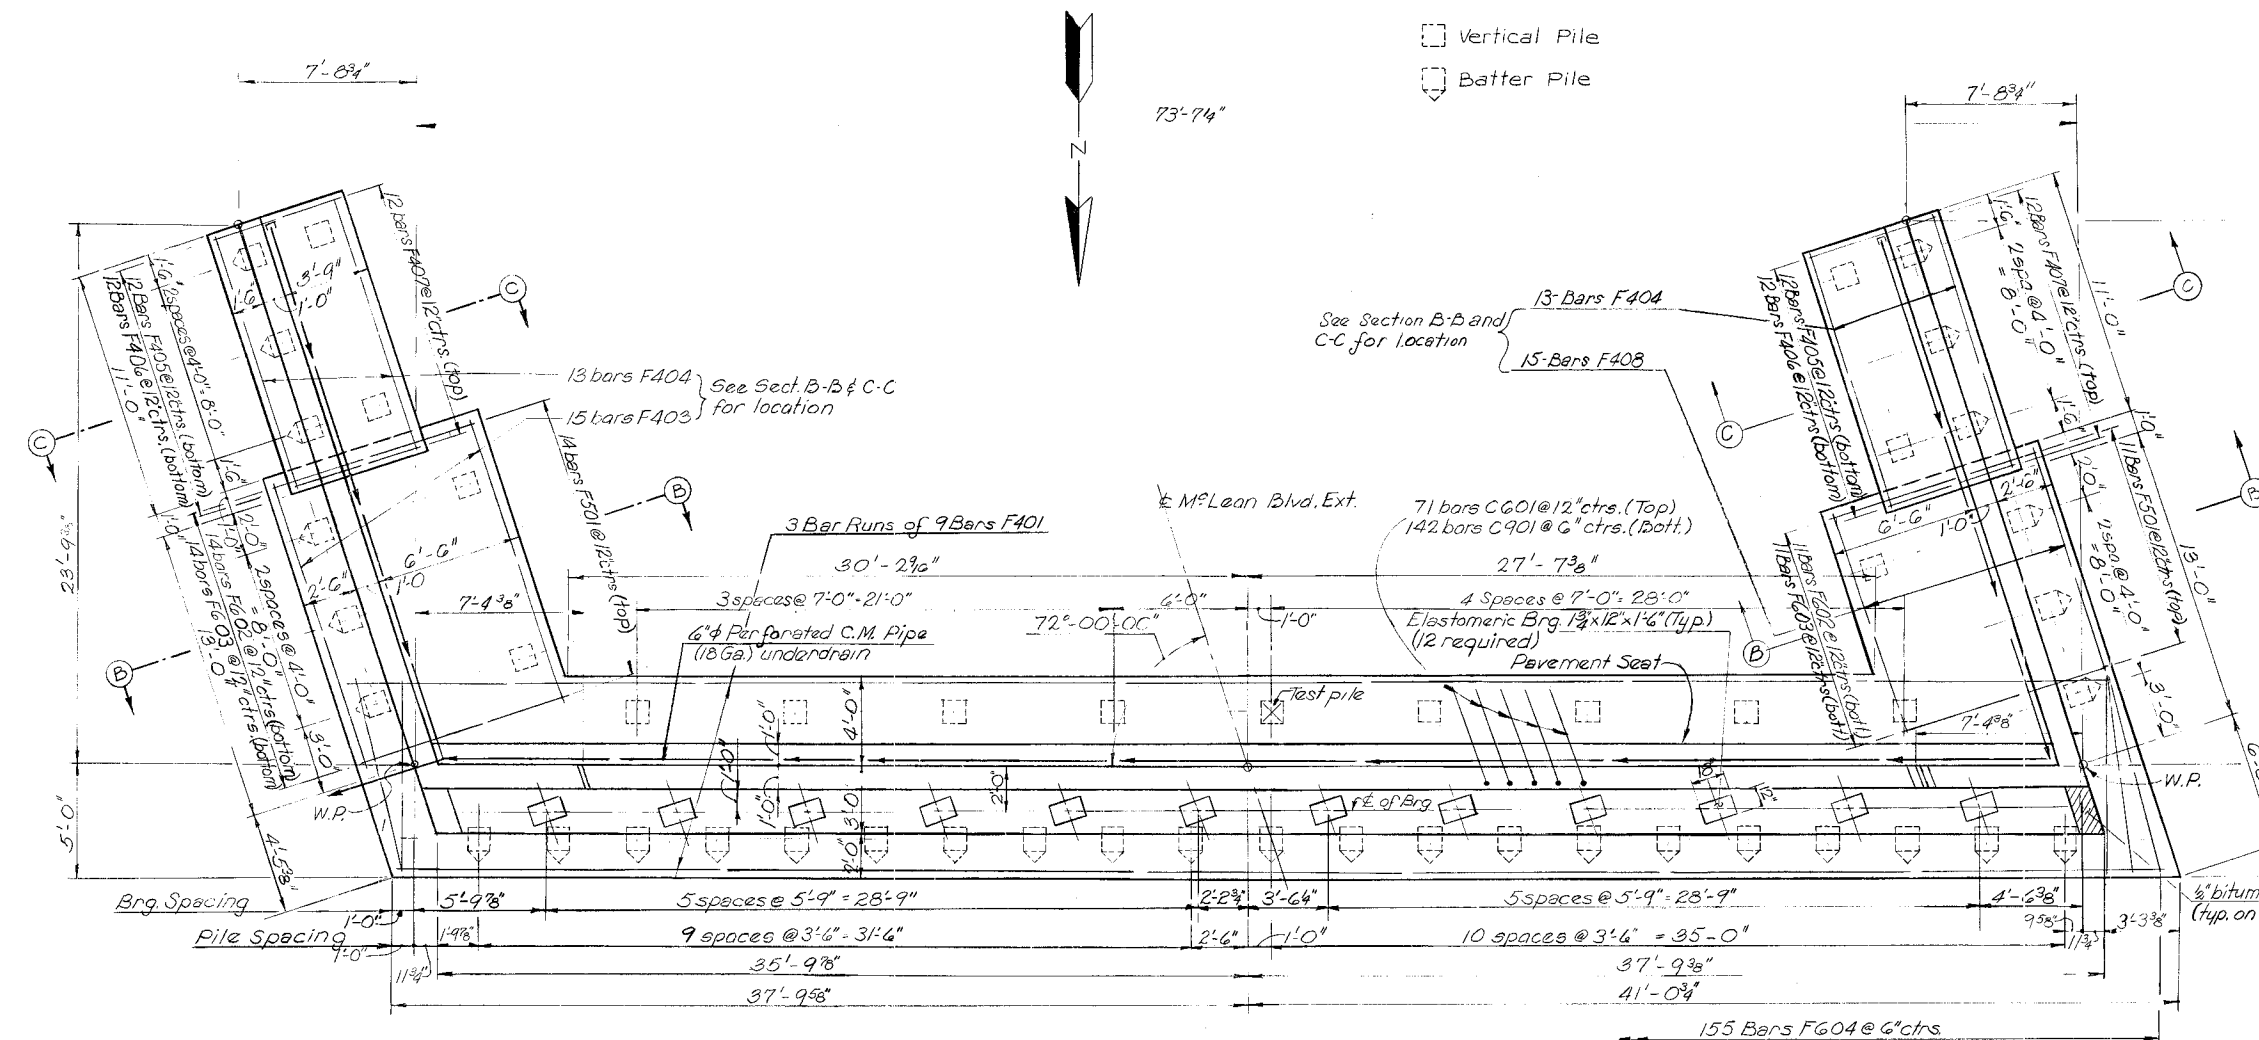[illegible]

FILE NOTE:

Ultimate bearing capacity = 96 Tons for piles in Sections A-A & B-B (39 reqd). Ultimate bearing capacity = 60 Tons for piles in Section C-C (10 reqd). See Dwg. M-44-32 for additional pile data.

- Note:
1. See Dwg. M-44-23 for Bill of Steel, Wingwall Elevations, Section B-B, & C-C and Estimated Quantities.
2. See Dwg. M-44-68 for Parapet Reinforcement to be placed in wing walls.
3. See Std. Dwg. K-6-144 for details of Reinforced Concrete Pavement at Bridge Ends. Also see Dwg. M-44-23.
4. All drainage pipes to have minimum slope - 1/8" / Ft.
5. The Backfill shall not be poured until after inspection of the Superstructure and Post-Tensioning operations have been completed and the end inspection openings closed.
6. See Dwg. M-44-68 for Parapet and Wingpost details.
7. Cost of Bridgerail and Wingposts to be included in the cost of the Bridgerail System.
8. See Dwg. M-44-29 for details of Elastomeric Bearing Pads.

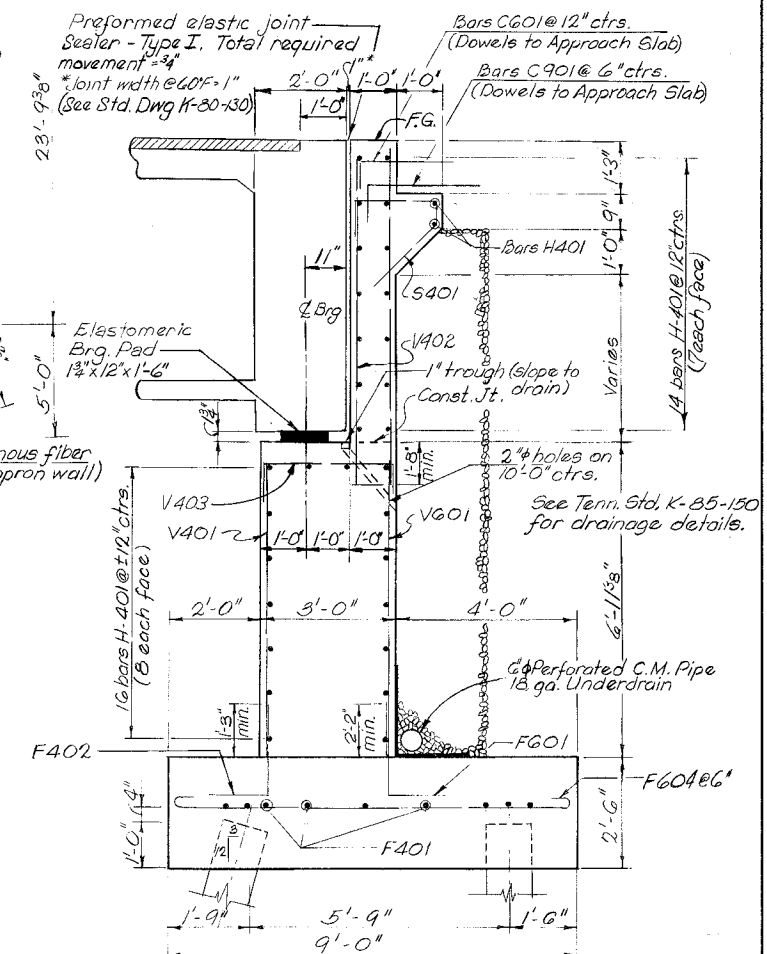


SECTION A-A
Scale: 1/2" = 1'-0"
STATE OF TENNESSEE
DEPARTMENT OF TRANSPORTATION
BUREAU OF HIGHWAYS
BRIDGE 33C
McLEAN BLVD. EXT. OVER I-240
ABUTMENT A
STA. 323+00.00
SHELBY COUNTY

CORRECT _____
ENGINEER OF STRUCTURES


APPROVED _____
DIRECTOR OF HIGHWAYS

M-44-22

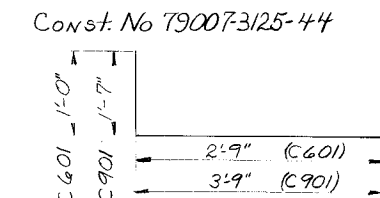


MICROFILMS


PROJECT NO.		YEAR	SHEET NO.
EACT-240-11326		1975	
REVISIONS			
NO.	DATE	BY	BRIEF DESCRIPTION
1	1-16-76	CEH	Changed dia. of steel sleeve for utility

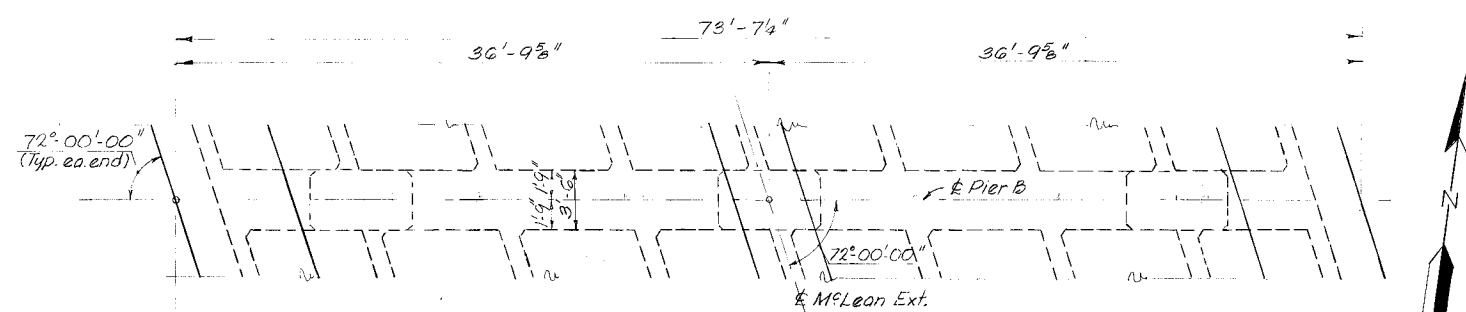


PLAN
Scale: 3/8" = 1'-0"

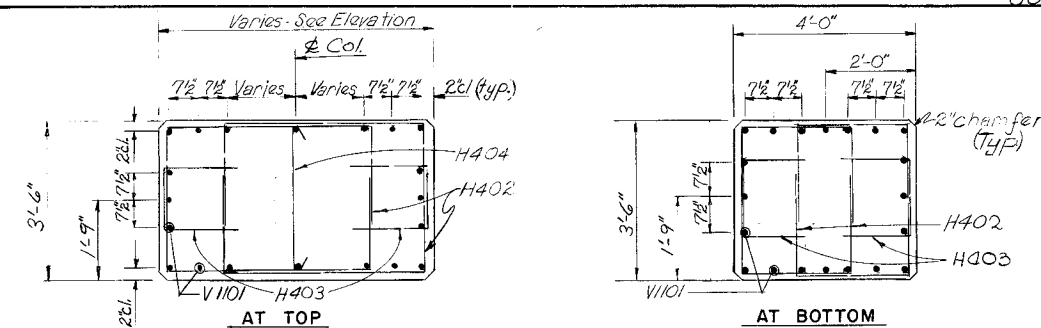

COLUMN SECTION
Scale: 1/2" = 1'-0"

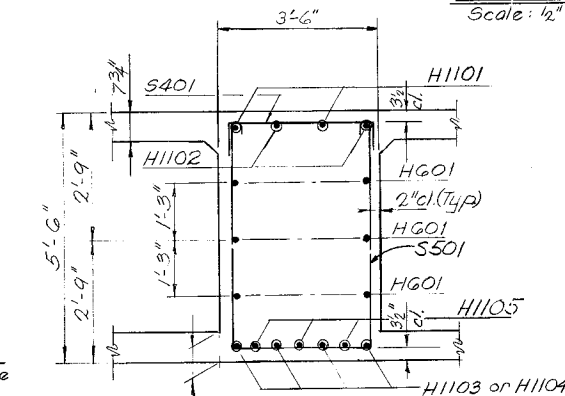

SECTION A-A
Scale: 1/2" = 1'-0"

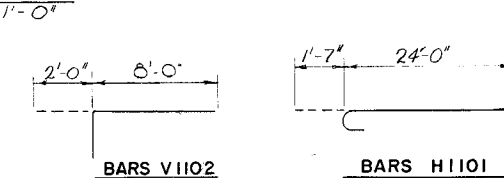

BARS H1102

BILL OF STEEL

Mark	No. Req'd	Length	Shape
H1101	4	25'-7"	
H1102	5	48'-4"	
H1103	4	28'-9"	
H1104	4	40'-6"	
H1105	4	18'-0"	
HG01	12	33'-1"	
H401	9	12'-8"	
H402	6 sets	Varies	
H403	162	4'-9"	
H404	75	3'-11"	
S401	44	3'-11"	
S501	44	14'-2"	
VII01	60	28'-1"	
VII02	12	10'-0"	
F801	135	14'-4"	

* 27 bars Per Set. 1 bar each length 12'-0" to 18'-6" in 3" increments.

ESTIMATED QUANTITIES

Item No.	Item	Unit	Quantity
204-02.01	Dry Excavation	Cu. Yd.	206
(1) 604-03.01	Class A Concrete	Cu. Yd.	138.3
(2) 604-03.02	Steel Bar Reinforcement	Pound	17,562
606-09.01	Test Piles (Precast Conc. Size 1)	Lin. Ft.	20'
606-09.02	Loading Tests (Precast Conc. Size 1)	Each	1
606-09.03	Precast Conc. Piling (Size 1)	Lin. Ft.	1480

- (1) Class "A" Concrete quantity includes concrete in footings and columns only. Concrete in pier cap is included in superstructure quantities.
(2) Steel Bar Reinforcement includes the steel in footing and columns only. Reinforcement in pier cap is included in Superstructure Quantities.

PILE NOTE:


See General Notes on Dwg. M-44-21 ultimate bearing capacity is 84 tons. 75 piles required. See Dwg. M-44-32 for additional pile data.

Notes:

1. Space Bars S501 as required to clear utilities and cut Bars H401 as required to clear utilities.
2. Space or Bend Bottom slab & cap Reinforcement as required to clear column Reinforcement. Cut column Reinforcement as required to clear Post Tensioning Tendons.

CORRECT
ENGINEER OF STRUCTURES
APPROVED
DIRECTOR OF HIGHWAYS


M-44-24

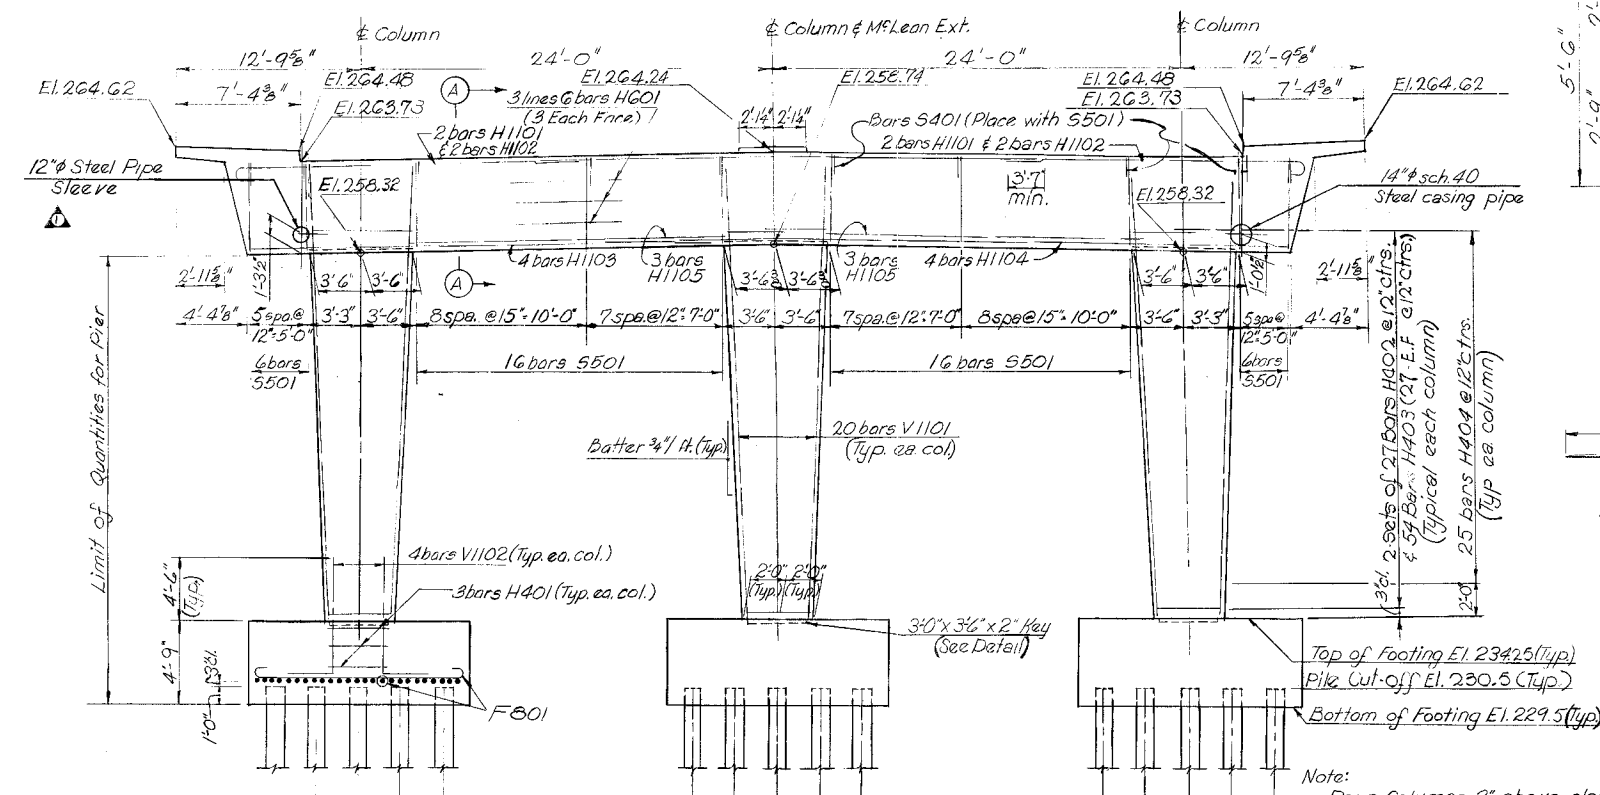


ELEVATION
Scale: 3/8" = 1'-0"

BARS H403

Note:
Pour Columns 2" above elevations shown. Column reinforcing shall extend a minimum of 4'-6" into Cap. Columns shall be supported until superstructure is in place.

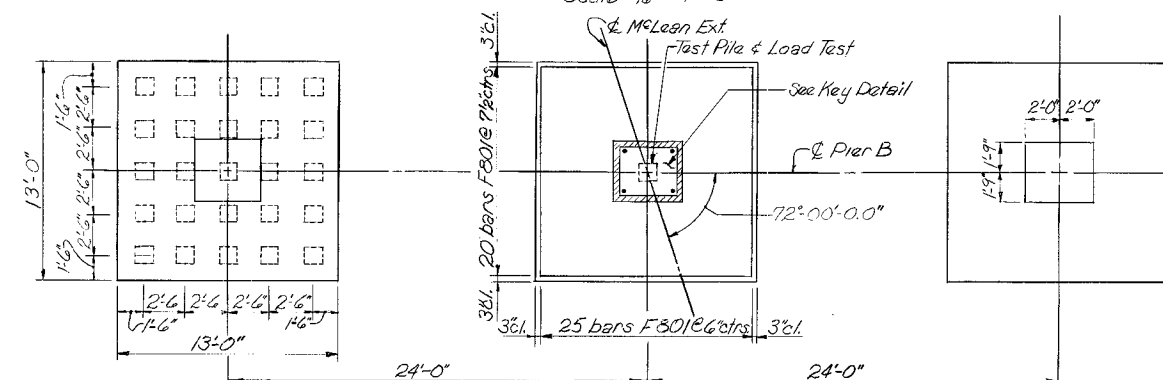

FOOTING PLAN
Scale: 3/8" = 1'-0"

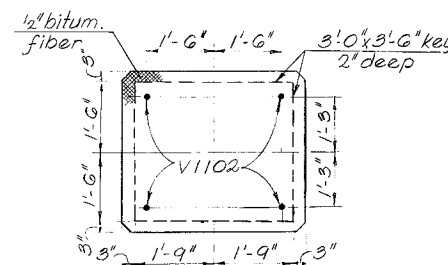

KEY DETAIL
Scale: 1/2" = 1'-0"



HARLAND BARTHOLOMEW AND ASSOCIATES
MEMPHIS, TENNESSEE

DESIGNED BY: D. McCorkle
DRAWN BY: J. Stort
SUPERVISED BY: D. McCorkle
CHECKED BY: F. Hoffman

DATE: July 1975
DATE: July 1975
DATE: July 1975
DATE: Aug. 1975

PROJECT NO.		YEAR		SHEET NO.	
EACI-240-11(132)6		1975			
REVISIONS					
NO	DATE	BY	BRIEF DESCRIPTION		
1	1-16-76	CEH	Charged dia. of steel sleeve for utility		

1. See Dwg M-44-26 for Bill of Steel, Wing Wall Elevation, Section B-B & C-C and Estimated Quantities.
2. See Std. Dwg. K-38-154 for Parapet Reinforcement to be placed in Wing Walls.
3. See Std. Dwg. K-86-144 for details of Reinforced Concrete Pavement at Bridge Ends. Also See Dwg. M-44-26.
4. All drainage pipes to have minimum slope = 1/8"ft
5. The backwall shall not be poured until after inspection of the Superstructure has been completed and the end inspection openings closed.
6. See Dwg. M-44-26 for Parapet and Wingpost details.
7. Cost of Bridgerail and Wingpost to be included in the cost of the Bridgerail System.
8. See Dwg M-44-31 for details of Elastomeric Bearing Pads.

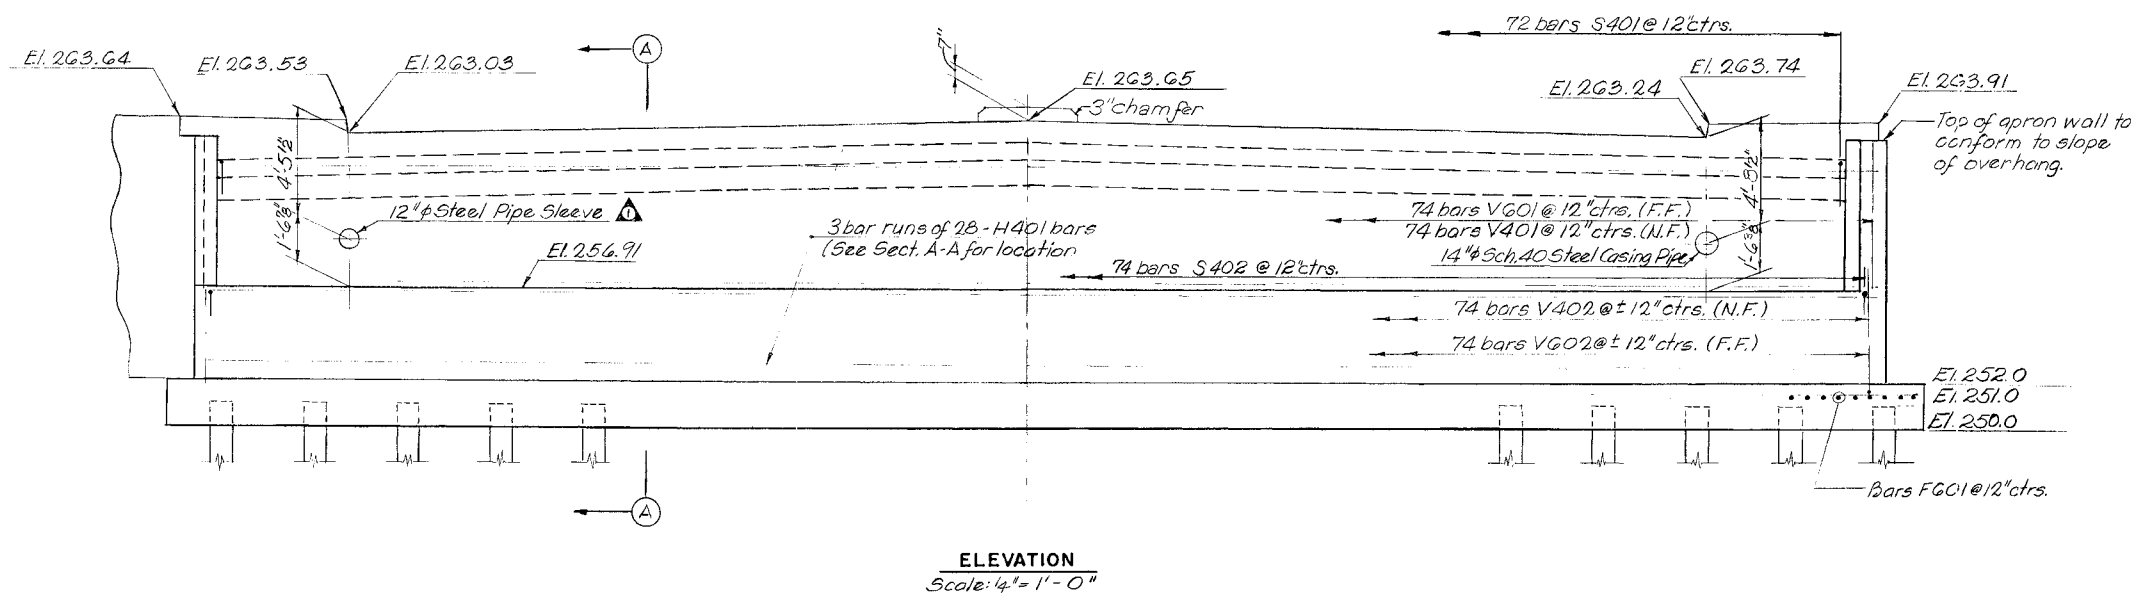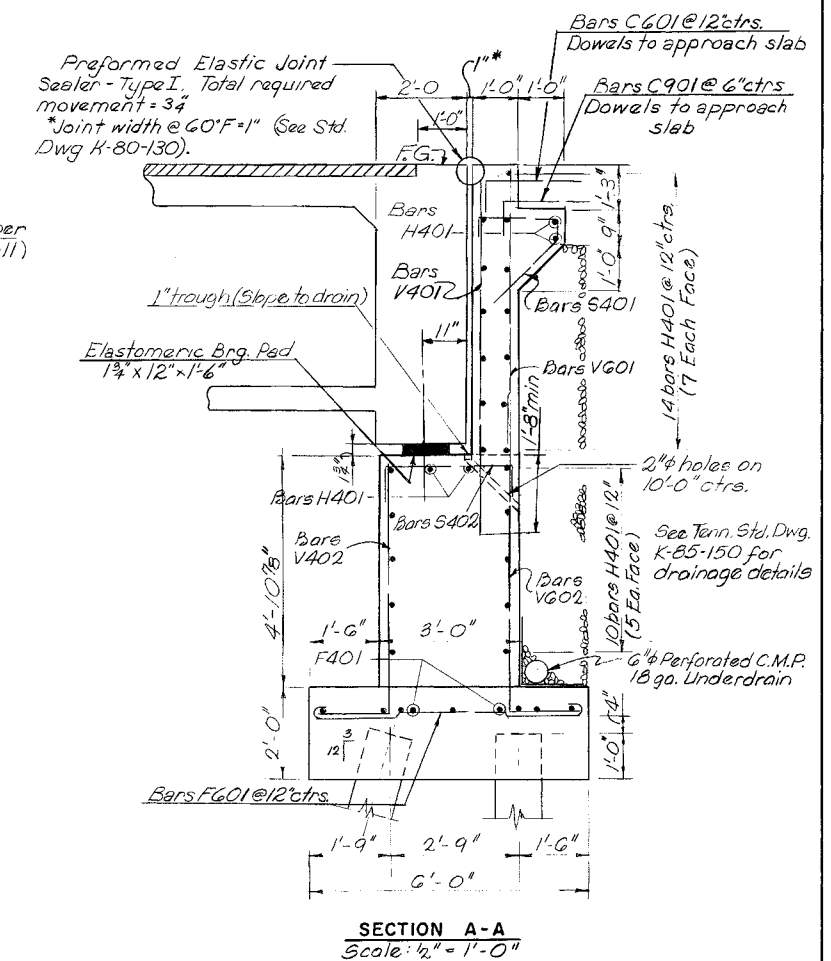

FILE NOTE: See General Notes
on Dwg. M-44-21. Drive piles in Sect. A-A to an ultimate
bearing capacity of 94 tons. (30 piles required.)
Drive piles in Sect. B-B to an ultimate bearing
capacity of 60 tons (10 piles required)
See Dwg. M-44-32 for additional data.

DESIGNED BY D. McCorkle DATE June '75
DRAWN BY J. Starr DATE June '75
SUPERVISED BY D. McCorkle DATE June '75
CHECKED BY F. Hoffman DATE Aug. '75

SHELBY COUNTY


APPROVED

DIRECTOR OF HIGHWAYS


M-44-25

Const. No. 79007-3125-44

PROJECT NO.	YEAR	SHEET NO.
EAC I-240-1(132)	1975	
REVISIONS		
NO.	DATE	BY

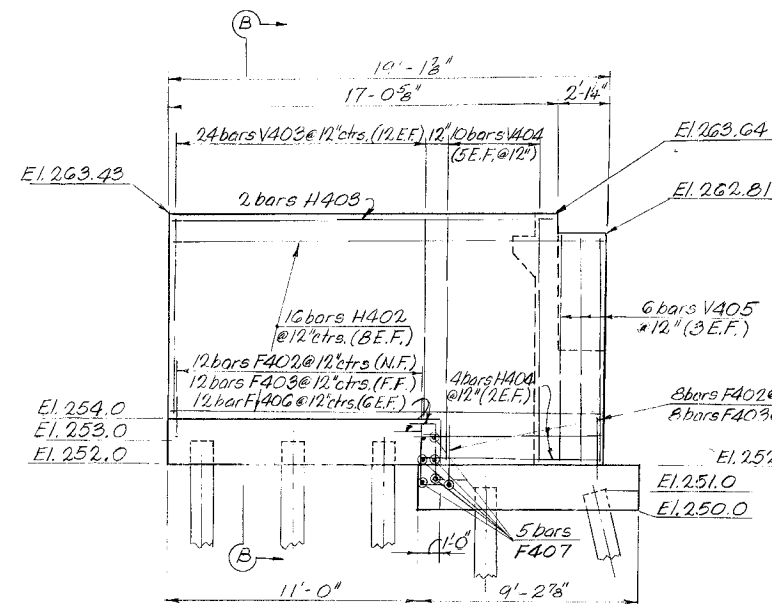


ABUTMENT C - WEST WALL
Scale 1/4" = 1'-0"

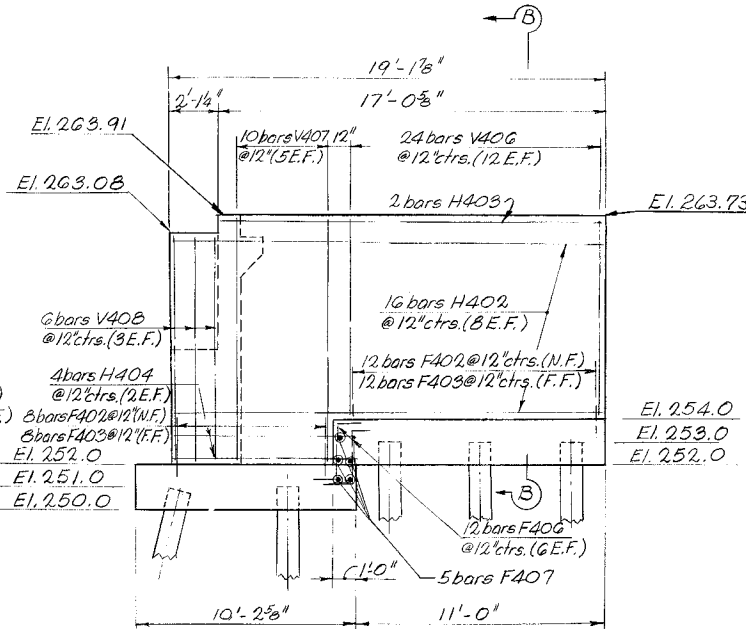


ABUTMENT C - EAST WALL
Scale 1/4" = 1'-0"

ESTIMATED QUANTITIES





Item No.	Item	Unit	Quantity
204-02.01	Dry Excavation	Cu.Yd.	211
604-03.01	Class A Concrete	Cu.Yd.	122.6
604-03.02	Steel Bar Reinforcement	Pound	10,124
606-09.01	Test Piles (Precast Conc. Size 1)	Lin.Ft.	30'
606-09.03	Precast Conc. Piling (Size 1)	Lin.Ft.	1,170
710-10.00	6" Perforated C.M.P. (18 Ga) w/porous baffle	Lin.Ft.	101.0
710-11.00	6" C.M.P. Underdrain (18 Ga)	Lin.Ft.	4.0

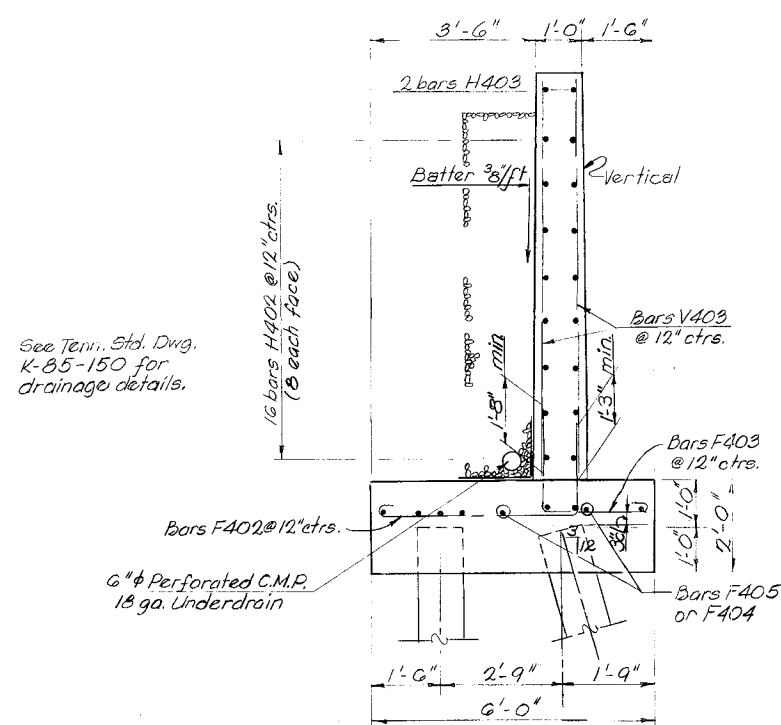

SECTION B-B
Scale 1/2" = 1'-0"

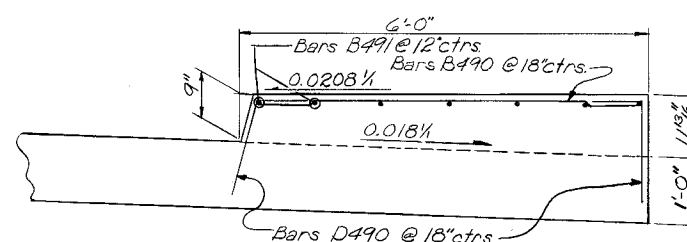

APPROACH SLAB SECTION THRU SIDEWALK
Scale 3/4" = 1'-0"

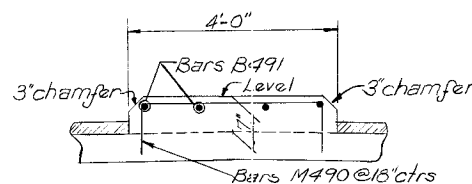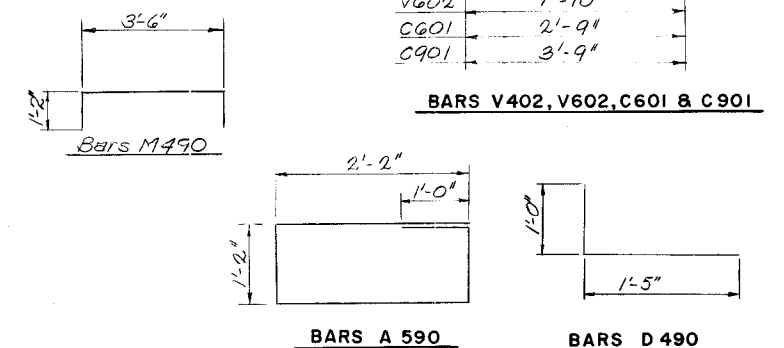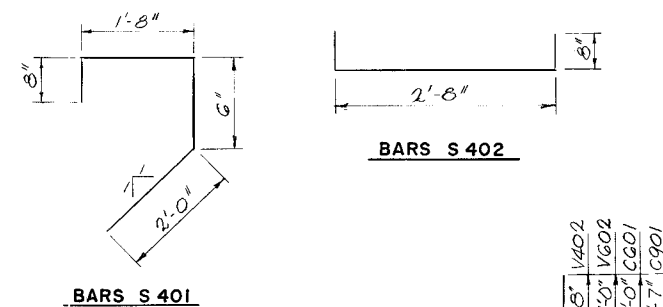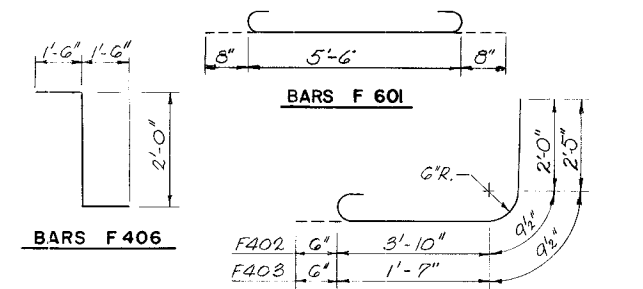

APPROACH SLAB SECTION
THRU RAISED MEDIAN

BILL OF STEEL

Mark	No. Req'd	Length	Shape
F401	27	26'-7"	
F402	40	7'-2"	
F403	40	5'-4"	
F404	18	4'-0"	
F405	18	11'-8"	
F406	24	5'-0"	
F407	10	5'-8"	
C601	71	3'-9"	
C901	142	5'-4"	
FG01	79	6'-10"	
H401	84	25'-6"	
H402	32	18'-10"	
H403	4	16'-9"	
H404	8	8'-0"	
S401	72	4'-9"	
S402	74	4'-0"	
V401	74	8'-2"	
V402	74	6'-2"	
V403	24	9'-3"	
V404	10	11'-4"	
V405	6	10'-6"	
V406	24	9'-7"	
V407	10	11'-8"	
V408	6	10'-9"	
V601	74	5'-10"	
V602	74	8'-10"	
APPROACH SLAB			
A490	150	24'-10"	
A590	116	7'-6"	
A690	69	24'-0"	
A790	16	37'-0"	
A990	137	24'-0"	
B490	34	5'-6"	
B491	18	24'-0"	
M490	17	5'-10"	
D490	68	2'-5"	

STATE OF TENNESSEE
DEPARTMENT OF TRANSPORTATION
BUREAU OF HIGHWAYS

BRIDGE 33C
McLEAN BLVD. EXT. OVER I-240

ABUTMENT C - DETAILS
STA. 323+00.00

SHELBY COUNTY

CORRECT ENGINEER OF STRUCTURES

APPROVED DIRECTOR OF HIGHWAYS

M-44-26

HARLAND BARTHOLOMEW AND ASSOCIATES
MEMPHIS, TENNESSEE

DESIGNED BY D. McCorkle DATE July 75
DRAWN BY J. Starr DATE July 76
SUPERVISED BY D. McCorkle DATE July 76
CHECKED BY F. Hoffman DATE Aug 76

Note:
Approach Slab to be built according to Tenn. Std. Dwg. K-86-144 except as noted above. Bars D490 & M490 to be pushed into green concrete after slab has been screeded.


MICROFILMED

Minimum lap longitudinal bars	
#4	1'-3"
#5	1'-7"
#6	2'-2"

NOTES: Const. No. 79007-3125-44

- See Dwg. M-44-27 for Typical Section, Estimated Quantities and Diaphragm Details.
- See Dwg. M-44-29 for Bill of Steel.
- See Dwg. M-44-26 for details of Parapet & Rail.
- When pouring sidewalk provisions shall be made for setting reinforcing steel for parapet. The parapet shall not be poured until the sidewalk is poured, cured and post tensioning completed. When pouring parapet, provisions shall be made for setting anchor bolts for rail. Sidewalks shall be poured before Post-Tensioning.
- For details of Pier Cap See Dwg. M-44-24.
- Pier Cap shall be poured monolithically with Superstructure.
- See Dwg. M-44-30 for Post Tensioning details.

PROJECT NO.		YEAR	SHEET NO.
EACI-240-K(32)0		1975	
REVISIONS			
NO.	DATE	BY	BRIEF DESCRIPTION
1	1-16-76	CEH	Changed dia. of Steel Sleeve for Utility

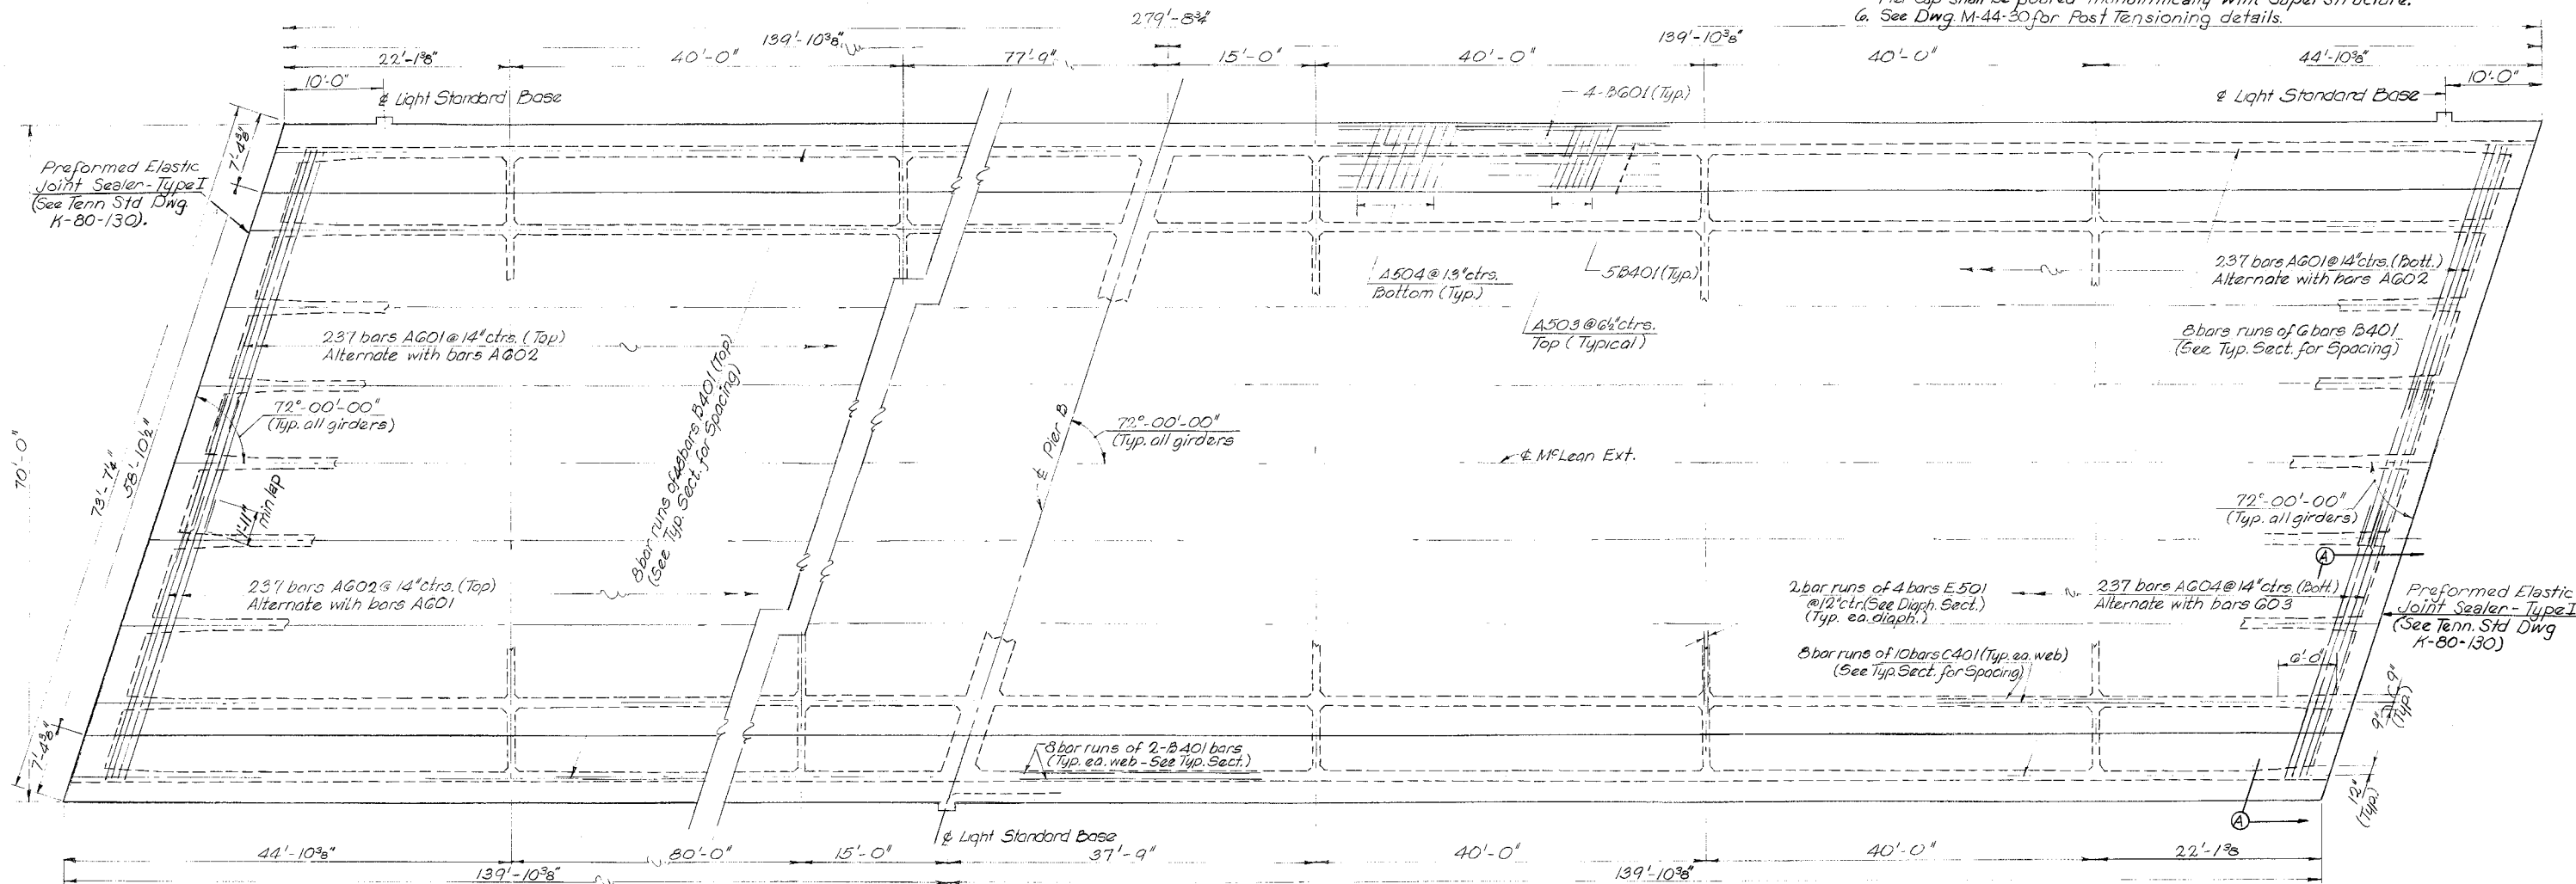


TOP SLAB PLAN

Scale-1/8"=1'-0"


Measured along Bk of Abut.

Note:
Openings shall be formed in ea. cell @ ea. end of bridge for inspection. Openings shall be closed following inspection and approval of forms and completion of Post-tensioning operation. Opening to be sealed with expansive grout.

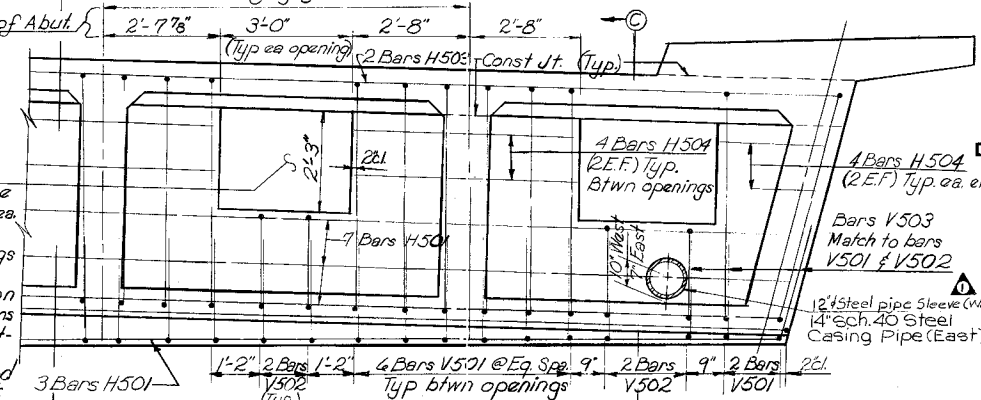


SECTION A-A

Scale-1/2"=1'-0"

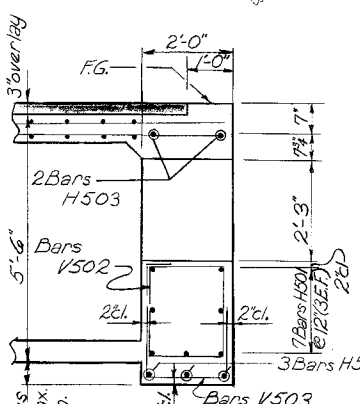

SECTION C-C

Scale-1/2"=1'-0"

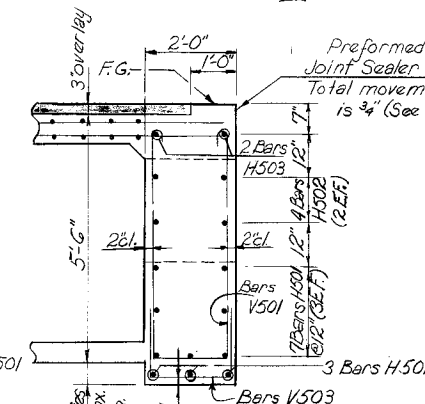

SECTION B-B

Scale-1/2"=1'-0"

STATE OF TENNESSEE
DEPARTMENT OF TRANSPORTATION
BUREAU OF HIGHWAYS

BRIDGE 33C
McLEAN BLVD. EXT. OVER I-240

TOP SLAB PLAN
STA. 323+00.00

SHELBY COUNTY

HARLAND BARTHOLOMEW AND ASSOCIATES
MEMPHIS, TENNESSEE
DESIGNED BY D. Mc Corkle
DRAWN BY J. Starr
SUPERVISED BY D. Mc Corkle
CHECKED BY F. Hoffman
DATE June '75
DATE June '75
DATE Aug. '75


CORRECT
ENGINEER OF STRUCTURES
APPROVED
DIRECTOR OF HIGHWAYS

M-44-28


MICROFILMED

Const. No. 79007-3125-44

PROJECT NO.	YEAR	SHEET NO.
EACI 240-1(132)6	1975	
REVISIONS		
NO.	DATE	BY
BRIEF DESCRIPTION		

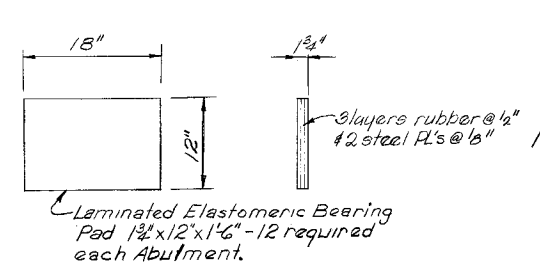


ELASTOMERIC BEARING DETAIL
Scale 1"=1'-0"

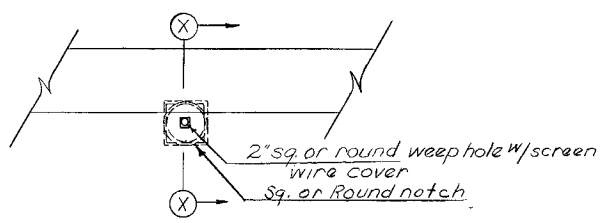


PLAN

WEEP HOLE DETAIL
No Scale

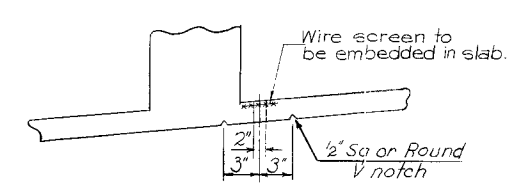


SECTION X-X

- NOTES:**
1. See Dwg. M-44-27 for Estimated Quantities, Typical Section, Longitudinal Section, Diaphragm Details and Section A-A, B-B & C-C.
 2. Pier Cap to be poured monolithically with Superstructure. See Dwg. M-44-24 for Pier Cap detail.
 3. See Dwg. M-44-30 for Post-Tensioning details.
 4. See Abutment drawings for location of elastomeric bearings.
 5. Elastomeric bearing pads shall conform to Section 25 of AASHTO Standard Specifications for Highway Bridges (1973) plus Interim.
 6. See Dwg. M-44-28 for min. lap for longitudinal bars.
- Laminated Bearings shall be made of 50 Durometer Hardness Elastomers.

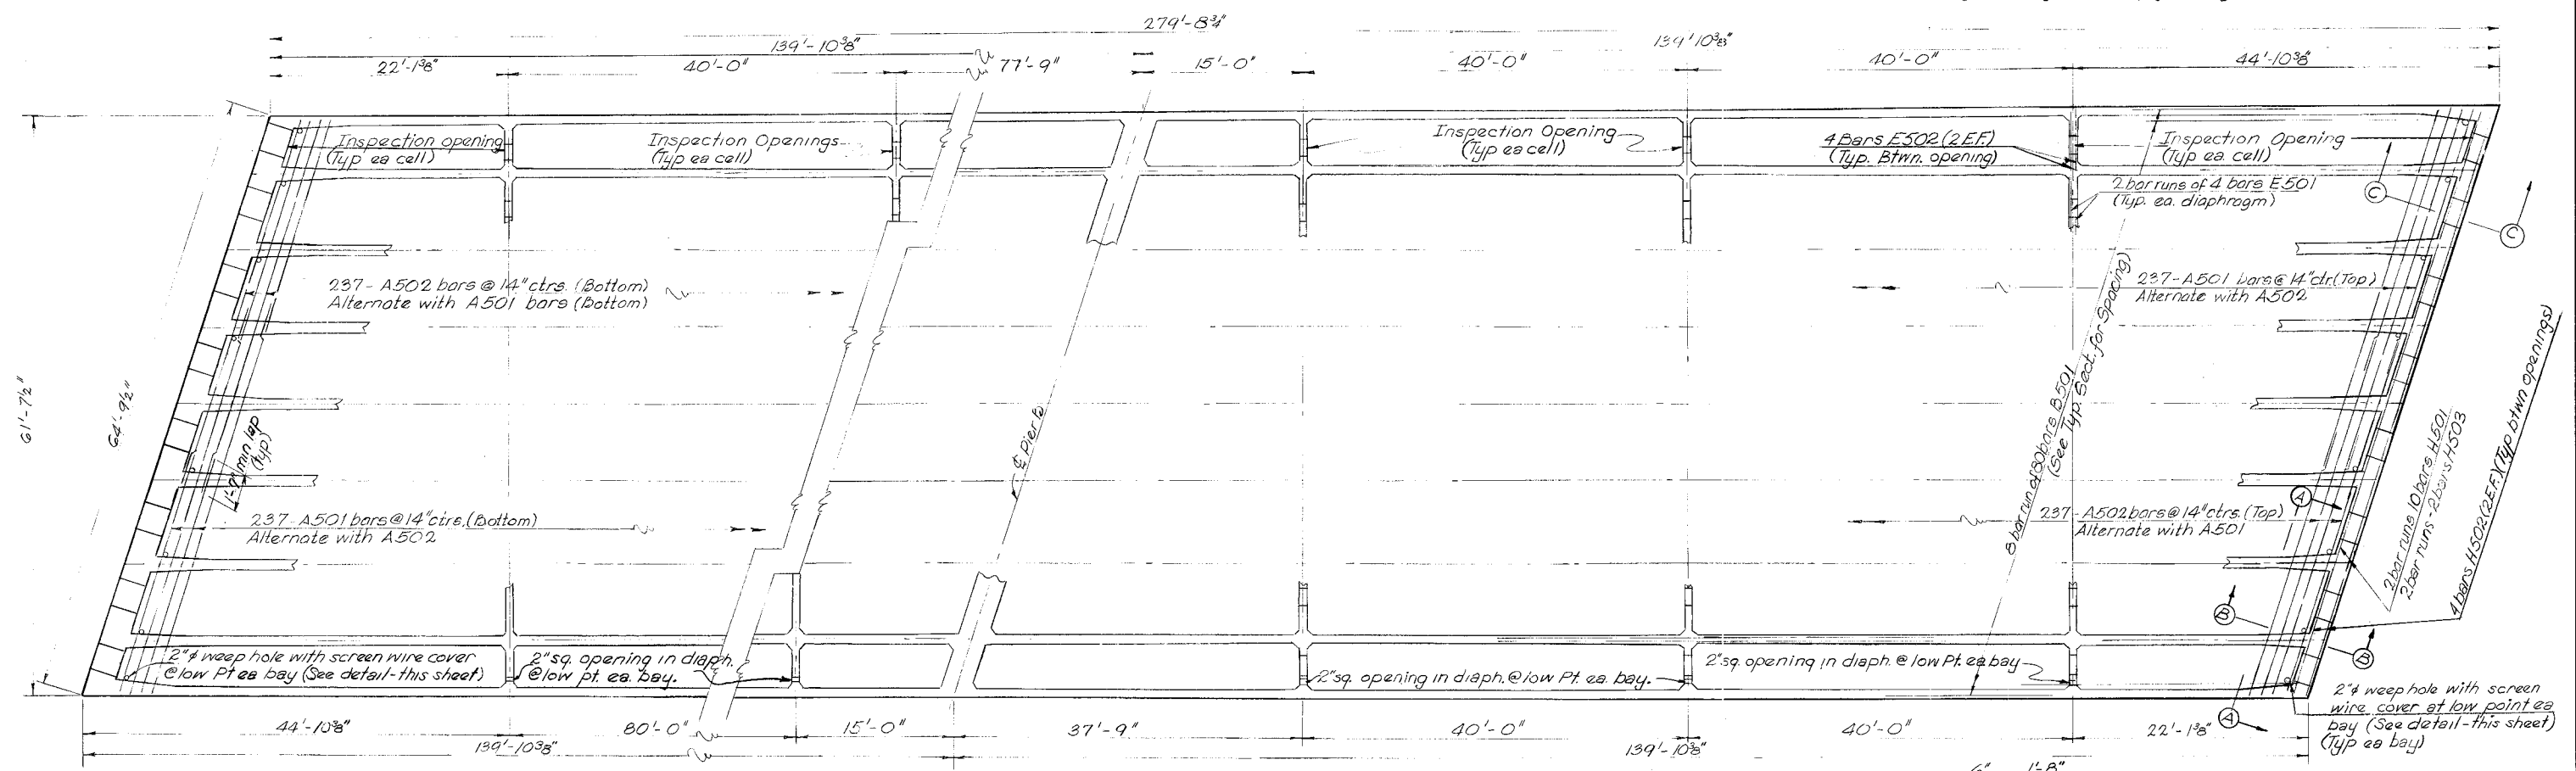


BOTTOM SLAB PLAN
Scale: 1/8"=1'-0"


BILL OF REINFORCING							
Mark	No. Req'd	Length	Shape	Mark	No. Req'd	Length	Shape
A501	474	24'-10"	—	E501	48	31'-4"	—
A502	474	41'-6"	—	E502	168	5'-6"	—
A503	1032	9'-0"	C	E503	48	2'-0"	—
A504	516	6'-8"	—				
A601	237	32'-3"	C				
A602	237	37'-9"	—	H501	40	33'-2"	—
A603	237	27'-5"	—	H502	56	5'-0"	—
A604	237	41'-11"	—	H503	8	34'-4"	—
				H504	16	2'-0"	—
B401	608	36'-2"	—				
B501	1032	36'-6"	—				
B601	64	36'-9"	—	V501	92	12'-10"	E
				V502	32	8'-4"	—
				V503	124	5'-8"	—
C401	720	36'-2"	—				
S401	384	4'-7"	—				
S501	2016	6'-9"	—				
S502	576	7'-0"	—				

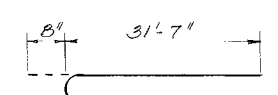


BARS A 601

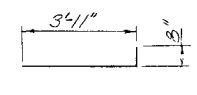


BARS S 401

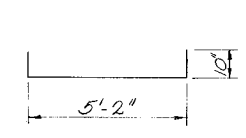


BARS S 501

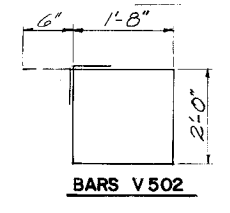


BARS V 502

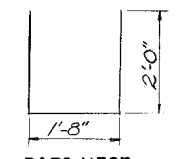


BARS V 503

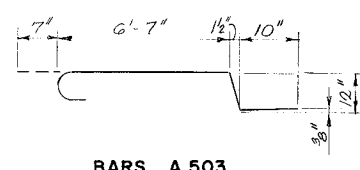

BARS A 503

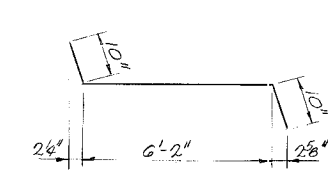

BARS S 502

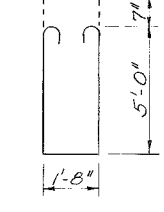

BARS V 501

STATE OF TENNESSEE
DEPARTMENT OF TRANSPORTATION
BUREAU OF HIGHWAYS

BRIDGE 33C
McLEAN BLVD. EXT. OVER I-240

BOTTOM SLAB PLAN
STA. 323+00.00

SHELBY COUNTY

HARLAND BARTHOLOMEW AND ASSOCIATES
MEMPHIS, TENNESSEE

DESIGNED BY: D. McCorkle
DRAWN BY: J. Starr
SUPERVISED BY: D. McCorkle
CHECKED BY: F. Hoffman

DATE: June '75
DATE: June '75
DATE: June '75
DATE: Aug. '75

CORRECT
ENGINEER OF STRUCTURES
APPROVED
DIRECTOR OF HIGHWAYS

1. POST TENSIONING: See Special Provision No.560, Special Provision Regarding Post-Tensioned Prestress Concrete and notes this sheet

2 CONCRETE: To be Class A $f_c = 4000$ psi, Stressing operations shall not begin until the concrete has reached a compression strength of 3500 psi as indicated by test specimens. See Section 615.09 of the Tennessee Standard Specification.

3. DESIGN: Based on $U=0.25$ and $K=0.0002$, P/J ack specified at the jacking ends includes friction losses plus provision for 5000 psi. loss in stress at jacking plus 31,600 psi. long term loss in stress.

4 TENSIONING FORCE: The maximum required tensioning force at the jack is 1945 kips per web which is 76 percent of the specified minimum ultimate tensile strength of the prestressing steel. Tendons shall be jacked to the above value and anchored at an equivalent anchor set of 38".

5. STRESSING SEQUENCE: Jacking shall be done from both abutments. Avoid stressing sequence that will cause unsymmetrical forces about a vertical axis.

6. CLEARANCES FOR POST-TENSIONING UNIT: Horizontal clearances between units = 2 1/2" minimum. Units may be bundled vertically in groups of 3 maximum. Vertical clearance between bundled units = 3" minimum.

7. Bar reinforcement interfering with prestressing tendon alignment shall be adjusted by the Engineer.

8. Form work shall not be removed until all Post-Tensioning is complete.

9. If ducts are to be placed within limits of the bottom slab, provisions shall be made to tie the ducts to the vertical steel before the bottom slab is poured.

10. Ducts to be vented through slab to within 3 ft of high points of the cable path.


11. Anchorage details are to be determined by the fabricator. Double end pulls of all tendons are required.

12. Camber: Dead load camber shown on the plans is based on $E_c = 1,214,700$ psi. The Contractor shall submit calculations of deflections due to prestress load based on tendon arrangement selected and $E_c = 1,214,700$ psi. These deflections shall be subtracted from the dead load camber shown on these plans and adjusted to the vertical curve to determine screed elevations for pouring.

13. Reinforcing Steel Reinforcing Steel required at each end anchorage shall not be paid for separately, but shall be included in the price bid for Post-tensioning. These details are to be included in post-tensioning shop drawings.


SECTION PROPERTIES

At Φ Spans (Bottom Slab $t = 5\frac{1}{2}"$)	At Pier (Bottom Slab $t = 8"$)
$A = 17,473 \text{ in.}^2$	$A = 19,052 \text{ in.}^2$
$I = 11,856,739 \text{ in.}^4$	$I = 13,381,731 \text{ in.}^4$
$Z_t = 326,557 \text{ in.}^3$	$Z_t = 343,147 \text{ in.}^3$
$Z_b = 302,532 \text{ in.}^3$	$Z_b = 366,599 \text{ in.}^3$
$Y_t = 36.31 \text{ in.}$	$Y_t = 39.0 \text{ in.}$
$Y_b = 39.19 \text{ in.}$	$Y_b = 36.5 \text{ in.}$

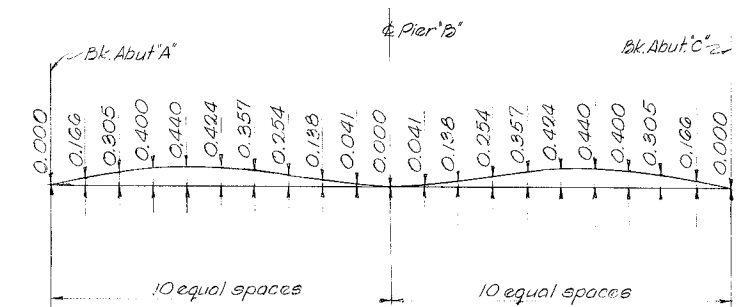

DEAD LOAD CAMBER DIAGRAM

NOTE: The curve shows the dead load camber only. Camber shall be increased by the amount of anticipated take-up in the falsework. Camber values are based on $E_c = 1,214,700$ psi. See Note 12, this Dwg for adjustments necessary due to prestress forces and vertical curve.

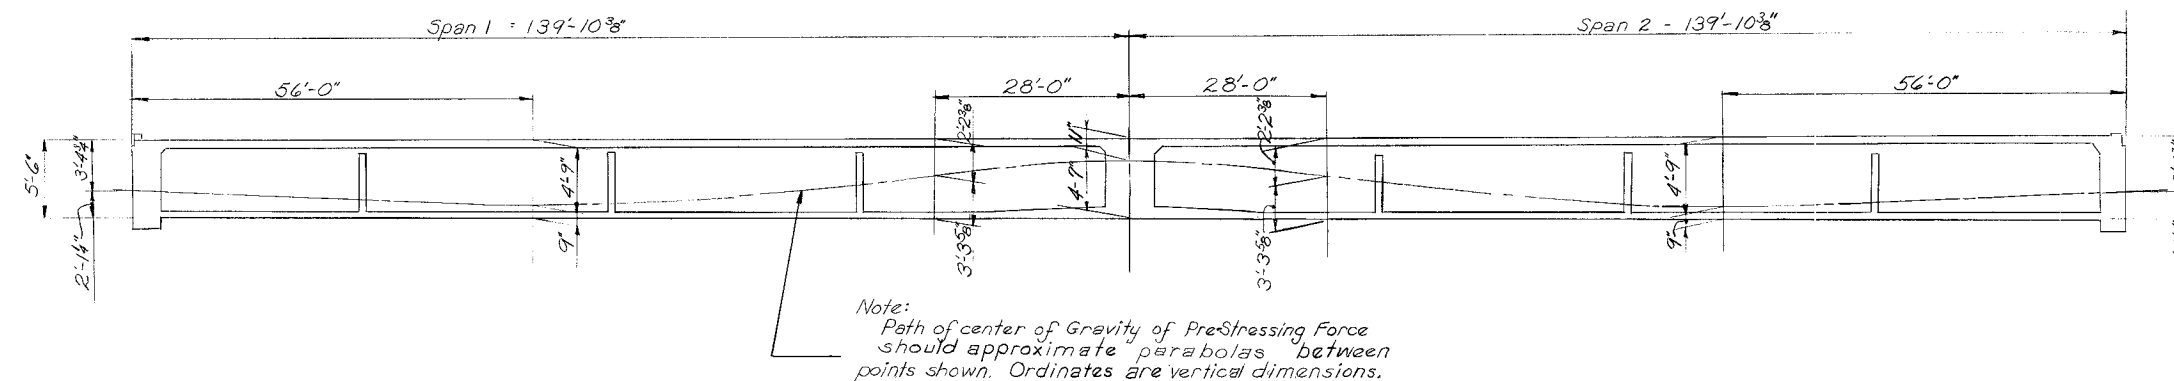

DRAPE COORDINATES FOR PRE-STRESSED STEEL
~No Scale~

STATE OF TENNESSEE
DEPARTMENT OF TRANSPORTATION
BUREAU OF HIGHWAYS

BRIDGE 33C
McLEAN BLVD. EXT. OVER I-240

POST-TENSIONING DETAILS
STA. 323+00.00

SHELBY COUNTY

DESIGNED BY D. McCorkle DATE June 75
DRAWN BY J. Milam DATE June 75
SUPERVISED BY D. McCorkle DATE June 75
CHECKED BY E. Hoffman DATE July 75


CORRECT _____
ENGINEER OF STRUCTURES

APPROVED _____
DIRECTOR OF HIGHWAYS

M-44-30

[illegible]

1. The Elevations given are at top of Concrete and do not include 3" Asphalt Overlay.
2. Header Elevations are given at the end of slab but do not include the 3" x 3 3/4" Recess for the Type I Preformed Elastic Joint Sealer

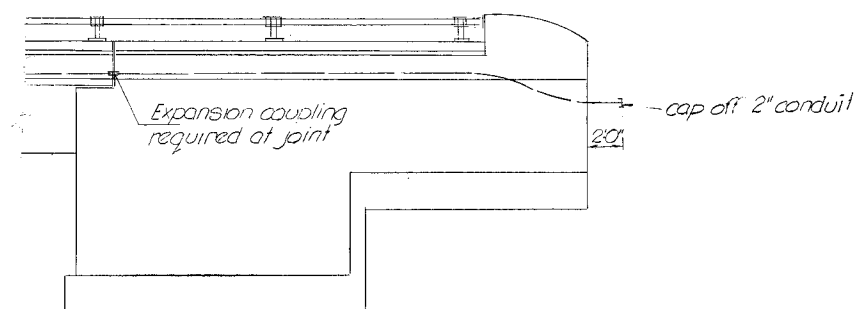

STATE OF TENNESSEE
DEPARTMENT OF TRANSPORTATION
BUREAU OF HIGHWAYS

BRIDGE 33C
MCLEAN BLVD. EXT. OVER I-240

SCREED ELEVATIONS & RAIL POST SPACING
STA. 323 +00.00

SHELBY COUNTY



CORRECT _____
ENGINEER OF STRUCTURES

APPROVED _____
DIRECTOR OF HIGHWAYS

M-44-31


Const. No. 79007-3125-44

PROJECT NO.	YEAR	SHEET NO.
EAC I-240-1(132)6	1975	

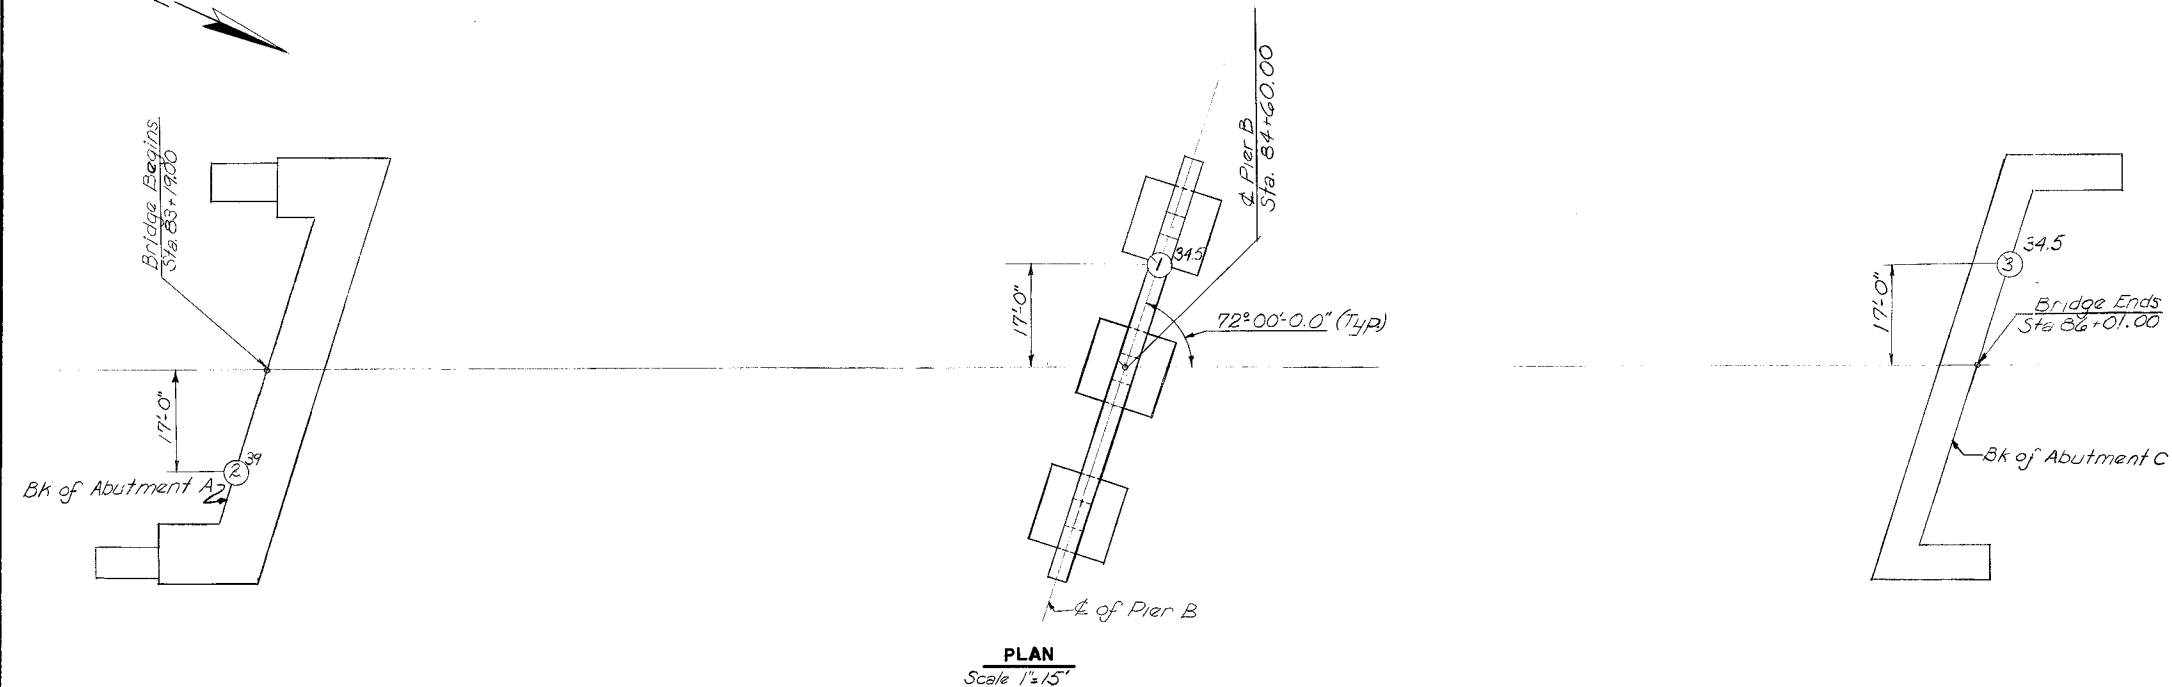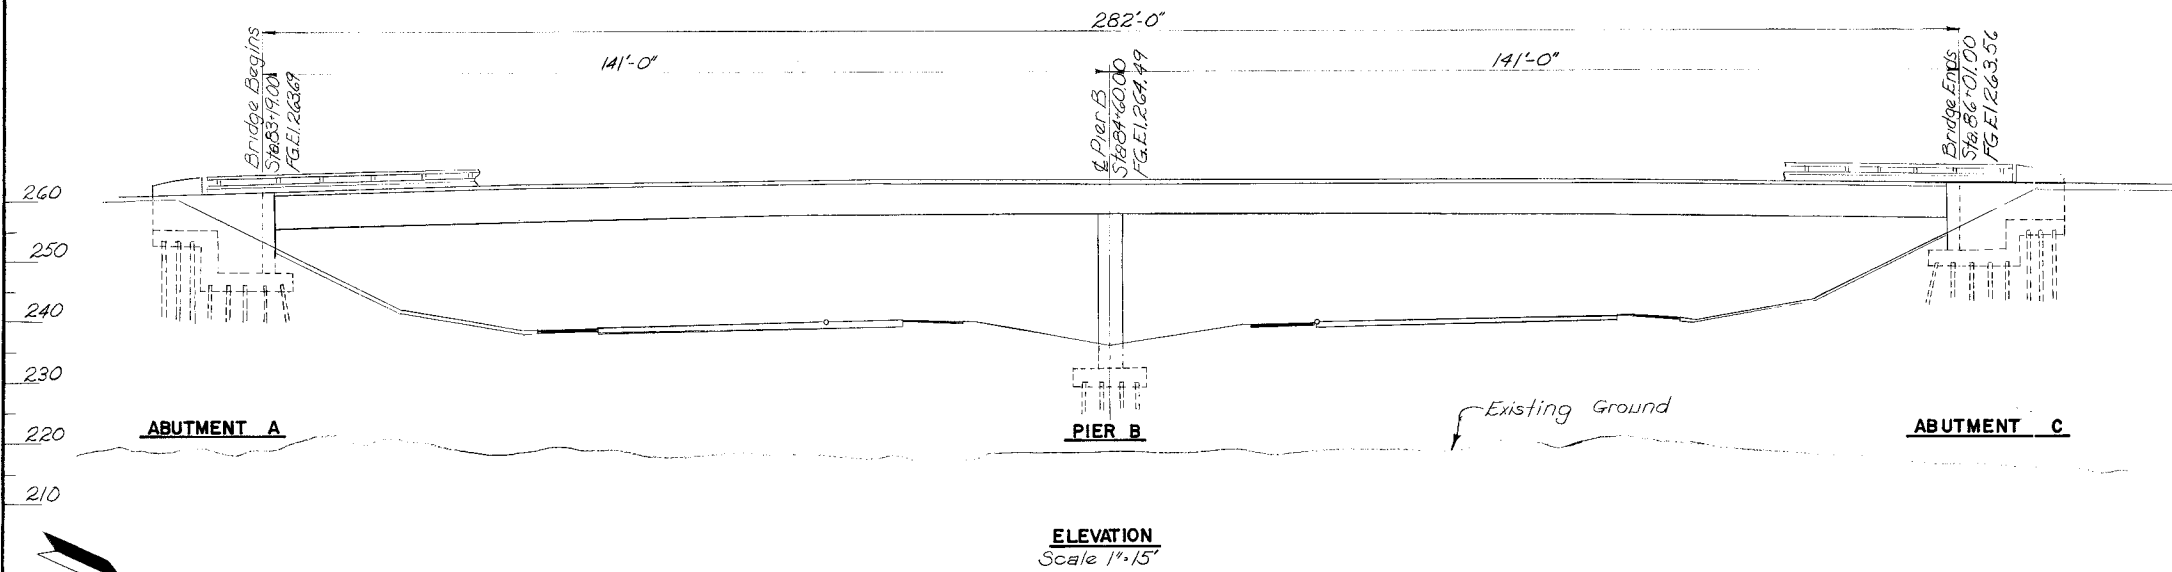

PILE DATA					
Location	Design Load	No. Piles	Cut-Off Elevation	Estimated Tip Elevation	Estimated Pile length
Abutment A	98 Tons	39	248.50	223.5	25.0
	60 Tons	10	255.00	230.0	25.0
Pier B	84 Tons	75	230.50	210.5	20.0
Abutment C	94 Tons	30	251.00	221.0	30.0
	60 Tons	10	253.00	223.0	30.0

① Design Loads are based on factored loads.
② Pile lengths subject to change after reviewing of the load test.

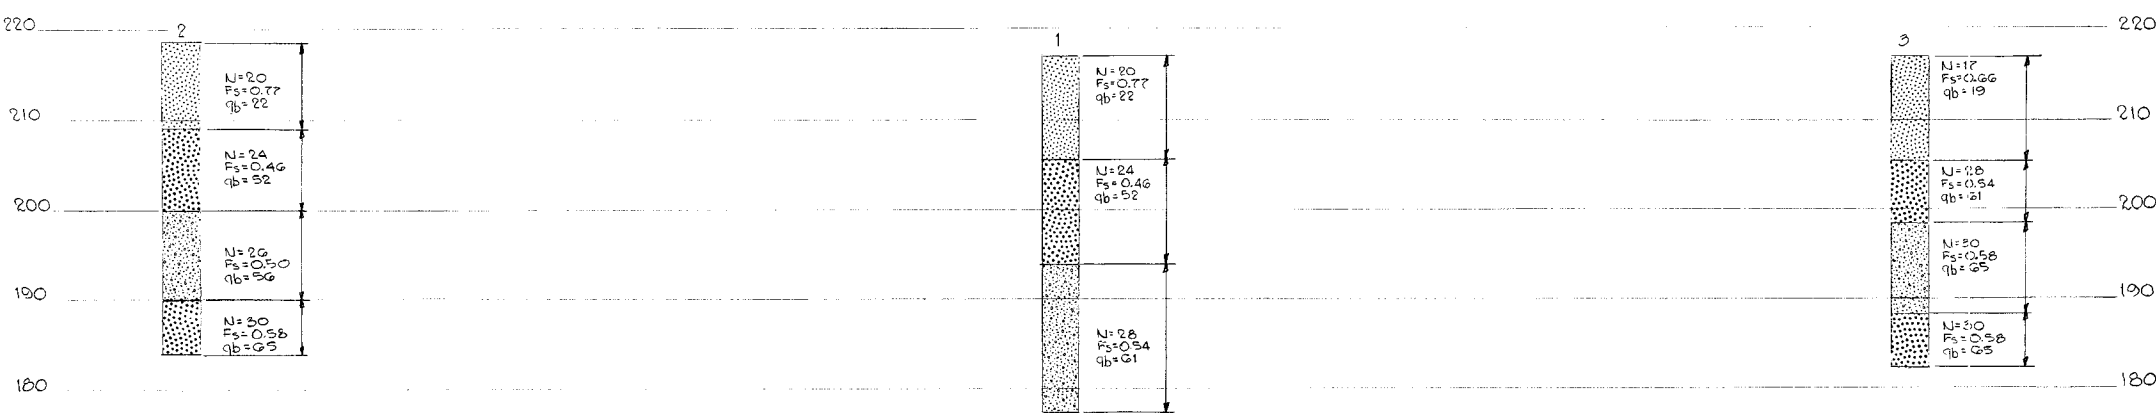

Legend

- Depth augered (no refusal)
- Boring no. 39.5'
- N = "N" Value
- Fs = Tons/Ft.²
- qb = Tons/Ft.²
- Silt
- Sand
- Gravel

SOIL BORINGS

MCLEAN BLVD. EXTENDED OVER E.B. & W.B. I-240

SHELBY COUNTY




PROJECT NO.	YEAR	SHEET NO.
REVISIONS		
NO.	DATE	BY
1	10-13-59	
2	6-16-70	
3	9-12-74	
4	1-14-75	
5	8-27-76	
BRIEF DESCRIPTION		
Reinf. bar clearance		
Gen. Revisions		
Note 3 changed		
Revised Note		
Revised Note #10 & added TABLE A & B, added note 13.		

TABLE A


Bar Size	Approx. dia. outside deformations (inches)
#3	7/16
#4	9/16
#5	11/16
#6	7/8
#7	1

TABLE B


Bar Size	Approx. dia. outside deformations (inches)
8	1 1/8
9	1 1/4
10	1 7/16
11	1 5/8
14	1 7/8
13	2 1/2

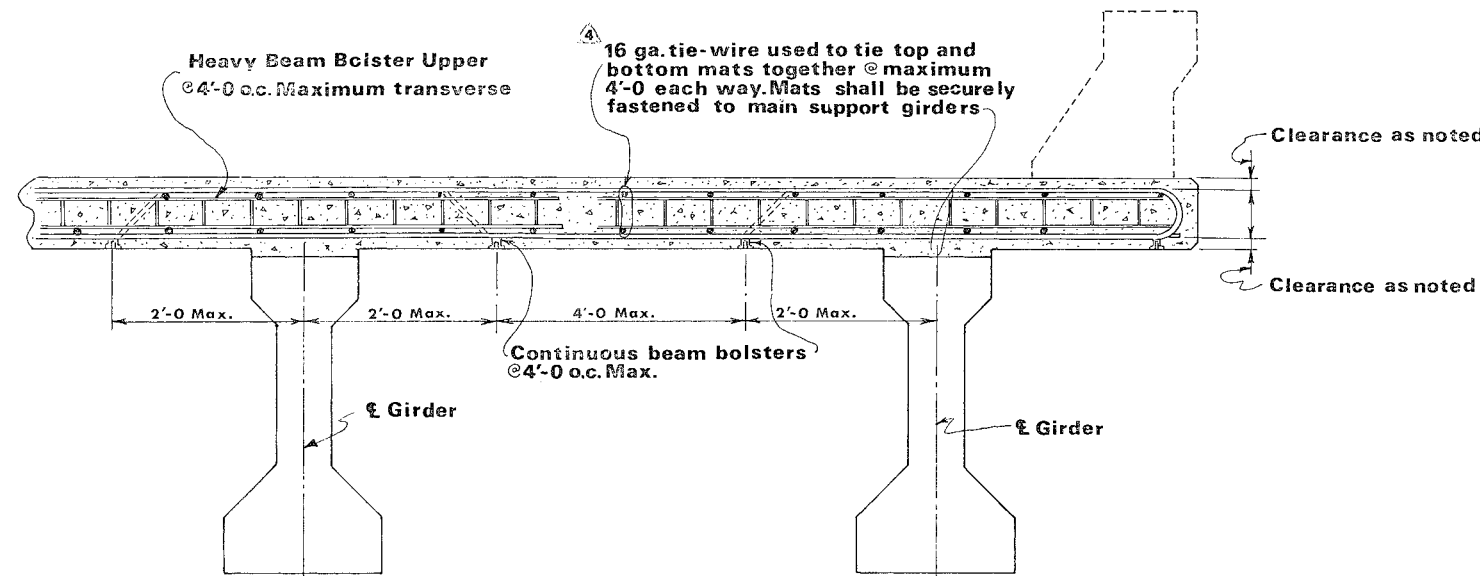


TYPICAL DETAILS FOR GIRDER TYPE BRIDGES

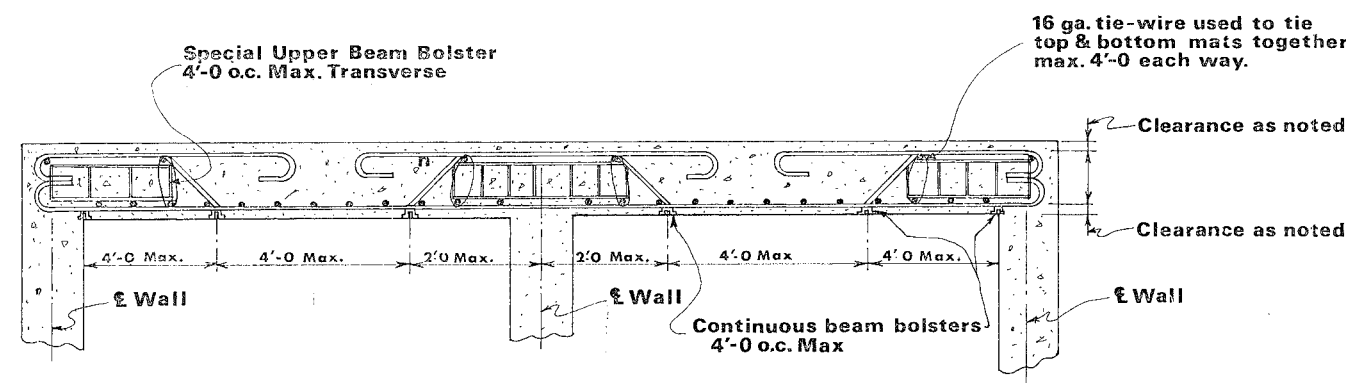


TYPICAL DETAILS FOR BOX TYPE STRUCTURES

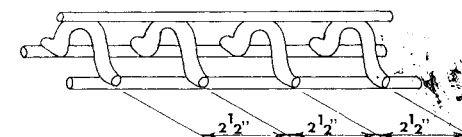


HEAVY BEAM BOLSTER UPPER (HBBU)

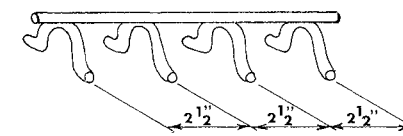

BEAM BOLSTER (BB)

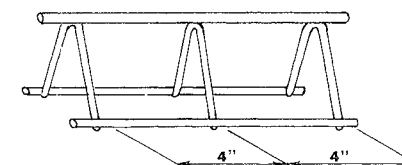

SPECIAL UPPER BEAM BOLSTER

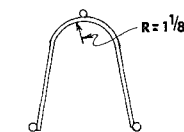

END VIEW

- Reinforcement in Bridge slabs and top slabs of boxes shall be securely spaced from the forms by metal spacers as indicated this sheet. Other type spacers will not be permitted.
- All beam bolsters (BB) & heavy beam bolster upper (HBBU) and Special Upper Beam bolster shall be made according to C.R.S.I. Specifications.
- Beam bolster (BB) legs in contact with forms and to be at exposed surface of concrete, shall be either "plastic protected" or "stainless steel protected"
- Reinforcing bars shall be securely fastened together at each intersection using a minimum 16 ga. tie wire, except where spacing is less than one foot in each direction, alternate intersections shall be fastened.
- Reinforcing bar supports shall be furnished to minus 1/16" or plus 1/8" of specified bar.
- The top and bottom reinforcing mats shall be tied together at maximum of 4'-0" o.c. each way.
- When any type shear connector protrudes from the top flange of the beam, the reinforcing steel shall be tied to these connectors at maximum 2'-0" o.c. along the beam.
- Reinforcing steel shall not be used to support concrete buggies, material carts, or bundles of re-bars.
- Cost of all bar supports and tie wire shall be included in bid price for reinforcing steel.
- A reinforcing bar may be substituted when a heavy Beam Bolster Upper of a 1" or less height is required. See Table A above.
- A special Upper Beam Bolster (as detailed this sheet) may be substituted for heavy Beam Bolster Uppers required in heights of 5 1/4" or greater.
- Steel in top & bottom of slabs of Reinforced Concrete Hollow Box Girders will be supported in accordance with this drawing.
- 3a. Plastic protected legs shall be dipped and baked onto the upturned legs per the latest C.R.S.I. specifications.
- 3b. Stainless protected legs shall be made from stainless steel with a minimum chromium content of 16% (similar to AISI TYPE 430). Per the latest C.R.S.I. specifications.

13. Use table A and/or B for bar sizes to determine beam bolster size to use.

STATE OF TENNESSEE
DEPARTMENT OF TRANSPORTATION
BUREAU OF HIGHWAYS


STANDARD REINFORCING BAR SUPPORT DETAILS FOR CONCRETE SLABS

DESIGNED BY
DRAWN BY G.P. Mullican
SUPERVISED BY
CHECKED BY
DATE 8-29-73
DATE
DATE


CORRECT
ENGINEER OF STRUCTURES
APPROVED
DIRECTOR OF HIGHWAYS

K-80-14




NOTE: Top of slab to conform to roadway slope & grade.

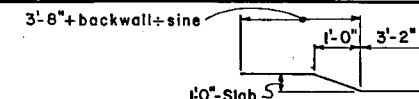


PROJECT NO.		YEAR	SHEET NO.
REVISIONS			
NO.	DATE	BY	BRIEF DESCRIPTION
1	11-16-70	CMH	Compression seal added, aggregate size changed. General notes revised & bridge drain details.
2	12-18-70	CMH	Section D-D & notes added, compression seal note removed & Expansion joint note added
3	8-12-71	RMD	Clarified spacing & no. of L590 bars
4	3-12-74	RMD	Removed V Notch
5	7-18-75	RMD	Added Detail X & Revised Note 3
6	8-18-75	RMD	Revised Roadway Drain
7	3-2-76	CPR	Changed Draw No. on Detail "A"
8	6-17-76	CMH	Revised aggregate designation
9	8-30-76	RMD	Revised minimum clearances
10	5-Dec-77	EPW	Rev. Note 2 & Min. Cl. on top Re bar.
11	8-Nov-79	LGH	Change slab 3 to 4, Added new Note 3
12	7-17-81	RMD	deleted Detail X Add SHORT PLAN

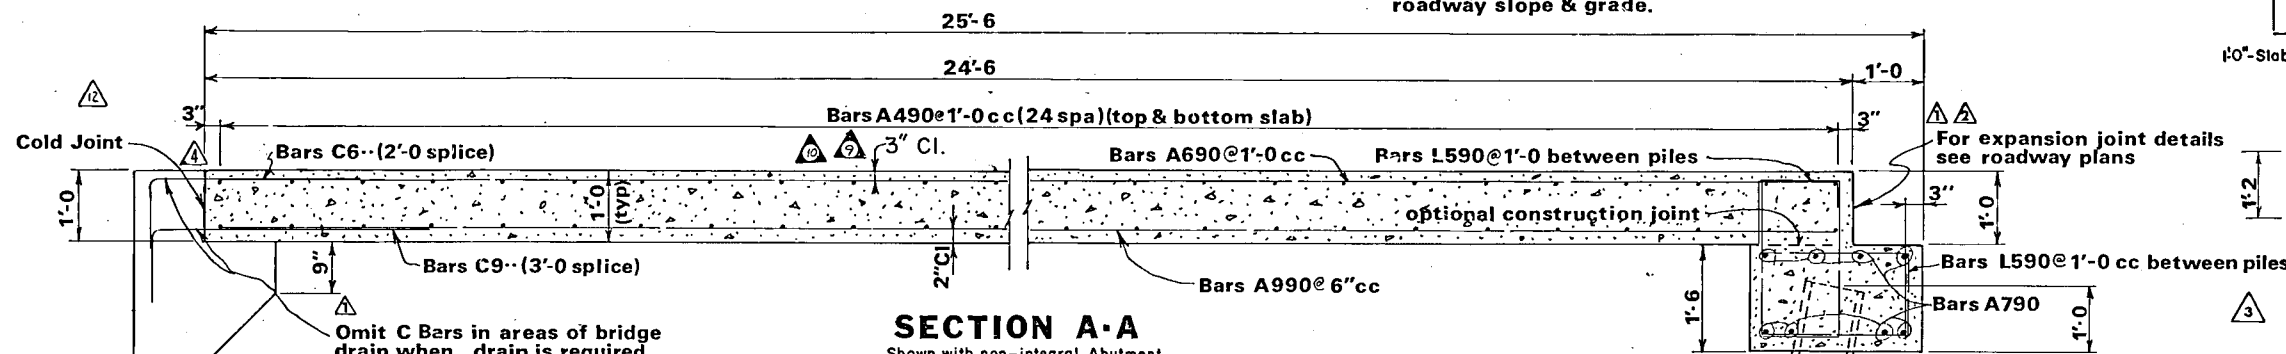

Note: Location of notch for bridge drain shall be as shown on the Roadway Plans and/or Bridge Plans and shall be constructed in accordance with the fit-up requirements of Standard Drawing D-CB-9 or as directed by the Engineer.

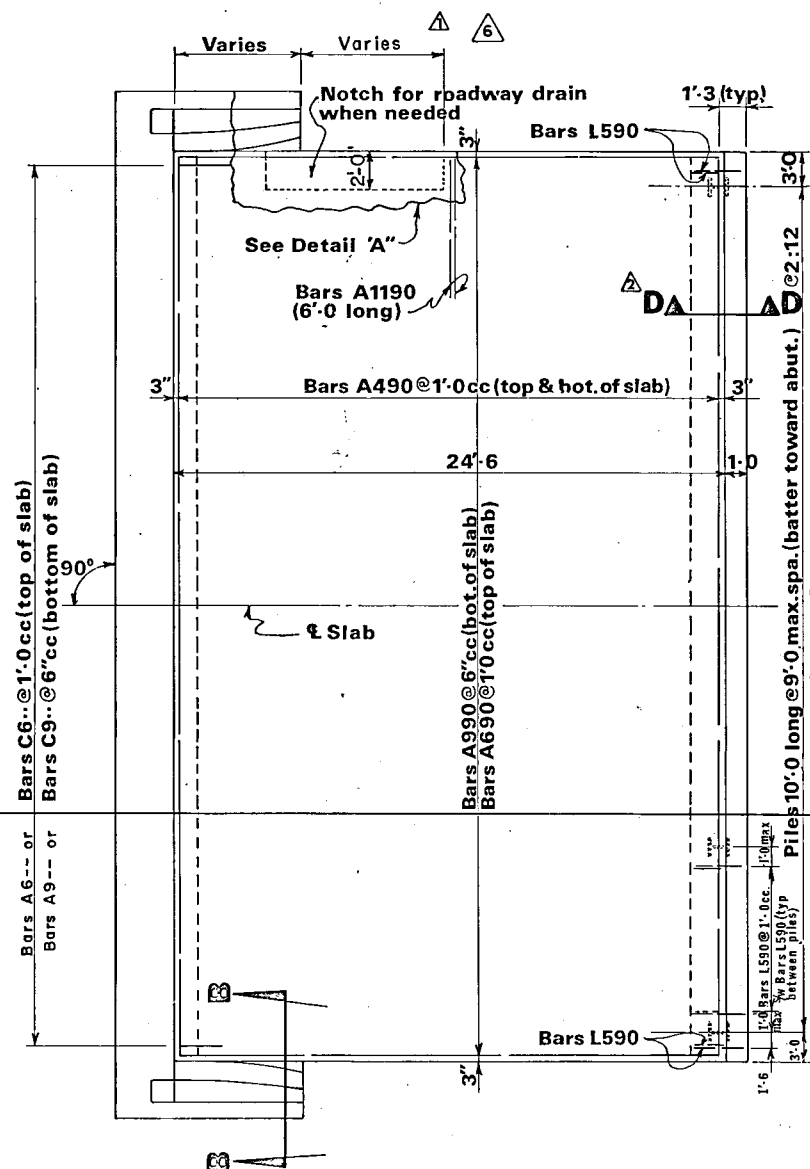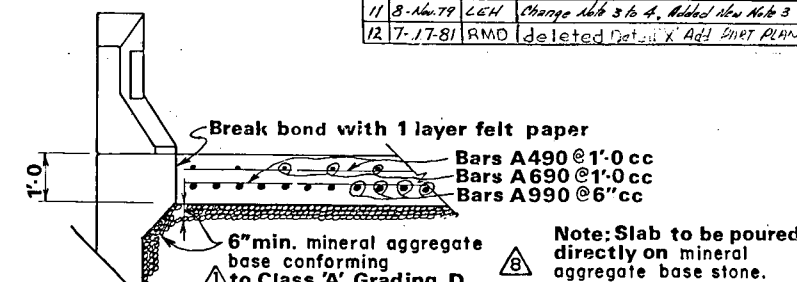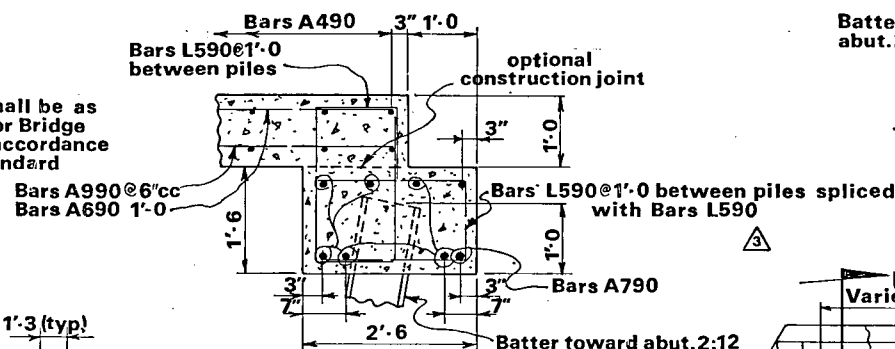


SECTION D-D

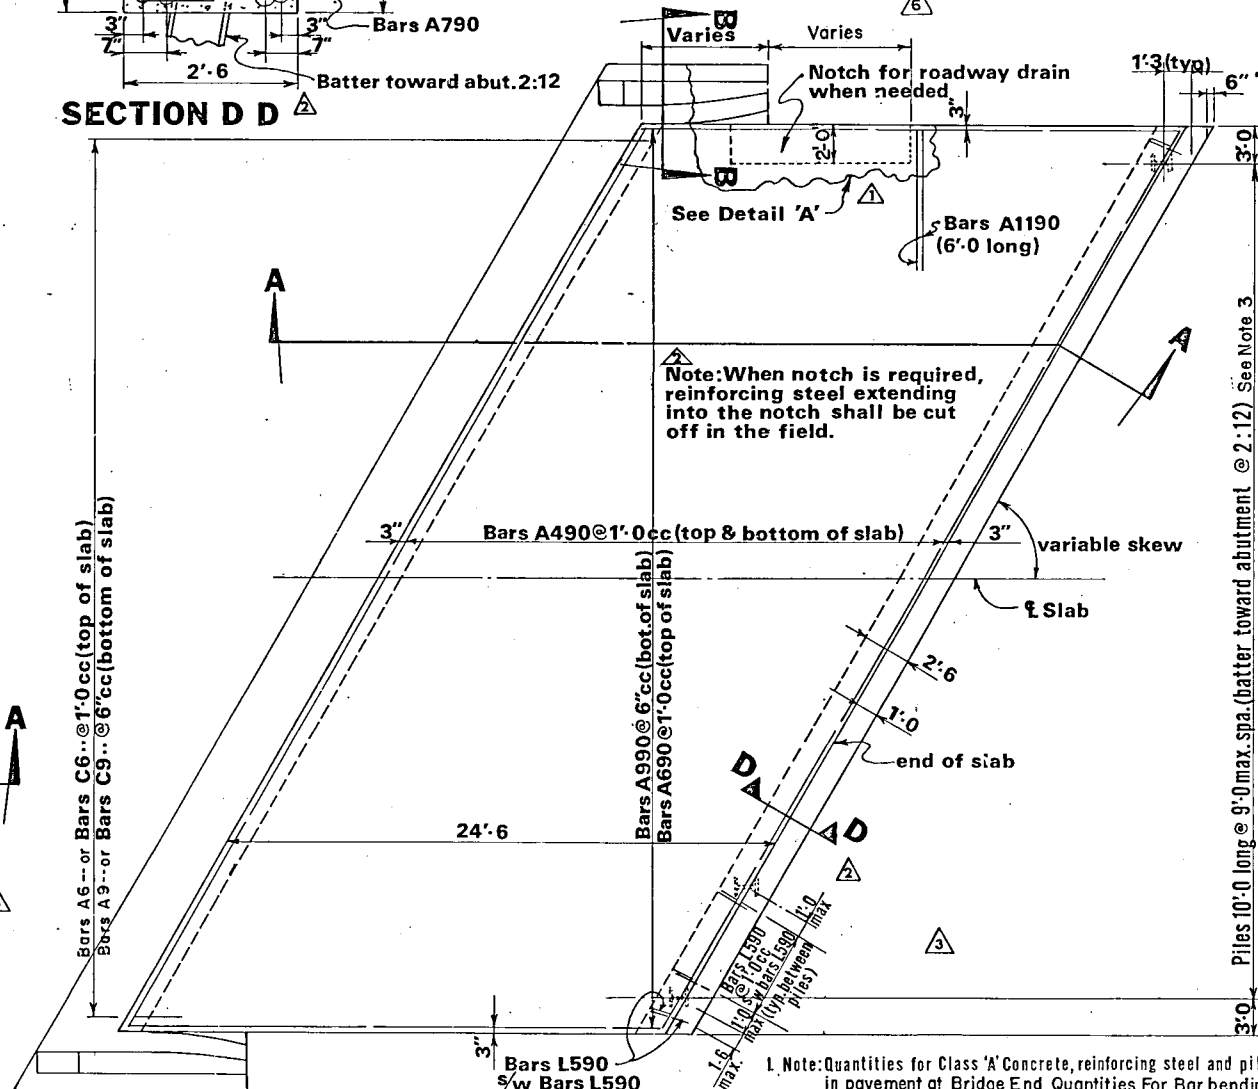

PLAN


"Clip corners 6" for 60° or less

SECTION B-B

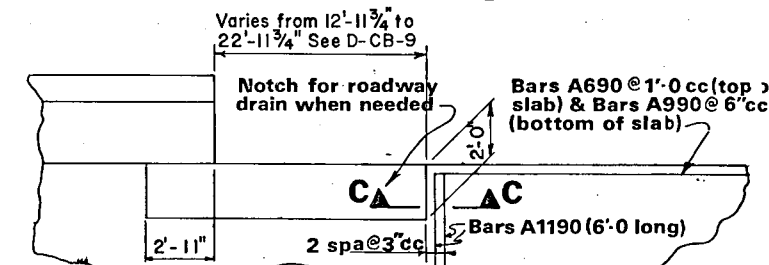

Note: See State Standard Details Drawing No. D-CB-9

DETAIL 'A'

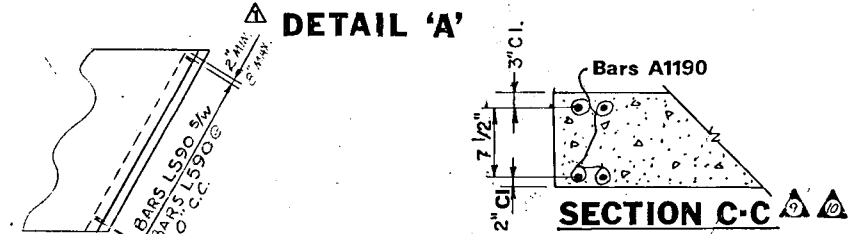

SECTION C-C

GENERAL NOTES

CONCRETE: To be Class 'A' (F'c=3,000 psi)
 REINFORCING STEEL: To be ASTM A615. Bending dimensions shown are based on Grade 40. Spacing dimensions are center to center unless otherwise noted.
 SPECIFICATIONS: Standard Road & Bridge Specifications of the Tennessee Department of Highways (Current Edition)

STATE OF TENNESSEE
 DEPARTMENT OF TRANSPORTATION
 BUREAU OF HIGHWAYS

STANDARD DRAWING REINFORCED CONCRETE PAVEMENT AT BRIDGE ENDS



- Note: Quantities for Class 'A' Concrete, reinforcing steel and piles are included in pavement at Bridge End Quantities. For Bar bending dimensions, see Bill of Steel.
- Note: Cost of mineral aggregate base quantity to be paid as Item 303-01 Mineral Aggregate Class A, Grading D.
- Note: In lieu of the Class A, Grading D material shown, Class B, Grading C or D may be used.
- Note: Piles shall be HP10 @ 42" or Precast Concrete Size 1 as shown in Estimated Quantities. Piles shall have a maximum length of 10'-0" regardless of bearing and shall be spaced at 9'-0" maximum. Piles shall be omitted if beam is supported on rock or rock fill prior to the Abutment is integral.

CORRECTED: *[Signature]*
 ENGINEER OF STRUCTURES
 APPROVED: *[Signature]*
 DIRECTOR OF HIGHWAYS

K-86-144

DESIGNED BY: C.M. Hiles
 DRAWN BY: CPM
 SUPERVISED BY: C.M. Hiles
 CHECKED BY: D.W. Fortner
 DATE: 8-70
 DATE: 10-8-70




FED. ROAD DIST. NO.	STATE	FED. AID PROJ. NO.	FISCAL YEAR	SHEET NO.	TOTAL SHEETS
3	TENN.		18		

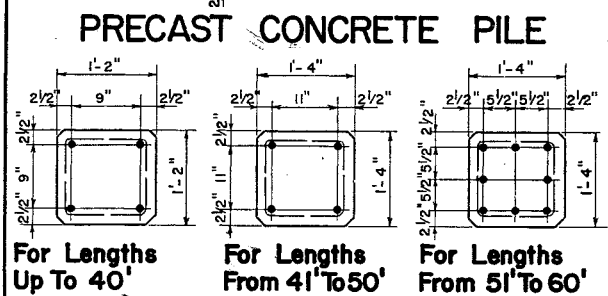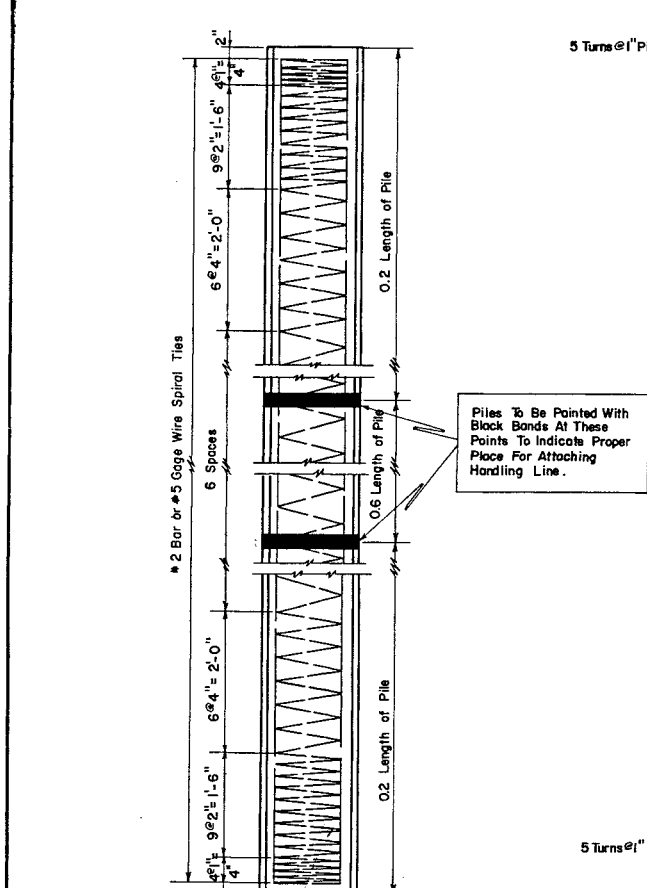


NOTE: If It Becomes Necessary To Use Size 2 Piles The Contractor Will Be Allowed An Increase In The Size 1 Bid Of 25 %.

Length Of Pile	Longitudinal Reinforcing	Weight Of Steel Per Ft.	Weight Of Pile Per Ft.
Up To 35'	4 # 7 Bars	9.6 #	205.3 #
36' To 40'	4 # 8 Bars	12.2 #	205.3 #
41' To 45'	4 # 9 Bars	15.1 #	265.3 #
46' To 50'	4 # 10 Bars	18.8 #	265.3 #
51' To 55'	8 # 9 Bars	28.9 #	265.3 #
56' To 60'	8 # 10 Bars	36.2 #	265.3 #


NOTE: In Handling The Piles, They Shall Be Supported At The Points Indicated. Piles To Be Picked Up By Pulling On Both Lines Uniformly. End Of Pile Not To Touch Ground Unless Piles Inclined 1:2 Or Steeper.

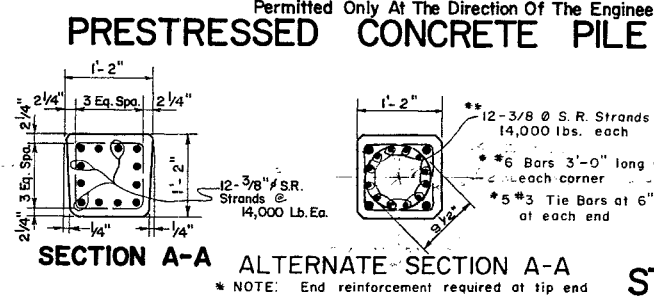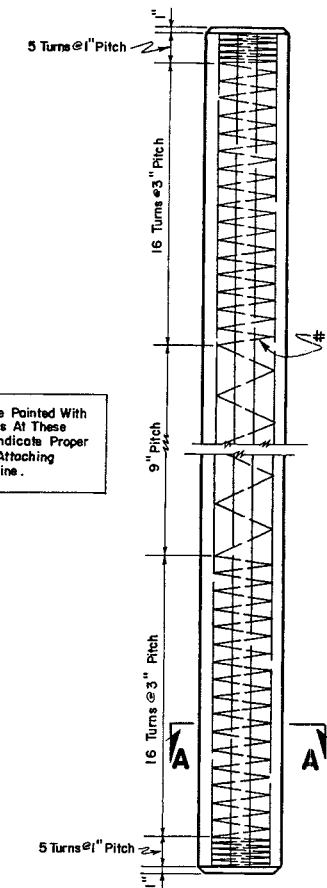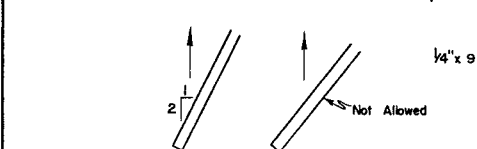


NOTE: Subject to the approval of the Engineer of Structures, alternate strand sizes and arrangements of equivalent total force may be substituted.

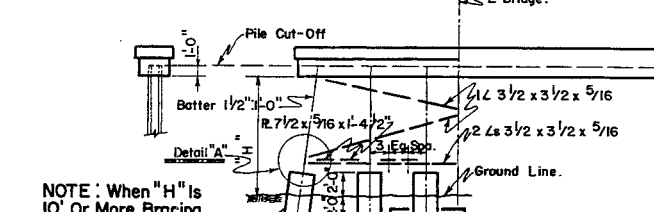

NOTE: When 'H' Is 10' Or More Bracing For Bents Is Required.

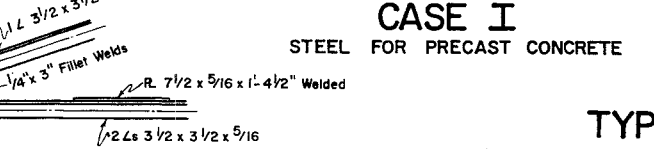

NOTE: When 'H' Is 10' Or More Bracing For Bents Is Required.

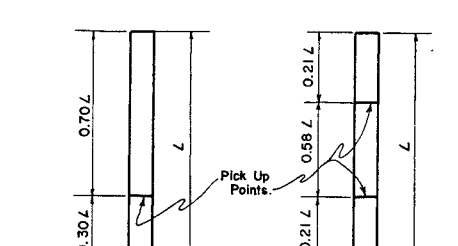


SINGLE POINT PICK-UP DOUBLE POINT PICK-UP

NOTES: (1) Maximum Length Single Pick Up Point - 60'-0" (2) Maximum Length Double Pick Up Point - 85'-0" (3) Piles To Be Marked At These Points To Indicate Proper Place For Attaching Handling Lines. (4) For Greater Lengths Three Point Pick-up is Required.




TIMBER PILE SPLICE

Length of bolts based on full 12" diam pile. Vary this length with diam. of pile.

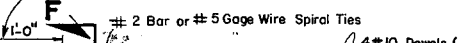


PIPE PILE

NOTE: If Additional Driving Is Necessary, Use 2" Pitch For Spiral Ties Within These Limits.

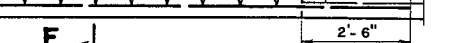

BUILD UP DETAILS

NOTE: Driving Of Built-Up Piles Shall Be Permitted Only At The Direction Of The Engineer.

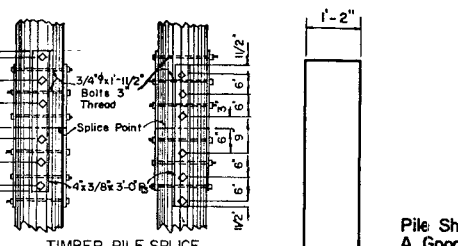

STEEL PILES

NOTE: End reinforcement required at tip end and driving end for all piles with circular strand patterns.



DETAIL OF PILE SPLICE

NOTE: Subject to the approval of the Engineer of Structures, alternate strand sizes and arrangements of equivalent total force may be substituted.




HALF BENT HALF ABUTMENT CASE I

NOTE: When 'H' Is 10' Or More Bracing For Bents Is Required.




HALF BENT HALF ABUTMENT CASE II

NOTE: When 'H' Is 10' Or More Bracing For Bents Is Required.

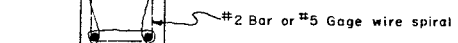

SECTION X-X

NOTE: Subject to the approval of the Engineer of Structures, alternate strand sizes and arrangements of equivalent total force may be substituted.

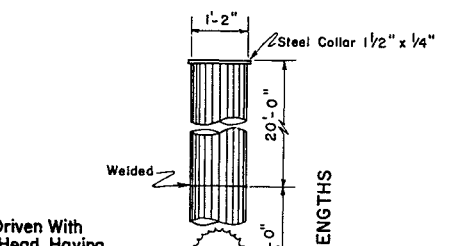

STEP TAPER PILE

NOTE: Subject to the approval of the Engineer of Structures, alternate strand sizes and arrangements of equivalent total force may be substituted.



CAST IN PLACE PILES

NOTE: Concrete In Cast In Place Piles To Be Class "A"



STEEL CAGE FOR MANDREL DRIVEN PILE

NOTE: Subject to the approval of the Engineer of Structures, alternate strand sizes and arrangements of equivalent total force may be substituted.




DETAIL OF PILE DRIVING POINT

NOTE: Cost of driving point to be included in the unit price bid for steel piles.




DETAIL OF PILE DRIVING POINT

NOTE: Cost of driving point to be included in the unit price bid for steel piles.

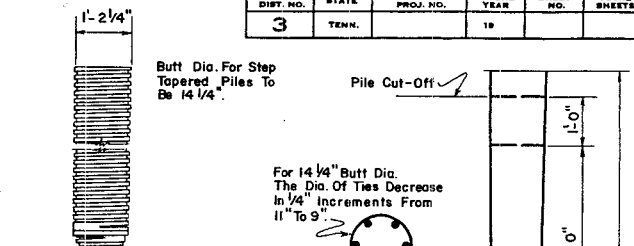

STEEL CAGE FOR MANDREL DRIVEN PILE

NOTE: Subject to the approval of the Engineer of Structures, alternate strand sizes and arrangements of equivalent total force may be substituted.

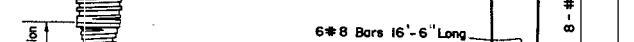

DETAIL OF PILE DRIVING POINT

NOTE: Cost of driving point to be included in the unit price bid for steel piles.



DETAIL OF PILE DRIVING POINT

NOTE: Cost of driving point to be included in the unit price bid for steel piles.

GENERAL NOTES

- SPECIFICATIONS: Standard Road And Bridge Specifications Of The Tennessee Department Of Highways.
- CHOICE OF PILES: To Be Specified On The Layout Sheet For Each Bridge.
- CAST IN PLACE: Pile Shells Shall Have A Minimum Thickness As Follows:
 - Piles Driven Without Mandrel - 7 Gage.
 - Piles Driven With Mandrel Shall Be Of Sufficient Strength And Thickness To Hold Its Original Form And Show No Sign Of Distortion After The Core Has Been Withdrawn.
 - Steel Pipe Shall Be Welded Or Seamless Steel Conforming To ASTM Designation A-252 Grade 2 Welded And Seamless Steel Pipe Piles.
- PRESTRESSED CONCRETE PILES: 1. Concrete Shall Have A Minimum 28 Day Strength Of 5000 PSI With A Release Strength Of 3500 PSI For 3/8" Strands. 2. Spiral Ties Shall Be Tied To Corner Strands At Intervals Adequate To Prevent Excessive Movement During Vibration. They May Be Manufactured From Stock Meeting Any Grade Of Reinforcing Steel Or Hard Drawn Wire.
- PILE POINTS: All Cast In Place Piles Shall Be Equipped With A Steel Driving Point. Driving Points Shall Be Mill Welded To The Pile Shell. Driving Points May Be Either Structural Steel, Forged Steel Or Cast Steel. Steel Piles Shall Have A Square Cut End Only. No Driving Point Is Required Unless Shown On The Bridge Plans.
- SPLICES: Splice Details For Cast In Place Piles Shall Be Made In Accordance With The Manufacturers Recommendations, Subject To The Approval Of The Engineer. Splice Details For Steel And Prestressed Concrete Piles Shall Be In Accordance With The Details Shown On This Sheet.
- DRIVING FORMULA: Piles Shall Be Driven To A Minimum Capacity As Specified On The Layout Sheet As Determined By The Driving Formulas Stipulated In The Specifications.
- MILL TEST REPORTS: Notarized Mill Test Reports Will Be Required For All Steel Piles And Cast In Place Pile Shells.
- WELDING SPECIFICATIONS: AWS for Bridges.
- STRUCTURAL STEEL: Structural Steel conforming to ASTM A-7 or ASTM A-36-62T will be acceptable.

Pile	2 Rb	4 Ls
10"	6 1/2"	3 1/2" x 3/2" x 1/2"
12"	7" x 1/2"	4" x 4" x 1/2"
14"	8" x 1/2"	5" x 5" x 1/2"

STATE OF TENNESSEE
DEPARTMENT OF HIGHWAYS
NASHVILLE

STANDARD PILE DETAILS

DESIGNED BY: J.W. SOUTHERLAND
DRAWN BY: J.W. SOUTHERLAND
CHECKED BY: J.W. SOUTHERLAND
DATE: 5-27-60
DATE: 2-6-62
DATE: 2-6-62

REV. - FEB. 6, 1962
REV. - MAR. 1, 1961 BATTER ON PRESTRESSED PILE
REV. - DEC. 8, 1960
REV. - OCT. 27, 1960
REV. - SEPT. 27, 1960 DELETE PILE SUBSTITUTIONS

REV. - JULY 25, 1960
REV. - DEC. 14, 1964 SPIRAL TIES
REV. - JAN. 22, 1964 COST OF WIRE FABRIC
REV. - FEB. 24, 1966 TIMBER PILE SPLICE, DETAIL OF PILE DRIVING POINT
REV. - NOV. 27, 1973 ADDED ALT. SECTION A-A




REV. - NOV. 12, 1982 DETAIL OF PILE SPLICE

DETAIL OF PILE DRIVING POINT
NOTE: Cost of driving point to be included in the unit price bid for steel piles.

APPROVED: Fred Green
BRIDGE ENGINEER
STATE HIGHWAY ENGINEER

H-5-III

SEE Std-5-1 & 5-2

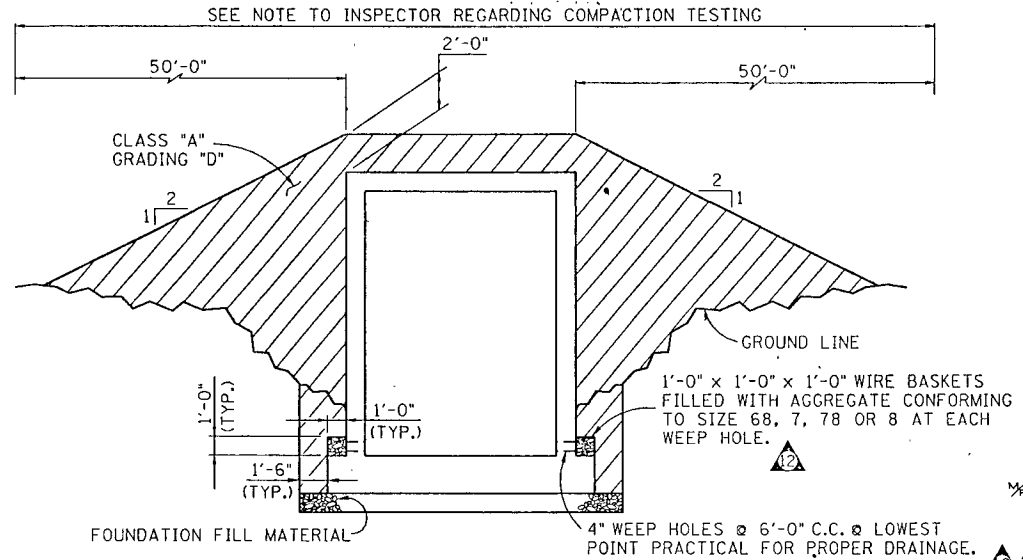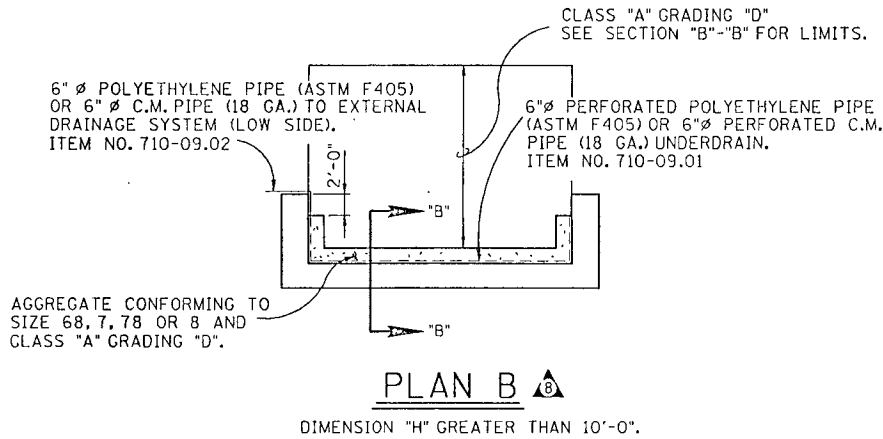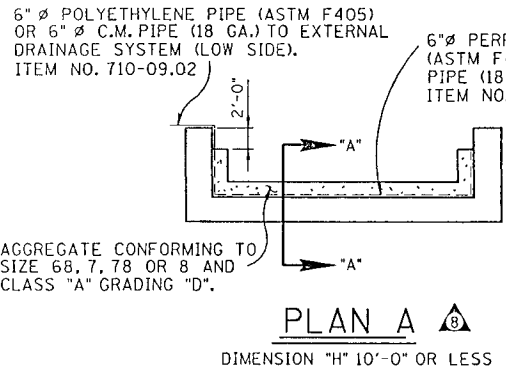

PROJECT NO.		YEAR	SHEET NO.
		1971	
REVISIONS			
NO.	DATE	BY	BRIEF DESCRIPTION
1	2-24-71	R.G.	
2	3-18-71	E.R.G.	ADDED NOTE NO.3
3	10-8-71	R.M.D.	EXCAVATION SECTION "B"-B CLARIFIED
4	10-10-72	R.M.D.	
5	11-27-72	R.M.D.	
6	9-9-72	C.L.L.	CHANGE NOTE
7	1-9-75	R.M.D.	NOTE CHANGED
8	7-17-86	R.M.D.	ADDED POLYETHYLENE PIPE
9	2-9-87	D.W.F.	GENERAL REVISIONS
10	6-25-87	R.M.D.	REV. PAY LIMIT BOX CULVERT, REMOVED INSERT & ADDED ITEM NO. FOR CLASS "A" GRADING "D"
11	1-7-91	R.M.D.	REV. ITEM NO. 710-09.02 TO 710-09.01 AND REV. ITEM NO. 303-01.01 TO 303-01.02
12	2-8-91	R.M.D.	REV. NOTE 2 TO INCLUDE RETAINING WALLS AND REV. ITEM NO. 710-09.02 TO 710-09.01
13	6-24-91	M.A.H.	ADDED SECTION SHOWING GEOCOMPOSITE DRAINAGE SYSTEM AND NOTE NO.4
14	9-1-91	M.A.H.	CHANGED DWG. NO. FROM K-85-150
15	9-18-91	M.A.H.	REMOVED WATERPROOFING
16	5-11-92	M.A.H.	DELETED ALTERNATE "B" AND NOTES

NOTES

Δ 1. BACKFILLING: UNLESS OTHERWISE SPECIFIED OR DIRECTED, THE CONTRACTOR SHALL BACKFILL BEHIND ABUTMENTS, RETAINING WALLS OF BOX TYPE BRIDGES AND CULVERTS AS SOON AS THE FOLLOWING CONDITIONS ARE MET:

A. CONCRETE SURFACES AGAINST WHICH BACKFILL WILL BE PLACED HAVE BEEN GIVEN A CLASS 1 FINISH AS SPECIFIED IN SUBSECTION 604.22.

B. REPRESENTATIVE SPECIMENS OF THE CONCRETE IN THE STRUCTURE, SECTION OR UNIT, CURED BY THE METHODS AND IN THE MANNER THAT THE CONCRETE WHICH THE TEST SPECIMENS REPRESENT IS CURED, ATTAIN A COMPRESSIVE STRENGTH OF 3,000 POUNDS PER SQUARE INCH.

C. THE CONCRETE SHALL HAVE BEEN PLACED A MINIMUM OF 7 DAYS, NOT COUNTING THE DAYS OF TWENTY-FOUR HOURS EACH IN WHICH THE TEMPERATURE FALLS BELOW FOURTY DEGREES FAHRENHEIT, OR 21 CALENDAR DAYS WHICHEVER OCCURS FIRST.

THE PLACEMENT OF BACKFILL AND EMBANKMENT SHALL BE IN ACCORDANCE WITH SUBSECTION 204.11 AND SUBSECTION 205.04, RESPECTIVELY, AND AS SPECIFIED ON THE PLANS.


Δ 2. CLASS "A" GRADING "D" MATERIAL SHALL BE PAID FOR UNDER ITEM NO. 303-01.02, GRANULAR BACKFILL (BRIDGES) OR ITEM 303-01.03 THRU 303-01.08, GRANULAR BACKFILL (RETAINING WALLS).

Δ 3. IN LIEU OF THE CLASS "A" GRADING "D" MATERIAL SHOWN, CLASS "B" GRADING "C" OR "D" MAY BE USED.

Δ 4. LOCATE PIPE AT LOWEST POINT PRACTICAL FOR PROPER DRAINAGE WITH SLOPE PARALLEL TO ABUTMENT BEAM OR RETAINING WALL ($\frac{1}{8}$ " PER FOOT MINIMUM). INSTALL PIPE AND 1'-0" OF COVER AS SOON AS POSSIBLE AFTER FORMING WALL.


$\frac{1}{8}$ MINOR REVISION - FHWA APPROVAL NOT REQUIRED

STATE OF TENNESSEE
DEPARTMENT OF TRANSPORTATION
MISCELLANEOUS ABUTMENT
AND
DRAINAGE DETAILS
1971

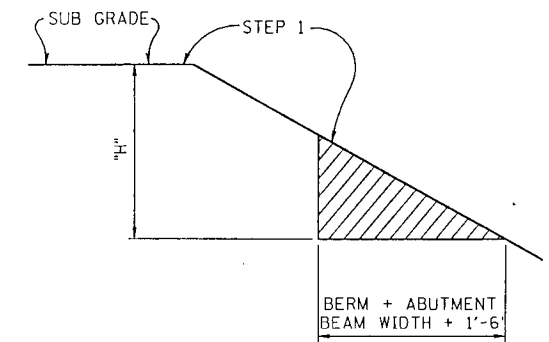

STEP 1: PLACE AND COMPACT END FILL.

STEP 2: EXCAVATE SHADED AREA AS SHOWN. SHALL BE PAID AS DRY EXCAVATION (BRIDGE) OR UNCLASSIFIED EXCAVATION (BRIDGE).

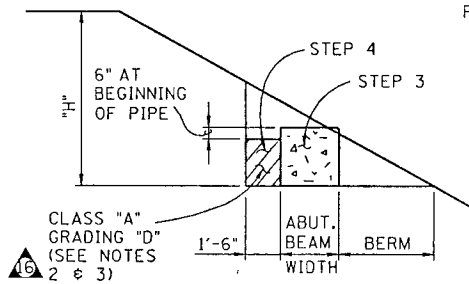


STEP 3: POUR ABUTMENT BEAM.

STEP 4: PLACE BACKFILL MATERIAL BEHIND ABUTMENT BEAM. SEE NOTE 1.


SECTION "A"-A

NOTE: THE CONSTRUCTION SEQUENCE SHOWN ABOVE IS APPLICABLE WHERE DIMENSION "H" IS LESS THAN OR EQUAL TO 10'-0".

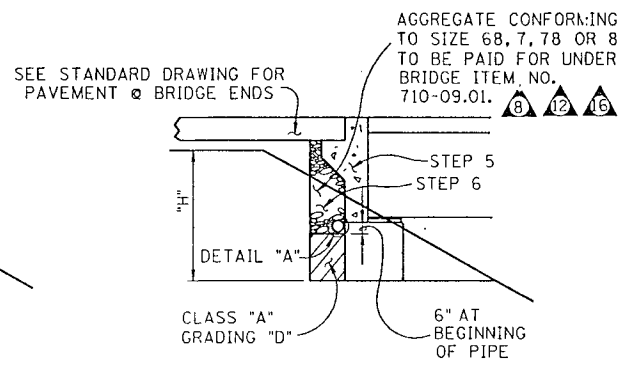


STEP 5: POUR ENDWALL.

STEP 6: PLACE BACKFILL MATERIAL BEHIND ENDWALL. SEE NOTE 1.

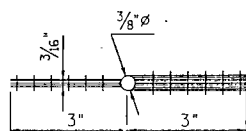


WATERSTOP DETAIL

(FOR LOCATION SEE DESIGN DRAWING)

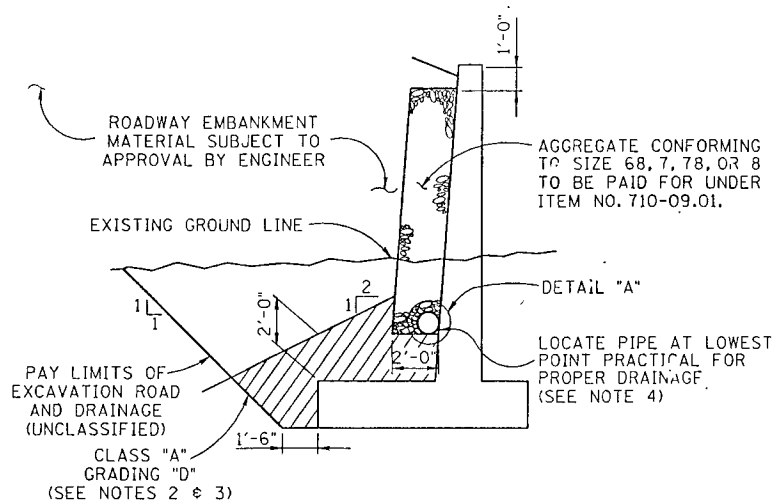



Δ 9 BOX CULVERT OR BRIDGE

NOTE: CLASS "A" GRADING "D" LIMITS ARE TYPICAL FOR BOX CULVERT OR BRIDGE AND WINGWALLS. CLASS "A" GRADING "D" MATERIALS SHALL BE PAID FOR UNDER ROADWAY ITEM NO. 303-01.01. (SEE ROADWAY PLANS.)

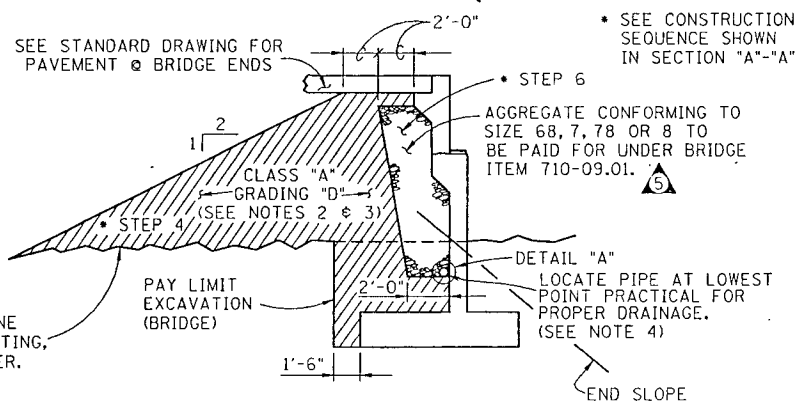

SECTION "B"-B

(TYPICAL FOR COUNTERFORT OR CANTILEVER CLOSED ABUTMENTS GREATER THAN 10' IN HEIGHT)

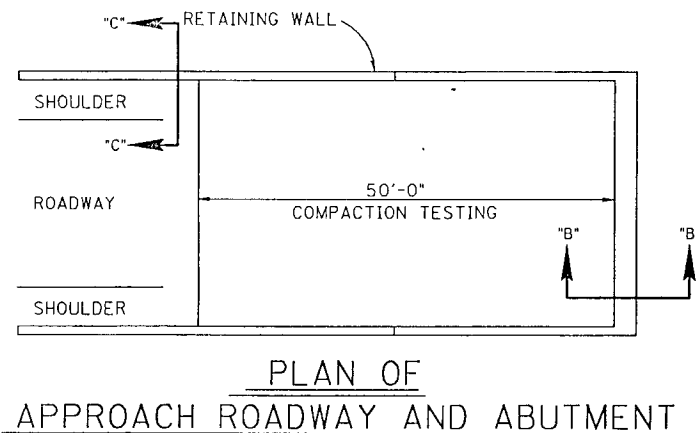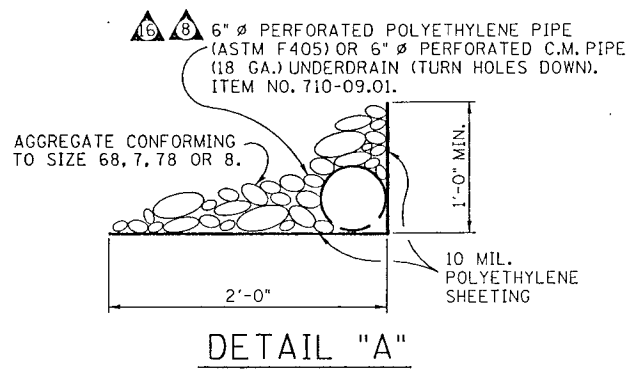

Δ NOTE TO INSPECTOR: SEE MATERIALS AND TESTS SAMPLING AND TESTING SCHEDULE FOR FREQUENCY OF COMPACTION TESTING OF EMBANKMENT AND BACKFILL MATERIAL. ALSO NOTE 1.

Δ 16 Δ 13 Δ 9 RETAINING WALL SECTION "C"-C

DESIGNED BY R. DISHNER DATE 1-91
DRAWN BY KEITH DOUGLAS DATE 1-91
SUPERVISED BY DATE 1-91
CHECKED BY R. DISHNER DATE 1-91

CORRECT Edward P. Wasserman
ENGINEER OF STRUCTURES