

FED. ROAD DIST. NO.	STATE	FED. AID PROJ. NO.	FISCAL YEAR	SHEET NO.	TOTAL SHEETS
3	TENN.	I-40-5(9) 264 CONSTR.	1960	1	372

INDEX OF SHEETS

I-40-5(9) 264 CONSTR.

SHEET NO.	TITLE
2, 2A-2C	TYPICAL CROSS SECTIONS
2D & 2E	ESTIMATED ROADWAY & BRIDGE QUANTITIES
3-5	SOIL PROFILES
14-1G	R.O.W. PROPERTY MAPS
17-25	R.O.W. PLANS
17A-25A	PROPOSED LAYOUT & PROFILE FINISHED GRADE — INCLUDES 17-B THRU 25B, 19C, 20C & 21C
26	STD. SUPERELEVATION DETAILS — DWG. N° S-E-1
27	TYPE "A" CONC. ENDWALL 2:1 SLOPE
28	STD. CONC. ENDWALLS & SPRING DRAIN — DWG. N° D-O-13
29	STD. CONC. ENDWALLS 3:1 SLOPE — DWG. N° E-2-90
30	CORRUGATED METAL & STRUCTURAL PLATE PIPE & PIPE ARCHS — DWG. N° CM-1-4
31	PIPE & PIPE ARCH CULVERTS BEVELLED ENDS & RIP-RAP — DWG. N° CM-1-5
32	STD. METAL END SECTIONS FOR CORRUGATED METAL PIPE & PIPE ARCH CULVERTS — DWG. N° CM-1-6
33	STRUTTING DETAILS — CORRUGATED METAL & STRUCTURAL PLATE ROUND PIPE — DWG. N° CM-1-7
34	STD. N° 31 CATCH BASIN — DWG. N° M-D-1
35	STD. N° 33 CATCH BASIN — DWG. N° M-D-2
36	REINF. CONC. SPILLWAYS — DWG. N° P-S-8
37	CONC. BOX CULV. — SPANS 8' & 10' — HEIGHTS 3' TO 10' — DWG. N° C-4-141
38	CONC. BOX CULV. — SPAN 8' — HEIGHTS 7' & 8' — SKEW 90° & 75° — DWG. N° E-8-57
39	CONC. BOX CULV. — SPAN 8' — HEIGHTS 7' & 8' — SKEW 60° — DWG. N° E-8-58
40 NOTE:	CONSTR. DETAILS — DWG. N° C-2-95
41	ROADSIDE DEVELOPMENT & LANDSCAPING — DWG. N° RD-L-1b
42	CONC. R.O.W. POST — DWG. N° RW-M-2a
43	BEDDING STANDARD FOR PIPE CULV. — DWG. N° C-B-2
44	LAYOUT OF BRIDGE OVER CANEY FORK RIVER — RIVER MI. 15.0 — STA. 296+15.74 E.B.L. — DWG. N° G-15-36
45	LAYOUT OF BRIDGE OVER CANEY FORK RIVER — RIVER MI. 15.0 — STA. 295+93.00 W.B.L. — DWG. N° G-15-45
46	LAYOUT OF BRIDGE OVER CANEY FORK RIVER — RIVER MI. 16.6 — STA. 331+93.00 E.B.L. — DWG. N° G-15-54
47	LAYOUT OF BRIDGE OVER CANEY FORK RIVER — RIVER MI. 16.6 — STA. 332+41.00 W.B.L. — DWG. N° G-15-65
48	LAYOUT OF BRIDGES OVER RELOC. COUNTY RD. — STA. 398+29.50 W.B.L. — STA. 401+48.00 E.B.L. — DWG. N° G-15-76
49	LAYOUT OF BRIDGE OVER CANEY FORK RIVER — RIVER MI. 18.7 — STA. 431+41.96 E.B.L. — DWG. N° G-15-82
50	LAYOUT OF BRIDGE OVER CANEY FORK RIVER — RIVER MI. 18.7 — STA. 424+17.07 W.B.L. — DWG. N° G-15-93
51	LAYOUT OF BRIDGE OVER CANEY FORK RIVER — RIVER MI. 19.7 — STA. 466+21.62 E.B.L. — DWG. N° G-15-104
52	LAYOUT OF BRIDGE OVER CANEY FORK RIVER — RIVER MI. 19.7 — STA. 464+32.38 W.B.L. — DWG. N° G-15-115
53	LAYOUT OF BRIDGES OVER CANEY FORK RIVER — RIVER MI. 20.7 — STA. 518+50.00 E.B.L. & W.B.L. — DWG. N° G-15-127
54-145	BRIDGE DETAILS — DWG. N° G-15-37 THRU 44; G-15-46 THRU 53; G-15-55 THRU 64; G-15-66 THRU 75; G-15-77 THRU 81; G-15-83 THRU 92; G-15-94 THRU 103; G-15-105 THRU 114; G-15-116 THRU 126; G-15-128 THRU 137
145-A	STEEL HAUSDRAIL FOR BRIDGES — DWG. G-10-55
146-153	CROSS SECTIONS — PIPE AND BOX CULVERTS
154-364	CROSS SECTIONS — INTERSTATE
365-372	CROSS SECTIONS — RELOCATED COUNTY ROAD & FARM ROADS

NOTE: SHEETS G-13 NOT INCLUDED IN THESE PLANS.

** SHEET NOS. 14 THRU 25 FILED IN IN-24 UNDER PROJ. NO. I-40-5(9) 259

THE CONTRACTOR WILL BE REQUIRED TO MAINTAIN TRAFFIC AT ALL TIMES DURING CONSTRUCTION ON THE COUNTY ROAD THAT CROSSES I-40 @ STA. 400+, ALL COSTS TO BE INCLUDED IN THE UNIT PRICE BID FOR REGULAR CONSTRUCTION ITEMS.

CONVENTIONAL SIGNS

COUNTY LINE	---
CITY VILLAGE OR BOROUGH	---
CULVERTS	---
POWER POLE	---
TELEPHONE OR TELEGRAPH POLE	---
FENCE LINE	---
GUARD RAIL	---
UNFENCED PROPERTY	---
RIGHT OF WAY LINE	---
TRAVELED WAY	---
RAILROAD	---
RETAINING WALL	---
BASE OR SURVEY LINE	---
DROP INLET	---
BRIDGE OVER 30 FT. SPAN	---
FULL CONTROL OF ACCESS	---

THIS PROJECT TO BE CONSTRUCTED UNDER THE STANDARD SPECIFICATIONS OF THE TENNESSEE DEPARTMENT OF HIGHWAYS AND PUBLIC WORKS DATED JULY 1, 1951 AND ADDITIONAL SPECIFICATIONS AND SPECIAL PROVISIONS CONTAINED IN THE PLANS AND IN THE PROPOSAL CONTRACT.

BEGIN I-40-5(9) 264 CONSTR.
STA. 265+70 W.B. LANE
STA. 264+15 E.B. LANE

DESIGN	DESIGNATION
ADT (1955)	2281
ADT (1975)	5201
DHV	676
D	60%
T	8%
V	70 M.P.H.

	SMITH CO.	PUTNAM CO.	TOTAL
ROADWAY LENGTH	4.356	0.081	4.437 AV. MI.
BRIDGE LENGTH	0.354	0.060	0.414 AV. MI.
PROJECT LENGTH	4.710	0.141	4.851 AV. MI.

	W.B.L.	E.B.L.
ROADWAY LENGTH	4.412 MILES	4.462 MILES
BRIDGE LENGTH	0.413 MILES	0.415 MILES
PROJECT LENGTH	4.825 MILES	4.877 MILES

STATE OF TENNESSEE

DEPARTMENT OF HIGHWAYS

PLAN AND PROFILE OF PROPOSED STATE HIGHWAY


FEDERAL AID PROJECT NO.
I-40-5(9) 264

SMITH - PUTNAM COUNTIES

FROM 3.6 MI. EAST OF GORDONSVILLE TO A POINT JUST EAST OF PUTNAM COUNTY LINE

INTERSTATE HIGHWAY NO. 40 F.A.H.S. NO.

SCALES { PLAN, 1 IN. = 100 FT.
PROFILE, HOR. 1 IN. = 100 FT., VERT. 1 IN. = 10 FT.

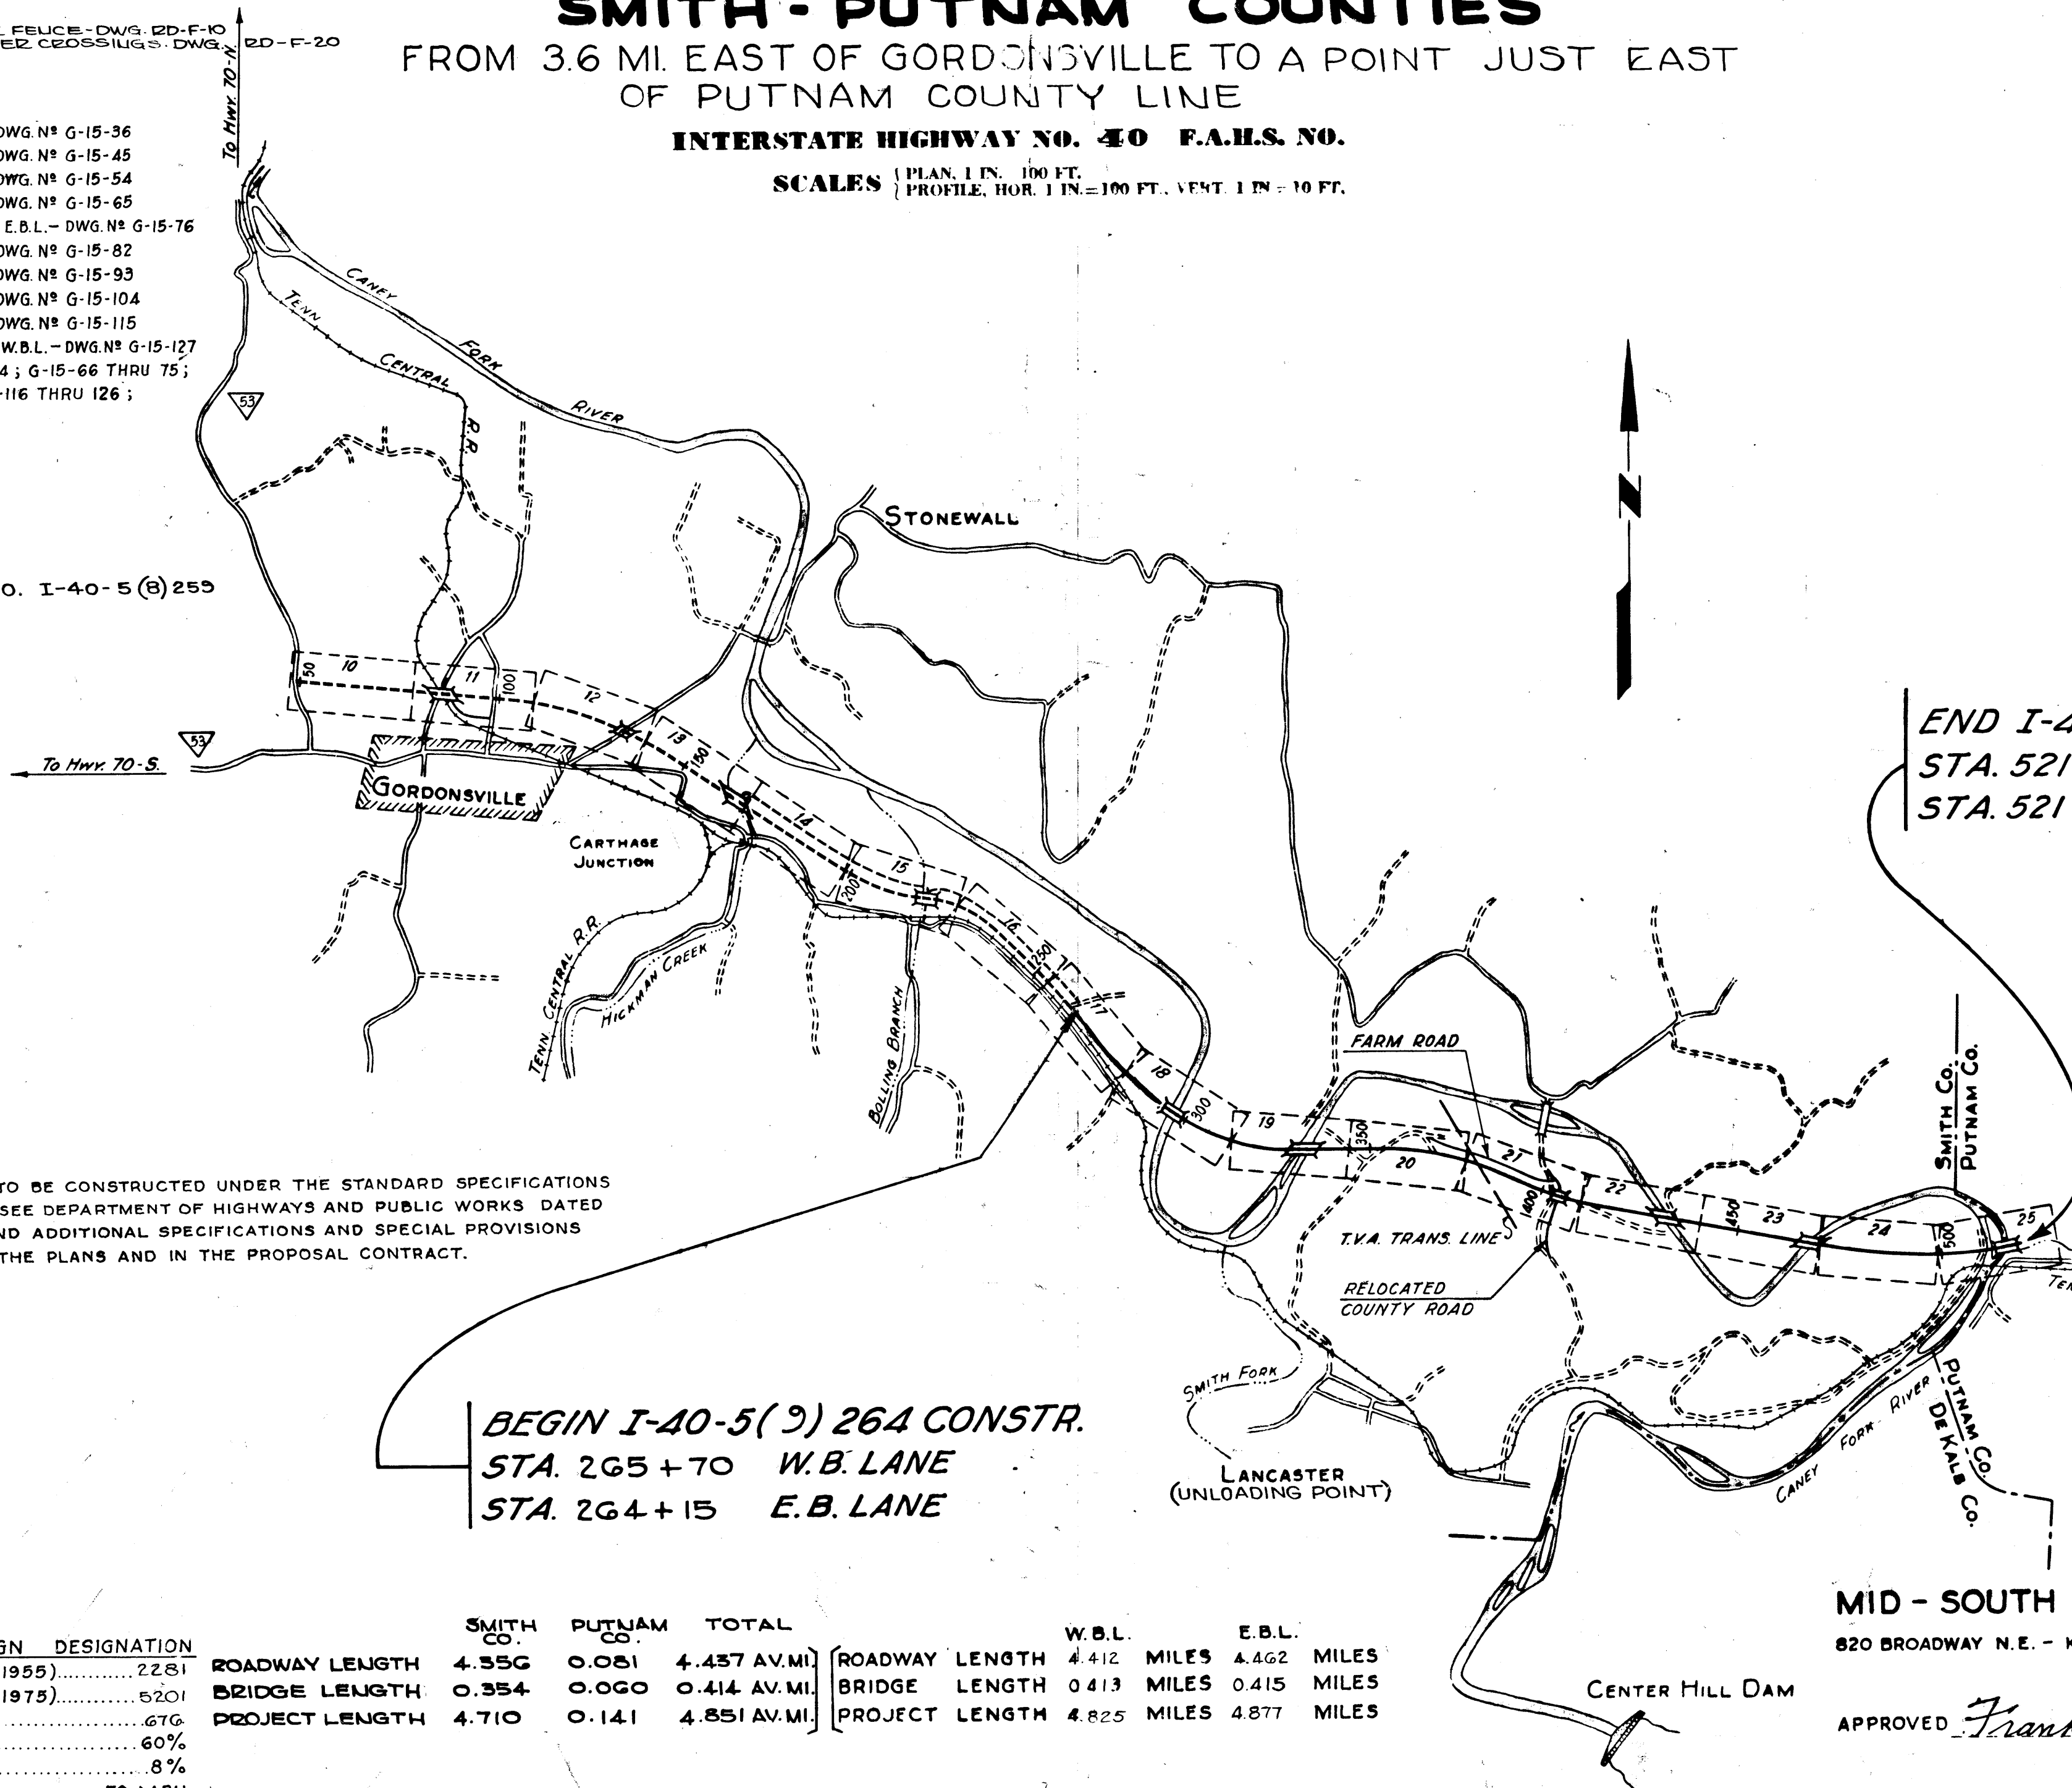

END I-40-5(9) 264 CONSTR.
STA. 521+70.00 W.B. LANE
STA. 521+70.00 E.B. LANE

TABLE OF EQUATIONS

LANE		+	-
W. BOUND	330+81.71 Bk. = 330+74.32 Ahd.	7.39	
W. BOUND	371+39.84 Bk. = 368+41.98 Ahd.	297.86	
W. BOUND	506+20.66 Bk. = 510+43.80 Ahd.		423.14
EFFECT ON NUMERATION			117.89
E. BOUND	NONE		

NO EXCEPTIONS
NO EXCLUSIONS

APPROVED *R. S. Patton*
ENGINEER OF SURVEYS AND DESIGN

DATE

APPROVED *W. E. Lee*
STATE HIGHWAY ENGINEER

DATE

APPROVED *W. E. Lee*
COMMISSIONER

DEPARTMENT OF COMMERCE
BUREAU OF PUBLIC ROADS

APPROVED


DISTRICT ENGINEER

DATE

MID - SOUTH ENGINEERING CO. INC.
620 BROADWAY N.E. - KNOXVILLE, TENNESSEE

APPROVED *Frank E. Bosland* 11-23-59
CHIEF HIGHWAY ENGINEER

PRINTED FOR DIV. OFFICE (FOR UTILITIES) 2-24-59

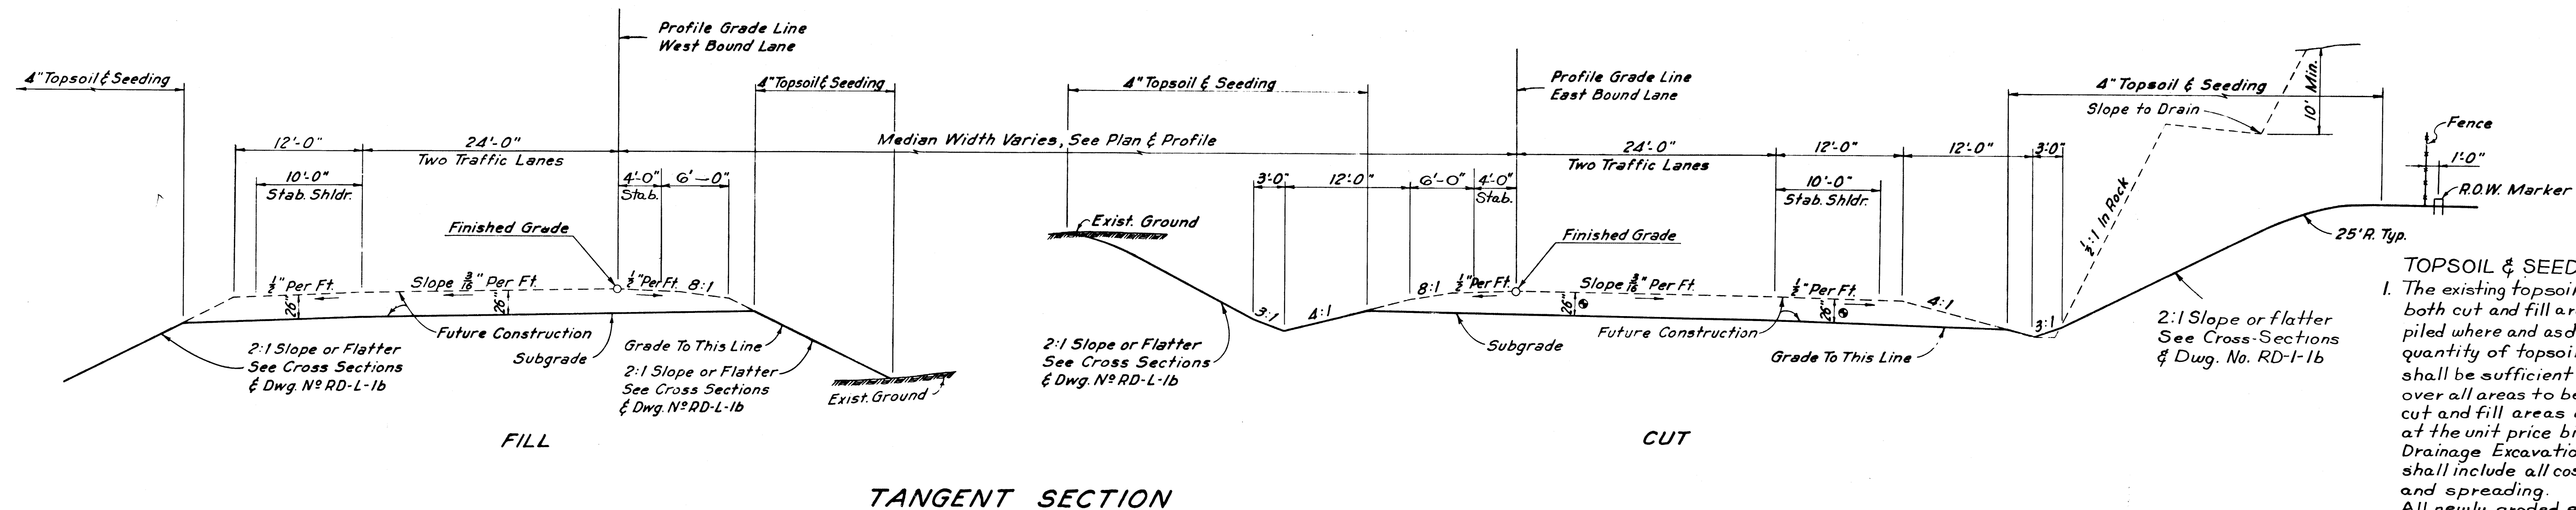

9 In rock cuts subgrade shall be $2\frac{1}{2}$ " below finished grade.

TOPSOIL & SEEDING

- The existing topsoil between slope stake points in both cut and fill areas shall be stripped and stockpiled where and as directed by the engineer. The quantity of topsoil to be stripped and stockpiled shall be sufficient to provide a minimum 4" depth over all areas to be seeded. Topsoil from both cut and fill areas will be measured and paid for at the unit price bid for item No. 13-3, Road and Drainage Excavation (Uncl), per cu. yd., which price shall include all costs of stripping, stockpiling and spreading. All newly graded earthen areas on the project that are not to be paved, stabilized or sodded shall be seeded in accordance with the Special Provision regarding Section 500. Prior to seeding, a 4" layer of topsoil shall be placed on all newly graded earthen areas except on cut slopes steeper than 2:1. Newly graded rock slopes that are flatter than 2:1 and other rock areas within interchanges shall be capped with 3" of material meeting the requirements of article 18.03 of the standard specifications plus 4" of topsoil & seeded.


2. ROCK FILL

Rock Fill shall be constructed from dense and durable rock obtained from roadway excavation or from borrow sources. The rock shall be placed and manipulated in such a manner that the larger stones will be in the exposed section of the slope, with the finer material adjacent to the earth slope. Rock Fill at ends of bridges shall be placed so as not to interfere with driving of piles. See bridge drawings for location of piles.

- Trenching of rock cuts below the limits shown on the typical section will not be required, however, rock excavation up to a maximum of 12" below subgrade, which is not due to carelessness or overshooting by the contractor, will be measured for payment in accordance with article 13.06 of the specifications. The area below subgrade within the limits of rock excavation as shown on Sheets T&TA shall be back-filled with material meeting the requirements of AASHO classification A-2 or better and have maximum size of 3".


CLEARING & GRUBBING

- Clearing and grubbing, item 11-1, shall comply with standard specifications of the Tennessee Dept. of Highways, except that in sections where the grading limits are separated by the wide median, payment for clearing and grubbing shall extend to a maximum of 10' outside the grading limits in the median. See sketch.

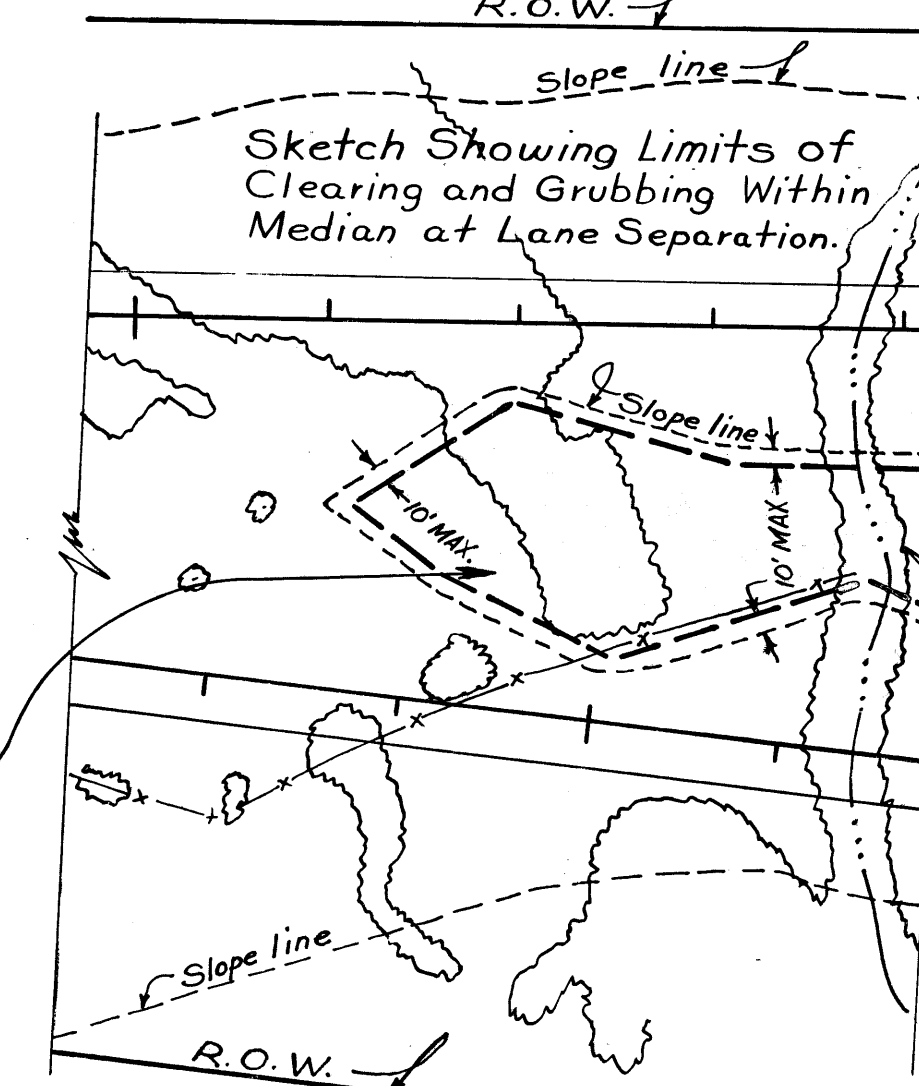

All areas within the R.O.W. to be cleared and grubbed in accordance with Standard Specifications, except no clearing and grubbing required in shaded area.

* Slope S = Superelevation Rate (e) where e is greater than normal shoulder slope.

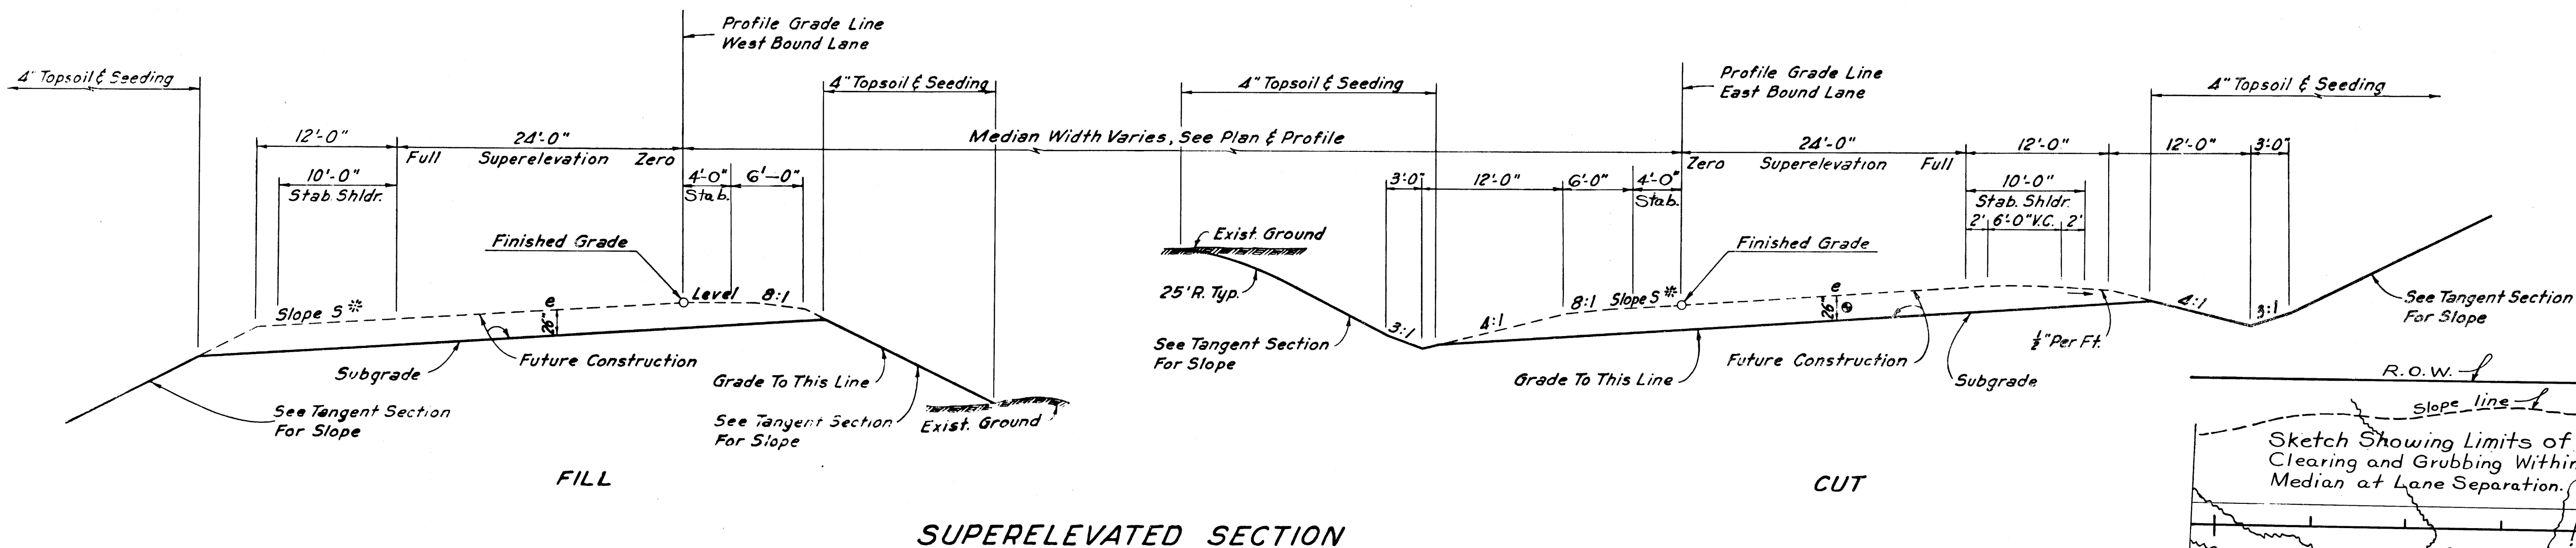


MID-SOUTH ENGINEERING CO., INC.
820 BROADWAY, N.E. KNOXVILLE, TENNESSEE

TYPICAL SECTIONS INTERSTATE VARIABLE MEDIAN

STATE OF TENNESSEE
DEPARTMENT OF HIGHWAYS
AND PUBLIC WORKS
NASHVILLE

DR. J.L.M.
CHK'D. M.L.S.
APP'D.


DATE
3-5-59
11-13-59

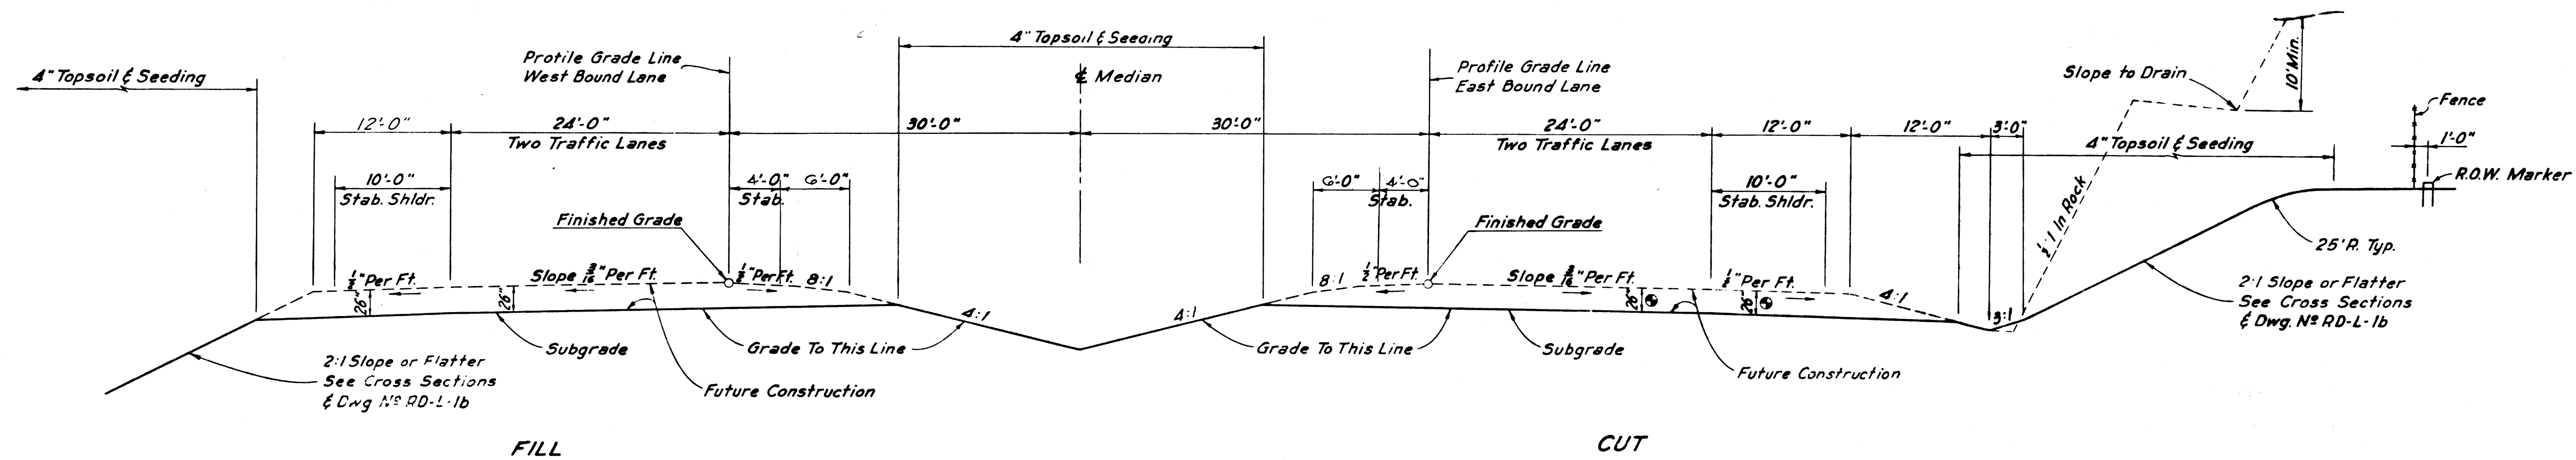

TANGENT SECTION

* In rock cuts subgrade shall be 2 1/2' below finished grade.


FOR NOTES SEE SHEET No. 2

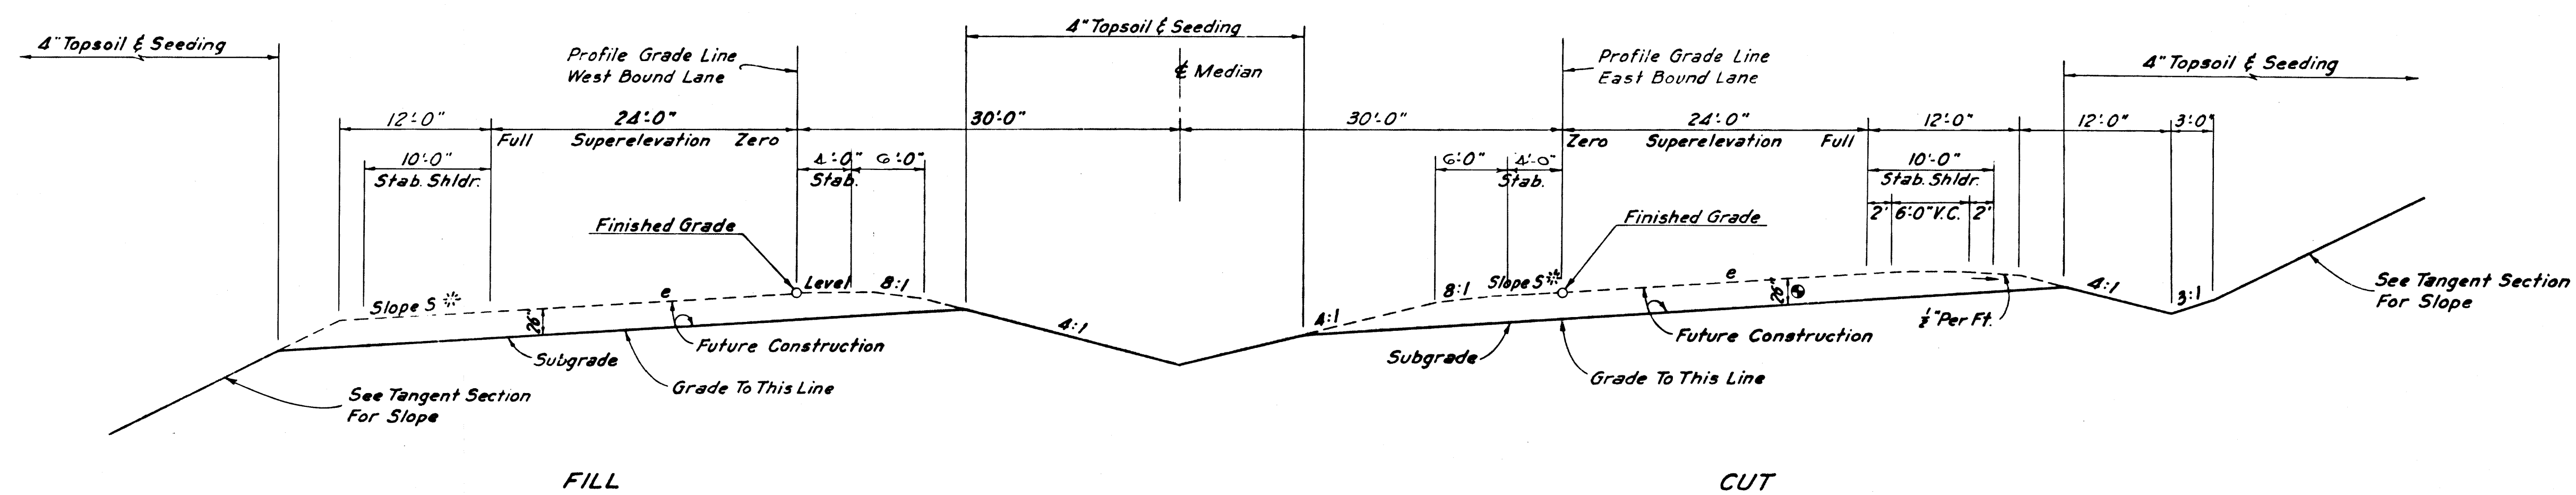

SUPERELEVATED SECTION

* Slope S = Superelevation Rate (e) where e is greater than normal shoulder slope.


MID-SOUTH ENGINEERING CO., INC. 820 BROADWAY N.E. KNOXVILLE, TENNESSEE	
TYPICAL SECTIONS INTERSTATE 60 FT. MEDIAN	
STATE OF TENNESSEE DEPARTMENT OF HIGHWAYS AND PUBLIC WORKS NASHVILLE	
DR. J.L.M.	DATE 3-6-59
CHK'D. M.L.S.	11-13-59
APP'D.	

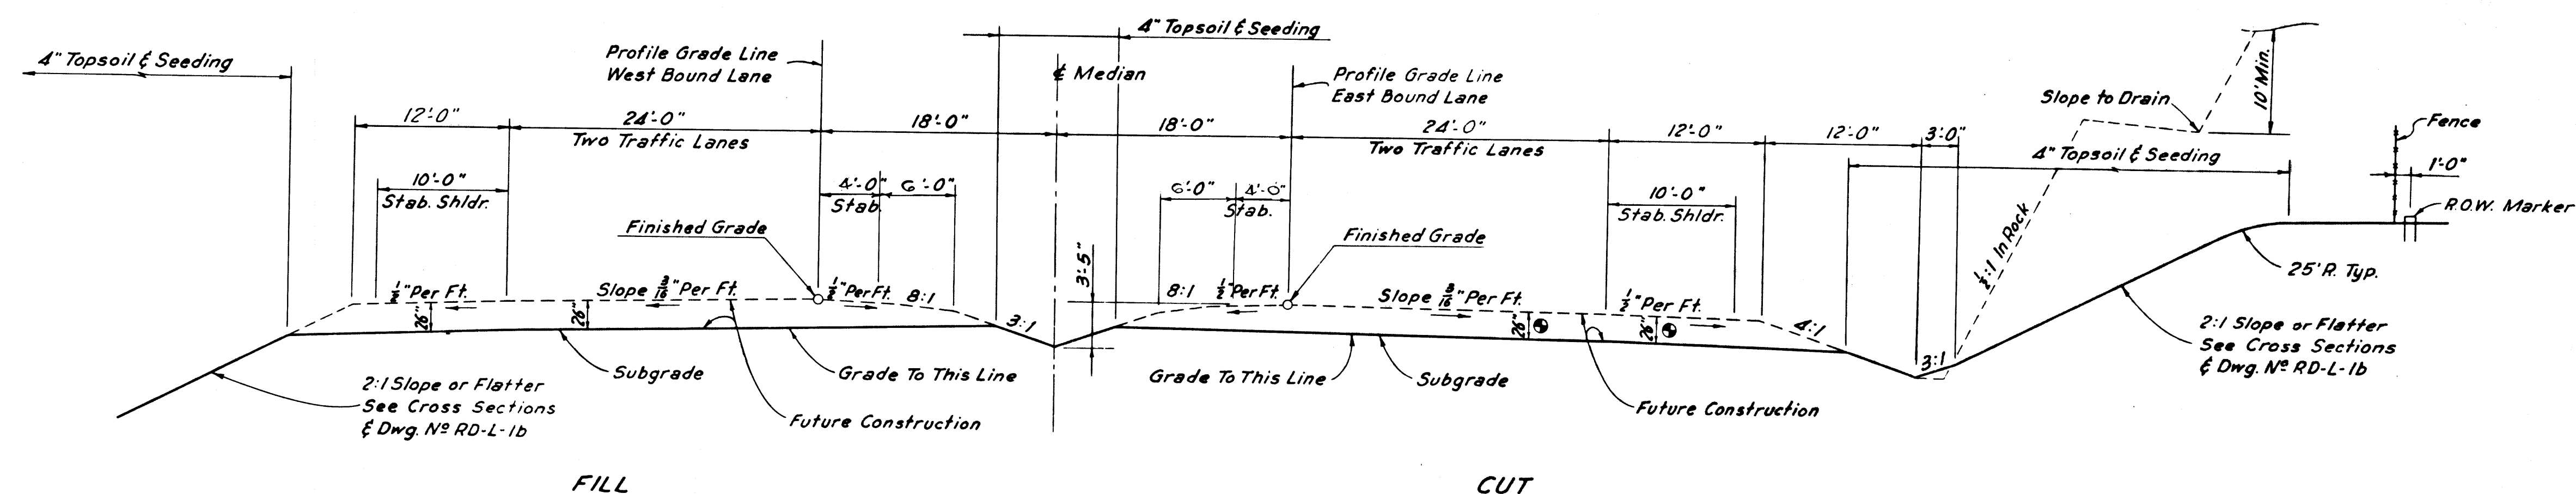

TANGENT SECTION


* In rock cuts subgrade shall be 2 1/2" below finished grade.

FOR NOTES SEE SHEET No 2

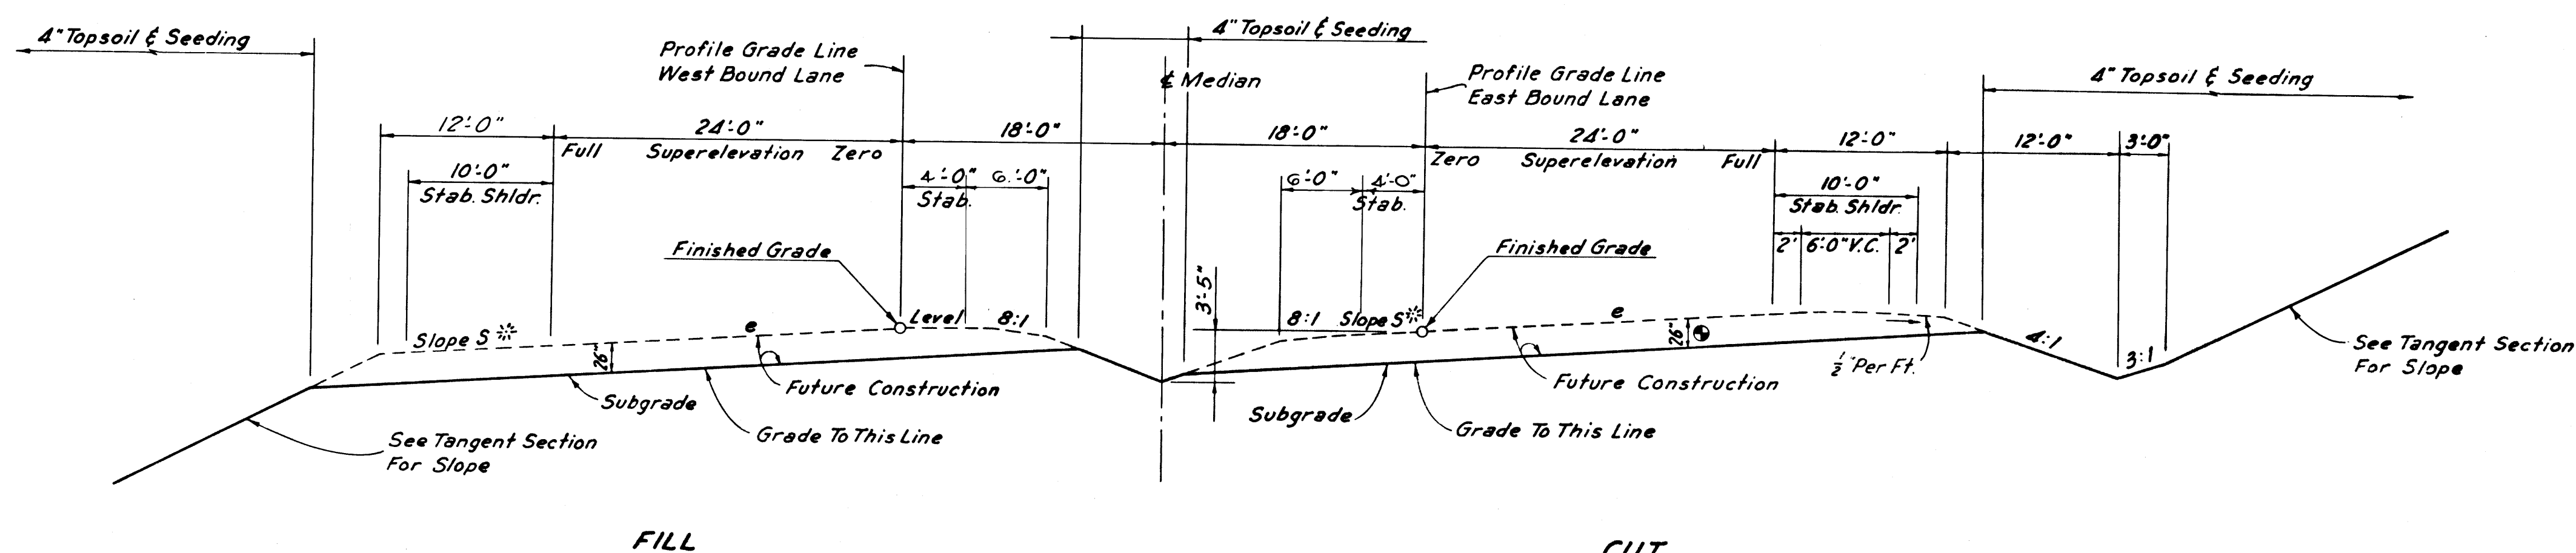


SUPERELEVATED SECTION


* Slope 5 = Superelevation Rate (e) where e is greater than normal shoulder slope.

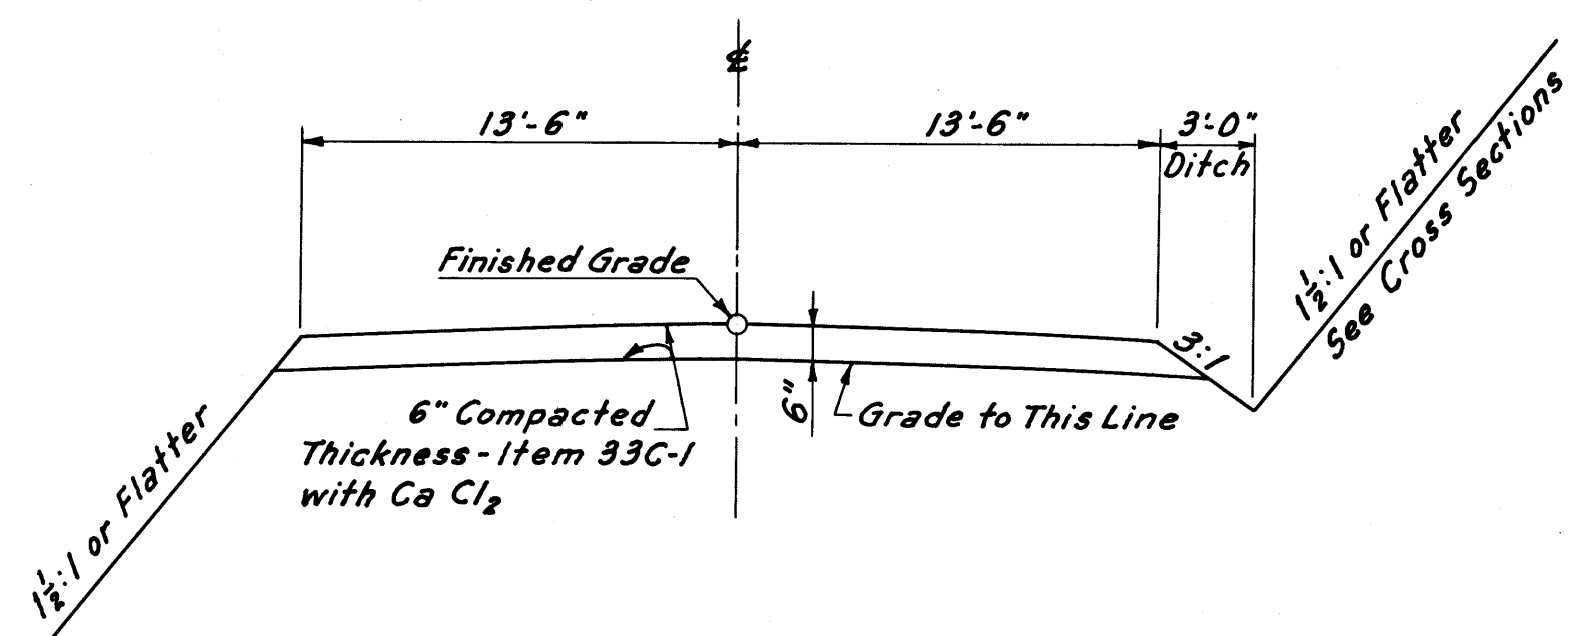


COUNTY RD. RELOC. @ STA. 401+85 (E.B.L.)

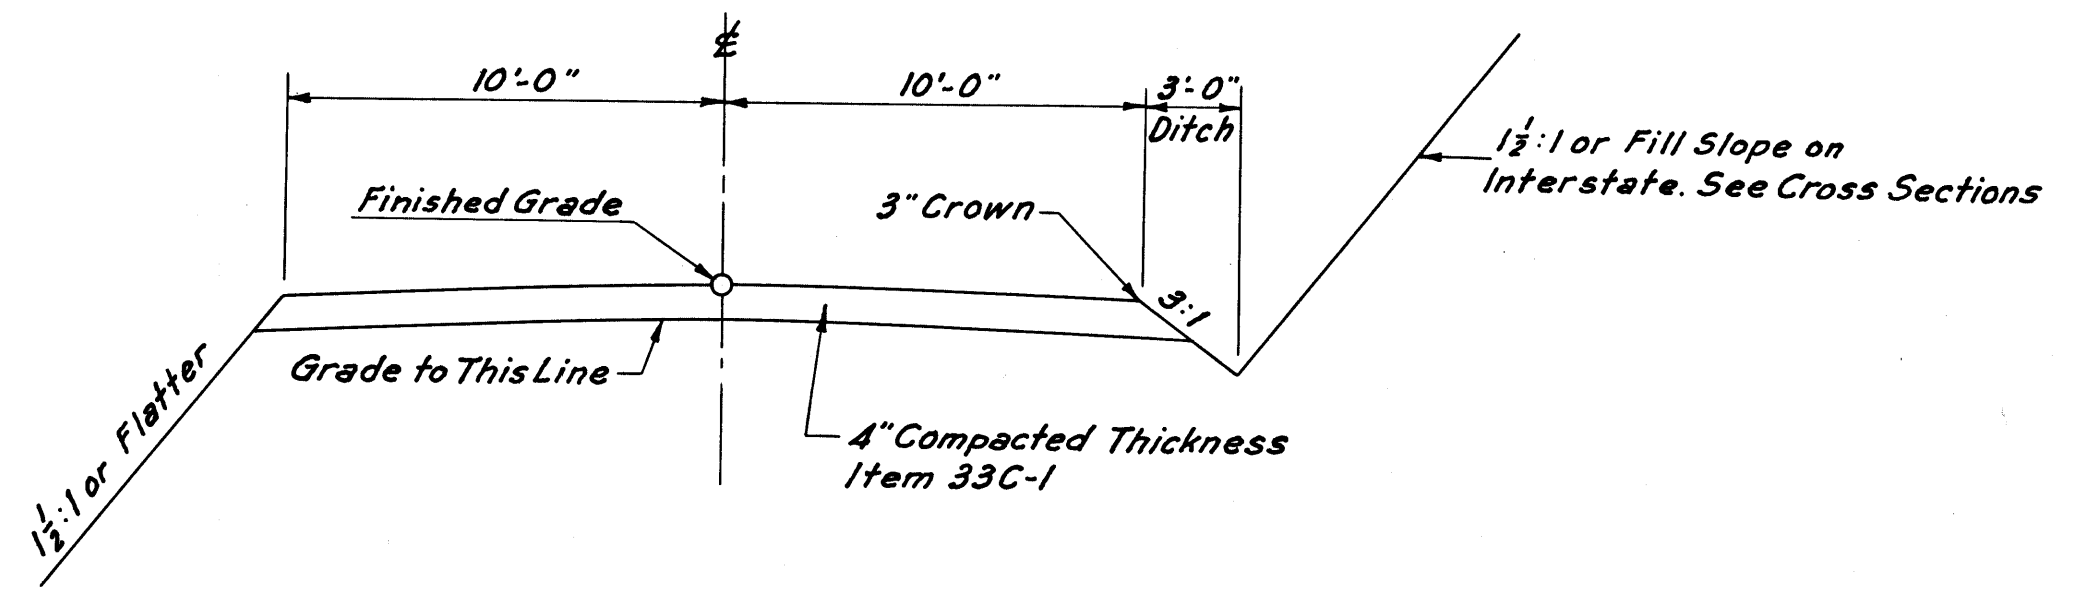


FARM ROADS

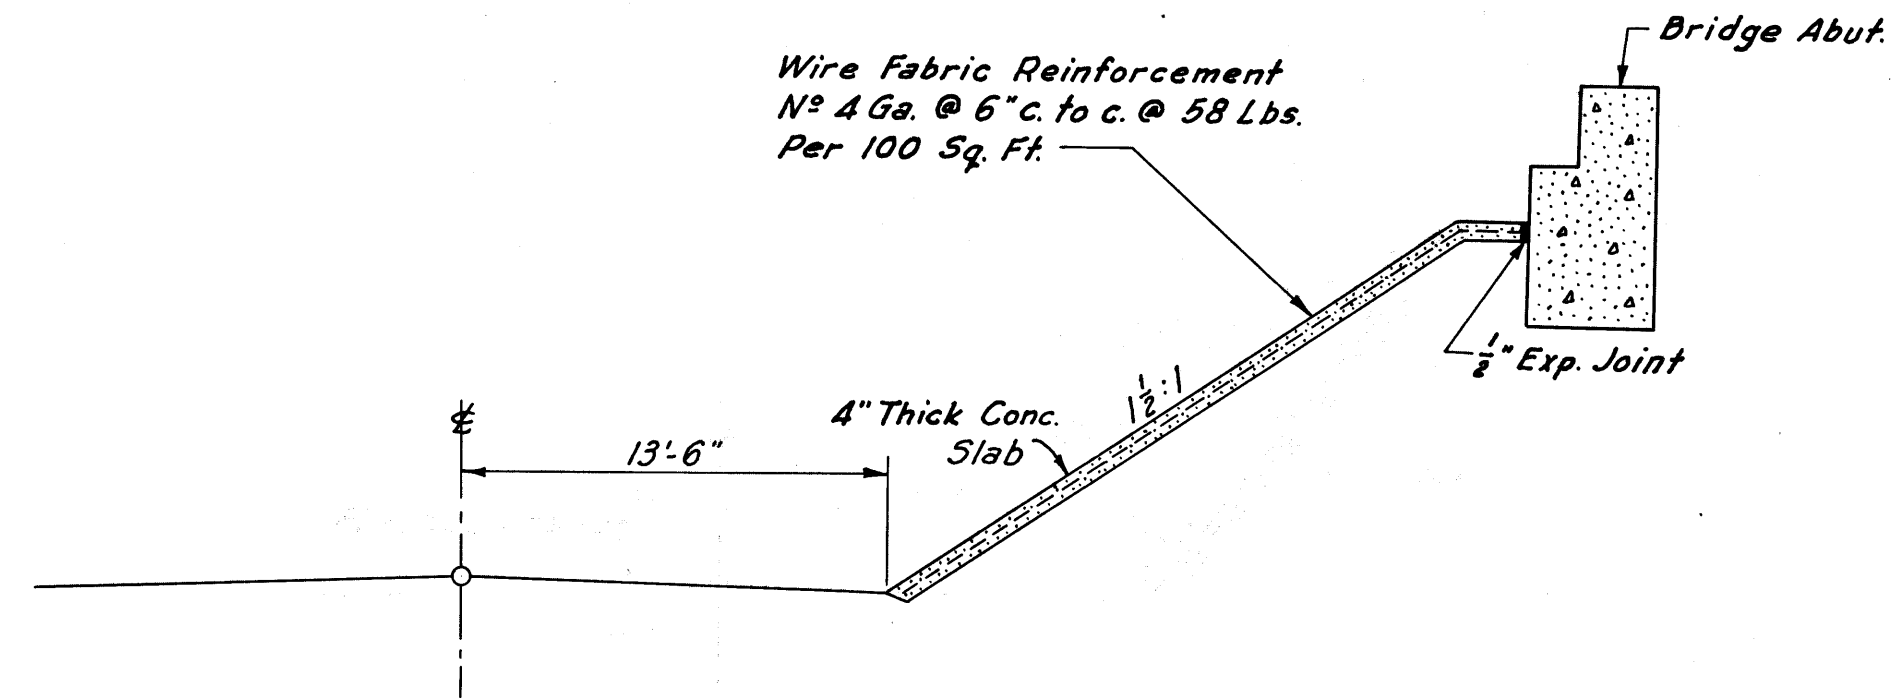

PAVED SLOPES UNDER BRIDGES @ COUNTY RD. RELOCATION

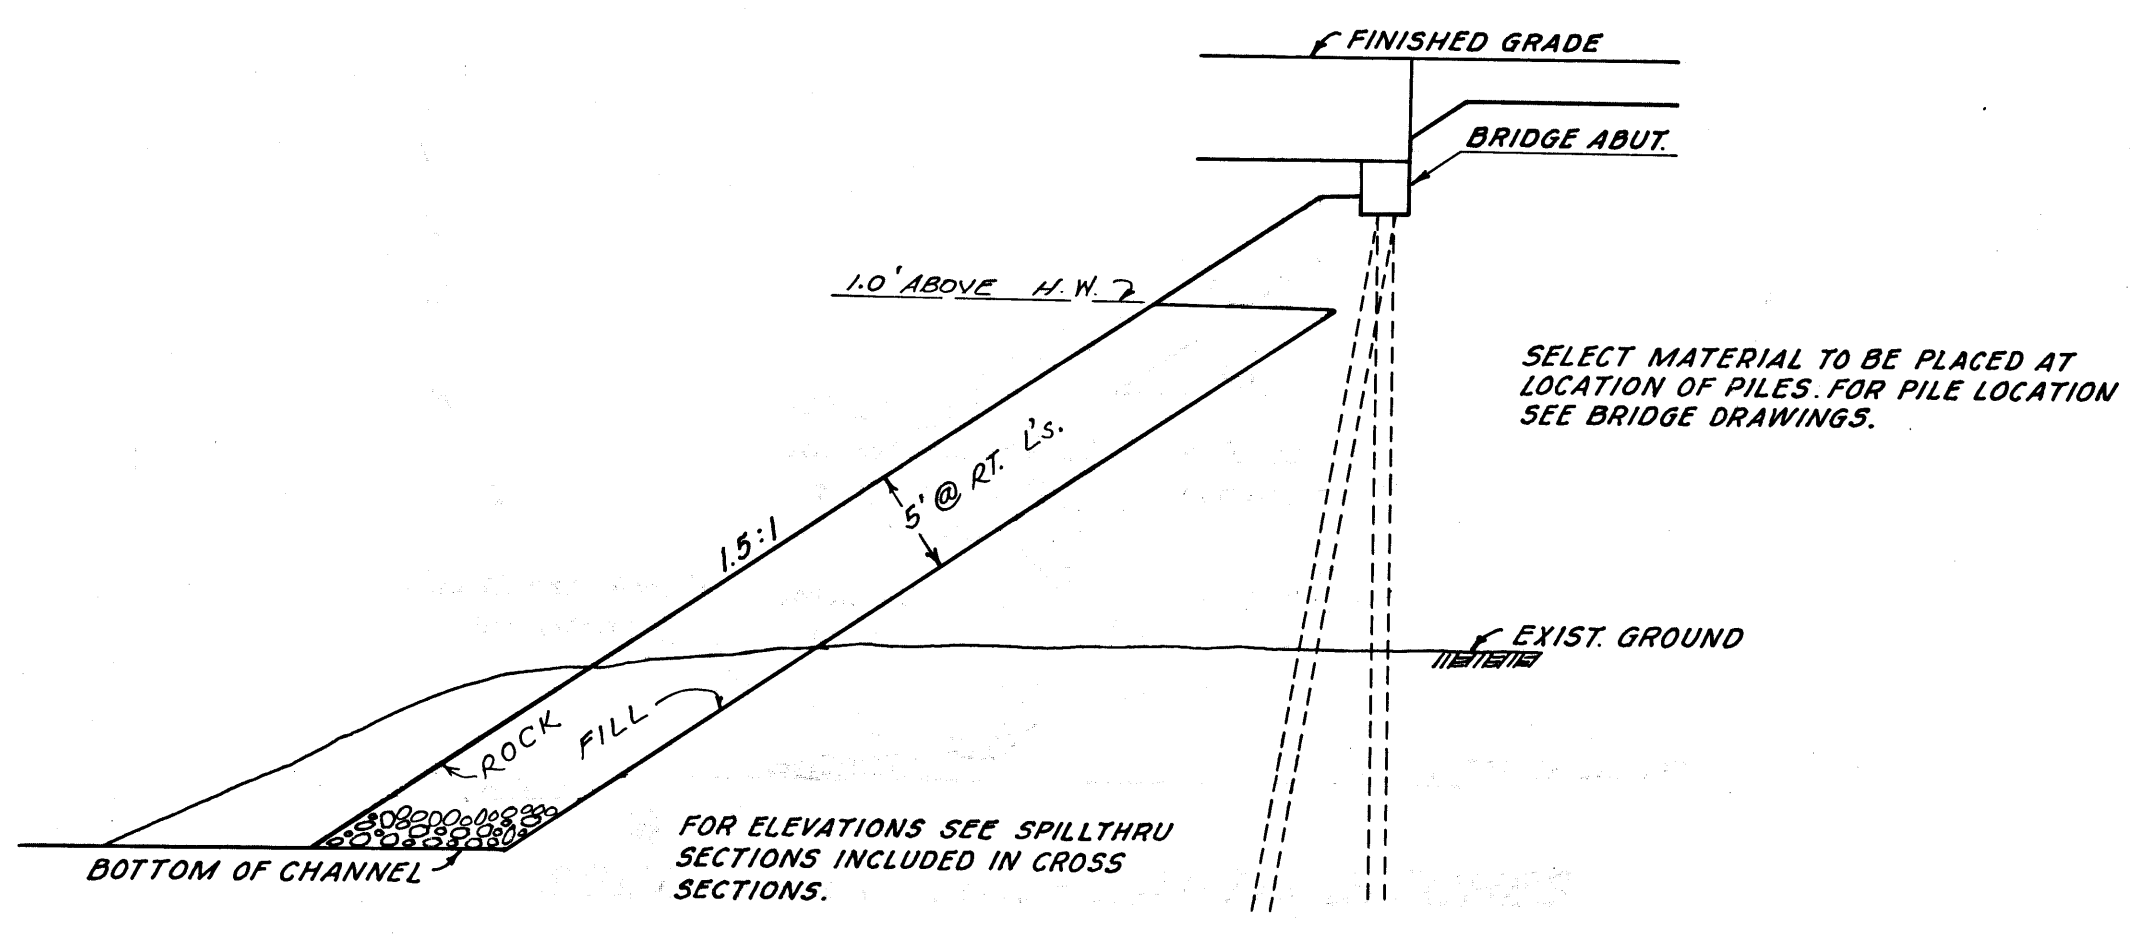

SPILLTHRU SECTION

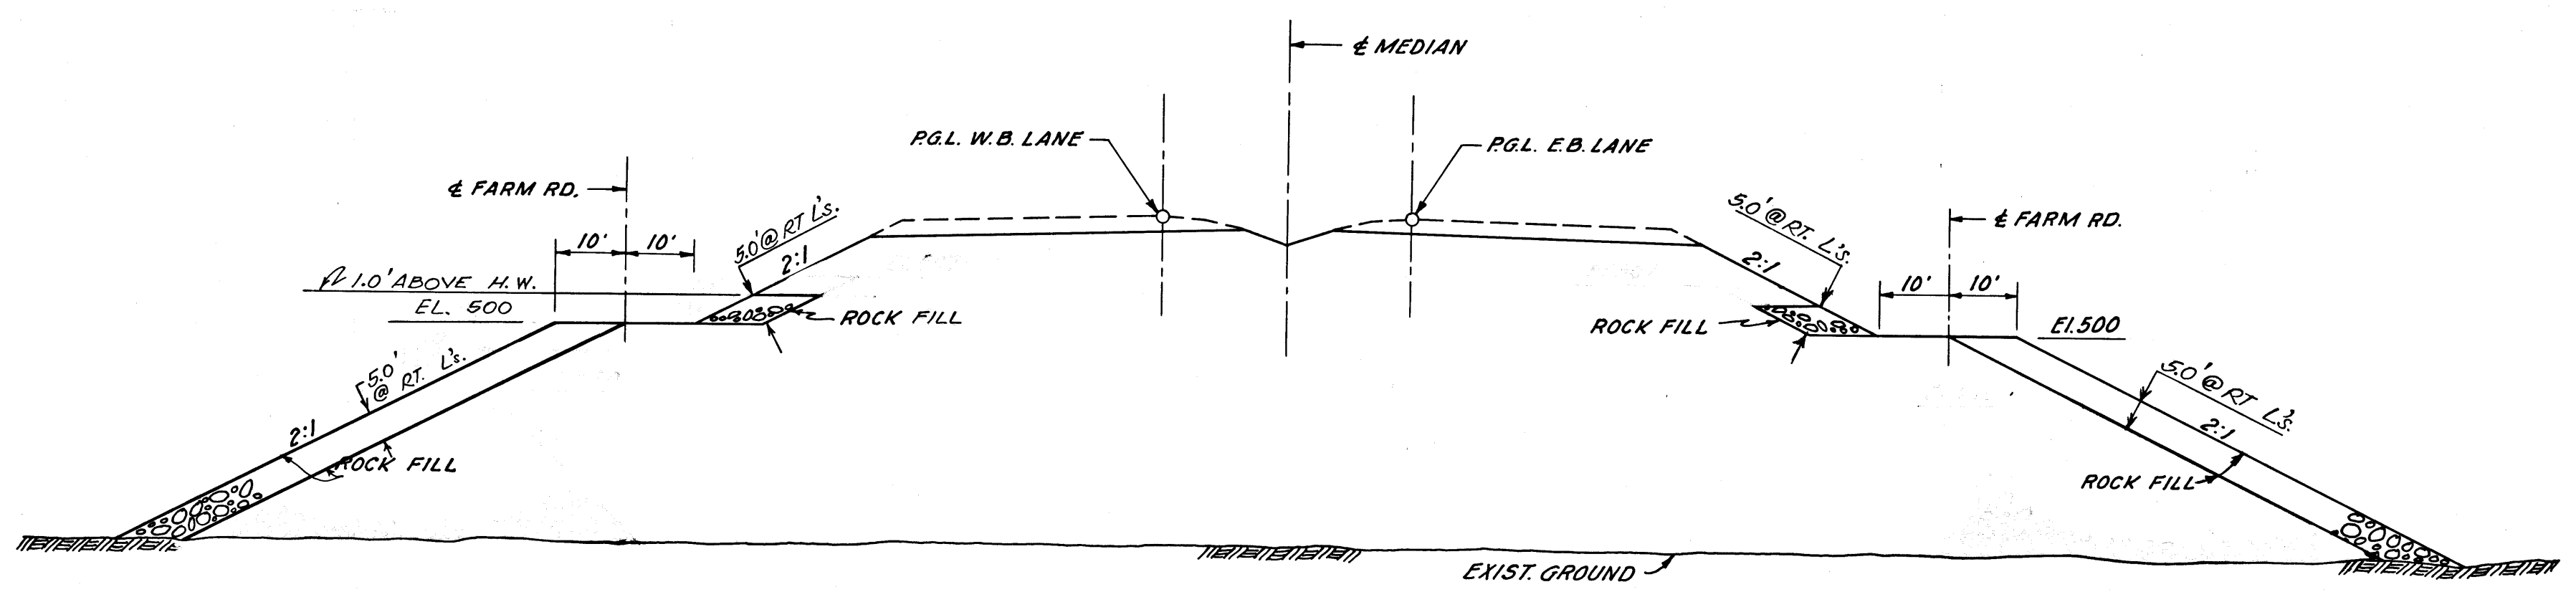

SECTION THRU FILL @ 514+50± TO 518+50±

PAVED SLOPES

Pave slopes under bridges with 4" thick concrete slab, reinforced with wire fabric reinforcement at 58 lbs. per 100 sq. ft. The slab shall extend the width of the structure plus 4 1/2 feet on each side and run parallel to the structure.

Wire fabric shall have No. 4 wires transverse @ 6" c. to c. and No. 4 wires longitudinal @ 6" c. to c. A 12" lap will be required on all sheets of wire fabric. The wire fabric shall extend to within 3" of the edge of slab. Wire fabric reinforcement shall be placed at one-half depth of slab.

1/2" preformed expansion joints without load transfers shall be formed about all structures and features projecting through, into, or against the slab.

The slab shall be grooved parallel to and at right angles to the skew of the bridge @ 6'-0" c. to c. Depth of groove to be not less than 1".

All cost of slope paving, including wire fabric reinforcement, to be included in unit price bid for class "A" concrete.


CLASS "A" CONCRETE REQUIRED: 74 CU. YDS.

NOTES:

Superelevation on Relocated County Road shall be rotated about the center line.

For other notes see Sheet No. 2

MID-SOUTH ENGINEERING CO., INC. 820 BROADWAY, N.E. KNOXVILLE, TENNESSEE		
TYPICAL SECTIONS SHEET No. 4		
STATE OF TENNESSEE DEPARTMENT OF HIGHWAYS AND PUBLIC WORKS NASHVILLE		
DR. J.L.M. CHK'D. APP'D.	DATE 9-11-59	

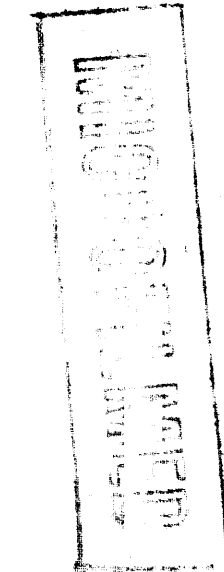

GENERAL NOTES

- 1- GRADE ON PROFILE SAME AS GRADE ON CROSS-SECTIONS AND SAME AS FINISHED GRADE ON TYPICAL CROSS SECTIONS.
- 2- THE COST OF CULVERT EXCAVATION FOR CONCRETE BOX CULVERTS SHALL BE INCLUDED IN THE UNIT PRICE BID PER CU.YD. OF CLASS "A" CONCRETE. THE COST OF CULVERT EXCAVATION FOR PIPE CULVERTS, INLETS AND ENDWALLS SHALL BE INCLUDED IN THE UNIT PRICE BID PER LINEAR FOOT OF PIPE. WHEN A CULVERT IS MOVED TO A NEW LOCATION OTHER THAN THAT SHOWN ON THE PLANS, THEREBY INCREASING OR DECREASING THE AMOUNT OF CULVERT EXCAVATION, NO INCREASE OR DECREASE IN AMOUNT OF PAYMENT WILL BE MADE DUE TO THE CHANGE.
- 3- ALL NECESSARY CONSTRUCTION JOINTS IN CONCRETE BOX CULVERTS AND BRIDGES SHALL BE THE BUTT TYPE. LOCATION OF JOINTS TO BE AS SHOWN ON THE PLANS OR DETERMINED BY THE ENGINEER.
- 4- SLOPES ALONG INTERSTATE ARE TO BE 2:1 OR FLATTER, EXCEPT IN ROCK CUTS.
- 5- ALL CONCRETE BOX CULVERTS ARE DESIGNED FOR H20-316-44 AND ALTERNATE MILITARY LOADING.

PROPOSED CONSTR. UNDER I-40-5(9)264

- 1- GRADING TO LINES INDICATED ON TYPICAL CROSS-SECTIONS OR AS DIRECTED BY THE ENGINEER.
- 2- COMPLETE DRAINAGE SYSTEM AS INDICATED ON PLAN AND PROFILE SHEETS.
- 3- TOPSOIL AND SEEDING OF ALL EARTH SLOPES AS NOTED ON THE TYPICAL CROSS-SECTION
- 4- STOCK FENCE.
- 5- TWELVE BRIDGES AS SPECIFIED IN THE PLANS(SIX TWIN)
- 6- TRAFFIC BOUND CRUSHED STONE SURFACE ON RELOCATED COUNTY ROAD AND FARM ROADS.

FUTURE CONSTR.-NOT UNDER I-40-5(9)264

- 1- ALL BASE AND PAVEMENT ON INTERSTATE.
- 2- GUARD RAIL.

GENERAL NOTES, CONT'D.

- 6- UNDER ITEMS 15-1 & 15-3, THE CONTRACTOR WILL BE REQUIRED TO FURNISH SUITABLE BORROW MATERIAL FROM A SITE APPROVED BY THE ENGINEER. THE BORROW SHALL BE TAKEN IN SUCH MANNER AS TO BE READILY MEASURED. BORROW MATERIAL IS TO BE USED ONLY AFTER ITEM 13-3, ROAD AND DRAINAGE EXCAVATION, IS EXHAUSTED.
7. CERTAIN PORTIONS OF THE R.O.W. AS DESIGNATED BY THE ENGINEER SHALL BE FENCED PRIOR TO THE REMOVAL OF EXISTING FENCES, AND PRIOR TO THE BEGINNING OF CONSTRUCTION OPERATIONS.
8. LOCATION OF STOCK FENCE, ITEM 173-7, SHALL BE ONE FOOT INSIDE OF, AND FOLLOWING THE ACCESS RTE. LINE EXCEPT WHERE OTHERWISE SHOWN ON PLANS. FENCE SHALL BE TURNED IN AT DRAINAGE AND SEPARATION STRUCTURES SO THAT THEY ABUT THE WINGWALLS OR ABUTMENTS AS SHOWN ON PLANS OR AS DIRECTED.

9. FENCE SHALL BE INSTALLED IN THE MEDIAN BETWEEN THE NORTH AND SOUTH BOUND LANES WHERE THE MEDIAN WIDTH IS SUCH THAT IT SEPARATES THE STRUCTURES, AS SHOWN ON PLANS OR AS DIRECTED BY THE ENGINEER.

MID-SOUTH ENGINEERING CO., INC.
820 BROADWAY, N.E. KNOXVILLE, TENNESSEE

ESTIMATED
RDWY. & BRIDGE
QUANTITIES

STATE OF TENNESSEE
DEPARTMENT OF HIGHWAYS
AND PUBLIC WORKS
NASHVILLE

DR. J.L.M.
CHKD. DATE 10-29-59
APP'D.

ESTIMATED BRIDGE QUANTITIES

ITEM N°	DESCRIPTION	QUANTITY		QUANTITY		QUANTITY		QUANTITY		QUANTITY		QUANTITY		TOTAL QUANTITY	UNIT
		RT. LANE	LT. LANE	RT. LANE	LT. LANE	RT. LANE	LT. LANE	RT. LANE	LT. LANE	RT. LANE	LT. LANE	RT. LANE	LT. LANE		
17-2	EXCAV. (BRIDGES) DRY	231	222	144	459			136	155			326	275	1,948	CU.YDS.
17-3	EXCAV. (BRIDGES) WET	320	558	750	593			536	266			336	336	4,988	CU.YDS.
17-4	EXCAV. (BRIDGES) ROCK	164	96	151	108			71	92			369	268	1,600	CU.YDS.
17-5	ROCK DRILLING													216	LIN. FT.
135-4	CLASS "A" CONC.													11,101.3	CU.YDS.
135-12	STEEL BAR REINF.	938.2	957.5	1,325.6	1,348.6	111.0	111.7	1,096.7	1,023.7	1,311.0	1,284.4	807.3	785.6	1,565,822	LBS.
132-1	STRUCTURAL STEEL	137,882	126,753	204,756	204,020	18,378	18,253	159,321	148,349	180,814	173,638	99,423	94,235	17,305	LBS.
137-3	STEEL PILES (10") @ 42 #	1,550	1,530	1,845	1,845			1,825	1,900	1,935	1,470	1,470	1,470	10,258	LIN. FT.
154-1	PRECAST PRESTRESSED CONC. BOX GIRDER 48"x33"x54'-0"	8												8	EACH
154-1A	" " " " " 48"x33"x63'-0"	24												24	"
154-1B	" " " " " 48"x42"x90'-0"	16												16	"
154-1C	" " " " " 48"x33"x65'-0"	8												8	"
154-1D	" " " " " 48"x33"x66'-0"		8											8	"
154-1E	" " " " " 48"x33"x67'-0"		24											24	"
154-1F	" " " " " 48"x42"x90'-0"		16											16	"
154-1G	" " " " " 48"x33"x62'-0"		8											8	"
154-1H	" " " " " 48"x33"x69'-11 1/2"													11	"
154-1J	" " " " " 48"x42"x89'-10 1/2"													11	"
154-1K	" " " " " 48"x42"x73'-6"													11	"
154-1L	" " " " " 48"x42"x75'-0"													11	"
154-PT1	AASHTO TYPE III PRECAST PRESTRESSED CONC. "I" BEAM 54"x87'-11 1/2"				12									12	"
154-PT2	" " " " " 54"x88'-10"			18	18									36	"
154-PT3	" " " " " 54"x87'-5 1/2"			6										6	"
154-PT4	" " " " " 54"x86'-5 1/2"			6										6	"
154-PT5	" " " " " 54"x70'-6"													10	"
154-PT6	" " " " " 54"x82'-10"							10						30	"
154-PT7	" " " " " 54"x70'-10 1/2"							15	15					10	"
154-PT8	" " " " " 54"x74'-9 1/2"								10					10	"
154-PT9	AASHTO TYPE III " " " " 45"x54'-3"									10				10	"
154-PT10	AASHTO TYPE IV " " " " 54"x79'-10"										10			10	"
501	STEEL HANDRAIL (2 BAR)	362	1,006	876	878	150	152	772	774	20	20	626	626	8,604	LIN. FT.

- ALL EXPANSION JOINT MATERIAL SHALL BE INCLUDED IN THE PRICE FOR CLASS "A" CONCRETE UNLESS PROVIDED FOR IN PROVISIONS FOR PRESTRESSED GIRDERS AND ITEMIZED STEEL EXPANSION JT. TRANSITE SCUPPERS FOR DECK DRAINAGE SHALL BE INCLUDED IN THE UNIT PRICE BID FOR CLASS "A" CONCRETE.

ESTIMATED ROADWAY QUANTITIES

ITEM N°	DESCRIPTION	QUANTITY	UNIT
11-1	CLEARING AND GRUBBING	1	LUMP SUM
12-1	REMOVAL OF STRUCTURES, ETC. (SEE SPEC. PROVISION)	1	LUMP SUM
12-1a	SALVAGE VALUE OF STRUCTURES REMOVED (SEE SPEC. PROVISION)	1	LUMP SUM
13-3	ROAD AND DRAINAGE EXCAVATION (UNCLASS)	1,735,182	CU. YD.
13-4	CHANNEL EXCAVATION (UNCLASS)	106,813	CU. YD.
13-5	WATER (EMBANKMENT)	3,376	M. GAL.
15-1	BORROW EXCAVATION (COMMON)	26,860	CU. YD.
15-2	BORROW EXCAVATION (SOLID ROCK)	15,215	CU. YD.
33C-1	CRUSHED STONE (TRAFFIC BOUND ROADWAY)	4,453	TON
33C-1b	FLAKE CALCIUM CHLORIDE (TRAFFIC BOUND ROADWAY)	4	TON
33C-1c	CONCENTRATED CALCIUM CHLORIDE (TRAFFIC BOUND ROADWAY)	3	TON
33C-10	GRANULAR BACKFILLING FOR PIPE CULVERTS (SEE SPEC. PROVISION)	1,243	CU. YD.
132-4a	GRAY IRON CASTINGS - CLASS 30	1,450	LB.
132-4b	GRAY IRON CASTINGS - CLASS 20	223	LB.
135-4	CLASS "A" CONCRETE	742	CU. YD.
135-4a	CLASS "A" CONCRETE (PAVED SLOPES UNDER BRIDGES)	74	CU. YD.
135-12	STEEL BAR REINFORCEMENT	90,478	LB.
141-3	18" STD. STR. CONCRETE PIPE CULVERT	116	LIN. FT.
141-4	24" STD. STR. CONCRETE PIPE CULVERT	296	LIN. FT.
141-7	42" STD. STR. CONCRETE PIPE CULVERT	40	LIN. FT.
141-10	60" STD. STR. CONCRETE PIPE CULVERT	44	LIN. FT.

ESTIMATED ROADWAY QUANTITIES

ITEM N°	DESCRIPTION	QUANTITY	UNIT
144	15" C.G.M. PIPE CULVERT BITUMINOUS COATED (PAVED INVERT)	1,130	LIN. FT.
144	24" C.G.M. PIPE CULVERT BITUMINOUS COATED	170	LIN. FT.
144	42" C.G.M. PIPE CULVERT BITUMINOUS COATED (PAVED INVERT)	524	LIN. FT.
144	60" C.G.M. PIPE CULVERT BITUMINOUS COATED (PAVED INVERT) STRUTTED	362	LIN. FT.
144	66" C.G.M. PIPE CULVERT BITUMINOUS COATED (PAVED INVERT) STRUTTED	344	LIN. FT.
149	102" C.G.M. STRUCTURAL PLATE PIPE CULVERT BITUMINOUS COATED STRUTTED	596	LIN. FT.
159	METAL END SECTION, PIPE CULVERT, 15"	11	EACH
159	METAL END SECTION, PIPE CULVERT, 24"	4	EACH
159	METAL END SECTION, PIPE CULVERT, 42"	4	EACH
173-7	STOCK FENCE (SEE SPECIAL PROVISION)	47,100	LIN. FT.
173-10	GATE FOR DITCH	868	SQ. FT.
173-12	WATER CROSSING	156	LIN. FT.
174-2	MARKERS (R.O.W.)	89	EACH
176-	RIP-RAP	48	CU. YD.
178-17	6" PERFORATED CONCRETE PIPE UNDERDRAIN	1,000	LIN. FT.
500	SEEDING (SEE SPECIAL PROVISION)	3,295	UNIT

- 1 INCLUDES AN ESTIMATED 21,022 CU. YD. OF TOPSOIL STRIPPING UNDER FILLS.
- 2 INCLUDES 67M. GALS. WATER FOR ITEM 33C-1.
- 3 QUANTITIES MAY BE REDUCED OR ELIMINATED AT THE DISCRETION OF THE ENGINEER.
- 4 CONTINGENCY ITEM - TO BE USED AS DIRECTED BY ENGINEER.
- 5 AASHTO DESIGNATION M-170-57, CLASS III.
- 6 THIS MATERIAL TO BE FURNISHED BY THE CONTRACTOR. SEE GENERAL NOTES.
- 7 SEE NOTE RE. CLEARING AND GRUBBING IN WIDE MEDIAN, SHEET NO. 2.
- 8 RUBBLE STONE (PLAIN) OR SACKED SAND-CEMENT.
- 9 SEE STANDARD DWG. RD-F-20.
- 10 INCLUDES THE REMOVAL AND DISPOSAL OF ONE ABANDONED FRAME HOUSE AND ONE FRAME BARN ON THE SID PETTY ESTATE. THESE BUILDINGS HAVE NO SALVAGE VALUE.

CONCRETE PIPE CULVERTS & ENDWALLS

STATION	DRAREA AC.	PIPE SIZE	LENGTH AND CLASS	SKREW	DWG. N°	CLASS "A" CONC. C.Y.	REINF STEEL LBS.	GRANU. BACKFILL C.Y.	CONC. ENDWALLS	
INTERSTATE										
315+00 W.B.L.	10-H.	116			STD. 90°	E-2-90	5.02	290	31	2-STRAIGHT
315+50 E.B.L.	8-H.	104			STD. 90°	E-2-90	5.02	290	28	2-STRAIGHT
FARM ROAD @ 332± E.B.L.										
27+88	4-H.	68			STD. 45°R					
FARM ROAD @ 370 TO 397 W.B.L.										
70+00	4-H.	48			STD. 90°					
76+00	36-H.		40		STD. 90°					
86+00	95-H.			44	STD. 90°					
RELOC. COUNTY ROAD @ 401+ 85 E.B.L.										
7+50	8-H.	38			STD. 90°	D-0-13	3.24			2-STRAIGHT
12+00	8-H.	38			STD. 90°	D-0-13	3.24			2-STRAIGHT
TOTAL										
		116	296		40	44		16.52	580	59

REMOVAL & SALVAGE OF BUILDINGS

TRACT N°	DESCRIPTION	ITEM 12 ESTIMATE	ITEM 12-P ESTIMATE
34	BARN		
36	FRAME DWELLING		
36	SHED		
37	BARN		
37	SHED		
38	FRAME DWELLING		
38	GARAGE		
38	SHED		
38	SHED		
38	SHED		
38	BARN		
40	FRAME DWELLING		
40	BARN		
40	SHED		
42	CEMETERY	(NOT IN CONTRACT)	
45	BARN		

3 I-40-5(3)264 1960 2-E 372
CONSTR.
REVISED 4-26-60: GRADING QUANTITIES
CHANGED.

CORRUGATED METAL AND SECTIONAL PLATE PIPE CULVERTS

STATION	DRAREA AC.	PIPE SIZE	LENGTH AND GAUGE	SKREW	DWG. N°	CLASS "A" CONC. C.Y.	REINF. STEEL LBS.	GRANU. BACKFILL C.Y.	MET. END SECT.	RIP-RAP C.Y.	CONC. END WALLS	REMARKS
INTERSTATE												
373+80 W.B.L.	34-H.		202 1/2		90°	CM-1-4;6		89	2			
376+55 E.B.L.	27-H.		162		85°R	CM-1-4;6		72	2			
386+00 W.B.L.	95-H.		180		90°	CM-1-4;5;7		116		7.6		BEVELLED ENDS-STRUTTED
389+00 E.B.L.	86-H.		182		90°	CM-1-4;5;7		117		7.6		BEVELLED ENDS-STRUTTED
397+74 W.B.L.	382-H.		316 1/2		60°LF	CM-1-4;5;7		381		12.4		BEVELLED ENDS-STRUTTED
398+59 E.B.L.	377-H.		280 1/2		82°LF	CM-1-4;5;7		338		12.4		BEVELLED ENDS-STRUTTED
419+85 E.B.L.	29-H.		160		60°LF	CM-1-4	10.58	178		71		TYPE "A"; SHEET N° 27
273+00 E.B.L.	125-H.		170		90°	CM-1-4;5;7		122		8.2		BEVELLED ENDS-STRUTTED
275+42 W.B.L.	125-H.		164		67°LT	CM-1-4;7	25.64	338		117		TYPE "A"; SHEET N° 27-STRUTTED
RELOC. COUNTY ROAD @ 401+85 E.B.L.												
18+00	8-H.	100		14	90°	CM-1-4;6			2			
21+50	5-H.	70		14	90°	CM-1-4;6			2			
TOTAL												
		170	344	524	362	596		36.22	516	1423	8	48.2 4

* 60' of #8 Ga.; 40' of #10 Ga. & 102' of #12 Ga.
 * 126' of #10 Ga., 120' of #12 Ga.
 * 56' of #5 Ga., 24' of #7 Ga., 38' of #8 Ga. & 60' of #10 Ga. & 102' of #12 Ga.

ITEMIZED QUANTITIES FOR MEDIAN DRAINS & SPILLWAYS

SHEET N°	DESCRIPTION	15" C.G.M. PIPE LENGTH (FT.)	CLASS "A" CONC. C.Y.	REINF. STEEL LBS.	METAL END SECTIONS	CASTINGS CLASS 20 LBS.	CASTINGS CLASS 30 LBS.	METELBOWS 25°
19A	MEDIAN DRAINS & SPILLWAYS	342	7.30	87	3		435	
19B	MEDIAN DRAINS & SPILLWAYS	226	5.95	87	2		290	2
20B	MEDIAN DRAINS	236	2.70		2		290	2
21A	SPILLWAYS	92	2.66	87	1	223		1
21B	SPILLWAYS		7.17	87				
22A	SPILLWAYS		3.54	87				
24A	SPILLWAYS		2.89	87				
24B	MEDIAN DRAINS	78	1.35		1		145	
25A	MEDIAN DRAINS & SPILLWAYS	156	6.51	87	2		290	
25B	SPILLWAYS		3.86	87				
TOTAL		1,130	43.93	696	11	223	1,450	5

CONCRETE BOX CULVERTS

STATION	DRAREA AC.	SIZE AND LENGTH	SKREW	DWG. N°	CLASS "A" CONC. C.Y.	REINF. STEEL LBS.
450+75 W.B.L.	477-H.	8'-0" 8'-0" 170	90°	C-4-141; E-8-57	253.52	35,086
455+41 E.B.L.	492-H.	8'-0" 8'-0" 242	60°R	C-4-141; E-8-58	391.59	53,600
TOTAL						
					645.11	88,686

R.O.W. MARKERS

TYPE "A"	46
TYPE "B"	21
TYPE "C"	22
TOTAL	89

ITEMIZED PAVING QUANTITIES

ITEM N°	DESCRIPTION	FARM ROADS	RELOC. COUNTY RD. @ 401+85 E.B.L.	TOTAL	UNIT
33C-1	CRUSHED STONE	2,462	1,991	4,453	TON
33C-1b	FLAKE CALC. CHLO.		4	4	TON
33C-1c	CONC. CALC. CHLO.		3	3	TON

GRADING QUANTITIES

STATION TO STATION	ROADWAY COMMON	EXCAVATIONS - CU. YD. SOLID ROCK CHANNEL	BORROW - CU. YD. COMMON SOLID ROCK
E.B.L. & W.B.L. *			
264+15	300+28	344,550	48,13
300+28	328+45	84,229	11,014
328+45	333+00	1,376	27,023
333+00	335+59		12,600
335+59	369+40	65,665	154,972
E.B.L.			
369+40	390+45	1,230	147,569
390+45	412+70	81,761	62,523
412+70	432+27	49,755	18,172
432+27	466+45	93,165	15,959
W.B.L.			
370+00	397+10	19,126	74,429
397+10	407+65	47,926	13,780
407+65	424+96	56,519	12,861
424+96	427+32		7,400
427+32	464+50	58,066	46,900
E.B.L. & W.B.L. *			
470+13	495+45	114,613	
495+45	520+95	117,446	6,860
		127,186	15,215
TOTAL			
	1,145,167	550,015	102,000

* STATIONS SHOWN ARE FOR E.B. LANE.

MID-SOUTH ENGINEERING CO., INC.
820 BROADWAY, N.E. KNOXVILLE, TENNESSEE


ESTIMATED ROADWAY QUANTITIES

STATE OF TENNESSEE
DEPARTMENT OF HIGHWAYS
AND PUBLIC WORKS
NASHVILLE


DR. J.L.M.
CHK'D. M.L.S.
APP'D.

DATE
11-2-59
11-13-59

FED. ROAD DIST. NO.	TENN.	FEDERAL AID PROJECT NO.	FISCAL YEAR	SHEET NO.	TOTAL SHEETS
3	N.	I-40-5 (D) 264 CONSTR.	1960	3	372


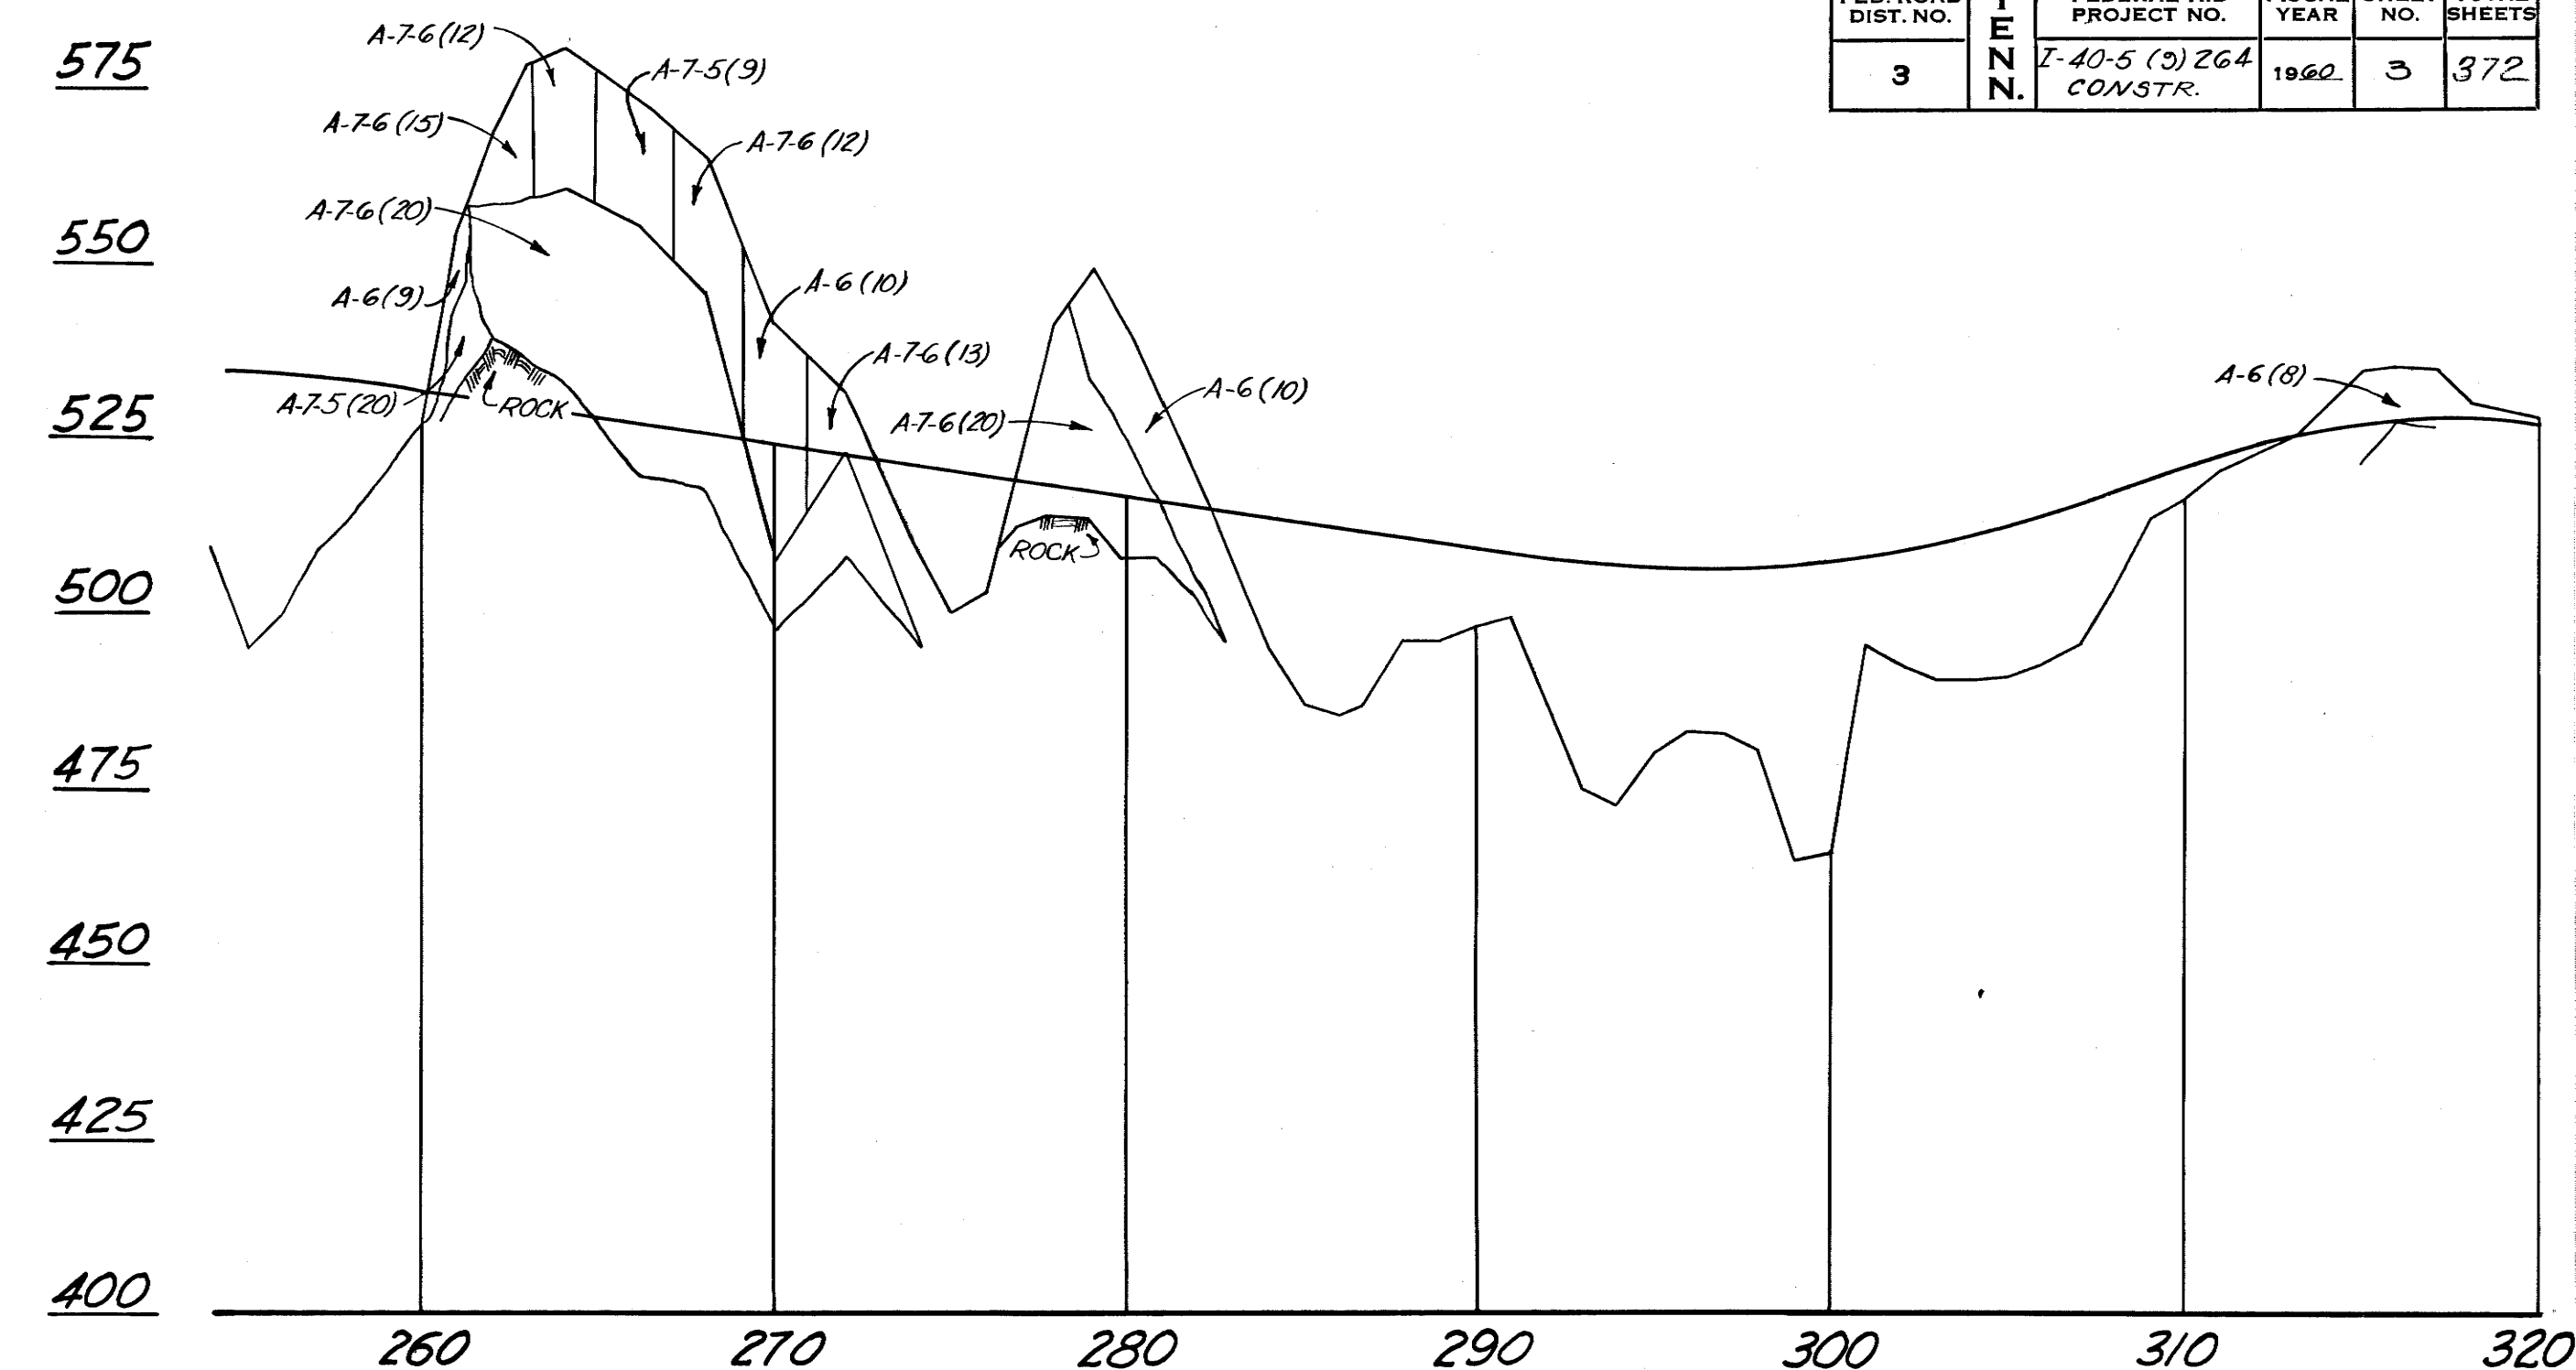


PROFILE LEFT LANE

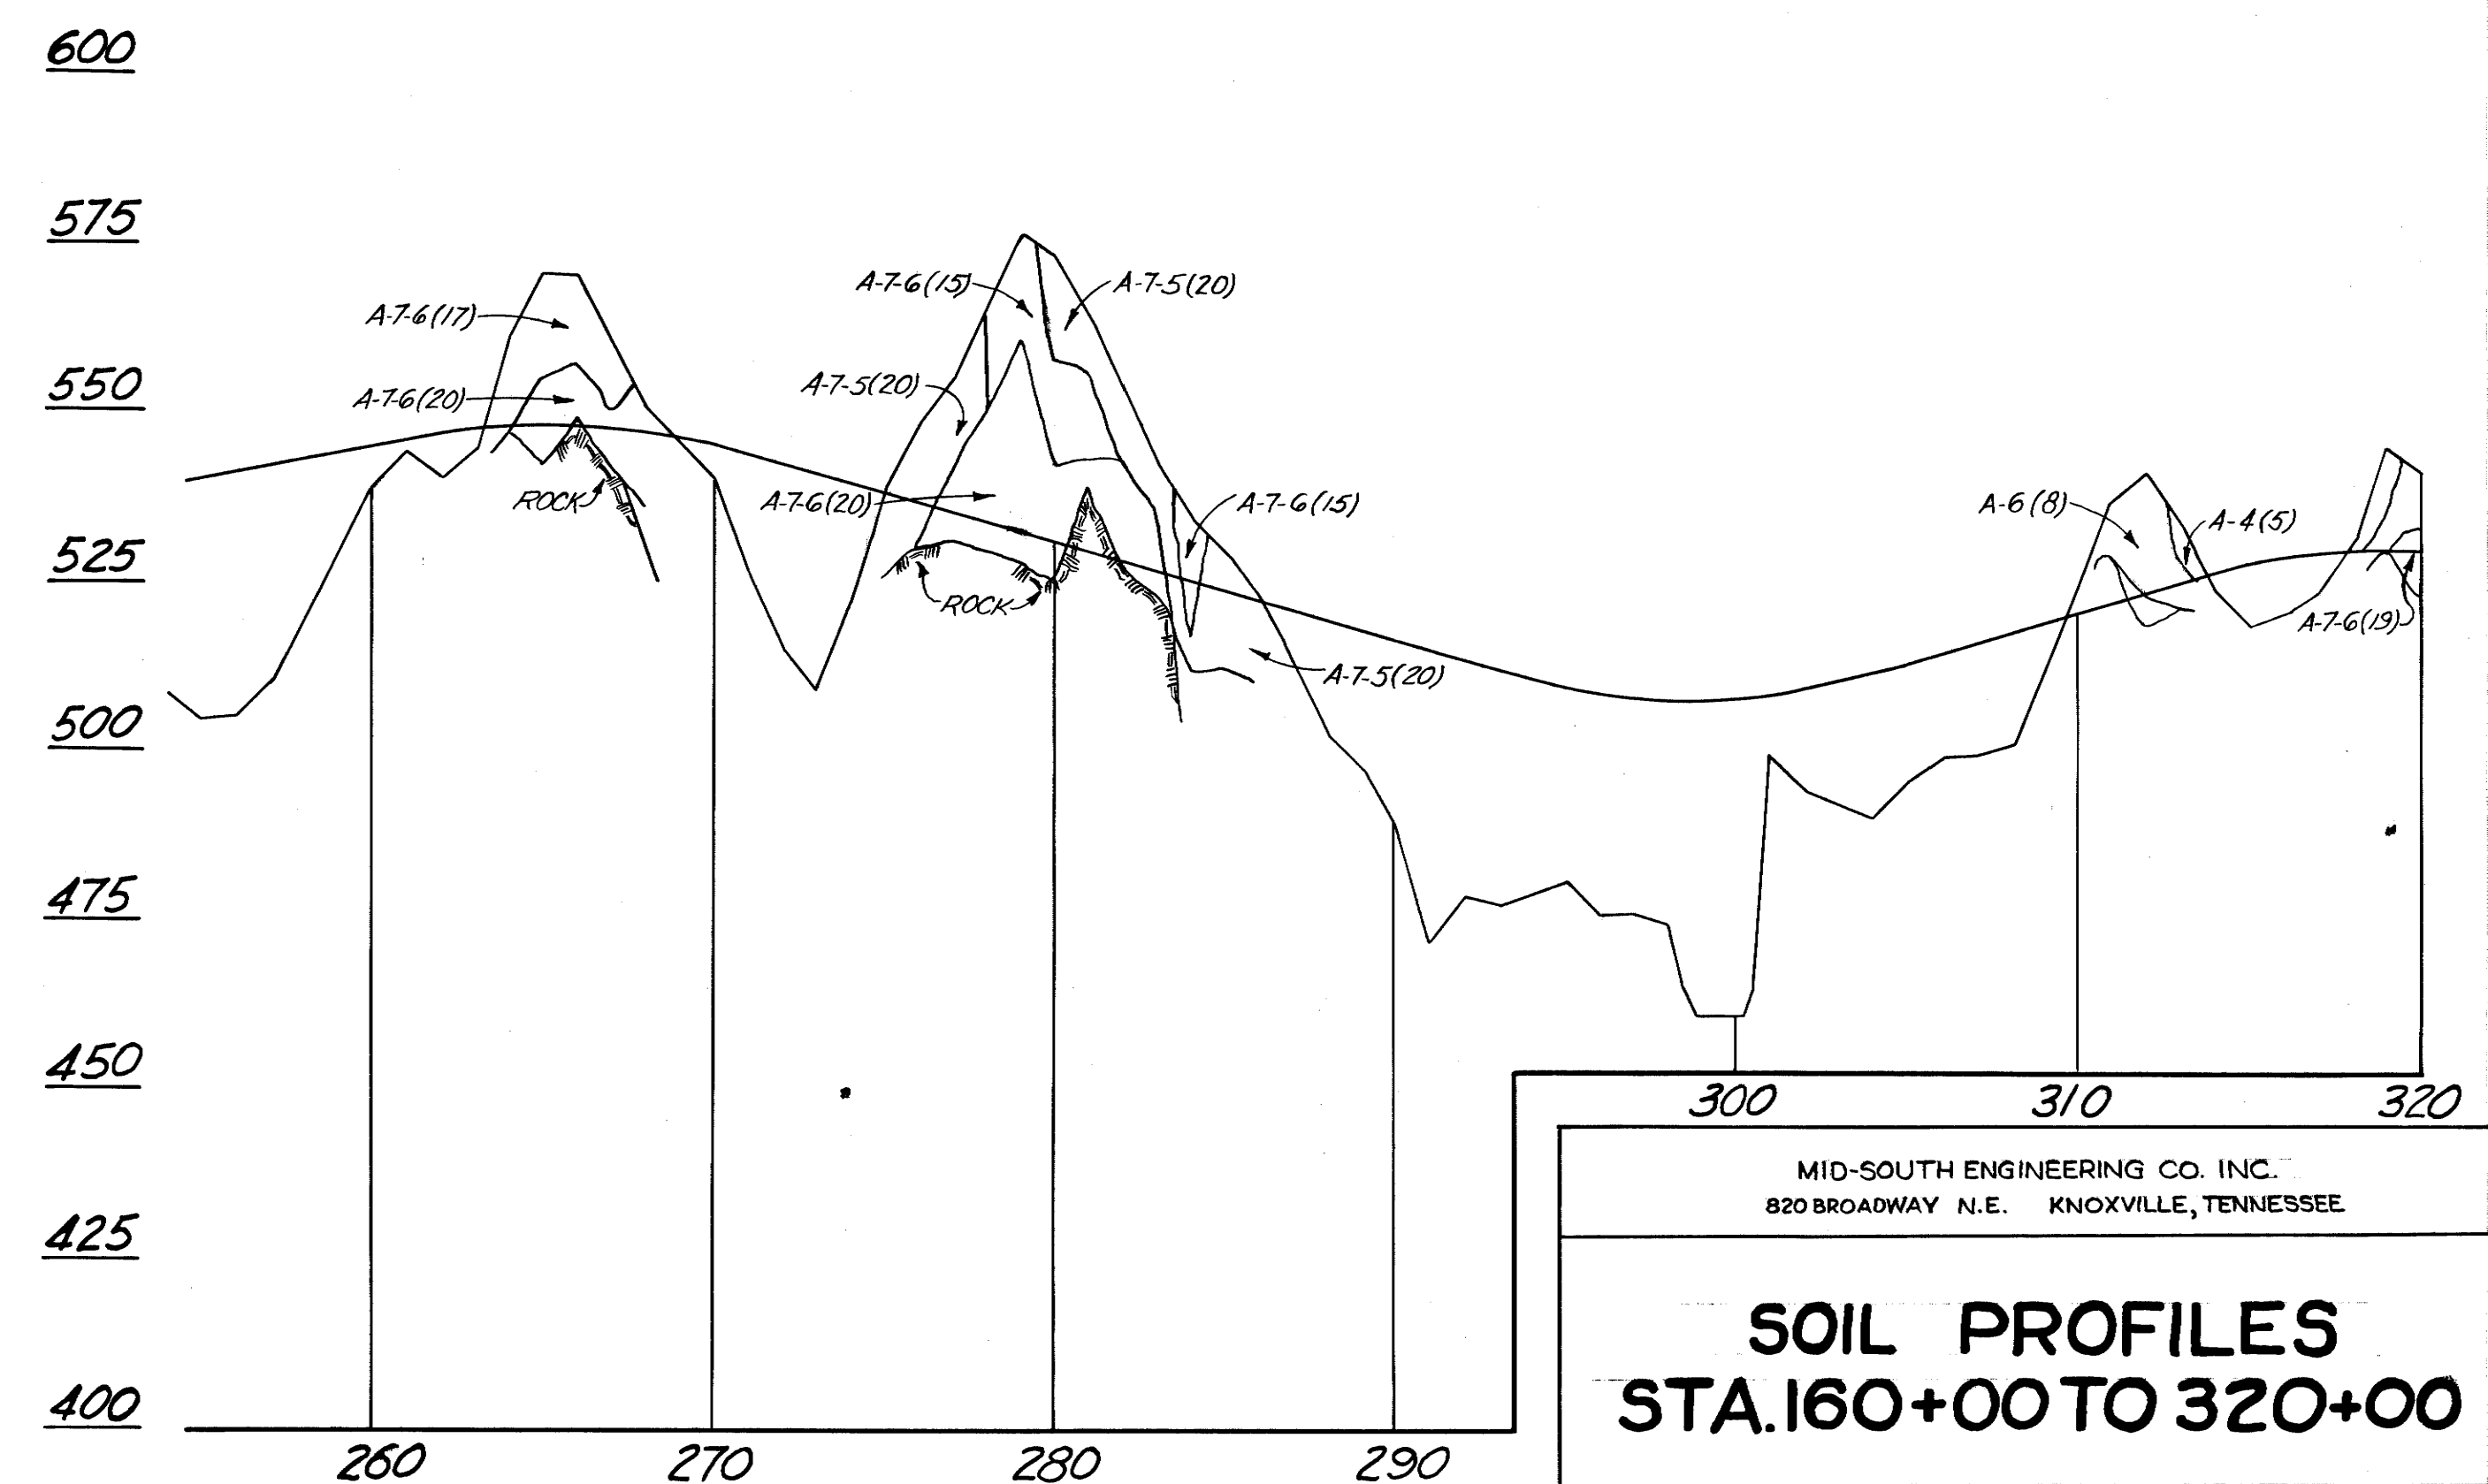



PROFILE RIGHT LANE

MID-SOUTH ENGINEERING CO. INC. 820 BROADWAY N.E. KNOXVILLE, TENNESSEE	
SOIL PROFILES STA. 160+00 TO 320+00	
STATE OF TENNESSEE DEPARTMENT OF HIGHWAYS AND PUBLIC WORKS NASHVILLE	
DR. JLM.	DATE 4-27-59
CHK'D.	
APP'D.	

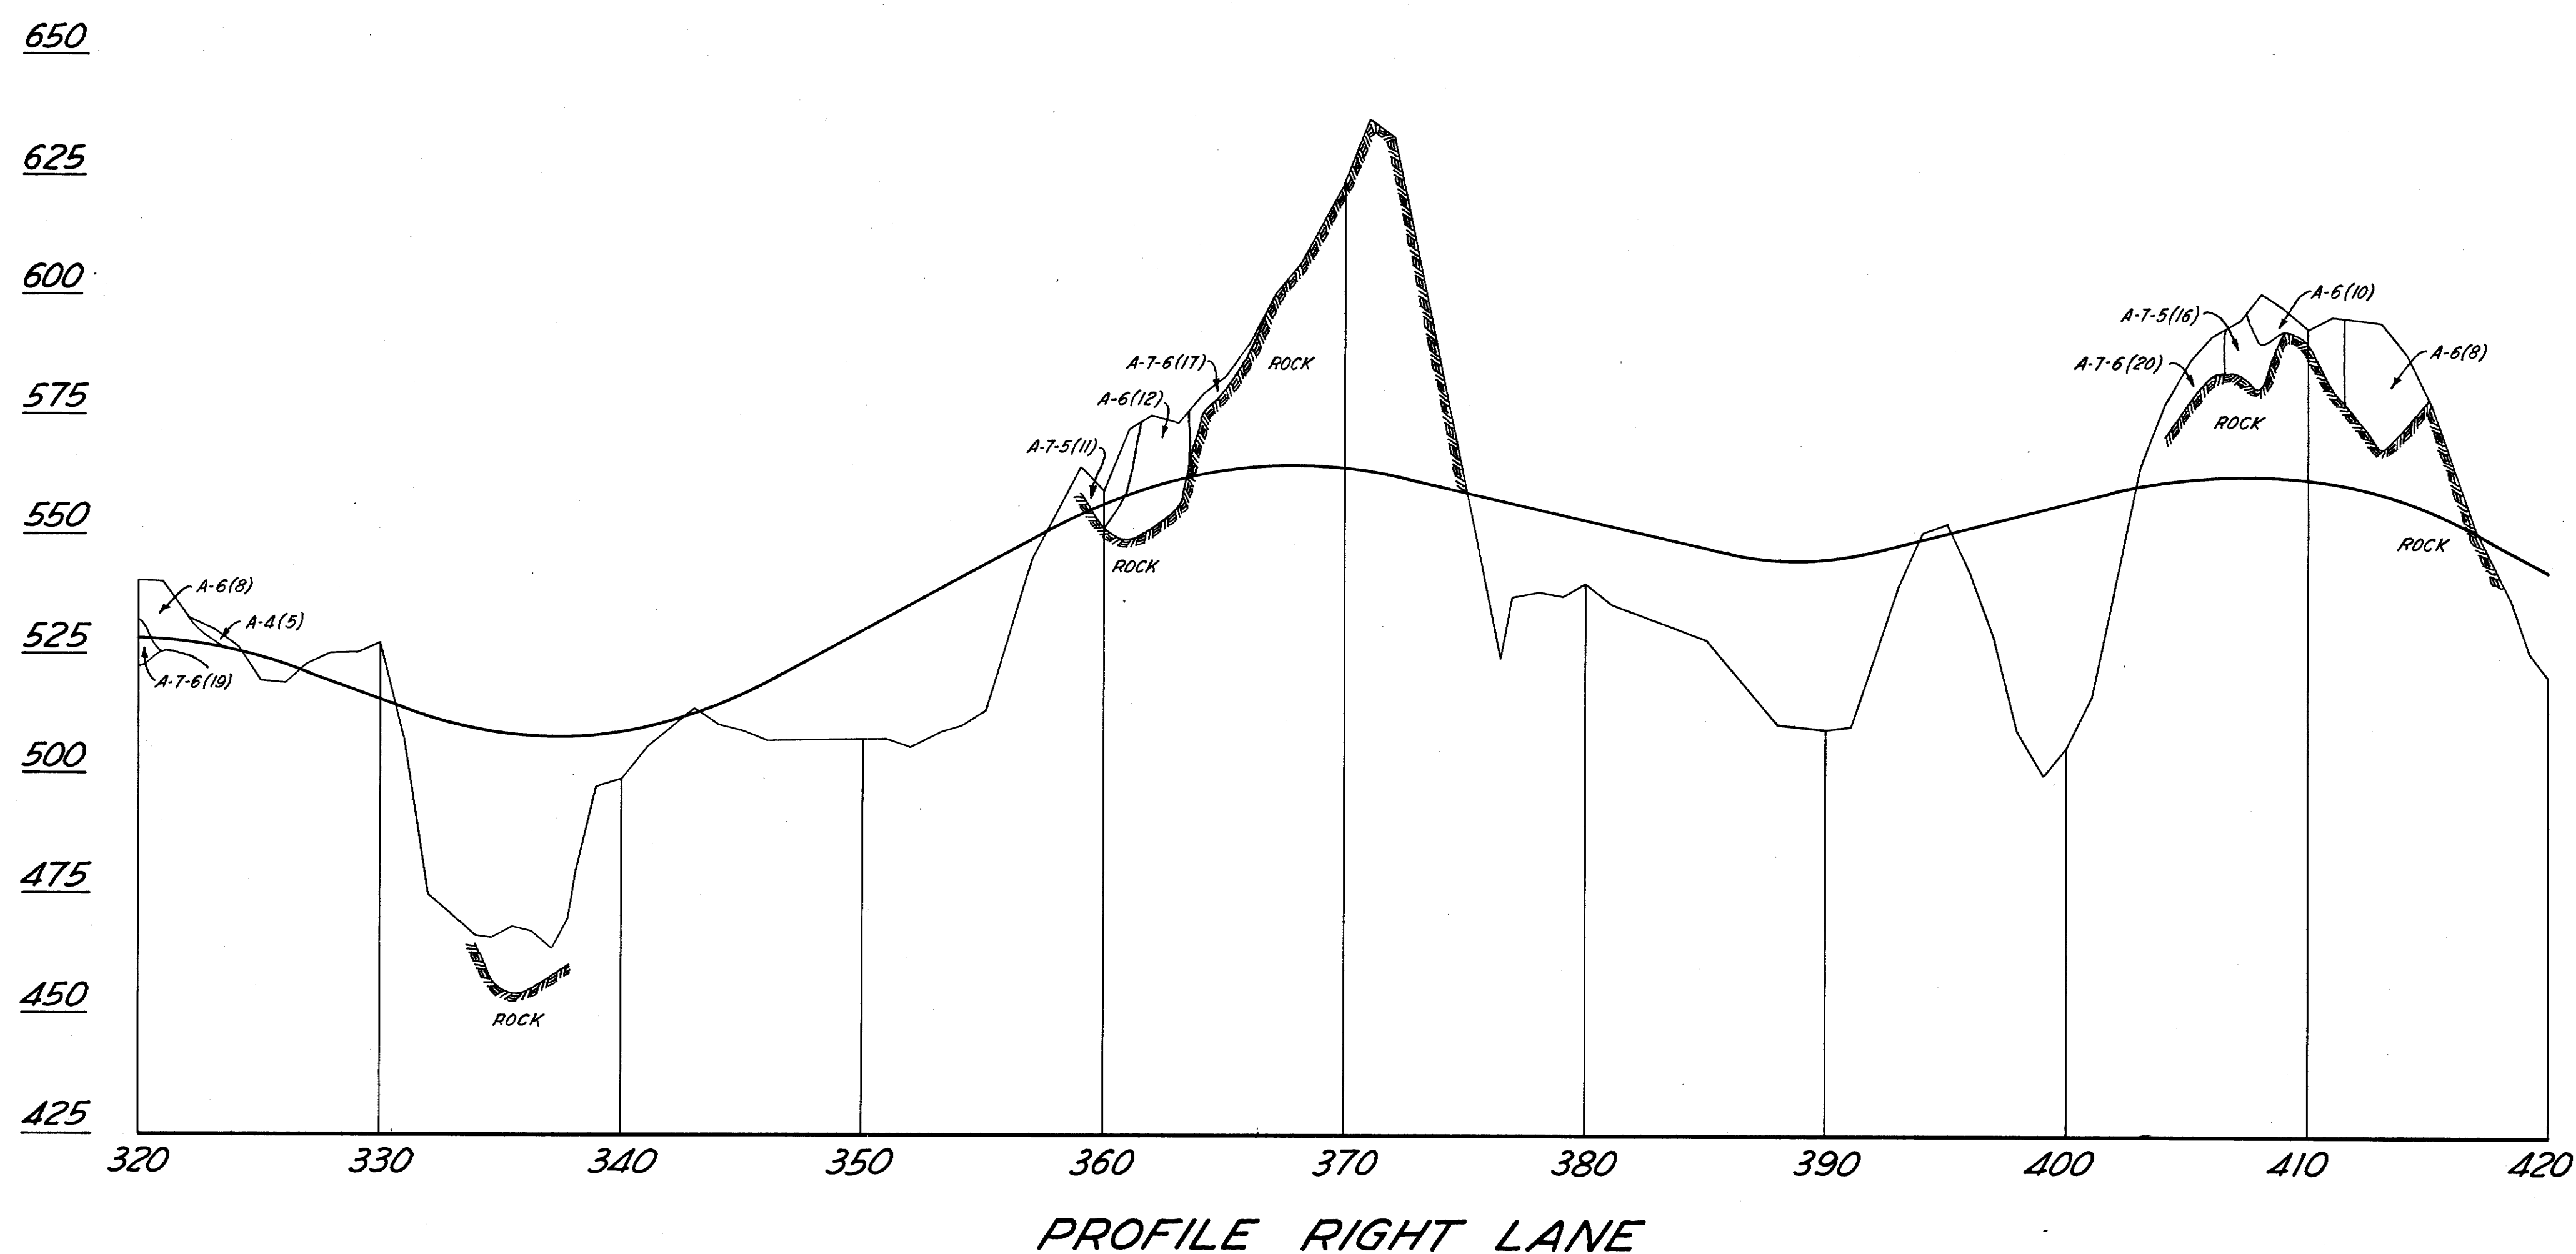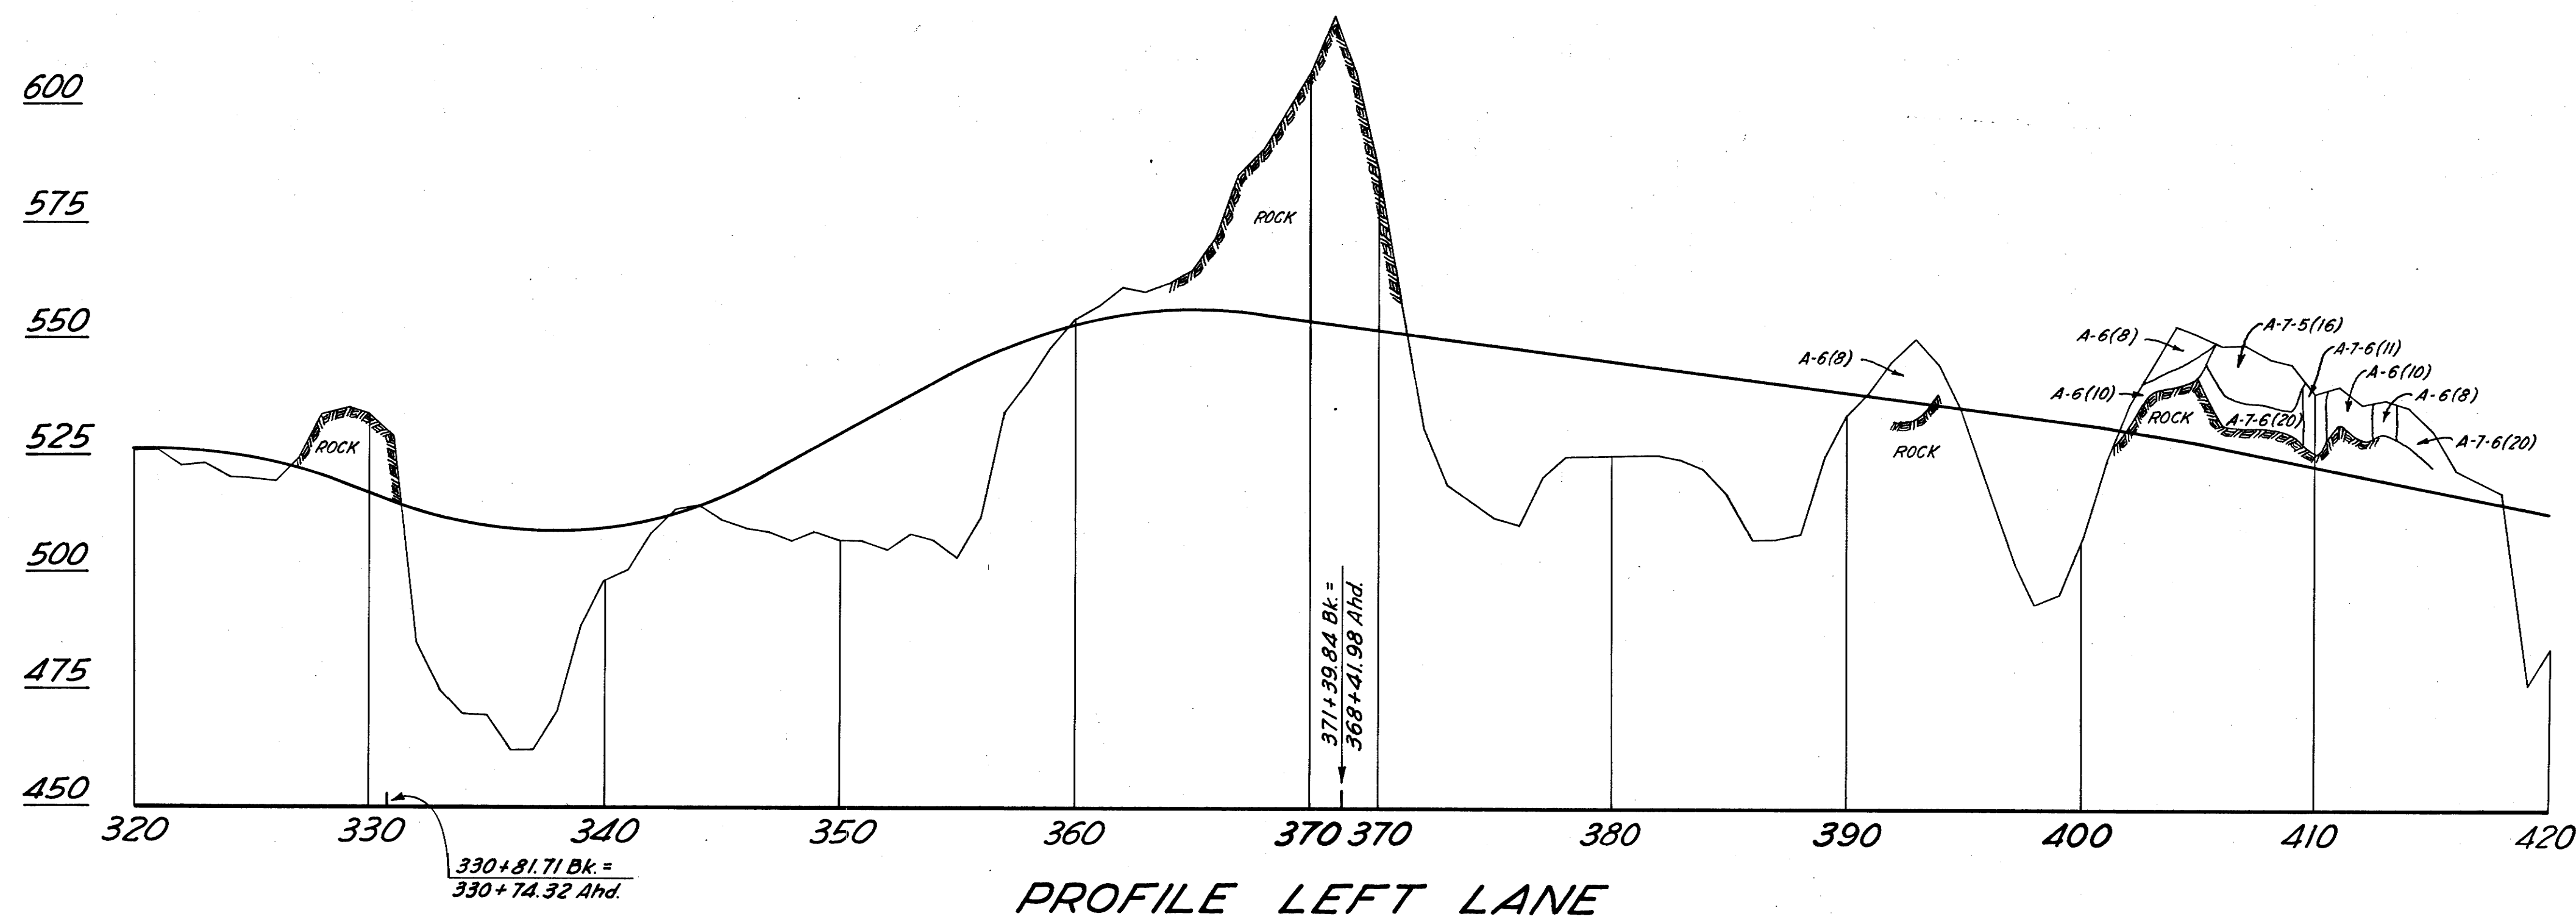


MID-SOUTH ENGINEERING CO., INC. 820 BROADWAY N.E. KNOXVILLE, TENNESSEE	
SOIL PROFILES STA. 320+00 TO 420+00	
STATE OF TENNESSEE DEPARTMENT OF HIGHWAYS AND PUBLIC WORKS NASHVILLE	
DR. <u>J.L.M.</u>	DATE <u>9-17-59</u>
CHK'D _____	
APP'D _____	

TENN STATE HIGHWAYS
Plans File 17-
No. 50

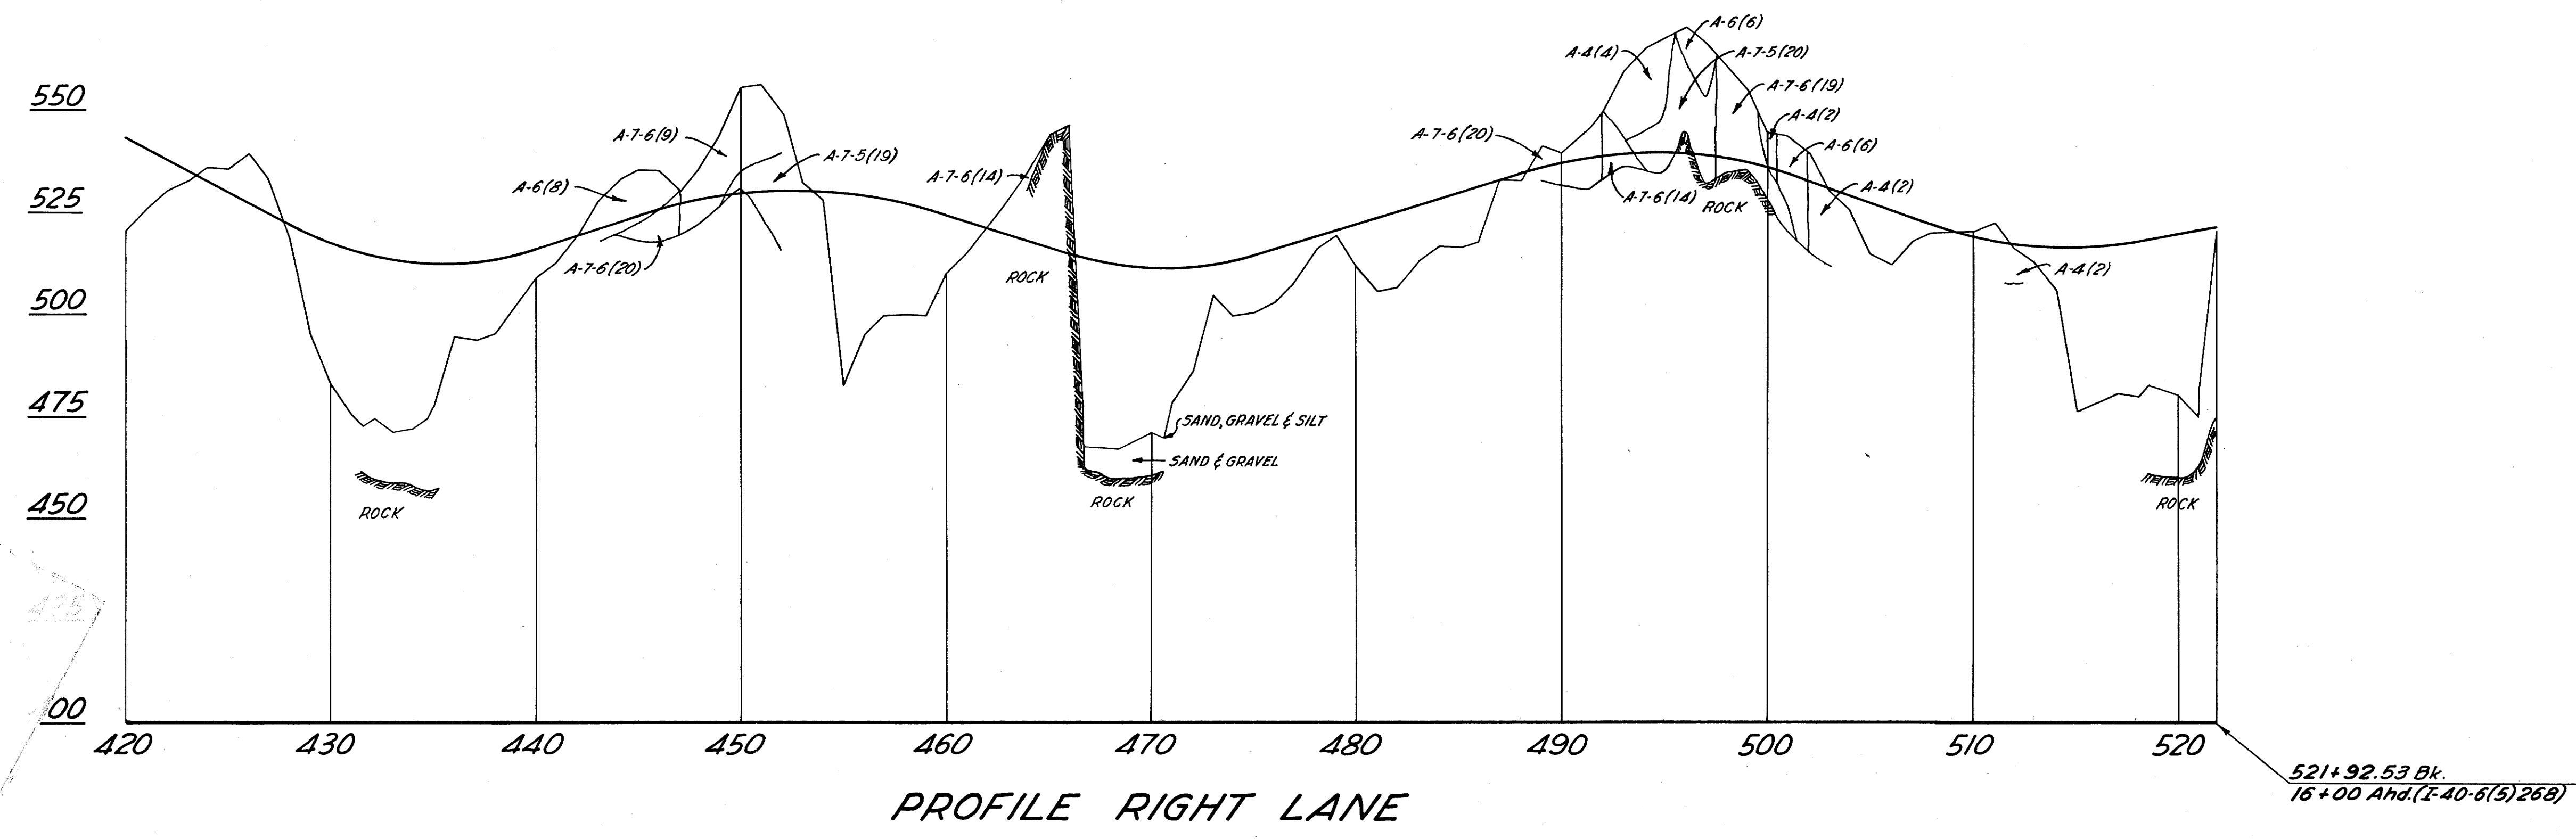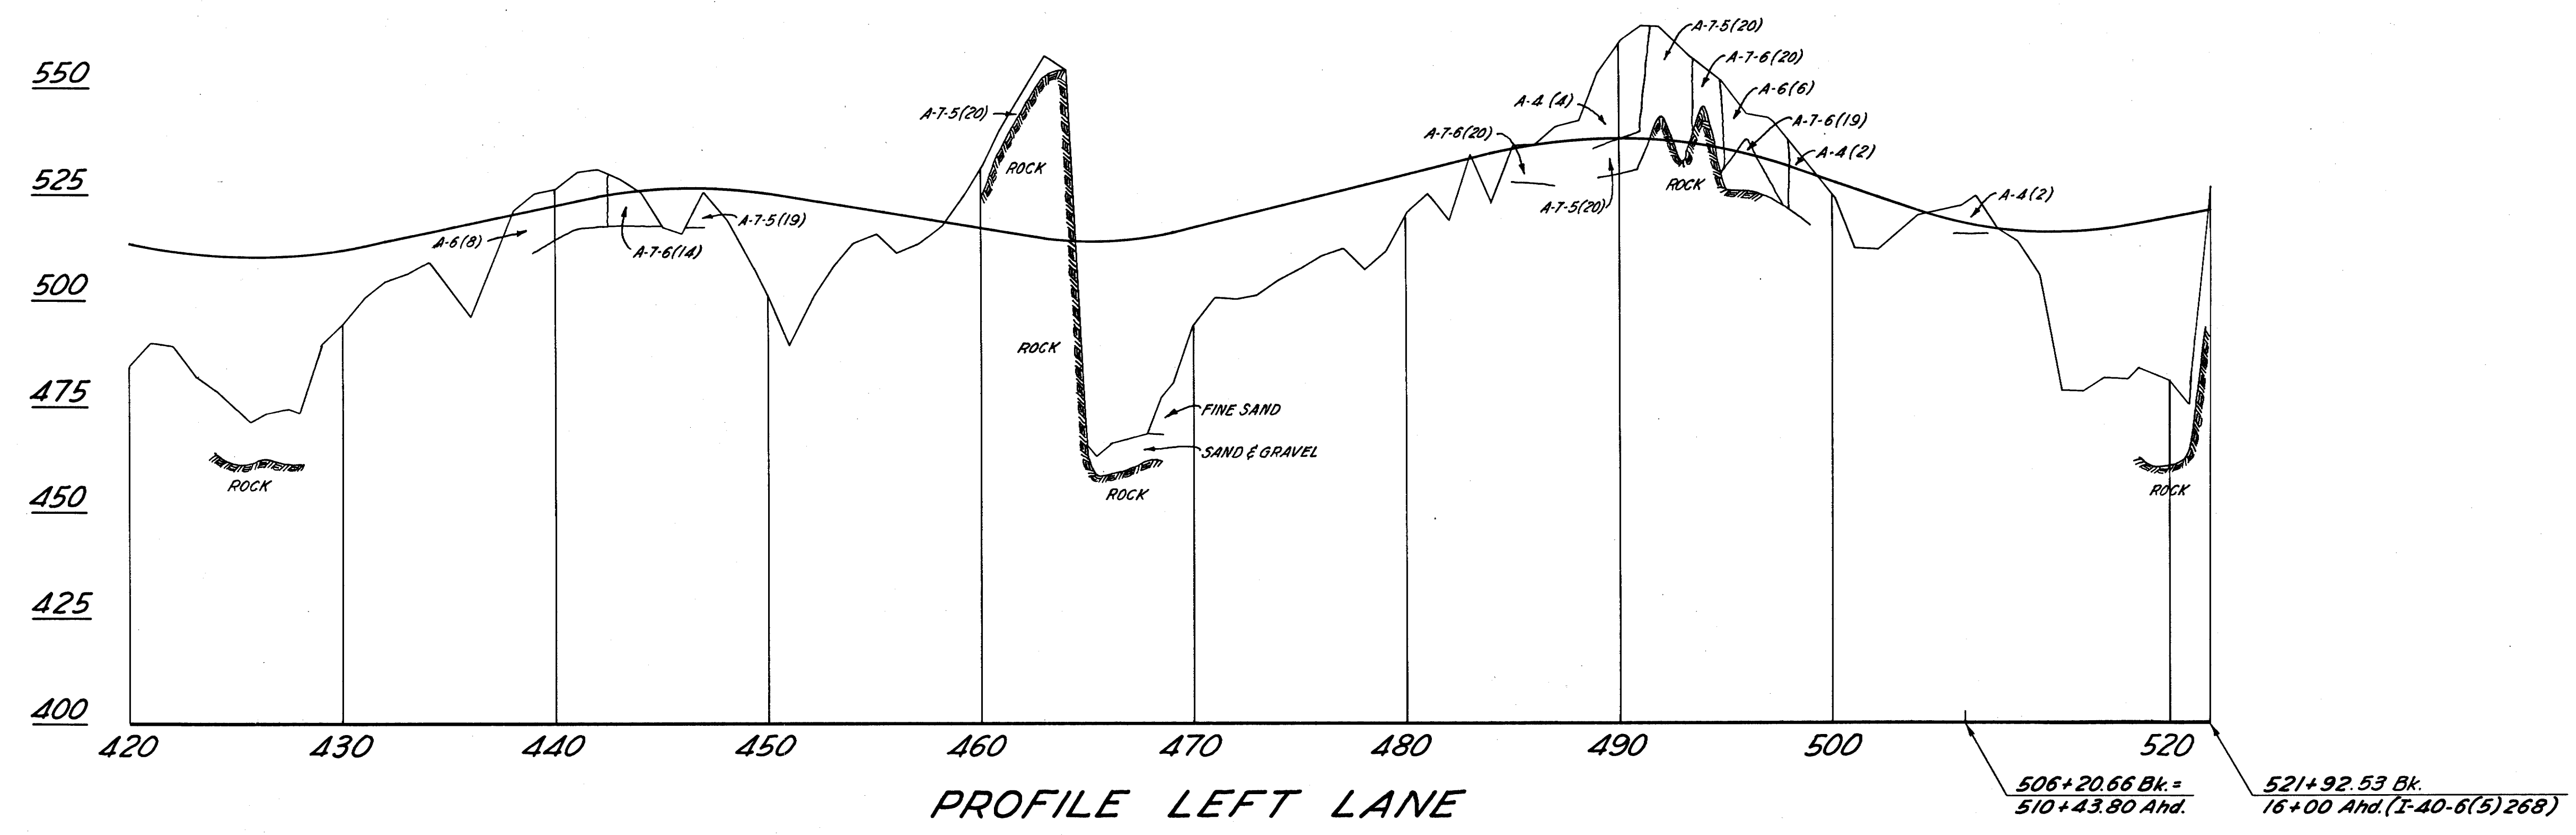


MID-SOUTH ENGINEERING CO., INC. 820 BROADWAY N.E. KNOXVILLE, TENNESSEE	
SOIL PROFILES STA. 420+00 TO 521+92	
STATE OF TENNESSEE DEPARTMENT OF HIGHWAYS AND PUBLIC WORKS NASHVILLE	
DR. J.L.M.	DATE 9-17-59
CHK'D.	
APP'D.	

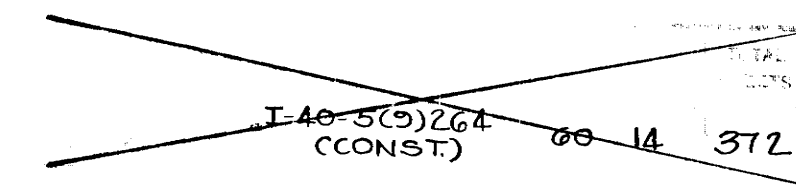

TRF. ROAD DIST. No.	T E N	FEDERAL AID PROJECT No.	FISCAL YEAR	SHEET No.	TOTAL SHEETS
I-40-5(0)264 (CONST)	N	I-40-5(0)259 R.O.W.	1959	7	25

REVISED 7-15-59: FRTS. RD. & HOUSES ADDED.
REVISED 7-31-59: LINE CHANGE W.B.L. AHEAD OF STA. 282.

DATE	1-3-59
CHK'D	ML5
APP'D	

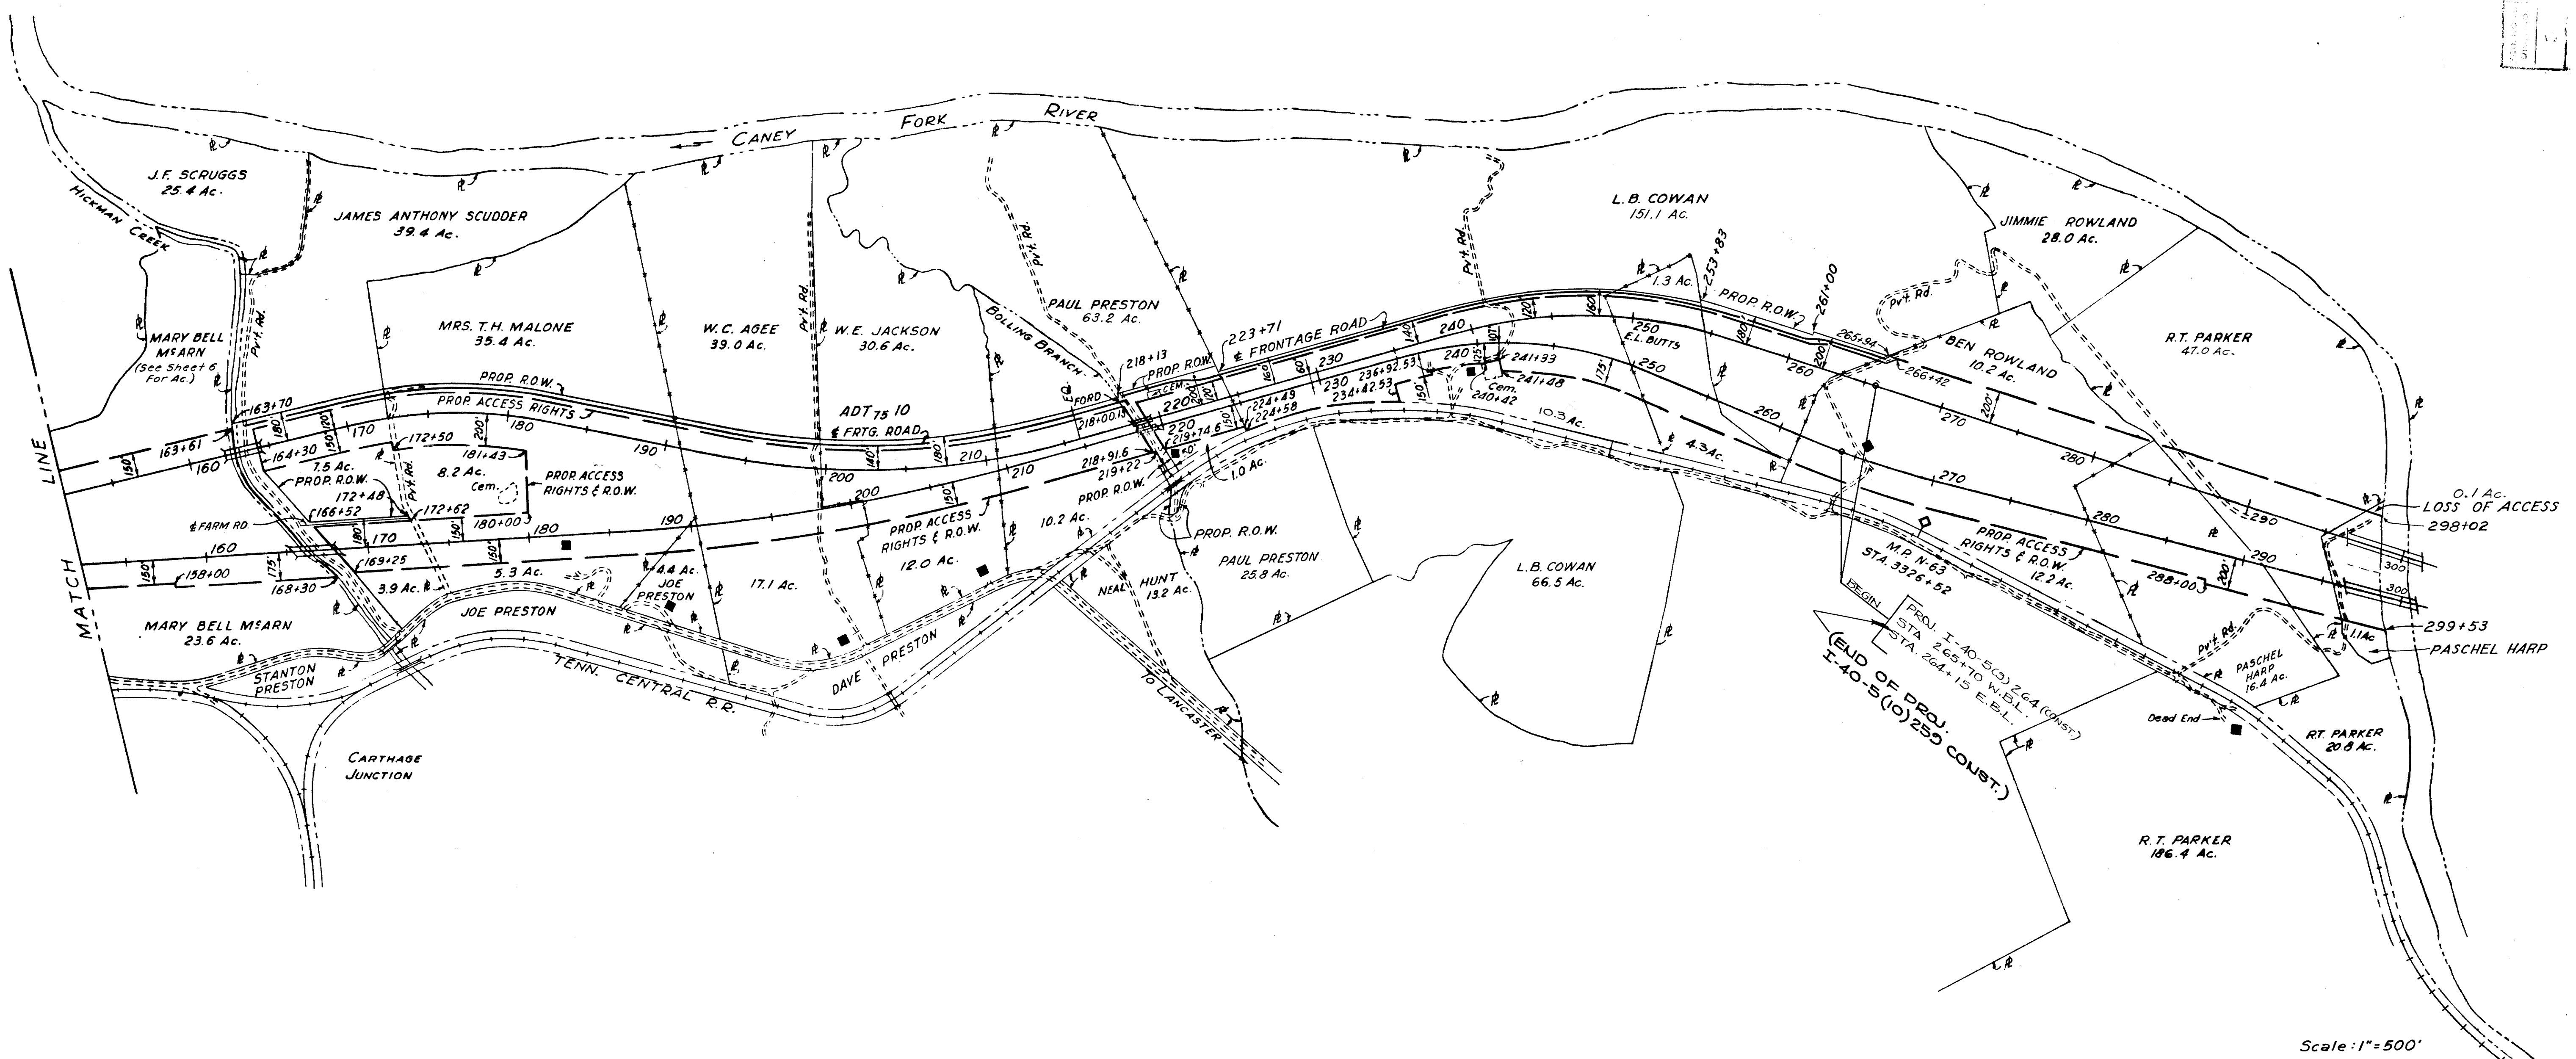

NOTE:
ACREAGES ON THIS SHEET ARE THOSE REMAINING
ON EITHER SIDE OF INTERSTATE R.O.W., SEE R.O.W.
SHEETS FOR ACREAGES TAKEN.

HOUSE = ■

MID-SOUTH ENGINEERING CO., INC.
820 BROADWAY, N. E. KNOXVILLE, TENNESSEE


PROPERTY LINE MAP
SMITH COUNTY
STA. 150+00 TO 300+00

STATE OF TENNESSEE
DEPARTMENT OF HIGHWAYS
AND PUBLIC WORKS
NASHVILLE

DR. J.L.M.	DATE 1-3-59
CHK'D ML5	4-15-59
APP'D	

FED. ROAD DIST. No.	TENN.	FEDERAL AID PROJECT No.	FISCAL YEAR	SHEET No.	TOTAL SHEETS
		I-40-5(5)259	1959	8	25
		R.O.W.			

REVISED 7-15-59: WATSON, LANCASTER & HELMS TRACTS REVISED, & HOUSES ADDED.
REV. 4-2-60: CORRECTED PROPERTY LINE OF SID PETTY AND MRS JOHN MOSS. ADDED PROPERTY OWNERS HOWARD MOSS AND JOEY RAY.

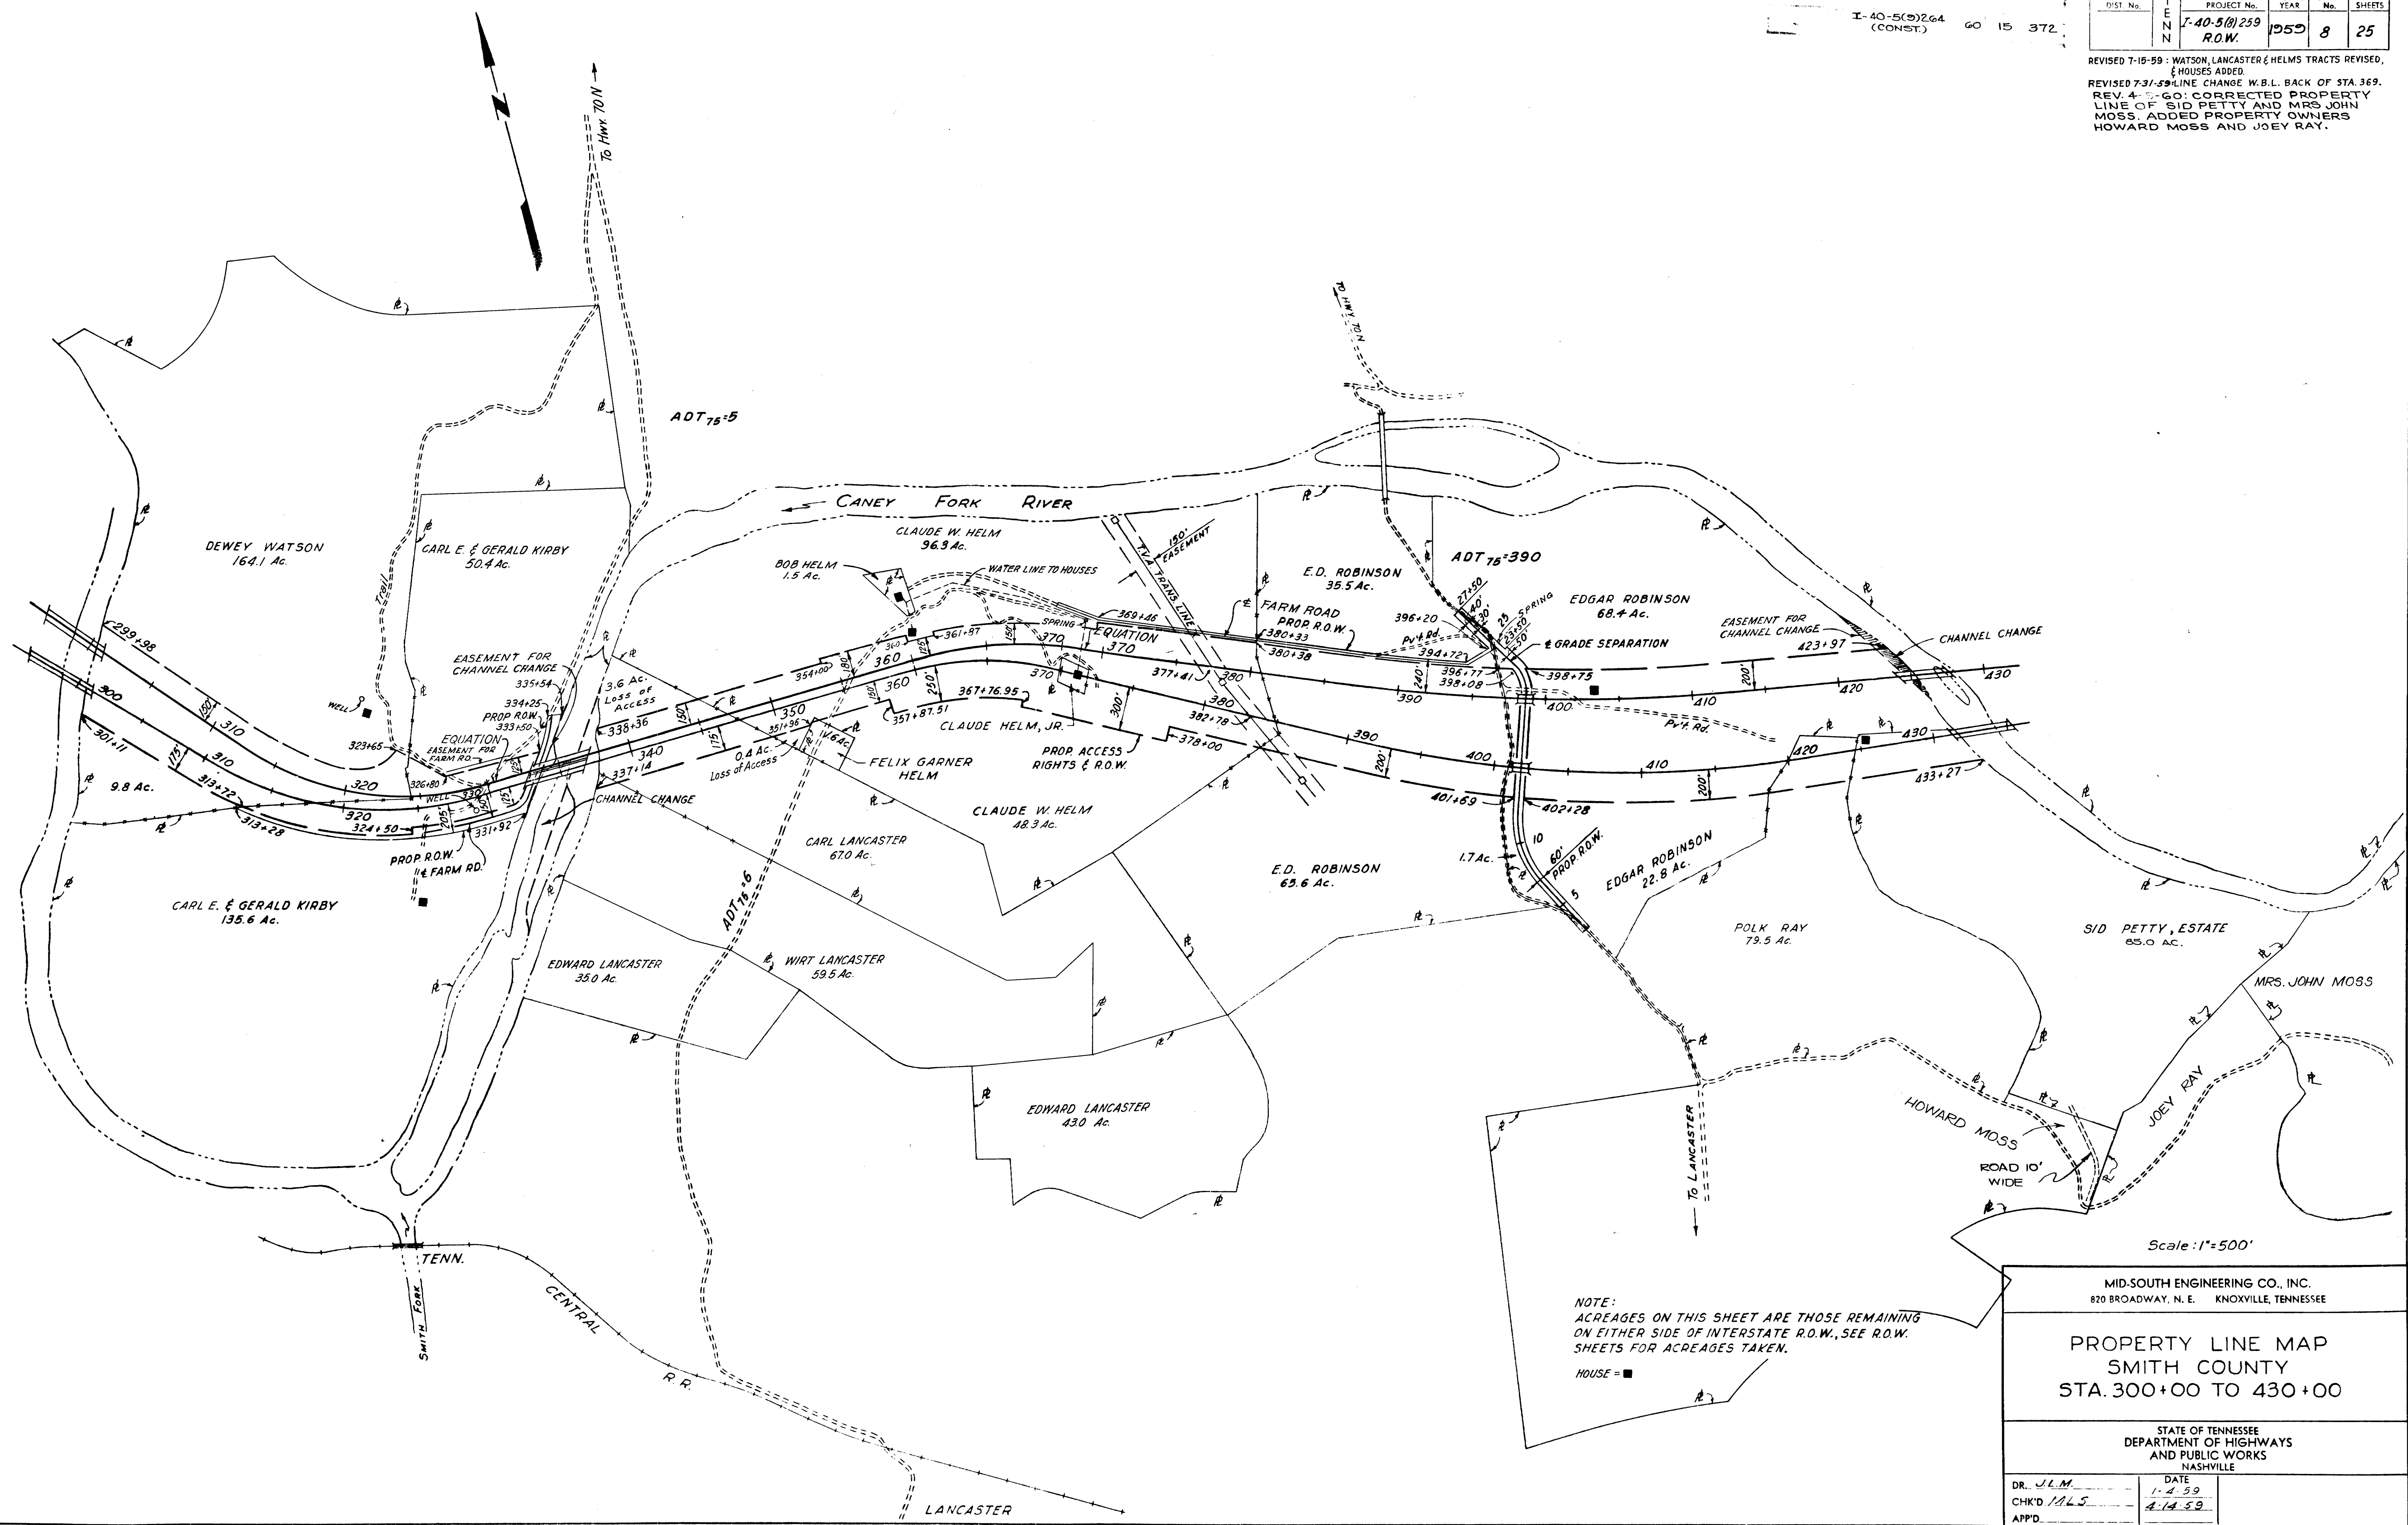

NOTE:
ACREAGES ON THIS SHEET ARE THOSE REMAINING
ON EITHER SIDE OF INTERSTATE R.O.W., SEE R.O.W.
SHEETS FOR ACREAGES TAKEN.
HOUSE = ■


MID-SOUTH ENGINEERING CO., INC.
820 BROADWAY, N. E. KNOXVILLE, TENNESSEE

PROPERTY LINE MAP
SMITH COUNTY
STA. 300+00 TO 430+00

STATE OF TENNESSEE
DEPARTMENT OF HIGHWAYS
AND PUBLIC WORKS
NASHVILLE

DR. J.L.M. DATE 1-4-59
CHK'D J.A.L.S. 4-14-59
APP'D

REVISED 7-15-59: HOUSES & PROPOSED REST AREAS ADDED.
REV. 4-8-60: CORRECTED PROPERTY LINES OF SID PETTY AND MRS. JOHN MOSS, ADDED PROPERTY OWNERS HOWARD MOSS AND JOEY RAY.

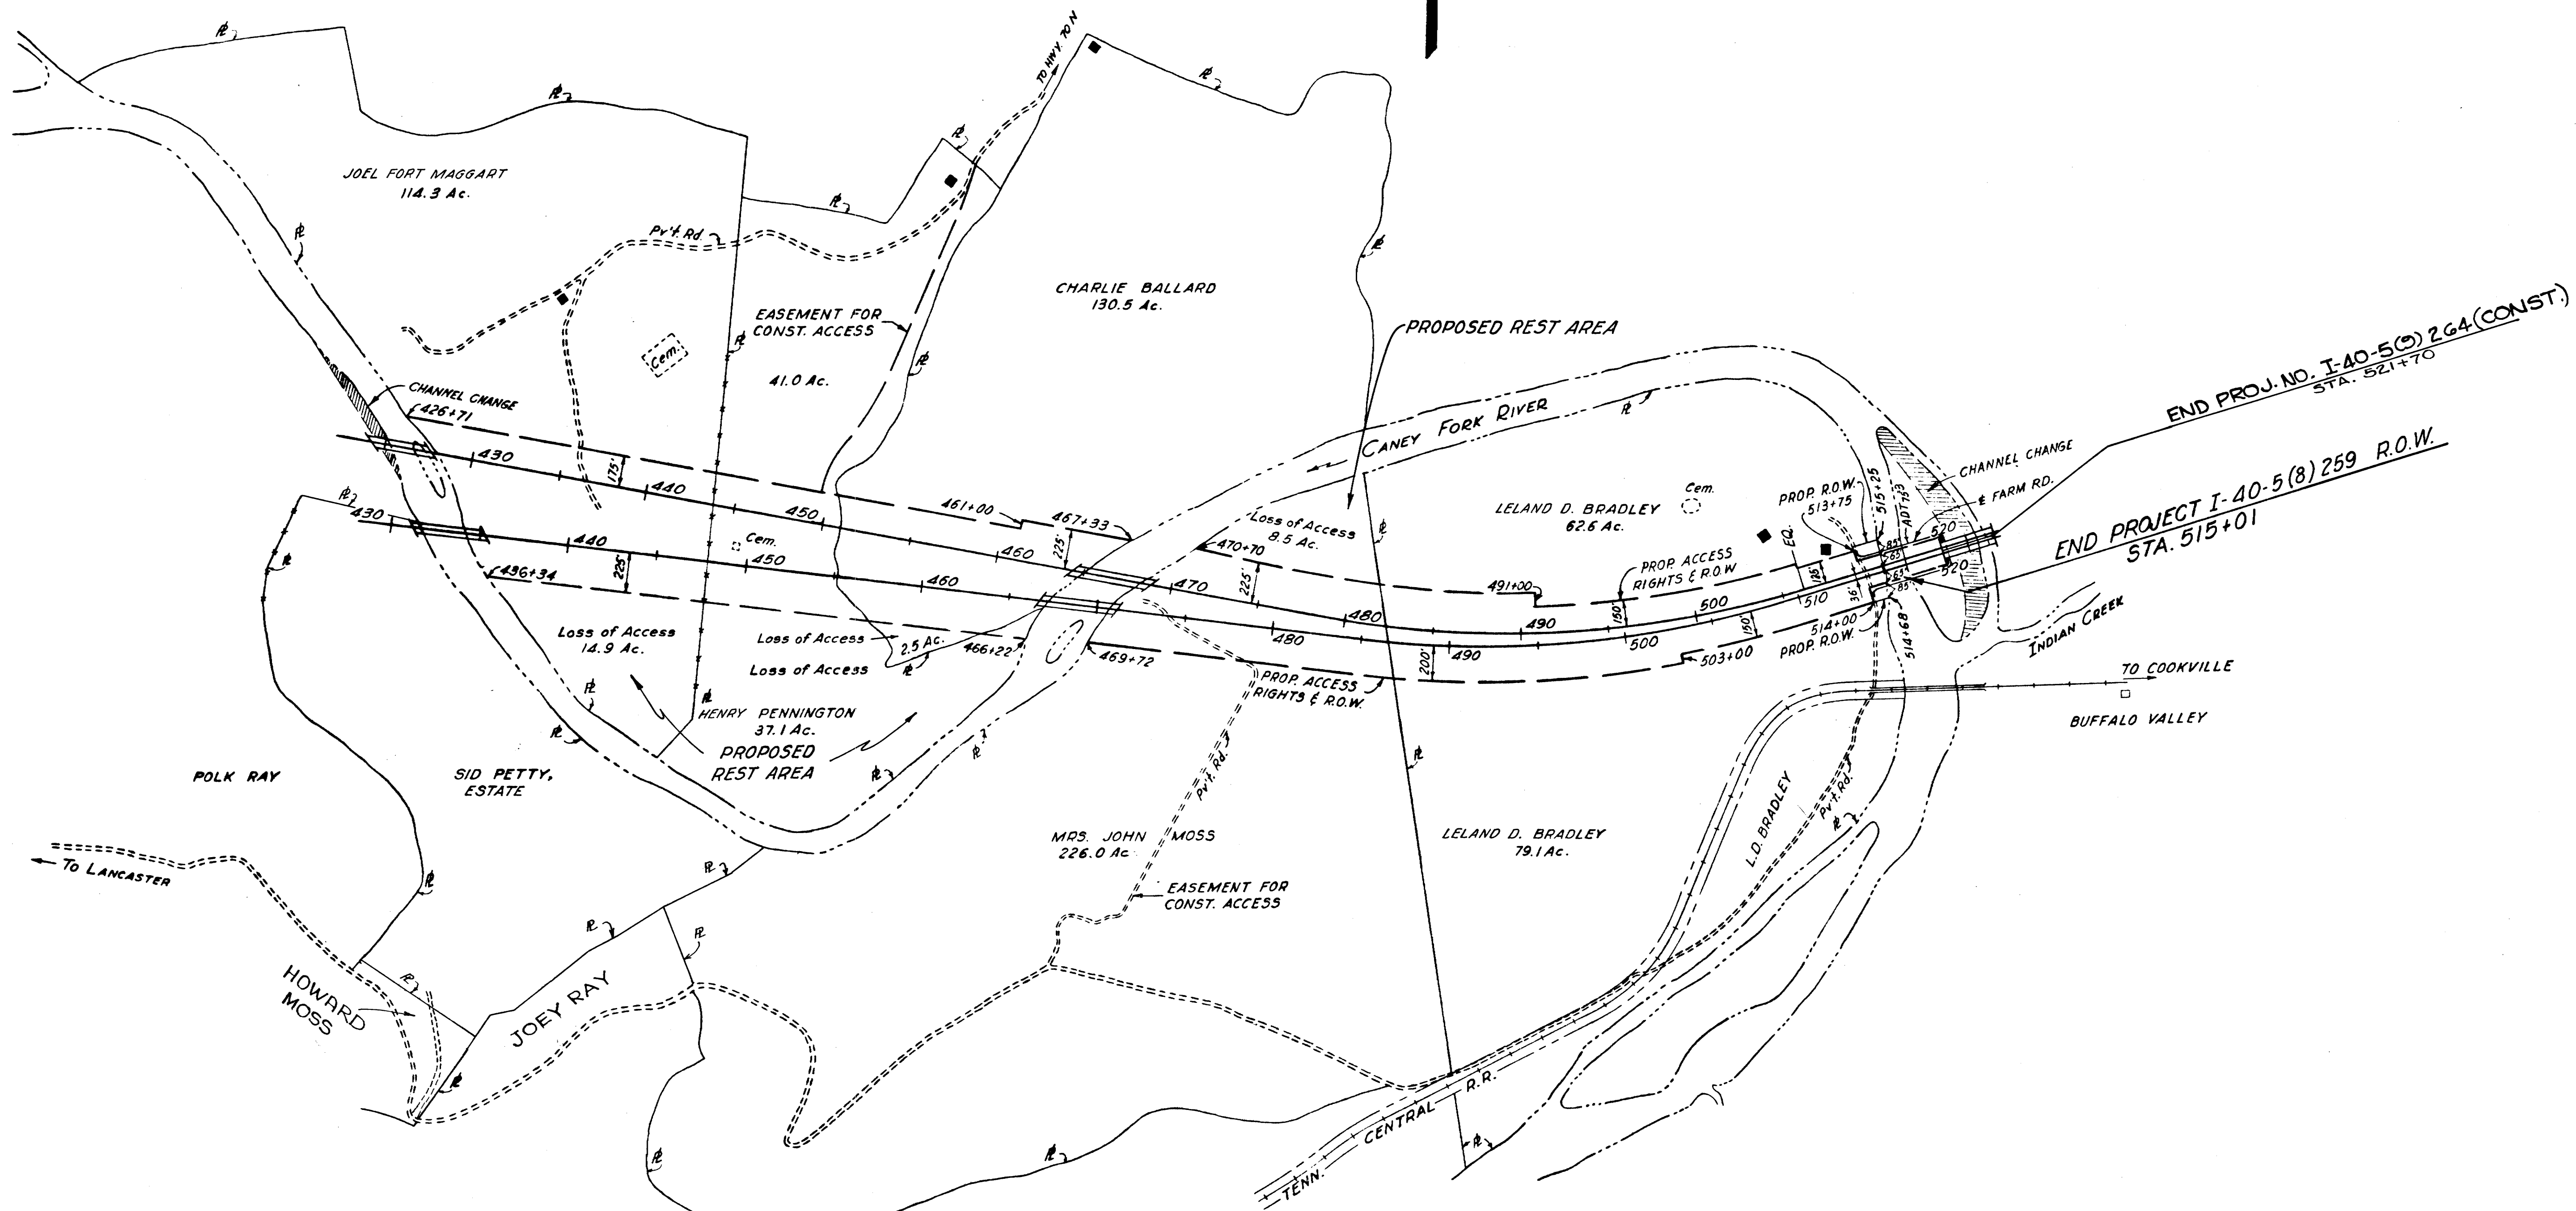

NOTE:
ACREAGES ON THIS SHEET ARE THOSE REMAINING
ON EITHER SIDE OF INTERSTATE R.O.W., SEE R.O.W.
SHEETS FOR ACREAGES TAKEN.

HOUSE = ■

Scale: 1" = 500'


MID-SOUTH ENGINEERING CO., INC. 820 BROADWAY, N. E. KNOXVILLE, TENNESSEE	
PROPERTY LINE MAP SMITH COUNTY STA. 430+00 TO 515+00	
STATE OF TENNESSEE DEPARTMENT OF HIGHWAYS AND PUBLIC WORKS NASHVILLE	
DR. J.L.M. CHK'D M.L.S. APP'D.	DATE 1-5-59 4-5-59

FED. ROAD DIST. NO.	3	1-40-5(10)259	GO	17	372
CONST.					

FED. ROAD DIST. NO.	FED. AID PROJECT NO.	FISCAL YEAR	SHEET NO.	TOTAL SHEETS
3	1-40-5(10)259	1959	17	25
R.O.W.				

REVISED 7-15-59: FRONTAGE ROAD ADDED.
REVISED 7-31-59: LINE CHANGE W.B.L. AHEAD OF STA. 282.
REVISED 10-4-60: CORRECTED PROPERTY OWNER'S NAME ON TRACT NO. 28

DATE	1-13-59
CHK'D	M.L.S.
APP'D.	

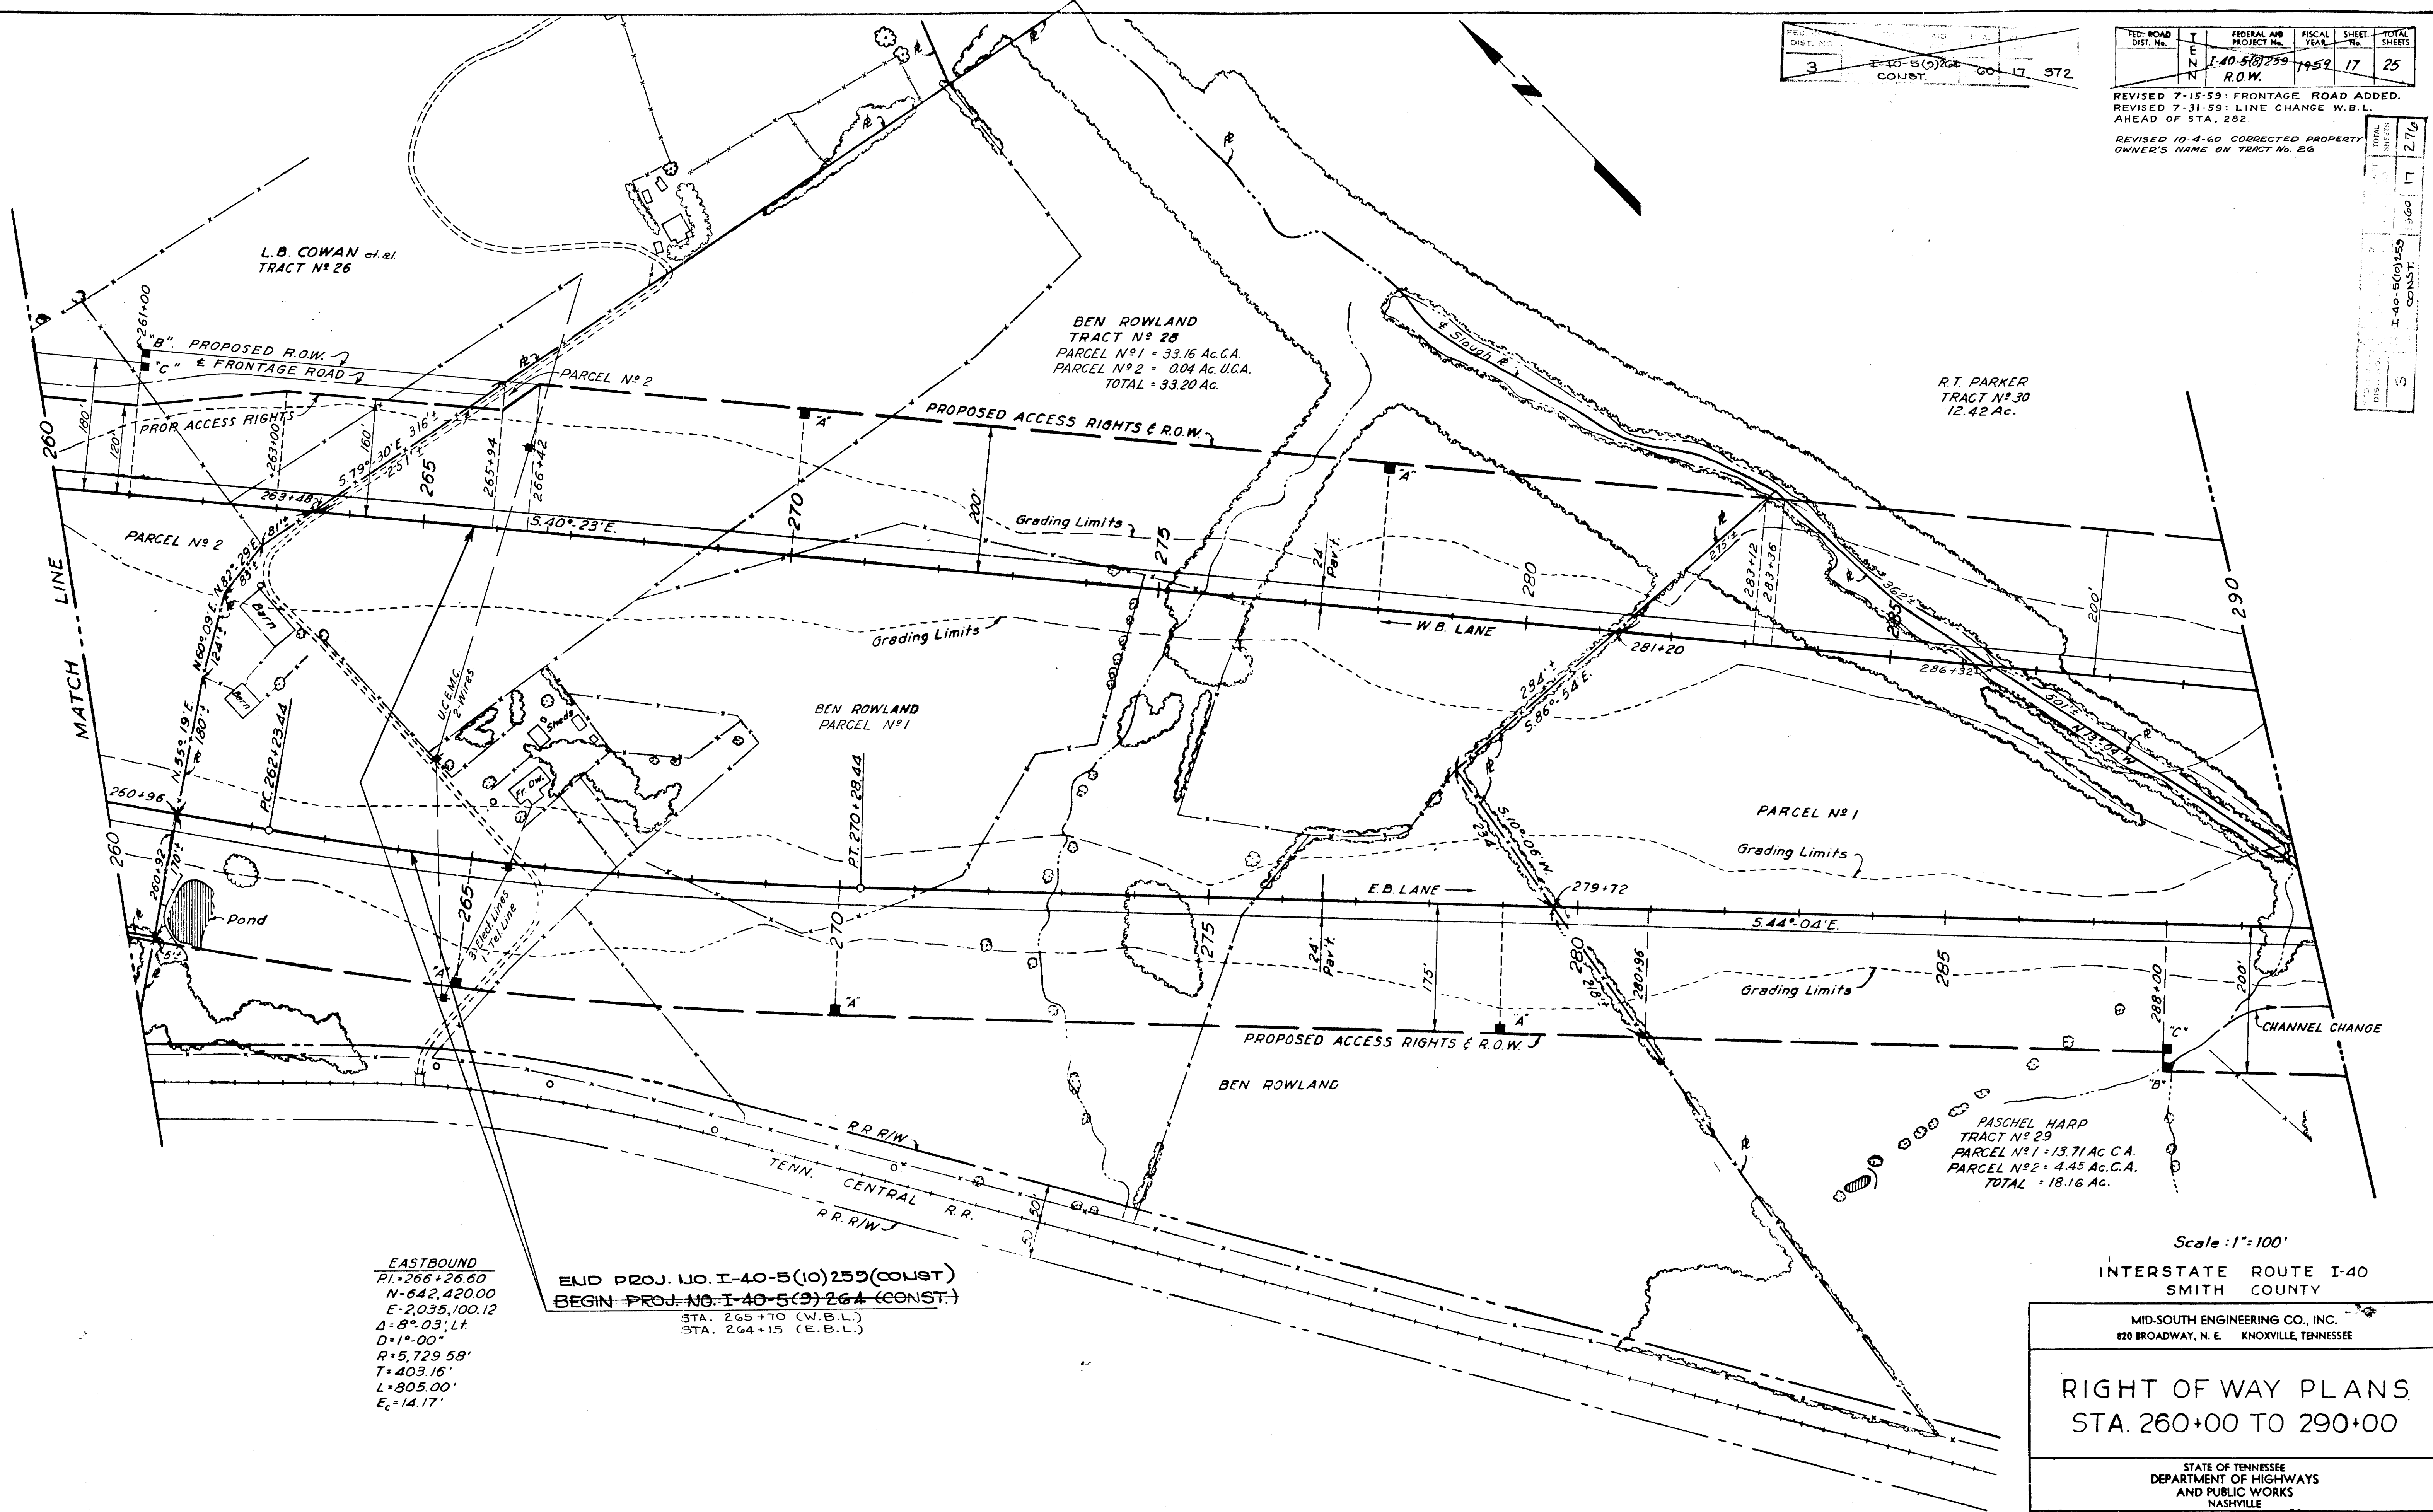

EASTBOUND
PI+266+26.60
N=642,420.00
E=2,035,100.12
Δ=8°03' Lt.
D=1°00'
R=5,729.58'
T=403.16'
L=805.00'
E_c=14.17'

END PROJ. NO. I-40-5(10)259 (CONST.)
BEGIN PROJ. NO. I-40-5(9)264 (CONST.)
STA. 265+70 (W.B.L.)
STA. 264+15 (E.B.L.)

Scale: 1"=100'

INTERSTATE ROUTE I-40
SMITH COUNTY

MID-SOUTH ENGINEERING CO., INC.
820 BROADWAY, N. E. KNOXVILLE, TENNESSEE

RIGHT OF WAY PLANS
STA. 260+00 TO 290+00

STATE OF TENNESSEE
DEPARTMENT OF HIGHWAYS
AND PUBLIC WORKS
NASHVILLE

DR.	J.L.M.	DATE	1-13-59
CHK'D	M.L.S.		4-13-59
APP'D.			

TENN. STATE HIGHWAYS	
Plans	File
Drawn	No. 50



PLAN	SURVEYED PLOTTED CHECKED BY	DATE

PROFILE	SURVEYED PLOTTED CHECKED BY	DATE

EASTBOUND
 PI=266+26.60
 N=642,420.00
 E=2,035,100.12
 Δ=8°03' Lt.
 D=1°00'
 R=5,729.58'
 T=403.16'
 L=805.00'
 E_c=14.17'
 S.E.=0.0322 ft./ft.

MID-SOUTH ENGINEERING CO.				
FED. ROAD DIST.	T E N	FEDERAL AID PROJECT No.	FISCAL YEAR	TOTAL SHEETS
		140-5(8)259	1959	25
		R.O.W.	17A	

SHEET NO.	17-A
TOTAL SHEETS	25
PROJECT NO.	140-5(8)259
CONTRACT	140-5(8)259
DATE	3

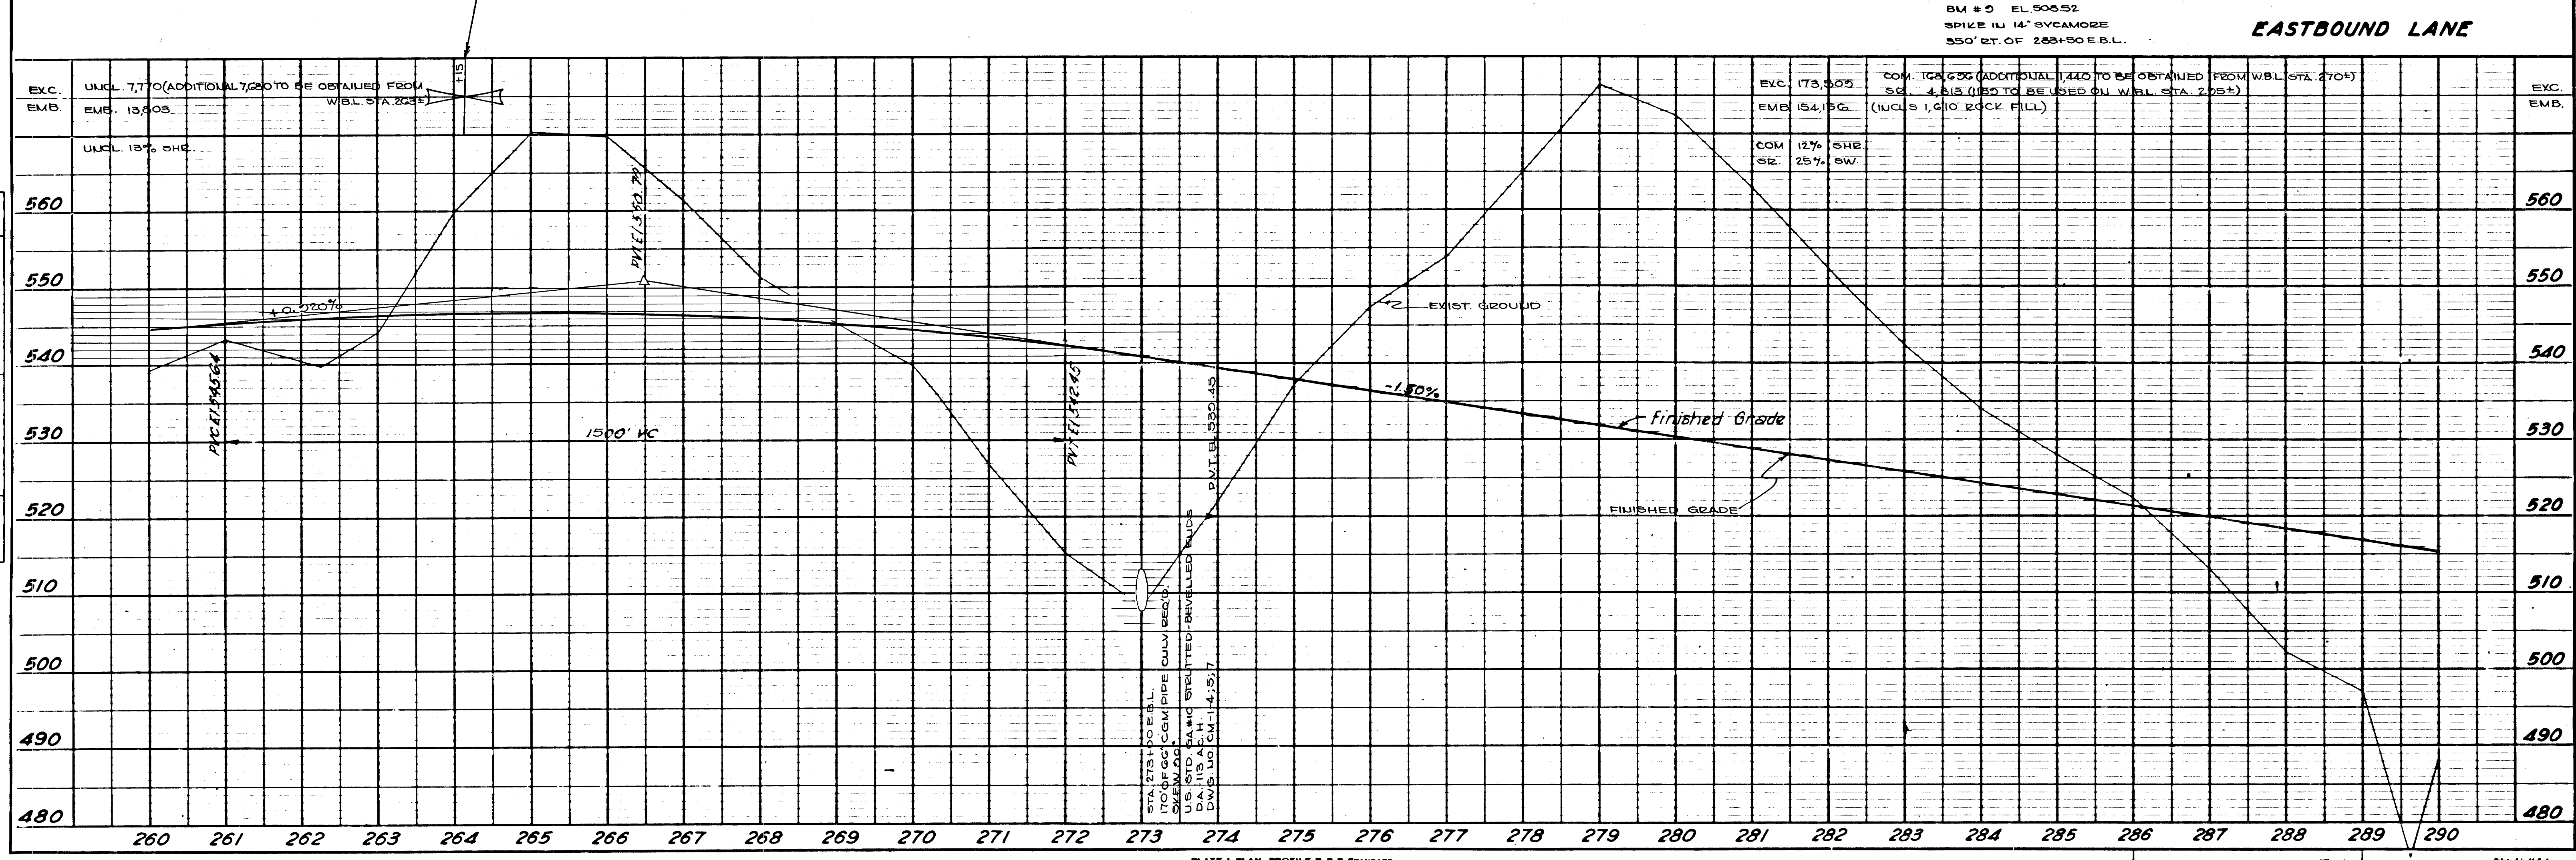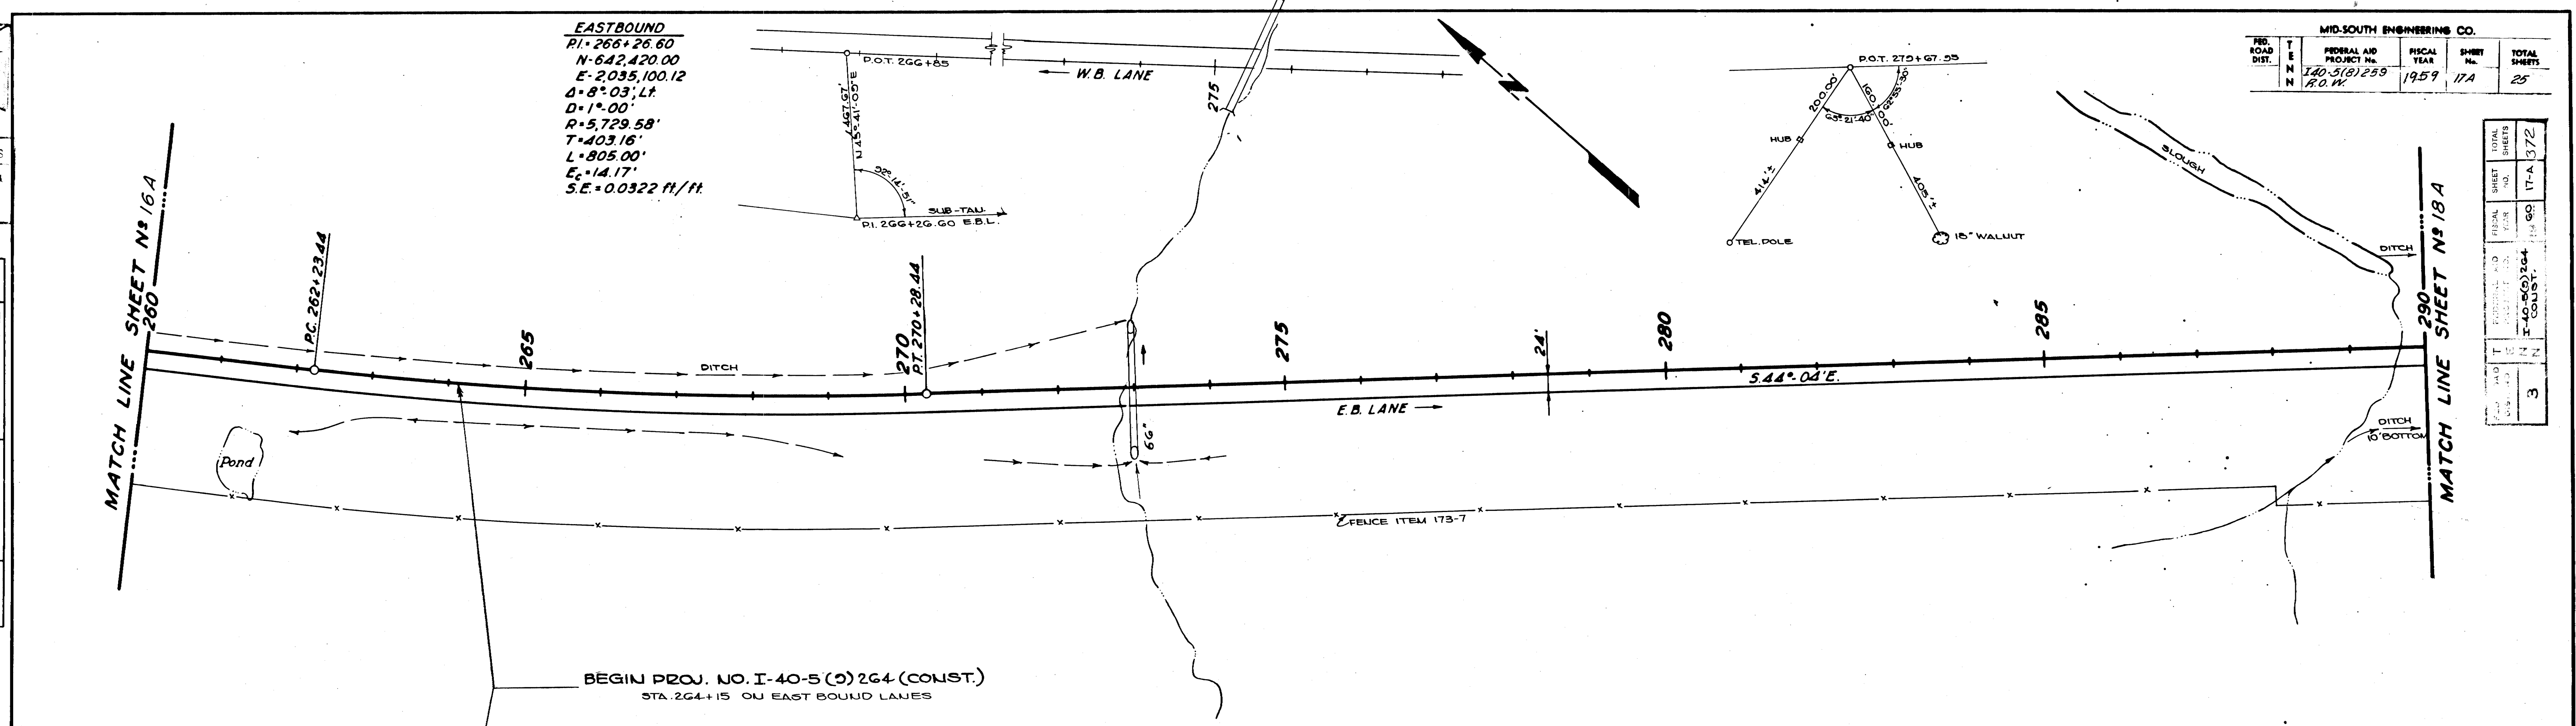

TENN. STATE HIGHWAYS	
File	17-B
Divn.	No. 50



PLAN	DATE
BY	
CHECKED	
APPROVED	

PROFILE	DATE
BY	
CHECKED	
APPROVED	

MID-SOUTH ENGINEERING CO.				
PROJ. ROAD DIST.	T E N N	FEDERAL AID PROJECT No.	FISCAL YEAR	TOTAL SHEETS
I-40-5(8)259		1959	178	25
R.O.W.				

REVISED 7-15-59: FRONTAGE ROAD ADDED.
REVISED 7-31-59: LINE CHANGE AHEAD OF STA. 282

TOTAL SHEETS	25
THIS SHEET	17-B
PROJECT NO.	I-40-5(8)259
DATE	7-31-59
BY	3
CHECKED	
APPROVED	

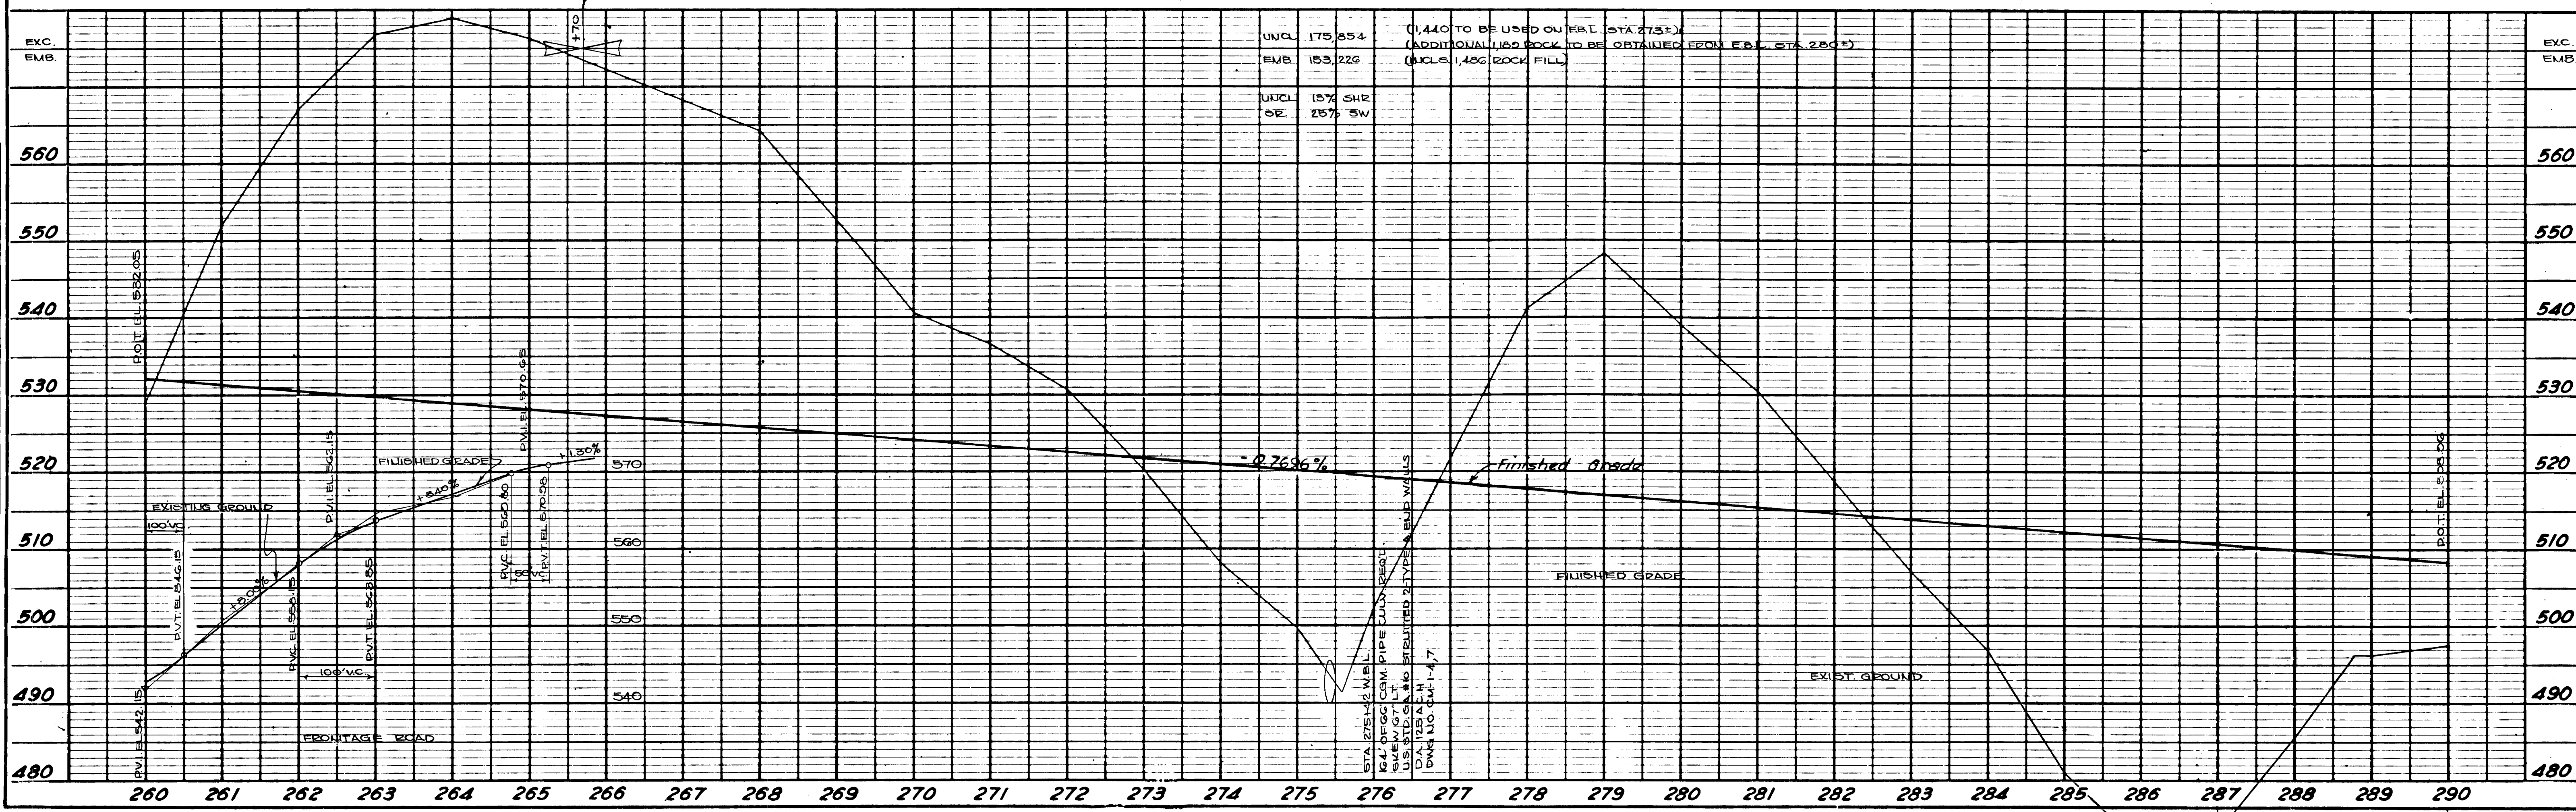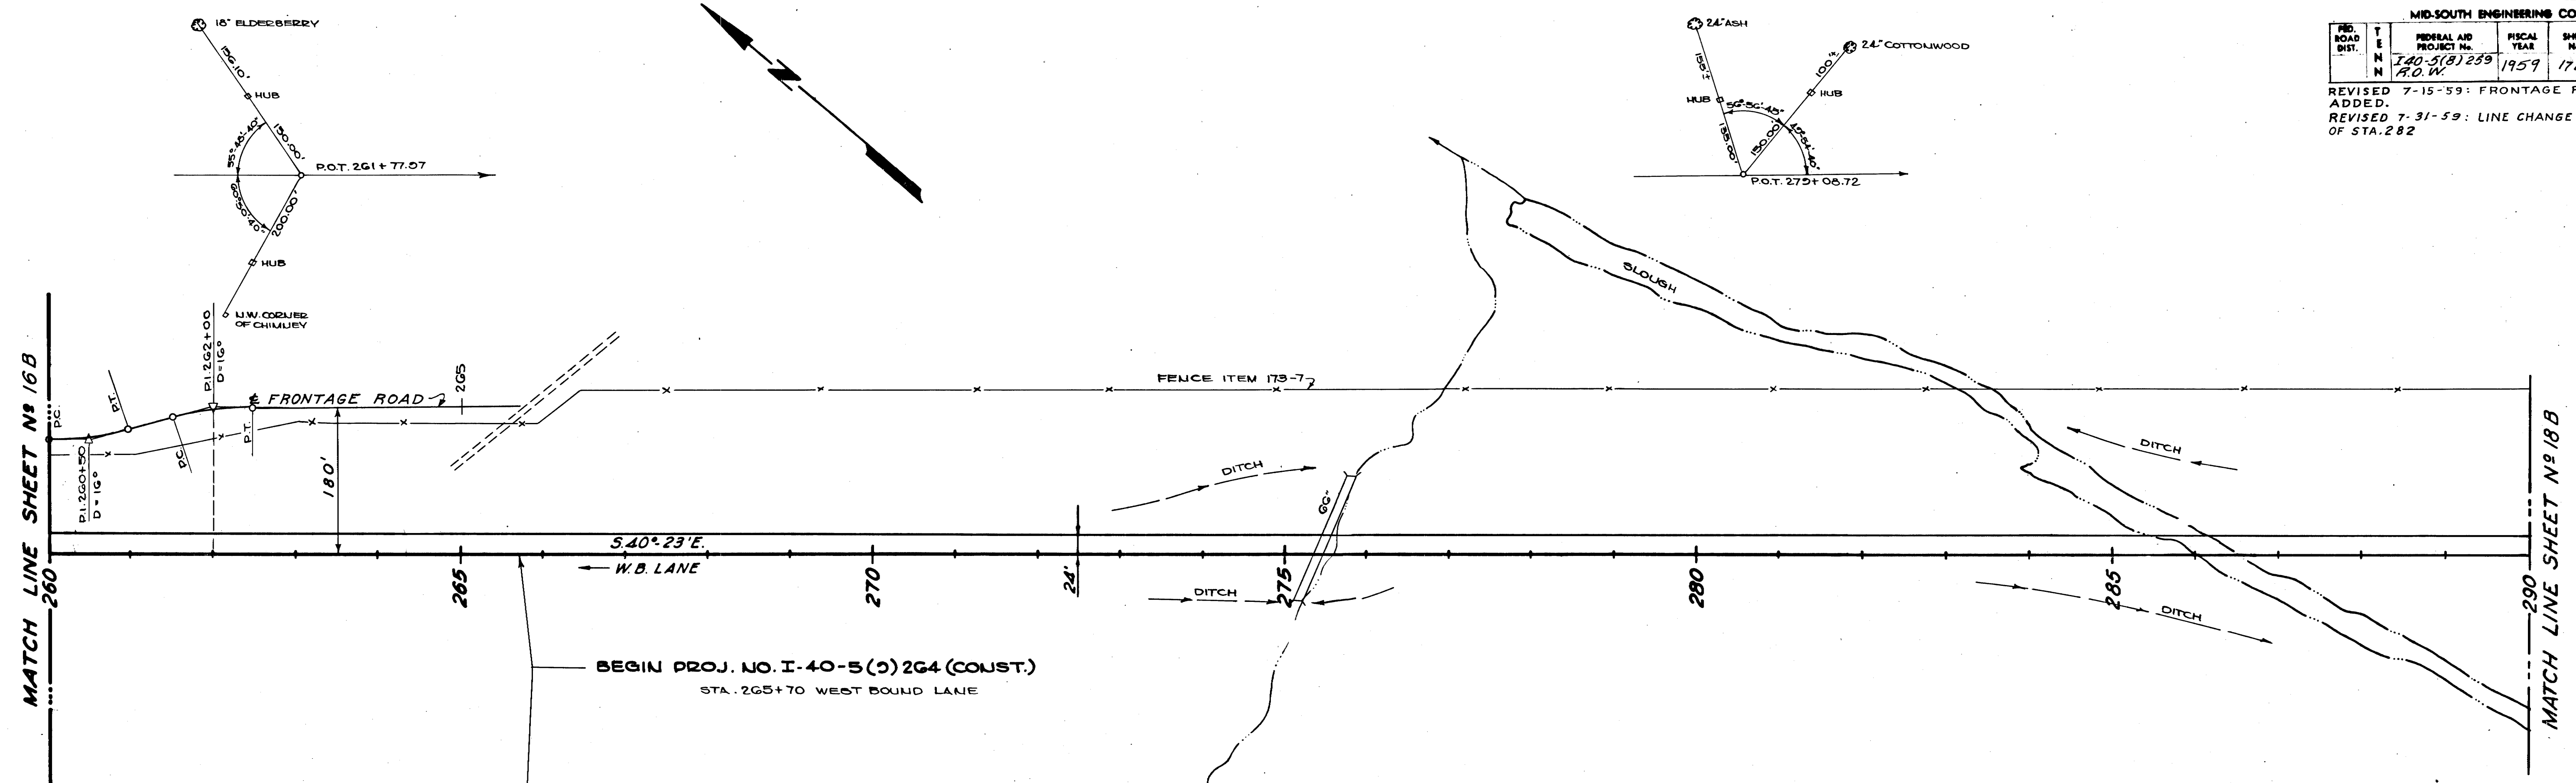


WESTBOUND
 PI=321+48.23
 N-638,596.69
 E-2,038,962.77
 $\Delta = 50^\circ 34'$, Lt.
 $\Delta_c = 41^\circ 34'$, Lt.
 $D = 3^\circ 00'$
 $R = 1,909.86'$
 $L_c = 1,385.56'$
 $T_s = 1,052.08'$
 $L_s = 300'$
 $Q_1 = 4^\circ 30'$
 $K = 149.97'$
 $P = 1.96'$
 $X_c = 299.81'$
 $Y_c = 7.85'$
 $E_s = 204.50'$

DIST. NO.	SECTION	FED. AID PROJECT NO.	FISCAL YEAR	SHEET NO.	TOTAL SHEETS
3	N	I-40-5(3)264	60	18	372

FED. ROAD DIST. NO.	SECTION	FED. AID PROJECT NO.	FISCAL YEAR	SHEET NO.	TOTAL SHEETS
3	N	I-40-5(3)259	1959	18	25

REVISED 7-31-59: LINE CHANGE W.B.L.
 REV. 12-11-59: CORRECTED CURVE DATA.

DEWEY WATSON
 TRACT N° 31
 24.00 AC. C.A.

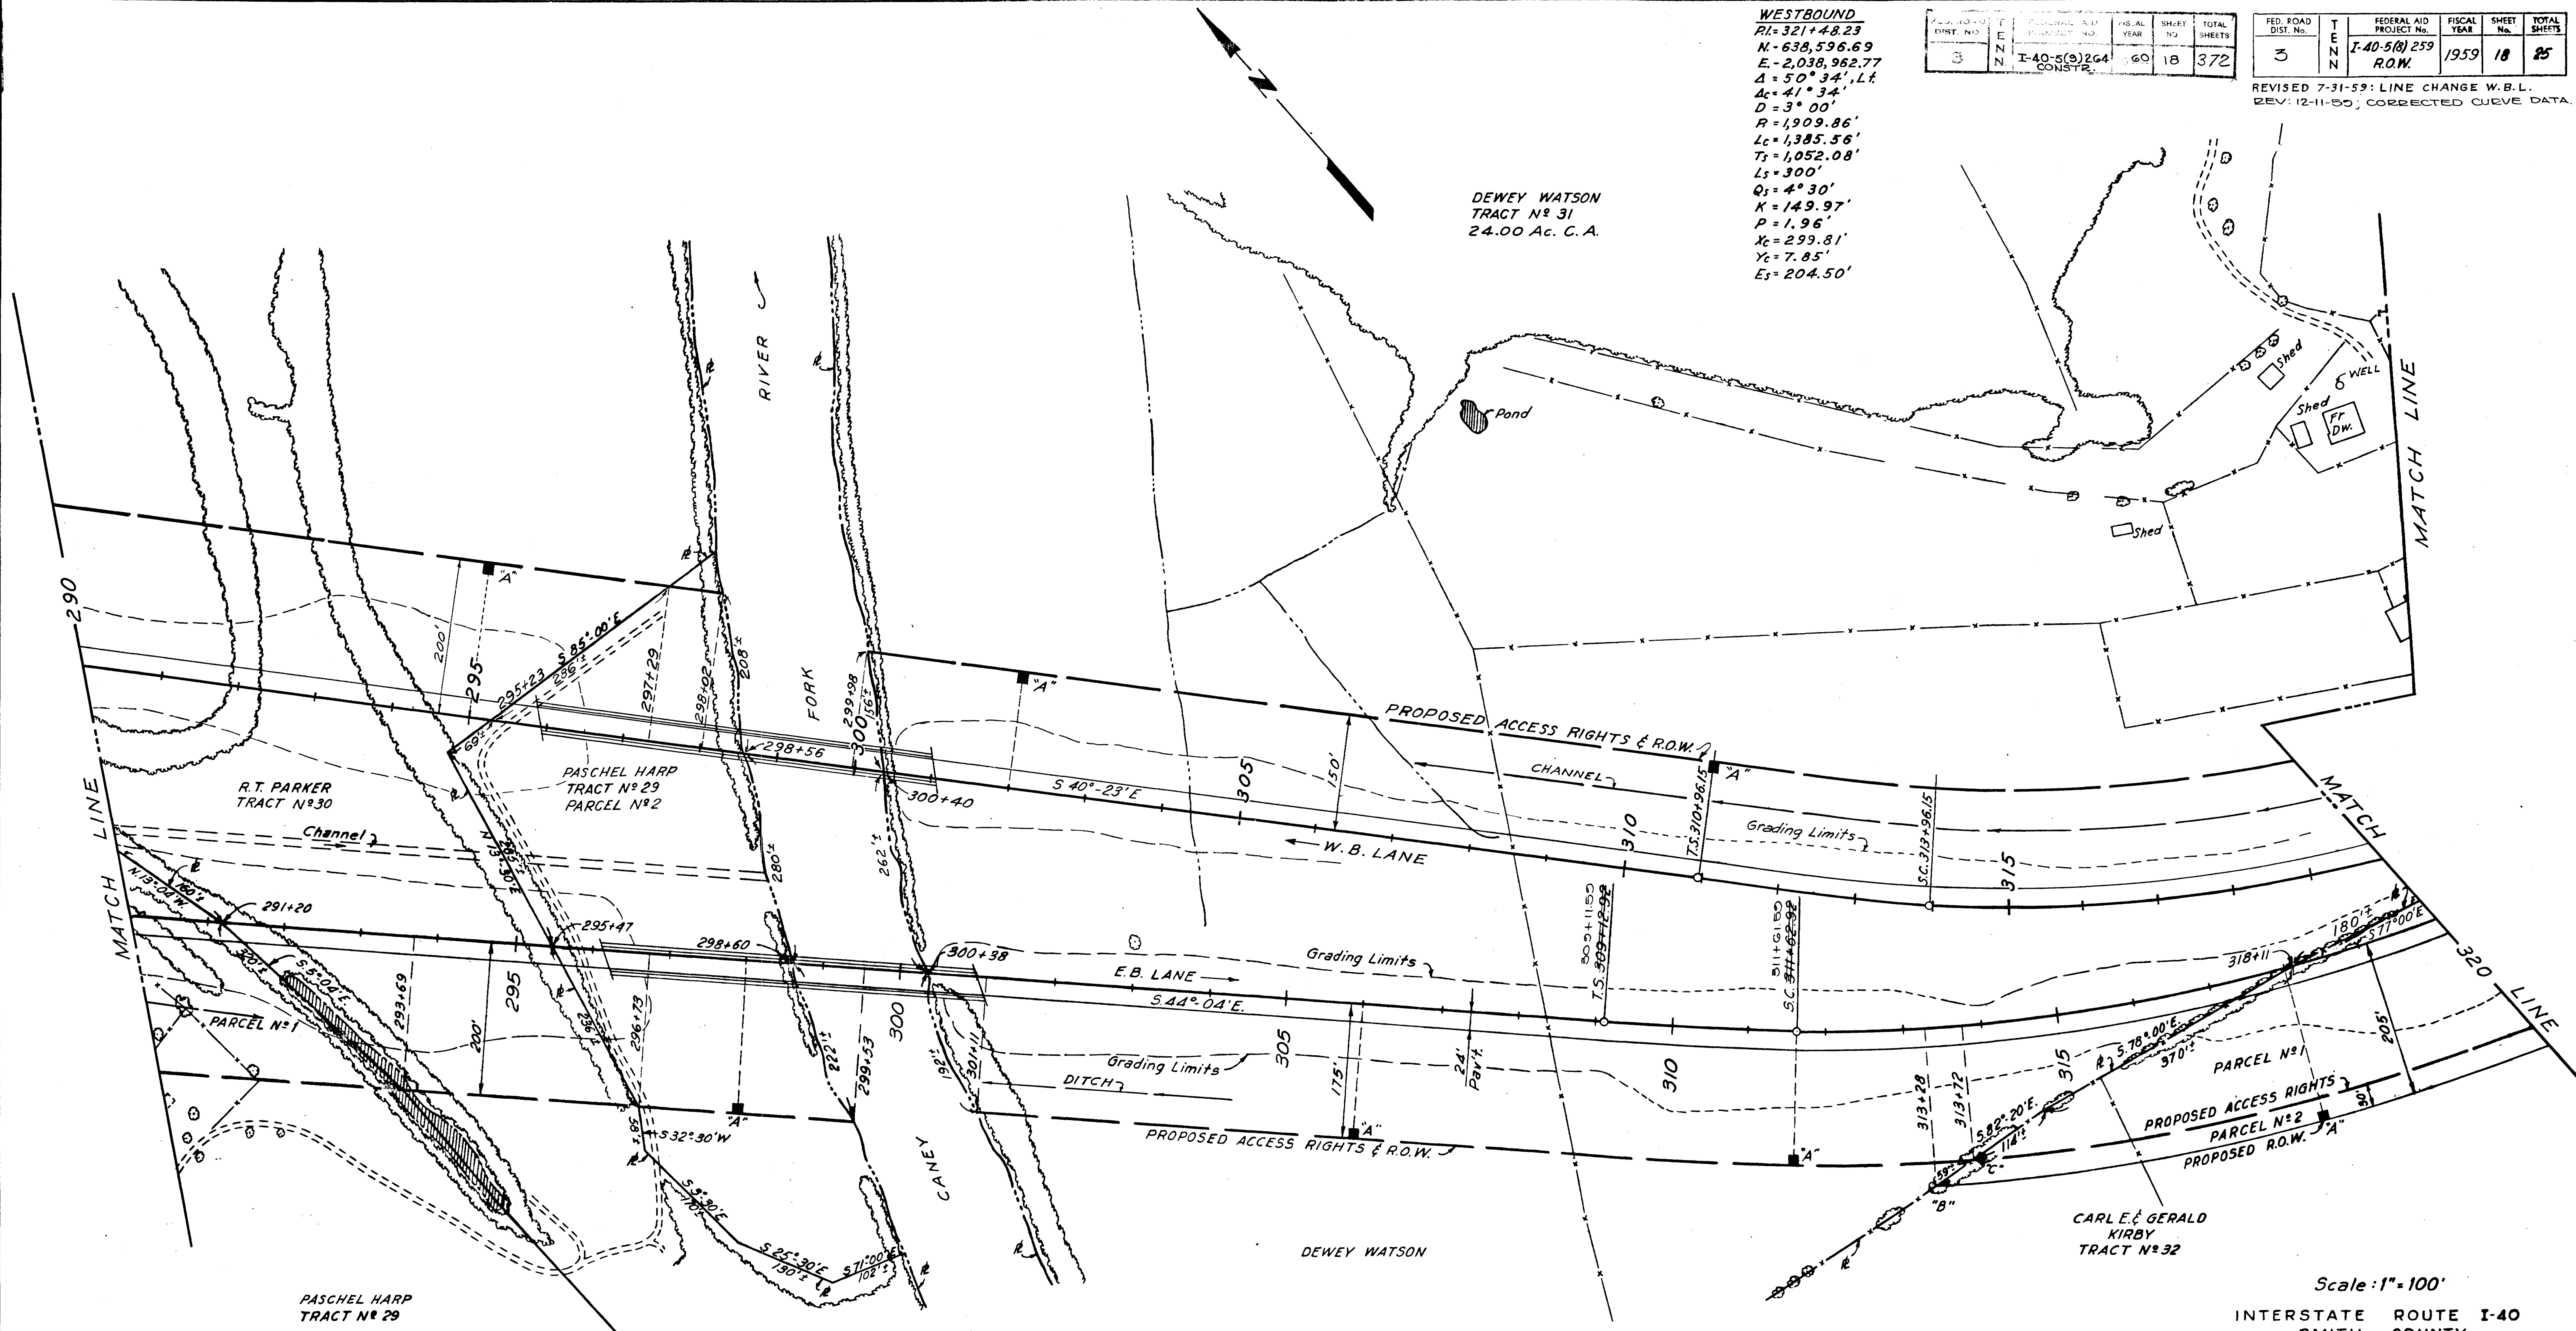

Scale: 1"=100'

INTERSTATE ROUTE I-40
 SMITH COUNTY

MID-SOUTH ENGINEERING CO., INC.
 820 BROADWAY, N. E. KNOXVILLE, TENNESSEE

RIGHT OF WAY PLANS
 STA. 290+00 TO 320+00

STATE OF TENNESSEE
 DEPARTMENT OF HIGHWAYS
 AND PUBLIC WORKS
 NASHVILLE

DR. J.L.M.
 CHK'D M.L.S.
 APP'D

DATE
 1-14-59
 4-14-59

EASTBOUND
 PI=320+52.14
 N-638,535.00
 E-2,038,860.56
 $\Delta = 46^\circ 53'$, Lt.
 $\Delta_c = 40^\circ 38'$
 $D = 2^\circ 30'$
 $R = 2,291.83'$
 $L_c = 1,623.33'$
 $T_s = 1,119.22'$
 $L_s = 250'$
 $Q_2 = 3^\circ 07' 30''$
 $K = 124.99'$
 $P = 1.13'$
 $X_c = 249.93'$
 $Y_c = 4.54'$
 $E_s = 207.40'$

PROJECT NO.	YEAR	SHEET NO.
IME-40-5(91)257	1989	17


EASTBOUND
 $PI=320+33.11$ 30.81
 $N=638,535.00$
 $E=2038,860.56$
 $\Delta=46^{\circ}53'11''$
 $\Delta_c=40^{\circ}38'$
 $D=2^{\circ}30'$
 $R=2,291.83'$
 $L_c=1,625.33'$
 $T_s=1,119.22'$
 $L_s=250'$
 $\theta_s=3^{\circ}07'30''$
 $k=124.99'$
 $p=1.13'$
 $x_c=249.93'$
 $y_c=4.54'$
 $E_s=207.40'$
 $SE=0.0806$ ft/ft.

FED. ROAD DIST. NO.	FED. AID PROJECT NO.	ESTAL YEAR	SHEET NO.	ESTAL PROJECTS
3	IME-40-5(34)259	1970	21	57


TYPE	YEAR	PROJECT NO.	SHEET #
RESURF	1999	IME-40-5(115)259	17

FED. ROAD DIST. NO.	FED. AID PROJECT NO.	ESTAL YEAR	SHEET NO.	ESTAL PROJECTS
3	IME-40-5(34)259	1970	21	57

TYPE	YEAR	PROJECT NO.	SHEET #
RESURF	1999	IME-40-5(115)259	17

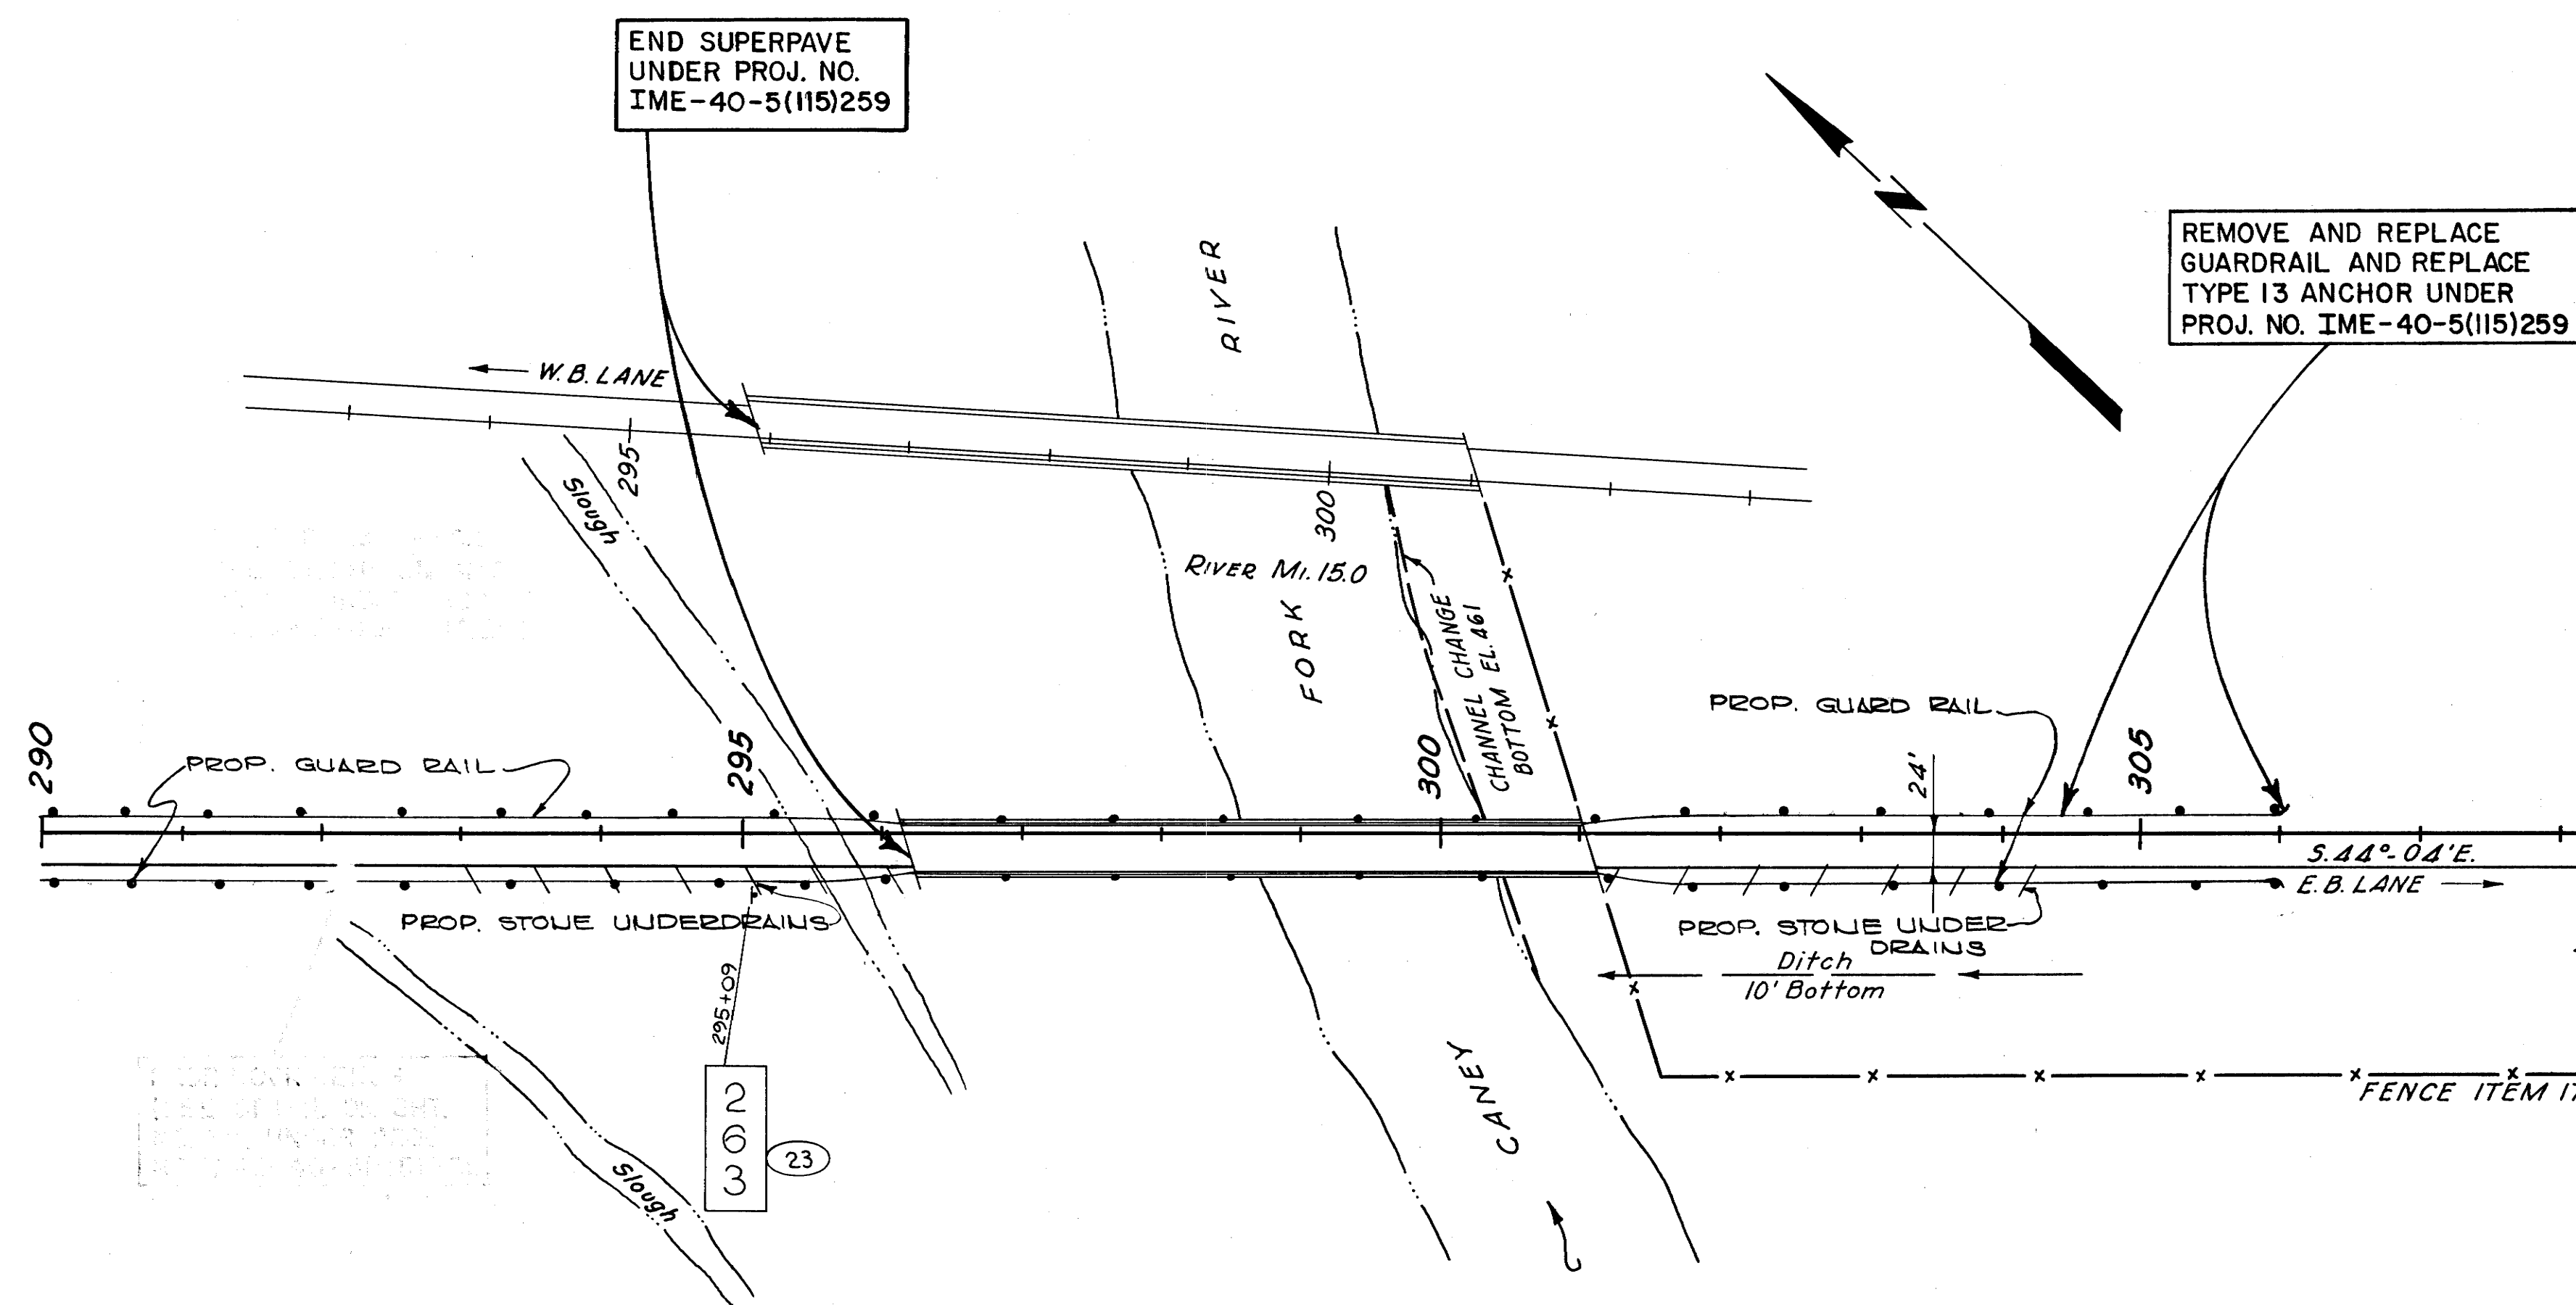

REV 2-25-99: DELETED BLOCK FOR PROPOSED ROCK BENCH.

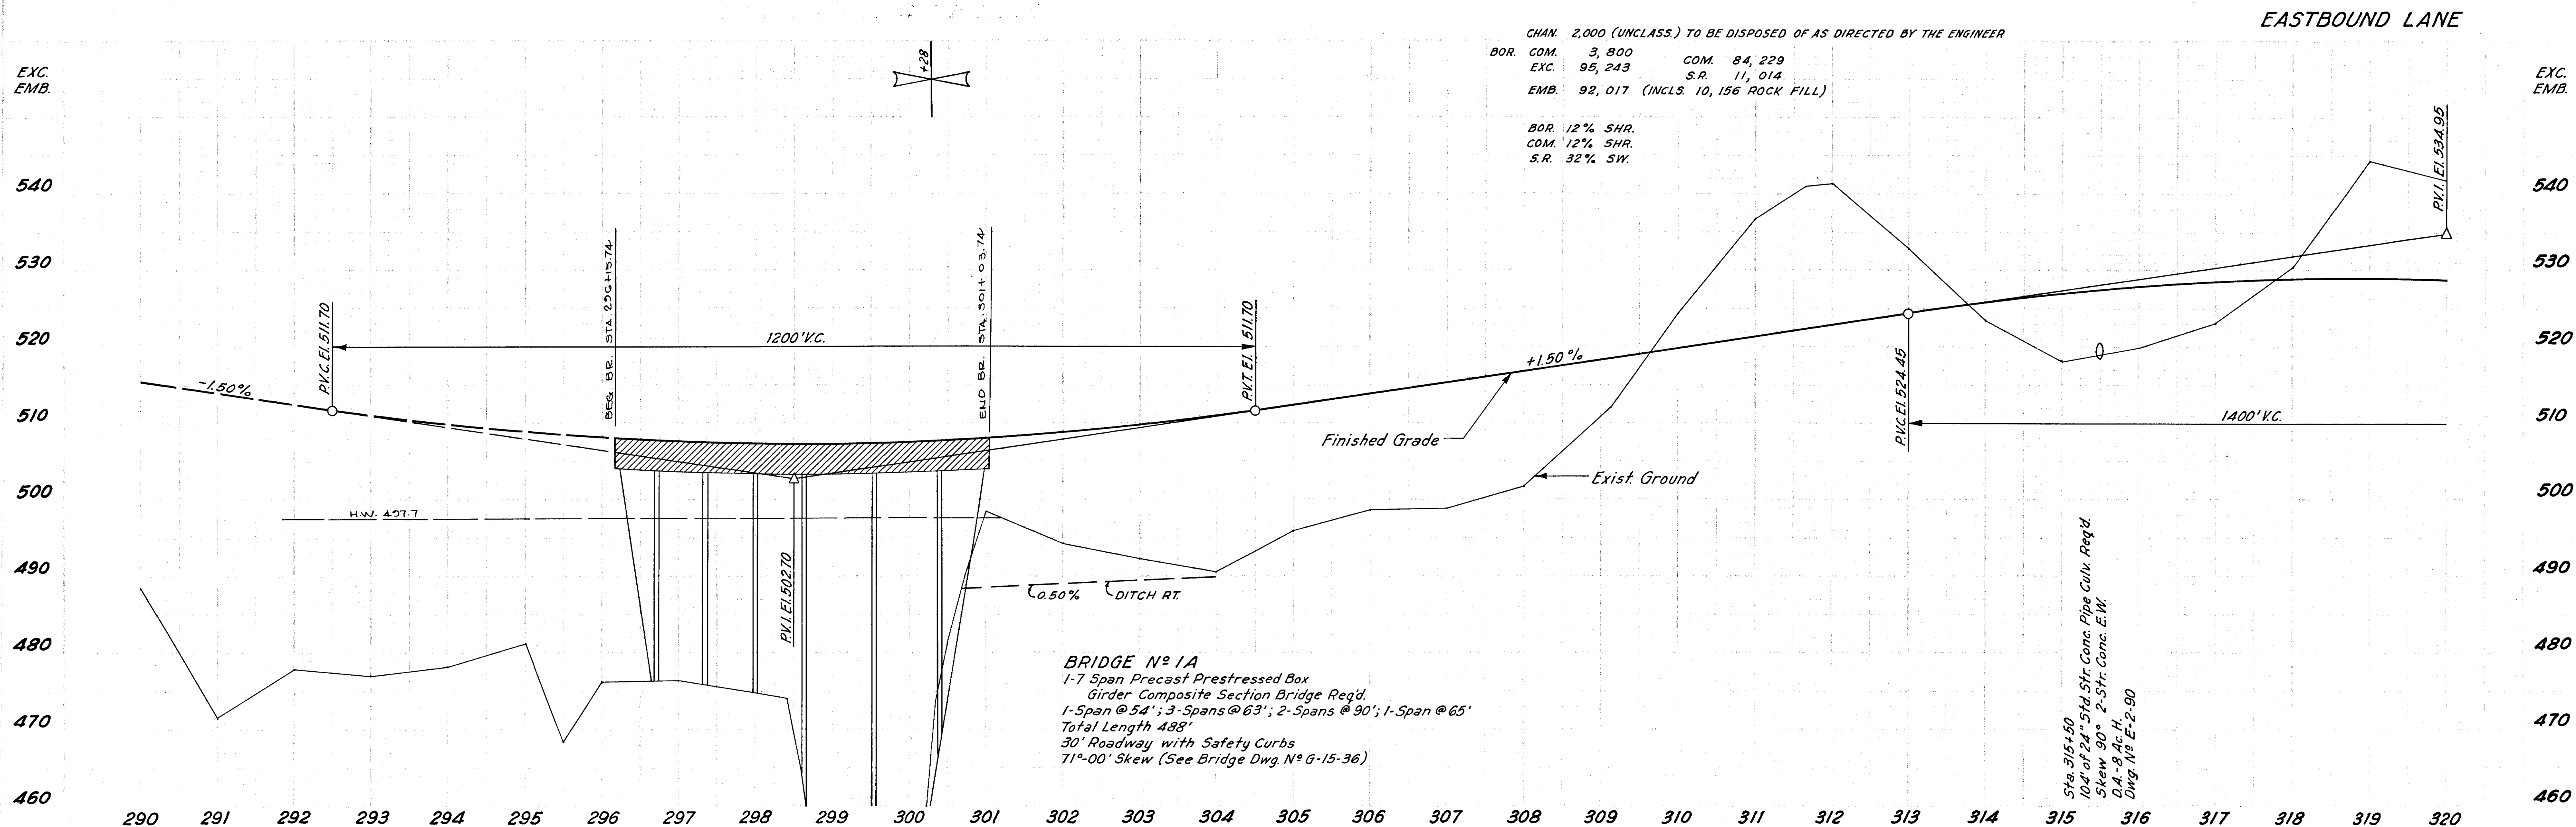


CHAN. 2,000 (UNCLASS.) TO BE DISPOSED OF AS DIRECTED BY THE ENGINEER

BOR. COM.	3,800	COM.	84,229
EXC.	95,243	S.R.	11,014
EMB.	92,017	(INCL. 10,156 ROCK FILL)	

BOR.	12% SHR.
COM.	12% SHR.
S.R.	32% SW.

Sta. 315+50
 104' of 24" Std. Str. Conc. Pipe Culv. Req'd.
 Skew 90° 2-Str. Conc. E.W.
 D.A.-B Ac. H.
 Dwg. N° E-2-90

PROP. TYPE 38
ANCHORS
UNDER PROJ. No.
IME-40-5(115)259

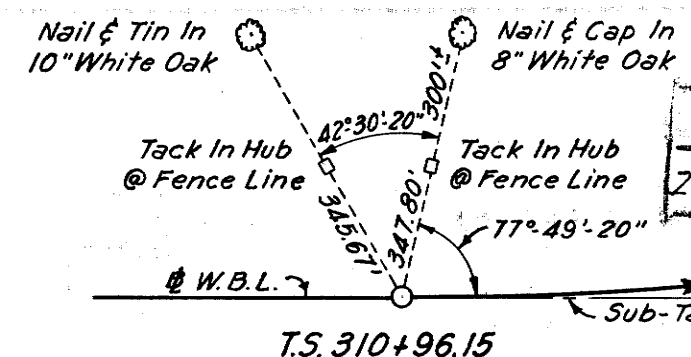


TYPE	YEAR	PROJECT NO.	SHEET #
RESURF	1999	IME-40-5(115)259	18

WESTBOUND
 PI-321+48.23
 W-638,596.69
 E-2,038,962.77
 Δ=50°34'11"
 Δ_c=41°34'
 D=3°00'
 R=1,909.86'
 L_c=1,385.56'
 L_s=1,052.08'
 L_s=300'
 θ_s=4°30'
 k=149.97'
 p=1.96'
 X_c=299.81'
 Y_c=7.85'
 E_s=204.50'
 S.E.=0.0967 ft./ft.


FED. ROAD DIST. NO.	FED. AID PROJECT NO.	FISCAL YEAR	SHEET NO.	TOTAL SHEETS
3	I-40-5(9)264	1960	18B	272

FED. ROAD DIST. NO.	FED. AID PROJECT NO.	FISCAL YEAR	SHEET NO.	TOTAL SHEETS
3	I-40-5(34)259	1970	22	57

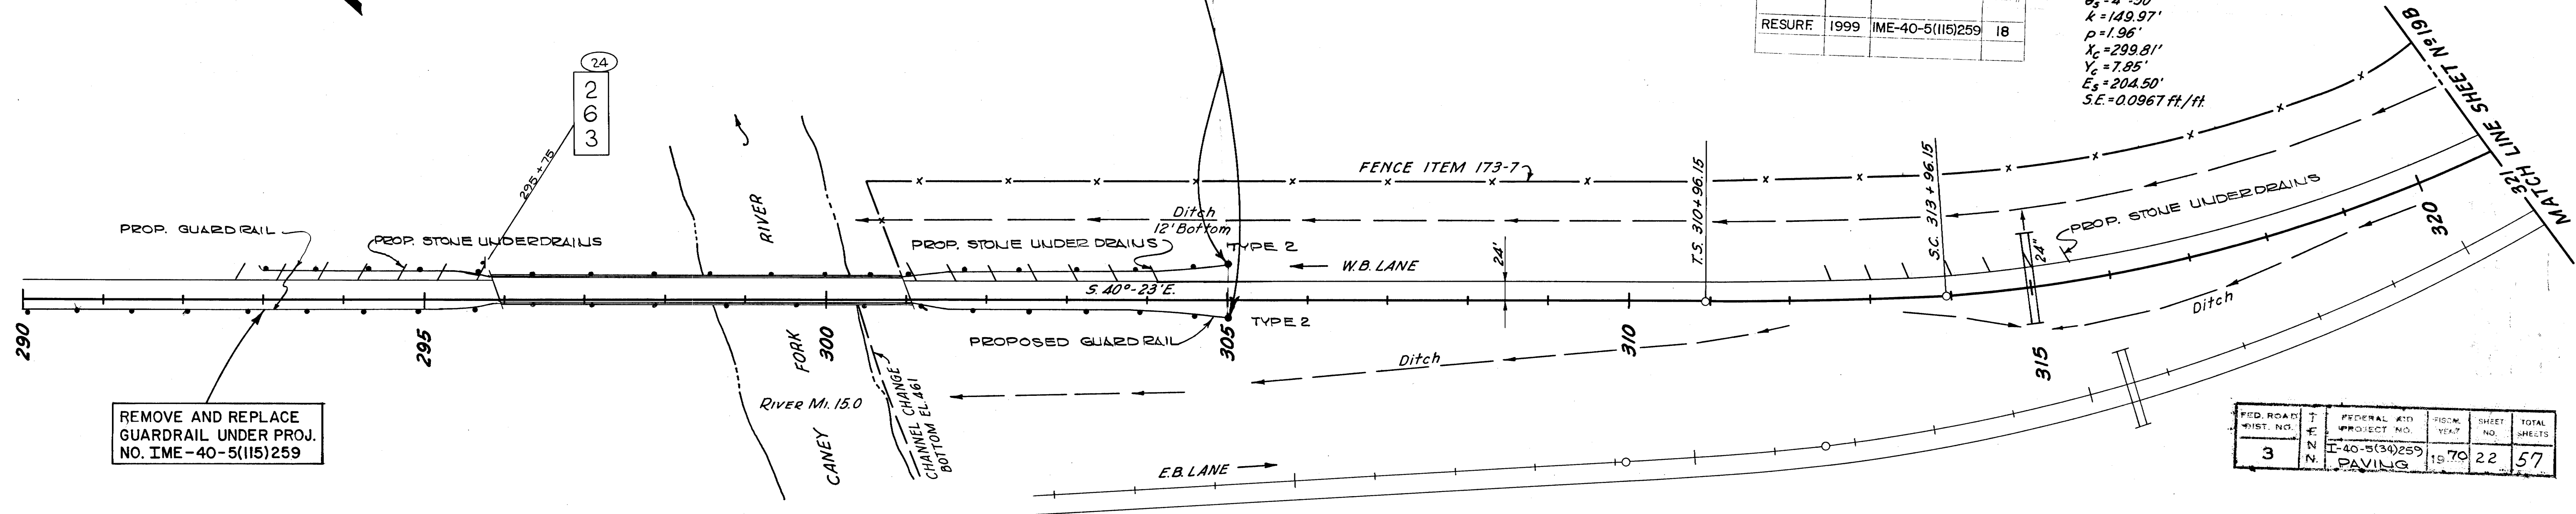

REMOVE AND REPLACE
GUARDRAIL UNDER PROJ.
NO. IME-40-5(115)259

GRADING QUANTITIES INCLUDED WITH E.B. LANE

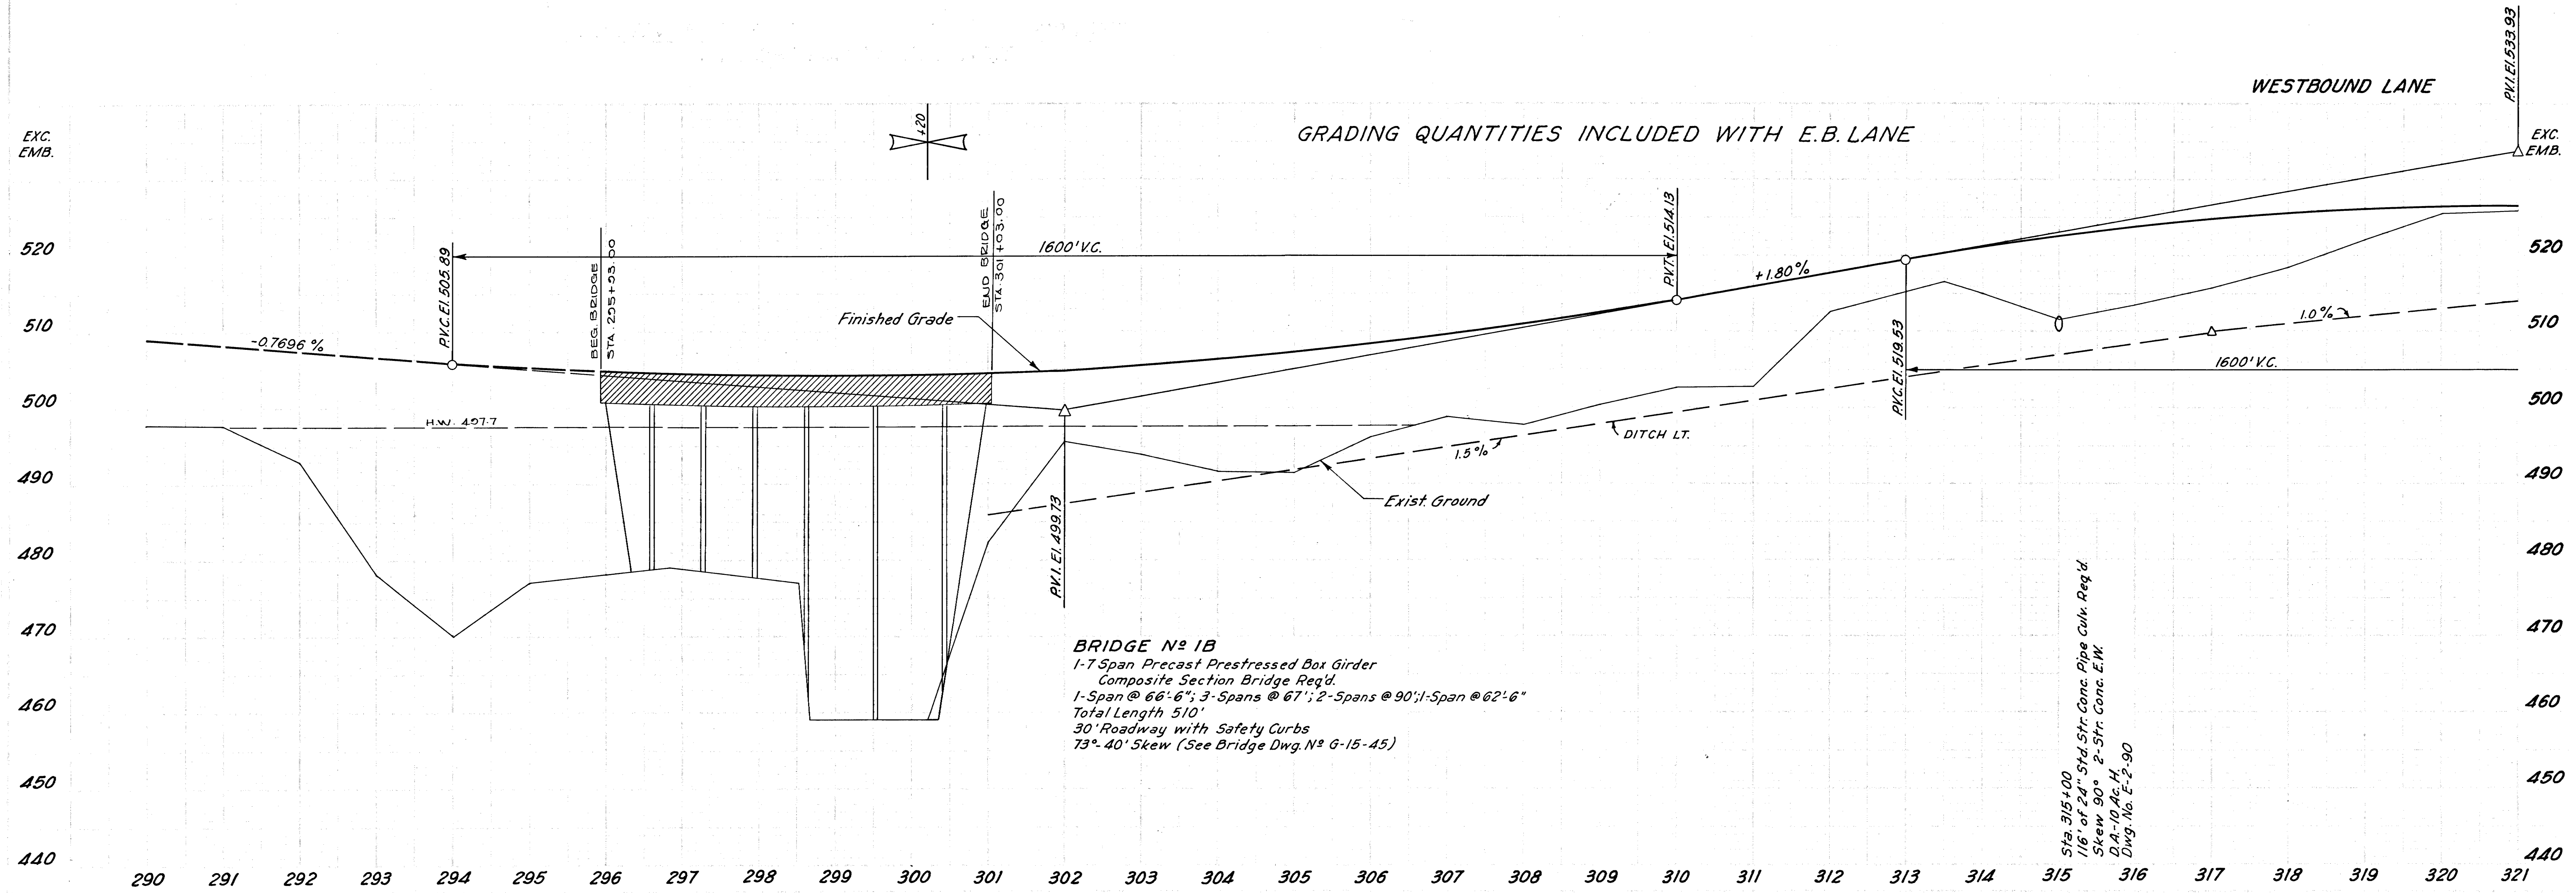

BRIDGE No 1B
 1-7 Span Precast Prestressed Box Girder
 Composite Section Bridge Req'd.
 1-Span @ 66'-6"; 3-Spans @ 67'; 2-Spans @ 90'; 1-Span @ 62'-6"
 Total Length 510'
 30' Roadway with Safety Curbs
 73° 40' Skew (See Bridge Dwg. No G-15-45)

Sta 315+00
 116' of 24" Std. Str. Conc. Pipe Culv. Req'd.
 Skew 90° 2-Str. Conc. L.W.
 D.A.-10 Ac. H.
 Dwg. No. E-2-90

REVISED FEB. 18, 1960
POND, CRIB, & PIG-PARLOR ADDED ON RT.
STA. 323±, 324± AND 329±.




INTERSTATE ROUTE I-40
SMITH COUNTY

MID-SOUTH ENGINEERING CO., INC.
820 BROADWAY, N. E. KNOXVILLE, TENNESSEE

RIGHT OF WAY PLANS
STA. 320+00 TO 350+00

STATE OF TENNESSEE
DEPARTMENT OF HIGHWAYS
AND PUBLIC WORKS
NASHVILLE

DR. <u>J.L.M.</u>	DATE <u>1-14-59</u>
CHK'D <u>MLG</u>	<u>4-14-59</u>
APP'D _____	

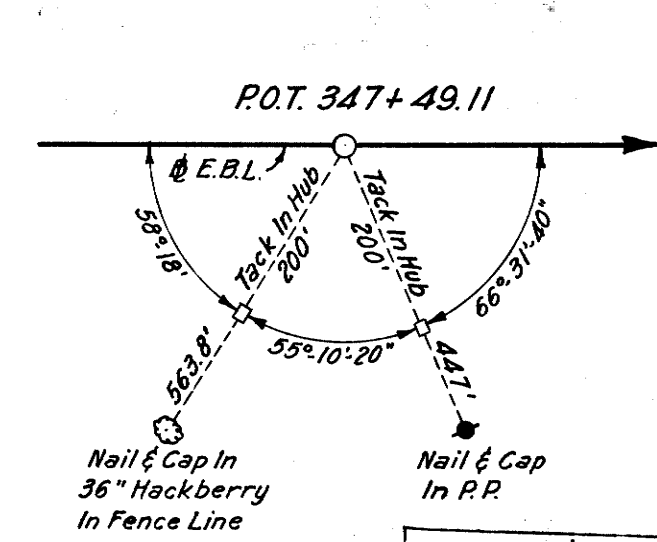


3		I-40-5(115)259		1989		19	
FED. DIST. NO.	T	FED. AID	EST. NO.	TOTAL	NO.	TOTAL	FEES
3	N	I-40-5(115)259	PAVING	13	21	40	

REV. 10-16-62: CORRECTED CURVE DATA

TYPE	YEAR	PROJECT NO.	SHEET #
RESURF.	1999	IME-40-5(115)259	19


TOTAL SHEETS	57
SHEET NO.	23
FED. AID	I-40-5(115)259
PROJECT NO.	PAVING
DIST. NO.	3

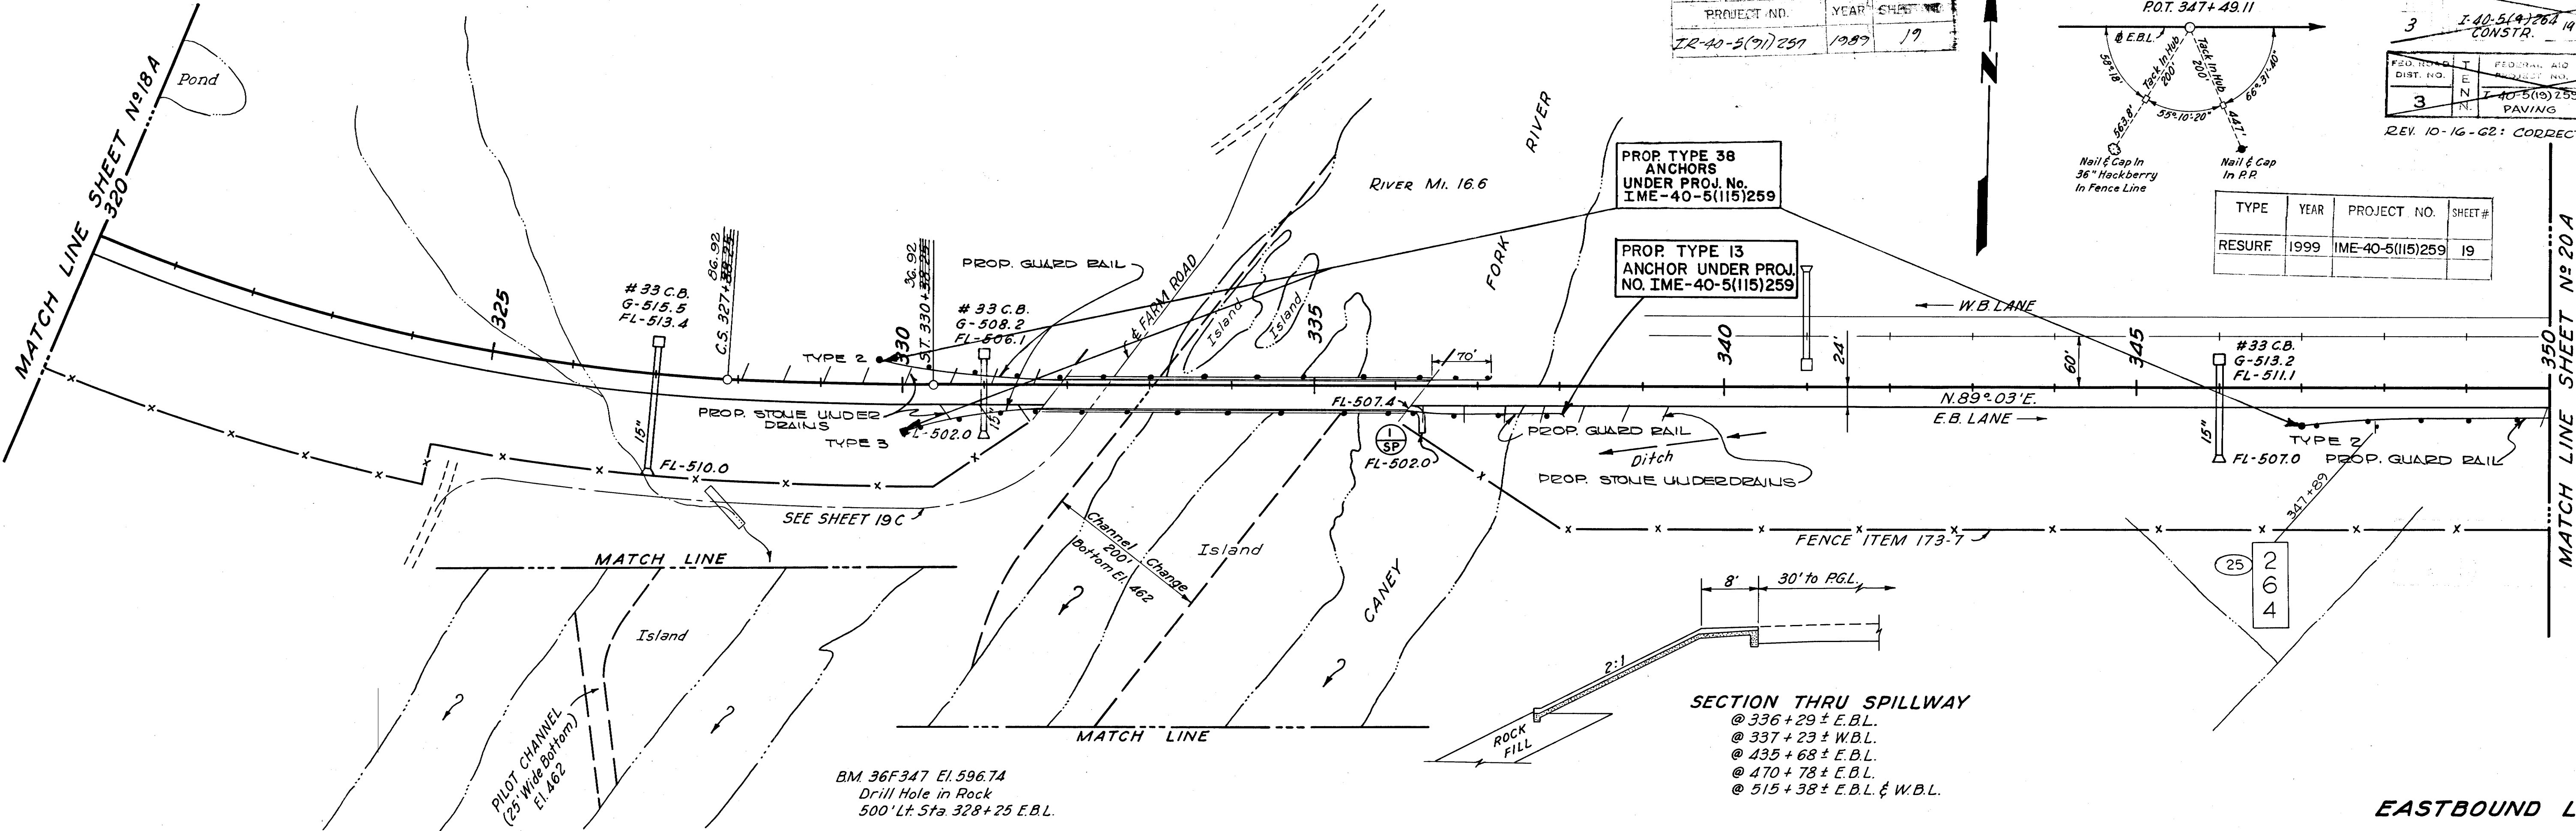

SECTION THRU SPILLWAY
@ 336+29 ± E.B.L.
@ 337+23 ± W.B.L.
@ 435+68 ± E.B.L.
@ 470+78 ± E.B.L.
@ 515+38 ± E.B.L. & W.B.L.

BM 36F347 El. 596.74
Drill Hole in Rock
500' Lt. Sta. 328+25 E.B.L.

EXC. 28,399 COM. 1,376
EMB. 36,647 S.R. 27,023
(INCL. 24,012 R.F.)
COM. 30% SHR.
S.R. 30% S.W.
CHAN. 12,600
TO BE DISPOSED OF AS DIRECTED BY THE ENGINEER

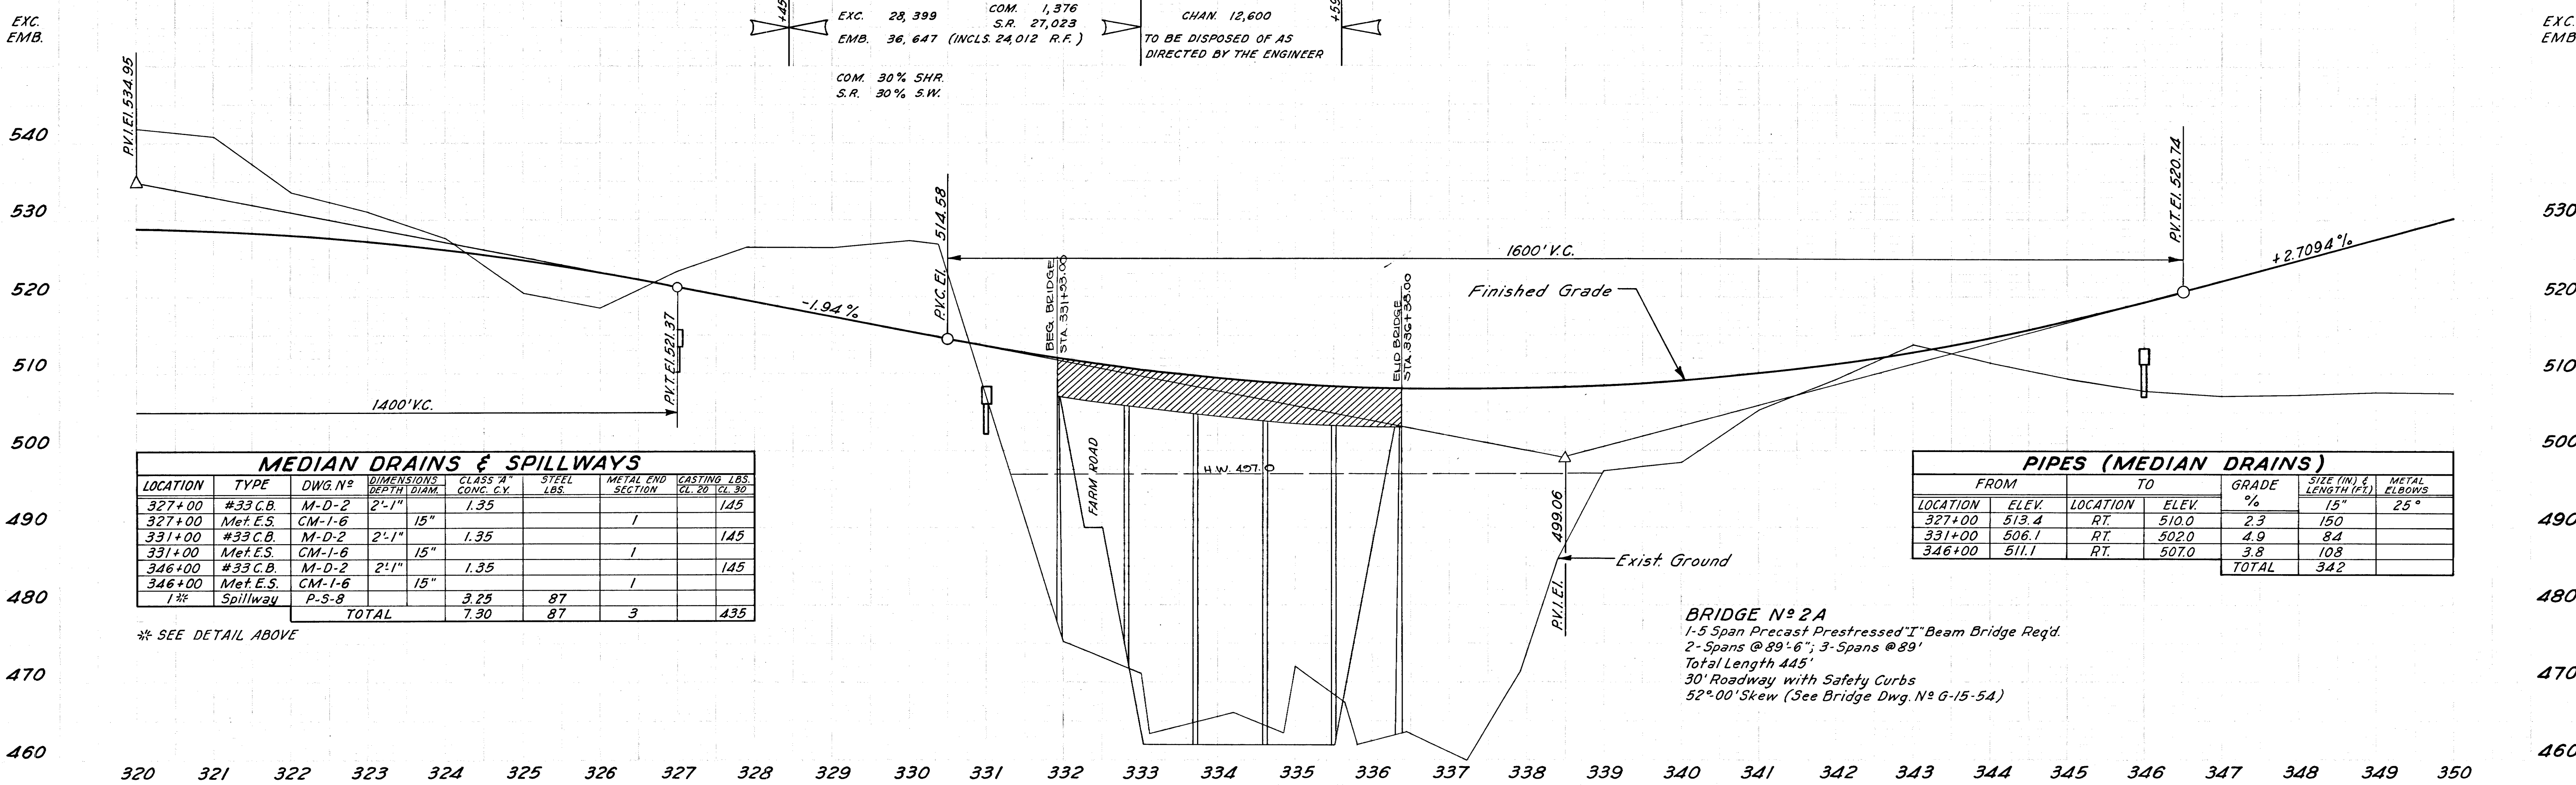



MEDIAN DRAINS & SPILLWAYS							
LOCATION	TYPE	DWG. N°	DIMENSIONS DEPTH DIAM.	CLASS "A" CONG. C.Y.	STEEL LBS.	METAL END SECTION	CASTING LBS. CL. 20 CL. 30
327+00	#33 C.B.	M-D-2	2'-1"	1.35			145
327+00	Met. E.S.	CM-1-6	15"			1	
331+00	#33 C.B.	M-D-2	2'-1"	1.35			145
331+00	Met. E.S.	CM-1-6	15"			1	
346+00	#33 C.B.	M-D-2	2'-1"	1.35			145
346+00	Met. E.S.	CM-1-6	15"			1	
1 1/2	Spillway	P-S-8		3.25	87		
TOTAL				7.90	87	3	435

PIPES (MEDIAN DRAINS)					
FROM	TO	GRADE %	SIZE (IN.) & LENGTH (FT.)	METAL ELBOWS	
LOCATION	ELEV.	LOCATION	ELEV.	15°	25°
327+00	513.4	RT.	510.0	2.3	150
331+00	506.1	RT.	502.0	4.9	84
346+00	511.1	RT.	507.0	3.8	108
TOTAL				34.2	



BRIDGE N° 2A
1-5 Span Precast Prestressed "I" Beam Bridge Req'd.
2- Spans @ 89'-6"; 3- Spans @ 89'
Total Length 445'
30' Roadway with Safety Curbs
52° 00' Skew (See Bridge Dwg. N° G-15-54)

* SEE DETAIL ABOVE

TYPE	YEAR	PROJECT NO.	SHEET #
RESURF.	1999	IME-40-5(115)259	20

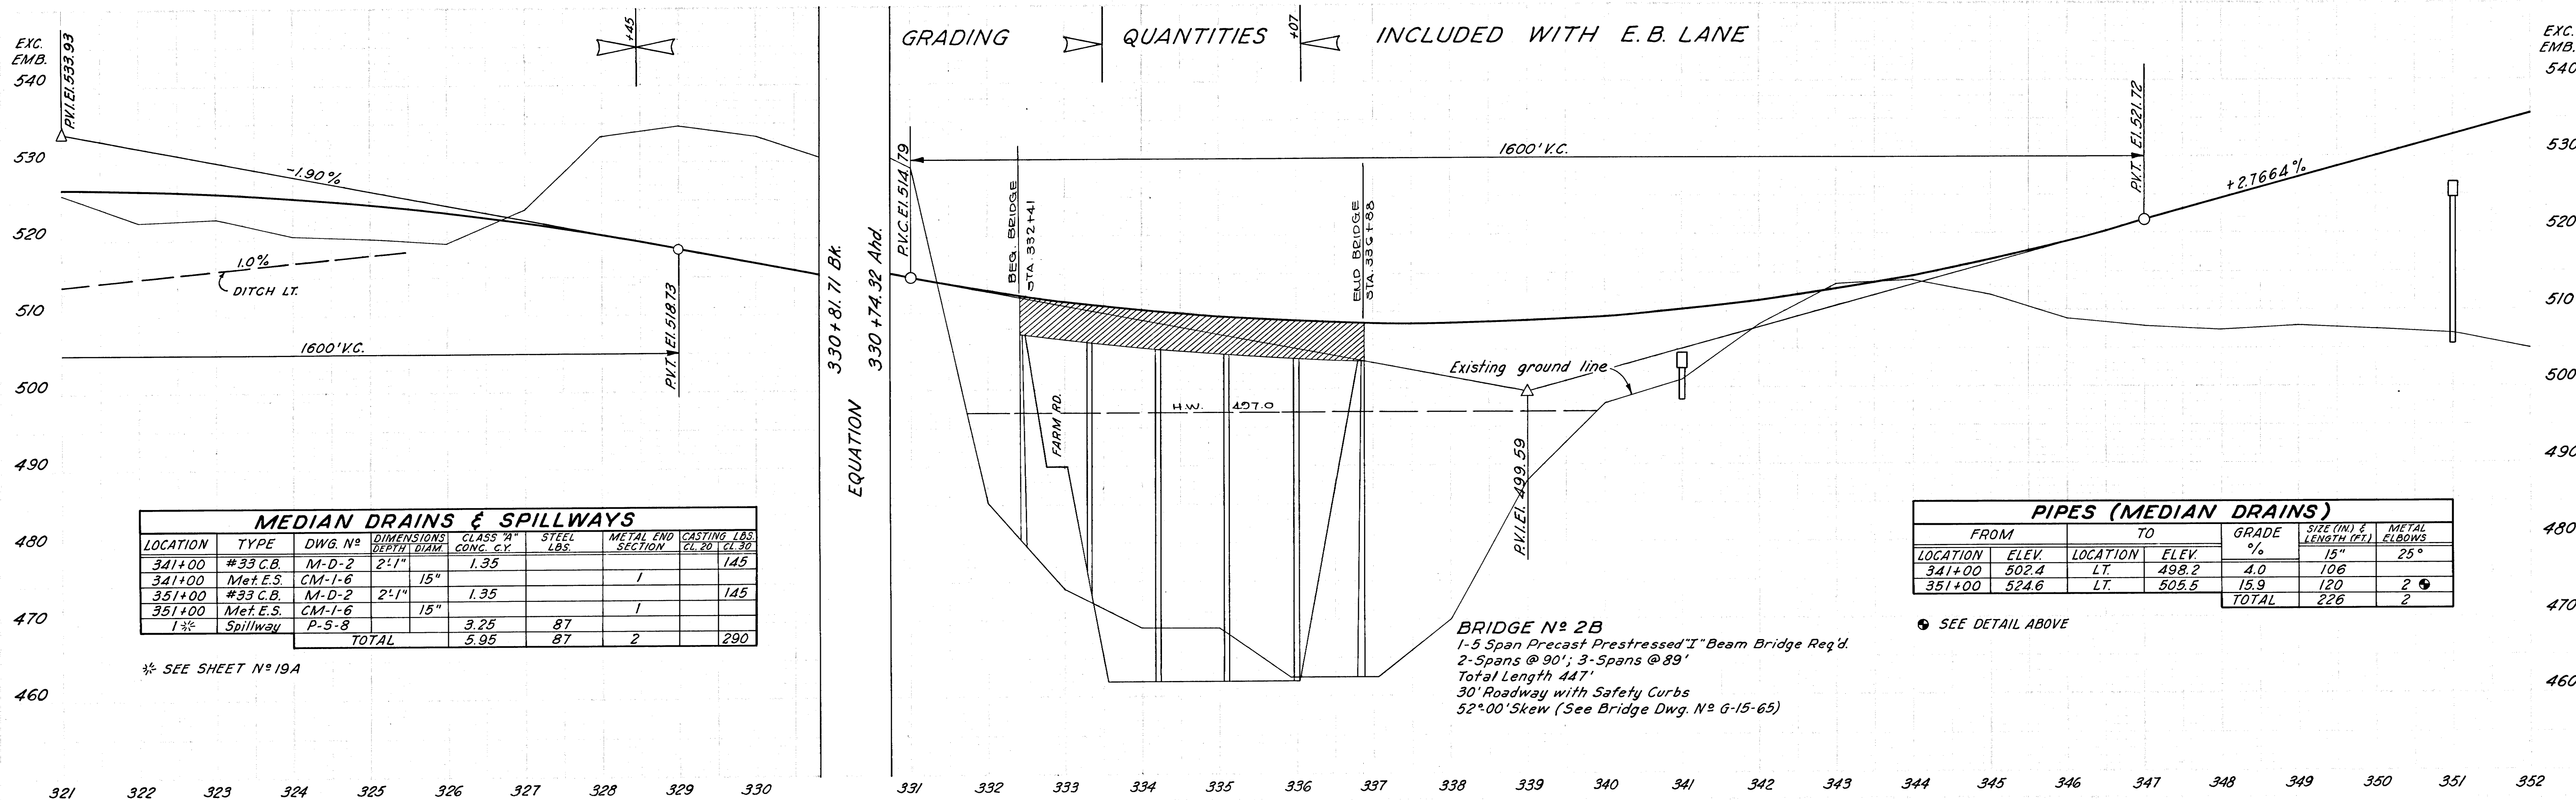
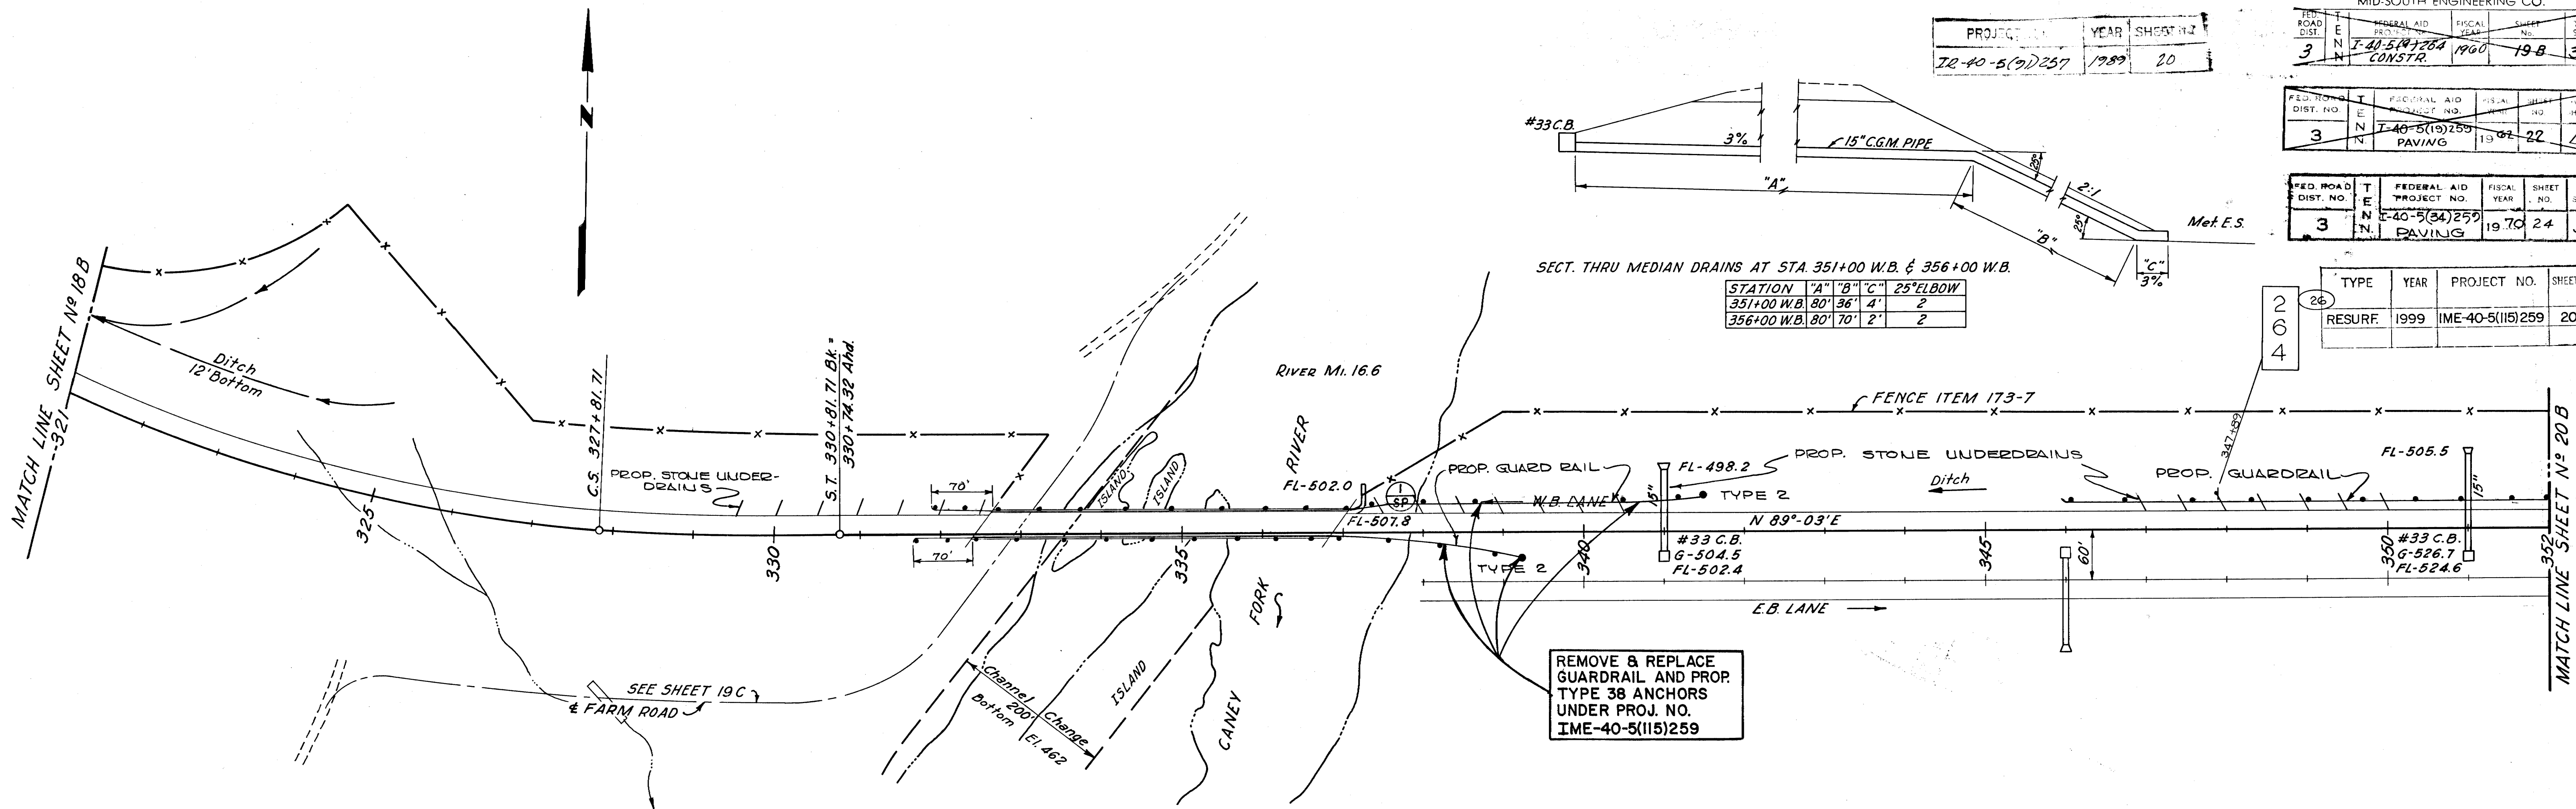


MICROFILMED

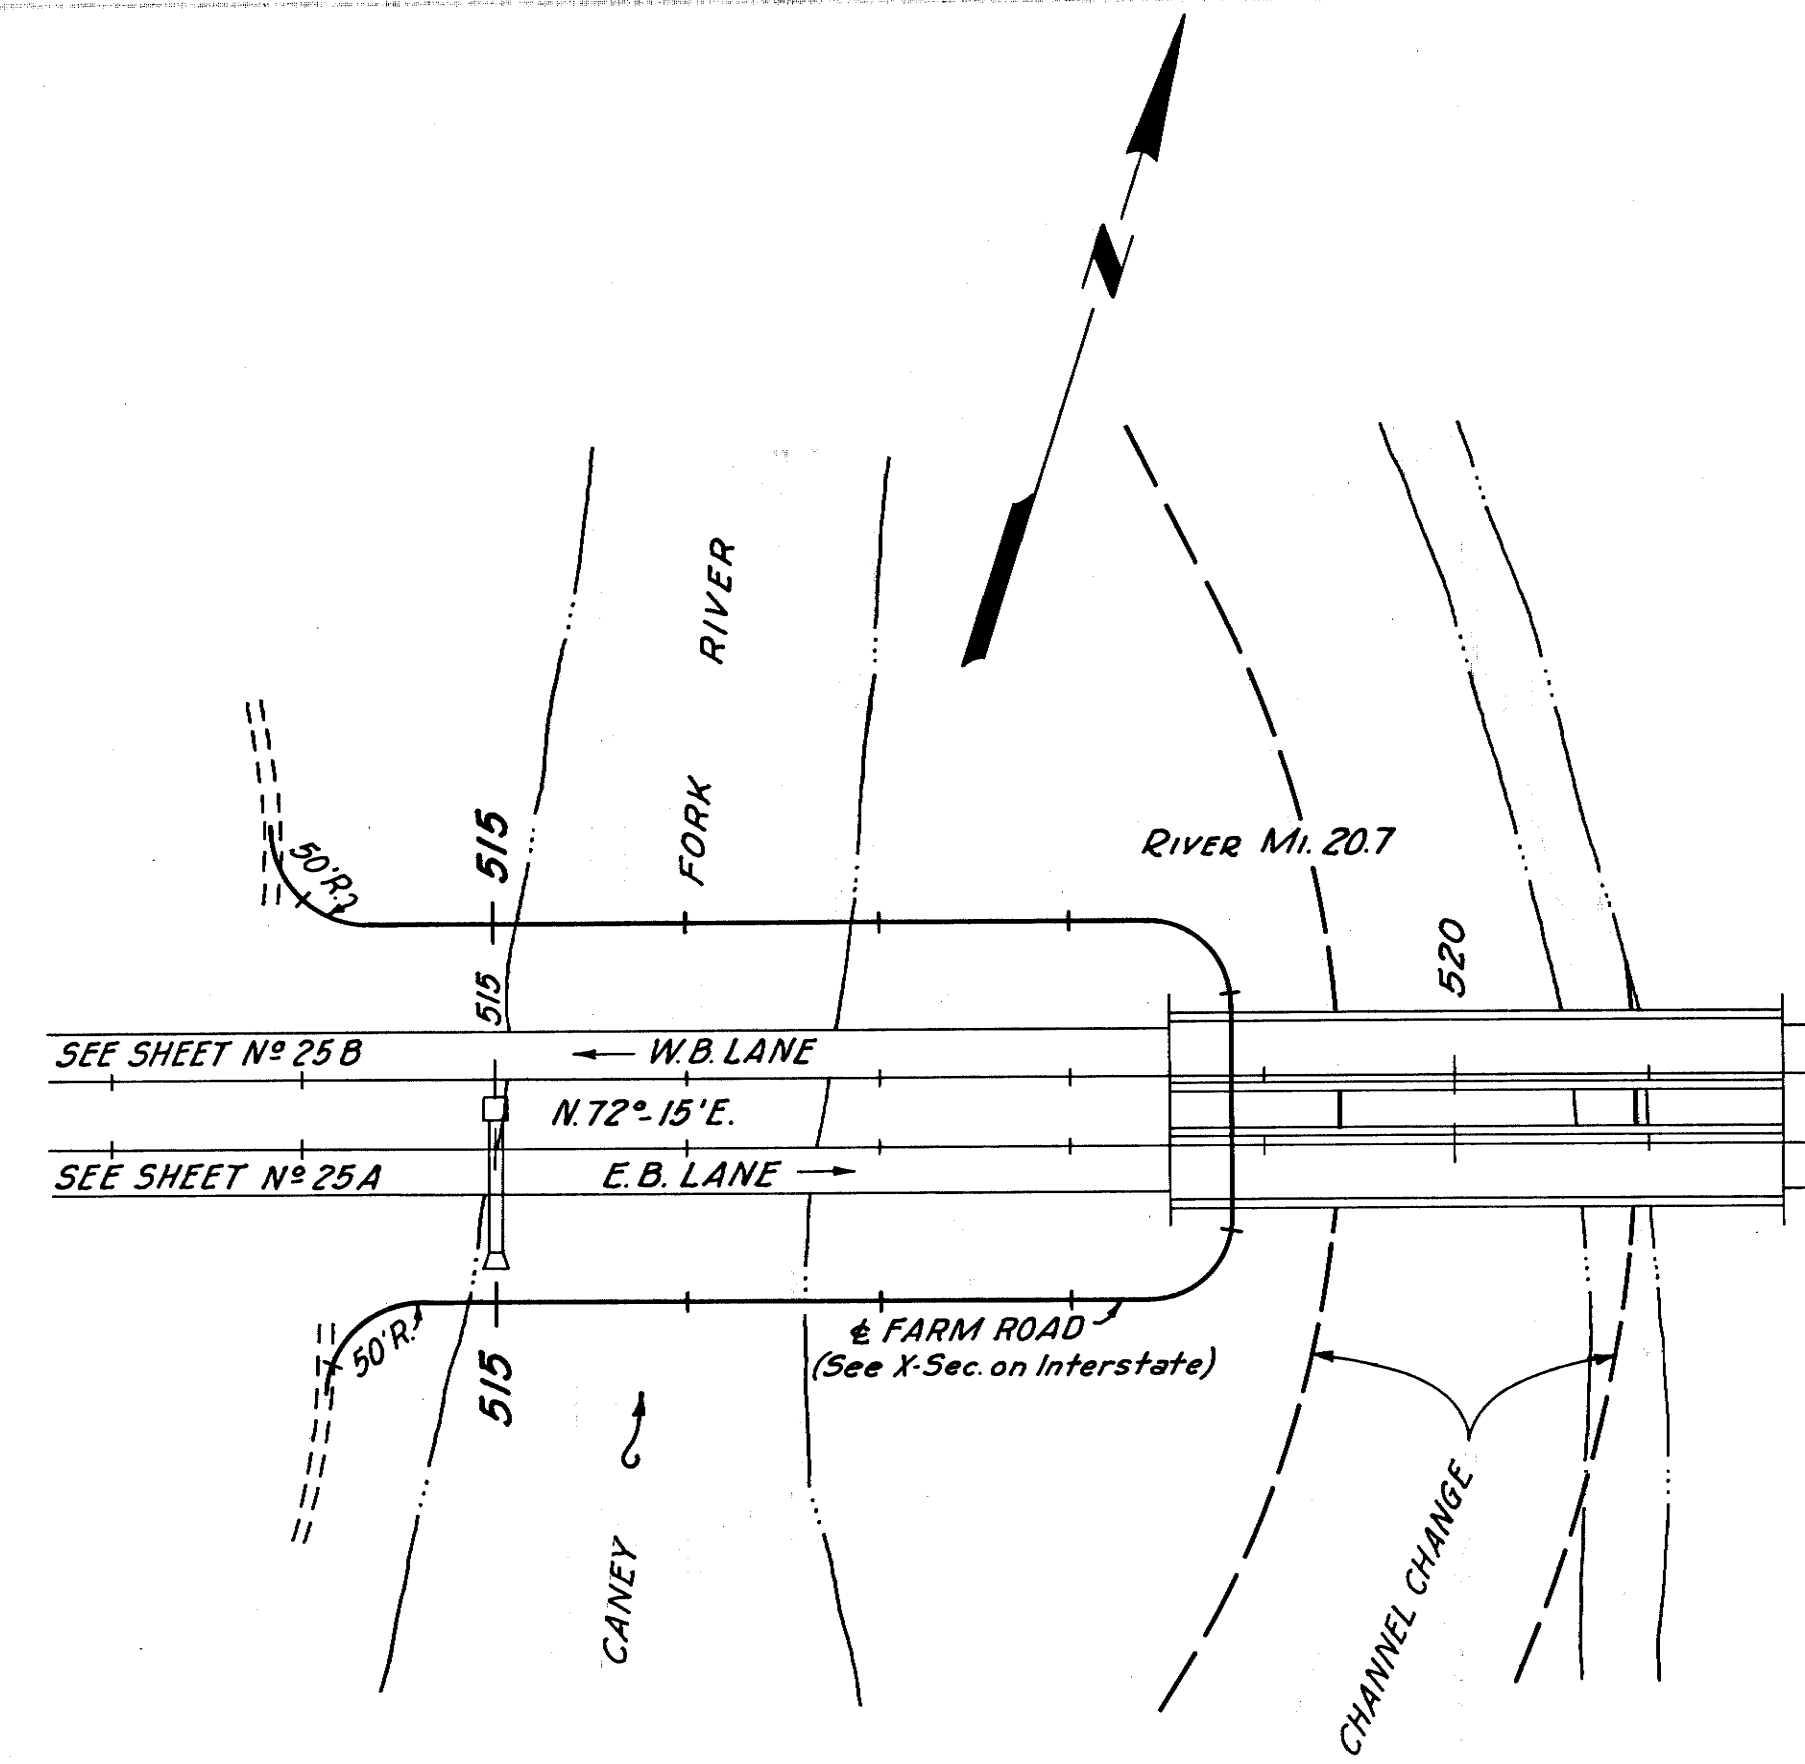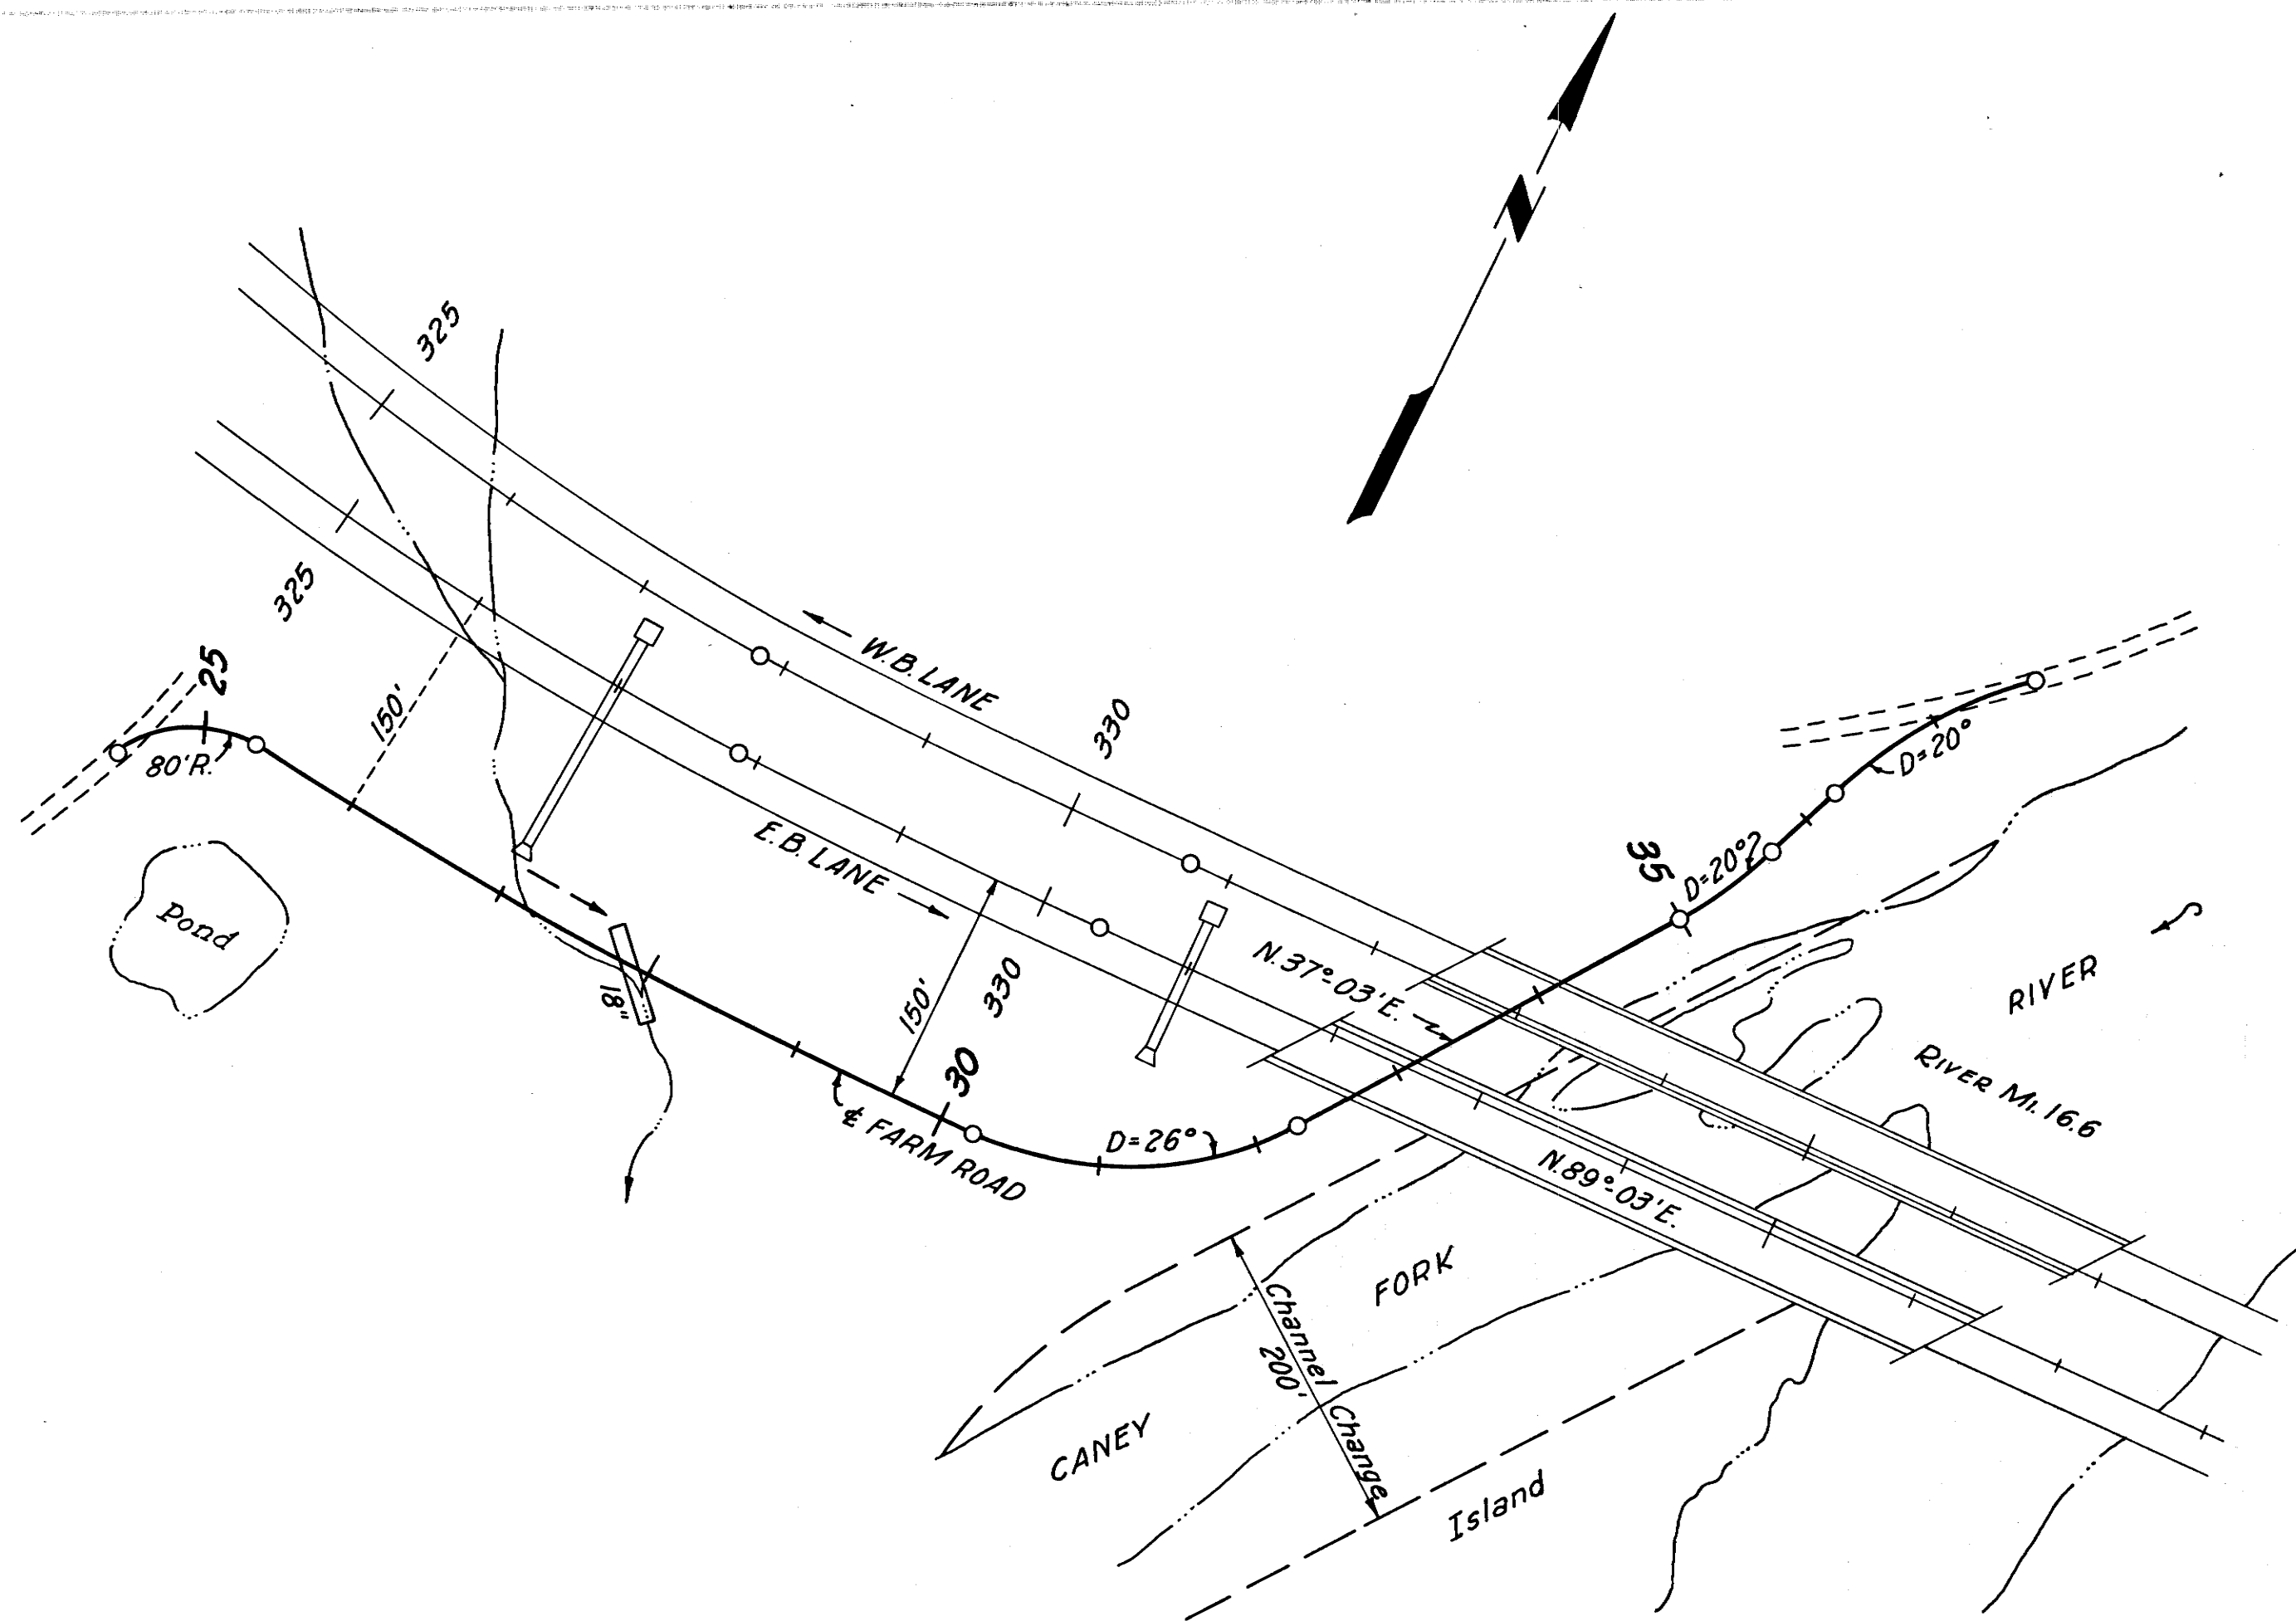

FARM ROADS
@ STA. 332 ±
@ STA. 518 ±


GRADING QUANTITIES INCLUDED WITH INTERSTATE

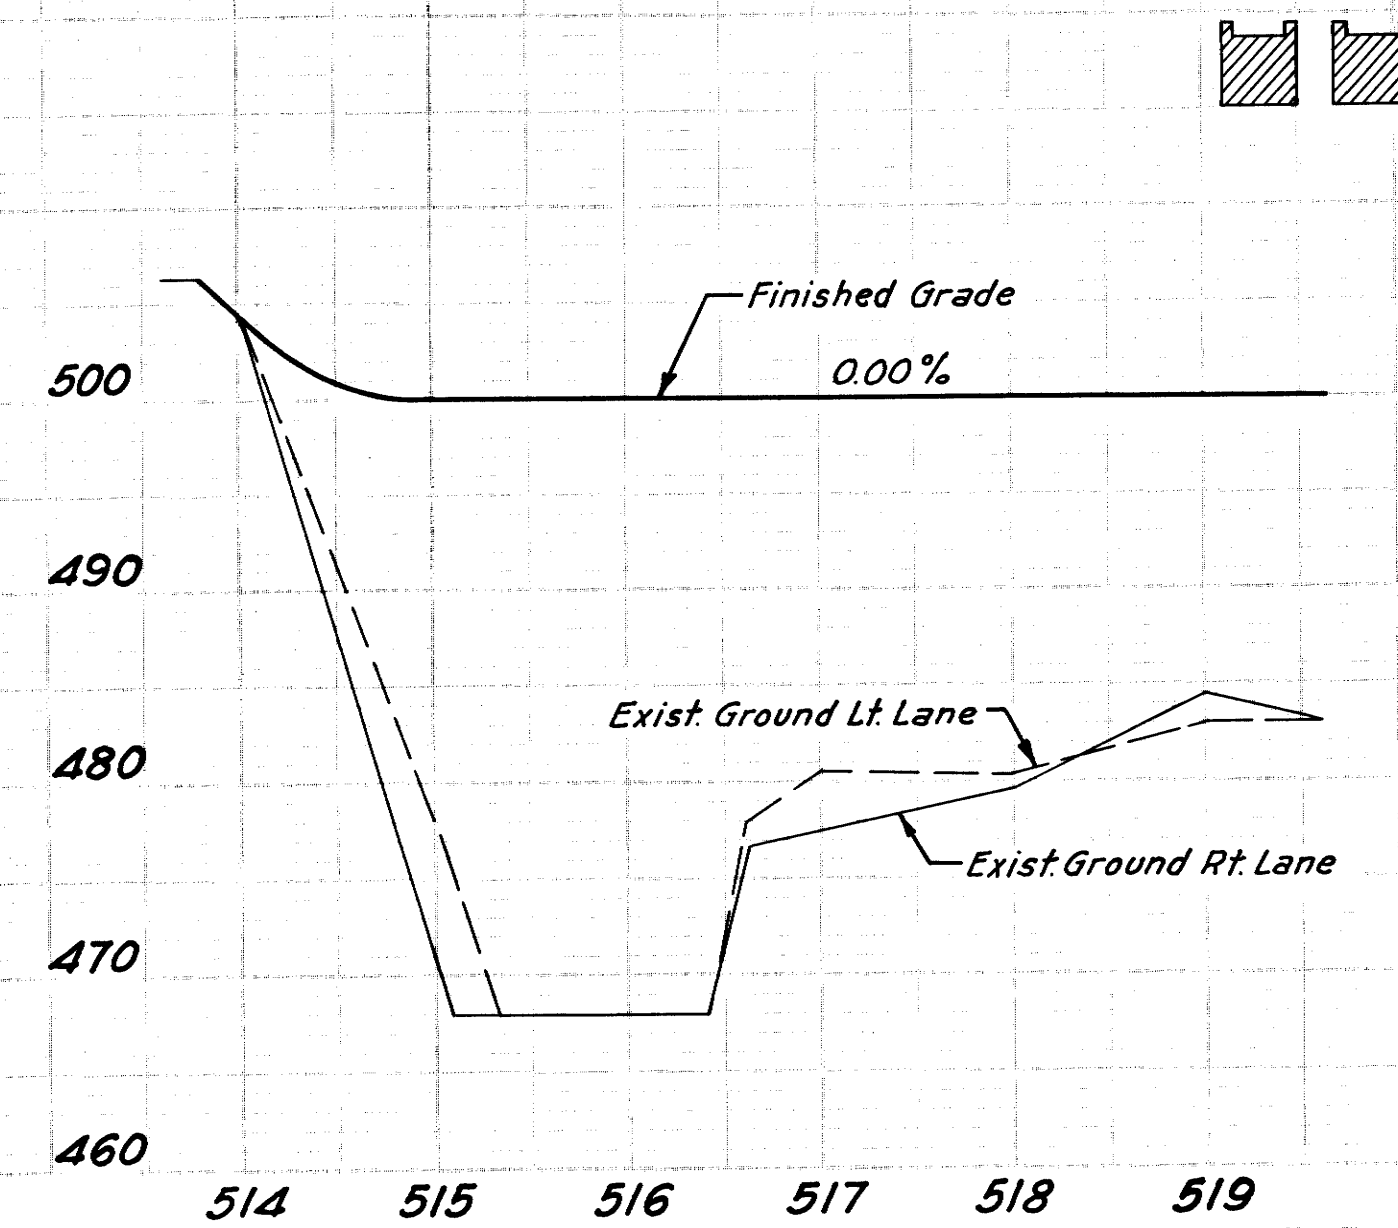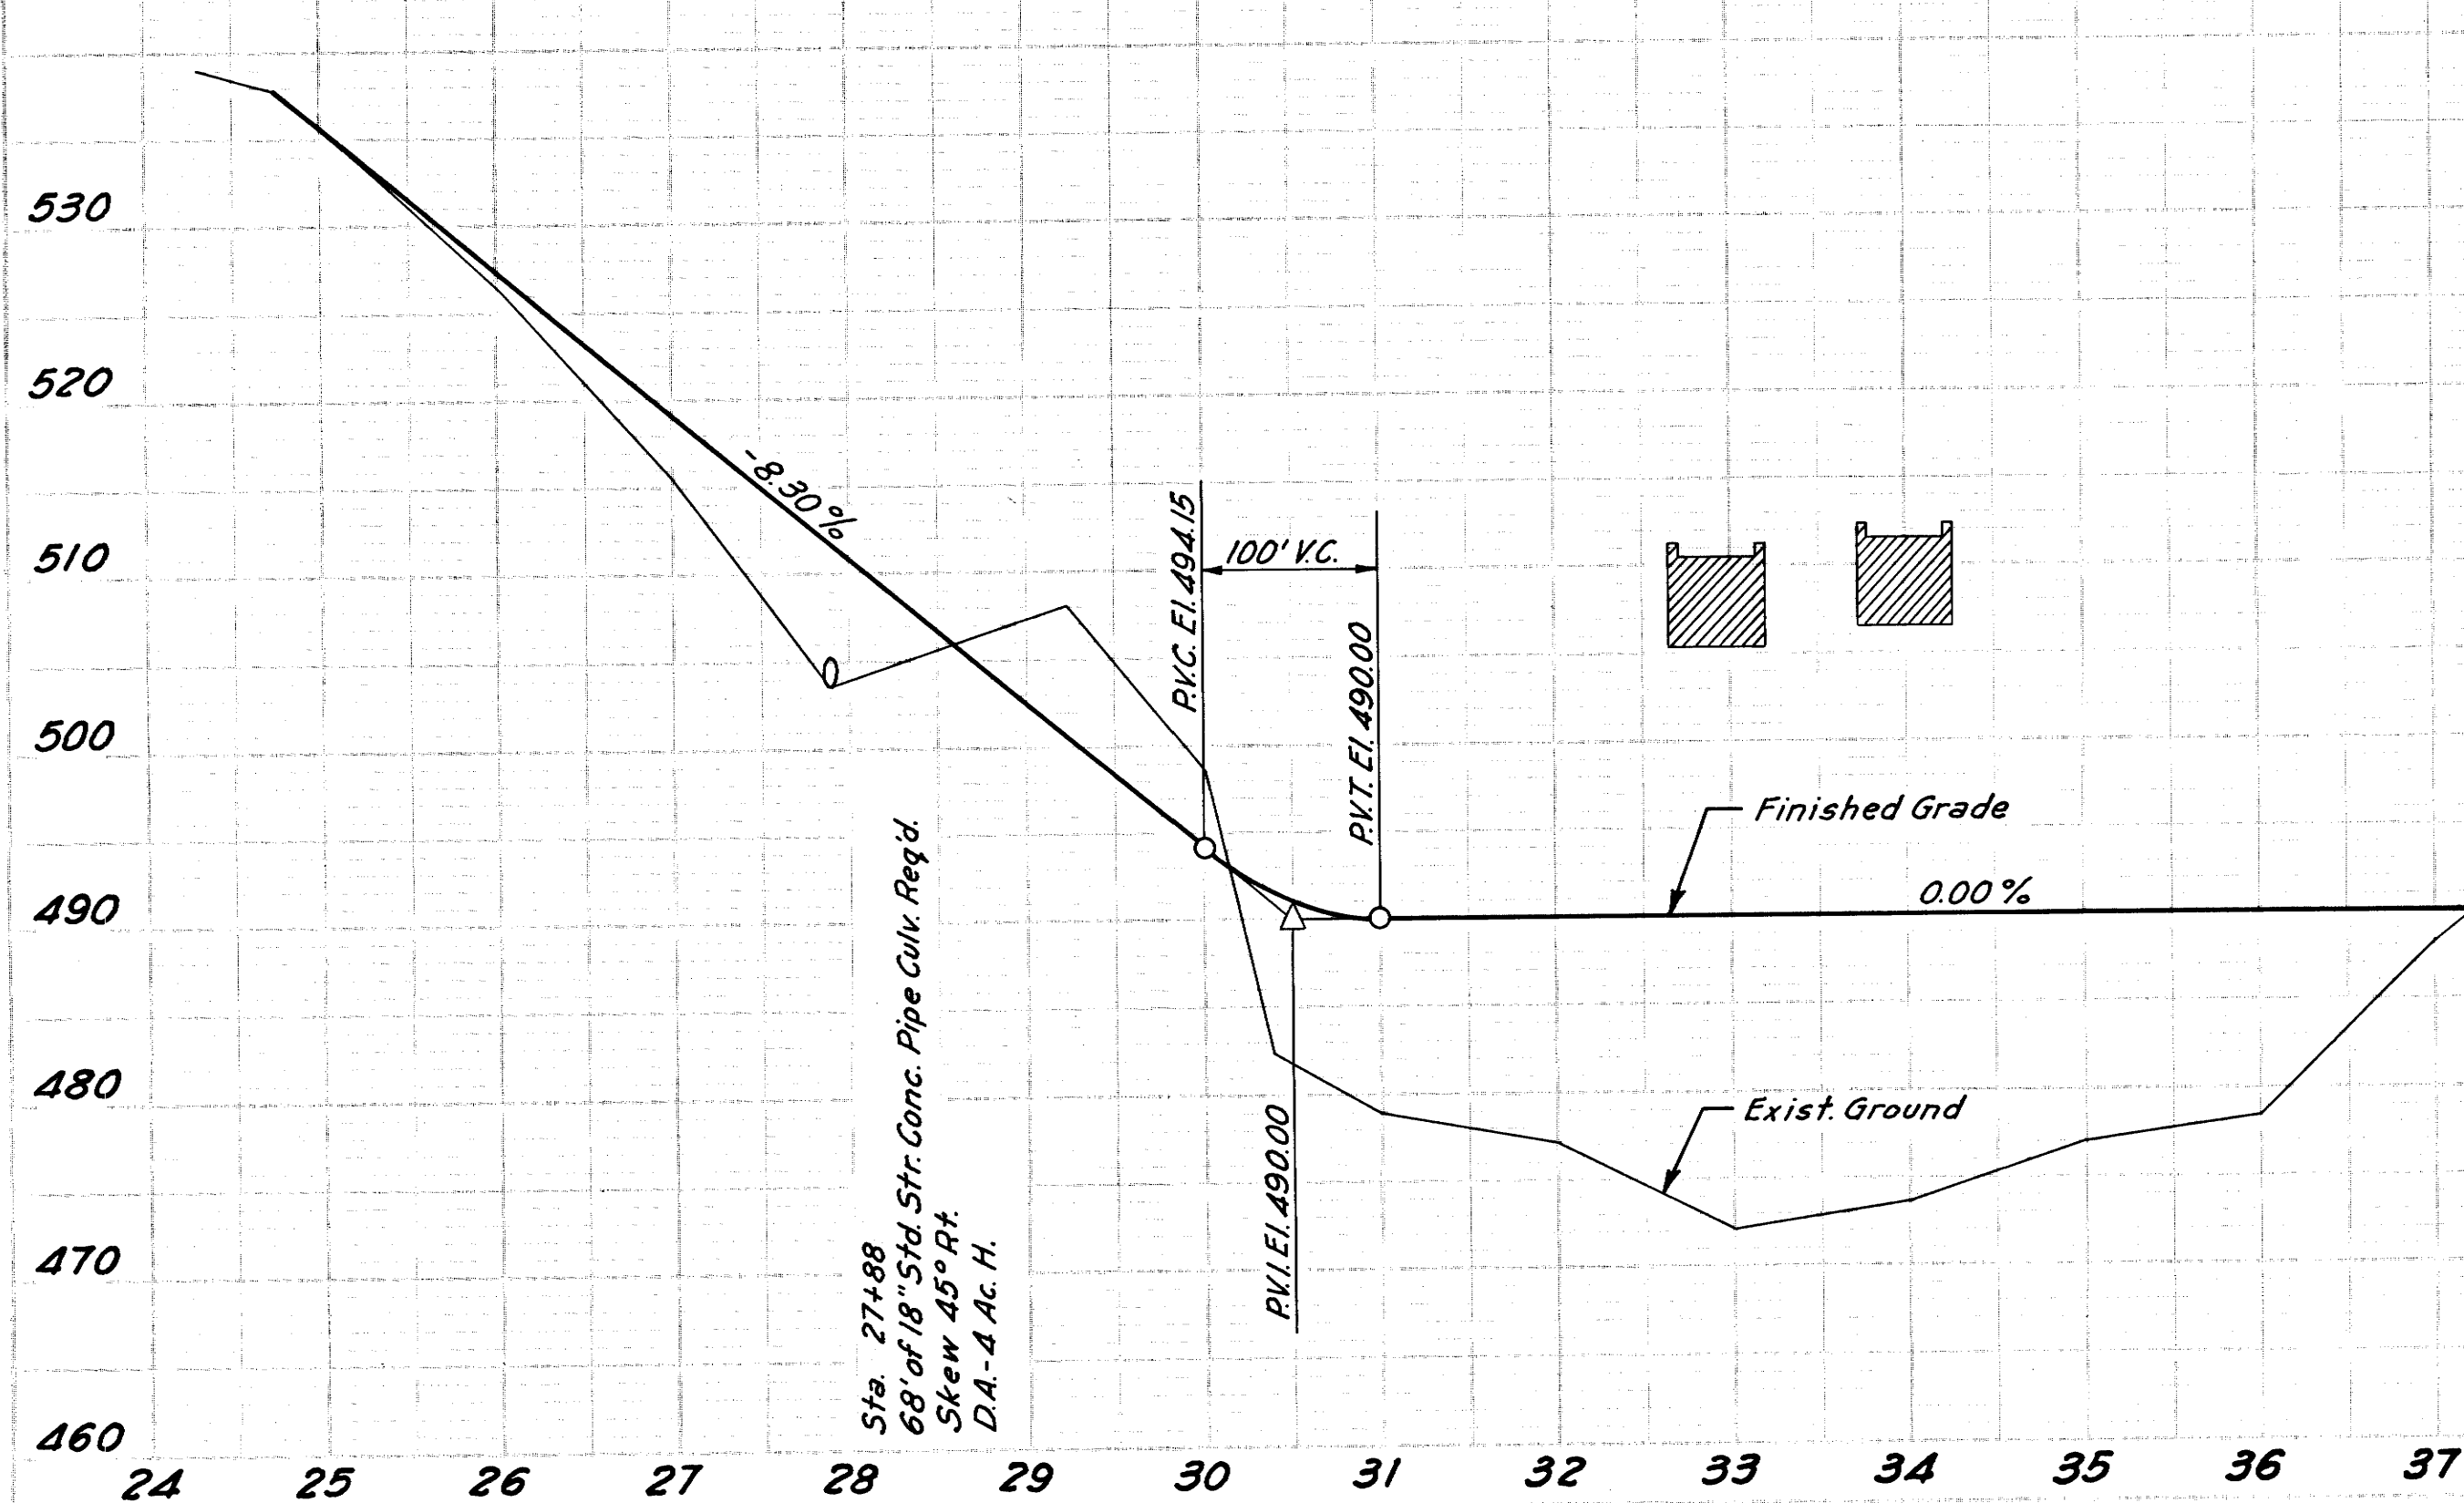

FED. ROAD DIST. NO.	FED. AID PROJECT NO.	FISCAL YEAR	SHEET NO.	TOTAL SHEETS
3	1-40-5(2) 264	1959	20	372
	CONSTR.			

FED. ROAD DIST. NO.	FED. AID PROJECT NO.	FISCAL YEAR	SHEET NO.	TOTAL SHEETS
3	1-40-5(2) 259	1959	20	25
	R.O.W.			

REVISED 7-15-59; TRACTS N° 33, 34 & 35 REV.
 REVISED 7-31-59: LINE CHANGE W.B.L. BACK OF STA. 369
 REVISED 12-11-50: CORRECTED Δ OF CURVE ON W.B. LANE
 REVISED 2-24-60: ADDED EASEMENT AREA TRACT NO. 34

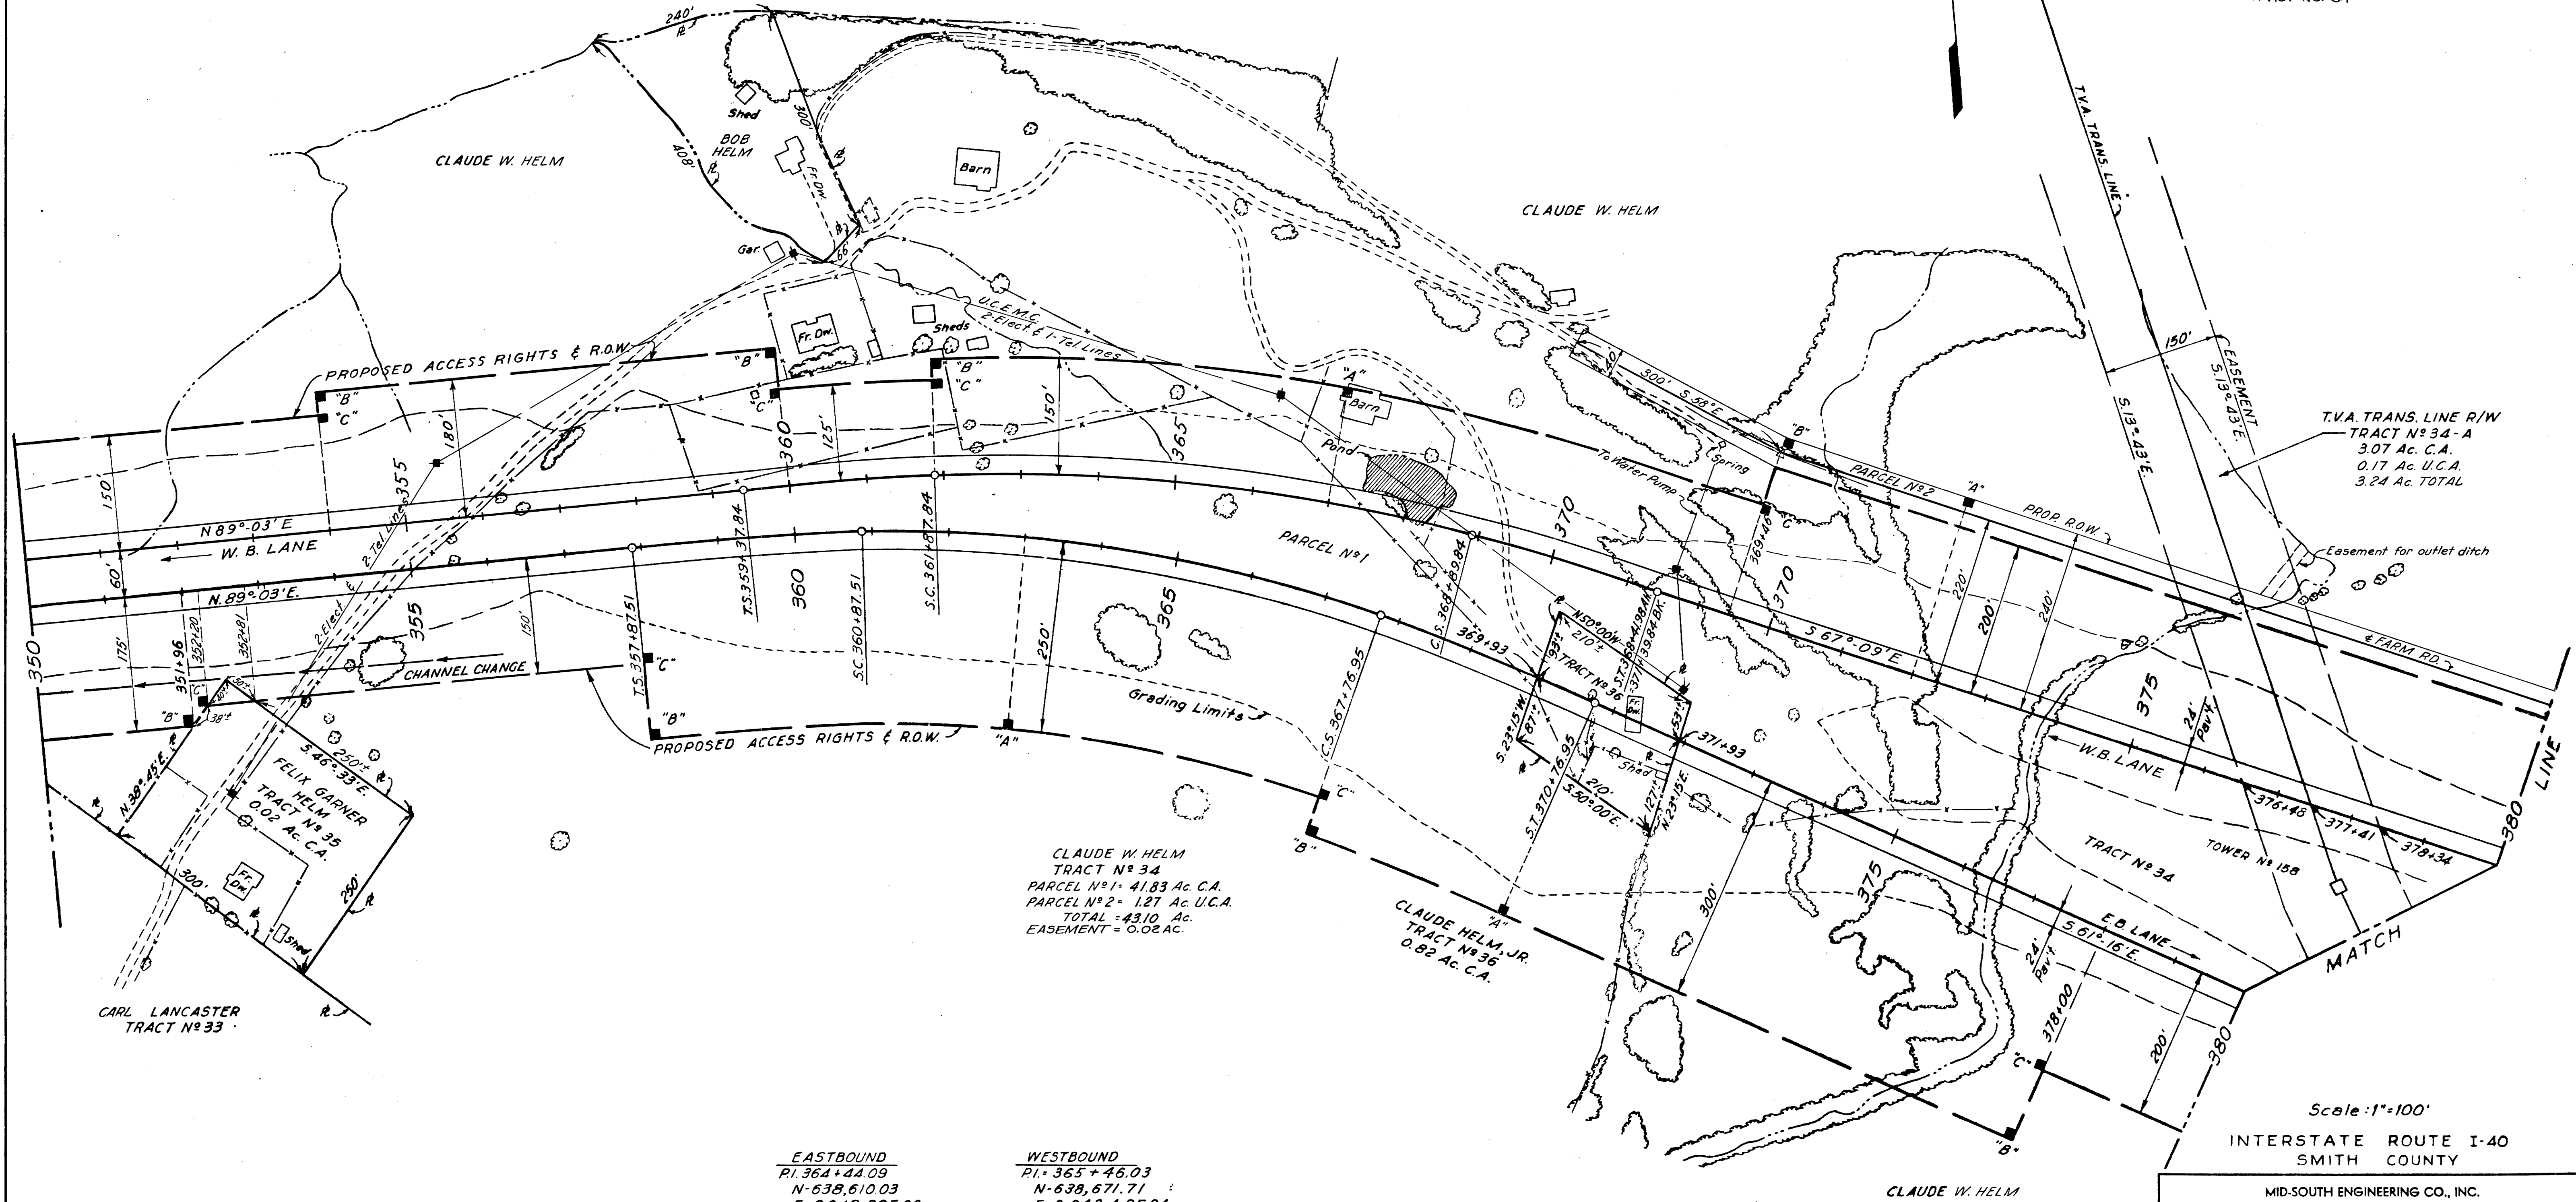

EASTBOUND
 PI = 364+44.09
 N = 638,610.03
 E = 2,043,385.00
 Δ = 29° 41' Rt.
 Δ_c = 20° 41'
 D = 3° 00'
 R = 1,909.86'
 L_c = 689.44'
 T_s = 656.58'
 L_s = 300'
 θ_s = 4° 30'
 K = 149.97'
 P = 1.96'
 X_c = 299.81'
 Y_c = 7.85'
 E_s = 67.94'

WESTBOUND
 PI = 365+46.03
 N = 638,671.71
 E = 2,043,485.94
 Δ = 23° 42' Rt. 23° 40'
 Δ_c = 17° 33'
 D = 2° 30'
 R = 2,291.83'
 L_c = 702.00'
 T_s = 608.19'
 L_s = 250'
 θ_s = 3° 7' 30"
 K = 124.99'
 P = 1.13'
 X_c = 249.93'
 Y_c = 4.54'
 E_s = 51.49'

RIGHT OF WAY PLANS
 STA. 350+00 TO 380+00

STATE OF TENNESSEE
 DEPARTMENT OF HIGHWAYS
 AND PUBLIC WORKS
 NASHVILLE

DR. J.L.M.
 CHK'D M.L.S.
 APP'D.

DATE
 1-15-59
 4-13-59


TENN. STATE HIGHWAYS
 Plans File No. **IN-50**
 Divn. No. **50**

MICROFILMED
 1980

PROJECT NO.	YEAR	SHEET NO.
IR-40-5(91)257	1989	21

FED. ROAD DIST. NO.	TENN. DIST. NO.	FEDERAL AID PROJECT NO.	FISCAL YEAR	SHEET NO.	TOTAL SHEETS
3	N	I-40-5(34)259	1970	25	57

PKY. NO.	TENN. DIST. NO.	FEDERAL AID PROJECT NO.	FISCAL YEAR	SHEET NO.	TOTAL SHEETS
3	N	I-40-5(91)259	1989	23	40

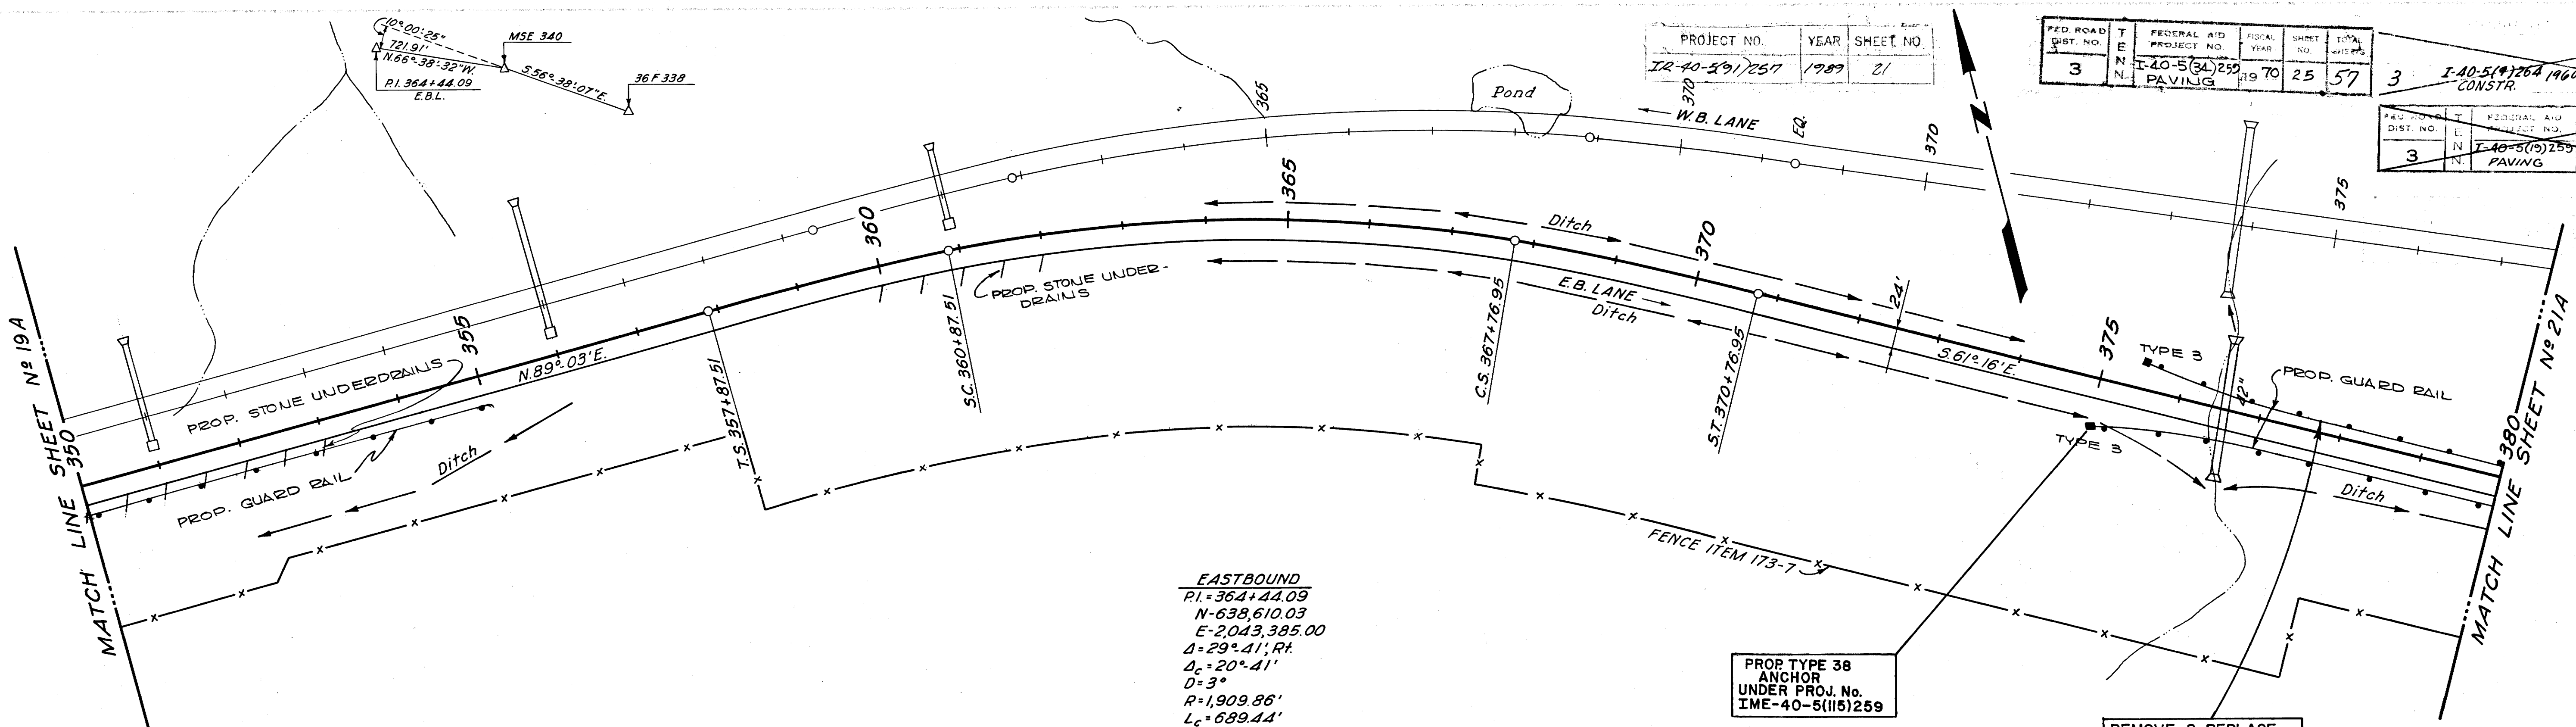

EASTBOUND
 PI=364+44.09
 N=638,610.03
 E=2,043,395.00
 Δ=29° 41' Rt.
 ΔC=20° 41'
 D=3°
 R=1,909.86'
 Lc=689.44'
 Ts=656.58'
 Ls=300'
 θs=4° 30'
 k=149.97'
 p=1.96'
 Xc=299.81'
 Yc=7.85'
 Es=67.86'
 S.E.=0.0967 ft/ft


PROP TYPE 38
 ANCHOR
 UNDER PROJ. No.
 IME-40-5(115)259

REMOVE & REPLACE
 GUARDRAIL AND ADD
 PROP. TYPE 12 & 13
 ANCHORS UNDER PROJ.
 NO. IME-40-5(115)259

TYPE	YEAR	PROJECT NO.	SHEET #
RESURF	1999	IME-40-5(115)259	21

B.M. M.S.E.-340 El. 637.86
 Bolt in Rock
 70' Lt. Sta. 371+30 E.B.L.

EASTBOUND LANE


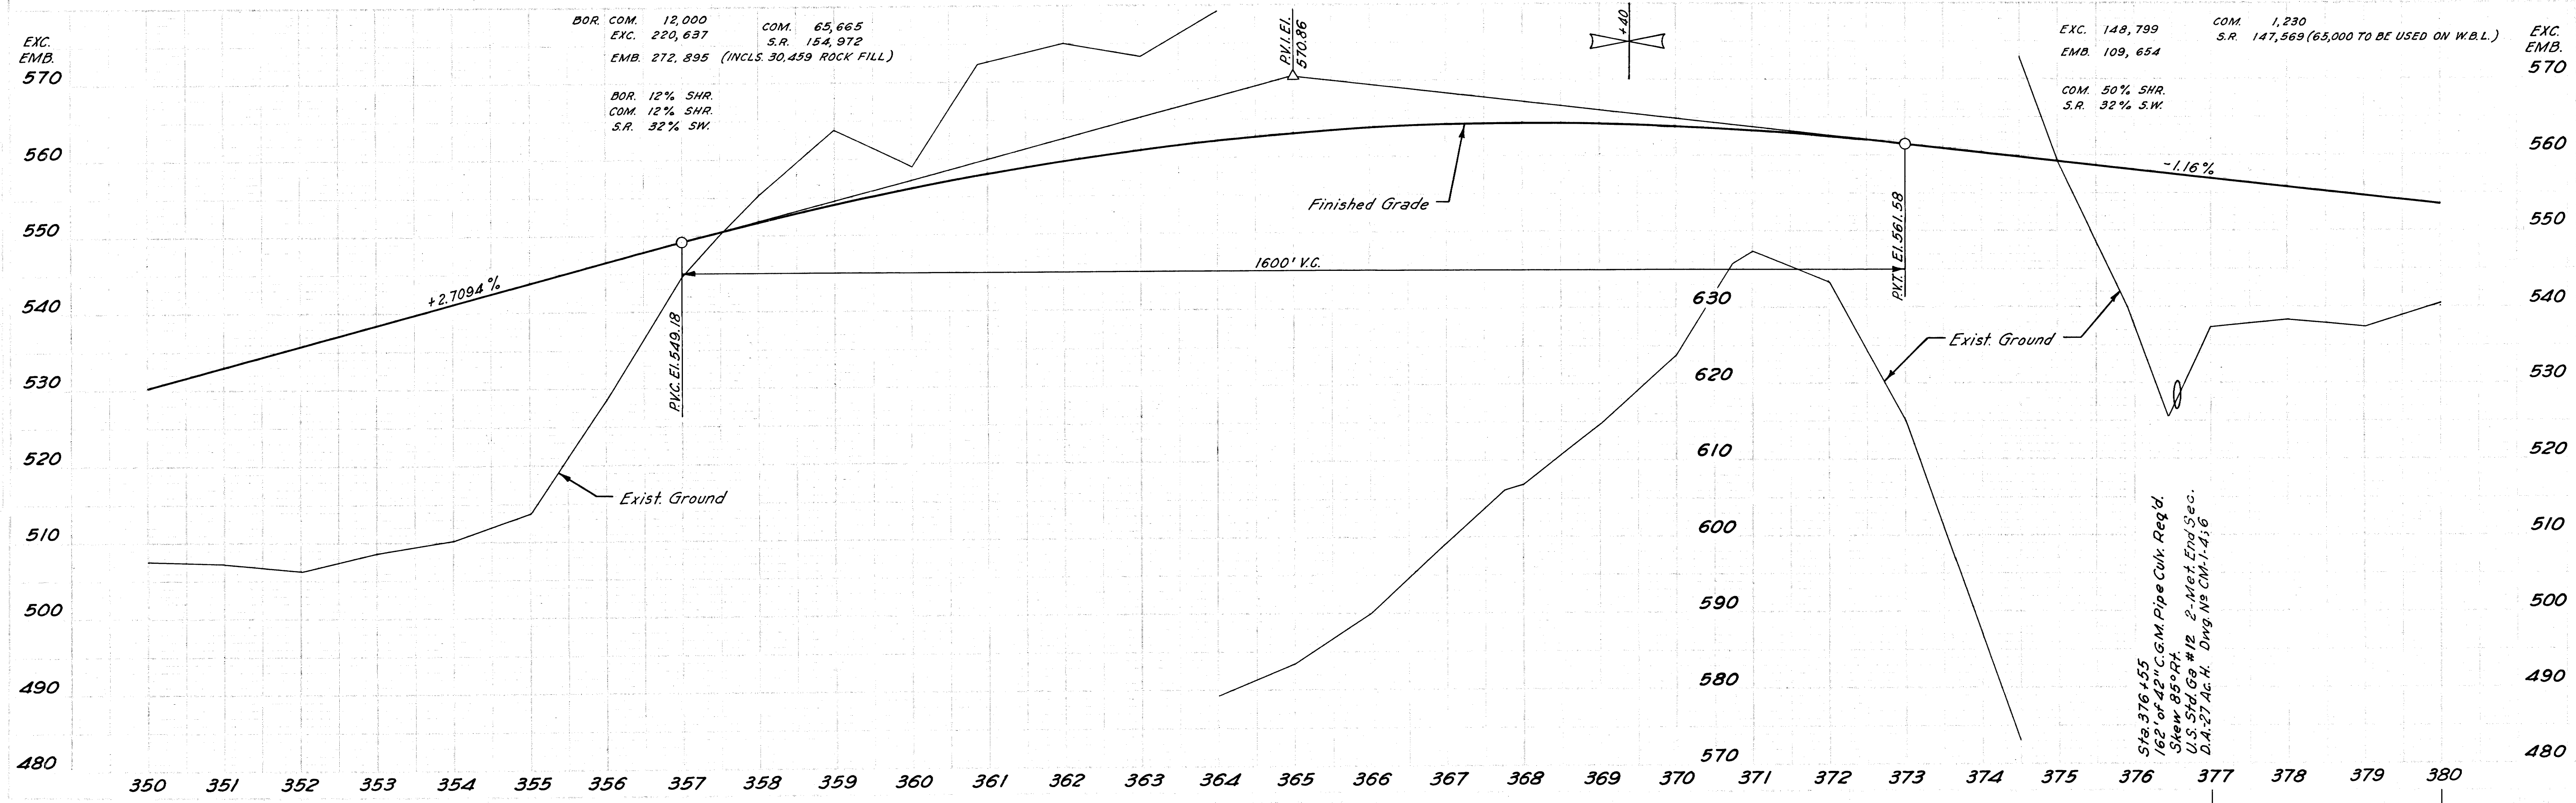


TRAIL-ROAD DIST.	T E N	FEDERAL AID PROJECT NO.	FISCAL YEAR	SHEET NO.	TOTAL SHEETS
3	N	I-40-5(4)25A CONSTR.	1960	20B	372


TRAIL-ROAD DIST. (NEW)	T E N	FEDERAL AID PROJECT NO.	FISCAL YEAR	SHEET NO.	TOTAL SHEETS
3	N	I-40-5(1)25B PAVING	1962	24	40

FED. ROAD DIST. NO.	TEN N.	FEDERAL AID PROJECT NO.	FISCAL YEAR	SHEET NO.	TOTAL SHEETS
3		I-40-5(34)252 PAVING	1970	26	57

TYPE	YEAR	PROJECT NO.	SHEET #
RESURF.	1999	IME-40-5(115)259	22

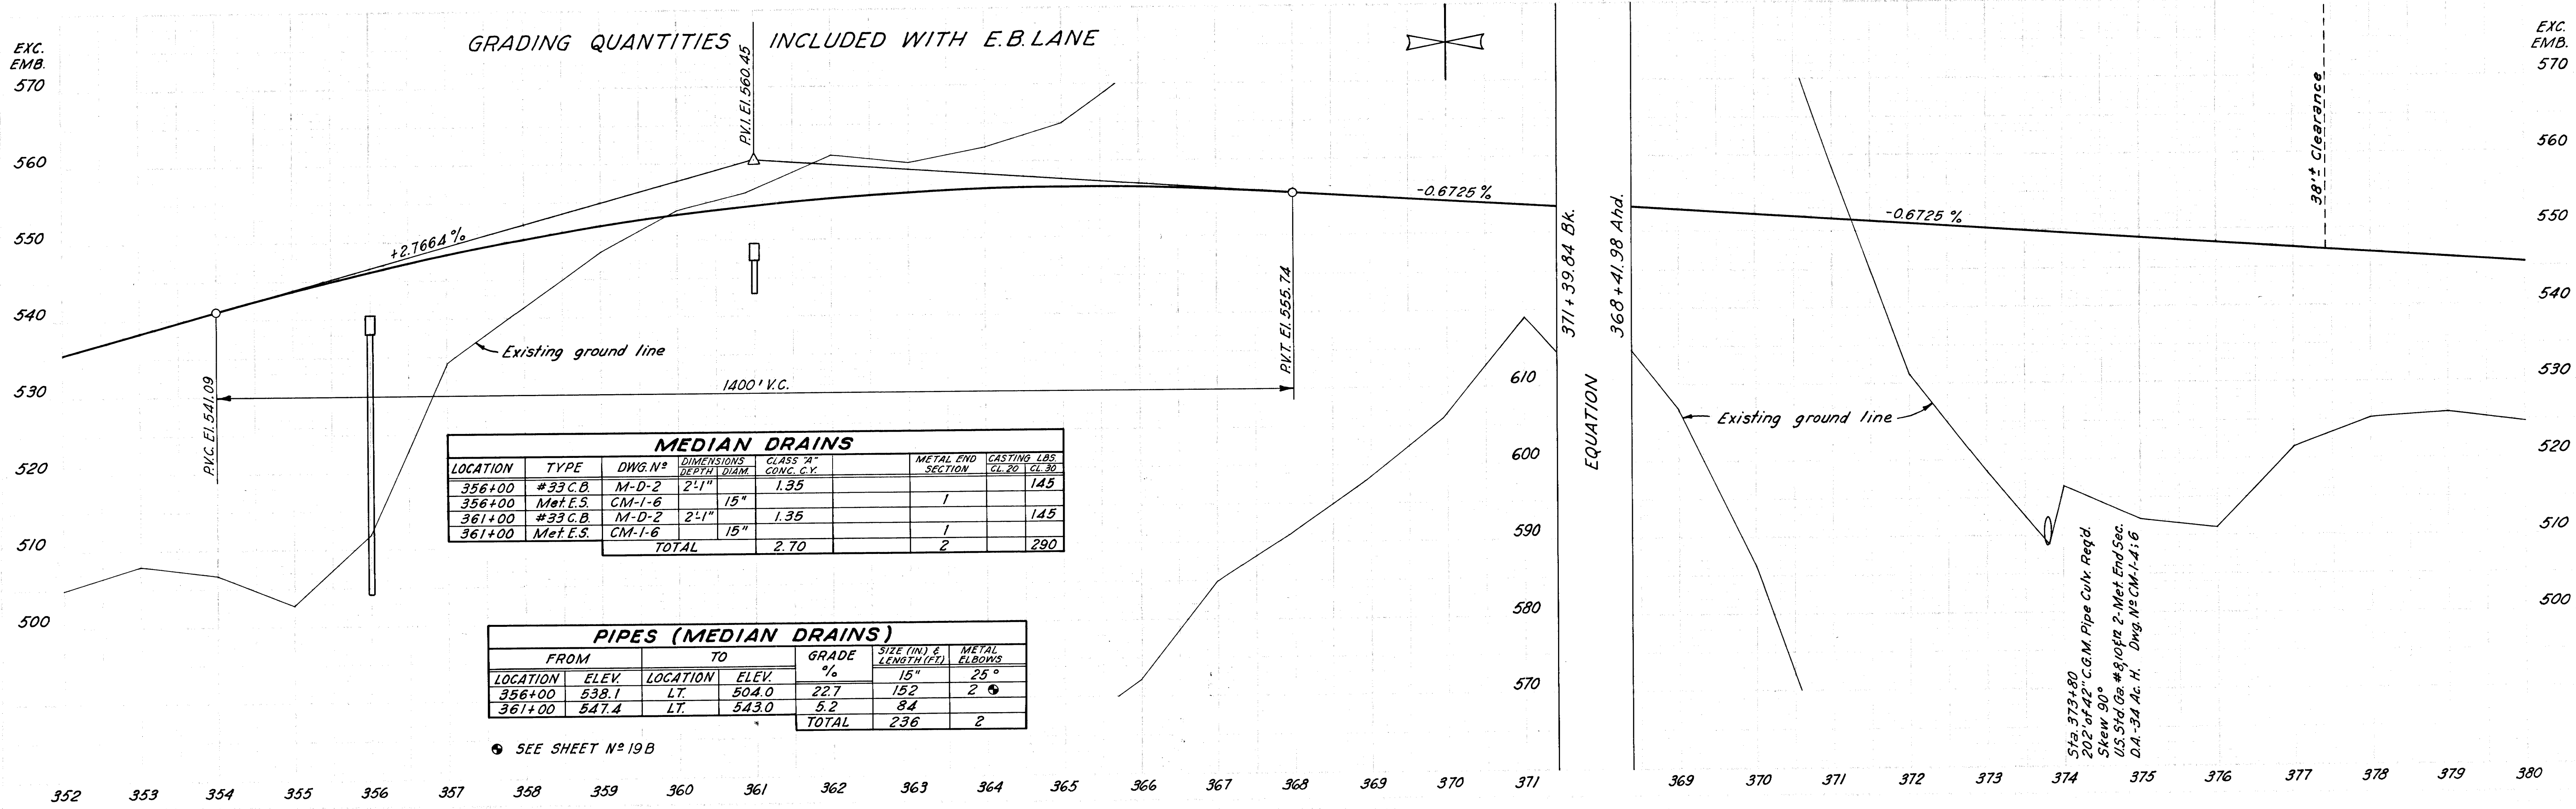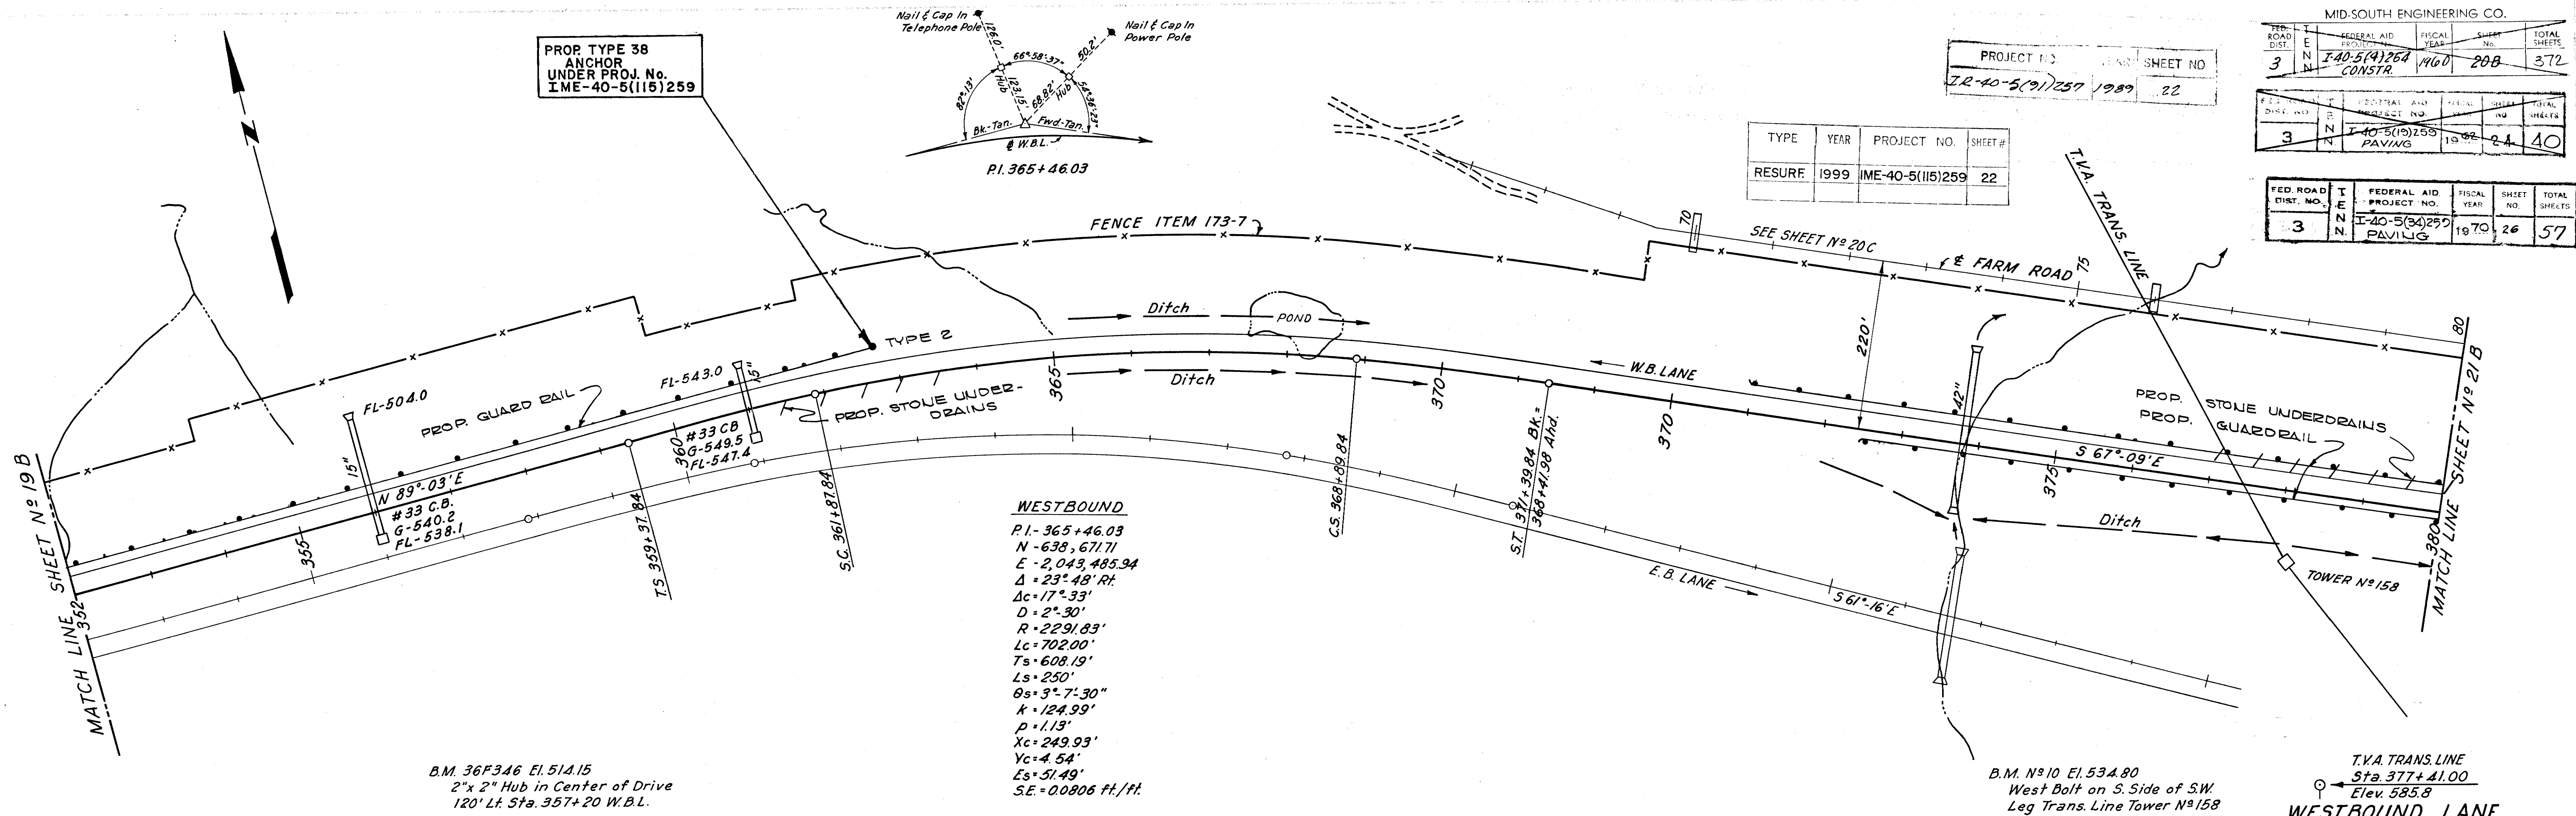


TENN. STATE HIGHWAYS	
Plans	File IN
Divn.	No. 50

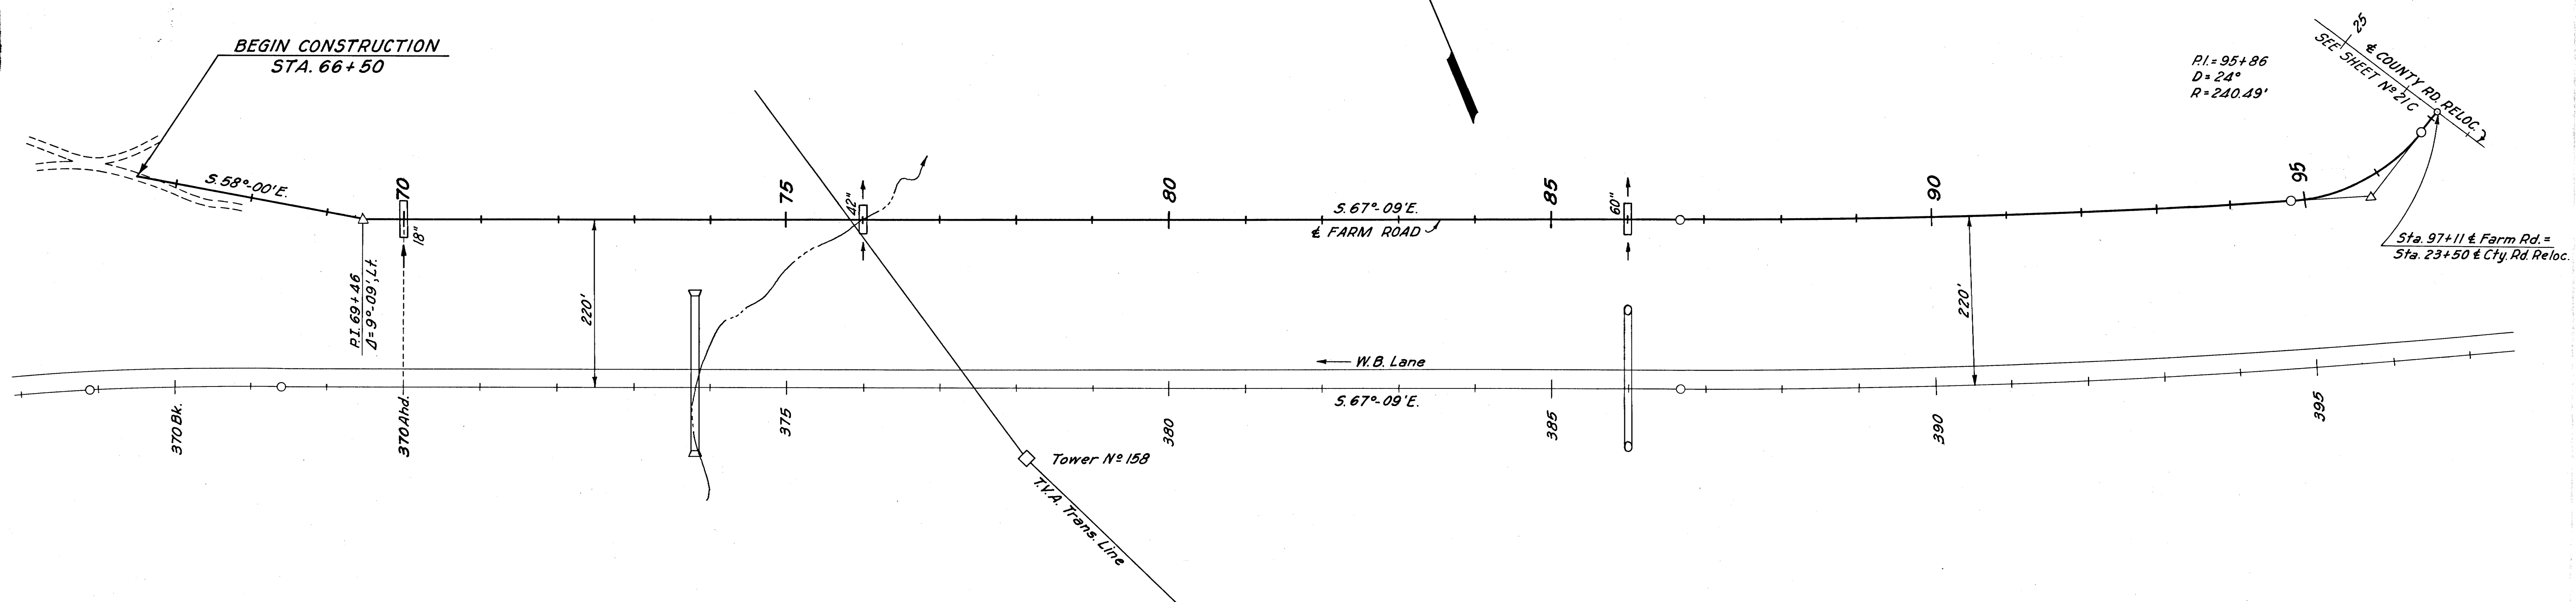

**FARM ROAD
STA. 370 TO STA. 397**

GRADING QUANTITIES INCLUDED WITH INTERSTATE

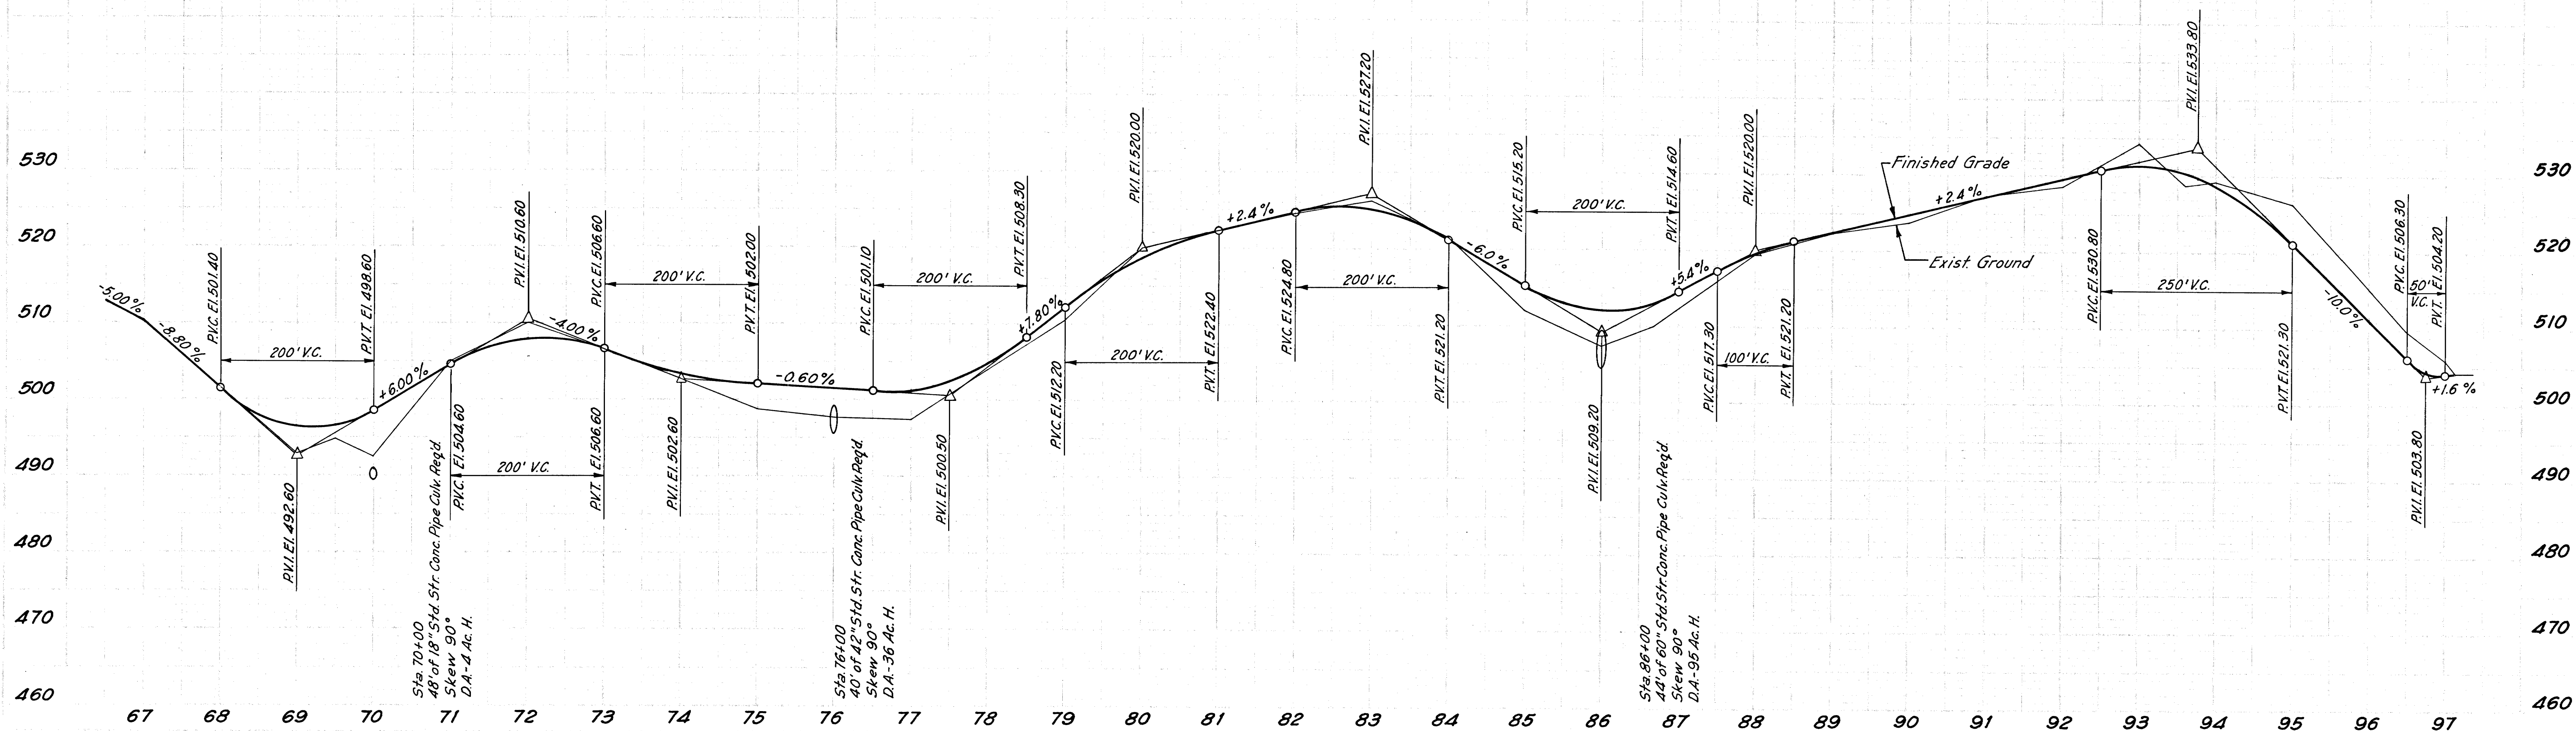

EASTBOUND
 PI=405+71.49
 N-636,614.44
 E-2,047,024.98
 Δ=22°27' Lt.
 D=0°45'
 R=7,639.44'
 T=1,516.11'
 L=2,993.33'
 E_c=148.99'

WESTBOUND
 PI=399+71.15
 N-637,220.42
 E-2,046,930.01
 Δ=13°00' Lt.
 D=0°30'
 R=11,459.16'
 T=1,305.61'
 L=2,600.00'
 E_c=74.14'


GRADE SEPARATION
 PI=21+19.60
 Δ=47°30' Lt.
 D=22°
 R=260.44'
 T=114.60'
 L=215.91'

EDGAR ROBINSON
 TRACT N° 38
 PARCEL N° 1 = 1.69 Ac. C.A.
 PARCEL N° 2 = 4725 Ac. C.A.
 PARCEL N° 3 = 3.18 Ac. U.C.A.
 TOTAL = 52.12 Ac.
 EASEMENTS: OUTLET DITCH, 0.02 AC.,
 CHANNEL CHANGE, SHEET NO. 22,
 0.40 AC.

E.D. ROBINSON
 TRACT N° 37
 PARCEL N° 1 = 29.20 Ac. C.A.
 PARCEL N° 2 = 2.17 Ac. U.C.A.
 PARCEL N° 3 = 0.23 Ac. U.C.A.
 TOTAL = 31.37 Ac.
 EASEMENT = 0.20 AC.

FED. ROAD DIST. NO.	T	FEDERAL AID PROJECT NO.	FISCAL YEAR	SHEET NO.	TOTAL SHEETS
3	N	I-40-5(8)259	1959	21	25

REVISED 7-15-59; EASEMENT FOR OUTLET DITCH ADDED.
 REVISED 7-31-59; LINE CHANGE ON GRADE SEPARATION AHEAD OF STA. 20.
 REVISED 2-24-60; ADDED EASEMENT AREAS TRACTS NOS. 37 & 38

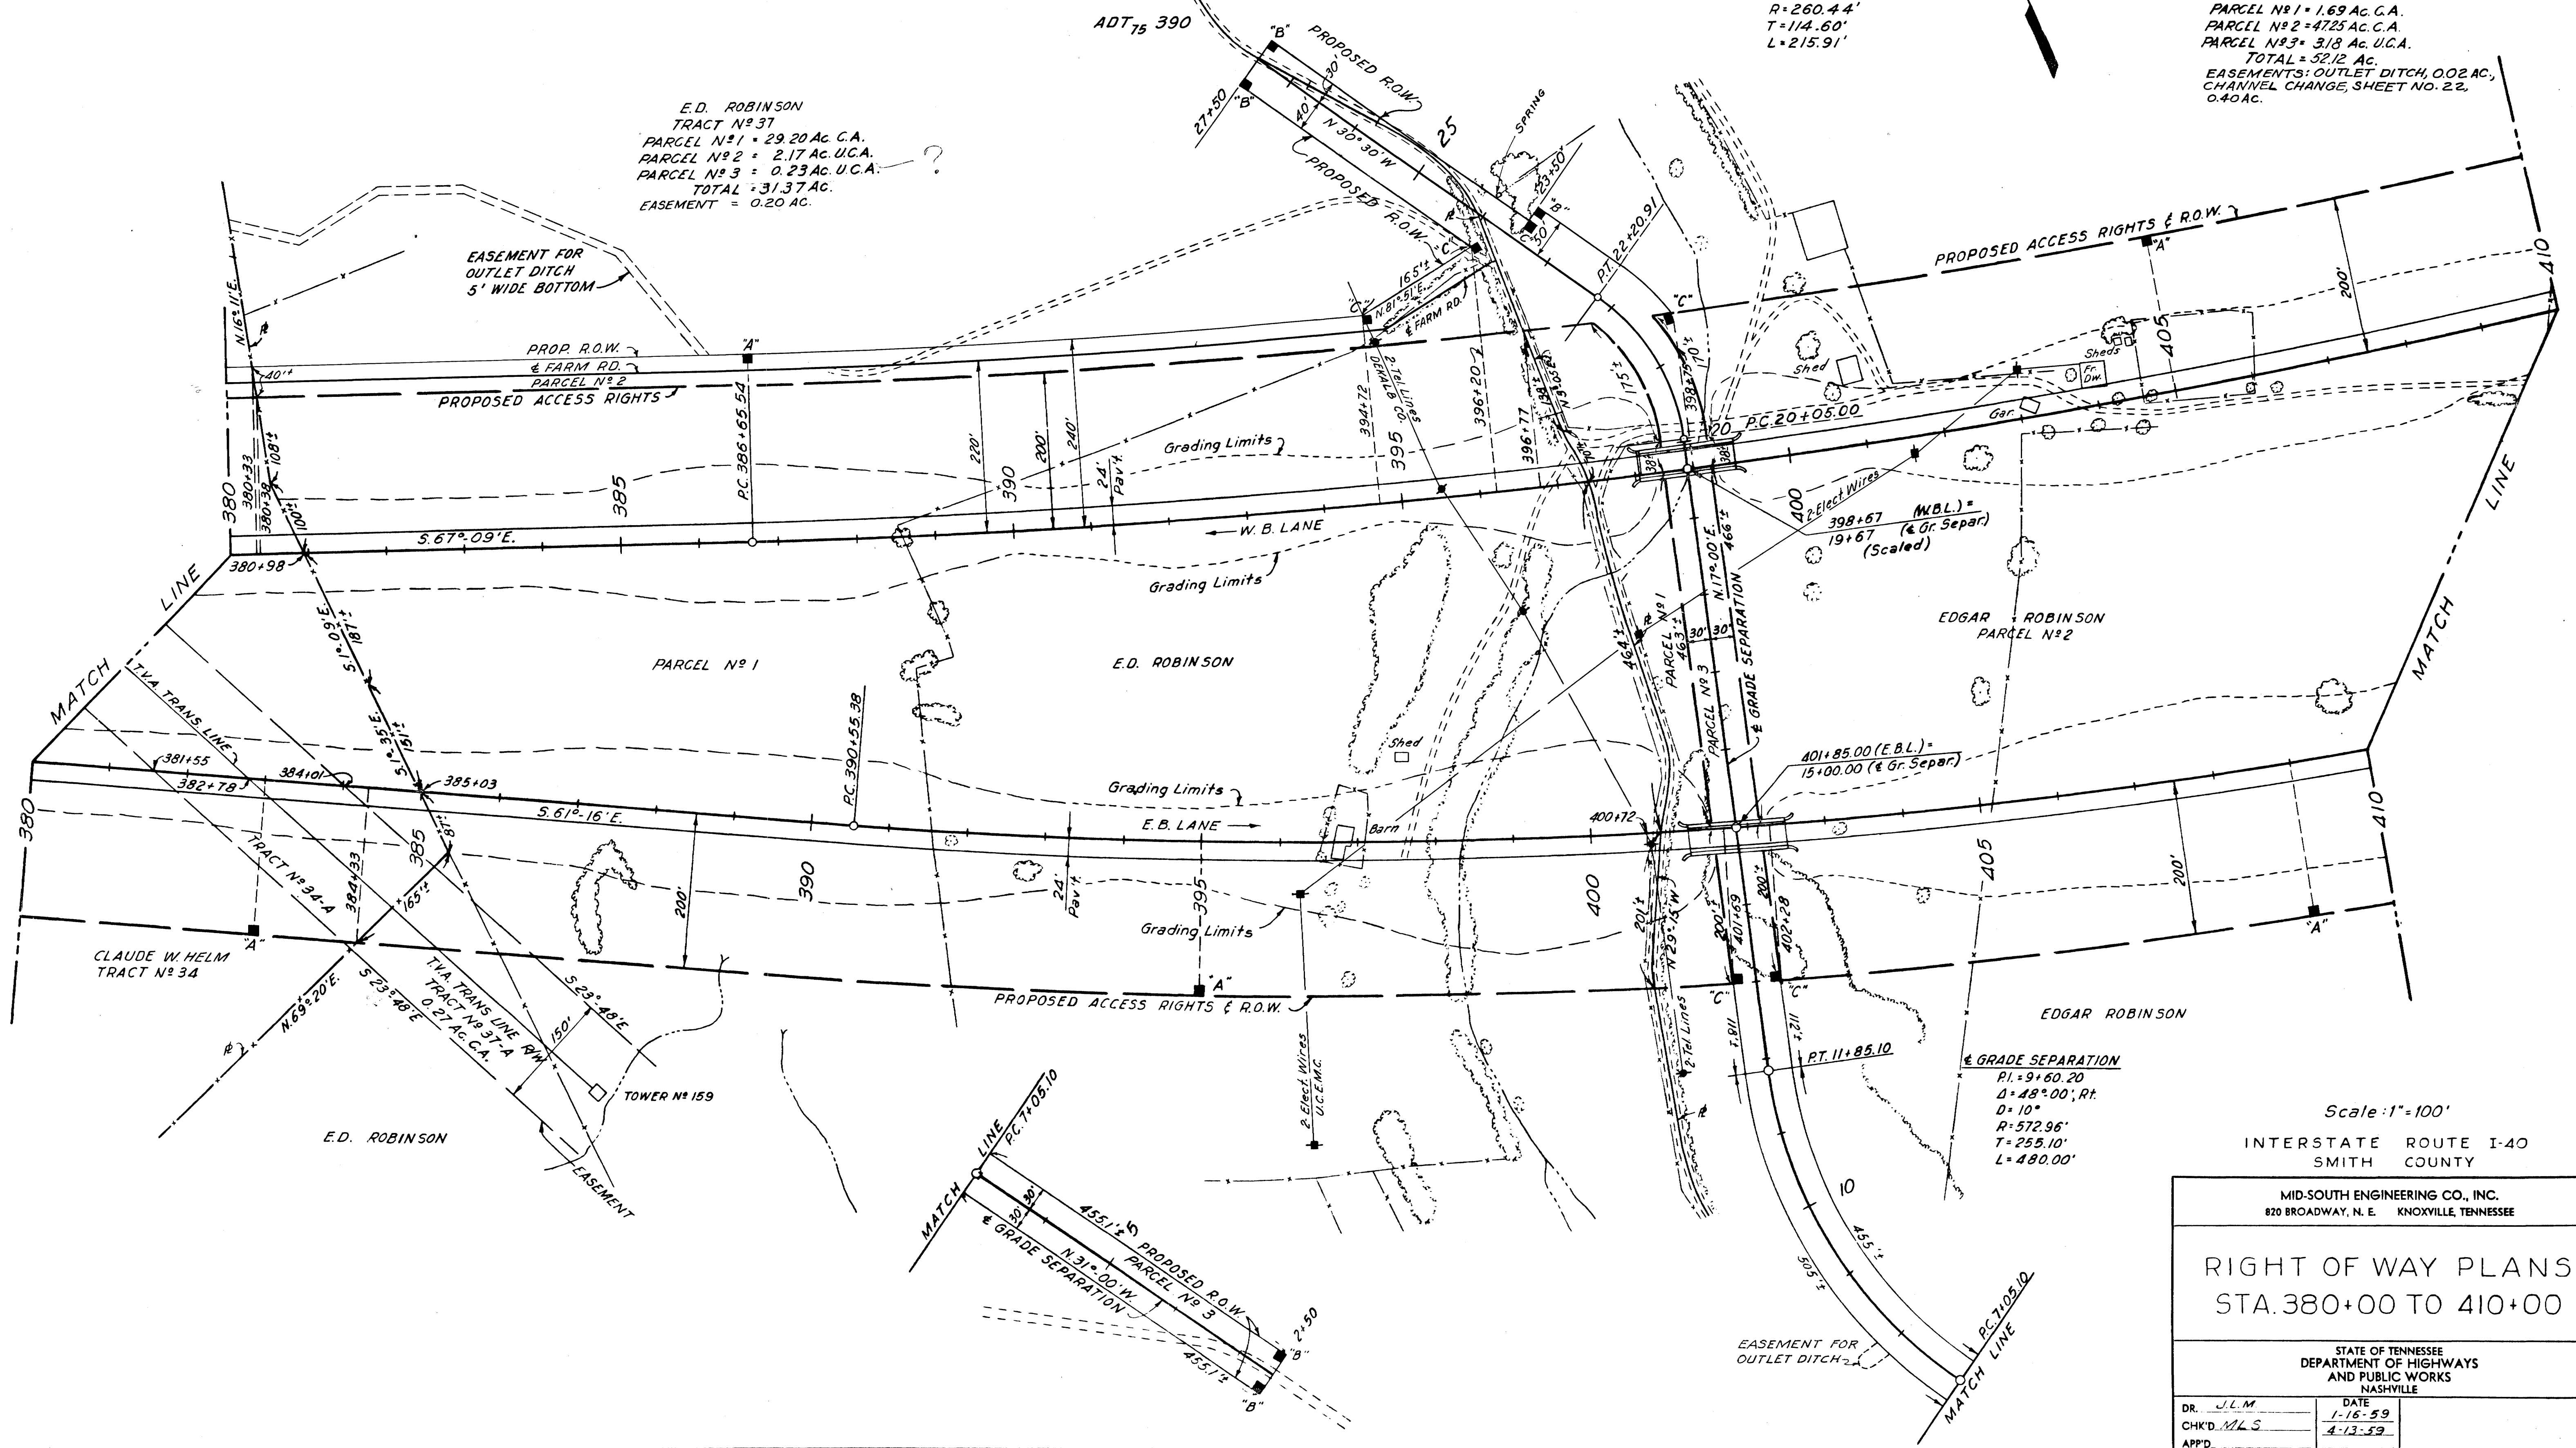

Scale: 1"=100'



INTERSTATE ROUTE I-40
 SMITH COUNTY

MID-SOUTH ENGINEERING CO., INC.
 820 BROADWAY, N. E. KNOXVILLE, TENNESSEE


RIGHT OF WAY PLANS STA. 380+00 TO 410+00

STATE OF TENNESSEE
 DEPARTMENT OF HIGHWAYS
 AND PUBLIC WORKS
 NASHVILLE

DR. J.L.M.	DATE 1-16-59
CHK'D. M.L.S.	4-13-59
APP'D.	

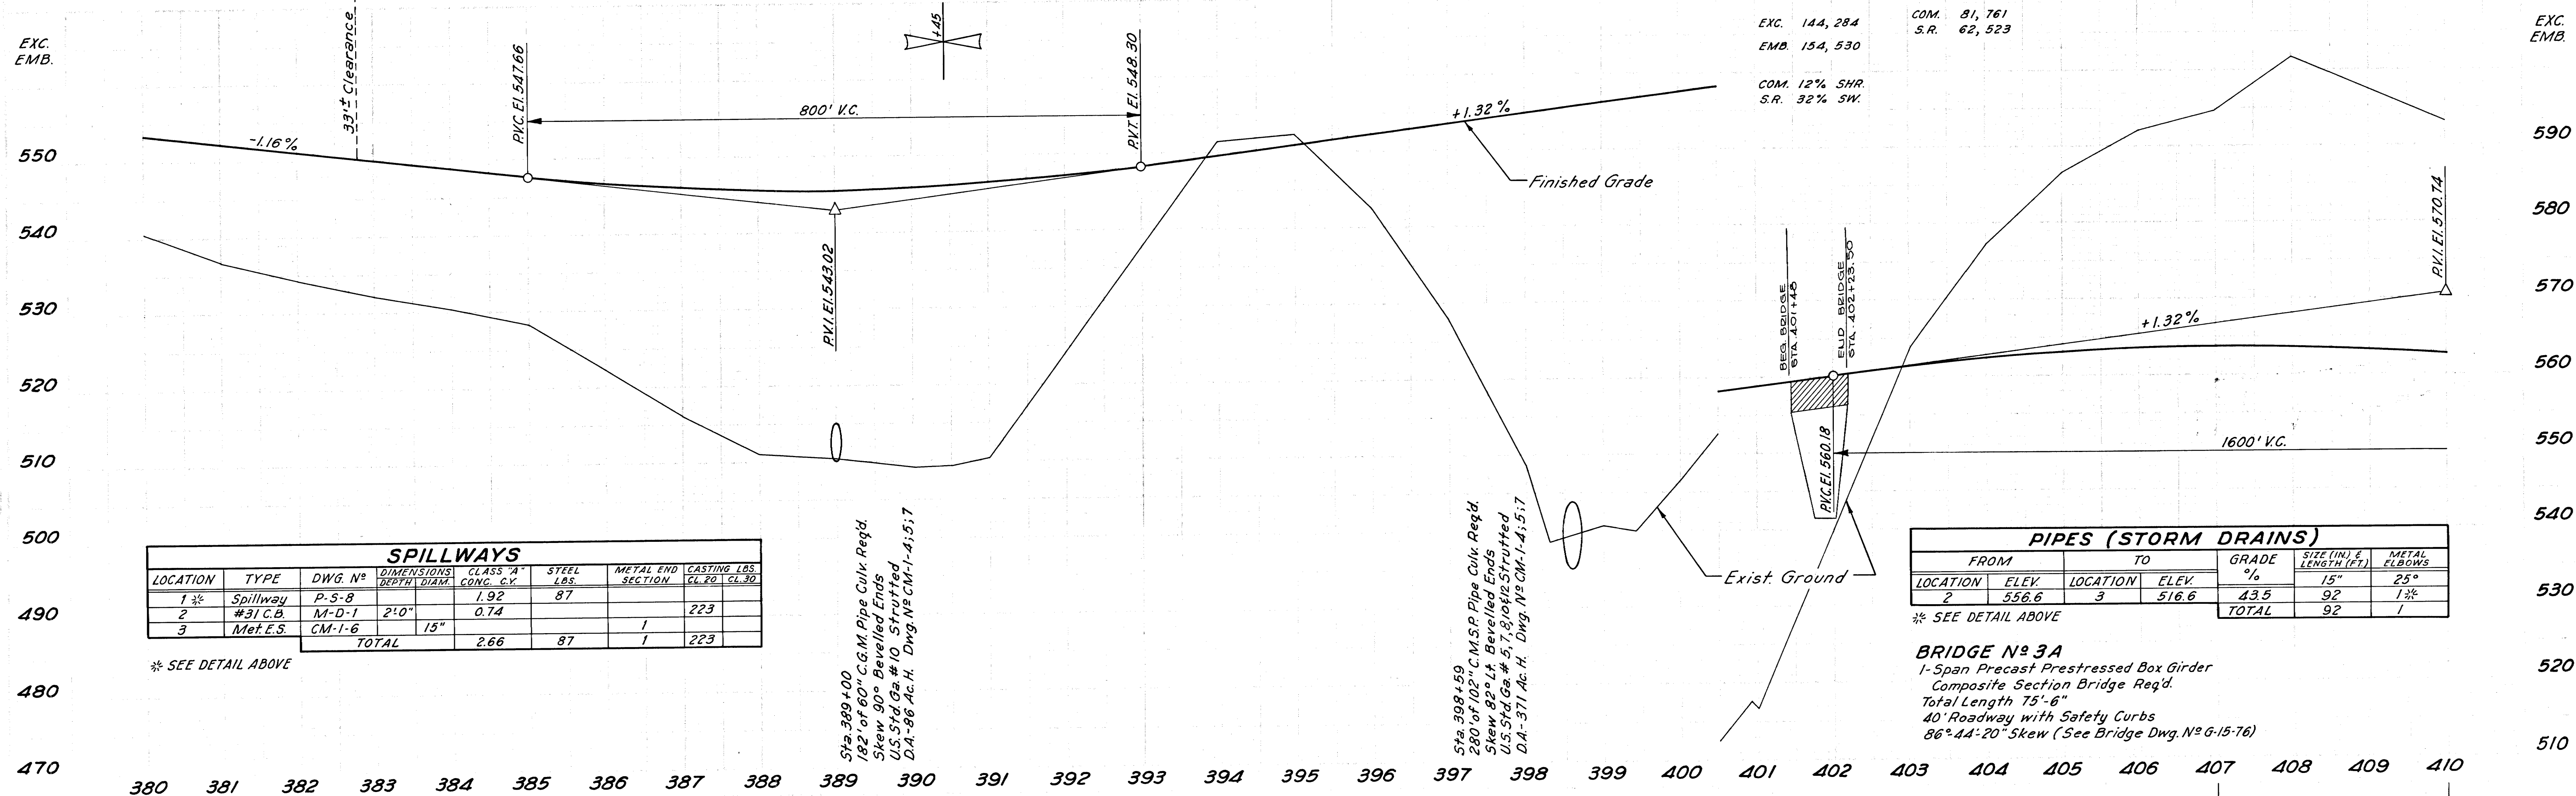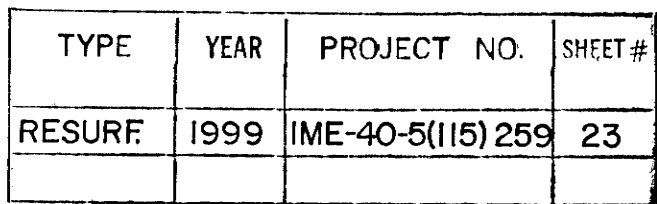

WESTBOUND
PI=399+71.15
N=637,220.42
E=2,046,930.01
Δ=13°00', Lt.
D=0°30'
R=11,459.16'
T=1,305.61'
L=2,600.00'
E_c=74.14'
S.E.=0.0161 ft./ft.

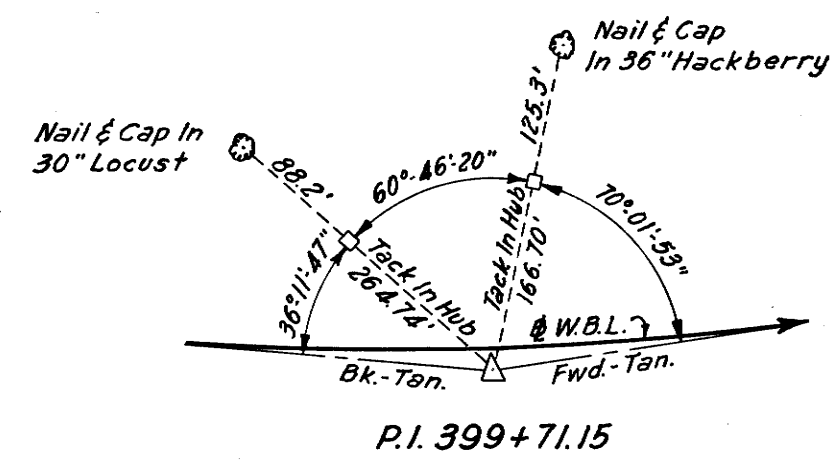



FED. ROAD DIST. NO.	T E N	FEDERAL AID PROJECT NO.	FISCAL YEAR	SHEET NO.	TOTAL SHEETS
3	N	1-40-5(15)259	1970	28	57




PROJECT NO.	YEAR	SHEET NO.
1-40-5(15)259	1970	24

FED. ROAD DIST. NO.	T E N	FEDERAL AID PROJECT NO.	FISCAL YEAR	SHEET NO.	TOTAL SHEETS
3	N	1-40-5(15)259	1970	26	40

REV. 11-16-G2: GRADE CHANGED ON CONSTRUCTION BETWEEN STA. 401+00 AND 410+00.


TYPE	YEAR	PROJECT NO.	SHEET #
RESURF	1999	IME-40-5(115)259	24

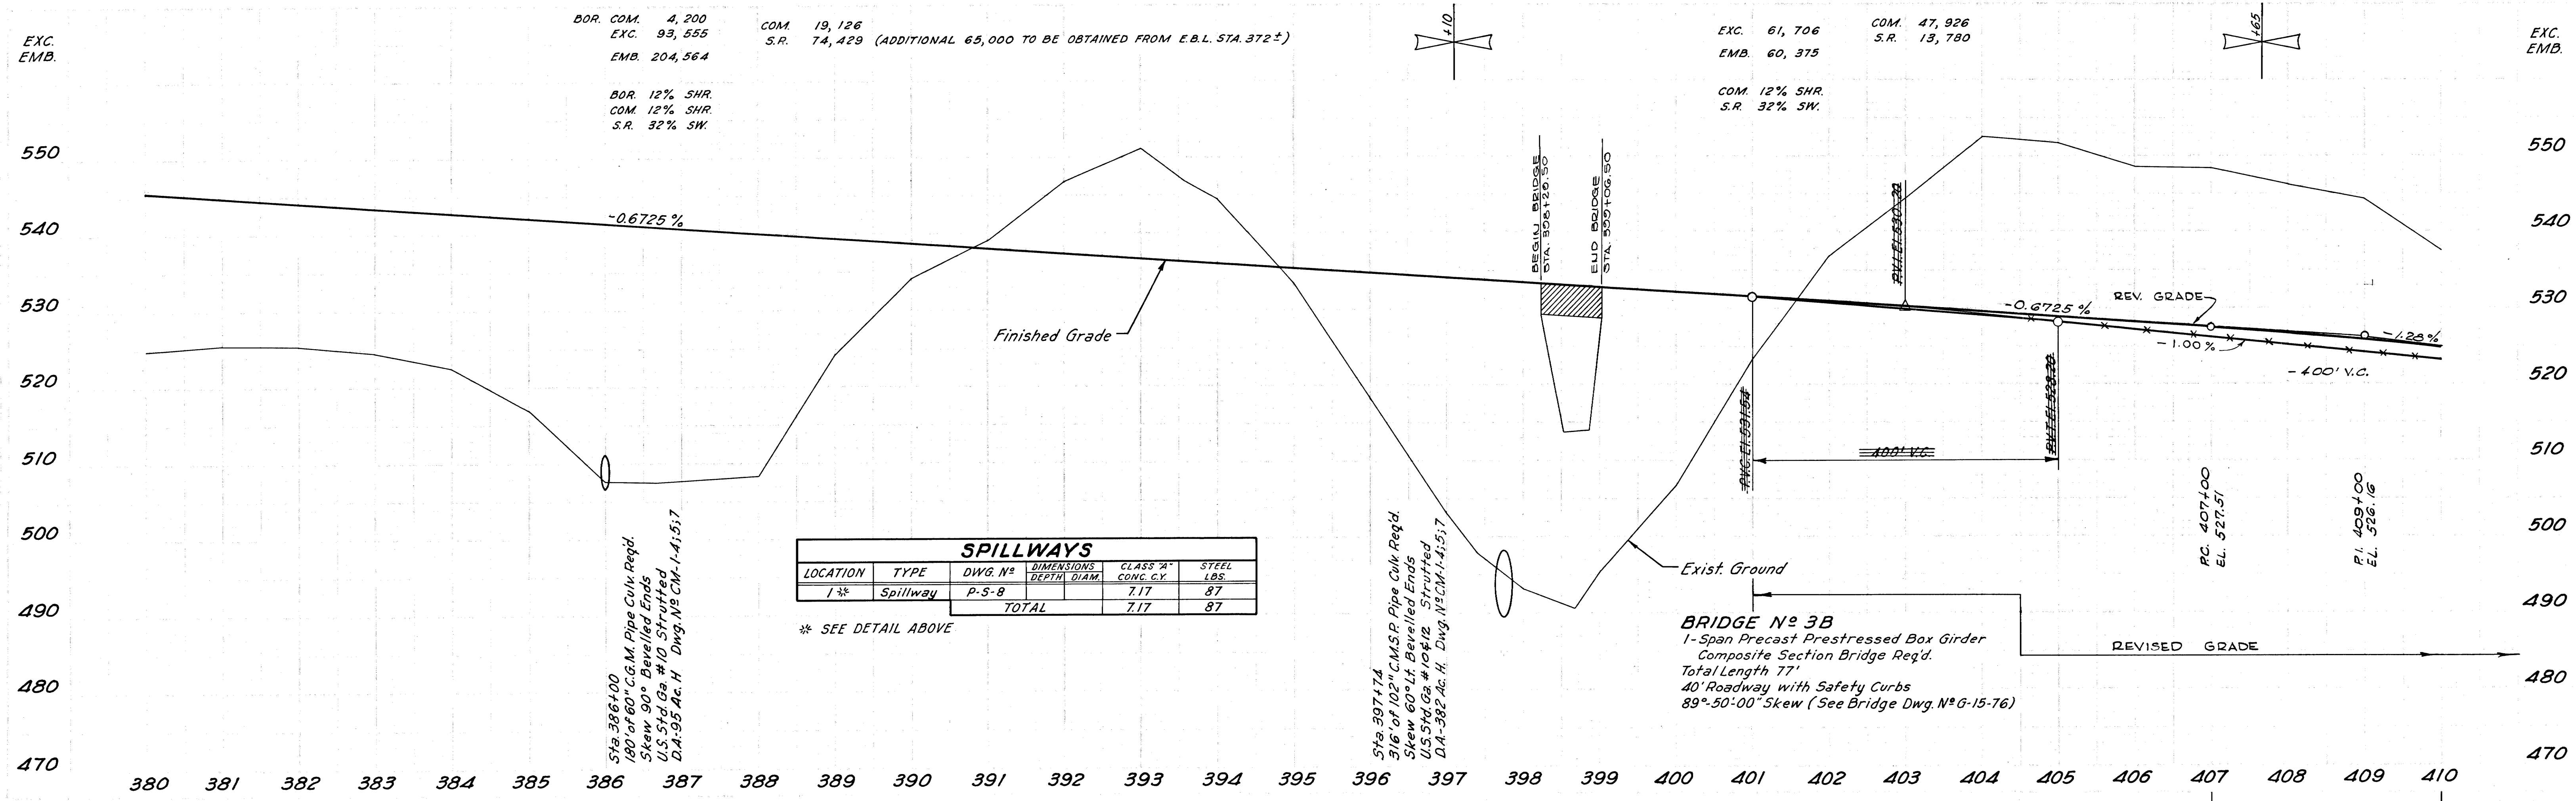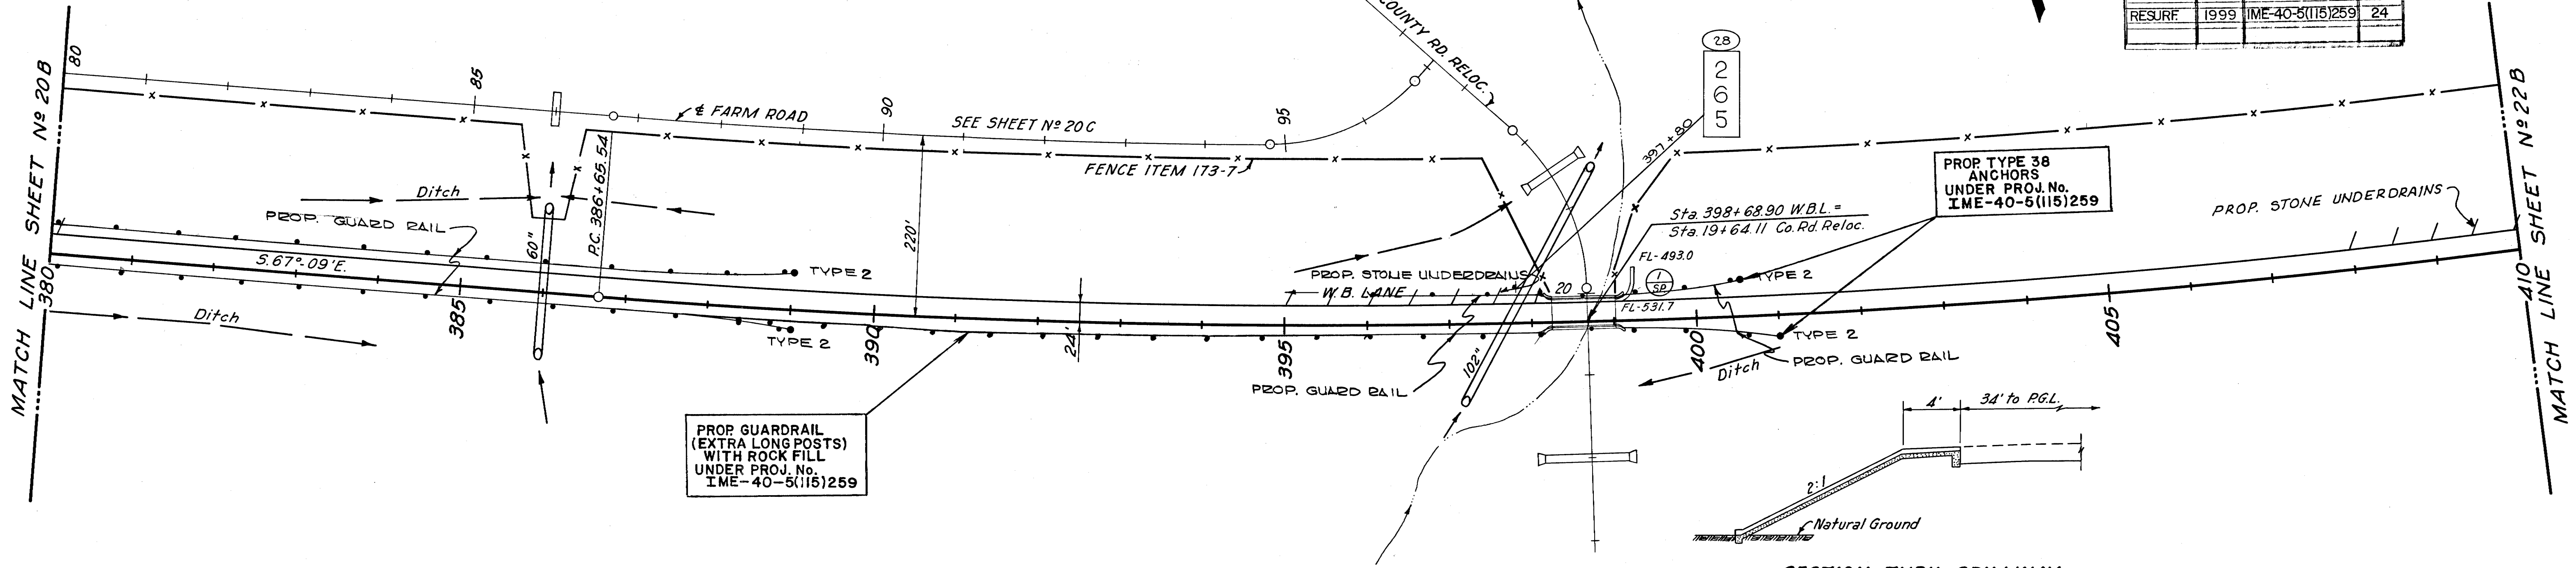

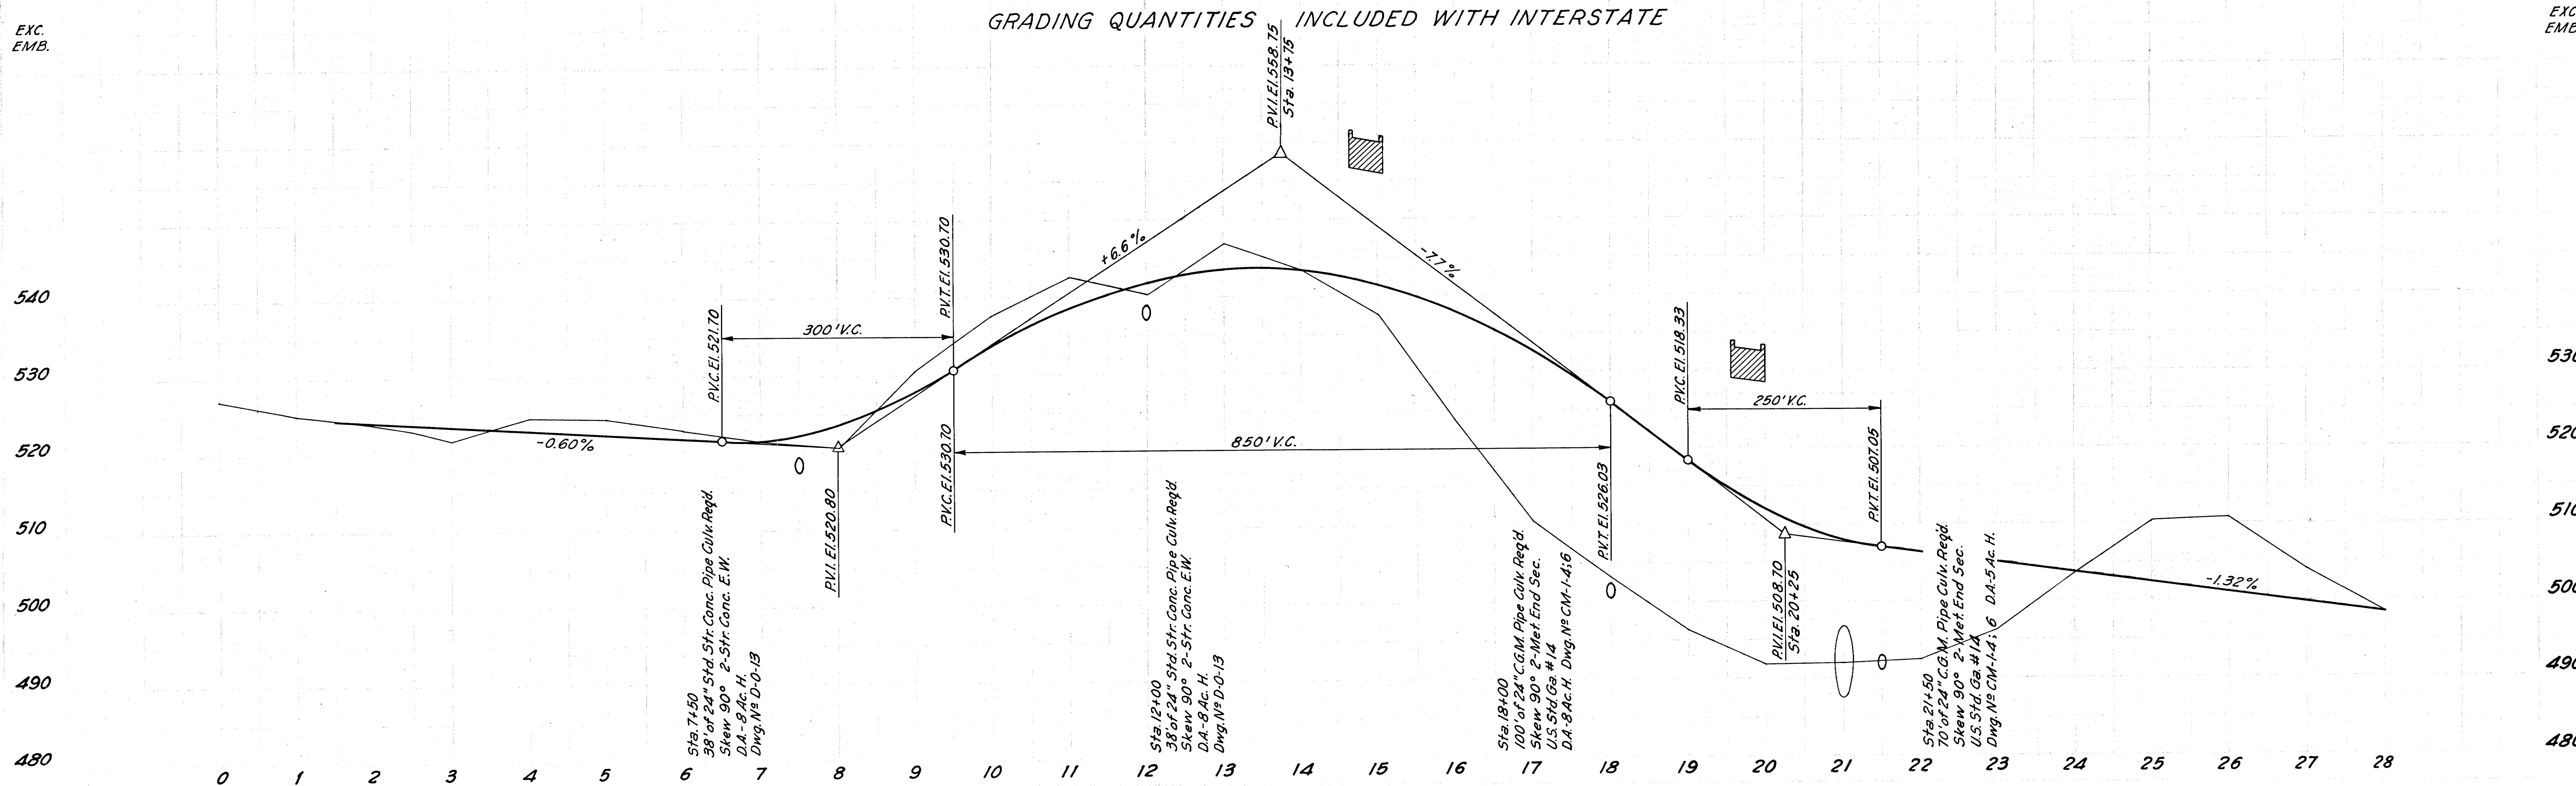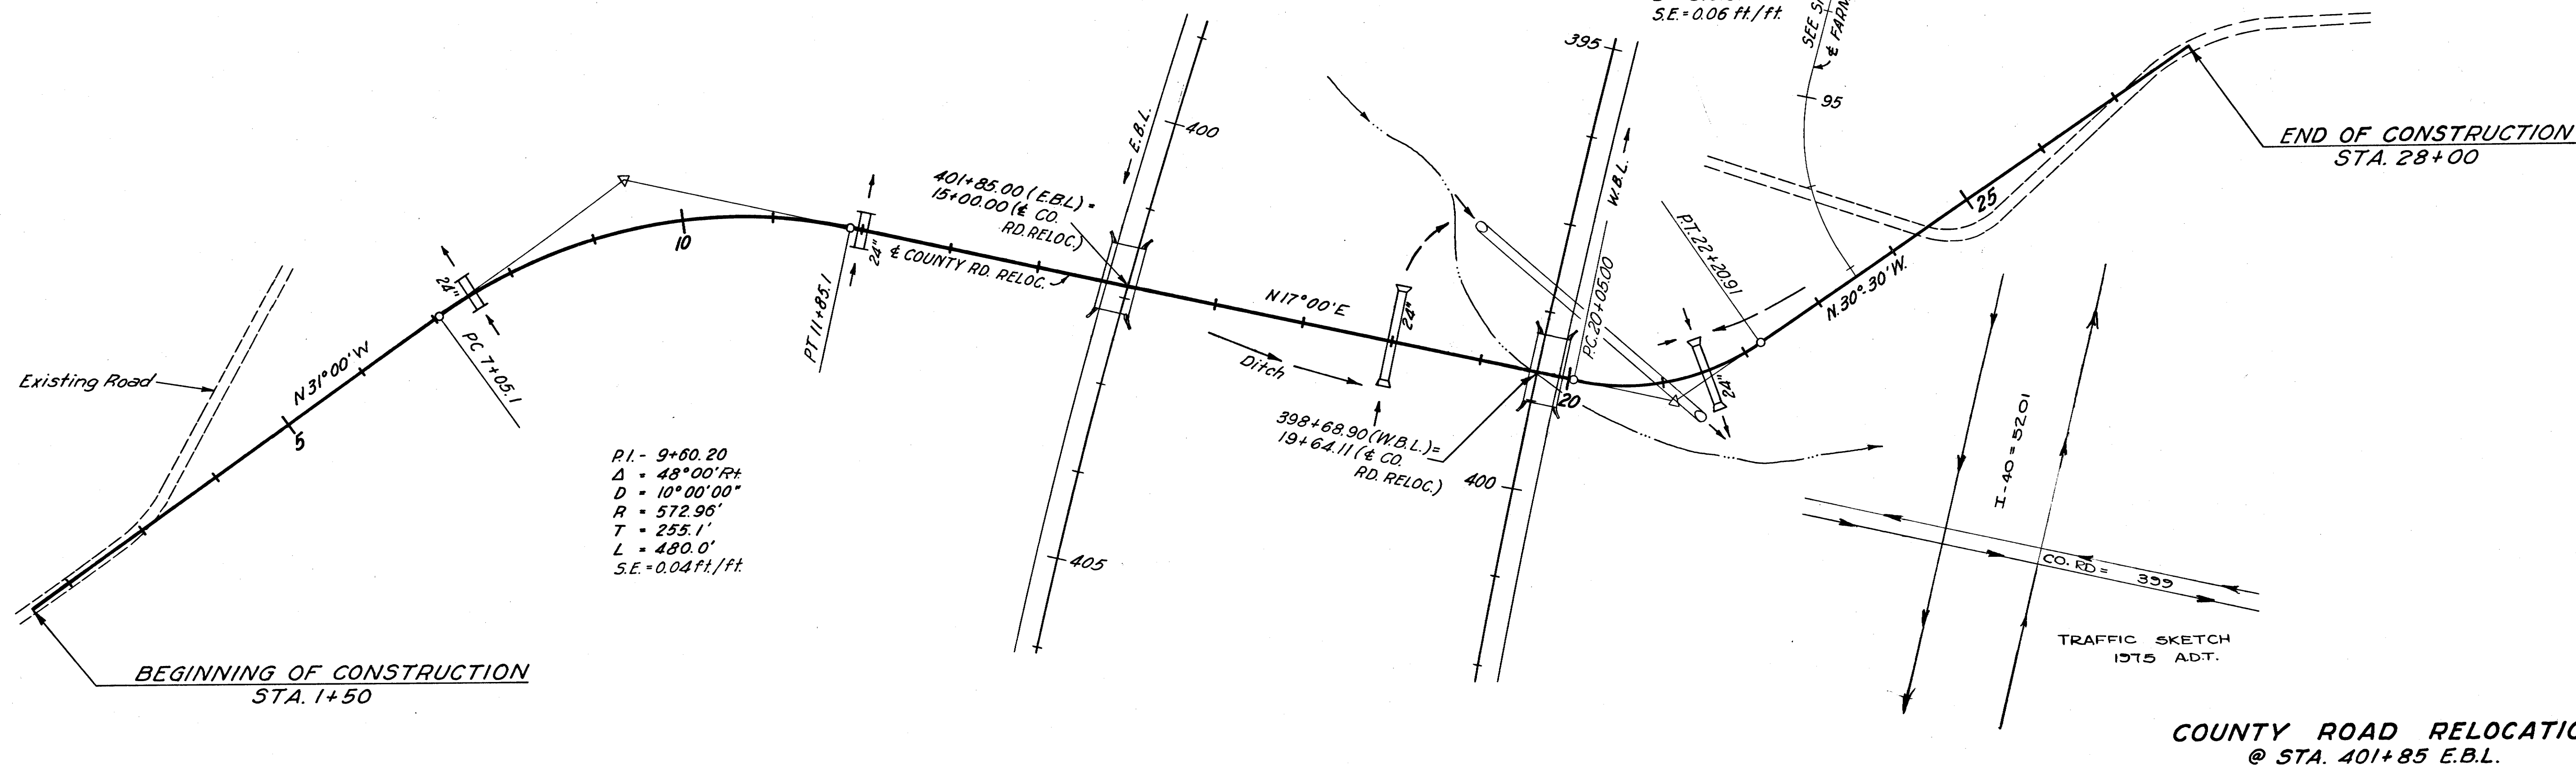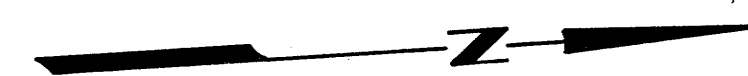

FED. ROAD DIST. NO.	T	FEDERAL AID PROJECT NO.	FISCAL YEAR	SHEET NO.	TOTAL SHEETS	FED. ROAD DIST. NO.	T	FEDERAL AID PROJECT NO.	FISCAL YEAR	SHEET NO.	TOTAL SHEETS
3	N	I-40-5(8)264	1959	22	372	3	N	I-40-5(8)259	1959	22	25
		CONSTR.						R.O.W.			

REV. 2-29-60 ADDED POND LT. OF STA. 421+50

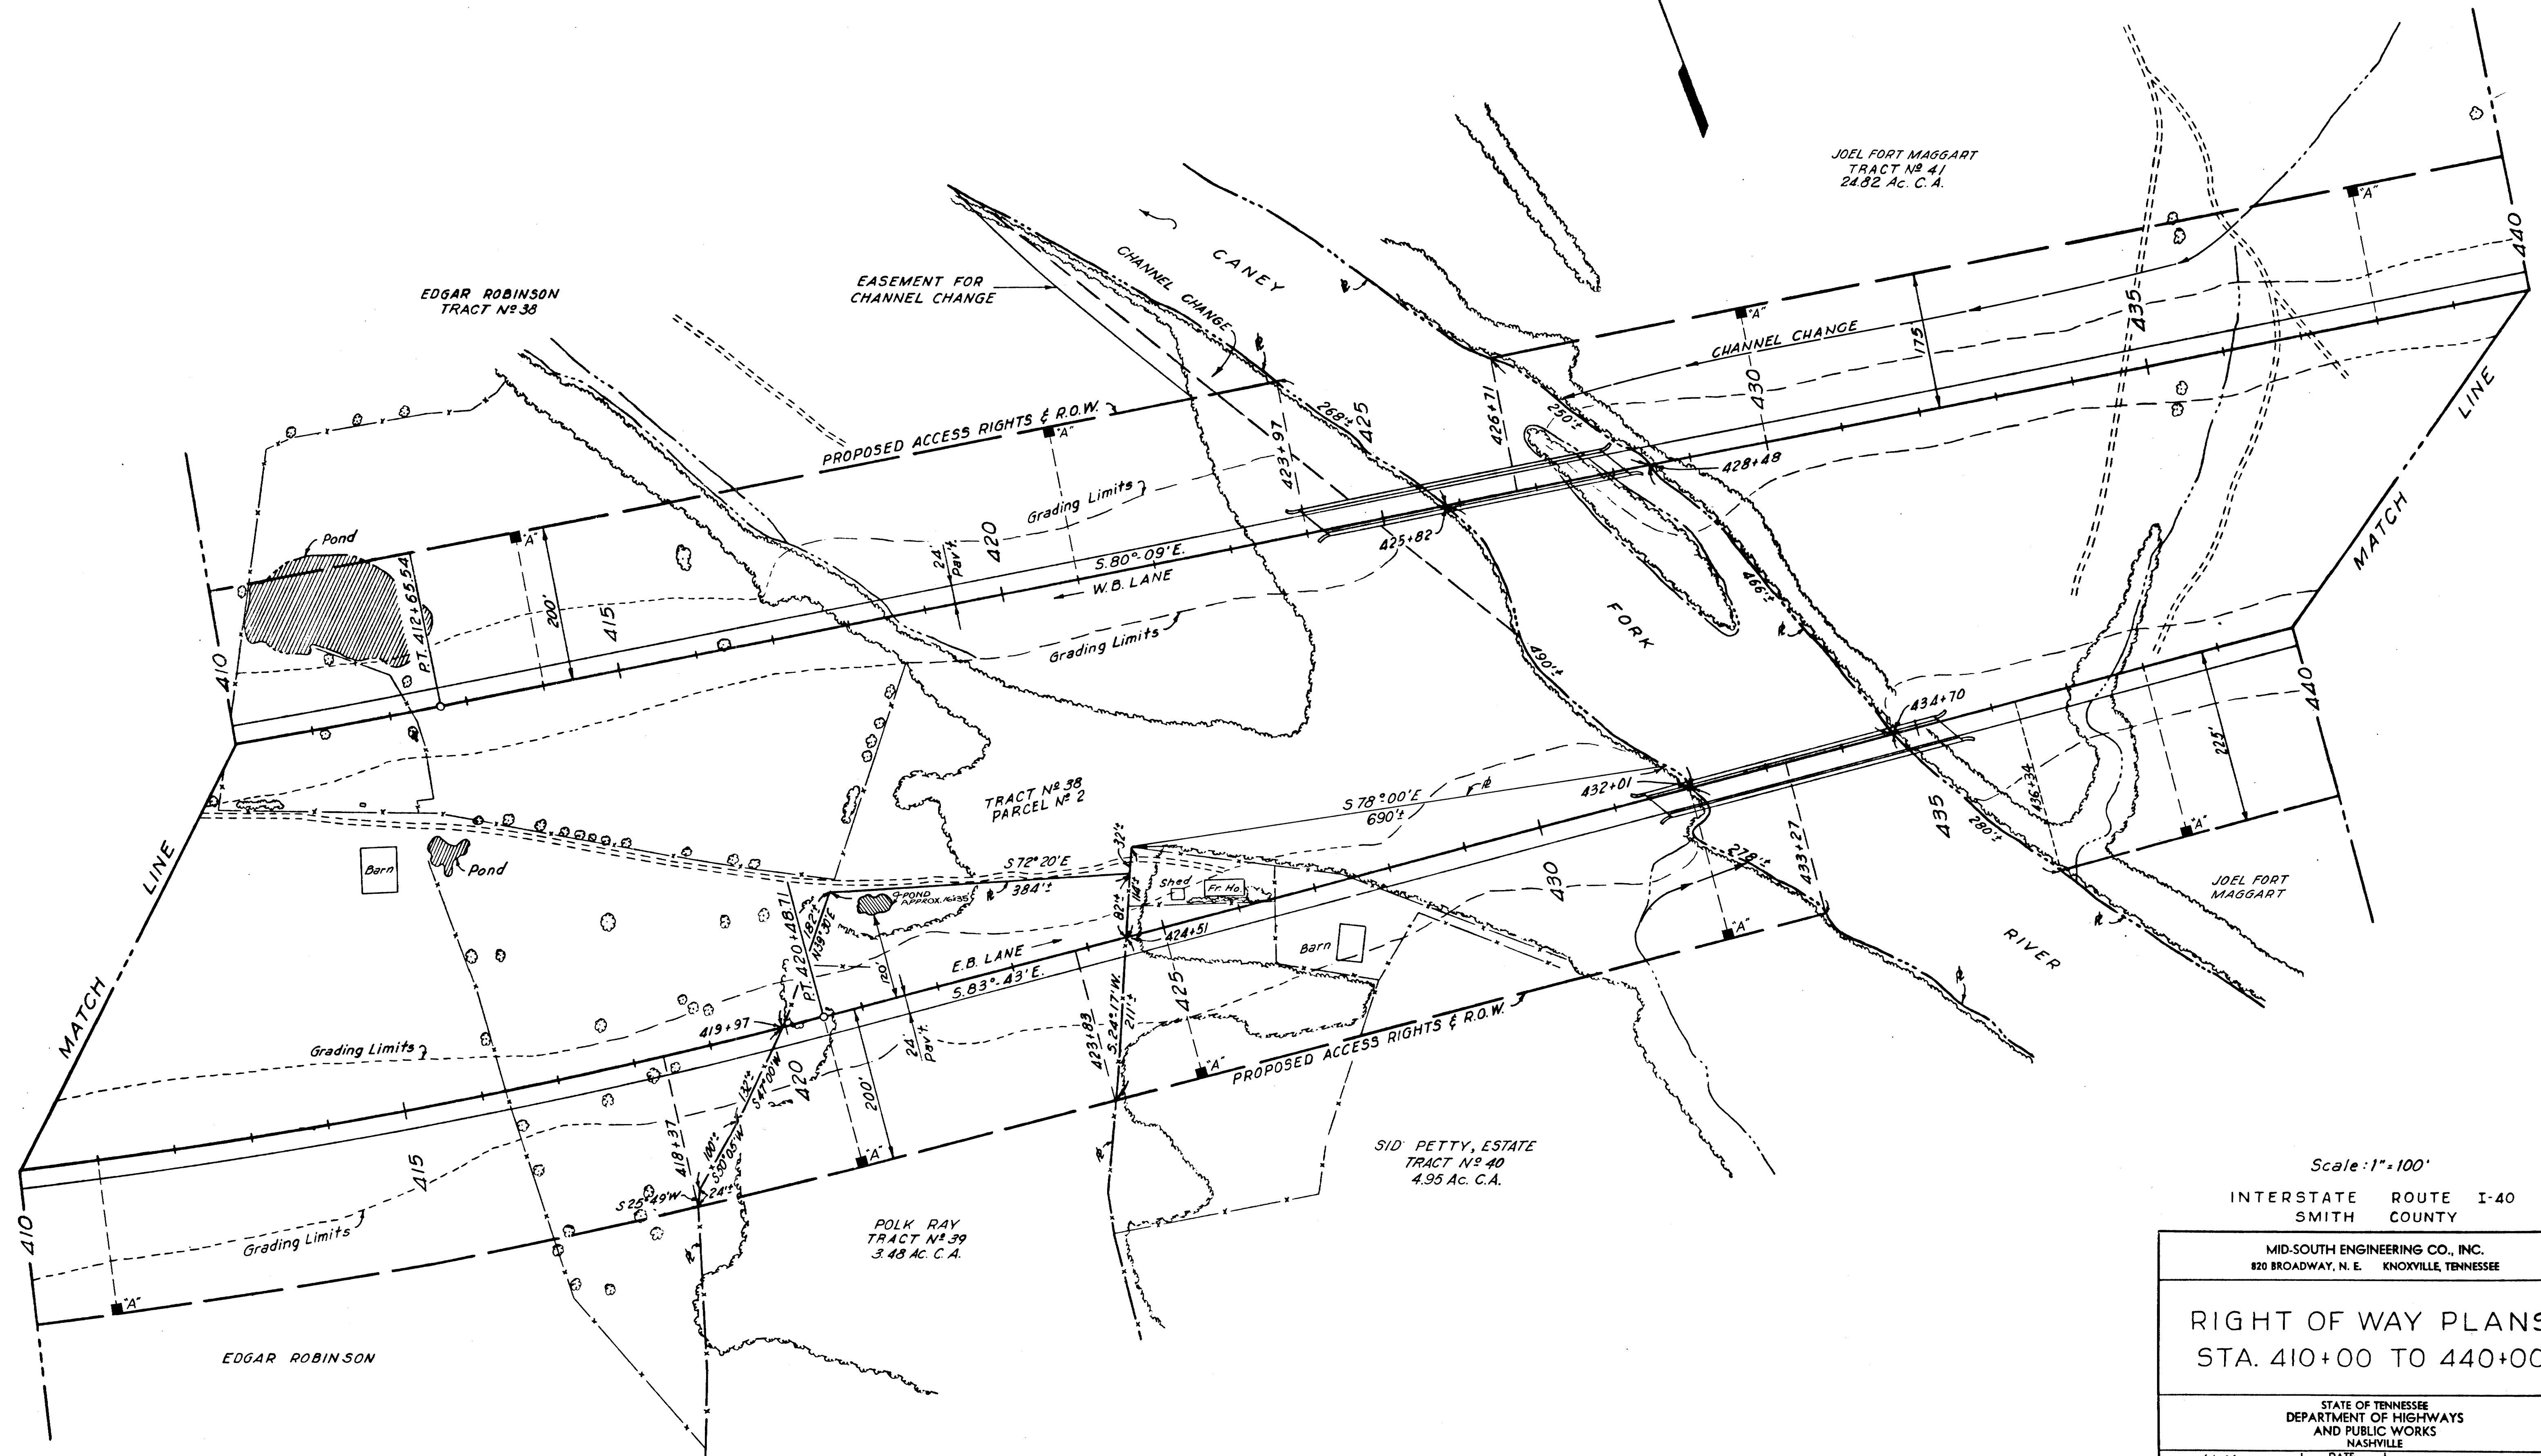

Scale: 1"=100'


INTERSTATE ROUTE I-40
SMITH COUNTY

MID-SOUTH ENGINEERING CO., INC. 820 BROADWAY, N. E. KNOXVILLE, TENNESSEE	
RIGHT OF WAY PLANS STA. 410+00 TO 440+00	
STATE OF TENNESSEE DEPARTMENT OF HIGHWAYS AND PUBLIC WORKS NASHVILLE	
DR. J.L.M.	DATE 1-16-59
CHK'D. M.L.S.	4-14-59
APP'D.	

FILED
No. 24

~~3 I-40-5(4)264 1460 22A 372~~
~~CONSTR.~~

TYPE	YEAR	PROJECT NO.	SHEET #
RESURF.	1999	IME-40-5(115)259	25

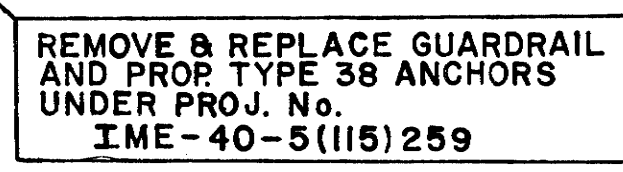

EXC.
EMB.



SPILLWAYS					
LOCATION	TYPE	DWG. N ^o	DIMENSIONS DEPTH DIAM.	CLASS "A" CONG. C.Y.	STEEL LBS.
1 %	Spillway	P. S-8		3.54	87
TOTAL				3.54	87

* SEE SHEET N° 19A

BRIDGE No 4A
 1-5 Span Precast Prestressed "I" Beam Bridge Req'd.
 2-Spans @ 72' 6"; 3-Spans @ 83'
 Total Length 394'
 30' Roadway with Safety Curbs
 53° 00' Skew (See Bridge Dwg. No G-15-82)



FED. ROAD DIST. NO.	T E N	FEDERAL AID PROJECT NO.	NSCAL YEAR	SHEET NO.	TOTAL SHEETS
3	N	ME-40-5(115)259	1970	30	57
PAVING					

FED. ROAD DIST. NO.	T E N	FEDERAL AID PROJECT NO.	NSCAL YEAR	SHEET NO.	TOTAL SHEETS
3	N	ME-40-5(115)259	1970	28	40
PAVING					

PROJECT NO.	YEAR	SHEET NO.
ME-40-5(115)259	1970	24



REV. 11-16-62: GRADE CHANGED ON CONSTRUCTION BETWEEN STA. 401+00 AND 418+00.

TYPE	YEAR	PROJECT NO.	SHEET #
RESURF	1999	ME-40-5(115)259	26

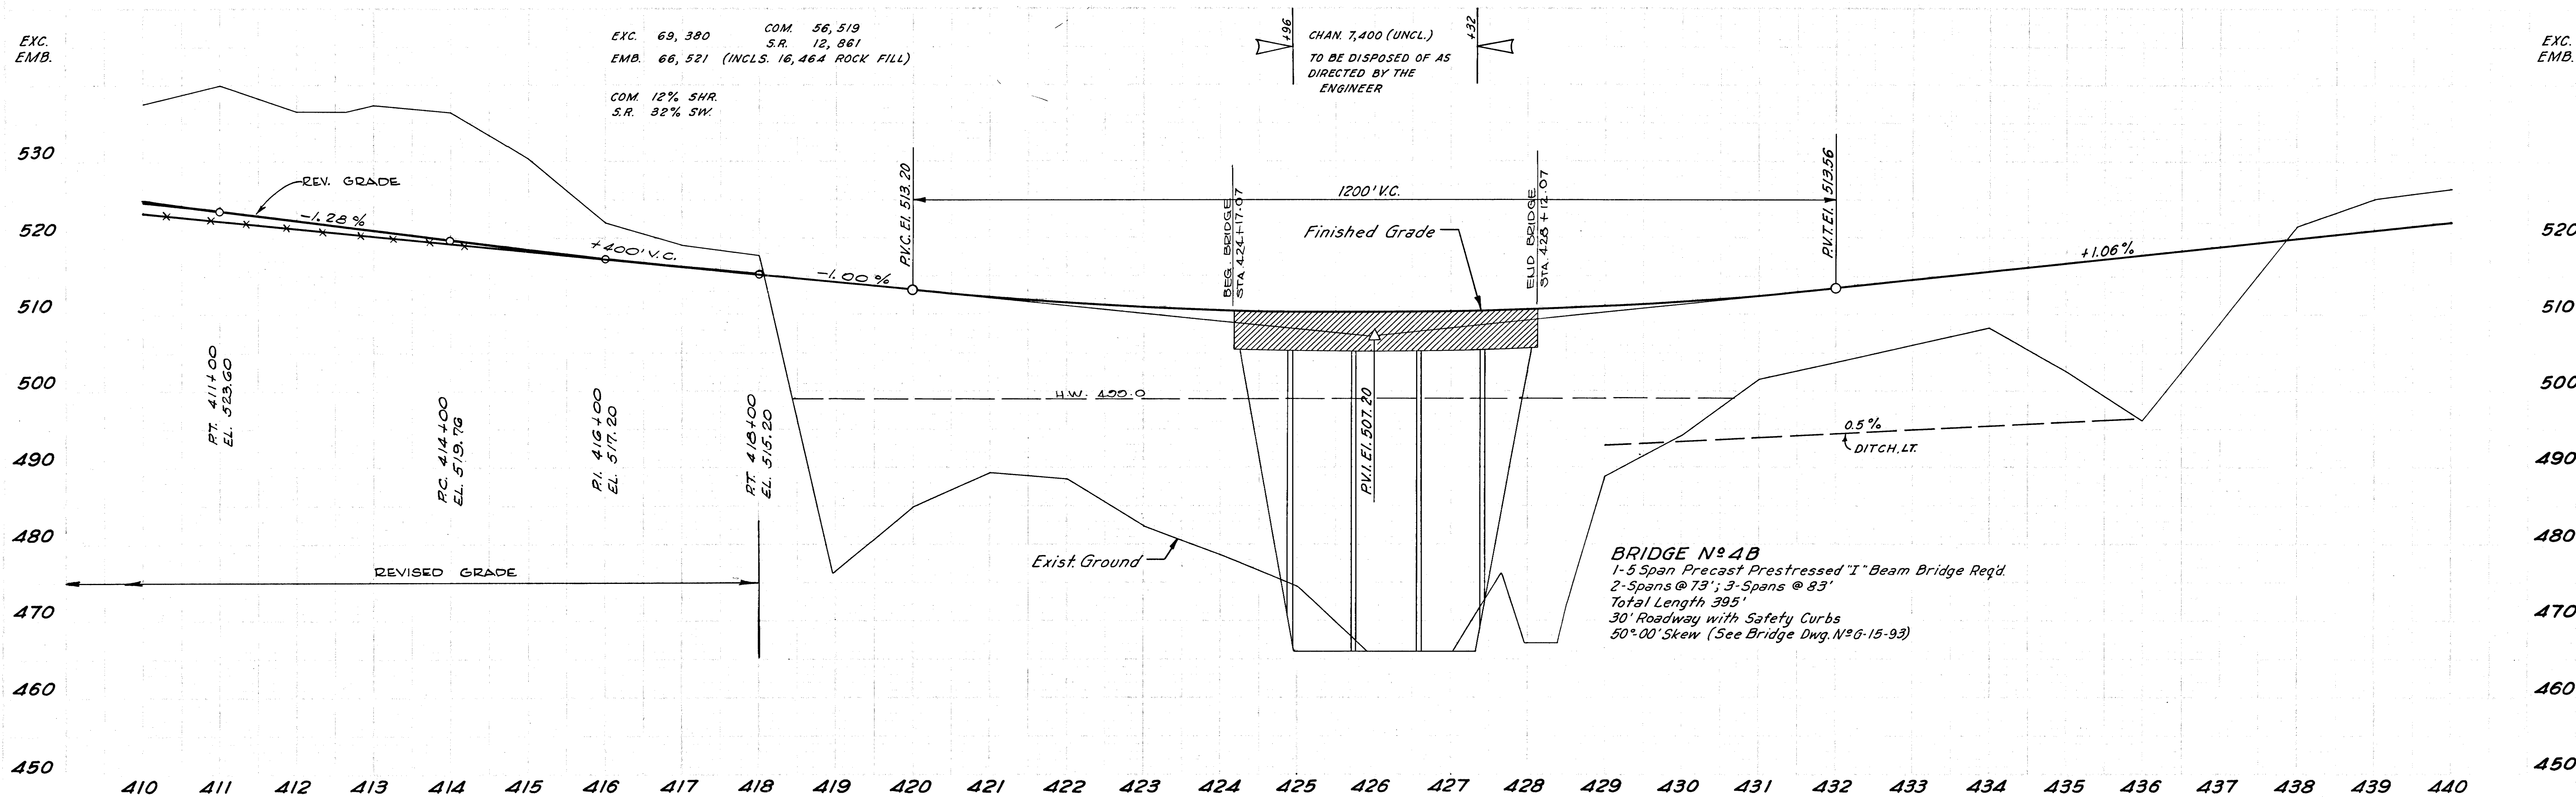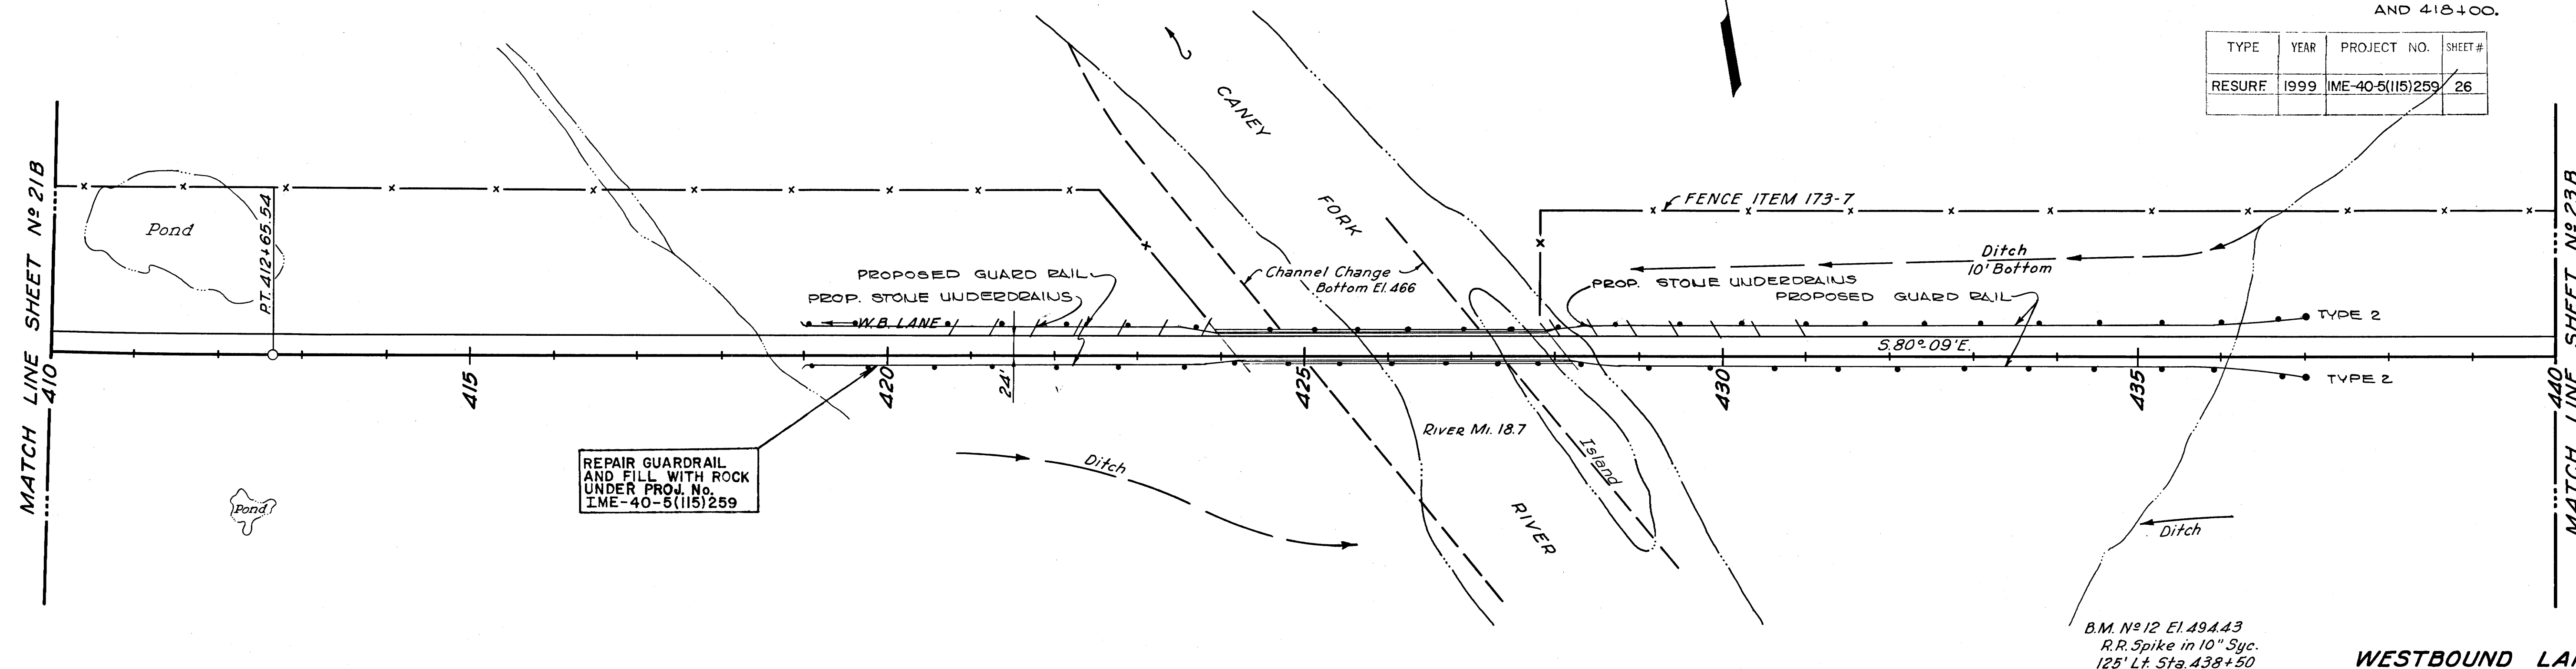

~~3 I-40-5497254 1960 23A 372
CONSTR.~~

FED. ROAD DIST. NO.	T E N	FEDERAL AID PROJECT NO.	FISCAL YEAR	SHEET NO.	TOTAL SHEETS
3	N	T-48-5(19)259	1962	29	40
	N	PAVING			

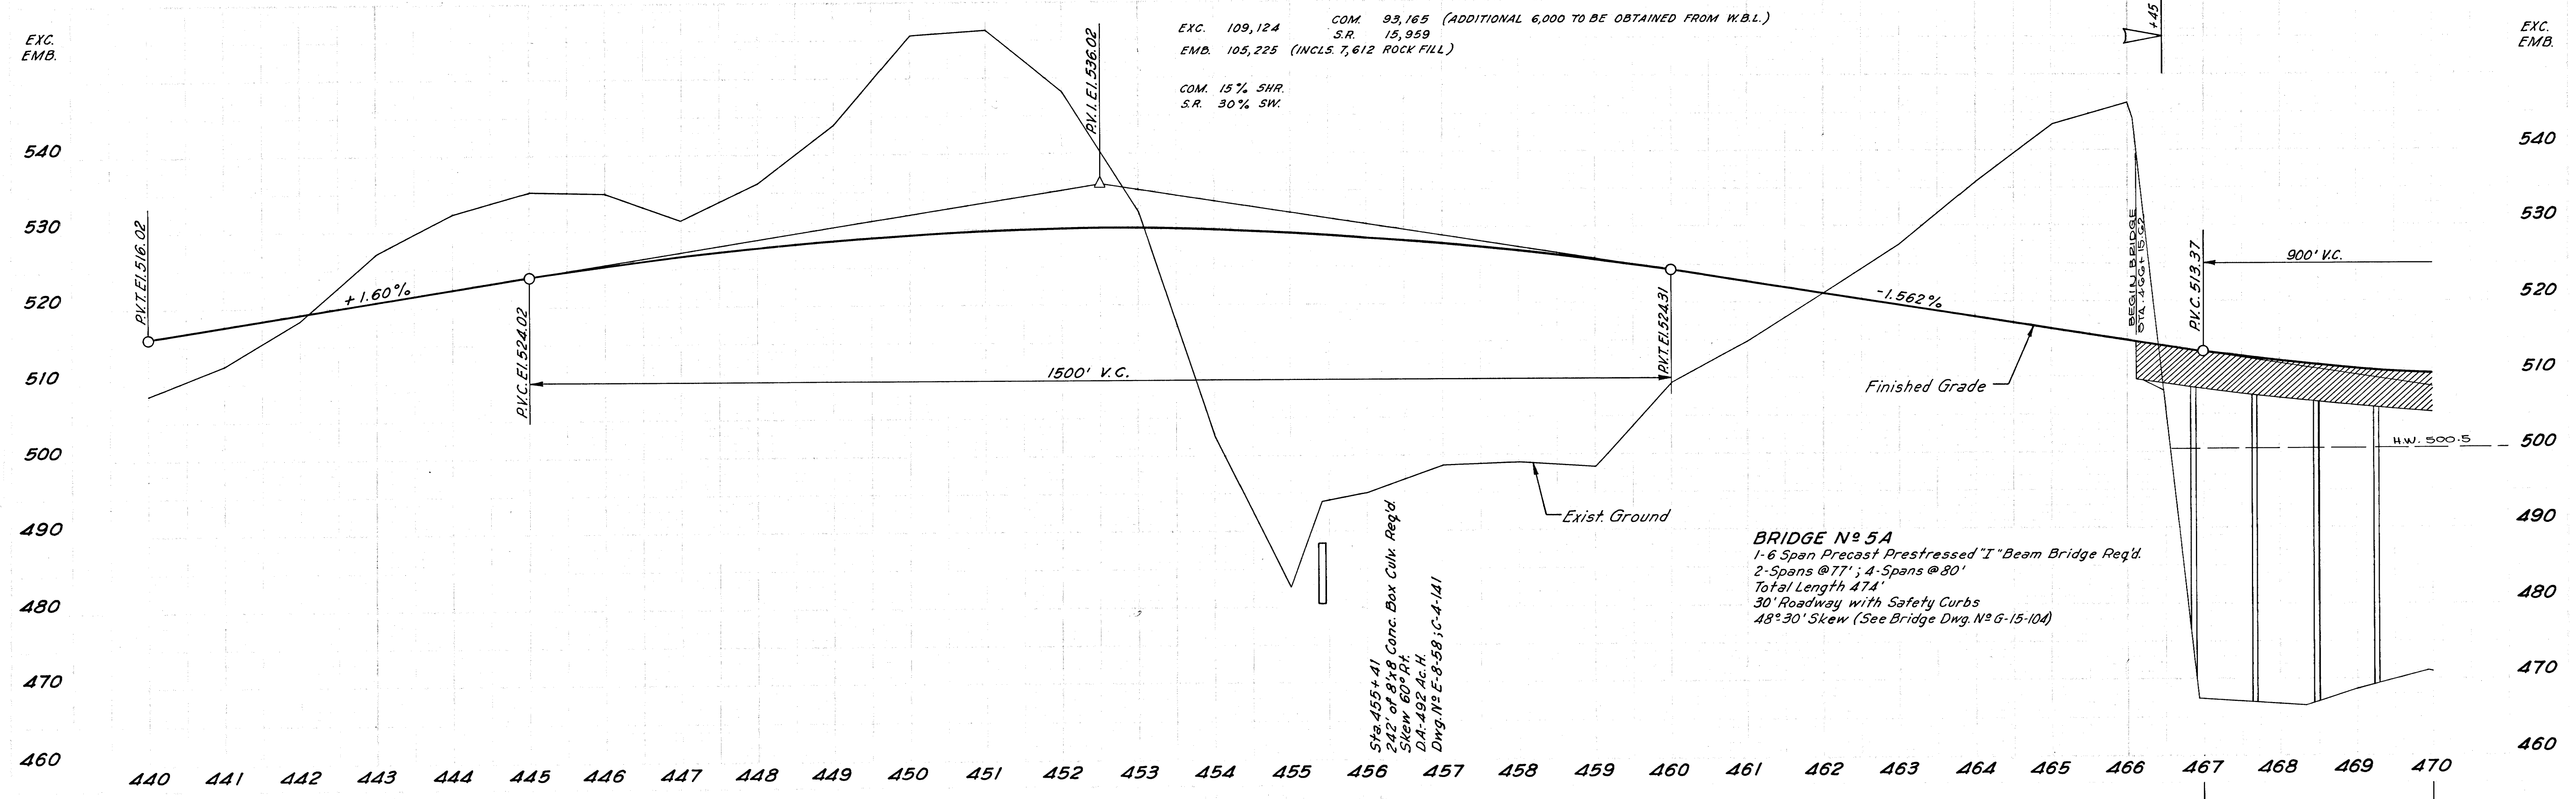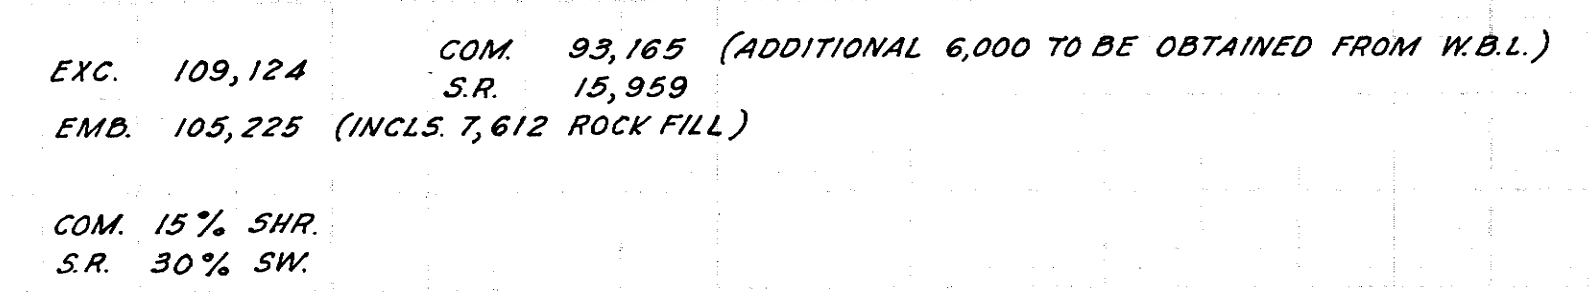

NOTE: THIS SHEET INCLUDED IN PROJECT I-40-5(31)267 PAVING (FINAL STAGE) PLANS TO SHOW THE WIDTH AND OUTLINE OF PAVEMENT AND ARE NOT INTENDED TO SHOW THE SCOPE OF WORK FOR THIS PROJECT.

FED. ROAD DIST. NO.	T	E	FEDERAL AID PROJECT NO.	FISCAL YEAR	SHEET NO.	TOTAL SHEETS
3	N	N	I-40-5(34)259 PAVING	1970	32	57

FED. ROAD DIST. NO.	T	E	FEDERAL AID PROJECT NO.	FISCAL YEAR	SHEET NO.	TOTAL SHEETS
3	N	N	I-40-5(19)259 PAVING	1967	90	40

PROJECT NO.	YEAR	SHEET NO.
IR-40-5(91)257	1969	28

END PROJ. I-40-5 (34)259 FINAL STAGE PAVING

TYPE	YEAR	PROJECT NO.	SHEET #
RESURF	1999	IME-40-5(115)259	28

PROP 522 TONS OF CLASS A-2 RIP-RAP UNDER PROJ. No. IME-40-5(115)259

PROP TYPE 38 ANCHOR UNDER PROJ. No. IME-40-5(115)259


MATCH LINE SHEET No 22B

MATCH LINE SHEET No 24B

EXC. EMB.

EXC. EMB.

EXC. 104,966 COM. 58,066 (6,000 TO BE USED ON E.B.L.)
 S.R. 46,900
 EMB. 105,262 (INCL. 10,642 ROCK FILL)
 COM. 15% SHR.
 S.R. 30% SW.

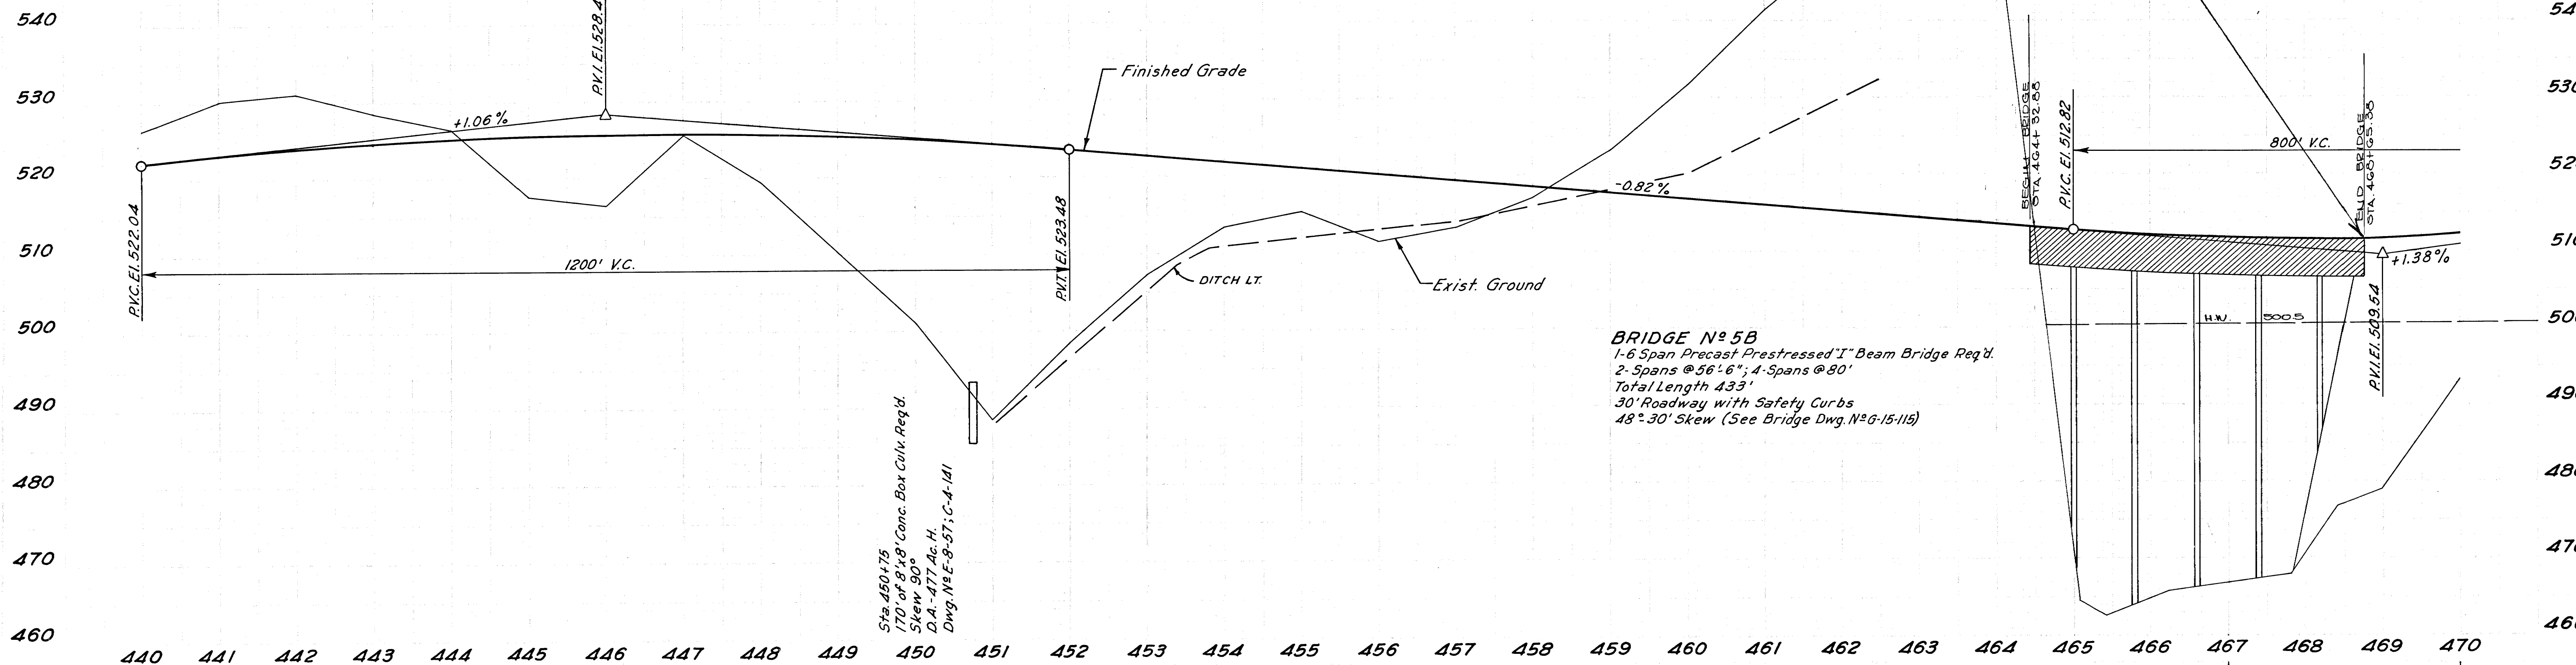

BRIDGE No 5B
 1-6 Span Precast Prestressed 'I' Beam Bridge Req'd.
 2 Spans @ 56'-6"; 4 Spans @ 80'
 Total Length 433'
 30' Roadway with Safety Curbs
 48° 30' Skew (See Bridge Dwg. No 6-15-115)

Sta 450+75
 170' of 8'x8' Conc. Box Culv. Req'd.
 Skew 90°
 D.A. 477 Ac.H.
 Dwg. No E-8-57; C-4-141

BEGIN I-40-5(31)267 PAVING
 STA. 468+65.38 WEST BOUND LANE

WESTBOUND LANE

B.M. No 14 El. 539.69
 R.R. Spike in Twin Walnut
 200' Lt. 461+50 W.B.L.

RIVER

RIVER MI. 19.7

FORK

CANEY Island

Island

E.B. LANE

W.B. LANE

FENCE ITEM 173-7

Ditch 10' Bottom

Ditch

2000

Nail & Cap In 18" Elm
 Tack In Hub
 50° 30' 12"
 150.000
 R.O.T. 450+85.00
 Nail & Cap In 24" Pine
 Tack In Hub
 84.0'

REMOVE & REPLACE GUARDRAIL UNDER PROJ. No. IME-40-5(115)259

PROPOSED GUARD RAIL

PROPOSED G.R.

PROP. STOLE UNDERDRAINS

PROP. G.R.

TYPE 2

TYPE 2

EASTBOUND
PI=497+21.40
N=635,608.77
E=2,056,158.54
Δ=24°-02'; Lt
D=1°-00'
R=5,729.58'
T=1,219.60'
L=2,403.33'
E_c=128.36'

WESTBOUND
PI=492+67.98
N=635,628.09
E=2,056,100.85
Δ=27°-36'; Lt
D=1°-00'
R=5,729.58'
T=1,407.32'
L=2,760.00'
E_c=170.30'


NOTE: THIS SHEET INCLUDED IN
PROJECT I-40-5(31) 267 PAVING
(FINAL STAGE) PLANS TO SHOW
THE WIDTH AND OUTLINE OF PAVE-
MENT AND ARE NOT INTENDED TO
SHOW THE SCOPE OF WORK FOR
THIS PROJECT.

FED. ROAD DIST. NO.	T	FEDERAL AID PROJECT NO.	FISCAL YEAR	SHEET NO.	TOTAL SHEETS
3	N	I-40-5(3) 264	1959	24	25

FED. ROAD DIST. NO.	T	FEDERAL AID PROJECT NO.	FISCAL YEAR	SHEET NO.	TOTAL SHEETS
3	N	I-40-5(3) 267	1959	24	25

FED. ROAD DIST. NO.	T	FEDERAL AID PROJECT NO.	FISCAL YEAR	SHEET NO.	TOTAL SHEETS
3	N	I-40-5(3) 267	1959	24	25

REVISED 10-4-60; CORRECTED
PROPERTY OWNER'S NAME ON
TRACT No. 44.

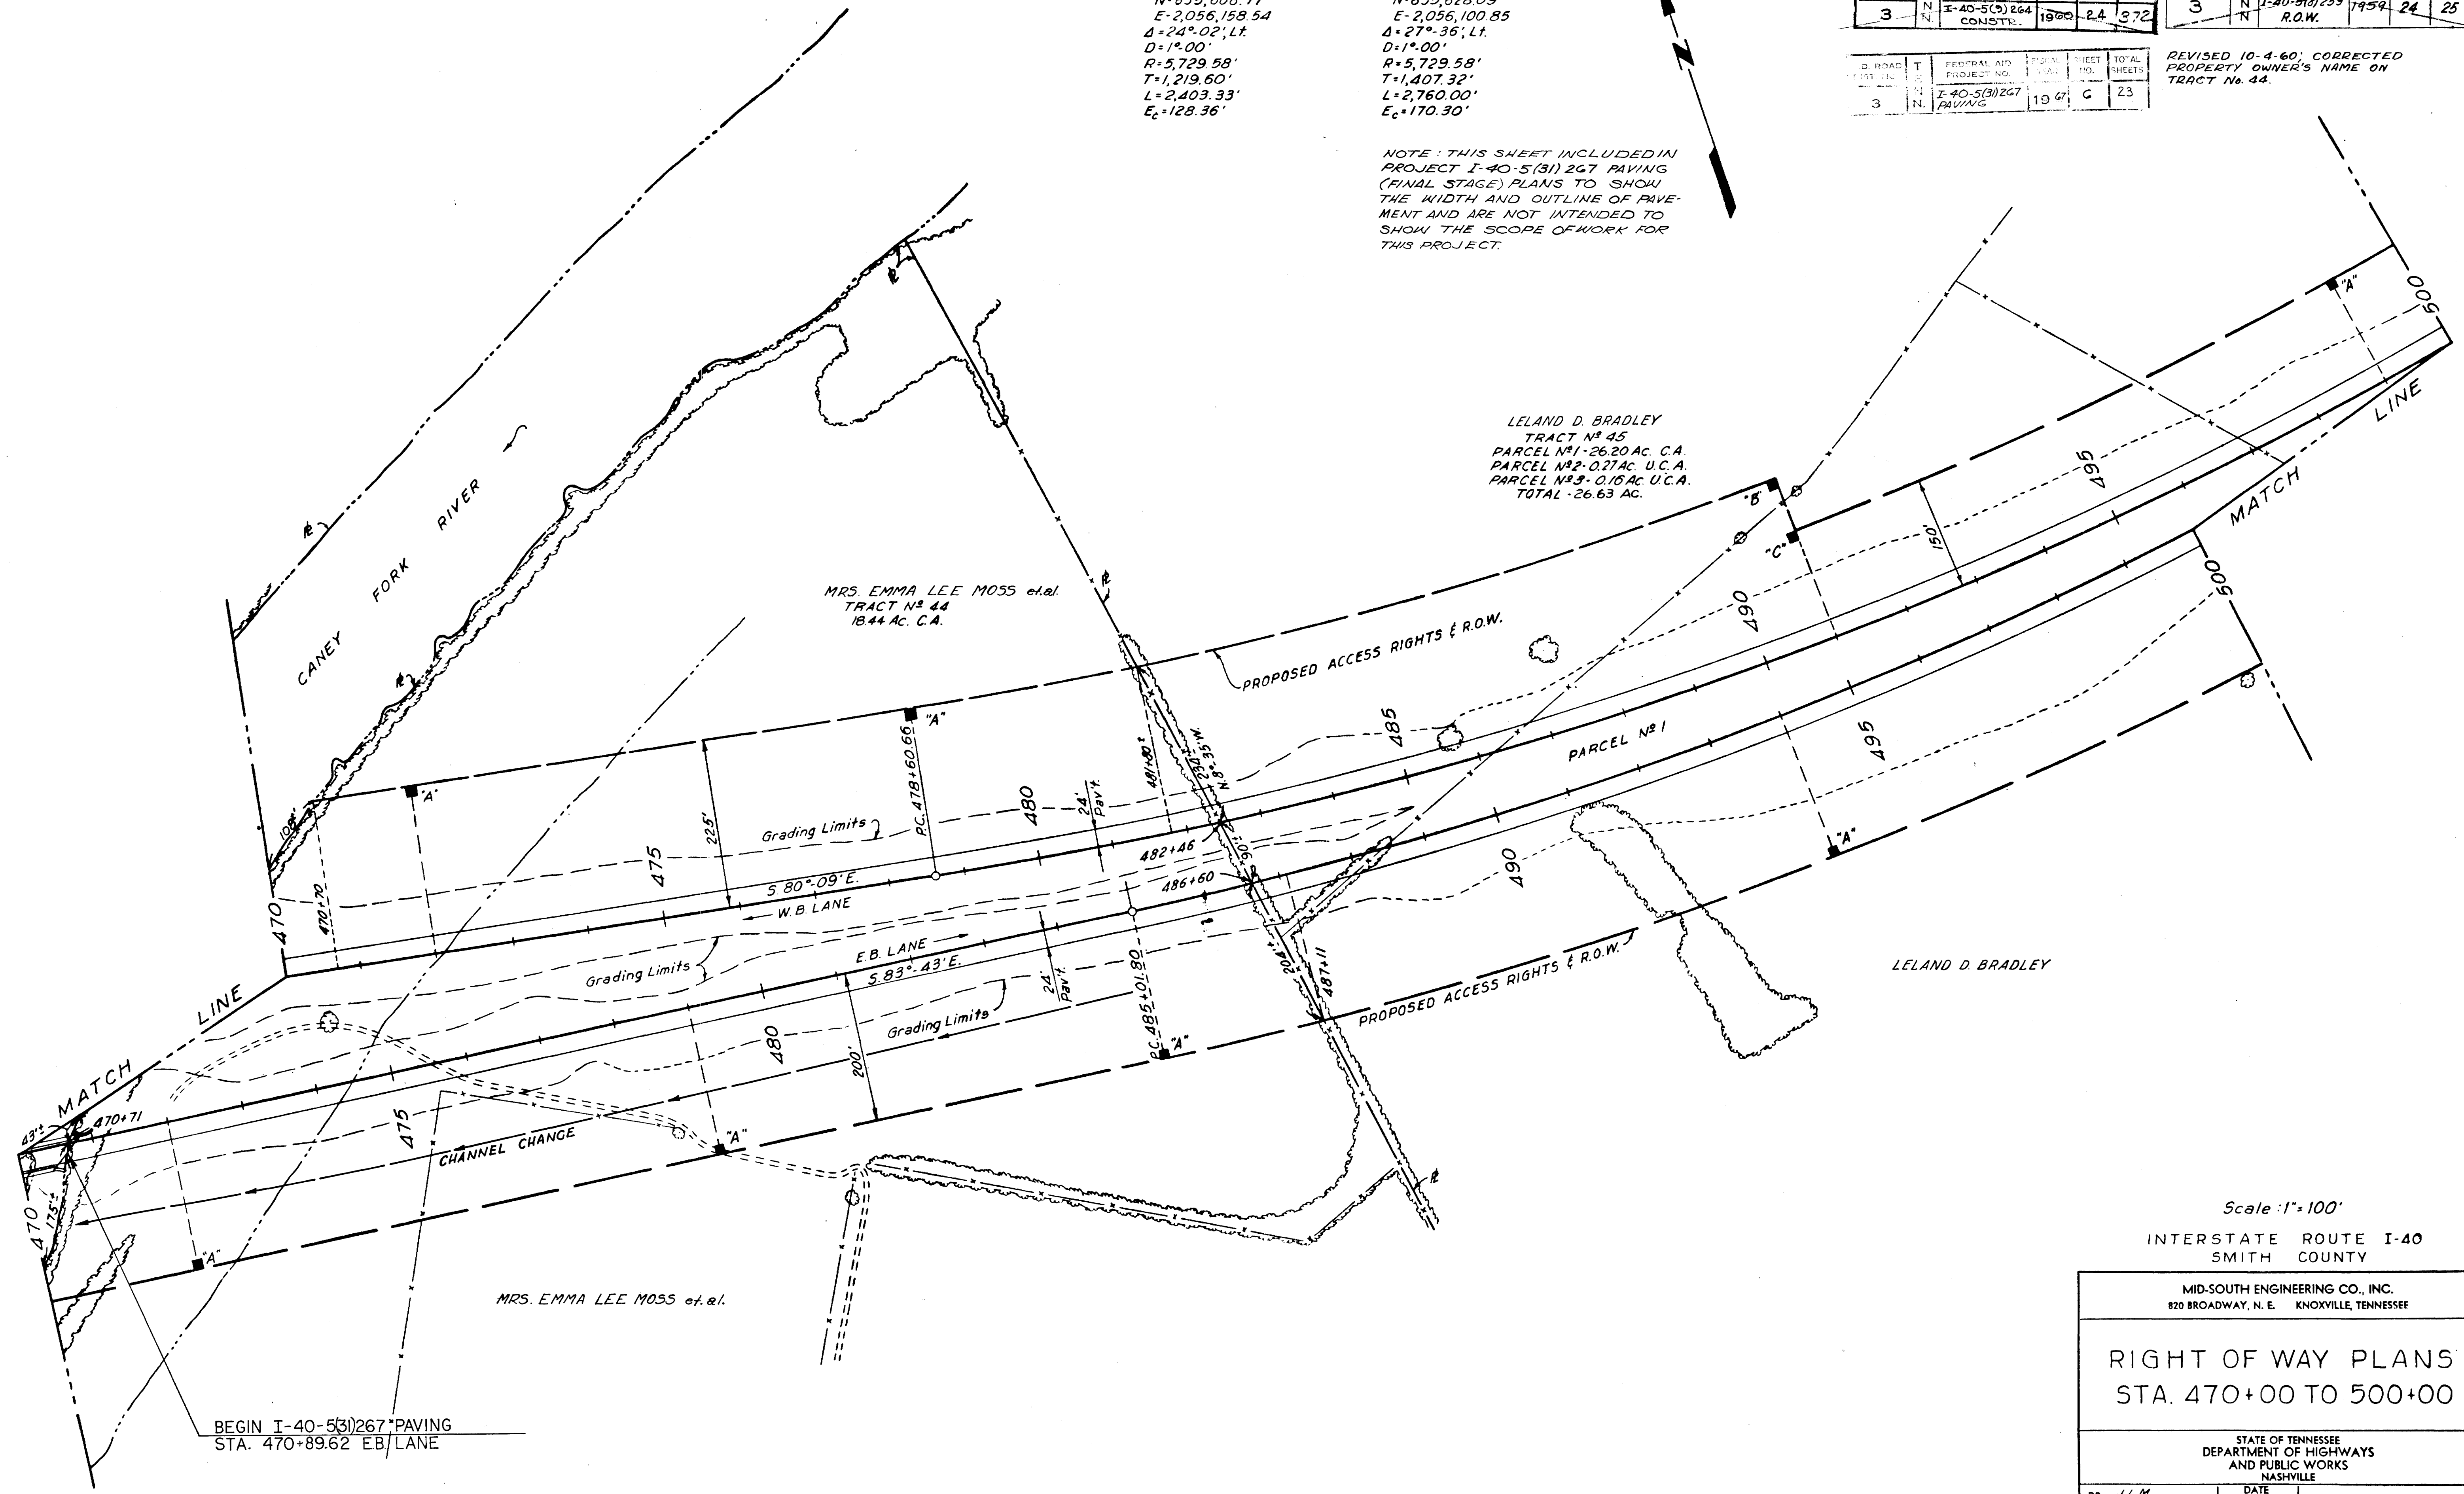

Scale: 1"=100'
INTERSTATE ROUTE I-40
SMITH COUNTY

MID-SOUTH ENGINEERING CO., INC. 820 BROADWAY, N. E. KNOXVILLE, TENNESSEE	
RIGHT OF WAY PLANS STA. 470+00 TO 500+00	
STATE OF TENNESSEE DEPARTMENT OF HIGHWAYS AND PUBLIC WORKS NASHVILLE	
DR. J.L.M. CHK'D M.L.S. APP'D	DATE 1-19-59 4-14-59

TENN. STATE HIGHWAYS
 PLAN SHEET NO. 50

NOTE: THIS SHEET INCLUDED
 IN PROJECT I-40-5(31)267 PAVING
 (FINAL STAGE) PLANS TO SHOW THE
 WIDTH AND OUTLINE OF PAVEMENT
 AND ARE NOT INTENDED TO
 SHOW THE SCOPE OF WORK FOR
 THIS PROJECT

EASTBOUND
 $PI=497+21.40$
 $N=635,608.77$
 $E=2,056,158.54$
 $D=24^{\circ}02'11''$
 $R=5,729.58'$
 $T=1,219.60'$
 $L=2,403.33'$
 $E_c=128.36'$
 $S.E.=0.0322 \text{ ft./ft.}$


FED. ROAD DIST. NO.	T	FEDERAL AID PROJECT NO.	FISCAL YEAR	SHEET NO.	TOTAL SHEETS
3	N	I-40-5(31)267 PAVING	1970	33	57

FED. ROAD DIST. NO.	T	FEDERAL AID PROJECT NO.	FISCAL YEAR	SHEET NO.	TOTAL SHEETS
3	N	I-40-5(31)267 PAVING	1970	33	57

FED. ROAD DIST. NO.	T	FEDERAL AID PROJECT NO.	FISCAL YEAR	SHEET NO.	TOTAL SHEETS
3	N	I-40-5(31)267 PAVING	1970	33	57

PROJECT NO.	YEAR	SHEET NO.
IR-40-5(31)267	1989	29

TYPE	YEAR	PROJECT NO.	SHEET #
RESURF	1999	IME-40-5(115)259	29

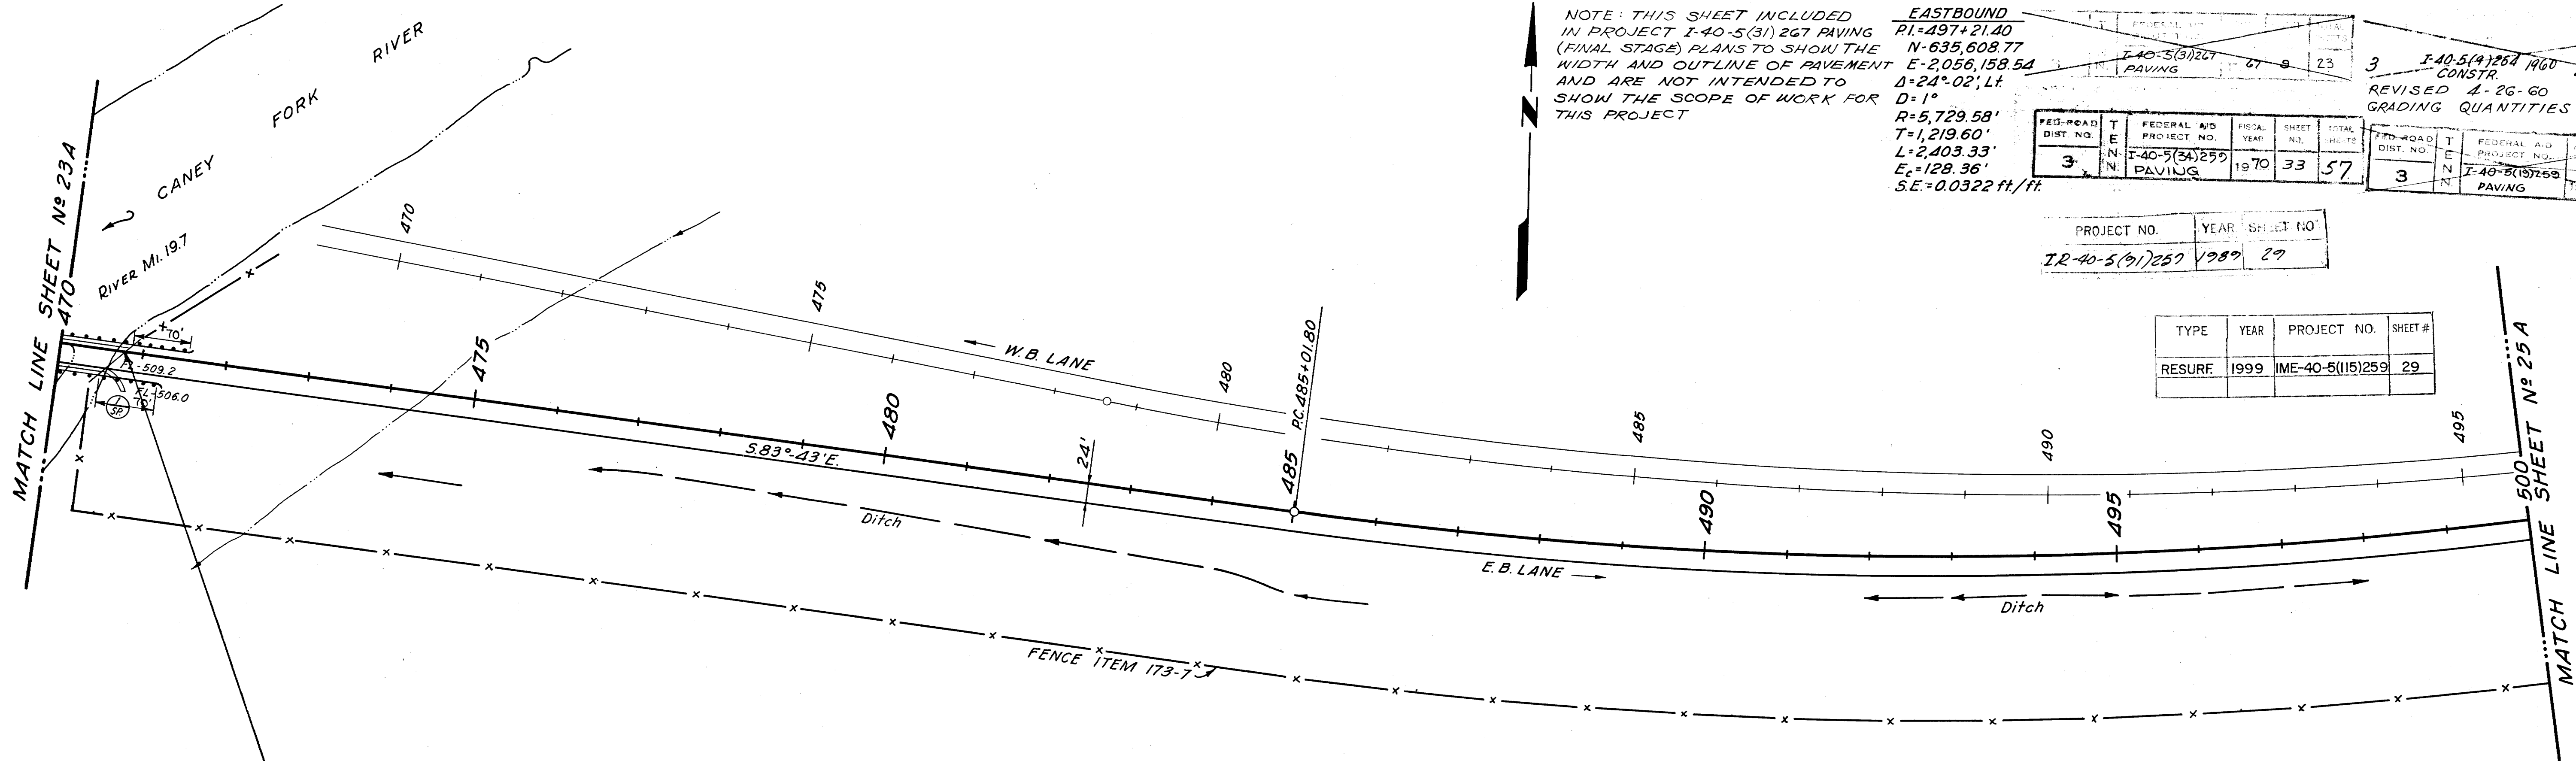


END PROJ. I-40-5(31)259 FINAL STAGE PAVING
 BEGIN I-40-5(31)267 PAVING
 STA. 470+89.62 E.B. LANE

B.M. No 16 El. 543.10
 R.R. Spike in 8" Hedge Apple
 190' R+ 487+50 E.B.L.

BOR. S.R. ~~11,200~~ 6,200
 COM. ~~11,118~~ 114,613
 EMB. ~~11,118~~ (INCL. ~~5,072~~ ROCK FILL)
 115,858 8,360
 RK. BOR. 35% SW.
 BOR. & COM. 13% SHR.

BORR. COM. 6860 C.Y.

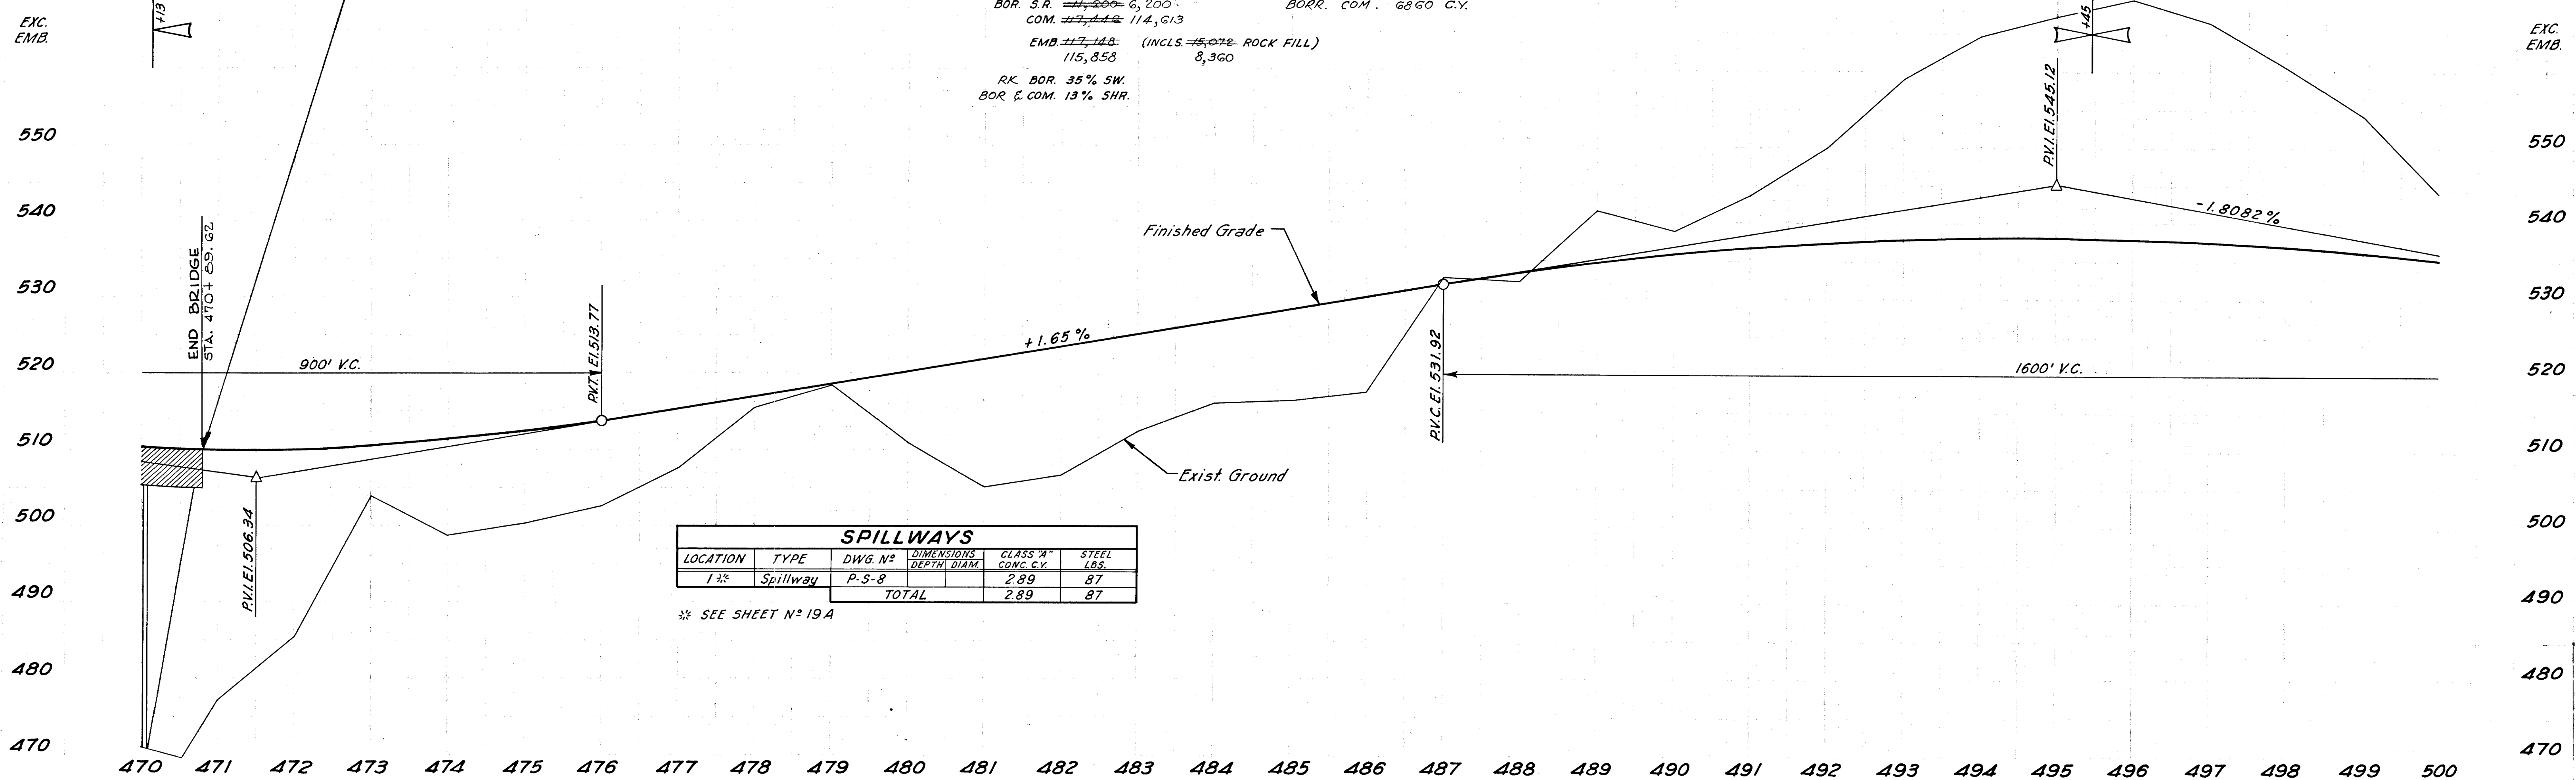

SPILLWAYS					
LOCATION	TYPE	DWG. NO.	DIMENSIONS DEPTH DIAM.	CLASS "A" CONC. C.Y.	STEEL LBS.
1 1/2"	Spillway	P-5-8		2.89	87
TOTAL				2.89	87

* SEE SHEET No 19A

TENN. STATE HIGHWAYS
Dist. No. **IN.**
Div. No. **50**


MICROFILMED
SERIALIZED

NOTE: THIS SHEET INCLUDED WESTBOUND
IN PROJECT I-40-5(31) 247 PI=492+67.98
PAVING (FINAL STAGE) PLANS N-635,628.09
TO SHOW THE WIDTH AND E-2,056,100.85
OUTLINE OF PAVEMENT AND D=1°
ARE NOT INTENDED TO SHOW R=5,729.58'
THE SCOPE OF WORK FOR T=1,407.32'
THIS PROJECT L=2,760.00'
E_c=170.30'
S.E.=0.0322 ft./ft.

PROJECT	SHEET NO.
I-40-5(19)259	30


FED. ROAD DIST. NO.	FED. ROAD DIST. NO.	FED. ROAD DIST. NO.	FED. ROAD DIST. NO.	FED. ROAD DIST. NO.
3	3	3	3	3

TYPE	YEAR	PROJECT NO.	SHEET #
RESURF	1999	IME-40-5(115)259	30

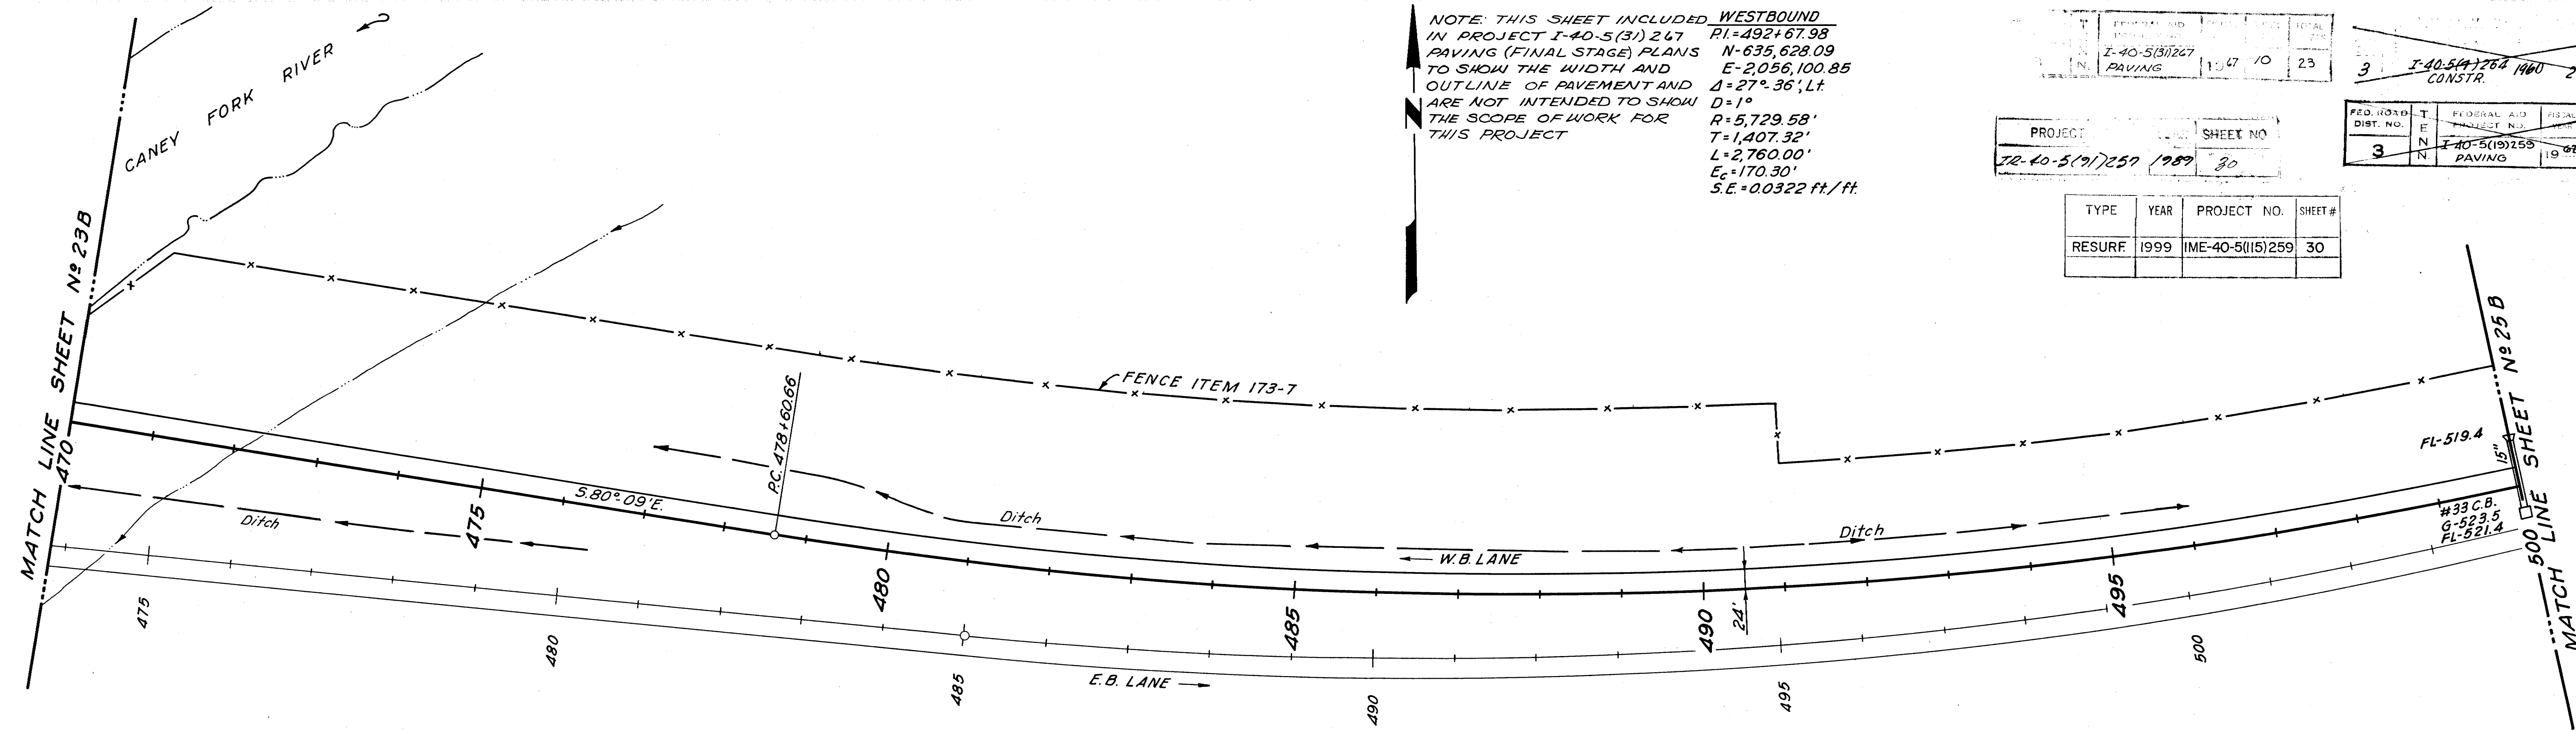

B.M. No. 15 El. 503.58
Bolt in Root of 36" Elm
60' Rt. Sta. 470+50 W.B.L.

GRADING QUANTITIES INCLUDED WITH E.B. LANE

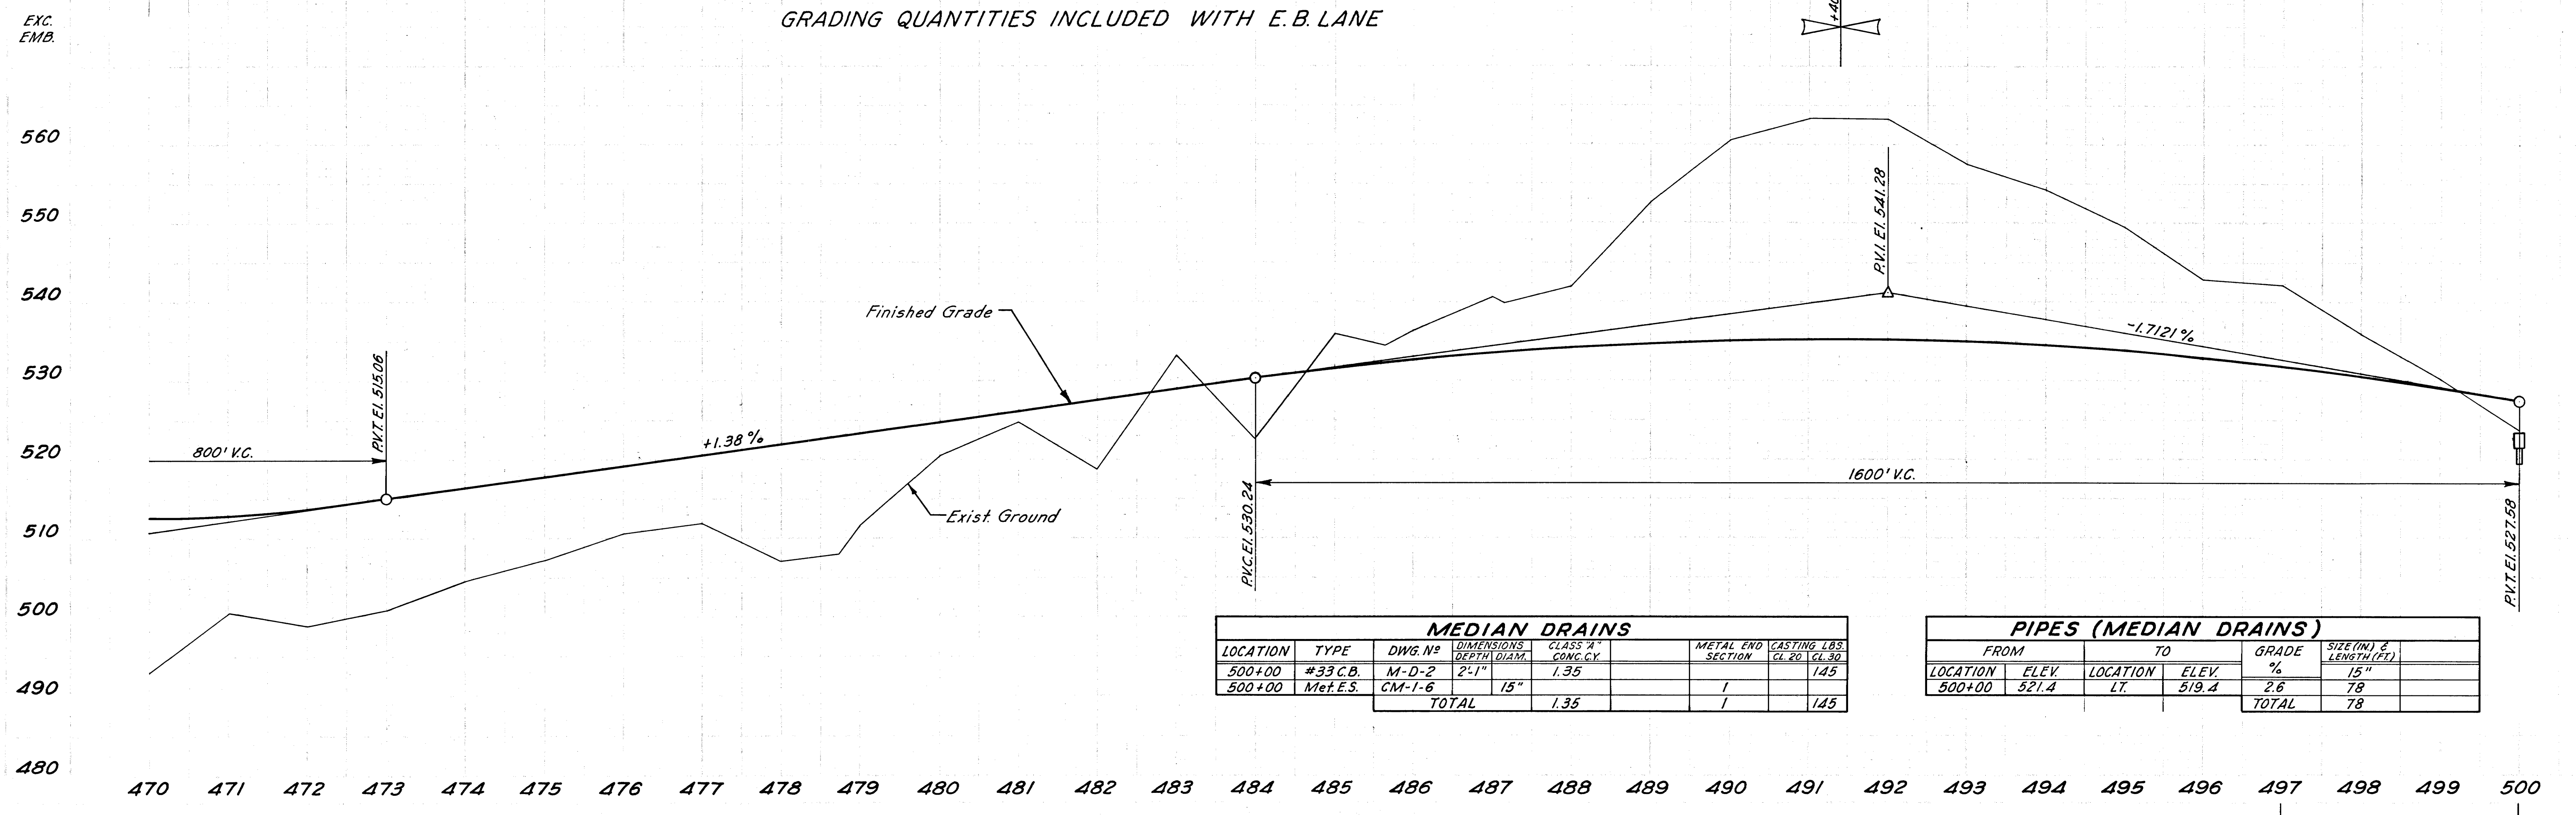


MEDIAN DRAINS						
LOCATION	TYPE	DWG. No.	DIMENSIONS DEPTH DIA.	CLASS "A" CONC. CY.	METAL END SECTION	CASTING LBS. CL. 20 CL. 30
500+00	#33 C.B.	M-D-2	2'-1"	1.35		145
500+00	Met. E.S.	CM-1-6	15"		1	
TOTAL				1.35	1	145

PIPES (MEDIAN DRAINS)					
FROM		TO		GRADE %	SIZE (IN) & LENGTH (FEET)
LOCATION	ELEV.	LOCATION	ELEV.		
500+00	521.4	LT.	519.4	2.6	78
TOTAL					78

FIELD DIST. NO.	PROJECT NO.	FISCAL YEAR	SHEET NO.	TOTAL SHEETS
3	I-40-3(9) 264 CONSTR.	1960	25	372

FED. ROAD DIST. No.	T E N	FEDERAL AID PROJECT No.	FISCAL YEAR	SHEET No.	TOTAL SHEET'S
3	N	I-40-5(8)259 R.O.W.	1959	25	25

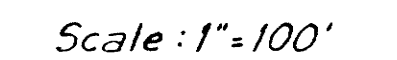

MID-SOUTH ENGINEERING CO., INC.
820 BROADWAY, N. E. KNOXVILLE, TENNESSEE

STATE OF TENNESSEE
DEPARTMENT OF HIGHWAYS
AND PUBLIC WORKS
NASHVILLE


DR. <u>J.L.M.</u>	DATE <u>1-20-59</u>
CHK'D <u>MLG</u>	<u>4-13-59</u>
APP'D	

NOTE: THIS SHEET INCLUDED IN PROJECT I-40-5(3) 267 PAVING (FINAL STAGE) PLANS TO SHOW THE WIDTH AND OUTLINE OF PAVEMENT AND ARE NOT INTENDED TO SHOW THE SCOPE OF WORK FOR THIS PROJECT

PROJECT NO.	SHEET NO.	TOTAL SHEETS
I-40-5(9) 257 1989	32	32

PROJECT NO.	SHEET NO.	TOTAL SHEETS
I-40-5(9) 264 1960 25A	372	372

REVISED 4-26-60: GRADING QUANTITIES CHANGED.

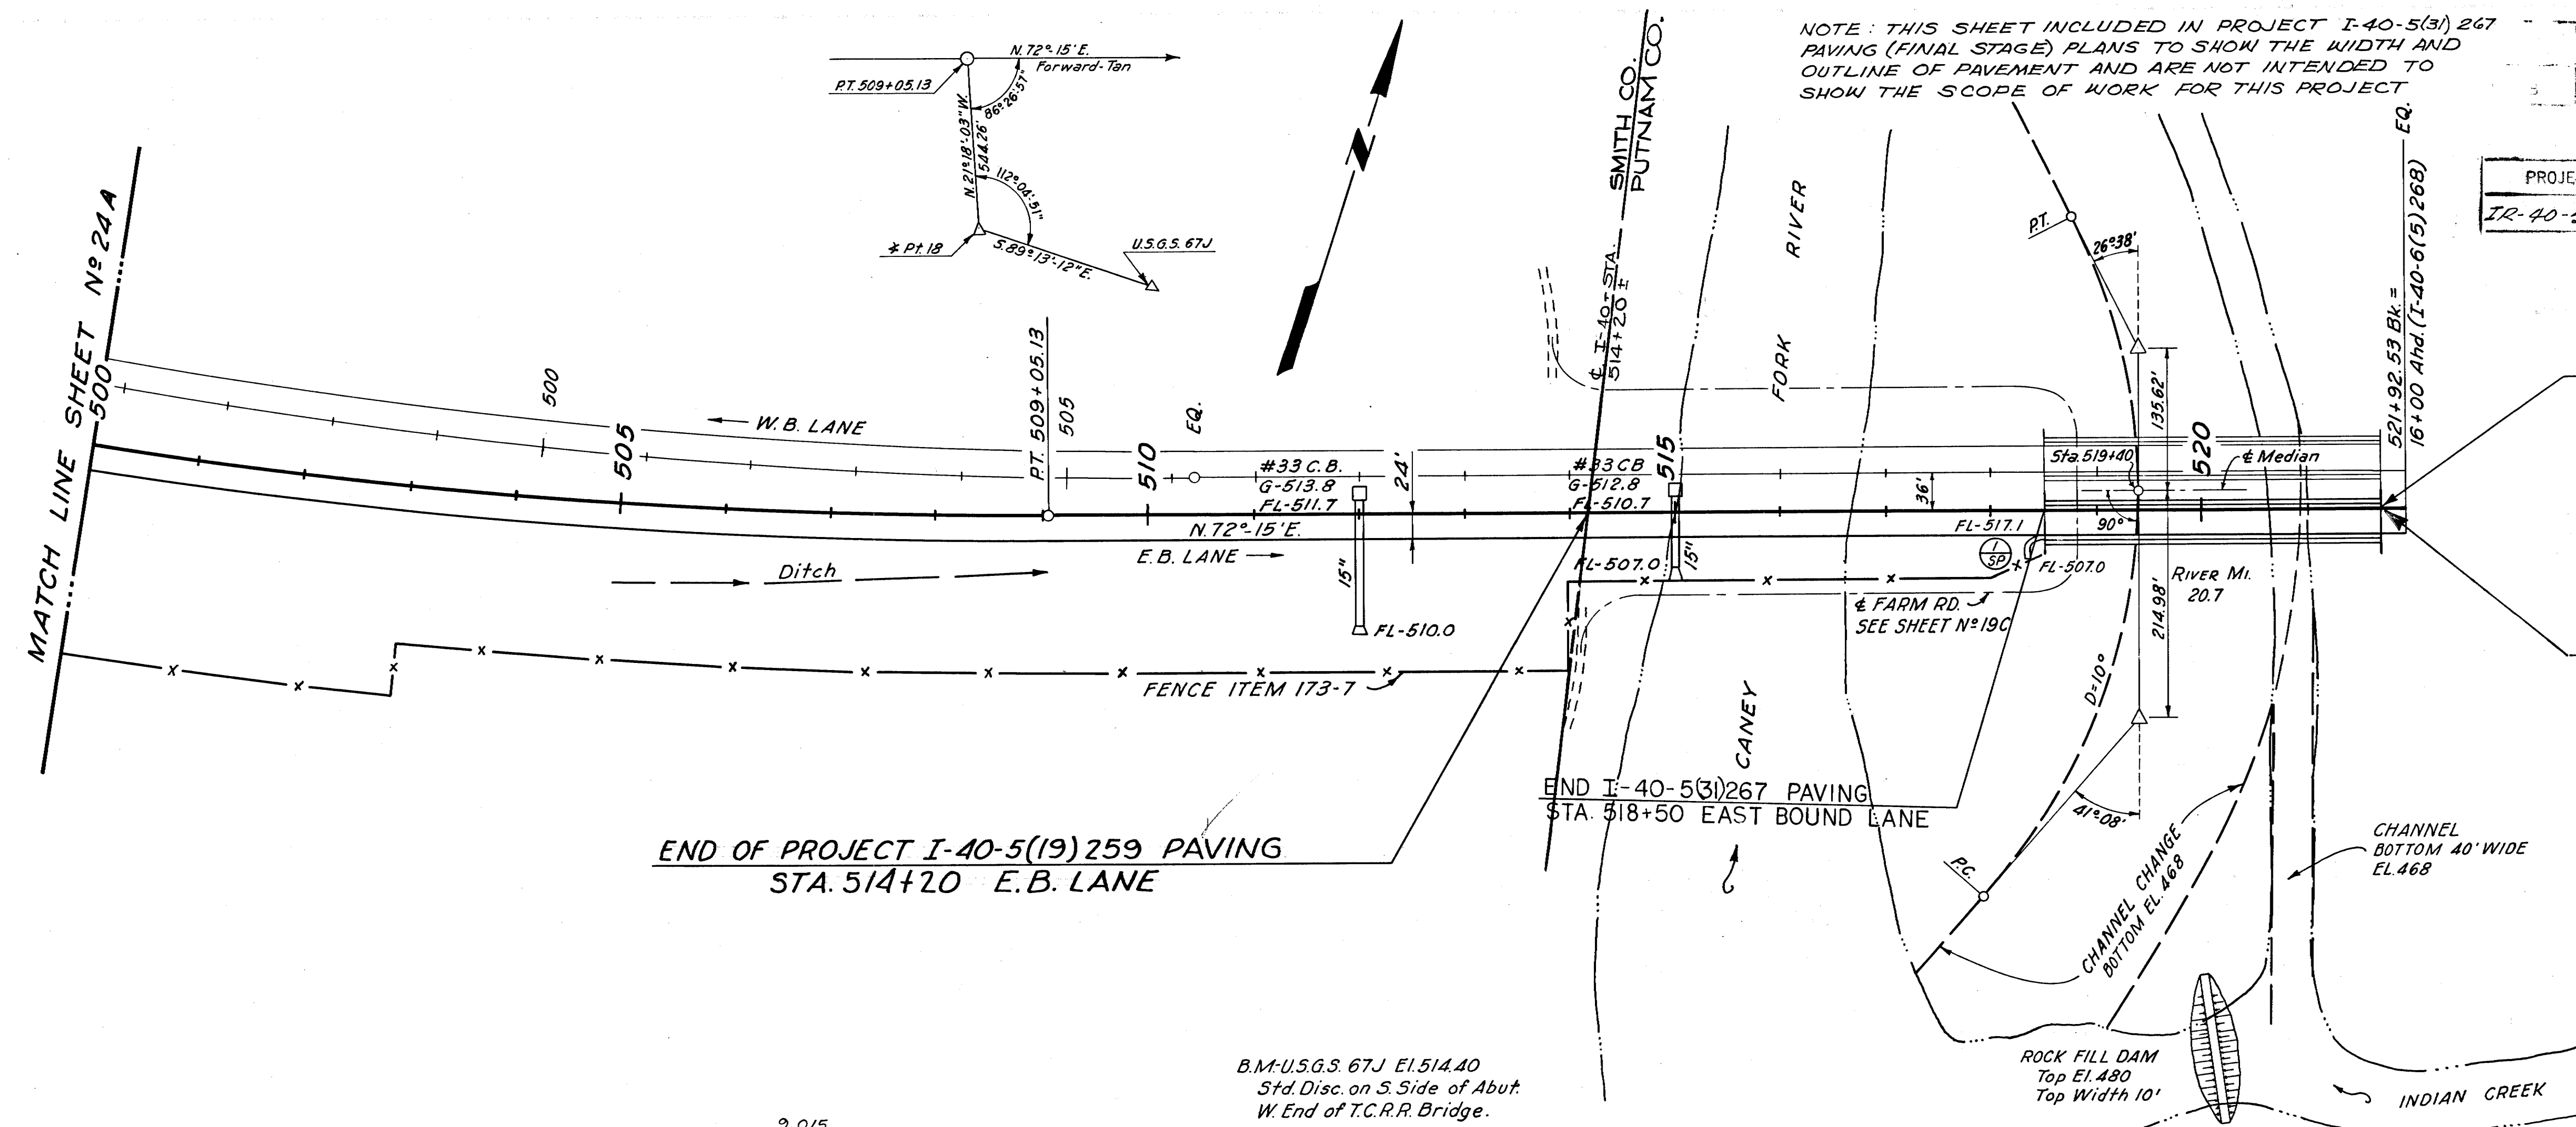

END OF PROJECT I-40-5(19) 259 PAVING
STA. 514+20 E.B. LANE

END OF PROJECT I-40-5(9) 264 CONSTR.
STA. 521+70.00 E.B. LANE

80001-8161-44
END OF PROJECT I-40-5(115) 259 RESURF.
L.M. 0.05 E.B.L. & W.B.L.
STA. 521+70.00 E.B.L.


NOTE:
Minimum Channel Width of 155' on Caney Fork River
Shall be Maintained During All Stages of Construction.

B.M.-U.S.G.S 67J E1514.40
Std. Disc. on S. Side of Abut.
W. End of T.C.R.R. Bridge.

BOR. S.R. 2,015
CHAN. EXC. 80,000 (26,000 TO BE USED IN ROWY. EMB; 54,000 TO BE DISPOSED OF AS DIRECTED BY THE ENGINEER)
COM. 127,186
EMB. 152,716 (INCL. 26,000 ROCK FILL)
BOR. 35% SW.
CHAN. 20% SHR.
COM. 13% SHR.

EXC.
EMB.

EXC.
EMB.

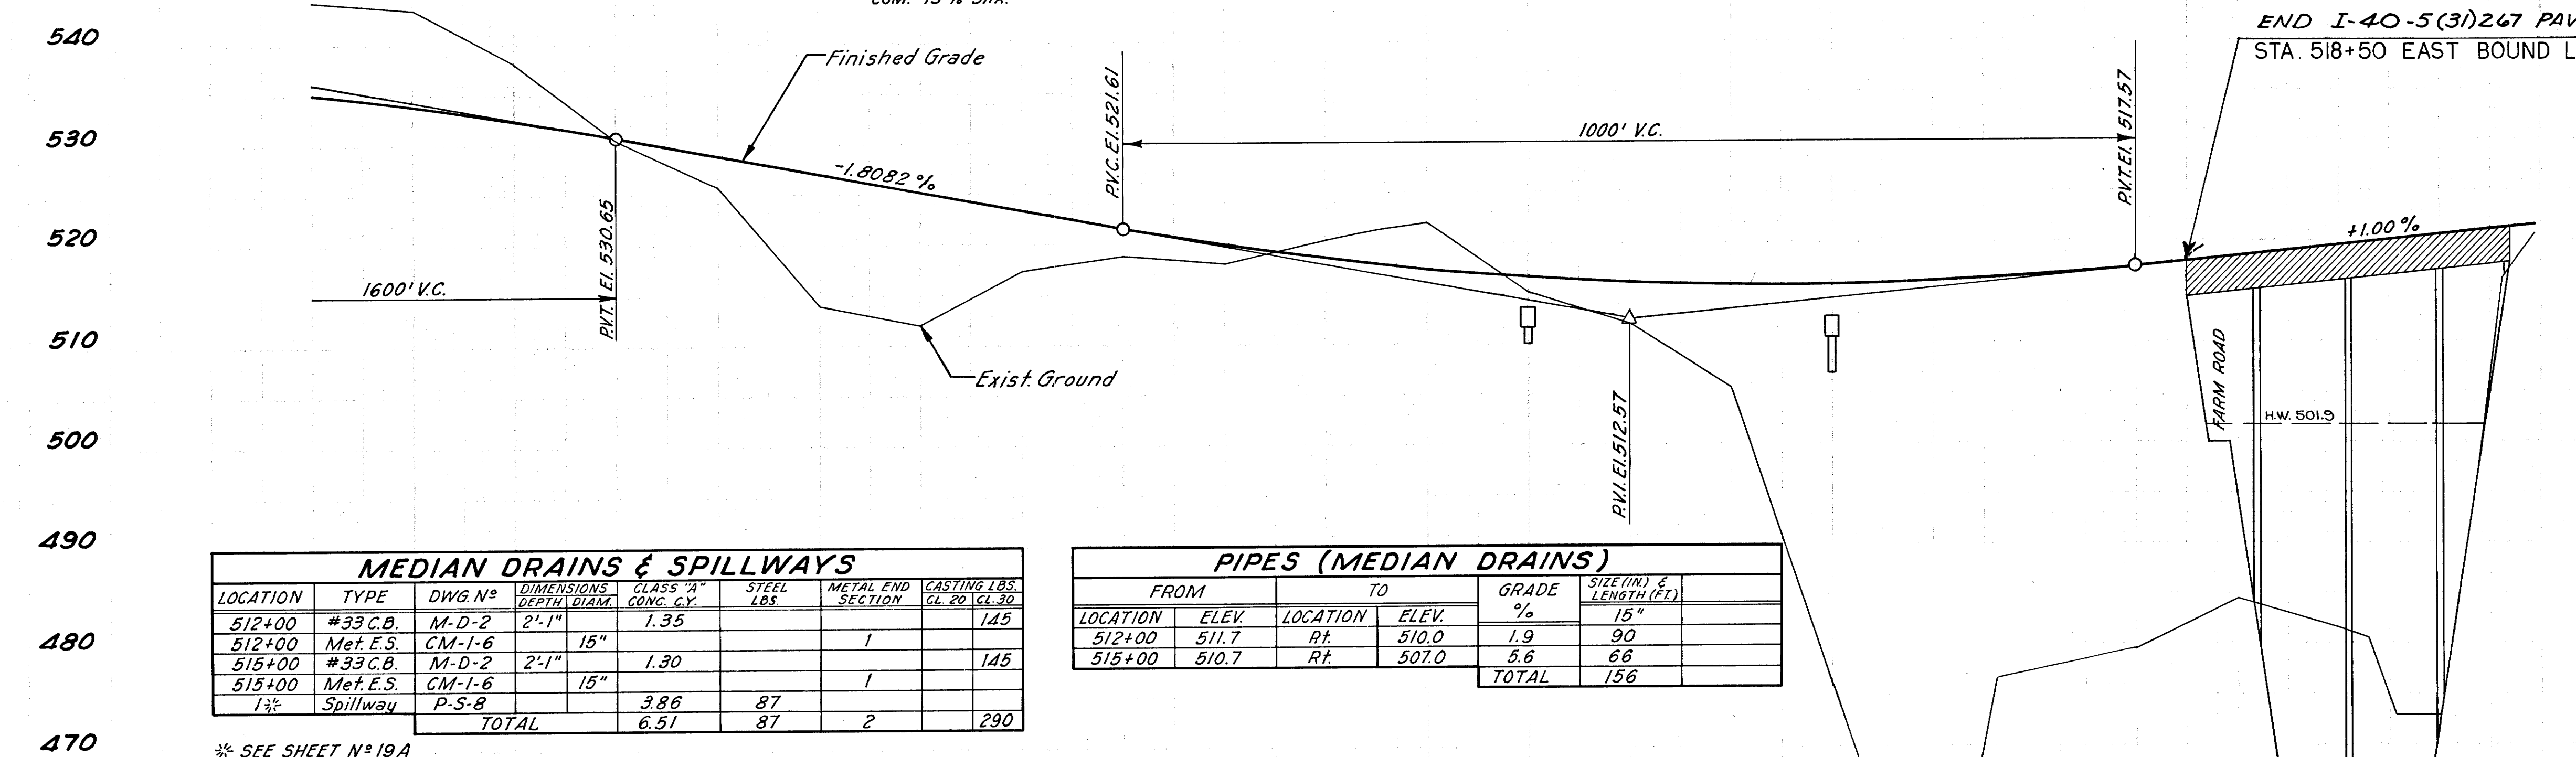

MEDIAN DRAINS & SPILLWAYS

LOCATION	TYPE	DWG. NO.	DIMENSIONS DEPTH x DIAM.	CLASS "A" CONC. CY.	STEEL LBS.	METAL END SECTION	CASTING LBS. CL 20 CL 30
512+00	#33 C.B.	M-D-2	2' x 1"	1.35			145
512+00	Met. E.S.	CM-I-6	15"			1	
515+00	#33 C.B.	M-D-2	2' x 1"	1.30			145
515+00	Met. E.S.	CM-I-6	15"			1	
515+00	1 1/2" Spillway	P-S-8		3.86	87		
TOTAL				6.51	87	2	290

PIPES (MEDIAN DRAINS)

FROM	TO	GRADE %	SIZE (IN.) & LENGTH (FT.)
LOCATION	ELEV.	LOCATION	ELEV.
512+00	511.7	Rt.	510.0
515+00	510.7	Rt.	507.0
TOTAL			156

BRIDGE No 6A
1-4 Span Precast Prestressed Box Girder
Composite Section Bridge Req'd.
2-Spans @ 70'; 2-Spans @ 90'
Total Length 320'
30' Roadway with Safety Curbs
90° 00' Skew (See Bridge Dwg. No G-15-127)

* SEE SHEET No 19A

500 501 502 503 504 505 506 507 508 509 510 511 512 513 514 515 516 517 518 519 520 521

STATE HIGHWAYS
IN
No. 50

NOTE: THIS SHEET INCLUDED IN PROJECT
I-40-5(3) 267 PAVING (FINAL STAGE) PLANS
TO SHOW THE WIDTH AND OUTLINE OF PAVE-
MENT AND ARE NOT INTENDED TO SHOW THE
SCOPE OF WORK FOR THIS PROJECT.


FED. ROAD DIST. NO.	FED. AID PROJECT NO.	FED. AID DIST. NO.	FED. AID SHEET NO.	TOTAL SHEETS
3	N	I-40-5(3) 267 PAVING	1067 12 23	372

FED. ROAD DIST. NO.	FED. AID PROJECT NO.	FED. AID DIST. NO.	FED. AID SHEET NO.	TOTAL SHEETS
3	N	I-40-5(19) 259 PAVING	1067 12 23	372

PROJECT	SHEET NO.
I-40-5(1) 257 1987	33

FED. ROAD DIST. NO.	FED. AID PROJECT NO.	FED. AID DIST. NO.	FED. AID SHEET NO.	TOTAL SHEETS
3	N	I-40-5(19) 259 PAVING	1067 12 23	372

TYPE	YEAR	PROJECT NO.	SHEET #
RESURF	1999	IME-40-5(115) 259	32

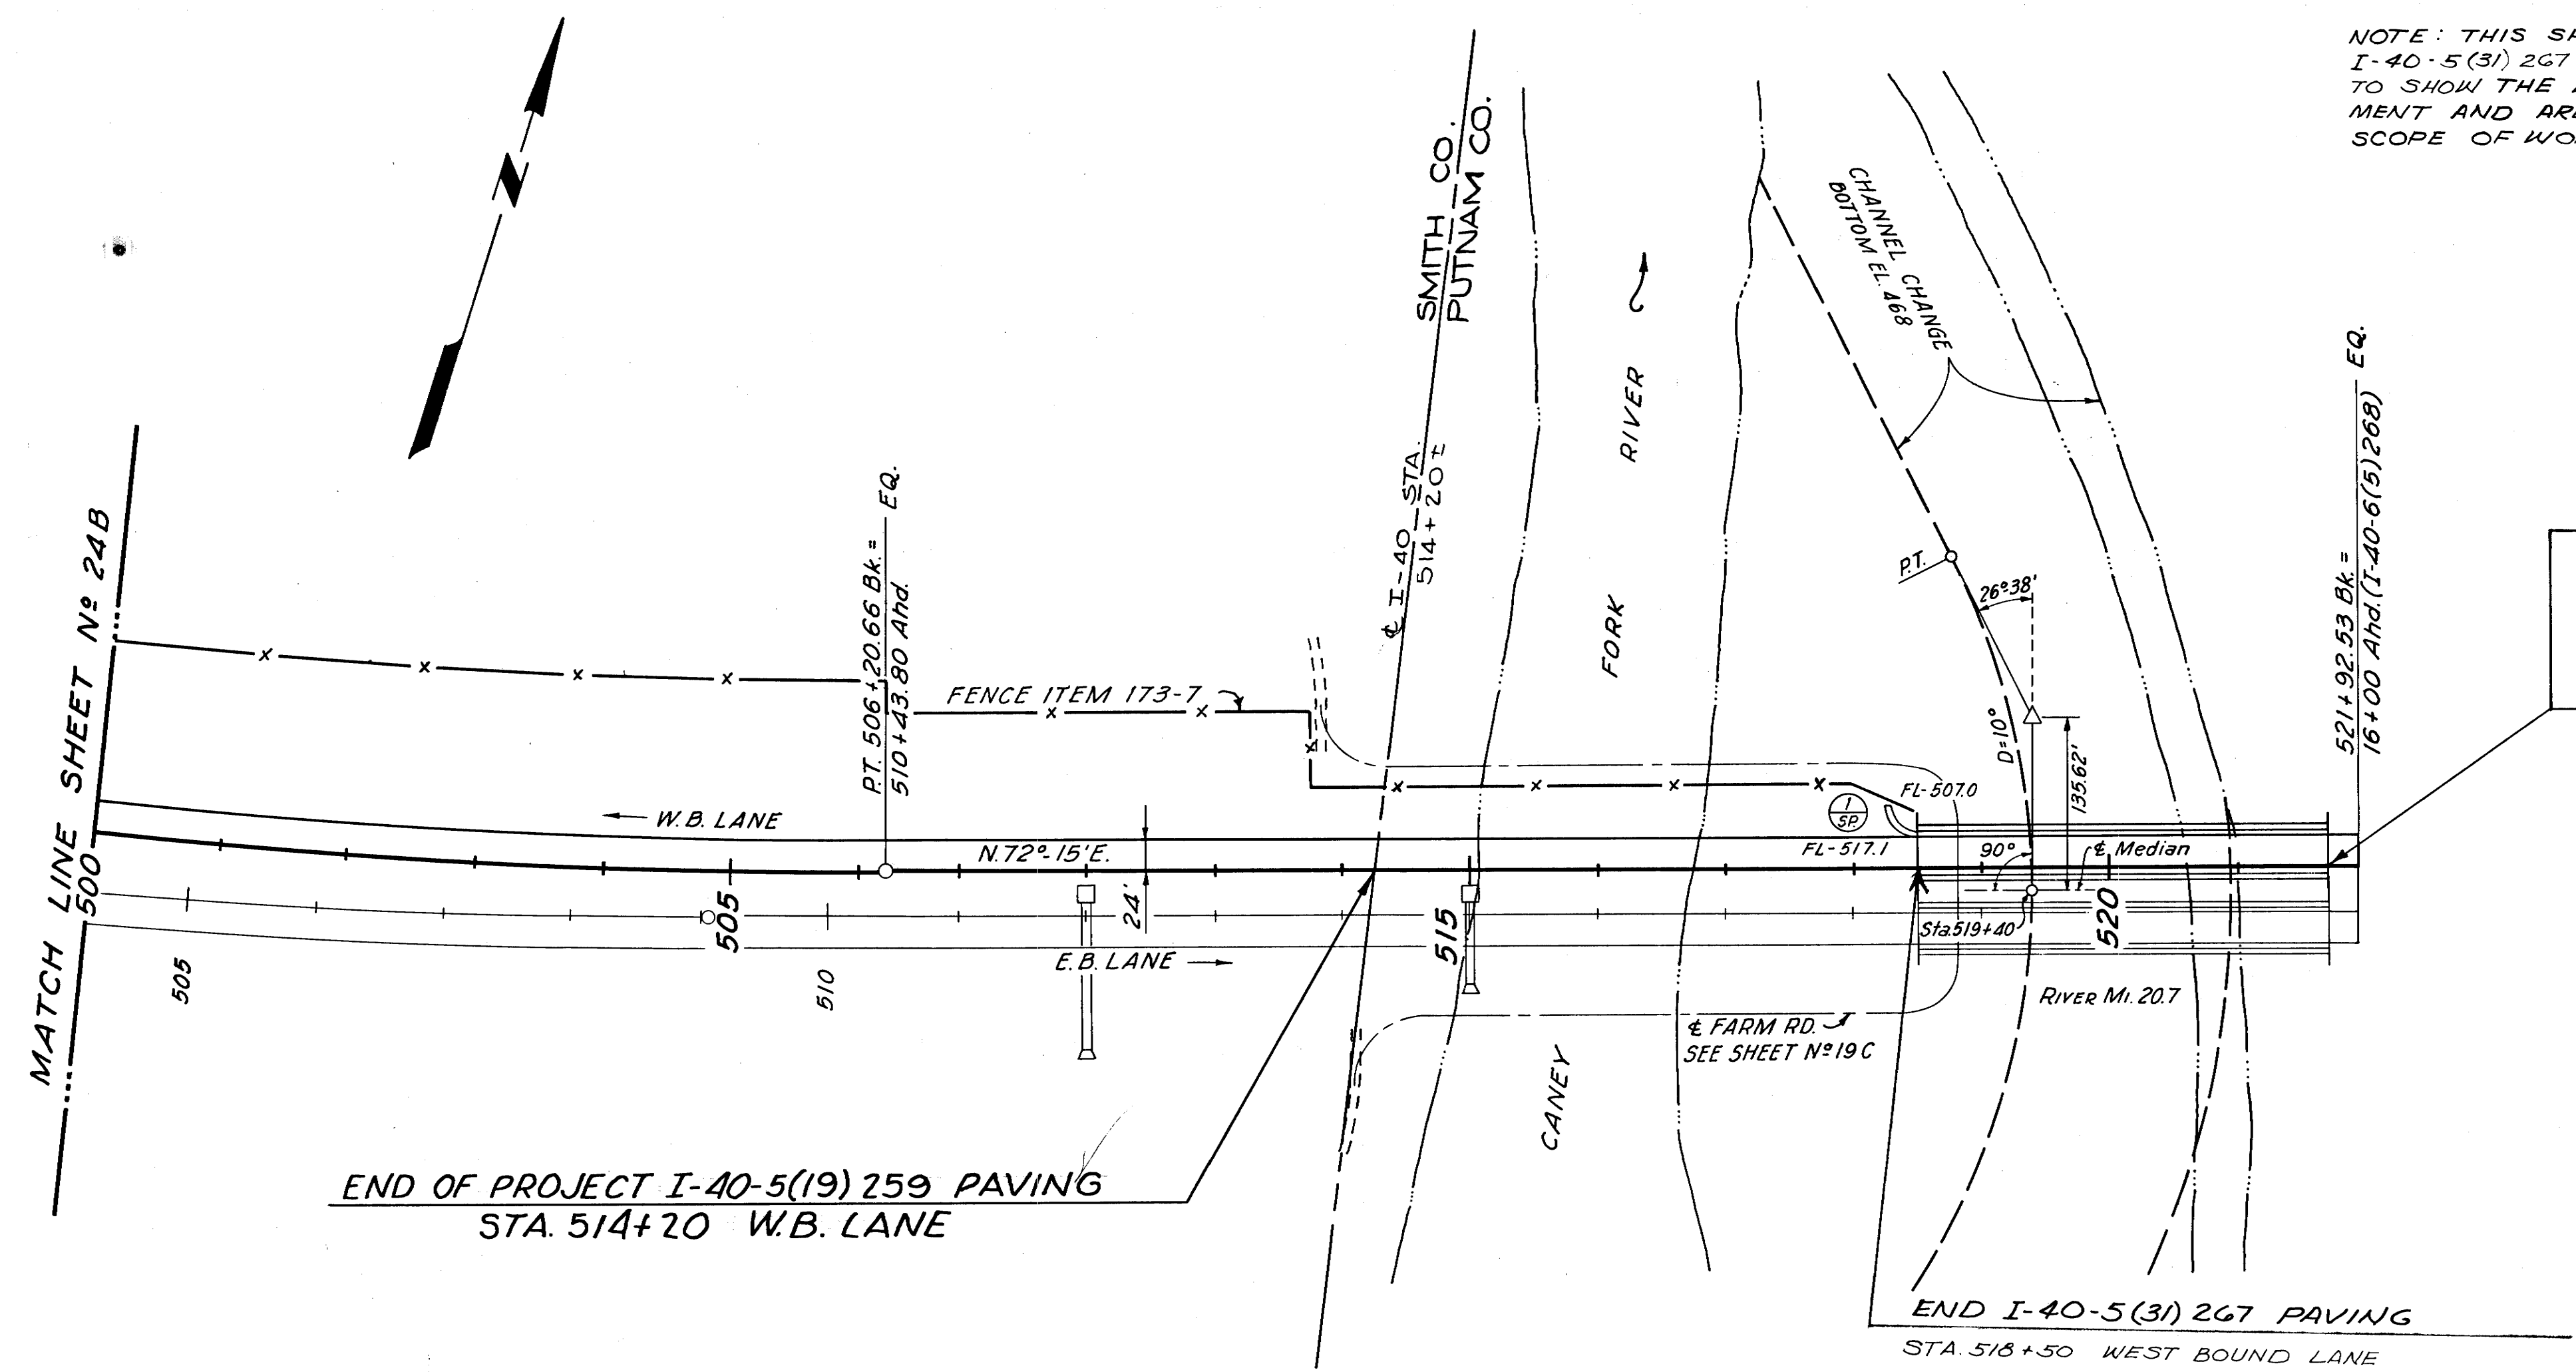


80001-8161-44
END OF PROJECT I-40-5(115) 259 RESURF.
L.M. 0.05 W.B.L.
STA. 521+ 70.00 W.B.L.

END OF PROJECT I-40-5(9) 264 CONSTR.
STA. 521+70.00 W.B. LANE

NOTE:
Minimum Channel Width of 155' on Caney Fork River
Shall be Maintained During All Stages of Construction.

GRADING QUANTITIES INCLUDED WITH E.B. LANE

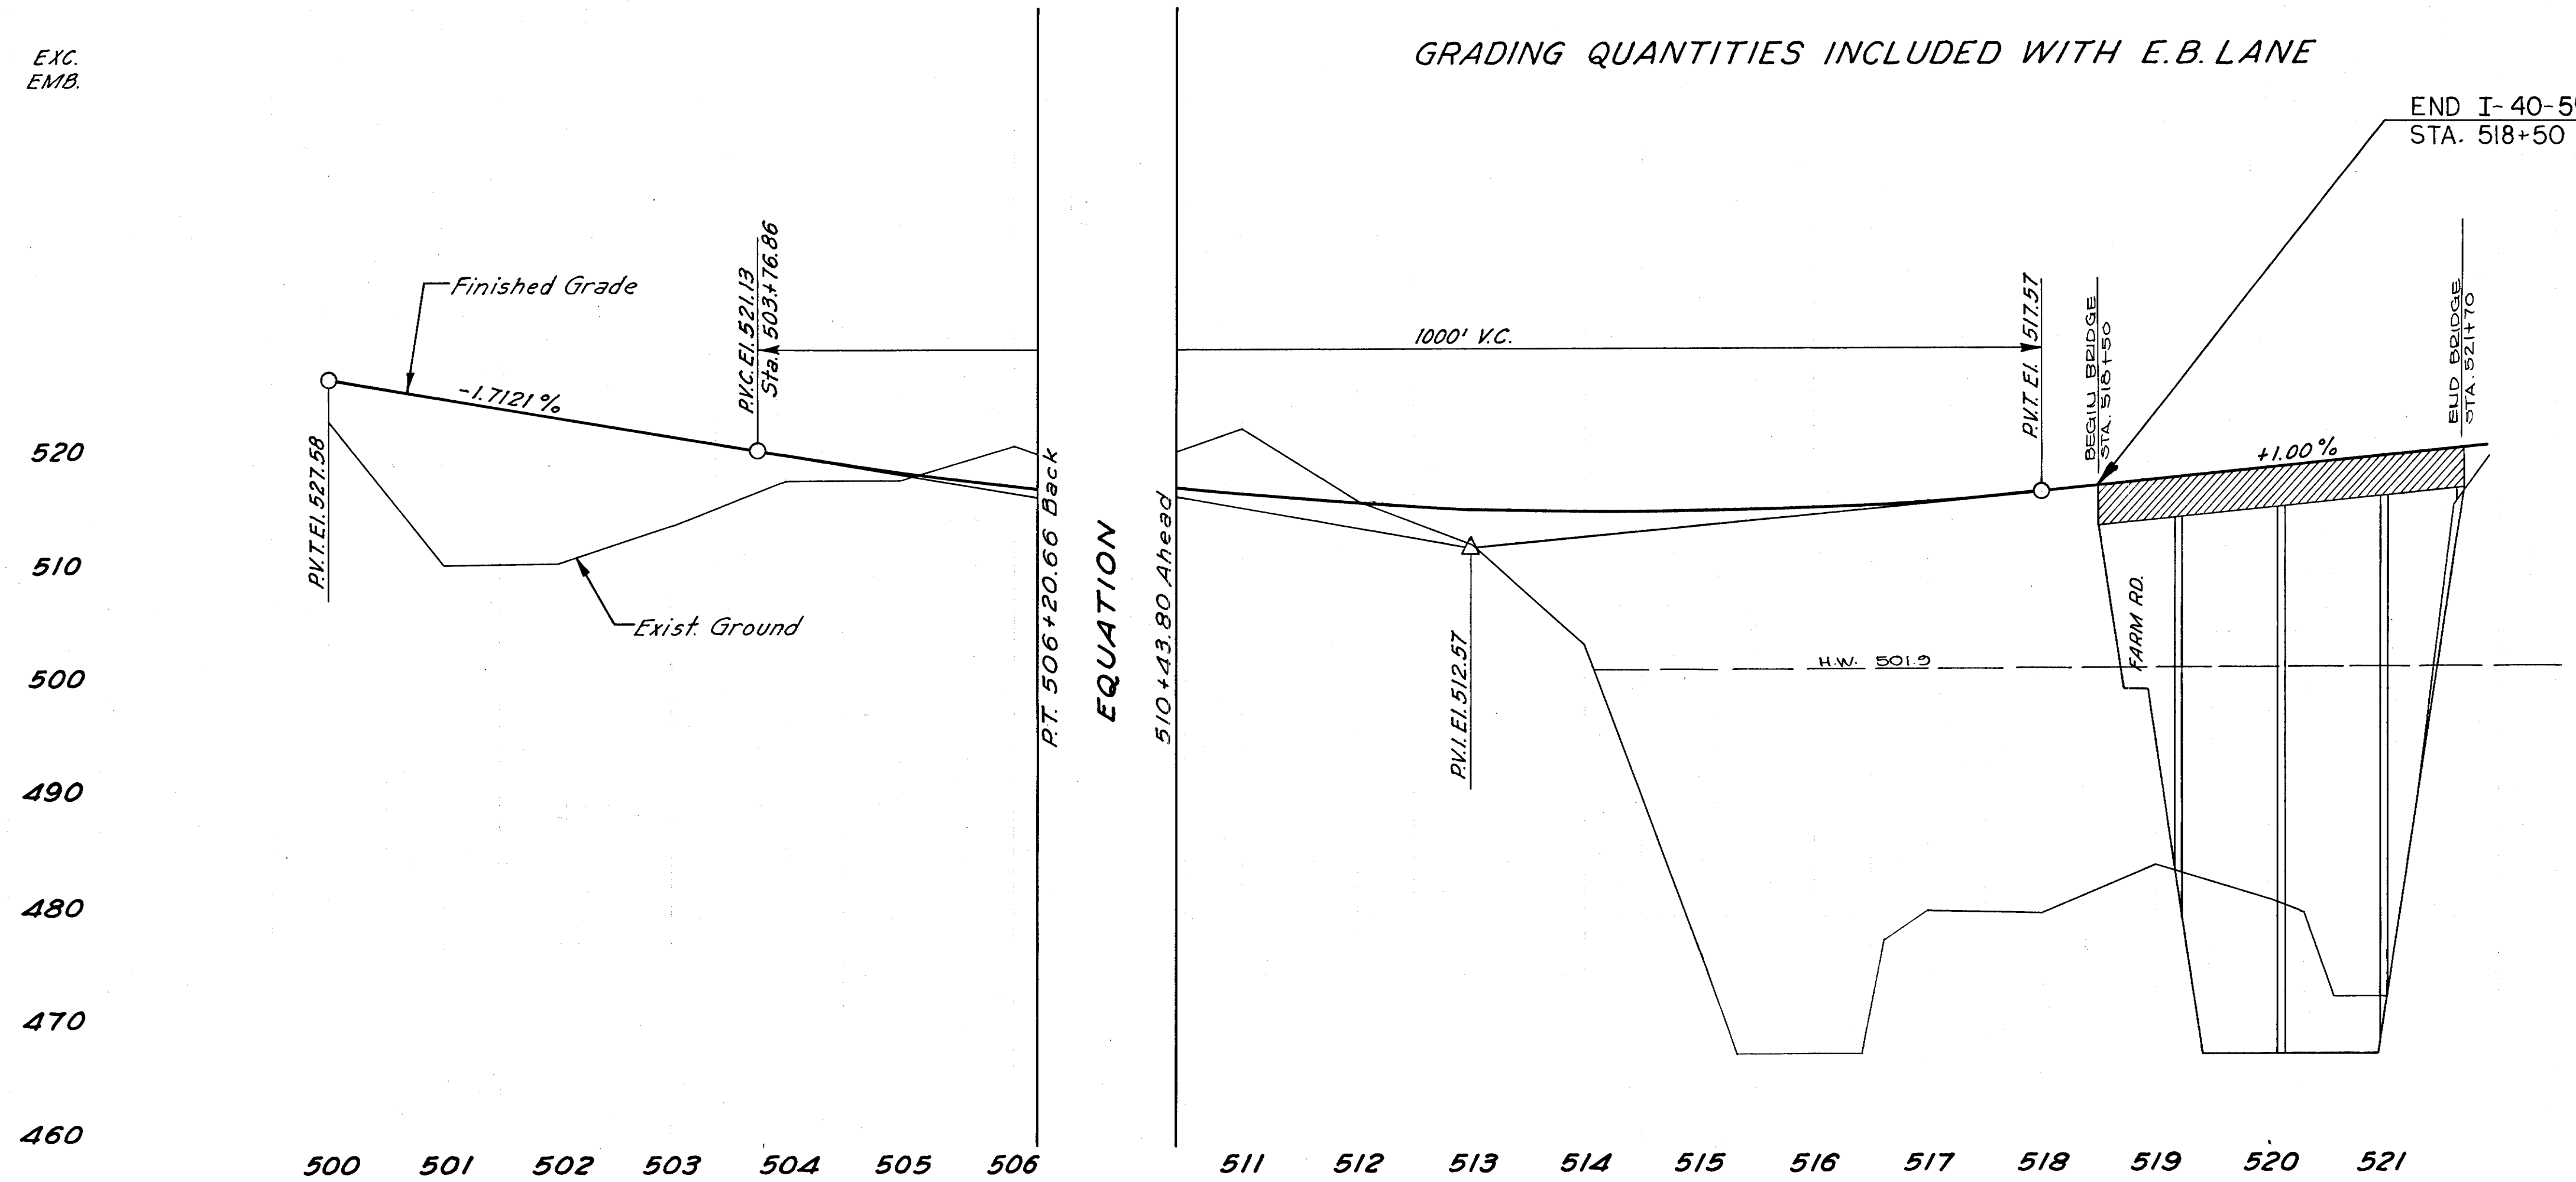

SPILLWAYS					
LOCATION	TYPE	DWG. N°	DIMENSIONS DEPTH DIAM.	CLASS 'A' CONG. C.Y.	STEEL LBS.
1%	Spillway	P-5-8		3.86	87
TOTAL				3.86	87


* SEE SHEET N° 19A

BRIDGE N° 6B
1-4 Span Precast Prestressed Box Girder
Composite Section Bridge Req'd.
2-Spans @ 70'; 2-Spans @ 90'
Total Length 320'
30' Roadway with Safety Curbs
90° 00' Skew (See Bridge Dwg. N° G-15-127)


WESTBOUND LANE

EXC.
EMB.


520
510
500
490
480
470
460

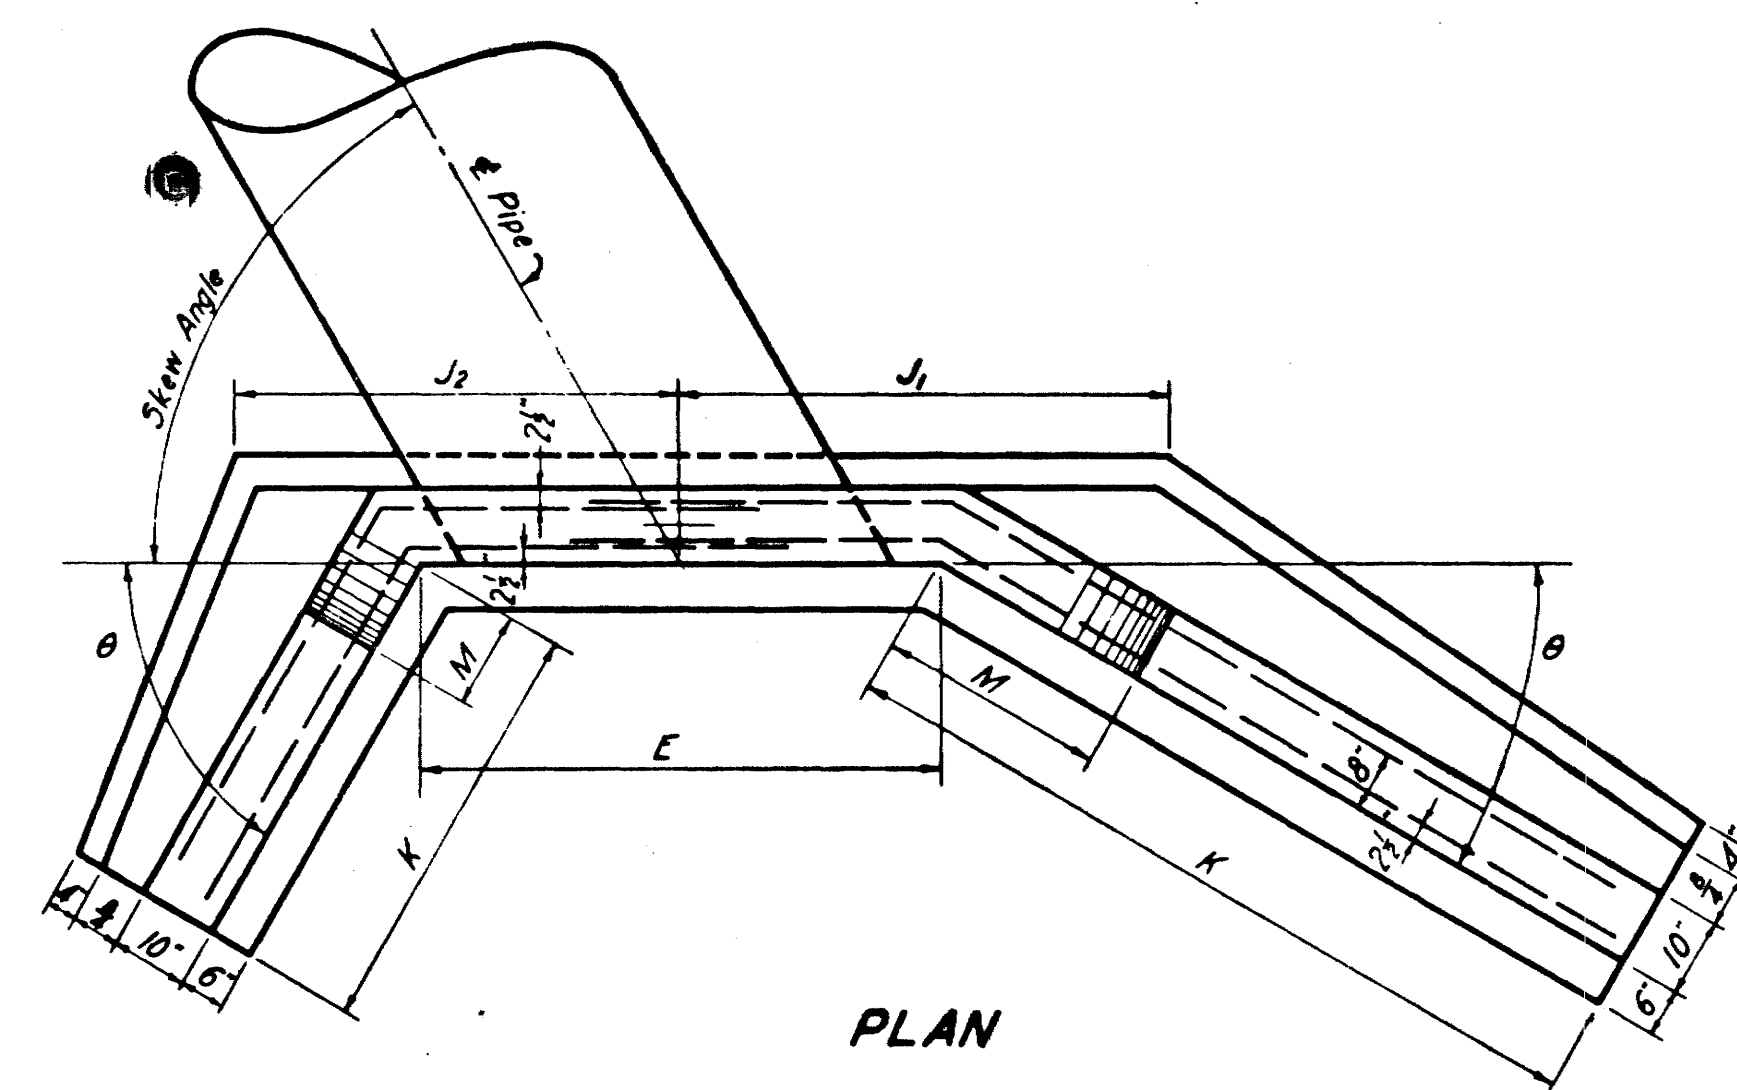


PLAN

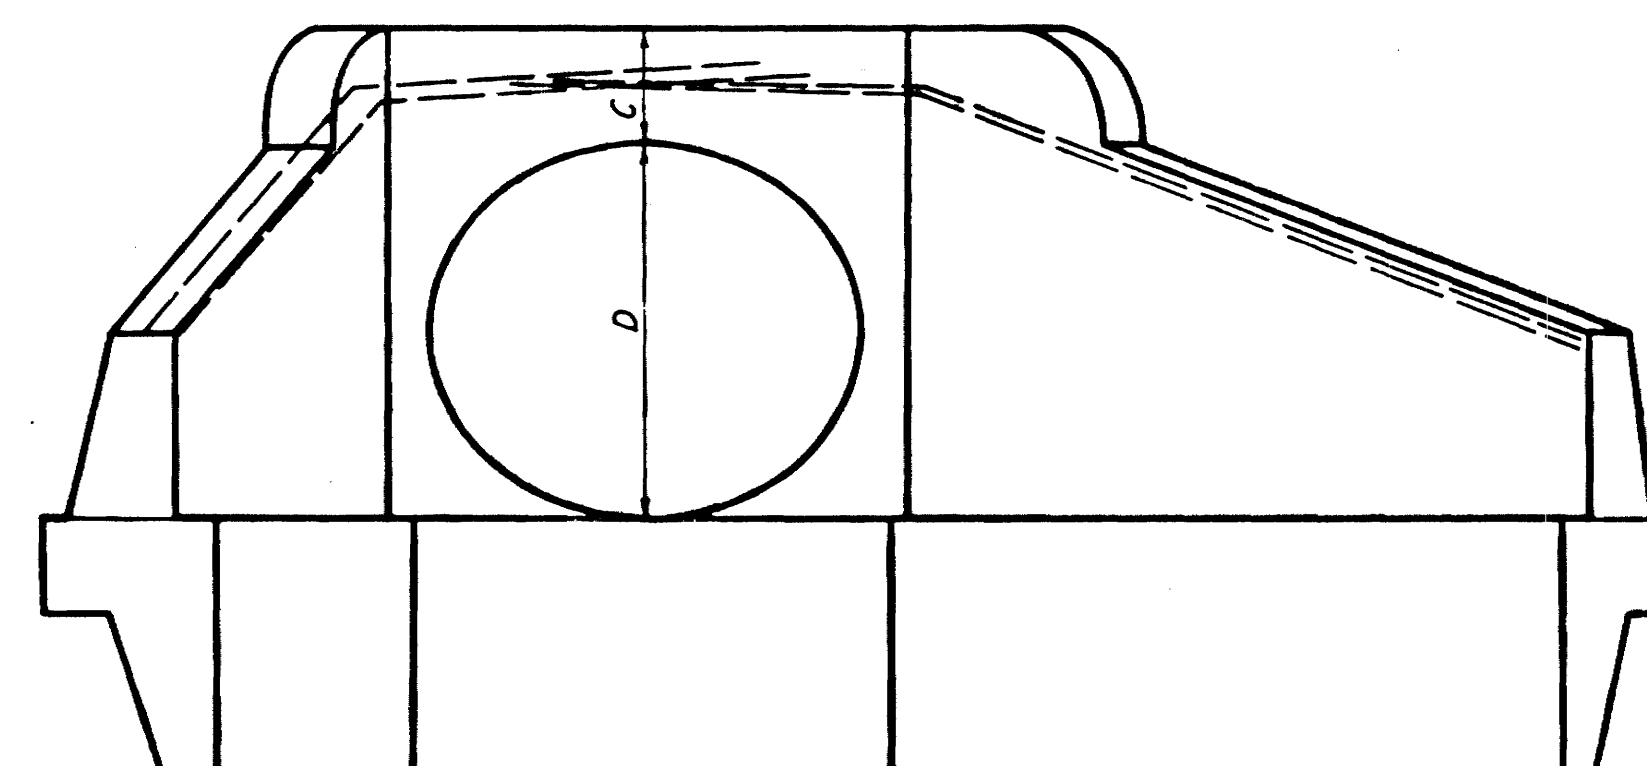


ELEVATION

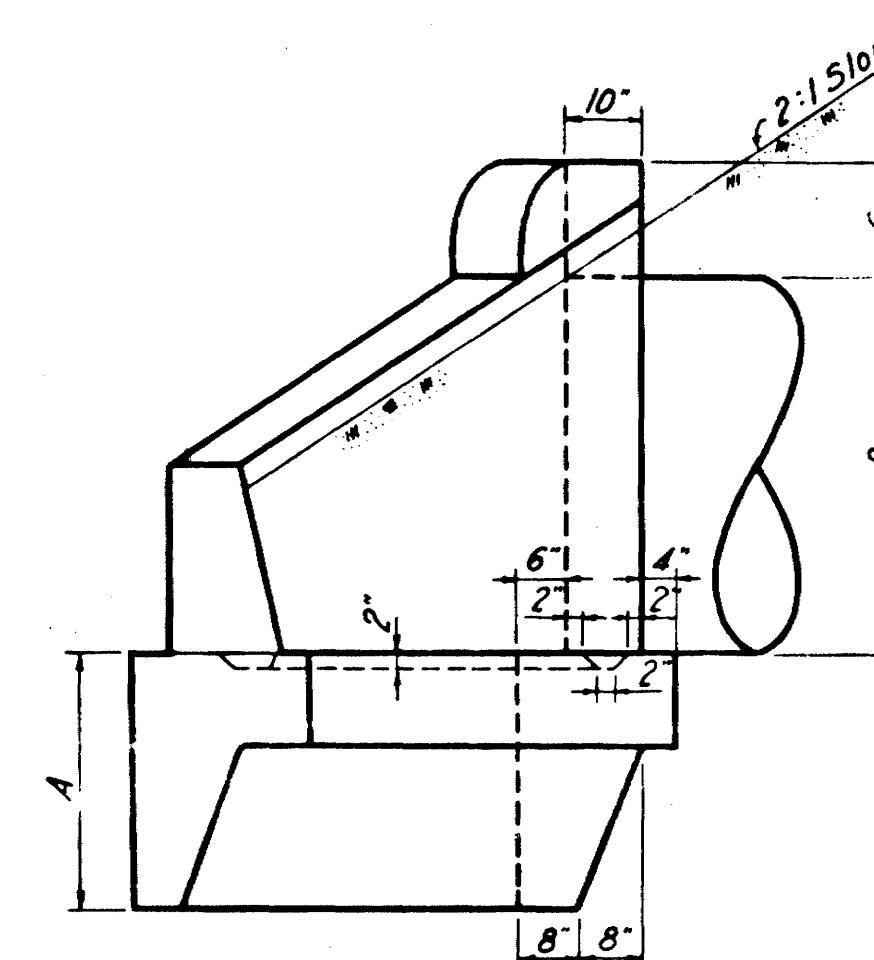


END VIEW

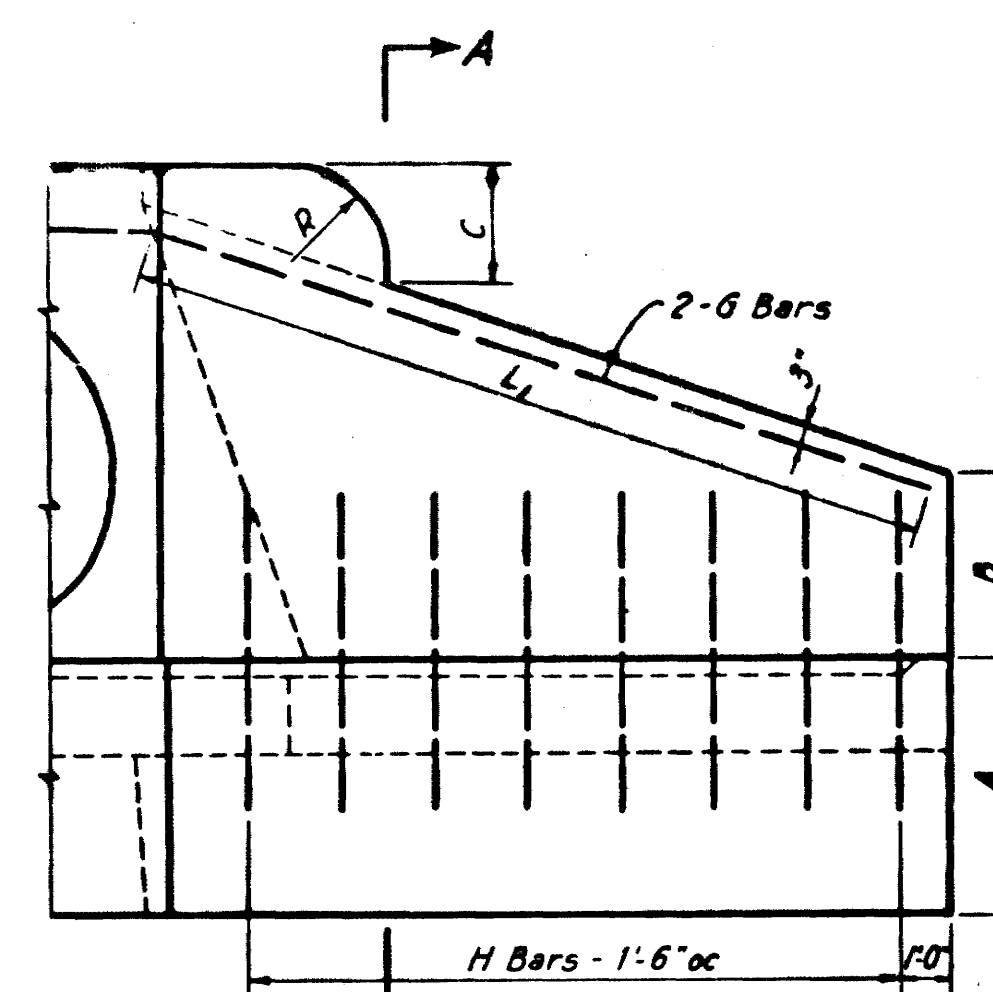


FRONT ELEVATION OF WING

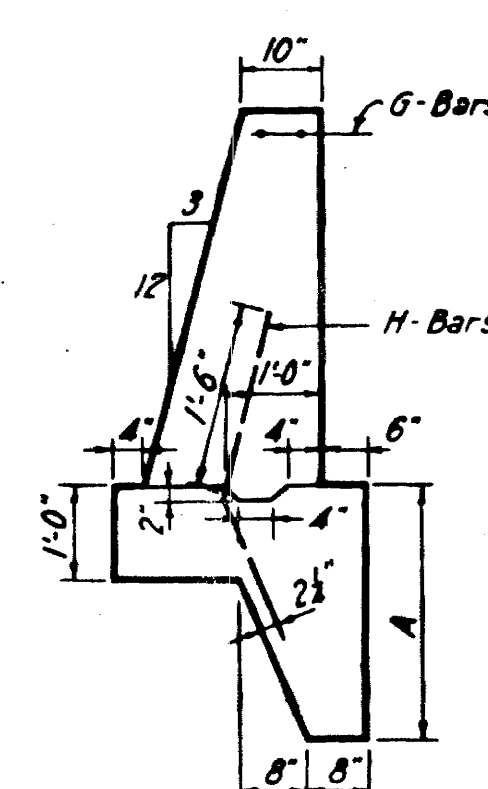

SECTION A-A

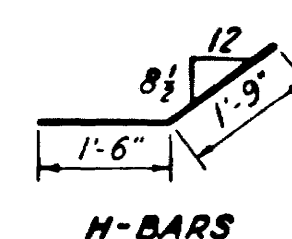

H-BARS

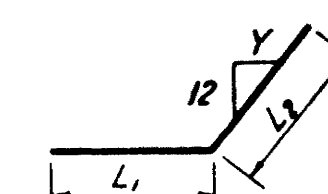

G-BARS

DIAM. D	DIMENSIONS													REINFORCING STEEL						QUANTITIES IN ONE ENDWALL	
	A	B	C	SKEW	E	J ₁	J ₂	WING	Θ	K	M	R	H-BARS #4 5'-3" Lg. NO.	G-BARS #6				STEEL LBS.	CONC. CU.YDS.		
														NO.	LENGTH		BEND Y				
															L ₁	L ₂	TOTAL				
36"	2'-6"	1'-6"	1'-0"	90°	3'-8"	3'-6"	3'-6"	Both	45°	6'-0"	1'-9"	1'-0"	8	4	6'-2"	3'-2"	9'-4"	11 1/2	73	3.89	
				75°	3'-9 1/2"	3'-8 1/2"	3'-7"	Long	37°30'	7'-1 1/2"	2'-2 1/2"	1'-0"	4	2	7'-2"	3'-2"	10'-4"	15	73	4.00	
								Short	52°30'	5'-3 3/4"	1'-5 3/4"	1'-0"	3	2	5'-6"	3'-3"	8'-9"	9			
				60°	4'-2 1/2"	4'-1 1/2"	3'-10"	Long	30°00'	8'-9 1/2"	2'-9 1/2"	1'-0"	5	2	8'-10"	3'-5"	12'-3"	19 1/2	80	4.37	
								Short	60°00'	4'-8 1/2"	1'-3"	1'-0"	3	2	5'-0"	3'-6"	8'-6"	6 1/2			
				45°	5'-2 1/2"	5'-0 1/2"	4'-4 1/2"	Long	22°30'	11'-7"	3'-9"	1'-0"	7	2	11'-7"	3'-11"	15'-6"	27	94	5.16	
								Short	67°30'	4'-3 1/2"	1'-0 1/2"	1'-0"	3	2	4'-7"	4'-0"	8'-7"	5			
42"	2'-6"	1'-9"	1'-0"	90°	4'-3"	4'-0"	4'-0"	Both	45°	6'-8 1/2"	1'-9 1/2"	1'-0"	8	4	6'-11"	3'-5"	10'-4"	11 1/2	79	4.72	
				75°	4'-4 1/2"	4'-2 1/2"	4'-0 1/2"	Long	37°30'	7'-11 1/2"	2'-2 1/2"	1'-0"	5	2	8'-1"	3'-6"	11'-7"	15	84	4.85	
								Short	52°30'	5'-10 1/2"	1'-5 1/2"	1'-0"	4	2	6'-2"	3'-7"	9'-9"	9			
				60°	4'-11"	4'-8 1/4"	4'-3 1/4"	Long	30°00'	9'-9 1/2"	2'-9 1/2"	1'-0"	6	2	9'-10"	3'-9"	13'-7"	19 1/2	89	5.29	
								Short	60°00'	5'-3 1/2"	1'-3"	1'-0"	3	2	5'-8"	3'-10"	9'-6"	6 1/2			
				45°	6'-0 1/2"	5'-8 1/4"	4'-11"	Long	22°30'	12'-10 1/2"	3'-9"	1'-0"	8	2	12'-11"	4'-4"	17'-3"	27	105	6.25	
								Short	67°30'	4'-10 1/2"	1'-0 1/2"	1'-0"	3	2	5'-3"	4'-5"	9'-8"	5			
				90°	4'-10"	4'-5 1/2"	4'-5 1/2"	Both	45°	7'-5"	1'-9 1/2"	1'-0"	10	4	7'-8"	3'-9"	11'-5"	11 1/2	90	5.88	
48"	2'-9"	2'-0"	1'-3"	75°	5'-0"	4'-8 1/2"	4'-5 1/2"	Long	37°30'	8'-9"	2'-2 1/2"	1'-0"	6	2	8'-11"	3'-9"	12'-8"	15	92	6.05	
								Short	52°30'	6'-6 1/2"	1'-5 1/2"	1'-0"	4	2	6'-10"	3'-10"	10'-8"	9			
				60°	5'-7"	5'-3"	4'-9 1/4"	Long	30°00'	10'-9 1/2"	2'-9 1/2"	1'-0"	7	2	10'-11"	4'-1"	15'-0"	19 1/2	100	6.60	
								Short	60°00'	5'-10 1/2"	1'-3"	1'-0"	4	2	6'-3"	4'-2"	10'-5"	6 1/2			
				45°	6'-10"	6'-5 1/4"	5'-5 1/4"	Long	22°30'	14'-2 1/2"	3'-9"	1'-0"	9	2	14'-3"	4'-9"	19'-0"	27	117	7.80	
								Short	67°30'	5'-4 1/2"	1'-0 1/2"	1'-0"	4	2	5'-10"	4'-10"	10'-8"	5			
54"	2'-9"	2'-0"	1'-3"	90°	5'-5"	4'-11"	4'-11"	Both	45°	8'-10 1/2"	1'-9 1/2"	1'-0"	12	4	9'-2"	4'-0"	13'-2"	11 1/2	105	7.26	
				75°	5'-7 1/2"	5'-2"	4'-11 1/4"	Long	37°30'	10'-4 1/2"	2'-2 1/2"	1'-0"	7	2	10'-8"	4'-1"	14'-9"	15	108	7.46	
								Short	52°30'	7'-9 1/2"	1'-5 1/2"	1'-0"	5	2	8'-2"	4'-2"	12'-4"	9			
				60°	6'-3"	5'-9 3/4"	5'-3"	Long	30°00'	12'-9 1/2"	2'-9 1/2"	1'-0"	8	2	12'-11"	4'-5"	17'-4"	19 1/2	114	8.13	
								Short	60°00'	7'-0 1/2"	1'-3"	1'-0"	4	2	7'-6"	4'-6"	12'-0"	6 1/2			
				45°	7'-8"	7'-1 1/4"	6'-0"	Long	22°30'	16'-9 1/2"	3'-9"	1'-0"	11	2	16'-11"	5'-2"	22'-1"	27	136	9.60	
								Short	67°30'	6'-5 1/2"	1'-0 1/2"	1'-0"	4	2	7'-0"	5'-3"	12'-3"	5			
60"	3'-0"	2'-0"	1'-6"	90°	6'-0"	5'-4 1/2"	5'-4 1/2"	Both	45°	10'-3 1/2"	1'-9 1/2"	1'-0"	14	4	10'-8"	4'-4"	15'-0"	11 1/2	120	9.07	
				75°	6'-2 1/2"	5'-8"	5'-4 1/2"	Long	37°30'	12'-0 1/2"	2'-2 1/2"	1'-0"	8	2	12'-4"	4'-5"	16'-9"	15	123	9.32	
								Short	52°30'	9'-0"	1'-5 1/2"	1'-0"	6	2	9'-7"	4'-6"	14'-1"	9			
				60°	6'-11 1/2"	6'-4 1/2"	5'-8 1/2"	Long	30°00'	14'-9 1/2"	2'-9 1/2"	1'-0"	9	2	15'-0"	4'-9"	19'-9"	19 1/2	130	10.17	
								Short	60°00'	8'-2 1/2"	1'-3"	1'-0"	5	2	8'-9"	4'-10"	13'-7"	6 1/2			
				45°	8'-5 1/2"	7'-10 1/2"	6'-6 1/2"	Long	22°30'	19'-5 1/2"	3'-9"	1'-0"	12	2	19'-7"	5'-6"	25'-1"	27	152	12.00	
								Short	67°30'	7'-6 1/2"	1'-0 1/2"	1'-0"	5	2	7'-6"	5'-8"	13'-2"	5			
66"	3'-3"	2'-0"	1'-6"	90°	6'-7"	5'-10"	5'-10"	Both	45°	11'-8 1/2"	1'-9 1/2"	1'-0"	24	4	11'-5"	4'-8"	16'-1"	11 1/2	153	11.41	
				75°	7'-0"	6'-3"	5'-11 1/2"	Long	37°30'	13'-8 1/2"	2'-2 1/2"	1'-0"	14	2	13'-5"	4'-10"	18'-3"	15	158	11.74	
								Short	52°30'	10'-3 1/2"	1'-5 1/2"	1'-0"	11	2	10'-0"	4'-11"	14'-11"	9			
				60°	7'-9 1/2"	7'-0 1/2"	6'-3 1/2"	Long	30°00'	16'-9 1/2"	2'-9 1/2"	1'-0"	17	2	16'-6"	5'-3"	21'-9"	19 1/2	169	12.82	
								Short	60°00'	9'-4"	1'-3"	1'-0"	9	2	9'-1"	5'-4"	14'-5"	6 1/2			
				45°	9'-6 1/2"	8'-8 1/2"	7'-2 1/2"	Long	22°30'	22'-0 1/2"	3'-9"	1'-0"	22	2	21'-9"	6'-2"	27'-11"	27	198	16.60	
								Short	67°30'	8'-8"	1'-0 1/2"	1'-0"	8	2	8'-3"	6'-3"	14'-6"	5			
				35°	11'-5 1/2"	10'-6 1/2"	8'-1 1/2"	Long	47°30'	28'-1 1/2"	4'-9"	1'-0"	28	2	27'-9"	6'-6"	34'-3"	35	225	18.00	
								Short	72°30'	8'-3"	1'-0"	1'-0"	8	2	8'-2"	6'-8"	14'-10"	4			

MID-SOUTH ENGINEERING CO., INC.
820 BROADWAY, N. E. KNOXVILLE, TENNESSEE

TYPE-A
CONCRETE ENDWALL
2:1 FILL SLOPE

STATE OF TENNESSEE
DEPARTMENT OF HIGHWAYS
AND PUBLIC WORKS
NASHVILLE

DR. J.L.M. DATE 7-15-58
CHK'D
APP'D


STATE HIGHWAYS
Plans File **IN-**
Divn No. **50**

MICROFILMED

DATE	BY	REVISIONS
		PLOTTED
		TEMPLATE
		AREAS CHECKED
FINAL SURVEY	NOTE BOOK	NO.

DATE	BY	REVISIONS
		PLOTTED
		TEMPLATE
		AREAS CHECKED
ORIGINAL SURVEY	NOTE BOOK	NO.

MID-SOUTH ENGINEERING CO.				
FED. ROAD DIST.	TENN.	FEDERAL AID PROJECT No.	FISCAL YEAR	SHEET No.
3	N	I-40-5(7)264	1960	146
				147
				372

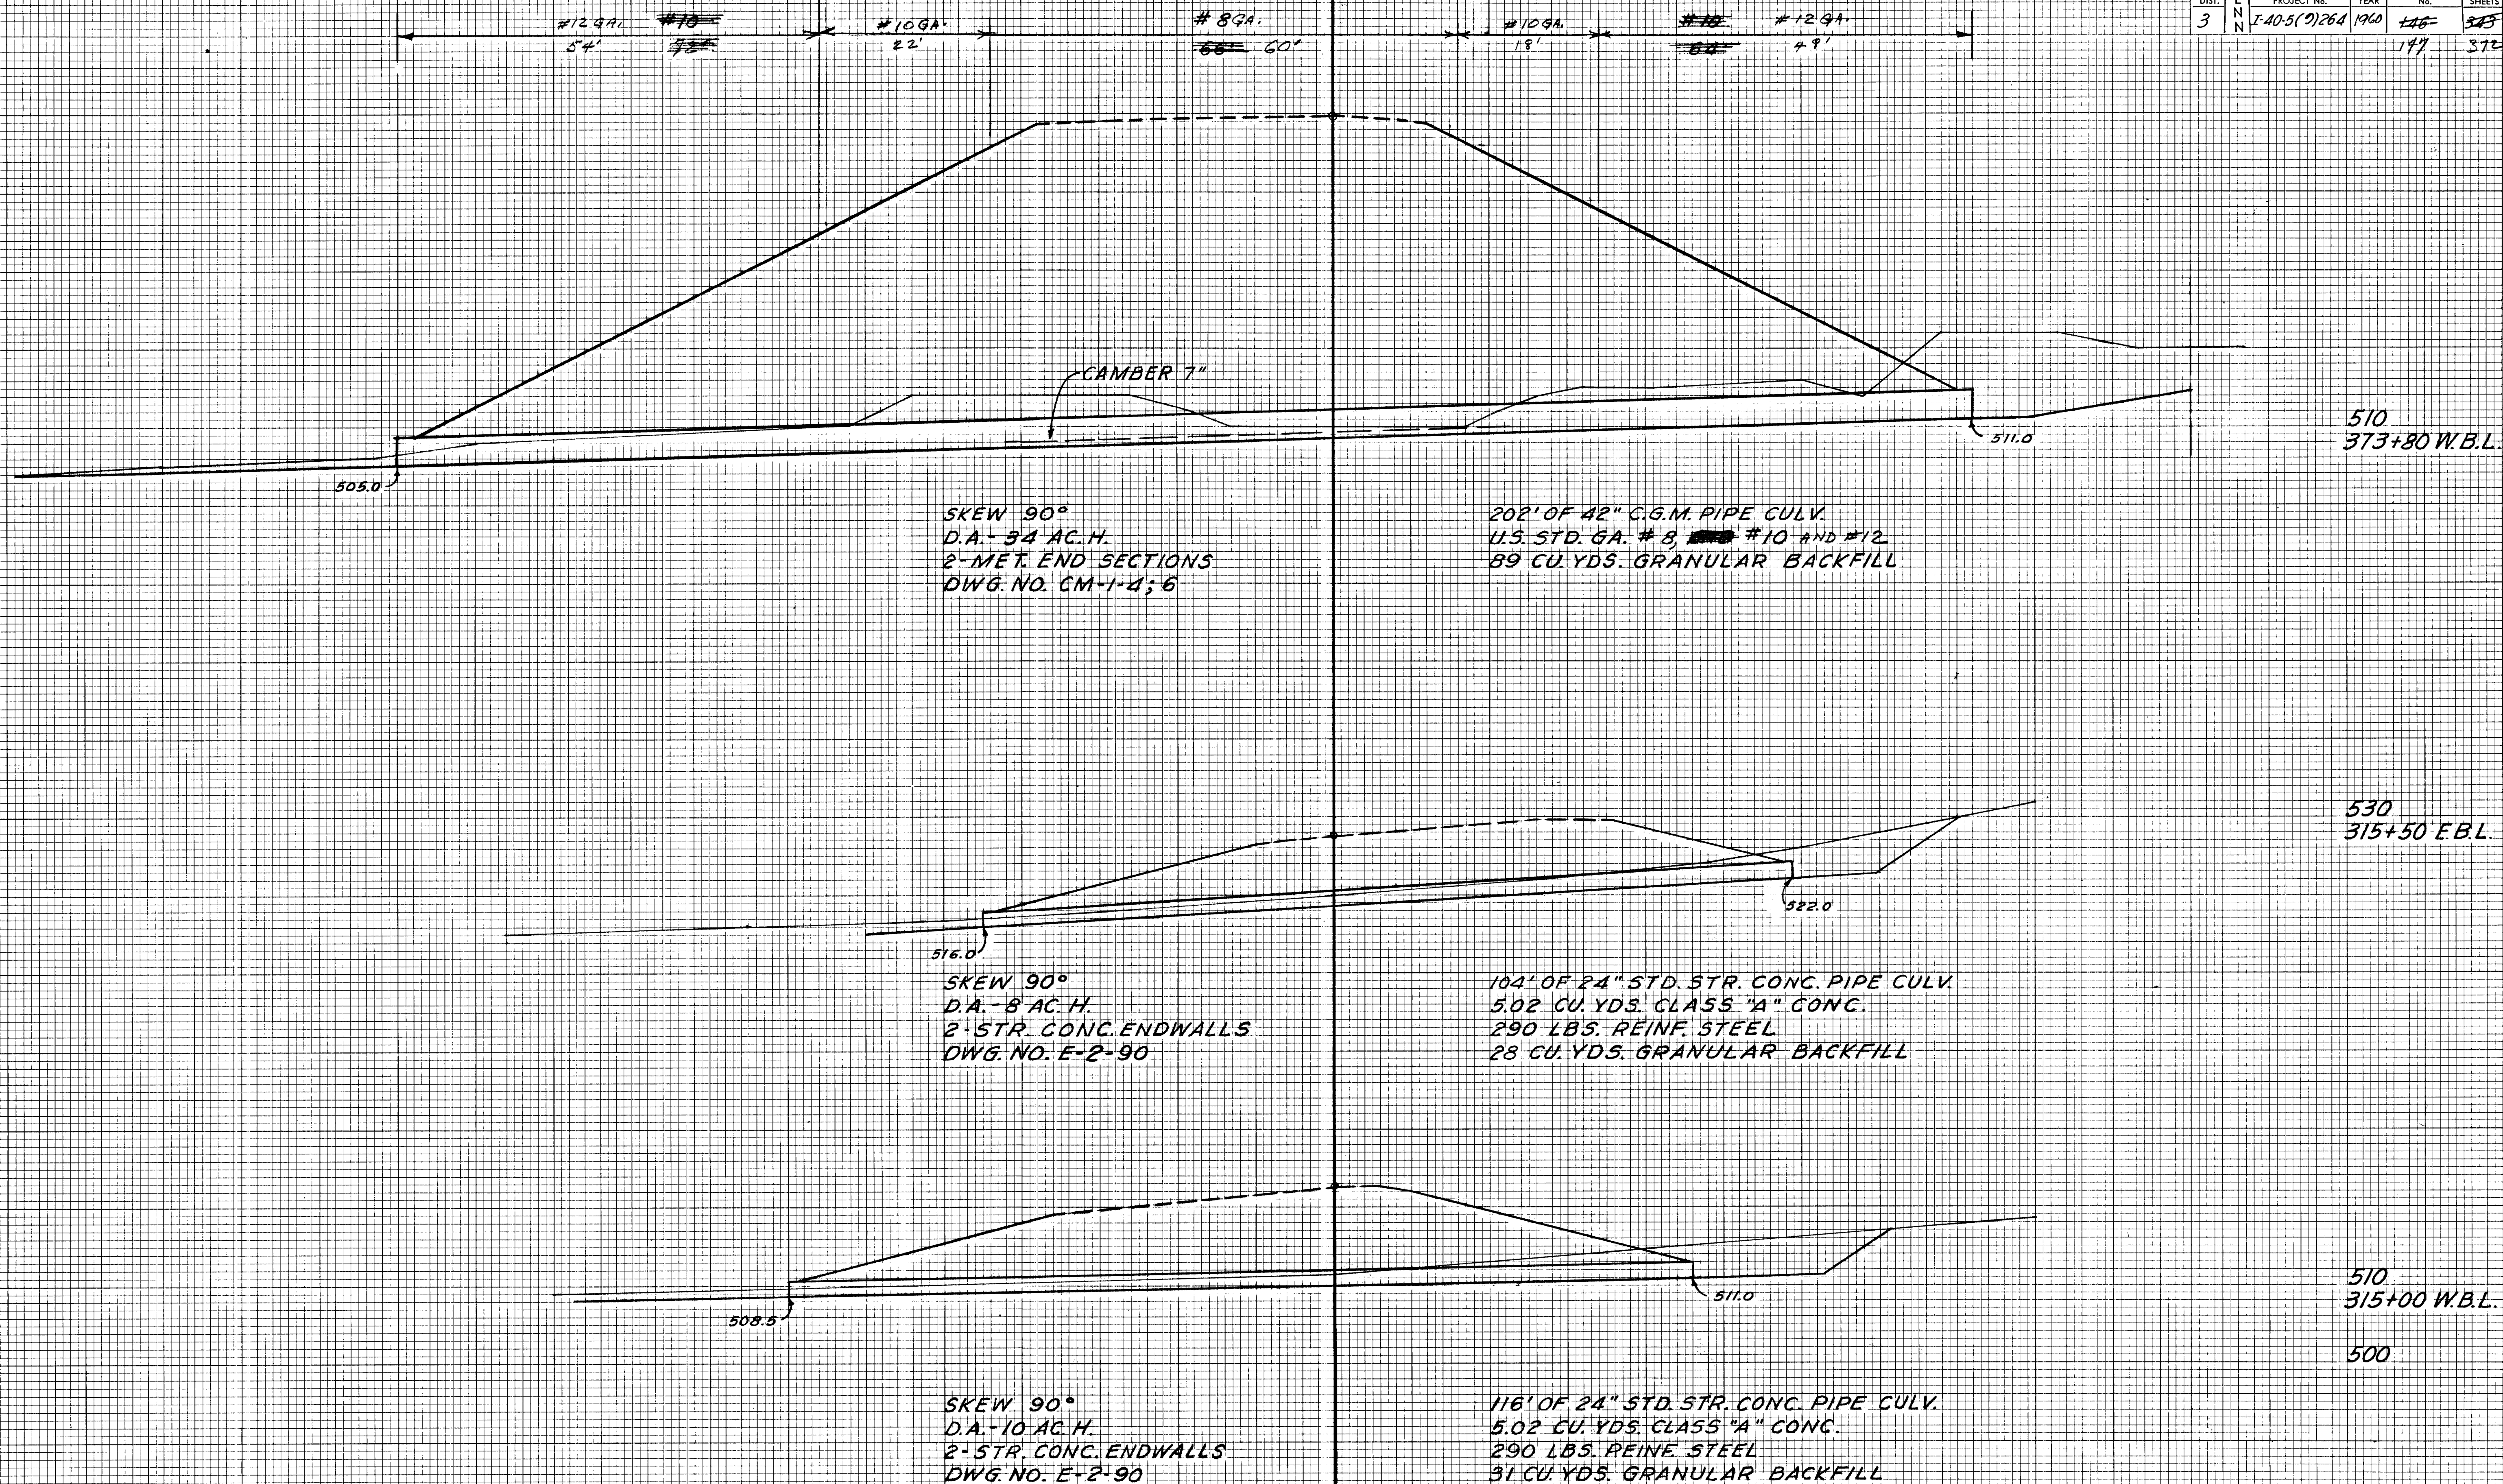


MID-SOUTH ENGINEERING CO.					
FED. ROAD DIST.	TENN.	FEDERAL AID PROJECT No.	FISCAL YEAR	SHEET No.	TOTAL SHEETS
3		I-40-5(9)264	1960	147 148	343 372

TENN. STATE HIGHWAYS
Plans File **IN-**
Divn. No. **50**

MICROFILMED

DATE	BY	REVIEWED	DATE
		PLOTTED	
		TEMPLATE	
		NOTE BOOK	
		NO.	

DATE	BY	REVIEWED	DATE
		PLOTTED	
		TEMPLATE	
		NOTE BOOK	
		NO.	

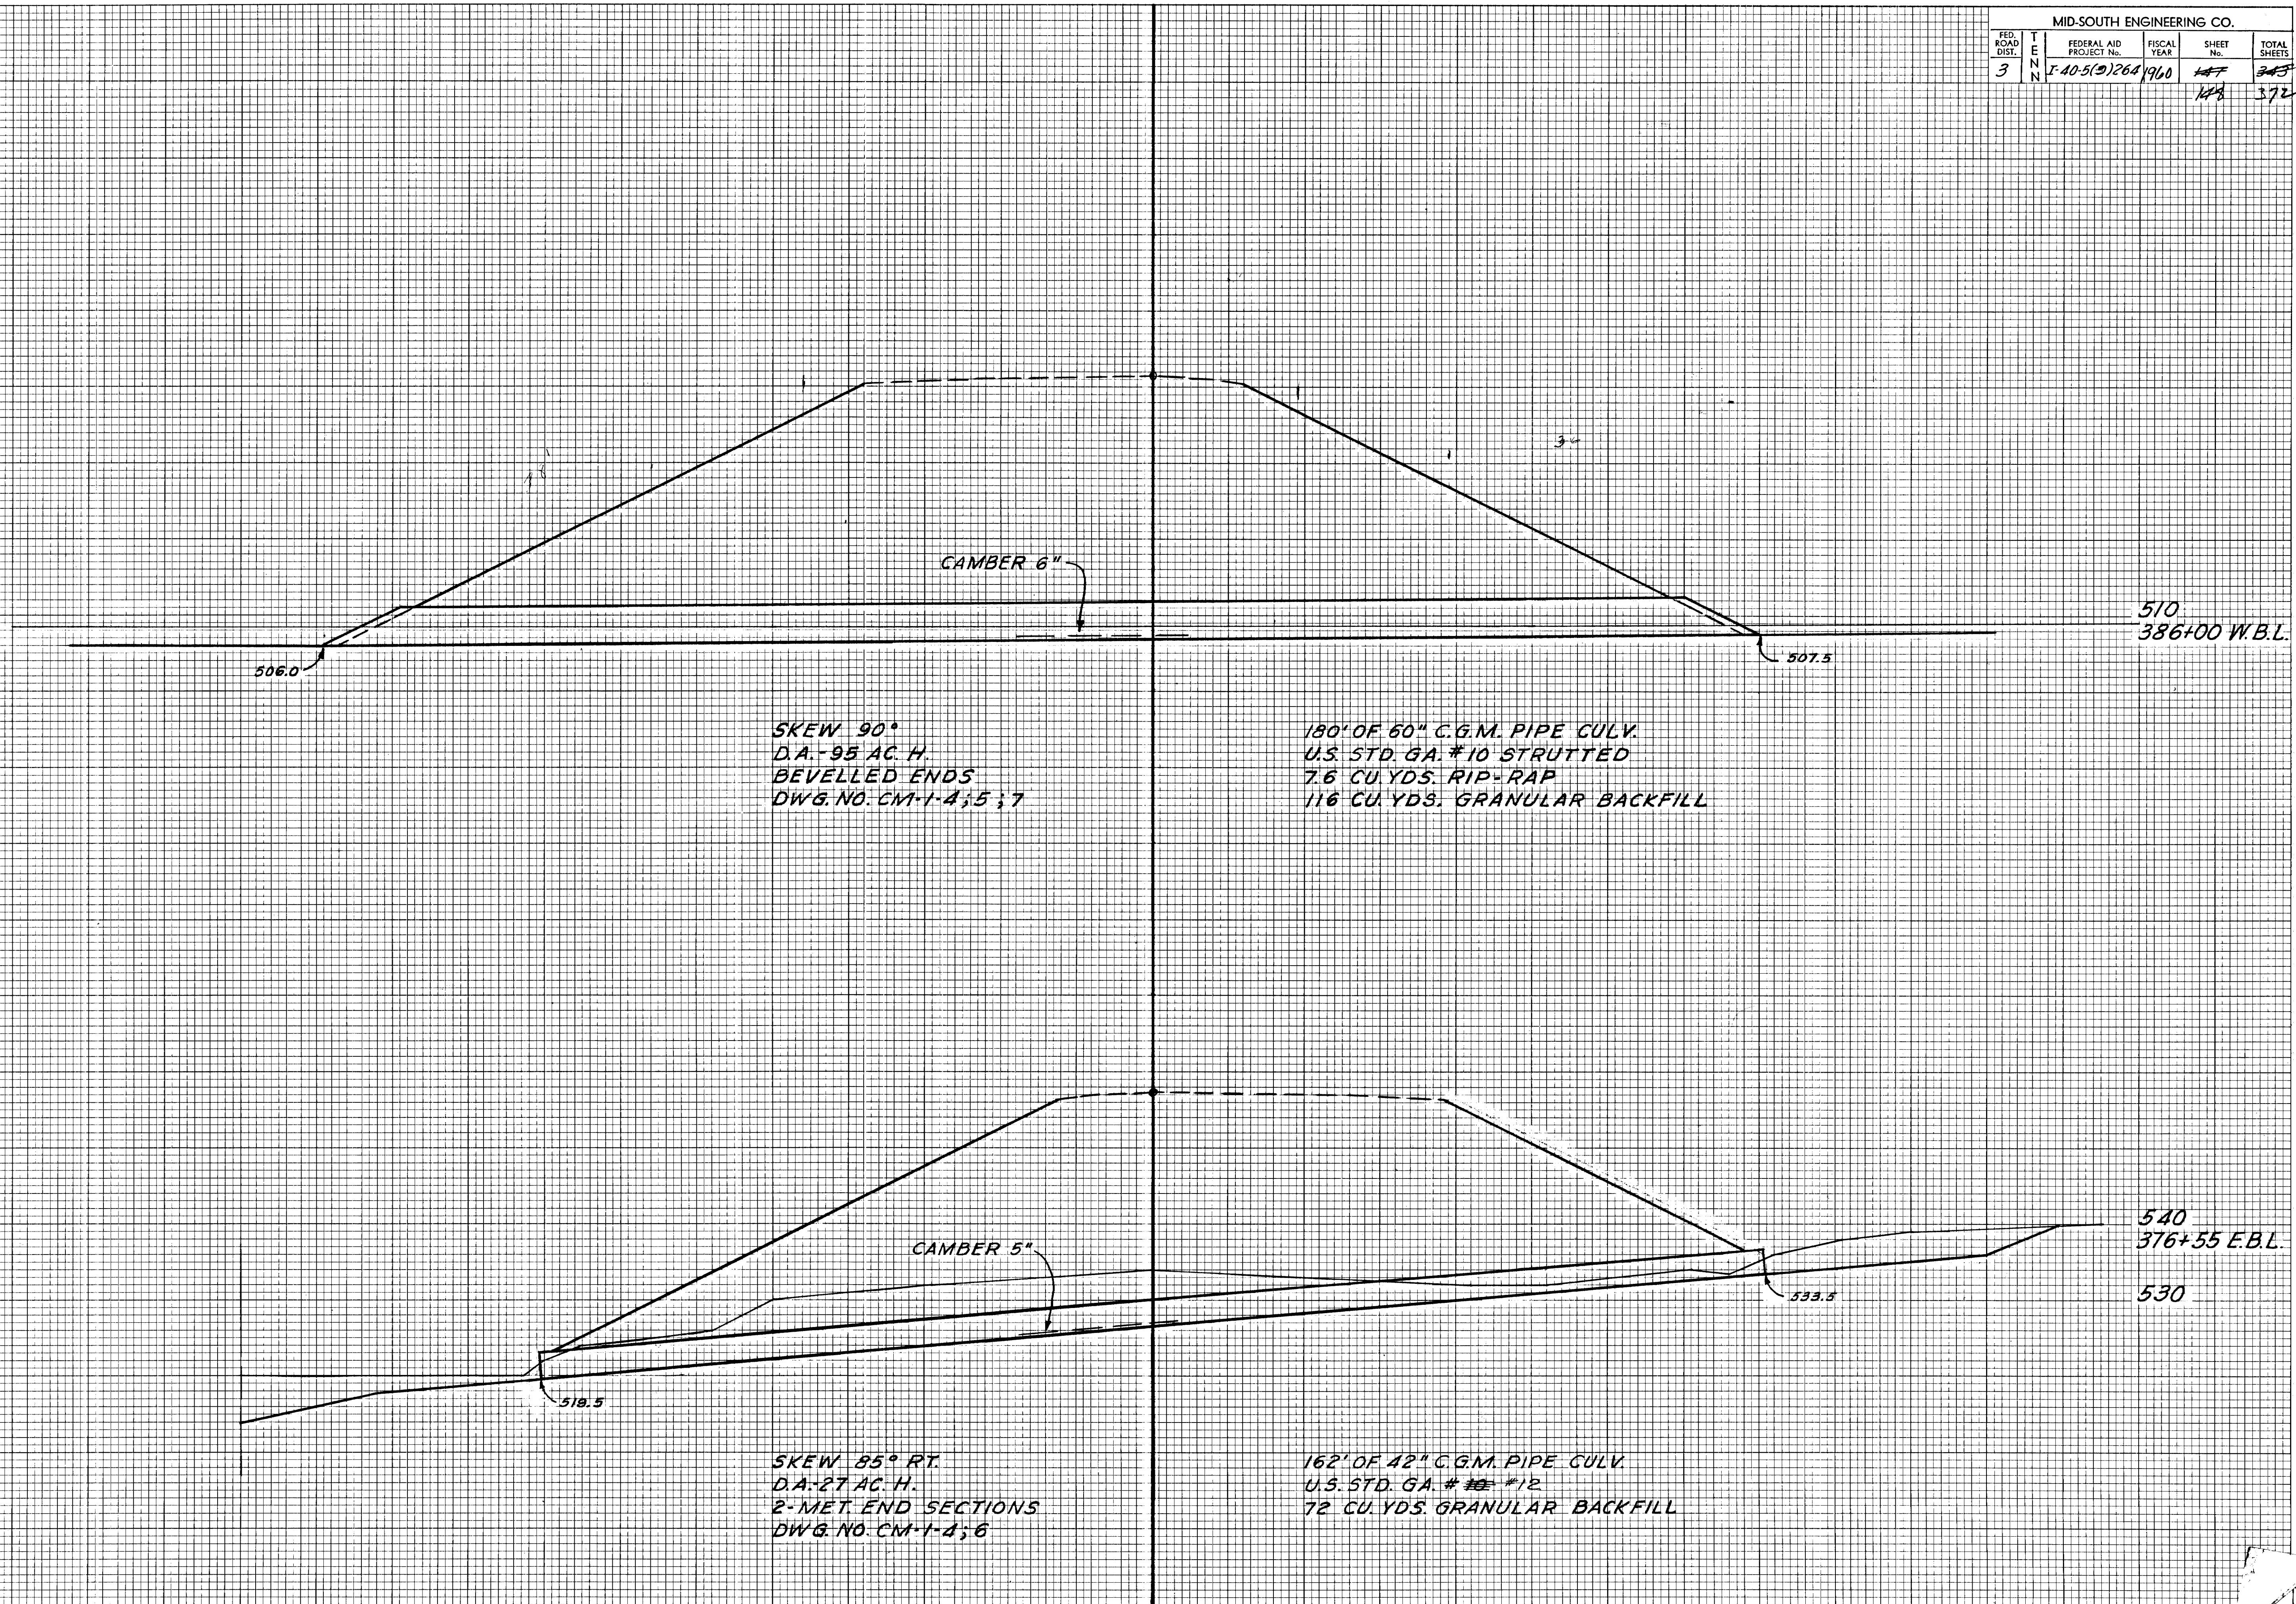


MID-SOUTH ENGINEERING CO.					
FED. ROAD DIST.	T E N N	FEDERAL AID PROJECT No.	FISCAL YEAR	SHEET No.	TOTAL SHEETS
3	N	I-40-5(2)264	1960	148	343
				149	372

TENN. STATE HIGHWAYS
Plans File **IN.**
Divn. No. **50**

MICROFILMED


DATE	BY
REVIEWED	DATE
PLOTTED	BY
TEMPLATE	AREAS
NO. BOOK	CHECKED
NO.	

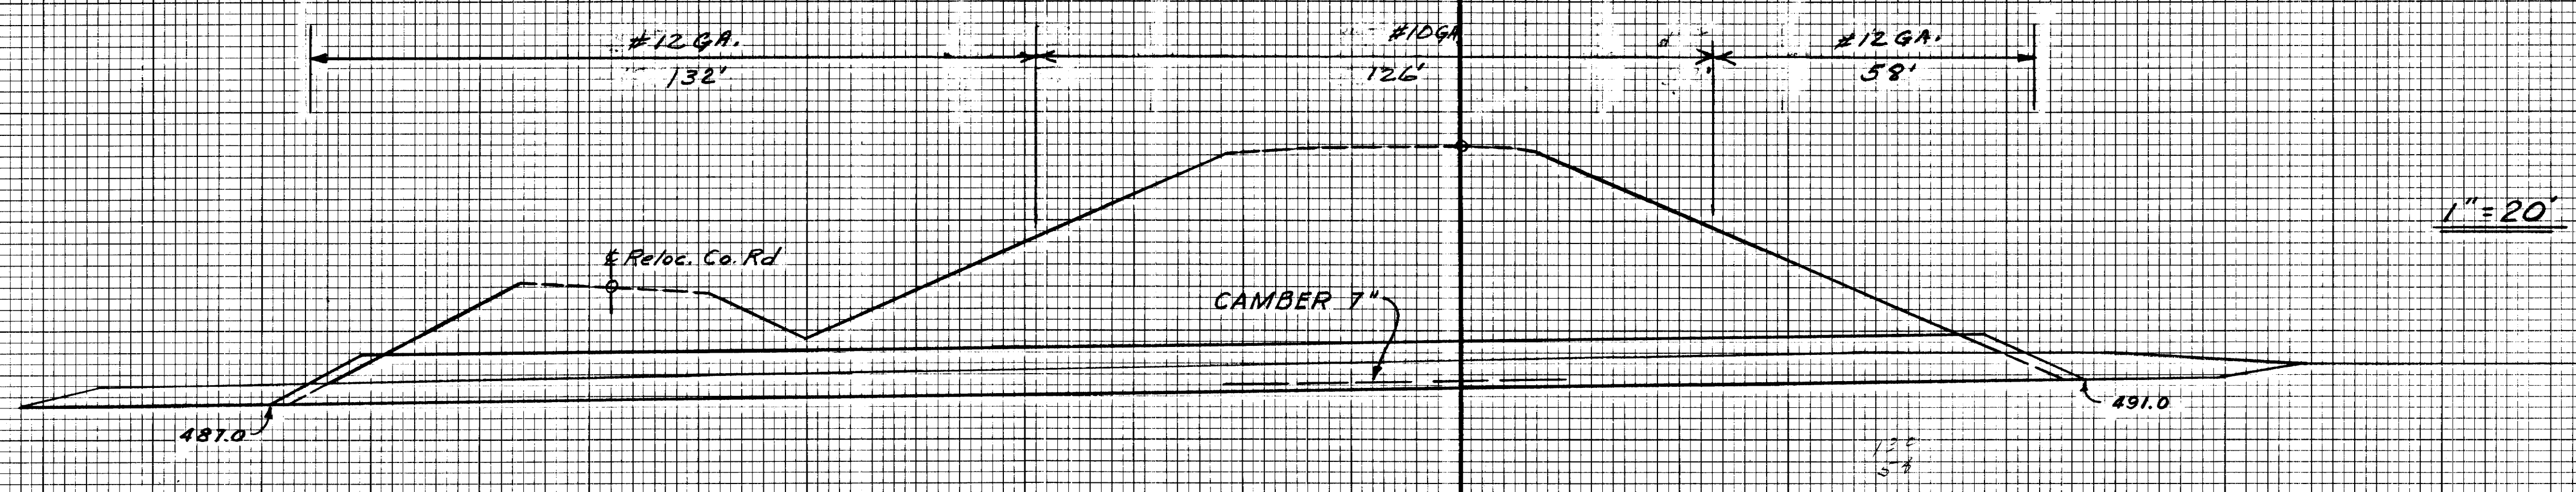

520
397+74 W.B.L.
500

SKREW 60° LT.
D.A. 382 AC.H.
BEVELLED ENDS (70°)
DWG. NO. CM-1-4;5;7

316' OF 102" C.M.S.P. PIPE CULV.
U.S. STD. GA. ~~#7~~, ~~#8~~, ~~#9~~ #10 & #12 STRUTTED
12.4 CU. YDS. RIP-RAP
381 CU. YDS. GRANULAR BACKFILL

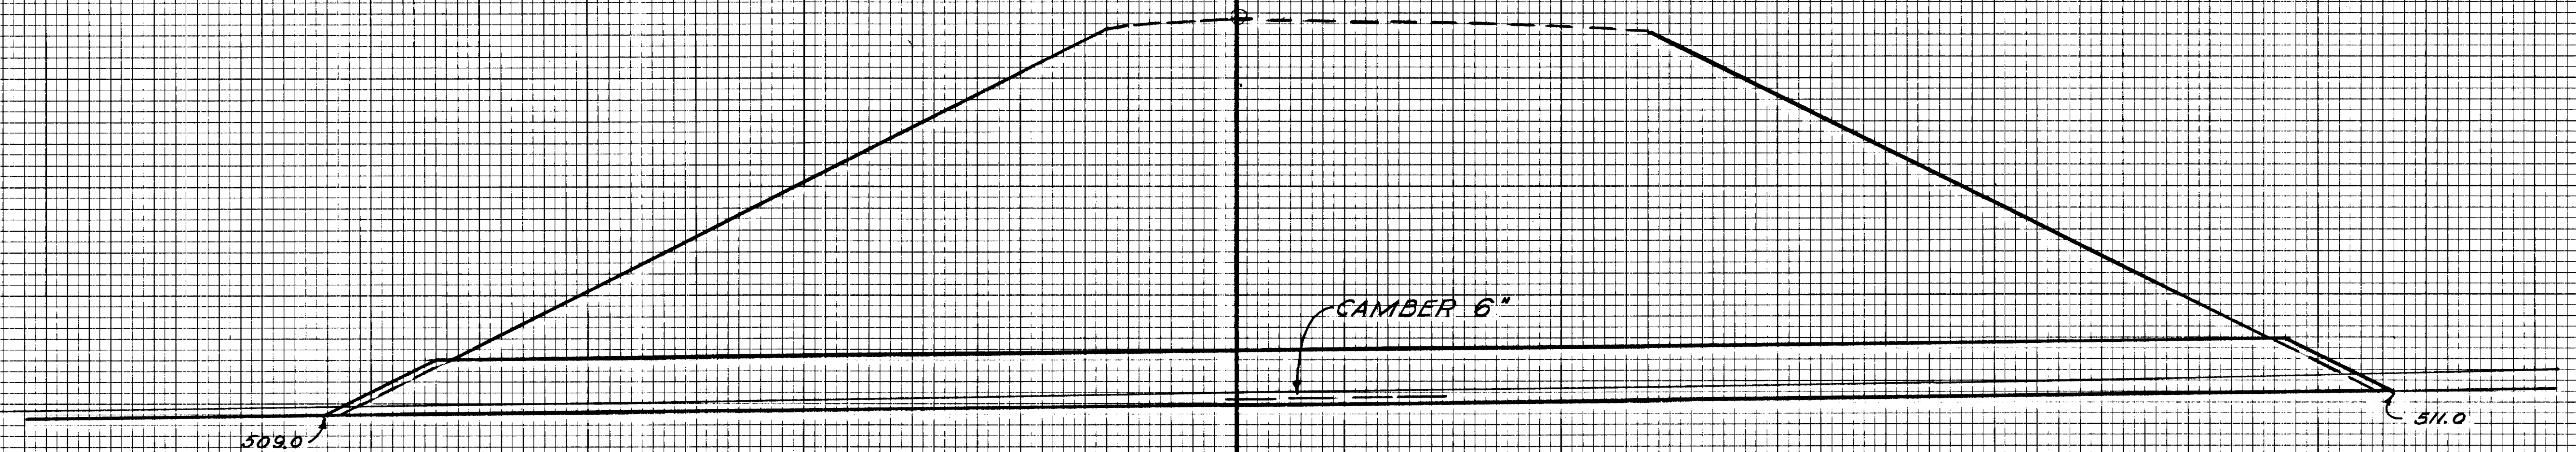


520
389+00 E.B.L.
510

SKREW 90°
D.A. 86 AC.H.
BEVELLED ENDS
DWG. NO. CM-1-4;5;7

182' OF 60" C.G.M. PIPE CULV.
U.S. STD. GA. #10 STRUTTED
7.6 CU. YDS. RIP-RAP
117 CU. YDS. GRANULAR BACKFILL

FINAL SURVEY	SURVEYED _____	BY _____	DATE _____
NOTE BOOK	FIELD NO. _____		
	TEMPLATE _____		
	AREAS _____		
NO. _____	AREAS CHECKED _____		

ORIGINAL SURVEY	SURVEYED _____	BY _____	DATE _____
NOTE BOOK	TEMPLATED <i>RCEPAL</i>		
NO. _____	AREAS _____		
	AREAS CHECKED _____		


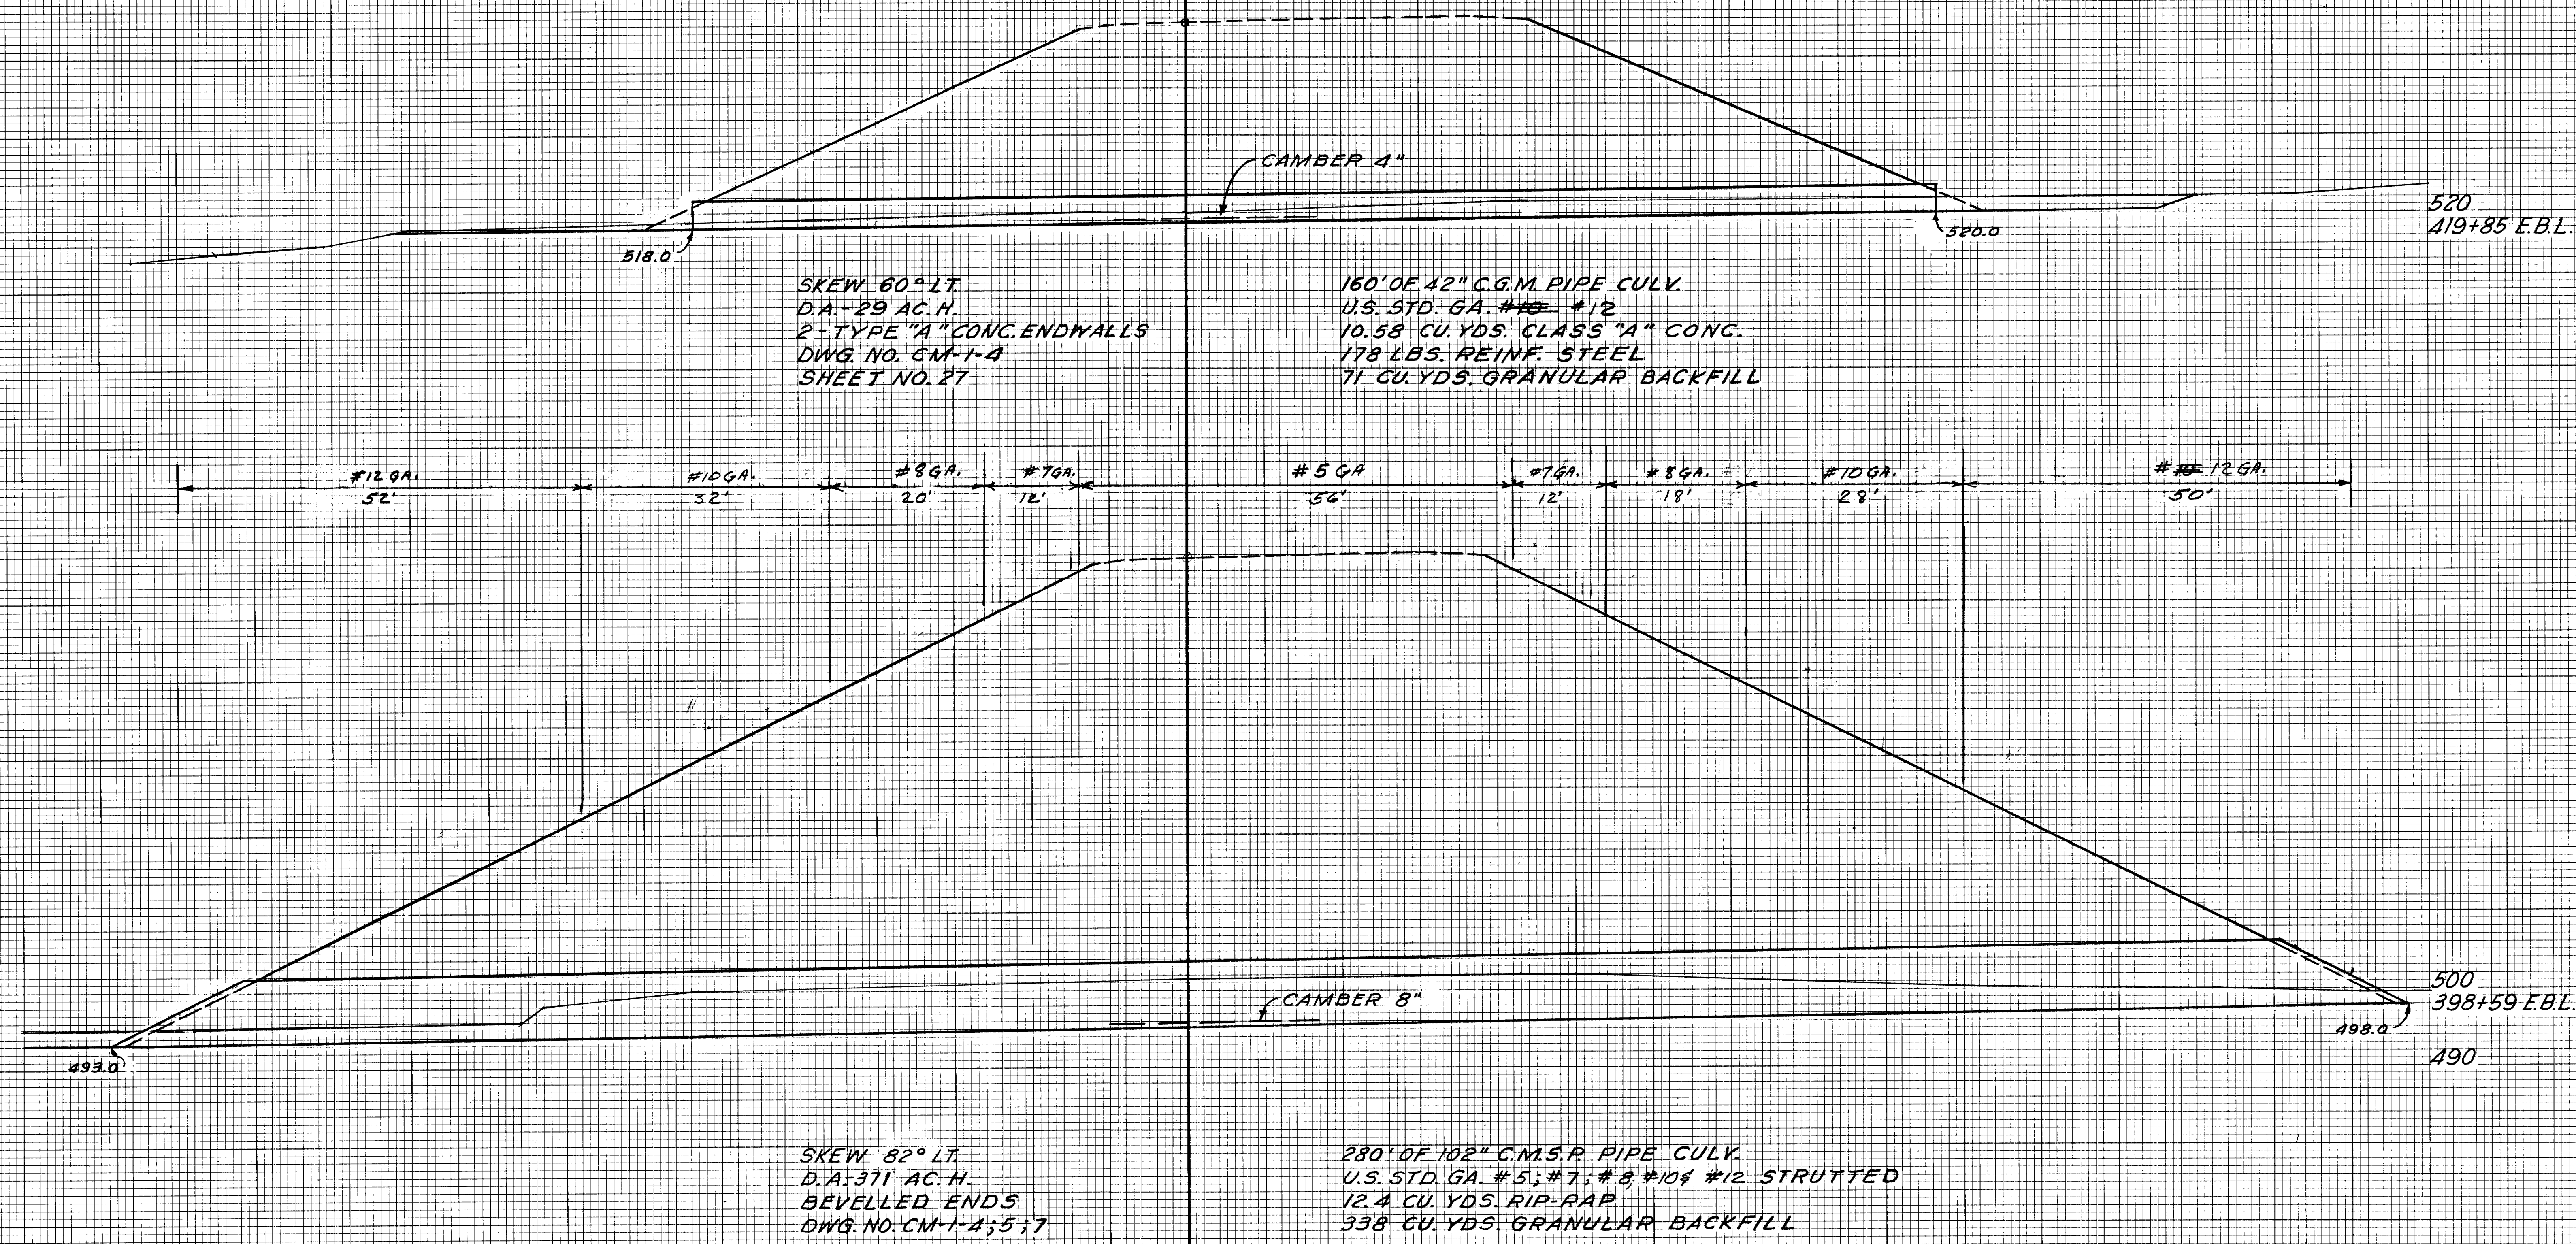


TENN. STATE HIGHWAYS
Plans File **IN**
Divn. No. **60**

DATE
BY
SURVEYED
PLOTTER
TEMPLATE
NOTE BOOK
AREAS CHECKED
NO.

DATE
BY
ORIGINAL
SURVEY
PLOTTER
NOTE BOOK
AREAS CHECKED
NO.

MID-SOUTH ENGINEERING CO.				
FED. ROAD DIST.	T E N N	FEDERAL AID PROJECT No.	FISCAL YEAR	SHEET No.
3		I-40-5(9)264	1960	150
				151
				372

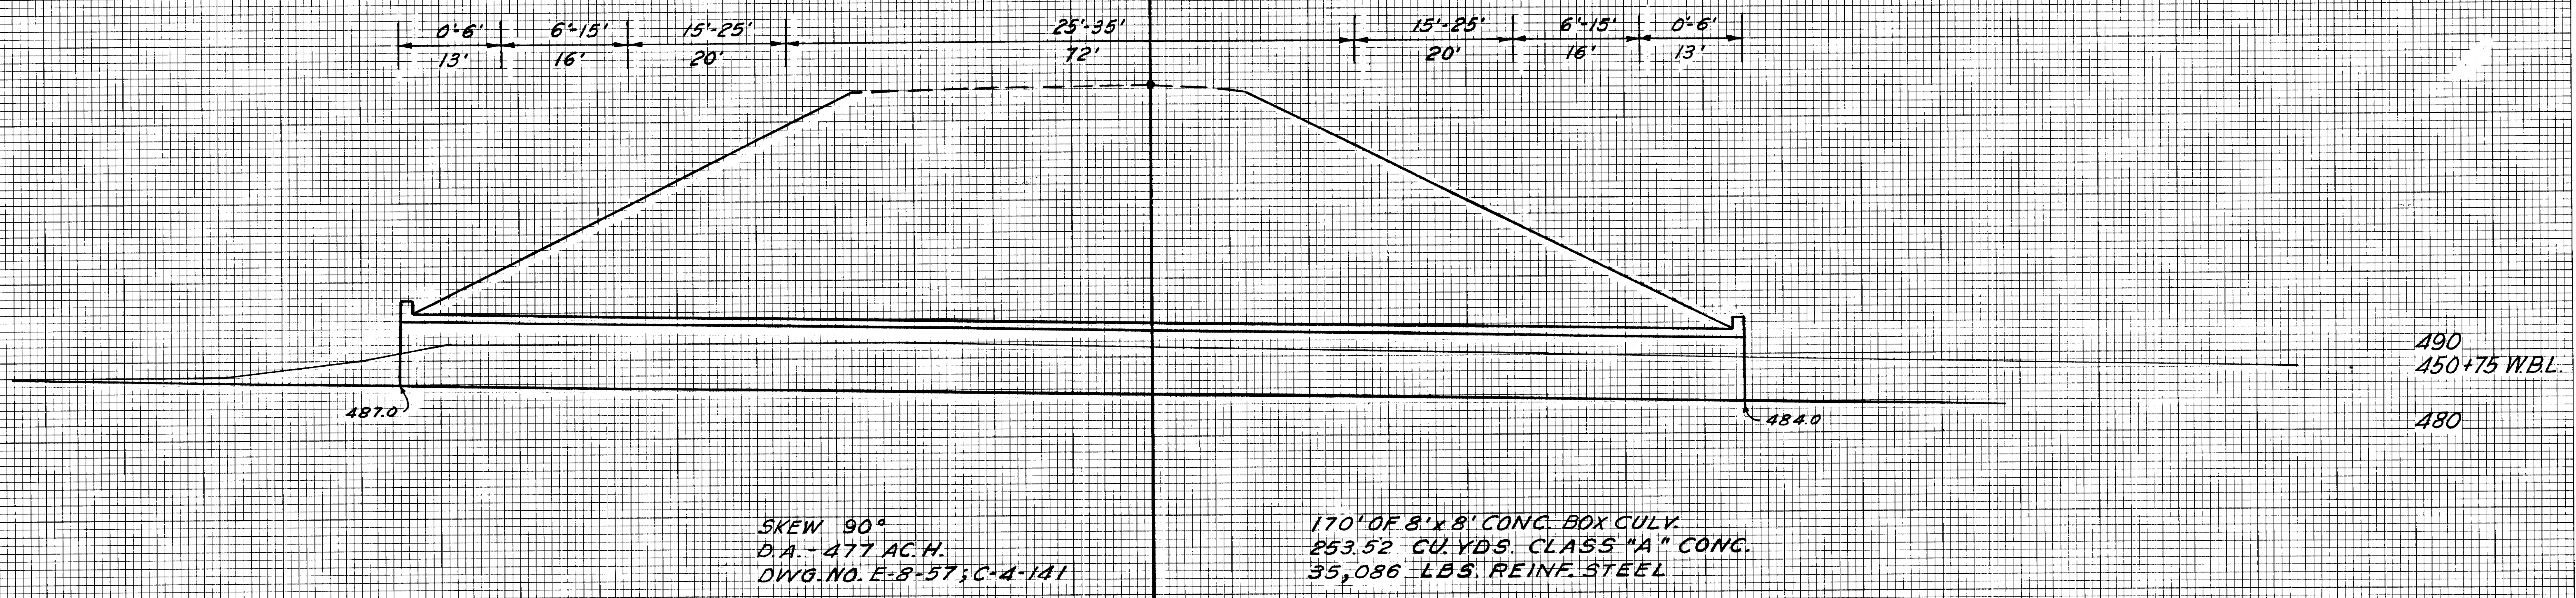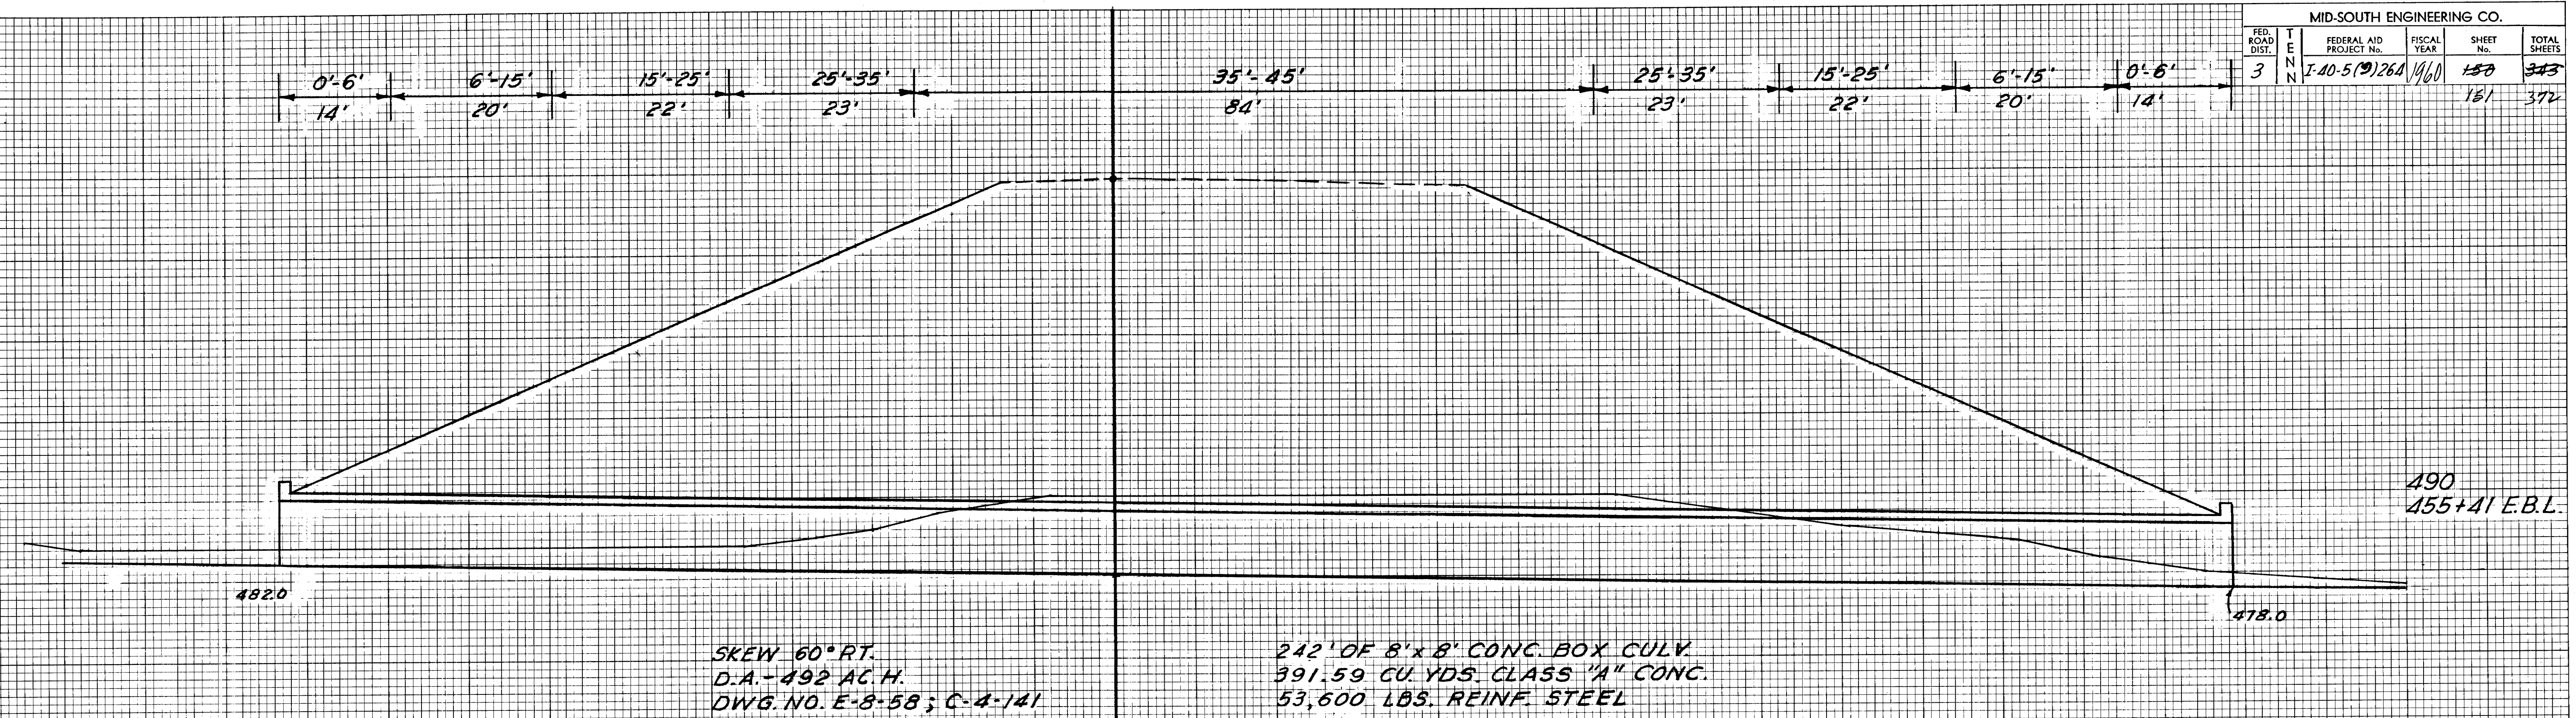

TENN. STATE HIGHWAYS


Plans File **IN**
Divn. No. **50**

FINAL SURVEY	SURVEYED	DATE
NOTE BOOK	PLOTTED	BY
NO.	TEMPLATE	
	AREAS CHECKED	

ORIGINAL SURVEY	SURVEYED	DATE
NOTE BOOK	PLOTTED	BY
NO.	TEMPLATE	
	AREAS CHECKED	

MID-SOUTH ENGINEERING CO.				
FED. ROAD DIST.	TENN.	FEDERAL AID PROJECT No.	FISCAL YEAR	SHEET No.
3	N	I-40-5(7)264	1960	157
				152
				372

FARM ROAD @ 332[±] E.B.L.
FARM ROAD @ 370 to 397 W.B.L.

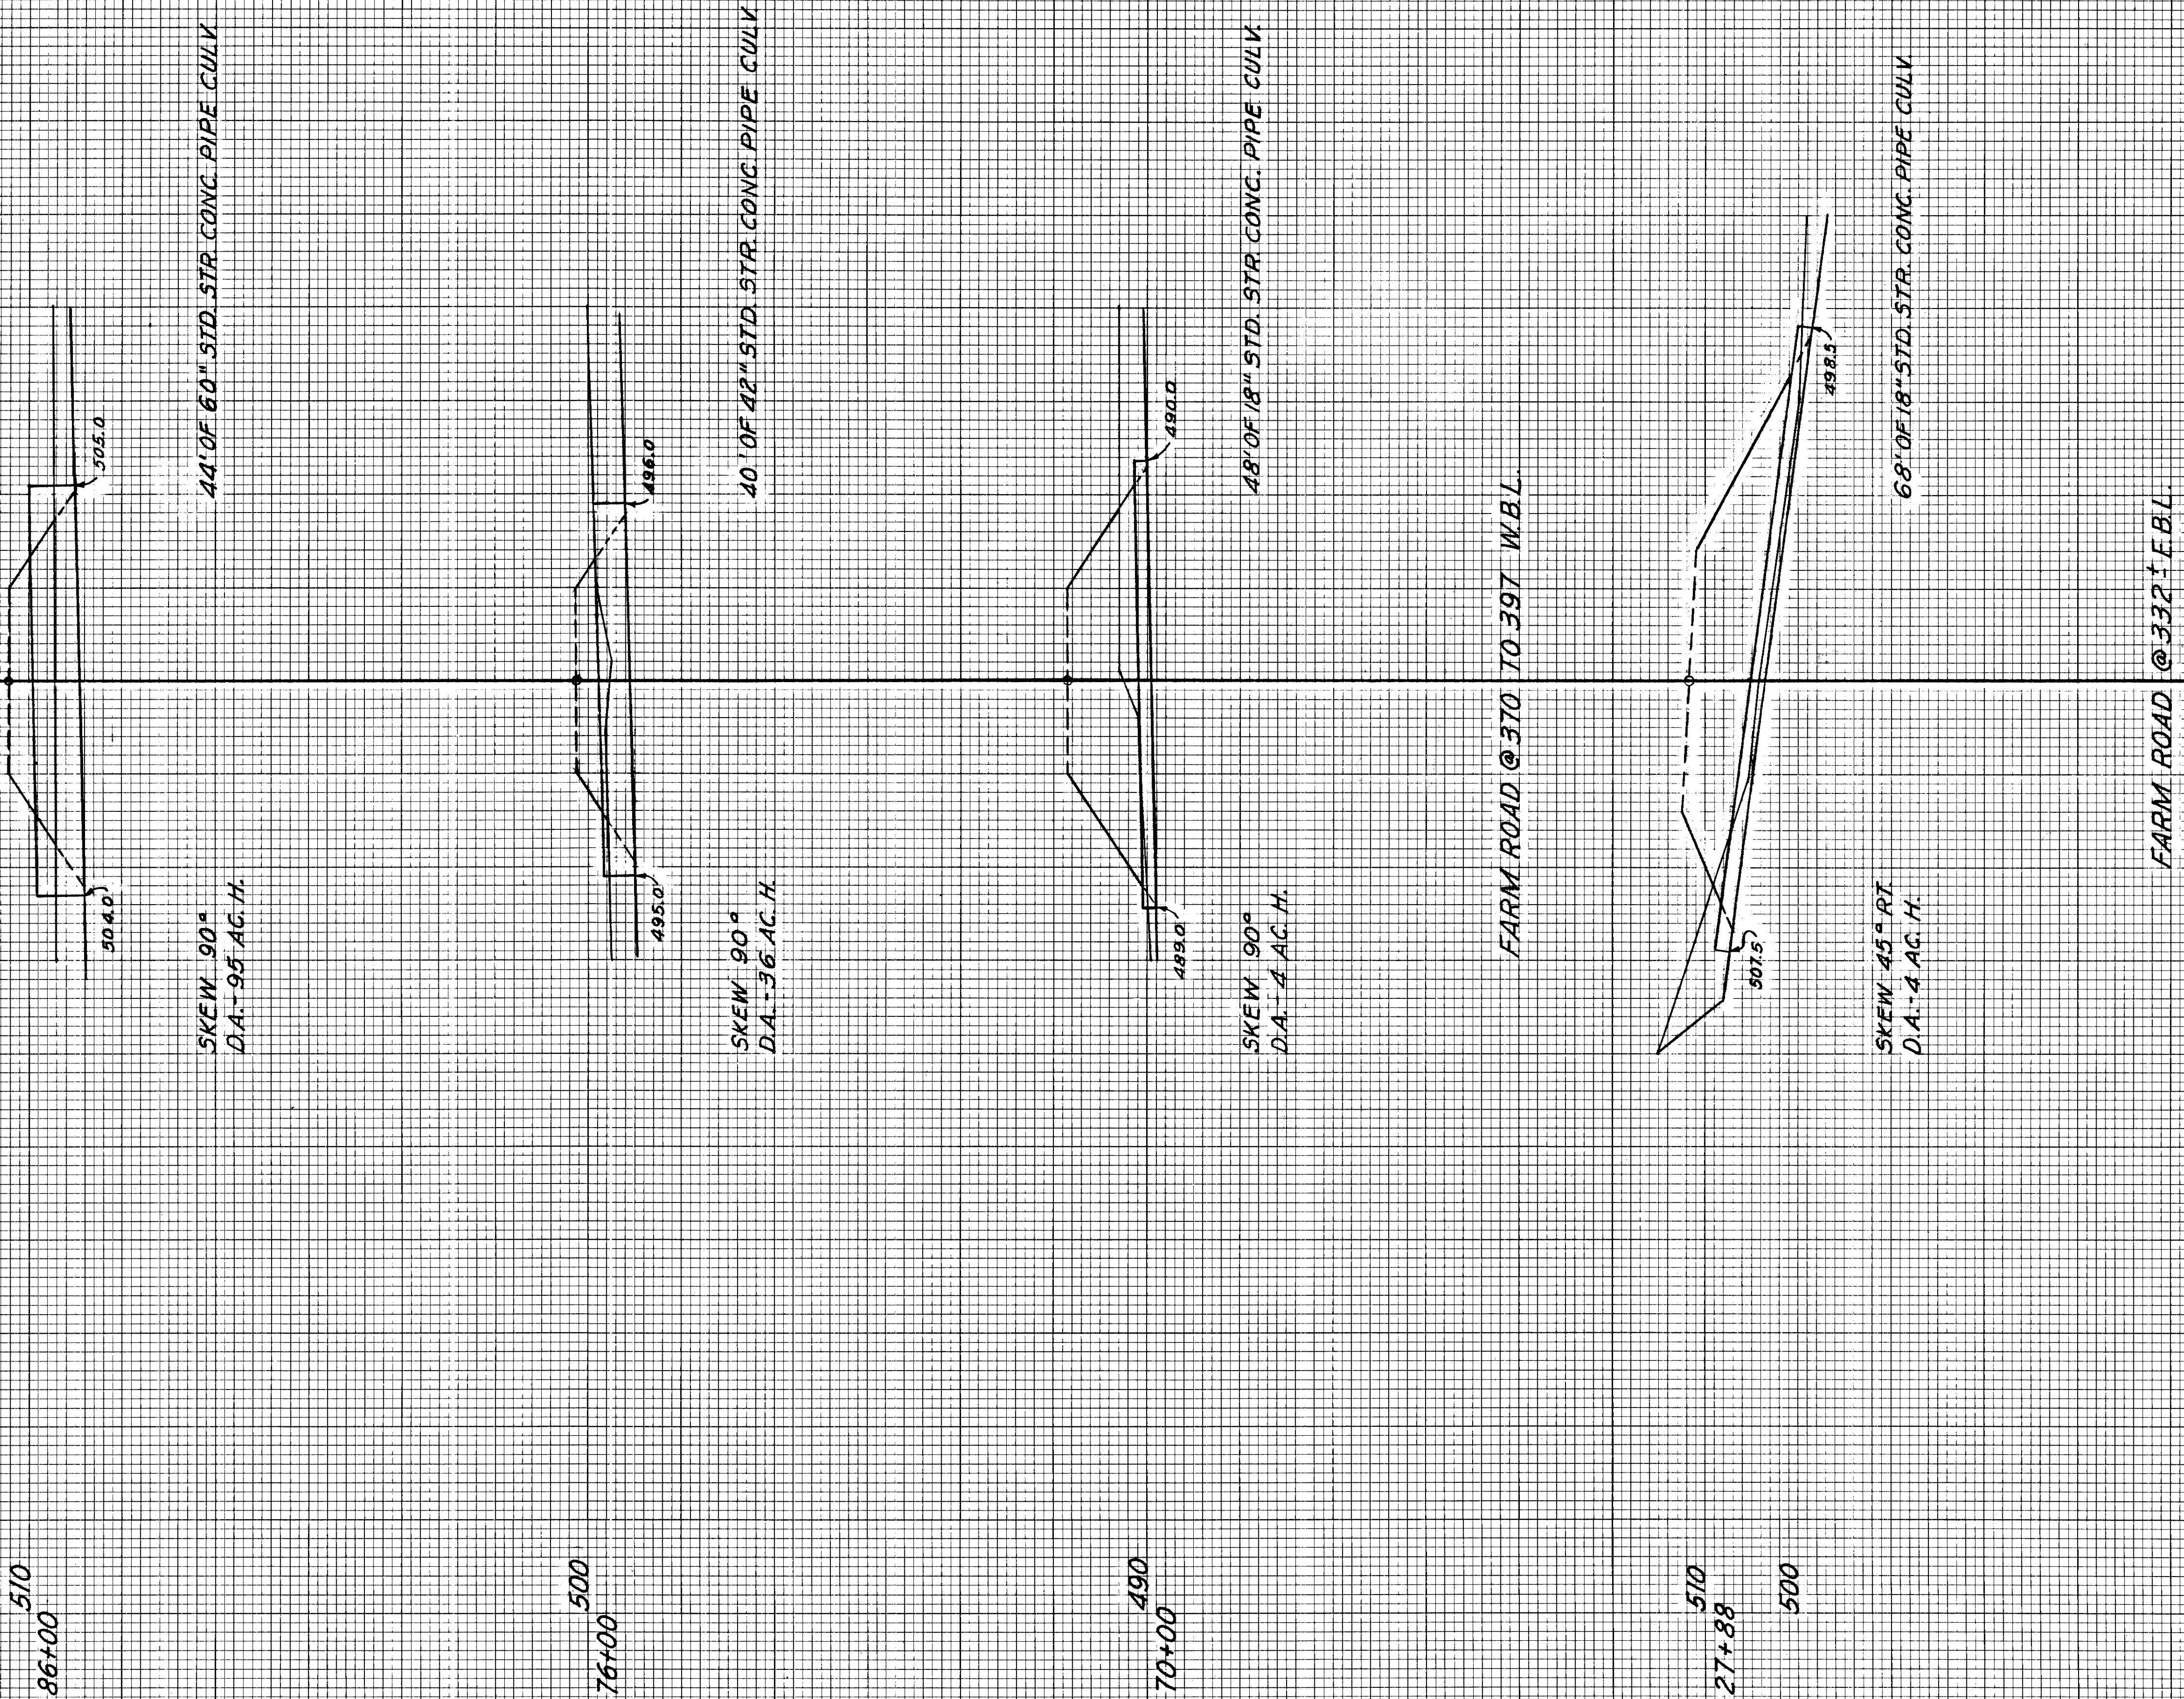

TENN. STATE HIGHWAYS	
Plans	File IN
Divn.	No. 50

FINAL	BY _____	DATE _____
SURVEY		
PLOTTED _____		
NOTE BOOK _____		
NO. _____		
AREAS _____	AREAS CHECKED _____	

ORIGINAL SURVEY	SURVEYED _____	BY _____	DATE _____
NOTE BOOK	PLOTTED _____		
	TEMPLATE _____		
	AREAS _____		
NO. _____	AREAS CHECKED _____		

MID-SOUTH ENGINEERING CO.					
FED. ROAD DIST.	T E N N	FEDERAL AID PROJECT No.	FISCAL YEAR	SHEET No.	TOTAL SHEETS
3		I-40-5(9)264	1960	152 153	343 372

RELOC COUNTY ROAD @
401+85 E.B.L.

