

TENNESSEE VALLEY AUTHORITY - DIVISION OF ENGINEERING DESIGN

CONTRACT REFERENCE OR REQUISITION NO.	ITEM	CLASSIFICATION	DESCRIPTION	QUANTITY	UNITS	MARK NO.
C			48" D PRECAST CONCRETE PIPE, ASTM C76-72a, CLASS V, 4'-0" LONG WITH COMPRESSION TYPE RUBBER GASKETS, ASTM C443-72a	173	PCS	101-19E209-1
C			DUCTILE IRON MANHOLE STEPS, NEENAH R-1982-J, AS MFD BY NEENAH FOUNDRY CO., NEENAH, WISCONSIN, OR EQUAL	46	PCS	-2
C			CAST IRON MANHOLE FRAME & COVER, NEENAH R-1794-V, AS MFD BY NEENAH FOUNDRY CO., NEENAH, WISCONSIN, OR EQUAL	2		-3

NOTE: ALL QUANTITIES ARE NET

MF
RO

CIVIL BILL OF MATERIAL

PROJECT SOUTH CHICKAMAUGA CREEK - LEVEE, CHANNEL & DETENTION BASIN

DWG NO. 101-19E209-1, 2 & 3

TVA 10573A (DED-11-75)

0		3-30-78	JLM	HAM	HAM	JWW			TJA	GLB	KNOXVILLE, TENN	DATE 3-30-78
REV NO.	ECN NO.	DATE	MADE	CHKD	SUPV	ENGR	INSP	SUBM	RECM	APPD	SH 1 OF 1	81 C 101-19BM209 RO

TENNESSEE VALLEY AUTHORITY - DIVISION OF ENGINEERING DESIGN

CONTRACT REFERENCE OR REQUISITION NO.	ITEM	CLASSIFICATION	DESCRIPTION	QUANTITY	UNITS	MARK NO.
C			CAST IRON GRATING, NEENAH R-4890, AS MFD BY NEENAH FOUNDRY CO., NEENAH, WISCONSIN, OR EQUAL	1		101-19E212-1
C			*36" D PRECAST CONCRETE PIPE, ASTM C76-72a CLASS III, 4'-0" LONG WITH COMPRESSION TYPE RUBBER GASKETS, ASTM C443-72a	85 PCS		-2
C			*24" D PRECAST CONCRETE PIPE, ASTM C76-72a CLASS III, 4'-0" LONG WITH COMPRESSION TYPE RUBBER GASKETS, ASTM C443-72a	30 PCS		-3
C			CAST IRON GRATING, NEENAH R-4891-A, AS MFD BY NEENAH FOUNDRY CO., NEENAH, WISCONSIN, OR EQUAL	2		-4
C			DUCTILE IRON MANHOLE STEPS, NEENAH R-1982-J, AS MFD BY NEENAH FOUNDRY CO., NEENAH, WISCONSIN, OR EQUAL	24 PCS		-5

* IF STEEL PIPE IS USED FOR TUNNELING UNDER EXISTING ROADS, QUANTITIES OF CONCRETE PIPE REQUIRED WILL BE REDUCED.

NOTE : ALL QUANTITIES ARE NET

MR
RO
RI

TVA 10573A (DED-11-75)

										CIVIL BILL OF MATERIAL	
										PROJECT SOUTH CHICKAMAUGA CREEK-LEYEE CHANNEL & DETENTION BASIN	
1		7-25-78	JLM	JWR	JWN	ELS					DWG NO. 101-19E212-1 & 2
0		7-18-78	JLM	HAM	HAM	JWAF	ELS				KNOXVILLE, TENN DATE 7-18-78
REV NO.	ECN NO.	DATE	MADE	CHKD	SUPV	ENGR	INSP	SUBM	RECM	APPD	SH 1 OF 1 81 C 101-19BM212R1

TENNESSEE VALLEY AUTHORITY - DIVISION OF ENGINEERING DESIGN

CONTRACT REFERENCE OR REQUISITION NO.	ITEM	CLASSIFICATION	DESCRIPTION	QUANTITY	UNITS	MARK NO.
C			STEEL FRAME AND COVER, HOT DIP GALVANIZED, TYPE Q-3, AS MFD BY THE BILCO CO., NEW HAVEN, CONN, OR EQUAL	2		101-19E220 -1
C			TS 3"x 3"x .2500 STRUCTURAL TUBING : SQUARE, 6" LONG	32 PCS		

WF
RD

VVA 10573A (EN DES-2-77)

CIVIL BILL OF MATERIAL
 PROJECT SOUTH CHICKAMAUGA
 CREEK-LEVEE, CHANNEL &
 DETENTION BASIN,
 MONITORING STA NO. 1 & 2
 DWG NO. 101-19E220

0		12-27-78	JLM	HAM	HAM	JWW HAM						KNOXVILLE, TENN	DATE 12-27-78
REV NO.	ECN NO.	DATE	MADE	CHKD	SUPV	ENGR	INSP	SUBM	RECM	APPD		SH 1 OF 1	81 C 101-19BM220 RO

TENNESSEE VALLEY AUTHORITY - DIVISION OF ENGINEERING DESIGN

CONTRACT REFERENCE OR REQUISITION NO.	ITEM	CLASSIFICATION	DESCRIPTION	QUANTITY	UNITS	MARK NO.
C			TYPE I PVC SEALS	179	LF	
C			TYPE II PVC SEALS	350	LF	
C			4" D STD WT BLACK STEEL, 22" LONG	14 PCS		101-19E225 - 4

NOTE: ALL QUANTITIES ARE NET.

MF
20

CIVIL BILL OF MATERIAL

PROJECT SOUTH CHICKAMAUGA
CREEK-PUMPING STATION NO. 1

DWG NO. 101-19E225-1 THRU 4

TVA 10573A (DED-11-75)

0		6-24-77	E.P.C.	JLM	HAM	JWW						KNOXVILLE, TENN	DATE	6-24-77
REV NO.	ECN NO.	DATE	MADE	CHKD	SUPV	ENGR	INSP	SUBM	RECM	APPD	SH 1 OF 1	C	101-19BM225 R	

TENNESSEE VALLEY AUTHORITY - DIVISION OF ENGINEERING DESIGN

CONTRACT REFERENCE OR REQUISITION NO.	ITEM	CLASSIFICATION	DESCRIPTION	QUANTITY	UNITS	MARK NO.							
C			CAST IRON GRATING, NEENAH R-4825, AS MFD BY NEENAH FOUNDRY CO., NEENAH, WISCONSIN, OR EQUAL	1		101-19E230 -1							
C			15" D PRECAST CONCRETE PIPE, ASTM C76-72a, CLASS V, 4'-0" LONG WITH COMPRESSION TYPE RUBBER GASKETS, ASTM C443-72a	7 PCS		-2							
NOTE: ALL QUANTITIES ARE NET													
				CIVIL BILL OF MATERIAL									
				PROJECT SOUTH CHICKAMAUGA CREEK-PUMPING STATION NO. 1 FINAL GRADING									
				DWG NO. 101-19E230-1 & 2									
0		3-31-78	JLM HAM HAM JWP ELS			KNOXVILLE, TENN DATE 3-31-78							
REV NO.	ECN NO.	DATE	MADE	CHKD	SUPV	ENGR	INSP	SUBM	RECM	APPD	SH / OF /	81 C	101-19BM230 RD

TVA 10573A (DED-11-75)

TENNESSEE VALLEY AUTHORITY - DIVISION OF ENGINEERING DESIGN

CONTRACT REFERENCE OR REQUISITION NO.	ITEM	CLASSIFICATION	DESCRIPTION	QUANTITY	UNITS	MARK NO.													
C			Cast iron manhole steps, Neenah R-1982-J, as mfd by Neenah Foundry Co., Neenah, Wisconsin, or equal	17 pcs		101-19E-235 -1													
C			4" D std wt black steel pipe, 9" long	6 pcs		-2													
C			54" D precast concrete pipe, ASTM C 76-72 a, Class III, 4'-0" long with compression type rubber gaskets, ASTM C 443-72 a	6 pcs		-3													
C			54" D precast concrete pipe adapter section 21" long (see 101-19E 235-5, detail G5). Strength to conform to ASTM C 76-72 a, Class III	1		-4													
C			Type II PVC seals	1200	lf														
Note: All quantities are net																			
<div style="border: 1px solid black; padding: 5px; width: fit-content; margin: auto;"> <p><u>CIVIL</u> BILL OF MATERIAL</p> <p>PROJECT <u>SOUTH CHICKAMAUGA</u></p> <p><u>CREEK-PUMPING STATION NO. 2</u></p> <p>-----</p> <p>DWG NO. <u>101-19E 235-1 THRU 5</u></p> <p>KNOXVILLE, TENN DATE <u>6-1-77</u></p> </div>																			
0		6-1-77	V.F.V.	RBR	HAM	JNW	ELS												
REV NO.	ECN NO.	DATE	MADE	CHKD	SUPV	ENGR	INSP	SUBM	RECM	APPD	SH	OF	81	C	101-19BM235	RO			

MF
RO

TVA 10573A (DED-11-75)

TENNESSEE VALLEY AUTHORITY - DIVISION OF ENGINEERING DESIGN

CONTRACT REFERENCE OR REQUISITION NO.	ITEM	CLASSIFICATION	DESCRIPTION	QUANTITY	UNITS	MARK NO.
C			Cast iron manhole steps, Neenah R-1982-J, as mfd by Neenah Foundry Co., Neenah, Wisconsin, or equal	17 pcs		101-19E 240-1
C			4" D std wt black steel pipe, 9" long	4 pcs		-2
C			36" D precast concrete pipe, ASTM C76-72a, Class III, 4'-0" long with compression type rubber gaskets, ASTM C 443-72 a	12 pcs		-3
C			36" D precast concrete pipe adapter section 21" long (see 101-19E 240-4, detail G4). Strength to conform to ASTM C76-72 a, Class III	1		-4
C			Type II PVC seals	900	lf	

Note: All quantities are net

MF
RO


CIVIL BILL OF MATERIAL

PROJECT SOUTH CHICKAMAUGA CREEK-PUMPING STATION NO. 3


DWG NO. 101-19E 240-1 THRU 4

TVA 10573A (DED-11-75)





0	6-1-77	V.F.V.	RBR	HAM	JWW	ELS					KNOXVILLE, TENN	DATE 6-1-77
REV NO.	ECN NO.	DATE	MADE	CHKD	SUPV	ENGR	INSP	SUBM	RECM	APPD	SH 1 OF 1	81 C 101-19BM240 RO

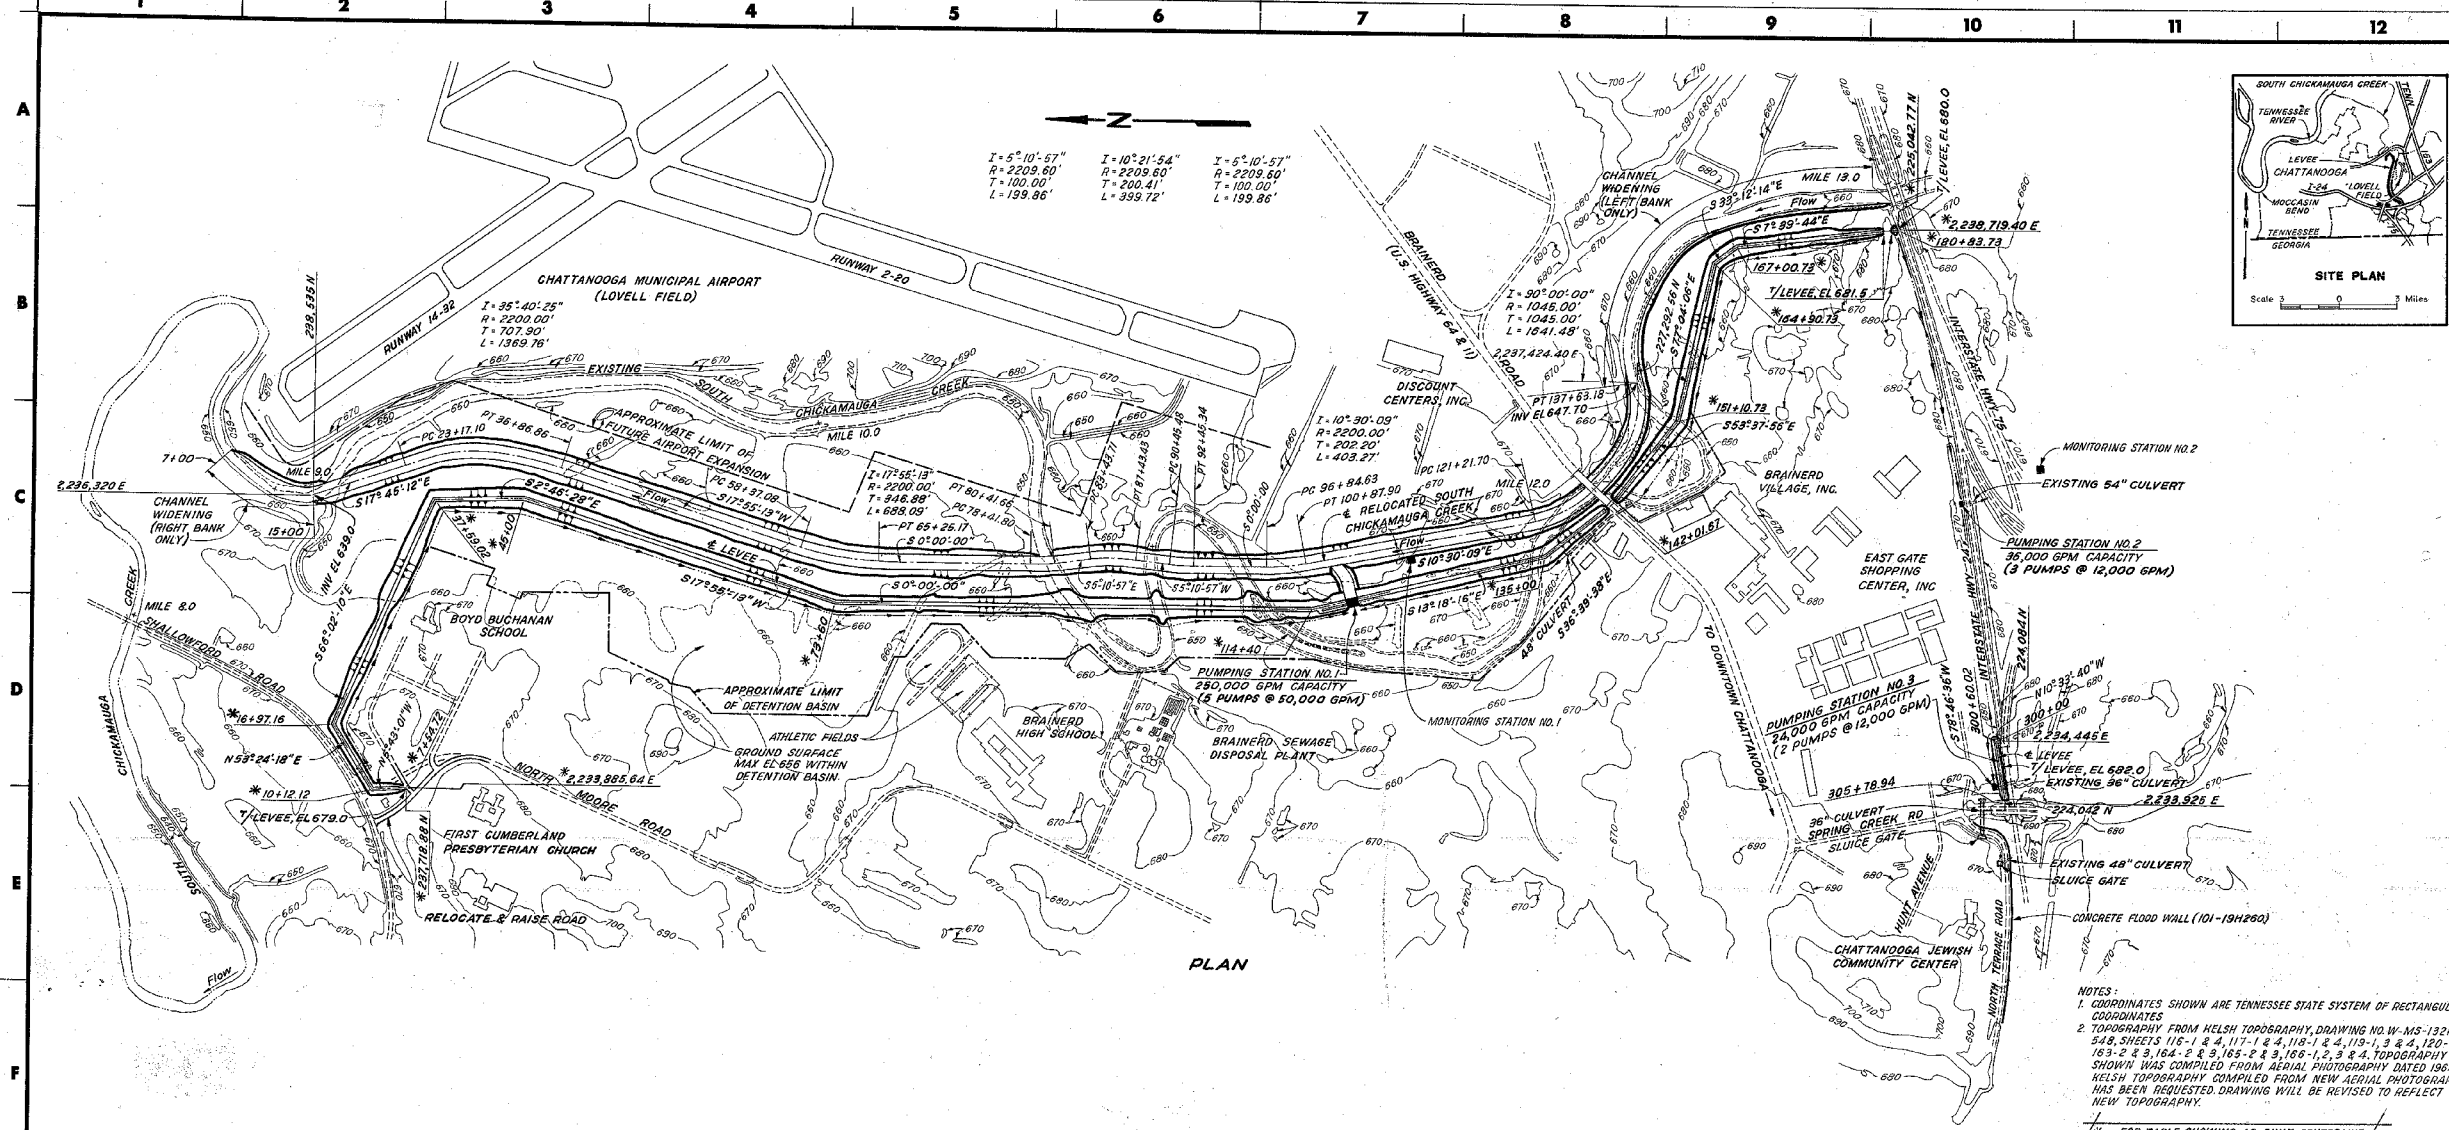

$I = 5^{\circ}10'57''$ $I = 10^{\circ}21'54''$ $I = 5^{\circ}10'57''$
 $R = 2209.80'$ $R = 2209.80'$ $R = 2209.80'$
 $T = 100.00'$ $T = 200.41'$ $T = 100.00'$
 $L = 199.86'$ $L = 399.72'$ $L = 199.86'$

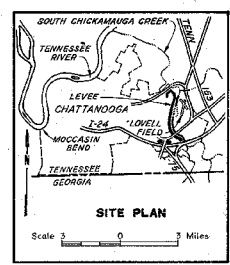





NOTES:
 1. COORDINATES SHOWN ARE TENNESSEE STATE SYSTEM OF RECTANGULAR COORDINATES
 2. TOPOGRAPHY FROM HELSH TOPOGRAPHY, DRAWING NO. W-MS-1324-548, SHEETS 116-1 & 4, 117-1 & 4, 118-1 & 4, 119-1, 3 & 4, 120-1, 123-2 & 3, 124-1 & 3, 125-1 & 3, 126-1, 2 & 4. TOPOGRAPHY SHOWN WAS COMPILED FROM AERIAL PHOTOGRAPHY DATED 1964. HELSH TOPOGRAPHY COMPILED FROM NEW AERIAL PHOTOGRAPHY HAS BEEN REQUESTED DRAWING WILL BE REVISED TO REFLECT NEW TOPOGRAPHY.
 3. % = FOR TABLE SHOWING AS-BUILT CENTERLINE OF LEVEE SEE 101-19E205-1

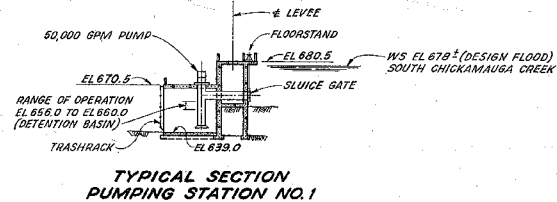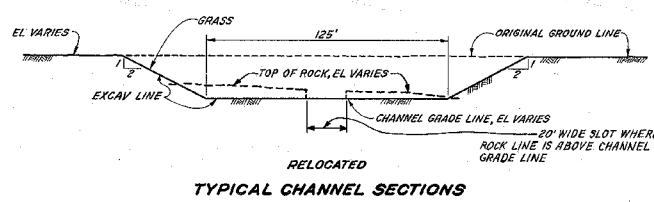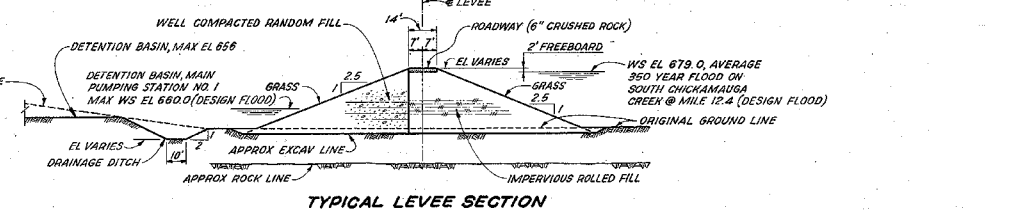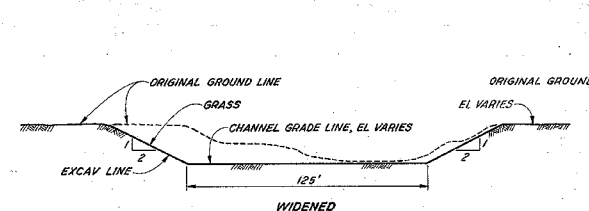

7	FINAL FIELD REV	1-3-83	JAM	PM	10/15/83
6	REVISED ALIGNMENT & STATIONS OF LEVEE AT RELOCATED NORTH MOORE ROAD, D2	11-6-79	JAM	PM	10/15/83
5	REVISED ALIGNMENT & STATIONS OF LEVEE AT RELOCATED NORTH MOORE ROAD, D2; REMOVED LEVEE AT HUNT AVENUE; RELOCATED 36" D CULVERT & SLUICE GATE; REMOVED 48" D CULVERT & RELOCATED SLUICE GATE; ADDED CONCRETE FLOODWALL ALONG SOUTH SIDE OF NORTH TERRACE ROAD, END; REVISED CHANNEL WIDENING, C1	5-5-78	JAM	PM	10/15/83
4	REVISED ALIGNMENT & STATIONS OF RELOCATED SOUTH CHICKAMAUGA CREEK	11-23-77	JAM	PM	10/15/83
3	REVISED ALIGNMENT & STATIONS OF LEVEES; REMOVED HOLD, C12	11-26-76	JAM	PM	10/15/83
2	DELETED NOTE 3; ADDED HOLD, C12; MONITORING STATIONS B, C, D, E, F, G, H, I, J, K, L, M, N, O, P, Q, R, S, T, U, V, W, X, Y, Z; REMOVED 36" D CULVERT, C2; LEVEE, B9; LONG FLOODWALLS, C3; TYPICAL LONG FLOODWALL, H1; CHANGED ALIGNMENT & STATIONING OF LEVEES 1; REVISED TYP SECTION PUMPING STATION NO. 1, & TYP LEVEE SECTION; RELOCATED PUMPING STATION NO. 1; CHANGED TO "E" SIZE DWG	11-23-77	JAM	PM	10/15/83
1	REMOVED RDWAY & BRIDGE TO PUMPING STA NO. 1, REV TYP CHANNEL SECTION, MINOR REV	11-23-77	JAM	PM	10/15/83

CHATTANOOGA FLOOD PROTECTION ALL FEATURES		
GENERAL PLANS & SECTIONS		
SOUTH CHICKAMAUGA CREEK PROJECT TENNESSEE VALLEY AUTHORITY DIVISION OF ENGINEERING DESIGN		
SUBMITTED	RECOMMENDED	APPROVED
<i>[Signature]</i>	<i>[Signature]</i>	<i>[Signature]</i>
INSPECTED AND APPROVED FOR ISSUE		
KNOXVILLE	2-17-76	BT C 101-19E200 R7

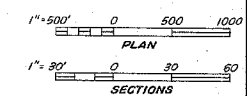

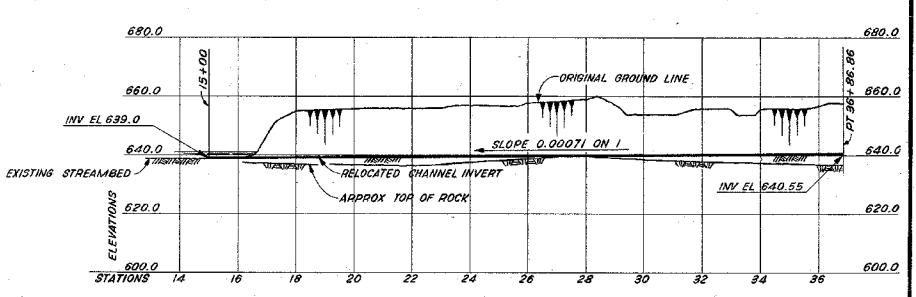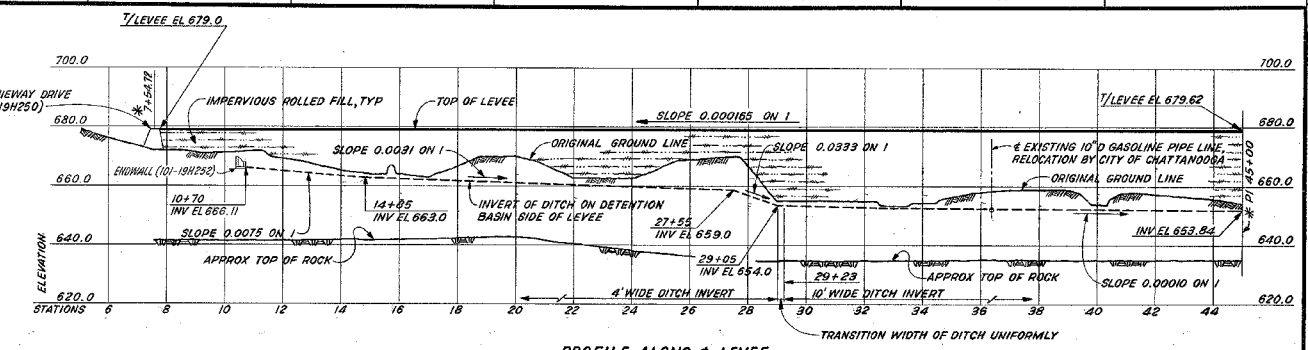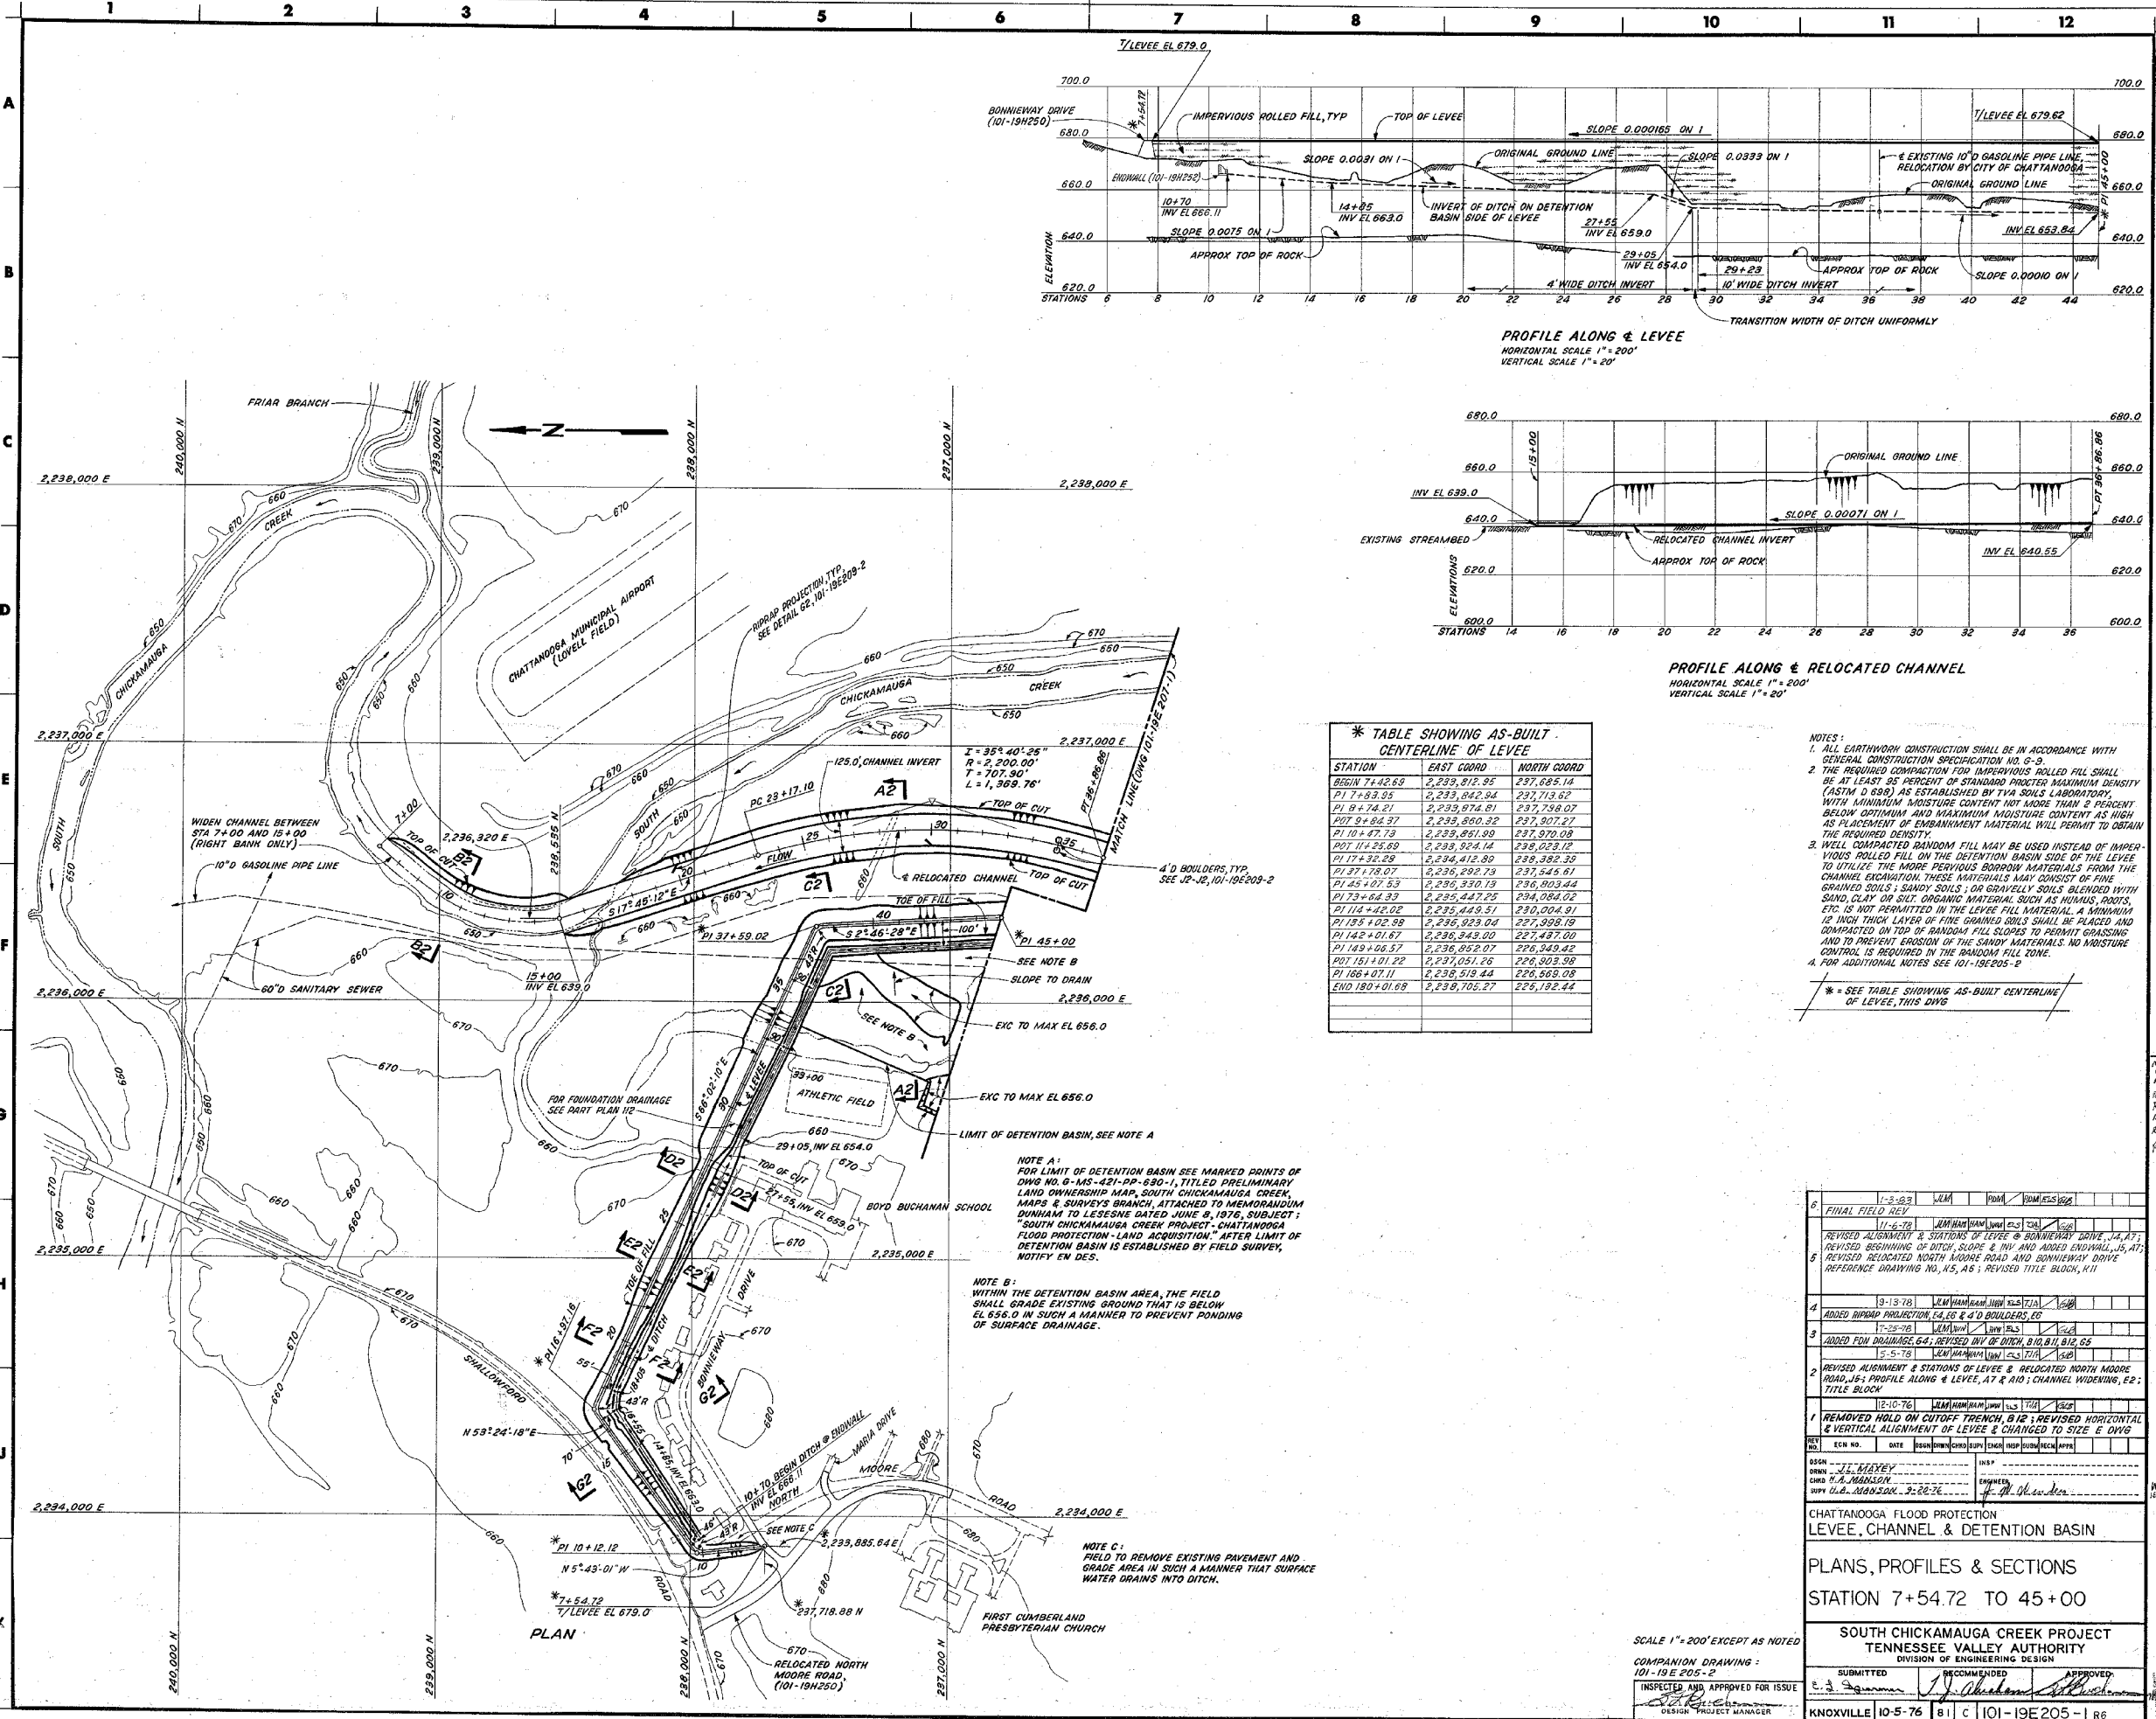

*** TABLE SHOWING AS-BUILT CENTERLINE OF LEVEE**

STATION	EAST COORD	NORTH COORD
BEGIN 7+42.68	2,233,812.95	237,685.14
PI 7+53.25	2,233,842.84	237,713.62
PI 9+74.21	2,233,874.81	237,738.07
POT 9+84.37	2,233,880.32	237,907.27
PI 10+47.73	2,233,861.09	237,970.08
POT 11+25.89	2,233,924.14	238,023.12
PI 17+32.29	2,234,412.89	238,382.39
PI 27+78.07	2,236,292.79	237,545.67
PI 45+01.53	2,236,330.19	236,903.44
PI 73+64.32	2,235,447.25	234,084.02
PI 114+42.02	2,235,449.51	230,004.91
PI 135+02.98	2,236,923.04	227,998.19
PI 142+01.67	2,236,343.00	227,487.00
PI 143+06.57	2,236,852.07	226,349.42
POT 151+01.22	2,237,051.25	226,303.98
PI 168+07.11	2,236,519.44	226,569.08
END 180+01.08	2,238,705.27	229,192.44

NOTES:

- ALL EARTHWORK CONSTRUCTION SHALL BE IN ACCORDANCE WITH GENERAL CONSTRUCTION SPECIFICATION NO. 6-9.
- THE REQUIRED COMPACTION FOR IMPERVIOUS ROLLED FILL SHALL BE AT LEAST 95 PERCENT OF STANDARD PROCTOR MAXIMUM DENSITY (ASTM D 698) AS ESTABLISHED BY TVA SOILS LABORATORY WITH MINIMUM MOISTURE CONTENT NOT MORE THAN 2 PERCENT BELOW OPTIMUM AND MAXIMUM MOISTURE CONTENT AS HIGH AS PLACEMENT OF EMBANKMENT MATERIAL WILL PERMIT TO OBTAIN THE REQUIRED DENSITY.
- WELL COMPACTED RANDOM FILL MAY BE USED INSTEAD OF IMPERVIOUS ROLLED FILL ON THE DETENTION BASIN SIDE OF THE LEVEE TO UTILIZE THE MORE PREVIOUS BORROW MATERIALS FROM THE CHANNEL EXCAVATION. THESE MATERIALS MAY CONSIST OF FINE GRAINED SOILS & SANDY SOILS; OR GRAVELLY SOILS BLENDED WITH SAND, CLAY OR SILT ORGANIC MATERIAL SUCH AS HUMUS, ROOTS, ETC. IS NOT PERMITTED IN THE LEVEE FILL MATERIAL. A MINIMUM 12 INCH THICK LAYER OF FINE GRAINED SOILS SHALL BE PLACED AND COMPACTED ON TOP OF RANDOM FILL SLOPES TO PERMIT GRASSING AND TO PREVENT EROSION OF THE SANDY MATERIALS. NO MOISTURE CONTROL IS REQUIRED IN THE RANDOM FILL ZONE.
- FOR ADDITIONAL NOTES SEE 101-19E205-2

* SEE TABLE SHOWING AS-BUILT CENTERLINE OF LEVEE, THIS DWG

NO.	DATE	BY	CHKD	APPV	DESCRIPTION
6	1-3-83	WAM	WAM	WAM	FINAL FIELD REV
5	11-2-78	WAM	WAM	WAM	REVISED ALIGNMENT & STATIONS OF LEVEE & DETENTION BASIN; REVISED BEGINNING OF DITCH, SLOPE & INV AND ADDED ENVIRONMENTAL; REVISED RELOCATED NORTH MOORE ROAD AND BONNIWAY DRIVE REFERENCE DRAWING NO. 101-19E205-2; REVISED TITLE BLOCK, K11
4	9-13-78	WAM	WAM	WAM	ADDED RIPRAP PROJECTION, E4, E6 & 4' D BOULDERS, E8
3	7-28-78	WAM	WAM	WAM	ADDED FILL DRAINAGE, E4; REVISED INV OF DITCH, B10, B11, B12, E5
2	11-5-78	WAM	WAM	WAM	REVISED ALIGNMENT & STATIONS OF LEVEE & RELOCATED NORTH MOORE ROAD, J5; PROFILE ALONG & LEVEE, AT & 410; CHANNEL WORKING, E2; TITLE BLOCK
1	12-10-76	WAM	WAM	WAM	REMOVED HOLD ON CUTOFF TRENCH, B12; REVISED HORIZONTAL & VERTICAL ALIGNMENT OF LEVEE & CHANGED TO SIZE E DWG

CHATTANOOGA FLOOD PROTECTION
 LEVEE, CHANNEL & DETENTION BASIN


PLANS, PROFILES & SECTIONS
 STATION 7+54.72 TO 45+00

SOUTH CHICKAMAUGA CREEK PROJECT
 TENNESSEE VALLEY AUTHORITY
 DIVISION OF ENGINEERING DESIGN

SUBMITTED: [Signature] APPROVED: [Signature]
 INSPECTED AND APPROVED FOR ISSUE: [Signature]
 DESIGN PROJECT MANAGER

KNOXVILLE 10-5-76 | 81 C | 101-19E205-1 R6

SCALE 1" = 200' EXCEPT AS NOTED
 COMPANION DRAWING:
 101-19E205-2

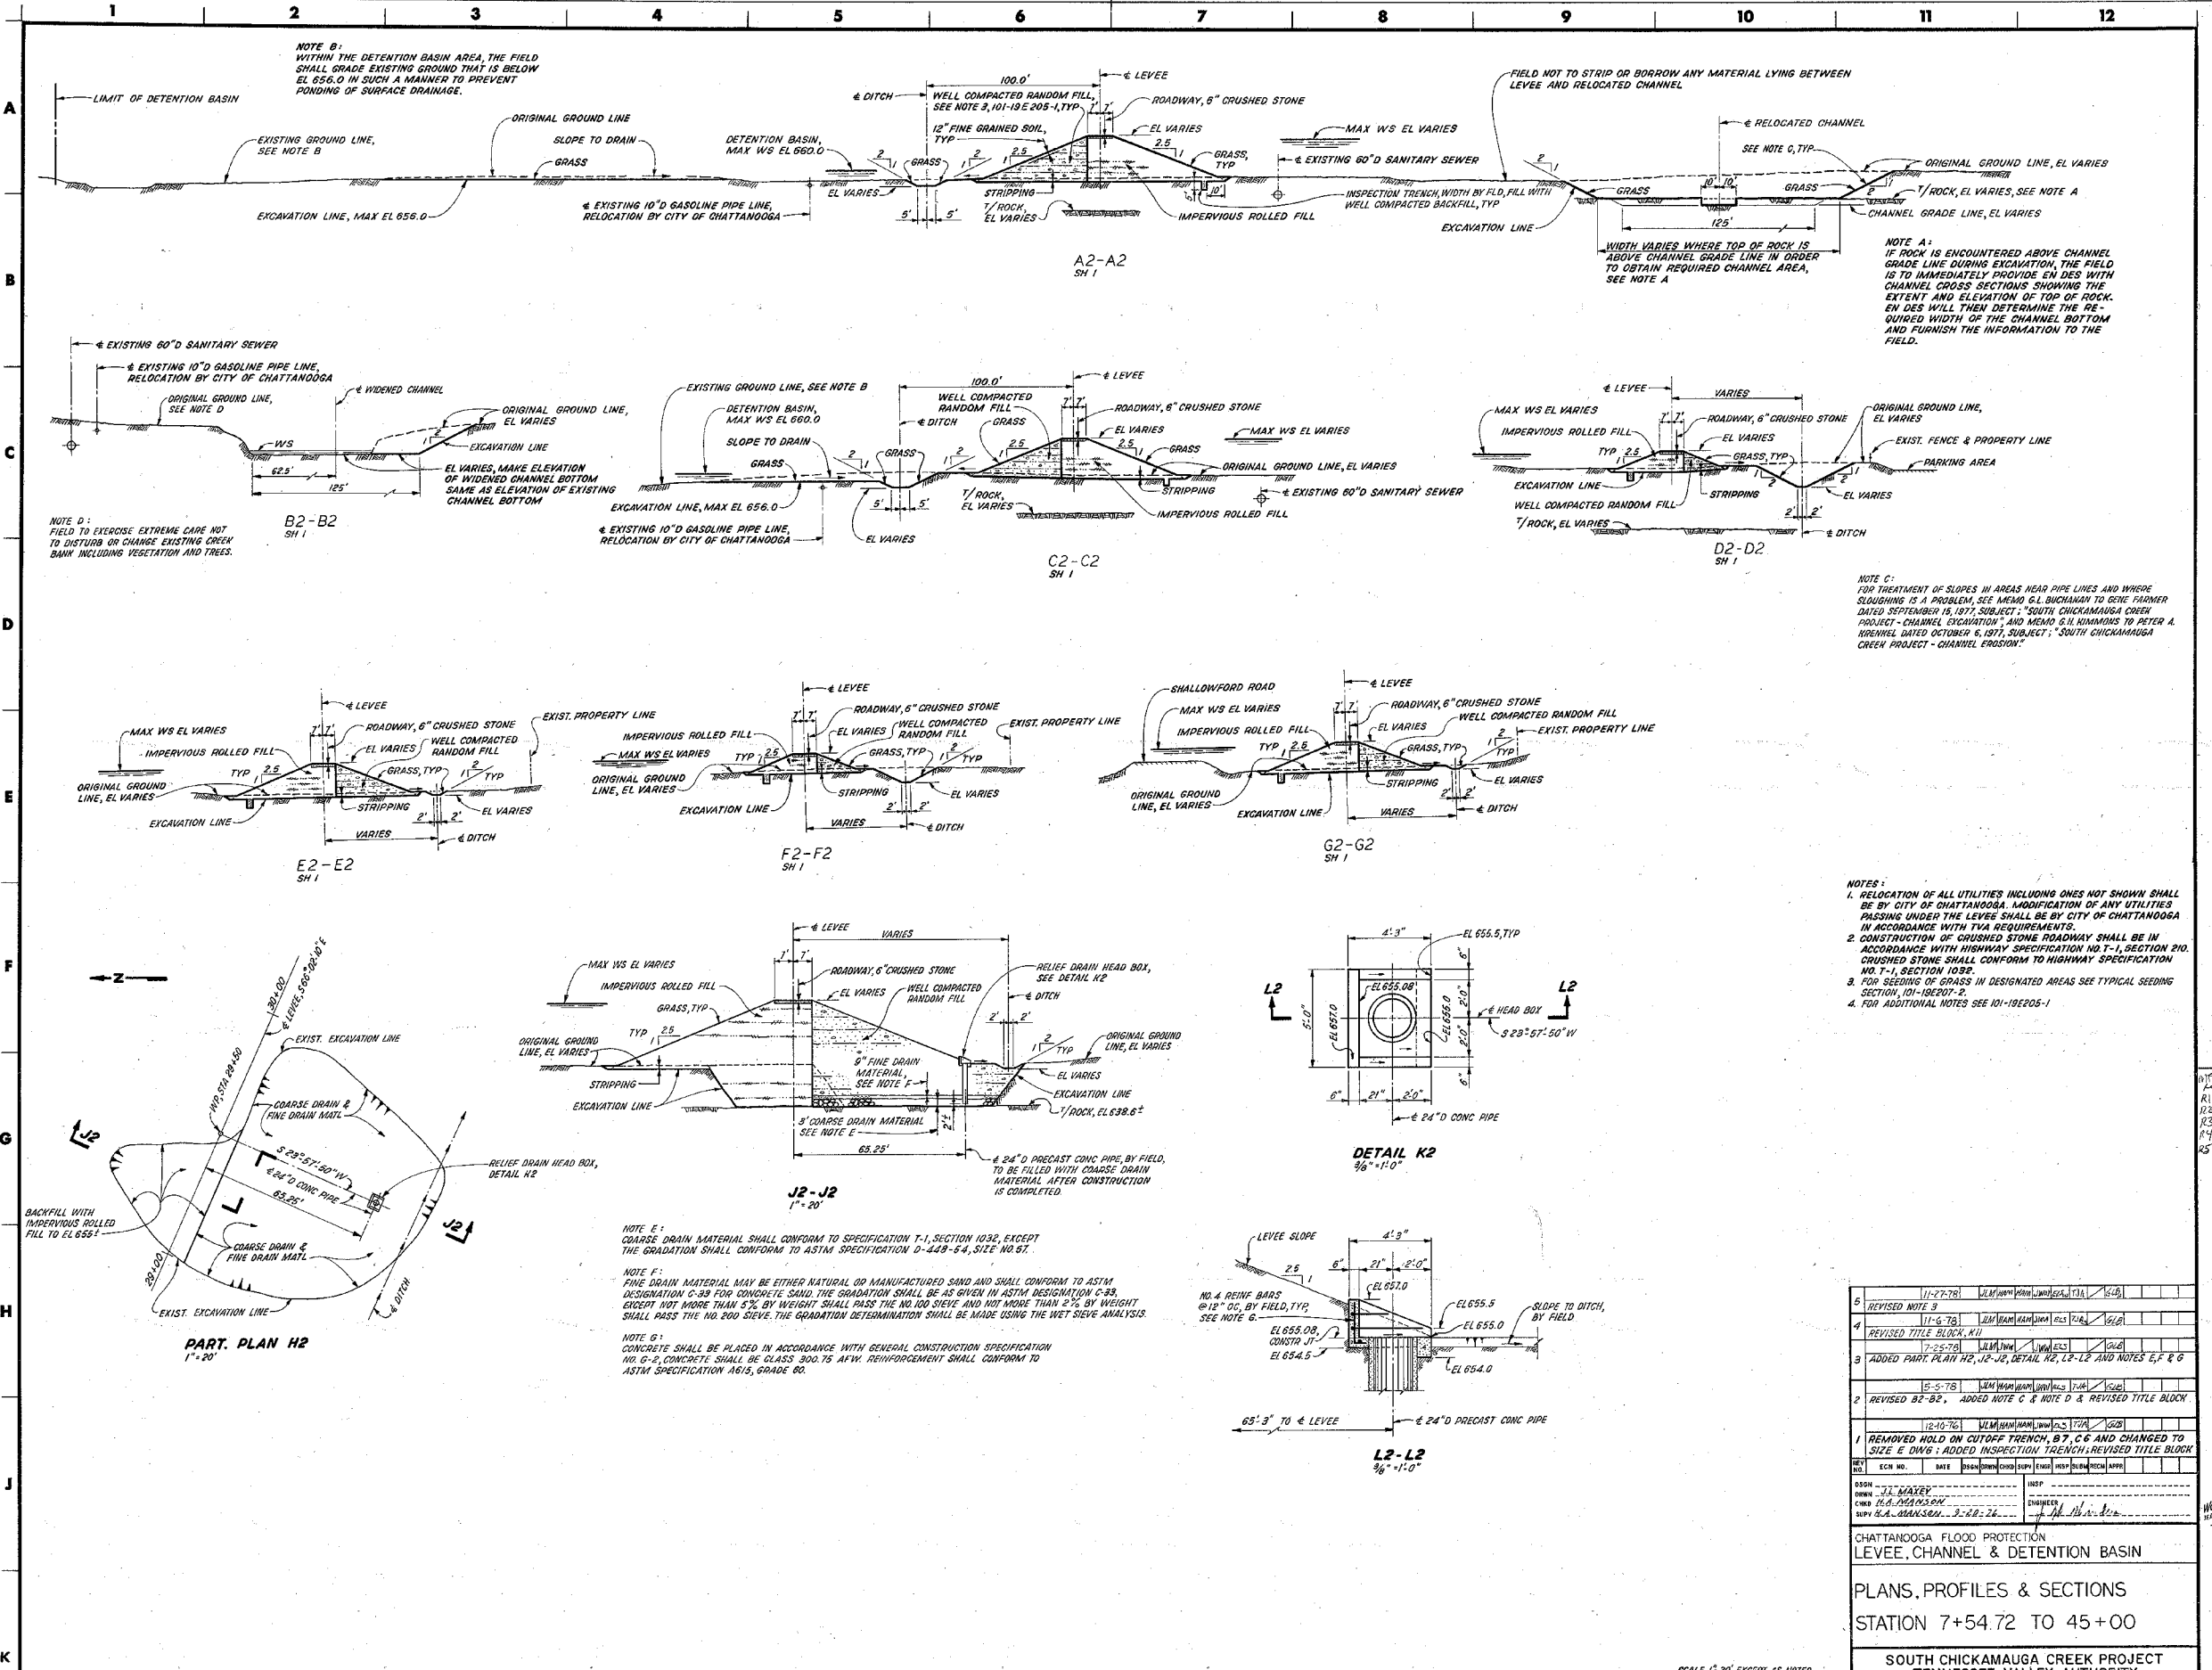

NOTE B:
WITHIN THE DETENTION BASIN AREA, THE FIELD SHALL GRADE EXISTING GROUND THAT IS BELOW EL 656.0 IN SUCH A MANNER TO PREVENT PONDING OF SURFACE DRAINAGE.

NOTE D:
FIELD TO EXERCISE EXTREME CARE NOT TO DISTURB OR CHANGE EXISTING CREEK BANK INCLUDING VEGETATION AND TREES.

NOTE D:
FIELD TO EXERCISE EXTREME CARE NOT TO DISTURB OR CHANGE EXISTING CREEK BANK INCLUDING VEGETATION AND TREES.

NOTE A:
IF ROCK IS ENCOUNTERED ABOVE CHANNEL GRADE LINE DURING EXCAVATION, THE FIELD IS TO IMMEDIATELY PROVIDE ENDS WITH CHANNEL CROSS SECTIONS SHOWING THE EXTENT AND ELEVATION OF TOP OF ROCK. ENDS WILL THEN DETERMINE THE REQUIRED WIDTH OF THE CHANNEL BOTTOM AND FURNISH THE INFORMATION TO THE FIELD.

NOTE C:
FOR TREATMENT OF SLOPES IN AREAS NEAR PIPE LINES AND WHERE SLOUGHING IS A PROBLEM, SEE MEMO G.L. BUCHANAN TO GENE FARMER DATED SEPTEMBER 16, 1977, SUBJECT: "SOUTH CHICKAMAUGA CREEK PROJECT - CHANNEL EXCAVATION" AND MEMO G.L. NUMMERS TO PETER A. KRUMHOLTZ DATED OCTOBER 6, 1977, SUBJECT: "SOUTH CHICKAMAUGA CREEK PROJECT - CHANNEL EROSION".

NOTES:
1. RELOCATION OF ALL UTILITIES INCLUDING ONES NOT SHOWN SHALL BE BY CITY OF CHATTANOOGA. MODIFICATION OF ANY UTILITIES PASSING UNDER THE LEVEE SHALL BE BY CITY OF CHATTANOOGA IN ACCORDANCE WITH TVA REQUIREMENTS.
2. CONSTRUCTION OF CRUSHED STONE ROADWAY SHALL BE IN ACCORDANCE WITH HIGHWAY SPECIFICATION NO. T-1, SECTION 210. CRUSHED STONE SHALL CONFORM TO HIGHWAY SPECIFICATION NO. T-1, SECTION 103E.
3. FOR SEEDING OF GRASS IN DESIGNATED AREAS SEE TYPICAL SEEDING SECTION, 101-19E205-1.
4. FOR ADDITIONAL NOTES SEE 101-19E205-1.

NOTE E:
COARSE DRAIN MATERIAL SHALL CONFORM TO SPECIFICATION T-1, SECTION 103E, EXCEPT THE GRADATION SHALL CONFORM TO ASTM SPECIFICATION D-449-54, SIZE NO. 57.

NOTE F:
FINE DRAIN MATERIAL MAY BE EITHER NATURAL OR MANUFACTURED SAND AND SHALL CONFORM TO ASTM DESIGNATION G-39 FOR CONCRETE SAND. THE GRADATION SHALL BE AS GIVEN IN ASTM DESIGNATION G-39 EXCEPT NOT MORE THAN 5% BY WEIGHT SHALL PASS THE NO. 100 SIEVE AND NOT MORE THAN 2% BY WEIGHT SHALL PASS THE NO. 200 SIEVE. THE GRADATION DETERMINATION SHALL BE MADE USING THE WET SIEVE ANALYSIS.

NOTE G:
CONCRETE SHALL BE PLACED IN ACCORDANCE WITH GENERAL CONSTRUCTION SPECIFICATION NO. G-2, CONCRETE SHALL BE CLASS 300.75 AFW. REINFORCEMENT SHALL CONFORM TO ASTM SPECIFICATION A615, GRADE 60.

PART. PLAN #2
1" = 20'

DETAIL K2
3/8" = 1'-0"

L2-L2
3/8" = 1'-0"

6	REVISED NOTE 3	11-2-78	JLM	WMM	WMM	WMM	WMM	WMM	WMM	WMM
4	REVISED TITLE BLOCK, K1	11-6-78	JLM	WMM	WMM	WMM	WMM	WMM	WMM	WMM
3	ADDED PART. PLAN #2, J2-J2, DETAIL K2, L2-L2 AND NOTES E, F & G	7-25-78	JLM	WMM	WMM	WMM	WMM	WMM	WMM	WMM
2	REVISED B2-B2, ADDED NOTE C & NOTE D & REVISED TITLE BLOCK	5-5-78	JLM	WMM	WMM	WMM	WMM	WMM	WMM	WMM
1	REMOVED HOLD ON CUTOFF TRENCH, B7, C6 AND CHANGED TO SIZE E DWG; ADDED INSPECTION TRENCH; REVISED TITLE BLOCK	12-10-76	JLM	WMM	WMM	WMM	WMM	WMM	WMM	WMM

CHATTANOOGA FLOOD PROTECTION
LEVEE, CHANNEL & DETENTION BASIN

PLANS, PROFILES & SECTIONS
STATION 7+54.72 TO 45+00




SOUTH CHICKAMAUGA CREEK PROJECT
TENNESSEE VALLEY AUTHORITY
DIVISION OF ENGINEERING DESIGN

SUBMITTED: *[Signature]*
RECOMMENDED: *[Signature]*
APPROVED: *[Signature]*

INSPECTED AND APPROVED FOR ISSUE: *[Signature]*
SECTION PROJECT MANAGER

KNOXVILLE 10-5-76 81 C 101-19E205-2 R5

SCALE 1" = 30' EXCEPT AS NOTED
COMPANION DRAWING: 101-19E205-1

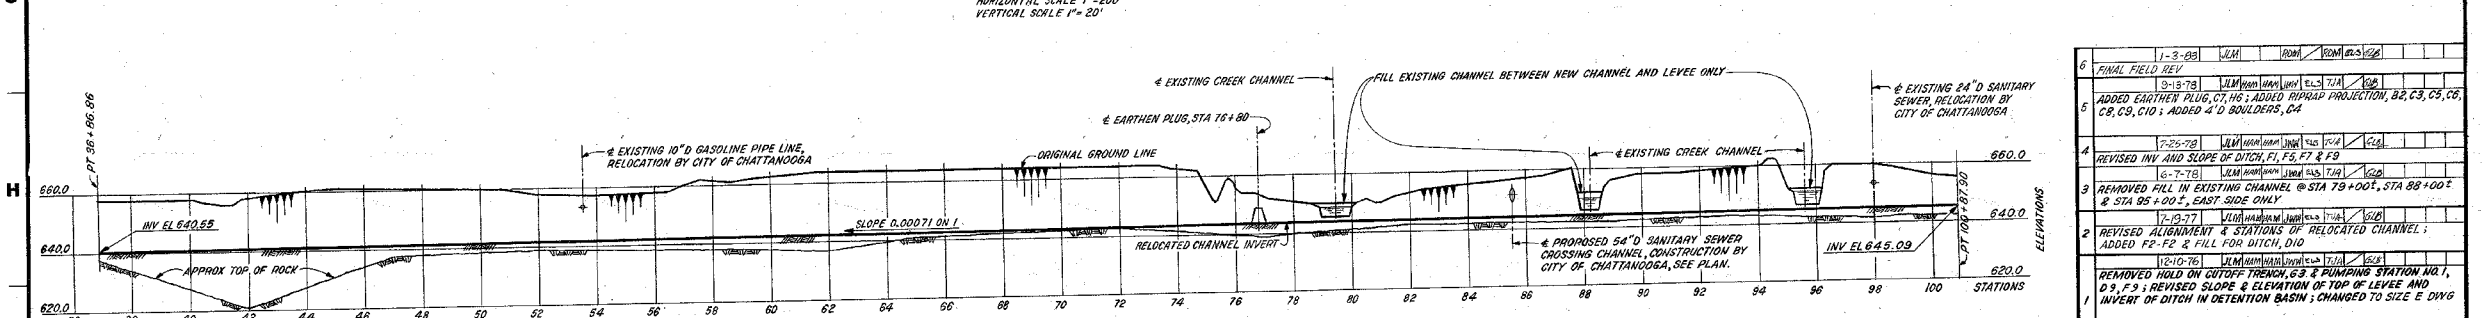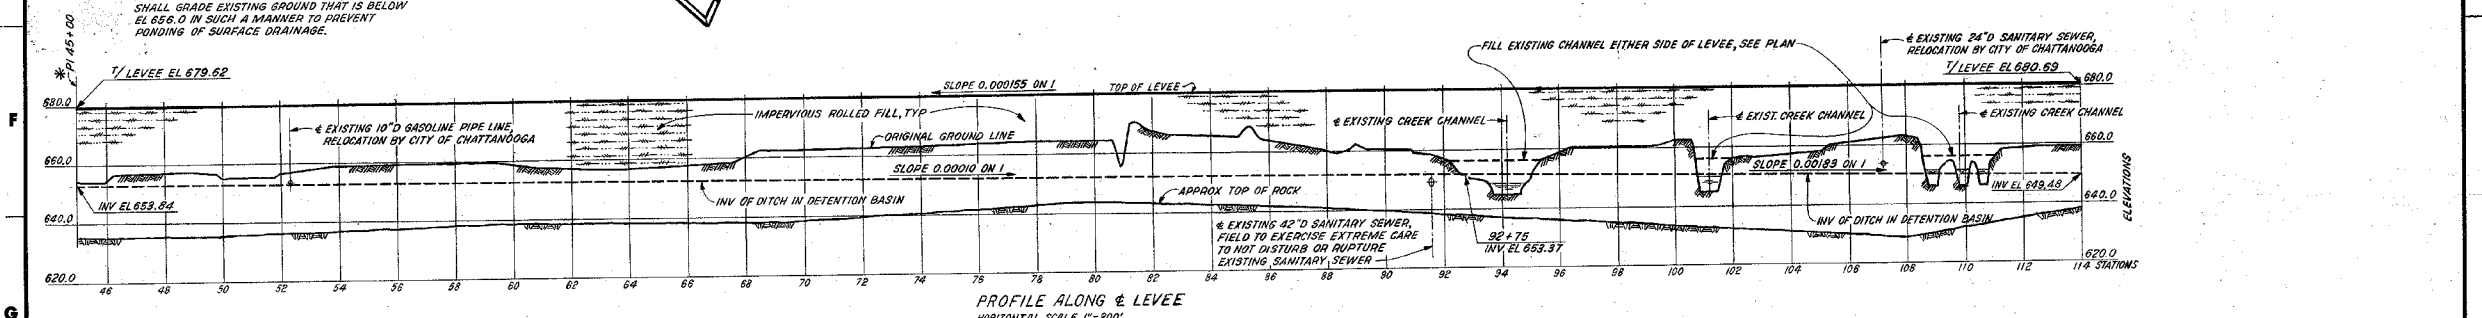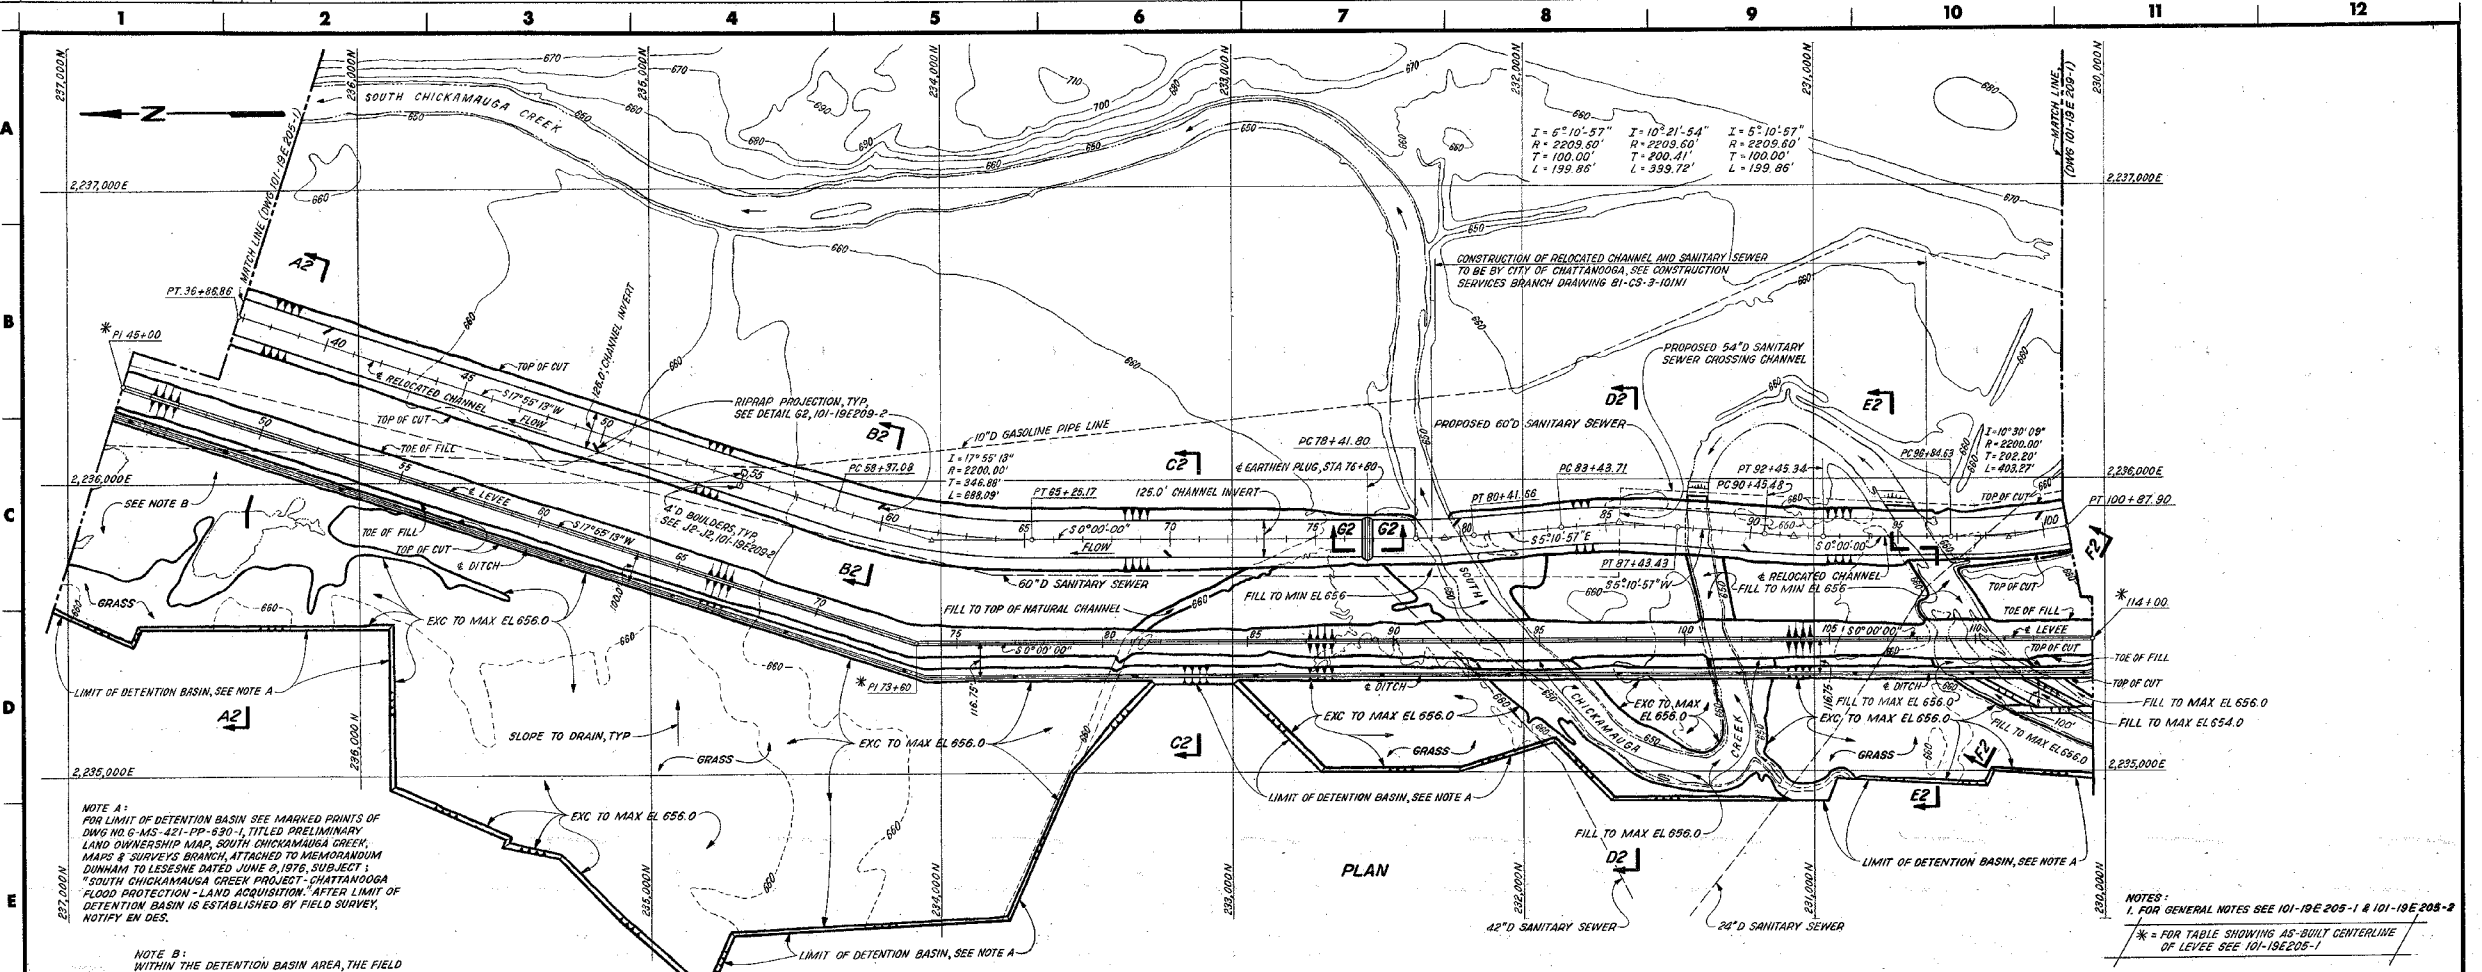

**CHATTANOOGA FLOOD PROTECTION
LEVEE, CHANNEL & DETENTION BASIN**

**PLANS, PROFILES & SECTIONS
STATION 45+00 TO 114+00**


**SOUTH CHICKAMAUGA CREEK PROJECT
TENNESSEE VALLEY AUTHORITY
DIVISION OF ENGINEERING DESIGN**

SCALE 1"=200' EXCEPT AS NOTED
COMPANION DRAWING 101-19E207-2
INSPECTED AND APPROVED FOR ISSUE

REV	NO.	DATE	BY	CHKD	APP'D
6	1-3-08	JUL 11 2008	W.M.	W.M.	W.M.
5	10-13-78		W.M.	W.M.	W.M.
4	7-25-78		W.M.	W.M.	W.M.
3	6-7-78		W.M.	W.M.	W.M.
2	1-10-77		W.M.	W.M.	W.M.
1	12-10-76		W.M.	W.M.	W.M.

DESIGNED BY: VANCE & MAREY
CHECKED BY: H.A. MORGANSON
DATE: 1-10-77

PRINTED AT: KNOXVILLE, TENN. 37902
81 C 101-19E207-1

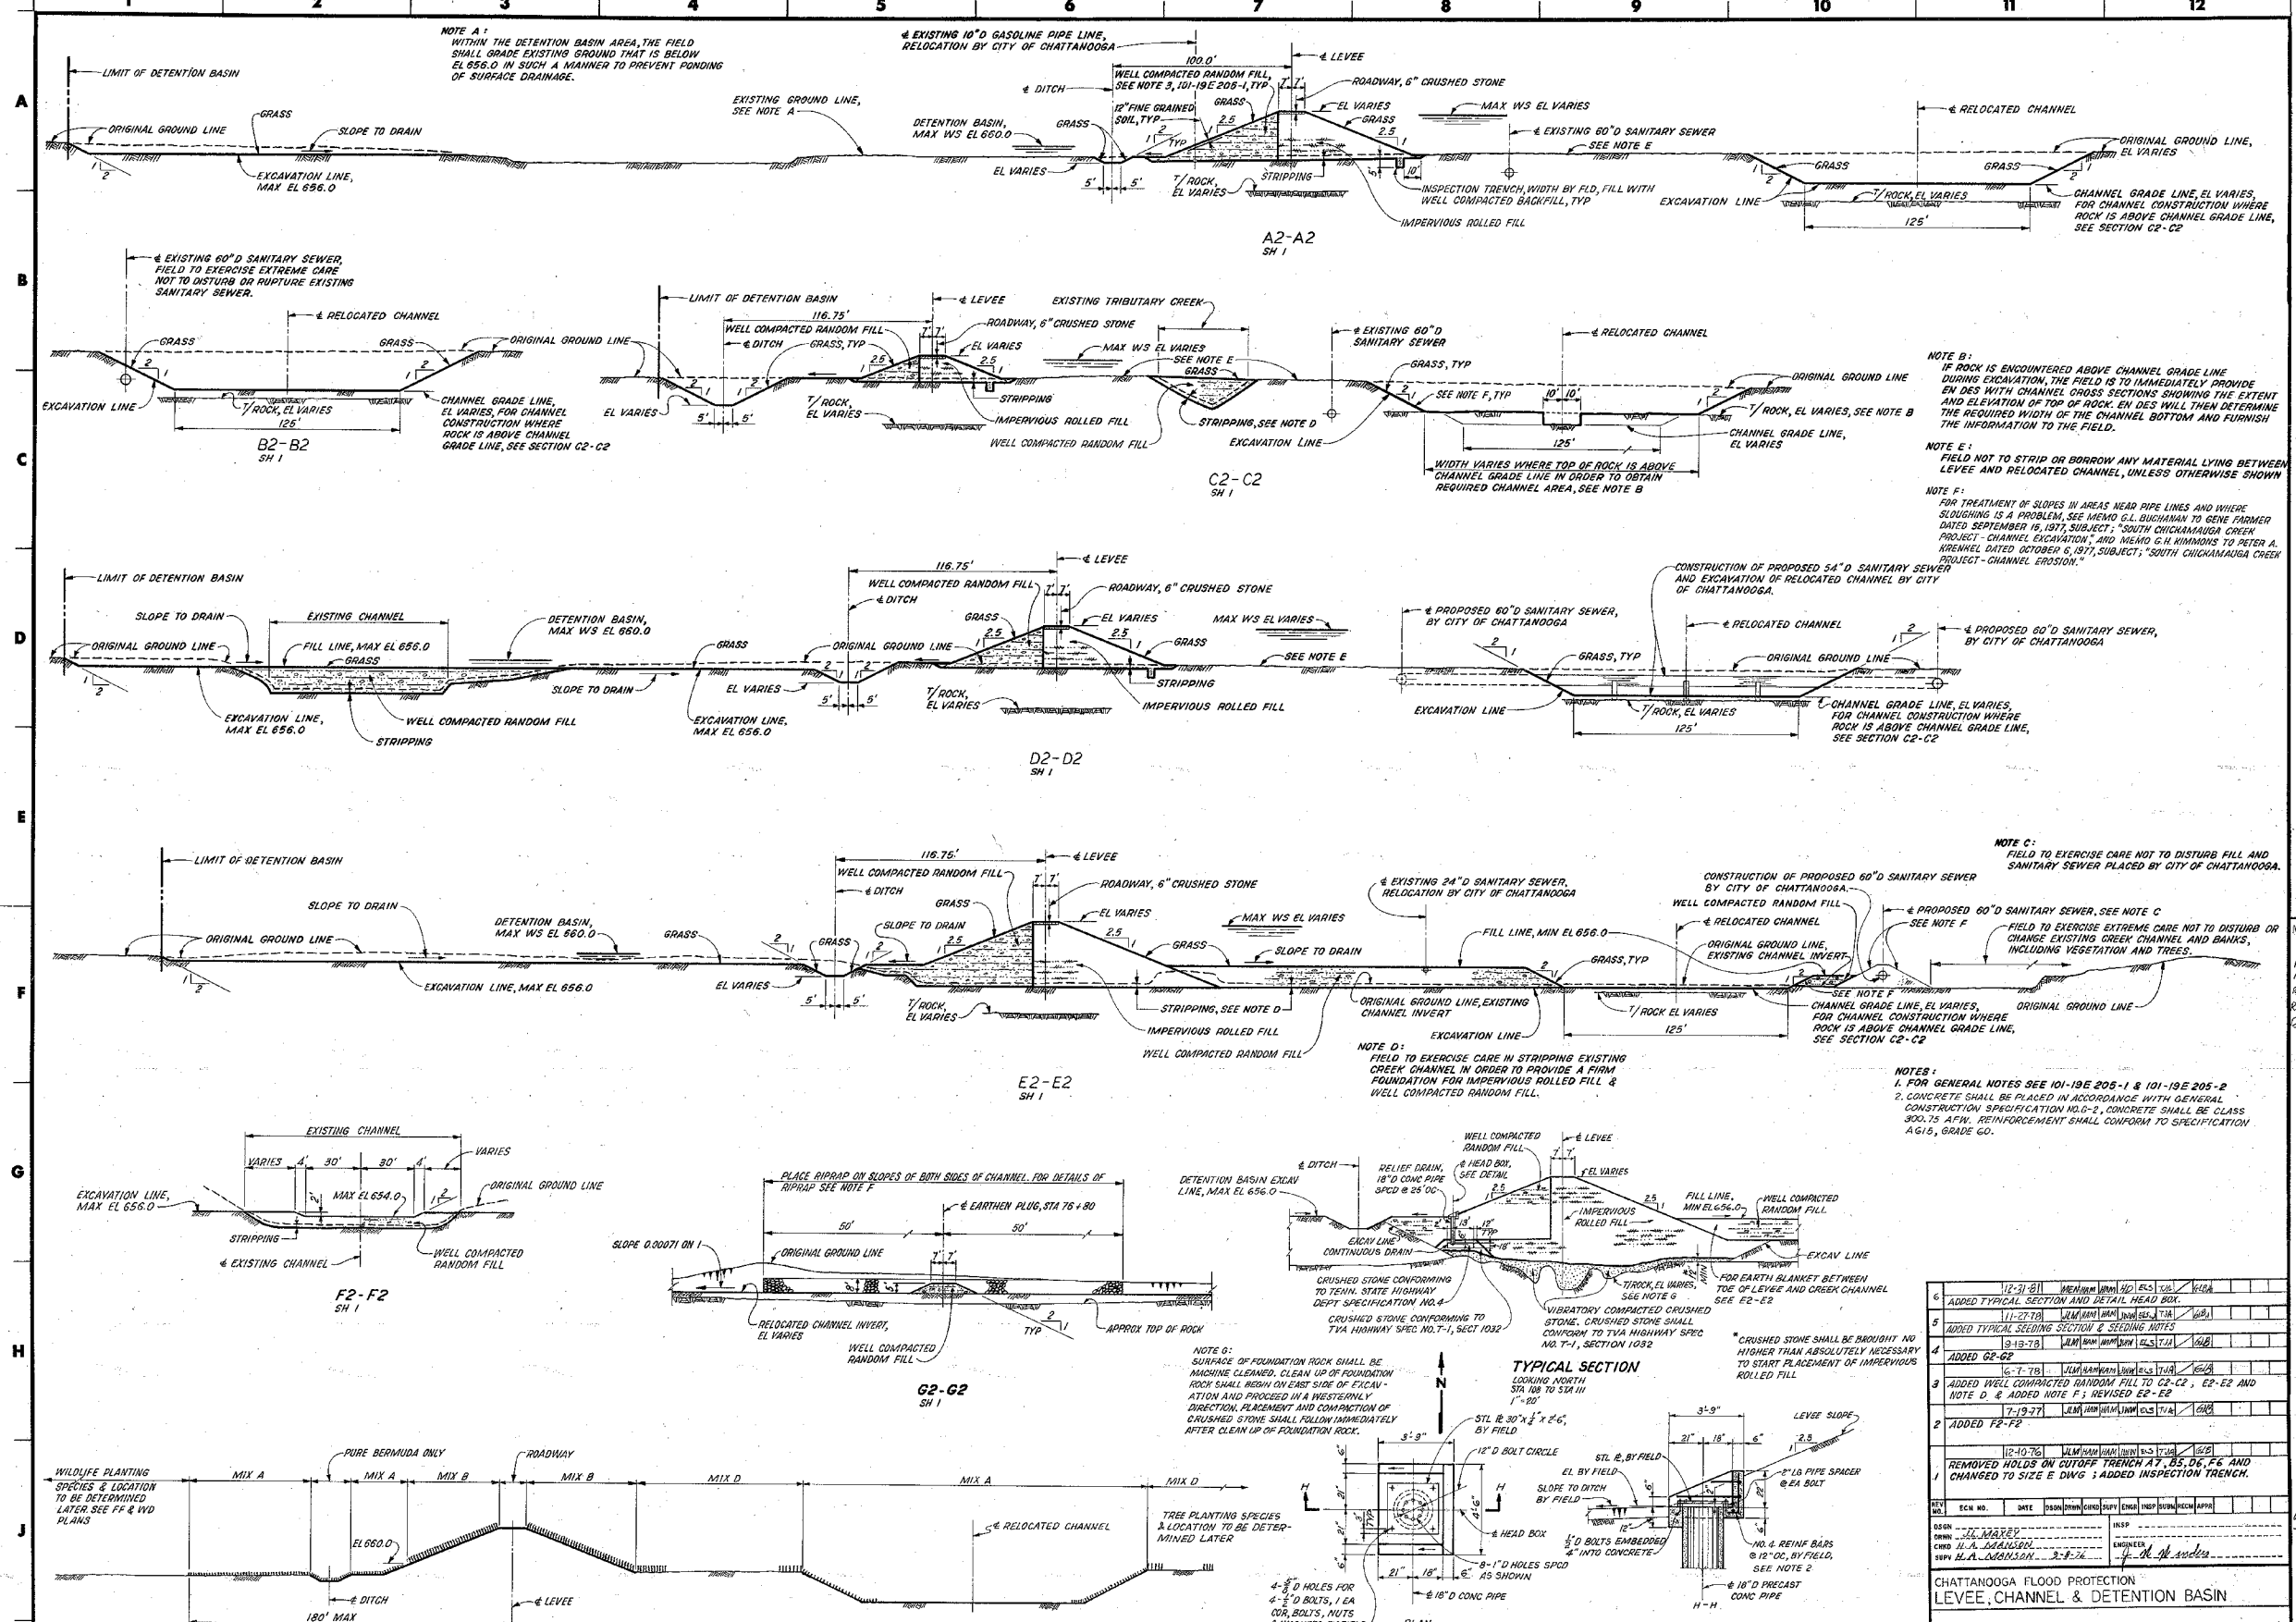


GRASS SPECIES

GRASS MIXTURE	NAME	SEEDING RATE (LBS PER AC)	PLANTING SEASON
A	BERMUDA GRASS	40	MAY 15 - JULY 15
	KOREAN LESPEDEZA	10	
	CROWN VETCH	30	MARCH 15 - MAY 1
	CHEWING FESCUE	30	AUG 15 - OCT 15
B	DWARF SERICIA	20	MARCH 15 - MAY 15
	ORCHARD GRASS	20	AUG 15 - OCT 15
	WHITE CLOVER	15	AUG 15 - OCT 15
	CRIMSON CLOVER	15	AUG 15 - OCT 15

TYPICAL SEEDING SECTION

NOTE: SURFACE OF FOUNDATION ROCK SHALL BE MACHINE CLEANED. CLEAN UP OF FOUNDATION ROCK SHALL BE ON EAST SIDE OF FOUNDATION AND PROCEED IN A WESTERLY DIRECTION. PLACEMENT AND COMPACTING OF CRUSHED STONE SHALL FOLLOW IMMEDIATELY AFTER CLEAN UP OF FOUNDATION ROCK.

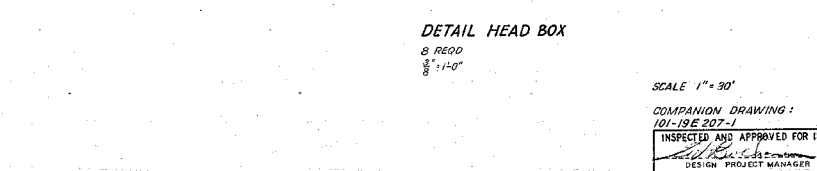

NOTE A: WITHIN THE DETENTION BASIN AREA, THE FIELD SHALL GRADE EXISTING GROUND THAT IS BELOW EL 656.0 IN SUCH A MANNER TO PREVENT FLOODING OF SURFACE DRAINAGE.

NOTE B: IF ROCK IS ENCOUNTERED ABOVE CHANNEL GRADE LINE DURING EXCAVATION, THE FIELD IS TO IMMEDIATELY PROVIDE EN DES WITH CHANNEL CROSS SECTIONS SHOWING THE EXTENT AND ELEVATION OF TOP OF ROCK. EN DES WILL THEN DETERMINE THE REQUIRED WIDTH OF THE CHANNEL BOTTOM AND FURNISH THE INFORMATION TO THE FIELD.

NOTE C: FIELD TO EXERCISE CARE NOT TO DISTURB FILL AND SANITARY SEWER PLACED BY CITY OF CHATTANOOGA.

NOTE D: FIELD TO EXERCISE CARE IN STRIPPING EXISTING CREEK CHANNEL IN ORDER TO PROVIDE A FIRM FOUNDATION FOR IMPERVIOUS ROLLED FILL & WELL COMPACTED RANDOM FILL.

NOTE E: FIELD NOT TO STRIP OR BORROW ANY MATERIAL LYING BETWEEN LEVEE AND RELOCATED CHANNEL, UNLESS OTHERWISE SHOWN.

NOTE F: FOR TREATMENT OF SLOPES IN AREAS NEAR PIPE LINES AND WHERE SLUGHING IS A PROBLEM, SEE MEMO E.L. DUCHAMMAN TO BENE FARMER DATED SEPTEMBER 16, 1977, SUBJECT: "SOUTH CHICKAMAUGA CREEK PROJECT - CHANNEL EXCAVATION", AND MEMO G.H. KIMMINS TO PETER A. KRENDEL DATED OCTOBER 6, 1977, SUBJECT: "SOUTH CHICKAMAUGA CREEK PROJECT - CHANNEL EROSION".

NOTES:
1. FOR GENERAL NOTES SEE 101-19E 205-1 & 101-19E 205-2
2. CONCRETE SHALL BE PLACED IN ACCORDANCE WITH GENERAL CONSTRUCTION SPECIFICATION NO. G-2, CONCRETE SHALL BE CLASS 3000 LBS. PER CU. YD. REINFORCEMENT SHALL CONFORM TO SPECIFICATION AG 15, GRADE 60.

CHATTANOOGA FLOOD PROTECTION LEVEE, CHANNEL & DETENTION BASIN PLANS, PROFILES & SECTIONS STATION 45+00 TO 114+00

SOUTH CHICKAMAUGA CREEK PROJECT TENNESSEE VALLEY AUTHORITY DIVISION OF ENGINEERING DESIGN

NO.	DATE	BY	CHECKED	APPROVED
1	12-31-81
2	11-27-79
3	9-19-78
4	7-19-77
5	12-10-76

REMOVED HOLDS ON CUTOFF TRENCH AT 85.06 FE AND CHANGED TO SIZE E DWG. ADDED INSPECTION TRENCH.

DESIGNED BY: W. WARE
CHECKED BY: H. A. JOHNSON
ENGINEER: H. A. JOHNSON

CHATTANOOGA FLOOD PROTECTION LEVEE, CHANNEL & DETENTION BASIN
PLANS, PROFILES & SECTIONS
STATION 45+00 TO 114+00

SOUTH CHICKAMAUGA CREEK PROJECT TENNESSEE VALLEY AUTHORITY DIVISION OF ENGINEERING DESIGN





APPROVED: [Signature]
INSPECTED AND APPROVED FOR ISSUE: [Signature]
DESIGN PROJECT MANAGER: [Signature]

KNOXVILLE 10-5-76 81 c 101-19E207-2 R6


SCALE 1"=30'

COMPARISON DRAWING: 101-19E 207-1

81 c 101-19E207-2

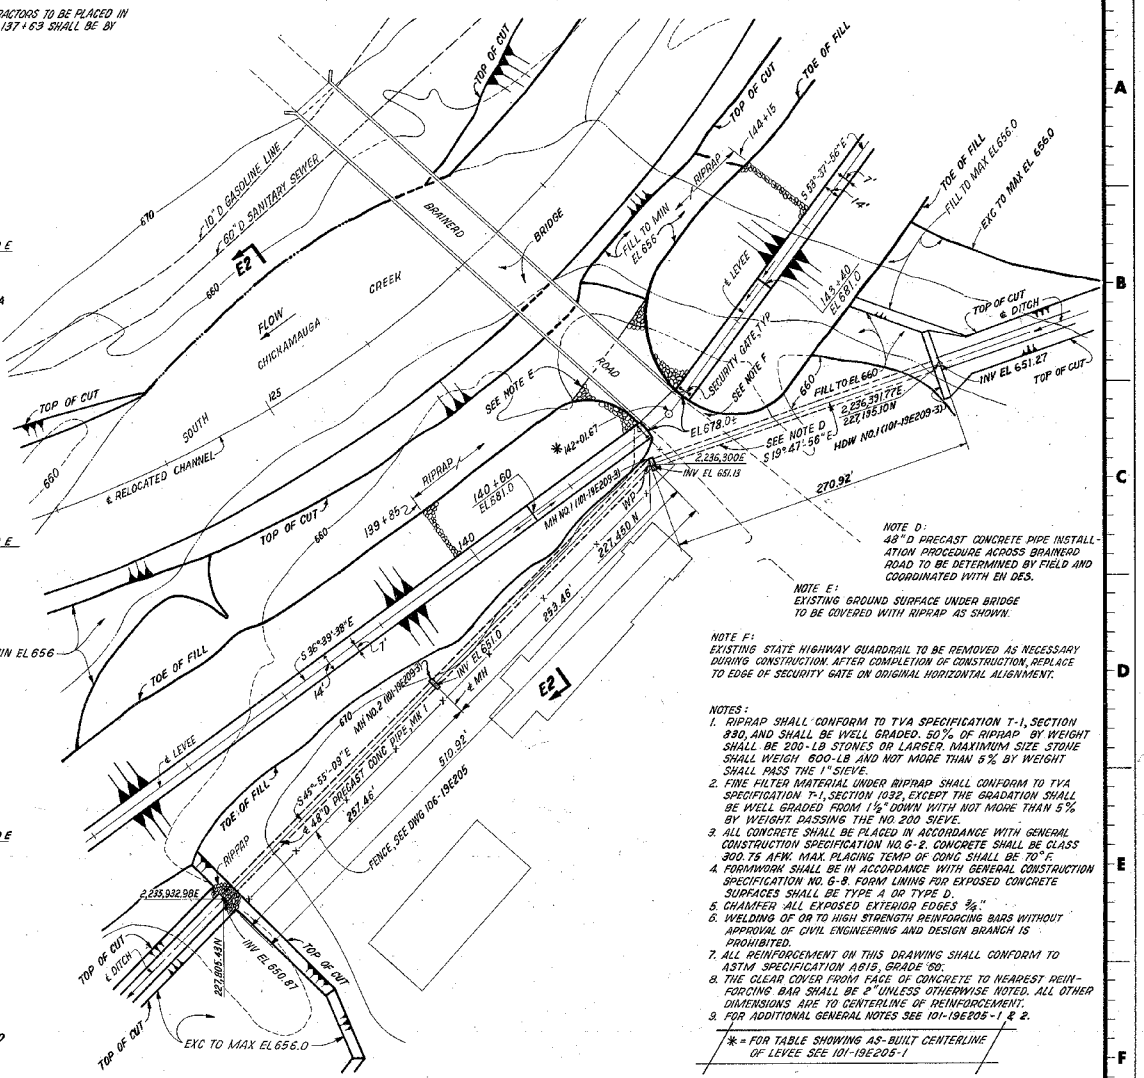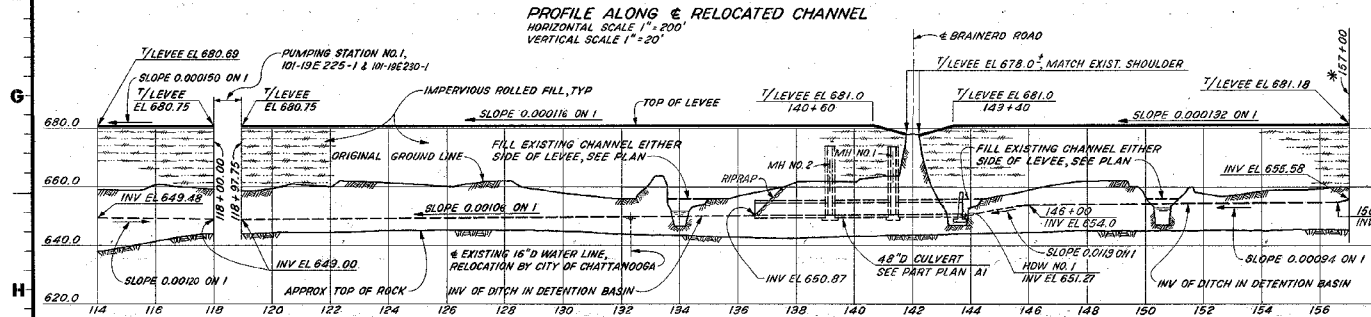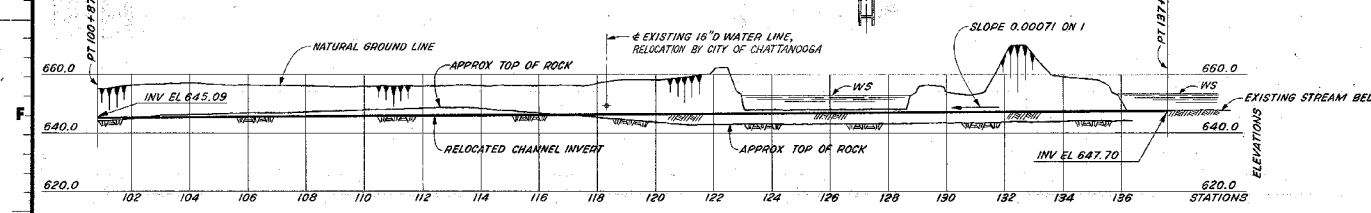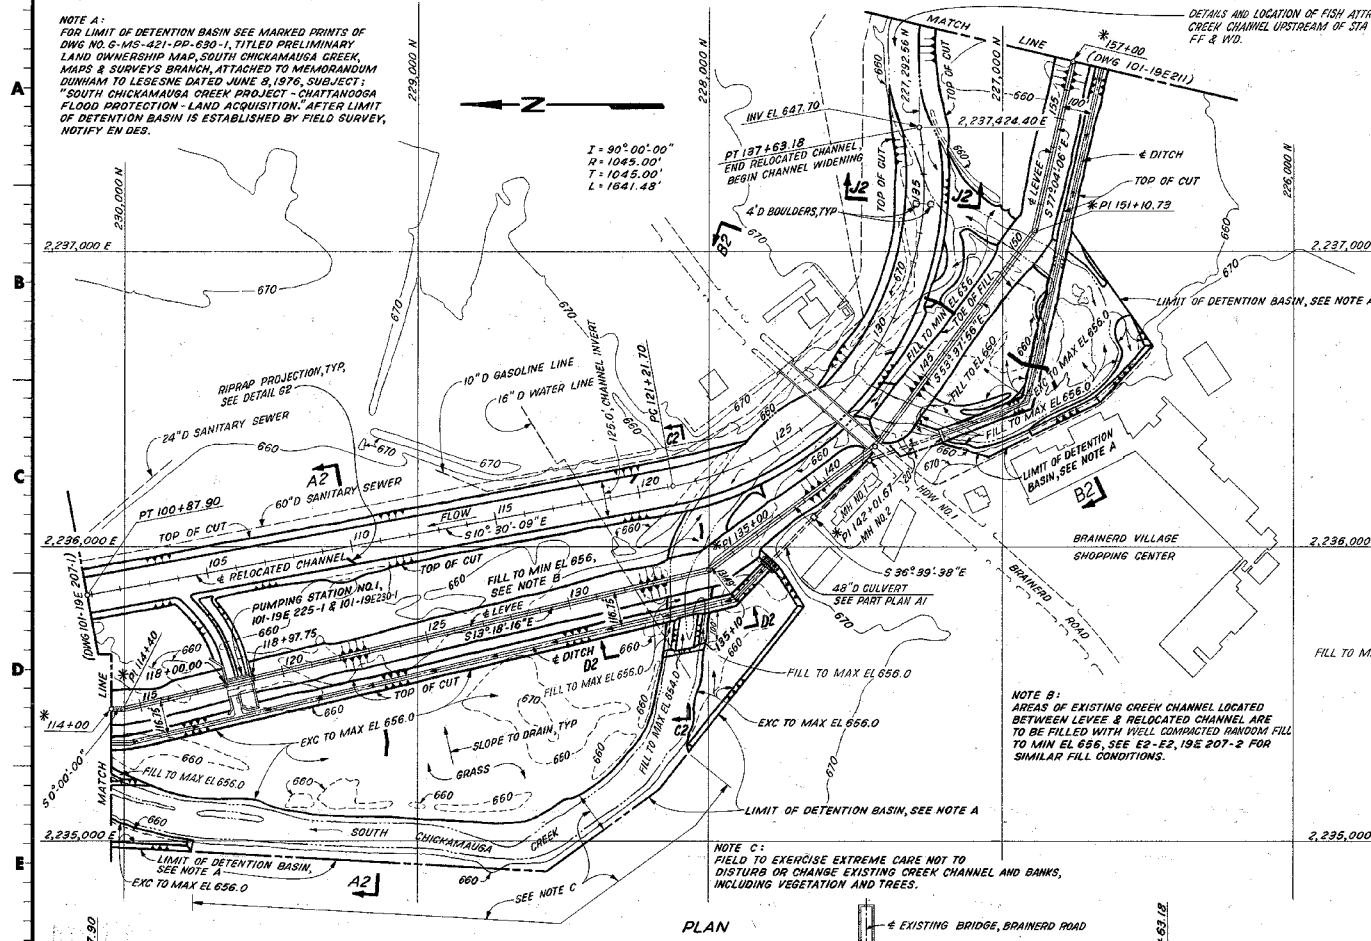

PART PLAN A1
1" = 50'

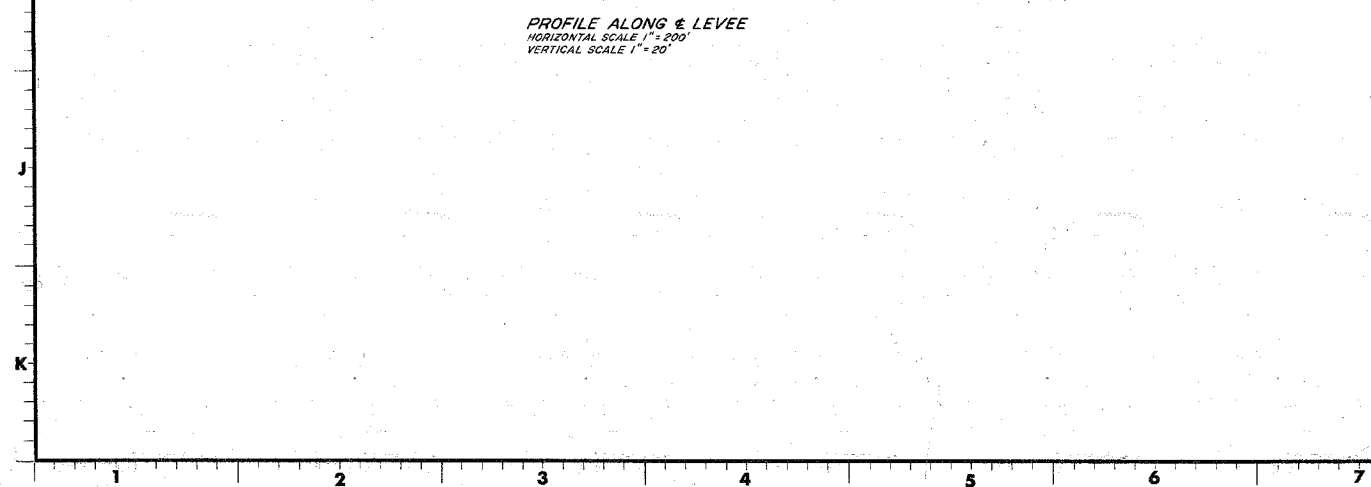

NOTES:

1. RIPRAP SHALL CONFORM TO TVA SPECIFICATION T-1, SECTION 830, AND SHALL BE WELL GRADED, 50% OF RIPRAP BY WEIGHT SHALL BE 200-LB STONES OR LARGER, MAXIMUM SIZE STONE SHALL WEIGH 600-LB AND NOT MORE THAN 5% BY WEIGHT SHALL PASS THE 1" SIEVE.
2. FINE FILTER MATERIAL UNDER RIPRAP SHALL CONFORM TO TVA SPECIFICATION T-1, SECTION 1039, EXCEPT THE GRADATION SHALL BE WELL GRADED FROM 1/2" DOWN WITH NOT MORE THAN 5% BY WEIGHT PASSING THE NO. 200 SIEVE.
3. ALL CONCRETE SHALL BE PLACED IN ACCORDANCE WITH GENERAL CONSTRUCTION SPECIFICATION NO. G-2. CONCRETE SHALL BE CLASS 300-75 AFK. MAX. PLACING TEMP OF CONG SHALL BE 70°F.
4. FORMWORK SHALL BE IN ACCORDANCE WITH GENERAL CONSTRUCTION SPECIFICATION NO. G-8. FORM LINING FOR EXPOSED CONCRETE SURFACES SHALL BE TYPE A OR TYPE D.
5. CHAMFER ALL EXPOSED EXTERIOR EDGES 3/8".
6. WELDING OF OR TO HIGH STRENGTH REINFORCING BARS WITHOUT APPROVAL OF CIVIL ENGINEERING AND DESIGN BRANCH IS PROHIBITED.
7. ALL REINFORCEMENT ON THIS DRAWING SHALL CONFORM TO ASTM SPECIFICATION A615, GRADE 60.
8. THE CLEAR COVER FROM FACE OF CONCRETE TO NEAREST REINFORCING BAR SHALL BE 2" UNLESS OTHERWISE NOTED. ALL OTHER DIMENSIONS ARE TO CENTERLINE OF REINFORCEMENT.
9. FOR ADDITIONAL GENERAL NOTES SEE 101-19E205-1 & 2.

* = FOR TABLE SHOWING AS-BUILT CENTERLINE OF LEVEE SEE 101-19E205-1

REVISIONS:

4	FINAL FIELD REV	1-3-83	MM	MM	MM	MM	MM
3	REV PLAN, PART PLAN A1 & PROFILE ALONG & LEVEE	8-28-79	MM	MM	MM	MM	MM
2	REVISED INVERT AND SLOPE OF DITCH IN DETENTION BASIN, H5, G6 & H8	11-1-78	MM	MM	MM	MM	MM
1	ADDED RIPRAP PROJECTION AT C3 BE 4' 4" BOULDERS, G5 & NOTE A7	3-13-76	MM	MM	MM	MM	MM

**CHATTANOOGA FLOOD PROTECTION
LEVEE, CHANNEL & DETENTION BASIN**

**PLANS, PROFILES & SECTIONS
STATION 114+00 TO 157+00**

**SOUTH CHICKAMAUGA CREEK PROJECT
TENNESSEE VALLEY AUTHORITY
DIVISION OF ENGINEERING DESIGN**

DESIGN PROJECT MANAGER: KNOXVILLE 3-30-78 81 c 101-19E209-1 R4

SCALE 1" = 200' EXCEPT AS NOTED

COMPANION DRAWINGS:
101-19E209-1 THRU 3

REFERENCE DRAWING:
19E205 - BILL OF MATERIAL

INSPECTED AND APPROVED FOR ISSUE

DESIGN PROJECT MANAGER


PRINT

SIZE

PRINTS RECD

SUBMITTED: [Signature]
RECOMMENDED: [Signature]
APPROVED: [Signature]

DATE: 3-30-78
PROJECT: 101-19E209-1 R4


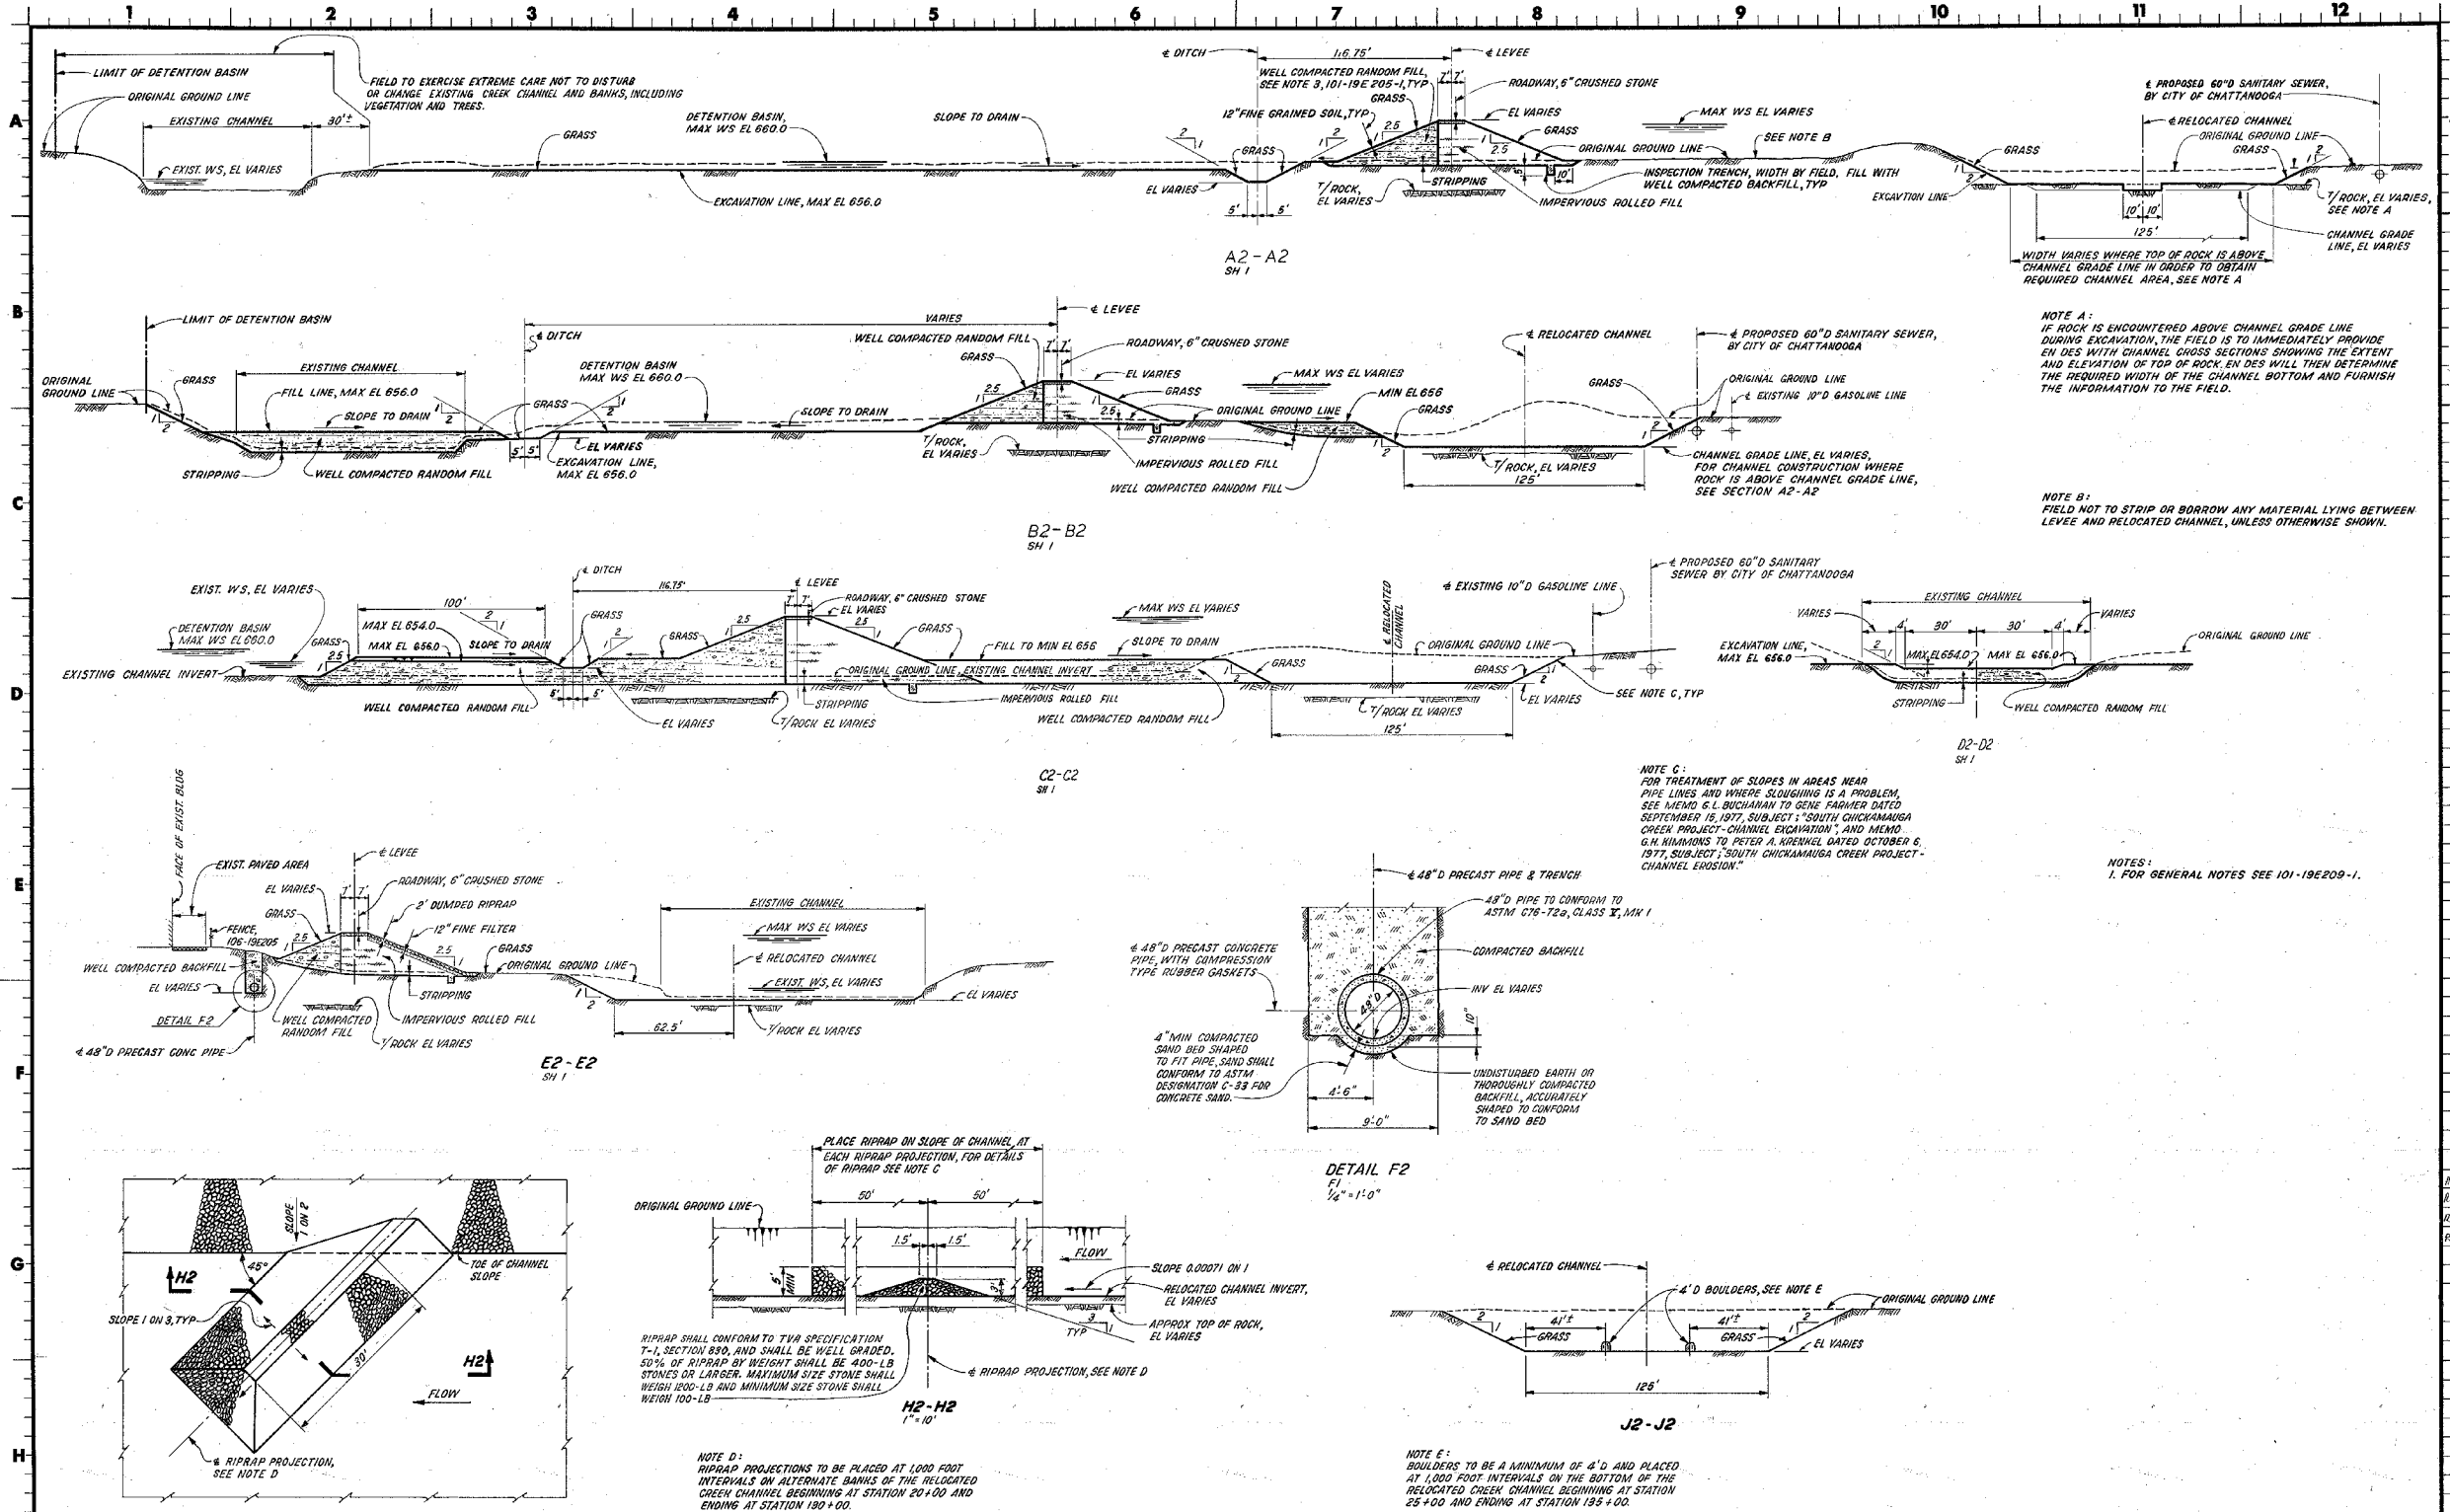


NOTE A:
 IF ROCK IS ENCOUNTERED ABOVE CHANNEL GRADE LINE DURING EXCAVATION, THE FIELD IS TO IMMEDIATELY PROVIDE ENDS WITH CHANNEL CROSS SECTIONS SHOWING THE EXTENT AND ELEVATION OF TOP OF ROCK; ENDS WILL THEN DETERMINE THE REQUIRED WIDTH OF THE CHANNEL BOTTOM AND FURNISH THE INFORMATION TO THE FIELD.


NOTE B:
 FIELD NOT TO STRIP OR BORROW ANY MATERIAL LYING BETWEEN LEVEE AND RELOCATED CHANNEL, UNLESS OTHERWISE SHOWN.

NOTE C:
 FOR TREATMENT OF SLOPES IN AREAS NEAR PIPE LINES AND WHERE SLOUGHING IS A PROBLEM, SEE MEMO G.L. BUCHANAN TO GENE FARMER DATED SEPTEMBER 19, 1977, SUBJECT: "SOUTH CHICKAMAUGA CREEK PROJECT - CHANNEL EXCAVATION"; AND MEMO G.H. KIRKMAN TO PETER A. KIRKMAN DATED OCTOBER 6, 1977, SUBJECT: "SOUTH CHICKAMAUGA CREEK PROJECT - CHANNEL EROSION."

NOTES:
 1. FOR GENERAL NOTES SEE 101-19E209-1.

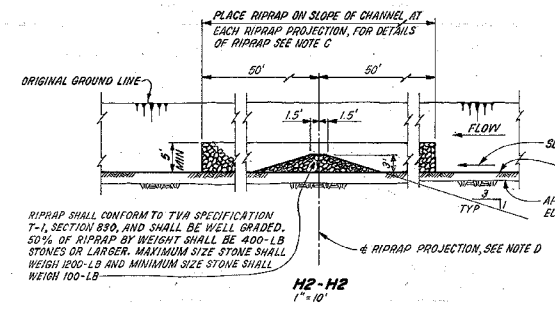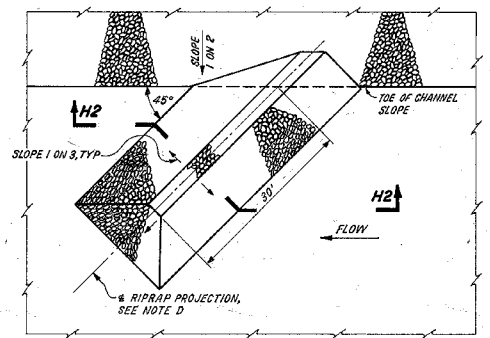

NOTE D:
 RIPRAP PROJECTIONS TO BE PLACED AT 100 FOOT INTERVALS ON ALTERNATE BANKS OF THE RELOCATED CREEK CHANNEL BEGINNING AT STATION 20+00 AND ENDING AT STATION 190+00.

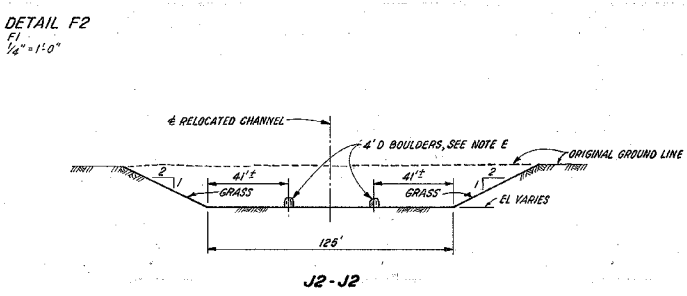

NOTE E:
 BOULDERS TO BE A MINIMUM OF 4'-0" AND PLACED AT 100 FOOT INTERVALS ON THE BOTTOM OF THE RELOCATED CREEK CHANNEL BEGINNING AT STATION 25+00 AND ENDING AT STATION 135+00.

SCALE 1" = 30' EXCEPT AS NOTED

REV	DATE	BY	CHKD	APP'D
2	8-28-79	PLW	WJM	WJM
1	3-13-78	WJM	WJM	WJM
1	ADDED DETAIL G2, H2, J2 AND NOTES D & E			
NO.	REV. NO.	DATE	ISSUED BY	REVISION
0000				
DRN	WJ	MAXEP		
CHKD	E.S.	CHERRY		
APP'D	G.A.	MAHESON	10-13-77	
CHATTANOOGA FLOOD PROTECTION LEVEE, CHANNEL & DETENTION BASIN				
PLANS, PROFILES & SECTIONS STATION 114+00 TO 157+00				
SOUTH CHICKAMAUGA CREEK PROJECT TENNESSEE VALLEY AUTHORITY DIVISION OF ENGINEERING DESIGN				
SUBMITTED		RECOMMENDED	APPROVED	
E.S. Cherry		W.J. Maheson	G.A. Maheson	
DESIGN PROJECT MANAGER		KNOXVILLE	3-30-78	81 c 101-19E209-2 R2
PRINT	H	1/2	1	
SIZE	F	3	3	
RE OR PROJ. ME. EE. CE. AD. CO. ED. MOD. BY. BL. PA.				

STRAIGHT REINFORCEMENT BAR LIST

(FOR FIELD INFORMATION ONLY)

MADE J. L. MAXEY
CHKD HAM

FOR DWG. NO. 101-19E209-3 R0




SHEET NO 1 OF 1

DATE 10-31-77

PROJECT SOUTH CHICKAMAUGA CREEK

BUILDING MANHOLES & HEADWALLS

BAR SIZE	BAR LENGTH	NO. REQ'D	BAR SIZE	BAR LENGTH	NO. REQ'D	BAR SIZE	BAR LENGTH	NO. REQ'D
8	11-6	90	4	19	2	4	5-6	3
			4	18-9	2	4	5-3	5
			4	18-6	2	4	5	4
6	55-6	42	4	18-3	6	4	4-9	7
6	27	4	4	18	8	4	4-6	96
6	25-6	8	4	17-9	2	4	4	6
6	25-3	4	4	17-3	2	4	3-9	4
6	13-3	128	4	14-6	6	4	3-3	5
6	11-6	60	4	14-3	2	4	3	1
6	8-6	2	4	14	4	4	2-9	7
6	8	2	4	13-6	4	4	2-6	4
6	7-6	2	4	13-3	4	4	2-3	2
6	7-3	79	4	13	6	4	1-9	2
6	7	7	4	9-6	10	4	1-6	13
6	6	32	4	9	10	4	1-3	1
6	3-3	2	4	7-6	10	4	1	8
6	2-6	2	4	7-3	8			
6	2-3	1	4	7	3			
			4	6-9	34			
			4	6-6	3			
4	31-6	26	4	6-3	3			
4	22-6	28	4	6	7			
4	19-3	4	4	5-9	7			

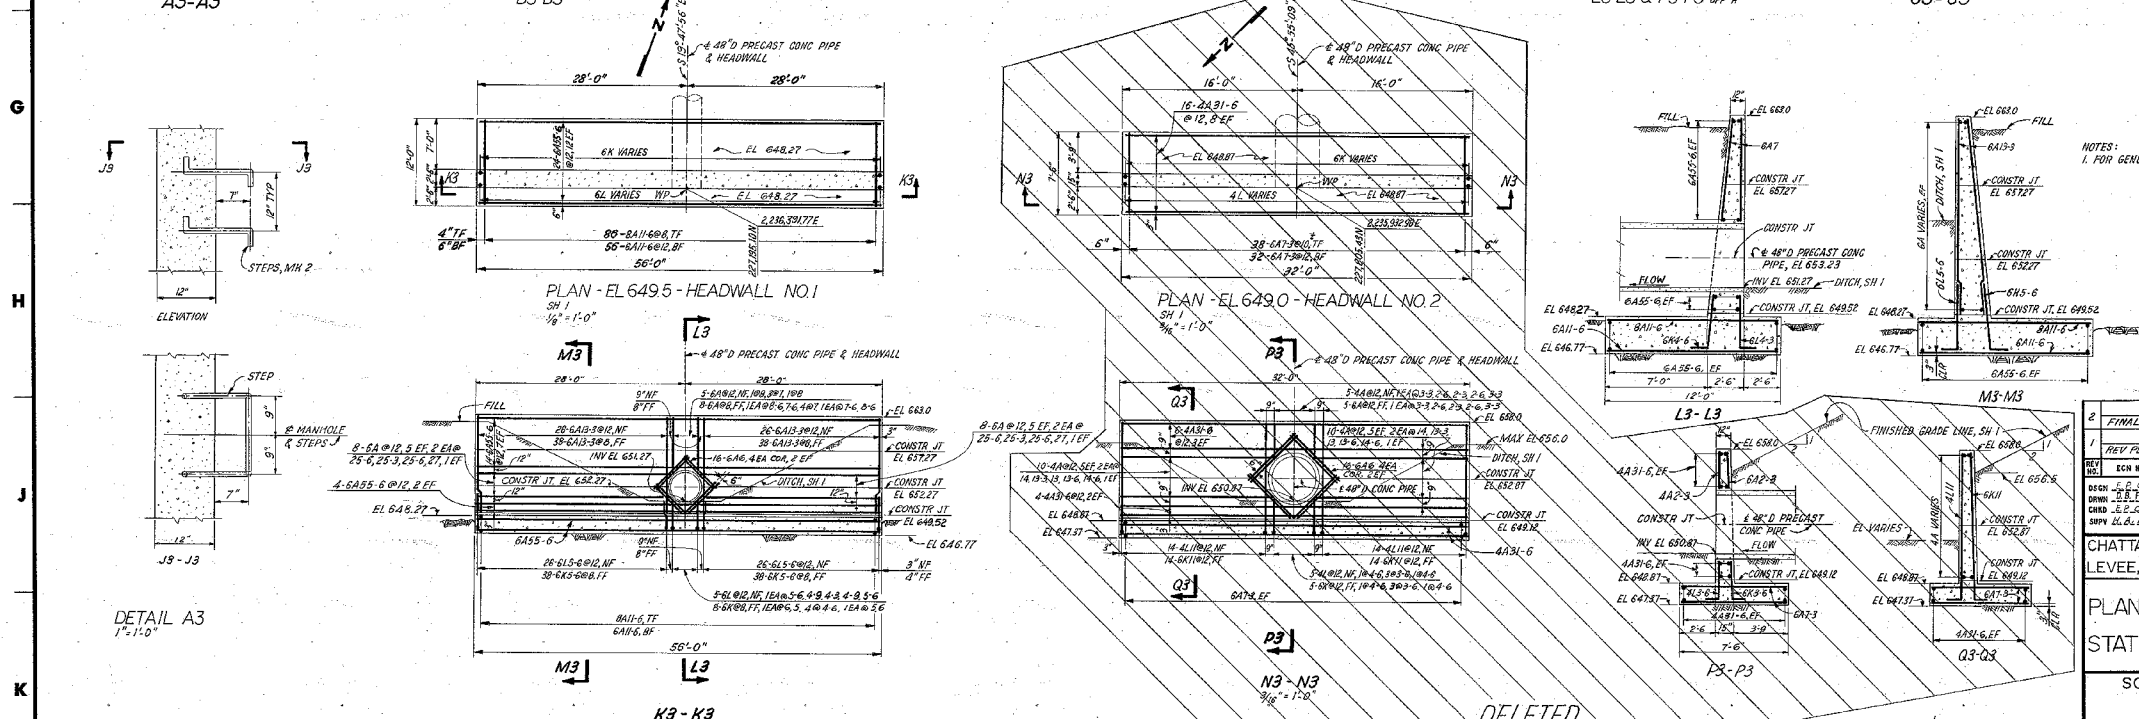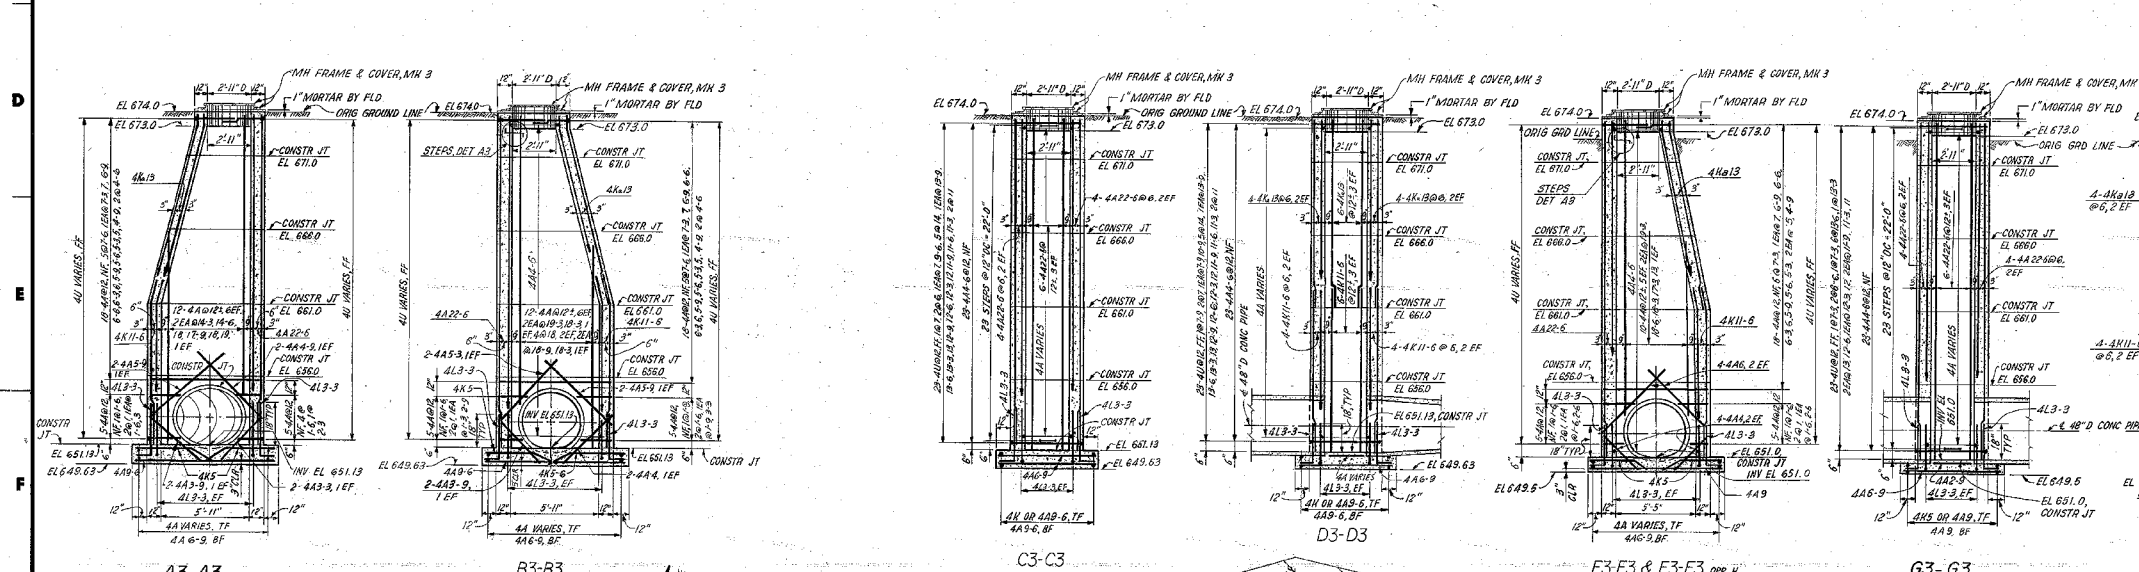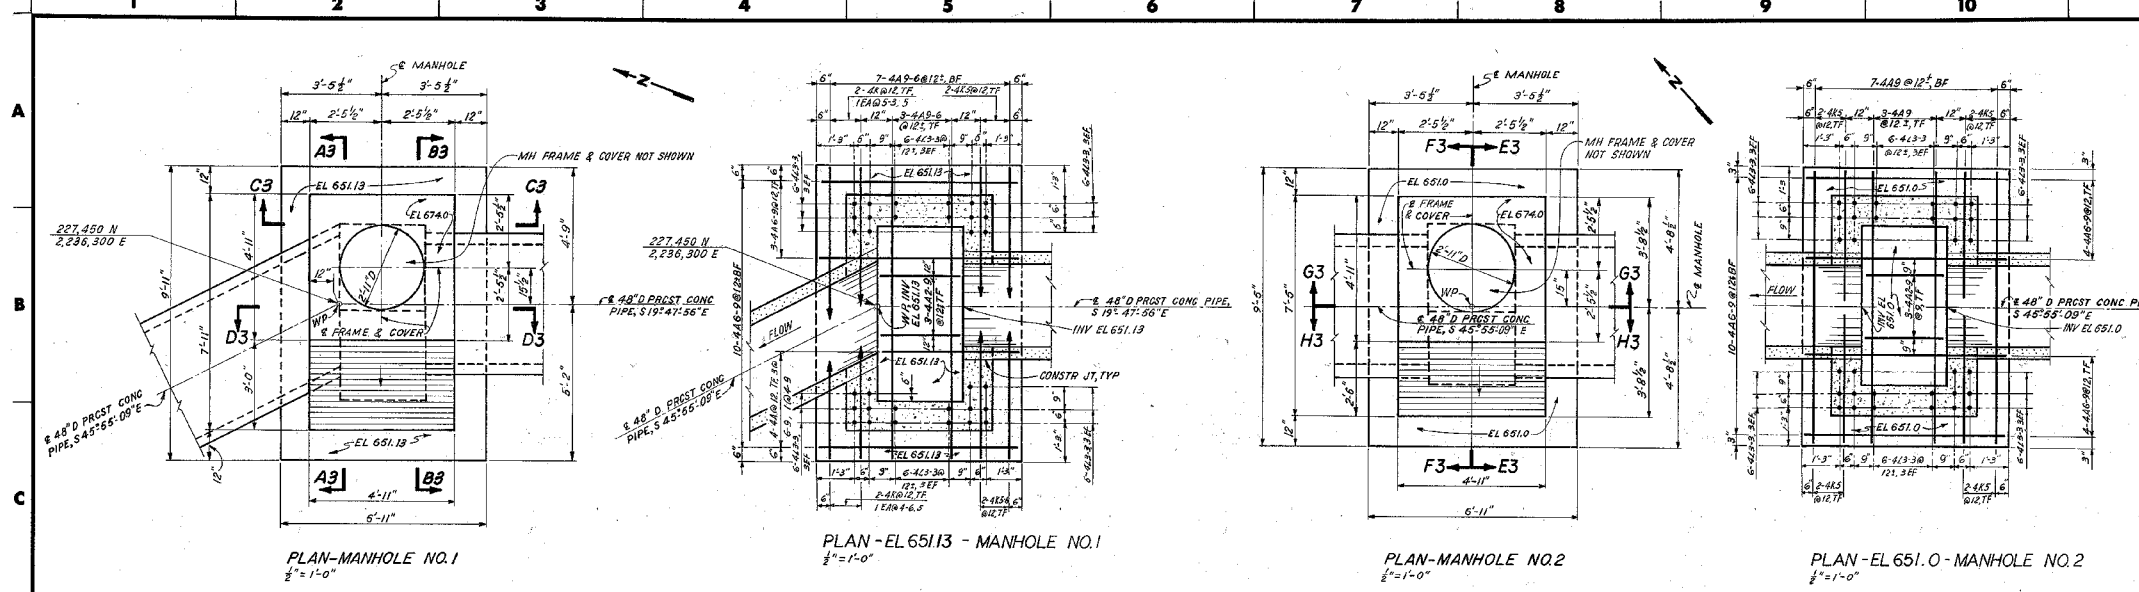




BENT BAR LIST						
BAR MARK	NO	BENDING DIMENSIONS				
		a	b	c	e	f
4U6	2	0-0	4-0			EX
4U6	4	1-0	4-0			EX
4U7	4	1-0	4-0			EX
4U7-3	4	1-3	4-0			EX
4U7-9	2	1-0	4-0			EX
4U11	8	3-0	4-0			EX
4U11-3	6	3-0	4-0			EX
4U11-6	2	3-0	4-0			EX
4U11-9	6	3-0	4-0			EX
4U12	4	3-0	4-0			EX
4U12-3	4	3-0	4-0			EX
4U12-6	6	3-0	4-0			EX
4U12-9	2	3-0	4-0			EX
4U13	6	3-0	4-0			EX
4U13-3	4	3-0	4-0			EX
4U13-6	2	3-0	4-0			EX
4U13-9	2	3-0	4-0			EX
4U19	10	4-0	4-0			EX
4U19-3	72	2-0				EX
4U19-6	2	2-0				EX
4U19-9	2	2-0				EX
4K11	28	10-0				EX
4K11-3	1	2-0			0-8	
4K11-6	1	2-0			0-8	
4K11-9	1	2-0			0-8	
4K12	2	2-0			0-8	
4K12-3	2	2-0			0-8	
4K12-6	2	2-0			0-8	
4K12-9	2	2-0			0-8	
4K13	28	10-0				EX
4K13-3	1	3-0			0-2 1/2	
4K13-6	2	3-0				
4K13-9	2	3-0				
4K14	54	4-7				EX
4K14-3	2	2-6			0-0	
4K14-6	6	3-8			0-1 1/2	
4K14-9	2	4-7			4-1 1/2	
4K15	70	4-7			4-6 1/2	
4K15-3	2	5-1			5-4	
4K11	8	12-0			8-2 1/2	

NOTES:
1. FOR GENERAL NOTES SEE 101-19E209-1.

2. FINAL FIELD REV
1. REV PLAN-EL 649.0 HEADWALL NO. 2 SEE 101-19E209-1

CHATTANOOGA FLOOD PROTECTION
LEVEE, CHANNEL & DETENTION BASIN
PLANS, PROFILES & SECTIONS
STATION 114+00 TO 157+00
SOUTH CHICKAMAUGA CREEK PROJECT
TENNESSEE VALLEY AUTHORITY
DIVISION OF ENGINEERING DESIGN

INSPECTED AND APPROVED FOR ISSUE	RECOMMENDED	APPROVED
<i>[Signature]</i>	<i>[Signature]</i>	<i>[Signature]</i>
KNOXVILLE 3-30-78	81	c 101-19E209-3 R2

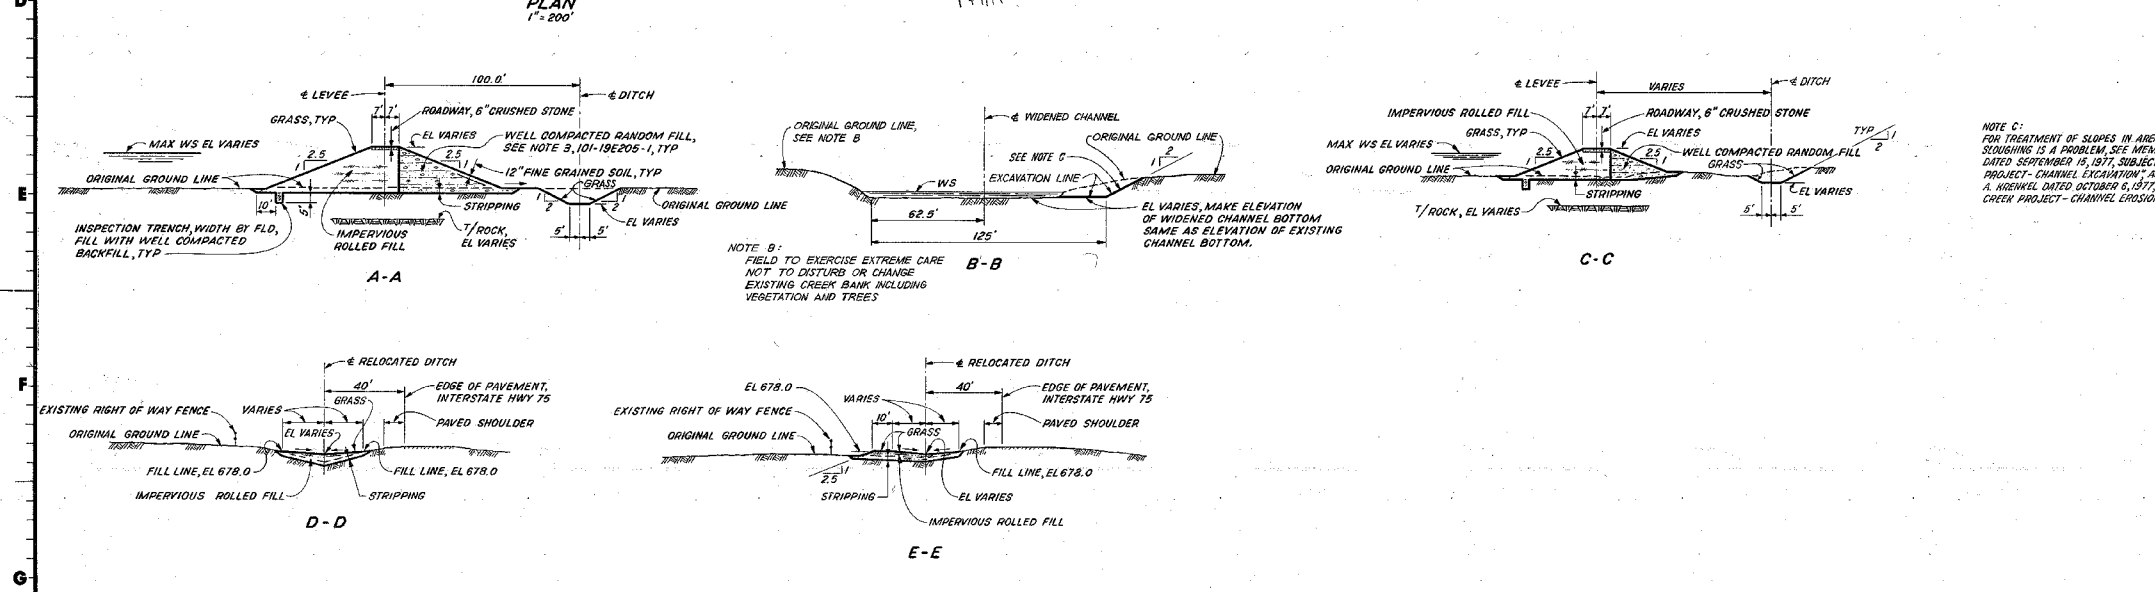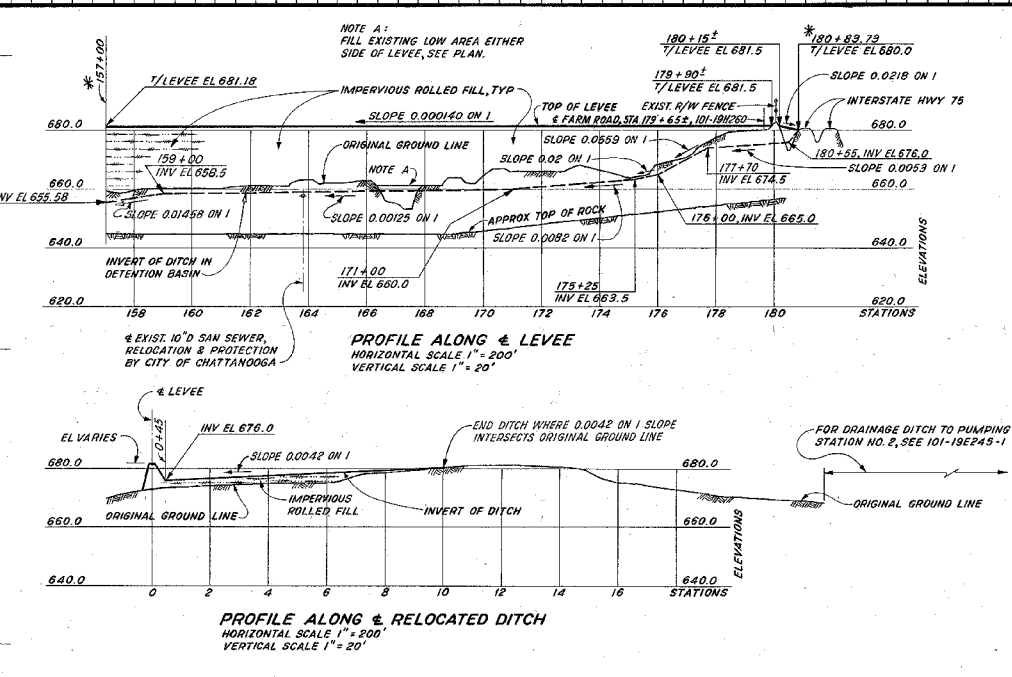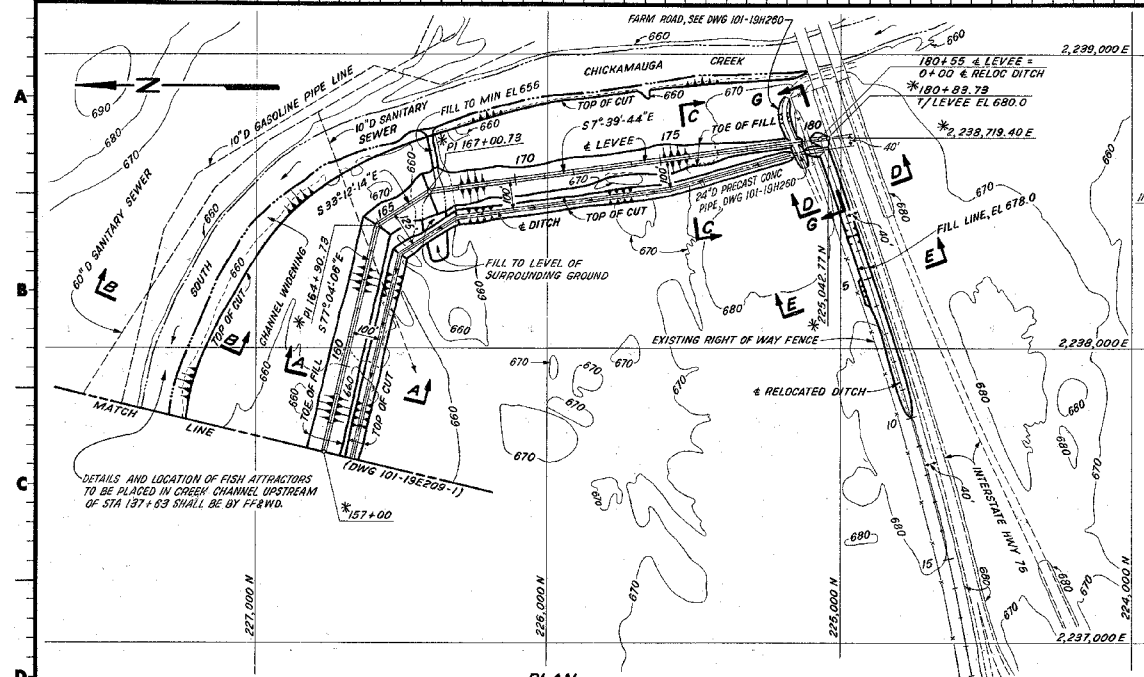

NOTE C:
FOR TREATMENT OF SLOPES IN AREAS NEAR PIPE LINES AND WHERE
SLUGHING IS A PROBLEM, SEE MEMO G.L. BUCHANAN TO GENE FARMER
DATED SEPTEMBER 15, 1977, SUBJECT: SOUTH CHICKAMAUGA CREEK
PROJECT - CHANNEL EXCAVATION AND MEMO G.L. BUCHANAN TO RALPH
A. KREWEK DATED OCTOBER 6, 1977, SUBJECT: SOUTH CHICKAMAUGA
CREEK PROJECT - CHANNEL EROSION.

* = FOR TABLE SHOWING AS-BUILT CENTERLINE
OF LEVEE SEE 101-19E205-1

NOTES:
1. FOR GENERAL NOTES SEE 101-19E205-1 & 101-19E205-2.

4	1-9-88	MM	MM	MM	MM	MM	MM	MM	MM
4	FINAL FIELD REV								
	12-21-78	MM	MM	MM	MM	MM	MM	MM	MM
	REVISED ALIGNMENT OF DITCH IN DETENTION BASIN & ADDED 24" CONC PIPE, A4; DELETED PART OF RELOCATED DITCH, C5; REVISED SLOPE 4. INVERT OF DITCH IN DETENTION BASIN, A9, A10, B9; REVISED 1. INVERT & SLOPE OF RELOCATED DITCH, C7 THRU C10; REVISED C-C; DELETED F-F, F8; ADDED G-G								
2	11-1-78	MM	MM	MM	MM	MM	MM	MM	MM
	REVISED NOTE, B3 AND REVISED INVERT & SLOPE OF DITCH IN DETENTION BASIN, B6, B7 & B8								
1	12-15-78	MM	MM	MM	MM	MM	MM	MM	MM
	ADDED NOTE, D1								
DESIGNER	DATE	DESIGNED BY	CHECKED BY	INSP	APPV	REC'D	ISSUED	DATE	BY
DRN: J.L. MAXEY									
CHD: E.B. CHEN									
APPV: A.C. 200815M, 180-18-02									

CHATTANOOGA FLOOD PROTECTION
LEVEE, CHANNEL & DETENTION BASIN

PLANS, PROFILES & SECTIONS
STATION 157+00 TO 180+83.73






SOUTH CHICKAMAUGA CREEK PROJECT
TENNESSEE VALLEY AUTHORITY
DIVISION OF ENGINEERING DESIGN

SCALE 1" = 30' EXCEPT AS NOTED

INSPECTED AND APPROVED FOR ISSUE	DESIGN PROJECT MANAGER	DATE	BY
E.B. CHEN		6-7-78	81 c 101-19E211 R4

PRINT	H	12	1
SIZE	F	S	1
BY OR PROJ	BY	EL	CE
NO	1	2	3
DATE	12/21/78	1/15/79	1/15/79

X-O-X

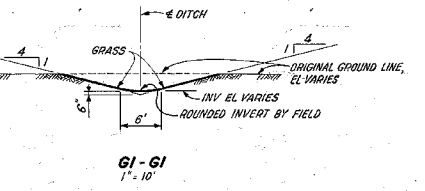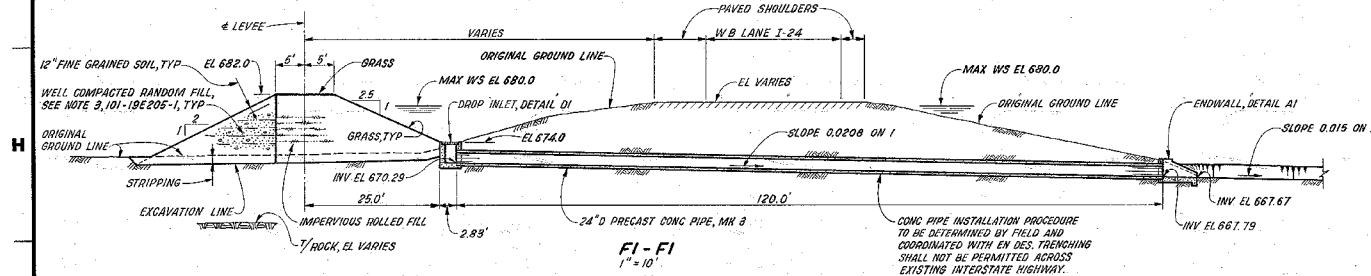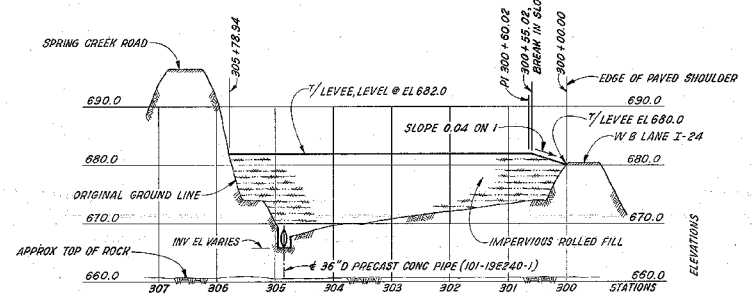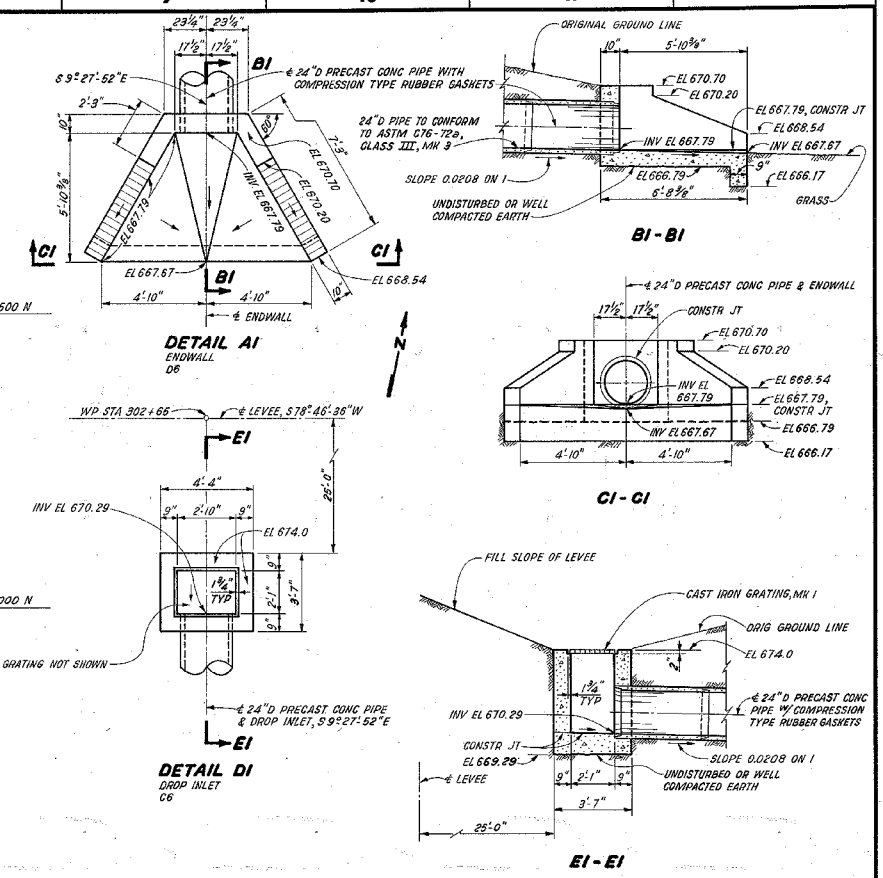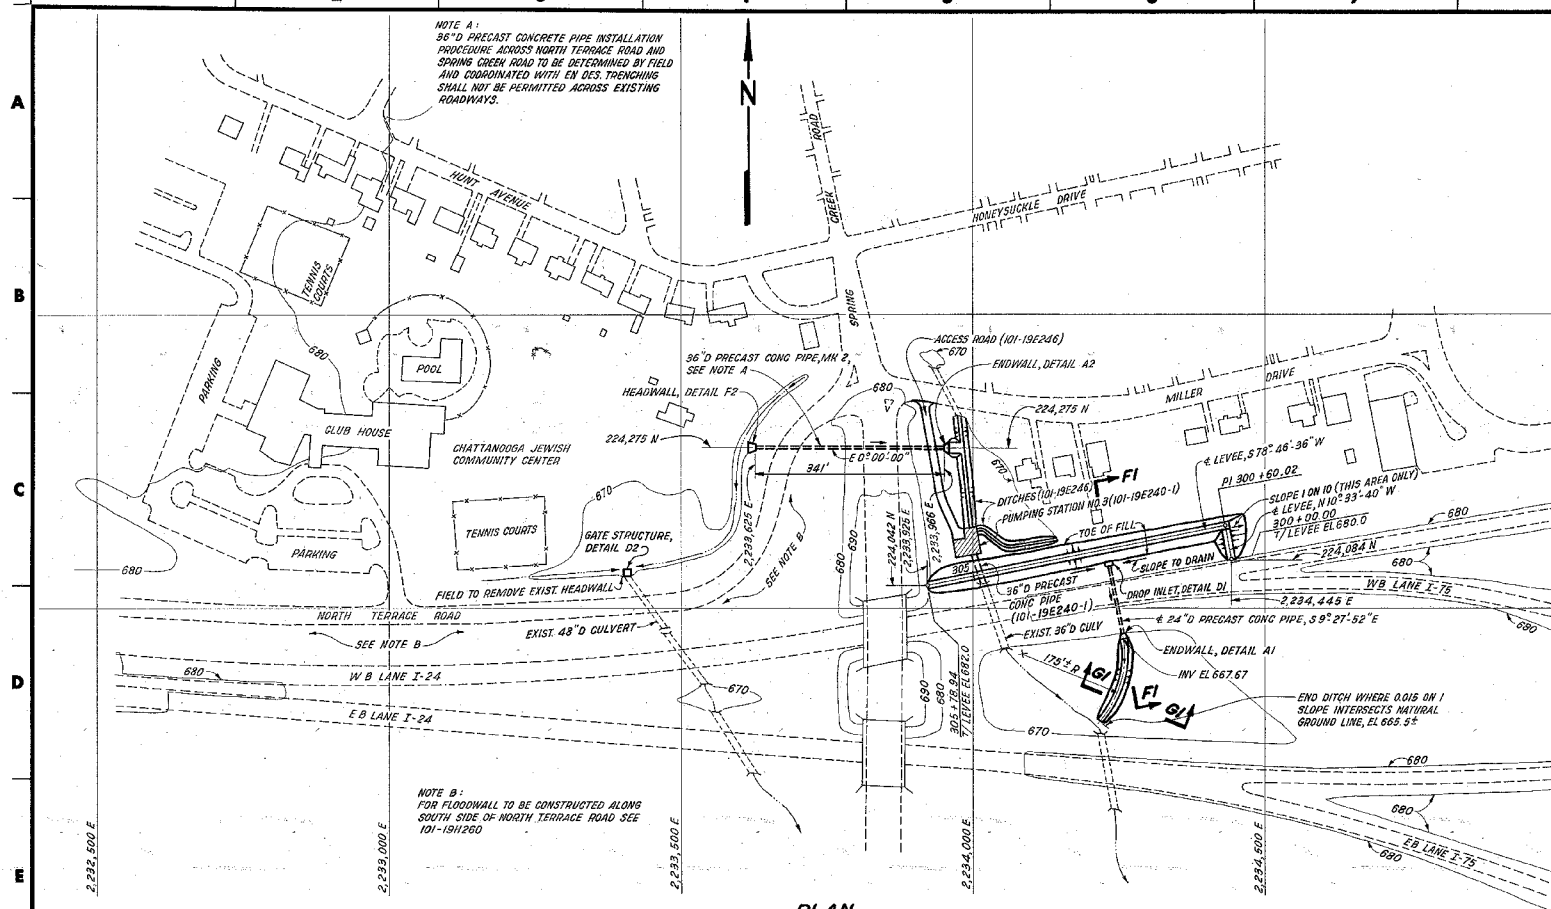

- NOTES:**
1. ALL CONCRETE SHALL BE PLACED IN ACCORDANCE WITH GENERAL CONSTRUCTION SPECIFICATION NO. G-2. CONCRETE SHALL BE CLASS 300.75 AFW.
 2. FORMWORK SHALL BE IN ACCORDANCE WITH GENERAL CONSTRUCTION SPECIFICATION NO. B-8. FORM LINING FOR EXPOSED CONCRETE SURFACES SHALL BE TYPE A OR TYPE D.
 3. CHAMFER ALL EXPOSED EXTERIOR EDGES 3/4".
 4. FOR ADDITIONAL NOTES SEE 101-19E205-1 & 2.

REV. NO.	DATE	DESCRIPTION	BY	CHKD.	APP'D.
1	7-5-78	REMOVED HOLD ON ENDWALL, B5; REVISED DIMENSION, C4; REVISED COORDINATE, C5	JL. MAYHEE	JL. MAYHEE	JL. MAYHEE
2	7-5-78	REMOVED HOLD ON ENDWALL, B5; REVISED DIMENSION, C4; REVISED COORDINATE, C5	JL. MAYHEE	JL. MAYHEE	JL. MAYHEE
3	7-5-78	REMOVED HOLD ON ENDWALL, B5; REVISED DIMENSION, C4; REVISED COORDINATE, C5	JL. MAYHEE	JL. MAYHEE	JL. MAYHEE

CHATTANOOGA FLOOD PROTECTION
LEVEE, CHANNEL & DETENTION BASIN

PLANS, PROFILES & SECTIONS
STATION 300+00 TO 305+78.94
MISC STRUCTURES-OUTLINE

SOUTH CHICKAMAUGA CREEK PROJECT
TENNESSEE VALLEY AUTHORITY
DIVISION OF ENGINEERING DESIGN

SUBMITTED: E. J. DAVENPORT
RECOMMENDED: J. H. WILSON
APPROVED: J. H. WILSON


INSPECTED AND APPROVED FOR ISSUE

KNOXVILLE 7-5-78 81 C 101-19E212-1 R1

SCALE 3/4" = 1'-0" EXCEPT AS NOTED
COMPANION DRAWINGS:
101-19E212-1 & 2

REFERENCE DRAWINGS:
101-19E212-1 - BILL OF MATERIAL

PRINTED AT THE OFFICE OF THE ENGINEER
KNOXVILLE, TENNESSEE

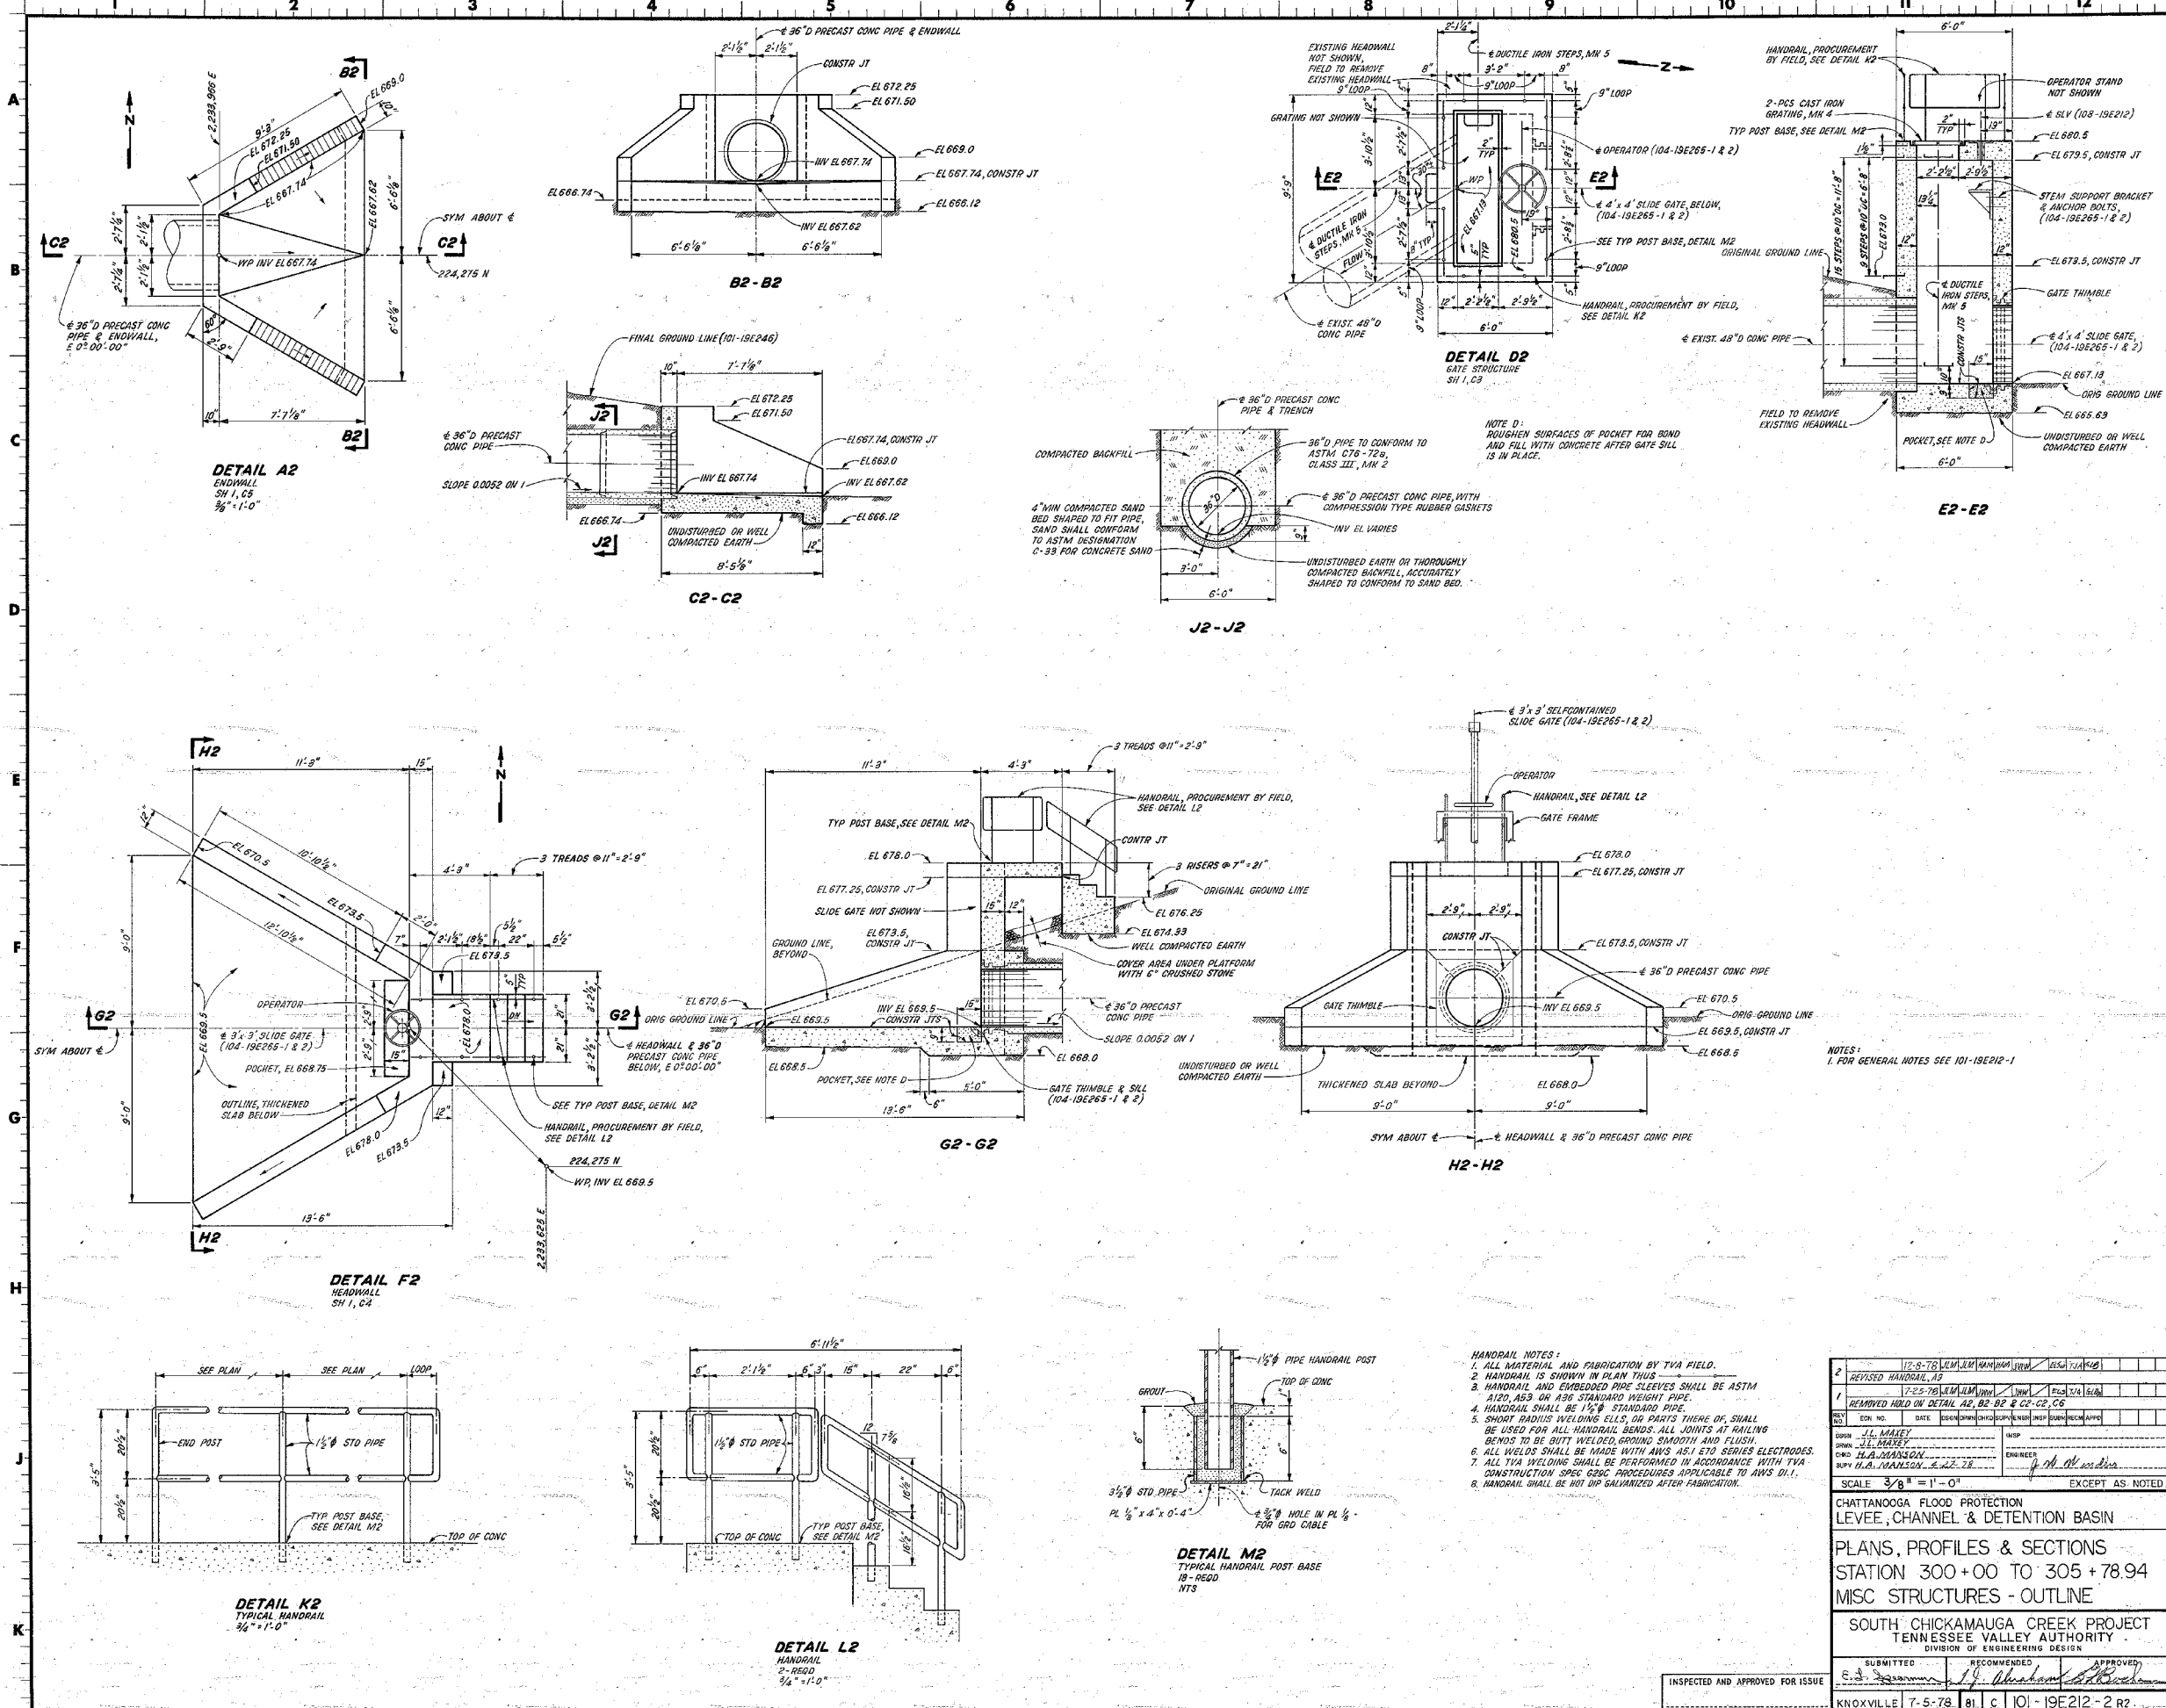


NOTE D:
ROUGHEN SURFACES OF POCKET FOR BOND
AND FILL WITH CONCRETE AFTER GATE SILL
IS IN PLACE.

HANDRAIL NOTES:
1. ALL MATERIAL AND FABRICATION BY TVA FIELD.
2. HANDRAIL IS SHOWN IN PLAN THUS
3. HANDRAIL AND EMBEDDED PIPE SLEEVES SHALL BE ASTM
A192, A53 OR A36 STANDARD WEIGHT PIPE.
4. HANDRAIL SHALL BE 1 1/2" STANDARD PIPE.
5. SHORT RADIUS WELDING ELLS OR PARTS THERE OF SHALL
BE USED FOR ALL HANDRAIL BENDS. ALL JOINTS AT RAILING
BENDS TO BE BUTT WELDED, GRIND SMOOTH AND FLUSH.
6. ALL WELDS SHALL BE MADE WITH AWS A51 E70 SERIES ELECTRODES.
7. ALL TVA WELDING SHALL BE PERFORMED IN ACCORDANCE WITH TVA
CONSTRUCTION SPEC SPEC PROCEDURE APPLICABLE TO AWS D11.
8. HANDRAIL SHALL BE HOT DIP GALVANIZED AFTER FABRICATION.


REVISED HANDRAIL AS	17-5-78	LEWIS	MANSON	MANSON	MANSON	MANSON	MANSON
REMOVED HOLD ON DETAIL A2, B2-B2 & C2-C2, G2	17-5-78	LEWIS	MANSON	MANSON	MANSON	MANSON	MANSON
DATE	DATE	DATE	DATE	DATE	DATE	DATE	DATE
BY	BY	BY	BY	BY	BY	BY	BY
CHKD	CHKD	CHKD	CHKD	CHKD	CHKD	CHKD	CHKD
APP'D	APP'D	APP'D	APP'D	APP'D	APP'D	APP'D	APP'D
SCALE 3/8" = 1'-0"	EXCEPT AS NOTED						

CHATTANOOGA FLOOD PROTECTION
LEVEE, CHANNEL & DETENTION BASIN
PLANS, PROFILES & SECTIONS
STATION 300+00 TO 305+78.94
MISC STRUCTURES - OUTLINE
SOUTH CHICKAMAUGA CREEK PROJECT
TENNESSEE VALLEY AUTHORITY
DIVISION OF ENGINEERING DESIGN


INSPECTED AND APPROVED FOR ISSUE	DATE	BY
DATE	DATE	DATE
DATE	DATE	DATE
DATE	DATE	DATE

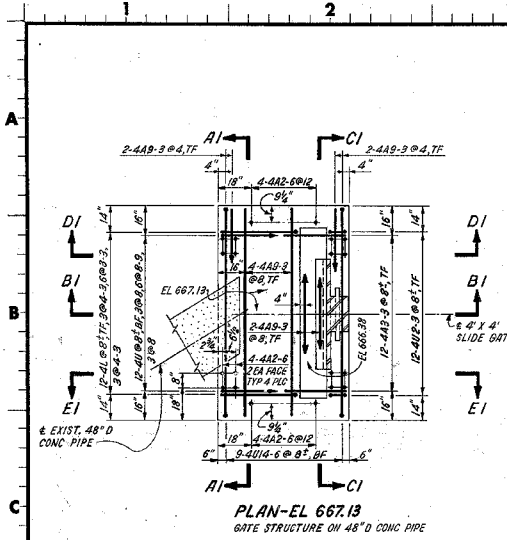


PLAN-EL 667.13
GATE STRUCTURE ON 48" D CONC PIPE

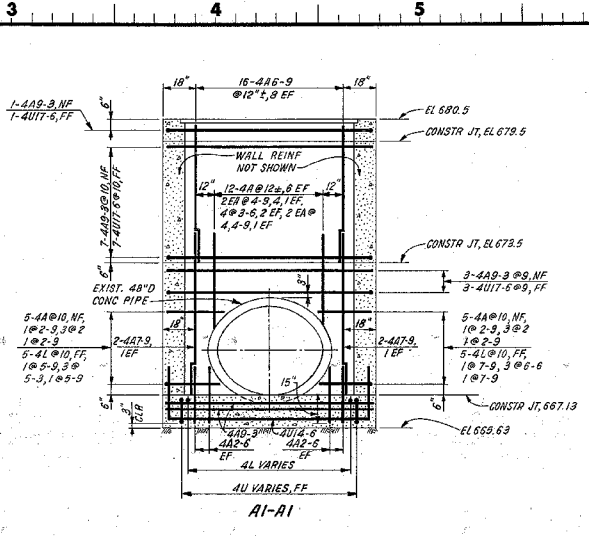


AI-AI

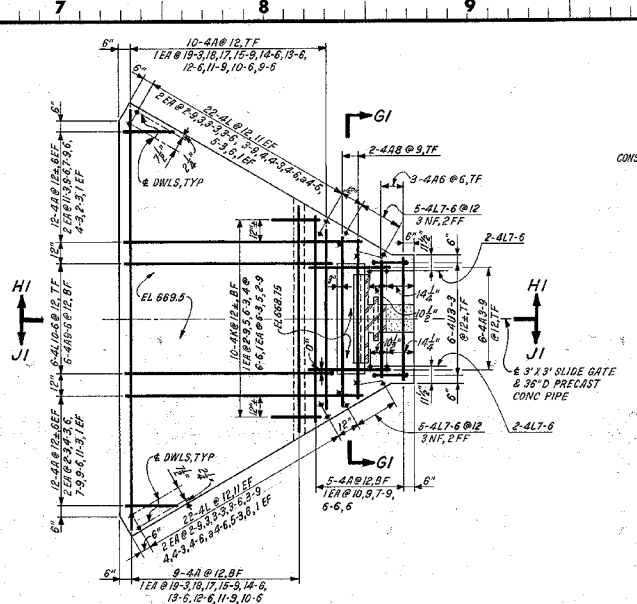


PLAN-EL 669.5
HEADWALL ON 36" D CONC PIPE

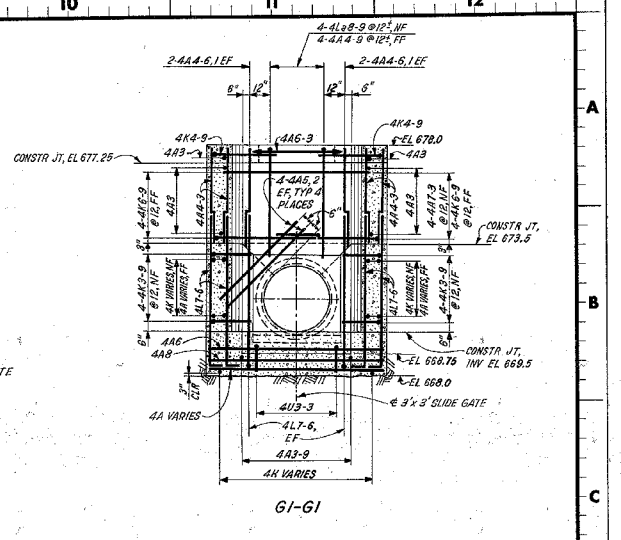

GI-GI

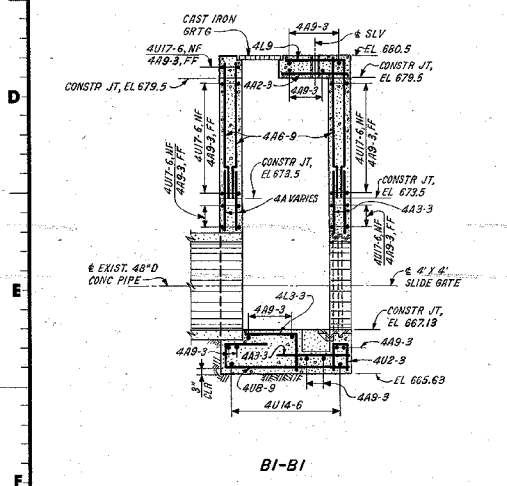


BI-BI

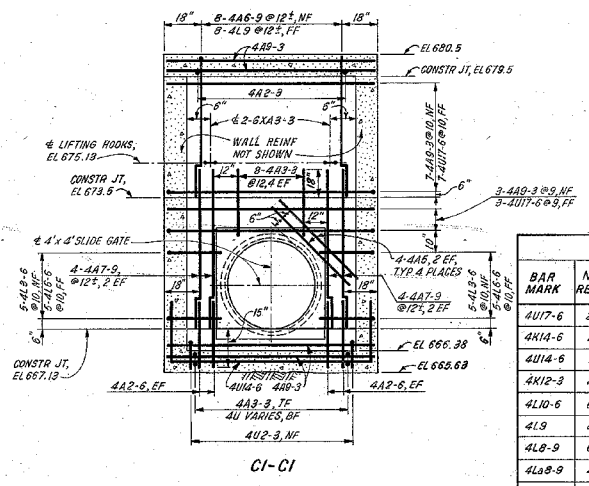


CI-CI


BENT BAR LIST						
BAR MARK	NO.	REQD	a	b	c	d
4U17-6	21	4-1	9-5	EX		
4K14-6	2	1-0	EX		0-10 1/2	
4U14-6	9	2-7	9-4	EX		
4K12-3	2	1-0	EX		0-10 1/2	
4K10-6	6	9-6	EX			
4L9	8	6-10	EX			
4L8-9	6	6-9	EX			
4L8-9-9	4	4-11	EX			
4U8-9	8	2-5	0-9	EX		
4U8	8	1-5	0-11	EX		
4L7-9	2	3-6	EX			
4L7-6	14	5-6	EX			
4K6-9	8	2-7	EX		2-3 1/2	
4K6-6	4	1-6 1/2	EX		1-1	
4L6-6	13	2-3	EX			
4K6-3	2	1-6 1/2	EX		1-1	
4L6	4	4-10	EX			
4L5-9	2	1-7	EX			
4L5-3	7	4-4	EX			
4K5	2	1-6 1/2	EX		1-1	
4K4-9	2	2-7	EX		2-3 1/2	
4K4-9-9	2	1-0	EX		0-10 1/2	
4L4-6	4	3-6	EX			
4L4-4-6	4	3-7	EX			
4L4-3	10	3-3	EX			
4L4	4	3-0	EX			
4K3-9	8	1-5	EX		1-4	
4L3-9	4	2-8	EX			
4L3-6	14	2-6	EX			
4L3-3	10	2-3	EX			
4U8-8	6	0-9	1-9	EX		
4L3	4	1-11	EX			
4K2-9	2	1-6 1/2	EX		1-1	
4L2-9	4	1-8	EX			
4U2-3	12	0-11	0-7	EX		
3XA3-3	2	0-6	1-2 1/2	EX		

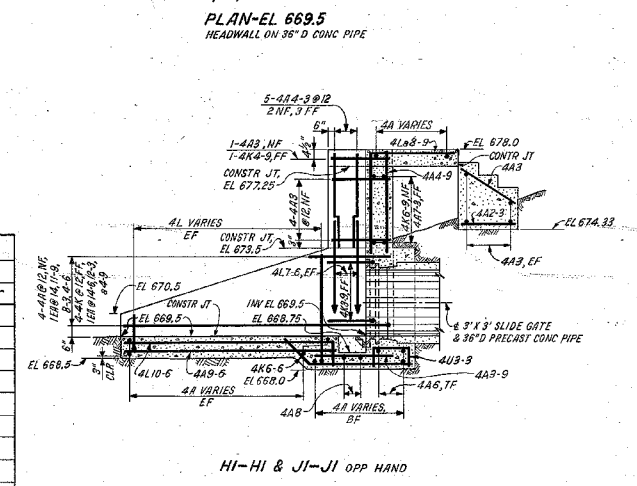


HI-HI & JI-JI OPP HAND

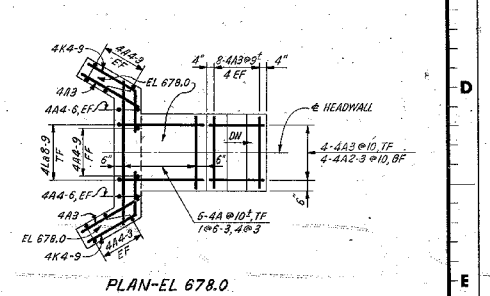


PLAN-EL 678.0

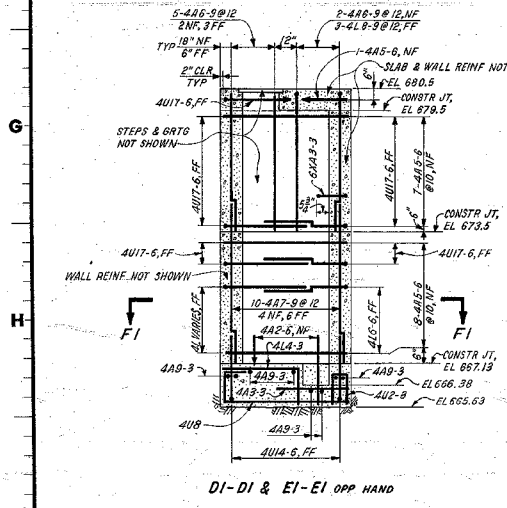


DI-DI & EI-EI OPP HAND

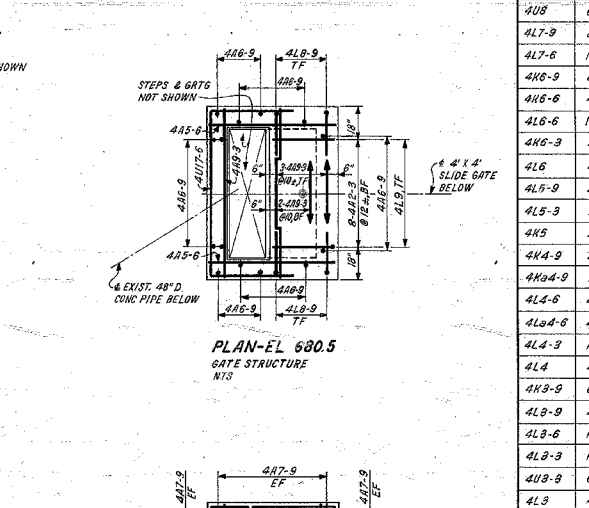

PLAN-EL 680.5
GATE STRUCTURE
N70

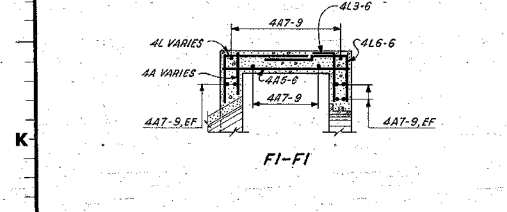

FI-FI

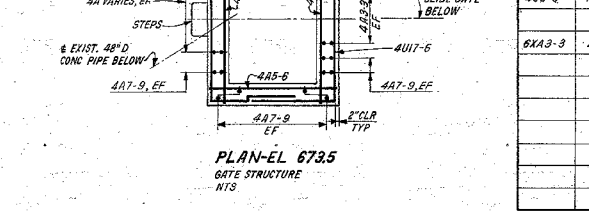

PLAN-EL 673.5
GATE STRUCTURE
N73

NOTES:
 1. ALL REINFORCEMENT ON THIS DRAWING SHALL CONFORM TO ASTM SPECIFICATION A-36 GRADE 60.
 2. WELDING OF OR TO HIGH STRENGTH REINFORCING BARS WITHOUT APPROVAL OF CIVIL ENGINEERING AND DESIGN BRANCH IS PROHIBITED.
 3. THE CLEAR COVER FROM FACE OF CONCRETE TO NEAREST REINFORCING BAR SHALL BE 4" UNLESS OTHERWISE NOTED. ALL OTHER DIMENSIONS ARE TO CENTERLINE OF REINFORCEMENT.

REV	NO.	DATE	BY	CHKD	APP'D
CHATTANOOGA FLOOD PROTECTION LEVEE, CHANNEL & DETENTION BASIN STATION 300+00 TO 305+78.94 MISCELLANEOUS STRUCTURES REINFORCEMENT SOUTH CHICKAMAUGA CREEK PROJECT TENNESSEE VALLEY AUTHORITY DIVISION OF ENGINEERING DESIGN					
SCALE 3/8" = 1'-0" EXCEPT AS NOTED			SUBMITTED RECOMMENDED APPROVED		
INSPECTED AND APPROVED FOR ISSUE KNOXVILLE 7-5-78 81 c 101-19E213-1-r0					

COMPANION DRAWINGS:
101-19E213-1 & 2


INSPECTED AND APPROVED FOR ISSUE

KNOXVILLE 7-5-78 81 c 101-19E213-1-r0


PRINT

SCALE


AS ON PRACTICE EL. CL. TO CE TO HORIZONTAL W. PA. DIMENTS NEGATIVE

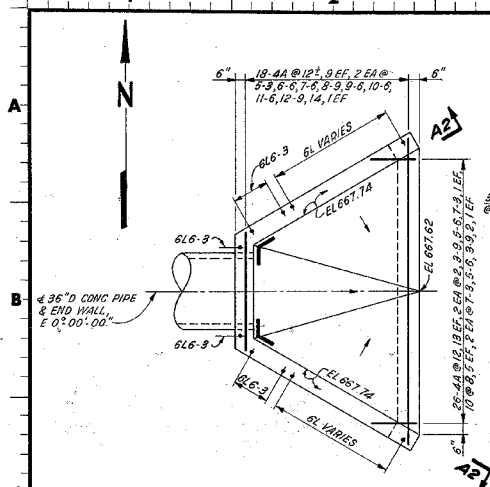


PLAN - EL 667.74
END WALL - 36" D CULVERT

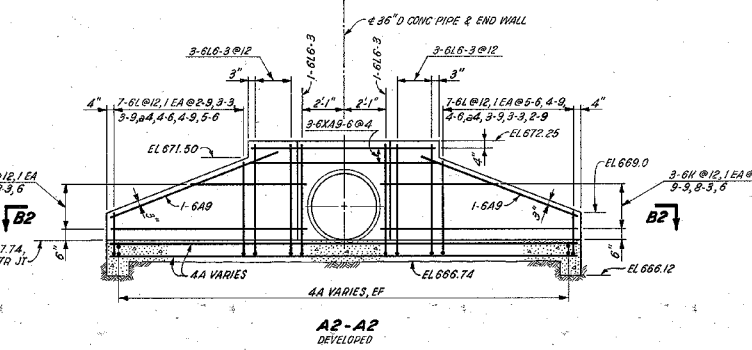


A2-A2
DEVELOPED

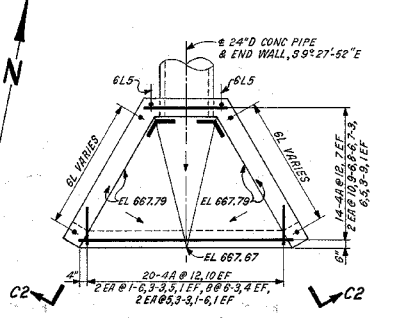


PLAN - EL 667.79
END WALL - 24" D CULVERT

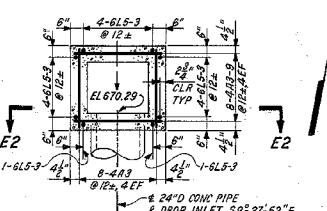


PLAN - EL 670.5
DROP INLET - 24" D CULVERT

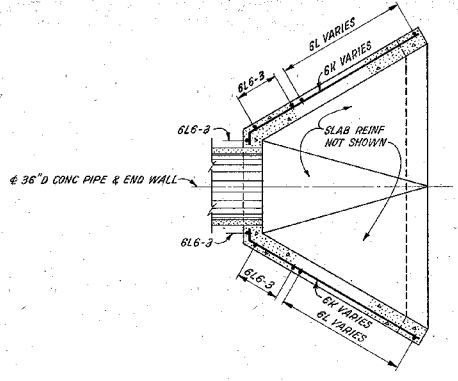


B2-B2
DEVELOPED

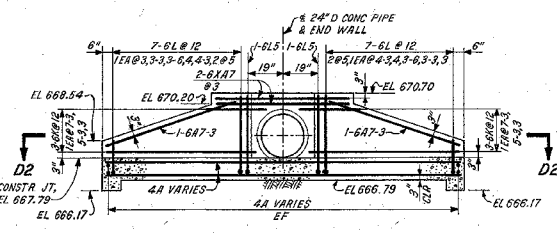

C2-C2
DEVELOPED

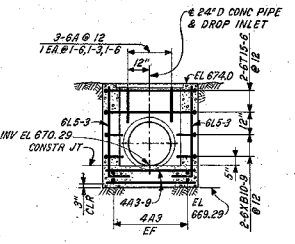


E2-E2
DEVELOPED

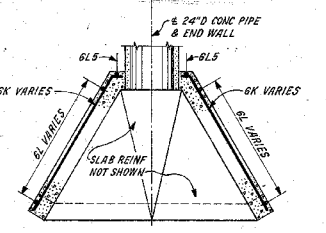

D2-D2
DEVELOPED

BENT BAR LIST						
BAR MARK	NO. REQD	BENDING DIMENSIONS				
		a	b	c	d	e
6K9-9	2	0-11	EX	0-10		
6K9-6	3	2-5	4-11	EX	2-1	
6K8-3	2	0-7	EX	0-6		
6L6-3	6	5-1	EX			
6N6	2	0-11	EX	0-10		
6L5-6	2	4-3	EX			
6T15-6	2	3-3	4-0			
6X10-3	2	0-5	3-3	4-0	EX	
6K7-3	2	2-6	EX	0-5 1/2		
6X17	2	1-11	3-6	EX	1-8 1/2	
6K5-3	2	0-5	EX	0-4 1/2		
6L5-3	14	4-3	EX			
6L5	6	3-6	EX			
6L4-3	2	3-3	EX			
6L4	2	2-10	EX			
6L3-6	2	2-6	EX			
6L3-3	4	2-3	EX			
6K3	2	1-0	EX	0-10 1/2		
6L3	2	1-9	EX			
6L4-9	2	3-10	EX			
6L4-6	2	3-6	EX			
6L4-4	2	3-1	EX			
6L3-9	2	2-8	EX			
6L2-9	2	1-9	EX			

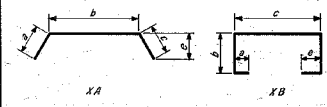

NOTES:
1. FOR GENERAL NOTES SEE 101-19E213-1.

1	7-25-78	REMOVED HOLD, CC & REVISED BENT BAR LIST
REV	NO.	DATE
DESIGN	J.L. MAJEY	
CHECKED	H.A. MADSEN	
APPROVED	J.M. MADSEN	
SCALE	3/8" = 1'-0"	EXCEPT AS NOTED
CHATTANOOGA FLOOD PROTECTION LEVEE, CHANNEL & DETENTION BASIN		
STATION 300+00 TO 305+78.94		
MISCELLANEOUS STRUCTURES REINFORCEMENT		
SOUTH CHICKAMAUGA CREEK PROJECT TENNESSEE VALLEY AUTHORITY DIVISION OF ENGINEERING DESIGN		
SUBMITTED	RECOMMENDED	APPROVED

INSPECTED AND APPROVED FOR ISSUE
KNOXVILLE 7-5-78 01-C 101-19E213-2 R1

PRINTED BY THE T.V. CO. 101-19E213-2 R1

STRAIGHT REINFORCEMENT BAR LIST

(FOR FIELD INFORMATION ONLY)

MADE J.L. MAXEY

FOR DWG. NO. 101-19E213-2 RI

CHKD: HAM 4-26-78 Ro
 11 JWW 7-20-78 R1


SHEET NO 1 OF 1

DATE 4-14-78

PROJECT SOUTH CHICKAMAUGA CREEK

BUILDING MISCELLANEOUS STRUCTURES

BAR SIZE	BAR LENGTH	NO. REQ'D	BAR SIZE	BAR LENGTH	NO. REQ'D	BAR SIZE	BAR LENGTH	NO. REQ'D
6	33-6	30	4	1-6	4			
6	15-3	8						
6	15	4	4	14	2			
6	9	60	4	12-9	2			
6	8-6	4	4	11-6	2			
6	7	68	4	10-6	2			
6	6-6	4						
6	5	4	4	8-9	2			
6	4-3	4	4	8	10			
6	1-6	2	4	7-6	2			
6	1-3	1						
6	7-3	2	4	6-6	2			
6	9	2	4	5-6	4			
4	10	2	4	5-3	2			
4	9-6	4						
4	8-6	2	4	2	4			
4	7-3	8						
4	6-3	8						
4	6	2						
4	5	6						
4	3-9	14						
4	3-3	4						
4	3	8						

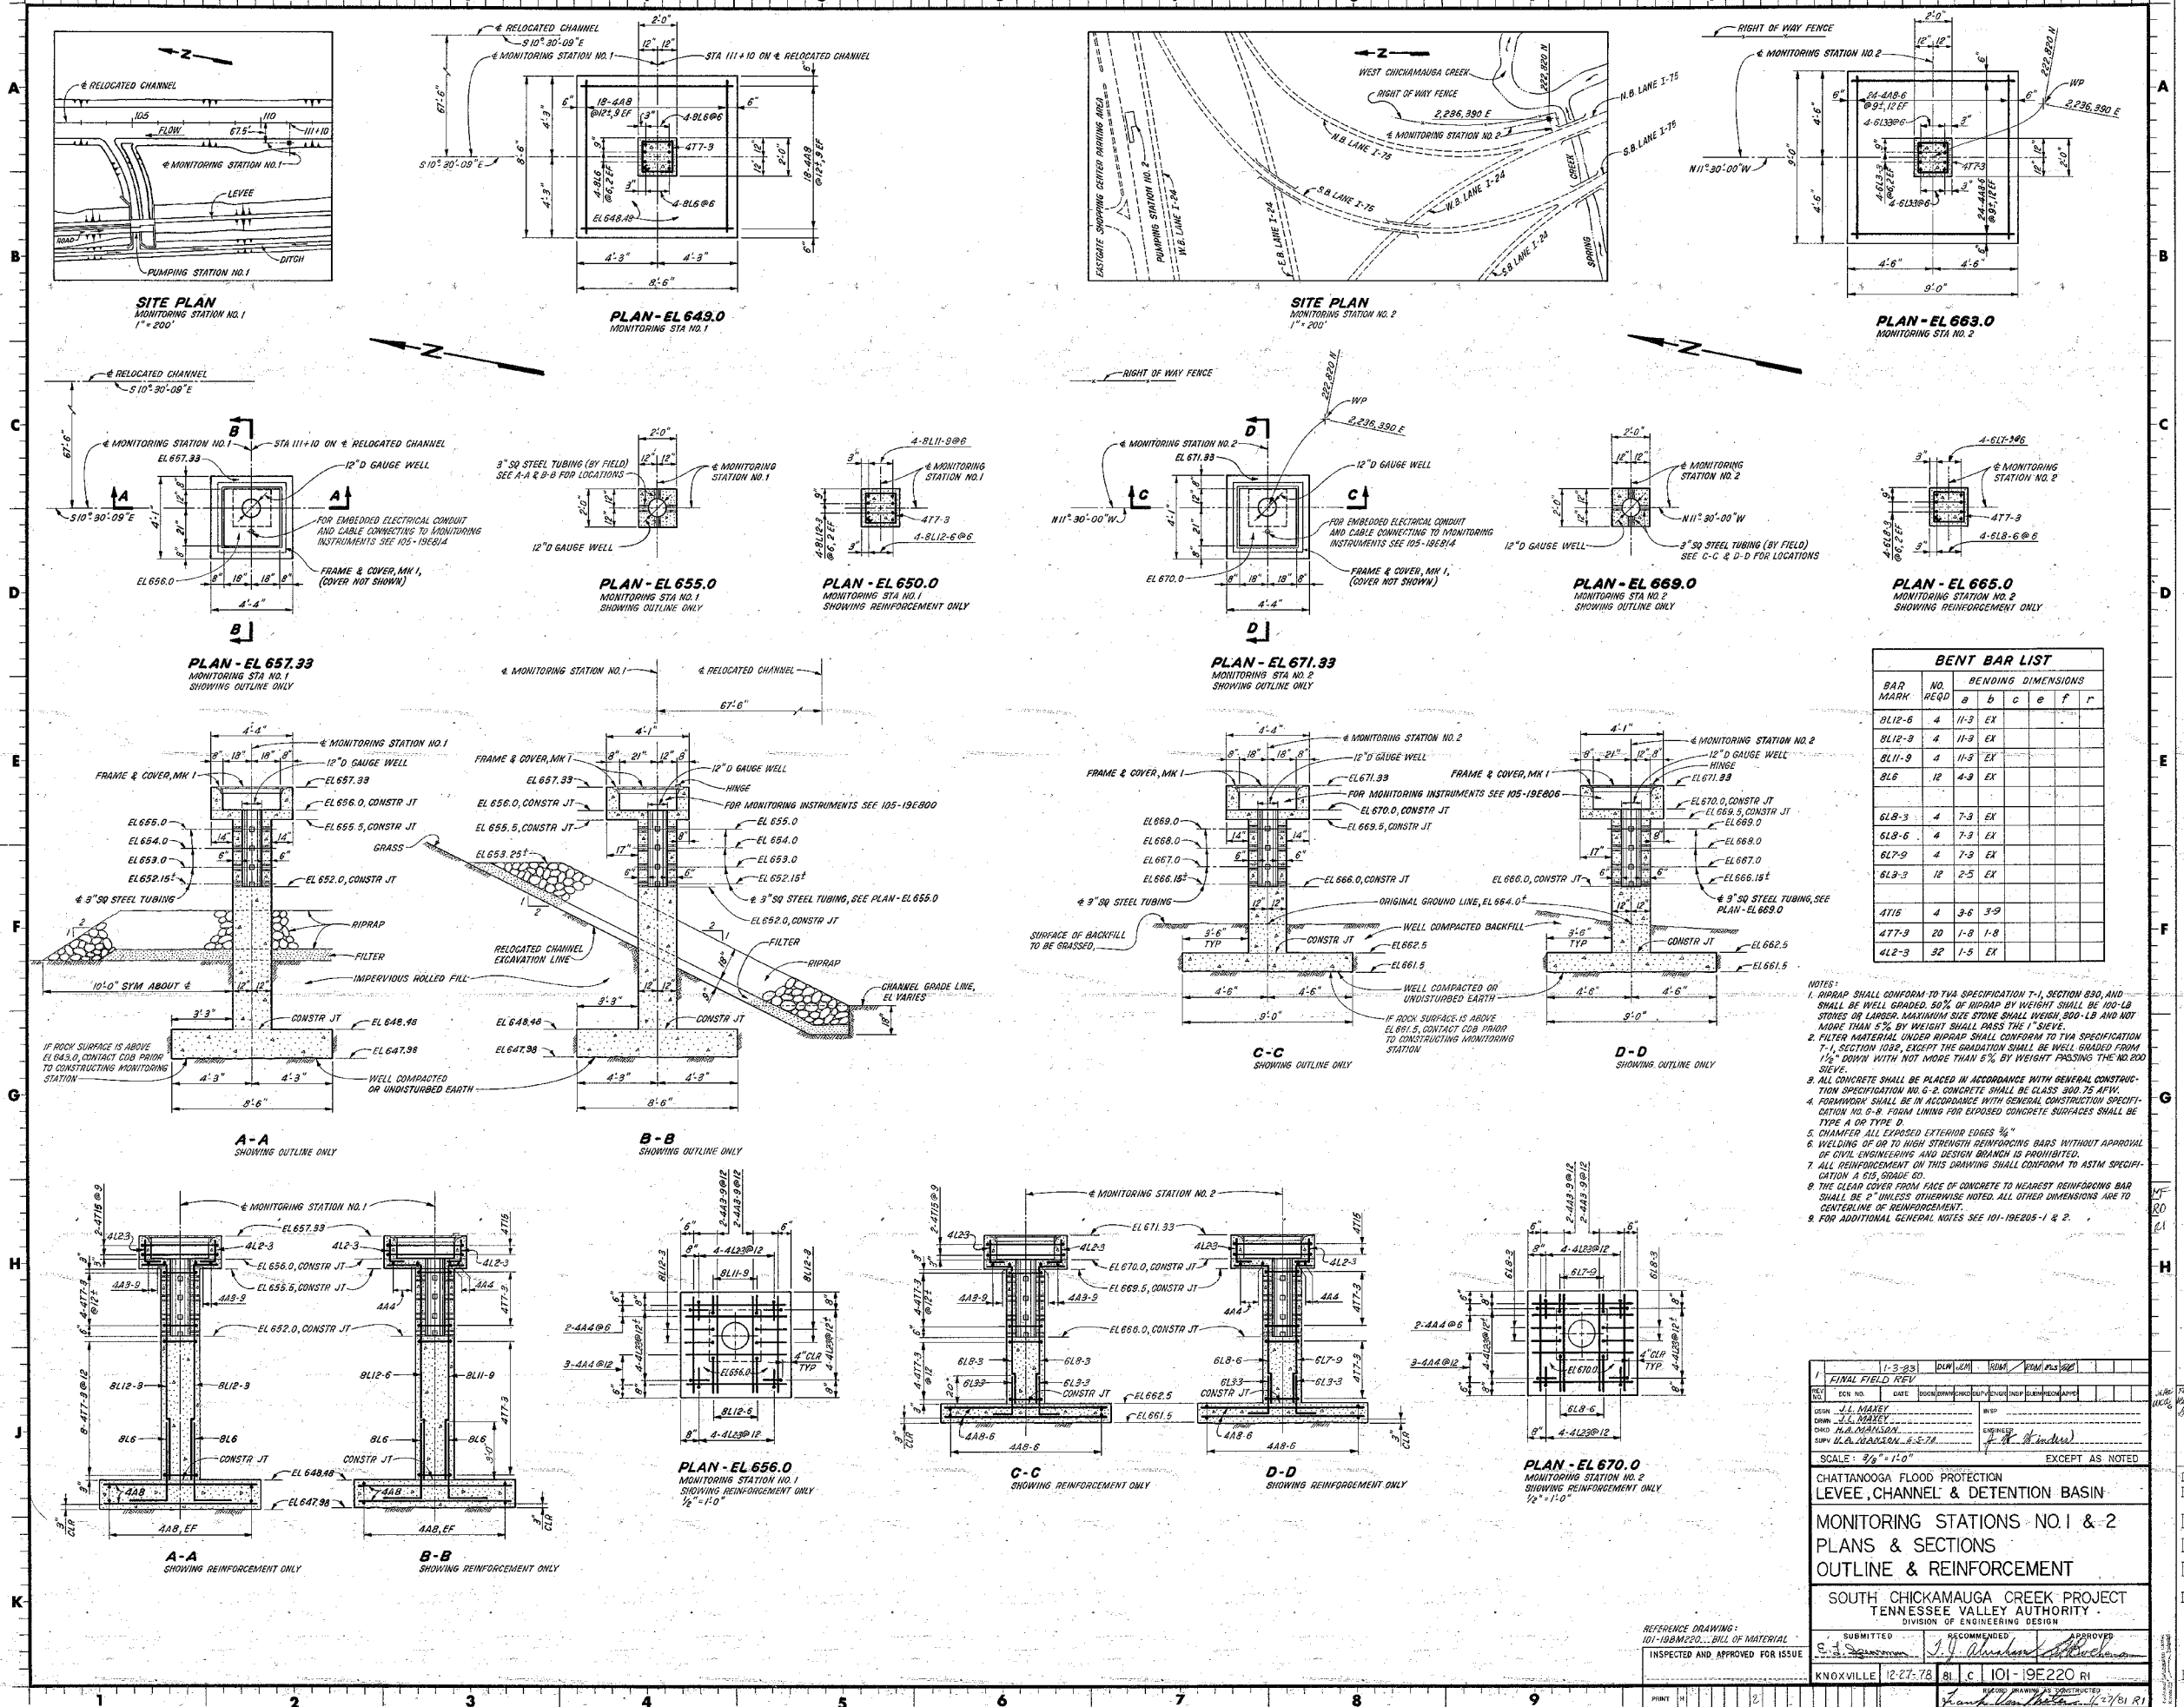

BENT BAR LIST						
BAR MARK	NO. REQD	BENDING DIMENSIONS				
		a	b	c	e	f
8L12-6	4	11-3	EX			
8L12-3	4	11-3	EX			
8L11-9	4	11-3	EX			
8L6	12	4-3	EX			
6L8-3	4	7-3	EX			
6L8-6	4	7-3	EX			
6L7-9	4	7-3	EX			
6L3-3	12	2-5	EX			
4T15	4	3-6	3-9			
4T7-3	20	1-8	1-8			
4L2-3	32	1-5	EX			

- NOTES:
1. RIPRAP SHALL CONFORM TO TVA SPECIFICATION T-1, SECTION B90, AND SHALL BE WELL GRADED. 50% OF RIPRAP BY WEIGHT SHALL BE 100-LB STONES OR LARGER. MAXIMUM SIZE STONE SHALL WEIGH 500-LB AND NOT MORE THAN 5% BY WEIGHT SHALL PASS THE 1" SIEVE.
 2. FILTER MATERIAL UNDER RIPRAP SHALL CONFORM TO TVA SPECIFICATION T-1, SECTION 1032, EXCEPT THE GRADATION SHALL BE WELL GRADED FROM 1/2" DOWN WITH NOT MORE THAN 5% BY WEIGHT PASSING THE NO. 200 SIEVE.
 3. ALL CONCRETE SHALL BE PLACED IN ACCORDANCE WITH GENERAL CONSTRUCTION SPECIFICATION NO. 6-2. CONCRETE SHALL BE CLASS 300.75 AFW.
 4. FORMWORK SHALL BE IN ACCORDANCE WITH GENERAL CONSTRUCTION SPECIFICATION NO. 6-8. FORM LINING FOR EXPOSED CONCRETE SURFACES SHALL BE TYPE A OR TYPE D.
 5. CHAMFER ALL EXPOSED EXTERIOR EDGES 3/4".
 6. WELDING OF OR TO HIGH STRENGTH REINFORCING BARS WITHOUT APPROVAL OF CIVIL ENGINEERING AND DESIGN BRANCH IS PROHIBITED.
 7. ALL REINFORCEMENT ON THIS DRAWING SHALL CONFORM TO ASTM SPECIFICATION A 615, GRADE 60.
 8. THE CLEAR COVER FROM FACE OF CONCRETE TO NEAREST REINFORCING BAR SHALL BE " UNLESS OTHERWISE NOTED. ALL OTHER DIMENSIONS ARE TO CENTERLINE OF REINFORCEMENT.
 9. FOR ADDITIONAL GENERAL NOTES SEE 101-19E205-1 & 2.

1-3-83 DWG. NO. 101-19E220

1 FINAL FIELD REV

DATE: 12-27-78

SCALE: 3/8" = 1'-0" EXCEPT AS NOTED

CHATTANOOGA FLOOD PROTECTION
LEVEE, CHANNEL & DETENTION BASIN

MONITORING STATIONS NO. 1 & 2
PLANS & SECTIONS
OUTLINE & REINFORCEMENT

SOUTH CHICKAMAUGA CREEK PROJECT
TENNESSEE VALLEY AUTHORITY
DIVISION OF ENGINEERING DESIGN

INSPECTED AND APPROVED FOR ISSUE

NO. OF PROJ. ME. EE. AD. CO. TO BE USED FOR PRINTING: 10

PRINTS: 5000-R

STRAIGHT REINFORCEMENT BAR LIST

(FOR FIELD INFORMATION ONLY)

MADE J.L. MAXEY
 CHK'D: HAM

FOR DWG. NO. 101-19E220

SHEET NO 1 OF 1



DATE 12-27-78

PROJECT S. CHICKAMAUGA CREEK

BUILDING MONITORING STATIONS NO. 1 & 2

BAR SIZE	BAR LENGTH	NO. REQ'D	BAR SIZE	BAR LENGTH	NO. REQ'D	BAR SIZE	BAR LENGTH	NO. REQ'D
4	8-6	48						
4	8-0	36						
4	4-0	10						
4	3-9	8						

RF
RD

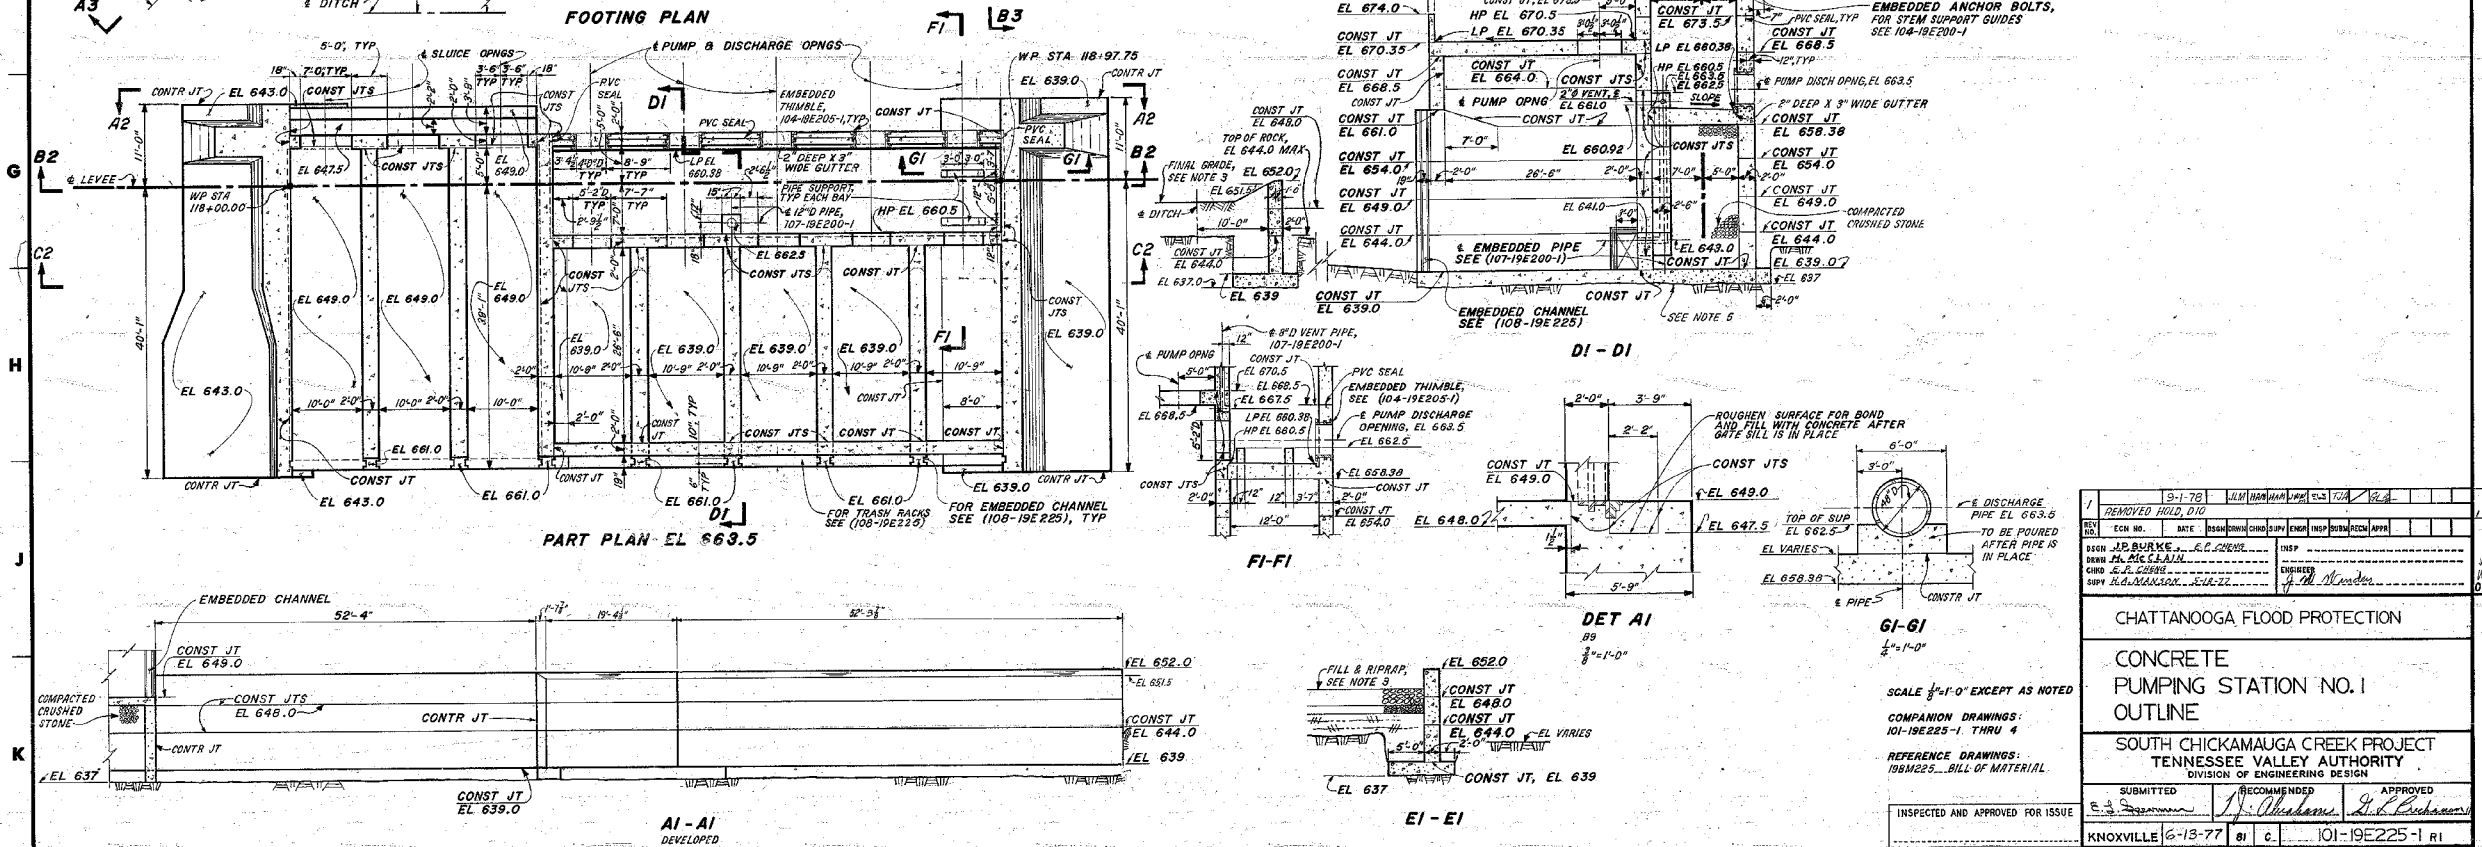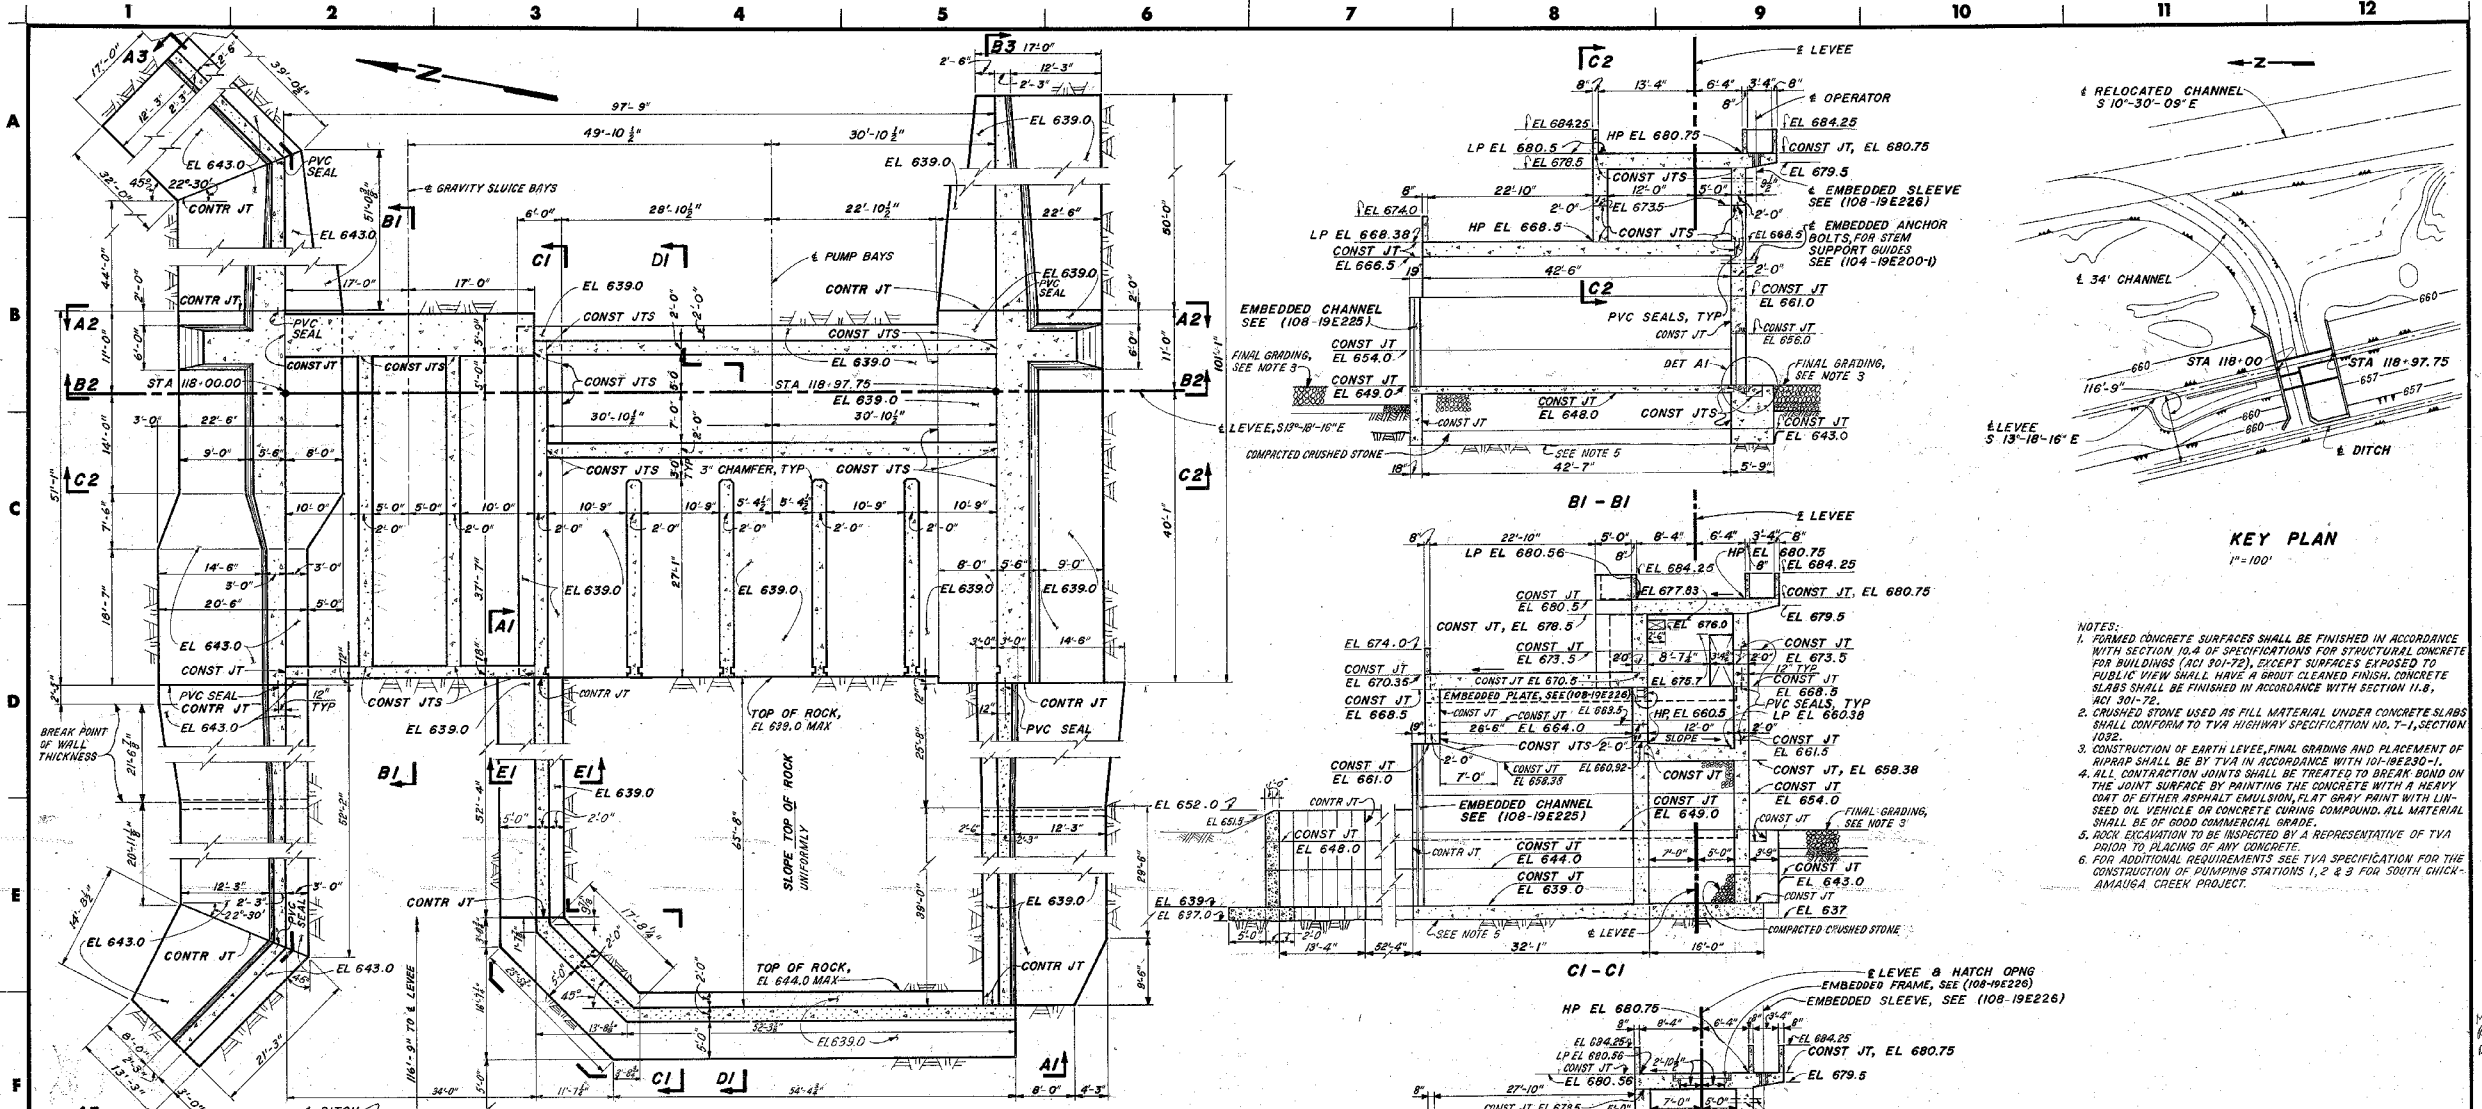

1	REMOVED HOLD, DTD	3-1-75	...
2
3
4
5
6
7
8
9
10
11
12

CHATTANOOGA FLOOD PROTECTION

CONCRETE PUMPING STATION NO. 1 OUTLINE

SOUTH CHICKAMAUGA CREEK PROJECT
TENNESSEE VALLEY AUTHORITY
DIVISION OF ENGINEERING DESIGN

SUBMITTED: *[Signature]* RECOMMENDED: *[Signature]* APPROVED: *[Signature]*


KNOXVILLE 6-13-77 81 c. 101-19225-1 R1

INSPECTED AND APPROVED FOR ISSUE

PRINT II 1/2 2

SIZE P

BY OR PROJ. ENG. OR DES. OR CHECKED BY SW. OR PL. PRINTS: 100-1

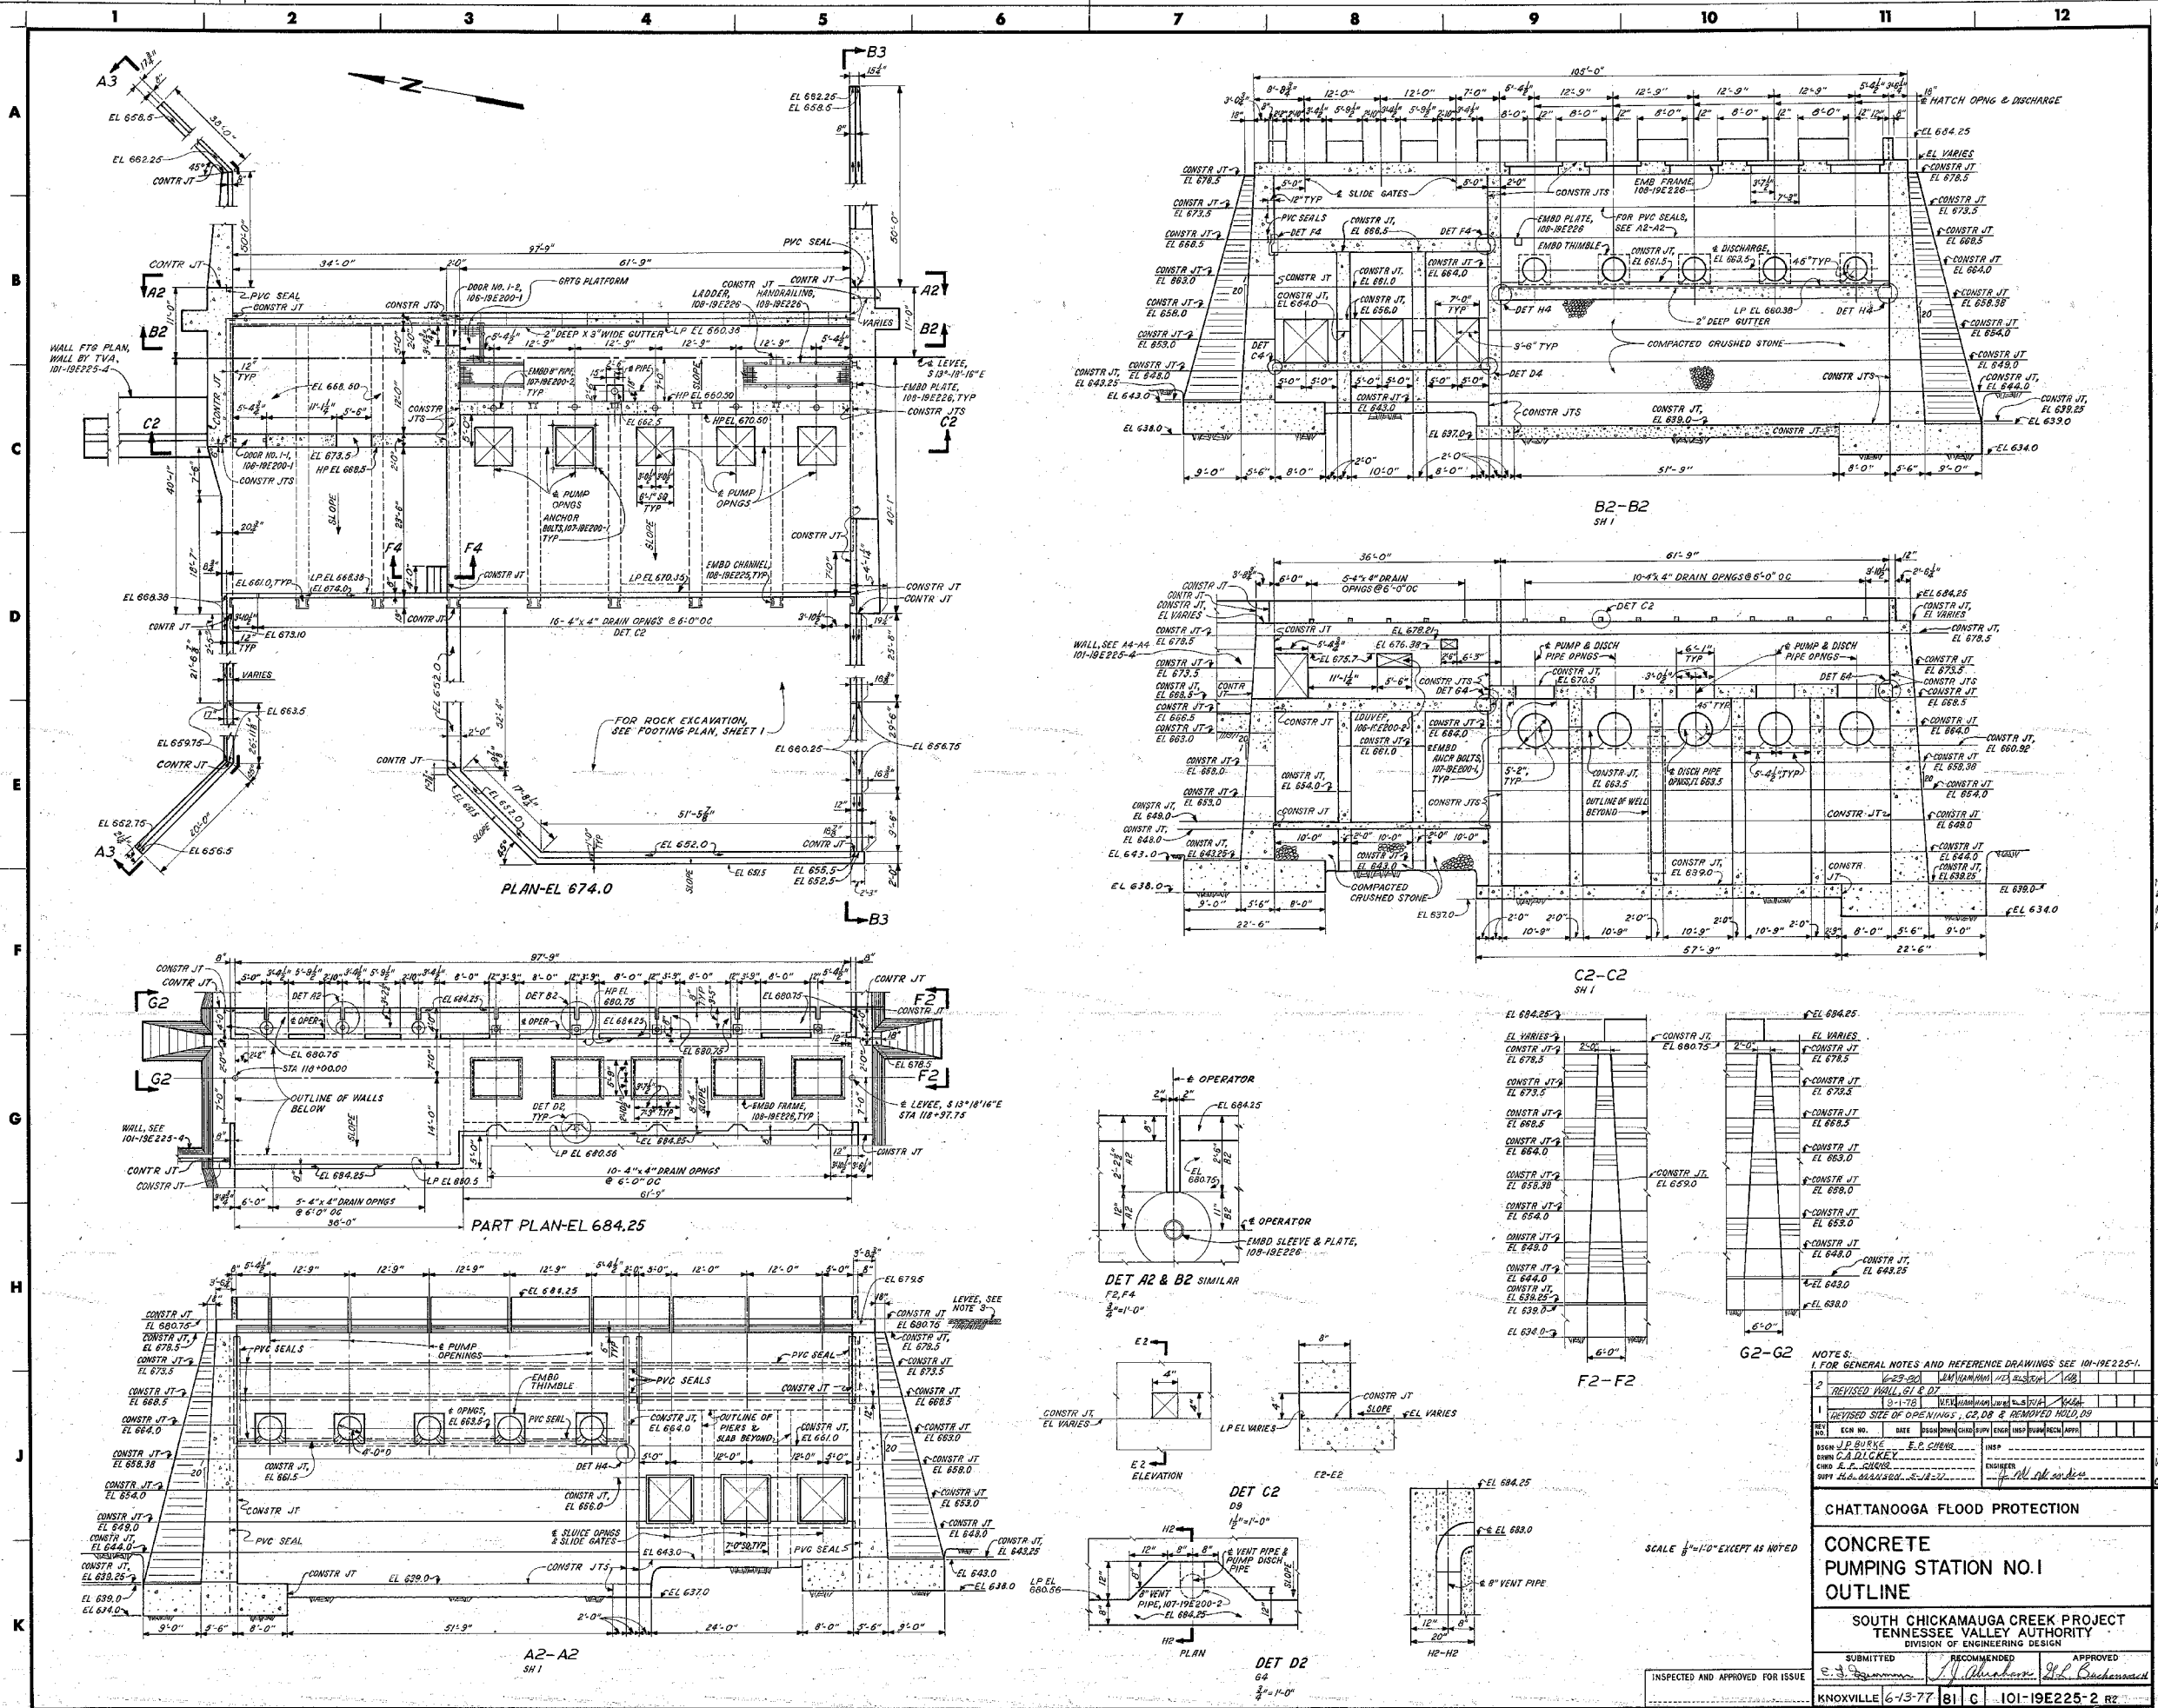

NOTES:
 1. FOR GENERAL NOTES AND REFERENCE DRAWINGS SEE 101-19E225-1.
 2. REVISED WALL, G1 & D7
 3. REVISED SIZE OF OPENINGS, C2, D8 & REMOVED HOLD, D9

NO.	DATE	BY	CHKD	APP'D	REVISION
1	8-29-90	EMM	HAMMILL	WALSH	1/68
2	8-1-78	WEX	HAMMILL	WALSH	1/68

DESIGN: J.P. BURKE, E.C. GIBBS
 CHECK: G.A. CALVEY
 SUPERVISOR: J.L. CHURCH

CHATANOOGA FLOOD PROTECTION
 CONCRETE PUMPING STATION NO. 1
 OUTLINE





SOUTH CHICKAMAUGA CREEK PROJECT
 TENNESSEE VALLEY AUTHORITY
 DIVISION OF ENGINEERING DESIGN

SUBMITTED: [Signature]
 RECOMMENDED: [Signature]
 APPROVED: [Signature]

INSPECTED AND APPROVED FOR ISSUE: [Signature]
 KNOXVILLE 6-13-77

PROJECT NO. 101-19E225-2 R2
 SHEET NO. 81 C

SCALE 1/4"=1'-0" EXCEPT AS NOTED

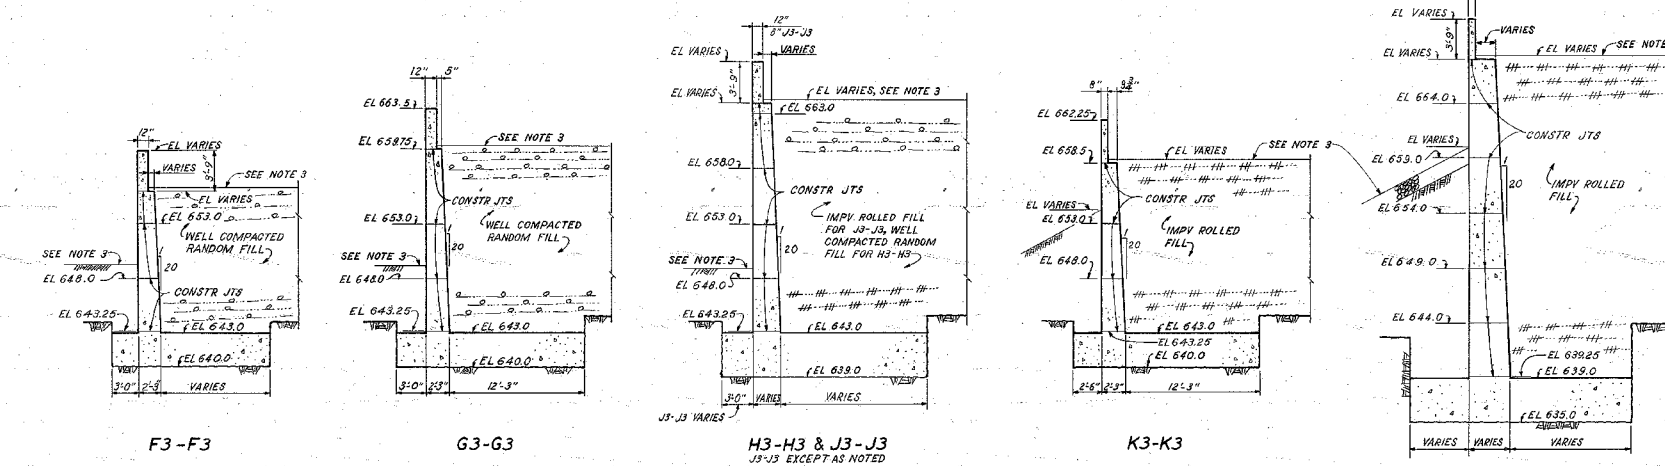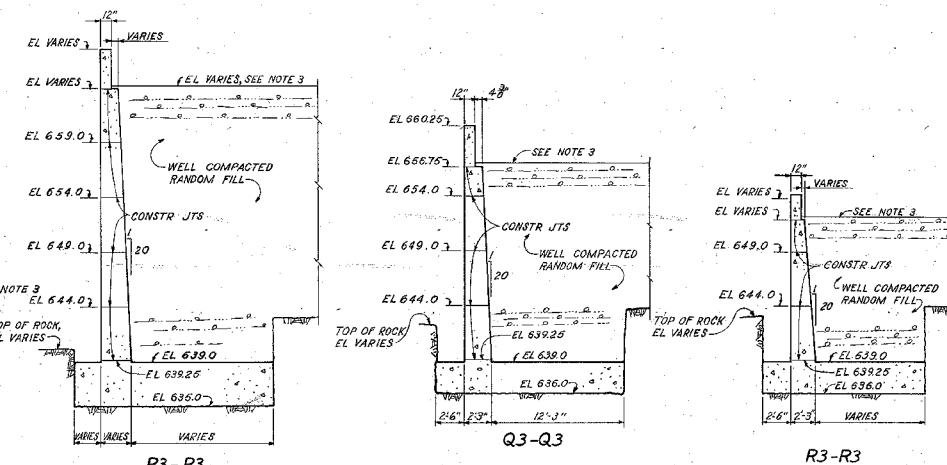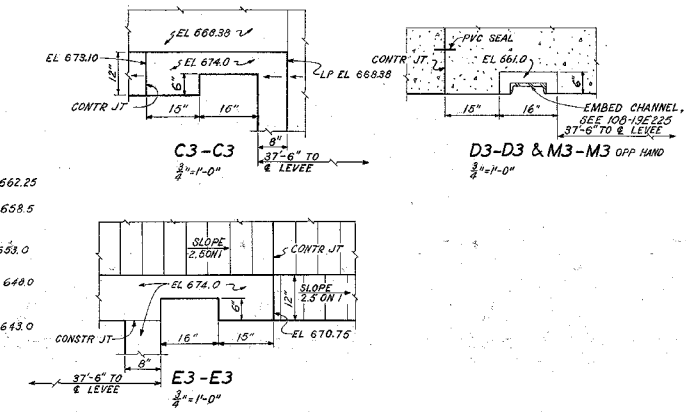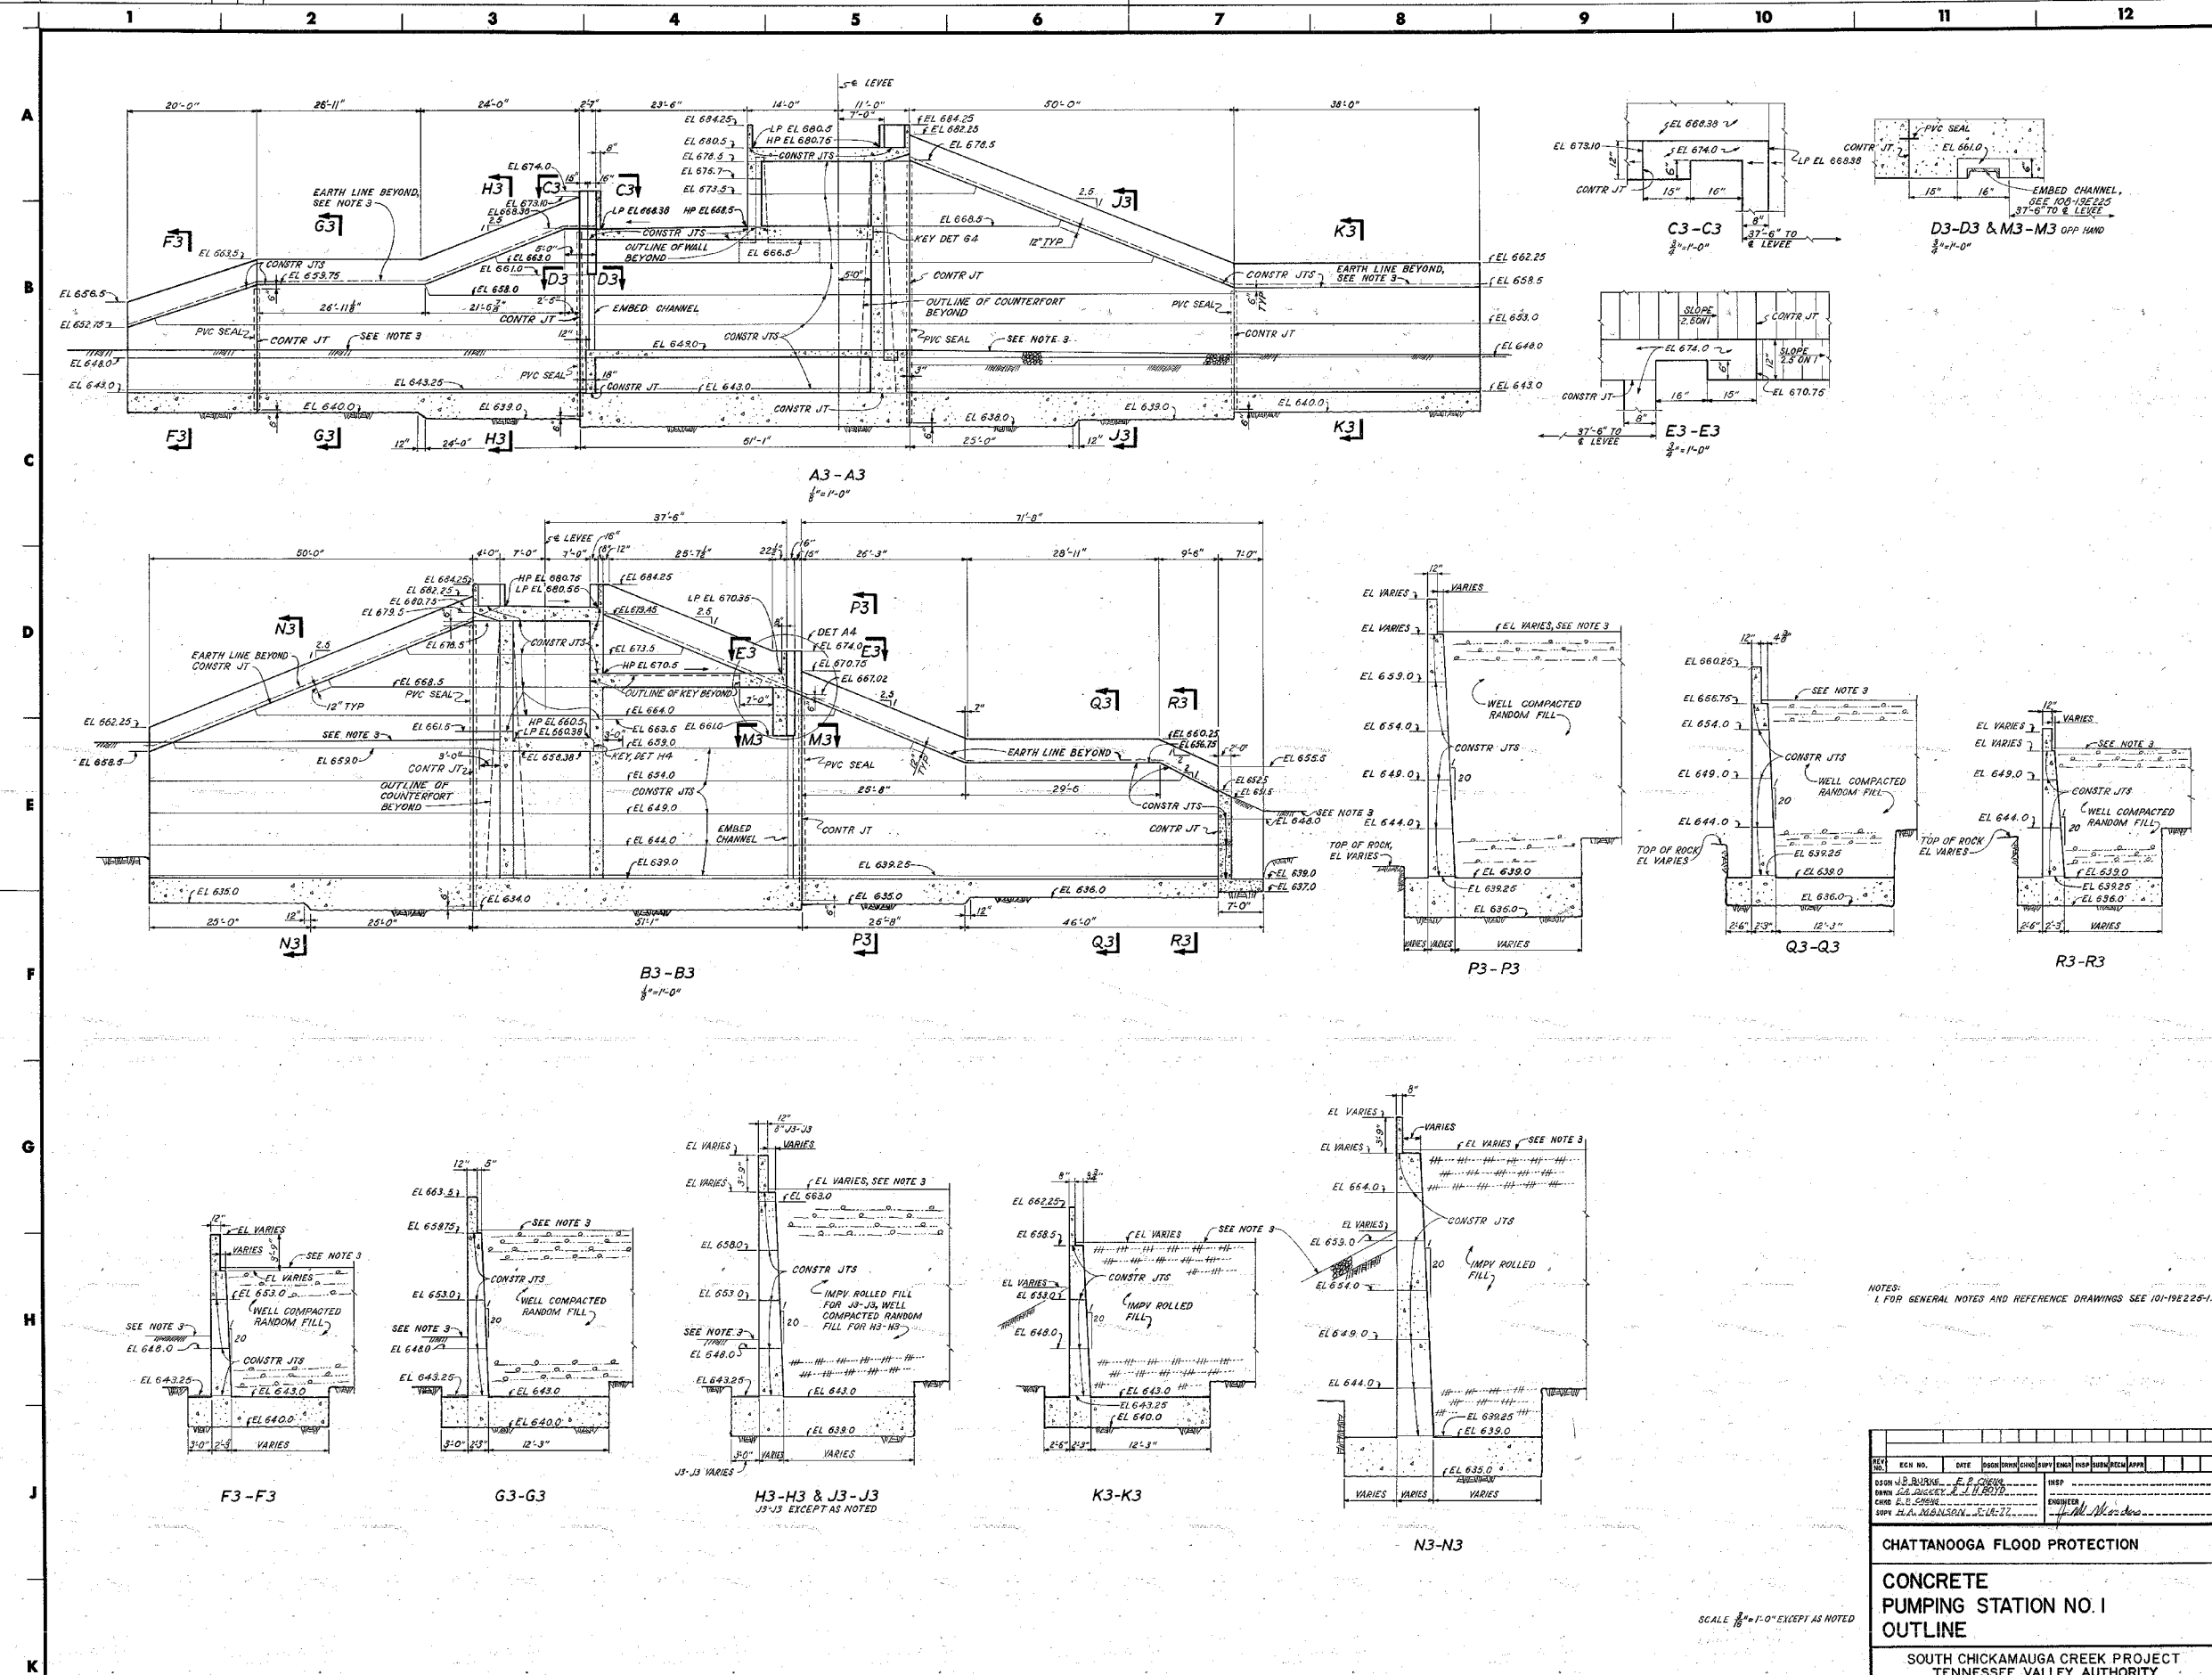

NOTES:
1. FOR GENERAL NOTES AND REFERENCE DRAWINGS SEE 101-19E225-1.

REV	NO.	DATE	BY	CHKD	APPD
03	1	8/20/03	E.P. COOPER		
04	2	8/20/03	E.P. COOPER		
05	3	8/20/03	E.P. COOPER		

DESIGNED BY: E.P. COOPER
 DRAWN BY: E.P. COOPER
 CHECKED BY: E.P. COOPER
 IN CHARGE: E.P. COOPER












CHATTANOOGA FLOOD PROTECTION
CONCRETE PUMPING STATION NO. 1
 OUTLINE

SOUTH CHICKAMAUGA CREEK PROJECT
 TENNESSEE VALLEY AUTHORITY
 DIVISION OF ENGINEERING DESIGN

SUBMITTED: E.P. COOPER
 RECOMMENDED: J. J. BARNETT
 APPROVED: J. J. BARNETT

SCALE 1/8" = 1'-0" EXCEPT AS NOTED

INSPECTED AND APPROVED FOR ISSUE	KNOXVILLE 6-13-77	81	C. 101-19E225-3 RO
PRINT	1	2	2
SIZE	1	2	2

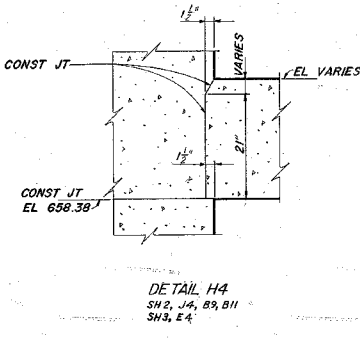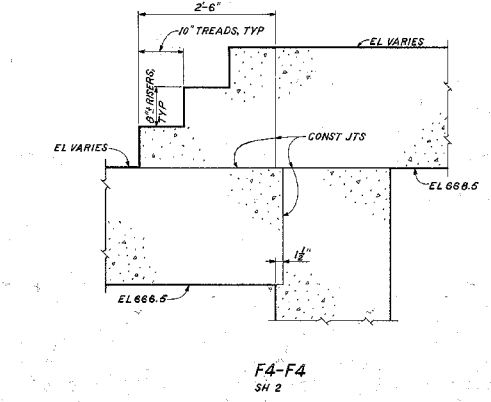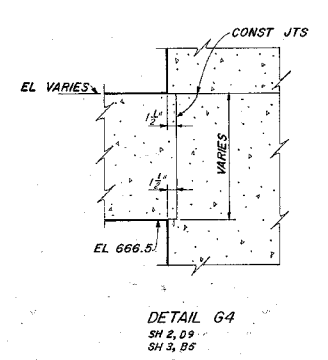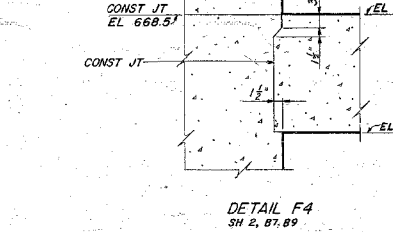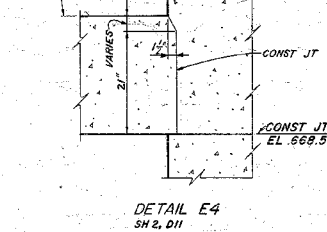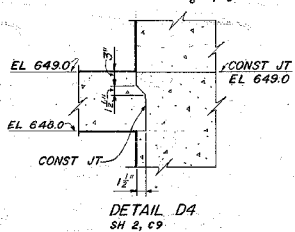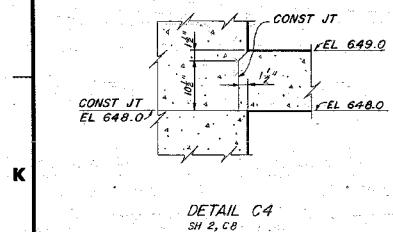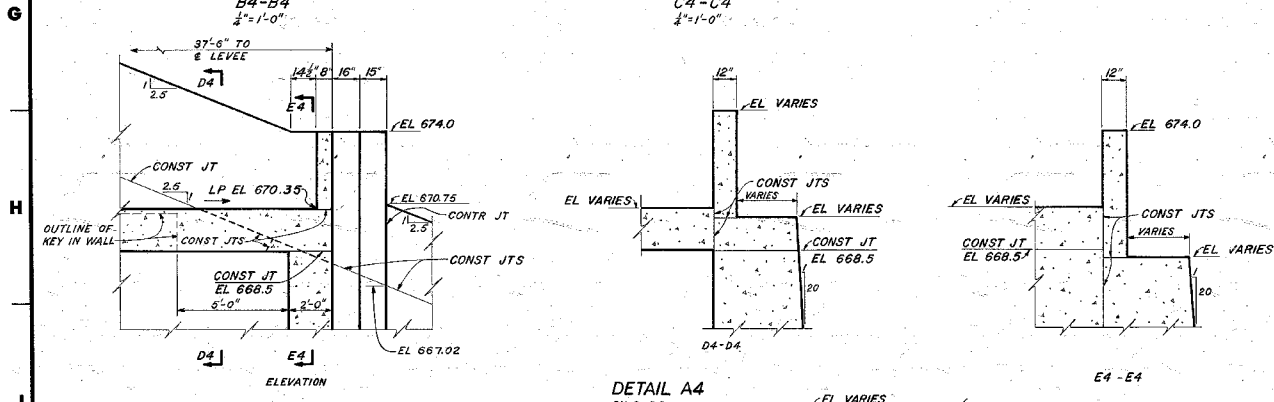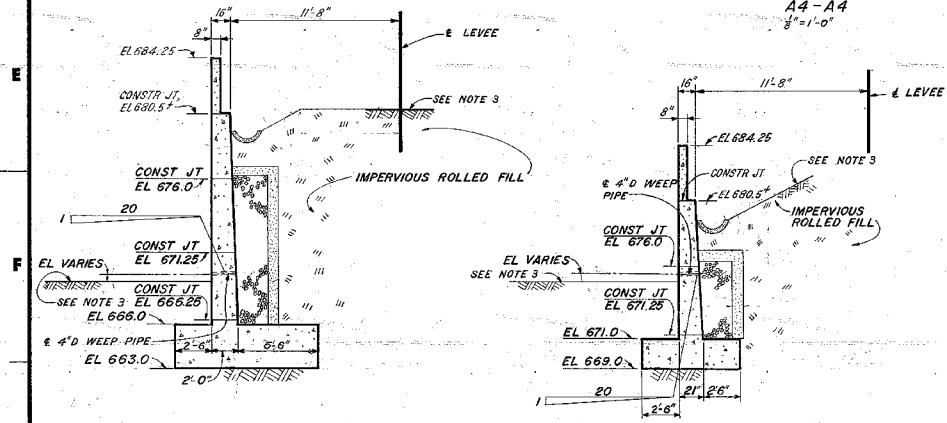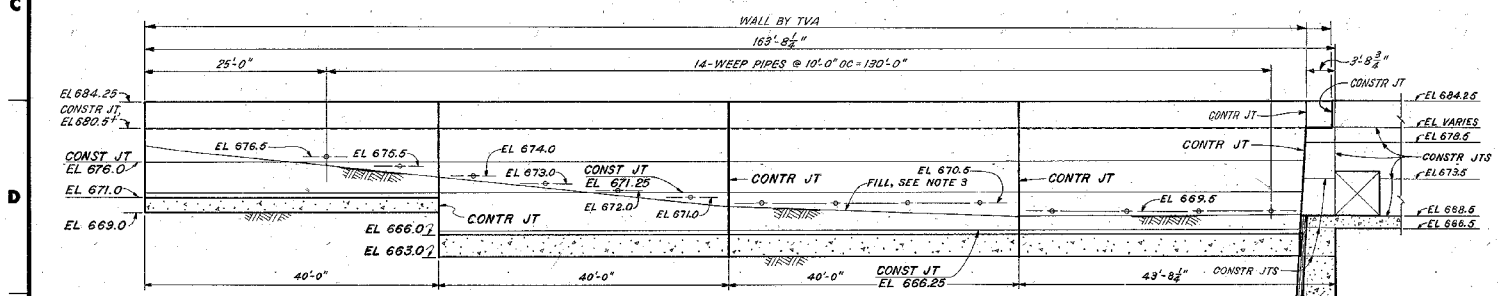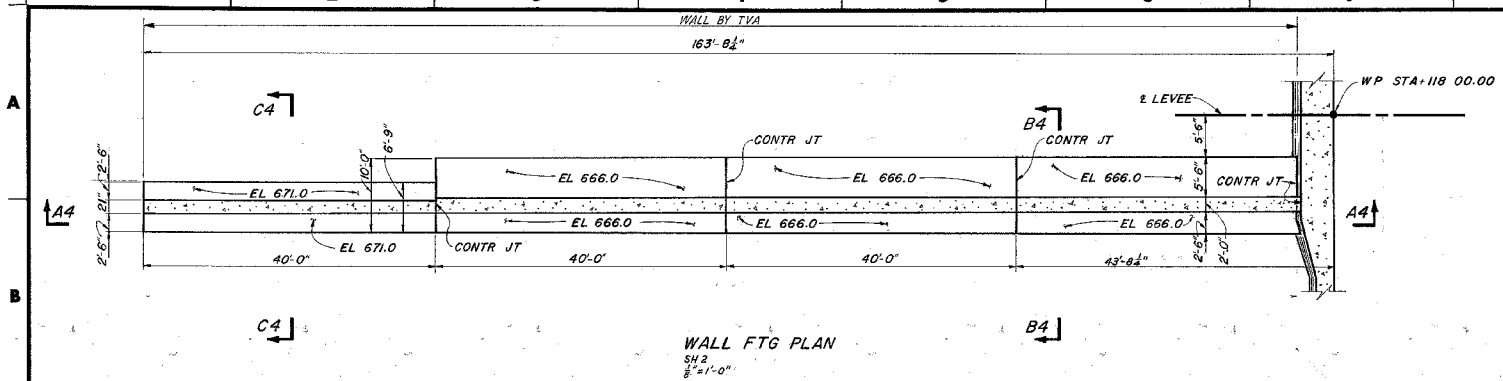

NOTES:
1. FOR GENERAL NOTES AND REFERENCE DRAWINGS SEE 101-19E225-1.

REV	NO.	DATE	BY	CHECKED	APPROVED
1	REVISED WALL DETAIL				
2					
3					
4					
5					
6					
7					
8					
9					
10					
11					
12					

CHATTANOOGA FLOOD PROTECTION
CONCRETE PUMPING STATION NO. 1
OUTLINE
SOUTH CHICKAMAUGA CREEK PROJECT
TENNESSEE VALLEY AUTHORITY
DIVISION OF ENGINEERING DESIGN



SUBMITTED: [Signature] RECOMMENDED: [Signature] APPROVED: [Signature]

KNOXVILLE 613-77 BI C 101-19E225-4RI

SCALE 1"=1'-0" EXCEPT AS NOTED


INSPECTED AND APPROVED FOR ISSUE

PRINT	H	1	2	3	4	5	6	7	8	9	10	11	12
SIZE													

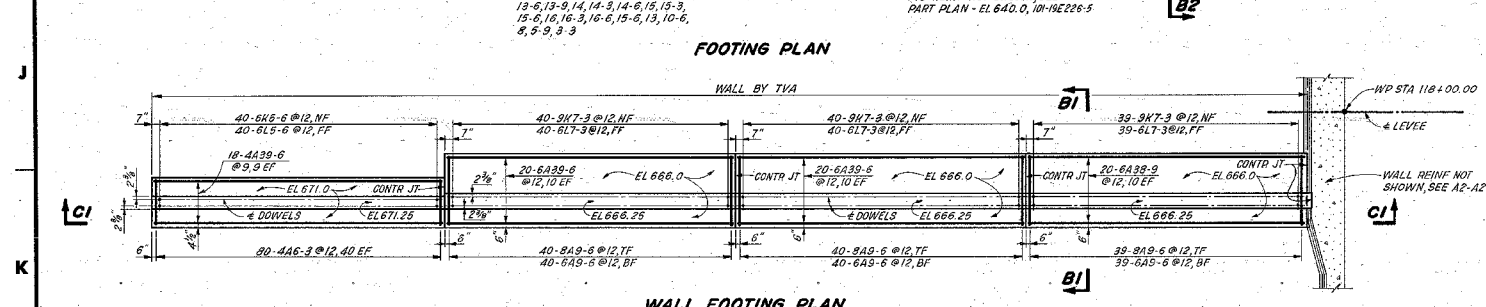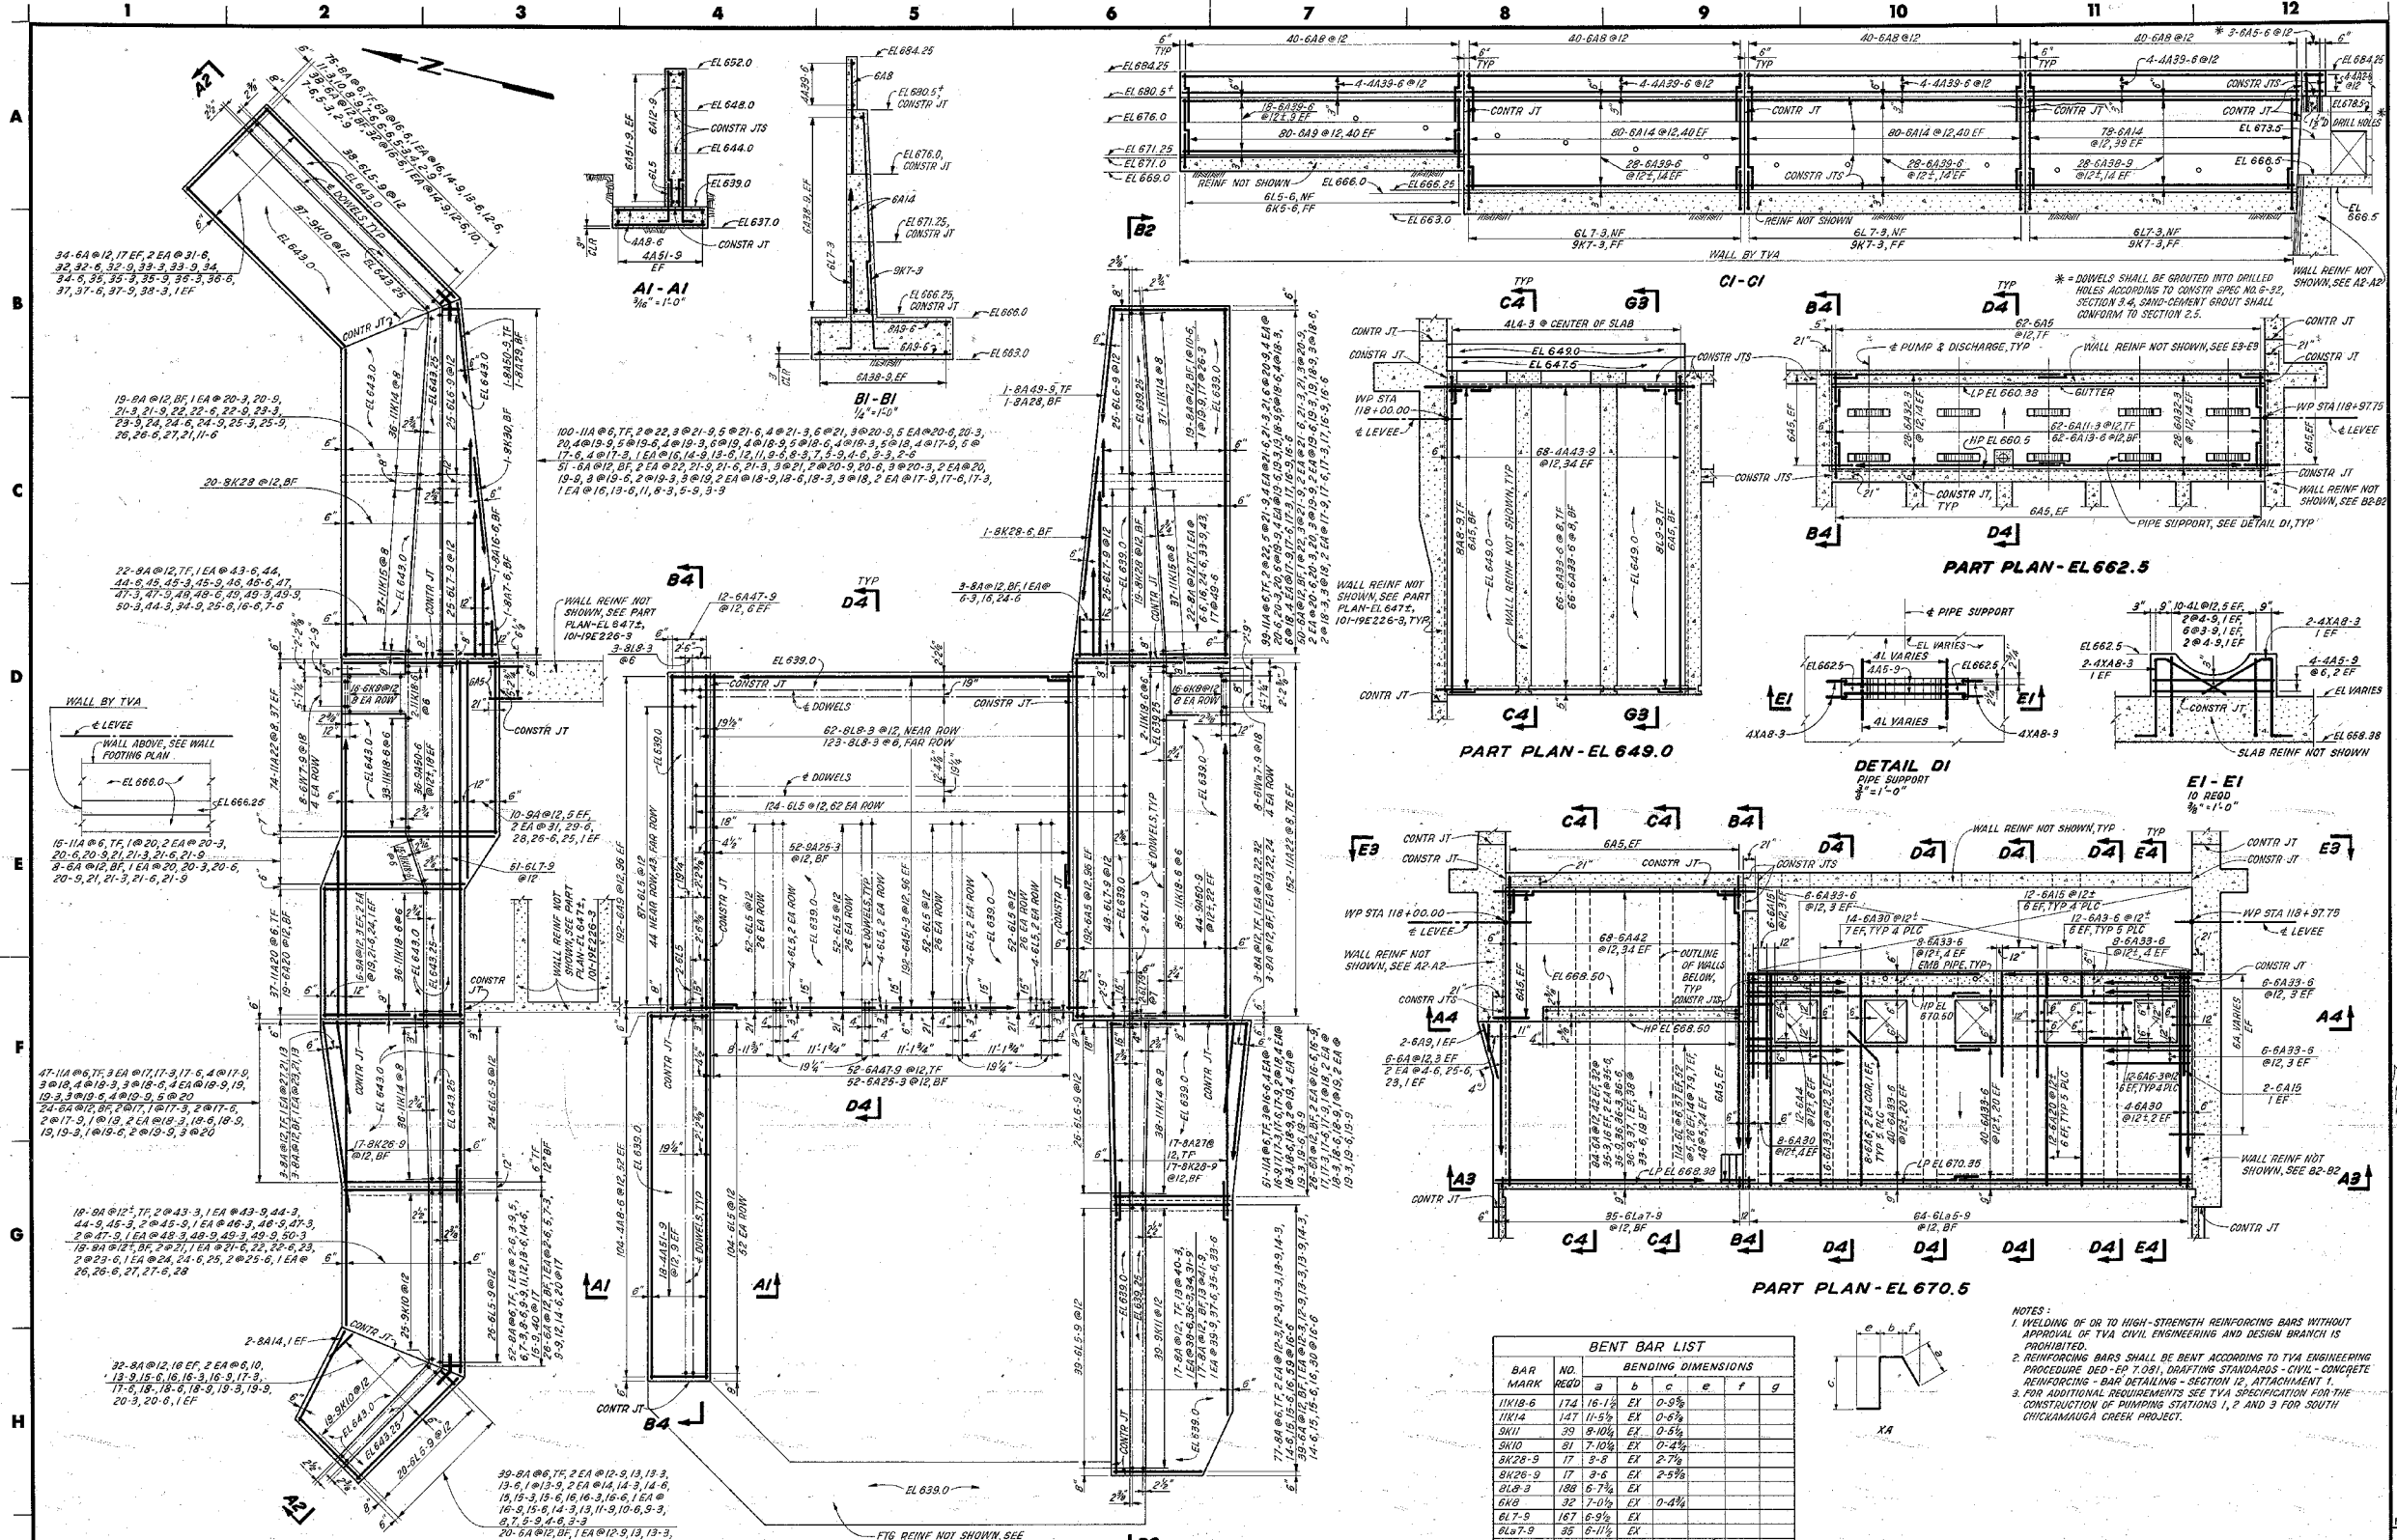

BENT BAR LIST

BAR MARK	NO.	REQD	a	b	c	e	f	g
11K18-6	174	16-12	EX	0-3%				
11K14	147	11-5	EX	0-6%				
SK11	39	8-10	EX	0-6%				
SK10	81	7-10	EX	0-4%				
SK28-9	17	3-8	EX	2-7%				
SK26-9	17	3-6	EX	2-5%				
SK19-3	188	6-7	EX	0-3%				
SK19	32	7-0	EX	0-4%				
ELT-9	167	6-9	EX					
BL7-9	35	6-11	EX					
6W7-9	8	2-6	EX	0-7%				
6W4-9	8	2-6	EX	0-6%				
SK7-3	119	6-4	EX	0-3%				
BL7-3	119	6-4	EX					
BL9-9	100	5-9	EX					
BL5-9	129	4-10	EX					
BL5-3	64	4-11	EX	0-2%				
BL5-6	40	4-9	EX	0-2%				
BL5-5	40	4-8	EX					
BL5	64	4-12	EX					
4A18-3	40	3-2	EX	3-7	EX	2-9		
4L4-9	40	3-8	EX					
4L9-9	60	2-8	EX					
11K19	74	12-5	EX	0-7%				
SK28	39	3-8	EX	2-7%				
SK28-6	1	4-0	EX	2-10				
SK30	1	5-7	EX	4-0				

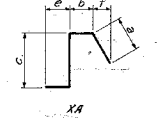

NOTES:
 1. WELDING OF OR TO HIGH-STRENGTH REINFORCING BARS WITHOUT APPROVAL OF TVA CIVIL ENGINEERING AND DESIGN BRANCH IS PROHIBITED.
 2. REINFORCING BARS SHALL BE BENT ACCORDING TO TVA ENGINEERING PROCEDURE DEP-EP-7.081, DRAFTING STANDARDS - CIVIL - CONCRETE REINFORCING - BAR DETAILING - SECTION 12, ATTACHMENT 1.
 3. FOR ADDITIONAL REQUIREMENTS SEE TVA SPECIFICATION FOR THE CONSTRUCTION OF PUMPING STATIONS 1, 2 AND 3 FOR SOUTH CHICKAMAUGA CREEK PROJECT.

CHATTANOOGA FLOOD PROTECTION
 CONCRETE PUMPING STATION NO. 1
 REINFORCEMENT

SOUTH CHICKAMAUGA CREEK PROJECT
 TENNESSEE VALLEY AUTHORITY
 DIVISION OF ENGINEERING DESIGN


INSPECTED AND APPROVED FOR ISSUE
 KNOXVILLE 6-24-77

REVISIONS:
 1 REVISED WALL AS A2-B1

DATE: 6-24-77
 DESIGNED BY: J.P. BUNNEL, E.P. CHENG
 CHECKED BY: E.P. CHENG
 ENGINEER: J.P. BUNNEL


SCALE: 1/4" = 1'-0" EXCEPT AS NOTED
 COMPANION DRAWINGS: 101-19E226-1 THRU 6

A
B
C
D
E
F
G
H
J
K

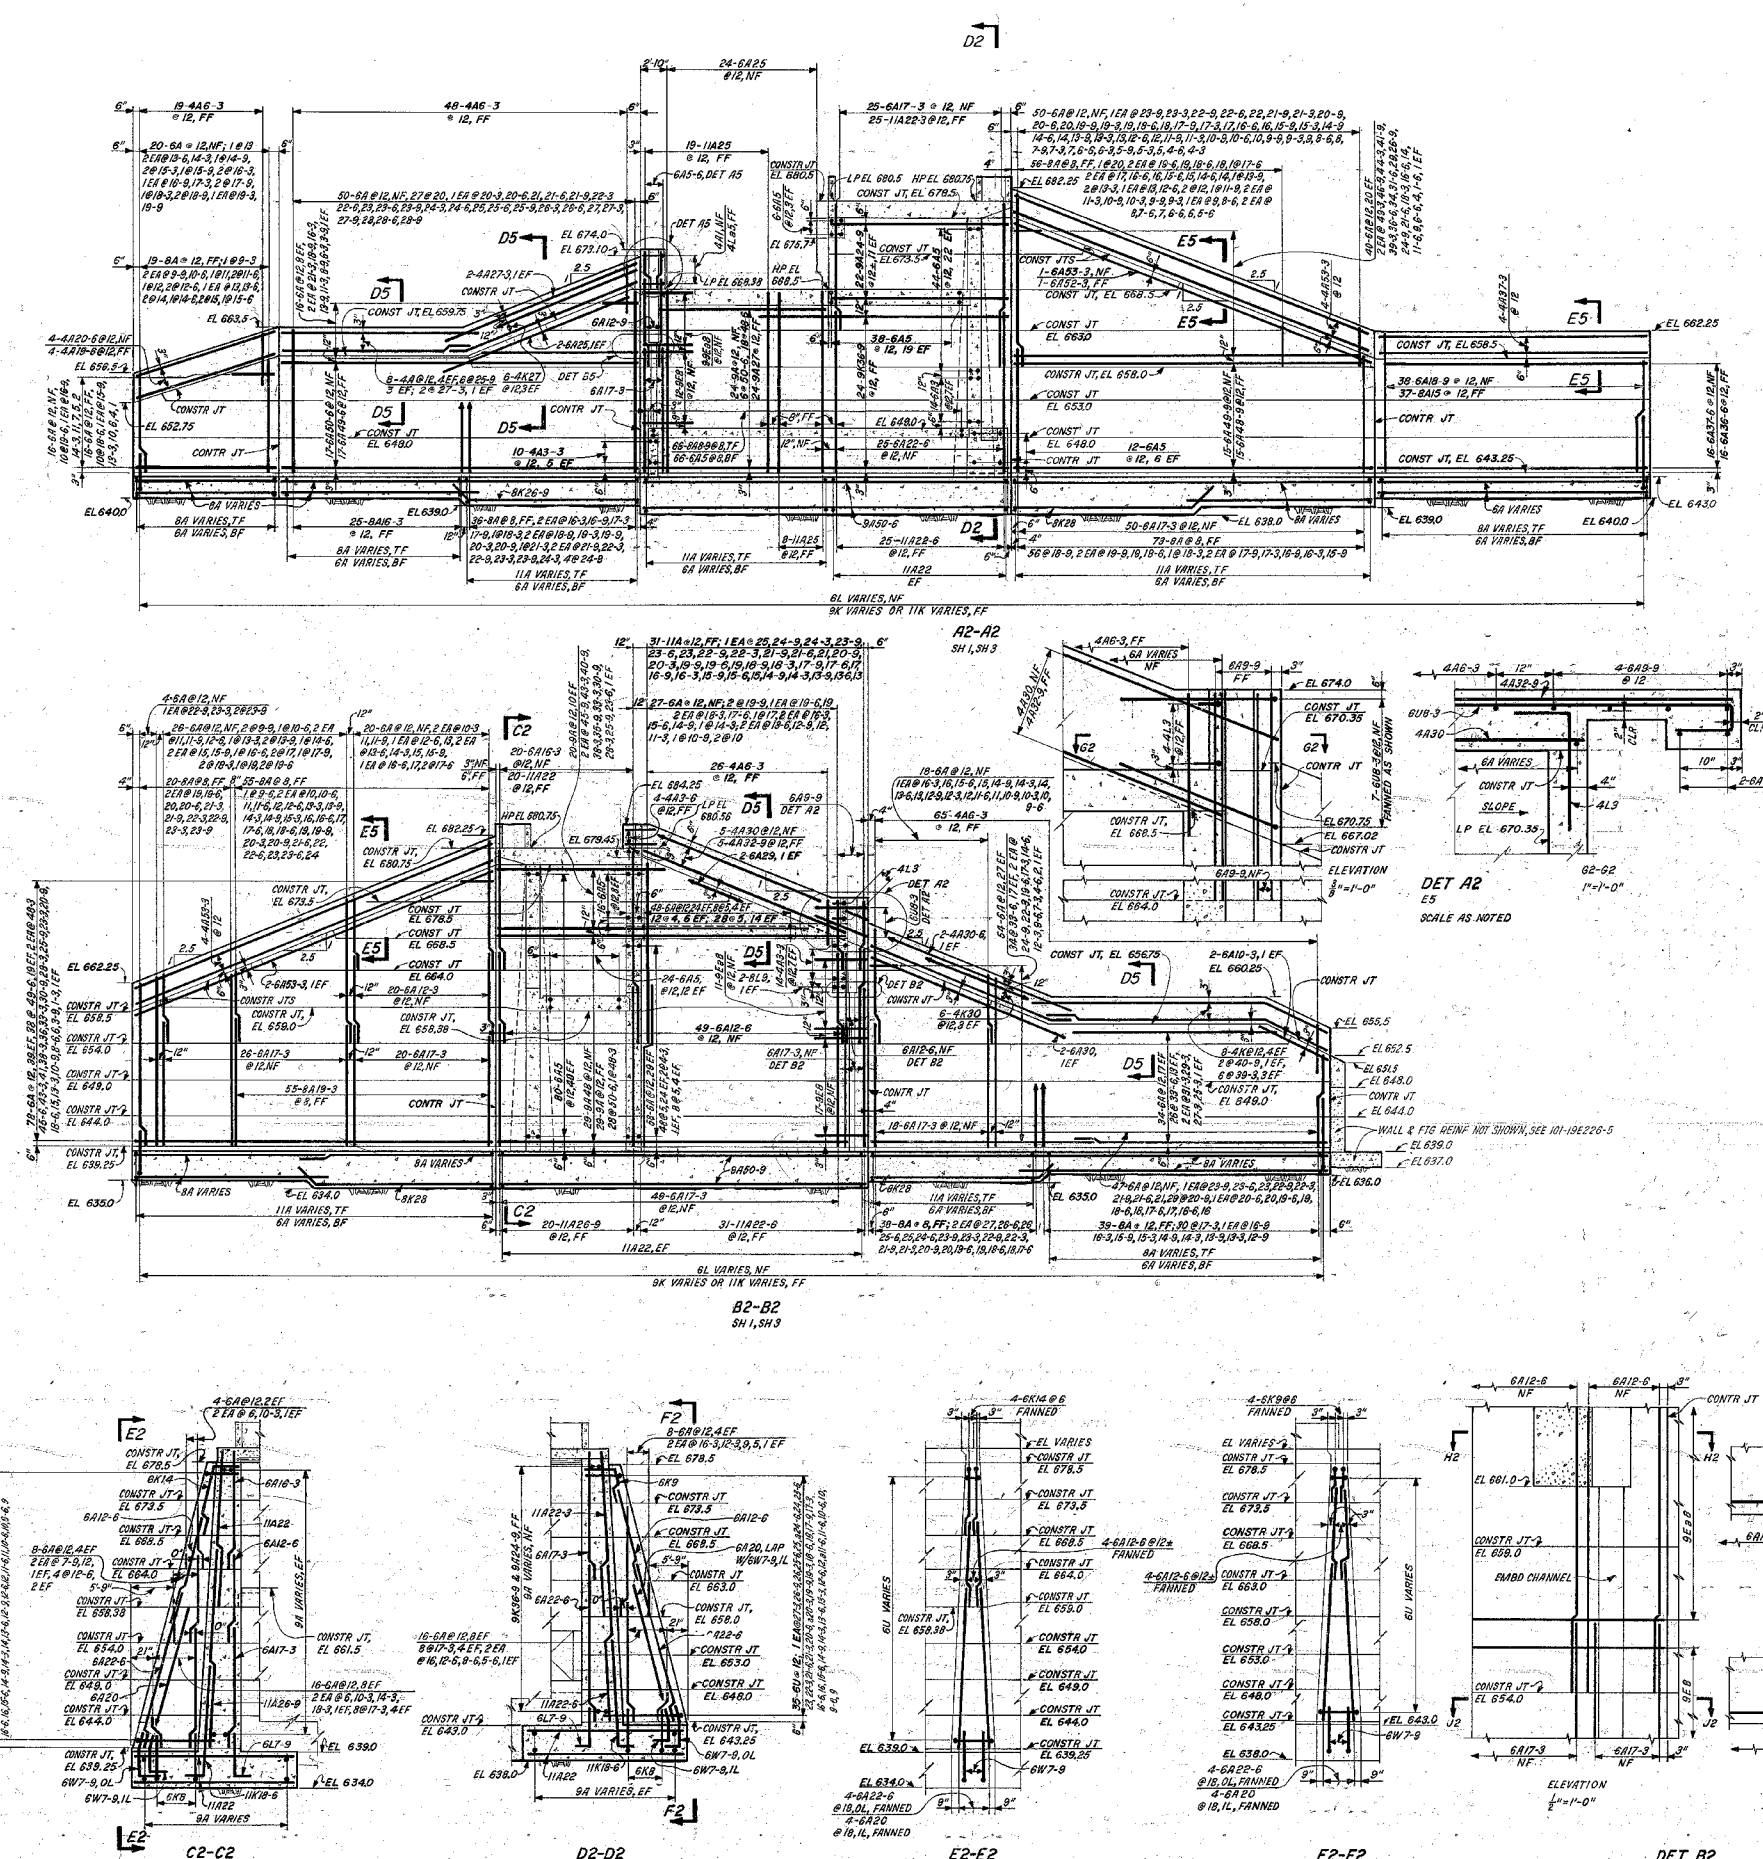


BENT BAR LIST						
BAR MARK	NO.	BENDING DIMENSIONS				
		a	b	c	e	f
8K30-9	24	24-0	EX	7-0		
9E8	28	0-11	0-3	1-1/2	EX	0-3
9E8	18	0-5	0-9	1-7/8	EX	0-7/8
8L9	2	7-6	EX			
6U27-6	1	11-1	5-8	EX		
6U27-3	2	10-11	5-7	EX		
6U20-9	2	10-9	5-6	EX		
6U20	2	10-6	5-4	EX		
6U25-6	2	10-3	5-3	EX		
6U25	2	10-0	5-2	EX		
6U24-6	1	9-11	5-1	EX		
6U24-6	1	9-10	5-0	EX		
6U24	2	8-9	4-11	EX		
6U23-6	2	8-6	4-9	EX		
6U23	2	8-3	4-8	EX		
6U22-3	2	8-0	4-7	EX		
6U22	1	8-0	4-6	EX		
6U21-6	2	8-9	4-5	EX		
6U21-3	2	8-7	4-4	EX		
6U20-6	2	8-4	4-3	EX		
6U20-3	1	8-2	4-1	EX		
6U20-3	1	8-2	4-2	EX		
6U19-9	2	8-0	4-0	EX		
6U19-3	2	7-9	3-11	EX		
6U18-6	2	7-8	3-10	EX		
6U18-3	1	7-4	3-9	EX		
6U18	1	7-4	3-8	EX		
6U17-9	2	7-3	3-7	EX		
6U17-3	2	7-0	3-6	EX		
6U16-9	1	6-10	3-5	EX		
6U16-6	2	6-8	3-4	EX		
6U16	2	6-8	3-3	EX		
6U15-6	2	6-3	3-2	EX		
6U14-9	2	6-0	3-0	EX		
6U14-3	2	5-10	2-11	EX		
6K14	4	4-9	EX	2-3		
6U14	1	3-9	2-10	EX		
6U13-6	2	3-7	2-9	EX		
6U13-3	1	3-5	2-8	EX		
6U12-9	1	3-3	2-7	EX		
6U12-6	2	3-2	2-6	EX		
6U12	2	3-0	2-5	EX		
6U11-6	2	2-8	2-3	EX		
6U11-6	1	2-8	2-4	EX		


BENT BAR LIST CONT'D						
BAR MARK	NO.	BENDING DIMENSIONS				
		a	b	c	e	f
6U11	1	4-8	2-2	EX		
6U10-6	2	4-4	2-1	EX		
6U10	2	4-2	2-0	EX		
6U9-6	2	4-0	1-10	EX		
6U9	4	4-0	EX	1-3/4		
6U8-9	2	3-9	1-9	EX		
6U8-3	7	0-11	0-6	EX		
6L5	14	2-9	EX			

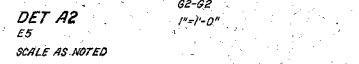


DET A2
SCALE AS NOTED

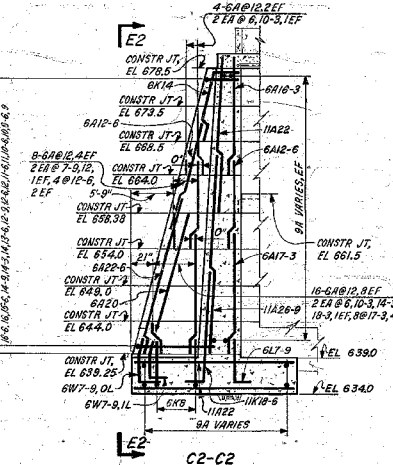


C2-C2

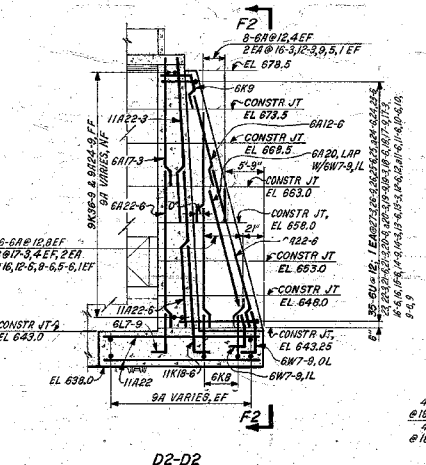

D2-D2

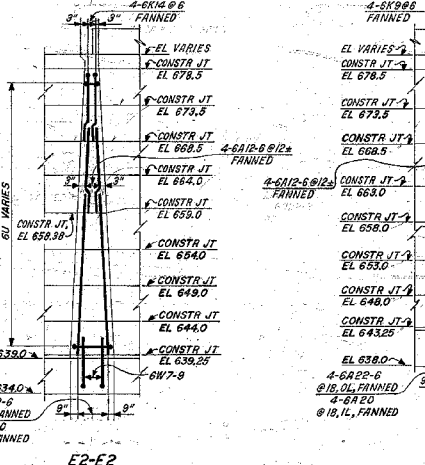

E2-E2

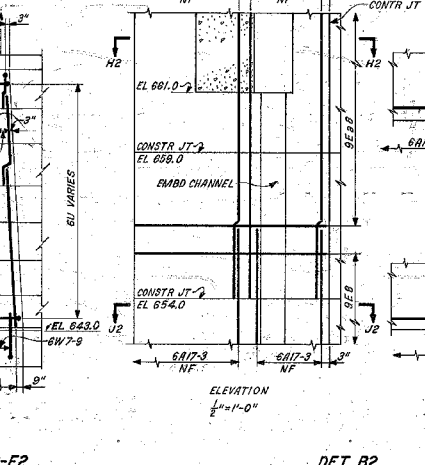

F2-F2


NOTES:
1. FOR GENERAL NOTES AND REFERENCE DRAWINGS SEE 101-19E226-1.

REV	NO.	DATE	BY	CHKD	APPD
05	1	6-24-77	J.P. CHENG	E.P. CHENG	
06	2		H.A. MANSON		


CHATTANOOGA FLOOD PROTECTION
CONCRETE PUMPING STATION NO 1
REINFORCEMENT
SOUTH CHICKAMAUGA CREEK PROJECT
TENNESSEE VALLEY AUTHORITY
DIVISION OF ENGINEERING DESIGN

SUBMITTED	RECOMMENDED	APPROVED


INSPECTED AND APPROVED FOR ISSUE
KNOXVILLE 6-24-77 81 C 101-19E226-2 RO

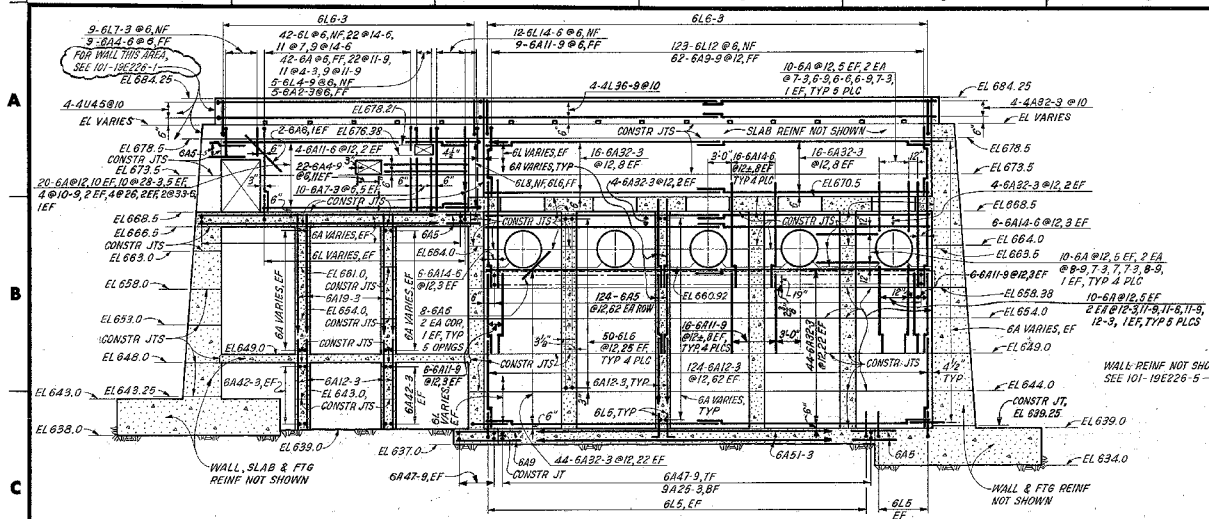


A4-A4
SH 1 & 3

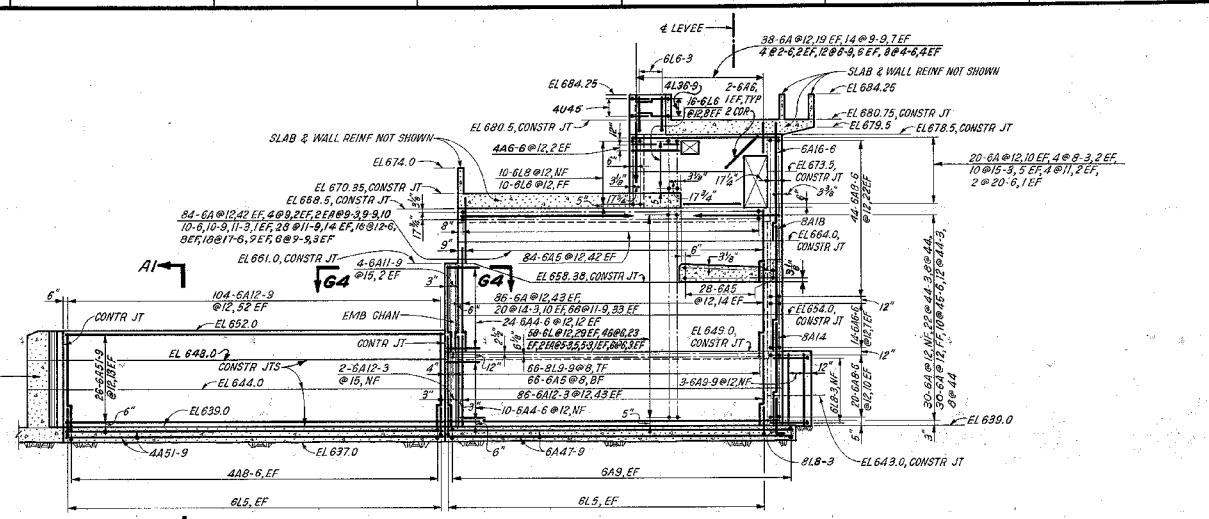


B4-B4
SH 1 & 3

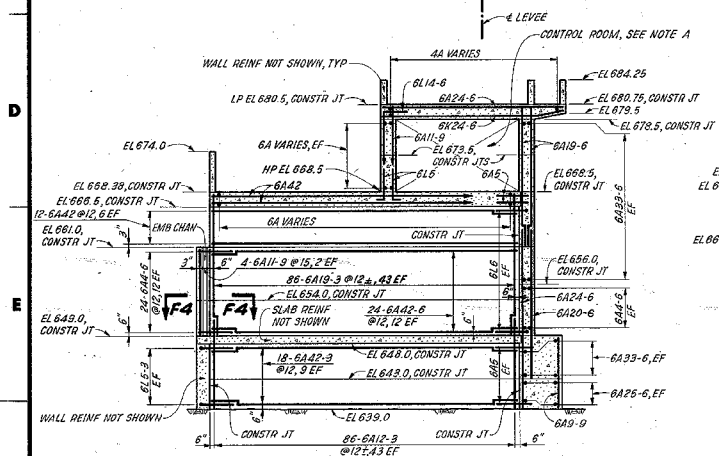

C4-C4
2 REOD
SH 1 & 3

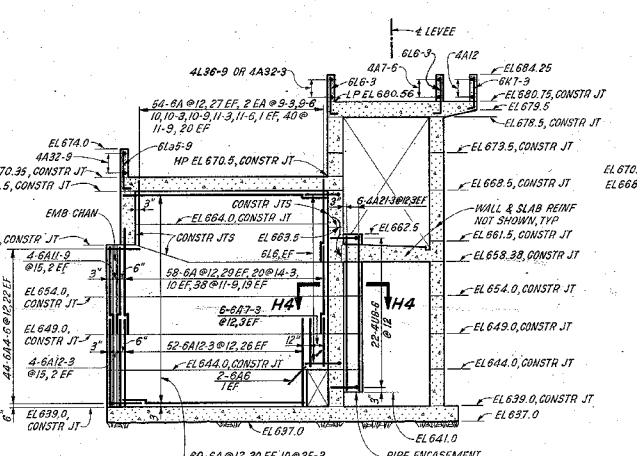


D4-D4
4 REOD
SH 1 & 3

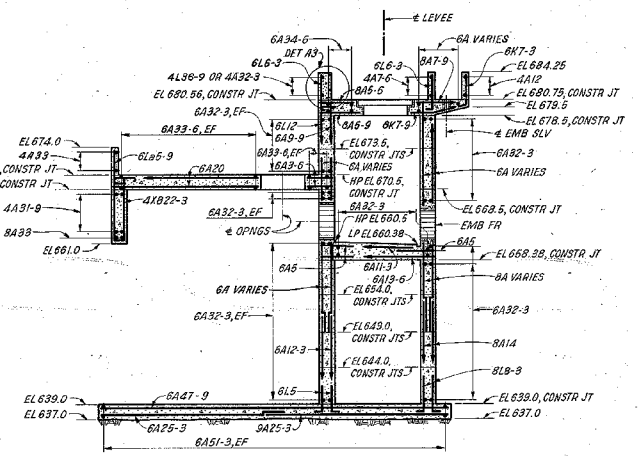


E4-E4
SH 1 & 3


BENT BAR LIST									
BAR MARK	NO	REOD	BENDING DIMENSIONS						
			a	b	c	e	f	g	
6L9-9	26	7-6 1/2	EX						
6L14-6	44	11-8 1/4	EX						
6L12	123	9-2	EX						
6L9	10	5-0 1/4	EX						
6L7-9	9	4-3 3/4	EX						
6L7	11	4-3 1/4	EX						
6L6	282	5-0 1/4	EX						
6L4-9	5	2-3	EX						
4L36-9	4	32-3	EX						
4A4-5	4	6-6	30-0	EX					
4A8-6	22	3-3 3/8	2-1	EX					
6L5-3	4	4-8 1/2	EX						
6L5	2	4-1 1/4	EX						

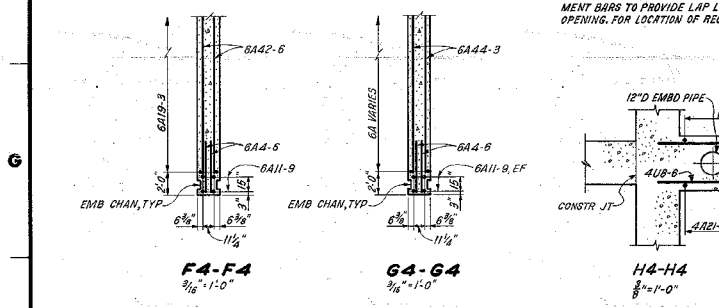

F4-F4
1/2" x 1'-0"

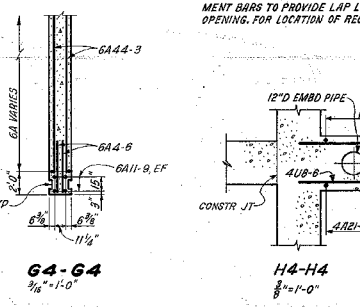

G4-G4
1/2" x 1'-0"

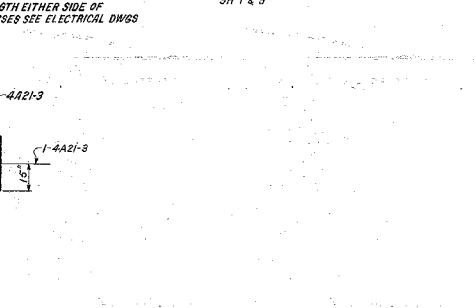






H4-H4
1/2" x 1'-0"

NOTE A1:
FIELD MAY SPREAD OR CUT REINFORCEMENT BARS IN THE CONTROL ROOM WALLS WHERE REQUIRED TO CLEAR ANY RECESSES; REPLACE ALL CUT REINFORCEMENT WITH EQUAL SIZE BARS BEHIND RECESSES. REPLACEMENT BARS TO PROVIDE LAP LENGTH EITHER SIDE OF OPENING. FOR LOCATION OF RECESSES SEE ELECTRICAL DWGS


NOTES:
1. FOR GENERAL NOTES AND REFERENCE DRAWINGS SEE 101-19E226-1.

2	6-22-80	NEW	MAN	JED	NS	TOAR	WJL		
ADDED NOTE FOR WALL, A1									
1	9-1-78	REV	MAN	JED	NS	TOAR	WJL		
REVISED SIZE OF OPENINGS, A2 & REVISED BENT BAR LIST, D11									
REV	NO.	DATE	BY	CHKD	APPD	ENGR	INSP	CONSTR	APPR
CHATTANOOGA FLOOD PROTECTION									
CONCRETE PUMPING STATION NO. 1 REINFORCEMENT									
SOUTH CHICKAMAUGA CREEK PROJECT TENNESSEE VALLEY AUTHORITY DIVISION OF ENGINEERING DESIGN									
INSPECTED AND APPROVED FOR ISSUE	SUBMITTED			RECOMMENDED			APPROVED		
	E. J. [Signature]			J. [Signature]			[Signature]		
PRINT	NO.	14							
SIZE									
KNOXVILLE 6-24-77 81 C 101-19E226-4 R2									

SCALE 1/8" = 1'-0" EXCEPT AS NOTED

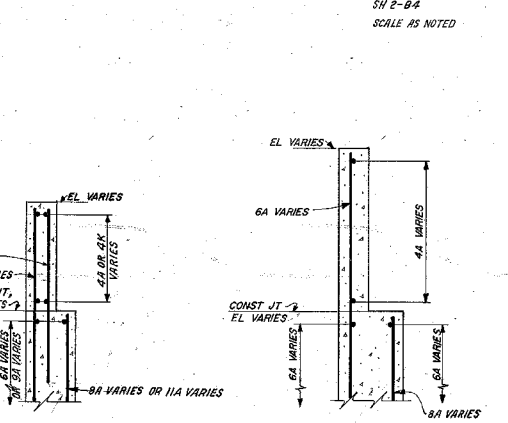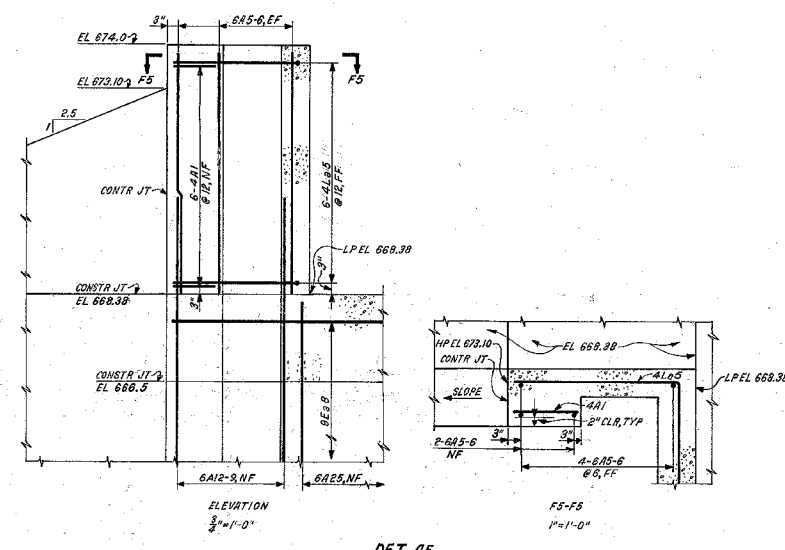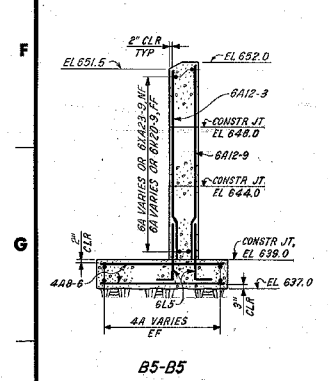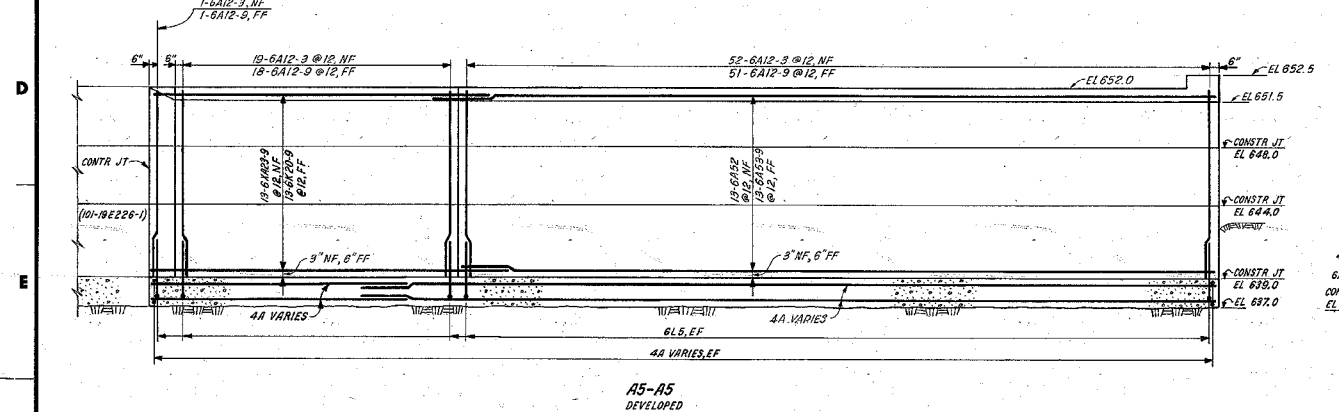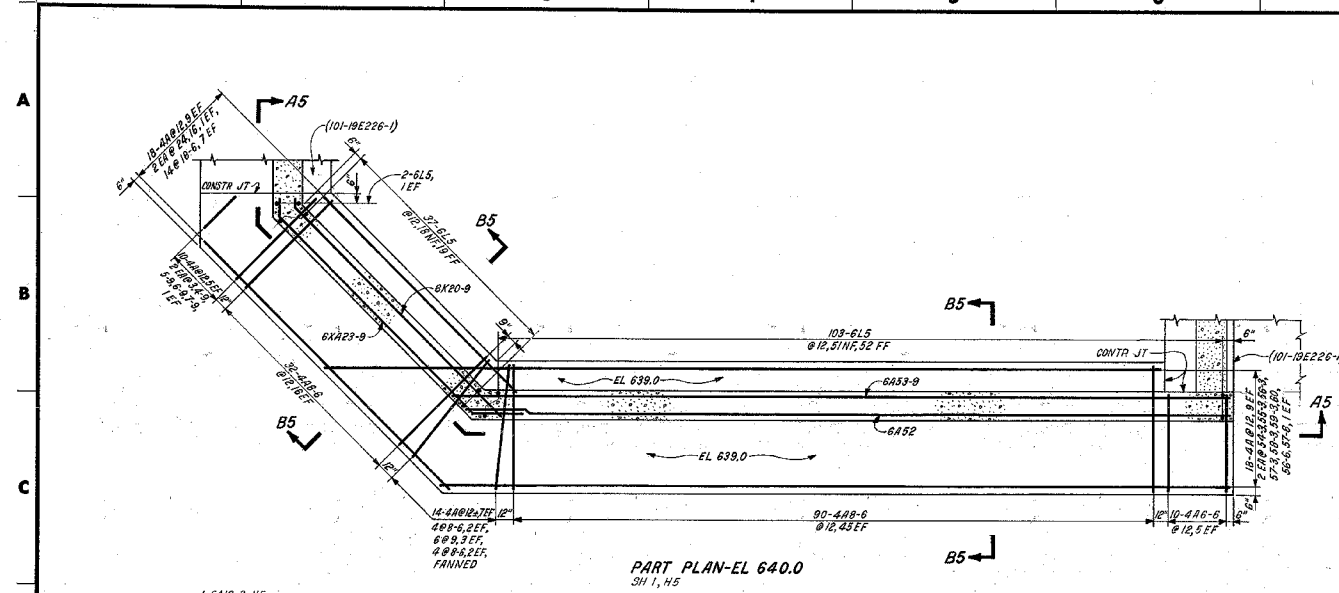

BENT BAR LIST							
BAR MARK	NO. REQD	BENDING DIMENSIONS					
		a	b	c	e	f	g
6A23-9	13	1'-8"	10-1/2"	EX	2'-5"	0'-11 1/2"	
6A25-9	13	0'-8"	EX	0'-6"			
6A5	140	0'-11 1/2"	EX				

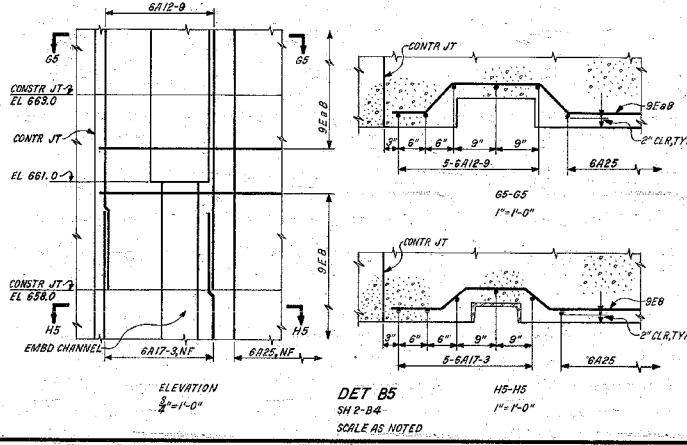

NOTES:
1. FOR GENERAL NOTES AND REFERENCE DRAWINGS SEE 101-19E226-1.





DESIGN	DATE	BY	CHECKED	APPROVED	DATE
J.P. BURKS, E.P. CHENG					

CHATTANOOGA FLOOD PROTECTION
CONCRETE PUMPING STATION NO 1 REINFORCEMENT
SOUTH CHICKAMAUGA CREEK PROJECT
TENNESSEE VALLEY AUTHORITY
DIVISION OF ENGINEERING DESIGN

INSPECTED AND APPROVED FOR ISSUE	DATE	BY	PROJECT NO.
	6-24-77		101-19E226-5Ro

SCALE 1/4" = 1'-0" EXCEPT AS NOTED

MF 1/8

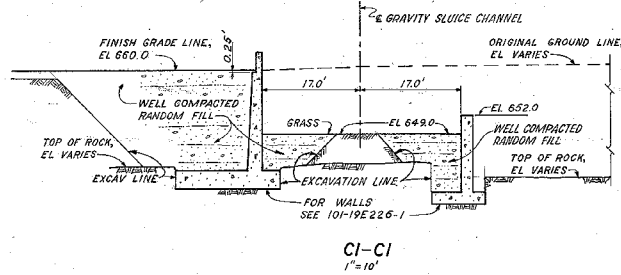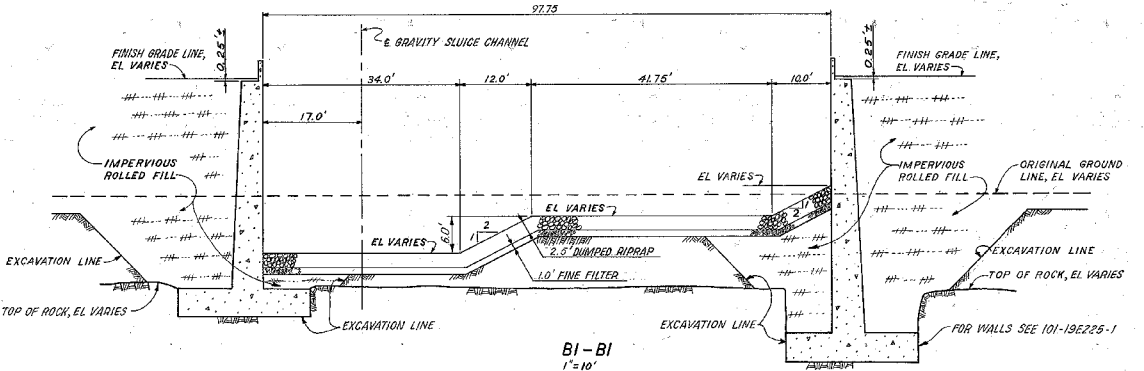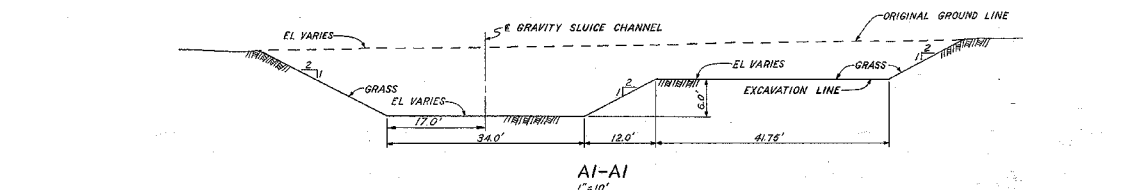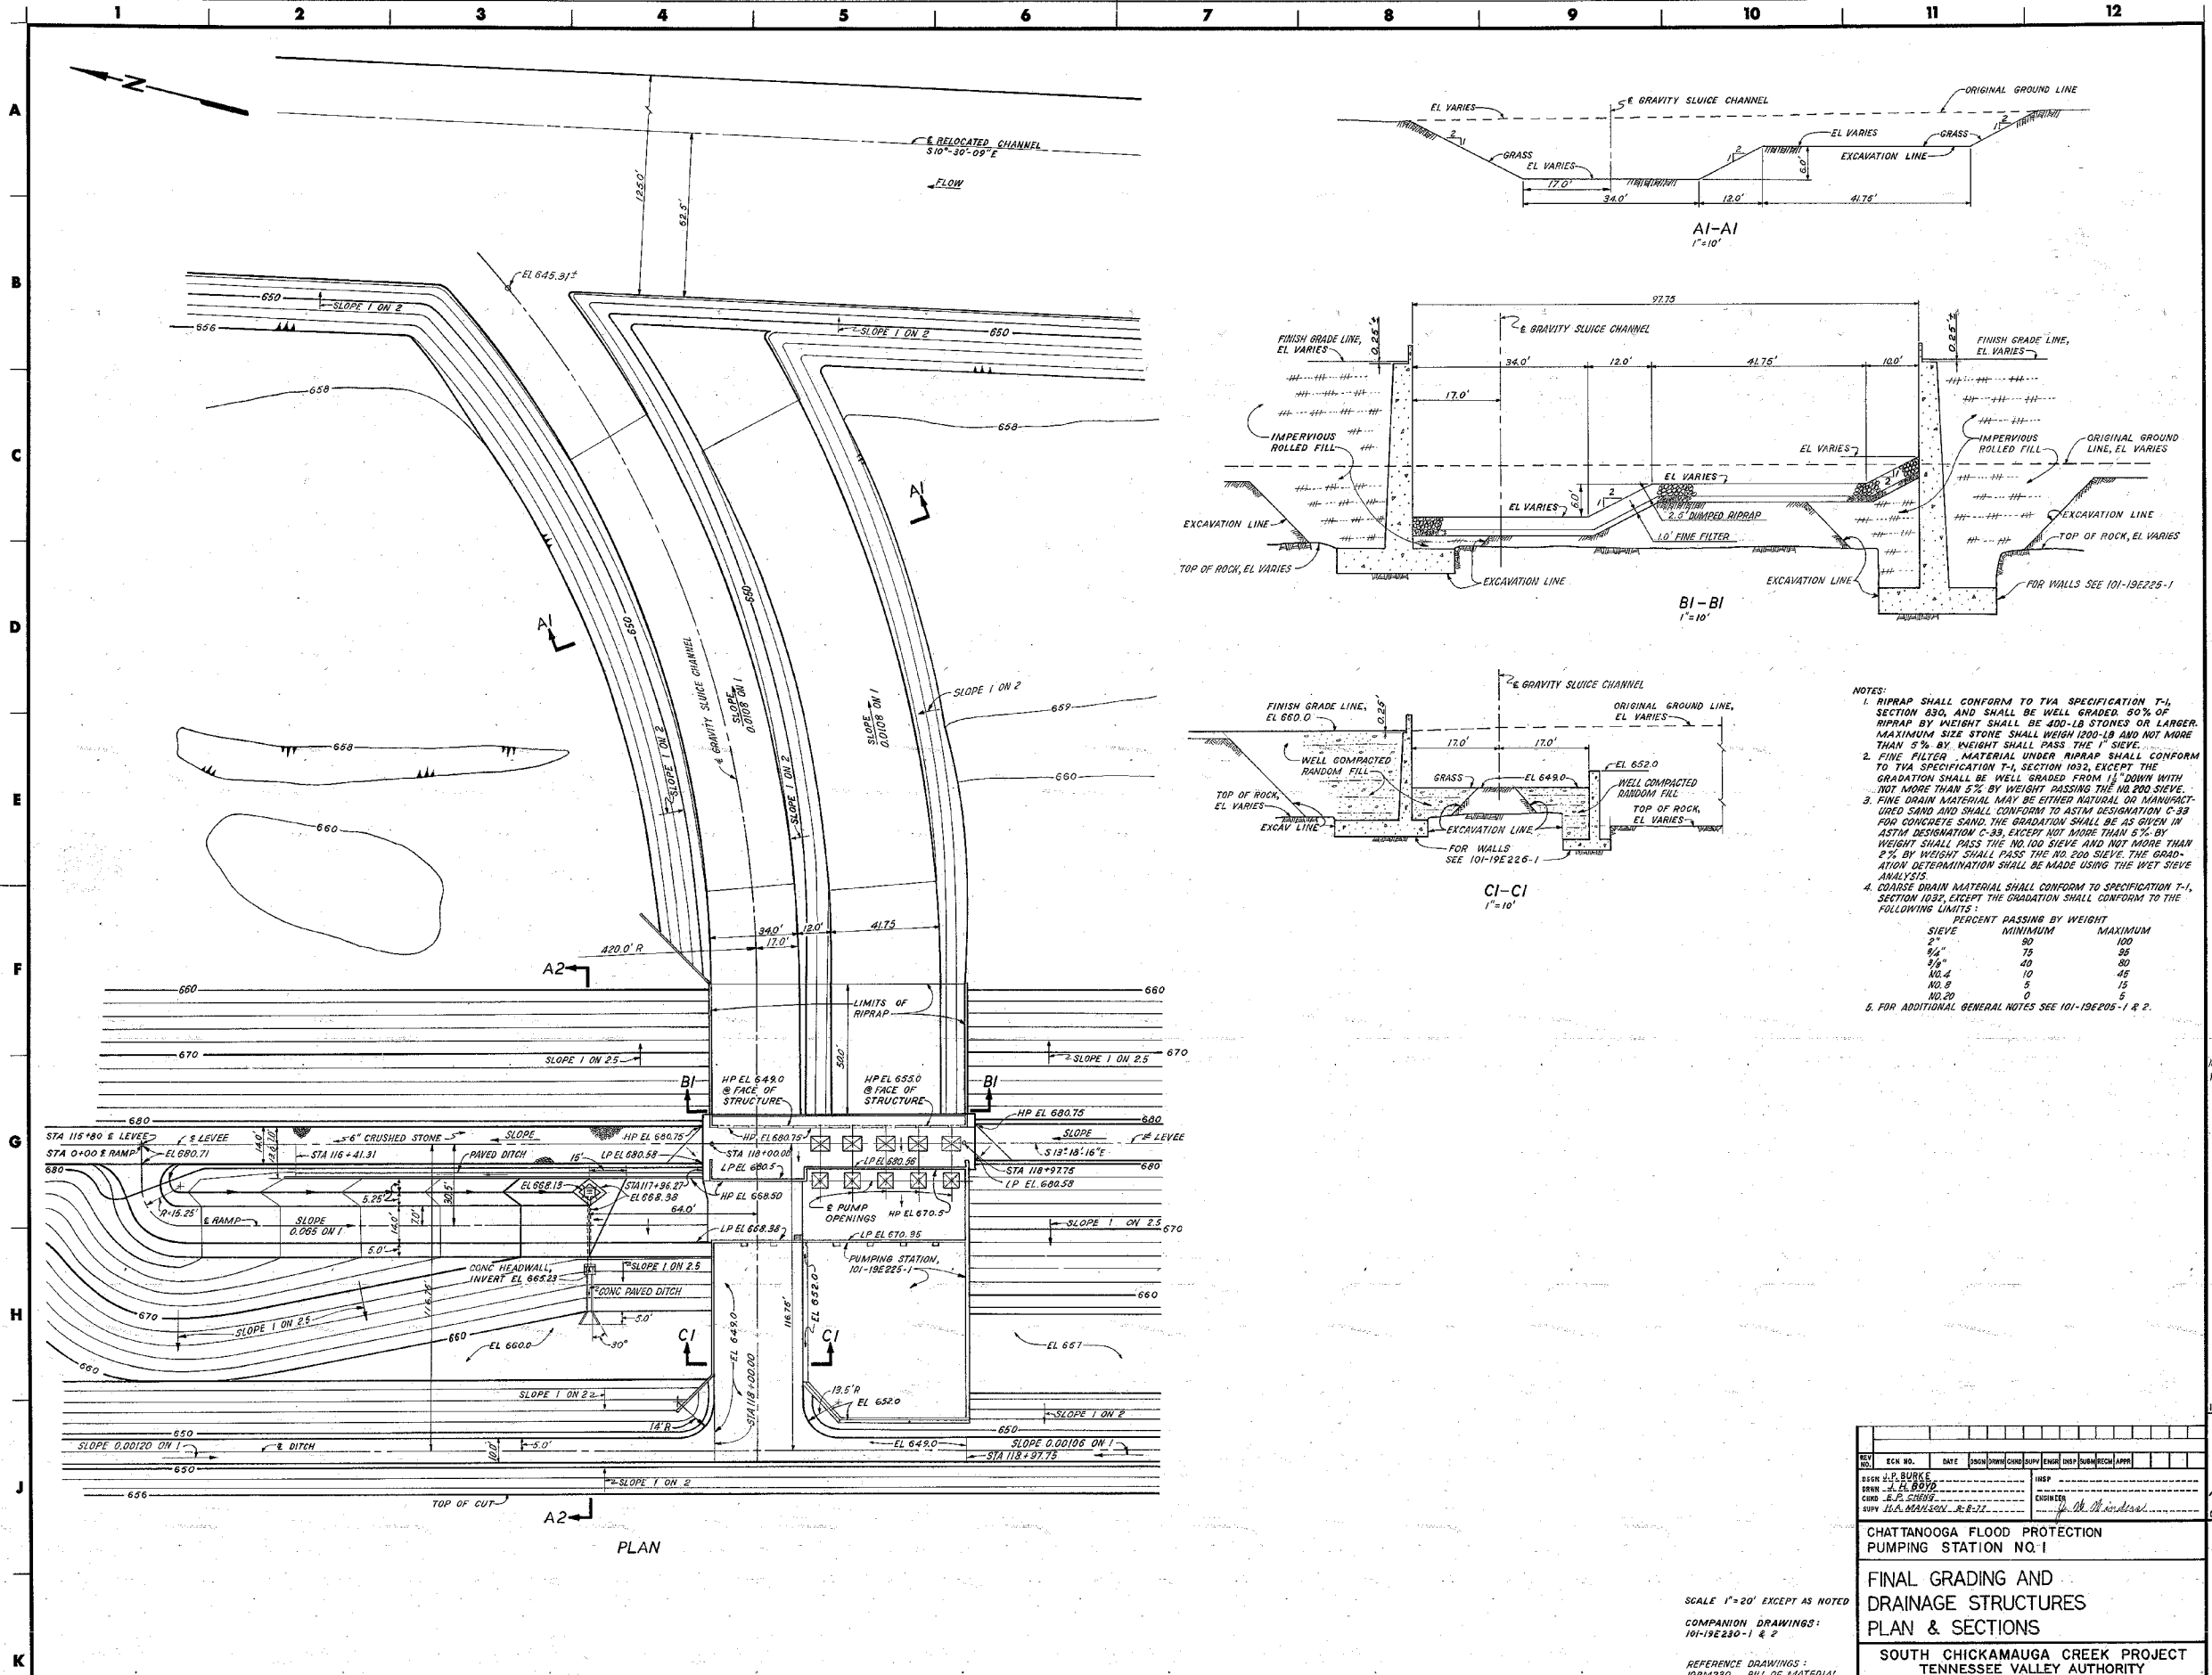

NOTES:

- RIPRAP SHALL CONFORM TO TYPICAL SPECIFICATION T-1, SECTION 830, AND SHALL BE WELL GRADED. 90% OF RIPRAP BY WEIGHT SHALL BE 400-LB STONES OR LARGER. MAXIMUM SIZE STONE SHALL WEIGH 1200-LB AND NOT MORE THAN 5% BY WEIGHT SHALL PASS THE 1" SIEVE.
- FINE FILTER MATERIAL UNDER RIPRAP SHALL CONFORM TO TYPICAL SPECIFICATION T-1, SECTION 1032, EXCEPT THE GRADATION SHALL BE WELL GRADED FROM 1/8" DOWN WITH NOT MORE THAN 5% BY WEIGHT PASSING THE NO. 200 SIEVE.
- FINE DRAIN MATERIAL MAY BE EITHER NATURAL OR MANUFACTURED SAND AND SHALL CONFORM TO ASTM DESIGNATION C-39 FOR CONCRETE SAND. THE GRADATION SHALL BE AS GIVEN IN ASTM DESIGNATION C-39, EXCEPT NOT MORE THAN 5% BY WEIGHT SHALL PASS THE NO. 100 SIEVE AND NOT MORE THAN 2% BY WEIGHT SHALL PASS THE NO. 200 SIEVE. THE GRADATION DETERMINATION SHALL BE MADE USING THE WET SIEVE ANALYSIS.
- COARSE DRAIN MATERIAL SHALL CONFORM TO SPECIFICATION T-1, SECTION 1032, EXCEPT THE GRADATION SHALL CONFORM TO THE FOLLOWING LIMITS:

SIEVE	PERCENT PASSING BY WEIGHT	
	MINIMUM	MAXIMUM
2"	90	100
3/4"	75	95
3/8"	40	80
NO. 4	10	45
NO. 9	5	15
NO. 20	0	5

5. FOR ADDITIONAL GENERAL NOTES SEE 101-19E205-1 & 2.

REV. NO.	ECH. NO.	DATE	BY	CHKD.	APP. BY	REASON

CHATANOOGA FLOOD PROTECTION
PUMPING STATION NO. 1

FINAL GRADING AND
DRAINAGE STRUCTURES
PLAN & SECTIONS

SOUTH CHICKAMAUGA CREEK PROJECT
TENNESSEE VALLEY AUTHORITY
DIVISION OF ENGINEERING DESIGN

SUBMITTED: *E. J. [Signature]*
RECOMMENDED: *[Signature]*
APPROVED: *[Signature]*

INSPECTED AND APPROVED FOR ISSUE: *[Signature]*
KNOXVILLE 3-31-78
81 c 101-19E230-1 R0

SCALE 1"=20' EXCEPT AS NOTED
COMPANION DRAWINGS:
101-19E230-1 & 2
REFERENCE DRAWINGS:
18B4230... BILL OF MATERIAL

STRAIGHT REINFORCEMENT BAR LIST

(FOR FIELD INFORMATION ONLY)

MADE J.L. MAXEY

FOR DWG. NO. 101-19E230-1 & 2 RO

CHKD: HAM
JCM 3-17-78


SHEET NO 1 OF 1

DATE 8-8-77



PROJECT SOUTH CHICKAMAUGA CRK

BUILDING PUMPING STATION NO. 1
FINAL GRADING

BAR SIZE	BAR LENGTH	NO. REQ'D	BAR SIZE	BAR LENGTH	NO. REQ'D	BAR SIZE	BAR LENGTH	NO. REQ'D
4	3-6	1						
4	3-9	2						
4	4-0	4						

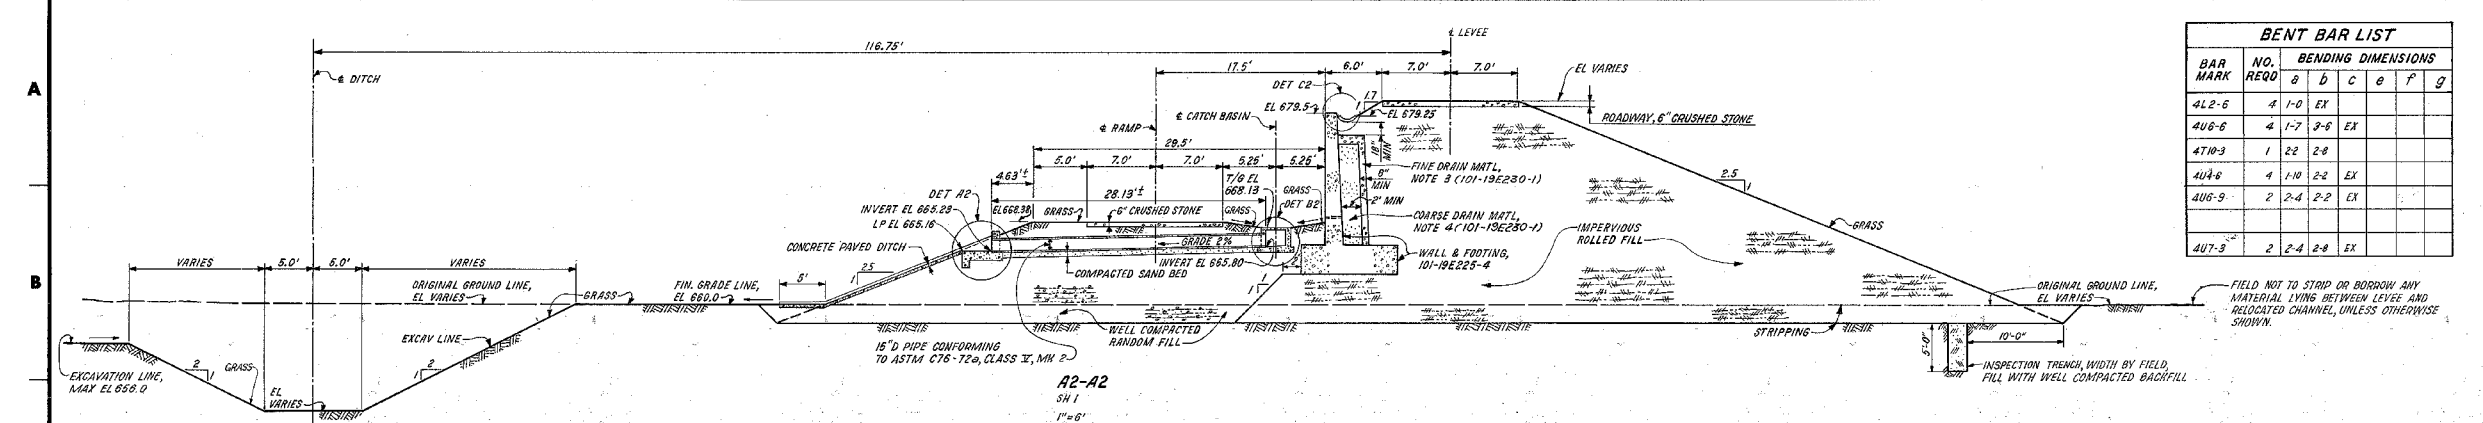

BENT BAR LIST						
BAR MARK	NO.	BENDING DIMENSIONS				
		a	b	c	e	f
4L2-6	4	1-0	EX			
4U6-6	4	1-7	EX			
4T10-3	1	2-2	EX			
4A4-6	4	1-10	EX			
4U6-9	2	2-4	EX			
4U7-3	2	2-4	EX			

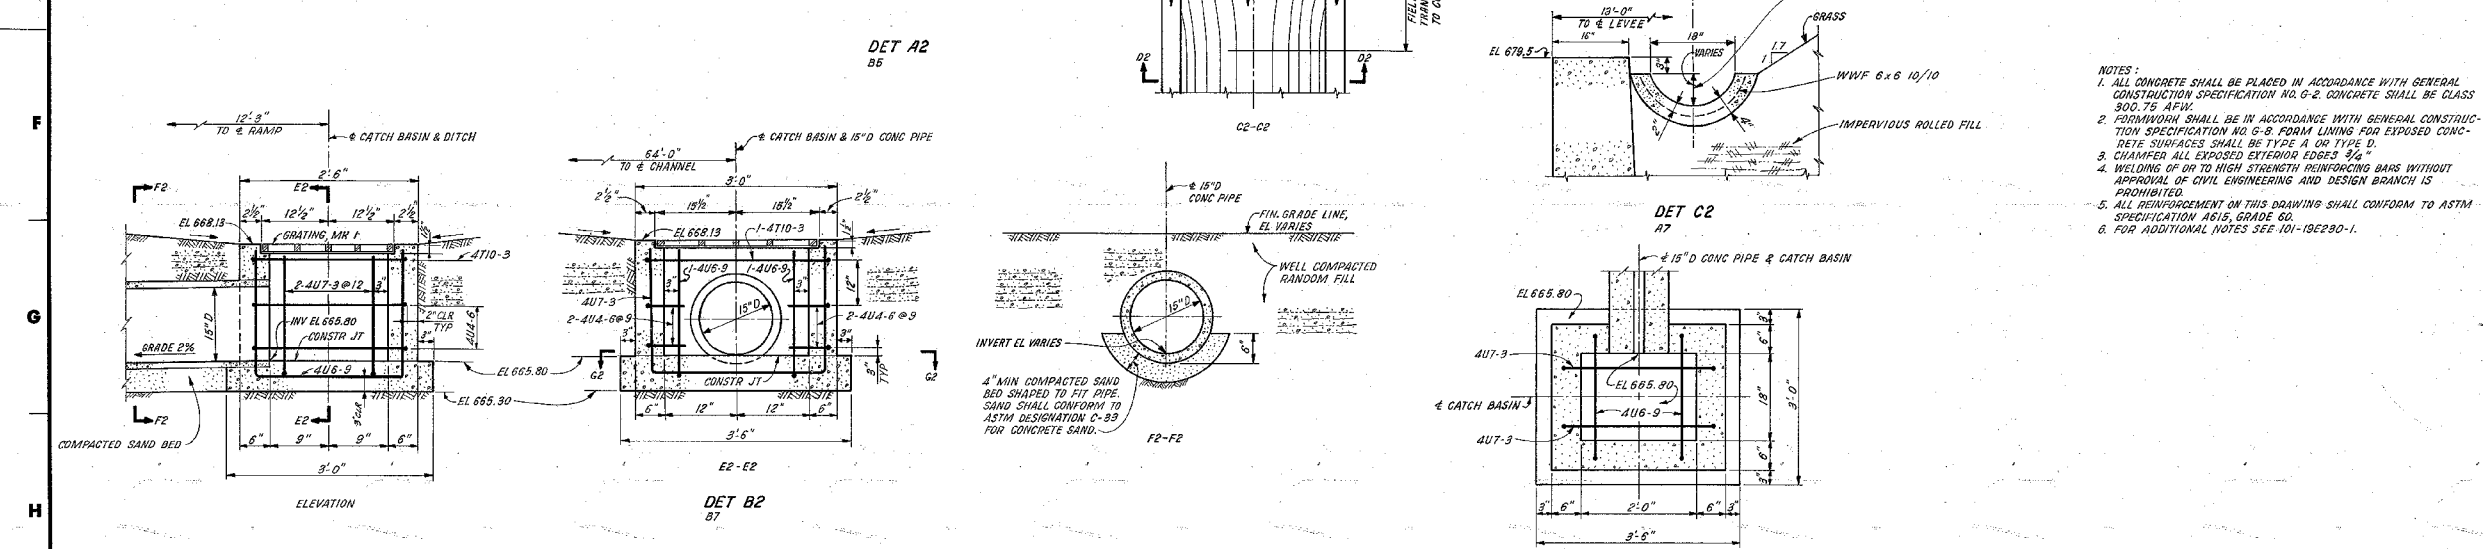
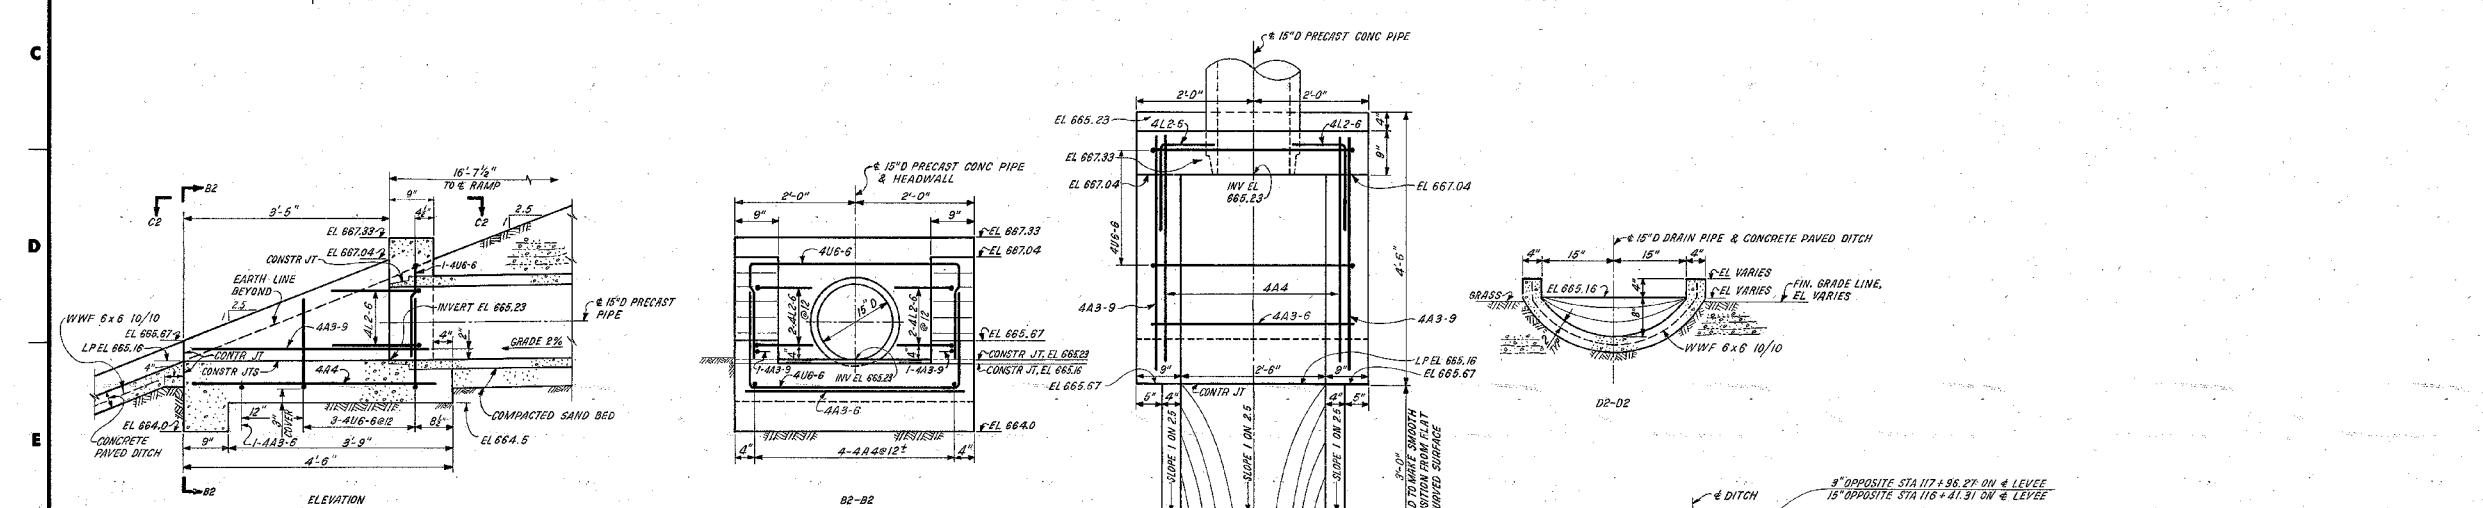


- NOTES:
1. ALL CONCRETE SHALL BE PLACED IN ACCORDANCE WITH GENERAL CONSTRUCTION SPECIFICATION NO. G-2. CONCRETE SHALL BE CLASS 300.75 AFW.
 2. FORMWORK SHALL BE IN ACCORDANCE WITH GENERAL CONSTRUCTION SPECIFICATION NO. G-8. FORM LINING FOR EXPOSED CONCRETE SURFACES SHALL BE TYPE A OR TYPE D.
 3. CHAMFER ALL EXPOSED EXTERIOR EDGES 3/4".
 4. WELDING OF OR TO HIGH STRENGTH REINFORCING BARS WITHOUT APPROVAL OF CIVIL ENGINEERING AND DESIGN BRANCH IS PROHIBITED.
 5. ALL REINFORCEMENT ON THIS DRAWING SHALL CONFORM TO ASTM SPECIFICATION A615, GRADE 60.
 6. FOR ADDITIONAL NOTES SEE 101-19E230-1.

1-3-03		REV	DATE	BY	CHKD	APP'D
FINAL FIELD REV						
DESIGN	J.P. BURKE	DATE	3-3-77	CHKD	E.P. GIBSON	APP'D
CHKD	E.P. GIBSON	DATE	3-3-77	APP'D	J. BURKE	
APP'D	J. BURKE	DATE	3-3-77	CHKD	E.P. GIBSON	
CHATTANOOGA FLOOD PROTECTION PUMPING STATION NO. 1						
FINAL GRADING AND DRAINAGE STRUCTURES PLAN & SECTIONS						
SOUTH CHICKAMAUGA CREEK PROJECT TENNESSEE VALLEY AUTHORITY DIVISION OF ENGINEERING DESIGN						
SUBMITTED		RECOMMENDED		APPROVED		
E.P. Gibson		J.P. Burke		J.P. Burke		
INSPECTED AND APPROVED FOR ISSUE						
KNOXVILLE 3-31-78 B1 C 101-19E230-2 R1						

SCALE 1"=1'-0" EXCEPT AS NOTED



PRINT	H	D							
SIZE	F	3	2	1					
BY OR FOR	ME	CE	AD	CD	ED	MD	PD	RD	SA
PRINTS READ-N-GO									

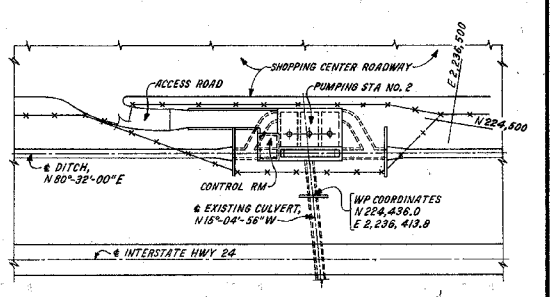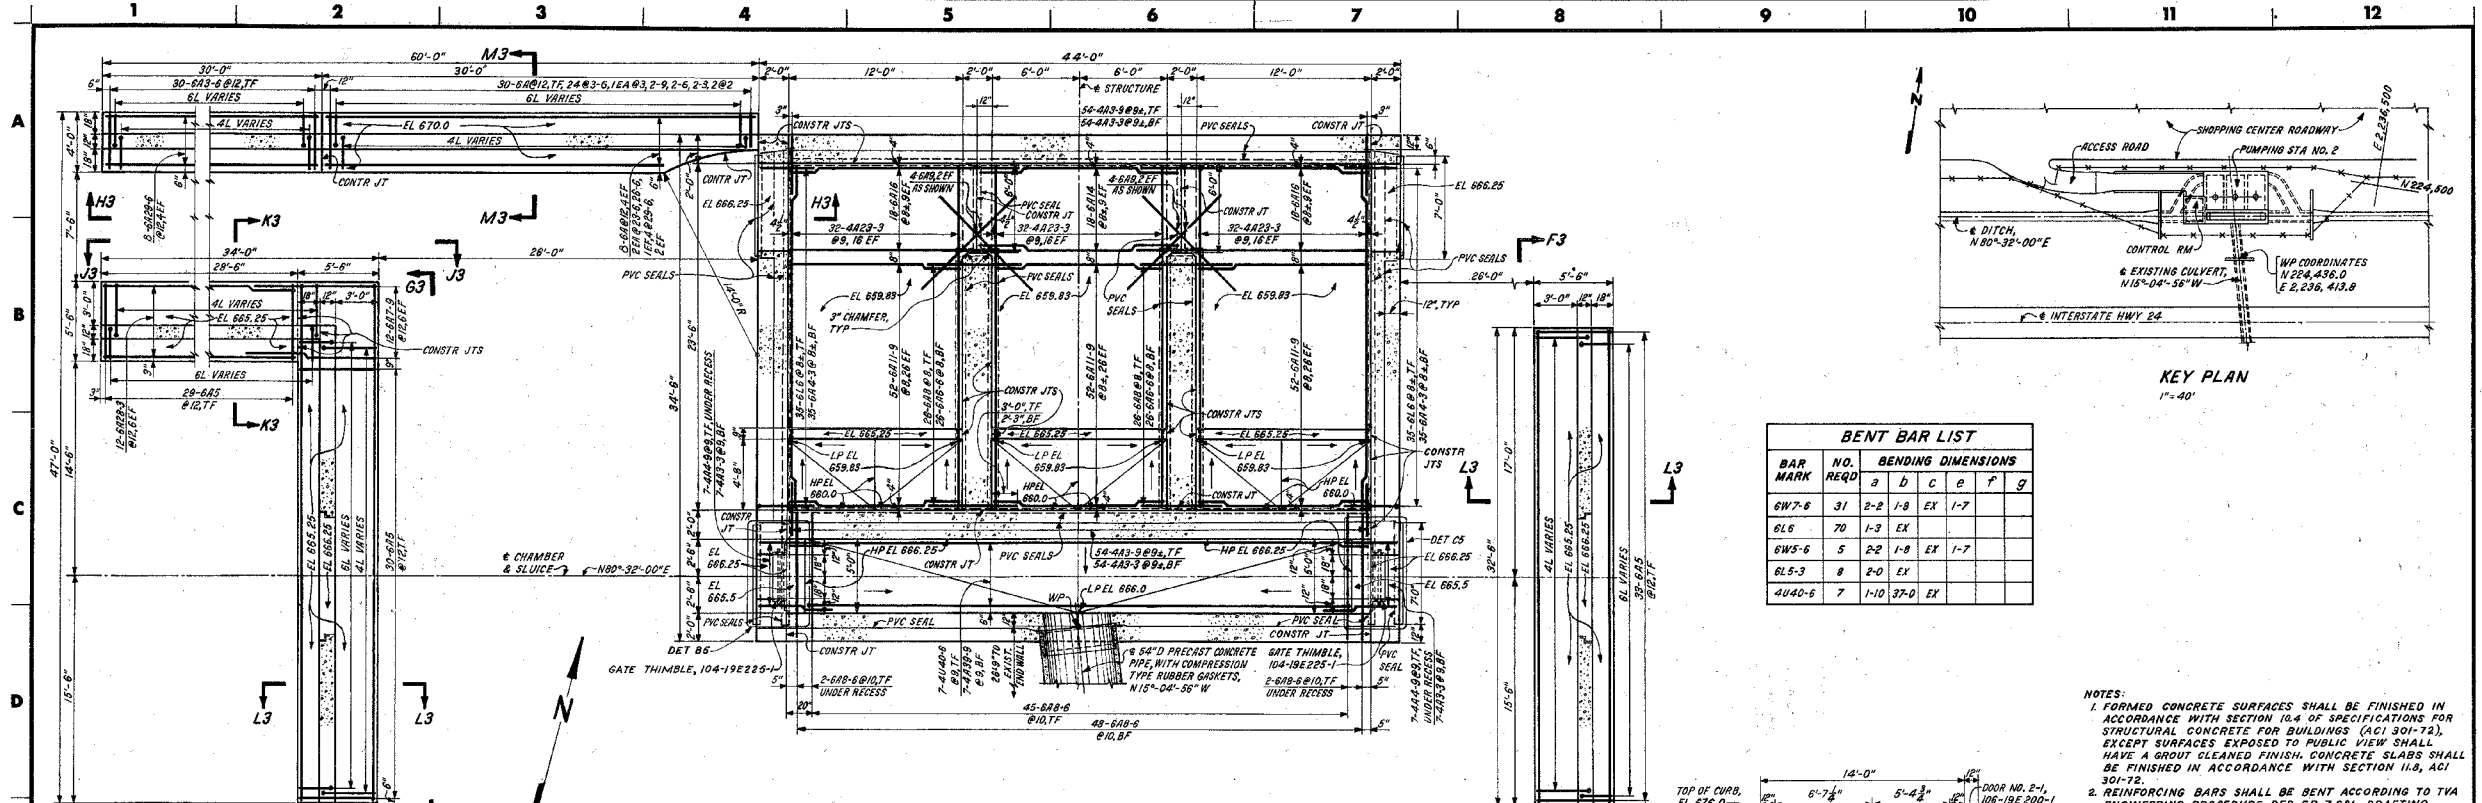

BENT BAR LIST

BAR MARK	NO. REQD	a	b	c	e	f	g
6W7-6	31	2-8	1-8	EX	1-7		
6L6	70	1-3	EX				
6W5-6	5	2-2	1-8	EX	1-7		
6L5-3	8	2-0	EX				
4U40-6	7	1-10	37-0	EX			

- NOTES:**
- FORMED CONCRETE SURFACES SHALL BE FINISHED IN ACCORDANCE WITH SECTION 16.4 OF SPECIFICATIONS FOR STRUCTURAL CONCRETE FOR BUILDINGS (ACI 301-72), EXCEPT SURFACES EXPOSED TO PUBLIC VIEW SHALL HAVE A GROUT CLEANED FINISH. CONCRETE SLABS SHALL BE FINISHED IN ACCORDANCE WITH SECTION 11.6, ACI 301-72.
 - REINFORCING BARS SHALL BE BENT ACCORDING TO TVA ENGINEERING PROCEDURE DEP-EP 7.001, DRAFTING STANDARDS-CIVIL-CONCRETE REINFORCING-BAR DETAILING-SECTION 12, ATTACHMENT 1.
 - CRUSHED STONE USED AS FILL MATERIAL UNDER CONCRETE SLABS SHALL CONFORM TO TVA HIGHWAY SPECIFICATION NO. T-1, SECTION 1032.
 - FINAL GRADING BY TVA IN ACCORDANCE WITH DRAWING NO. 91-C-101-19E245-1 & 2.
 - ALL CONTRACTION JOINTS SHALL BE TREATED TO BREAK BOND ON THE JOINT SURFACE BY PAINTING THE CONCRETE WITH A HEAVY COAT OF EITHER ASPHALT EMULSION, FLAT GRAY PRIMER WITH LINSEED OIL VEHICLE OR CONCRETE CURING COMPOUND. ALL MATERIAL SHALL BE OF GOOD COMMERCIAL GRADE.
 - FOR ADDITIONAL REQUIREMENTS SEE TVA SPECIFICATION FOR THE CONSTRUCTION OF PUMPING STATIONS 1, 2 AND 3 FOR SOUTH CHICKAMAUGA CREEK PROJECT.

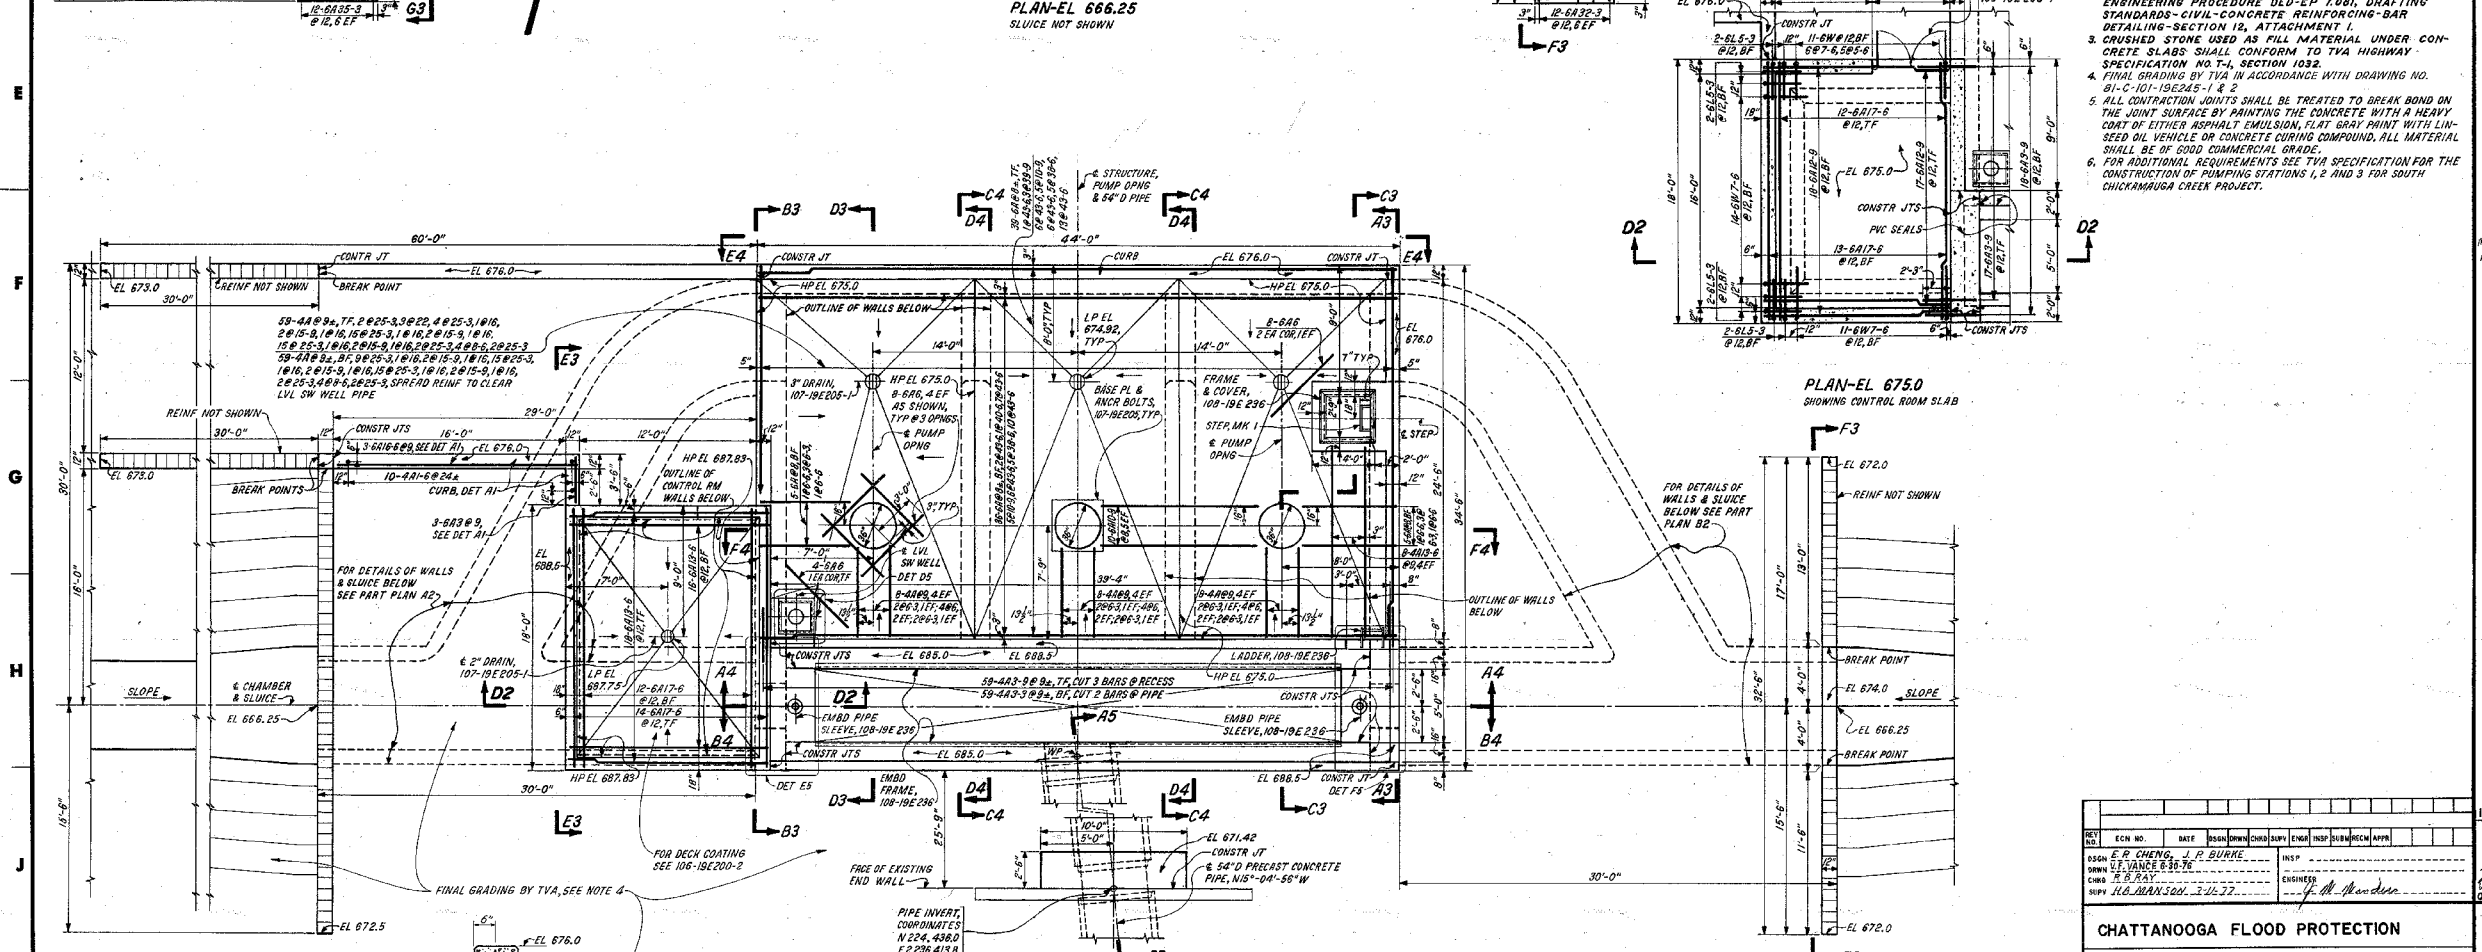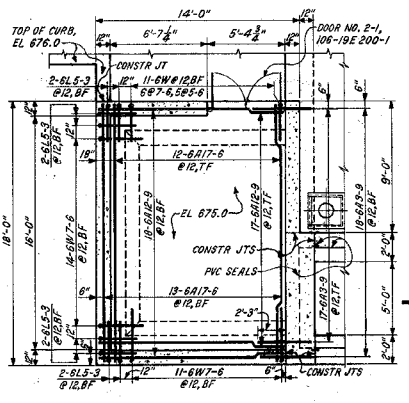

REV	NO.	DATE	BY	CHKD	APPD	REASON
1	1	10/19/01	J.P. BURKE	J.P. BURKE		ISSUED FOR CONSTRUCTION
2	2	11/15/01	J.P. BURKE	J.P. BURKE		REVISED FOR CONSTRUCTION
3	3	11/15/01	J.P. BURKE	J.P. BURKE		REVISED FOR CONSTRUCTION

CHATTANOOGA FLOOD PROTECTION

CONCRETE PUMPING STATION NO. 2

OUTLINE & REINFORCEMENT

SOUTH CHICKAMAUGA CREEK PROJECT

TENNESSEE VALLEY AUTHORITY

DIVISION OF ENGINEERING DESIGN

SUBMITTED: *[Signature]* RECOMMENDED: *[Signature]* APPROVED: *[Signature]*

NO. 101-19E235-1 R0

SCALE 1/4"=1'-0" EXCEPT AS NOTED

COMPANION DRAWINGS: 101-19E235-1 THRU 5

REFERENCE DRAWINGS: 19BM235.....BILL OF MATERIAL

DESIGN	PROJECT MANAGER	NO.	DATE	BY	CHKD	APPD
DESIGN	PROJECT MANAGER	NO.	DATE	BY	CHKD	APPD




PRINTED AT: *[Location]*

DATE: *[Date]*







SCALE: *[Scale]*

PROJECT: *[Project Name]*

A
B
C
D
E
F
G
H
J
K

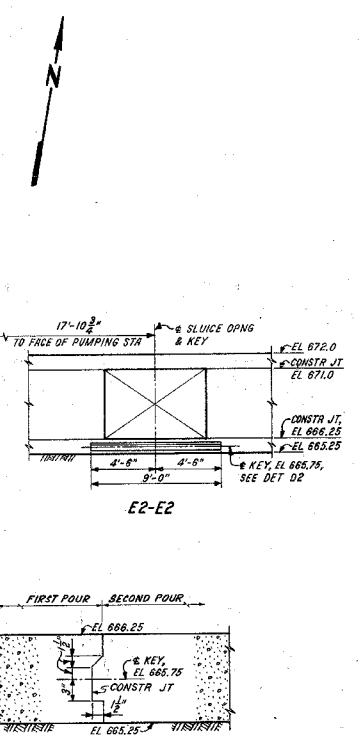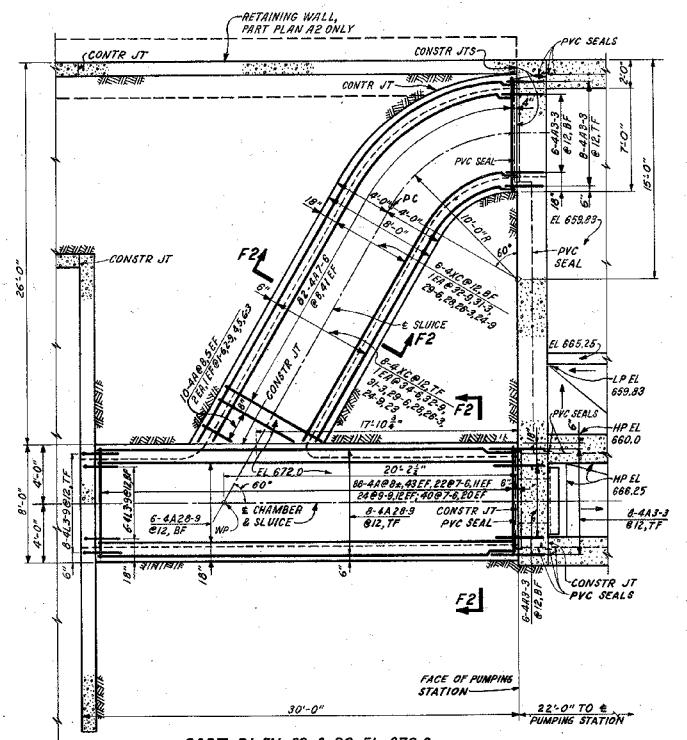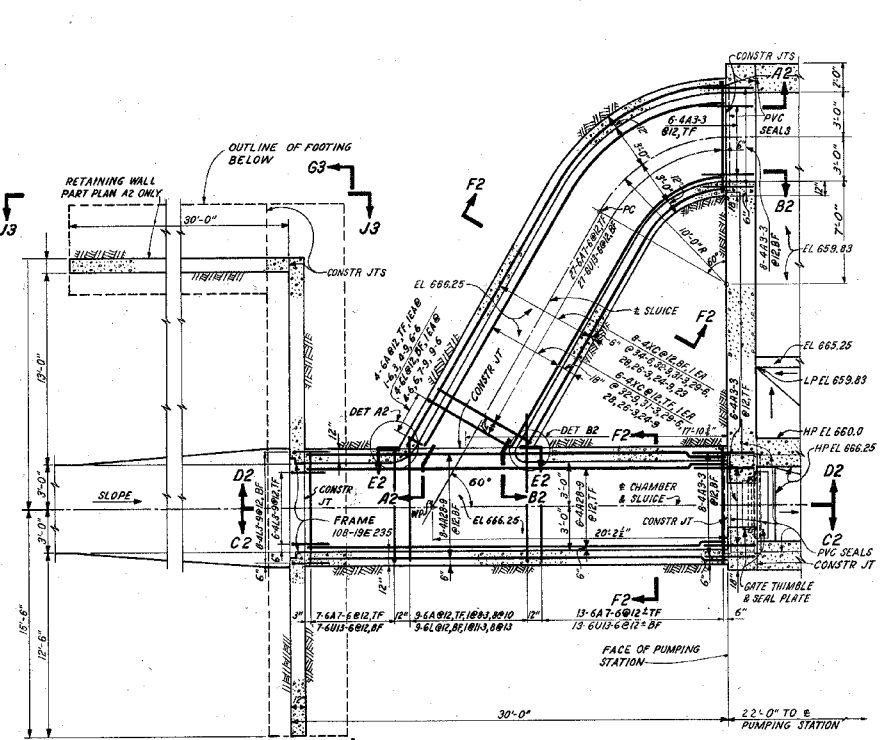

BENT BAR LIST							
BAR MARK	NO. REQD	BENDING DIMENSIONS					g
		a	b	c	e	f	
6L14-9	16	12-6				EX	
6L19-6	94	3-1	7-8			EX	
6L13	16	3-1				EX	
6L11-3	2	3-1				EX	
6L9-6	2	3-1				EX	
6L8-6	216	8-7				EX	
6L7-9	2	3-1				EX	
6L7-6	11	5-2				EX	
6L6	2	3-1				EX	
6K5-6	8	1-8	EX	1-2			
6L4-6	2	3-1				EX	
4XC35	10	20-9	EX				10-8
4XC34-6	4	20-9	EX				13-6
4XC34	10	20-2	EX				13-2
4XC34-9	8	19-9	EX				12-6
4XC31-3	8	19-3	EX				11-6
4XC29-6	8	18-6	EX				10-6
4XC28	8	18-0	EX				9-6
4XC28-3	8	17-3	EX				8-6
4XC24-9	8	17-0	EX				7-6
4XC23-6	10	16-6	EX				6-6
4XC23	4	16-9	EX				6-6
4XC22-9	10	16-2	EX				6-2
4X44-3	10	1-6	EX	0-7	1-4		
4X84	10	1-8	EX	1-11			3-5
4L3-9	110	1-6	EX				

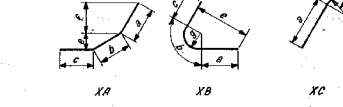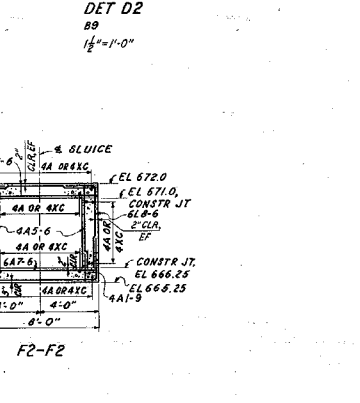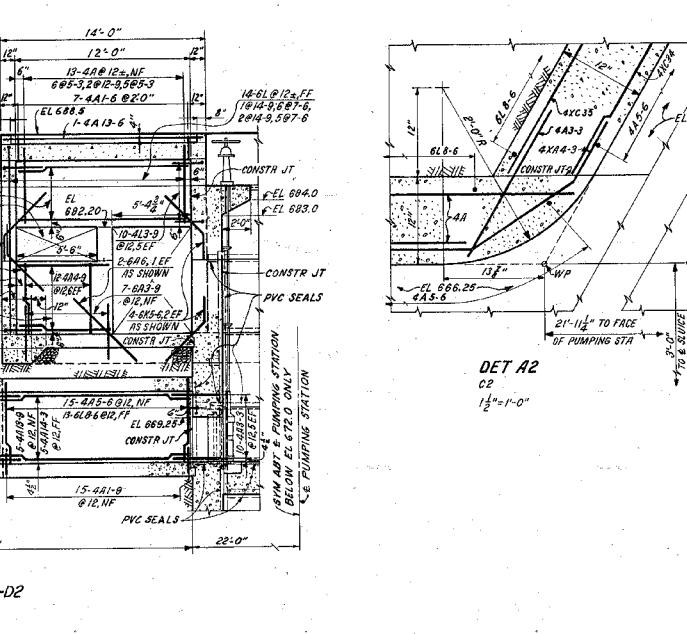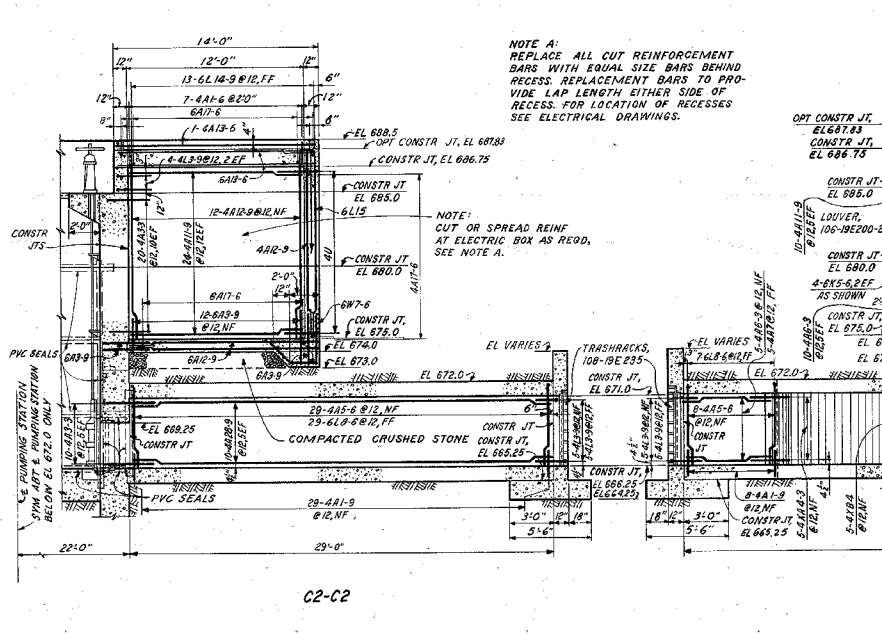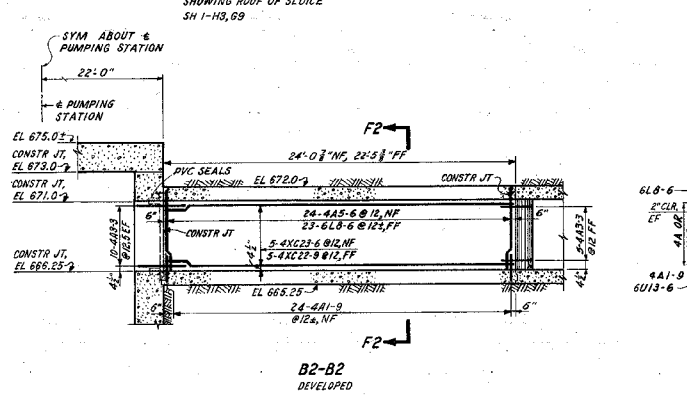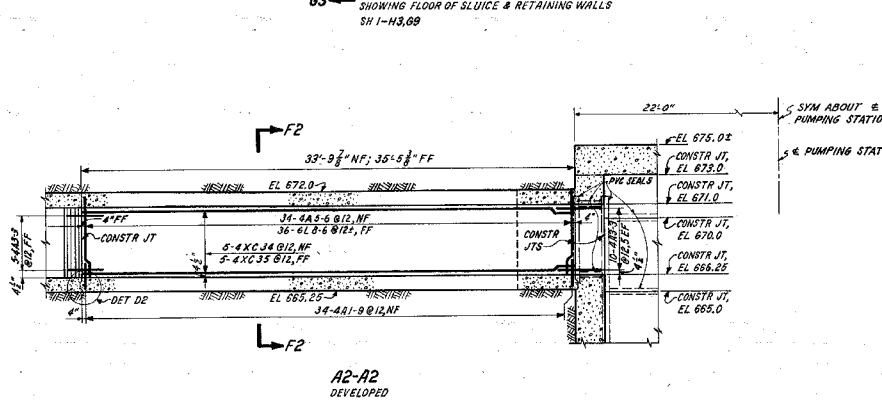

NOTE A: REPLACE ALL CUT REINFORCEMENT BARS WITH EQUAL SIZE BARS BEHIND RECESS. REPLACEMENT BARS TO PROVIDE LAP LENGTH EITHER SIDE OF RECESS. FOR LOCATION OF RECESSES SEE ELECTRICAL DRAWINGS.

NOTE: CUT OR SPREAD REINF AT ELECTRIC BOX AS REQD. SEE NOTE A.

NOTES:
1. FOR GENERAL NOTES AND REFERENCE DRAWINGS SEE 101-19E-235-1.

CHATTANOOGA FLOOD PROTECTION	
CONCRETE PUMPING STATION NO. 2	
OUTLINE & REINFORCEMENT	
SOUTH CHICKAMAUGA CREEK PROJECT	
TENNESSEE VALLEY AUTHORITY	
DIVISION OF ENGINEERING DESIGN	
SUBMITTED	RECOMMENDED
APPROVED	
KNOXVILLE 5-6-77 81 C 101-19E 235-2 R1	




SCALE 1/4"=1'-0" EXCEPT AS NOTED

INSPECTED AND APPROVED FOR ISSUE

DESIGN PROJECT MANAGER

DATE







PRINTED

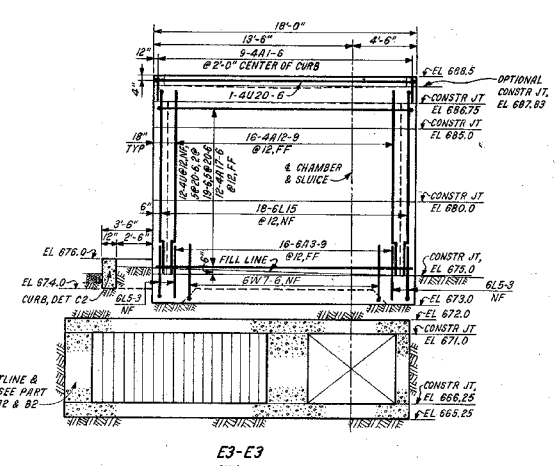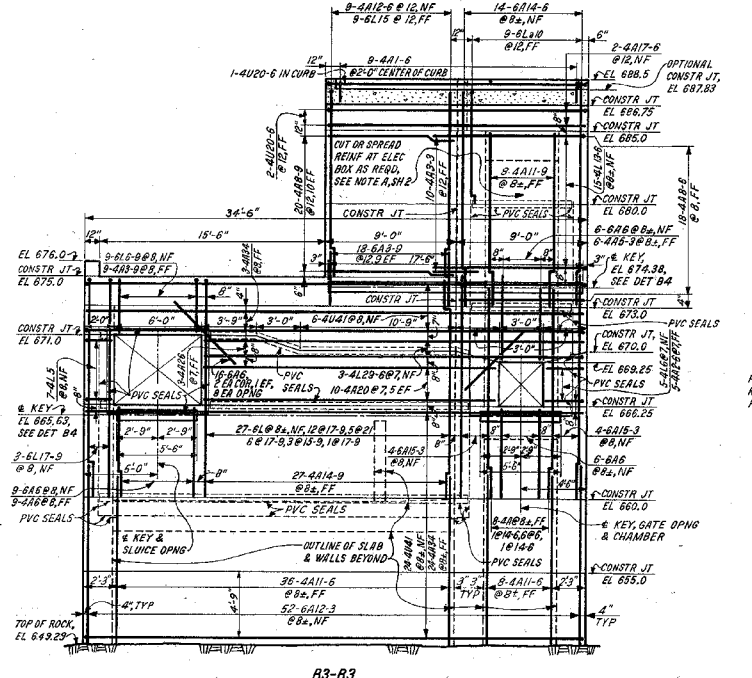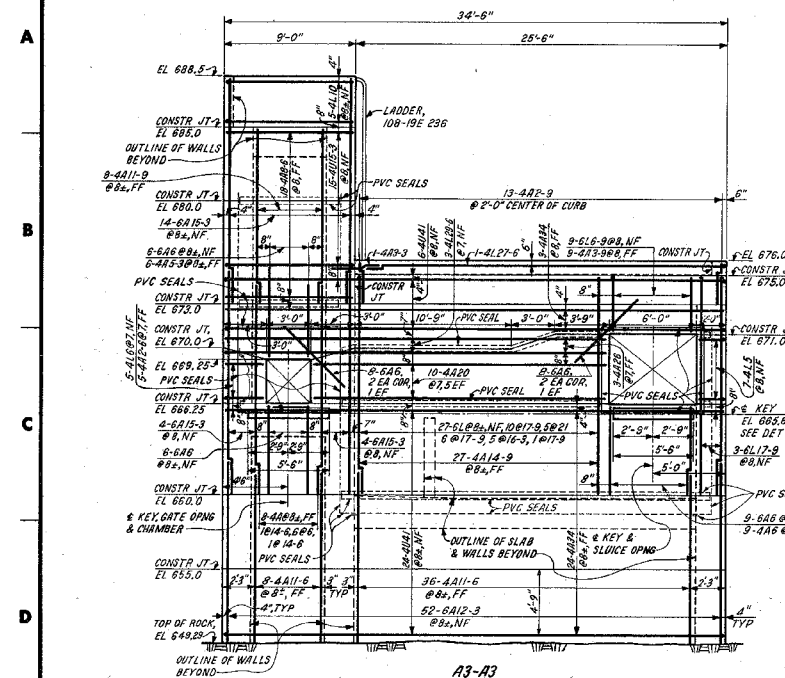

BENT BAR LIST									
BAR MARK	NO. REQD	BENDING DIMENSIONS							
		a	b	c	e	f	g		
6L21	10	14-10	EX						
6L17-9	42	14-10	EX						
6L16-3	5	14-10	EX						
6L15-9	3	14-10	EX						
6L15	27	12-8	EX						
6L13-3	3	11-3	EX						
6L13	5	11-0	EX						
6L12-9	5	10-9	EX						
6L12-6	4	10-6	EX						
6L12-3	4	10-3	EX						
6L12	6	10-0	EX						
6L11-9	4	9-9	EX						
6L11-6	2	9-6	EX						
6L11-3	6	9-3	EX						
6L11	8	9-0	EX						
6L10-9	8	9-9	EX						
6L10-6	8	9-6	EX						
6L10-3	7	9-3	EX						
6L10	5	9-0	EX						
6L10	9	7-8	EX						
6L9-9	4	7-8	EX						
6L9-6	4	7-6	EX						
6L9-3	2	7-3	EX						
6L8-9	18	3-7	EX						
6L8-6	12	1-8	EX						
4U41	80	3-7	30-4	EX					
4L29-6	6	20-0	EX						
4L27-6	1	20-0	EX						
4U20-6	14	1-7	17-6	EX					
4U19-6	2	0-7	17-6	EX					
4U18-3	15	3-6	8-5	EX					
4L14-9	1	11-3	EX						
4L14-6	5	11-0	EX						
4L14-3	5	10-9	EX						
4L14	4	10-6	EX						
4L13-9	19	10-3	EX						
4L13-6	6	10-0	EX						
4L13-3	4	9-9	EX						
4L13	2	9-6	EX						
4L12-9	6	9-3	EX						
4L12-6	8	9-0	EX						
4L12	8	8-9	EX						
4L11-9	7	8-3	EX						
4L11-6	5	8-0	EX						
4L11-3	4	7-9	EX						
4L11	4	7-6	EX						
4L10-9	2	7-3	EX						
4L10	5	8-6	EX						
4L6	10	2-6	EX						
4L5	26	1-6	EX						
4L3-9	22	1-6	EX						

BENT BAR LIST									
BAR MARK	NO. REQD	BENDING DIMENSIONS							
		a	b	c	e	f	g		
4L6	3	4-0	EX						
4L5-9	2	3-9	EX						
4L5-6	2	3-6	EX						

BENT BAR LIST									
BAR MARK	NO. REQD	BENDING DIMENSIONS							
		a	b	c	e	f	g		
6L8	3	8-0	EX						
6L7-9	2	5-9	EX						
6L7-6	2	5-6	EX						
6L7-3	3	5-3	EX						
6L7	3	5-0	EX						
6L6-9	2	4-9	EX						
6L6-6	2	4-6	EX						
6L6-3	3	4-3	EX						
6L6	3	4-0	EX						
6L5-9	2	3-9	EX						
6L5-6	2	3-6	EX						
4L8-6	24	6-6	EX						
4L8-3	3	6-3	EX						
4L8	3	6-0	EX						
4L8	1	6-6	EX						
4L7-9	2	5-9	EX						
4L7-6	1	6-6	EX						
4L7-3	3	6-3	EX						
4L7-3	1	6-6	EX						
4L7	3	6-0	EX						
4L6-9	2	4-9	EX						
4L6-6	2	4-6	EX						
4L6-3	3	4-3	EX						

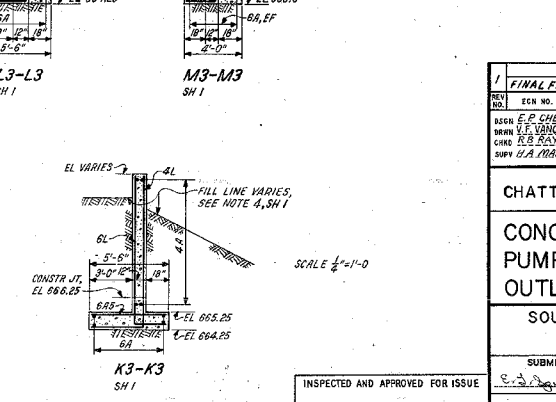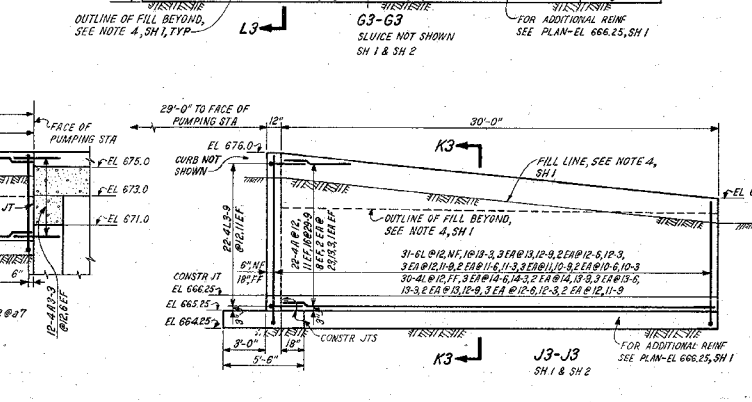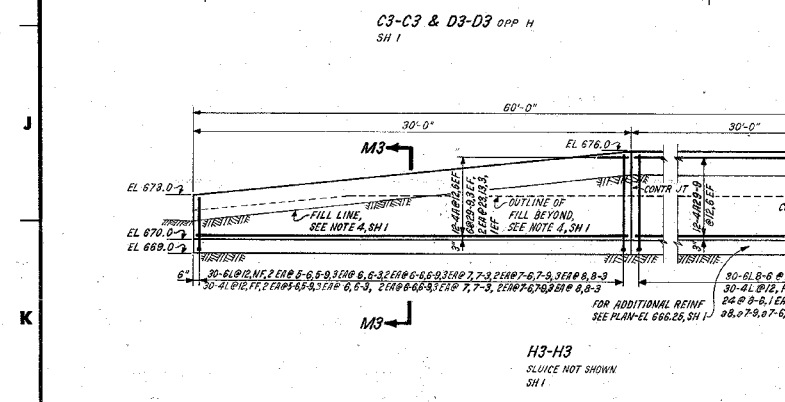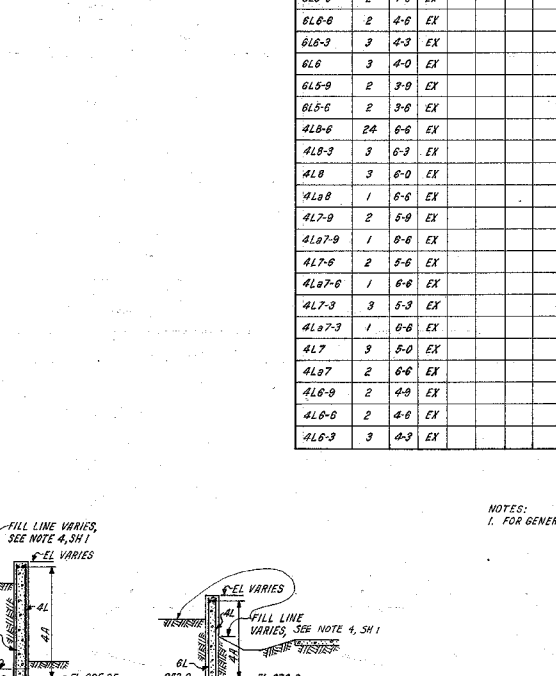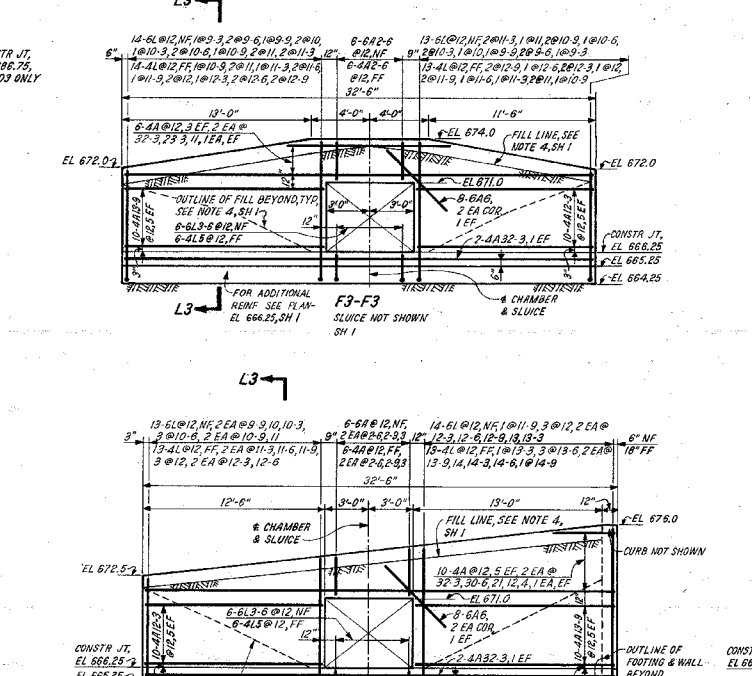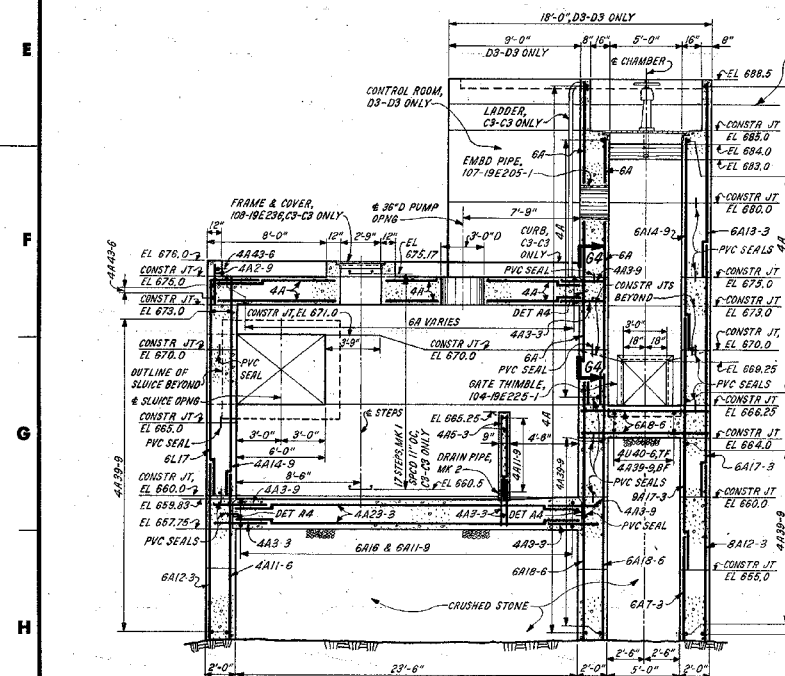

NOTES:
1. FOR GENERAL NOTES AND REFERENCE DRAWINGS SEE 101-19E235-1.

1-3-89									
NO.	DATE	BY	CHKD	APPV	INSP	RECH	APPV	APPV	APPV
1									

CHATTANOOGA FLOOD PROTECTION
CONCRETE
PUMPING STATION NO. 2
OUTLINE & REINFORCEMENT
SOUTH CHICKAMAUGA CREEK PROJECT
TENNESSEE VALLEY AUTHORITY
DIVISION OF ENGINEERING DESIGN

SUBMITTED: [Signature]
RECOMMENDED: [Signature]
APPROVED: [Signature]

KNOXVILLE 5-6-77 BI C 101-19E235-3 RI

INSPECTED AND APPROVED FOR ISSUE									
NO.	DATE	BY	CHKD	APPV	INSP	RECH	APPV	APPV	APPV
1									



SCALE 1/4"=1'-0"

PRINTED BY: [Signature]


DATE: [Signature]

BY: [Signature]

BENT BAR LIST						
BAR MARK	NO. REQD	BENDING DIMENSIONS				
		a	b	c	e	f
6L17	44	14'-8"	EX			
4L12-3	104	10'-10"	EX			
4L5	36	1'-6"	EX			
4L3-9	5	1'-6"	EX			

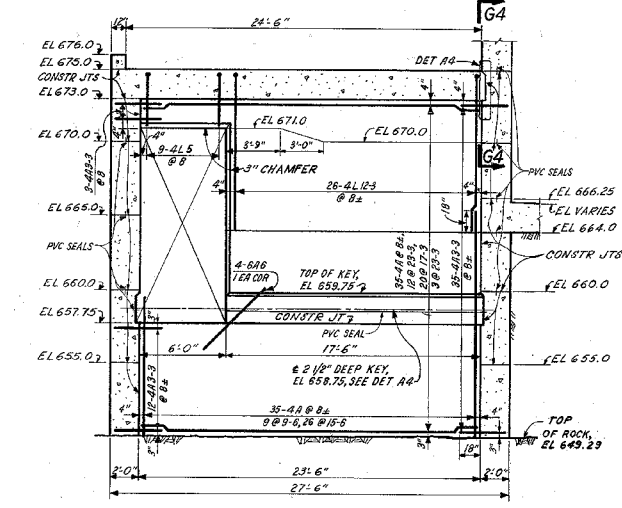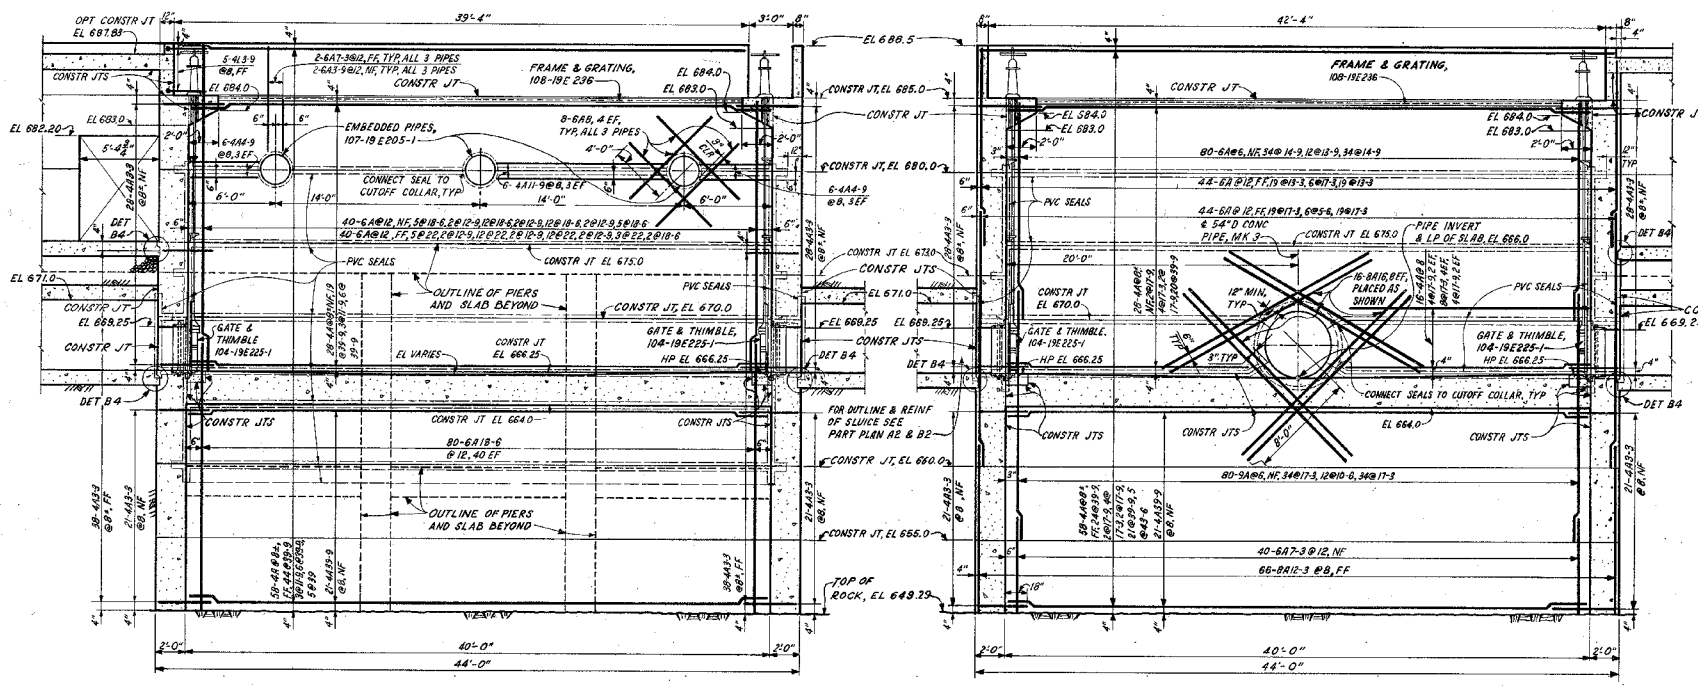


C4-C4 & D4-D4 OPP HAND
2 REQD
SLAB EL 659.83 NOT SHOWN
SH 1

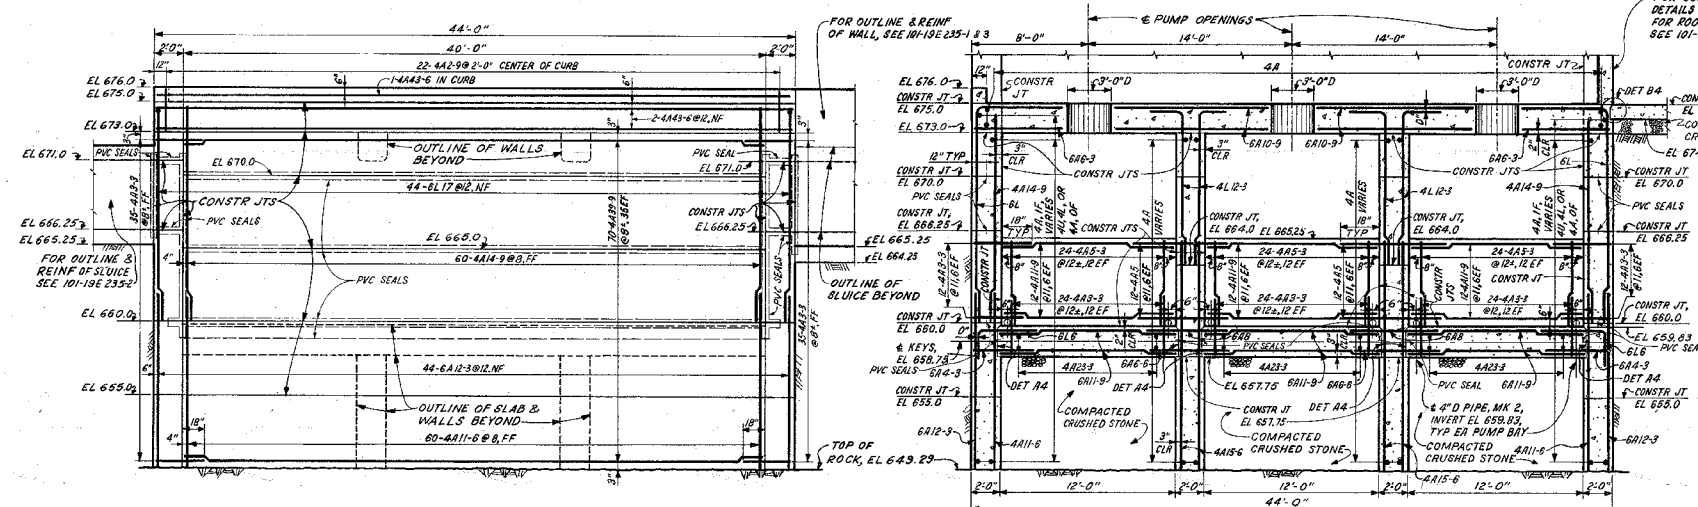


FOR CONTROL ROOM WALL
DETAILS SEE 101-19E235-2-3
FOR ROOF & FLOOR DETAILS,
SEE 101-19E235-1

E4-E4 SH 1
F4-F4 SH 1

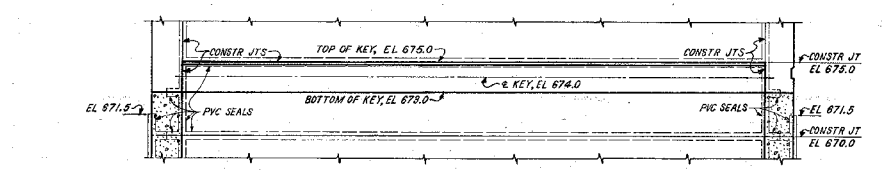

G4-G4
EL 676.0 SLAB NOT SHOWN
SH 3

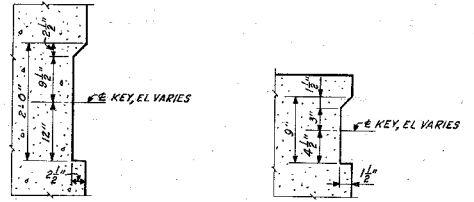

DET A4
1/2"=1'-0"

DET B4
1/2"=1'-0"

NOTES:
1. FOR GENERAL NOTES AND REFERENCE DRAWINGS SEE 101-19E235-1.

1	FINAL FIELD REV	DATE	DESIGN	CONSTRUCTION	INSPECTION	APPROVAL
NO.	NO.					
DESIGNER	E.P. CHEN	DATE	5-6-77	PROJECT	101-19E235-4 RI	
CHECKER	A.B. RAY	DATE		ENGINEER		
SUPPLIER	C.L. QUINN	DATE		APPROVED		

CHATTAHOOGA FLOOD PROTECTION
CONCRETE
PUMPING STATION NO.2
OUTLINE & REINFORCEMENT
SOUTH CHICKAMAUGA CREEK PROJECT
TENNESSEE VALLEY AUTHORITY
DIVISION OF ENGINEERING DESIGN















INSPECTED AND APPROVED FOR ISSUE
DESIGN PROJECT MANAGER
KNOXVILLE 5-6-77 81 c 101-19E235-4 RI
APPROVED
Frank Van Natta 12/31/81

SCALE 1/2"=1'-0" EXCEPT AS NOTED

PRINT	1	1/1	2
SIZE	F		
BR OR PROJ	ML	CE	AD
CD	EG	NO	BY
SH	SL	BL	AL
PRINTS	NEED	-	0

A
B
C
D
E
F
G
H
J
K

BENT BAR LIST						
BAR MARK	NO. REQD	BENDING DIMENSIONS				
		b	d	c	e	f
6XD12-3	16	3-9	0-7 1/2	3-9 1/2	EX	3-4
6C11-3	6					2-9 1/2
4U11-8	4	3-7	4-5 1/2	EX		
4U10	2	2-10	4-5 1/2	EX		
4U8-3	2	2-0	4-5 1/2	EX		

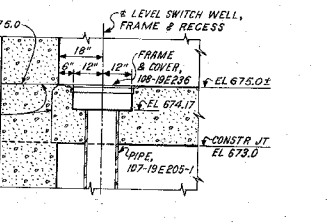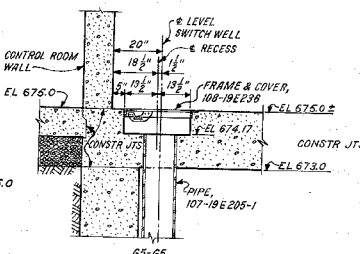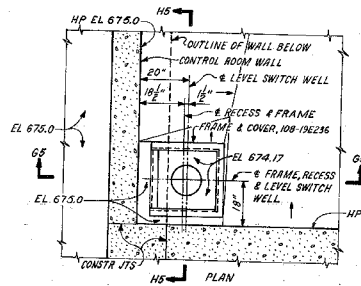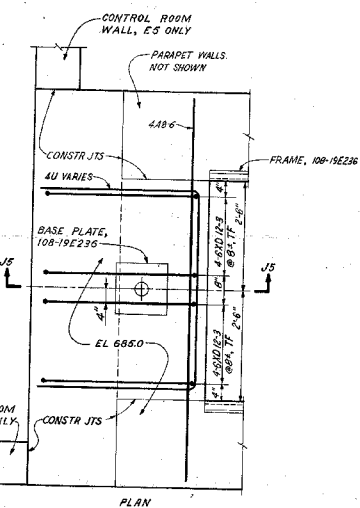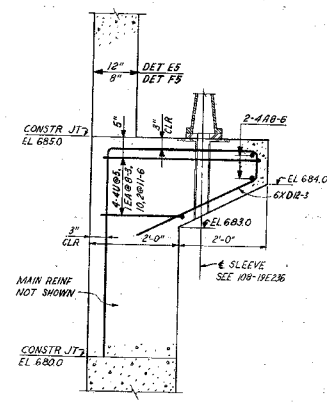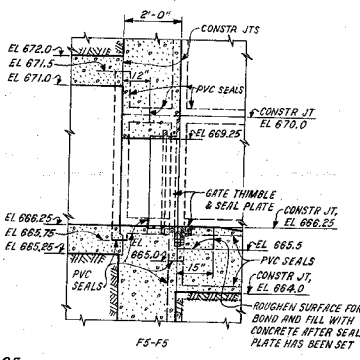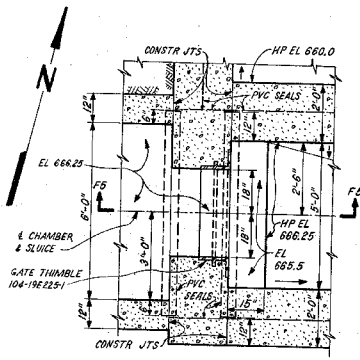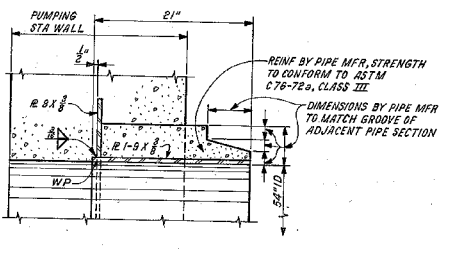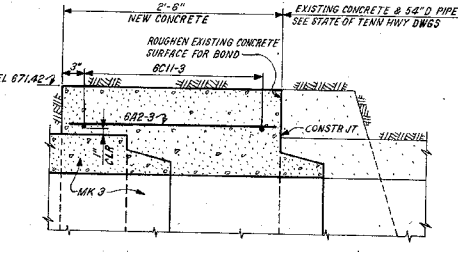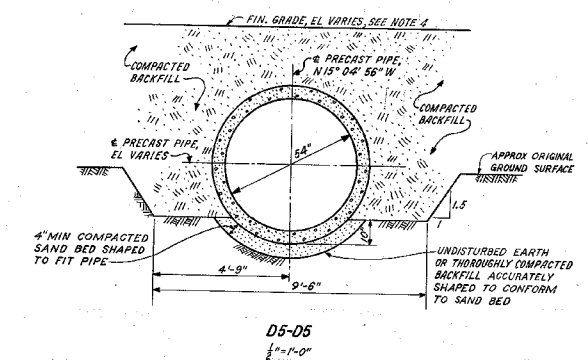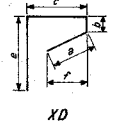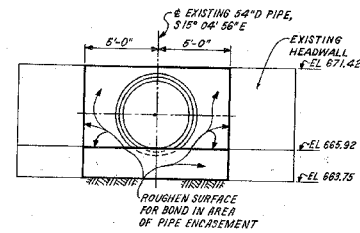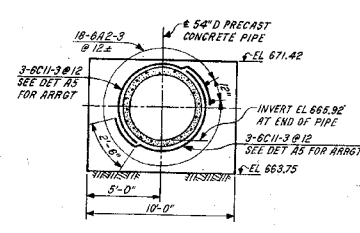
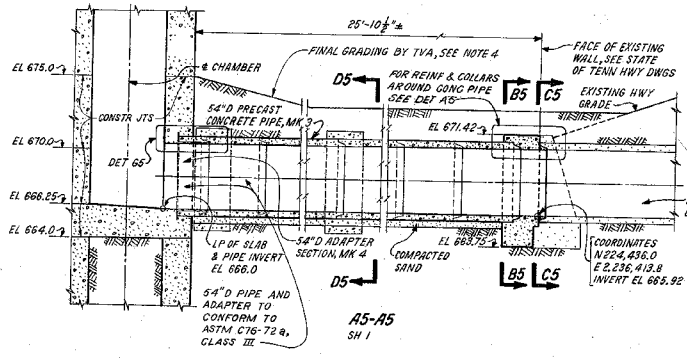


NOTES:
1. FOR GENERAL NOTES AND REFERENCE DRAWINGS SEE 101-19E235-1.


FINAL FIELD REV		1	1-3-83	DRW	JLM	REV	10/10/83	50
REV	NO.	DATE	ISSN	DRW	CHKD	ENGR	INSP	APPR
DRW	E. P. CHENG, J. P. BURKE							
CHKD	V. E. VANCE							
ENGR	R. B. BAY							
INSP	L. A. HANSON	2-11-82						
APPROVED								
CHATTANOOGA FLOOD PROTECTION								
CONCRETE PUMPING STATION NO. 2								
OUTLINE & REINFORCEMENT								
SOUTH CHICKAMAUGA CREEK PROJECT								
TENNESSEE VALLEY AUTHORITY								
DIVISION OF ENGINEERING DESIGN								
SUBMITTED		RECOMMENDED		APPROVED				
KNOXVILLE		5-6-77		81 C		101-19E235-5 R1		
SCALE 1/2"=1'-0" EXCEPT AS NOTED								

SCALE 1/2"=1'-0" EXCEPT AS NOTED

INSPECTED AND APPROVED FOR ISSUE	
DATE	
BY	
FOR PROJECT	
DATE	
BY	
FOR PROJECT	
DATE	
BY	

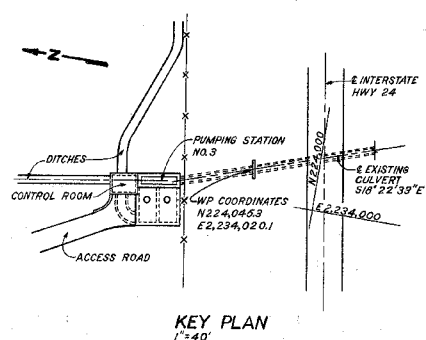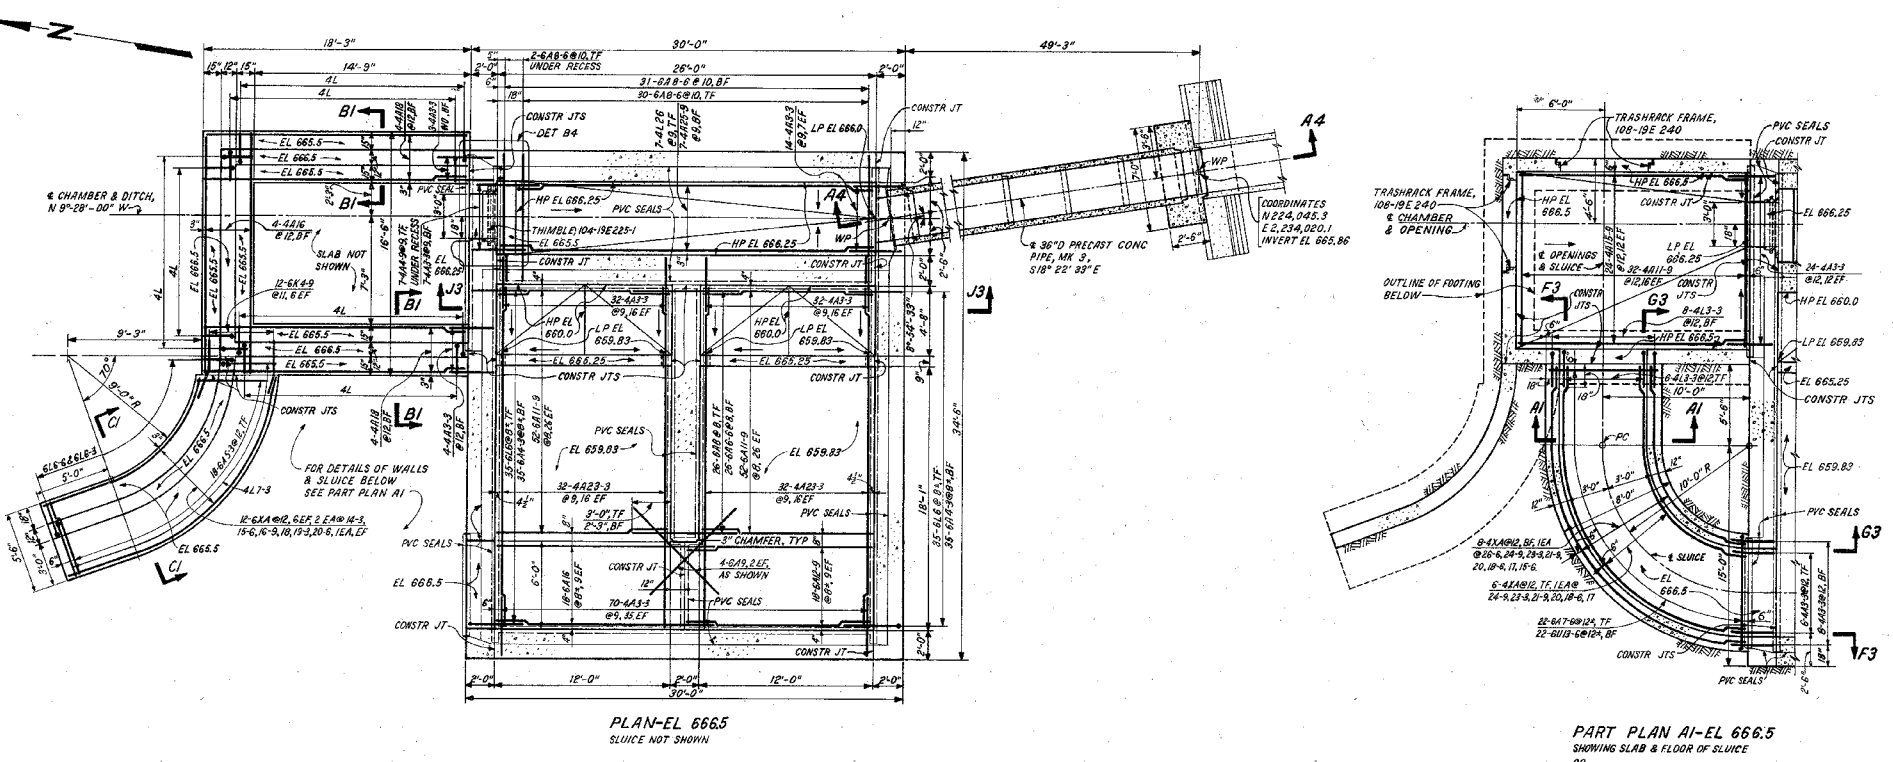


- NOTES:
- FORMED CONCRETE SURFACES SHALL BE FINISHED IN ACCORDANCE WITH SECTION 10.4 OF SPECIFICATIONS FOR STRUCTURAL CONCRETE FOR BUILDINGS (ACI 304-73), EXCEPT SURFACES EXPOSED TO PUBLIC VIEW SHALL HAVE A BROUT CLEANED FINISH. CONCRETE SLABS SHALL BE FINISHED IN ACCORDANCE WITH SECTION 11.6, ACI 304-73.
 - REINFORCING BARS SHALL BE BENT ACCORDING TO TVA ENGINEERING PROCEDURE DED-EP 7.08, DRAFTING STANDARDS-CIVIL-CONCRETE REINFORCING-BAR DETAILING-SECTION 12, ATTACHMENT 1.
 - CRUSHED STONE USED AS FILL MATERIAL UNDER CONCRETE SLABS SHALL CONFORM TO TVA HIGHWAY SPECIFICATION NO. T-1, SECTION 103.2.
 - FINAL GRADING BY TVA IN ACCORDANCE WITH DRAWING NO. 81-C-101-19E245-1 & 2.
 - FOR ADDITIONAL REQUIREMENTS SEE TVA SPECIFICATION FOR THE CONSTRUCTION OF PUMPING STATIONS 1, 2 & 3 FOR SOUTH CHICKAMAUGA CREEK PROJECT.

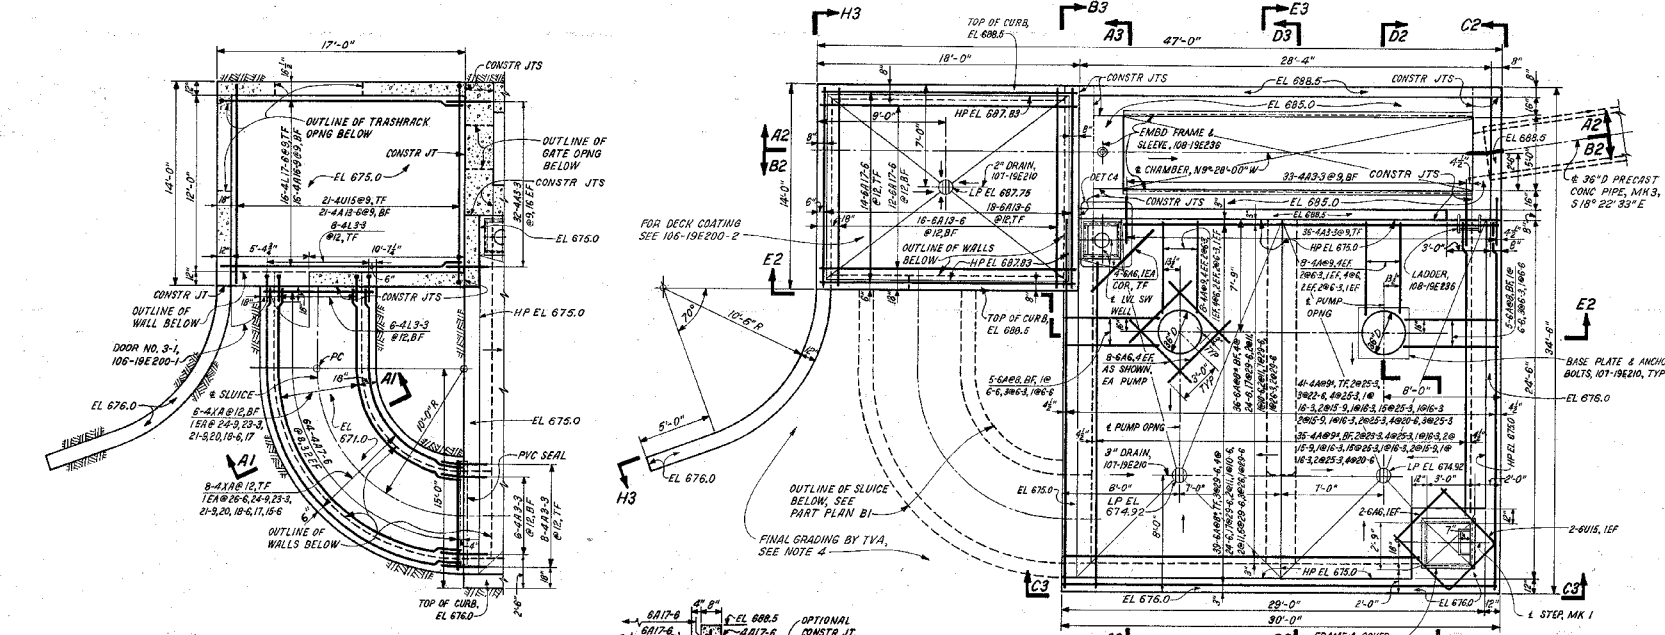


BENT BAR LIST								
BAR MARK	NO. REQD	BENDING DIMENSIONS						
		a	b	c	e	f	g	
6XA20-6	2	4-9	EX					14-3
6XA19-3	2	4-9	EX					13-3
6XA18	2	4-9	EX					12-3
6XA16-9	2	4-9	EX					11-3
6XA15-6	2	4-9	EX					10-3
6U15	2	5-4	4-7	EX				
6XA14-3	2	4-9	EX					9-3
6U13-6	22	3-1	7-8	EX				
6L6	70	1-3	EX					
6K4-9	12	2-7	EX	2-6				
4XA26-6	2	5-6	EX					13-6
4L26	7	2-6	EX					
4XA24-9	4	5-6	EX					12-6
4XA23-3	4	5-6	EX					11-6
4XA21-9	4	5-6	EX					10-6
4XA20	4	5-6	EX					9-6
4XA18-6	4	5-6	EX					8-6
4L17-6	18	18-9	EX					
4XA17	4	5-6	EX					7-6
4XA15-6	2	5-6	EX					6-6
4U15	21	0-10	13-6	EX				
4L3-3	28	2-3	EX					


REFERENCE DRAWING: 19B1240.....BILL OF MATERIAL

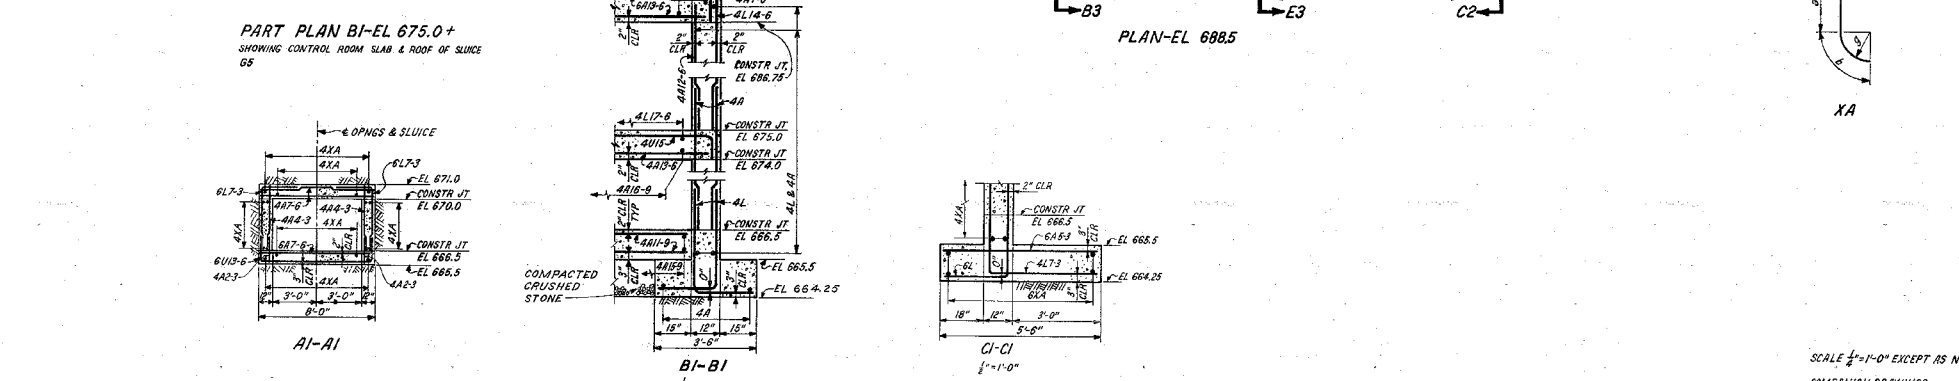


CHATTANOOGA FLOOD PROTECTION									
CONCRETE PUMPING STATION NO. 3 OUTLINE & REINFORCEMENT									
SOUTH CHICKAMAUGA CREEK PROJECT TENNESSEE VALLEY AUTHORITY DIVISION OF ENGINEERING DESIGN									
DESIGNER	PROJECT MANAGER	DATE	SCALE	NO.	REV.	BY	CHKD.	APPD.	DATE
E. J. BURKE	R. D. BAY	4-13-77	1/4" = 1'-0"	81	c	101-19E240-1 R0			
SUBMITTED: [Signature] RECOMMENDED: [Signature] APPROVED: [Signature]									
INSPECTED AND APPROVED FOR ISSUE: [Signature]									
RECORD DRAWING AS SHOWN ON CONTRACT									
DATE OF ISSUE: 4-13-77									
SCALE: 1/4" = 1'-0" EXCEPT AS NOTED									
COMPANION DRAWINGS: 101-19E240-1 THRU 4									
PRINT: [Signature]									
SIZE: [Signature]									
NO. OR PROJ. ME. EL. CL. AS CO. TO NO. OF SW. BY. BY. FA. PRINTS: 800-2									

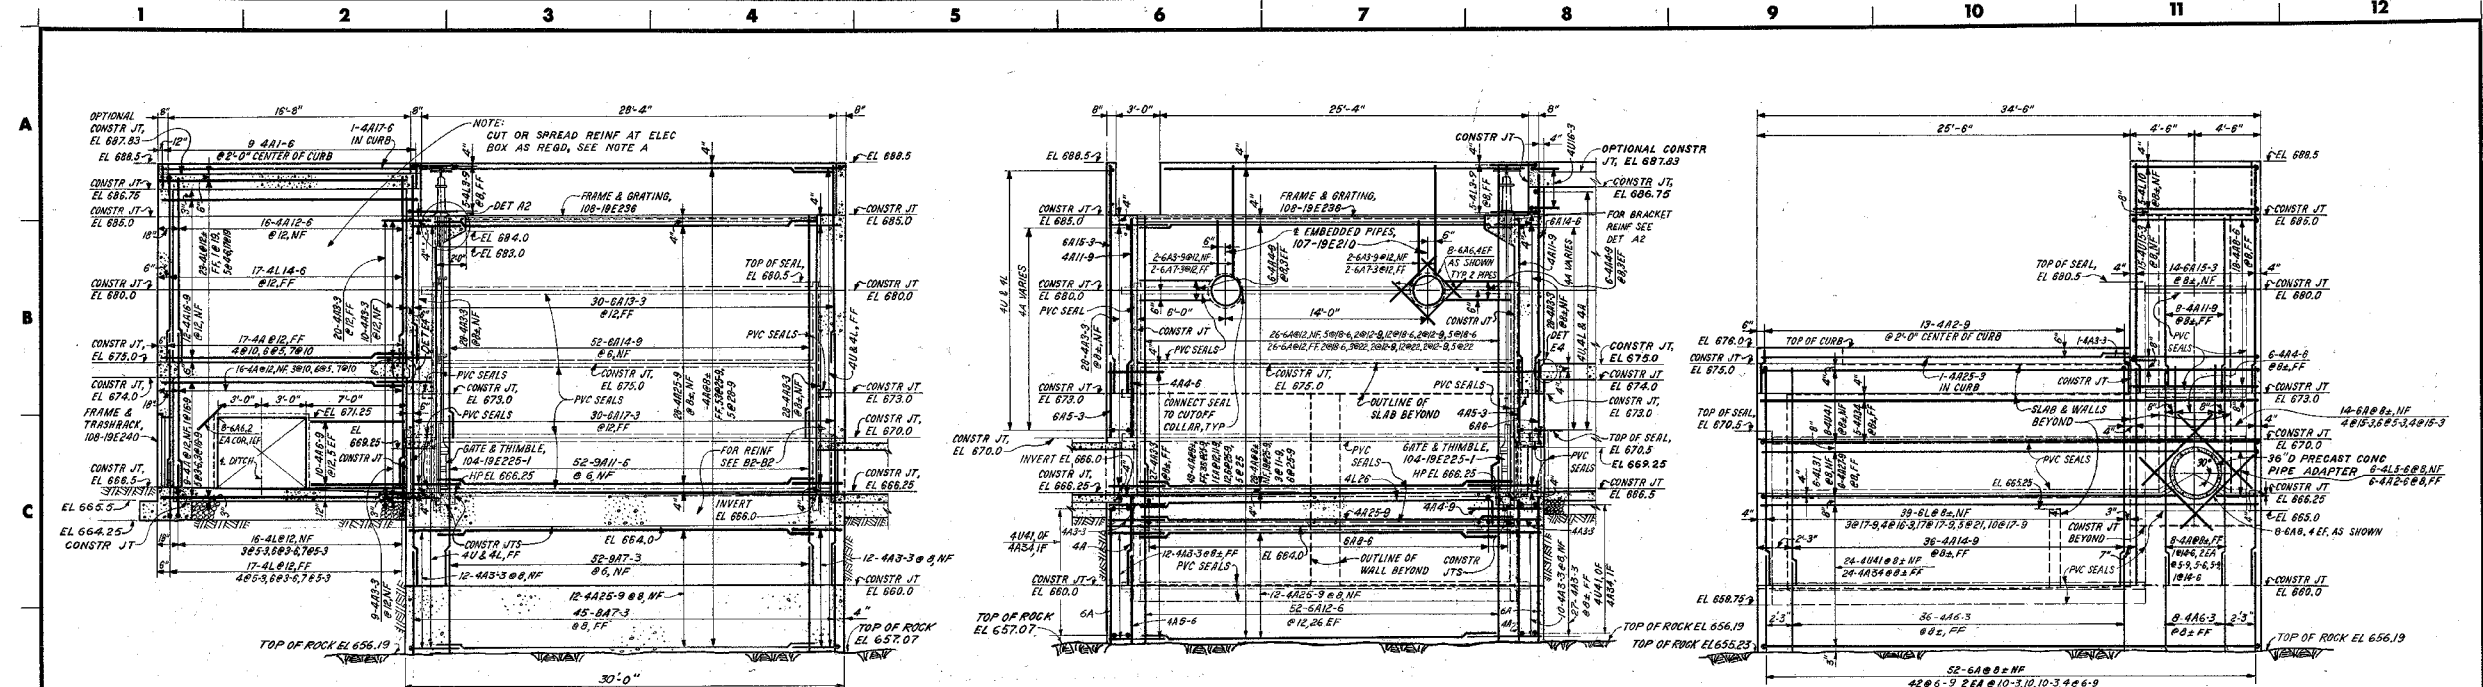

A2-A2 SH 1
B2-B2 SH 1
C2-C2 SH 1

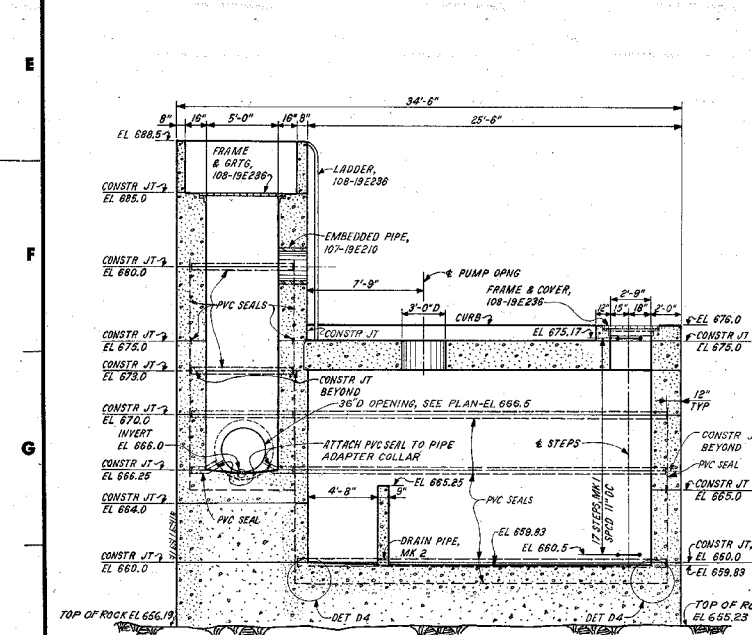



D2-D2 REINF NOT SHOWN SH 1

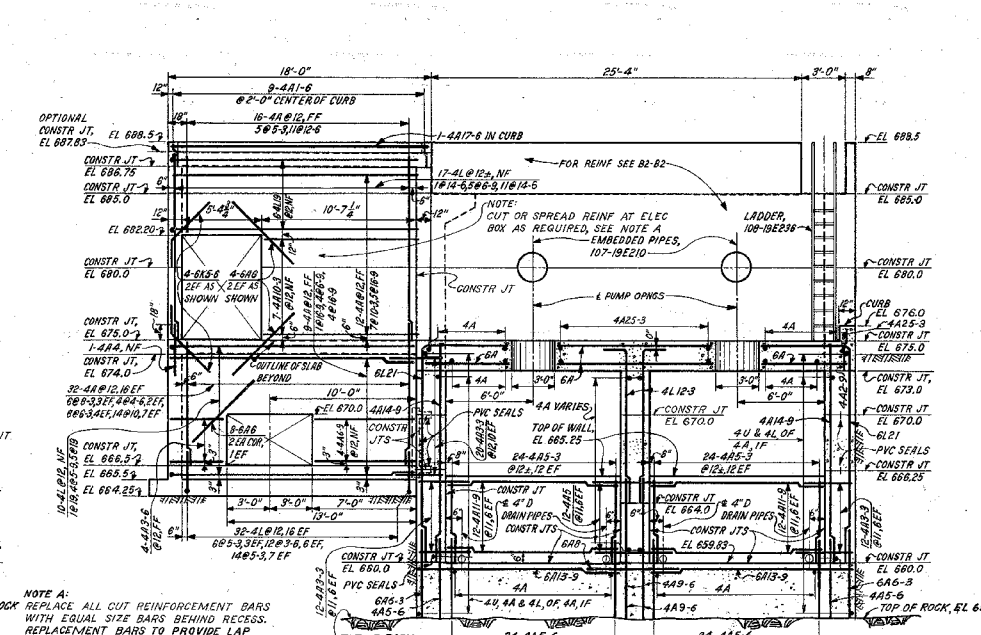

E2-E2 SLICE NOT SHOWN SH 1


BENT BAR LIST

BAR MARK	NO. REQD	B	D	C	E	F	G
6L21	5	14-10	EX				
6L17-9	30	14-10	EX				
6L16-3	4	14-10	EX				
6A12-3	8	3-8	0-7	3-6	EX	3-4	
6A5-6	4	1-8	EX	1-2			
4U41	32	3-7	33-11	EX			
4L31	6	27-9	EX				
4L19	30	10-9	EX				
4U15-3	15	3-6	8-5	EX			
4L14-6	20	12-8	EX				
4U11-6	2	3-7	4-5	EX			
4L10	5	8-6	EX				
4U10	1	2-10	4-5	EX			
4U8-3	1	2-10	4-5	EX			
4L8-9	5	3-3	EX				
4L8-9	4	3-6	EX				
4L5-6	6	2-5	EX				
4L5-3	41	3-6	EX				
4L4-6	5	3-6	EX				
4L3-9	10	1-6	EX				
4L3-6	24	1-9	EX				

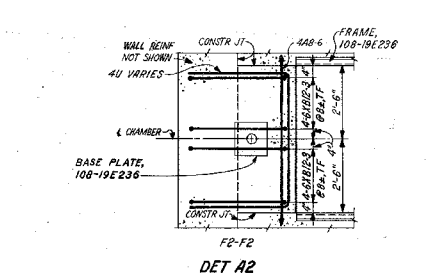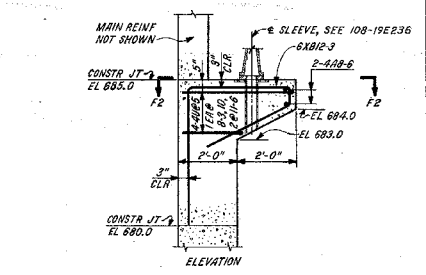

DET A2
RE
1/4"=1'-0"

NOTES:
1. FOR GENERAL NOTES AND REFERENCE DRAWINGS SEE 101-19E240-1.

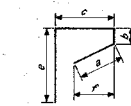





XB

1 FINAL FIELD REV		1-3-03	DLW/JUN	RDW	101-19E240-2
REV	NO.	DATE	ISSUED BY	DESIGNED BY	CHECKED BY
CHATTANOOGA FLOOD PROTECTION					
CONCRETE PUMPING STATION NO. 3					
OUTLINE & REINFORCEMENT					
SOUTH CHICKAMAUGA CREEK PROJECT					
TENNESSEE VALLEY AUTHORITY					
DIVISION OF ENGINEERING DESIGN					
SUBMITTED		RECOMMENDED		APPROVED	
E. J. CHENG		J. P. BURKE		[Signature]	
DESIGN		PROJECT MANAGER		KNOXVILLE 4-19-77	
81 C		101-19E240-2 RI		1/3/81	





INSPECTED AND APPROVED FOR ISSUE
DESIGN PROJECT MANAGER
KNOXVILLE 4-19-77
81 C 101-19E240-2 RI
1/3/81

1 2 3 4 5 6 7 8 9 10 11 12

A
B
C
D
E
F
G
H
J
K

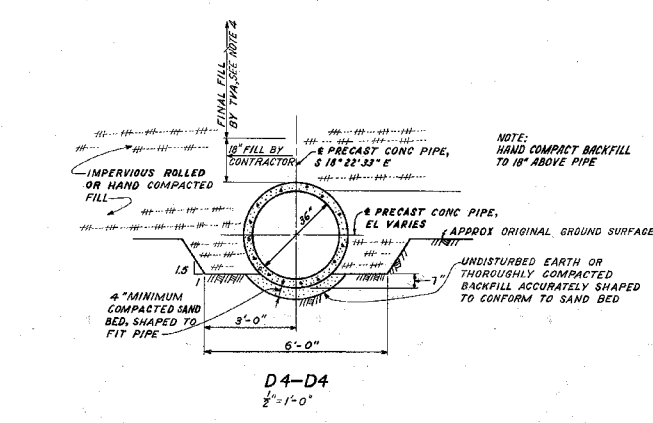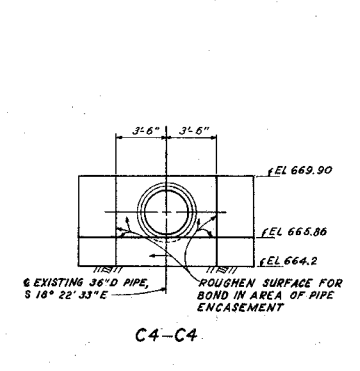
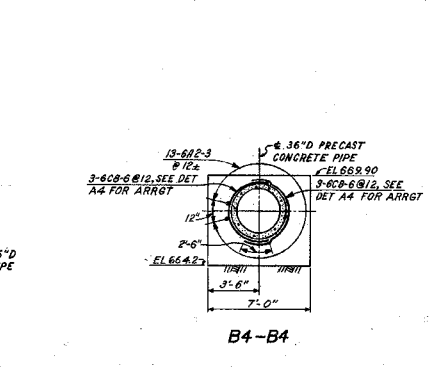
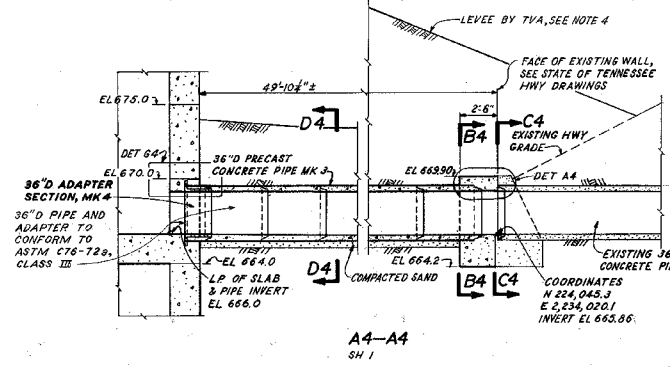


BENT BAR LIST							
BAR MARK	NO. REQD	BENDING DIMENSIONS					
		a	b	c	e	f	g
6C8-6	6						1-11

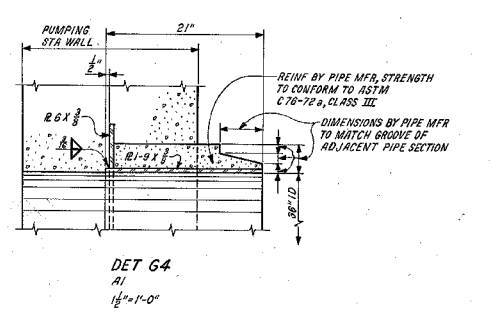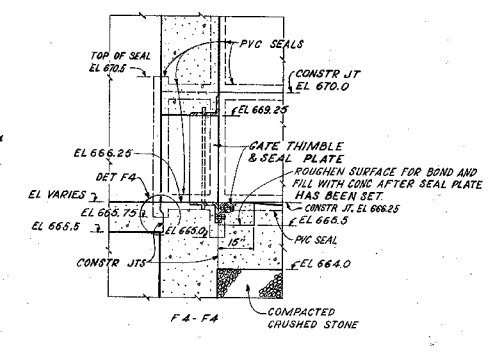
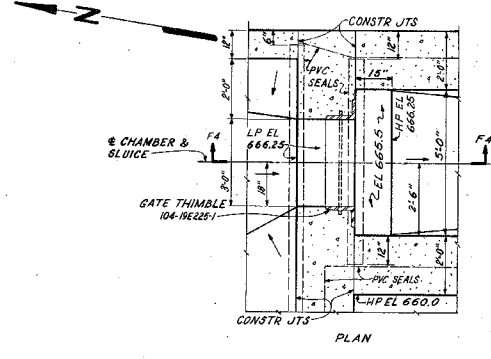
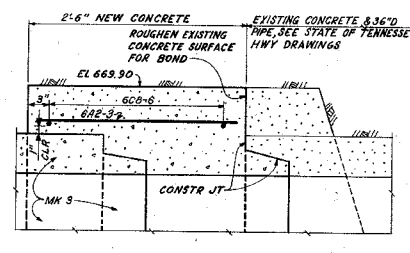


DET A4
A3
1/2"=1'-0"

DET B4
SHOWING OUTLINE ONLY
SH 1-A3
1/2"=1'-0"

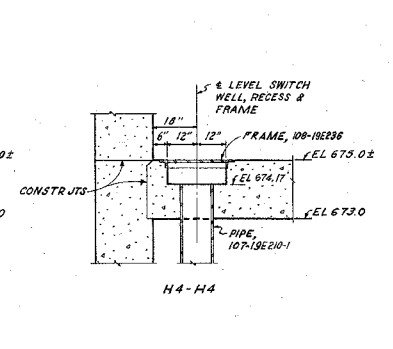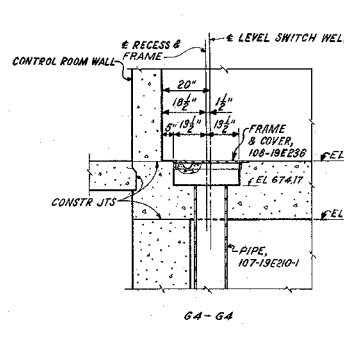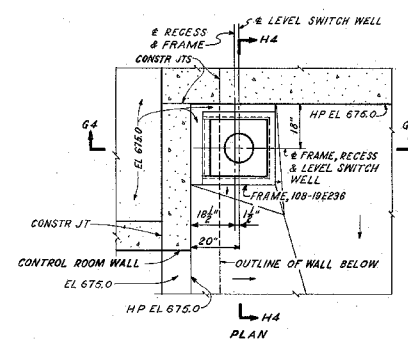

DET C4
SHOWING OUTLINE ONLY
SH 1-F8
1/2"=1'-0"

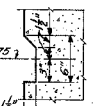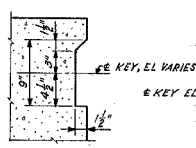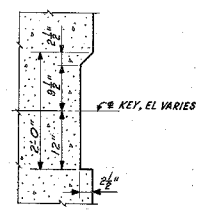

DET D4
SHOWING OUTLINE ONLY
SH 2-H2,H3
1"=1'-0"

DET E4
SHOWING OUTLINE ONLY
SH 2-B2,B8
1/2"=1'-0"

DET F4
SHOWING OUTLINE ONLY
D7
1/2"=1'-0"

NOTES:
1. FOR GENERAL NOTES AND REFERENCE DRAWINGS SEE 101-19E240-1.

SCALE 1/2"=1'-0" EXCEPT AS NOTED


REV	DATE	BY	CHECKED	APP'D
1	10/19/77	E.P. CHENG	J.P. BUENE	
DESIGN PROJECT MANAGER				
KNOXVILLE 4-19-77 81 C 101-19E240-4 R0				

CHATTANOOGA FLOOD PROTECTION
CONCRETE PUMPING STATION NO. 3
OUTLINE & REINFORCEMENT
SOUTH CHICKAMAUGA CREEK PROJECT
TENNESSEE VALLEY AUTHORITY
DIVISION OF ENGINEERING DESIGN

INSPECTED AND APPROVED FOR ISSUE
DESIGN PROJECT MANAGER
KNOXVILLE 4-19-77 81 C 101-19E240-4 R0

POINT	H	1	2
SIZE	F	1/8"	1/4"
OR PRODUCE BY	CE	CO	CU
OR PRINTED BY	CE	CO	CU


A
B
C
D
E
F
G
H
J
K

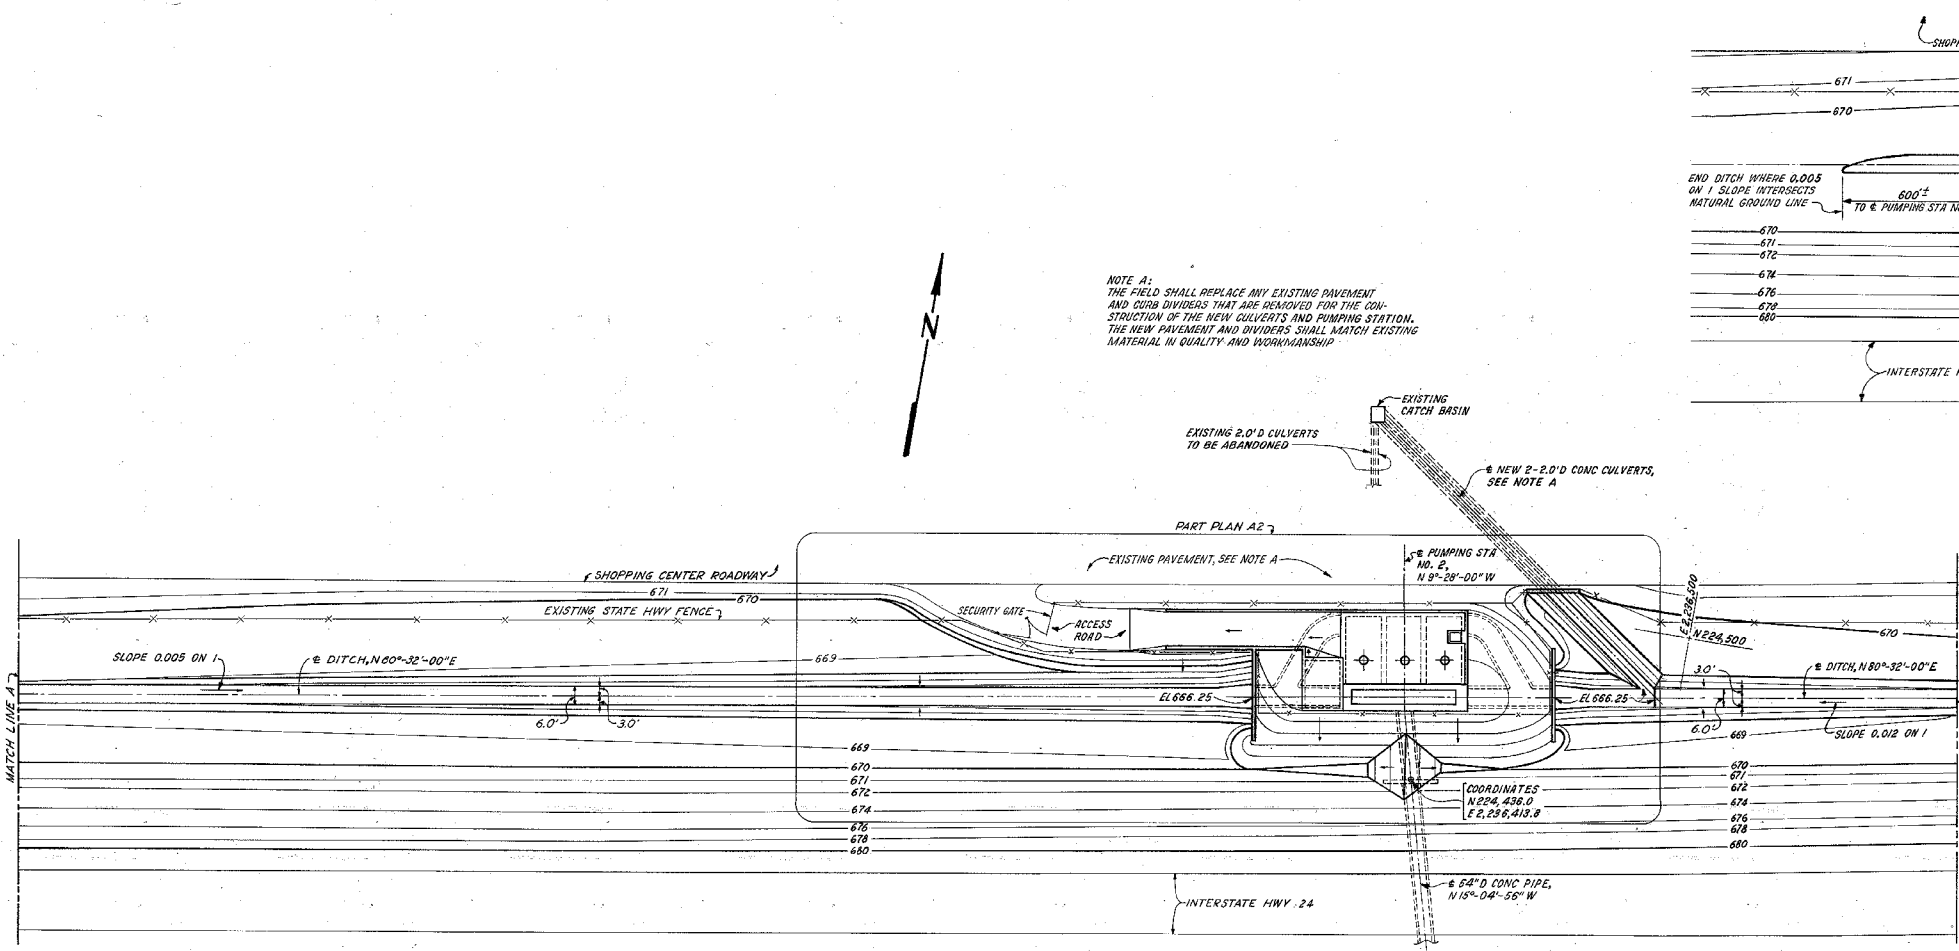


NOTE A:
THE FIELD SHALL REPLACE ANY EXISTING PAVEMENT AND CURB DIVIDERS THAT ARE REMOVED FOR THE CONSTRUCTION OF THE NEW CULVERTS AND PUMPING STATION. THE NEW PAVEMENT AND DIVIDERS SHALL MATCH EXISTING MATERIAL IN QUALITY AND WORKMANSHIP.

PLAN

- NOTES:
1. ALL CONCRETE SHALL BE PLACED IN ACCORDANCE WITH GENERAL CONSTRUCTION SPECIFICATION NO. 6-2. CONCRETE SHALL BE CLASS 300.75 AFW.
 2. FORMWORK SHALL BE IN ACCORDANCE WITH GENERAL CONSTRUCTION SPECIFICATION NO. 6-3. FORM LINING FOR EXPOSED CONCRETE SURFACES SHALL BE TYPE A OR TYPE D.
 3. CHAMFER ALL EXPOSED EXTERIOR EDGES 3/4"
 4. WELDING OF OR TO HIGH STRENGTH REINFORCING BARS WITHOUT APPROVAL OF CIVIL ENGINEERING AND DESIGN BRANCH IS PROHIBITED.
 5. ALL REINFORCEMENT ON THIS DRAWING SHALL CONFORM TO ASTM SPECIFICATION A615, GRADE 60.
 6. FOR ADDITIONAL NOTES SEE 101-19E205-1 & 2.

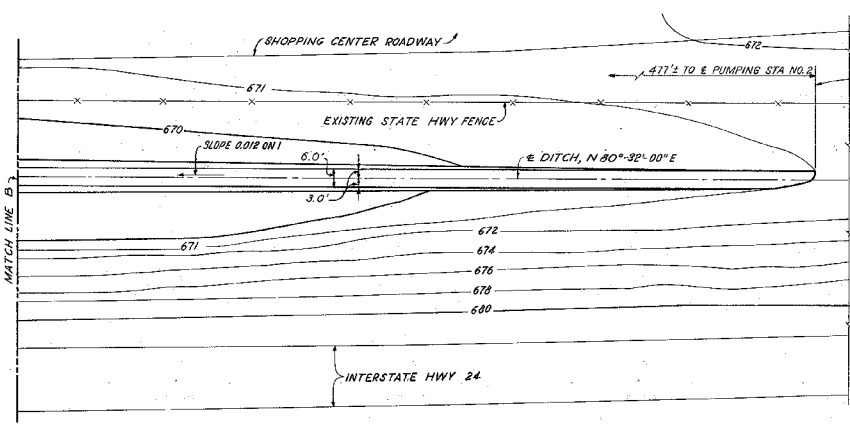

PLAN

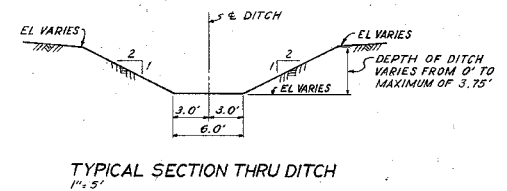

TYPICAL SECTION THRU DITCH
1" = 5'

SCALE 1" = 20' EXCEPT AS NOTED
COMPARISON DRAWINGS:
101-19E245-1 & 2

REV	NO.	ECN NO.	DATE	DESIGN	CHECK	INSP	INSP	INSP	MECH	APPR
055N										
055N										
055N										

CHATTANOOGA FLOOD PROTECTION
PUMPING STATION NO. 2
FINAL GRADING AND
DRAINAGE STRUCTURES
PLAN & SECTIONS

SOUTH CHICKAMAUGA CREEK PROJECT
TENNESSEE VALLEY AUTHORITY
DIVISION OF ENGINEERING DESIGN

INSPECTED AND APPROVED FOR ISSUE: *E. J. [Signature]*
DESIGN PROJECT MANAGER: *[Signature]*

APPROVED: *[Signature]*
RECOMMENDED: *[Signature]*

NO. 101-19E245-1 RO
DATE 11/27/01 RO

PKMT	H	16	13
SIZE	F	3	1

BY OR PROX ME CE AD CD ED NO BP SW EL VA
UNITS: METRIC-SI

STRAIGHT REINFORCEMENT BAR LIST

(FOR FIELD INFORMATION ONLY)

MADE J.L. MAXEY

FOR DWG. NO. 101-19E245-1&2 RD

CHKD: HAM
 for 3-17-28


SHEET NO 1 OF 1

DATE 10-31-77

PROJECT S. CHICKAMAUGA CREEK

BUILDING PUMPING STATION NO. 2
FINAL GRADING

BAR SIZE	BAR LENGTH	NO. REQ'D	BAR SIZE	BAR LENGTH	NO. REQ'D	BAR SIZE	BAR LENGTH	NO. REQ'D
6	7-0	4						

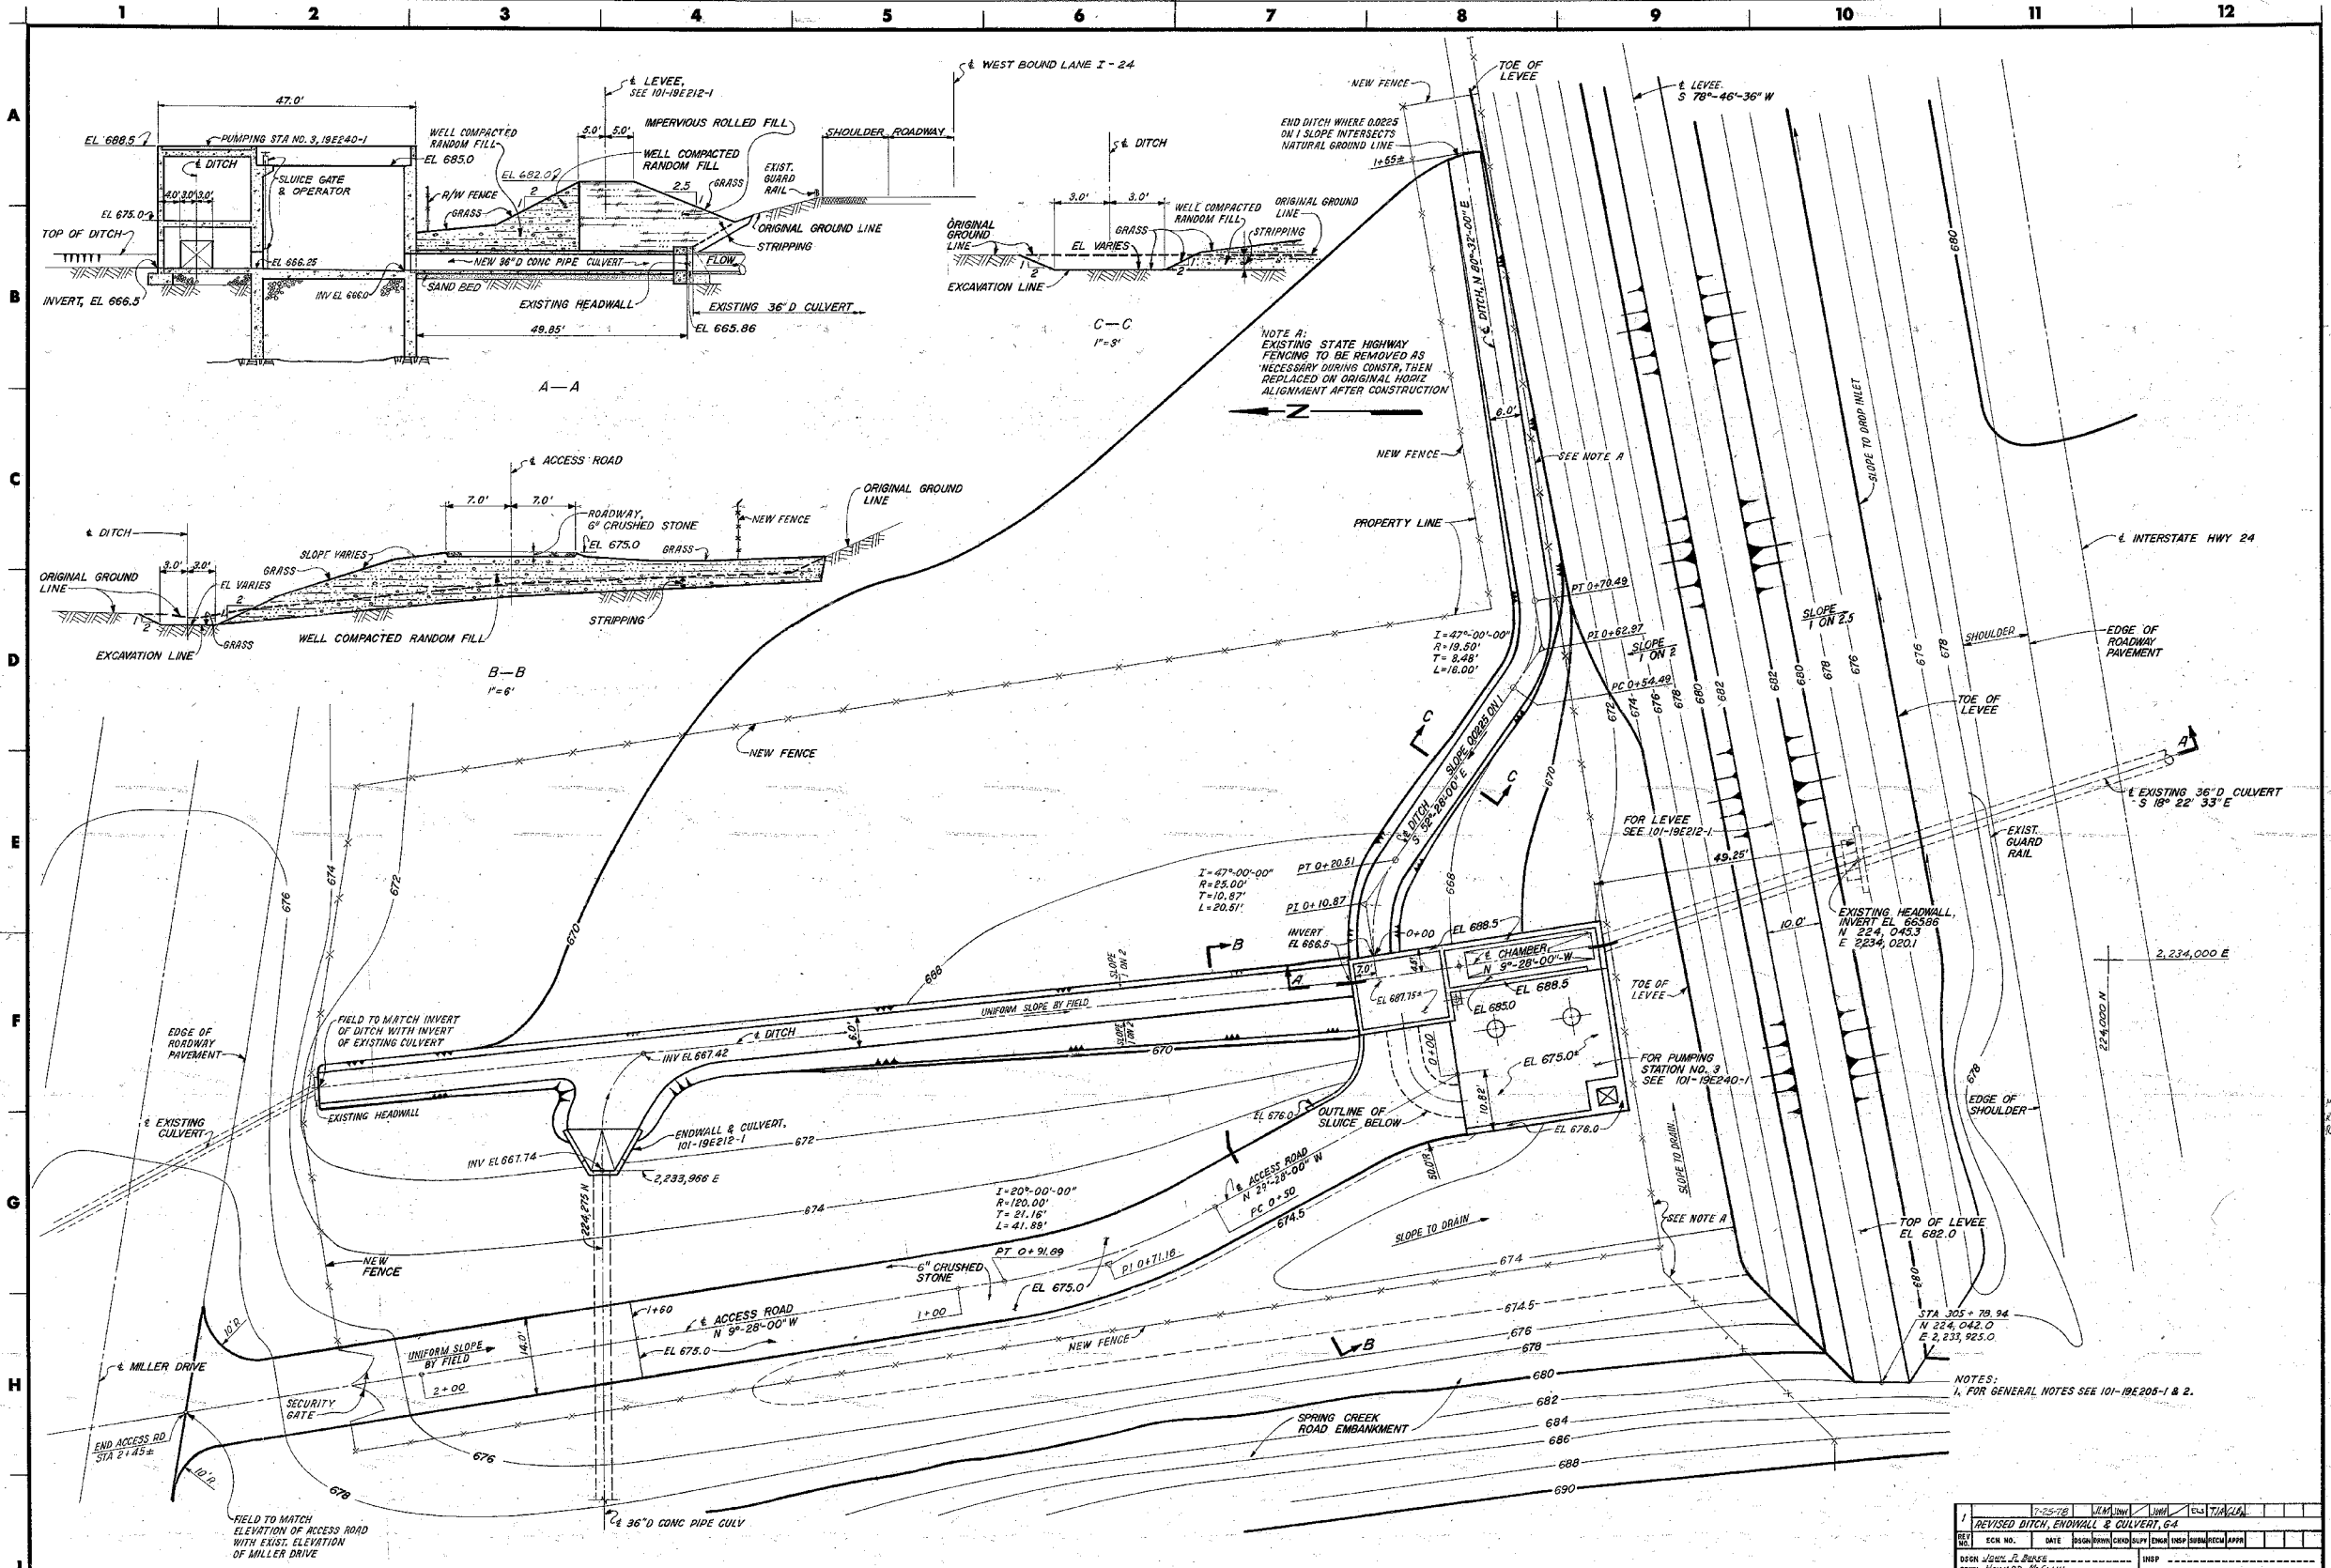

PLAN

1	REVISED DITCH, ENDWALL & CULVERT, C4	DATE	BY	CHECKED	DATE	BY	CHECKED
2							
3							
4							
5							
6							
7							
8							
9							
10							
11							
12							

CHATTANOOGA FLOOD PROTECTION PUMPING STATION NO. 3

FINAL GRADING PLAN & SECTIONS

SOUTH CHICKAMAUGA CREEK PROJECT TENNESSEE VALLEY AUTHORITY DIVISION OF ENGINEERING DESIGN

SUBMITTED	RECOMMENDED	APPROVED
<i>[Signature]</i>	<i>[Signature]</i>	<i>[Signature]</i>

KNOXVILLE 6-7-78 at c 101-19E246 RI

SCALE 1"=10' EXCEPT AS NOTED

INSPECTED AND APPROVED FOR ISSUE

PRINT	IN	2	7
SIZE	F	2	7
BY OR PROJ	BY	BY	BY
DATE	DATE	DATE	DATE
PRINTED	RECORD	DATE	BY

CONCRETE	CURB
LOCATION	ITEM NO. 390 LIN. FT.
10+30 - 2+42.57 R	1142.57
10+30 - 14+29.52 L	407.42
14+51.52 - 17+25.20 L	352.22
17+47.20 - 22+11.13 L	478.20
BONNIEWAY DRIVE	369.00
MARIA AVENUE	174.00
TOTAL	2923.41 *

LENGTH OF PROJECT	
END OF PROJECT	22+11.13
BEGINNING OF PROJECT	10+00
NET LENGTH IN FEET	1,211.13'
NET LENGTH IN MILES	0.23
BONNIEWAY DR. EXTENSION	209.50'
MARIA AVE. EXTENSION	112'

ITEM NO.	SURFACING				
	225 STAB CR STONE BASE 10" TONS	302 BIT PRIME COAT TONS	308 CR STONE BIT CONC. BASE - 2" TONS	308b TACK COAT TONS	346 ASPHALTIC CONC SURF 1" TONS
10+00 - 22+11.13	3995	10	760	3.00	380
BONNIEWAY DR.	(400)	.90	(75)	0.25	(40)
MARIA AVENUE	(215)	0.5	(45)	0.15	(25)
PVT DRIVEWAYS	(150)	0.60	(45)	0.20	(25)
TOTAL	(4,760)	12.0	(925)	3.60	(470)

INDEX TO DRAWINGS	
TITLE	SHEET NO.
SUMMARY OF QUANTITIES	250
GRADING & PAVING-TYPICAL SECTION & DETAILS	251
PLAN	252
PROFILE AND GRADING PLAN	253
FINISHED PAVEMENT PROFILES	254-1 - 254-2
DRAINAGE PROFILES & TURNING RADIUS PROFILES	255
STANDARD CATCH BASIN *	256-1
CATCH BASIN & GRATE	256-2
CONC. ENDWALLS & INLETS FOR PIPE CULVERTS	256-3
TRAFFIC CONTROL DEVICES, PAVEMENT STRIPING, AND DROP CURB DETAILS	257
CROSS SECTIONS	258-1 - 258-5

GRADING		
ITEM NO.	120 UNCLASS EXCAV. CU YDS	123 EARTH BOR EXCAV CU YDS
10+30 - 22+11.13	893	7,374
BONNIEWAY DRIVE	0	455
MARIA AVENUE	0	409
12+50 - 17+50 L	0	4,798
TOTAL	893	13,536

DRAINAGE STRUCTURES										
ITEM NO.	LOCATION	TYPE	602 PIPE LIN. FT.			CONC CU YDS	REINF STEEL LBS	CAST IRON LBS	CITY STD CATCH BASIN-EA	129 STR EXCAV CU YDS
			12"	15"	18"					
19+20 R N. MOORE RD (1)		CB	100'							30
18+20 R N. MOORE RD (2)		CB		56'						35
18+20 L N. MOORE RD (3)		CB		115'						50
4+09.91 R MARIA AVE (4)		CB		216'						80
FIELD ENTRANCE (5)		CB-TVA37			2.16		(430)			20
3+37.97 L BONNIEWAY DR (6)		CB		85'						5
3+37.97 R BONNIEWAY DR (7)		CB		22'						105
NW CORNER C.W. WEST R (JB)				(165)	2.00	(130)				20
HEAD OF DITCH		ENDWALL TVA-4		(65)	0.90	20				15
10+60 R N MOORE RD (9)		CB	45'							10
10+60 L N MOORE RD (10)		CB	32'							40
EXIST CB SHALLOWFORD RD (11)										40
EXIST CB 2+52 R BONNIEWAY DR (12)				86'						40
3+37.97 R BONNIEWAY DR (7)										40
TOTAL			263	387	(337)	(5.06)	(150)	(860)	8	410

* CITY OF CHATTANOOGA

GRASSING			
ITEM NO.	180 SEEDING SQ. YDS.	182 MULCHING SQ. YDS.	183 SODDING SQ. FT.
BONNIEWAY			1240
10+30 - 22+11.13 R	1925	1925	730
MARIA			730
12+50 - 17+50 L	16,127	16,127	
10+30 - 22+11.13 R & L			7170
TOTAL	18,052	18,052	9140

REMOVAL OF STRUCTURES & PAVEMENT			
ITEM NO.		110	134
LOCATION	DESCRIPTION	REMOVAL OF STR	REMOVAL PAVEMENT SQ YDS
80' L STA 18+00	CATCH BASIN	1	
110' L STA 16+00	CATCH BASIN	1	
190' L STA 15+00	CATCH BASIN	1	
EXT. N. MOORE RD. LEVEE TO STA 22+11.13	REMOVAL OF PAVEMENT		4600
EXT. N. MOORE RD LEVEE TO STA 22+11.13	REMOVAL OF EXIST. CURB & GUTTER	2000'	

TRAFFIC SIGNS			
LOCATION	DESCRIPTION	UNIT	QUANTITY
4+40 R BONNIEWAY	STOP SIGN (R1-1) *	EACH	1
4+45 R MARIA	STOP SIGN (R1-1) *	EACH	1
12+50 L N MOORE ROAD	SIGNAL AH (W3-3)	EACH	1
15+00 L N MOORE ROAD	RIGHT LANE MUST TURN RIGHT (R3-7)	EACH	1
18+00 L N MOORE ROAD	RIGHT LANE MUST TURN RIGHT (R3-7)	EACH	1

DROP CURB ENTRANCE		
ITEM NO.	395 CONC SIDEWALK SQ. YDS.	
19+23L N MOORE ROAD	16'	12.5
20+95L N MOORE ROAD	18'	13.5
2+98L BONNIEWAY DRIVE	14'	11.5
3+86.64R BONNIEWAY DRIVE	14'	11.5
3+85 R MARIA AVENUE	16'	12.5
TOTAL		61.5

* REFERS TO MANUAL ON UNIFORM TRAFFIC CONTROL DEVICES

DESIGN	H. L. PETTY	INSPECTION	J. R. ...
DRWN	J. R. ...	ENGINEER	E. B. Logan
CHKD	...		
SUPV	...		


NORTH MOORE ROAD RELOCATION

SUMMARY OF QUANTITIES

SOUTH CHICKAMAUGA CREEK PROJECT
TENNESSEE VALLEY AUTHORITY
DIVISION OF ENGINEERING DESIGN


SUBMITTED	RECOMMENDED	APPROVED
Robert J. ...	J. D. ...	H. L. Petty
KNOXVILLE	12-4-78	81 HR 101-19H250 RI

MT
 20
 RI

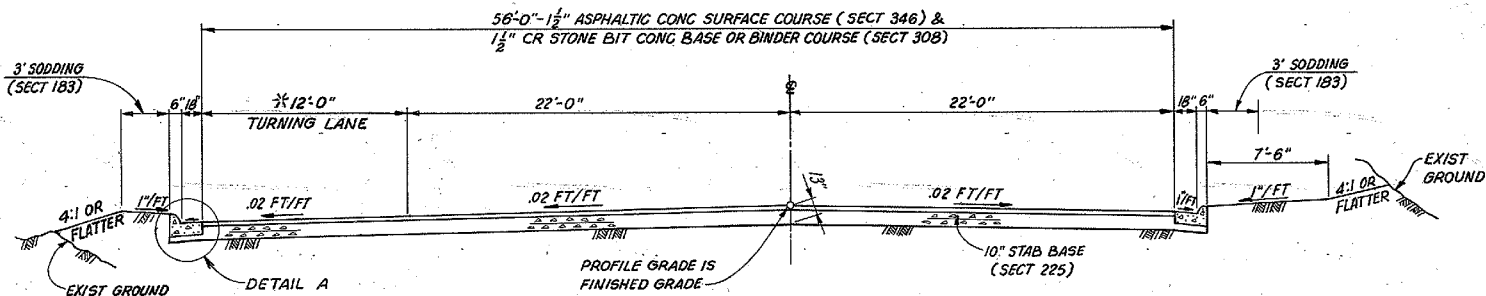


TANGENT SECTION

* VARIES FROM 0'-0" TO 12'-0"

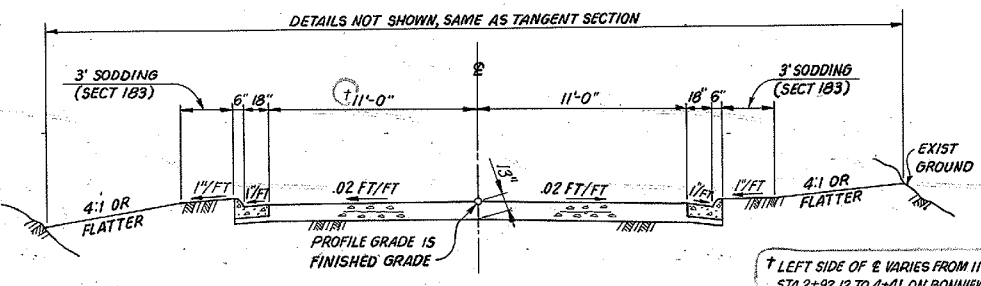


MARTA AVE & BONNIEWAY DR
NTS


† LEFT SIDE OF E VARIES FROM 11' TO 23'
STA 2+92.12 TO 4+41 ON BONNIEWAY DR.
SEE PAVEMENT TAPER @ CURVE 7
ON DWG 101-19H252 RI.

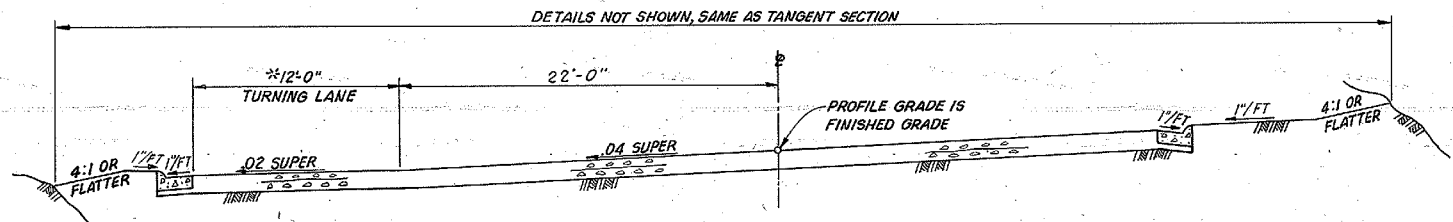


SUPERELEVATED SECTION (L)

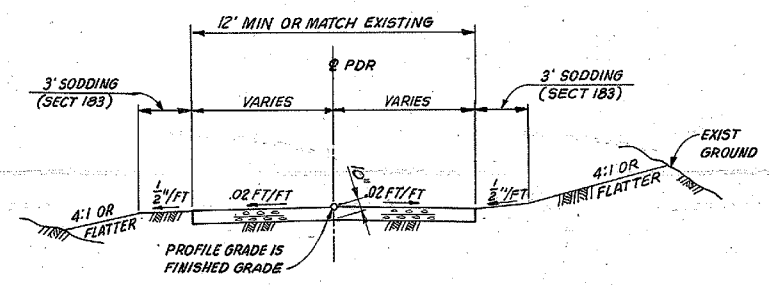

PRIVATE DRIVE
NTS

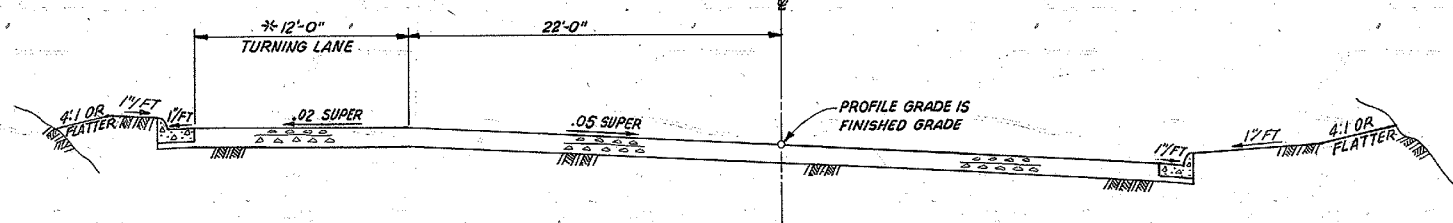


SUPERELEVATED SECTION (R)

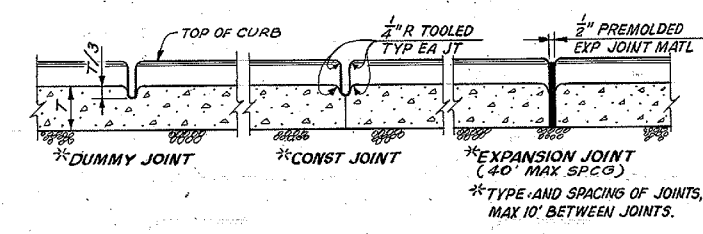


CURB & GUTTER JOINT DETAIL
NTS


*EXPANSION JOINT (40' MAX SPCG)
*TYPE AND SPACING OF JOINTS, BY FIELD,
MAX 10' BETWEEN JOINTS.

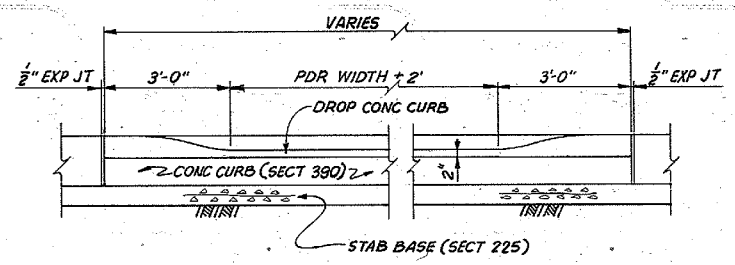

PRIVATE DR, SIDEWALK, CURB & GUTTER DETAILS
NTS

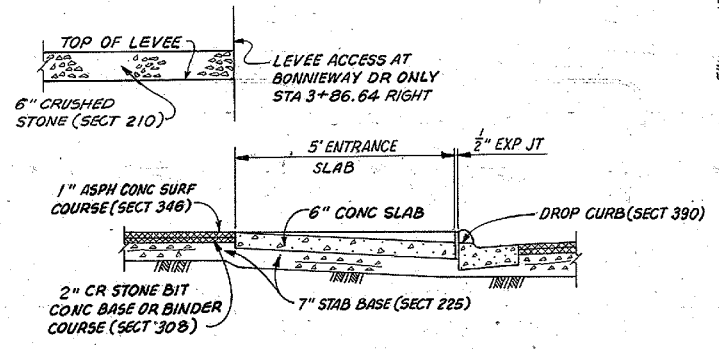

SECTION

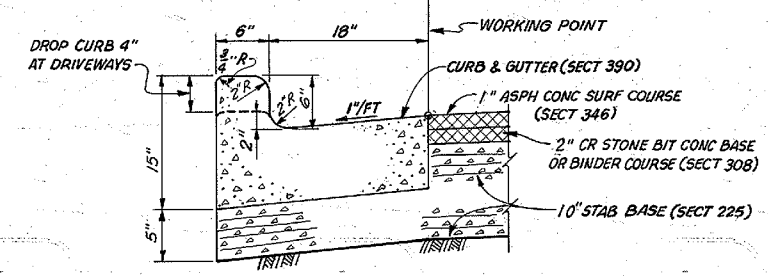


DETAIL A
PAVEMENT, CURB & GUTTER
NTS

SCALE: 1" = 5'-0"
EXCEPT AS NOTED

NOTES:
1. FOR NOTES & REFERENCE DWGS SEE 101-19H252.

101-19H252-1		REVISED BONNIEWAY DR; ADDED LEFT TURN LANE	
REV NO.	DATE	DESIGN	CHKD
1		H. L. PETTY	J. R. SOK
2		V. B. LEE	
3			
4			
5			
6			
NORTH MOORE ROAD RELOCATION		GRADING & PAVING-TYPICAL SECTIONS & DETAILS	
SOUTH CHICKAMAUGA CREEK PROJECT TENNESSEE VALLEY AUTHORITY DIVISION OF ENGINEERING DESIGN			
INSPECTED AND APPROVED FOR ISSUE	SUBMITTED	RECOMMENDED	APPROVED
	Robert J. Bowman	Robert J. Bowman	Robert J. Bowman
KNOXVILLE	12-4-78	81 HR	101-19H251 RI
RECORD DRAWING AS CONSTRUCTED			

- NOTES:
1. ALL WORK SHALL BE IN ACCORDANCE WITH HIGHWAY SPECIFICATION T-1, EXCEPT AS NOTED.
 2. GRASSING - SEEDING OF HIGHWAY SHOULDERS AND DITCH LINES SHALL BE TYPE 6a MIXTURE FOR SPRING SEEDING AND TYPE 8 MIXTURE FOR FALL SEEDING. SEEDING OF CUT AND FILL SLOPES AND OTHER DISTURBED AREAS SHALL BE TYPE 6e MIXTURE FOR SPRING SEEDING AND TYPE 8 MIXTURE FOR FALL SEEDING. IF TEMPORARY COVER IS NEEDED BEFORE SEEDING DATES USE TYPE 9 MIXTURE FOR WINTER SEEDING AND TYPE 10a MIXTURE FOR SUMMER SEEDING. ALL SEEDED AREAS SHALL BE LIMED, FERTILIZED, AND MULCHED IN ACCORDANCE WITH SECTIONS 180 AND 182 RESPECTIVELY.
 3. EARTH EMBANKMENTS SHALL BE CONSTRUCTED IN LAYERS APPROXIMATELY 6" THICK AND SHALL BE COMPACTED TO 95% OR MORE OF OPTIMUM DENSITY IN ACCORDANCE WITH SPECIFICATIONS SECTION 120.11. FOUNDATION PREPARATION FOR ALL EMBANKMENTS SHALL CONSIST OF REMOVAL OF ALL ORGANIC TOPSOIL TO A DEPTH THAT WILL REMOVE ALL ROOTS, AND EXCAVATION TO A DEPTH THAT WILL ASSURE A FOUNDATION THAT WILL SUPPORT HEAVY EARTHMOVING EQUIPMENT WITHOUT RUTTING INTO THE GROUND AND WITHOUT LATERAL HEAVING OF THE GROUND.
 4. EXCAVATION AND BACKFILL FOR PIPE CULVERTS SHALL CONFORM TO SECTION 125.
 5. EXISTING PAVEMENT, CURB AND GUTTER, CATCH BASINS AND PIPES WHICH ARE TO BE ABANDONED SHALL BE REMOVED AND SATISFACTORILY DISPOSED OF AND THE AREA GRADED TO DRAIN AND GRASSED. IN LIEU OF REMOVAL, ABANDONED PIPES MAY BE LEFT IN PLACE AND PLUGGED TO PREVENT UNDERGROUND SEEPAGE.
 6. REMOVAL OF EXISTING PAVEMENT SHALL CONFORM TO SECTION 134. REMOVAL OF EXISTING CATCH BASINS AND CURB & GUTTER SECTIONS SHALL CONFORM TO SECTION 110.
 7. FOR TRAFFIC SIGNS AND PAVEMENT MARKING DETAILS SEE DRAWING 101-19H257.
 8. FOR LEVEE AND DITCH DETAILS SEE DRAWING 101-19E205-1.
 9. THE PRIVATE ENTRANCE INTO THE CHURCH PROPERTY ON THE RIGHT IS NOT TO BE DISTURBED. NEW CURB AND GUTTER CONSTRUCTION SHALL END AT STATION 21+42.57.

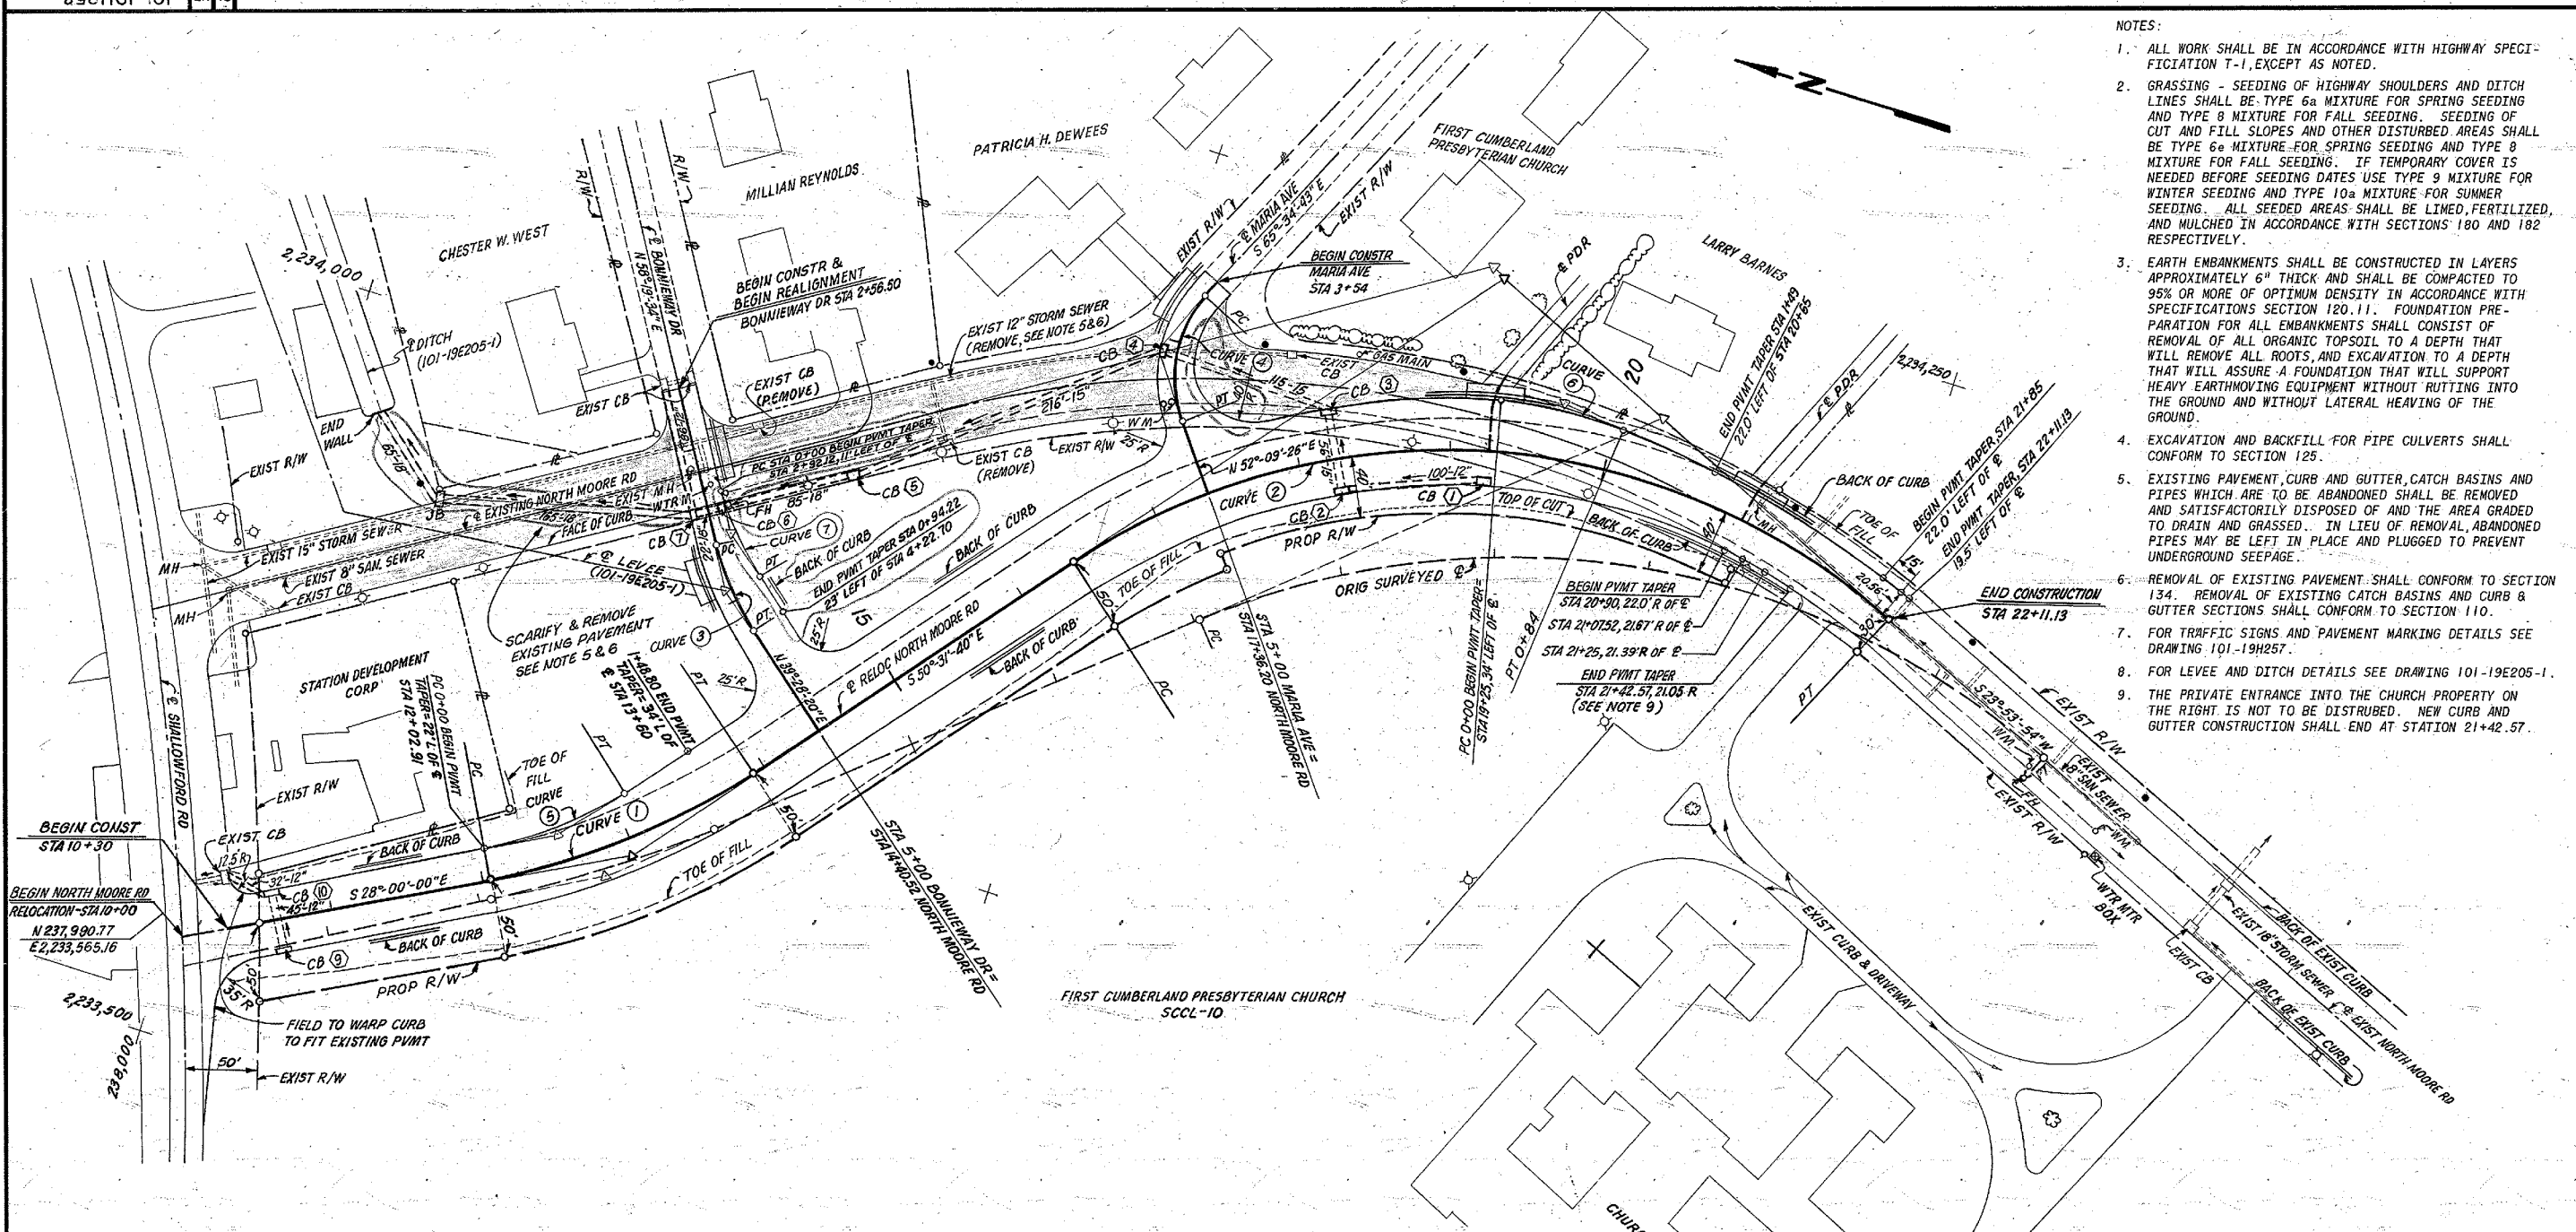

CURVE DATA

Curve No.	Curve No.	Curve No.	Curve No.	Curve No.	Curve No.	Curve No.
1	2	3	4	5	6	7
PI=12+98.00 N 237,727.65 E 2,233,705.06 PC=12+02.91 PT=13+90.64 Δ=22°-31'-40" D=12°-00'-00" R=47.74' T=95.09' L=187.73'	PI=19+73.32 N 237,296.79 E 2,234,228.25 PC=16+38.62 PT=22+11.13 Δ=74°-25'-34" D=13°-00'-00" R=440.74' T=334.70' L=572.51'	PI=3+92.54 N 237,718.88 E 2,233,885.64 PC=3+61.82 PT=4+22.70 Δ=18°-51'-14" D=30°-58'-14" R=185.0' T=30.72' L=60.88'	PI=4+10.19 N 237,500.73 E 2,234,116.38 PC=3+61.87 PT=4+48.81 Δ=62°-15'-51" D=71°-37'-11" R=80.0' T=48.32' L=86.94'	PI=0+50 N 237,727.65 E 2,233,705.06 PC=0+00 PT=0+98.88 Δ=20°-59'-35" D=21°-13'-52" R=269.87' T=50.0' L=98.88'	PI=0+42.5 N 237,237.15 E 2,234,161.55 PC=0+00 PT=84+00 Δ=19°-00'-37" D=22°-34'-19" R=253.83' T=42.5' L=84.22'	PI=0+30.72 N 237,729.99 E 2,233,924.59 PC=0+00 PT=0+60.88 Δ=18°-51'-14" D=30°-58'-13" R=185.0' T=30.72' L=60.88'

SCALE 1"=50'

REV	NO.	DATE	BY	CHKD	APPD

DESIGN: H.L. PETTY
 CHECKED: J. R. LEE
 SURVEY: W.M. HARRIS
 INSPECTOR: J.R. LEE
 ENGINEER: E.B. Logan

NORTH MOORE ROAD RELOCATION


PLAN

SOUTH CHICKAMAUGA CR PROJECT
 TENNESSEE VALLEY AUTHORITY
 DIVISION OF ENGINEERING DESIGN


INSPECTED AND APPROVED FOR ISSUE

SUBMITTED: Robert J. Bowman
 RECOMMENDED: R. J. ...
 APPROVED: ...
 KNOXVILLE 12-4-78 81 HR 101-19H252 RI


PRINT	
SHEET	
DATE	
SCALE	

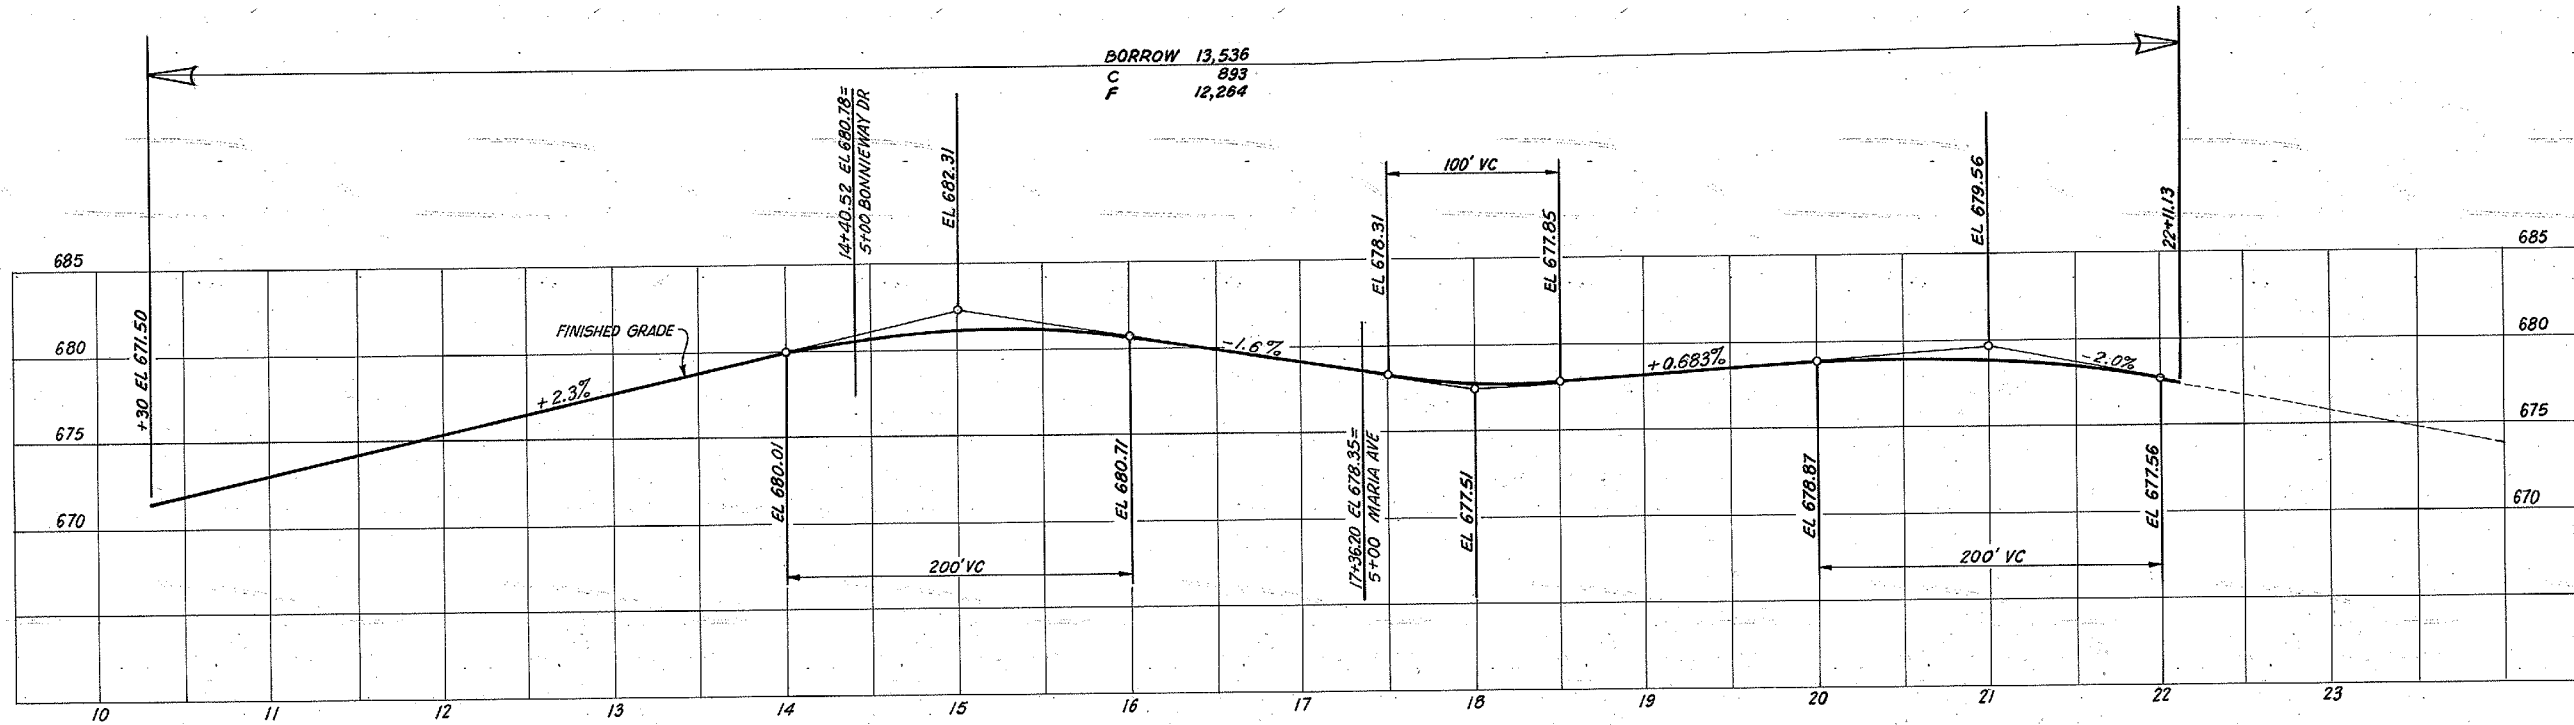


PROFILE-NORTH MOORE RD

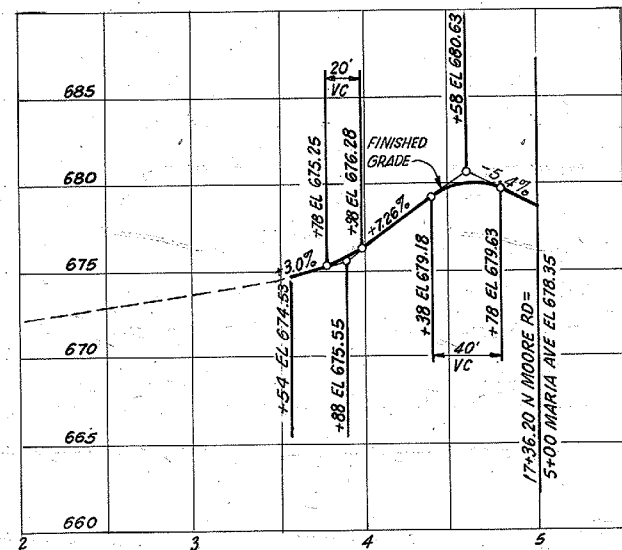

PROFILE-MARIA AVE

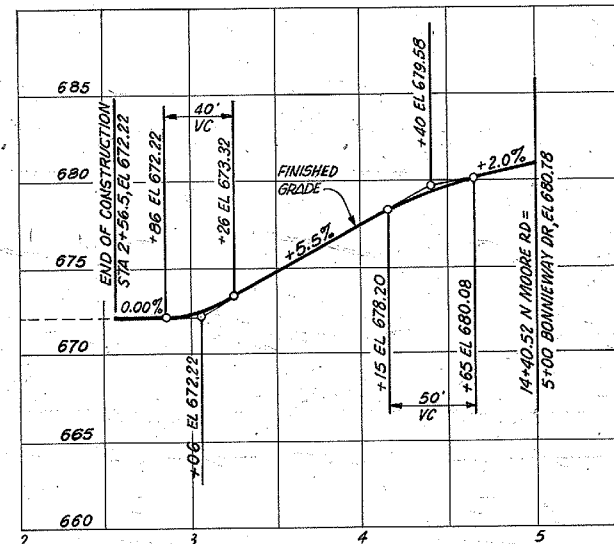

PROFILE-BONNIEWAY DR


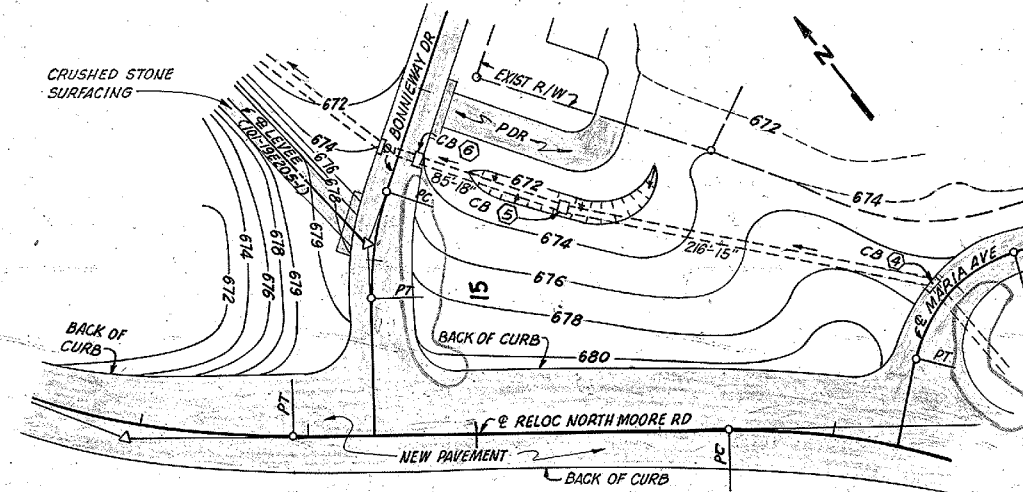


PLAN-GRADING
SCALE: 1"=50'

NOTES:
1. CONTOURS: DASHED CONTOURS REPRESENT EXISTING GROUND, SOLID CONTOURS REPRESENT FINISHED GRADING.
2. FOR ADDITIONAL NOTES AND REFERENCE DRAWINGS SEE 101-19H252.

SCALE: 1"=5' VERT
1"=50' HORIZ
EXCEPT AS NOTED

REVISED INTERSECTIONS AT BONNIEWAY AND MARIA	
REV. NO.	DATE
DESIGN	HL PETTY
DRAWN	V.R. LEE
CHECKED	W.M. GASTON
SUPV.	E. P. Logan
NORTH MOORE ROAD RELOCATION	
PROFILES & GRADING PLAN	
SOUTH CHICKAMAUGA CREEK PROJECT TENNESSEE VALLEY AUTHORITY DIVISION OF ENGINEERING DESIGN	
SUBMITTED	RECOMMENDED
INSPECTED AND APPROVED FOR ISSUE	APPROVED
KNOXVILLE	12-4-78
81 HR	101-19H253 RI


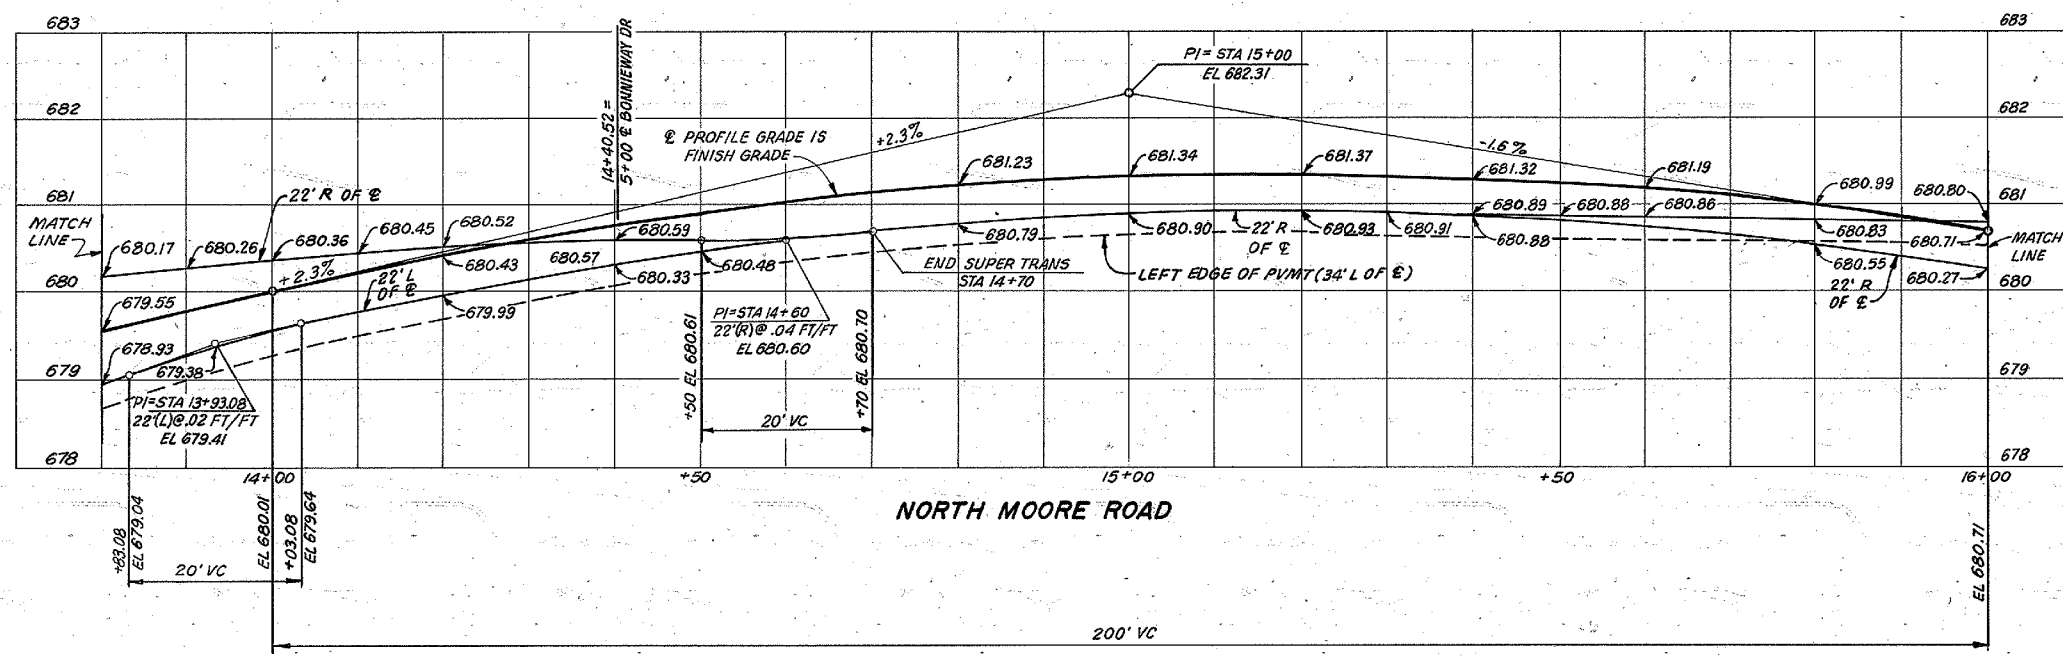
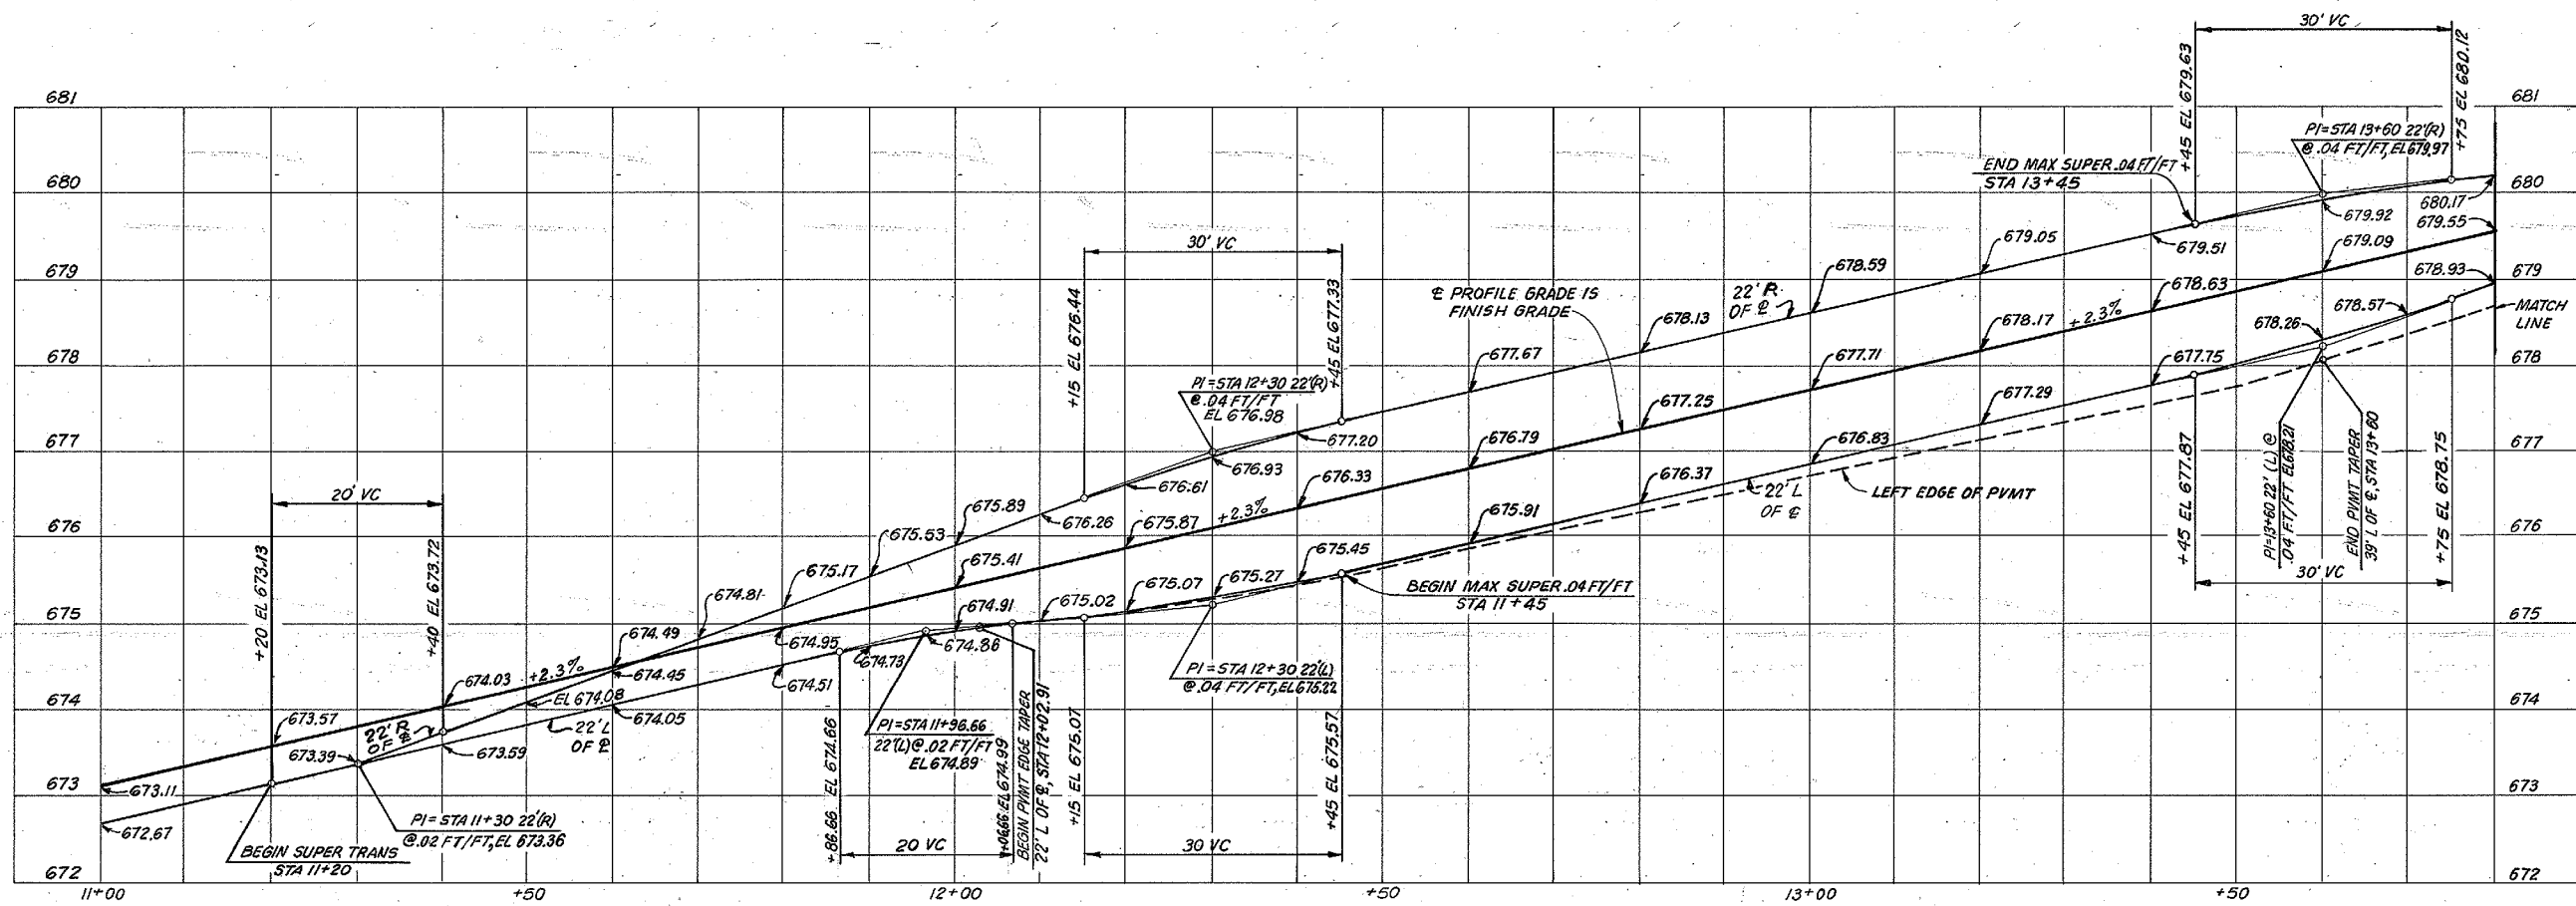


NORTH MOORE ROAD

NOTES:
FOR NOTES AND REFERENCE DRAWINGS SEE 101-19H252.

SCALE 1" = 1' VERT
1" = 10' HOR

REV NO.	ECN NO.	DATE	ISSN	CHKD	APPD	ENGR	INSP	DESIGN	REC'D	APPD
DRWN	H.L. PETTY		INSP	Sov						
CHKD	J.R. LEE		ENGR	E. B. Logan						
SUPV	W.M. MASTERS		ENGR							
NORTH MOORE ROAD RELOCATION										
FINISHED PAVEMENT PROFILE										
SOUTH CHICKAMAUGA CREEK PROJECT TENNESSEE VALLEY AUTHORITY DIVISION OF ENGINEERING DESIGN										
INSPECTED AND APPROVED FOR ISSUE			SUBMITTED		RECOMMENDED		APPROVED			
KNOXVILLE 12-4-78			H.L. Petty		J.R. Lee		E. B. Logan			
RECORD DRAWING AS CONSTRUCTED										

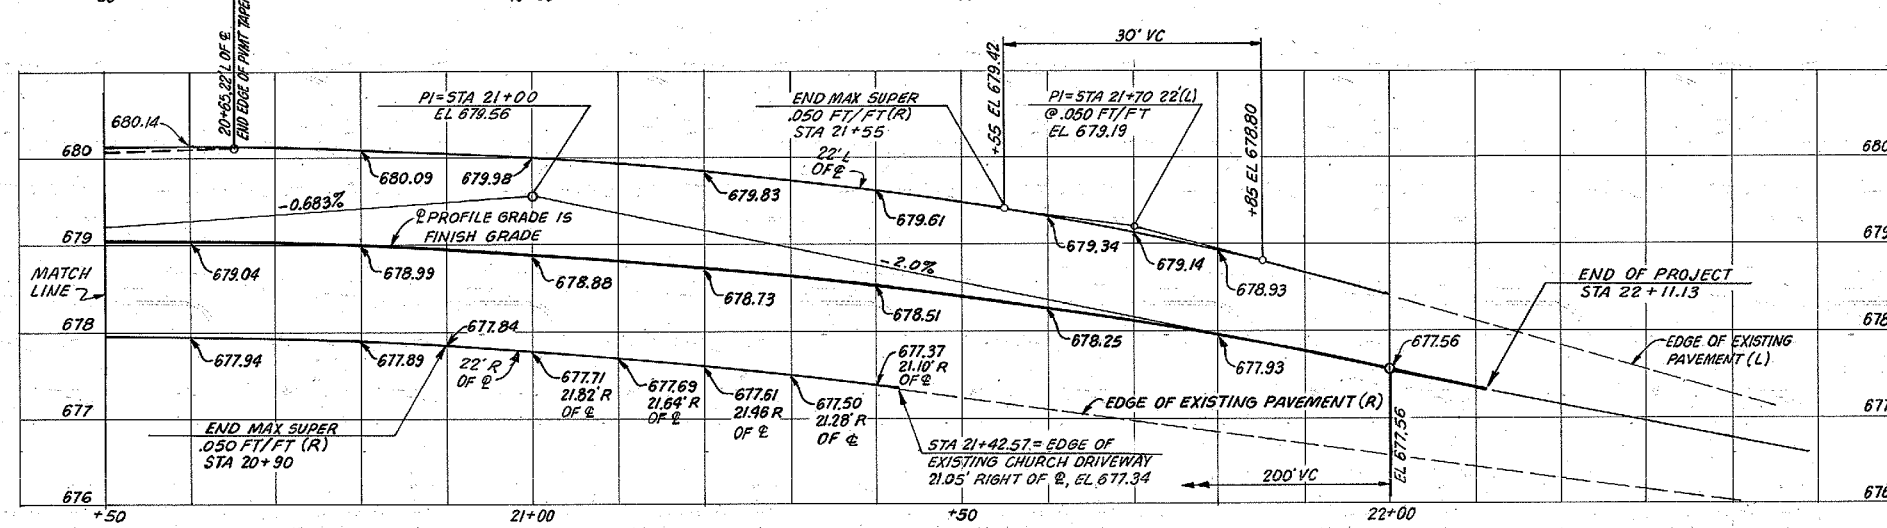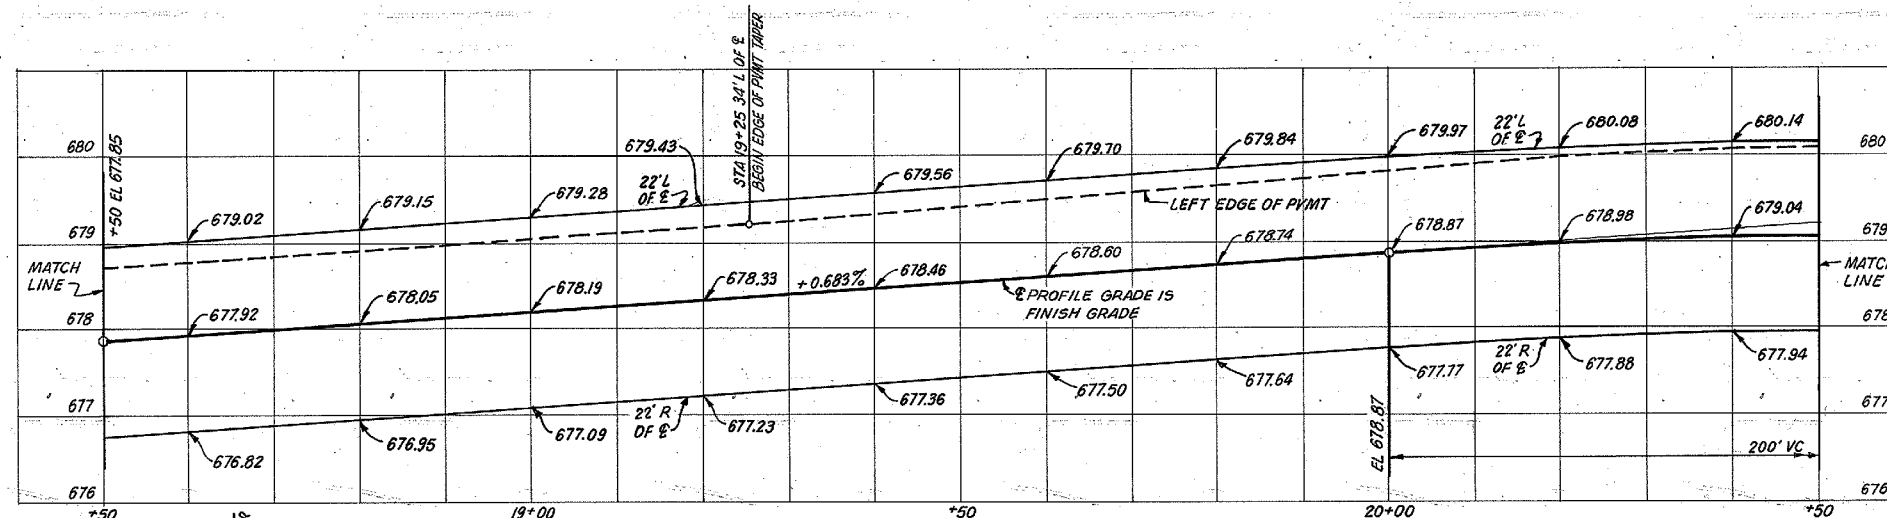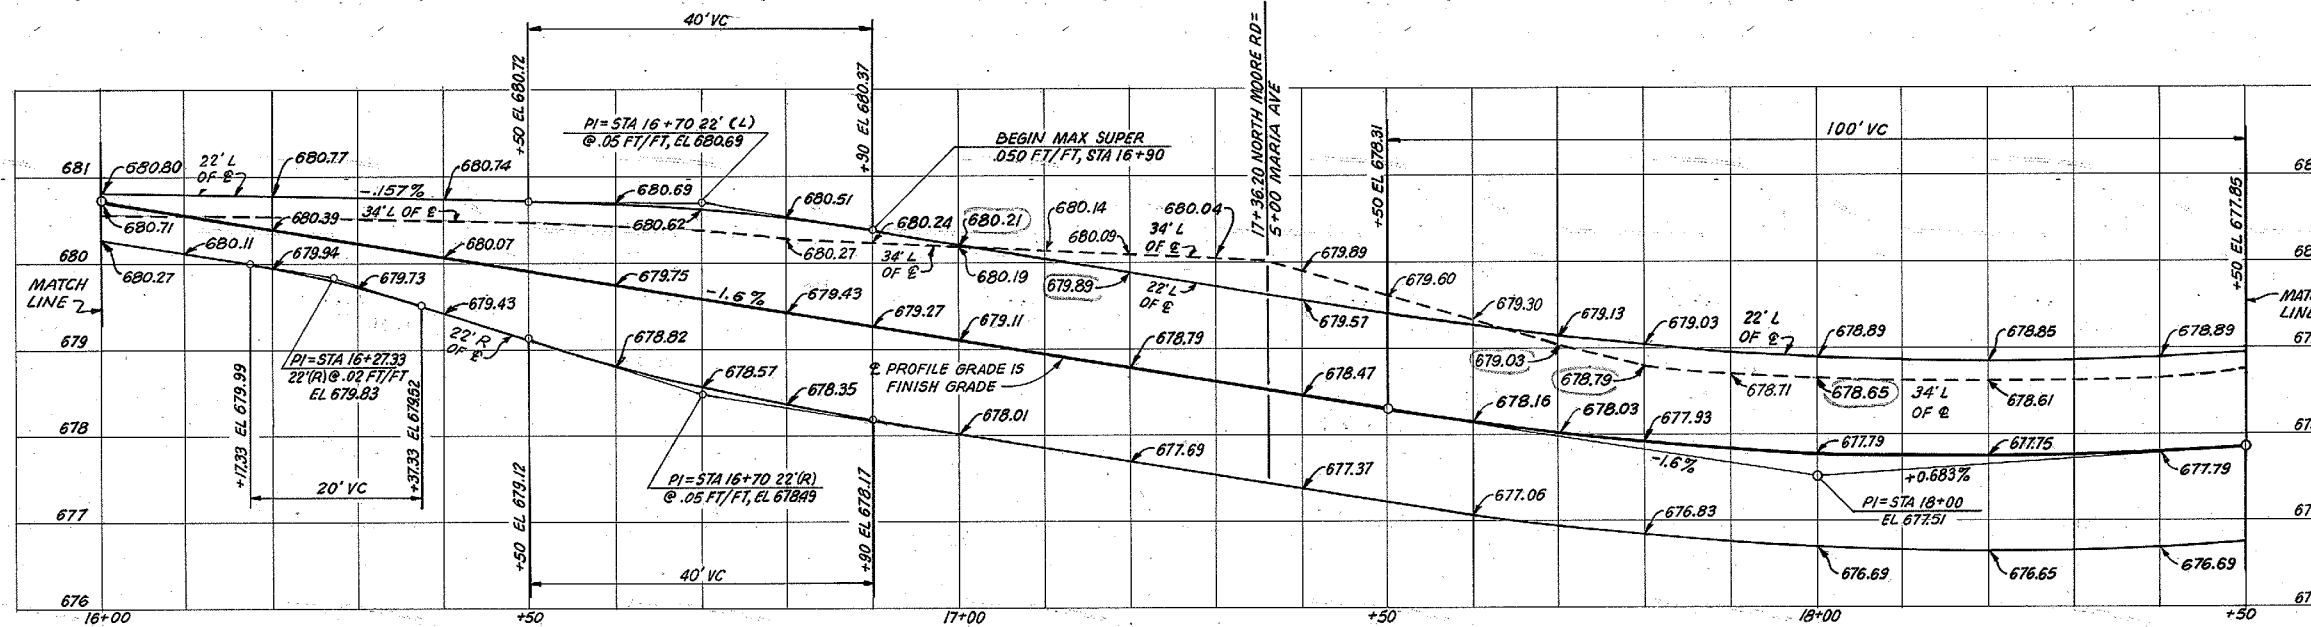

NORTH MOORE ROAD








NOTES:
FOR NOTES AND REFERENCE DRAWINGS SEE 101-19H 252.

SCALE { 1"=1'-0" VERT
1"=10'-0" HORIZ

REV. NO.		DATE		BY		CHKD		APPD	
H.L. PETTY		12-7-78		R.B. LEE		W. M. M. M.		S. B. J. J.	
DSSN		INSPECTION		RECOMMENDATION		APPROVAL		DATE	
W. M. M. M.		S. B. J. J.		R. B. L. E.		H. L. P. T.		12-7-78	
NORTH MOORE ROAD RELOCATION FINISHED PAVEMENT PROFILE									
SOUTH CHICKAMAUGA CREEK PROJECT TENNESSEE VALLEY AUTHORITY DIVISION OF ENGINEERING DESIGN									
SUBMITTED		RECOMMENDED		APPROVED		DATE		BY	
R. B. L. E.		S. B. J. J.		H. L. P. T.		12-7-78		R. B. L. E.	
INSPECTED AND APPROVED FOR ISSUE KNOXVILLE 12-7-78 81 HR 101-19H254-2 RI									


1	2	3	4	5	6
---	---	---	---	---	---

PRINT	IN	SCALE	DATE	BY

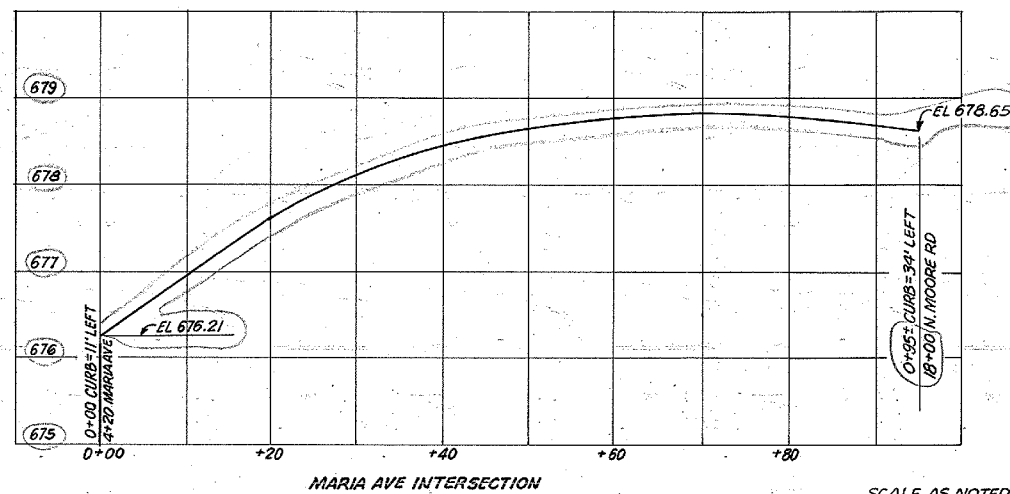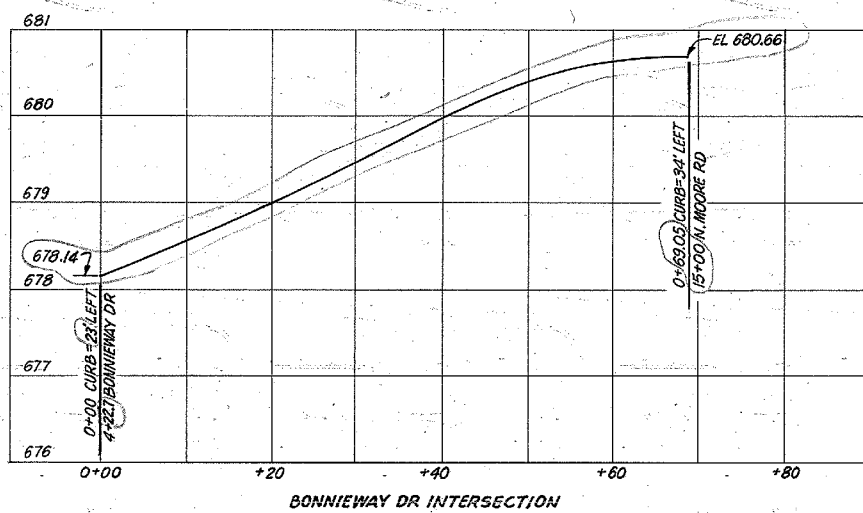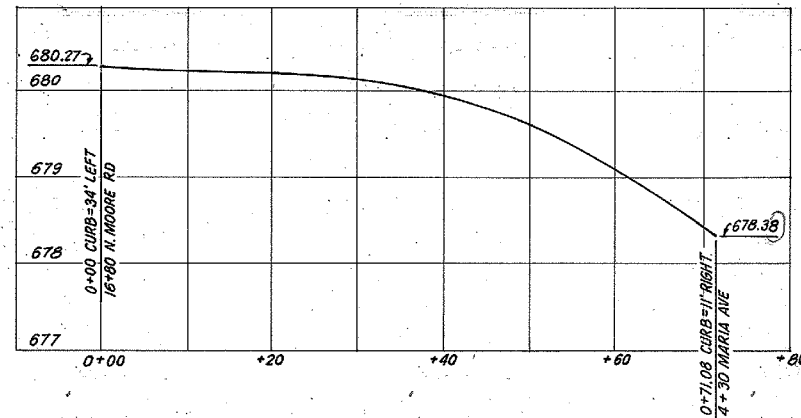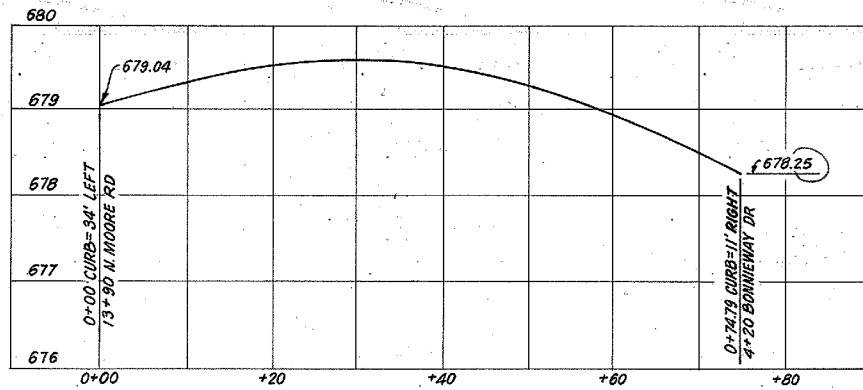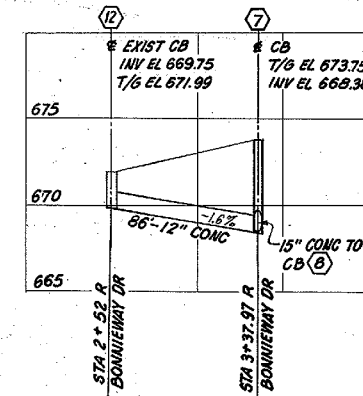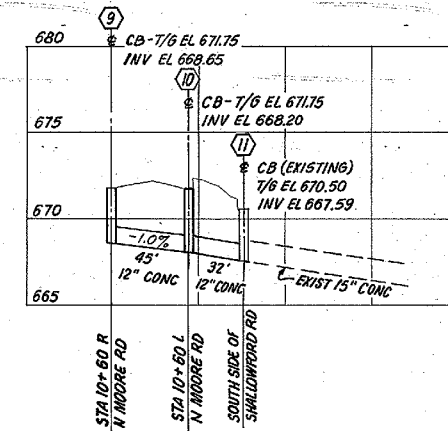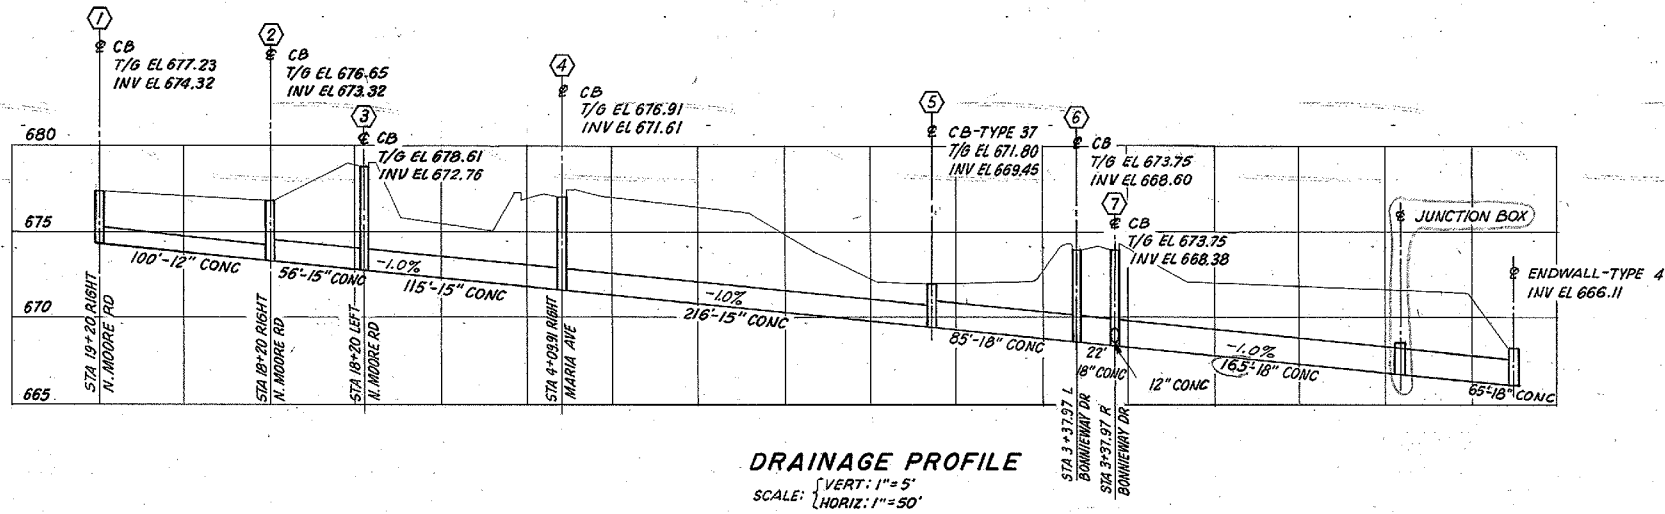


- NOTES:
 1. FOR CITY OF CHATTANOOGA STANDARD CATCH BASIN DETAILS SEE 101-19H256-1.
 2. FOR TVA-TYPE 37 CATCH BASIN DETAILS SEE 101-19H256-2.
 3. FOR TVA-TYPE 4 ENDWALL DETAILS SEE 101-19H256-3.
 4. FOR ADDITIONAL NOTES AND REFERENCE DRAWINGS SEE 101-19H252.
 5. ALL CATCH BASINS SHOWN ARE CITY OF CHATTANOOGA STANDARD CATCH BASINS EXCEPT AS NOTED.


REV	DATE	BY	CHKD	APPD
1	12-4-78	H.L. PETTY	J.P. FOX	E.L. SUGAN
NORTH MOORE ROAD RELOCATION DRAINAGE PROFILES AND TURNING RADIUS PROFILES SOUTH CHICKAMAUGA CREEK PROJECT TENNESSEE VALLEY AUTHORITY DIVISION OF ENGINEERING DESIGN				
INSPECTED AND APPROVED FOR ISSUE		SUBMITTED: <i>[Signature]</i> RECOMMENDED: <i>[Signature]</i> APPROVED: <i>[Signature]</i>		
KNOXVILLE		81 HR 101-19H255 RI		

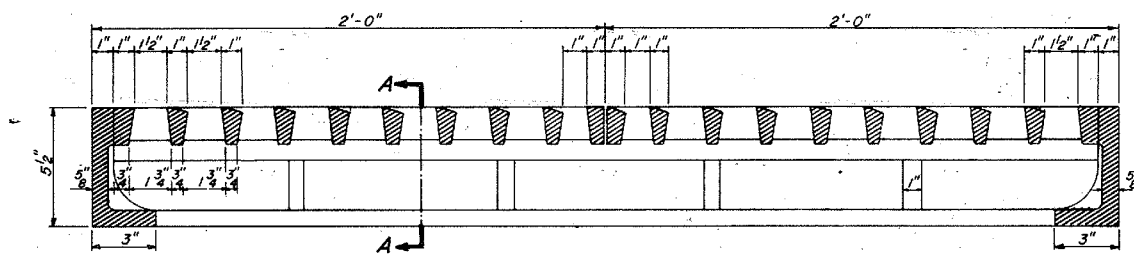


Section B-B

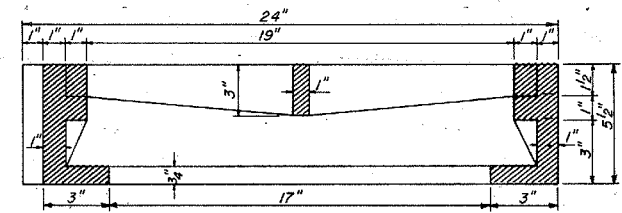


Section A-A

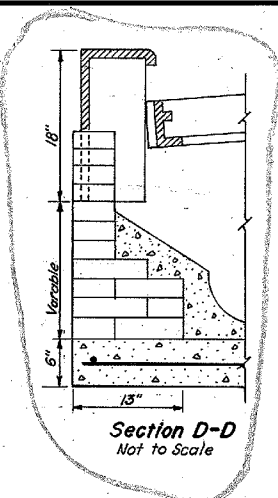


Section D-D
Not to Scale

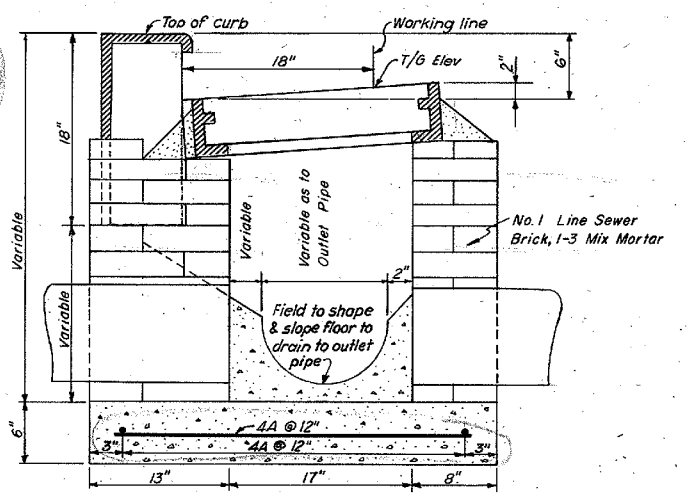


Section C-C
Scale: 1 1/2" = 1'-0"

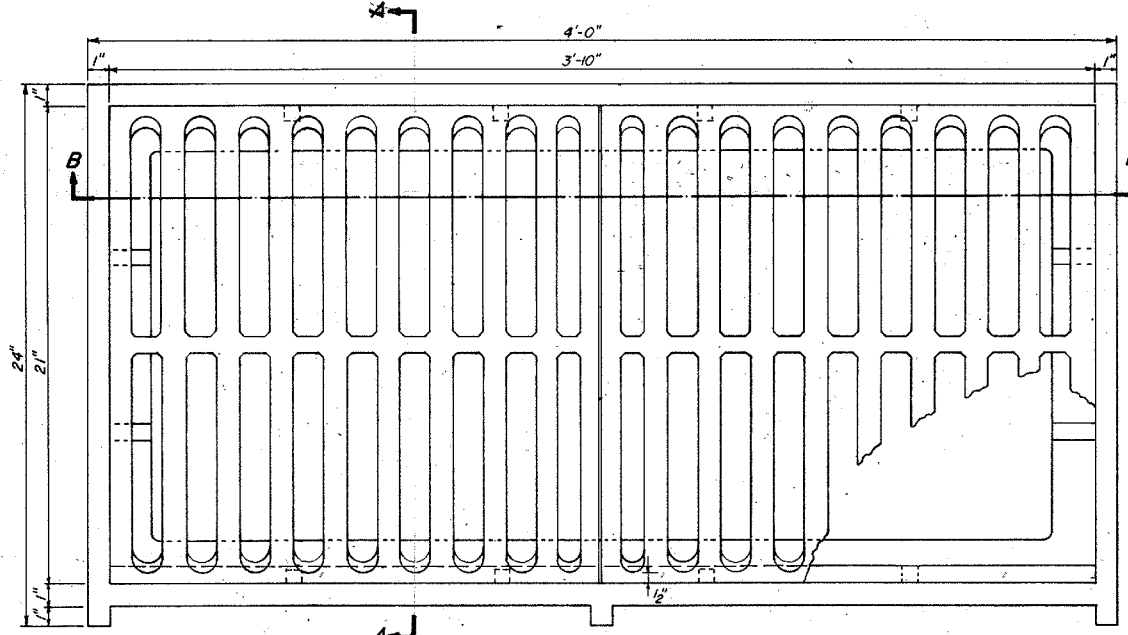


Plan
Frame & Grate
Scale: 3" = 1'-0"

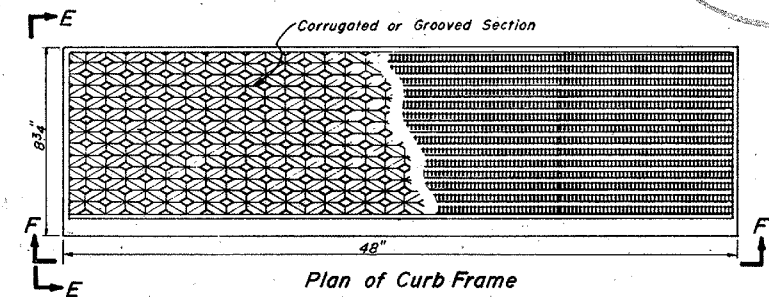


Plan of Curb Frame

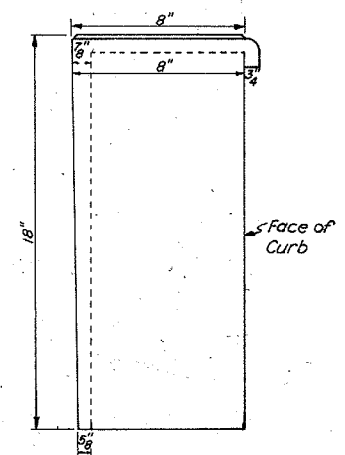


E-E

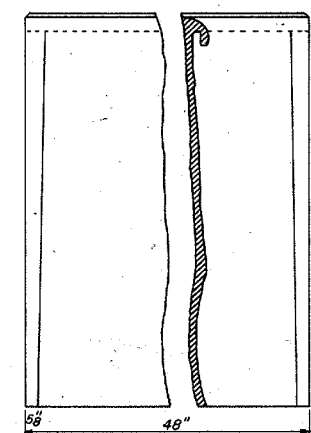


F-F

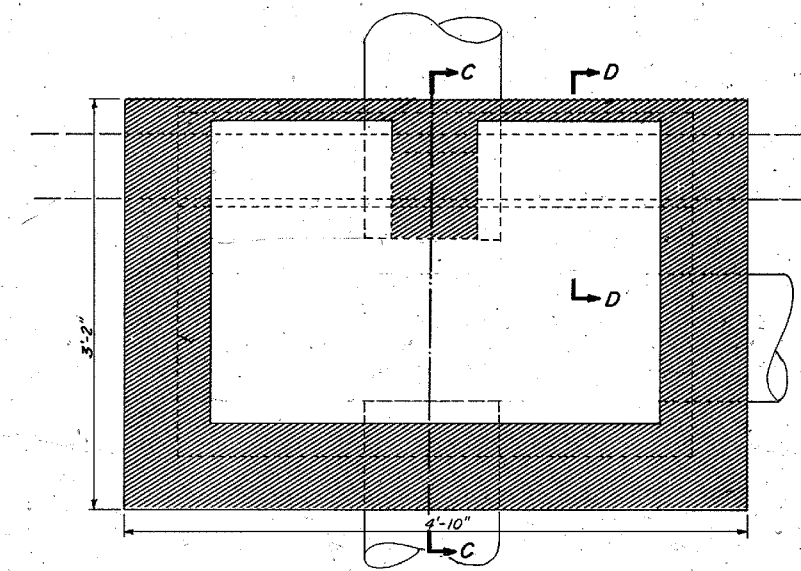

Plan of Inlet
Frame & Grates Removed
Scale: 1 1/2" = 1'-0"

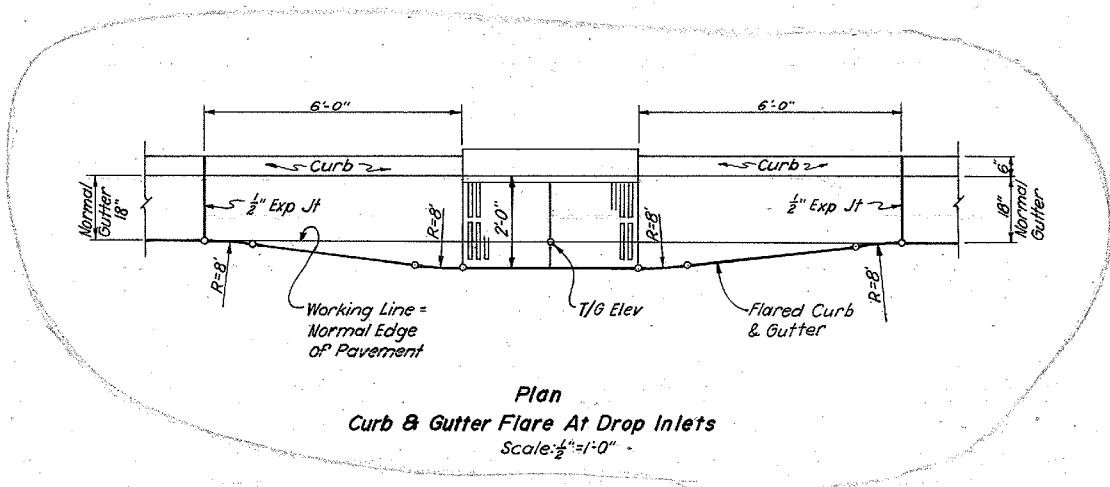

Plan
Curb & Gutter Flare At Drop Inlets
Scale: 1/2" = 1'-0"







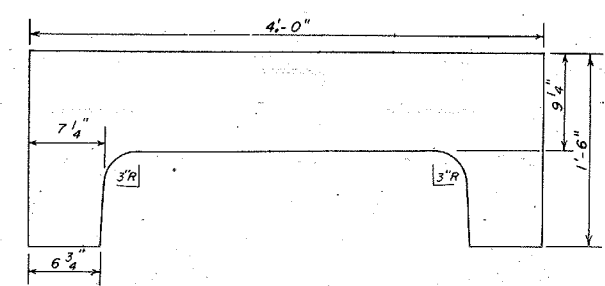


Alternate Back View Of Curb
Frame
Scale: 1 1/2" = 1'-0"

NOTES:
1. ALL MATERIALS REQUIRED FOR CONSTRUCTION OF THIS TYPE CATCH BASIN SHALL CONFORM TO THE CITY OF CHATTANOOGA STANDARDS & SPECS & SHALL BE OF THE SAME MANUFACTURE AS USED CURRENTLY BY THE CITY.
2. FOR ADDITIONAL NOTES AND REFERENCE DRAWINGS SEE 101-19H252.

Scale as noted

101-19H256-1 R1		101-19H256-1 R1		101-19H256-1 R1	
ADD CURB & GUTTER FLARE, SECTION D-D, MINOR REVISIONS					
REV	NO.	DATE	BY	CHKD	APPD
1					
DSGN	H. L. PETTY			INSP	R. S. P.
DRWN	W. R. LEE			ENGR	E. A. Pagan
CHKD	W. W. MASTON				
SUPV	W. W. MASTON				
NORTH MOORE ROAD RELOCATION					
STANDARD CATCH BASIN					
CITY OF CHATTANOOGA					
SOUTH CHICKAMAUGA CR PROJECT					
TENNESSEE VALLEY AUTHORITY					
DIVISION OF ENGINEERING DESIGN					
SUBMITTED	RECOMMENDED	APPROVED			
Robert J. Bowman		D. S. Pagan		E. A. Pagan	
KNOXVILLE 12-4-78		81 HR		101-19H256-1 R1	
RECORD DRAWING AS CONSTRUCTED					

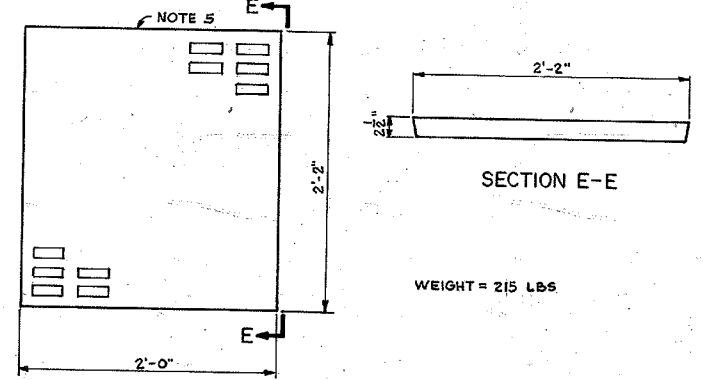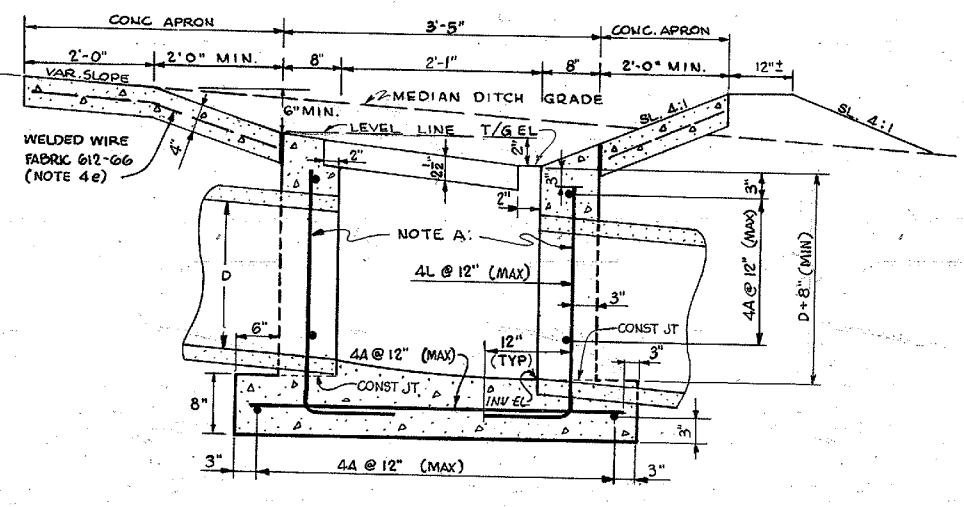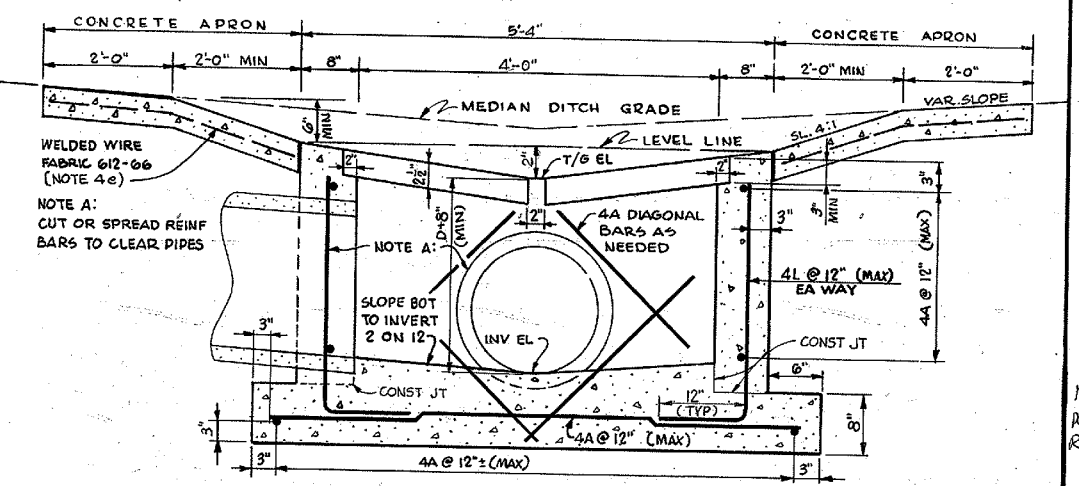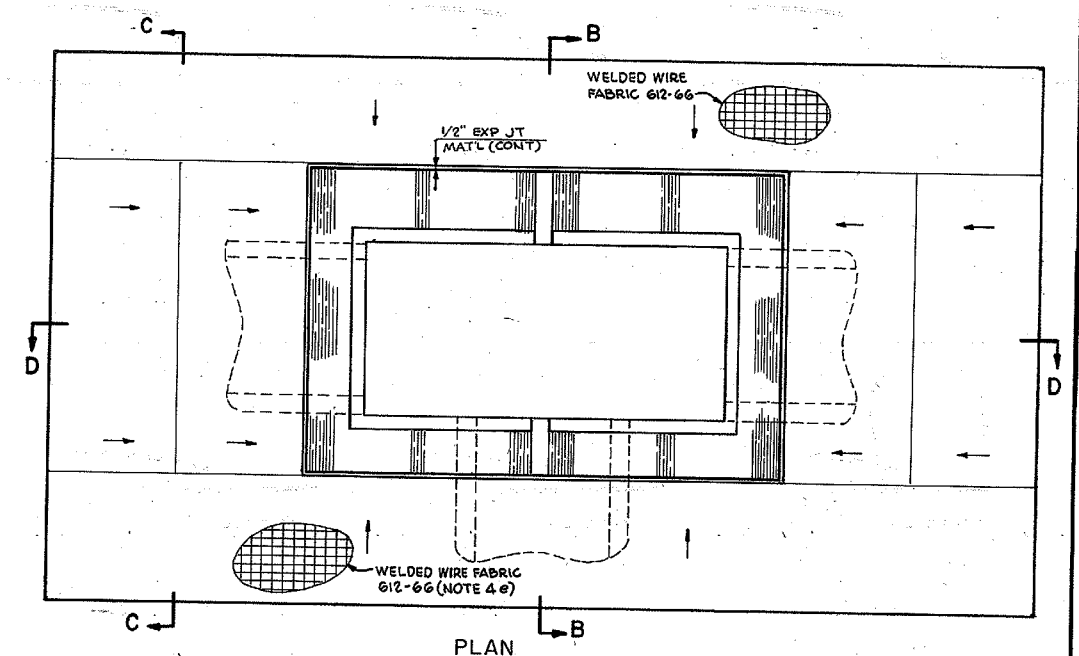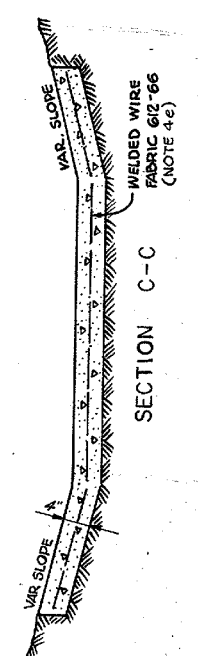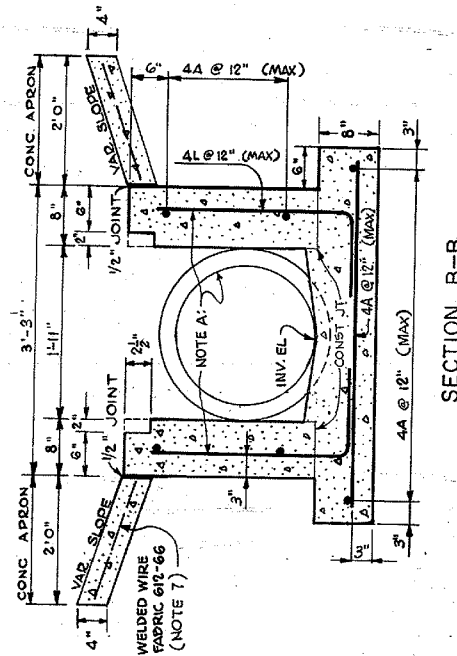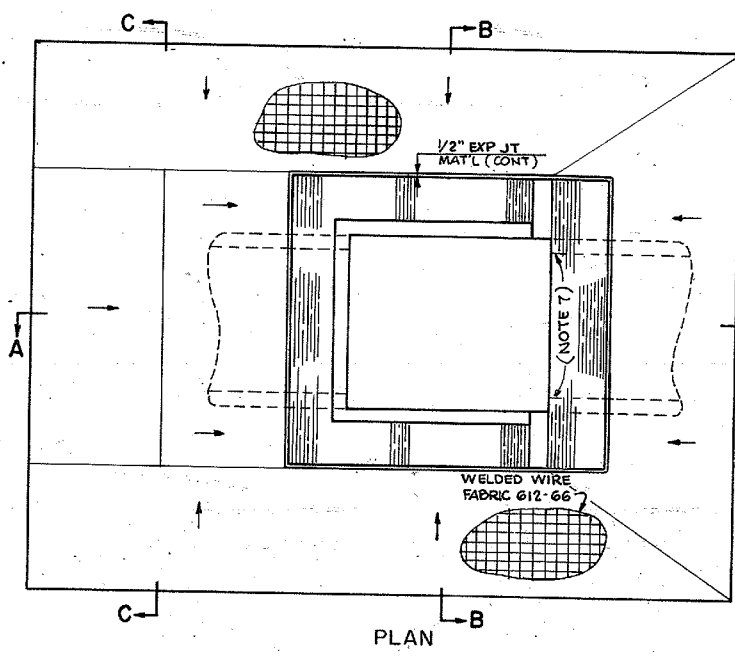

No. 36 CATCH BASIN
For Median Drain on
Straight Grade

CASTING DETAIL

No. 37 CATCH BASIN
For Median Drain
At Sag Point


Estimated Quantities*

DIAMETER PIPE "D"	CL. A CONCRETE	Cu. Yd.
12"	0.70	0.98
15"	0.77	1.07
18"	0.84	1.16
24"	0.98	1.35
Each Add'l Ft. of Depth	0.28	0.37

Pipe Deductions

DIAMETER	CONC. Cu. Yd.
12"	0.03
15"	0.05
18"	0.07
24"	0.11

* QUANTITIES FOR CONCRETE APRON BY FIELD.

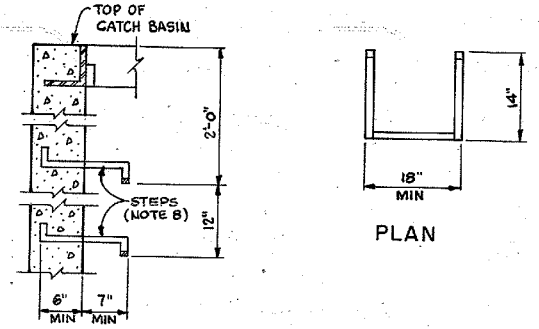

SECTIONAL ELEVATION THRU BASIN AND INLET
DETAIL-BASIN AND INLET STEPS
REQUIRED FOR BASIN & INLETS THAT ARE GREATER THAN 3'-0" IN DEPTH

- NOTES:
- ALL WORK SHALL BE IN ACCORDANCE WITH HIGHWAY SPECIFICATION NO. 11, UNLESS OTHERWISE NOTED.
 - EXCAVATION AND BACKFILL FOR PIPE CULVERTS SHALL CONFORM TO SECTION 125.
 - CONCRETE SHALL BE CLASS "A" IN ACCORDANCE WITH SECTION 400.
 - REINFORCEMENT
 - ALL REINFORCEMENT SHALL BE GRADE 60 IN ACCORDANCE WITH SECTION 418.
 - ALL REINFORCEMENT TO BE FURNISHED AND BENT BY FIELD.
 - PLACE ALL REINFORCEMENT IN WALLS AND SLABS 3" MINIMUM FROM FACE OF CONCRETE TO THE NEAREST REINFORCING BAR.
 - LAP SPLICES SHALL BE 12" MINIMUM WHERE REQUIRED.
 - WELDED WIRE FABRIC SHALL CONFORM TO ASTM-A185 PLAIN FINISH AND SHALL HAVE A MINIMUM LAP DISTANCE OF 8".
 - USE NEENAH NO. R 4822-F GRADE TYPE A OR EQUAL.
 - ALL EXPOSED EDGES SHALL BE CHAMFERED 3/4".
 - THE CONNECTION OF PIPE TO STRUCTURE SHALL BE NEAT AND SECURE WHERE ENTIRE END OF PIPE DOES NOT EXTEND TO INSIDE FACE OF STRUCTURE THE WALL OF THE STRUCTURE SHALL BE EXTENDED WITH SMOOTH RIGID CIRCULAR FORMS EXACTLY FITTING THE INNER CIRCUMFERENCE OF THE PIPE WHERE A PORTION OF PIPE EXTENDS BEYOND THE REQUIRED INSIDE FACE OF STRUCTURE IT SHALL BE CUT OFF SMOOTH AND FLUSH THEREWITH WHERE BELL AND SPIGOT PIPE IS USED THE BELL END IS TO BE PLACED UPSTREAM WITH THE END OF THE PIPE FLUSH WITH FACE OF WALL UNLESS OTHERWISE DIRECTED BY THE ENGINEER.
 - BASIN AND INLET STEPS SHALL CONFORM TO TYPE R-1982J AS MANUFACTURED BY NEENAH ROUNDRY CO. OR EQUAL. ALTERNATE TO CONFORM TO TVA HAZARD CONTROL STANDARD NO. 502.

NOT TO SCALE

DESIGN	H.L. BETTY	INSPECTION	
DRAWN	V.L. LEE	ENGINEER	
CHECKED	W.M. HAYES		
SUPV.	W.M. HAYES		


NORTH MOORE ROAD RELOCATION

CATCH BASINS AND GRATE




SOUTH CHICKAMAUGA CREEK PROJECT
TENNESSEE VALLEY AUTHORITY
DIVISION OF ENGINEERING DESIGN

SUBMITTED: Robert G. Bowman
RECOMMENDED: R.D. Stewart
APPROVED: J.A. Elms




KNOXVILLE 12-4-78 81 HR 101-19H256-2 RI

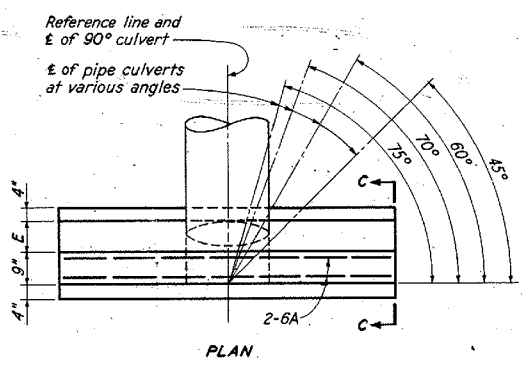





DIMENSIONS FOR TYPE 1 ENDWALL													QUANTITIES FOR ONE TYPE 1 ENDWALL		
DIA	ANG	A	B	C	D	E	F	H	J	J ₁	N	N ₁	P	CONCRETE CU YDS	STEEL LBS
18"	90°	2'-0"	2'-6"	1'-3"	1'-0"	6"	6'-0"	5'-8"	3'-0"	3'-0"	2'-3"	2'-3"	1'-6"	1.00	17.0
18"	75°	2'-0"	2'-6"	1'-3"	1'-0"	6"	6'-1"	5'-9"	3'-0"	3'-1"	2'-3"	2'-4"	1'-6"	1.01	17.5
18"	60°	2'-0"	2'-6"	1'-3"	1'-0"	6"	6'-2"	5'-10"	3'-0"	3'-2"	2'-2"	2'-4"	1'-8"	1.02	17.5
18"	45°	2'-0"	2'-6"	1'-3"	1'-0"	6"	6'-7"	6'-3"	3'-1"	3'-6"	2'-2"	2'-7"	1'-10"	1.09	19.0
24"	90°	2'-2"	3'-0"	1'-5"	1'-1"	8"	7'-10"	7'-6"	3'-11"	3'-11"	2'-11"	2'-11"	2'-0"	1.59	22.5
24"	75°	2'-2"	3'-0"	1'-5"	1'-1"	8"	8'-0"	7'-8"	3'-11"	4'-1"	2'-11"	3'-1"	2'-0"	1.62	23.0
24"	60°	2'-2"	3'-0"	1'-5"	1'-1"	8"	8'-2"	7'-10"	4'-0"	4'-2"	2'-11"	3'-1"	2'-2"	1.65	23.5
24"	45°	2'-2"	3'-0"	1'-5"	1'-1"	8"	8'-6"	8'-2"	4'-0"	4'-6"	2'-10"	3'-4"	2'-4"	1.71	24.5
30"	90°	2'-4"	3'-6"	1'-7"	1'-2"	10"	9'-6"	9'-2"	4'-9"	4'-9"	3'-6"	3'-6"	2'-6"	2.29	27.5
30"	75°	2'-4"	3'-6"	1'-7"	1'-2"	10"	9'-8"	9'-4"	4'-9"	4'-11"	3'-6"	3'-8"	2'-6"	2.33	28.0
30"	60°	2'-4"	3'-6"	1'-7"	1'-2"	10"	9'-11"	9'-7"	4'-10"	5'-1"	3'-6"	3'-9"	2'-8"	2.39	29.0
30"	45°	2'-4"	3'-6"	1'-7"	1'-2"	10"	10'-4"	10'-0"	4'-10"	5'-6"	4'-11"	5'-10"	2'-10"	2.48	30.0
30"	45°	2'-4"	3'-6"	1'-7"	1'-2"	10"	11'-10"	11'-6"	5'-1"	6'-9"	3'-4"	5'-0"	3'-6"	2.82	34.5

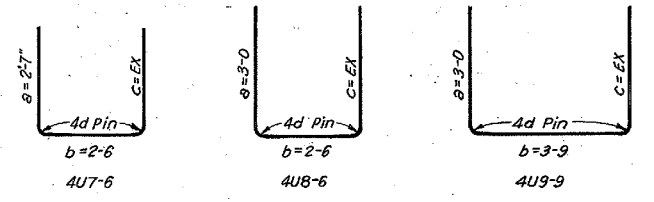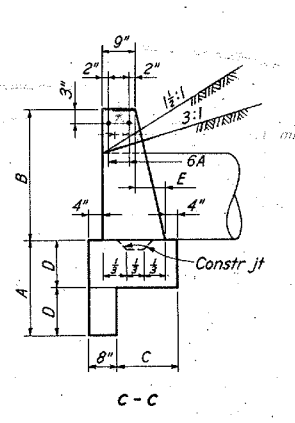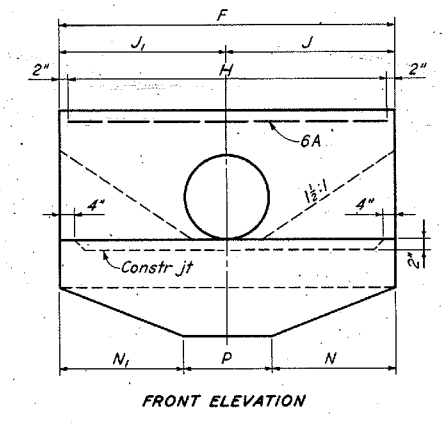

DIMENSIONS FOR TYPE 3 ENDWALL							QUANTITIES FOR ONE TYPE 3 ENDWALL	
PIPE SIZE	WALL	FOOTING	CONCRETE CU YDS	STEEL LBS				
12"	0.79	3'-6"	9"	1'-0"	1'-3"	2'-1"	0.46	20
15"	1.23	3'-9"	9"	1'-5"	1'-3"	2'-6"	0.58	"
18"	1.77	4'-0"	9"	1'-9"	1'-3"	2'-10"	0.69	"
24"	3.14	4'-6"	10"	2'-6"	1'-6"	3'-8"	1.09	"
30"	4.91	5'-2"	10"	3'-3"	1'-6"	4'-5"	1.43	"

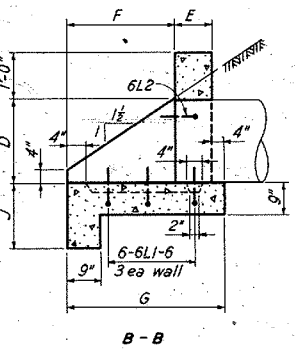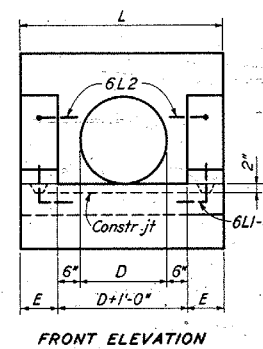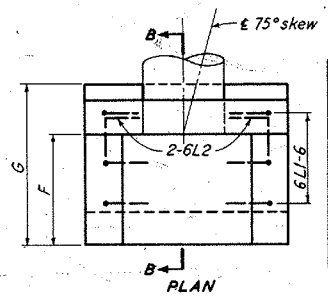


DIMENSIONS FOR TYPE 4 ENDWALL							QUANTITIES FOR ONE TYPE 4 ENDWALL	
PIPE SIZE	WALL	FOOTING	CONCRETE CU YDS	STEEL LBS				
12"	0.79	3'-6"	9"	2'-0"	1'-3"	3'-1"	0.55	20
15"	1.23	3'-9"	9"	2'-0"	1'-3"	3'-10"	0.72	"
18"	1.77	4'-0"	9"	3'-6"	1'-3"	4'-7"	0.90	"
24"	3.14	4'-8"	10"	5'-0"	1'-6"	6'-2"	1.49	"
30"	4.91	5'-2"	10"	6'-6"	1'-6"	7'-8"	2.06	"

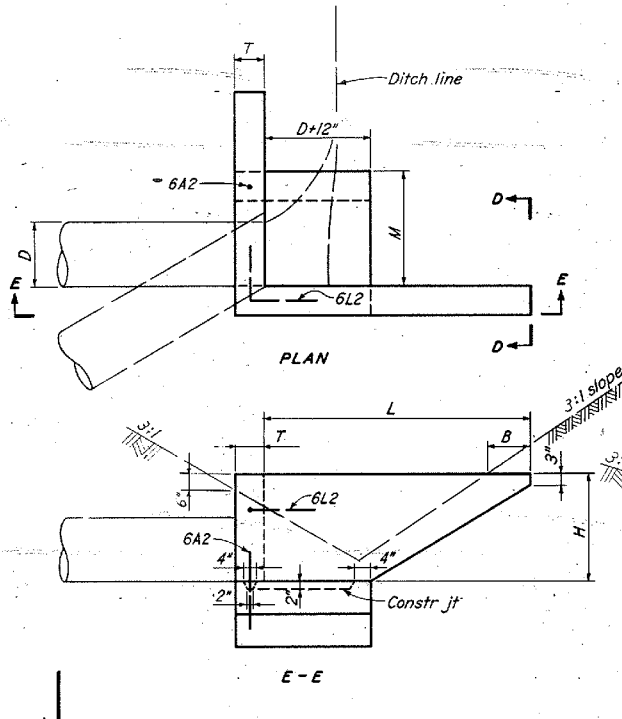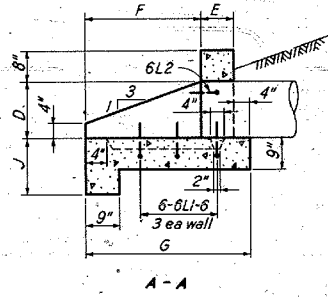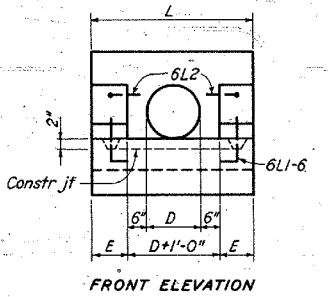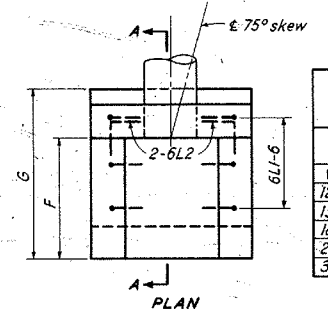



TYPE 2 ENDWALL
 Not to Scale

DIMENSIONS FOR TYPE 2 ENDWALL								QUANTITIES FOR ONE TYPE 2 ENDWALL	
D	H	F	L	T	M	B	CONCRETE CU YDS	STEEL LBS	
18"	2'-6"	4'-6"	6'-3"	0'-8"	2'-8"	1'-0"	0.91	None	
24"	3'-0"	7'-0"	6'-6"	0'-9"	4'-5"	1'-3"	1.57	6	
30"	3'-6"	10'-0"	7'-0"	0'-10"	6'-8"	1'-9"	2.58	6	
3'-1"	3'-0"	3'-6"	11'-0"	13'-3"	0'-10"	6'-8"	3.05	6	

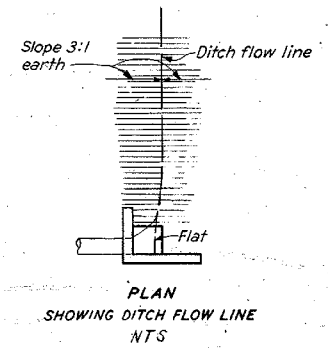

NOTES:
 SPECIFICATIONS: Construction of these structures to be in accordance with Highway Specification - No. 11. EXCAVATION, FOUNDATION, AND BACKFILL: Section 125. CONCRETE: Section 400, Class B concrete, type II portland cement. REINFORCING STEEL: Section 418. CHAMFER: All exposed edges shall be chamfered $\frac{3}{8}$ ". ENDWALL TYPES: Types 3 and 4 may be used for pipes skewed from 75° to 90°. Use dimensions and quantities given for 90° pipes. For all other skews use walls of type 1 and 2 only. CONNECTION TO PIPE: The connection of pipe to endwalls shall be neat and secure. Where entire end of pipe does not extend to front face of endwall, the barrel of the culvert shall be extended with smooth, rigid, circular forms exactly fitting the inner circumference of the pipe. Where a portion of pipe extends beyond the required front face of endwall, it shall be cut off smooth and flush therewith. Where bell and spigot pipe is used, the bell end is to be placed upstream with the end of the pipe flush with face of wall, unless otherwise directed by the Engineer. ENDWALL IN ROCK: Where solid rock is encountered the apron and cut-off wall shall be omitted and the endwall otherwise modified as required. Provide adequate construction keyways between concrete and the rock fdns. for additional notes & reference dwgs see 101-19H252.




Scale $\frac{1}{8}$ " = 1'-0"
 Except as noted

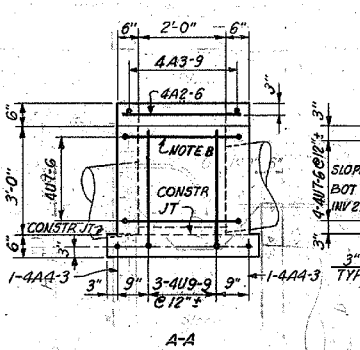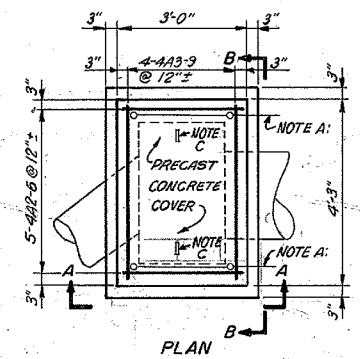



JUNCTION BOX
 1 REQD
 NTS

REMOVED SURVEY MARKER ADDED JUNCTION BOX BAR BENDING DETAILS			
REV	NO.	DATE	BY
DESIGN	CHKD	ENGR	INSUP
APPV	APPR		
DESIGN	CHKD	ENGR	INSUP
APPV	APPR		
NORTH MOORE ROAD RELOCATION			
CONCRETE ENDWALLS AND INLETS FOR PIPE CULVERTS			
SOUTH CHICKAMAUGA CREEK PROJECT			
TENNESSEE VALLEY AUTHORITY			
DIVISION OF ENGINEERING DESIGN			
SUBMITTED		RECOMMENDED	
APPROVED		APPROVED	
INSPECTED AND APPROVED FOR ISSUE			
KNOXVILLE 12-4-78		101-19H256-3.R1	

PRINTS RECD-R
 BR OF PROJ
 DWG SIZE
 F H
 ME
 EC
 CD
 AD
 ED
 MD
 BF
 SW
 BL
 PA

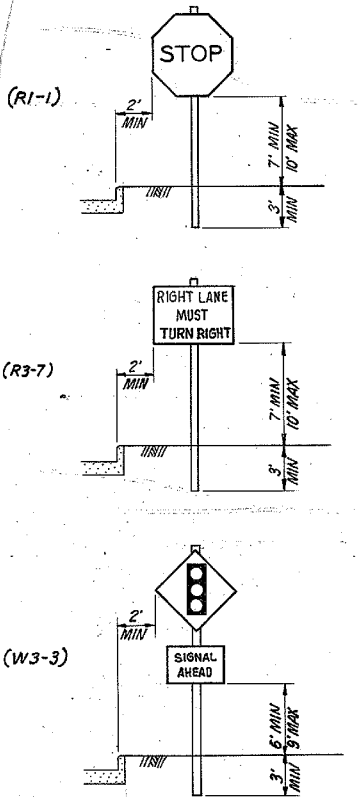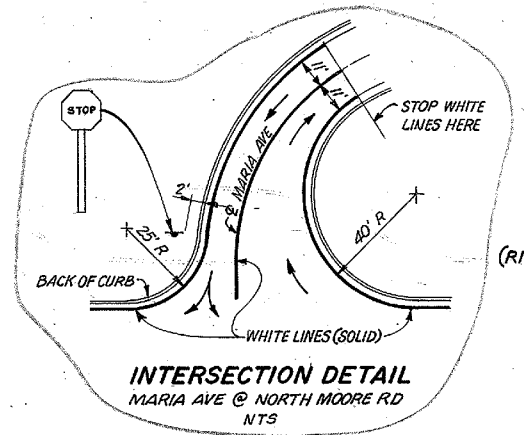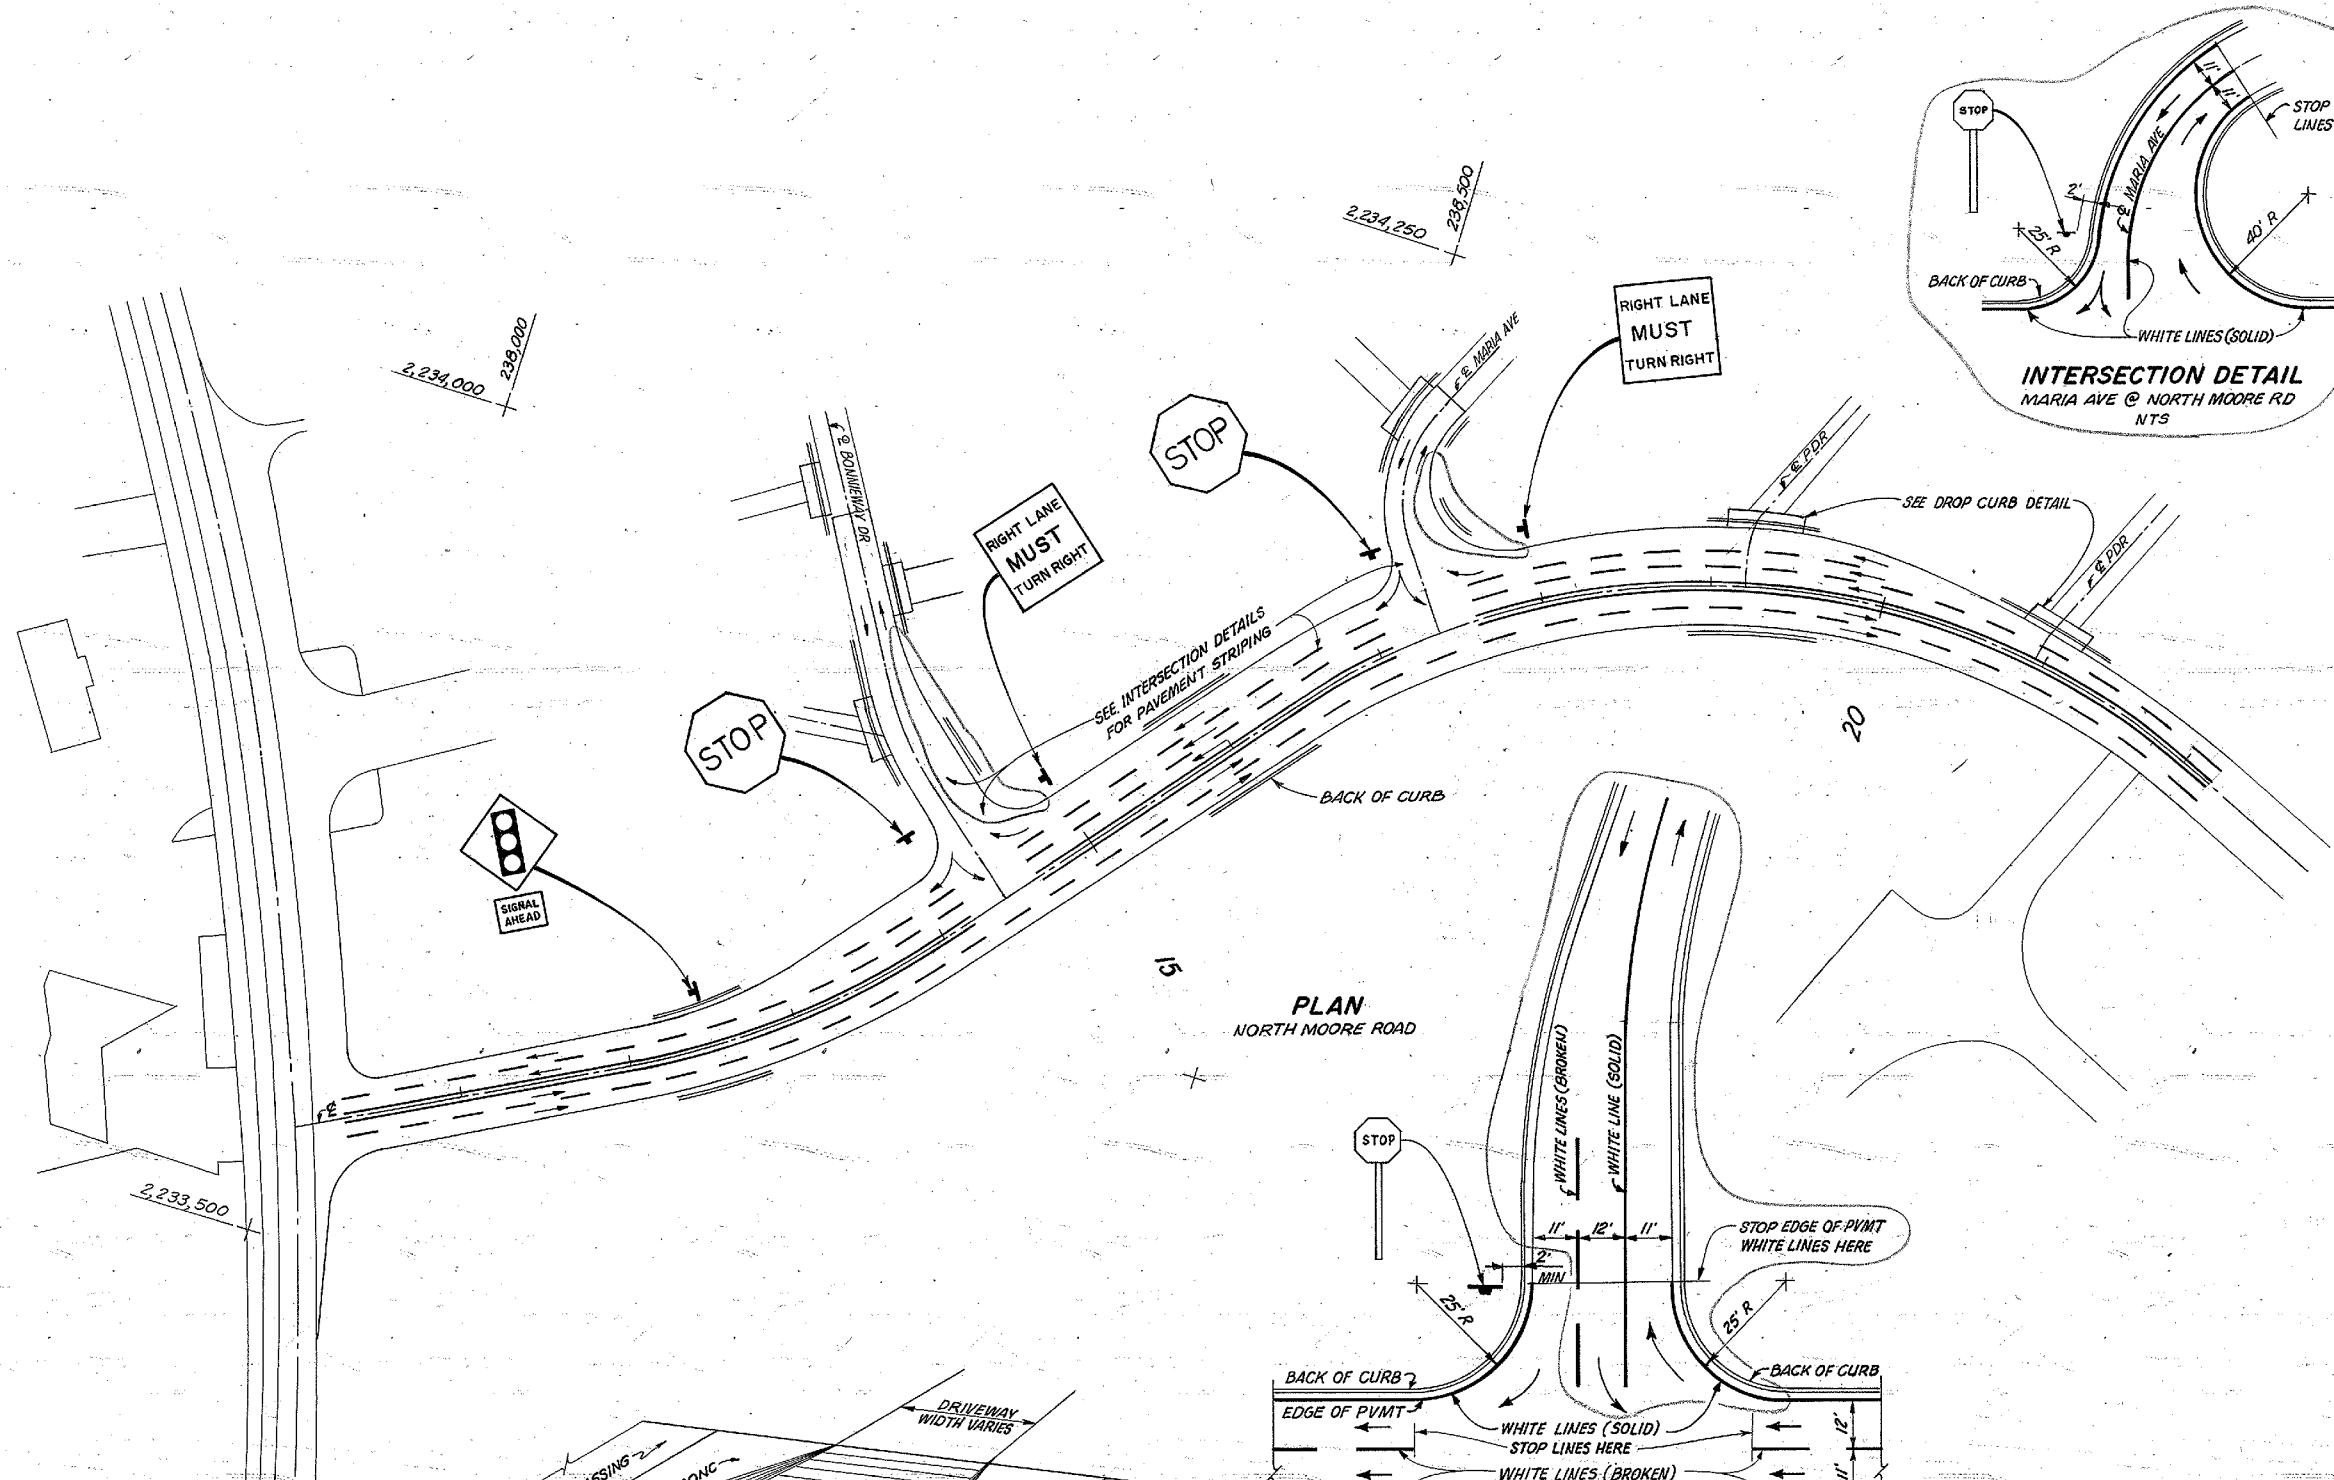

PLAN
NORTH MOORE ROAD

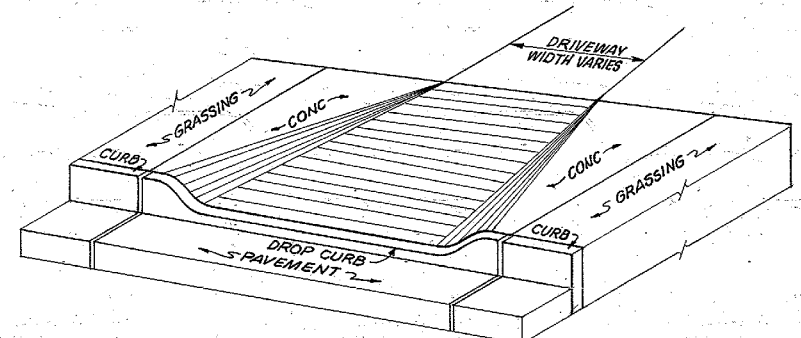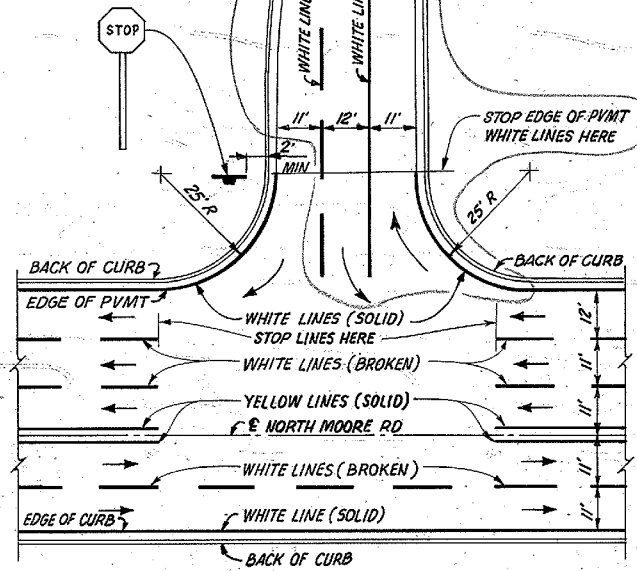

- NOTES:**
1. FOR TRAFFIC SIGN AND PAVEMENT STRIPING DETAILS SEE "MANUAL ON UNIFORM TRAFFIC CONTROL DEVICES" (D6, 1-1971)
 2. ALL MATERIALS REQUIRED FOR SIGNING AND STRIPING SHALL CONFORM TO CITY OF CHATTANOOGA STANDARDS AND SPECIFICATIONS AND SHALL BE OF THE SAME MANUFACTURE AS USED CURRENTLY BY THE CITY.
 3. FOR ADDITIONAL NOTES AND REFERENCE DRAWINGS SEE 101-19H252.


SCALE: 1" = 50'
EXCEPT AS NOTED

10-9-78									
REVISED INTERSECTIONS	NO.	DATE	DESIGN	CONC	SUPV	ENGR	INSP	APPR	APPR
DSGN	H.L. PETTY		INSP		J.R. LEE				
CHD	W. R. LEE		ENGR		W. R. LEE				
SUPV	W. R. LEE		ENGR		E. B. Sorenson				
NORTH MOORE ROAD RELOCATION									
TRAFFIC CONTROL DEVICES PAVEMENT STRIPING AND DROP CURB DETAILS									
SOUTH CHICKAMAUGA CREEK PROJECT TENNESSEE VALLEY AUTHORITY DIVISION OF ENGINEERING DESIGN									
SUBMITTED		RECOMMENDED		APPROVED					
[Signature]		[Signature]		[Signature]					
KNOXVILLE 12-4-78 81 HR 101-19H257 RI									
RECORD DRAWING AS CONSTRUCTED									

1	2	3	4	5	6
---	---	---	---	---	---

XX


BY	DATE
DESIGNED	1997/14
CHECKED	
DATE	
REVISION	
NO.	
DESCRIPTION	

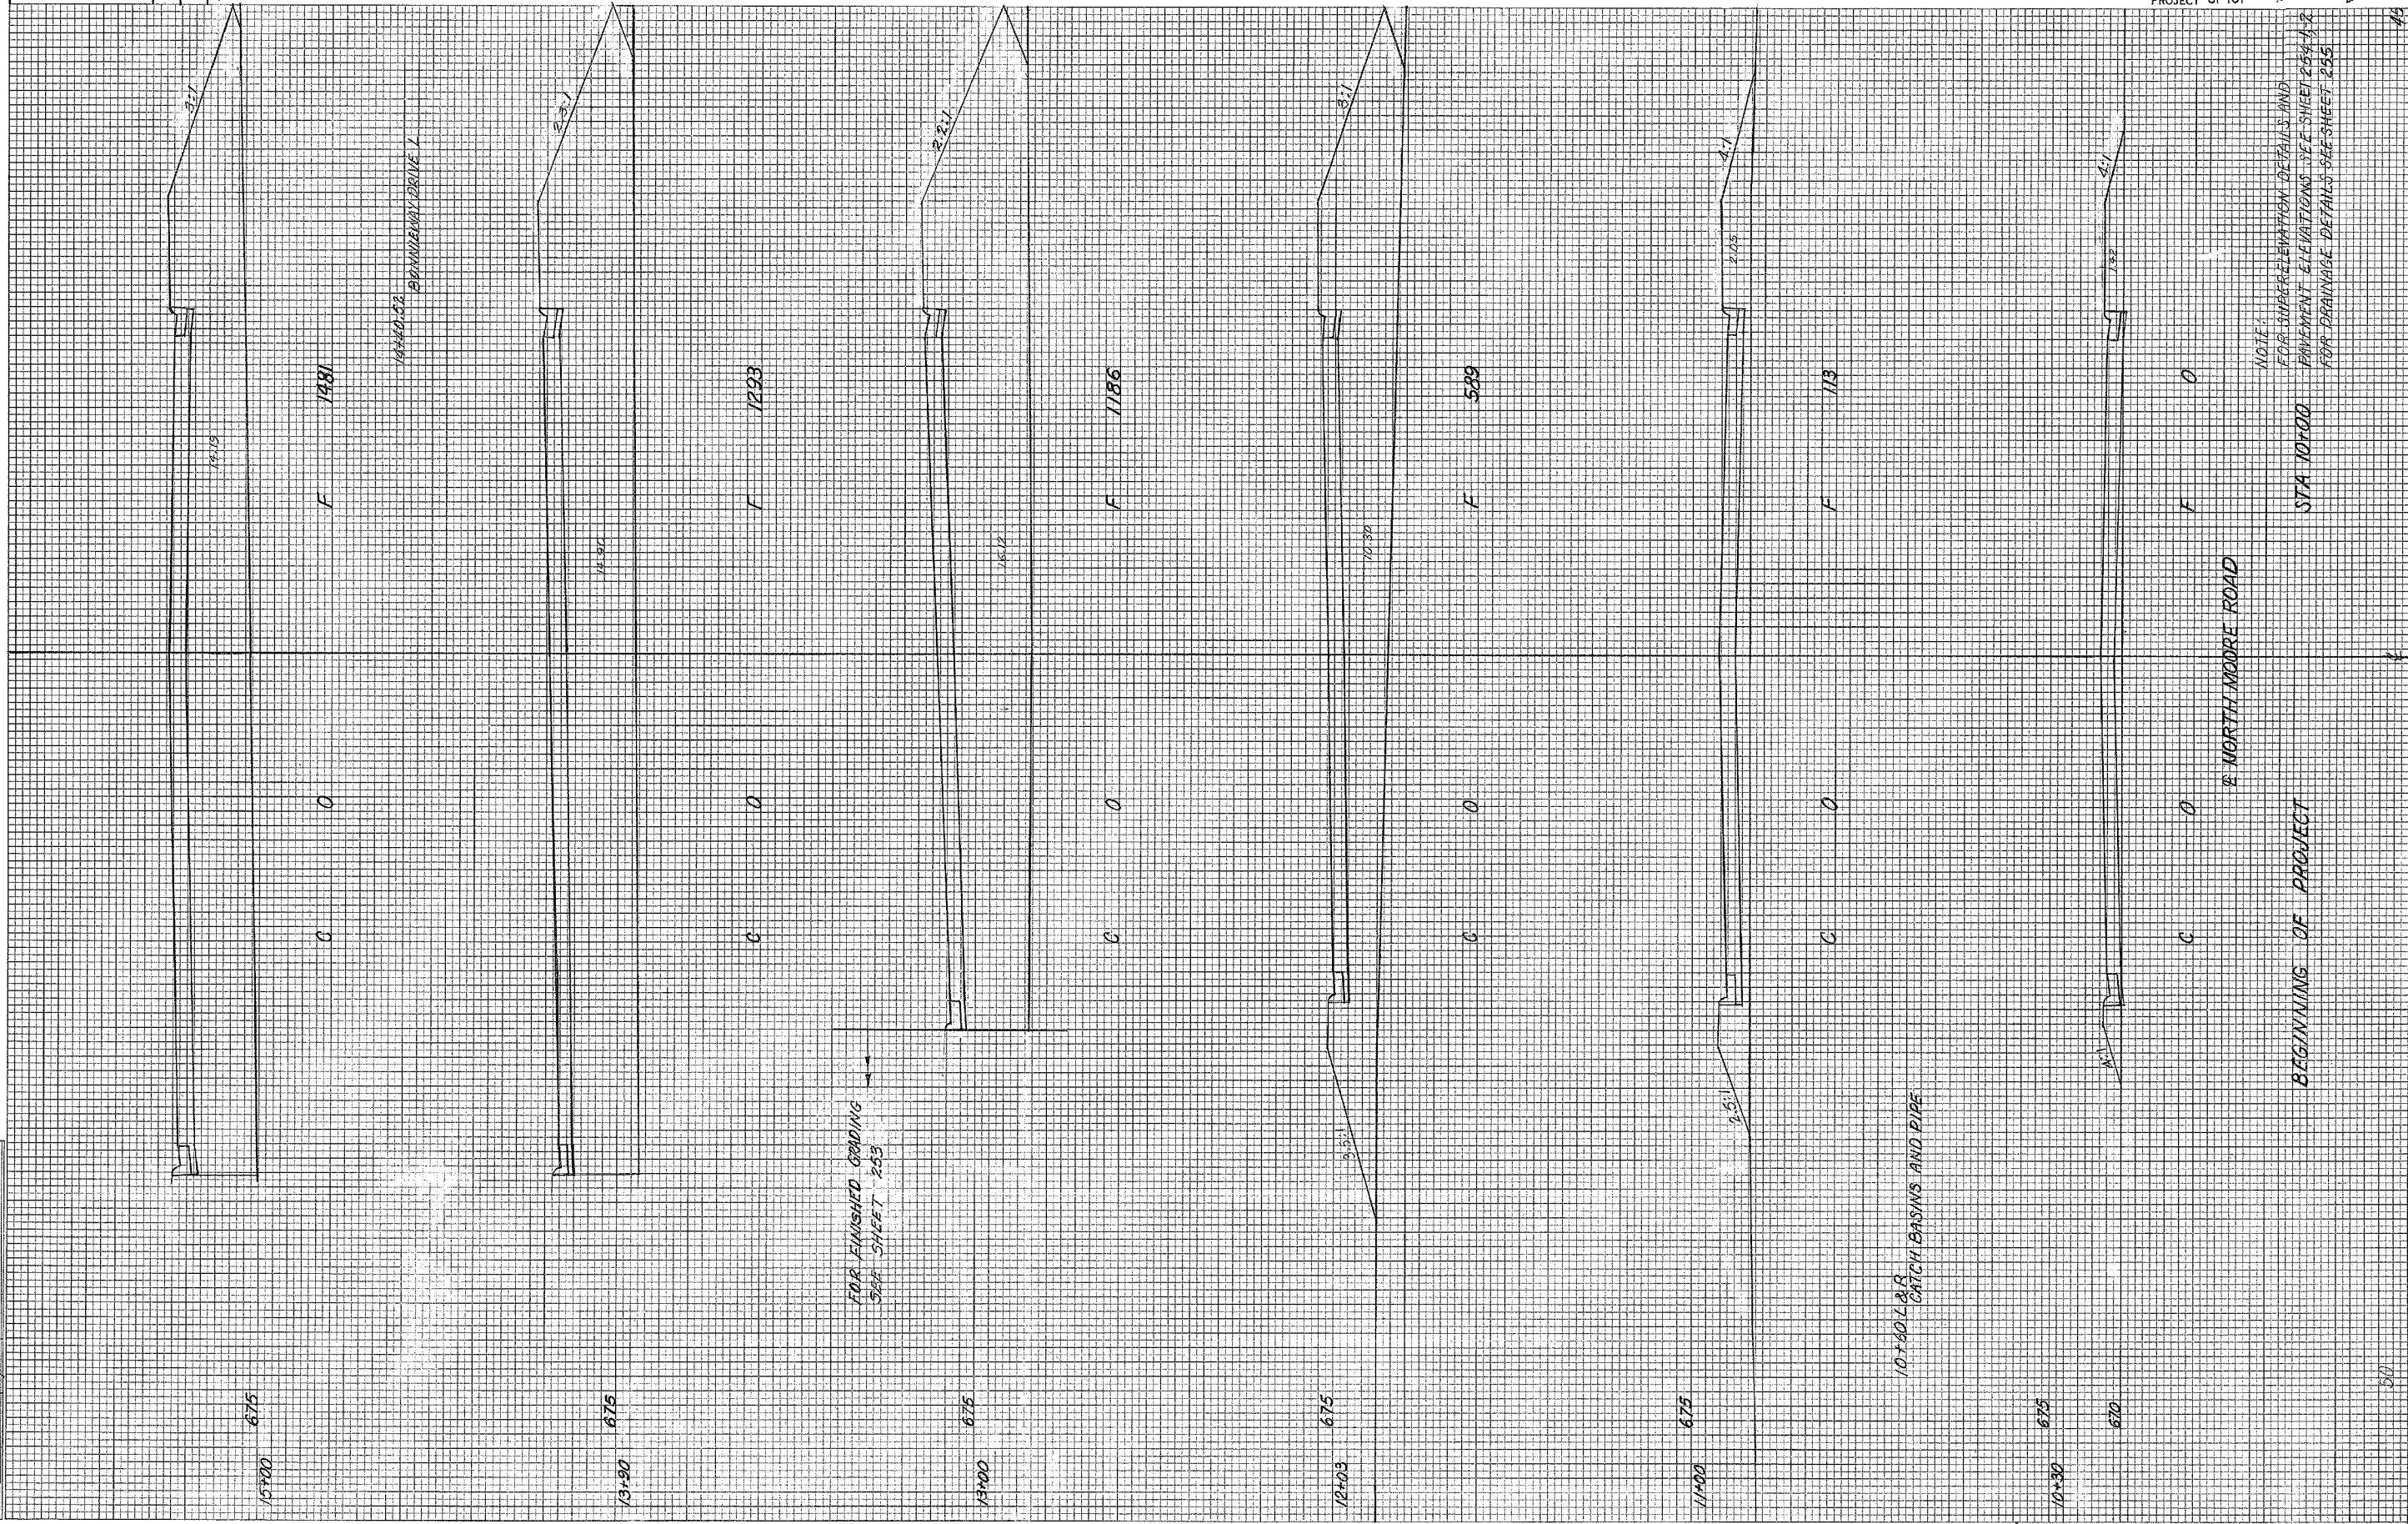

FOR FINISHED GRADING
SEE SHEET 253

NOTE:
FOR SUPERELEVATION DETAILS AND
PAVEMENT ELEVATIONS SEE SHEET 254-1, 2
FOR DRAINAGE DETAILS SEE SHEET 255

BY	CHECKED	DATE
PLOTTED	10/10/17	10/10/17
APPROVED	10/10/17	10/10/17
VOLUMES	1	2
REVISIONS		

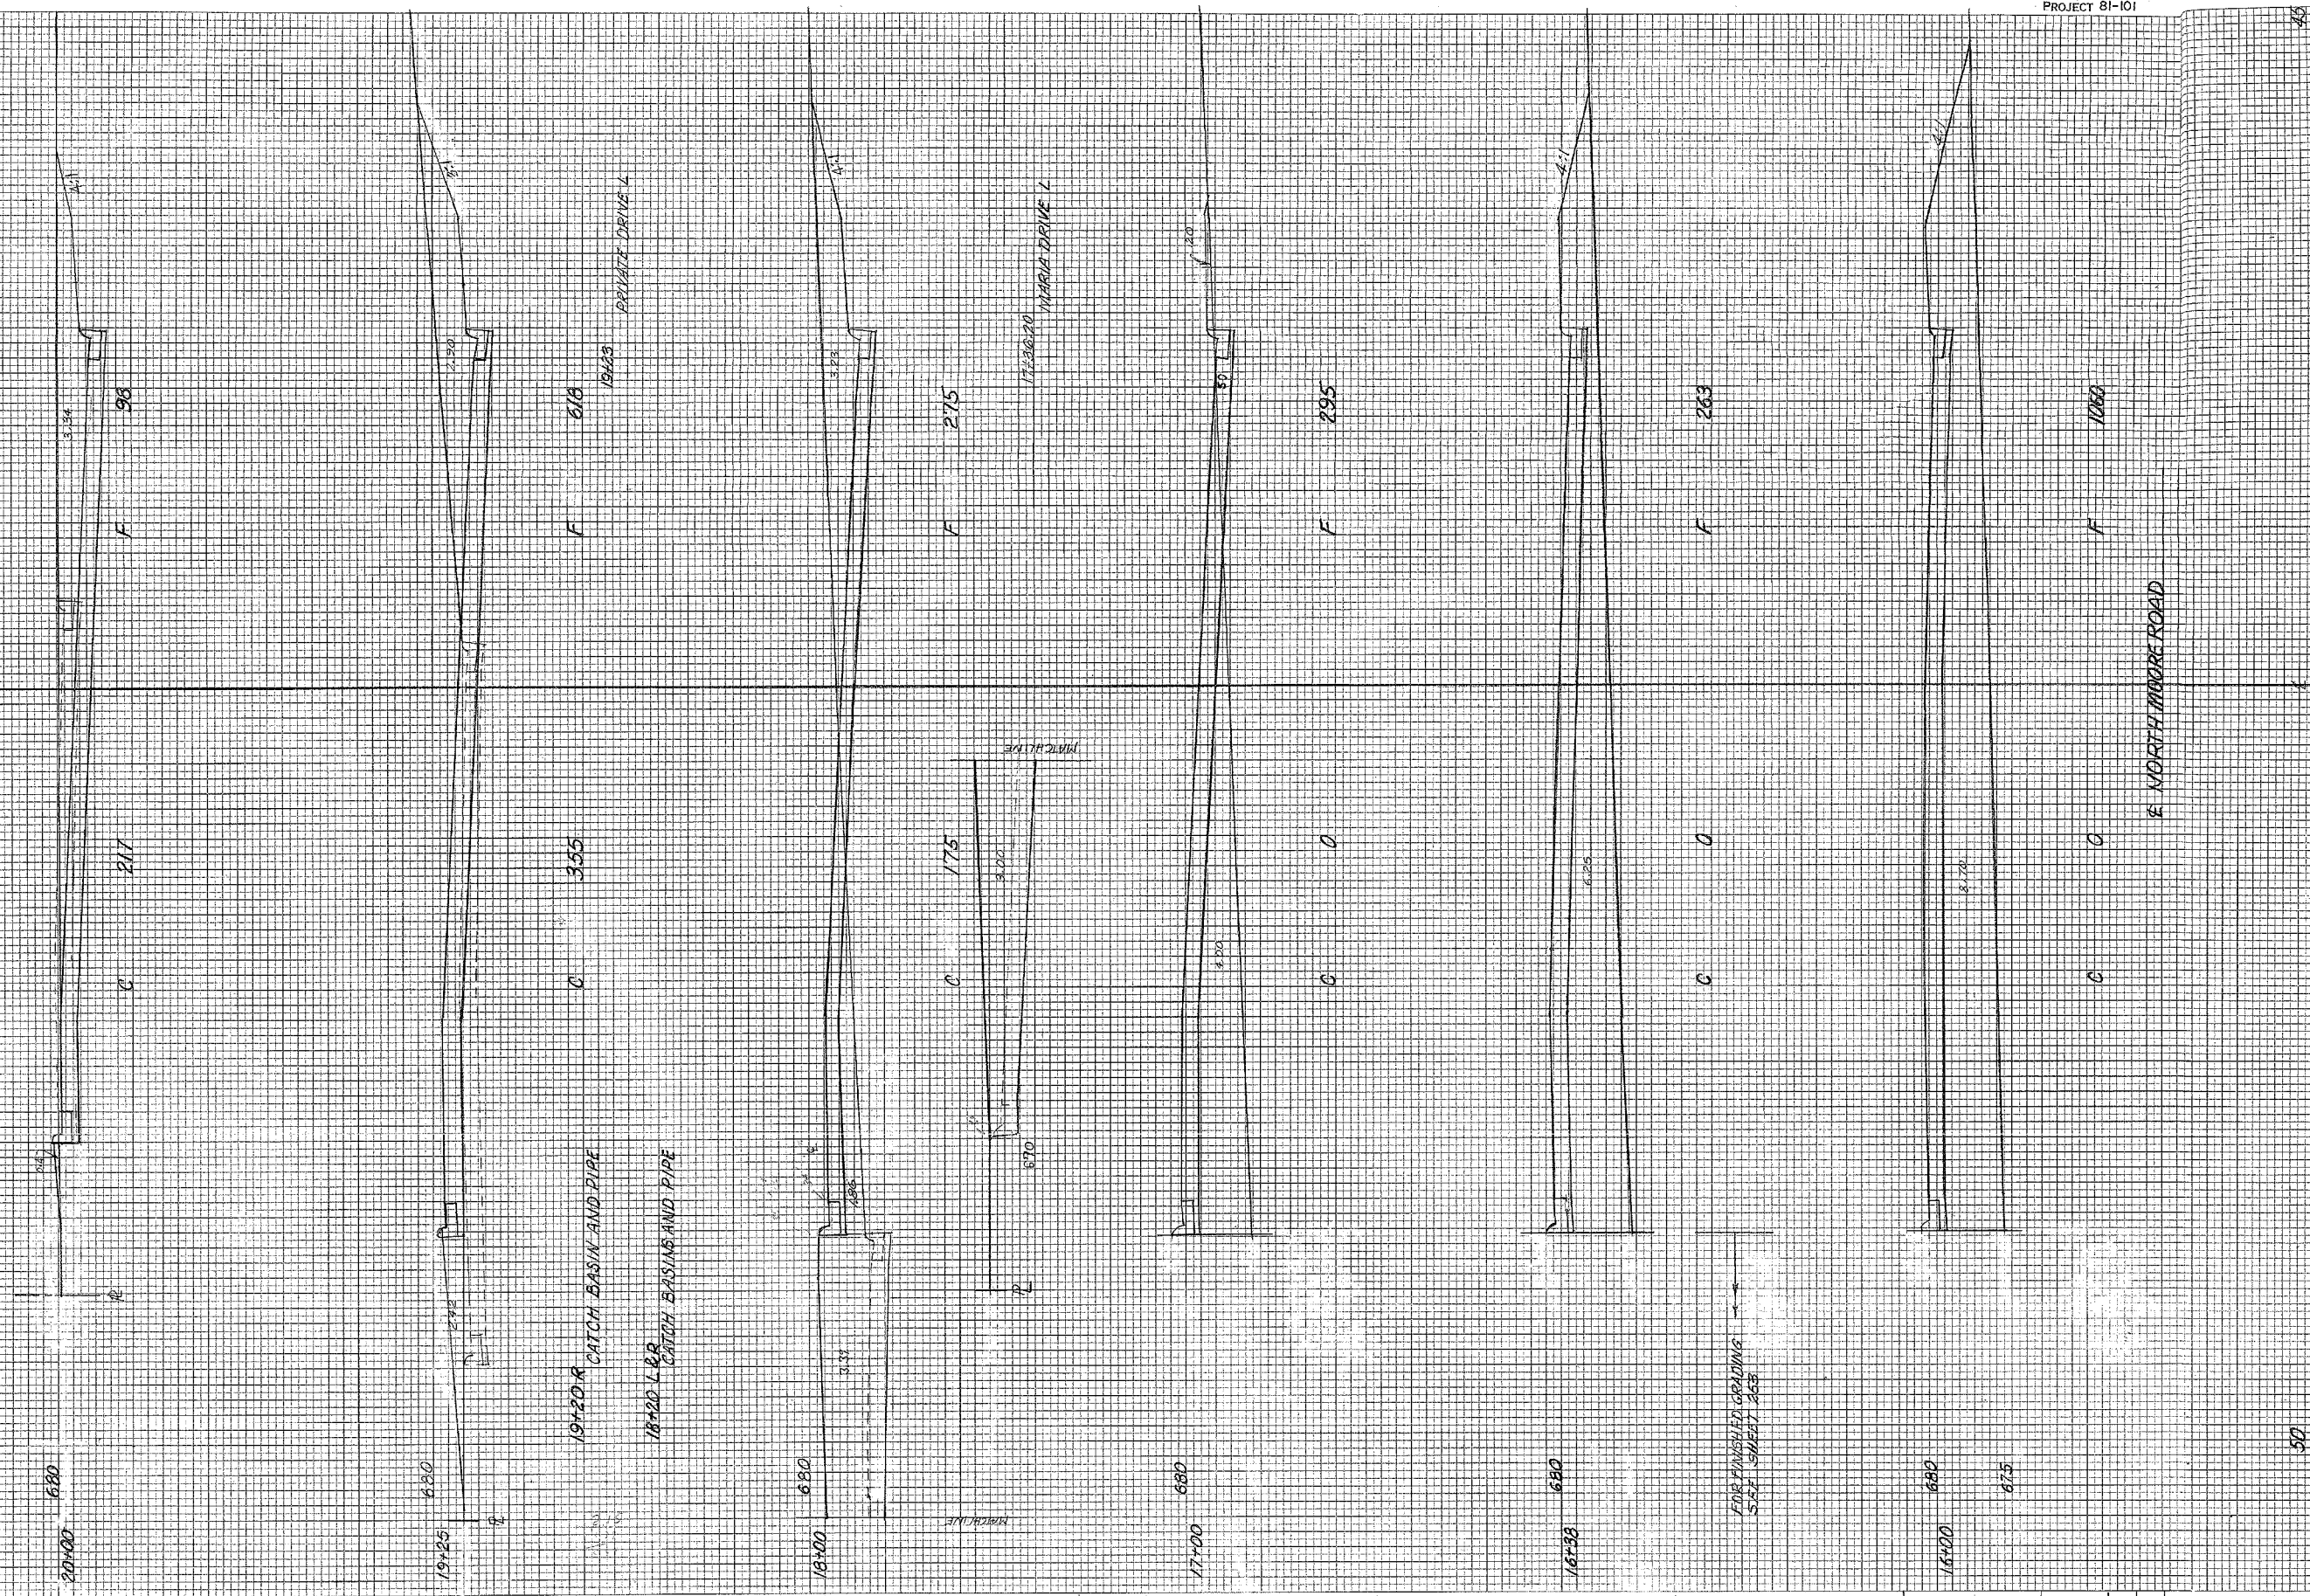

NOTED	CHECKED	DATE
1/18/81	1/22/81	1/24/81
1/18/81	1/22/81	1/24/81
KRE 252 3061*

END OF PROJECT

STA 22+11.3

22+11.3 680

21+85 680

21+65.7 680

20+90 680

675

E NORTHMOORE ROAD

END MEASURE CONSTRUCTION RIGHT

20+95 PRIVATE DRIVE L

EXIST. PAVT.

50

MT RO

76

BY	CHECKED	DATE
J.B. LEV	J.B. LEV	10/11/78
AREA	DATE	
J.R. LEV	J.R. LEV	
QUANTITIES		
REVISIONS		


END OF PROJECT

STA 4+66

CUT=0

FILL= 216 CU YDS.

FOR CONTOURS SEE
GRADING PLAN 511 253

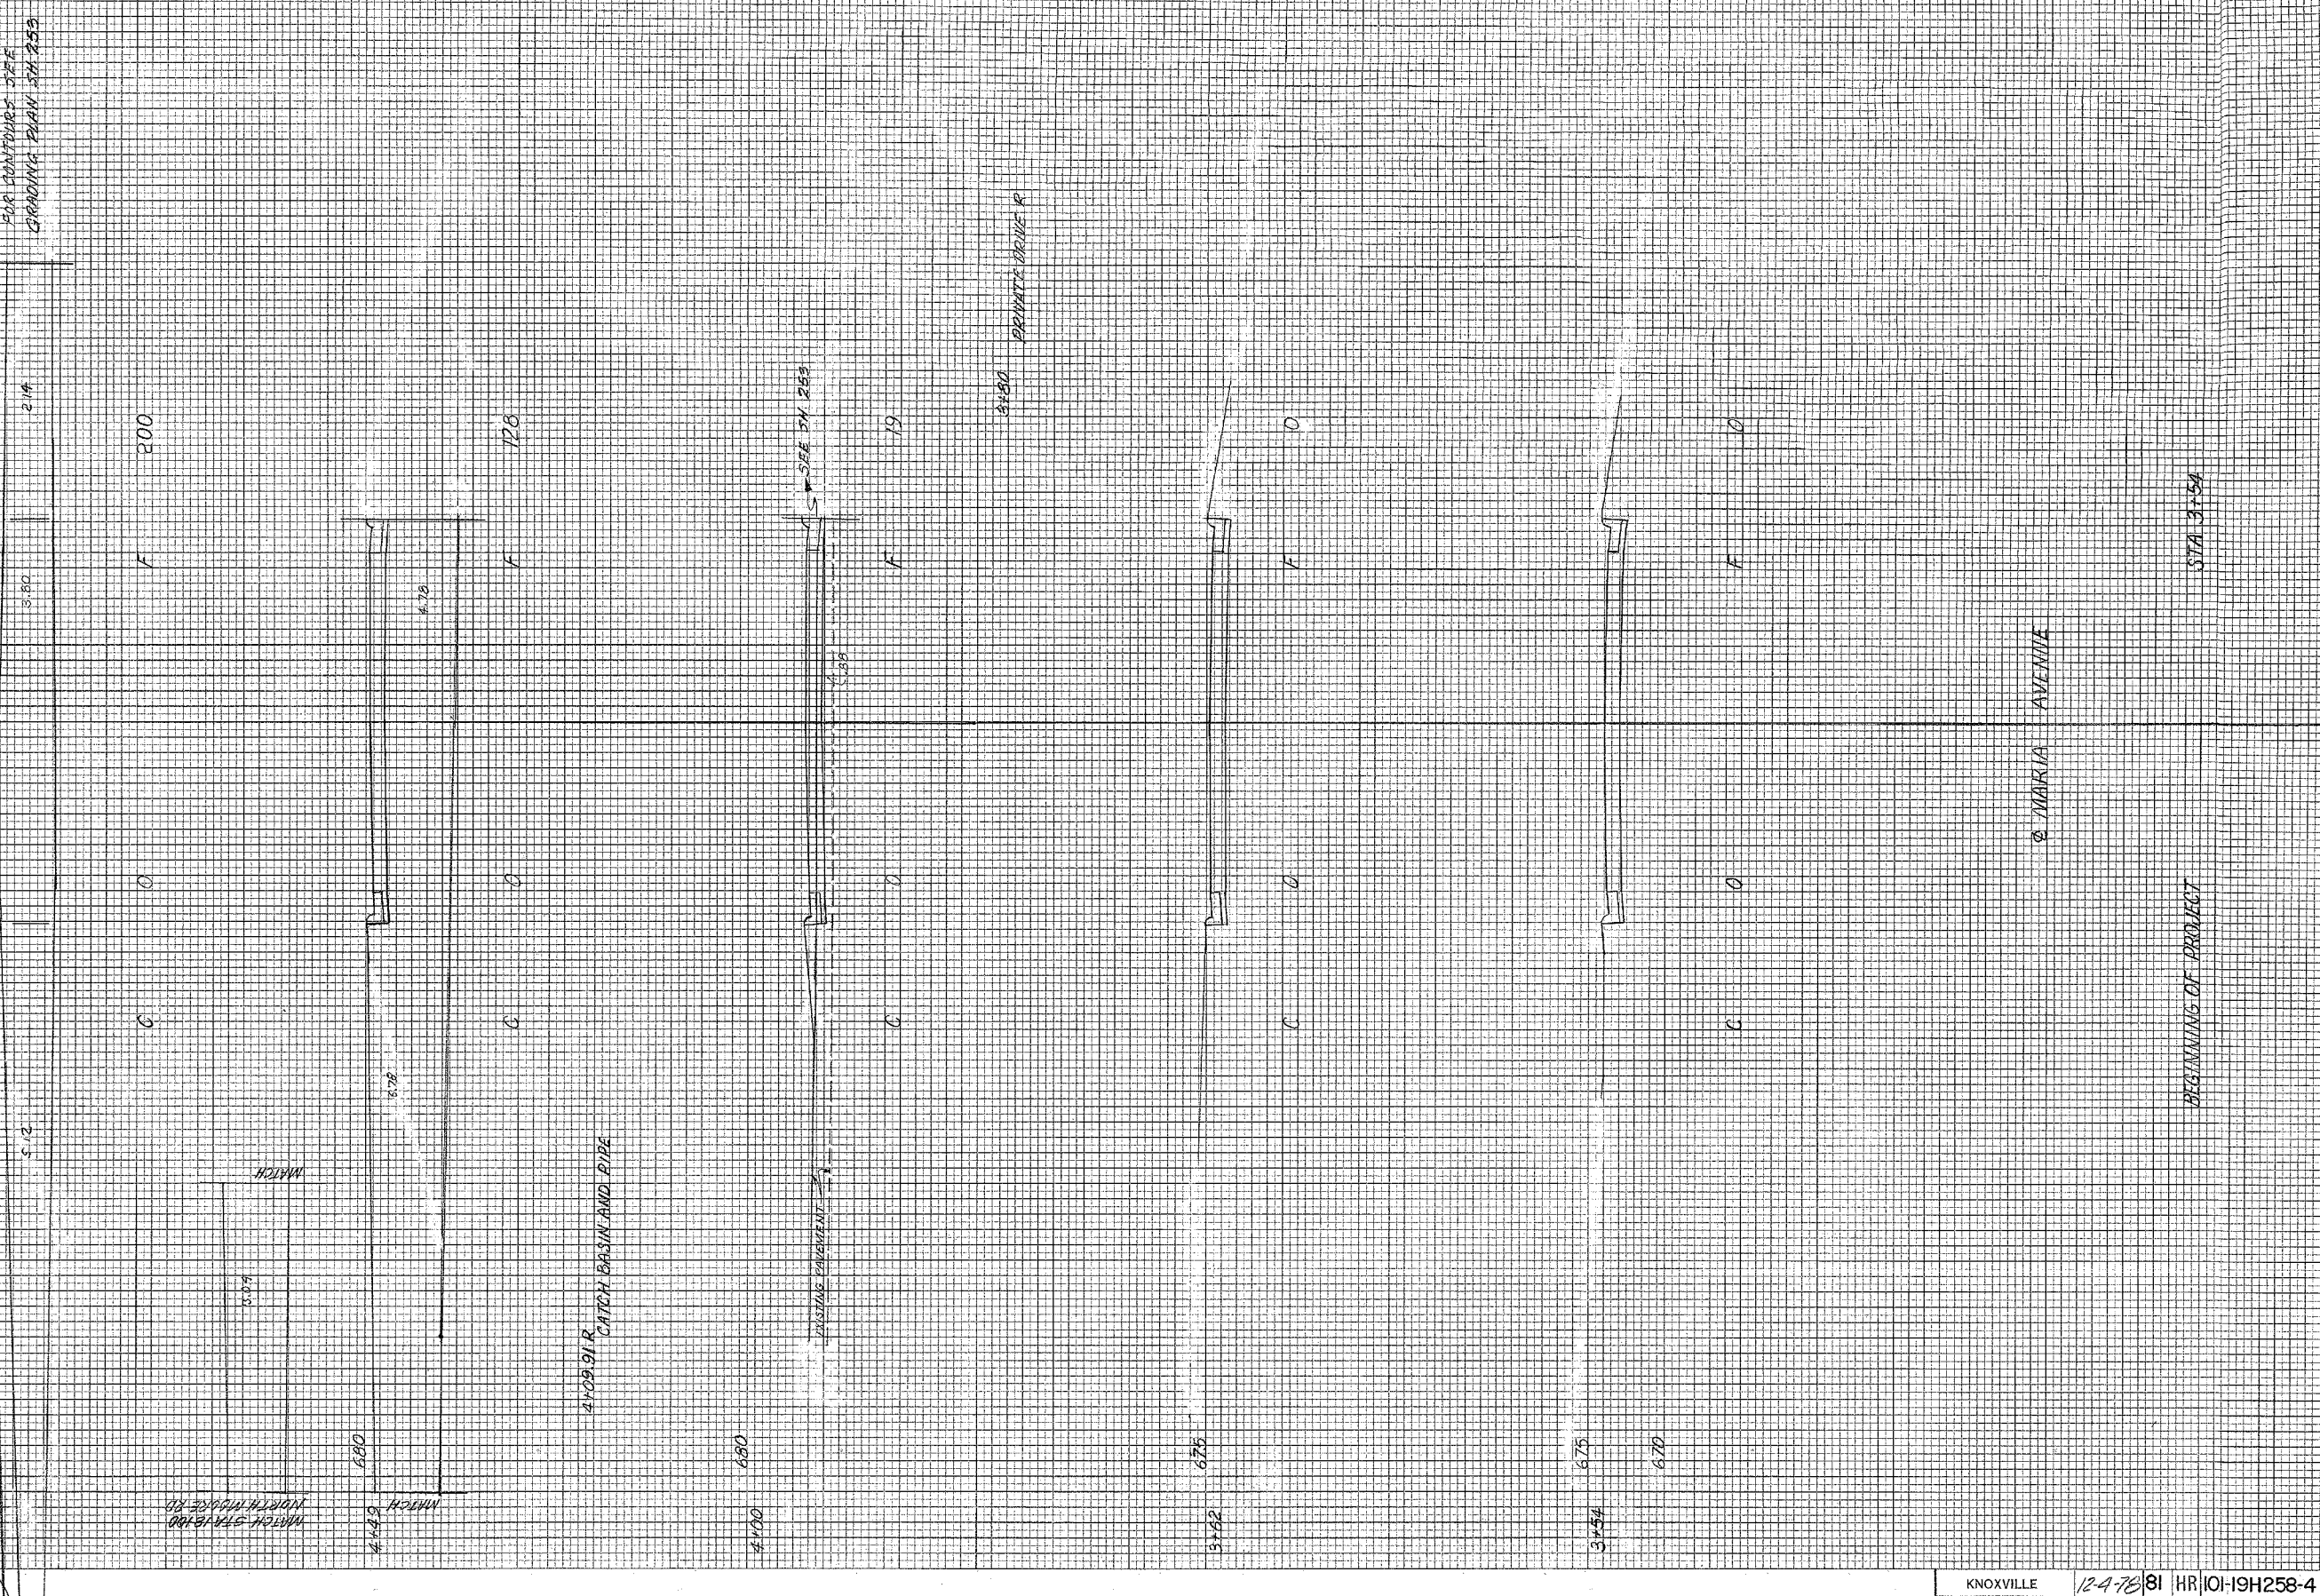

214

F 200

F 128

F 19

F 0

F 10

4+09 3+54
CATCH BASIN AND PIPE

3+50
DEWATERING R

MARIYA AVENUE


BEGINNING OF PROJECT

STA 3+54


BY	DATE
DESIGNED	10/17/78
CHECKED	
DATE	
BY	
DATE	
BY	
DATE	
BY	
DATE	

END OF PROJECT
CUT = 0

STA 4+86
FILL = 387 CU YDS.

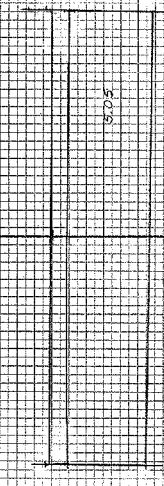


C 0
F 175

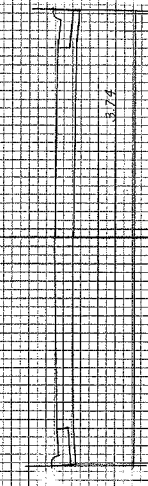

C 0
F 115

STAGGER LEVÉE ACCESS R

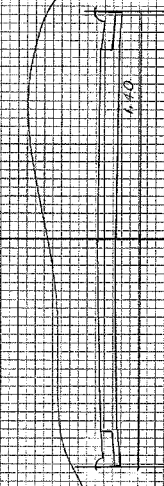

C 0
F 56

3+37.97 R&L
CATCH BASINS AND PIPES



C 0
F 11

2+42 PRIVATE DRIVE A




C 0
F 0

24+47.97 R&L
EXISTING CATCH BASIN
AND PIPE

4 BONNEWAY DRIVE

BEGINNING OF PROJECT

STA 2+56.5

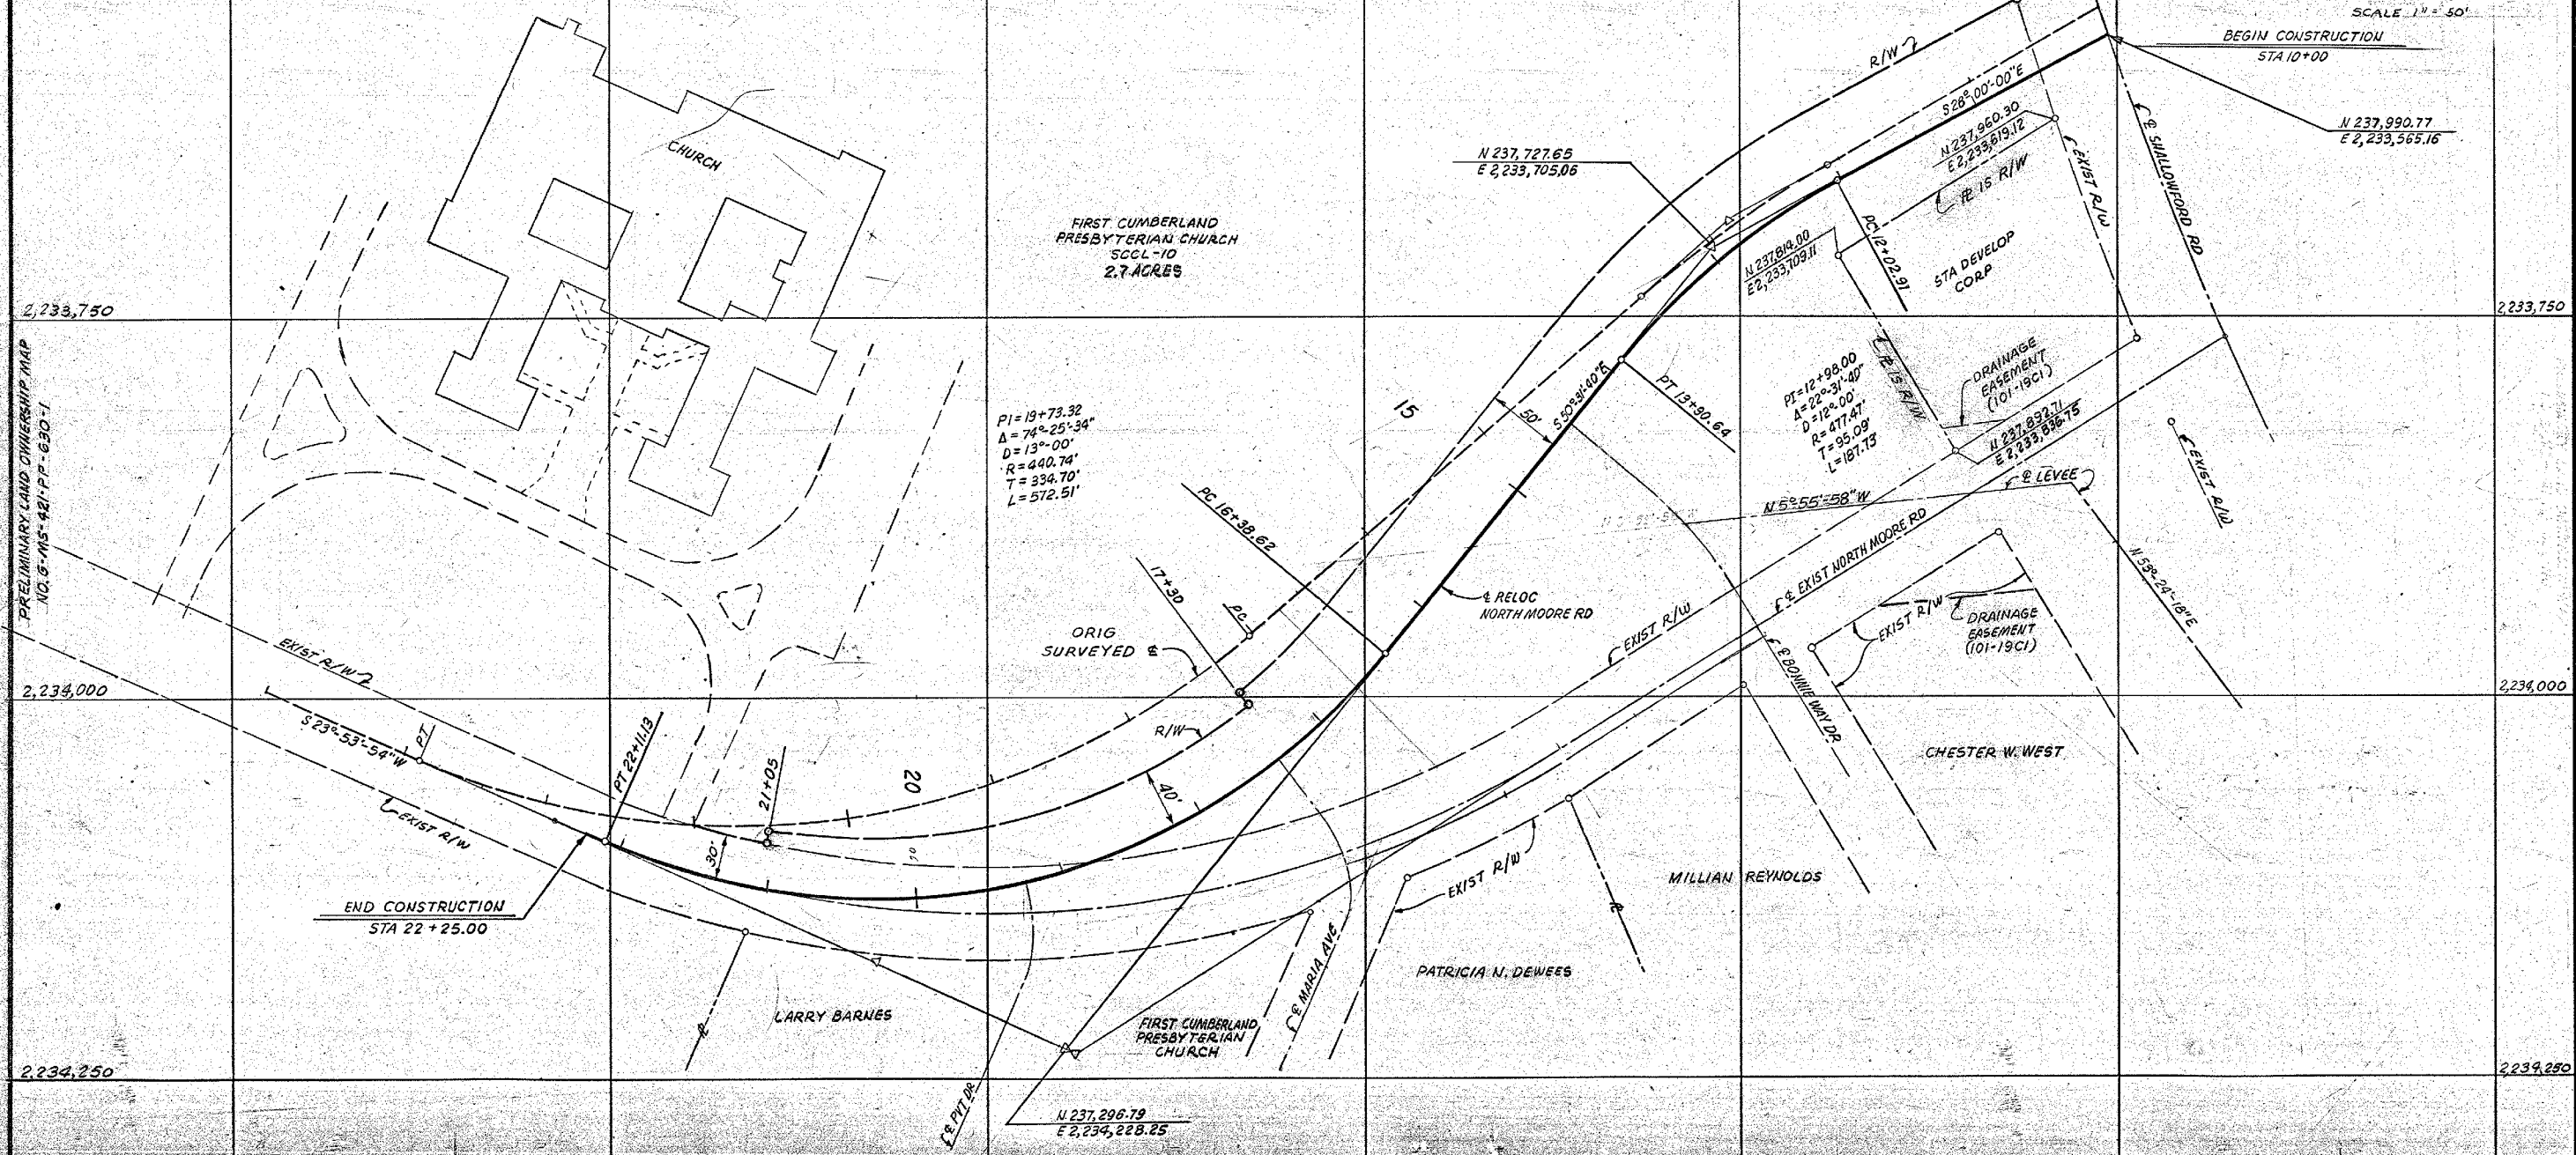



PRELIMINARY LAND OWNERSHIP MAP
NO. 6-MS-421-P-630-1

DRAWN: V.R. LEE
CHECKED: R.B.R.
INSP: E.C. B. JR.
R.B. 3/8/84

CITY OF CHATTANOOGA
HAMILTON COUNTY, TENNESSEE

OSBORNE FARM ROAD ACROSS LEVEE
SOUTH CHICKAMAUGA CREEK PROJECT
TENNESSEE VALLEY AUTHORITY
DIVISION OF ENGINEERING DESIGN

SCALES: PLAN - 1"=50'
HORIZ - 1"=50'
PROFILE - VERT: 1"=10'

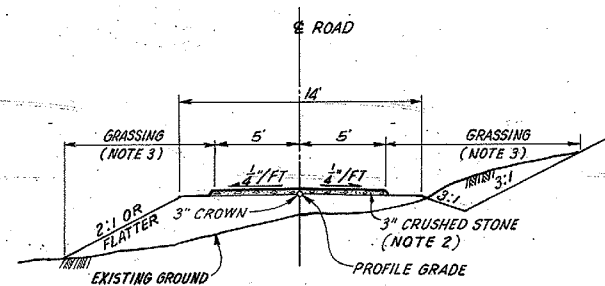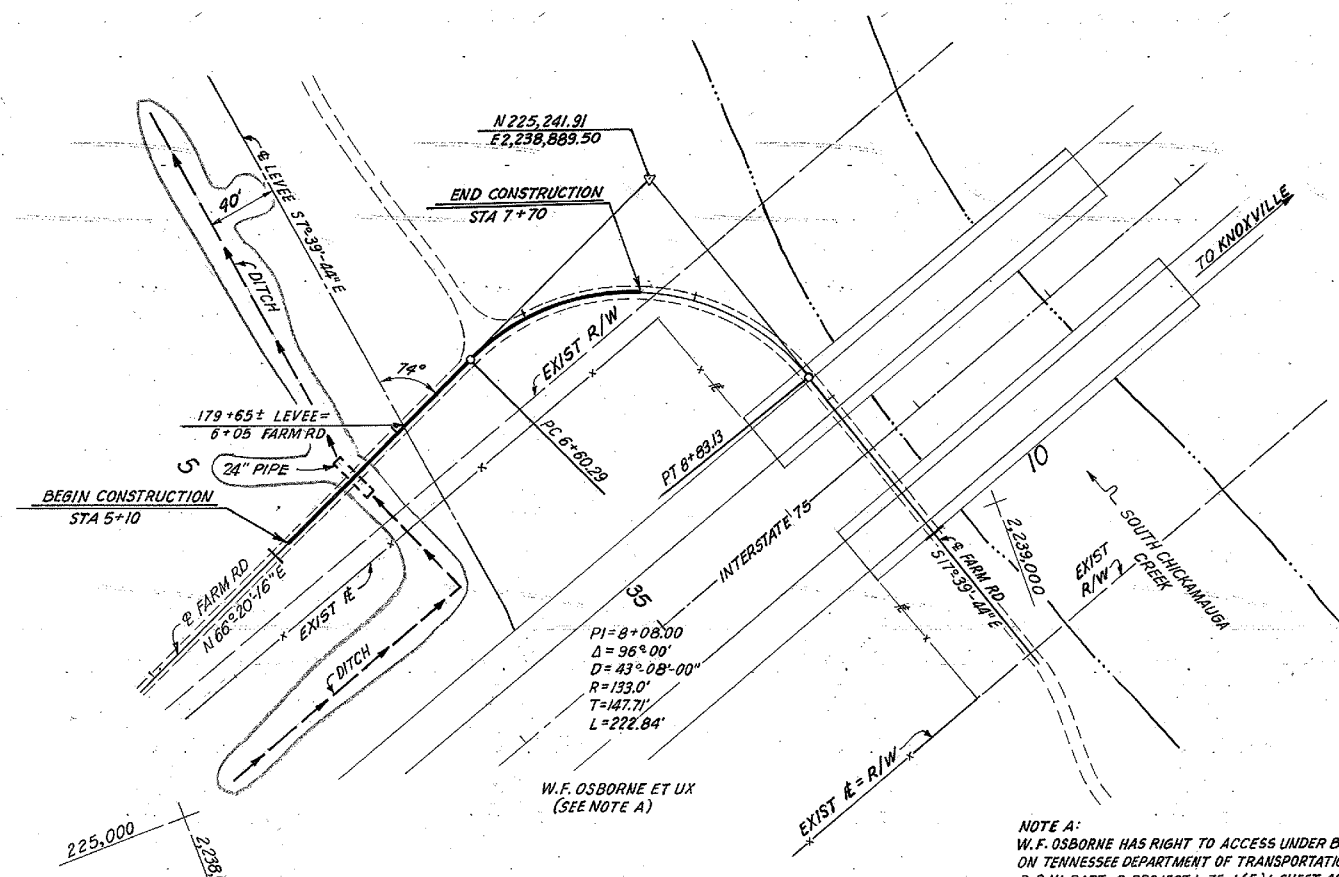

TYPICAL SECTION
NTS

LENGTH OF PROJECT = .05 MILE


ITEM NO	DESCRIPTION	QUANTITY
123	EARTH BORROW EXCAVATION	350 C.Y.
180 & 182	SEEDING & MULCHING	580 S.Y.
210	CRUSHED STONE	39 TONS
129	STRUCTURAL EXCAVATION	20 C.Y.
402	CLASS B CONCRETE	318 C.Y.
418	REINFORCING STEEL	45 LBS
602	24" CONCRETE PIPE	28 L.F.


INDEX TO SHEETS	
TITLE	SHEET NO
PLAN AND PROFILE	101-19H260

- NOTES:
1. ALL CONSTRUCTION TO BE IN ACCORDANCE WITH THE HIGHWAY T-1 SPECIFICATIONS UNLESS OTHERWISE NOTED
 2. SURFACING SHALL BE 3" OF CRUSHED STONE PLACED IN ACCORDANCE WITH SECTION 210.
 3. GRASSING: ALL CUT AND FILL SLOPES AND DISTURBED AREAS SHALL BE SEEDED, TYPE 7 MIXTURE, SHOULDERS AND DITCH SLOPES SHALL BE SEEDED WITH TYPE 5 MIXTURE. ALL GRASSED AREAS SHALL BE FERTILIZED AND MULCHED IN ACCORDANCE WITH SECTION 180 & 182 RESPECTIVELY.

NOTE A:
W.F. OSBORNE HAS RIGHT TO ACCESS UNDER BRIDGE GRANTED ON TENNESSEE DEPARTMENT OF TRANSPORTATION PLANS FOR R.O.W. PART-2 PROJECT 1-75-1(5)1 SHEET 4B OF 244.

CITY OF CHATTANOOGA
HAMILTON COUNTY, TENN

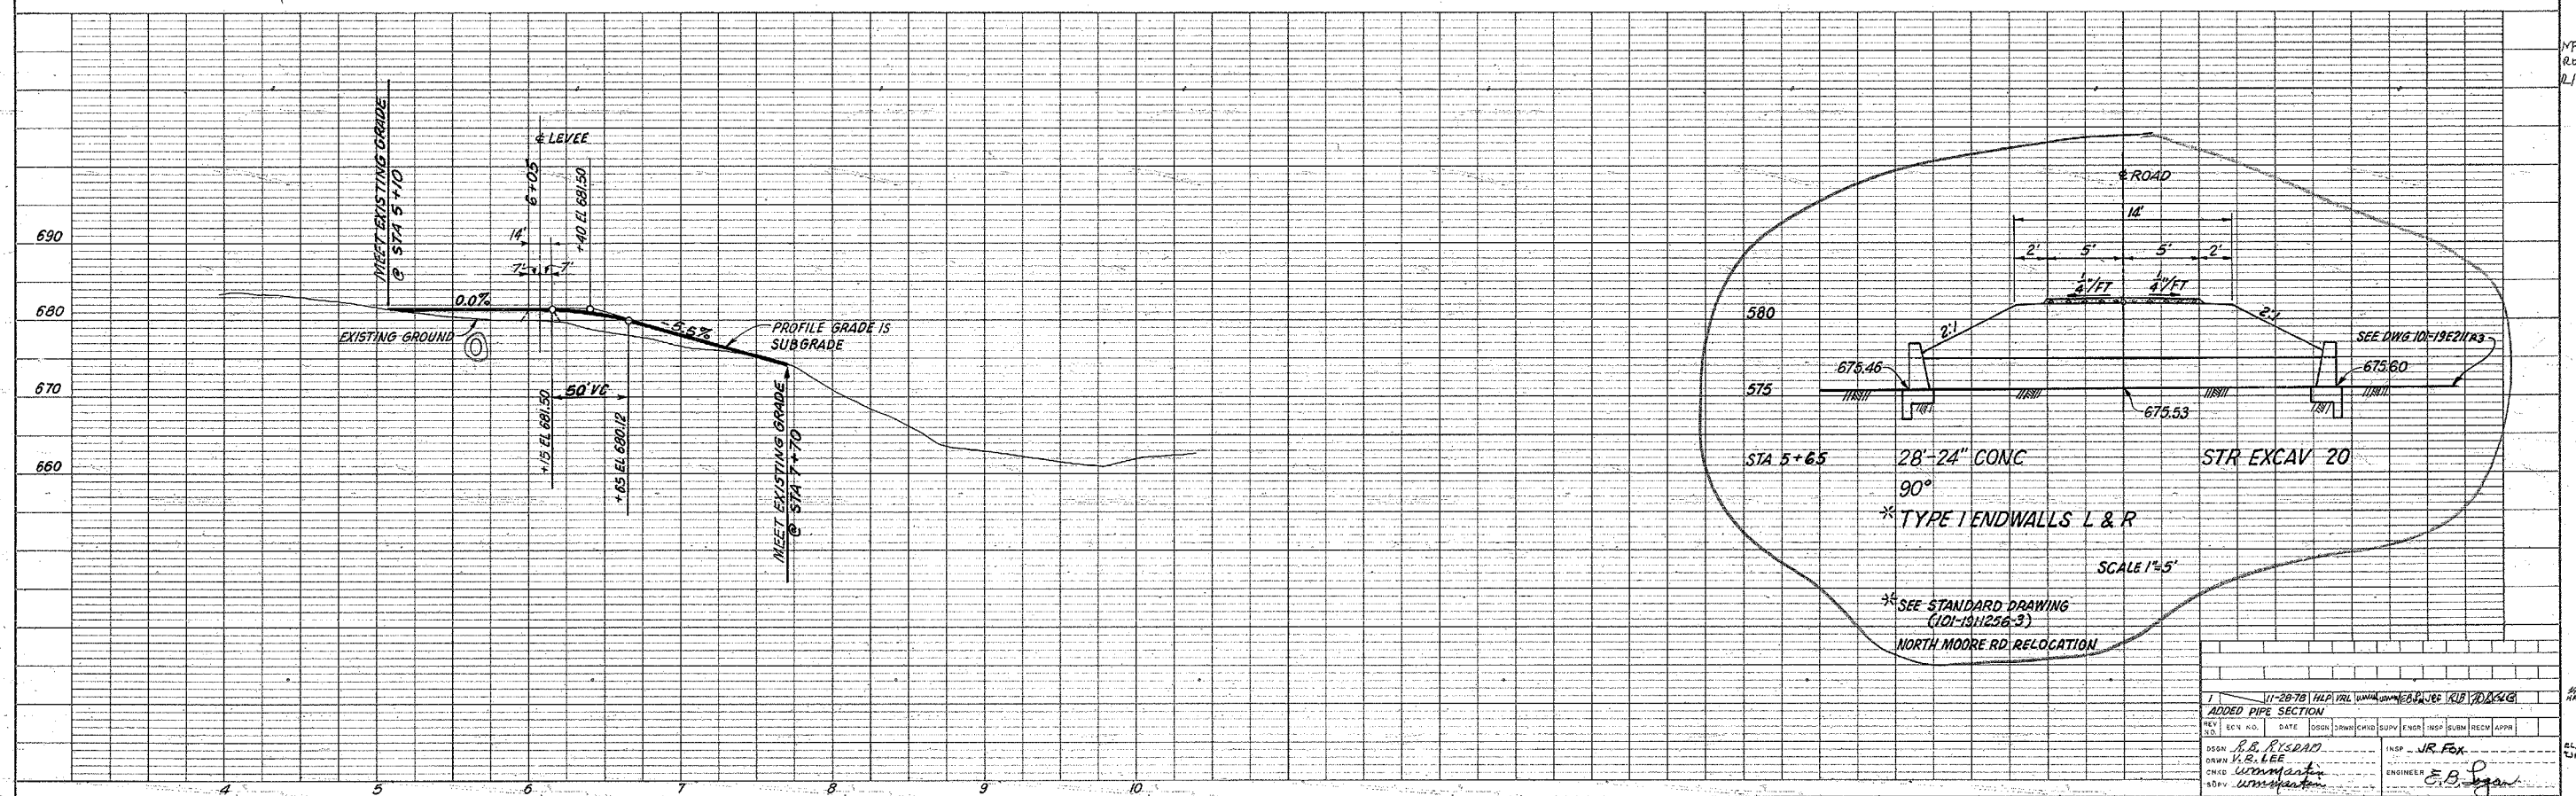

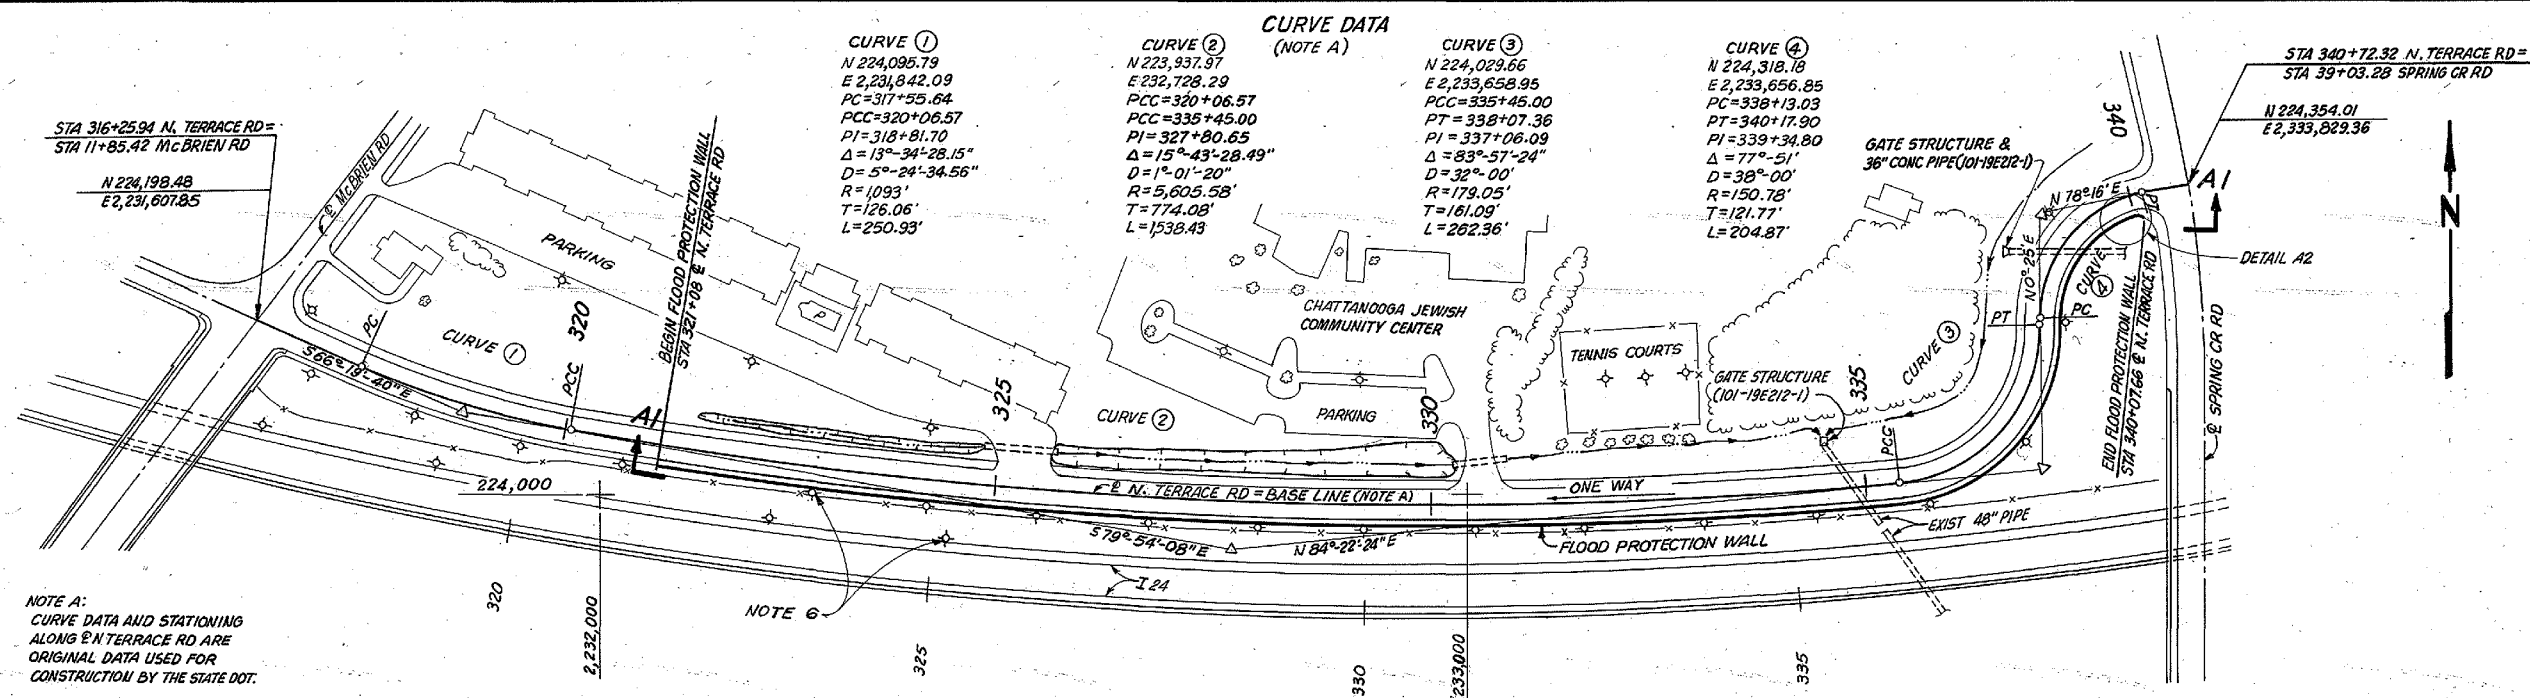


CURVE DATA (NOTE A)

CURVE	PC	PCC	PT	PI	Δ	D	R	T	L	
CURVE ①	N 224,095.79	E 2,231,842.09	PC=317+55.64	PCC=320+06.57	PT=318+81.70	Δ=13°-34'-28.15"	D=5°-24'-34.56"	R=1093'	T=126.06'	L=250.93'
CURVE ②	N 223,937.97	E 2,232,728.29	PC=320+06.57	PCC=335+45.00	PT=327+80.65	Δ=15°-43'-28.49"	D=1°-01'-20"	R=5,605.58'	T=774.08'	L=1538.43'
CURVE ③	N 224,029.66	E 2,233,658.95	PC=335+45.00	PCC=338+07.36	PT=337+06.09	Δ=83°-57'-24"	D=32°-00'	R=179.05'	T=161.09'	L=262.36'
CURVE ④	N 224,318.18	E 2,233,656.85	PC=338+07.36	PCC=340+17.90	PT=339+34.80	Δ=77°-51'	D=38°-00'	R=150.78'	T=121.77'	L=204.87'

NOTE A:
CURVE DATA AND STATIONING
ALONG N. TERRACE RD ARE
ORIGINAL DATA USED FOR
CONSTRUCTION BY THE STATE DOT.

PLAN
SCALE: 1"=100'

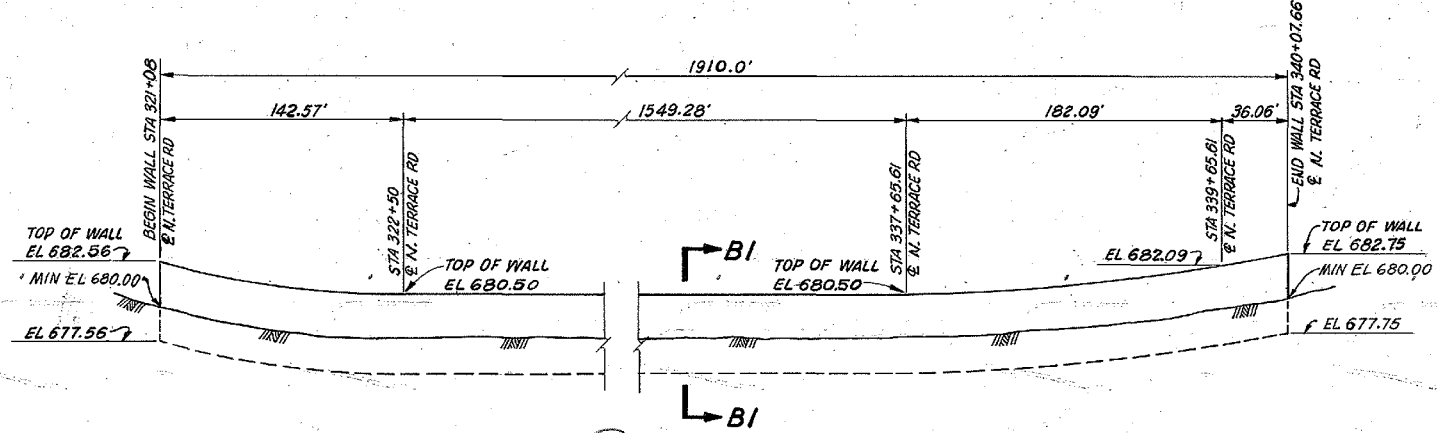


SUMMARY OF QUANTITIES

ITEM NO	DESCRIPTION	QUANTITY
129	EXCAVATION FOR STRUCTURE	560 C.Y.
180 & 182	SEEDING & MULCHING	1,060 S.Y.
225	STABILIZED BASE	250 TONS
302	BITUMINOUS TACK COAT	.75 TON
345	ASPHALTIC CONC SURF COURSE	190 TONS
418	REINFORCEMENT STEEL	12,300 LBS
	TYPE I PVC SEAL	260 L.F.

* PER GEN CONSTR SPEC NO. G-2

- NOTES:
- SPECIFICATIONS: ALL WORK SHALL BE IN ACCORDANCE WITH THE T-1 HIGHWAY SPECIFICATIONS, EXCEPT AS NOTED.
 - GRASSING: ALL DISTURBED AREAS SHALL BE SEEDED WITH TYPE 6a MIXTURE (SPRING SEEDING), TYPE 7a MIXTURE (SUMMER SEEDING), OR TYPE 8 MIXTURE (FALL SEEDING). SEEDING AND FERTILIZING AND MULCHING SHALL BE IN ACCORDANCE WITH SECTION 180 AND 182, RESPECTIVELY, OF T-1 SPECS.
 - FLOOD PROTECT WALL CONSTRUCTION SELECTS TO USE AN AUTOMATIC CURBING MACHINE WITH CONTINUOUS CURB ELEMENT IN CONTACT WITH THE FLOOD PROTECT WALL. THE REINFORCEMENT STEEL AND REVER JOINTS MAY BE EXEMPTED.
 - EARTH BACKFILL: EARTH BACKFILL SHALL BE PLACED AND THOROUGHLY COMPACTED PER SECTION 120.
 - SURFACING: STABILIZED BASE SHALL BE PLACED IN ACCORDANCE WITH SECTION 225, ASPHALTIC CONCRETE SURFACE COURSE PER SECTION 345, AND BIT TACK COAT PER SECTION 302 OF THE T-1 SPECS.
 - UTILITY POLES: THOSE UTILITY POLES (S) THAT CONFLICT WITH THE CONSTRUCTION OF THE FLOOD PROTECTION WALL SHALL BE RELOCATED BY OTHERS.

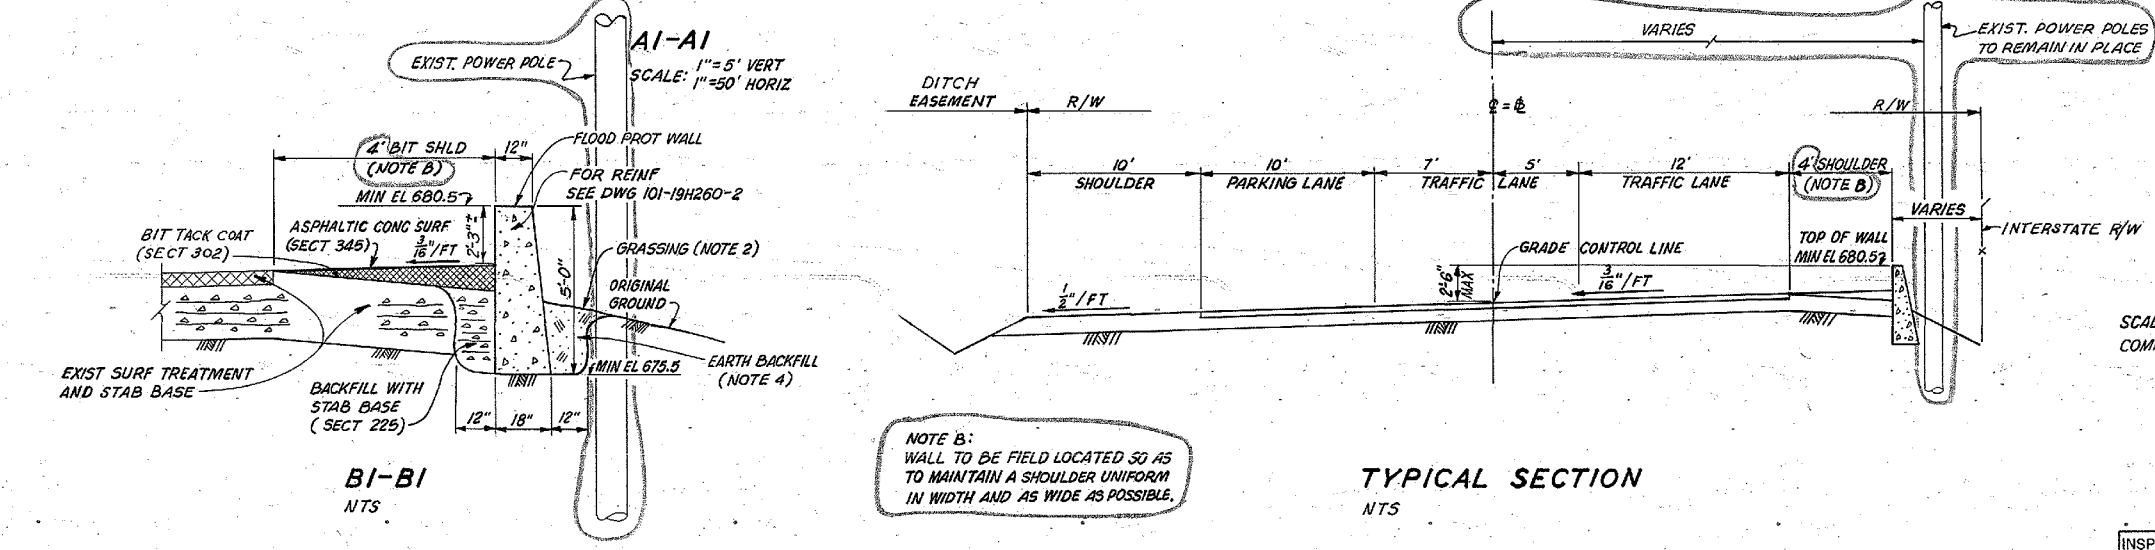

NOTE B:
WALL TO BE FIELD LOCATED SO AS
TO MAINTAIN A SHOULDER UNIFORM
IN WIDTH AND AS WIDE AS POSSIBLE.

TYPICAL SECTION
NTS

SCALE AS NOTED
COMPANION DWG: 101-19H260-2





REVISED WALL LOCATION	DATE	DESIGN	CHECK	SUPV	ENGR	INSP	RECM	APPD

NORTH TERRACE ROAD
FLOOD PROTECTION WALL


PLAN AND SECTIONS

SOUTH CHICKAMAUGA CREEK PROJECT
TENNESSEE VALLEY AUTHORITY
DIVISION OF ENGINEERING DESIGN

INSPECTED AND APPROVED FOR ISSUE: [Signature]
SUBMITTED: [Signature] RECOMMENDED: [Signature] APPROVED: [Signature]
KNOXVILLE 8-10-78 81 HR 101-19H260-1R1

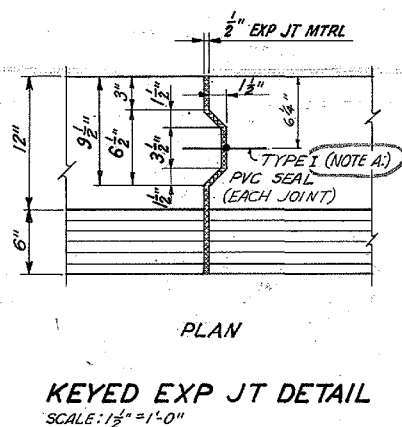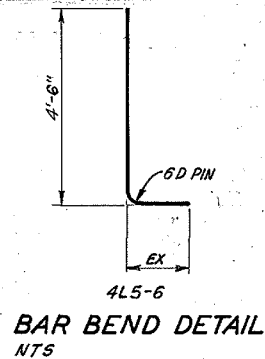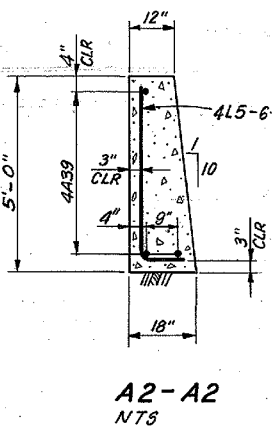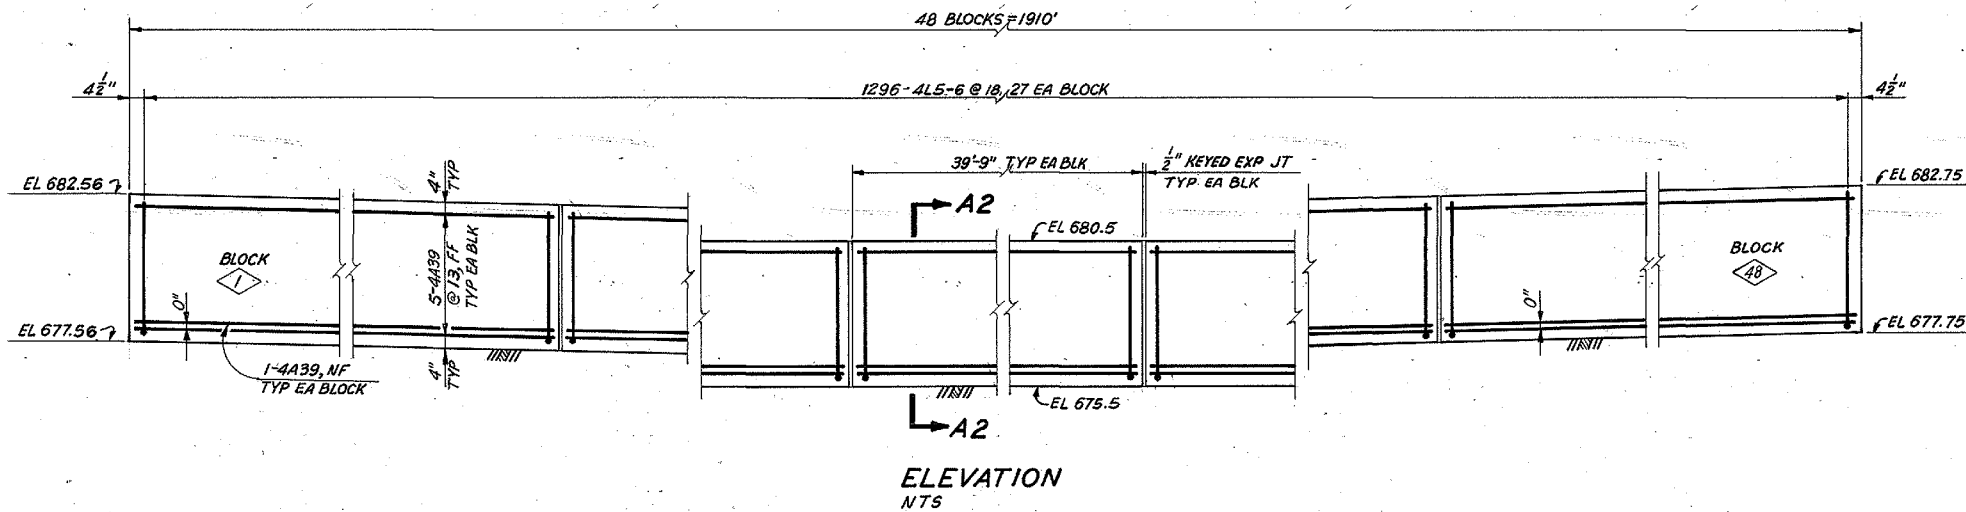

NOTE A:
PVC SEAL TYPE I SHALL CONFORM
TO TVA SPEC NO. PFI026.

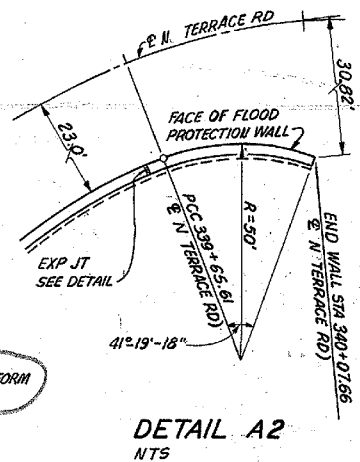

- NOTES:
- GENERAL NOTES: FOR GENERAL NOTES SEE DRAWING 101-19H260-1.
 - CONCRETE: CONCRETE SHALL BE PLACED IN ACCORDANCE WITH THE GENERAL CONSTRUCTION SPECS NO. G-2. CONCRETE SHALL BE CLASS 300.75 AFW. ALL EXPOSED CORNERS SHALL BE CHAMFERED 3/4 INCHES.
 - REINFORCEMENT: BARS SHALL CONFORM TO LATEST ASTM SPECS FOR HIGH STRENGTH BARS, DESIGNATION A615-60. ALL DIMENSIONS RELATIVE TO REINFORCED STEEL ARE TO CENTER OF BARS, EXCEPT WHERE OTHERWISE NOTED.
 - FORMWORK: ALL FORMWORK SHALL BE IN ACCORDANCE WITH THE GENERAL CONSTRUCTION SPECIFICATION NO. G-8. BOTH SIDES OF THE FLOOD PROTECTION WALL SHALL RECEIVE A SMOOTH FORM FINISH AS DEFINED IN SECT 1.4.

SCALE AS NOTED
COMPANION DWG 101-19H260-1

REVISED KEYED EXP. JT. DETAIL		DATE		DESIGN		CHECK		INSPECTION		APPROVAL	
DESIGN	TH Rogers, Jr.	INSPECTION	JR. Hays								
CHECK	EXM. W. W. W. W.	ENGINEER	EB								
SUPV	W. W. W. W.										
NORTH TERRACE ROAD FLOOD PROTECTION WALL											
OUTLINE, REINFORCEMENT AND MISCELLANEOUS DETAILS											
SOUTH CHICKAMAUGA CREEK PROJECT TENNESSEE VALLEY AUTHORITY DIVISION OF ENGINEERING DESIGN											
SUBMITTED			RECOMMENDED			APPROVED					
INSPECTED AND APPROVED FOR ISSUE											
KNOXVILLE 8-10-78 BI HR 101-19H260-2 R#1											

Quantity Cubic Yard Unless Noted	1976												1977												1978												1979																
	J			F			M			A			M			J			J			A			S			O			N			D																			
	J	F	M	J	A	S	O	N	D	J	F	M	J	A	S	O	N	D	J	F	M	J	A	S	O	N	D	J	F	M	J	A	S	O	N	D	J	F	M	J	A	S	O	N	D	J	F	M	J	A	S	O	N
1	Construction Plant																																																				
2	Clearing & Grubbing																																																				
3	Detention Basin - Clearing																																																				
4	- Excavation and Backfill																																																				
5	- Seeding																																																				
6	10 acres																																																				
7	620,000																																																				
8	794,000																																																				
9	Channel - Widening (Existing)																																																				
10	downstream																																																				
11	upstream																																																				
12	- Excavation																																																				
13	28,500																																																				
14	64,500																																																				
15	625,500																																																				
16	122,200																																																				
17	207,500																																																				
18	23,600																																																				
19	2,000																																																				
20	0																																																				
21	1,100																																																				
22	0																																																				
23	500,000																																																				
24	163,200																																																				
25	Levee Stripping																																																				
26	- Excavation - cut-off Trench																																																				
27	98,500																																																				
28	15,000																																																				
29	29,000																																																				
30	38,000																																																				
31	- Impervious Rolled Fill																																																				
32	562,000																																																				
33	164,500																																																				
34	245,300																																																				
35	276,500																																																				
36	- Mechanical Sluice Gates (3)																																																				
37	- Seeding																																																				
38	3,800																																																				
39	67,700																																																				
40	1,705																																																				
41	1,125																																																				
42	Pumping Stations																																																				
43	No. 1 - Excavation																																																				
44	- Concrete																																																				
45	- Mechanical - Sluice Gates																																																				
46	- Pumps & Piping																																																				
47	- Trash Racks																																																				
48	- Electrical - Embedded Material																																																				
49	- Other																																																				
50	- Architectural																																																				
51	No. 2 - Excavation																																																				
52	- Concrete																																																				
53	- Mechanical - Sluice Gates																																																				
54	- Pumps & Piping																																																				
55	- Trash Racks																																																				
56	- Electrical - Embedded Material																																																				
57	- Other																																																				
58	- Architectural																																																				
59	No. 3 - Excavation																																																				
60	- Concrete																																																				
61	- Mechanical - Sluice Gates																																																				
62	- Pumps & Piping																																																				
63	- Trash Racks																																																				
64	- Electrical - Embedded Material																																																				
65	- Other																																																				
66	- Architectural																																																				
67																																																					
68																																																					
69	Roads & Bridges																																																				
70	Utility Relocation (C.H. of Chattanooga)																																																				
71																																																					
72																																																					
Frank Van Meter
CONSTRUCTION SUPERINTENDENT











3	5-29-76	WAC	WAC	17A
Revised per G.B. memo dated 5/27/76				
2	1-15-76	WAC	17B	
Minor Revision				
1-22-76 WAC 17C				
Change Quantities Add 22835				
REV	DATE	MADE	BY	NO.
D	5-29-76	WAC	WAC	17A
D	1-15-76	WAC	WAC	17B
D	1-22-76	WAC	WAC	17C
DSENG, G.L. Helbert, SUPV.				
DRWN, M. Curtis, INSP.				
CHKD, _____				
TRCD, _____				
COMP, _____				
ENGINEER, <i>al.B. Reed</i>				

GENERAL		
CONSTRUCTION SCHEDULE SOUTH CHICKAMAUGA CREEK		
CHATTANOOGA FLOOD PROTECTION TENNESSEE VALLEY AUTHORITY DIVISION OF CONSTRUCTION		
SUBMITTED	RECOMMENDED	APPROVED
<i>J.O. Deaton</i>	<i>J.P. Bowles</i>	<i>Frank Van Meter</i>
KNOXVILLE	1-30-76	81 CS 3 102K1 R3
RECORD DRAWING AS CONSTRUCTED		

MC 23200

21
25

A
B
C
D
E
F
G
H
J
K

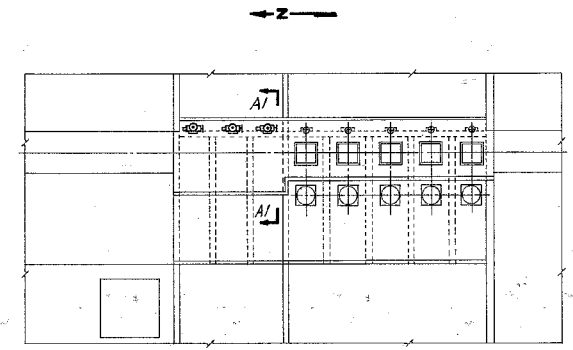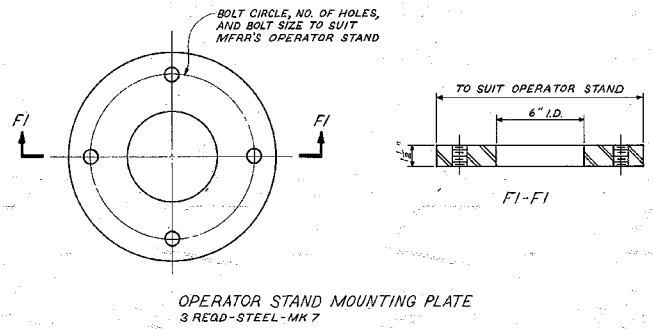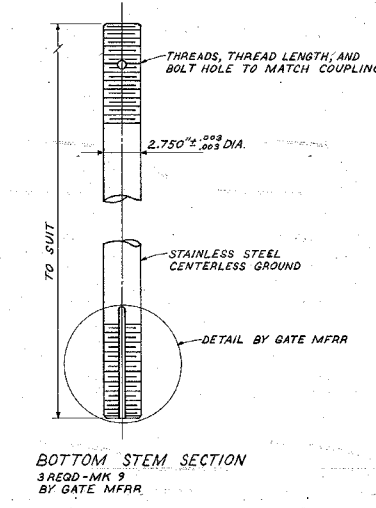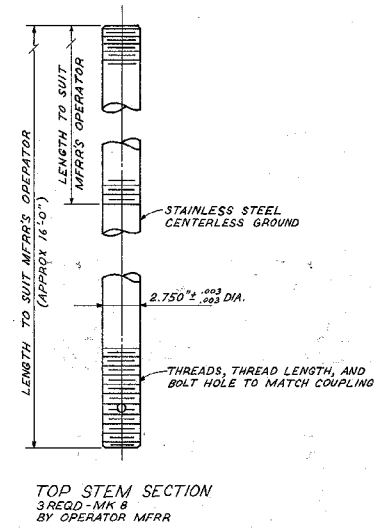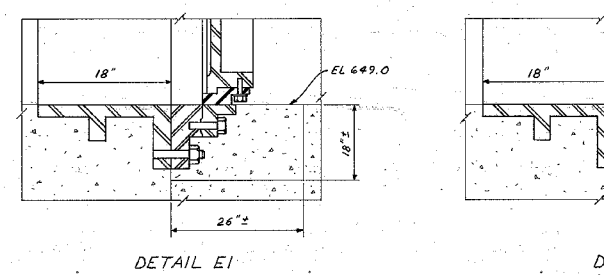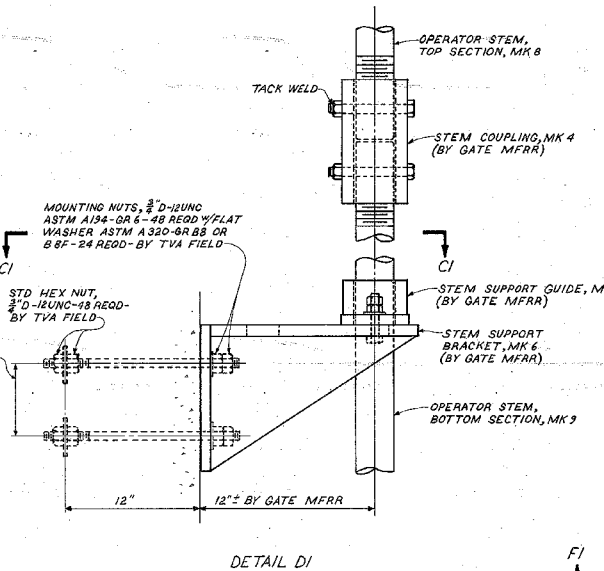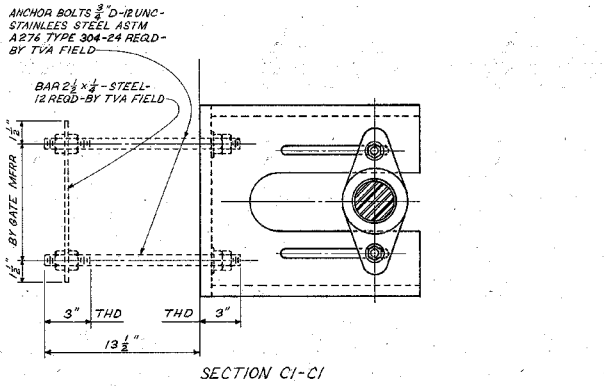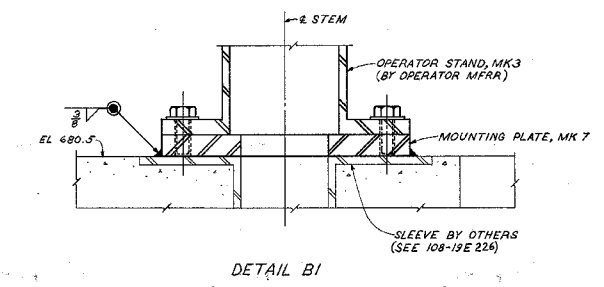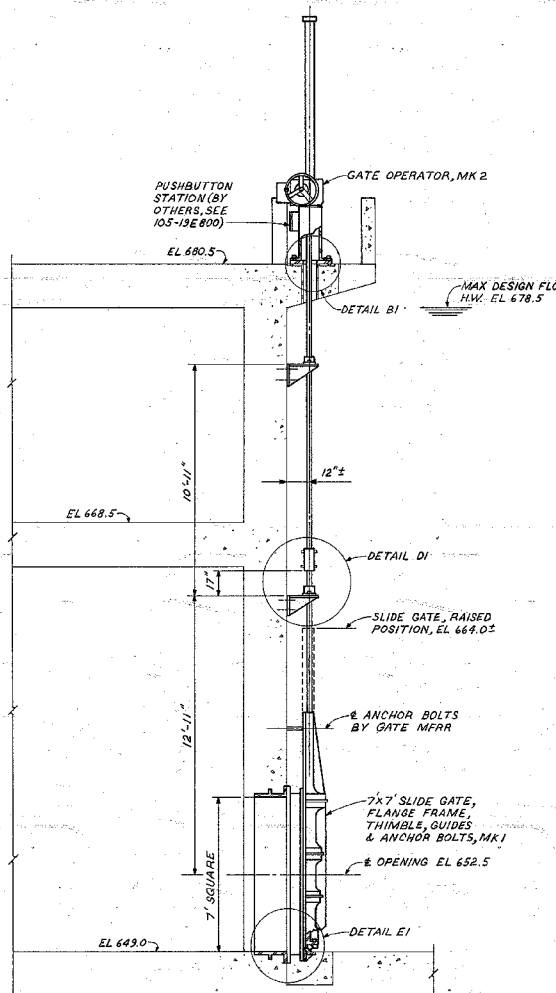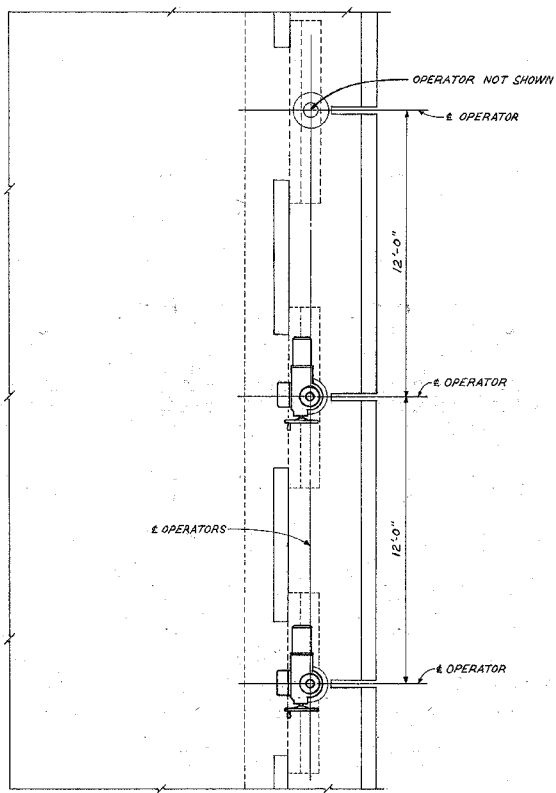

GENERAL NOTES:
 1. DIMENSIONS FOLLOWED BY ± MAY BE MODIFIED WITHIN THE SCOPE OF THE DESIGN AS REQUIRED TO SUIT THE DETAILS OF FURNISHED EQUIPMENT.
 2. UNLESS OTHERWISE SPECIFIED MACHINED TOLERANCES FOR FEET, INCHES, AND FRACTIONS 1/64" AND DECIMAL DIMENSIONS ±0.010".
 3. UNLESS OTHERWISE SPECIFIED MACHINED SURFACES 125 OR LESS MICRO-INCHES ARITHMETIC MEAN AVERAGE.
 4. SLIDE GATE TRAVEL IS 7'-0". STEM THREADS DESIGNED FOR A MINIMUM OF 3" OVERTRAVEL IN BOTH DIRECTIONS.
 5. INSIDE DIAMETER OF STEM SUPPORT GUIDE 1/16" LARGER THAN STEM DIAMETER.

PARTS:
 NUMBERS ON THIS DRAWING HAVE THE PREFIX 104-19E200-1
 MK 1 - SLIDE GATE ASSEMBLY - 3 RECD
 MK 2 - GATE OPERATOR - SELF-CONTAINED, WEATHERPROOF, ELECTRIC-MOTOR OPERATED WORM GEAR STEM SCREW LIFT WITH INTEGRAL ROTARY SEARDED LIMIT SWITCH, AUXILIARY HANDWHEEL, AND STEM COVER - 3 RECD
 MK 3 - OPERATOR FLOOR STAND WITH MOUNTING BOLTS - 3 RECD
 MK 4 - STEM COUPLING - THREADED AND BOLTED - 3 RECD
 MK 5 - STEM SUPPORT GUIDE - ONE-PIECE CAST IRON WITH BRONZE-SLEEVE BUSHING AND MOUNTING BOLTS WITH TWO HEX NUTS EACH - 3 RECD
 MK 6 - STEM SUPPORT BRACKET - CAST IRON, FULLY ADJUSTABLE, 4-BOLT WALL MOUNTED TYPE - 3 RECD
 MK 7 THROUGH MK 9 DETAILED ON THIS DRAWING.

FIELD NOTES:
 1. FIELD TO FURNISH ANCHOR BOLTS AND NUTS AS SHOWN IN DETAIL "D1" AND SECTION "C1-C1".
 2. FIELD TO INSTALL AND ALIGN SLIDE GATE, STEM, AND OPERATOR PER MANUFACTURER'S DRAWINGS AND INSTRUCTIONS.
 3. ALL SLIDE GATE FASTENERS TORQUED IN ACCORDANCE WITH GATE MANUFACTURER'S RECOMMENDATIONS.

SCALE 3/4"=1'-0"

INSPECTED AND APPROVED FOR ISSUE	DATE	DESIGN	CHKD	APPV	EXAM	TRF	FLW	REC	APPV
<i>[Signature]</i>	9-16-76	<i>[Signature]</i>	<i>[Signature]</i>	<i>[Signature]</i>					











PROJECT	3	6
SHEET	1	1
NO. ON PROJECT	104-19E200-1 R0	

CHATTANOOGA FLOOD PROTECTION PUMPING STATION I

7'x7' SLIDE GATE ARRANGEMENT & DETAILS

SOUTH CHICKAMAUGA CREEK PROJECT
 TENNESSEE VALLEY AUTHORITY
 DIVISION OF ENGINEERING DESIGN

RECORDED AS CONSTRUCTED

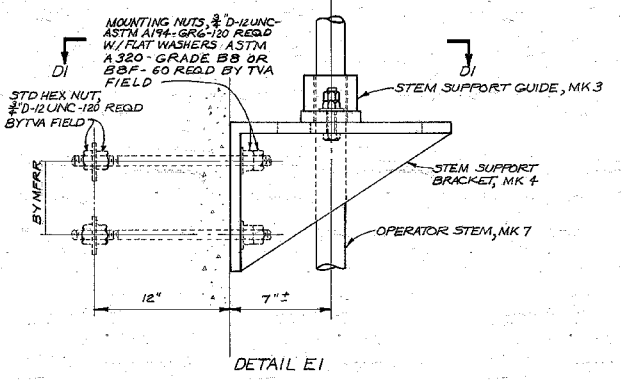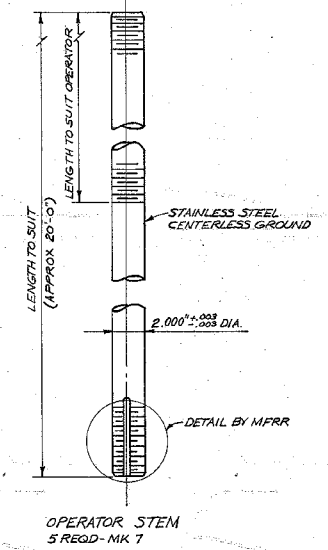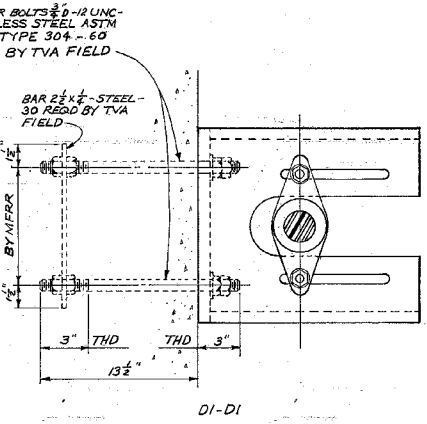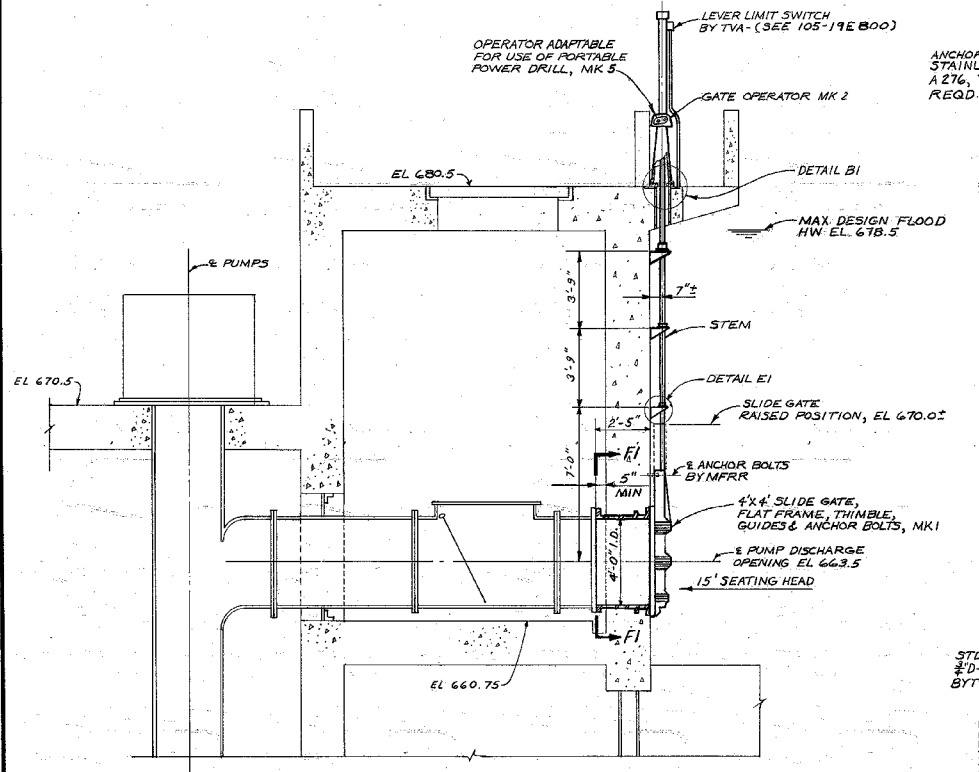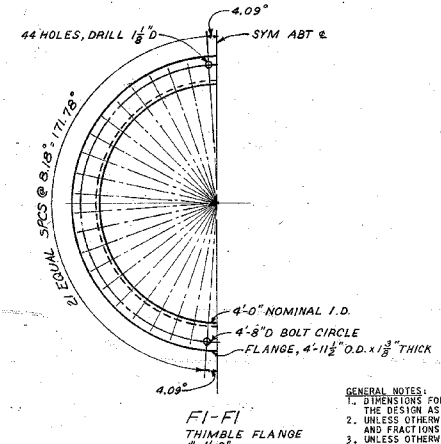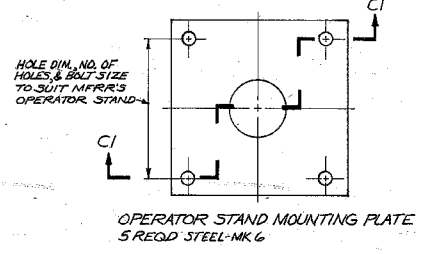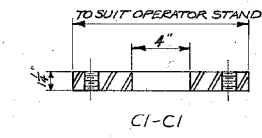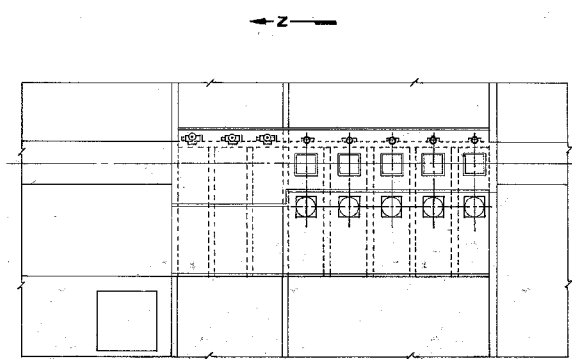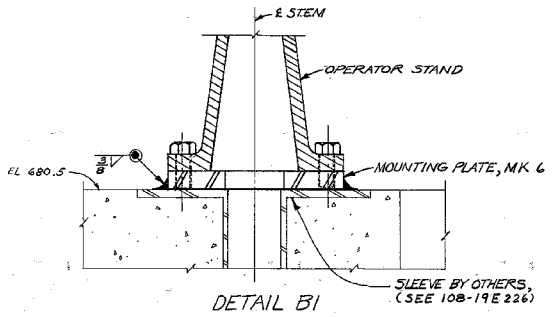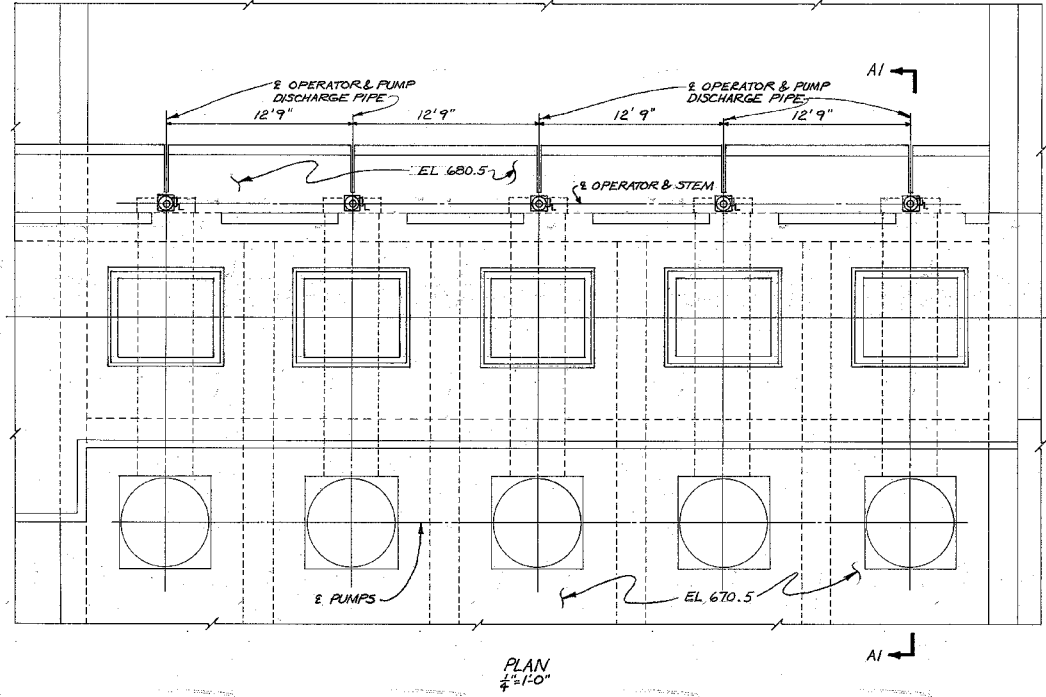

GENERAL NOTES:

1. DIMENSIONS FOLLOWED BY * MAY BE MODIFIED WITHIN THE SCOPE OF THE DESIGN AS REQUIRED TO SUIT THE DETAILS OF FURNISHED EQUIPMENT.
2. UNLESS OTHERWISE SPECIFIED MACHINED TOLERANCES FOR FEET, INCHES, AND FRACTIONS ± 1/64" AND DECIMAL DIMENSIONS ± 0.010".
3. UNLESS OTHERWISE SPECIFIED MACHINED SURFACES 125 OR LESS MICRO-INCHES ARITHMETIC MEAN AVERAGE.
4. SLIDE GATE TRAVEL IS 4'-6". STEM THREADS DESIGNED FOR A MINIMUM OF 3" OVERTRAVEL IN BOTH DIRECTIONS.
5. LIMIT SWITCH ON GATE OPERATOR SERVES AS AN INTERLOCK SO THAT THE PUMP CANNOT OPERATE UNLESS GATE IS FULLY OPEN.
6. A PORTABLE POWER DRILL WITH SLIP CLUTCH IS USED TO DRIVE THE OPERATORS.
7. INSIDE DIAMETER OF STEM SUPPORT GUIDE 1/16" LARGER THAN STEM DIAMETER.
8. THE WALL THIMBLE IS AN "M" TYPE WITH A STANDARD ANSI PIPE FLANGE AS SHOWN IN SECTION A1-A1 AND F1-F1.

DATES:

DATE: _____

REVISIONS:

NO.	DATE	DESCRIPTION

FIELD NOTES:

1. FIELD TO FURNISH ANCHOR BOLTS AND NUTS AS SHOWN IN DETAIL "E1" AND SECTION "DI-DI".
2. FIELD TO INSTALL AND ALIGN SLIDE GATE, STEM, AND OPERATOR PER MANUFACTURER'S DRAWINGS AND INSTRUCTIONS.
3. ALL SLIDE GATE FASTENERS TORQUED IN ACCORDANCE WITH GATE MANUFACTURER'S RECOMMENDATIONS.
4. FIELD TO INSTALL LEVER LIMIT SWITCH ON THE OPERATOR STEM COVER.


SCALE 3"=1'-0"

CHATTANOOGA FLOOD PROTECTION PUMPING STATION 1											
4'x4' SLIDE GATE ARRANGEMENT & DETAILS											
SOUTH CHICKAMAUGA CREEK PROJECT TENNESSEE VALLEY AUTHORITY DIVISION OF ENGINEERING DESIGN											
SUBMITTED				RECOMMENDED				APPROVED			
J.B. Doughty				J.B. Anderson, Jr.				S.L. Taylor			
KNOXVILLE 9-22-76 01 H 104-19E205-1 RC											
RECORD DRAWING AS CONSTRUCTED											


INSPECTED AND APPROVED FOR ISSUE	DATE	BY
<i>[Signature]</i>	9-22-76	01 H

PRINT	H	1	2	6
SIZE	#			


A
B
C
D
E
F
G
H
J
K

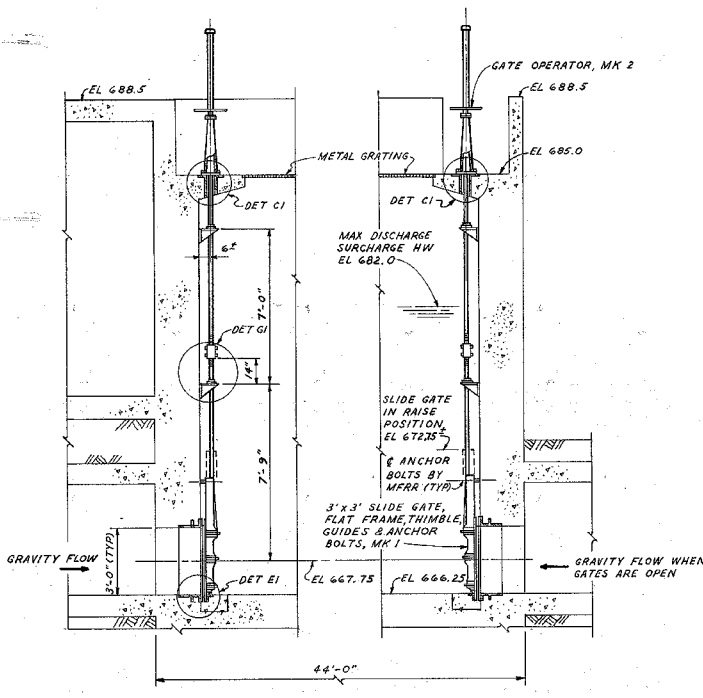


ELEVATION A1-A1
PUMPING STATION 2
DETS & DIMS TYP FOR
BOTH GATES
3/8" = 1'-0"

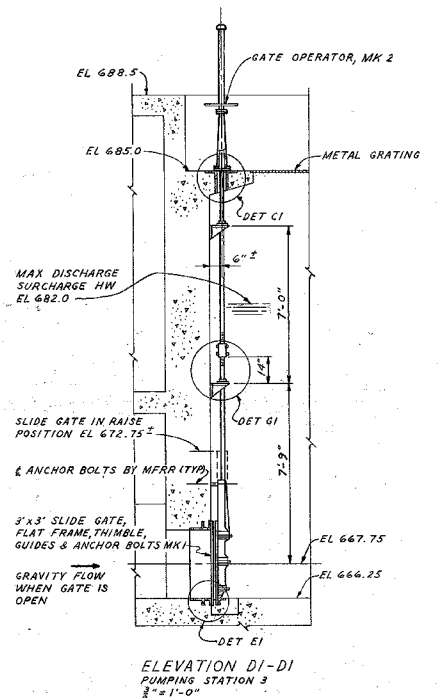


ELEVATION D1-D1
PUMPING STATION 3
3/8" = 1'-0"

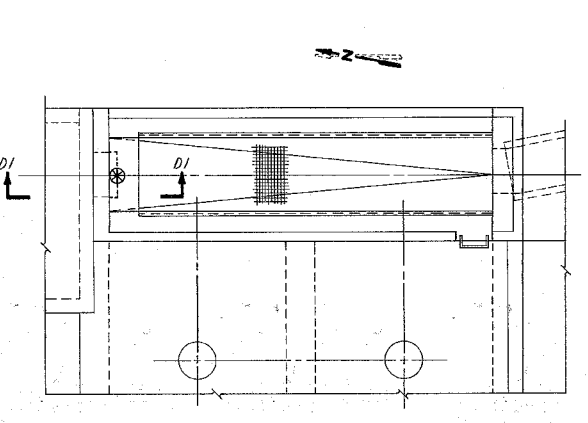


KEY PLAN
PUMPING STATION 3
3/8" = 1'-0"

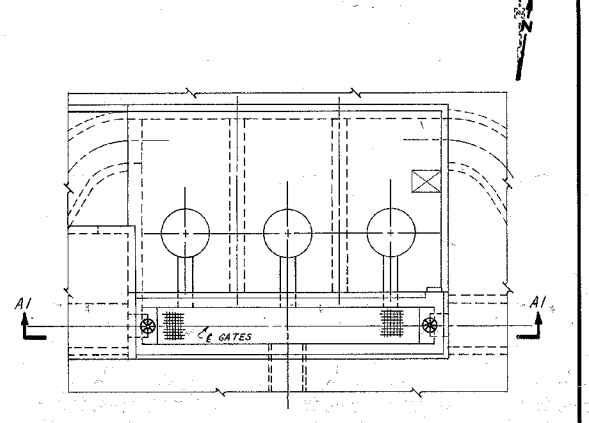


KEY PLAN
PUMPING STATION 2
3/8" = 1'-0"

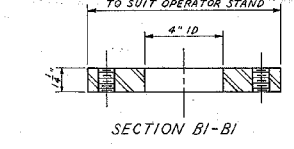


SECTION B1-B1

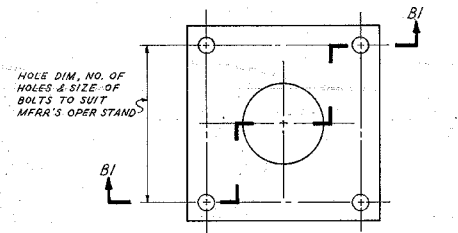


OPERATOR STAND MOUNTING R
3 REQ - MK 6
4" = 1'-0"

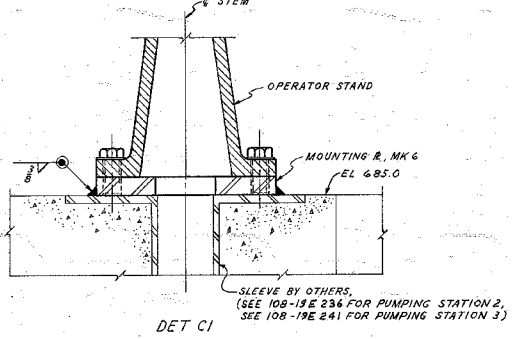


DET C1

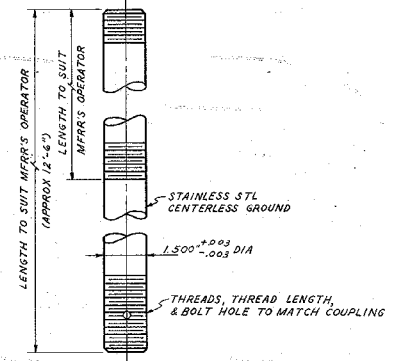


TOP STEM SECTION
3 REQ - MK 7
6" = 1'-0"

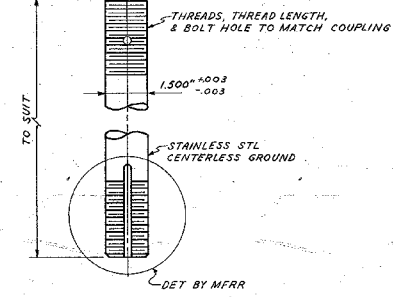


BOTTOM STEM SECTION
3 REQ - MK 8
6" = 1'-0"

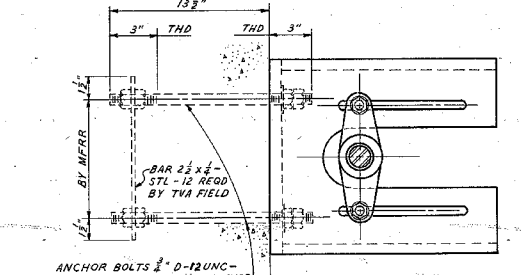


F1-F1

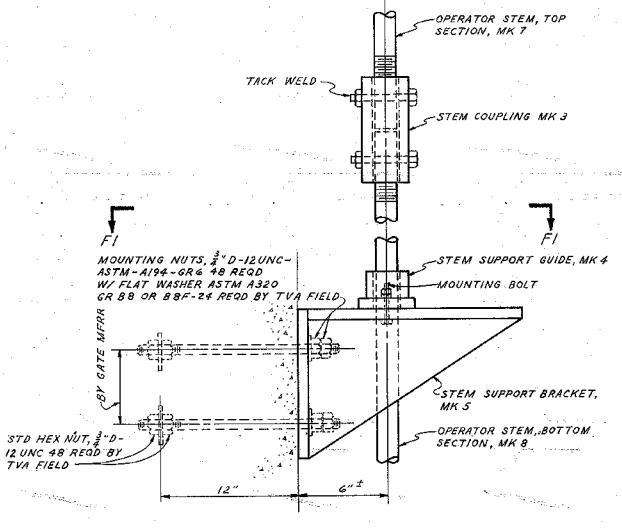

DET G1

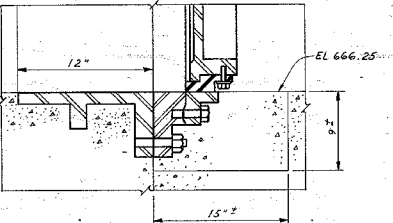

DET E1
ALTERNATE
NTS

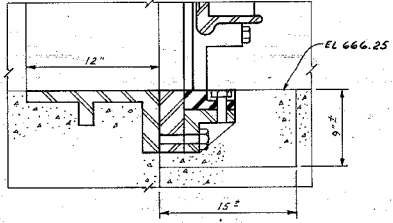

DET E1
ALTERNATE
NTS

- GENERAL NOTES:
- DIRECTIONS FOLLOWED BY 3 MAY BE MODIFIED WITHIN THE SCOPE OF THE DESIGN AS REQUIRED TO SUIT THE DETAILS OF FURNISHED EQUIPMENT.
 - UNLESS OTHERWISE SPECIFIED MACHINED TOLERANCES: FOR FEET, INCHES, AND FRACTIONS $\pm 1/64"$ AND DECIMAL DIMENSIONS $\pm 0.010"$.
 - UNLESS OTHERWISE SPECIFIED MACHINED SURFACES 125 OR LESS MICRO-INCHES ARITHMETIC MEAN AVERAGE.
 - SLIDE GATE TRAVEL IS $3'-0"$. STEM THREADS DESIGNED FOR A MINIMUM OF $3"$ OVERTRAVEL IN BOTH DIRECTIONS.
 - INSIDE DIAMETER OF STEM SUPPORT GUIDE $1/16"$ LARGER THAN STEM DIAMETER.

- PARTS:
- MARK NUMBERS ON THIS DRAWING HAVE THE PREFIX 104-19E225-1.
- MK 1 - SLIDE GATE ASSEMBLY - 3 REQ
 - MK 2 - GATE OPERATOR - PEDESTAL MOUNTED, HANDWHEEL TYPE WITH POSITION COUNTER INDICATOR, STOP NUT, STEM COVER, AND FLOOR STAND - 3 REQ
 - MK 3 - STEM COUPLING - THREADED AND BOLTED - 3 REQ
 - MK 4 - STEM SUPPORT GUIDE - ONE-PIECE CAST IRON WITH BRONZE-SLEEVE BUSHING AND MOUNTING BOLTS WITH TWO HEX NUTS EACH - 6 REQ
 - MK 5 - STEM SUPPORT BRACKET - CAST IRON, FULLY ADJUSTABLE, 4-BOLT WALL MOUNTED TYPE - 6 REQ
 - MK 6 THROUGH MK 8 DETAILED ON THIS DRAWING.

- FIELD NOTES:
- FIELD TO FURNISH ANCHOR BOLTS AND NUTS AS SHOWN IN DETAIL "G1" AND SECTION "F1-F1".
 - FIELD TO INSTALL AND ALIGN SLIDE GATE, STEM, AND OPERATOR PER MANUFACTURER'S DRAWINGS AND INSTRUCTIONS.
 - ALL SLIDE GATE FASTENERS TORQUED IN ACCORDANCE WITH GATE MANUFACTURER'S RECOMMENDATIONS.

REV	ECN NO.	DATE	DESIGNED	CHECKED	ENGR	INSP	SUBMIT	RECD	APPD
0508	J.M. SUAREZ	10/27							
0509	G.L. SUAREZ	6/29/24							
0510	J.L. SUAREZ	6/29/24							
0511	R.R. SUAREZ	6/29/24							

CHATTAHOOGA FLOOD PROTECTION
PUMPING STATION 2 & 3

3'X3' SLIDE GATE ARRANGEMENT
& DETAILS


SOUTH CHICKAMAUGA CREEK PROJECT
TENNESSEE VALLEY AUTHORITY
DIVISION OF ENGINEERING DESIGN

SUBMITTED: J.D. Dancy, Jr.
RECOMMENDED: J.B. Anderson, Jr.
APPROVED: S.J. Fisher


INSPECTED AND APPROVED FOR ISSUE: [Signature]
KNOXVILLE 9-22-76 81 H 104-19E225-1 RO

SCALE 3/4" = 1'-0"


PRINT: 1 2 6

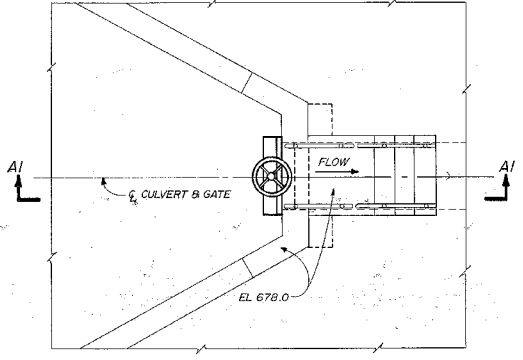


PLAN 3'x3' SLIDE GATE

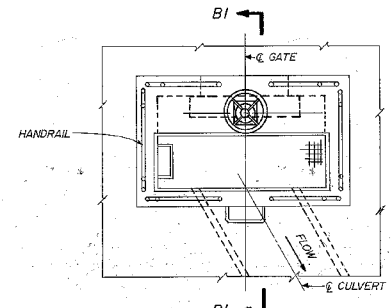


PLAN 4'x4' SLIDE GATE

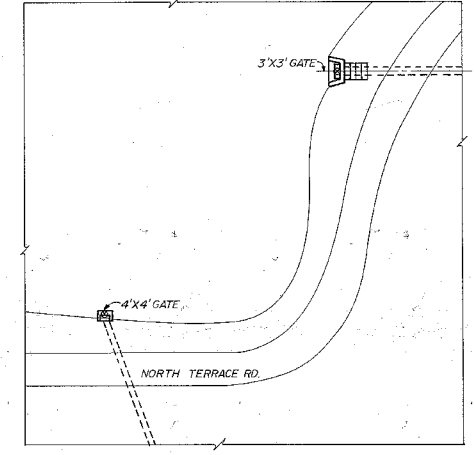


KEY PLAN FOR LOCATION SEE DWG 104-19E212-1 1" = 40'

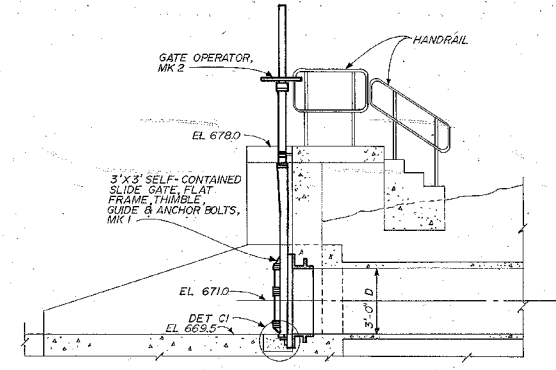


AI-AI

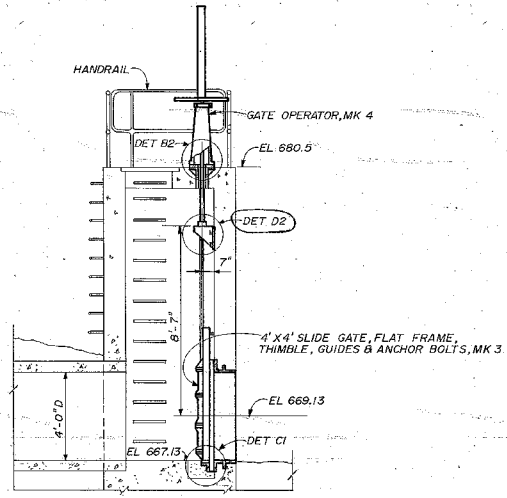

BI-BI

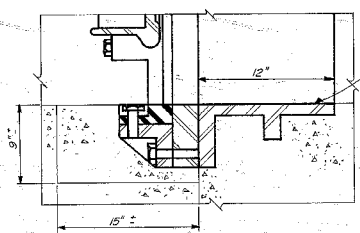

DET C1 NTS

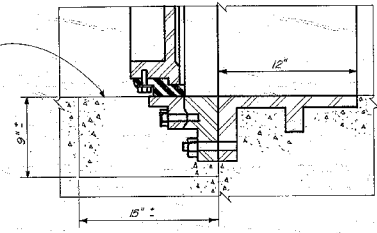

DET C1 ALTERNATE NTS

- GENERAL NOTES:
1. DIMENSIONS FOLLOWED BY ± MAY BE MODIFIED WITHIN THE SCOPE OF THE DESIGN AS REQUIRED TO SUIT THE DETAILS OF FURNISHED EQUIPMENT.
 2. UNLESS OTHERWISE SPECIFIED MACHINED TOLERANCES FOR FEET, INCHES, AND FRACTIONS ±1/64" AND DECIMAL DIMENSIONS ±0.010".
 3. UNLESS OTHERWISE SPECIFIED MACHINED SURFACES 125 OR LESS MICRO-INCHES ARITHMETIC MEAN AVERAGE.
 4. SLIDE GATE TRAVEL IS 3'-0" FOR MK 1 AND 6'-0" FOR MK 2; STEM THREADS DEFINED FOR A MINIMUM OF 3" OVERTRAVEL IN BOTH DIRECTIONS.
 5. INSIDE DIAMETER OF STEM SUPPORT GUIDE 1/16" LARGER THAN STEM DIAMETER.

- PARTS:
- MARK NUMBERS ON THIS DRAWING HAVE THE PREFIX 104-19E265.
- MK 1 - SELF-CONTAINED SLIDE GATE ASSEMBLY - 1 REQD
 - MK 2 - GATE OPERATOR, YOKE MOUNTED, HANDWHEEL TYPE WITH POSITION COUNTER INDICATOR, STOP NUT, AND STEM COVER - 1 REQD
 - MK 3 - SLIDE GATE ASSEMBLY - 1 REQD
 - MK 4 - GATE OPERATOR, POSTAL MOUNTED, HANDWHEEL TYPE WITH POSITION COUNTER INDICATOR, STOP NUT, STEM COVER, AND FLOOR STAND - 1 REQD
 - MK 5 - STEM SUPPORT GUIDE, ONE-PIECE CAST IRON WITH BRONZE-SLEEVE BUSHING AND MOUNTING BOLTS WITH TWO NUTS EACH - 1 REQD
 - MK 6 - STEM SUPPORT BRACKET, CAST IRON, FULLY ADJUSTABLE, 4 BOLT WALL MOUNTED TYPE - 1 REQD
 - MK 7 THROUGH MK 9 DETAILED ON SHEET 2 OF THIS DRAWING

- FIELD NOTES:
1. FIELD TO FURNISH ANCHOR BOLTS AND NUTS AS SHOWN IN DETAIL "C2" AND SECTION "D2-D2."
 2. FIELD TO INSTALL AND ALIGN SLIDE GATE, STEM, AND OPERATOR PER MANUFACTURER'S DRAWINGS AND INSTRUCTIONS.
 3. ALL SLIDE GATE FASTENERS TORQUED IN ACCORDANCE WITH GATE MANUFACTURER'S RECOMMENDATIONS.


REVISED & REDRAWN		DATE: 5-31-79	
DESIGNER: TM SUAREZ	INSPECTOR: [Signature]	DATE: 8-22-78	SCALE: 3/8" = 1'-0" EXCEPT AS NOTED
CHATTAHOOGA FLOOD PROTECTION LEVEE INSTALLATIONS			
3'x3' AND 4'x4' SLIDE GATE ARRANGEMENT & DETAILS			
SOUTH CHICKAMAUGA CREEK PROJECT TENNESSEE VALLEY AUTHORITY DIVISION OF ENGINEERING DESIGN			
SUBMITTED: [Signature]	RECOMMENDED: [Signature]	APPROVED: [Signature]	
KNOXVILLE 9-22-78		104-19E265-1 RI	

COMPANION DRAWING: 104-19E265-2

INSPECTED AND APPROVED FOR ISSUE [Signature]

PRINT	1	5
SIZE	11	0


TECHNICAL REPRESENTATIVE'S ROOMS

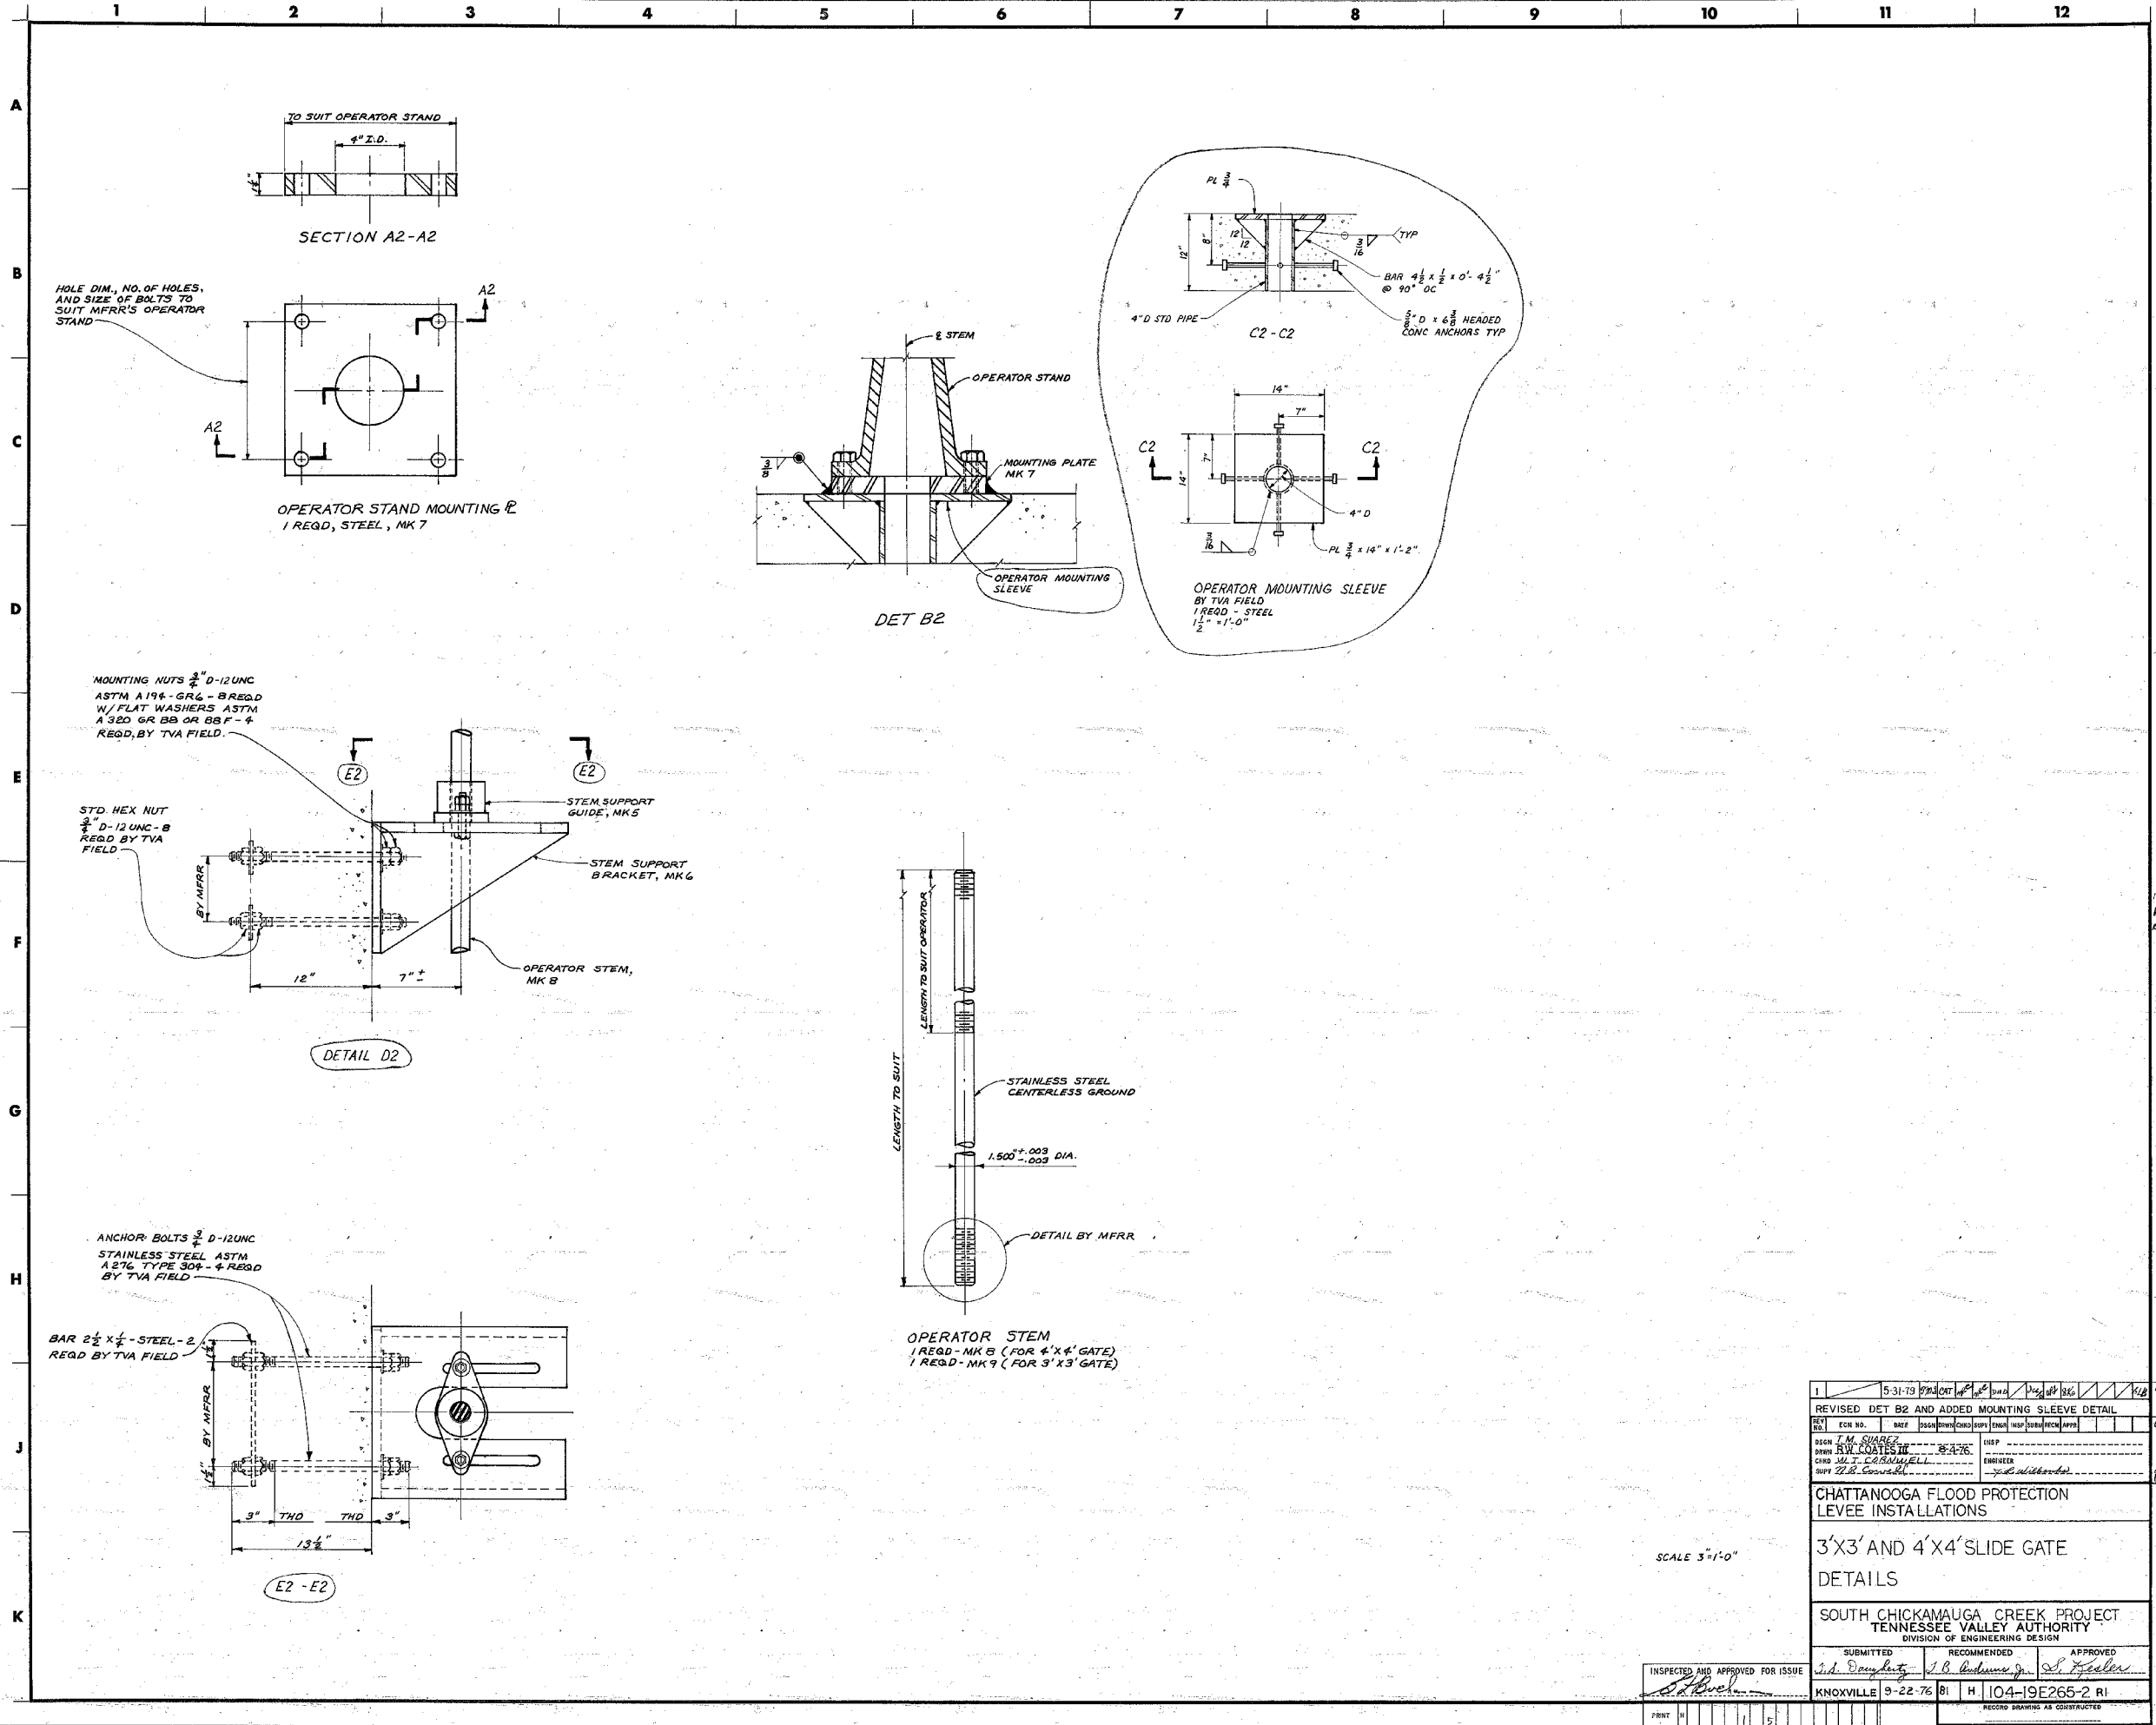

SCALE 3/4"=1'-0"





1	5-31-73	REVISED DET B2 AND ADDED MOUNTING SLEEVE DETAIL																		
REV	ECN NO.	DATE	ISSUED BY	DESIGNED BY	CHECKED BY	APPROVED BY	DATE	SCALE	PROJECT	LOCATION	NO.	REV.	BY	DATE	REASON					
DESIGN	J.M. SUAREZ								CHATTANOOGA FLOOD PROTECTION											
DRAWN	R.V. COATES, JR.	9-22-76							LEVEE INSTALLATIONS											
CHECKED	M.T. CORNWELL								3'X3' AND 4'X4' SLIDE GATE											
ENGINEER									DETAILS											
SOUTH CHICKAMAUGA CREEK PROJECT											TENNESSEE VALLEY AUTHORITY									
DIVISION OF ENGINEERING DESIGN											RECORD DRAWING AS CONSTRUCTED									
SUBMITTED			RECOMMENDED			APPROVED			J.D. Daugherty			J.B. Anderson, Jr.			S. Feiler					
KNOXVILLE 9-22-76											H 104-19E265-2 RI									

INSPECTED AND APPROVED FOR ISSUE	
PRINT	1 5
SIZE	0
NO. OR PROJ. OR ALL. OR AD. OR ED. OR BY. OR PL.	
PRINTS. REQD.	

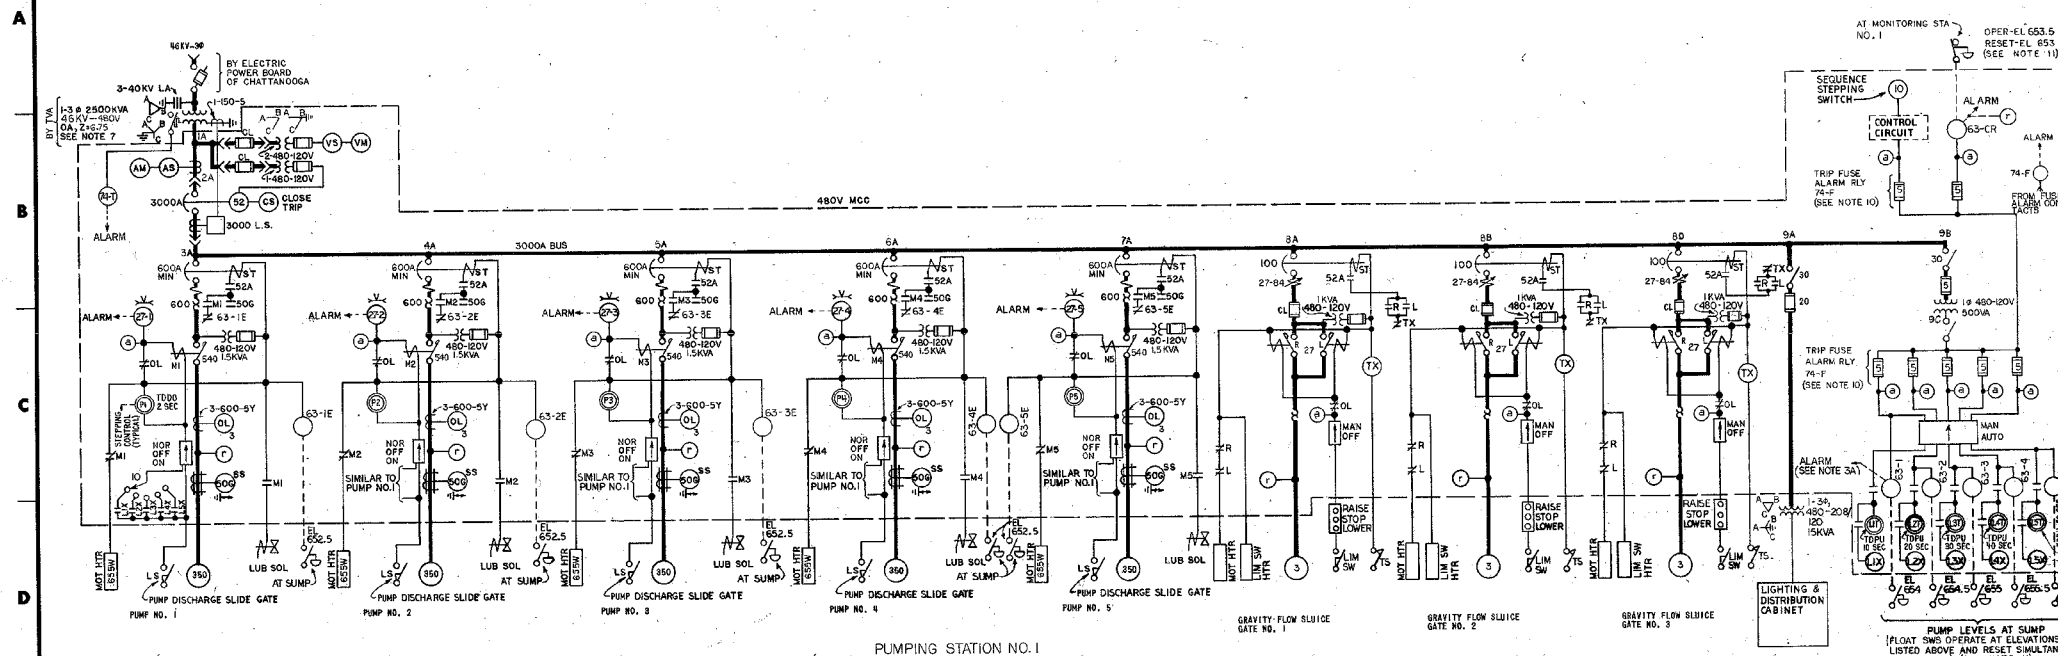

NOTES:

- WHEN THE COMMON PUMP CONTROL SWITCH IS IN AUTO POSITION AT ANY STATION PUMPS AT THAT PUMPING STATION WILL BE STARTED WITH RISING WATER LEVEL AS MEASURED BY LEVEL SENSORS LOCATED IN THE SHUPS AT EACH STATION - ONE SENSOR FOR EACH PUMP. AT STATION NO. 1, THESE SENSORS ARE SET TO OPERATE AT EL 654 THROUGH EL 656 AT 0.6' INCREMENTS. AT STATION NO. 2, THE SENSORS ARE SET TO OPERATE AT EL 662, 663.5, AND 670. AT PUMPING STATION NO. 3, THE SENSORS ARE SET TO OPERATE AT EL 662 AND EL 663.5. ALL PUMPS IN OPERATION AT STATIONS 1, 2, AND 3 WILL SHUT OFF SIMULTANEOUSLY AT EL 653.5, EL 660, AND EL 666 RESPECTIVELY WITH FALLING WATER LEVEL. A STEERING SCHEME EXERCISED AFTER EACH PUMPING CYCLE AT THE THREE STATIONS WILL ALTERNATE THE PUMPS SUCH THAT THE SENSORS OPERATING AT THE LOWEST LEVELS WILL OPERATE THE PUMPS USED THE LOWEST ON THE PREVIOUS PUMPING CYCLE. SUFFICIENT TIME DELAY OF 10 SEC BETWEEN STARTING ANY TWO PUMPS WILL PREVENT SIMULTANEOUS STARTING. AT STATION NO. 1, THE PUMPS ARE ELECTRICALLY INTERLOCKED TO PREVENT OPERATION IF THEIR INDIVIDUAL PUMP DISCHARGE SLIDE GATES ARE NOT FULLY OPEN. IF ANY PUMPS AT STATIONS 1, 2, & 3 ARE STILL OPERATING AT EL 652.5, 667 AND 667 RESPECTIVELY, A BACKUP LEVEL SWITCH WILL TRIP THE INDIVIDUAL PUMP BREAKER.
- WHEN MONITORING STATIONS NO.1 OR NO.2 SENSE CREEK LEVEL ABOVE EL.653.5 OR EL.667.5 RESPECTIVELY, THE APPROPRIATE GRAVITY FLOW SLUICE GATES ARE TO BE CLOSED AND THE AFFECTED PUMPING STATIONS PLACED IN AUTOMATIC CONTROL THROUGH THE COMMON CONTROL SWITCH LOCATED AT EACH STATION.
- REMOTE ALARMS ARE GROUPED AS FOLLOWS:
 - CREEK LEVEL ABOVE EL.653.5 BY SENSORS AT MONITORING STATION NO.1 OR SLUICE LEVEL AT PUMPING STATION NO.1 ABOVE EL.654 WITH THE COMMON PUMP CONTROL SWITCH IN MANUAL POSITION.
 - CREEK LEVEL ABOVE EL.667.5 BY SENSORS AT MONITORING STATION NO.2 OR SLUICE LEVEL AT PUMPING STATION NO.2 ABOVE EL.668 WITH THE COMMON PUMP CONTROL SWITCH IN MANUAL POSITION.
 - ABNORMAL CONDITION AT ANY OF THE THREE PUMPING STATIONS AS DETECTED BY DEVICE 27 (THERMAL OVERLOAD TROUBLE CONTROL TRANSFORMER FUSE BLOWN, OPEN BREAKER OR LOSS OF VOLTAGE FOR ALL PUMPS) OR BLOWN FUSE IN THE PUMP SEQUENCING CONTROL CIRCUITS ADDITIONALLY STATION 1 ADDITIONAL INCLUDES THE MAIN TRANSFORMER ALARMS FOR HIGH TEMP LOW LIQUID LEVEL AND PRESSURE RELIEF VALVE OPERATION.
- DISCONNECT SWITCHES ON THE AUXILIARY BOARD ARE HEAVY DUTY TYPE RATED 600V AND CAPABLE OF INTERRUPTING NOT LESS THAN 18 TIMES THEIR RATED CURRENT.
- ALL 480V FUSES TO BE TIME DELAY CLASS J.
- ALL BREAKERS ARE 3-POLE RATED 600V INTERRUPTING RATING:
 - AT STATION #1
DRAWOUT - 50,000 RMS SYM AT 480V
MOLDED CASE & MOLDED CASE/CL FUSE COMBINATION - 50,000 RMS SYM AT 480V
 - AT STATIONS #2 & 3
DRAWOUT - 38,000 RMS SYM AT 480V
MOLDED CASE - 14,000 RMS SYM AT 480V
- THE TRANSFORMER IS TO BE PROVIDED WITH A NO-LOAD TAP CHANGER PER ANSI STANDARD C57.12.0. THE TRANSFORMER RATINGS MUST NOT BE INCREASED BY THE ADDITION OF FORCED COOLING.
- BRANCH CIRCUIT GROUND RELAYS ARE SET TO TRIP AT 5 AMP PRIMARY GROUND CURRENT.
- VENDOR TO ESTABLISH FRONT VIEW AND COMPARTMENT ASSIGNMENTS BASED ON PHYSICAL REQUIREMENTS. THE PANELS DO NOT HAVE TO BE FLUSH MOUNTED.
- FUSES ARE RATED AT 5 AMPERES AND ARE SIGNAL ACTUATING TYPE, RATED AT 125 VAC BUSS TYPE FNA, OR EQUAL. THESE FUSES ARE USED IN CONJUNCTION WITH SIGNAL FUSE BLOCK, 4 POLE BUSS TYPE 3839 OR EQUAL.
- FLOAT SWITCHES SHOWN ARE SYMBOLIC OF THE FUNCTION BEING PERFORMED AND DO NOT NECESSARILY REPRESENT EQUIPMENT INSTALLED.

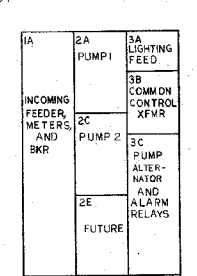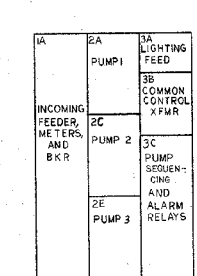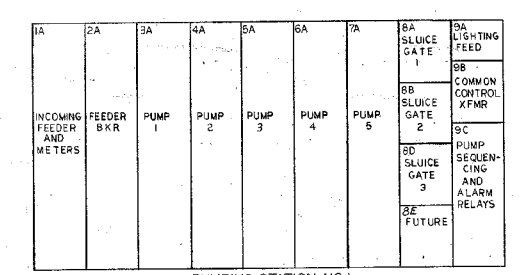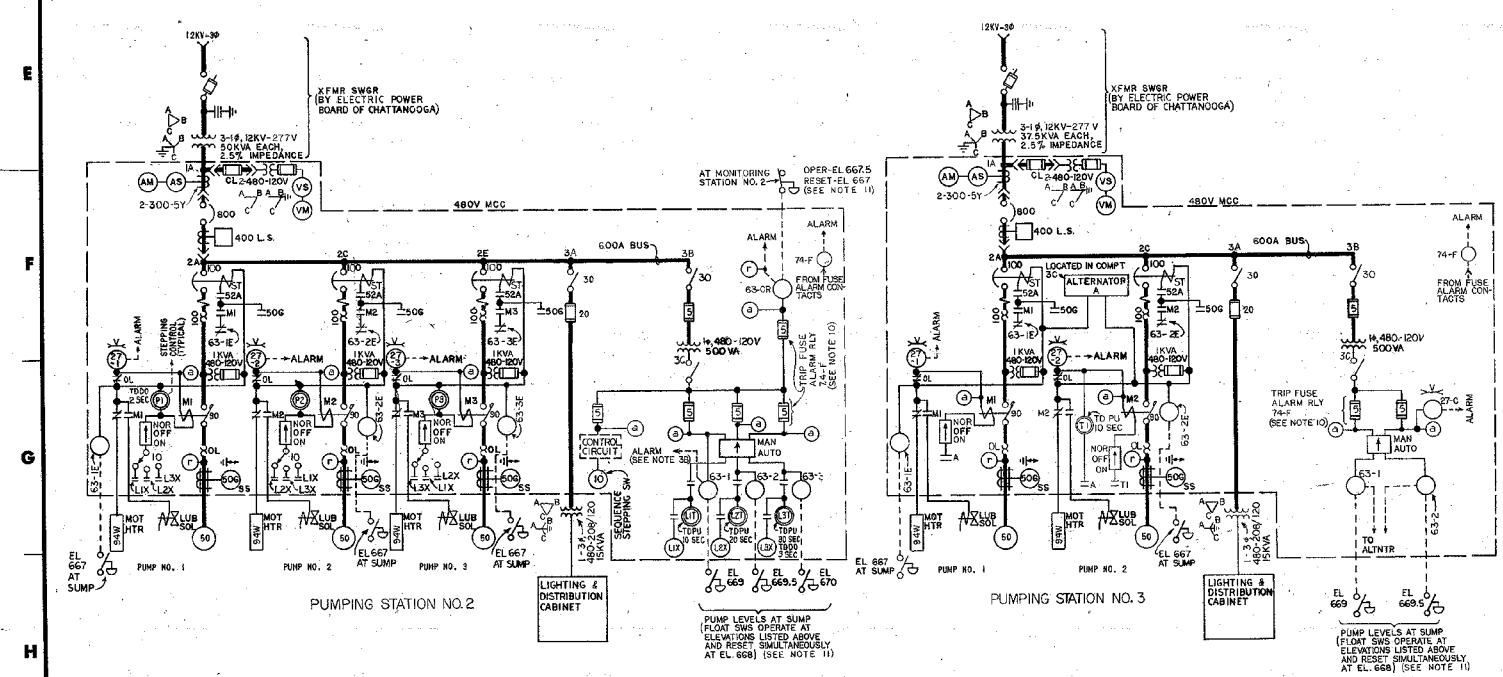

MINOR REVISION	
1	RELOCATED MONITORING STATION NO. 2, ADDED BACKUP ALARMS TO BOTH MONITORING STATIONS MANUFACTURERS AND MINOR CHANGES.
2	CHANGED TO C-SIZE DRAWING.
CHATTANOOGA FLOOD PROTECTION PUMPING STATION NOS. 1, 2, 3 WIRING DIAGRAMS AC AUXILIARY POWER SINGLE LINE SOUTH CHICKAMAUGA CREEK PROJECT TENNESSEE VALLEY AUTHORITY DIVISION OF ENGINEERING DESIGN	
SUBMITTED Robert E. Hunt ENGINEER	RECOMMENDED T. H. Henderson SUPERVISOR
INSPECTED AND APPROVED FOR ISSUE [Signature]	APPROVED John C. Holladay PROJECT MANAGER
KNOXVILLE 8-18-76 81 E 105-19E500 R2 RECORD DRAWING AS CONSTRUCTED Frank Van Meter 2/28/82 R2	



REFERENCE DWGS:

- 105-19E51-1 PUMPING STA #1 SCHEMATIC
- 105-19E51-2 PUMPING STA #2 SCHEMATIC
- 105-19E51-3 PUMPING STA #3 SCHEMATIC

PRINT	3	2-3
SIZE	P	

A
B
C
D
E
F
G
H
J
K

NOTES:
1. FOR GENERAL NOTES SEE DWG 105-19E511-1
2. FOR FURTHER DETAILS AND AS PURCHASED STATUS, SEE CONTROL POWER SYSTEMS INC. DRAWING R-41600, TVA CONTRACT 77K3-821901.

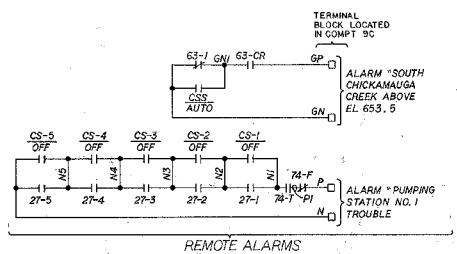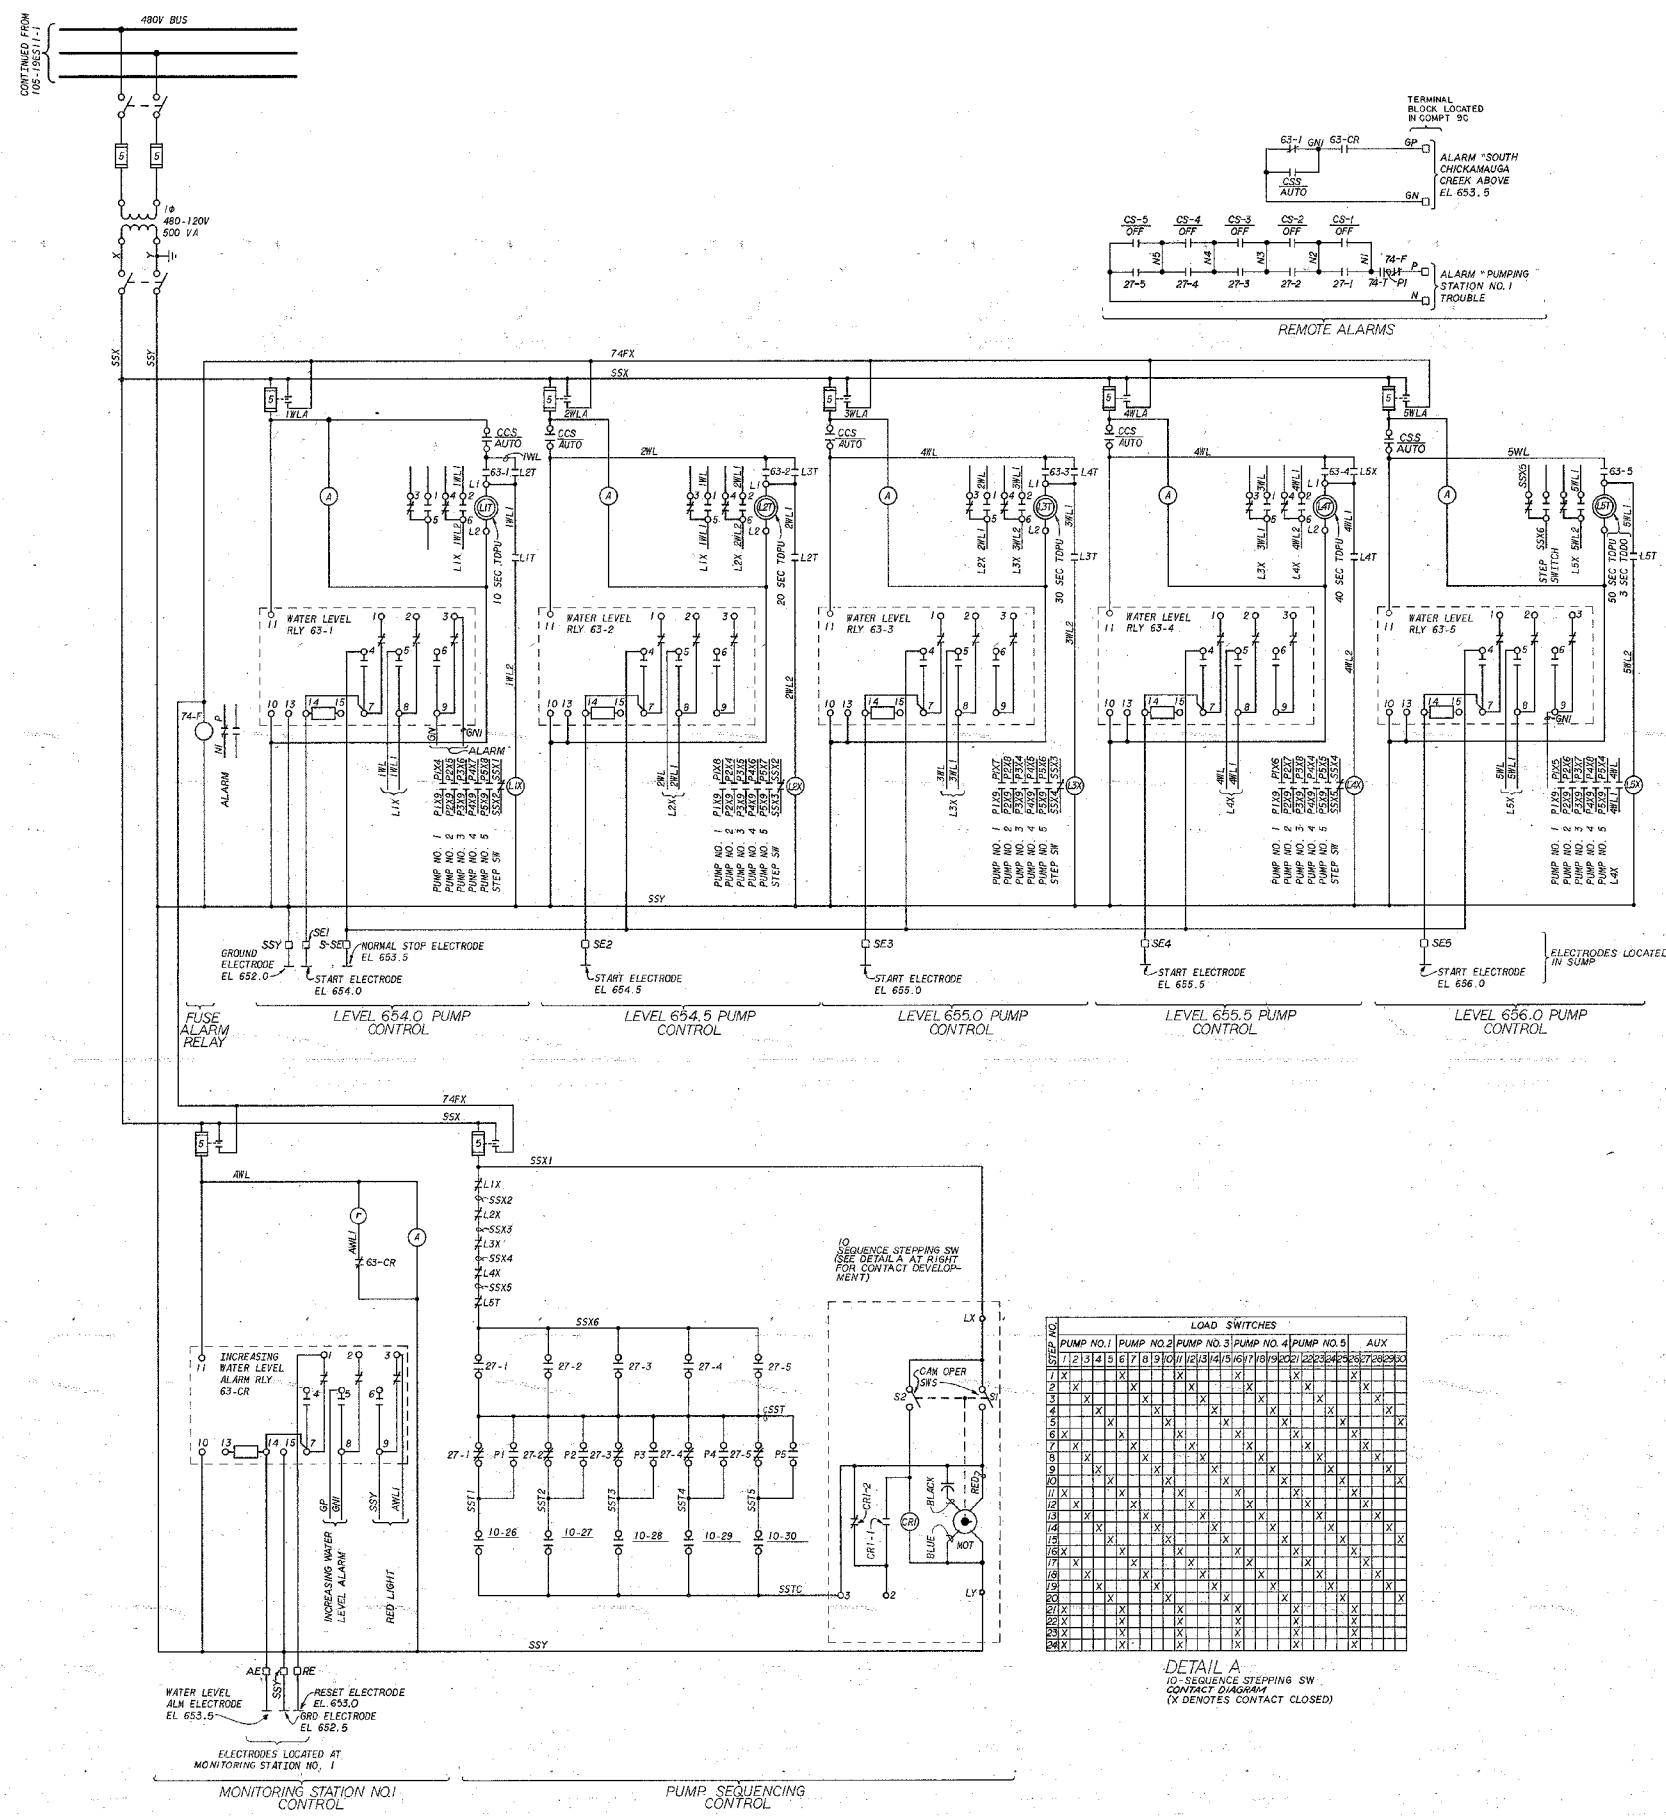

LOAD SWITCHES

STEP	PUMP NO. 1	PUMP NO. 2	PUMP NO. 3	PUMP NO. 4	PUMP NO. 5	AUX
1	X					
2	X	X	X	X	X	X
3	X	X	X	X	X	X
DETAIL A
10-SEQUENCE STEPPING SW
CONTACT DIAGRAM
(X DENOTES CONTACT CLOSED)

REFERENCE DWGS:
105-19E500 --- SINGLE LINE
COMPANION DWGS:
105-19E511-1 --- PUMPING STA. NO. 1
SCHEMATIC SH. 1

1	7-10-79	REVISED	105-19E511-2	105-19E511-2
MINOR CHANGES				
REV. NO.	ECN NO.	DATE	DESIGN/CHKD/APP'D	BY/APP'D
0001	D. E. TABLER			
0002	D. E. TABLER			
0003	D. E. TABLER			
0004	D. E. TABLER			
0005	D. E. TABLER			
CHATTANOOGA FLOOD PROTECTION PUMPING STATION NO. 1				
WIRING DIAGRAMS A-C AUXILIARY POWER SCHEMATIC DIAGRAMS				
SOUTH CHICKAMAUGA CREEK PROJECT TENNESSEE VALLEY AUTHORITY DIVISION OF ENGINEERING DESIGN				
SUBMITTED	RECOMMENDED	APPROVED		
Robert F. Hunt	John E. Haddock	John E. Haddock		
INSPECTED AND APPROVED FOR ISSUE	KNOXVILLE 1/31/77 81 E 105-19E511-2 R1			
G. L. Buchanan				
PRINT	H	S		
SIZE	F			
BR OR PROJ ME EE CE AS CD ED ND OF SW BL PA PRINTS, REORD-8				

105-19E511-2

A
B
C
D
E
F
G
H
J
K

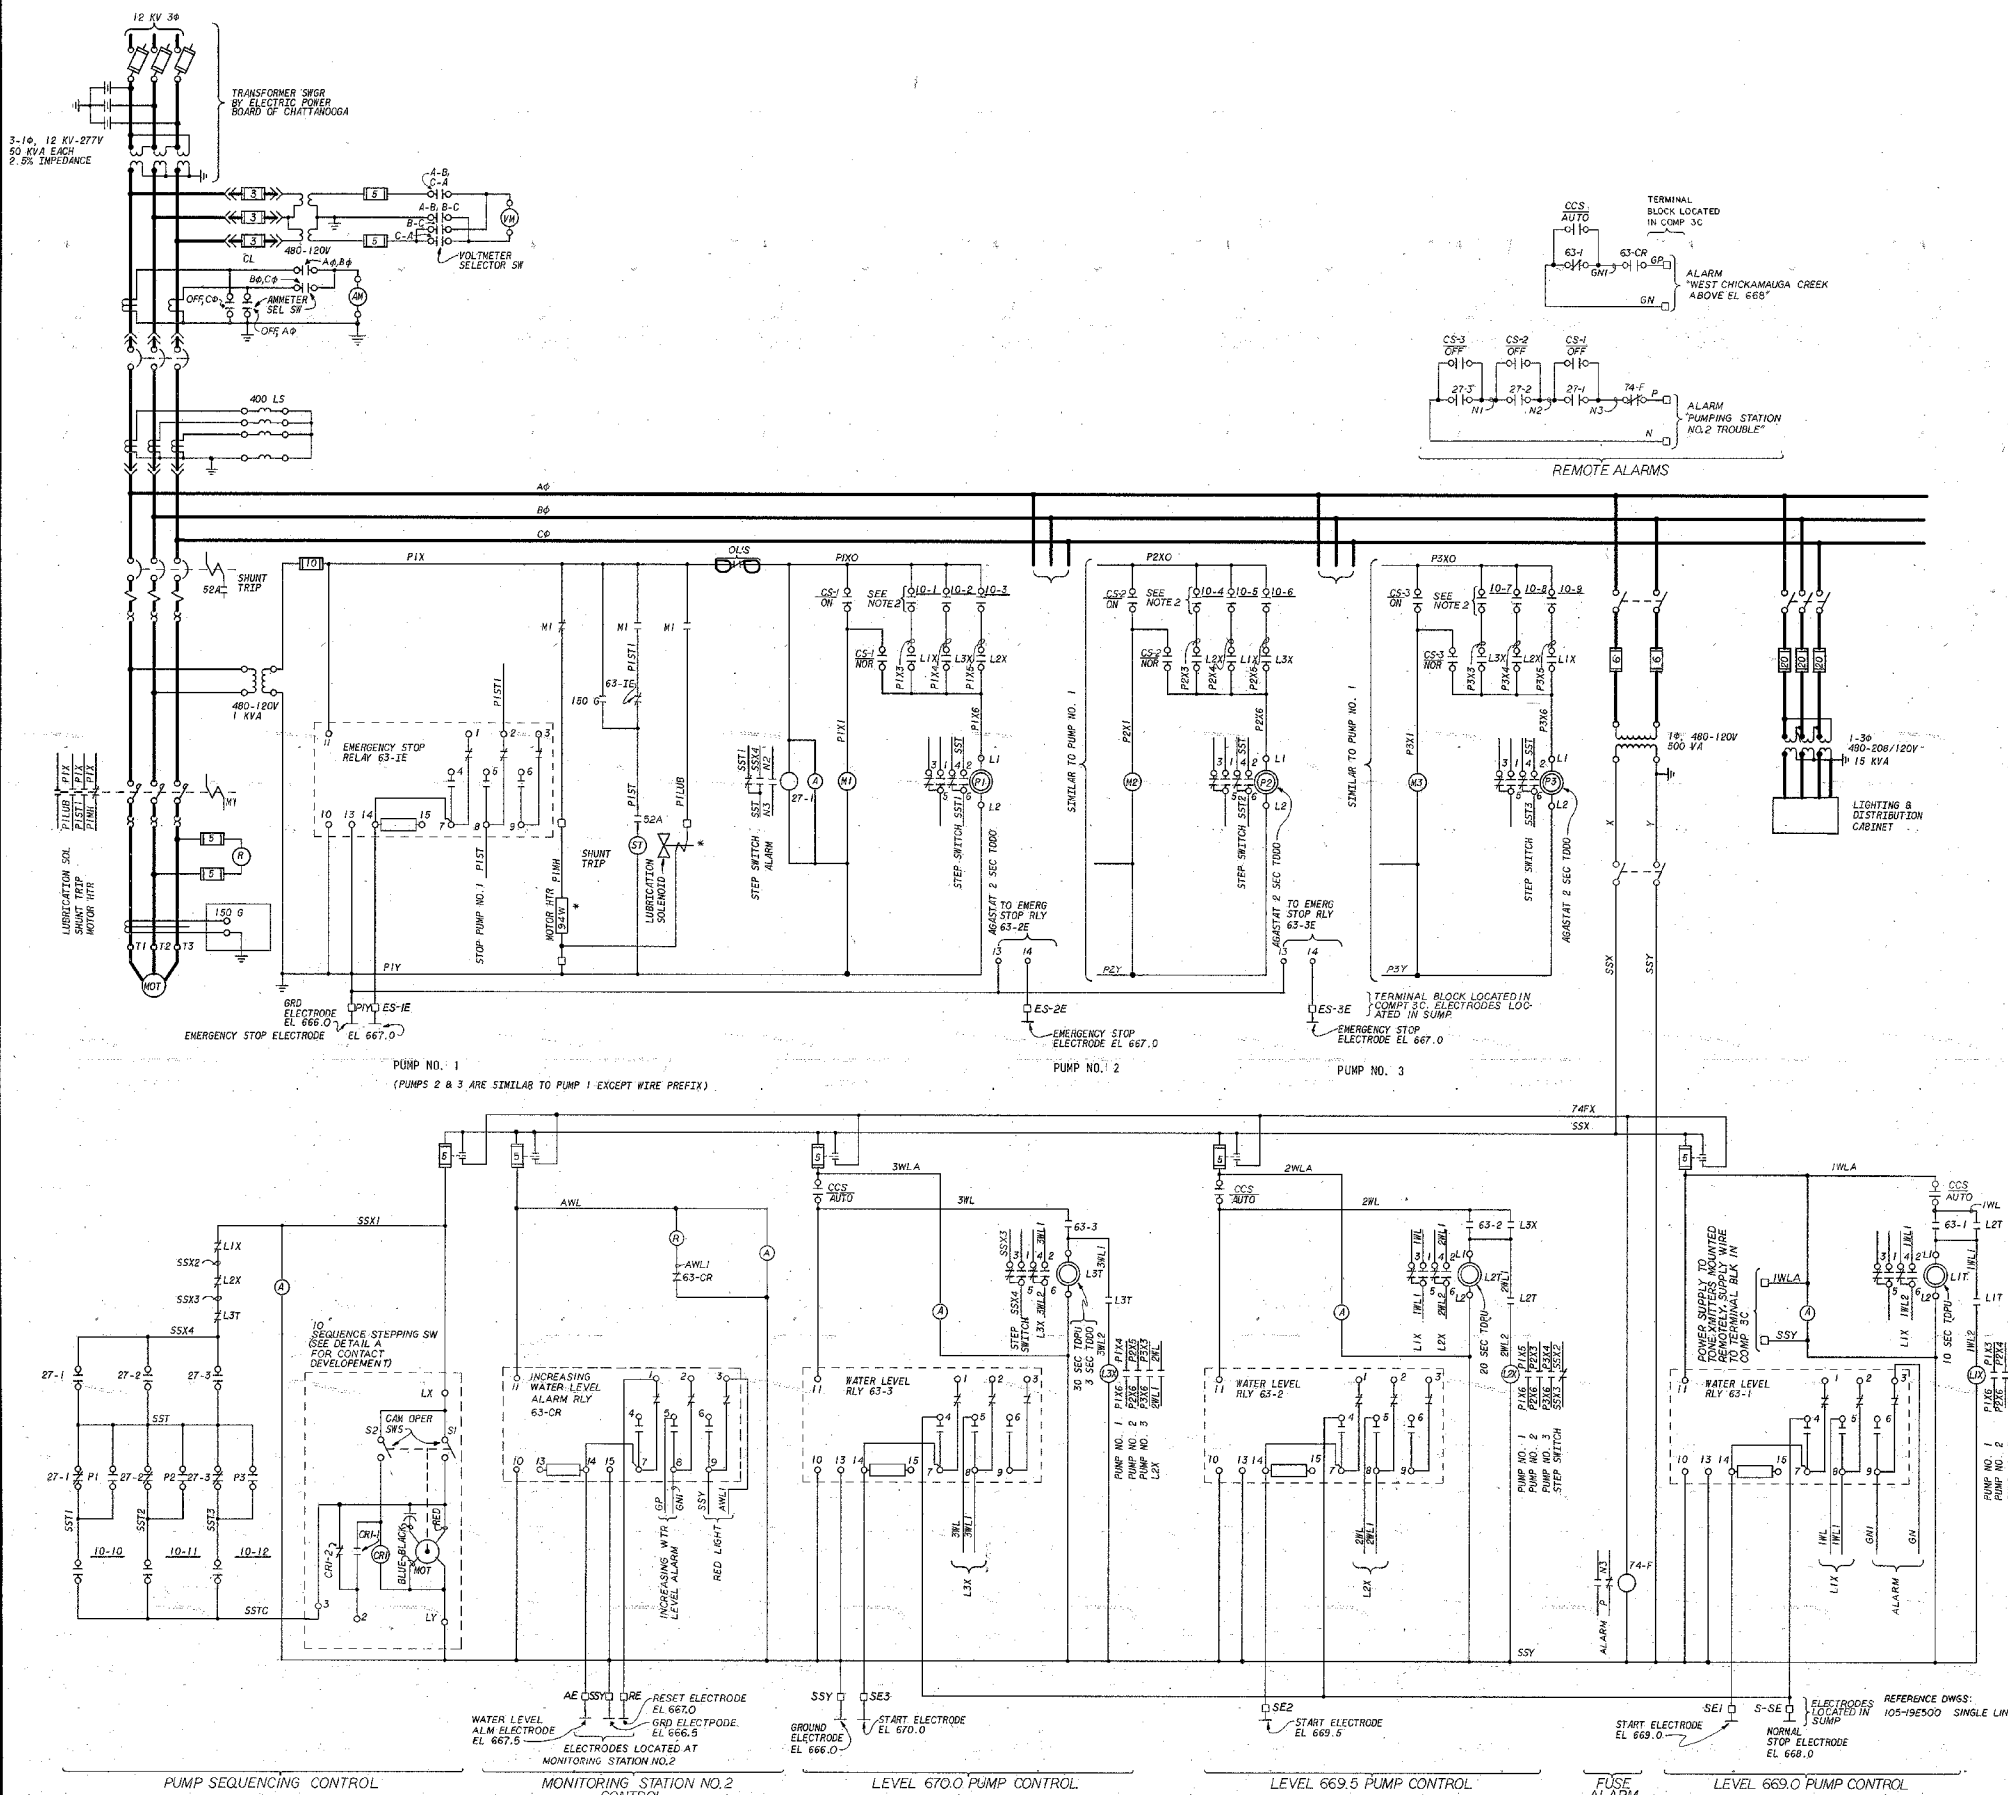

- NOTES:
- ASTERISKS (*) INDICATE CONTROL EQUIPMENT LOCATED REMOTE FROM THE MOTOR CONTROL CENTER. RECTANGULAR SYMBOLS (□) INDICATE WIRING THAT THE MOTOR CONTROL CENTER VENDOR IS TO MAKE AVAILABLE AT TERMINAL BLOCKS IN THE RESPECTIVE COMPARTMENT (UNLESS OTHERWISE NOTED) FOR TVA CABLES.
 - THE CONTACTS OF SEQUENCE STEPPING SWITCH ARE LABELLED 10-1, 10-2, ETC. FOR CONTACT DIAGRAM OF SEQUENCE STEPPING SWITCH SEE DETAIL A.
 - FOR FURTHER DETAILS AND AS PURCHASED STATUS, SEE CONTROL POWER SYSTEMS INC. DRAWING R-41604, TVA CONTRACT 77K3-821901.

LOAD SWITCH

NO.	PUMP NO. 1	PUMP NO. 2	PUMP NO. 3	AUX
1	X	X	X	X
2	X	X	X	X
DETAIL A
10-SEQUENCE STEPPING SW CONTACT DIAGRAM (X DENOTES CONTACT CLOSED)

CHATTANOOGA FLOOD PROTECTION PUMPING STATION NO. 2

WIRING DIAGRAMS
A-C AUXILIARY POWER
SCHEMATIC DIAGRAMS

SOUTH CHICKAMAUGA CREEK PROJECT
TENNESSEE VALLEY AUTHORITY
DIVISION OF ENGINEERING DESIGN


REVISIONS: 7-10-78

REV. NO.	DATE	BY	CHKD.	APPV.
1	7-10-78	D.R. TABLER		


INSPECTED AND APPROVED FOR ISSUE: *G.L. Buchanan* KNOXVILLE 1-31-77

RECORD DRAWING AS CONSTRUCTED
Frank Van Dyke

ME R.O. A1

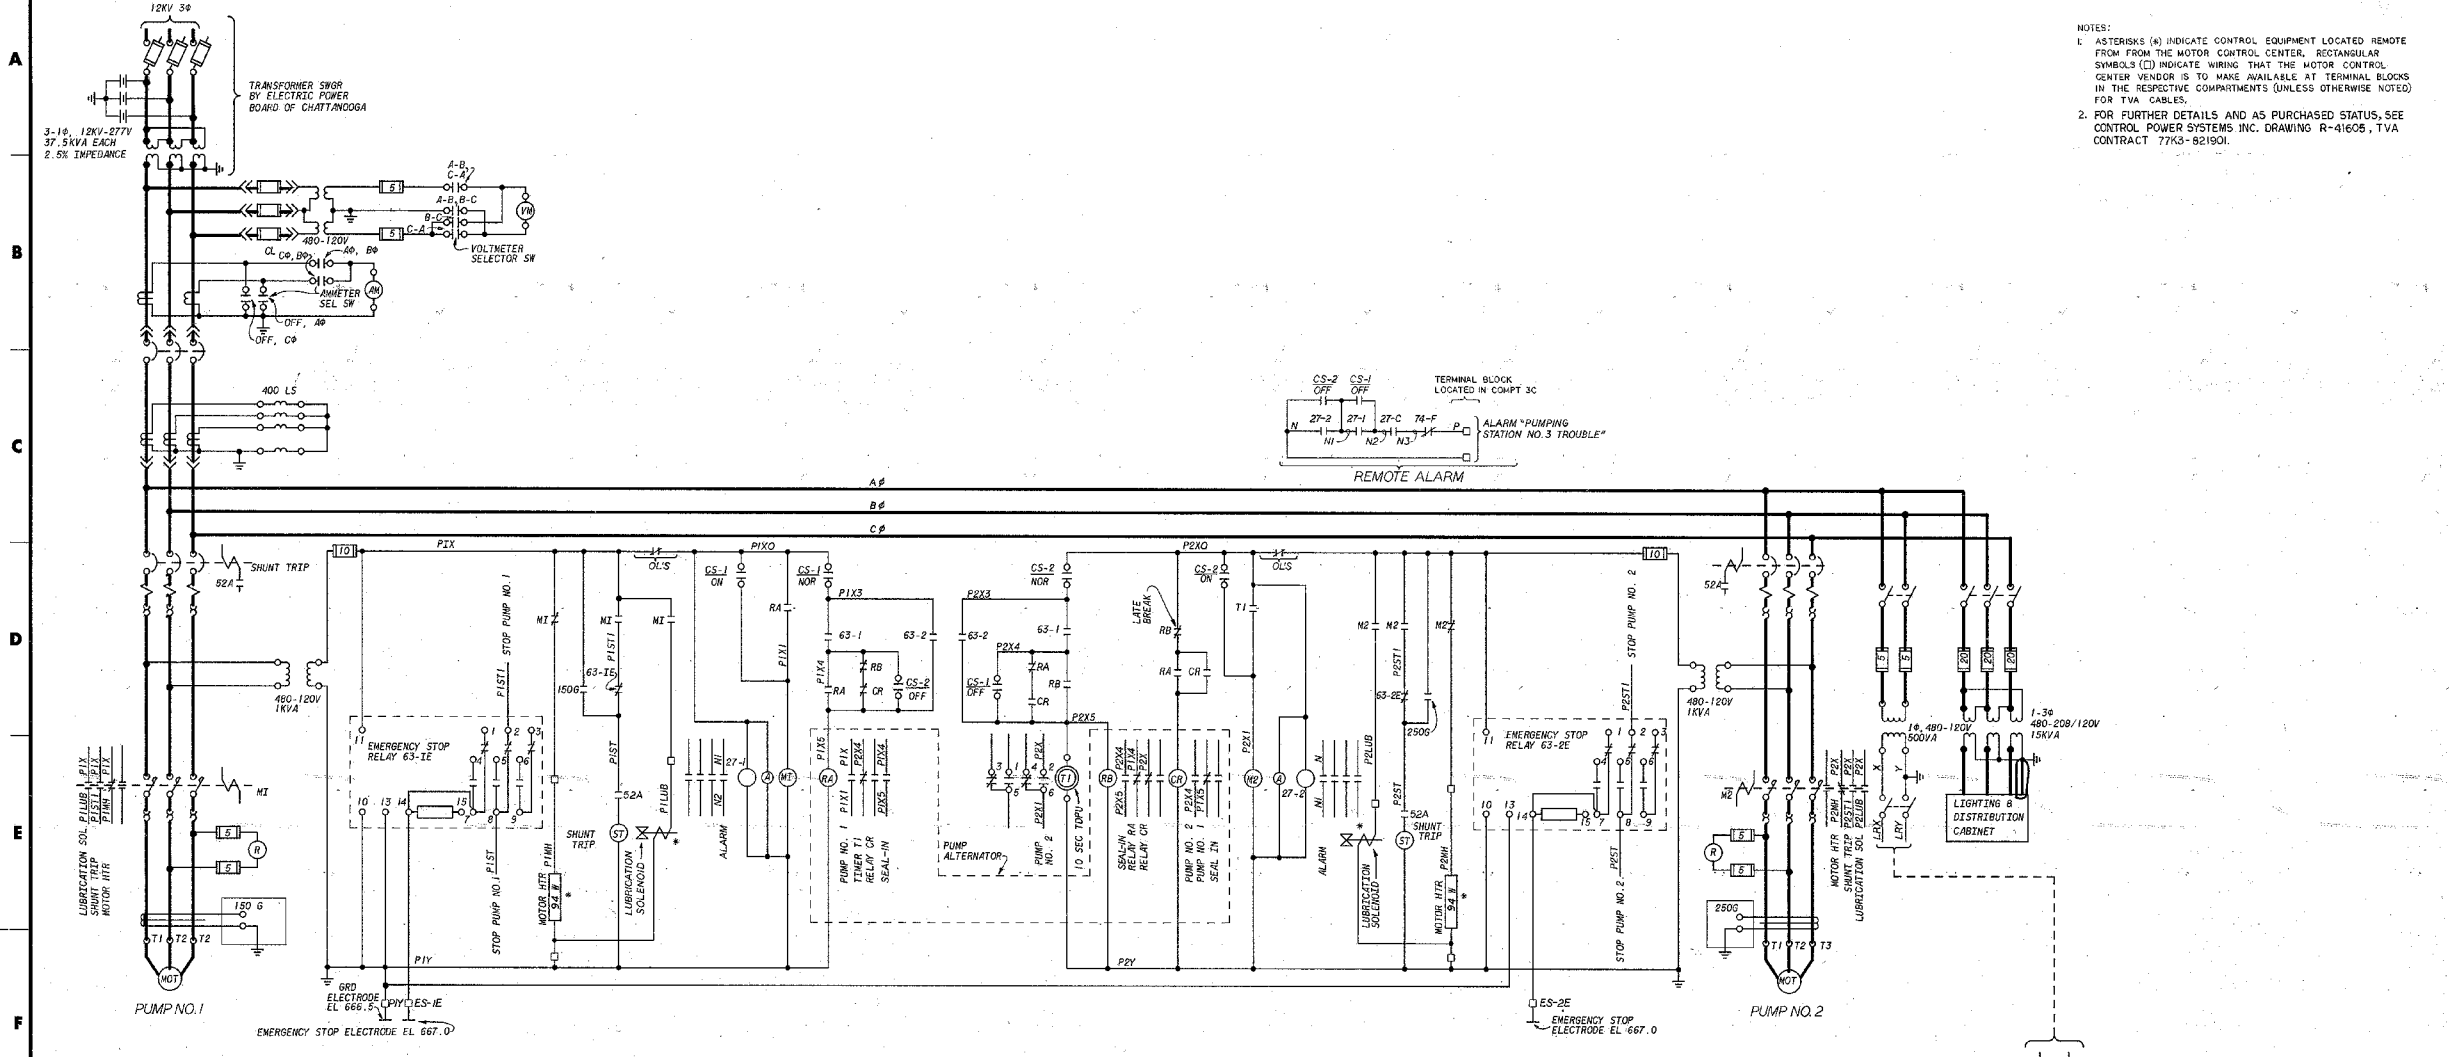

NOTES:
1. ASTERISKS (*) INDICATE CONTROL EQUIPMENT LOCATED REMOTE FROM THE MOTOR CONTROL CENTER. RECTANGULAR SYMBOLS (□) INDICATE WIRING THAT THE MOTOR CONTROL CENTER VENDOR IS TO MAKE AVAILABLE AT TERMINAL BLOCKS IN THE RESPECTIVE COMPARTMENTS (UNLESS OTHERWISE NOTED) FOR TVA CABLES.
2. FOR FURTHER DETAILS AND AS PURCHASED STATUS, SEE CONTROL POWER SYSTEMS INC. DRAWING R-41605, TVA CONTRACT 77K3-621901.

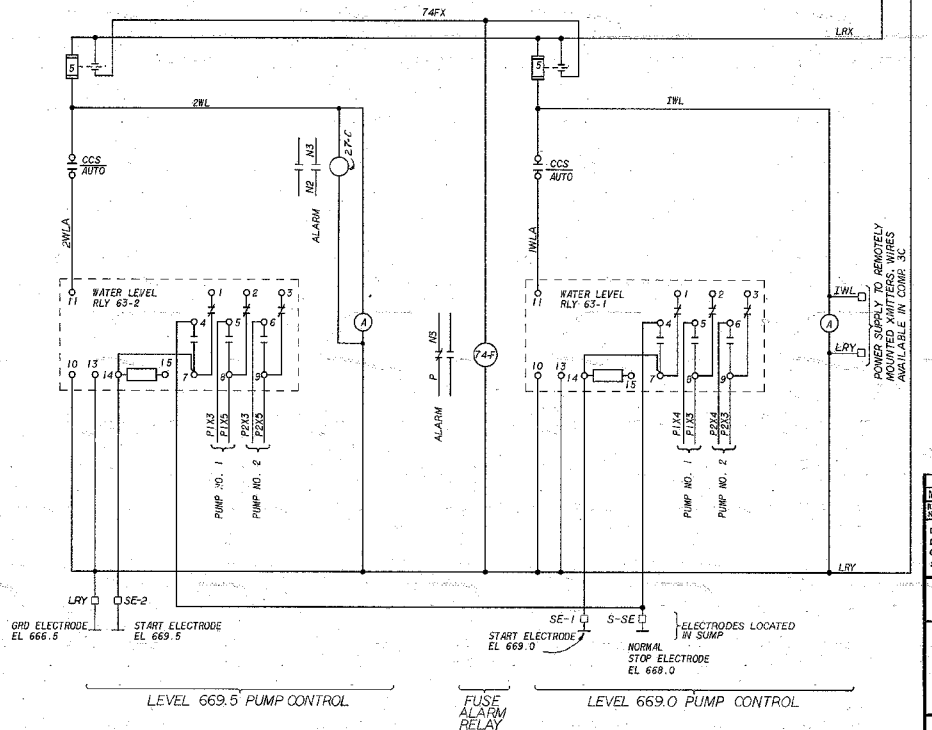

MINOR REVISIONS		DATE		BY		CHKD		APPD	
REV	NO.	DATE	BY	CHKD	APPD	DATE	BY	CHKD	APPD
1									
DRAWN BY: J. P. TABLER				CHKD BY: J. P. TABLER		APPD BY: J. P. TABLER		DATE: 1-31-77	
PROJECT: CHATTANOOGA FLOOD PROTECTION PUMPING STATION NO. 3				ENGINEER: J. P. TABLER		DATE: 1-31-77		DRAWING NO: 105-19E513	
WIRING DIAGRAMS A-C AUXILIARY POWER SCHEMATIC DIAGRAMS SOUTH CHICKAMAUGA GREEK PROJECT TENNESSEE VALLEY AUTHORITY DIVISION OF ENGINEERING DESIGN									
SUBMITTED BY: Robert D. Hunt				RECOMMENDED BY: R. A. Henderson		APPROVED BY: J. P. Tabler			
KNOXVILLE				1-31-77		81 E 105-19E513		RI	
RECORD DRAWING AS CONSTRUCTED									




REFERENCE DWGS:
105-19E500... SINGLE LINE

INSPECTED AND APPROVED FOR ISSUE:
G. L. Buchanan

PRINT	H	5	1	1
SIZE	F			



74F 80 41

A
B
C
D
E
F
G
H
J
K

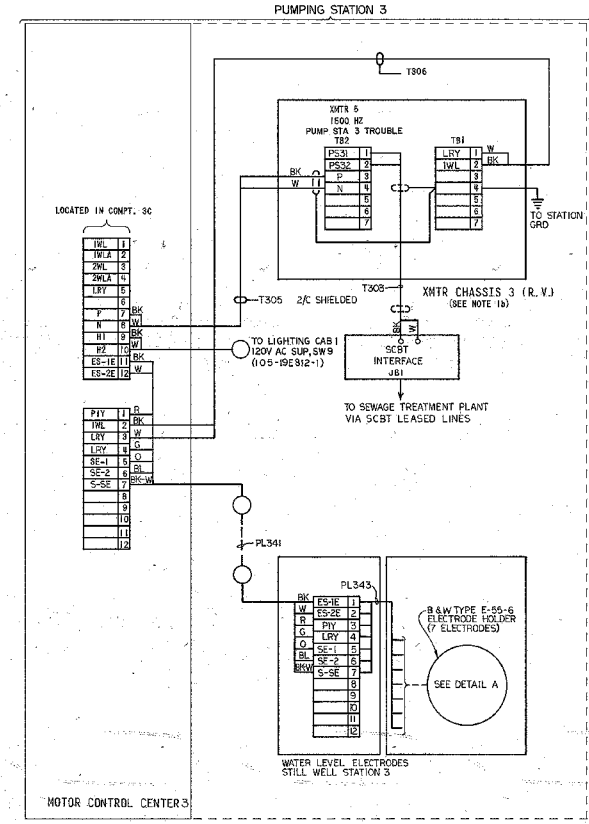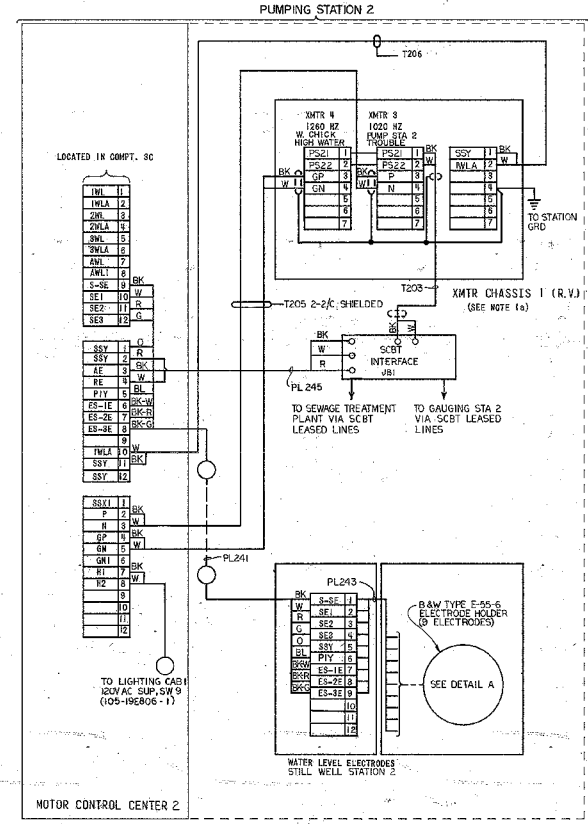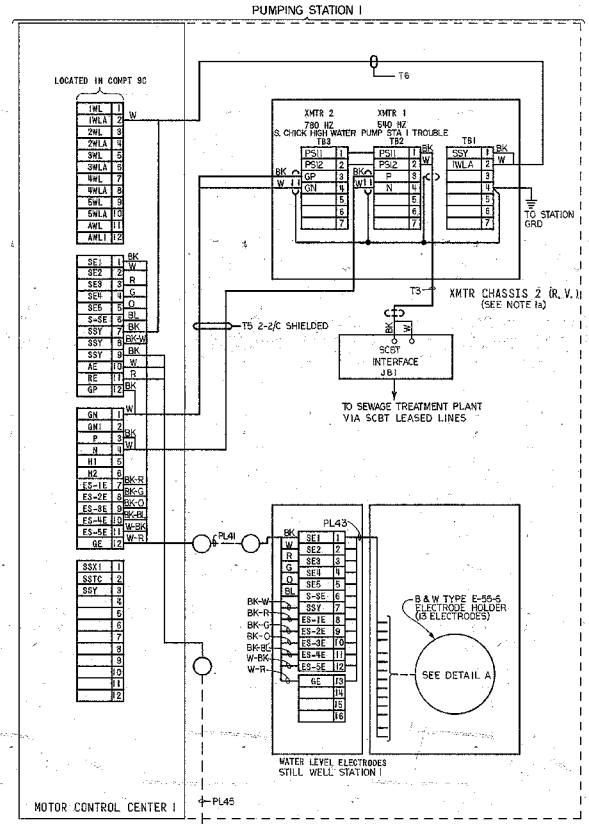


- NOTES:
- FOR XTMR AND PWR SUPPLY INTERVALS SEE TVA CONTRACT NO. 77K15-822428-1.
 - a) DWG NO. CB-21923-1
 - b) DWG NO. CB-21924-1
 - FOR REC. AND PWR SUPPLY INTERVALS SEE TVA CONTRACT NO. 77K15-822428-1. DWG NO. CB-21925-1.
 - FIELD TO LOCATE AND MOUNT PWR SUPPLY, SWITCHES, AND ALARM BELL PER TVA DWG 105-196206-1.
 - FOR MISC. L.S. & S. DETAILS, SEE TVA CONTRACT NO. 77K15-822428-2, DWG R-41658, R-41656 & R-41678.
 - FOR ANNUNCIATOR PANEL DETAILS, SEE TVA CONTRACT NO. 77K15-822428-2. FIELD TO REPLACE EXISTING NAMEPLATE ENGRAVING WITH SPARE NAMEPLATES ENGRAVED AS SHOWN.
 - SCBT IS SOUTH CENTRAL BELL TELEPHONE.

REFERENCE DWGS:
105-196511-1-2
105-196512
105-196513
101-19E220

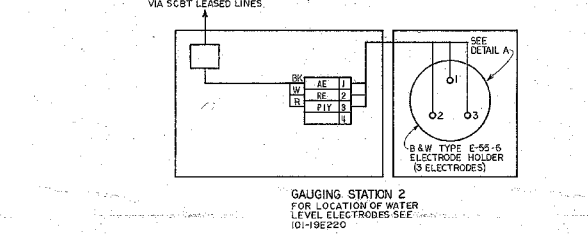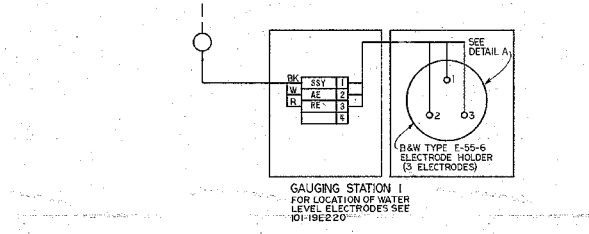


ELECTRODE NO.	WIRE NO.	ELEC. NO.	WIRE NO.	ELEC. NO.	WIRE NO.	ELEC. NO.	WIRE NO.	ELEC. NO.	WIRE NO.	ELEC. NO.
1	SE1	654	S-SE	668	ES-IE	667	SSY	662	AE	667.0
2	SE2	654.5	SE1	669	ES-2E	667	AE	663.5	RE	667.0
3	SE3	655	SE2	669.5	PIY	666.0	RE	663.0	SSY	666.0
4	SE4	656.5	SE3	670	LRY	666.0				
5	SE5	656	SSY	666.0	SE-1	669				
6	S-SE	663.5	PIY	666.0	SE-2	669.5				
7	SSY	662	W-IE	667	S-SE	668				
8	ES-IE	652.5	ES-2E	667						
9	ES-2E	662.5	ES-3E	667						
10	ES-3E	662.5								
11	ES-4E	662.5								
12	ES-5E	662.5								
13	GE	652								

* GROUND ELECTRODE

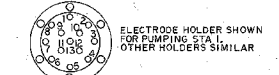



DETAIL A

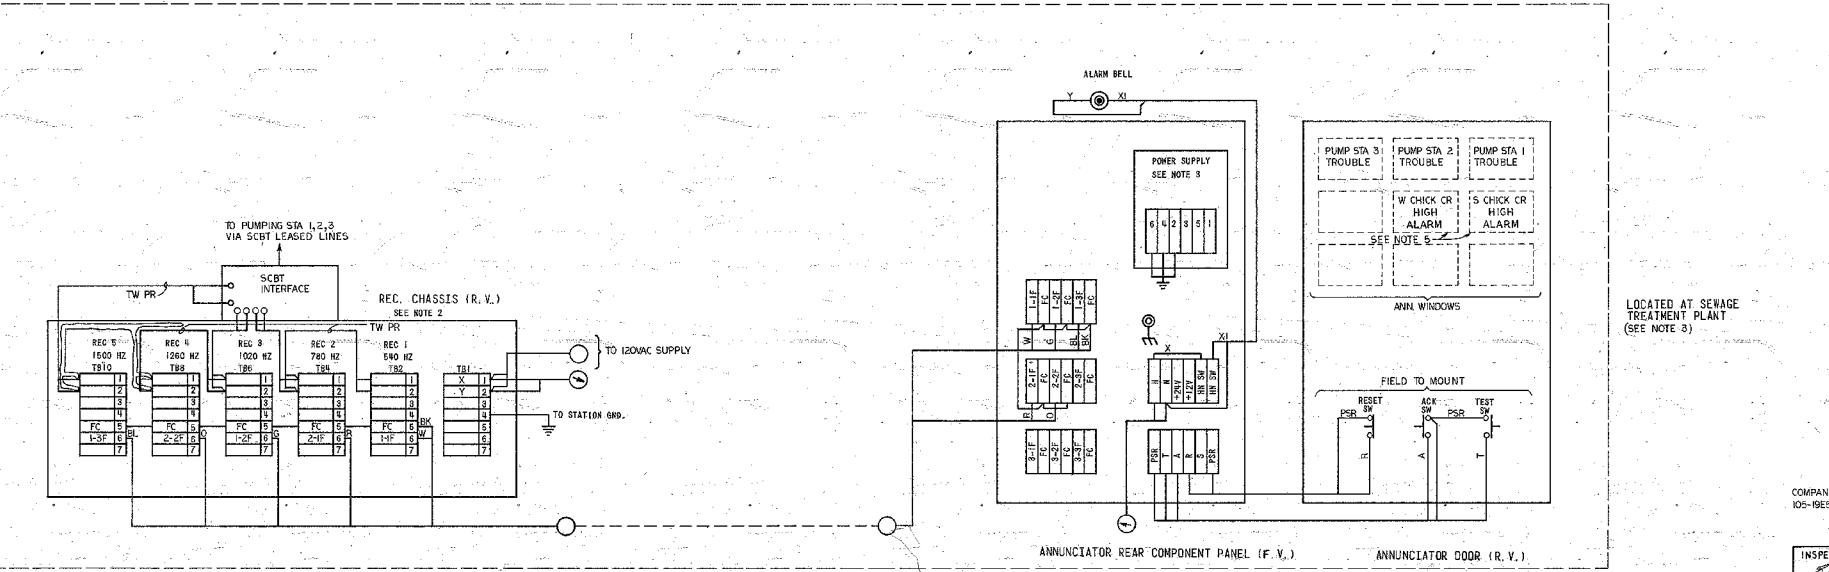

2	1925-87	10/11/78	10/11/78	10/11/78	10/11/78	10/11/78	10/11/78	10/11/78	10/11/78	10/11/78
MINOR REVISION										
SCALE EXCEPT AS NOTED										
CHATTANOOGA FLOOD PROTECTION PUMP STA 1,2,3 & SEWAGE TREATMENT PLANT										
WIRING DIAGRAMS CONTROL AND ALARM EQPT CONNECTION DIAGRAM										
SOUTH CHICKAMAUGA CREEK PROJECT TENNESSEE VALLEY AUTHORITY DIVISION OF ENGINEERING DESIGN										
SUBMITTED: Robert J. Stewart, RECOMMENDED: R. H. Warden, APPROVED: John B. Holliday										
INSPECTED AND APPROVED FOR ISSUE: [Signature] KNOXVILLE 1-25-79 81 E 105-19E520-1 A2										

COMPANION DWGS: 105-19E520-2

PRINTED AT THE TENNESSEE VALLEY AUTHORITY PRINTING SHOP, KNOXVILLE, TENNESSEE

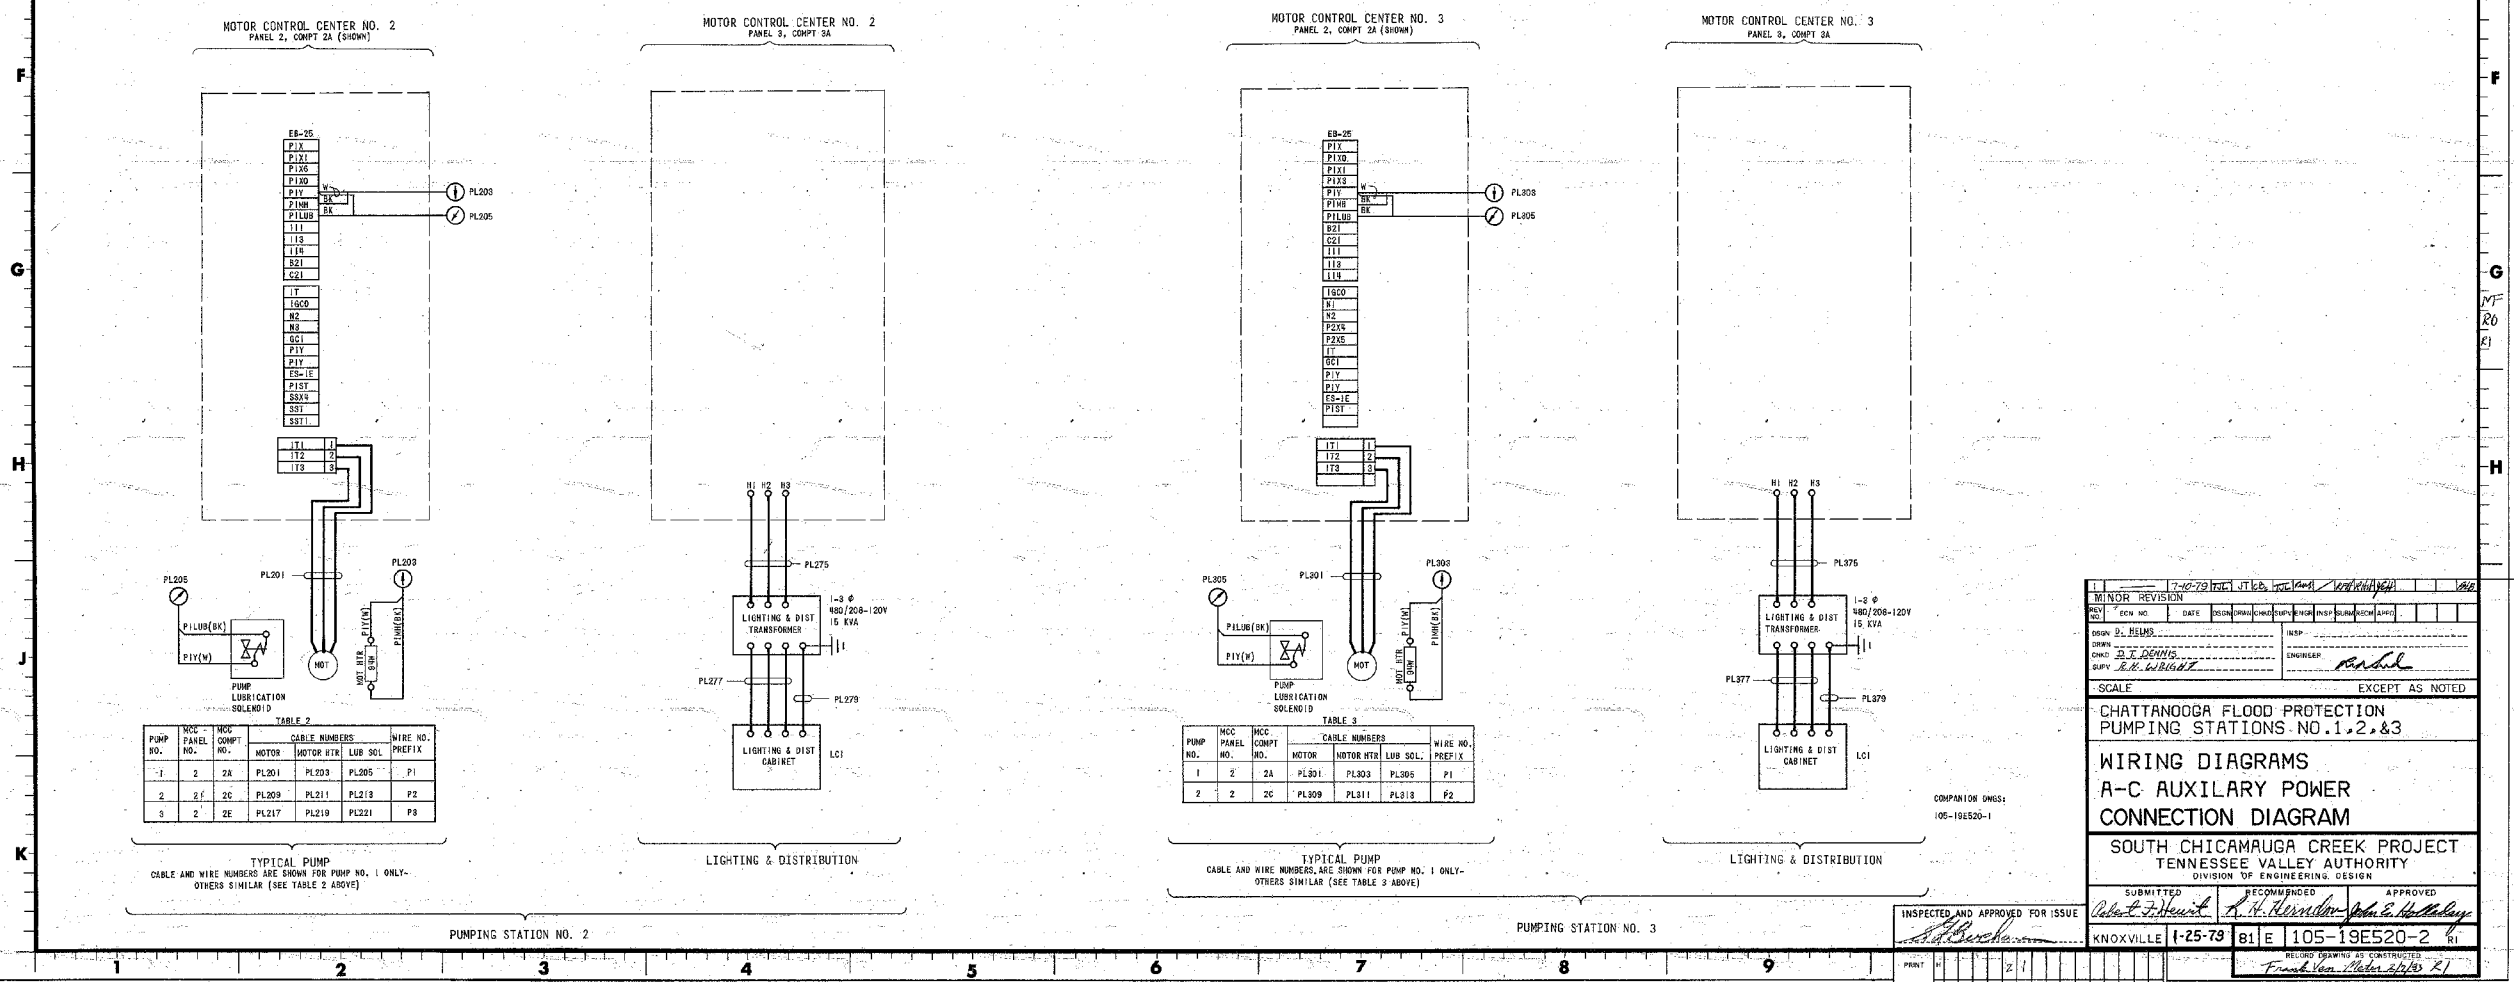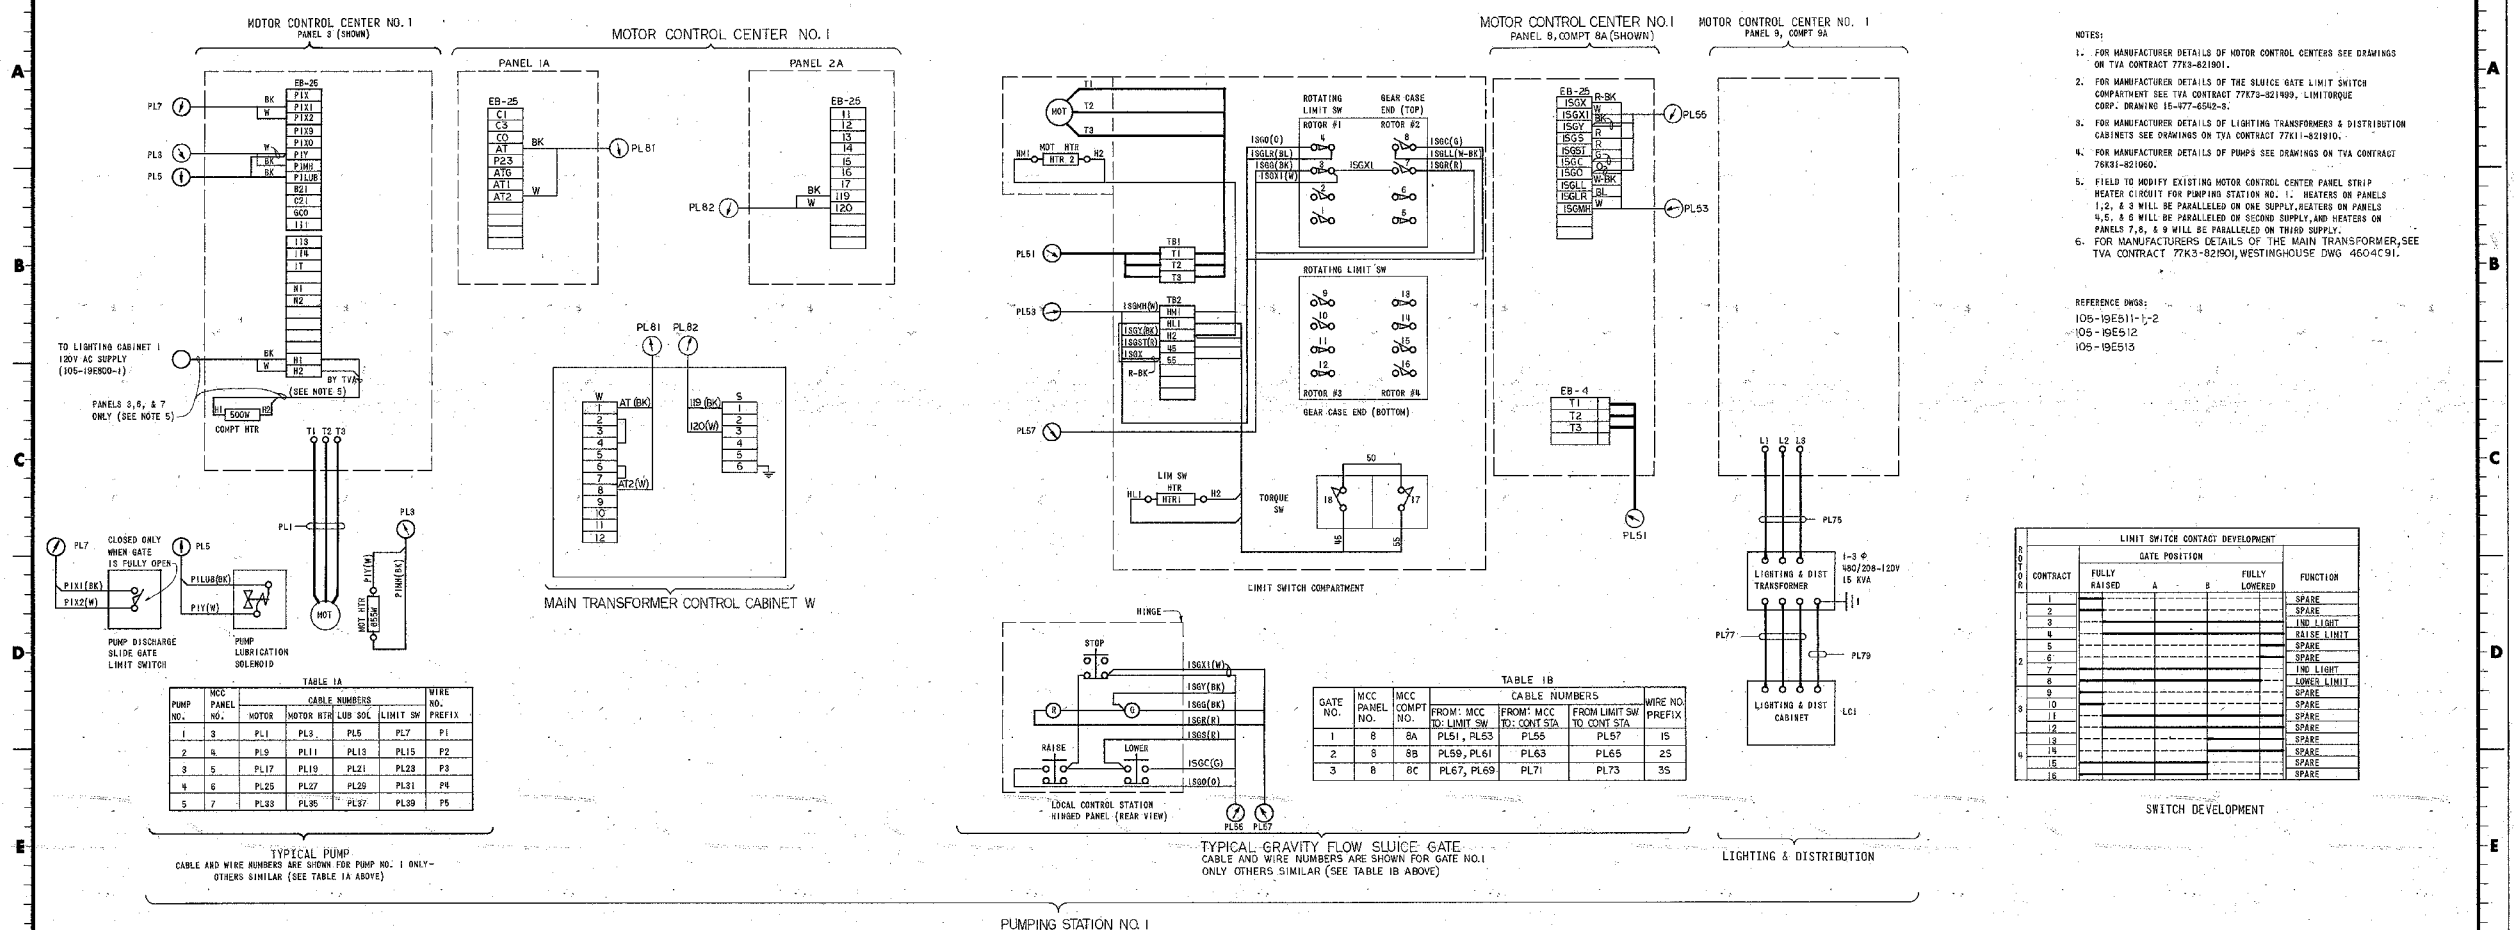

7-10-79 INCL. 1, 2, 3, 99, 100

MINOR REVISION

REV 1 ECH NO DATE

DESIGN BY: BEIMS

DRAWN BY: J. H. BEIMS

CHECKED BY: J. H. BEIMS

SCALE: EXCEPT AS NOTED

CHATTANOOGA FLOOD PROTECTION PUMPING STATIONS NO. 1, 2, & 3



WIRING DIAGRAMS A-C AUXILIARY POWER CONNECTION DIAGRAM

SOUTH CHICAMAUGA CREEK PROJECT TENNESSEE VALLEY AUTHORITY DIVISION OF ENGINEERING DESIGN





INSPECTED AND APPROVED FOR ISSUE: [Signature]

APPROVED: [Signature]

KNOXVILLE 1-25-79 81E 105-19E520-2 RI

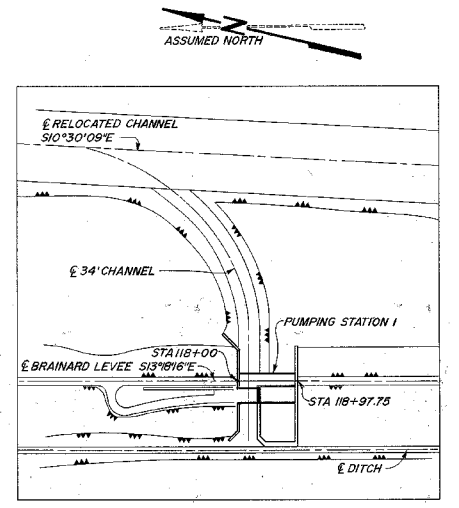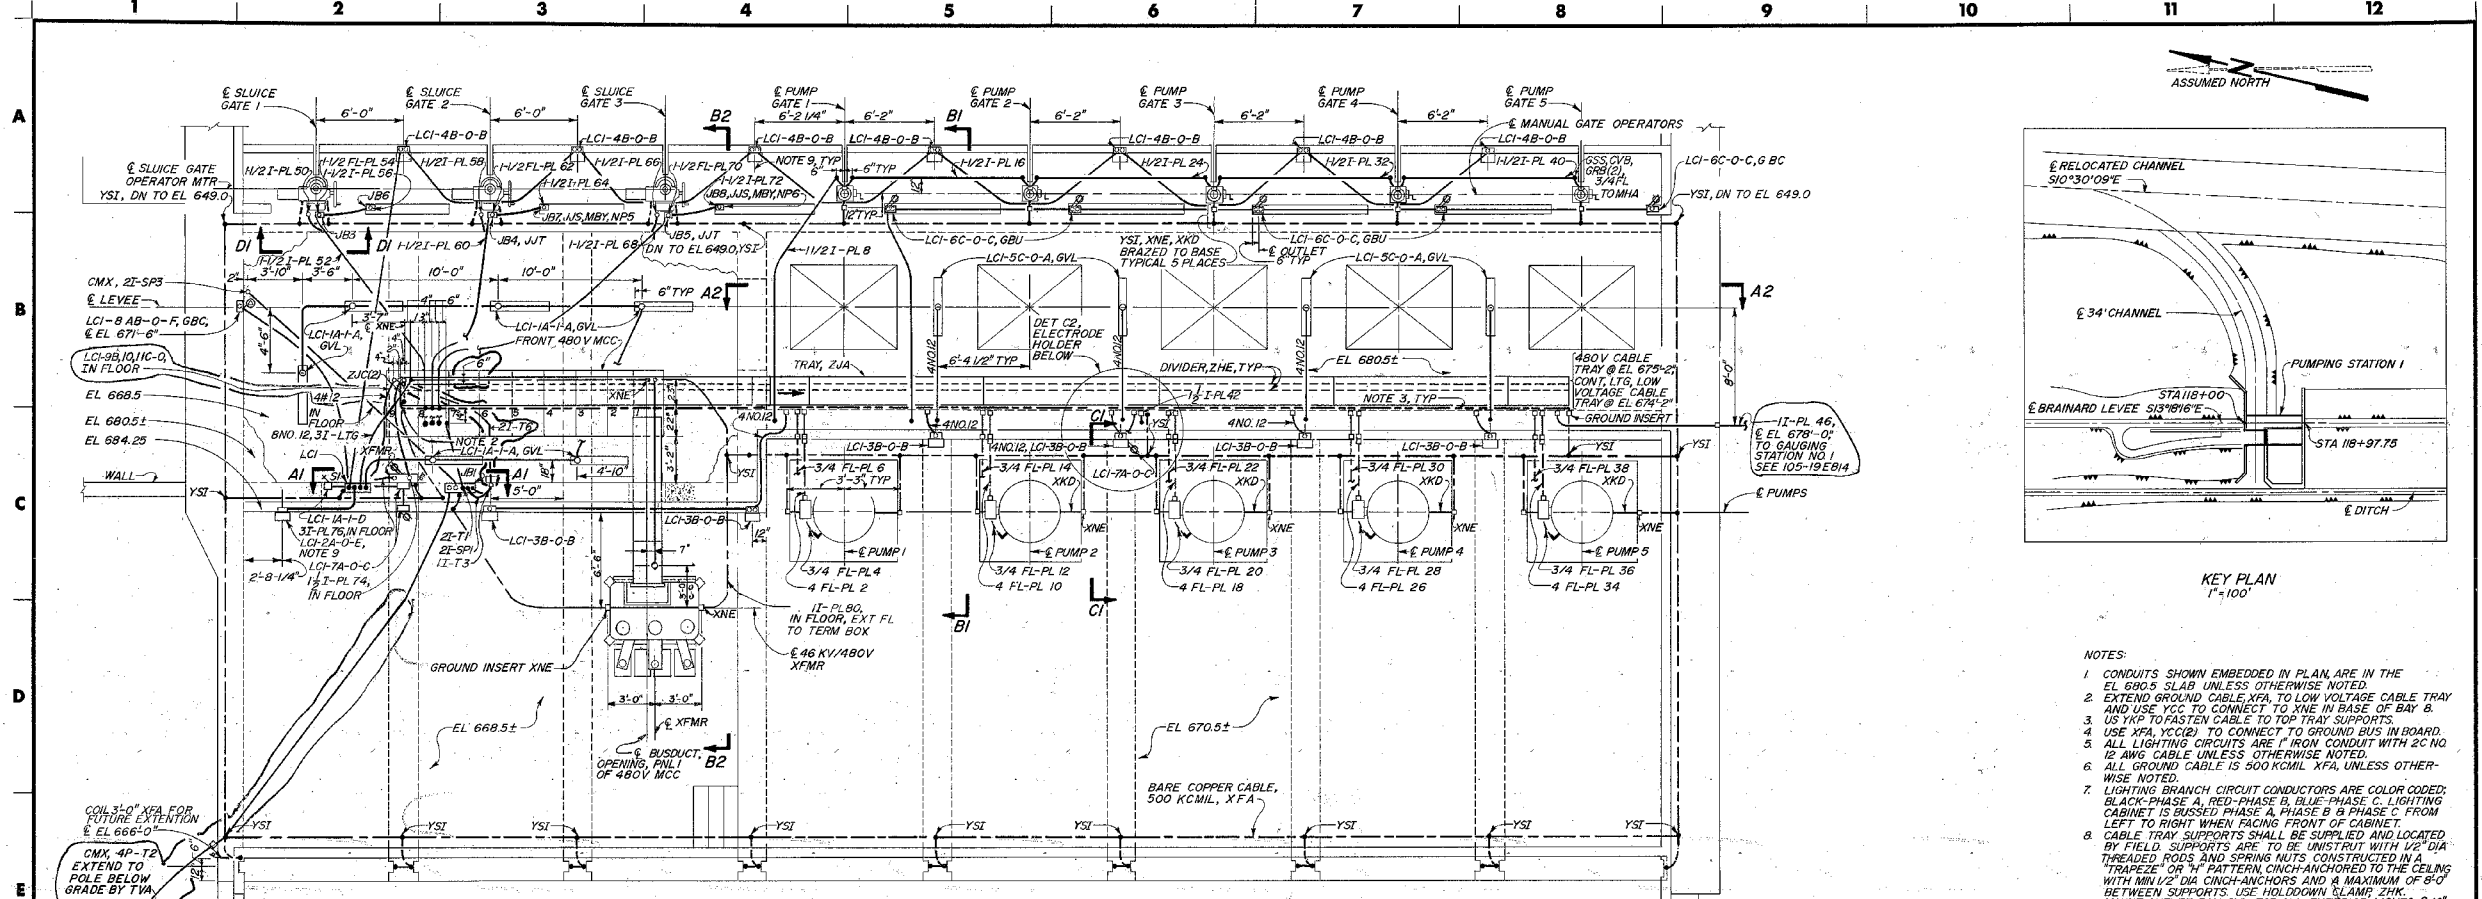

- NOTES:
- CONDUITS SHOWN EMBEDDED IN PLAN, ARE IN THE EL 680.5 SLAB UNLESS OTHERWISE NOTED.
 - EXTEND GROUND CABLE, XFA, TO LOW VOLTAGE CABLE TRAY AND USE YCC TO CONNECT TO XNE IN BASE OF BAY B.
 - USE YCP TO FASTEN CABLE TO TOP TRAY SUPPORTS.
 - USE XFA, YCC(B) TO CONNECT TO GROUND BUS IN BOARD.
 - ALL LIGHTING CIRCUITS ARE 1" IRON CONDUIT WITH 2C NO 12 AWG CABLE UNLESS OTHERWISE NOTED.
 - ALL GROUND CABLE IS 500 KCMIL, XFA UNLESS OTHERWISE NOTED.
 - LIGHTING BRANCH CIRCUIT CONDUCTORS ARE COLOR CODED: BLACK-PHASE A, RED-PHASE B, BLUE-PHASE C. LIGHTING CABINET IS BUSSED PHASE A, PHASE B PHASE C FROM LEFT TO RIGHT WHEN FACING FRONT OF CABINET.
 - CABLE TRAY SUPPORTS SHALL BE SUPPLIED AND LOCATED BY FIELD. SUPPORTS ARE TO BE UNISTRUT WITH 1/2" DIA THREADED RODS AND SPRING NUTS CONSTRUCTED IN A "TRAPEZOID" OR "T" PATTERN, CINCH-ANCHORED TO THE CEILING WITH MIN 1/2" DIA CINCH-ANCHORS AND A MAXIMUM OF 8'-0" BETWEEN SUPPORTS. USE HOLDDOWN CLAMP ZHK.
 - MOUNT OUTLET BOX, GVL, FOR ALL EXTERIOR LIGHTS & 10" BELOW TOP OF WALL.
 - THE CIRCUIT INDEX CARD LOCATED ON LCI SHALL BE LABELED PER DETAIL E1.
 - INSTALLATION FOR PUMP GATE LIMIT SWITCHES 2 THRU 4 IS SIMILAR TO PUMP GATE LIMIT SWITCH 1 AS SHOWN IN B-11. SEE CONDUIT & CABLE SCHEDULES.
 - FIELD TO GROUND ALL STRUCTURAL STEEL, EQUIPMENT FRAMES, AND MISC STEEL.
- REFERENCE DRAWINGS:
105-19C800... CONDUIT & CABLE SCHEDULE
105-19B800... BILL OF MATERIAL

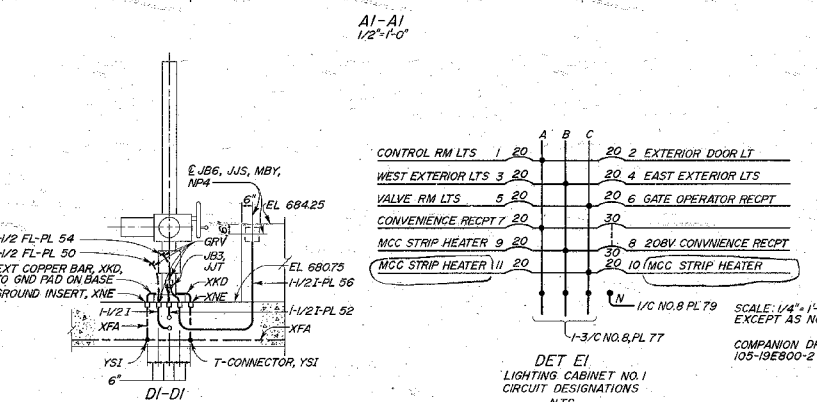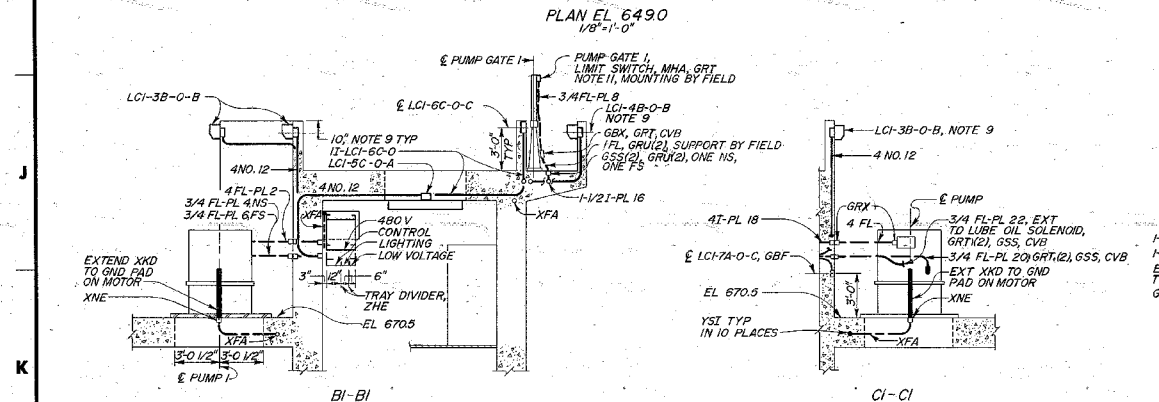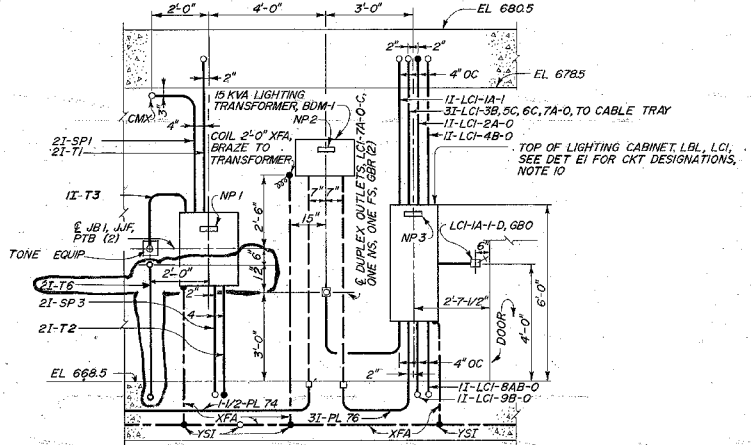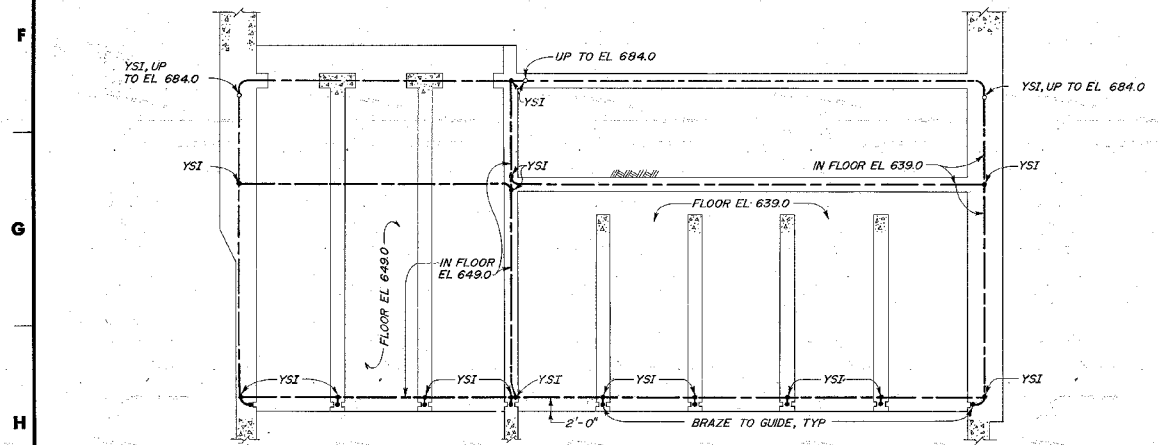

CONTROL RM LTS	1	20	20	2	EXTERIOR DOOR LT
WEST EXTERIOR LTS	3	20	20	4	EAST EXTERIOR LTS
VALVE RM LTS	5	20	20	6	GATE OPERATOR RECEPT
CONVENIENCE RECEPT	7	20	30	8	ROBY CONVENIENCE RECEPT
MCC STRIP HEATER	9	20	30	10	MCC STRIP HEATER

- SYMBOLS:
- EXPOSED CONDUIT TURNING DOWN
 - EMBEDDED CONDUIT TURNING UP
 - 120V AC DUPLEX OUTLET
 - 208V AC OUTLET
 - SINGLE POLE SWITCH

3	19-2-78	BY	PKS/SLT/RWS	REV	1/1/81	1/28
2	MINOR REVISION					
1	11-3-77	BY	SLT	REV	1/1/77	1/28

CHATTAHOOGA FLOOD PROTECTION
PUMPING STATION NO. 1
CONDUIT & GROUNDING & LIGHTING
GENERAL ARRANGEMENT
PLAN & DETAILS
SOUTH CHICKAMAUGA CREEK PROJECT
TENNESSEE VALLEY AUTHORITY
DIVISION OF ENGINEERING DESIGN

INSPECTED AND APPROVED FOR ISSUE
W.H. Wainwright
KNOXVILLE 1-25-77
SCALE: 1/4"=1'-0"
EXCEPT AS NOTED
COMPANION DRAWING:
105-19E800-2




PRINT	H	7	2
SIZE	F	7	2
BY OR PROJ	ME	EE	CE
AD	GD	ED	MD
SD	BD	WD	LD
PRINTS	1000-2-A		

10
11
12
13


14
15
16
17
18
19
20

REVISIONS
DATE
BY
REASON

A
B
C
D
E
F
G
H
J
K

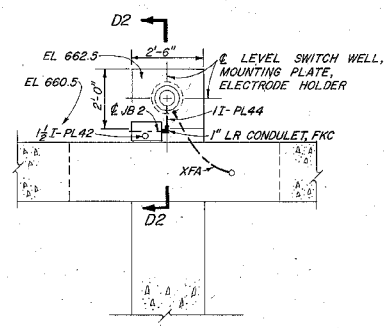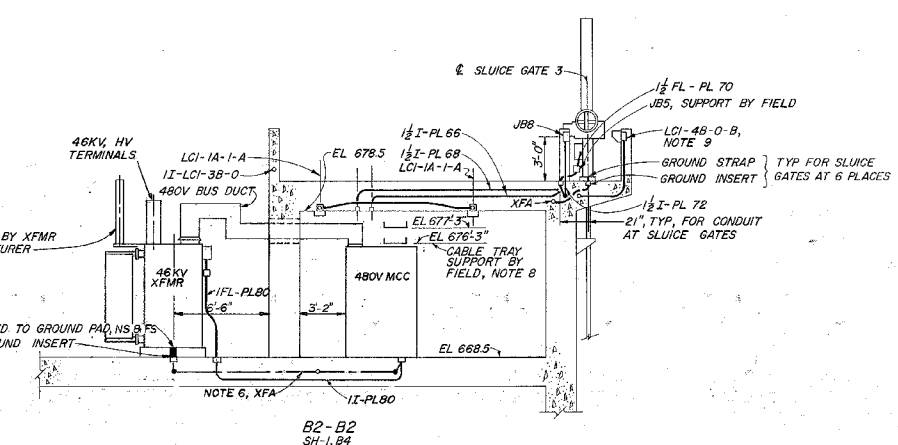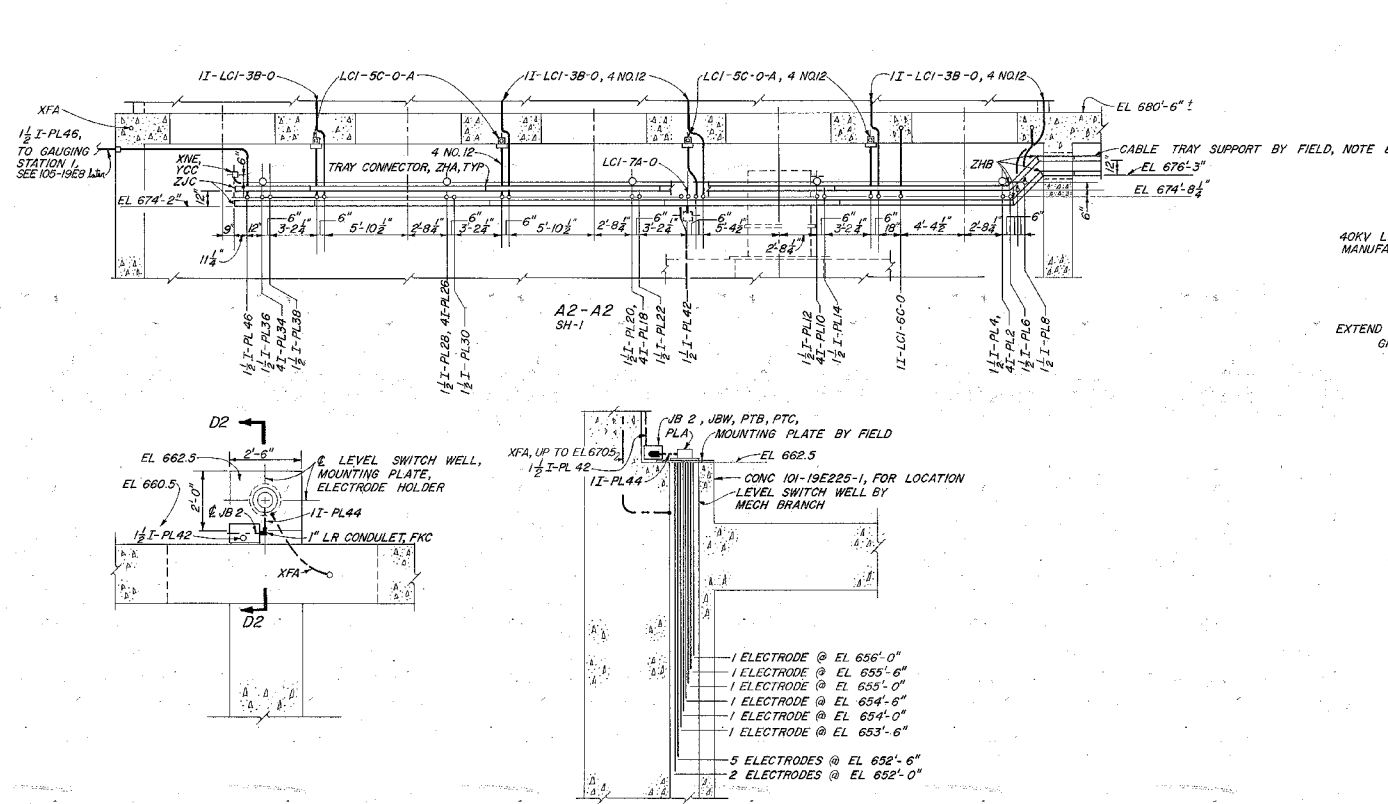

DET C2
PLAN EL 662.5
SH-1, B5
1/2" x 1'-0"

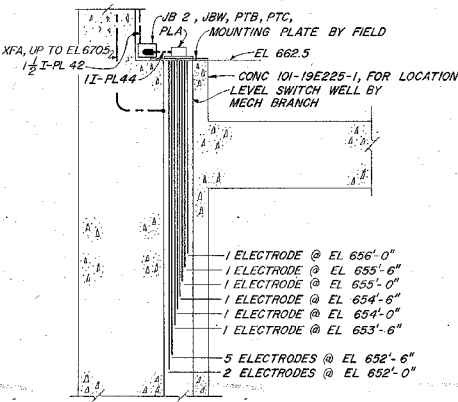

D2-D2
1/2" x 1'-0"

FOR NOTES AND REFERENCES
SEE 105-19E800-1

NAME PLATE INDEX

NO.	TYPE	FIRST LINE	SECOND LINE	THIRD LINE
1	A	TEL TERM CAB.		JBI
2	A	LIGHTING CABINET	480V/208V/120V XFMR	
3	A	SLUICE GATE 1	LOCAL CONT STA	JBB
4	A	SLUICE GATE 2	LOCAL CONT STA	JBB
5	A	SLUICE GATE 3	LOCAL CONT STA	JBB

JUNCTION BOX INDEX

NO.	MK	SIZE (INCHES)	LOCATION	USAGE	NP NO.
1	JUF	30 x 24 x 8	SECT A1-A1 TELEPHONE TERM CAB		1
2	JWB	12 x 8 x 6	SECT D2-D2 TERM BOX, PL 41, PL 43		---
3	JJT	6 x 6 x 6	SECT D1-D1 PULL BOX		---
4	JJT	6 x 6 x 6	PLAN EL 660.5 PULL BOX		---
5	JJT	6 x 6 x 6	PLAN EL 660.5 PULL BOX		---
6	JWS	6 x 6 x 6	SECT D1-D1 LOCAL CONT STA, SLUICE GATE 1		4
7	JWS	6 x 6 x 6	PLAN EL 660.5 LOCAL CONT STA, SLUICE GATE 2		5
8	JWS	6 x 6 x 6	PLAN EL 660.5 LOCAL CONT STA, SLUICE GATE 3		6

LIGHTING FIXTURE SCHEDULE

DESCRIPTION	FIXTURE TYPES						MK LTR TOTALS
	A	B	C	D	E	F	
WALL LIGHT, 100W, HIGH PRESS. SODIUM, HOPHANE, 486-120							13
WALL LIGHT 100W, HIGH PRESS. SODIUM WITH PHOTO CONTROL, HOPHANE, 487-120							1
FLUORESCENT UNIT 2-40W, SURFACE MOUNTED, DAY BRITE, 48240-1							10
LAMP 100W, HIGH PRESS. SODIUM, MUGUL BASE, 120V, GE LW100/BU							20
DUPLEX RECEPTACLE, 2P-20A BY GROUNDING, HUBBELL 5302, FOR 120V USE							8
RECEPTACLE, 2P-3W GROUNDING, HUBBELL 9330, FOR 208V USE							1
COVER PLATE WITH SPRING DOOR COVER, FOR USE WITH LRB-8, CAST ALUMINUM, CROUSE HINDS-10309							1
TUMBLER SWITCH, 1P, 20A, 277V, HUBBELL 1221							1
SWITCH PLATE, HINGED COVER, CAST ALUMINUM, HUBBELL 1420							1
RECEPTACLE COVER, CAST ALUMINUM, SPRING DOORS WITH GASKET, FOR USE WITH LRB-7, HUBBELL 5206							8

* SEE TVA DWG NO. GE 4 304 360

SCALE: 1" = 1' 0"
EXCEPT AS NOTED

COMPANION DRAWING:
105-19E800-1

NO.	DATE	BY	CHKD	APP'D	REVISION
1	11-3-77	OC	NEW	WMS	105-19E800-2
2	16-14-77	IS	CA	WMS	105-19E800-2

CHATANOOGA FLOOD PROTECTION
PUMPING STATION NO. 1


CONDUIT & GROUNDING & LIGHTING
GENERAL ARRANGEMENT
PLAN & DETAILS

SOUTH CHICKAMAUGA CREEK PROJECT
TENNESSEE VALLEY AUTHORITY
DIVISION OF ENGINEERING DESIGN


INSPECTED AND APPROVED FOR ISSUE
W. Wainwood
KNOXVILLE 1-25-77

RECORDED AS CONSTRUCTED 7-28-83
FIGURE VAN METER R2


PRINT	H	1	2
SIZE	A	11	17
BY OR FROM	ME	CE	AD

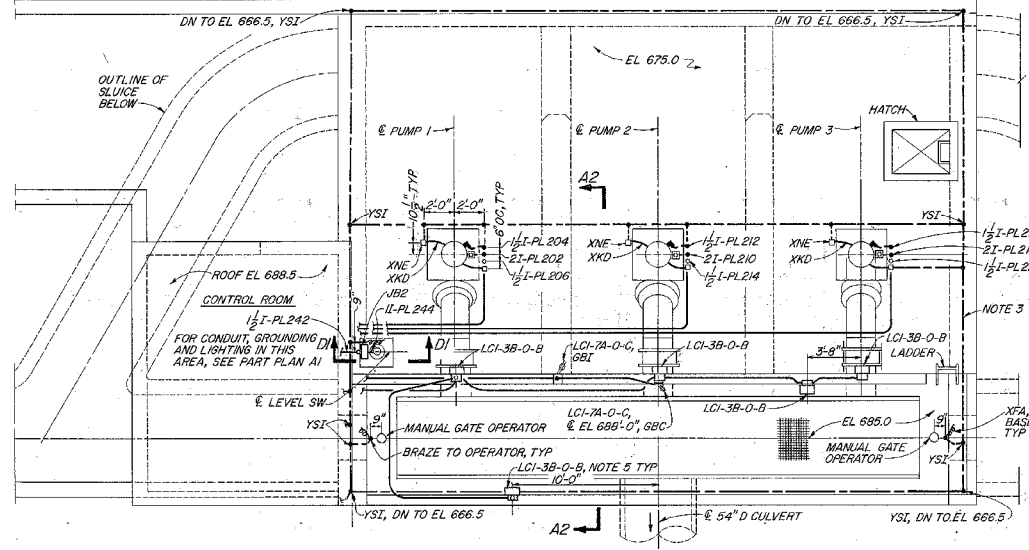

PLAN EL 688.5

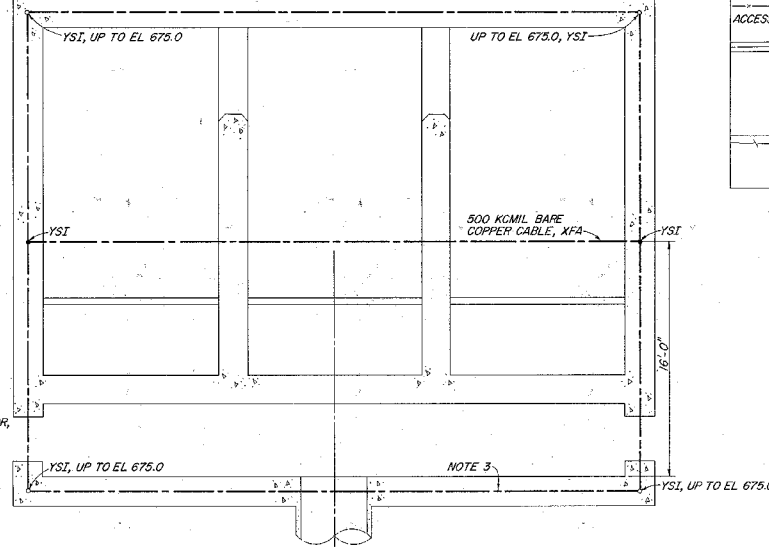


PLAN EL 666.5

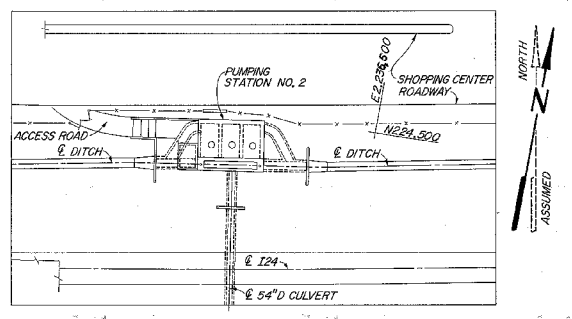


KEY PLAN
1\"/>

- NOTES:
1. USE XFA, YCC, TO CONNECT TO GROUND BUS IN BOARD.
 2. ALL LIGHTING CIRCUITS ARE 1\"/>
 - 3. ALL GROUND CABLE IS 500KCMIL XFA UNLESS OTHERWISE NOTED.
 - 4. LIGHTING BRANCH CIRCUIT CONDUCTORS ARE COLOR CODED; BLACK - PHASE A, RED - PHASE B, BLUE - PHASE C. LIGHTING CABINET IS BUSSED PHASE A, PHASE B & PHASE C FROM LEFT TO RIGHT, WHEN FACING FRONT OF CABINET.
 - 5. MOUNT OUTLET BOX, GVL, FOR EXTERIOR LIGHTS @ 10\"/>
 - 6. THE CIRCUIT INDEX CARD LOCATED ON LCI SHALL BE LABELED PER DETAIL E1.
 - 7. FIELD TO GROUND ALL STRUCTURAL STEEL, EQUIPMENT FRAMES, AND MISC. STEEL.
- REFERENCE DRAWINGS:
 105-19C800 - CONDUIT & CABLE SCHEDULE
 105-19B806 - BILL OF MATERIAL


- SYMBOLS:
- EXPOSED CONDUIT TURNING DOWN
 - EMBEDDED CONDUIT TURNING UP
 - ⊕ 120V AC DUPLEX OUTLET
 - ⊙ 208V AC SINGLE OUTLET
 - ⊥ SINGLE POLE SWITCH

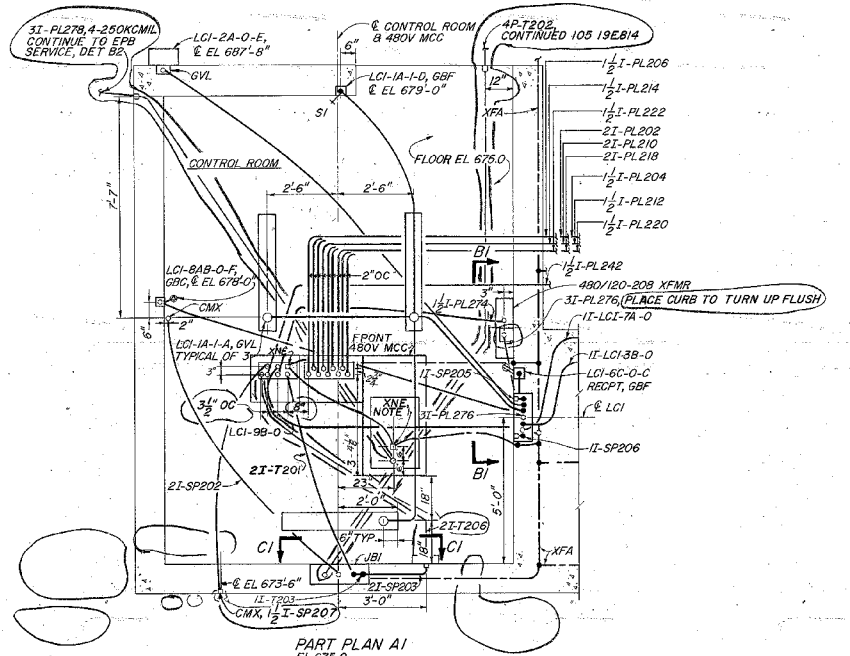

PART PLAN A1
EL 675.0
CONTROL ROOM
2\"/>

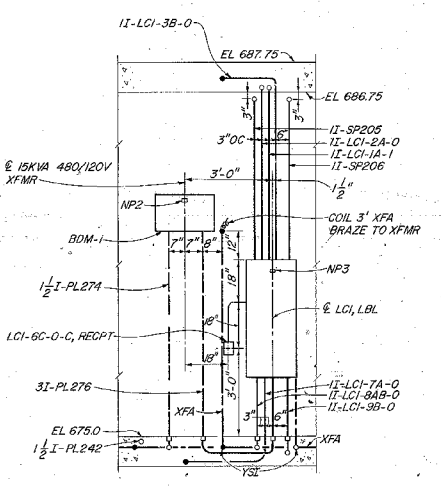

BI-BI
1/2\"/>

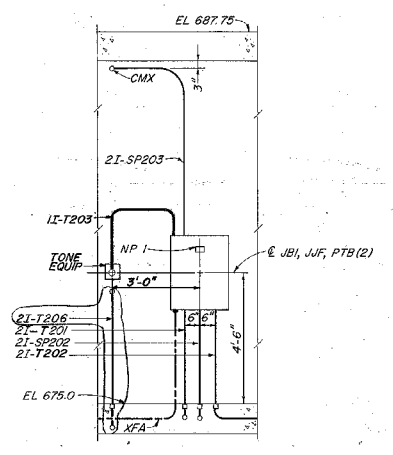


CI-CI
1/2\"/>

NO.	DESCRIPTION	QTY	UNIT
1	CONTROL RM LTS 1	20	20
2	EXTERIOR LTS 3	20	20
3	EXTERIOR LTS 5	20	20
4	EXTERIOR LTS 7	20	20
5	EXTERIOR LTS 9	20	20
6	CONT. RM CONVENIENCE RECPT	20	20
7	EXTERIOR CONVENIENCE RECPT	20	20
8	208V CONVENIENCE RECPT	20	20
9	MCC STRIP HEATER	20	20
10	1-3/C NO.8, PL.277	20	20

DET E1
LIGHTING CABINET NO. 1
CIRCUIT DESIGNATIONS
NTS

SCALE: 1/4\"/>

COMPANION DRAWING:
105-19E806-2

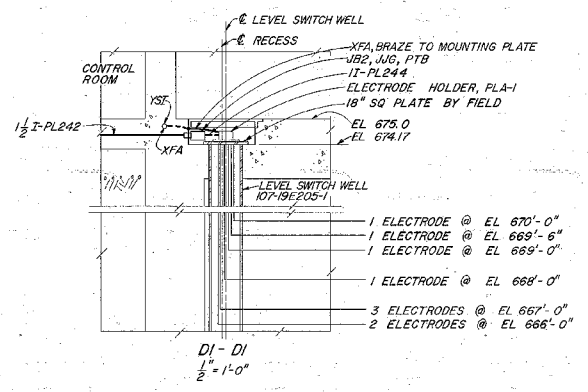

DI-DI
1/2\"/>

NO.	DATE	BY	CHKD.	APP'D.	DESCRIPTION
1	10-2-77	W.H. HARRISON	G.P. DILLON	J.M. HARRISON	ISSUED FOR PERMIT
2	11-2-77	D.C. HARRISON	W.H. HARRISON	J.M. HARRISON	MINOR REVISION
3	10-2-77	W.H. HARRISON	G.P. DILLON	J.M. HARRISON	MINOR REVISION

CHATTANOOGA FLOOD PROTECTION
PUMPING STATION NO. 2

CONDUIT & GROUNDING & LIGHTING
GENERAL ARRANGEMENT
PLAN & DETAILS

SOUTH CHICKAMAUGA CREEK PROJECT
TENNESSEE VALLEY AUTHORITY
DIVISION OF ENGINEERING DESIGN


INSPECTED AND APPROVED FOR ISSUE:
W.H. HARRISON

APPROVED:
George Dillman, John E. Harkley


KNOXVILLE 1-25-77 81 E 105-19E806-1 R3

RECORD DRAWING AS CONSTRUCTED 7 PL. #3
FRANK VAN MEER R5

A
B
C
D
E
F
G
H
J
K

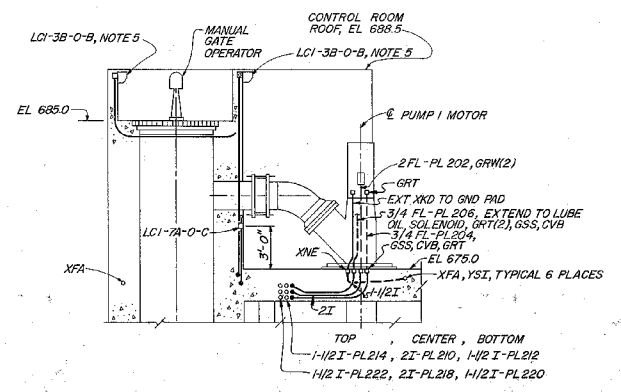

A2-A2
TYPICAL PUMP MOTOR INSTALLATION
SH 1, C4

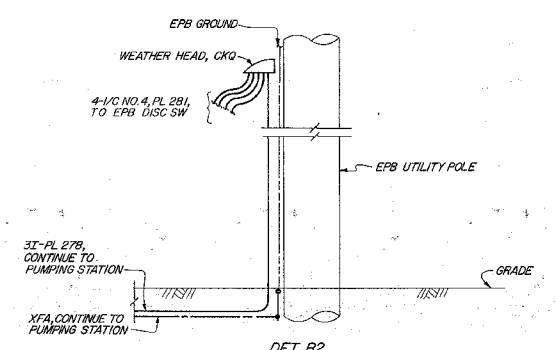

DET B2
EPB SERVICE
SH 1, H2
NTS

FOR NOTES AND REFERENCES
SEE 105-19E806-1.

NAME PLATE INDEX

MP NO.	TYPE	NUMBER	FIRST LINE	SECOND LINE	THIRD LINE
1	A	1	TELEPHONE TERM CAB		JB1
2	A	1		480V/120-208V XFMR	
3	A	1		LC1	3 @ 2.4W/120-208V

JUNCTION BOX INDEX

NO.	MK	SIZE (INCHES)			LOCATION	USAGE	JP NO.
		H	W	D			
1	JJF	30	24	8	SECT C1-C1	TELEPHONE TERM CAB	1
2	JJG	12	6	4	SECT D1-D1	TERM BOX, PL241, PL243	

LIGHTING FIXTURE SCHEDULE

DESCRIPTION	FIXTURE TYPES						MK LTR TOTALS
	A	B	C	D	E	F	
WALL LIGHT 100W, HIGH PRESS. SODIUM, HOLOPHANE, 486-120.		1					5
WALL LIGHT 100W, HIGH PRESS. SODIUM, WITH PHOTO CONTROL, HOLOPHANE, 487-120.					1		1
FLUORESCENT UNIT 2-40W, SURFACE MOUNTED, DAY BRITE, 48240-4.		1					3
LAMP 40 W COOL WHITE, RAPID START, GE F40 CW.		2					6
LAMP 100W, HIGH PRESS. SODIUM, MAGUL BASE, 120 V, GE LU100/BU		1			1		6
DUPLEX RECEPTACLE 2P-20A, 3W GROUNDING, HUBBELL 5362, FOR 120V USE.				1			3
RECEPTACLE, 2P-3W GROUNDING, HUBBELL 9330, FOR 208V USE.						1	1
COVER PLATE WITH SPRING DOOR COVER FOR USE WITH LR B-8, CAST ALUMINUM, CROUSE-HINDS DS-10306.						1	1
TUMBLER SWITCH, 1P, 20A, 277V, HUBBELL 1221.				1			1
SWITCH PLATE HINGED COVER, CAST ALUMINUM, HUBBELL 7450.					1		1
RECEPTACLE COVER, CAST ALUMINUM SPRING DOORS WITH GASKET, FOR USE WITH LRB-7, HUBBELL 5206.						1	3

* SEE TVA DWG GE 4 30A 360

SCALE: 1/8" = 1'-0"
EXCEPT AS NOTED

COMPANION DRAWING:
105-19E806-1

INSPECTED AND APPROVED FOR ISSUE


MINOR REVISION											
NO.	DATE	BY	CHKD	APPV	REASON						
1	6-9-77	W.H. HAINWOOD									
CHATTANOOGA FLOOD PROTECTION PUMPING STATION NO.2											
CONDUIT & GROUNDING & LIGHTING GENERAL ARRANGEMENT PLAN & DETAILS											
SOUTH CHICKAMAUGA CREEK PROJECT TENNESSEE VALLEY AUTHORITY DIVISION OF ENGINEERING DESIGN											
SUBMITTED				RECOMMENDED				APPROVED			
W.H. HAINWOOD George D. ... John S. ... KNOXVILLE 1-25-77 81 E 105-19E806-2 R 1											
RECORD DRAWING AS CONSTRUCTED 7 FEB 83											
PAUL VAL METER 21											

PRINT	1	2									
SIZE	11	12									


W
ED
A1

I
I

A
B
C
D
E
F
G
H
J
K

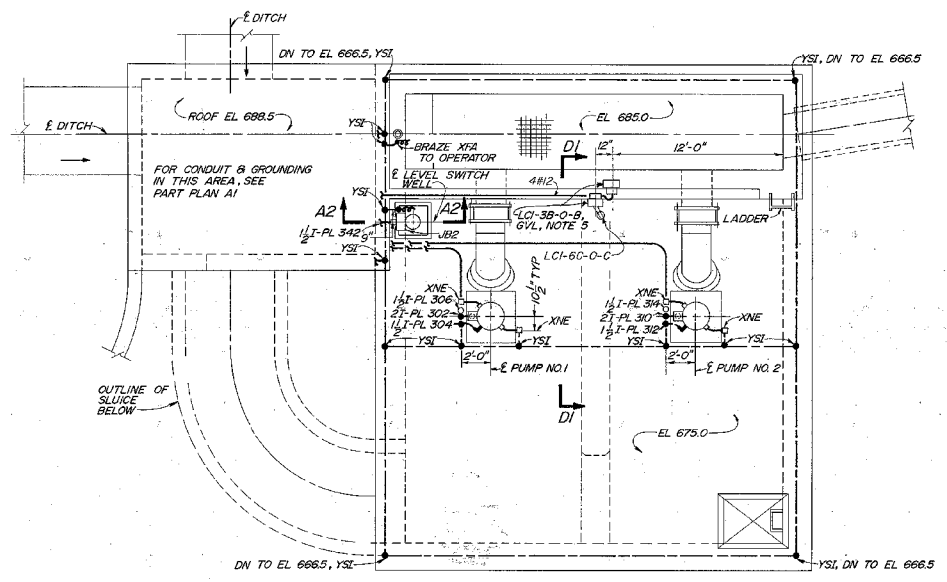

PLAN EL 688.5

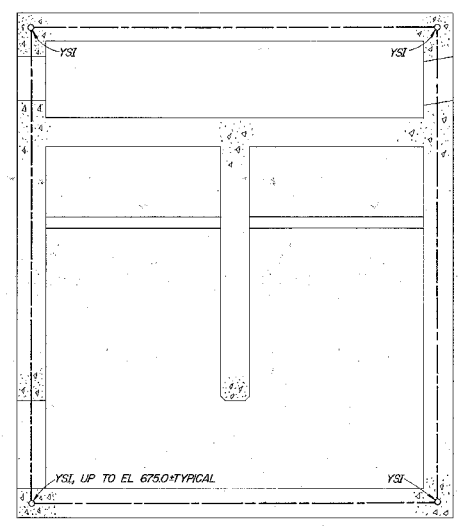


PLAN EL 666.5

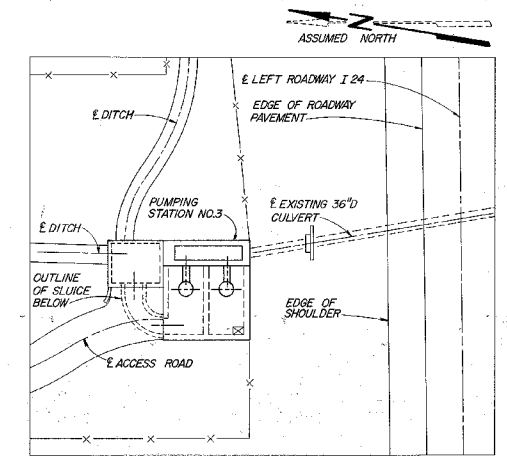


KEY PLAN
1"=20'-0"


- NOTES:
- USE XFA, YCC TO CONNECT TO GROUND BUS IN BOARD.
 - ALL LIGHTING CIRCUITS ARE 1" IRON CONDUIT WITH 2C NO.12 AWG CABLE UNLESS OTHERWISE NOTED.
 - ALL GROUND CABLE IS 850KCMIL XFA UNLESS OTHERWISE NOTED.
 - LIGHTING BRANCH CIRCUIT CONDUCTORS ARE COLOR CODED: BLACK-PHASE A, RED-PHASE B, BLUE-PHASE C. LIGHTING CABINET IS BUSSED PHASE A, PHASE B & PHASE C FROM LEFT TO RIGHT WHEN VIEWING FRONT CABINET.
 - MOUNT OUTLET BOX, GVL, FOR EXTERIOR LIGHTS 8" 10" BELOW WALL UNLESS OTHERWISE NOTED.
 - THE CIRCUIT INDEX CARD LOCATED ON LCI SHALL BE LABELED PER DETAIL E1.
 - FIELD TO GROUND ALL STRUCTURAL STEEL, EQUIPMENT FRAMING, AND MISC. STEEL.
- REFERENCE DRAWINGS:
105-19C-800-CONDUIT & CABLE SCHEDULE
105-19B-912-BILL OF MATERIAL

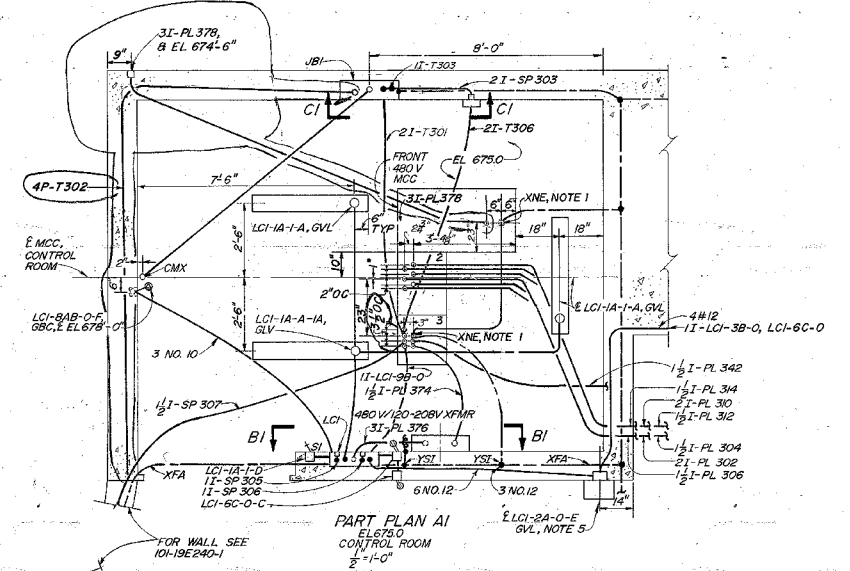

PART PLAN A1
EL 675.0
CONTROL ROOM
2'-1'-0"

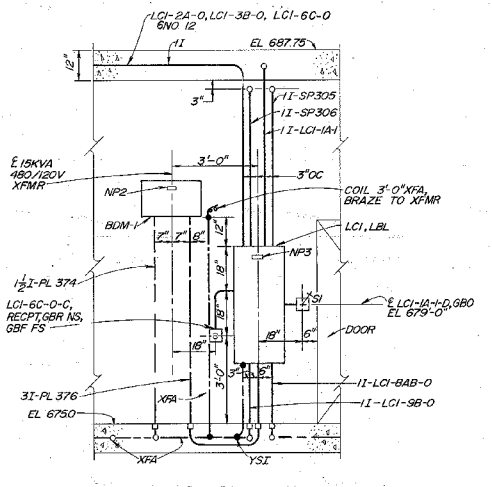


BI-BI
1/2"-1'-0"

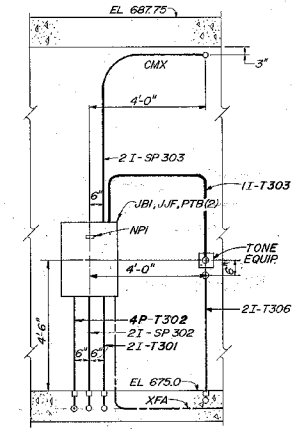


CI-CI
1/2"-1'-0"


- SYMBOLS:
- EXPOSED CONDUIT TURNING DOWN
 - EMBEDDED CONDUIT TURNING UP
 - 120V AC DUPLEX OUTLET
 - 208V AC SINGLE OUTLET
 - SINGLE POLE SWITCH

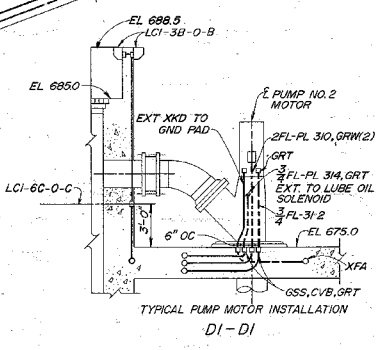

TYPICAL PUMP MOTOR INSTALLATION
DI-DI

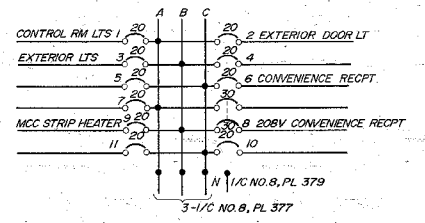

DETAIL E1
LIGHTING CABINET NO.1
CIRCUIT DESIGNATIONS
NTS

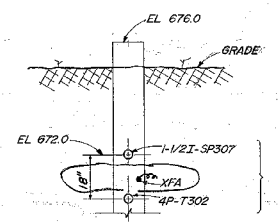

FI-FI
CONDUIT AT FACE OF
RETAINING WALL
1/2"=1'-0"

FOR CONTINUATION
SEE 105-19E814

SCALE: 1/4"=1'-0"
EXCEPT AS NOTED.
COMPANION DRAWING:
105-19E812-2

NO.	DATE	DESCRIPTION	BY	CHECKED
2	12-27-77	RELOCATED PL 378, T-302	W.H. DUNN	J.M. WILSON
3	8-1-78	REVISION	W.H. DUNN	J.M. WILSON
4	11-3-77	REVISION	W.H. DUNN	J.M. WILSON

CHATTAHOOGA FLOOD PROTECTION
PUMPING STATION NO. 3

CONDUIT & GROUNDING & LIGHTING
GENERAL ARRANGEMENT
PLAN & DETAILS

SOUTH CHICKAMAUGA CREEK PROJECT
TENNESSEE VALLEY AUTHORITY
DIVISION OF ENGINEERING DESIGN

INSPECTED AND APPROVED FOR ISSUE: *[Signature]*
DATE: 1-25-77


RECOMMENDED: *[Signature]*
DATE: 1-25-77

APPROVED: *[Signature]*
DATE: 1-25-77


NO. 105-19E812-1
PAGE NO. 1 OF 1

PRINT	4	7	2	1
SIZE	F	3	3	3

A
B
C
D
E
F
G
H
J
K

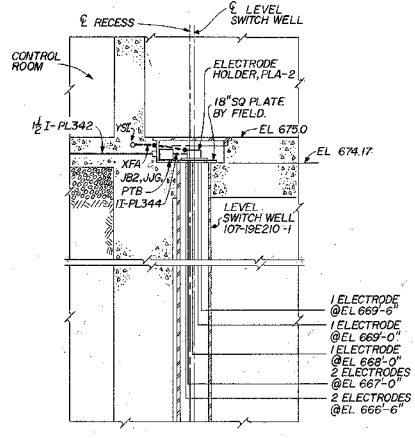

A2-A2
SH 1, B3
2 = 1'-0"

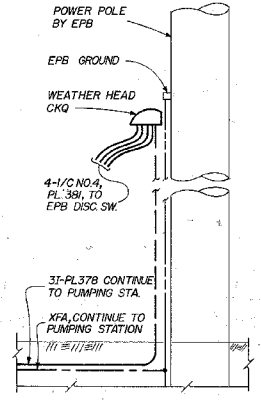

DET B2
EPB SERVICE
SH 1, E2
NTS

- 1 ELECTRODE @ EL. 669'-0"
- 1 ELECTRODE @ EL. 669'-0"
- 1 ELECTRODE @ EL. 669'-0"
- 2 ELECTRODES @ EL. 667'-0"
- 2 ELECTRODES @ EL. 666'-6"

FOR NOTES AND REFERENCES SEE 105-19E812-1.

NAME PLATE INDEX

NP NO.	TYPE	FIRST LINE	SECOND LINE	THIRD LINE
1	A	TELEPHONE TERM CAB		JBI
2	A	480V 120-208V XFMR		
3	A	LCI	3 # 4W, 120-208V	

*SEE T14 DWG NO GE 30A360

JUNCTION BOX INDEX

NO.	MARK	SIZE (INCHES)			LOCATION	USAGE	NP NO.
		H	W	D			
1	JJF	30	24	8	SECT CI-CI	TELEPHONE TERM CAB.	1
2	JJB	12	6	4	SECT A2-A2	TERMINAL BOX PL 341, PL 343	

LIGHTING FIXTURE SCHEDULE

DESCRIPTION	FIXTURE TYPES	MARK						MARK LTR	TOTALS
		A	B	C	D	E	F		
WALL LIGHT, 100W, HIGH PRESS. SODIUM, HOLOPHANE, 486-120	LOK1		1					2	
WALL LIGHT, 100W, HIGH PRESS. SODIUM, WITH PHOTO CONTROL, HOLOPHANE, 487-120	LOK2				1			1	
FLORESCENT UNIT 2-40W, SURFACE MOUNTED, DAY BRITE, 48240-4	LHD	1						3	
LAMP, 40W COOL WHITE, RAPID START, GE F40 CW.	LPA-1	2						6	
LAMP, 100W, HIGH PRESS. SODIUM, MDCIL BASE, 120V, GE LU100/BU	LPP-1		1					3	
DUPLEX RECEPTACLE, 2P, 20A, 3W GROUNDING, HUBBELL 5362, FOR 120 V USE.	LRF-1			1				2	
RECEPTACLE, 2P-3W GROUNDING, HUBBELL 9330, FOR 208V USE.	LRB-6					1		1	
COVER PLATE WITH SPRING DOOR COVER, FOR USE WITH LRB-6, CAST ALUMINUM, CROUSE-HINDS DS-10306.	LRB-9						1	1	
TUMBLER SWITCH, 1P, 20A, 277V, HUBBELL 1221.	LSE				1			1	
SWITCH PLATE, HINGED COVER CAST ALUMINUM, HUBBELL 7420.	LVD					1		1	
RECEPTACLE COVER, CAST ALUMINUM, SPRING DOORS WITH GASKET FOR USE WITH LRB-7 HUBBELL 5206.	LVO						1	2	

SCALE: 1/8" = 1'-0"
EXCEPT AS NOTED
COMPANION DRAWING: 105-19E812-1

1		6/29/77		REVISION		DATE		BY		APP	
MINOR REVISION.											
DESIGN	DRWN	CHKD	APPV	ENGR							
J.T. KING	J.A. WINTER	J.T. KING	J.T. KING	R.W. STEWART							
CHATTANOOGA FLOOD PROTECTION PUMPING STATION NO. 3											
CONDUIT & GROUNDING & LIGHTING GENERAL ARRANGEMENT PLAN & DETAILS											
SOUTH CHICKAMAUGA CREEK PROJECT TENNESSEE VALLEY AUTHORITY DIVISION OF ENGINEERING DESIGN											
SUBMITTED			RECOMMENDED			APPROVED					
W.H. DANWOOD			George D. Williams			John C. Williams					
KNOXVILLE		1-25-77		81 E		105-19E812-2		R1			

INSPECTED AND APPROVED FOR ISSUE

PRINT


SIZE

SCALE


DATE

BY


APP

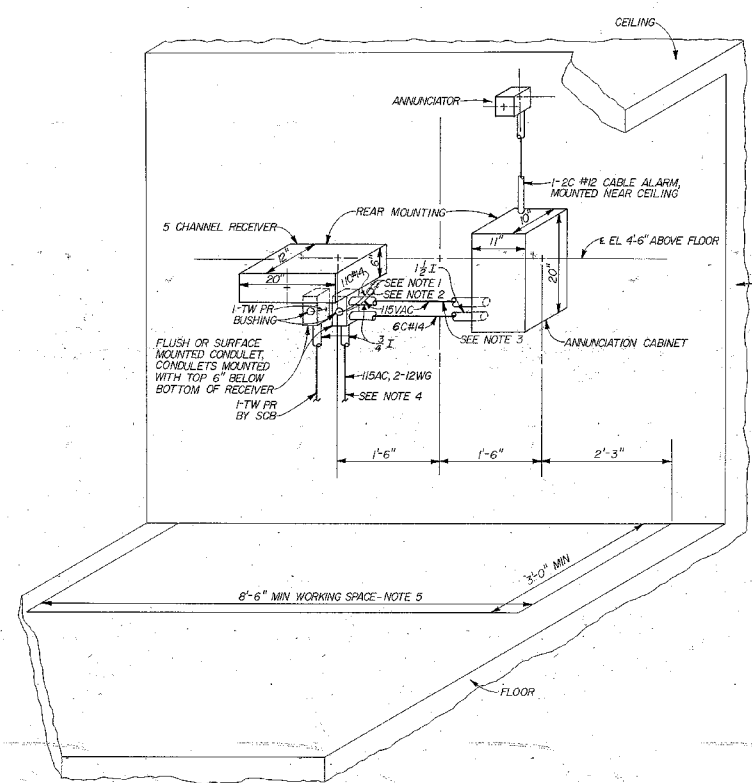

CENTRAL CONTROL CENTER
WORKING SPACE REQUIREMENTS
1"=1'-0"

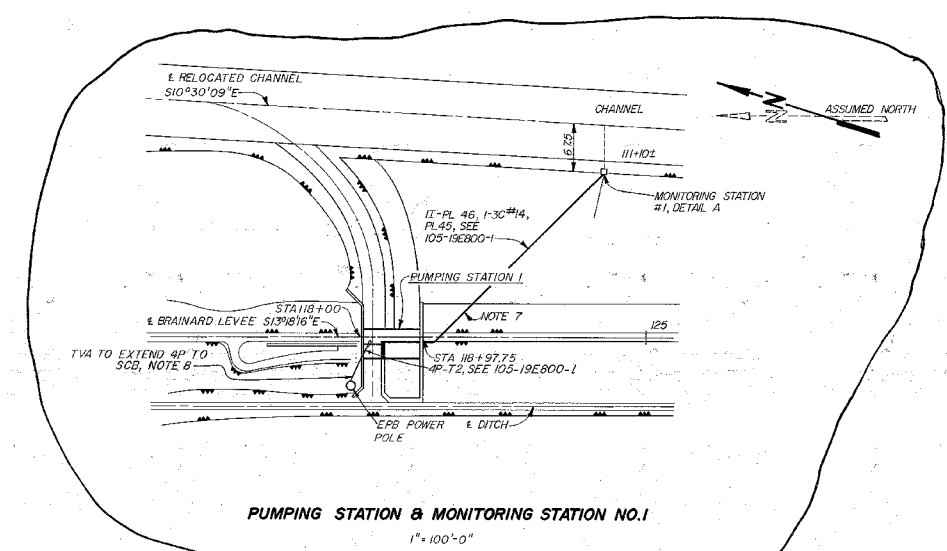


HOLD

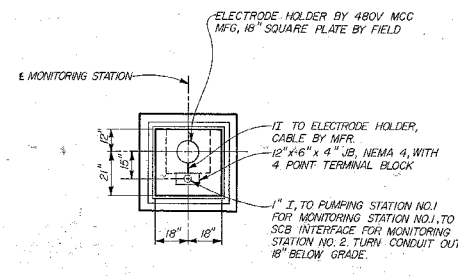


DETAIL A
MONITORING STATIONS 1 & 2, NOTE 6
3/8"=1'-0"

- NOTES:
1. RUN EXPOSED TO RECEIVER
 2. 110V AC AND TEL (1-TW-PR) 1-1/2" CABLE, STA GND CONDUCTOR TO ANN. CABINET
 3. 1-1/2" COND CABLE, 115V AC (2-#12AWG) SPliced TO FEEDER IN JB, STA GND CONDUCTOR
 4. 115V AC, 60 HZ FEEDER FUSED FOR 15A, STA GND CONDUCTOR
 5. WORKING SPACE MAY BE OCCUPIED BY REMOVABLE EQUIPMENT
 6. FOR LOCATION OF MONITORING STATIONS 1 & 2 SEE 104-9E220
 7. FIELD TO INSTALL PULL POINTS AS NEEDED TO MEET FIELD CONDITIONS
 8. TELEPHONE CABLE SUPPLIED BY SOUTH CENTRAL BELL

REFERENCE DRAWINGS:
105-19800 CONDUIT & CABLE SCHEDULE
105-19820 CONNECTION DIAGRAM

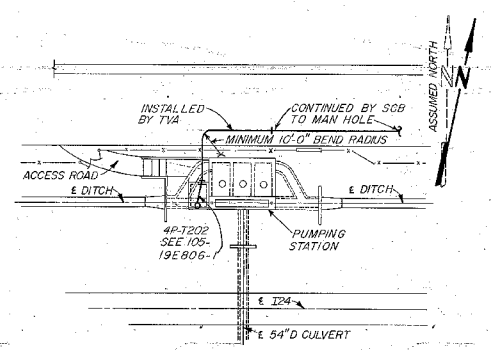

PUMPING STATION NO. 2
1"=40'-0"

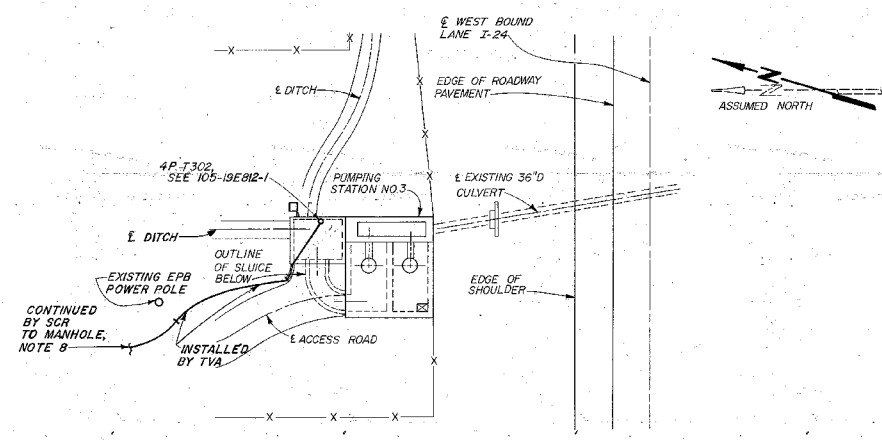

PUMPING STATION NO. 3
1"=20'-0"

REV NO.	REV NO.	DATE	BY	CHKD	APP'D	DATE	BY	CHKD	APP'D


SCALE: AS NOTED EXCEPT AS NOTED

CHATTANOOGA FLOOD PROTECTION


CONDUIT & GROUNDING GENERAL ARRANGEMENT PLANS & DETAILS

SOUTH CHICKAMAUGA CREEK PROJECT
TENNESSEE VALLEY AUTHORITY
DIVISION OF ENGINEERING DESIGN


INSPECTED AND APPROVED FOR ISSUE:	W. H. Woodward	RECOMMENDED:	George D. Holladay	APPROVED:	John E. Holladay
DATE:	KNOXVILLE 9-5-78	BY:	91 E	PROJECT NO.:	105-19E814
SIZE:	7 1/2 x 10 1/2	SCALE:	AS NOTED	RECORD DRAWING AS CONSTRUCTED:	7 1/2 x 10 1/2
PRINTED AT:	FRANK VAN NETER, INC.	DATE:	9-5-78	BY:	AD

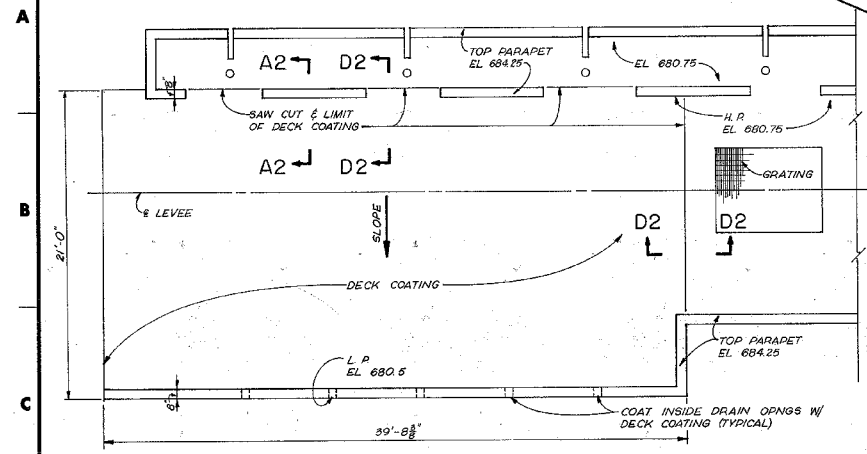


PART PLAN - EL 684.25
PUMPING STATION NO. 1

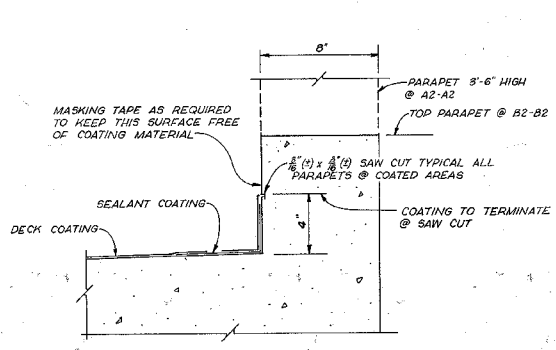


SECTION A2-A2 & B2-B2
3'-1'-0"

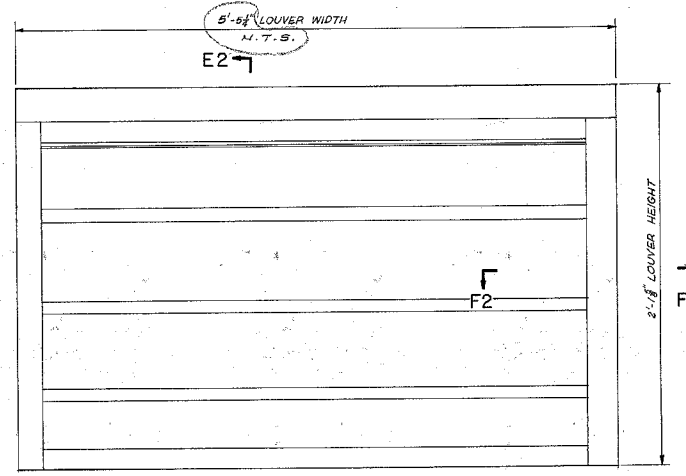


ELEVATION LOUVER - TYPE A

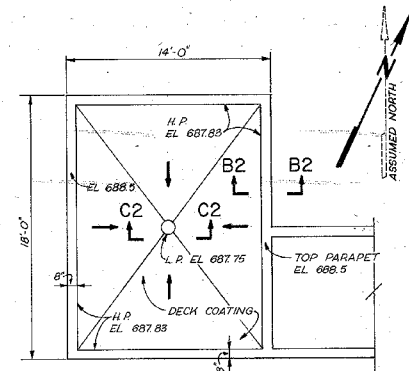


PART PLAN - EL 688.5
PUMPING STATION NO. 2

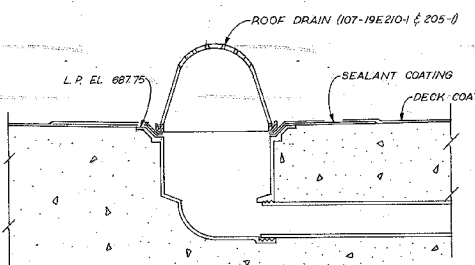

SECTION C2-C2
3'-1'-0"

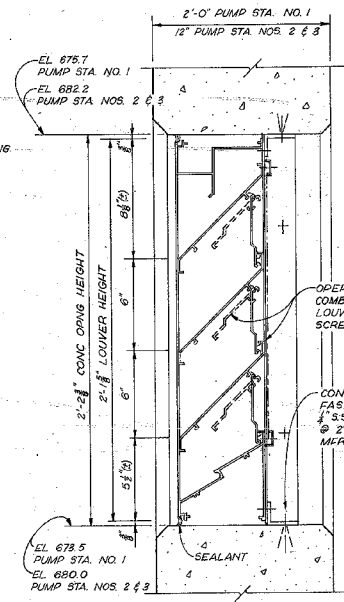


SECTION E2-E2

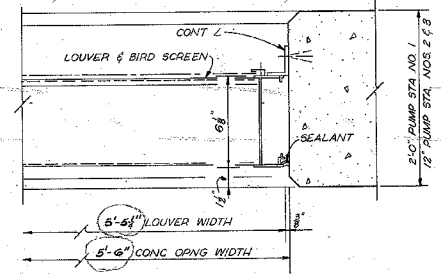


SECTION F2-F2

LOUVER SCHEDULE			
QUANTITY	TYPE	LOCATION	DRAWING REFERENCE NO.
1	A	PUMPING STATION NO. 1	101-19E225-2
1	A	PUMPING STATION NO. 2	101-19E235-2
1	A	PUMPING STATION NO. 3	101-19E240-3
3 TOTAL REQUIRED			

LOUVER DETAILS
3'-1'-0"

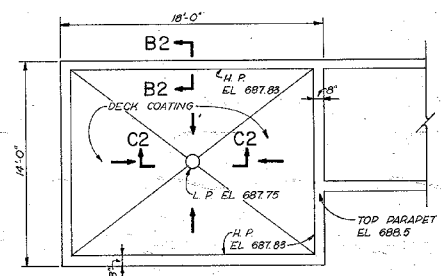

PART PLAN - EL 688.5
PUMPING STATION NO. 3

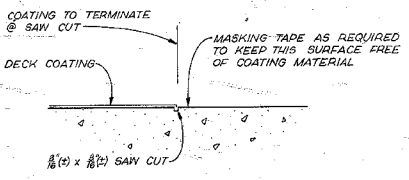

SECTION D2-D2
3'-1'-0"










CONTROL ROOM ROOF PLANS

SCALE: 1/4" = 1'-0"
EXCEPT AS NOTED

INSPECTED AND APPROVED FOR ISSUE
[Signature]

REV. NO.	DATE	BY	CHKD.	APPD.	REASON
CHATTANOOGA FLOOD PROTECTION PUMPING STATION NOS. 1, 2 & 3 ARCHITECTURAL ROOF PLANS & DETAILS LOUVER DETAILS SOUTH CHICKAMAUGA CREEK PROJECT TENNESSEE VALLEY AUTHORITY DIVISION OF ENGINEERING DESIGN					
SUBMITTED		RECOMMENDED		APPROVED	
<i>[Signature]</i>		<i>[Signature]</i>		<i>[Signature]</i>	
KNOXVILLE 3-22-77 81 A 106-19E200-2					

PRINT	1	2	3	4	5	6	7	8	9	10	11	12
SIZE	11	12	13	14	15	16	17	18	19	20	21	22

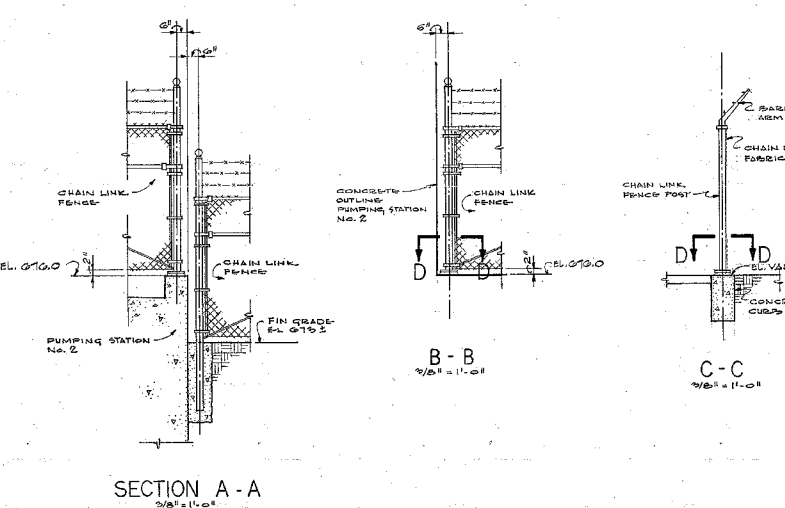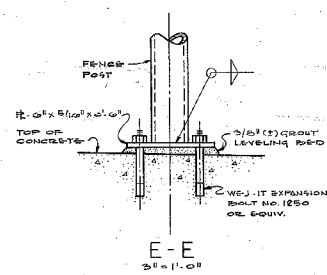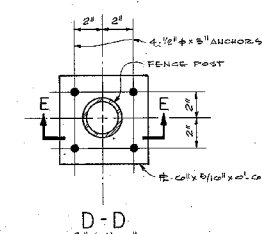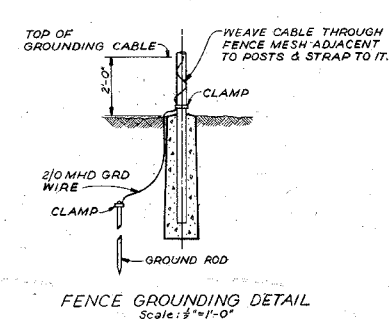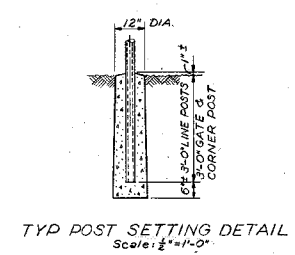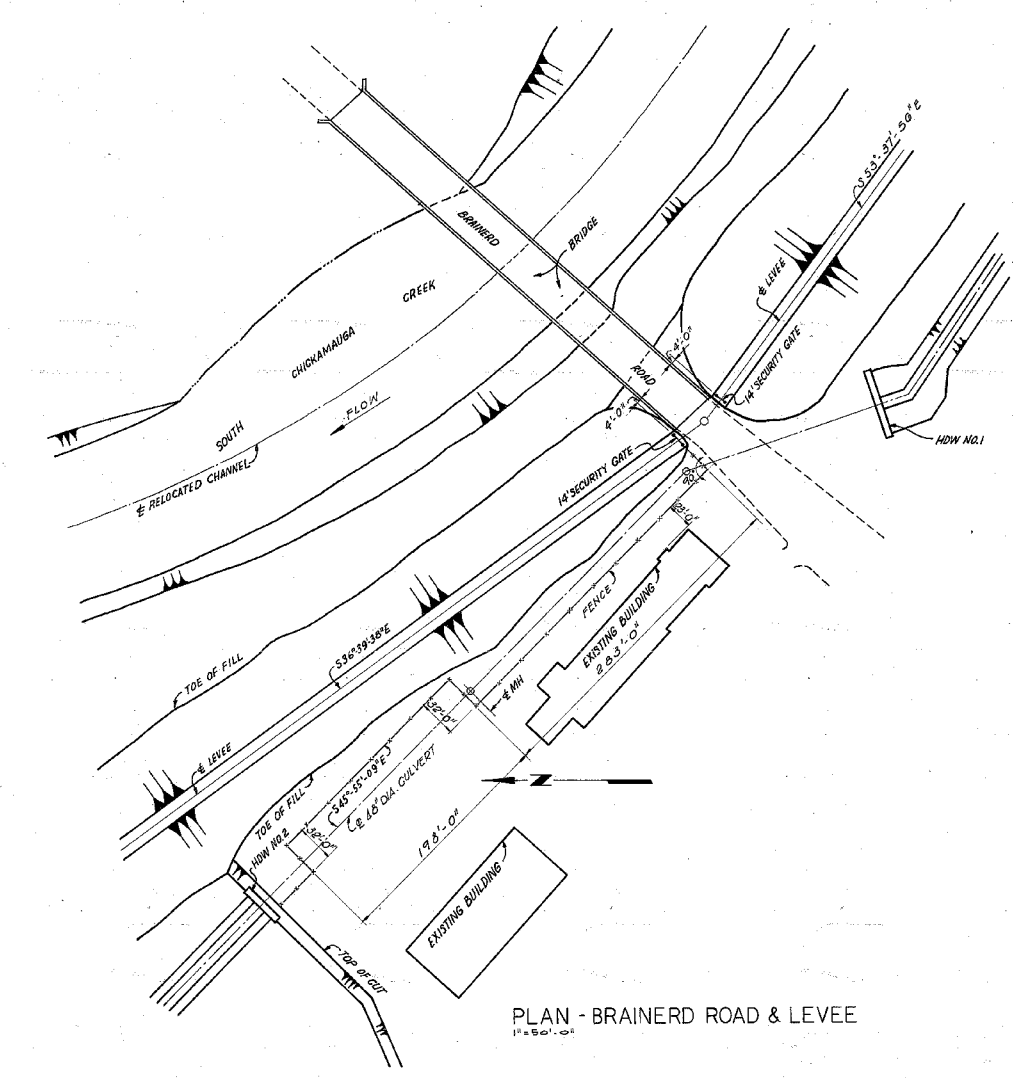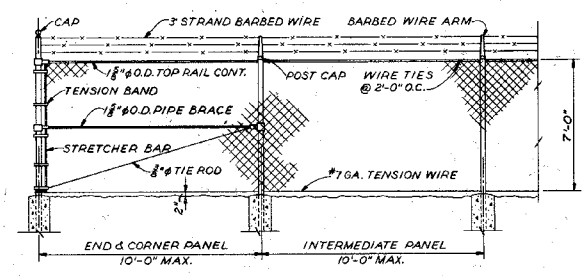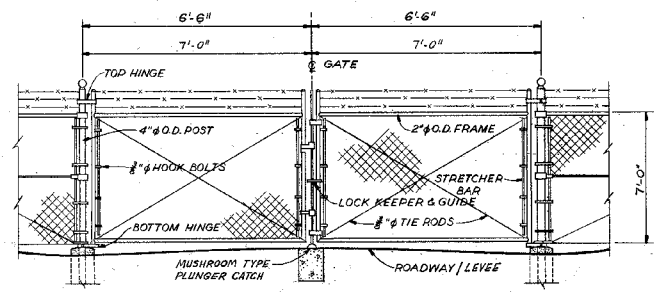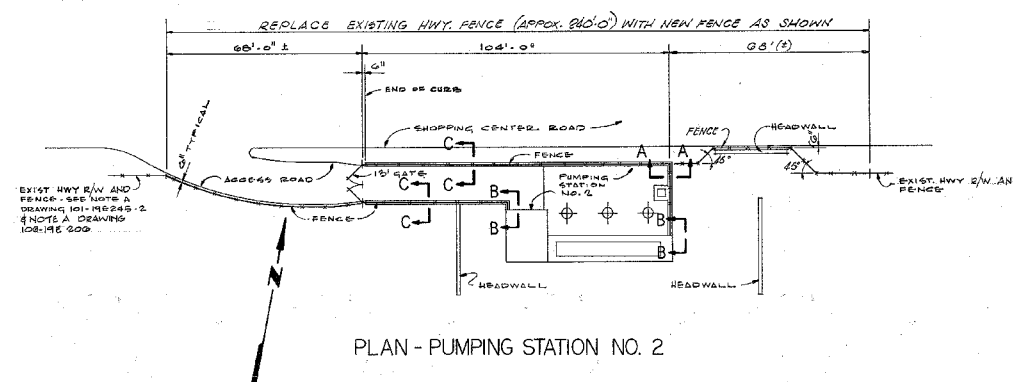

REV. NO.	CON. NO.	DATE	DESCRIPTION	DESIGNED BY	CHECKED BY	INSP. BY	APPROVED BY	DATE
SCALE 1" = 20'-0" EXCEPT AS NOTED								
CHATTANOOGA FLOOD PROTECTION								
CHAIN LINK FENCE								
ARCHITECTURAL								
PLANS & DETAILS								
SOUTH CHICKAMAUGA CREEK PROJECT								
TENNESSEE VALLEY AUTHORITY								
DIVISION OF ENGINEERING DESIGN								
SUBMITTED			RECOMMENDED			APPROVED		
INSPECTED AND APPROVED FOR ISSUE			ARCHITECT					
KNOXVILLE			6-9-78			81A 106-19E205		
RECORD DRAWING AS CONSTRUCTED								

COMPANION DRAWING: 106-19E206


INSPECTED AND APPROVED FOR ISSUE

ARCHITECT: M. J. ...

KNOXVILLE 6-9-78 81A 106-19E205

PRINT	1	2	2	2	2	2	2	2	2
SZ	1	2	3	4	5	6	7	8	9

RECORD DRAWING AS CONSTRUCTED

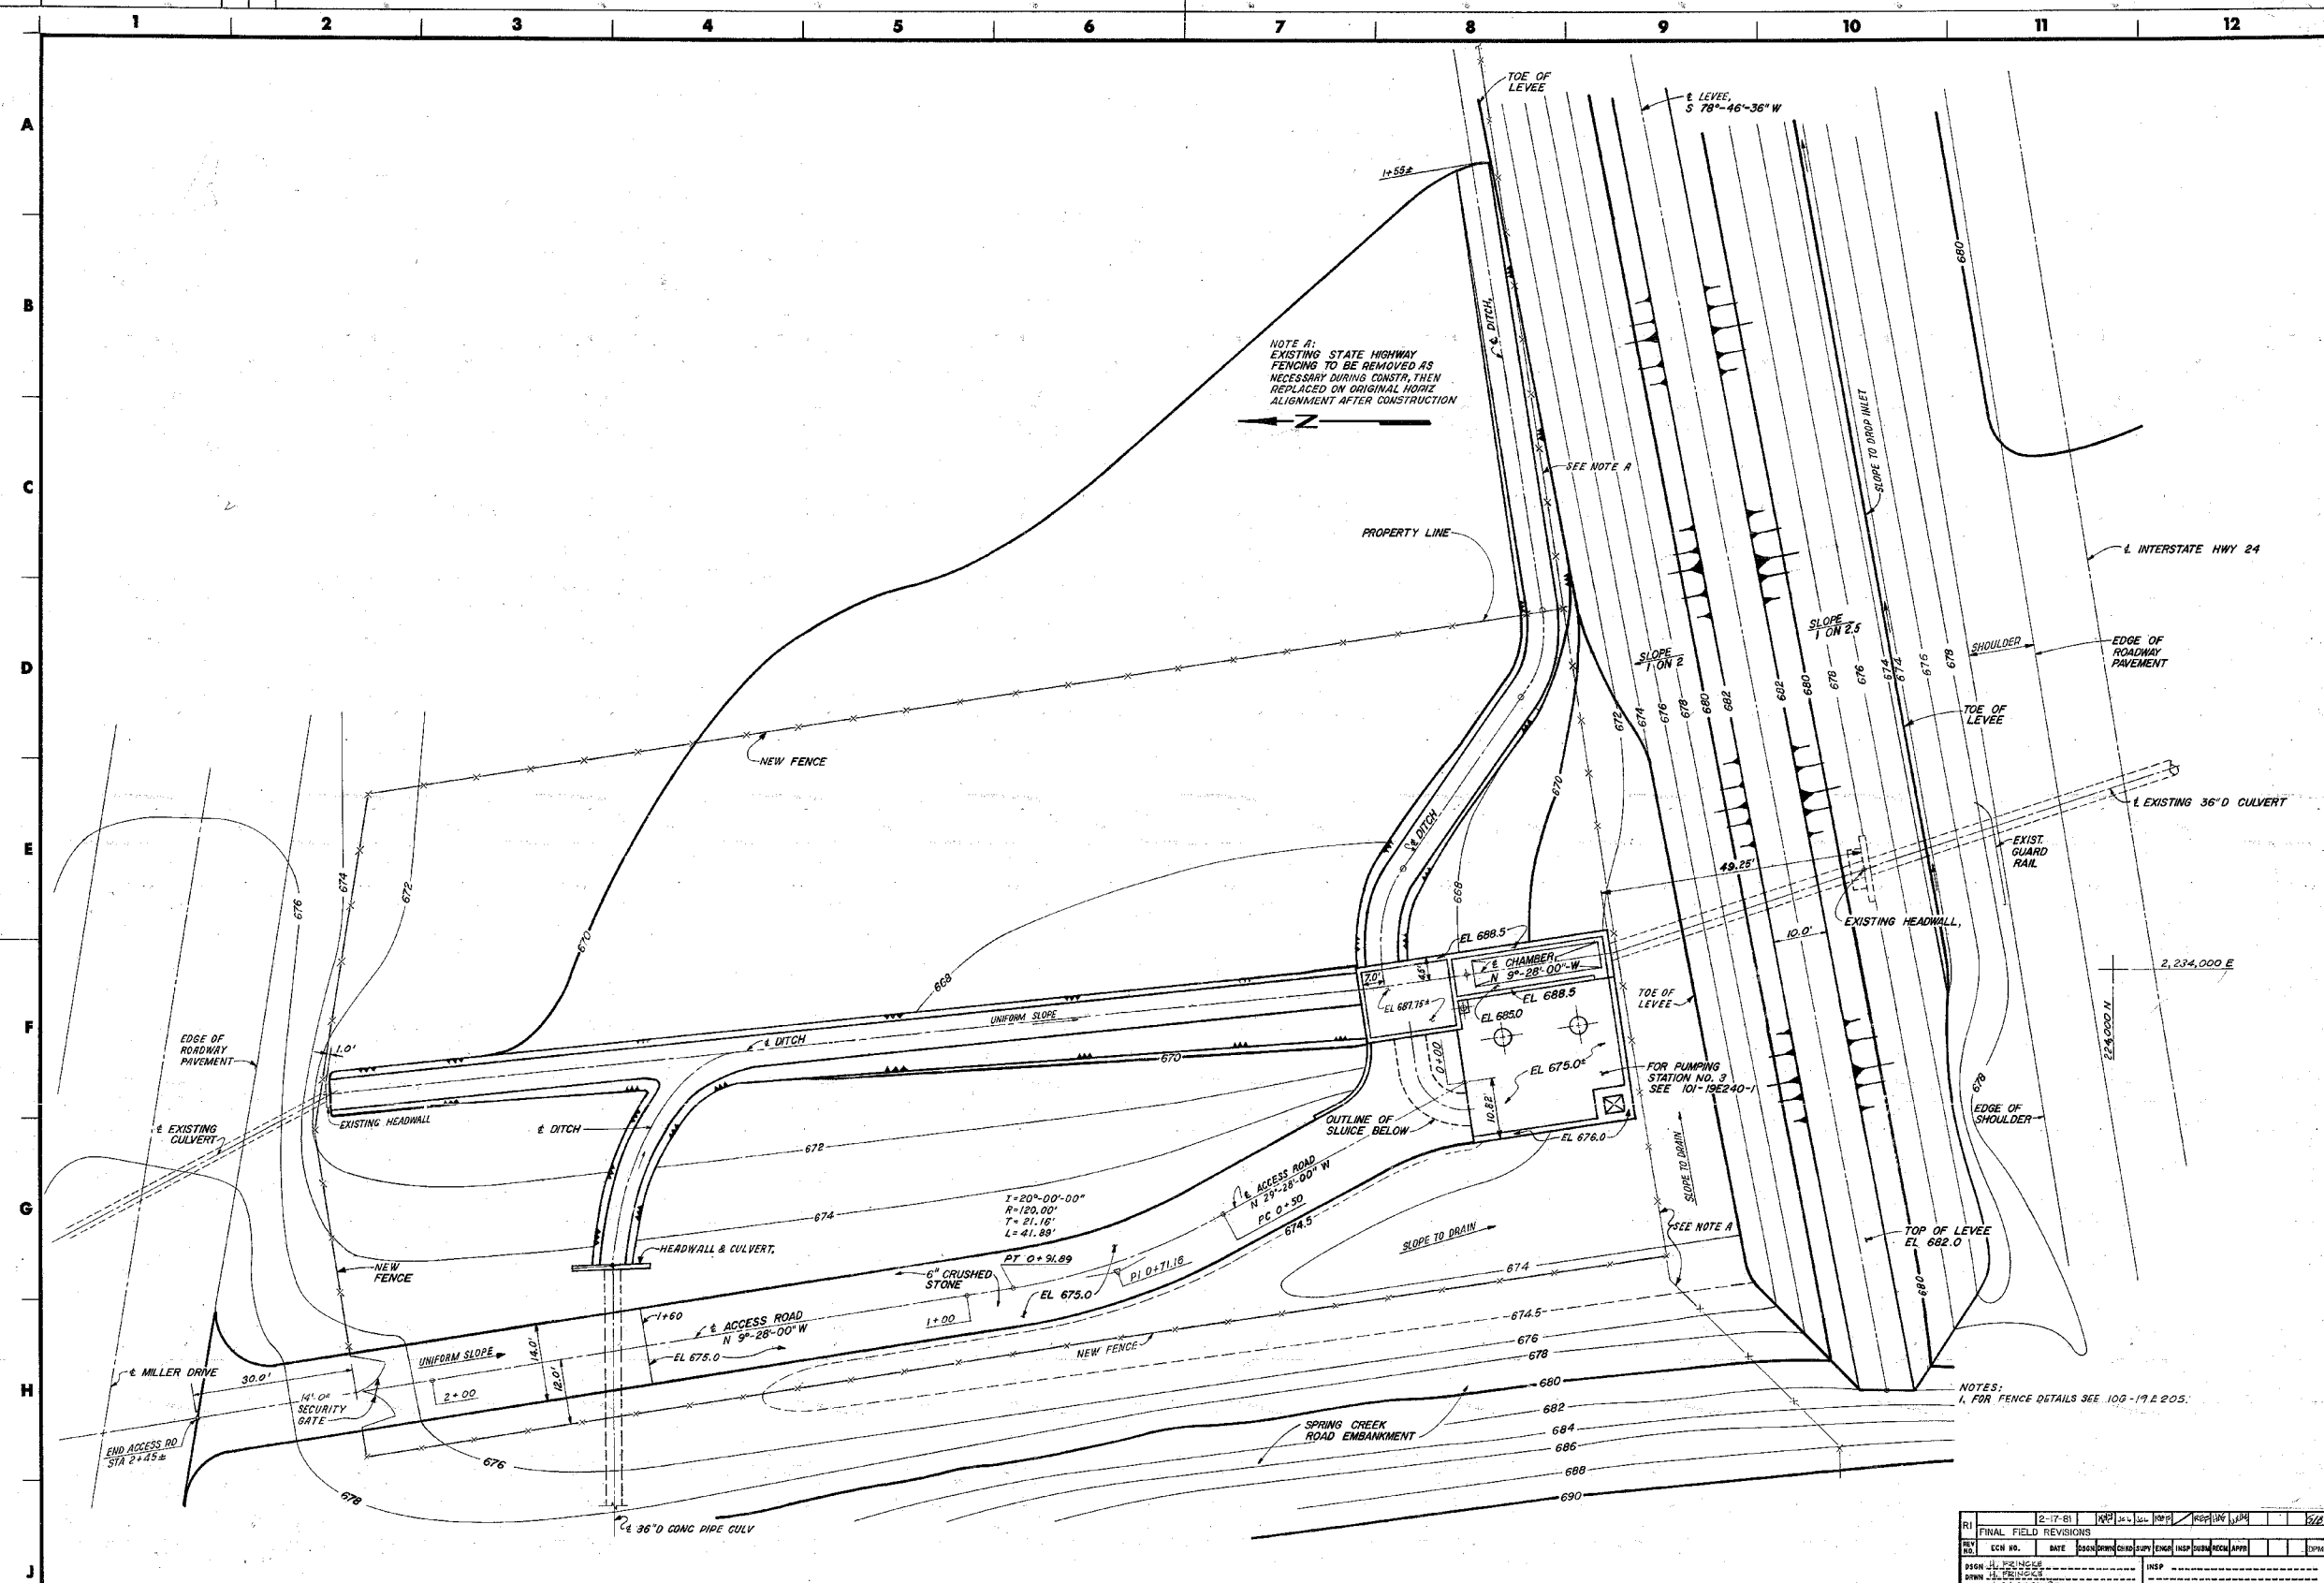

PLAN

NOTES:
1. FOR FENCE DETAILS SEE 100-19E205.

RI	2-17-81	REVISED	BY	DATE	REASON
RI	10-1-81	REVISED	BY	DATE	REASON
RI	10-1-81	REVISED	BY	DATE	REASON
CHATTANOOGA FLOOD PROTECTION
CHAIN LINK FENCE

ARCHITECTURAL
PLAN-PUMPING STATION NO.3

SOUTH CHICKAMAUGA CREEK PROJECT
TENNESSEE VALLEY AUTHORITY
DIVISION OF ENGINEERING DESIGN

SUBMITTED: [Signature] RECOMMENDED: [Signature] APPROVED: [Signature]

KNOXVILLE 5-9-78 81 A 106-19E206 RI


RECORDED AS CONSTRUCTED
JAN 27, 1981

SCALE 1"=10' EXCEPT AS NOTED
COMPANION DRAWING:
100-19E205


INSPECTED AND APPROVED FOR ISSUE
[Signature]

PRINT	IN	1	2
SIZE	F	3	4
NO. ON PRINT	1	2	3

106-19E206
81 A
106-19E206

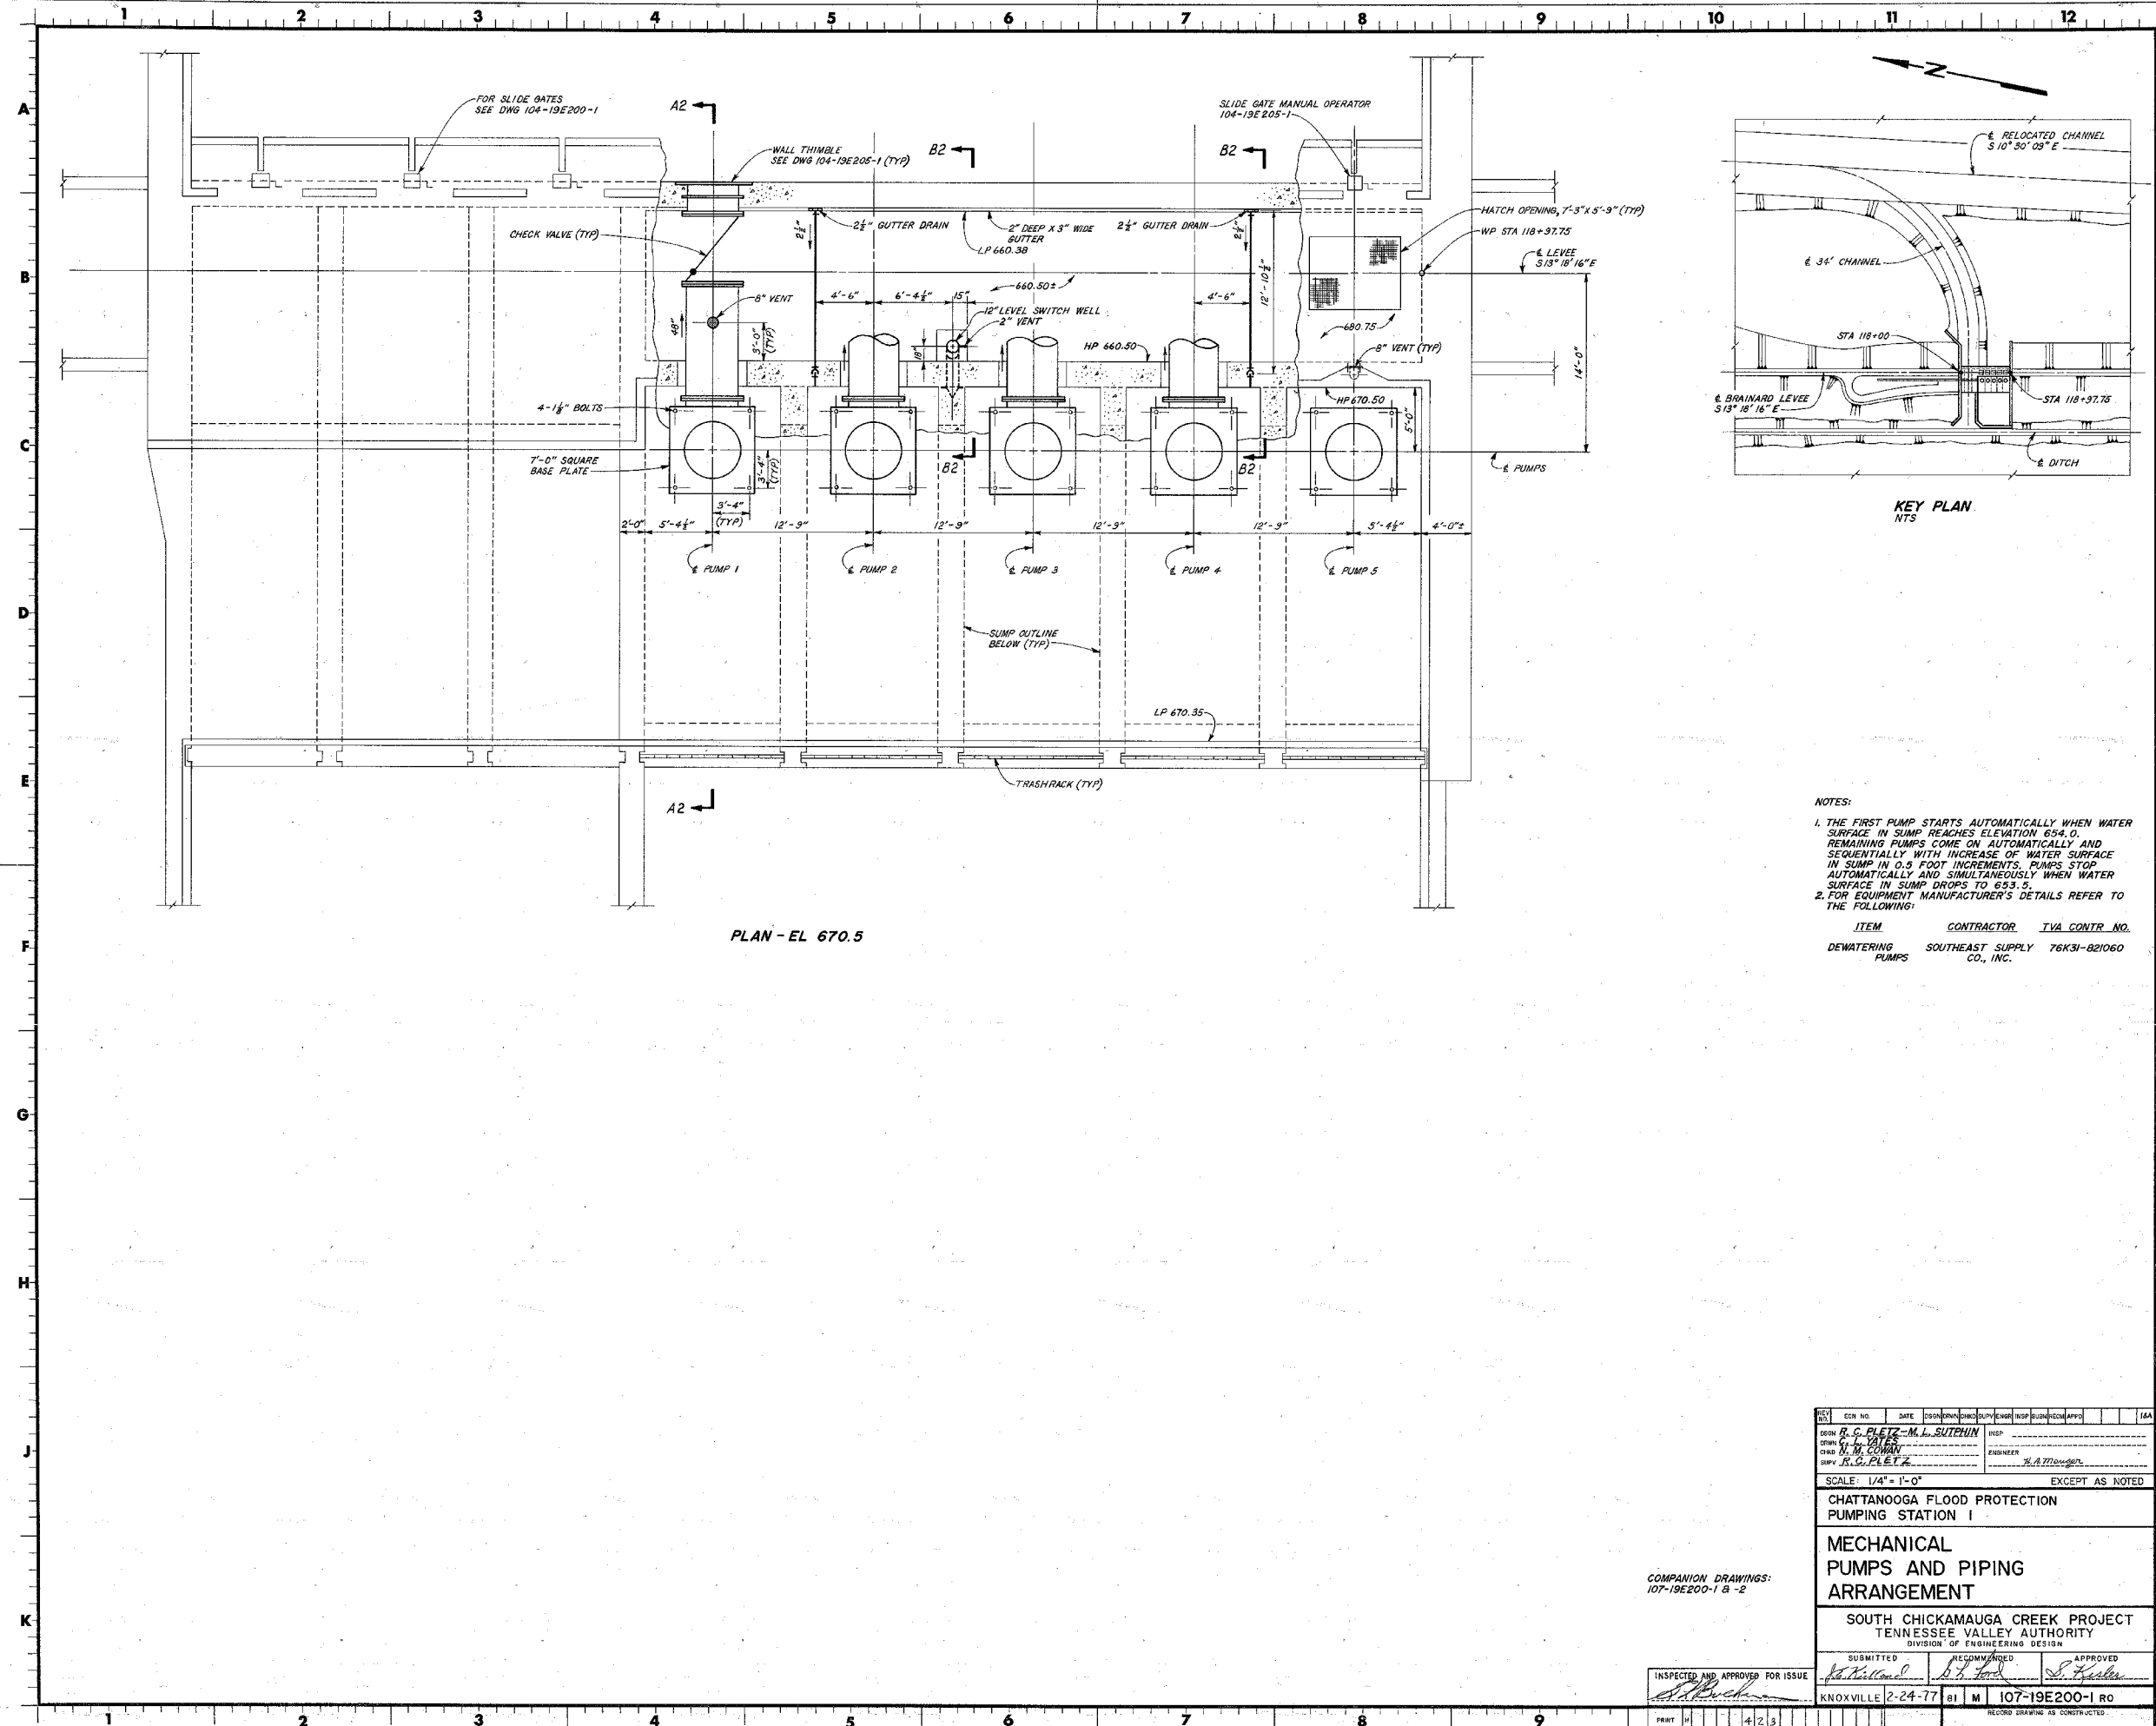

PLAN - EL 670.5

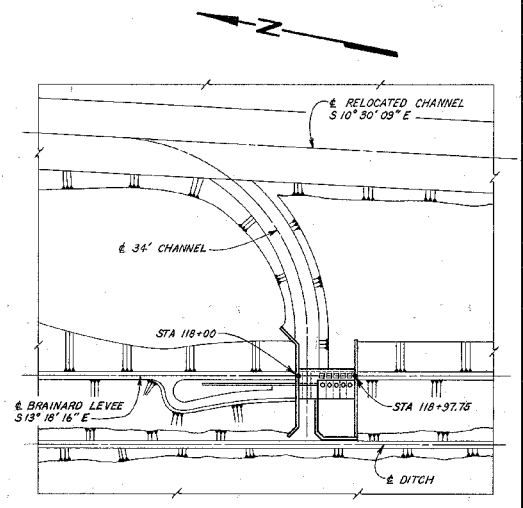

KEY PLAN
NTS

NOTES:
 1. THE FIRST PUMP STARTS AUTOMATICALLY WHEN WATER SURFACE IN SUMP REACHES ELEVATION 654.0. REMAINING PUMPS COME ON AUTOMATICALLY AND SEQUENTIALLY WITH INCREASE OF WATER SURFACE IN SUMP IN 0.5 FOOT INCREMENTS. PUMPS STOP AUTOMATICALLY AND SIMULTANEOUSLY WHEN WATER SURFACE IN SUMP DROPS TO 653.5.
 2. FOR EQUIPMENT MANUFACTURER'S DETAILS REFER TO THE FOLLOWING:

ITEM	CONTRACTOR	I.V.A. CONTR. NO.
DEWATERING PUMPS	SOUTHEAST SUPPLY CO., INC.	76K31-821060


COMPANION DRAWINGS:
107-19E200-1 B -2

INSPECTED AND APPROVED FOR ISSUE
[Signature]

DESIGNER R. C. PLETZ - M. L. SUTPHIN	CHECKED [Signature]
DRAWN BY R. C. PLETZ	ENGINEER [Signature]
SCALE: 1/4" = 1'-0" EXCEPT AS NOTED	
CHATTANOOGA FLOOD PROTECTION PUMPING STATION I	
MECHANICAL PUMPS AND PIPING ARRANGEMENT	
SOUTH CHICKAMAUGA CREEK PROJECT TENNESSEE VALLEY AUTHORITY DIVISION OF ENGINEERING DESIGN	
SUBMITTED [Signature]	APPROVED [Signature]
KNOXVILLE 2-24-77 61 M 107-19E200-1 RO	

PRINT	4	2	3
SIZE			

[Handwritten notes and signatures]

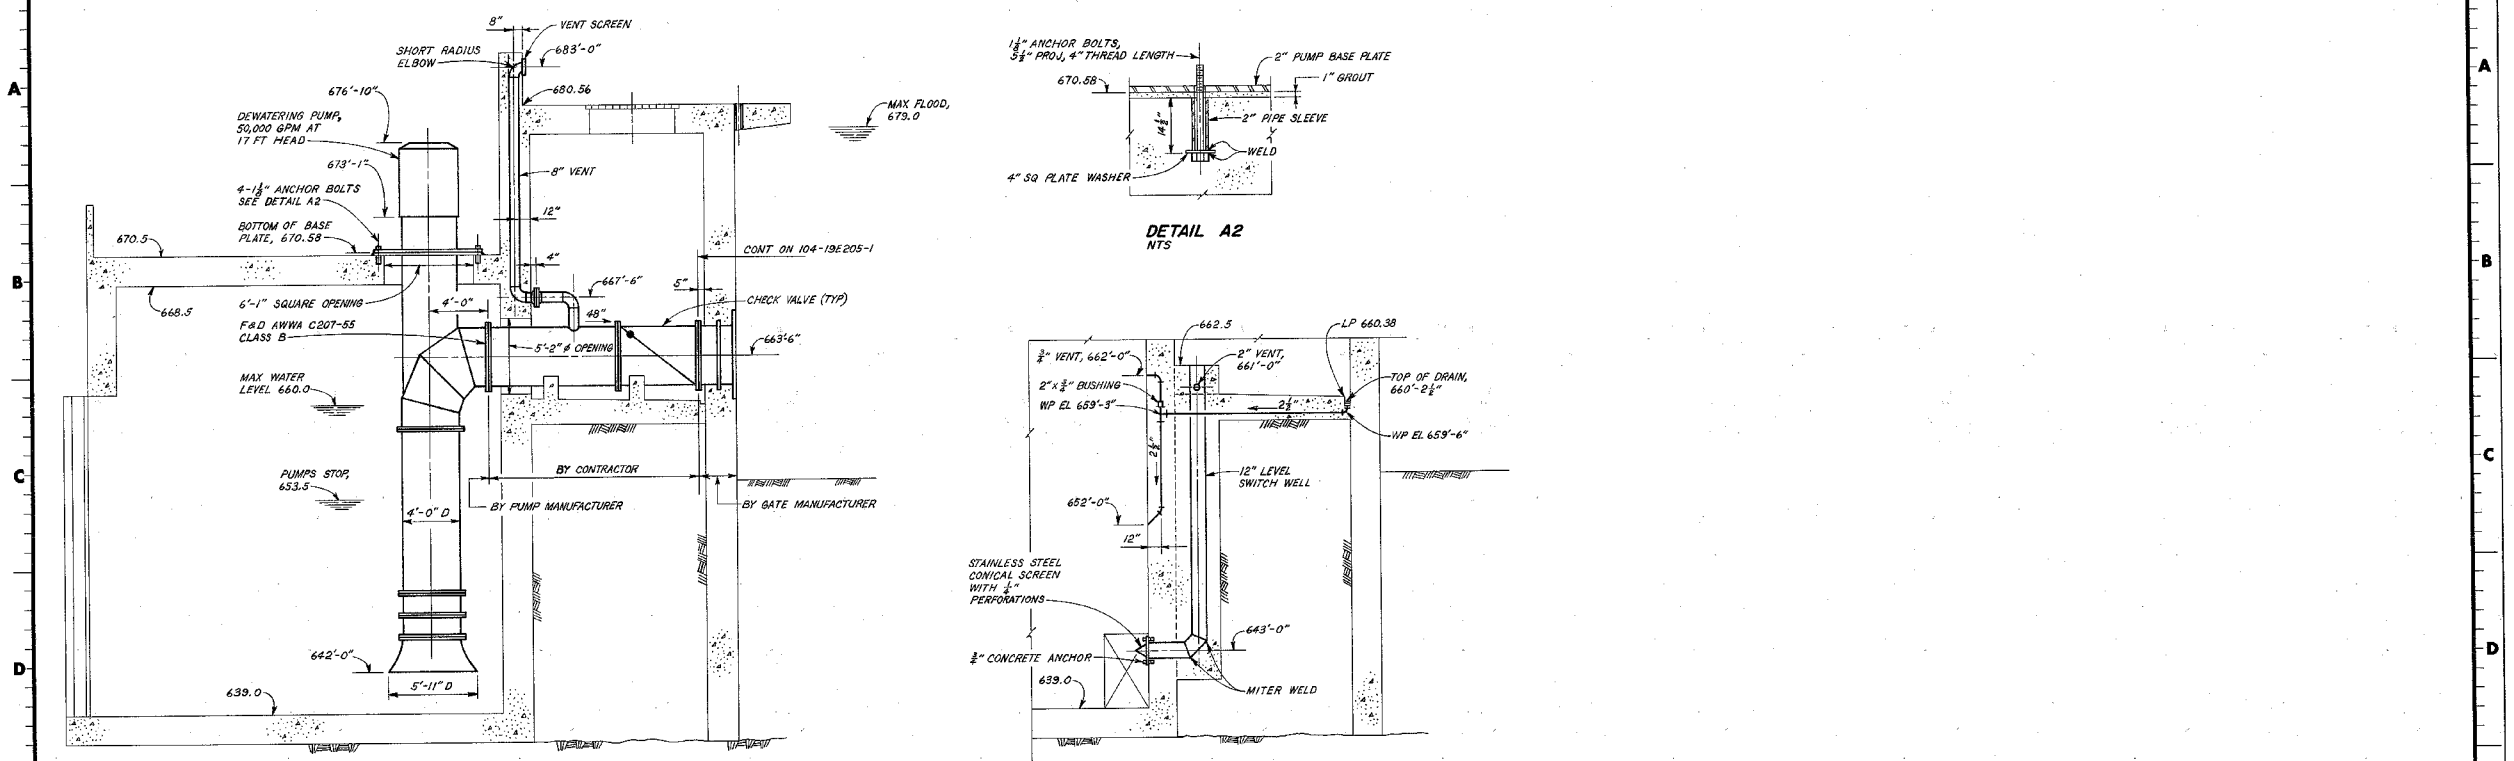

SECTION A2-A2








B2-B2

NO.	REV. NO.	DATE	BY	CHKD.	APP'D.	DATE	SCALE	EXCEPT AS NOTED
							1/4" = 1'-0"	
CHATTANOOGA FLOOD PROTECTION PUMPING STATION I MECHANICAL PUMPS AND PIPING ARRANGEMENT SOUTH CHICKAMAUGA CREEK PROJECT TENNESSEE VALLEY AUTHORITY DIVISION OF ENGINEERING DESIGN								
SUBMITTED <i>[Signature]</i>			RECOMMENDED <i>[Signature]</i>			APPROVED <i>[Signature]</i>		
KNOXVILLE 2-24-77 81 M 107-19E200-2 RO								

INSPECTED AND APPROVED FOR ISSUE
[Signature]

PANEL	NO.	DATE
1	4-23	

TECHNICAL SUPPLY CENTER
 KNOXVILLE

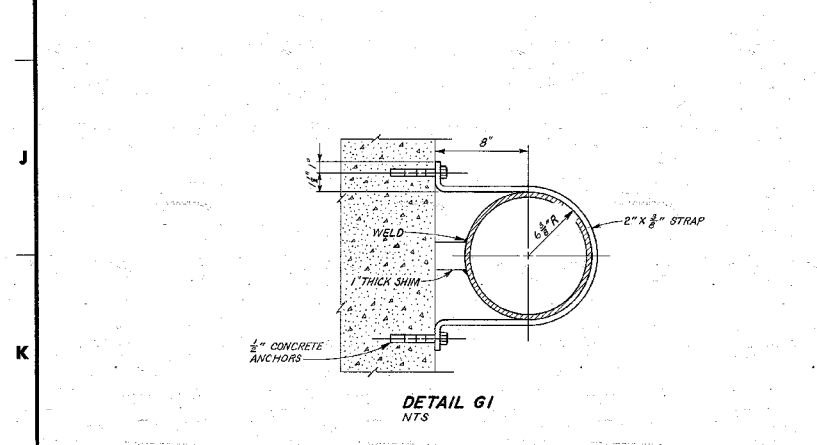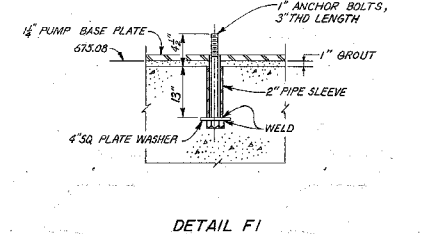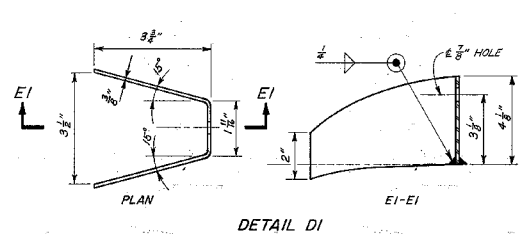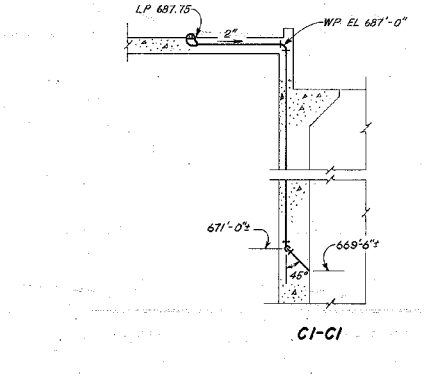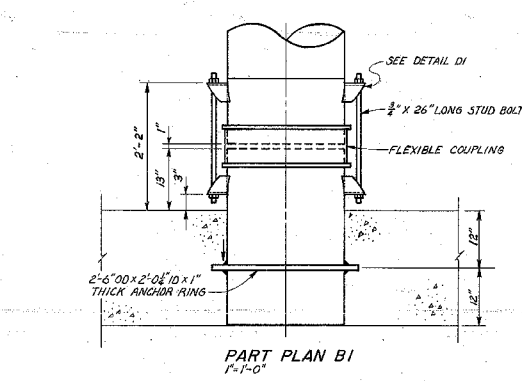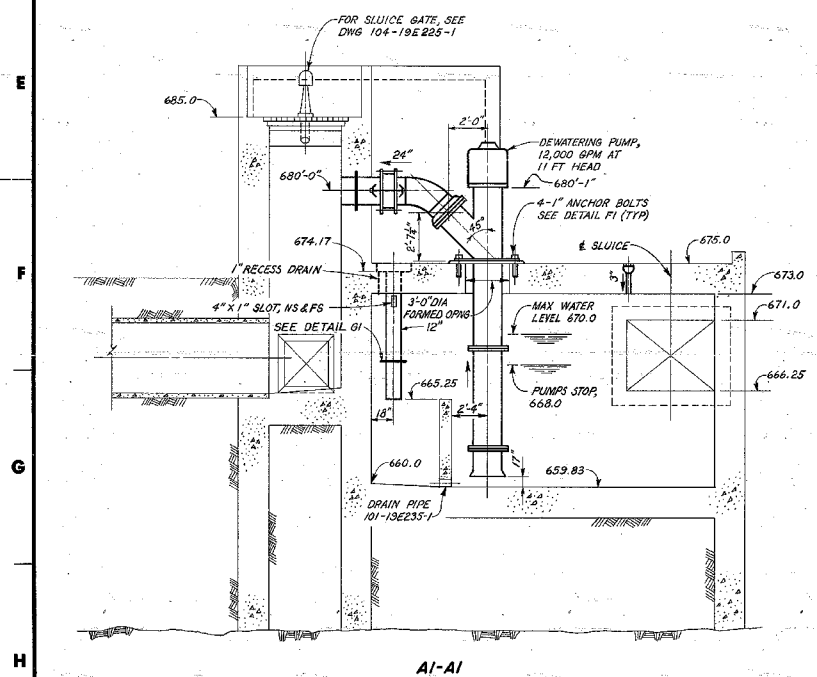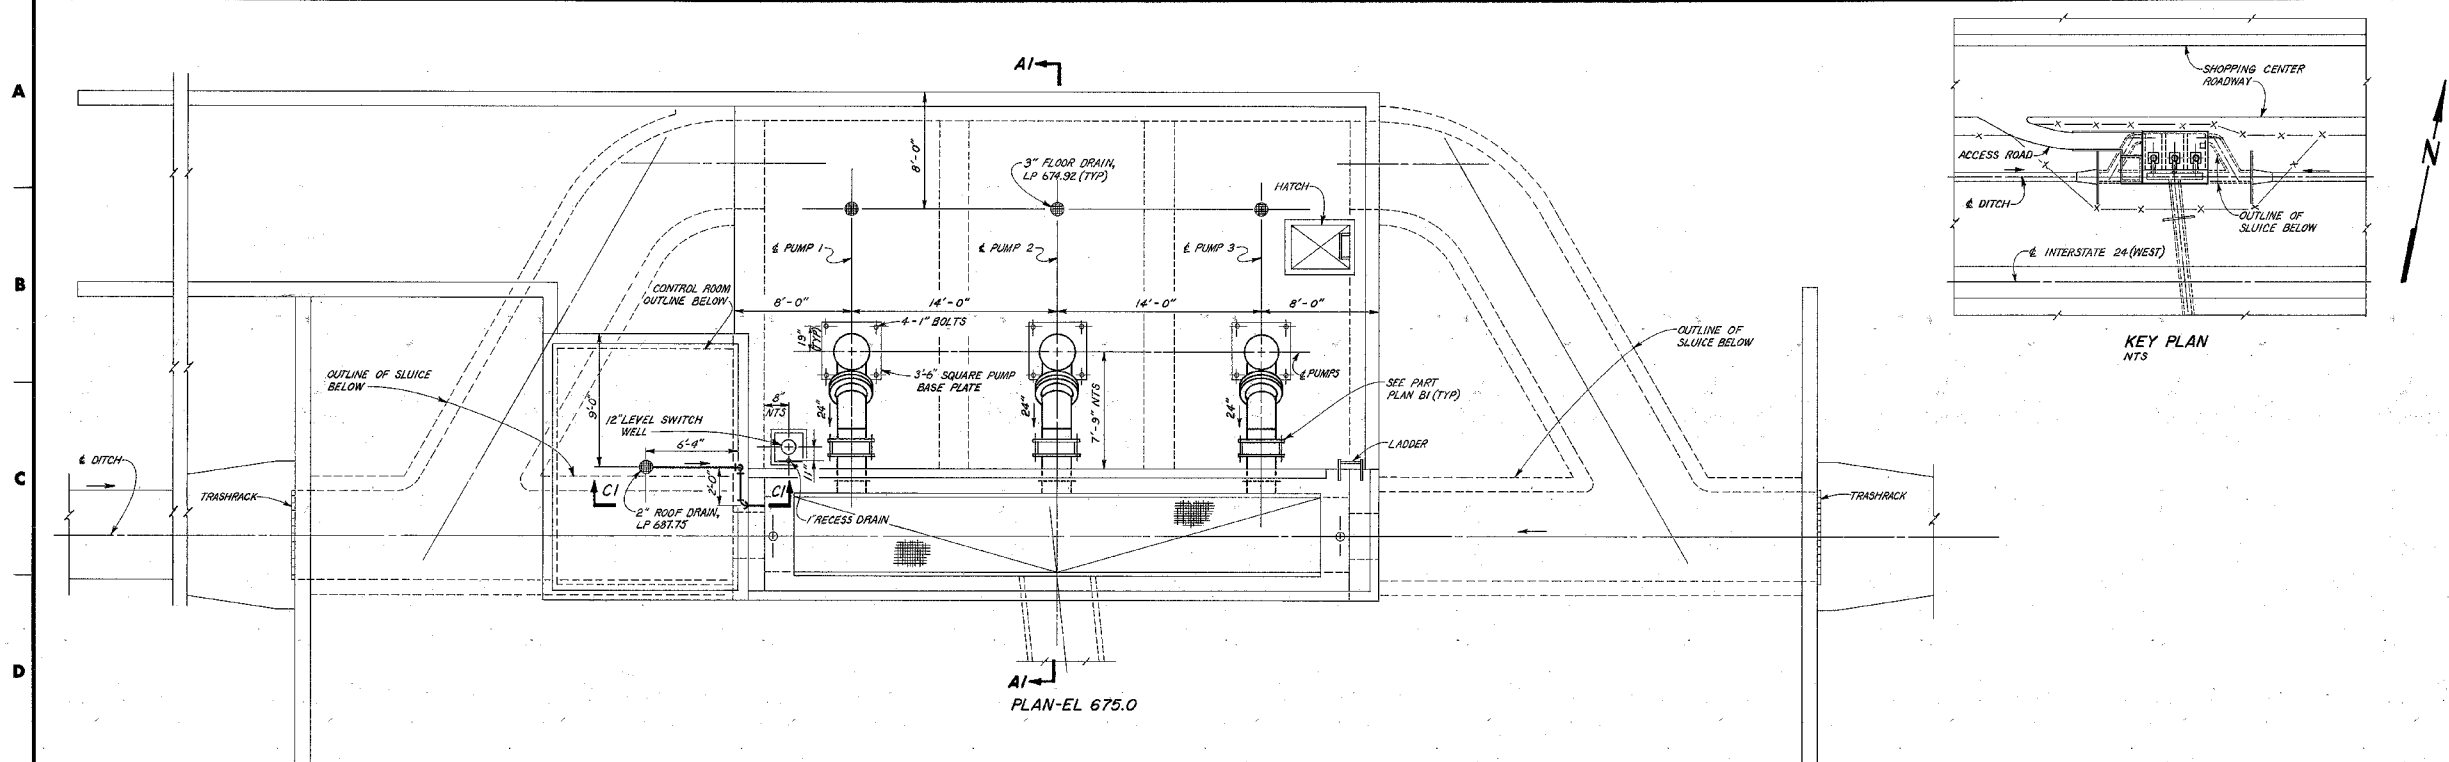


NOTES:
1. THE FIRST PUMP STARTS AUTOMATICALLY WHEN WATER SURFACE IN SUMP REACHES ELEVATION 668.0. REMAINING PUMPS COME ON AUTOMATICALLY AND SEQUENTIALLY WITH INCREASE OF WATER SURFACE IN SUMP IN 0.5 FOOT INCREMENTS. PUMPS STOP AUTOMATICALLY AND SIMULTANEOUSLY WHEN WATER SURFACE IN SUMP DROPS TO ELEVATION 666.0.
2. FOR DETAILS OF PUMPS REFER TO SOUTHEAST SUPPLY CO., INC., FILE, TVA CONTRACT 76K31-821060.

SCALE 1/4" = 1'-0"
EXCEPT AS NOTED


REV	NO.	DATE	BY	CHKD	APPD	DATE	DESCRIPTION
1	1						
CHATTANOOGA FLOOD PROTECTION PUMPING STATION 2 MECHANICAL PUMPS AND PIPING ARRANGEMENT SOUTH CHICKAMAUGA CREEK PROJECT TENNESSEE VALLEY AUTHORITY DIVISION OF ENGINEERING DESIGN							
SUBMITTED: <i>[Signature]</i> KNOXVILLE 2-24-77				RECOMMENDED: <i>[Signature]</i> APPROVED: <i>[Signature]</i>			
INSPECTED AND APPROVED FOR ISSUE: <i>[Signature]</i> KNOXVILLE 2-24-77							

PROJECT NO.	423
DATE	2-24-77
BY	W. H. H.
CHECKED	
APPROVED	


A
B
C
D
E
F
G
H
J
K

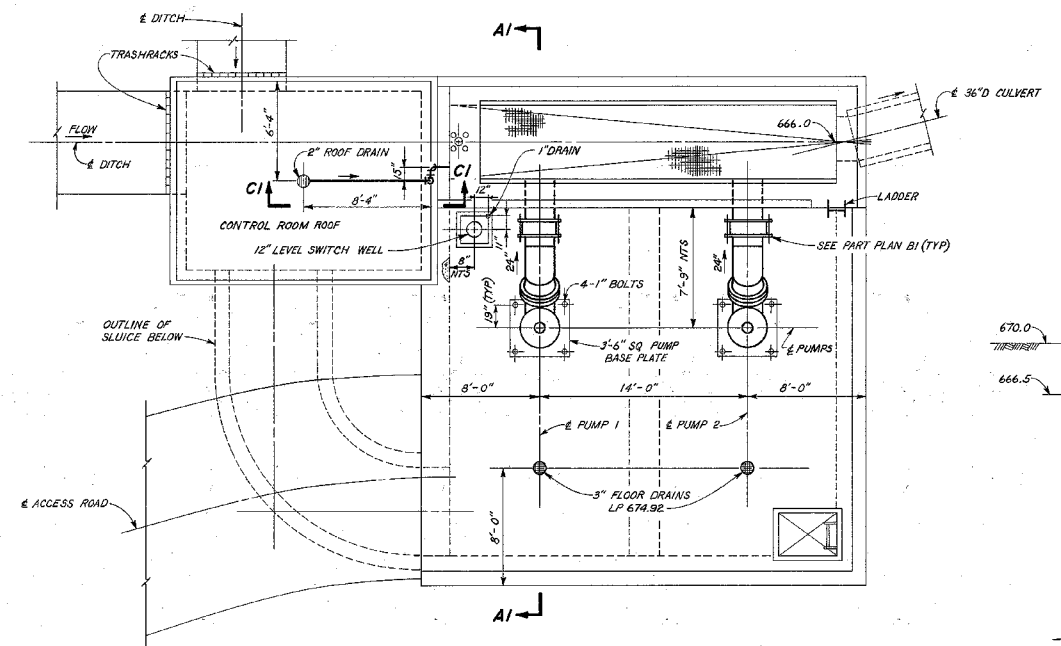


PLAN EL 675.0

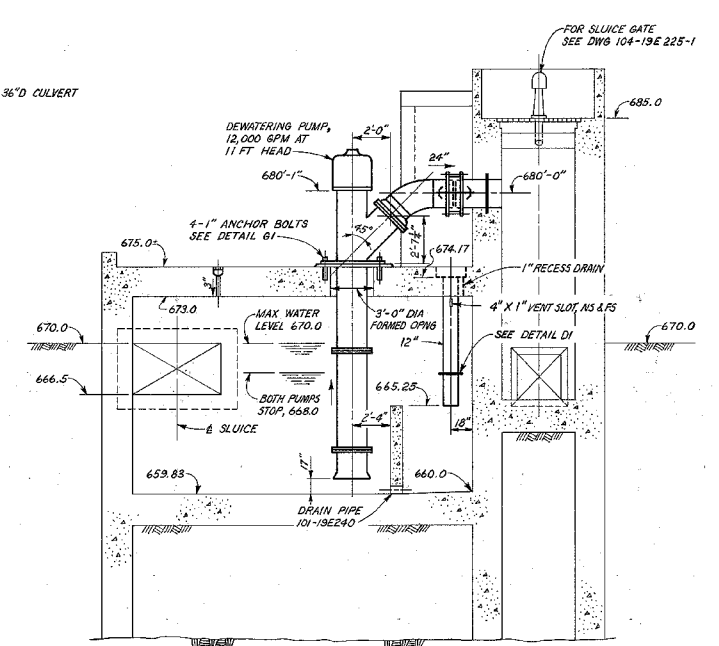


AI-AI

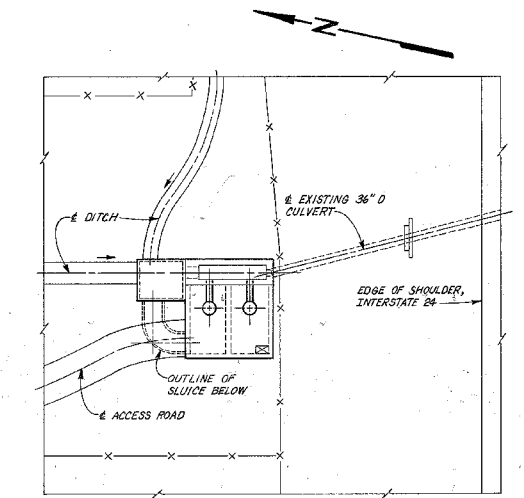


KEY PLAN
NTS

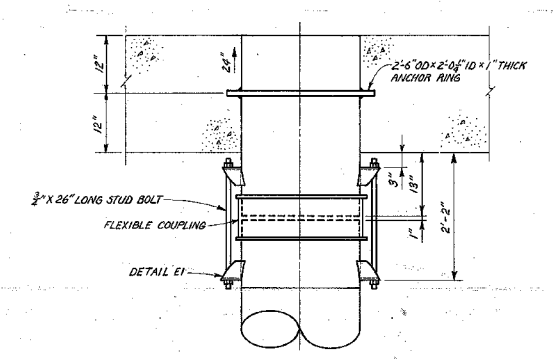


PART PLAN B1
1'-1-0"

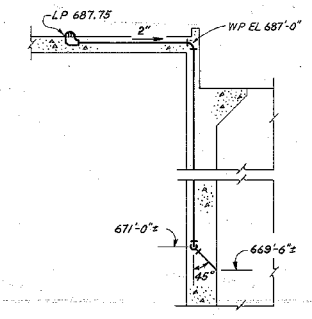


CI-CI

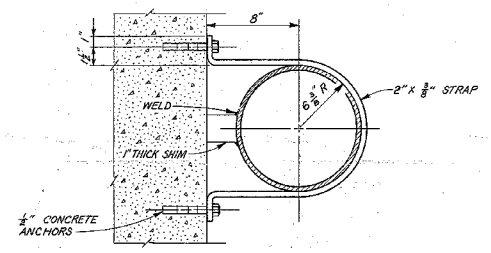

DETAIL D1
NTS

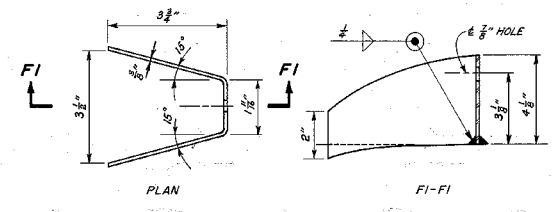

DETAIL E1
NTS

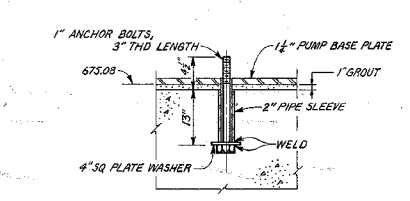

DETAIL G1
NTS

NOTES
1. THE FIRST PUMP STARTS AUTOMATICALLY WHEN WATER SURFACE IN SUMP REACHES ELEVATION 669.0. THE SECOND PUMP STARTS AUTOMATICALLY WHEN WATER SURFACE IN SUMP REACHES ELEVATION 669.5. PUMPS SHUTOFF AUTOMATICALLY AND SIMULTANEOUSLY WHEN WATER SURFACE IN SUMP RECEDES TO ELEVATION 668.0.
2. FOR DETAILS OF PUMPS REFER TO SOUTHEAST SUPPLY CO., INC. FILE, TVA CONTRACT 76K31-821060.

MF
RD


SCALE 1/4" = 1'-0"
EXCEPT AS NOTED

REV	NO.	DATE	BY	CHKD	APPD	REASON
001	1	2-24-77	J. C. PLETZ	M. L. SUTPHIN		
002	2		J. C. PLETZ			
003	3		J. C. PLETZ			
004	4		J. C. PLETZ			
005	5		J. C. PLETZ			
CHATTANOOGA FLOOD PROTECTION PUMPING STATION 3 MECHANICAL PUMPS AND PIPING ARRANGEMENT SOUTH CHICKAMAUGA CREEK PROJECT TENNESSEE VALLEY AUTHORITY DIVISION OF ENGINEERING DESIGN						
INSPECTED AND APPROVED FOR ISSUE			SUBMITTED		RECOMMENDED	
[Signature]			[Signature]		[Signature]	
KNOXVILLE 2-24-77			BI M		107-19E210-1 RO	
RECORD DRAWING AS CONSTRUCTED						


PRINT	4	2	3
SIZE	11 X 17		
MADE IN U.S.A. BY THE NATIONAL ARCHITECTURAL CENTER PRINTS DEPT. 3-0			

RECORD DRAWING AS CONSTRUCTED



LEGEND	
MATERIAL	SYM.
EXISTING TREES	
PROPOSED TREES	
PROPOSED SHRUBS	

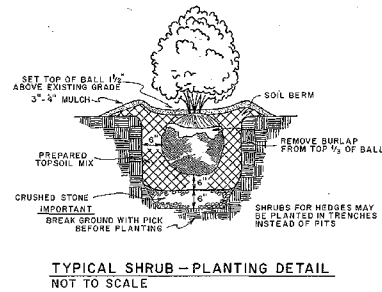


TYPICAL SHRUB-PLANTING DETAIL
NOT TO SCALE

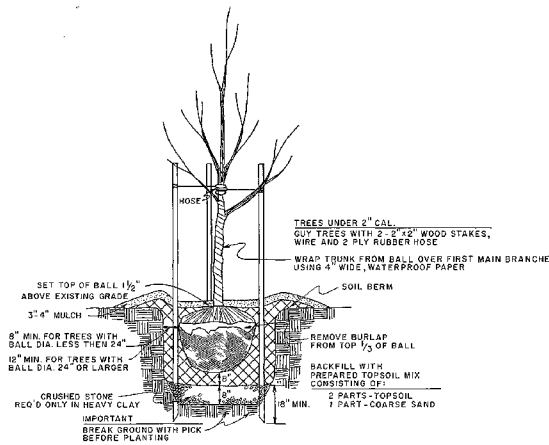

TYPICAL TREE-PLANTING DETAIL
NOT TO SCALE

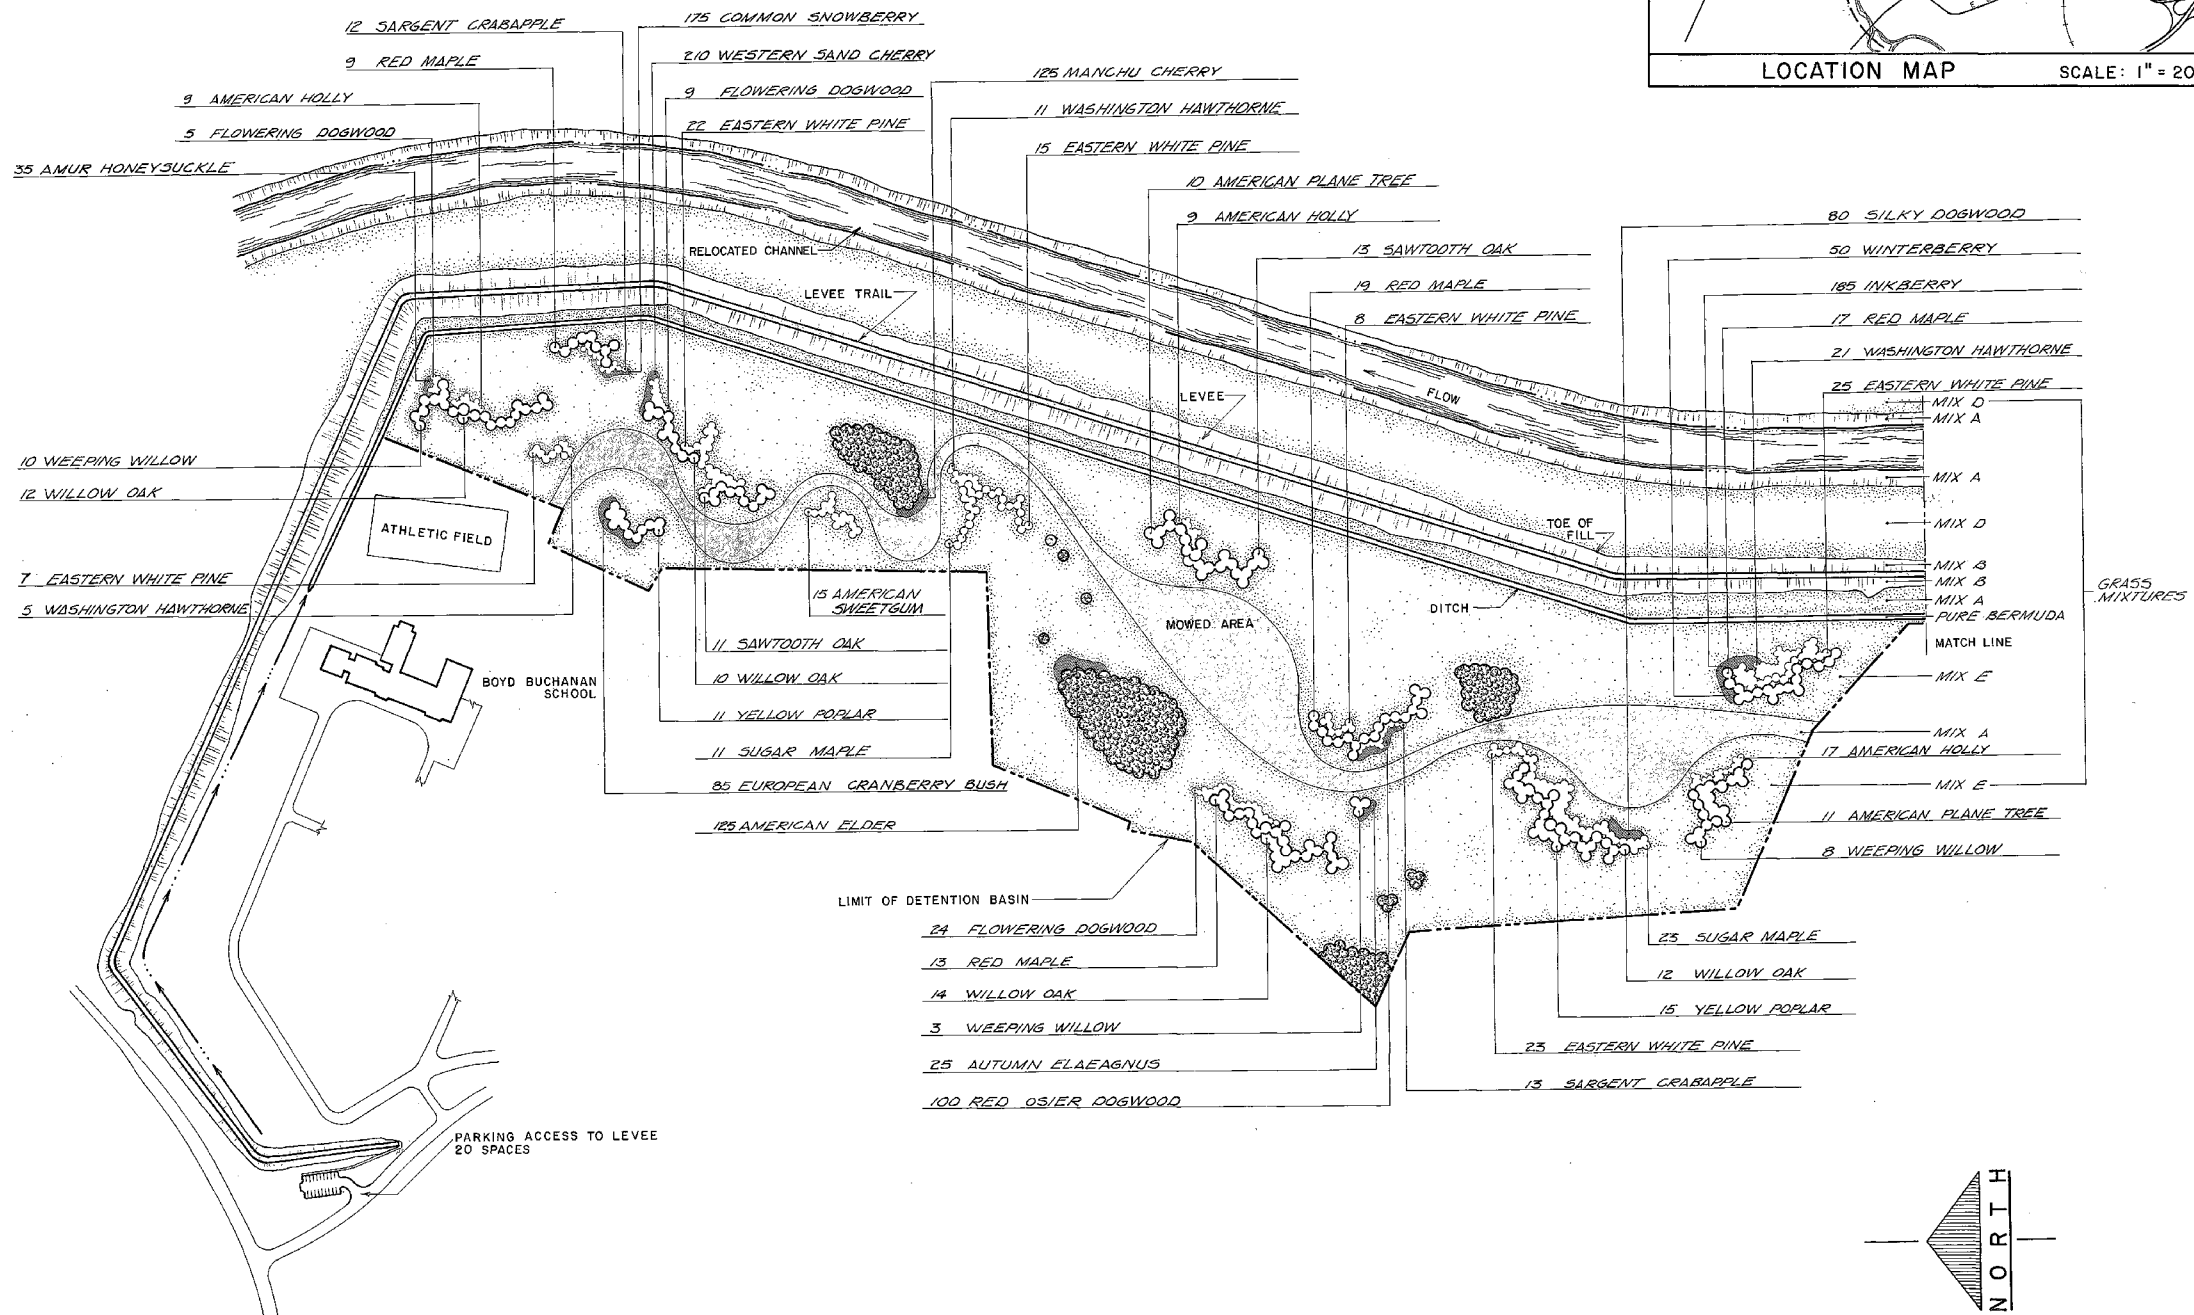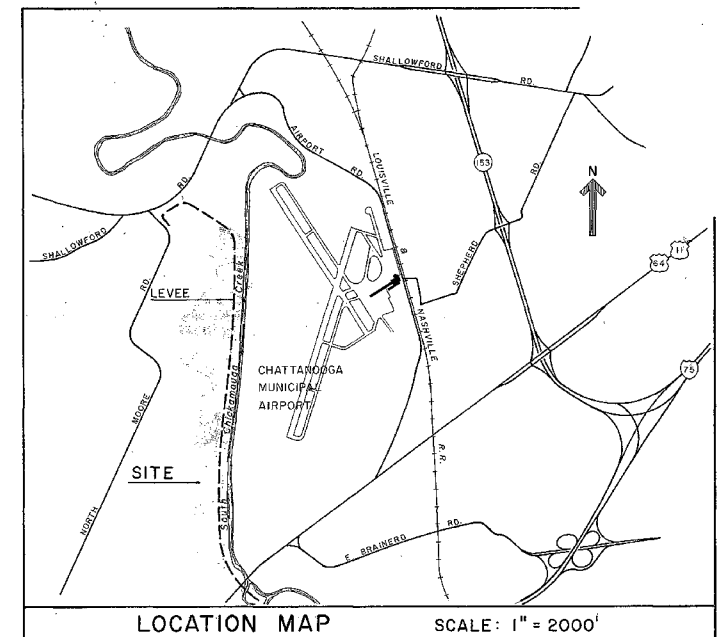



LEGEND	
MATERIAL	SYM.
EXISTING TREES	
PROPOSED TREES	
PROPOSED SHRUBS	
BALL AND BURLAP	
MOWED AREA	

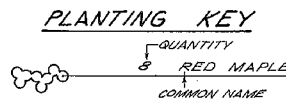

PLANT LIST							
ITEM	BOTANICAL NAME	COMMON NAME	SIZE	ROOT	SPACING	QUANTITY	REMARKS
TREES							
1	ALER RUBRUM	RED MAPLE	6'-8'	3" x 3"	30'	58	
2	ACER SACCHARUM	SUGAR MAPLE	6'-8'	3" x 3"	22'	34	
3	BETULA NIGRA	RIVER BIRCH	6'-8'	3" x 3"	22'	41	
4	CORNUS FLORIDA	FLOWERING DOGWOOD	4'-6"	3" x 3"	15'	88	WHITE FLOWERING
5	GRATAEGUS PHAENOPYRUM	WASHINGTON HAWTHORNE	4'-6"	3" x 3"	15'	46	
6	ILEX OPACA	AMERICAN HOLLY	24-30"	3" x 3"	15'	44	
7	LIRIODENDRON STYRACIFLUA	AMERICAN SWEETGUM	6'-8"	3" x 3"	22'-30'	36	
8	LIRIODENDRON TULIPIFERA	YELLOW POPLAR	6'-8"	3" x 3"	30'	35	
9	MALUS SARGENTII	SARGENT CRABAPPLE	4'-6"	3" x 3"	15'	45	
10	PINUS STROBUS	EASTERN WHITE PINE	6'-8"	3" x 3"	22'	149	DENSE FOLIAGE
11	PLATANUS OCCIDENTALIS	AMERICAN PLANE TREE	6'-8"	3" x 3"	30'	34	
12	QUERCUS ALUTISSIMA	SAWTOOTH OAK	6'-8"	3" x 3"	30'	24	
13	QUERCUS PHellos	WILLOW OAK	6'-8"	3" x 3"	30'	65	
14	SALIX BABYLONICA	WEeping WILLOW	6'-8"	3" x 3"	30'	56	
SHRUBS							
15	CORNUS AMOMUM	SILKY DOGWOOD	18-24"	3" x 3"	5'	85	
16	CORNUS STOLONIFERA	RED OSIER DOGWOOD	18-24"	3" x 3"	5'	100	
17	ELAEAGNUS UMBELLATUS	AUTUMN ELAEAGNUS	18-24"	3" x 3"	6'	25	
18	ILEX GLABRA	INKBERRY	18-24"	3" x 3"	4'	285	
19	ILEX VERTICILLATA	WINTERBERRY	18-24"	3" x 3"	5'	86	
20	LONICERA MAACKI	AMUR HONEYSUCKLE	18-24"	3" x 3"	6'	55	
21	PRUNUS BESSEYI	WESTERN SAND CHERRY	18-24"	3" x 3"	3'6"	310	
22	PRUNUS TOMENTOSA	MANCHURI CHERRY	18-24"	3" x 3"	4'	125	
23	SAMBUCUS CANADENSIS	AMERICAN ELDER	18-24"	3" x 3"	6'	125	
24	SYMPHORICARPOS ALBUS	COMMON SNOWBERRY	15-18"	3" x 3"	5'	175	
25	VIBURNUM DILATATUM	LINDEN VIBURNUM	18-24"	3" x 3"	7'	DELETE	
26	VIBURNUM OPULUS	EUROPEAN CRANBERRY BUSH	18-24"	3" x 3"	6'	85	
27	VIBURNUM SIEBOLDII	SIEBOLD VIBURNUM	18-24"	3" x 3"	6'	20	
GRASS MIXTURES							
A	CYNODON DACTYLON	BERMUDA GRASS	40 *				PLANTING SEASON MAY 15 - JULY 15
B	LESPEDEZA STYRACIFLORAE	KOREAN LESPEDEZA	12 = 50 TOTAL				MAY 15 - JULY 15
C	CROWNVELTCH	CROWNVELTCH	30 = 50 TOTAL				MARCH 15 - MAY 15
D	FESTUCA RUPESTRIS COMMUTATA	CHEWINGS FESCUE	30 = 60 TOTAL				AUG. 15 - OCT. 15
E	BREMCHLOA OPHIURHOIDES	CENTPEDE GRASS	DELETE				MAY 15 - JULY 15
F	TRIFOLIUM REPENS	WHITE CLOVER	DELETE				AUG. 15 - OCT. 15
G	LESPEDEZA CUNEATA	DWARF SEREGIA "INTERSTATE"	20 *				MARCH 15 - MAY 15
H	DACTYLIS GLABRATA	ORCHARD GRASS	20 *				AUG. 15 - OCT. 15
I	TRIFOLIUM REPENS	WHITE CLOVER	15 *				AUG. 15 - OCT. 15
J	TRIFOLIUM INCARNATUM	CRIMSON CLOVER	15 = 70 TOTAL				AUG. 15 - OCT. 15
K	PHLEUM PRATENSE	TIMOTHY GRASS	20 *				AUG. 15 - OCT. 15
L	PDA TRIVIALIS	SABRE BLUEGRASS	30 *				AUG. 15 - OCT. 15
M	TRIFOLIUM HYBRIDUM	ALSIKE CLOVER	20 = 70 TOTAL				AUG. 15 - OCT. 15


- SEEDING NOTES**
- SEEDING OF DESIGNATED AREAS SHALL FOLLOW IMMEDIATELY BEHIND CONSTRUCTION. PLACING OF SEED, COMMERCIAL FERTILIZER AND AGRICULTURE LIMESTONE SHALL CONFORM TO HIGHWAY SPECIFICATION NO. 71, SECTION 180. SOIL PREPARATION SHALL BE TO A DEPTH OF 2" IN ACCORDANCE WITH PARAGRAPH 180.04.
 - BERMUDA GRASS SEED TO BE HULLED.
 - KOREAN LESPEDEZA AND DWARF SEREGIA SEED TO BE SCARIFIED.
 - CROWNVELTCH SEED TO BE SCARIFIED AND INOCULATED.
 - LIME AREAS TO BE PLANTED AT RATE OF 3 1/2 TONS PER ACRE.
 - FERTILIZE WITH 14-19-19 AT RATE OF 400 POUNDS PER ACRE.
 - STRAW MULCH ALL PLANTED AREAS AT RATE OF 60 BALES PER ACRE.

NOTE: BARE ROOT OR CONTAINER GROWN MATERIAL MAY BE SUBSTITUTED FOR BALLED AND BURLAPED SHRUBS AND SMALL TREES (UP TO 4'-6").

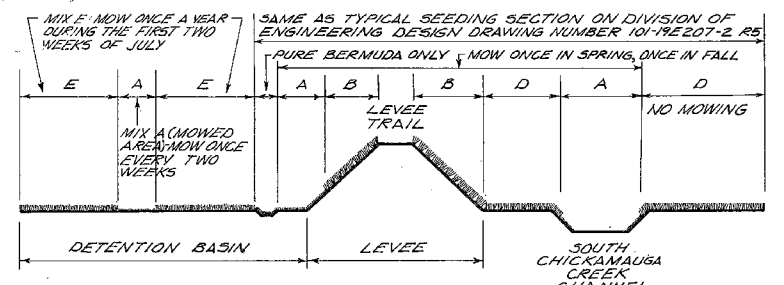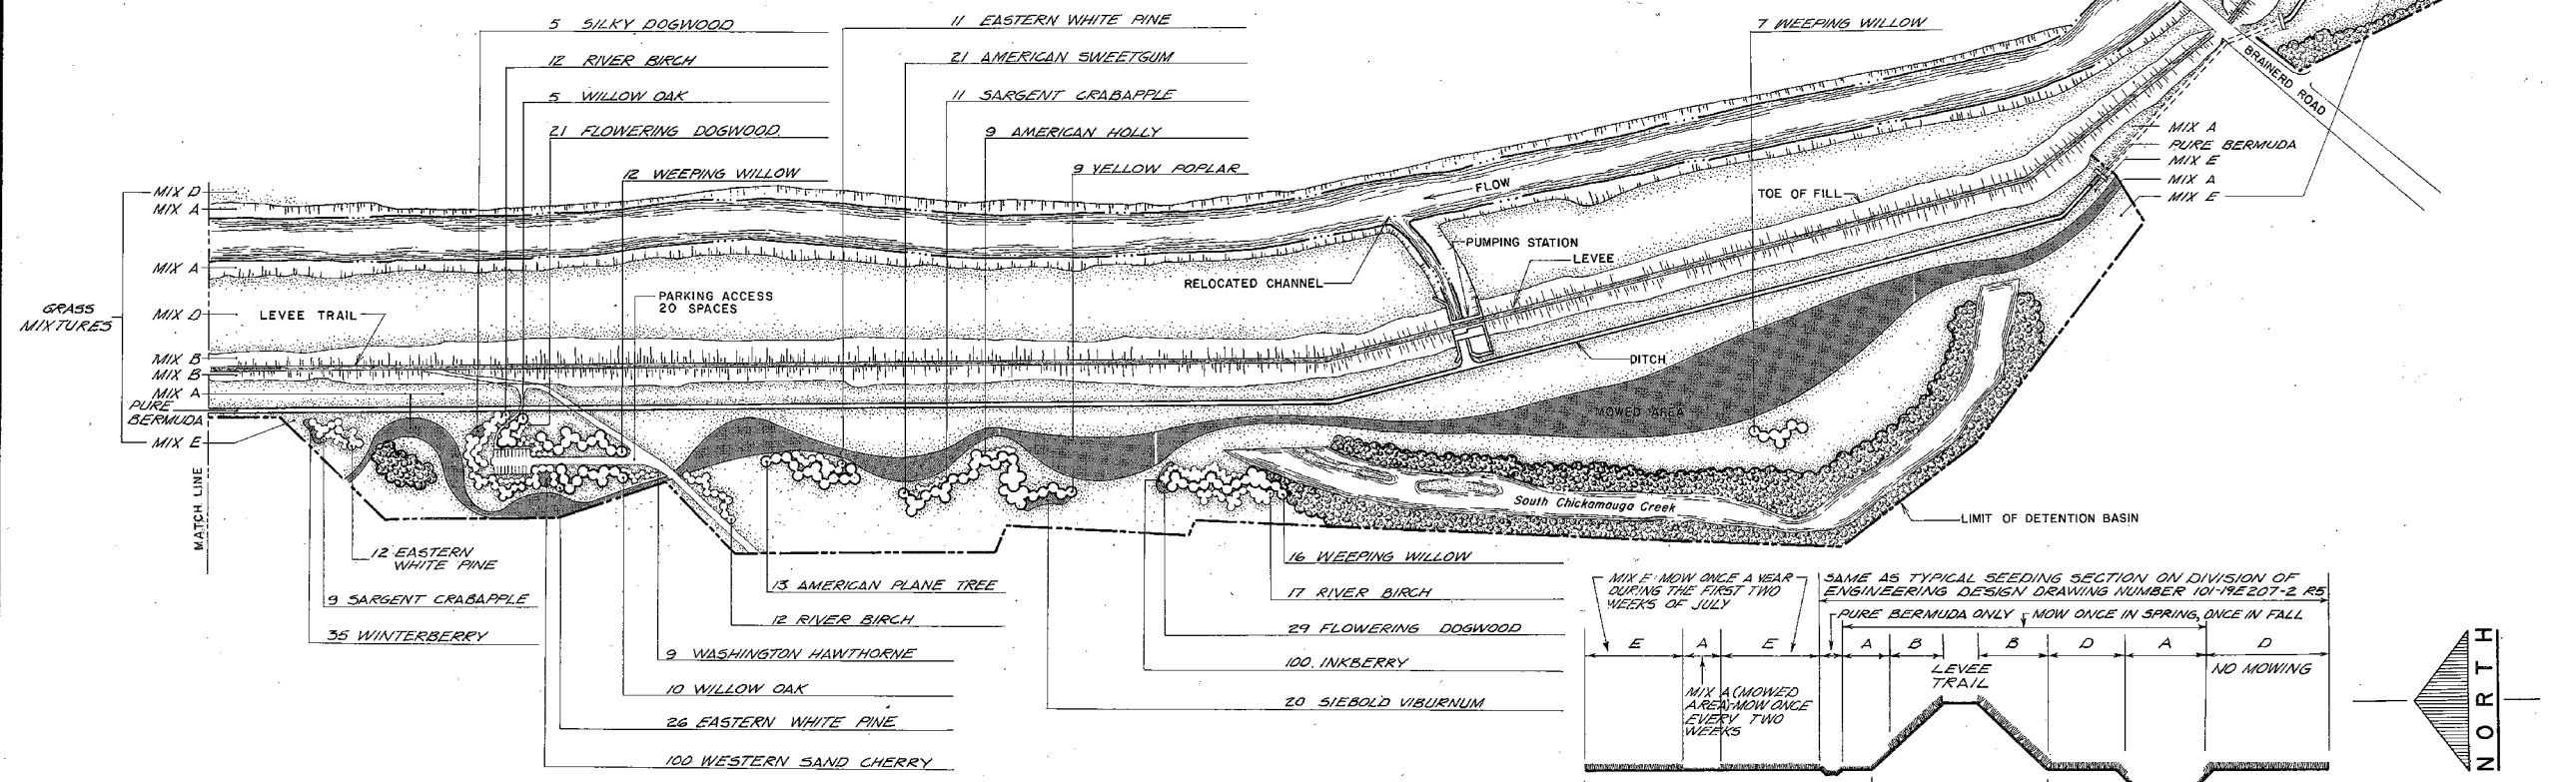

**GRASS MIXTURES
TYPICAL SECTION - VIEW DOWNSTREAM**

NOTE: NO MOWING BETWEEN APRIL 15 AND JUNE 30 EXCEPT FOR SHADED AREA OF MIX A DESIGNATED MOWED AREA.

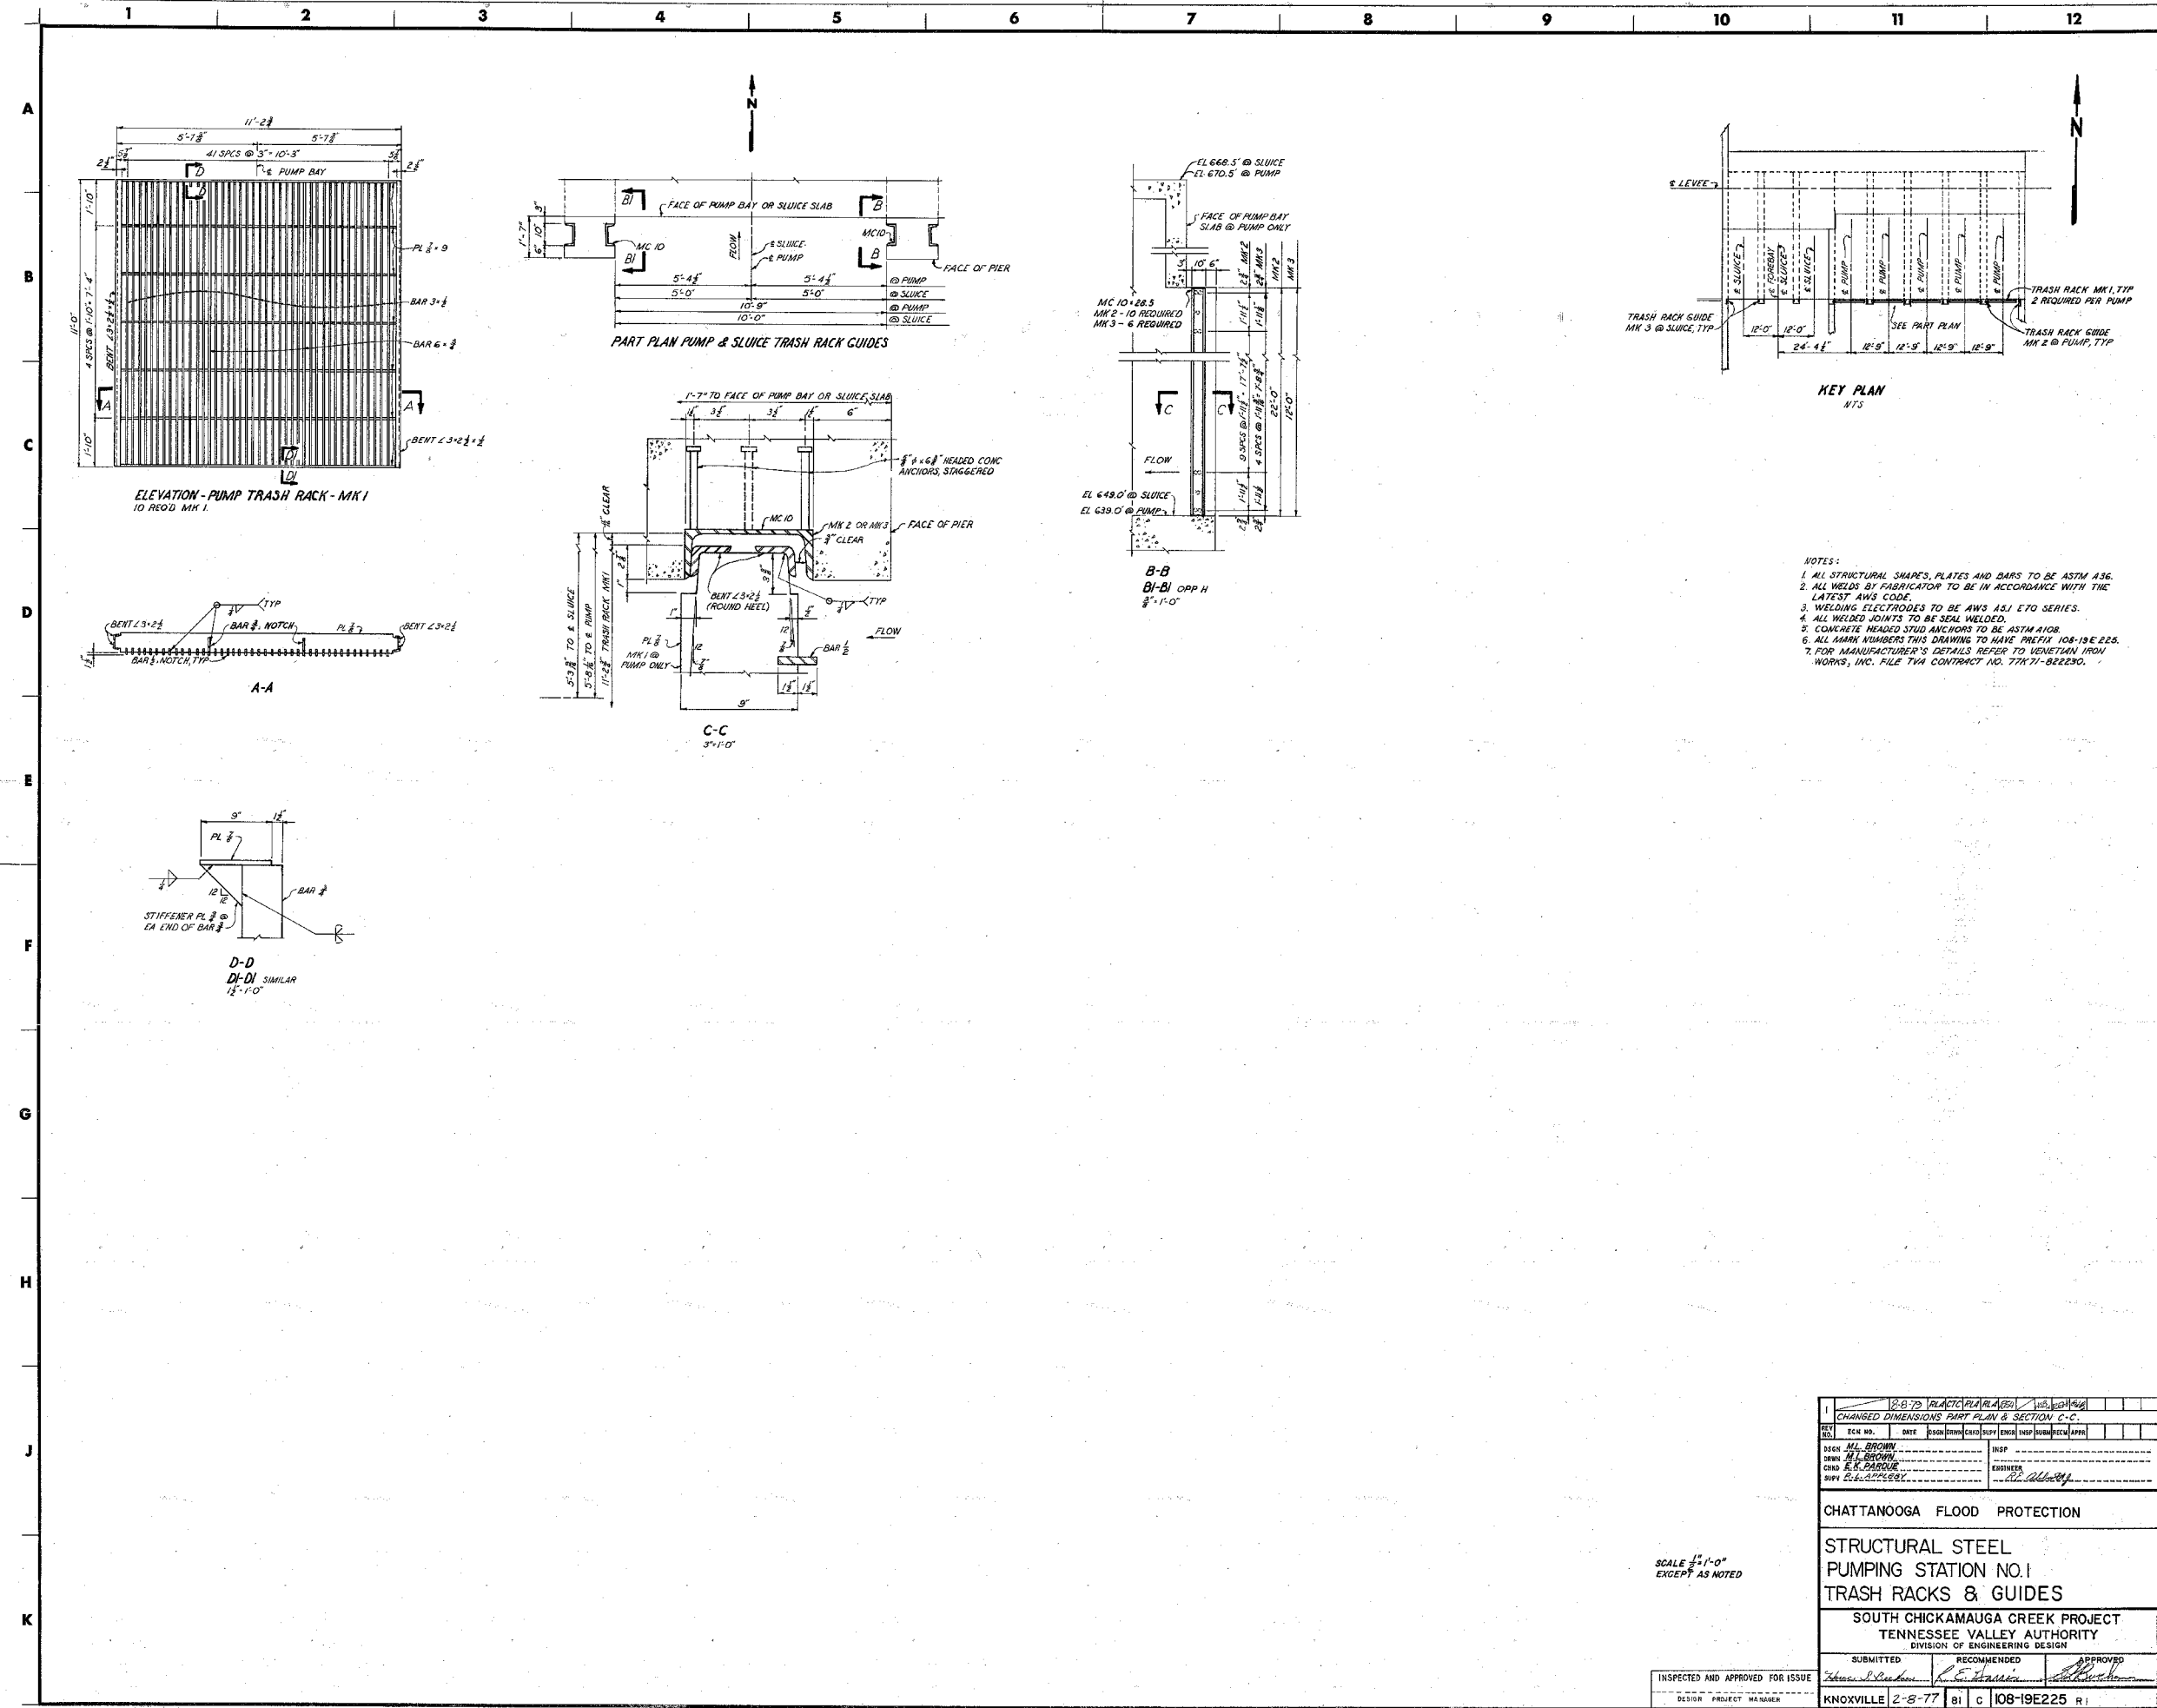





- NOTES:
1. ALL STRUCTURAL SHAPES, PLATES AND BARS TO BE ASTM A56.
 2. ALL WELDS BY FABRICATOR TO BE IN ACCORDANCE WITH THE LATEST AWS CODE.
 3. WELDING ELECTRODES TO BE AWS A51 E70 SERIES.
 4. ALL WELDED JOINTS TO BE SEAL WELDED.
 5. CONCRETE HEADED STUD ANCHORS TO BE ASTM A108.
 6. ALL MARK NUMBERS THIS DRAWING TO HAVE PREFIX 108-19E 225.
 7. FOR MANUFACTURER'S DETAILS REFER TO VENETIAN IRON WORKS, INC. FILE TPA CONTRACT NO. TPA-71-82250.

SCALE 1/4" = 1'-0"
EXCEPT AS NOTED

INSPECTED AND APPROVED FOR ISSUE		DESIGNER PROJECT MANAGER	
PRINT	SIZE	OR FOR PROJ	ME EL CE AD CO ES NO BF SW BL PA
PRINTS	REQD	1	

SUBMITTED		RECOMMENDED		APPROVED	
KNOXVILLE 2-8-77		BI C		108-19E225 R1	

108-19E225		108-19E225	
CHANGED DIMENSIONS PART PLAN & SECTION C-C			
REV	NO.	DATE	BY
1			
2			
DESIGNER: M.L. BROWN CHECKER: E.R. PARSONS SUPERVISOR: [Signature]			
CHATTANOOGA FLOOD PROTECTION STRUCTURAL STEEL PUMPING STATION NO. 1 TRASH RACKS & GUIDES SOUTH CHICKAMAUGA CREEK PROJECT TENNESSEE VALLEY AUTHORITY DIVISION OF ENGINEERING DESIGN			
SUBMITTED: [Signature] RECOMMENDED: [Signature] APPROVED: [Signature]			
KNOXVILLE 2-8-77 BI C 108-19E225 R1			








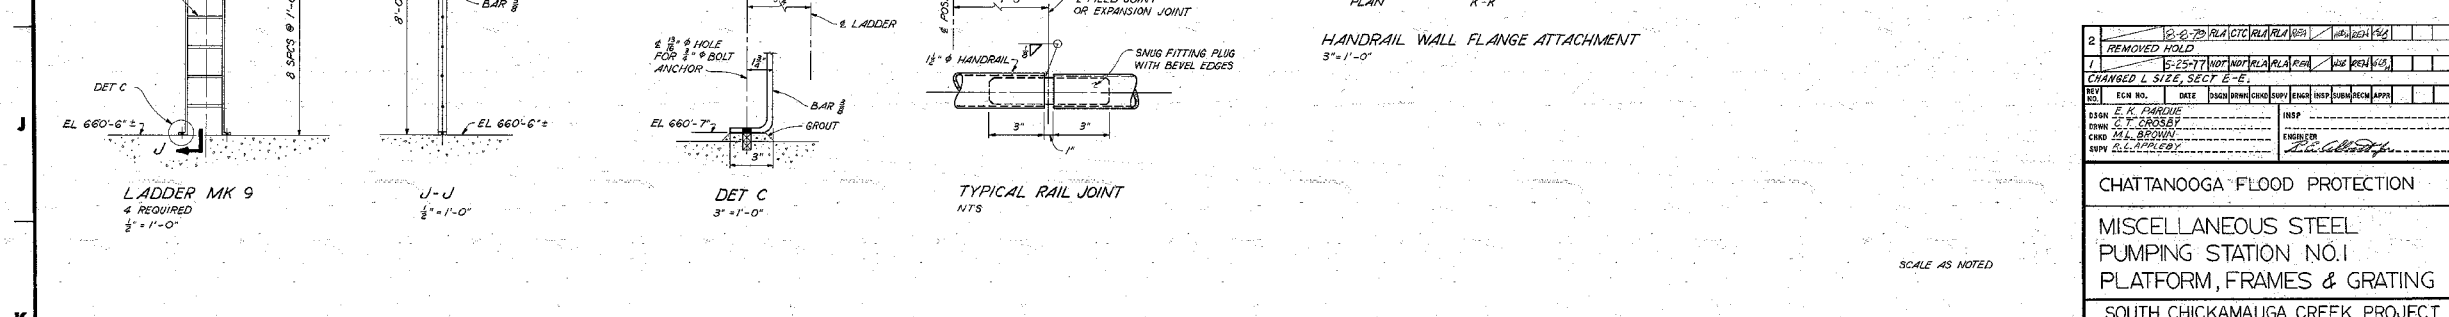
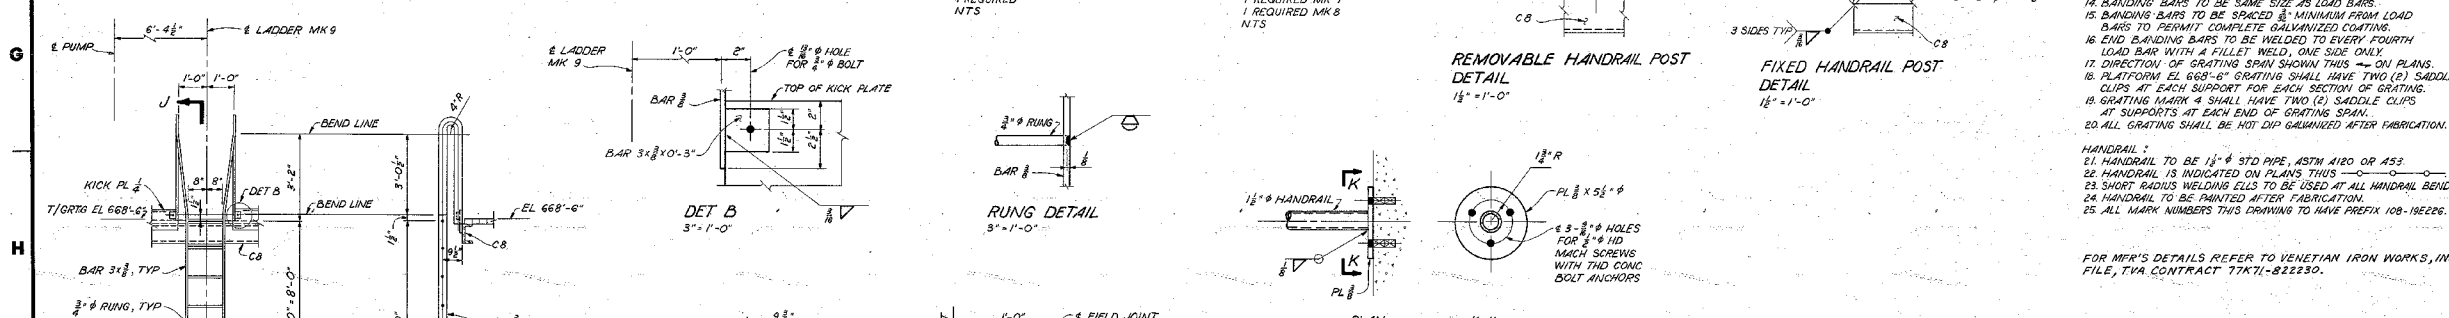
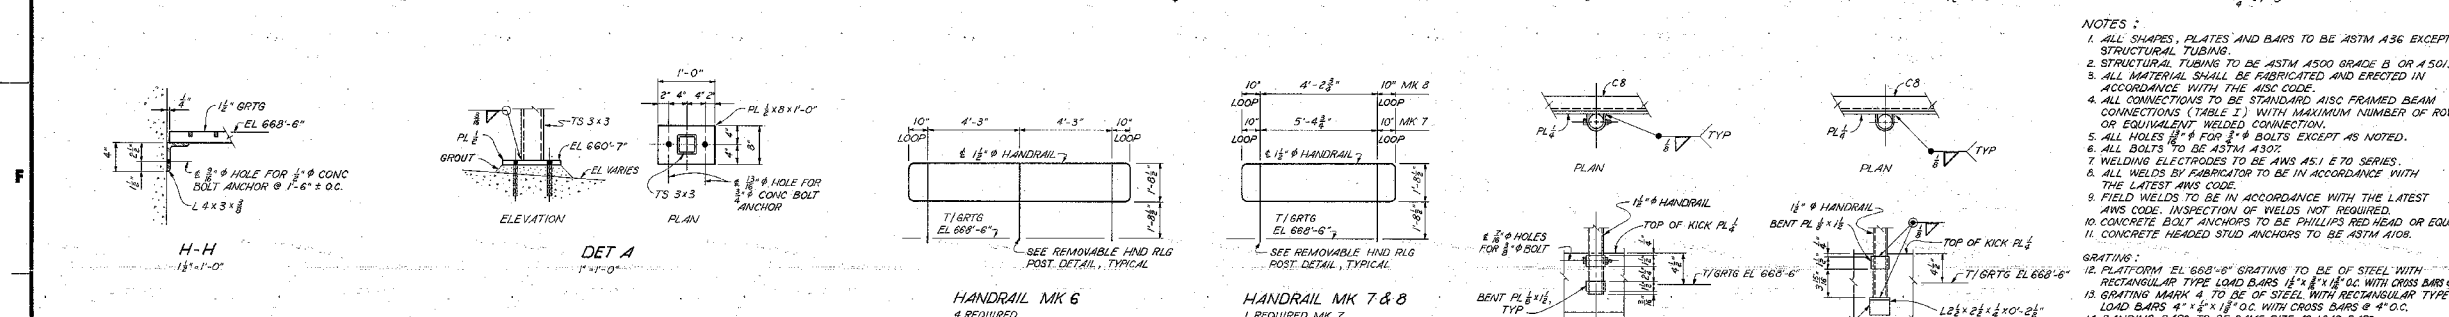
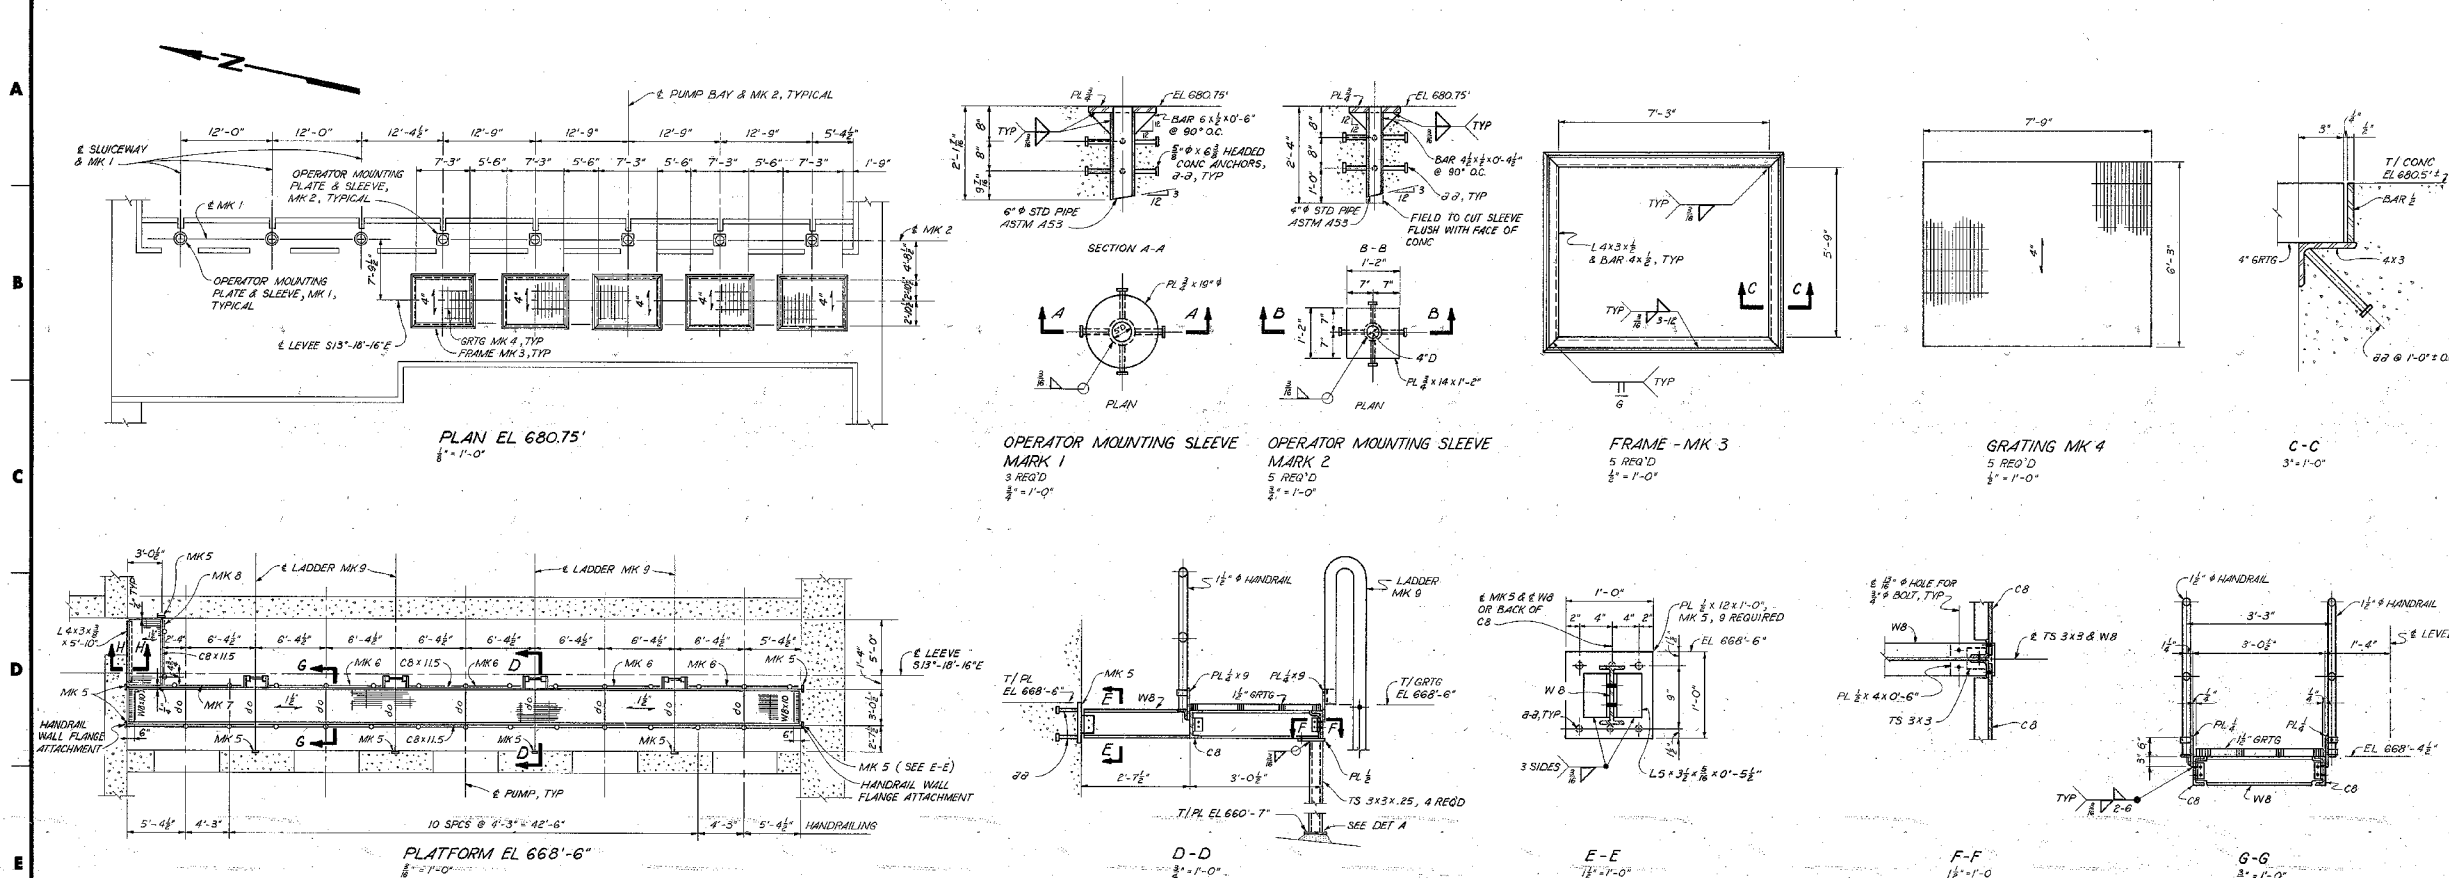


- NOTES:**
1. ALL SHAPES, PLATES AND BARS TO BE ASTM A36 EXCEPT STRUCTURAL TUBING.
 2. STRUCTURAL TUBING TO BE ASTM A500 GRADE B OR A 501.
 3. ALL MATERIAL SHALL BE FABRICATED AND ERECTED IN ACCORDANCE WITH THE AISC CODE.
 4. ALL CONNECTIONS TO BE STANDARD AISC FRAMED BEAM CONNECTIONS (TABLE I) WITH MAXIMUM NUMBER OF ROWS OR EQUIVALENT WELDED CONNECTION.
 5. ALL WELDS TO BE IN ACCORDANCE WITH THE LATEST AISC CODE.
 6. ALL BOLTS TO BE ASTM A307.
 7. WELDING ELECTRODES TO BE AWS A5.1 E70 SERIES.
 8. ALL WELDS BY FABRICATOR TO BE IN ACCORDANCE WITH THE LATEST AISC CODE.
 9. FIELD WELDS TO BE IN ACCORDANCE WITH THE LATEST AISC CODE. INSPECTION OF WELDS NOT REQUIRED.
 10. CONCRETE BOLT ANCHORS TO BE PHILLIPS BED HEAD OR EQUAL.
 11. CONCRETE HEADED STUD ANCHORS TO BE ASTM A193.
- GRATING:**
12. PLATFORM EL 668.6" GRATING TO BE OF STEEL WITH RECTANGULAR TYPE LOAD BARS 1 1/2" x 1 1/2" O.C. WITH CROSS BARS #4X.
 13. GRATING MARK 4 TO BE OF STEEL WITH RECTANGULAR TYPE LOAD BARS 4" x 2" O.C. WITH CROSS BARS #4 O.C.
 14. HANDING BARS TO BE SAME SIZE AS LOAD BARS.
 15. BANDING BARS TO BE SPACED 6" MINIMUM FROM LOAD BARS TO PERMIT COMPLETE GALVANIZED COATING.
 16. END BANDING BARS TO BE WELDED TO EVERY FOURTH LOAD BAR WITH A FILLET WELD, ONE SIDE ONLY.
 17. DIRECTION OF GRATING SPAN SHOWN THIS - ON PLANS.
 18. PLATFORM EL 668.6" GRATING SHALL HAVE TWO (2) SADDLE CLIPS AT EACH SUPPORT FOR EACH SECTION OF GRATING.
 19. GRATING MARK 4 SHALL HAVE TWO (2) SADDLE CLIPS AT SUPPORTS AT EACH END OF GRATING SPAN.
 20. ALL GRATING SHALL BE HOT DIP GALVANIZED AFTER FABRICATION.
- HANDRAIL:**
21. HANDRAIL TO BE 1 1/2" STD PIPE, ASTM A193 OR A53.
 22. HANDRAIL IS INDICATED ON PLANS THIS - ON PLANS.
 23. SHORT RADIUS WELDING ELLS TO BE USED AT ALL HANDRAIL BENDS.
 24. HANDRAIL TO BE PAINTED AFTER FABRICATION.
 25. ALL MARK NUMBERS THIS DRAWING TO HAVE PREFIX 108-19E226.

FOR MFR'S DETAILS REFER TO VENETIAN IRON WORKS, INC FILE, TVA CONTRACT 77K1-82230.

2	REMOVED HOLD	2/26
1	CHANGED L SIZE, SECT E-E	1/26
REV	NO.	DATE
DESIGN	BY	DATE
CHKD	BY	DATE
APPV	BY	DATE
CHATTANOOGA FLOOD PROTECTION		
MISCELLANEOUS STEEL		
PUMPING STATION NO.1		
PLATFORM, FRAMES & GRATING		
SOUTH CHICKAMAUGA CREEK PROJECT		
TENNESSEE VALLEY AUTHORITY		
DIVISION OF ENGINEERING DESIGN		
INSPECTED AND APPROVED FOR ISSUE	RECOMMENDED	APPROVED
KNOXVILLE 2-8-77	BI	108-19E226 R2
SECOND DRAWING AS CONSTRUCTED		

PRINT	SCALE	DATE	BY
SIZE	AS NOTED	2-8-77	BI
TECHNICAL INFORMATION CENTER			
KNOXVILLE			

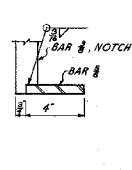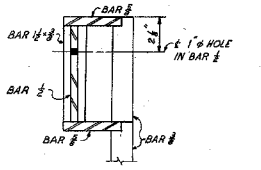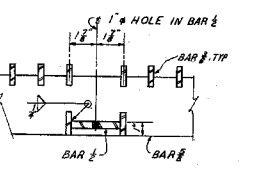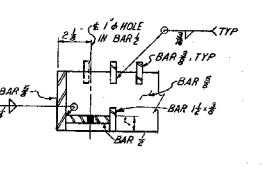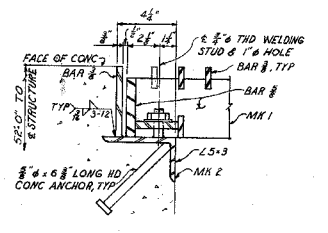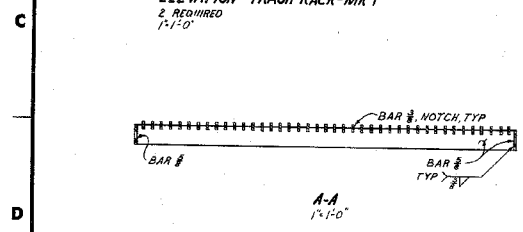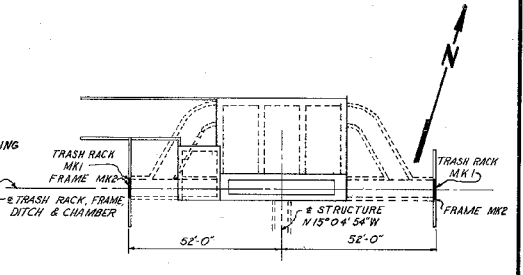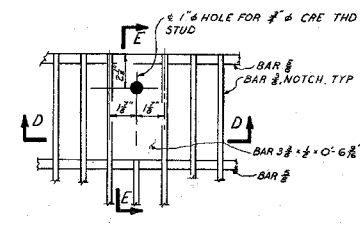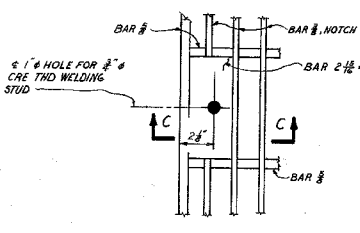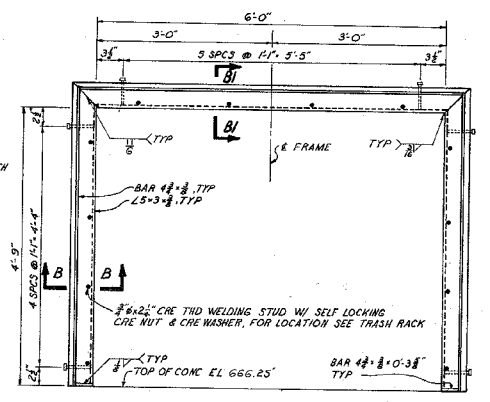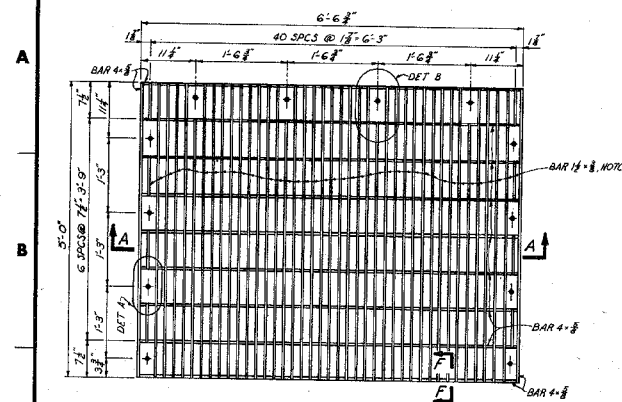

- NOTES:**
1. STRUCTURAL SHAPES, PLATES AND BARS TO BE ASTM A-36.
 2. ALL WELDS BY FABRICATOR TO BE IN ACCORDANCE WITH LATEST AWS CODE.
 3. WELDING ELECTRODES TO BE AWS A51 E70 SERIES.
 4. ALL WELDED JOINTS TO BE SEAL WELDED.
 5. CONCRETE HEADED STUD ANCHORS TO BE ASTM A193.
 6. THREADED STUD WELDING FASTENERS SHALL BE K3M PRODUCT INC. STANDARD WELDING STUDS OR EQUAL.
 7. ALL SELF-LOCKING NUTS TO BE ANCO OR EQUAL.
 8. MARK NUMBERS TO HAVE PREFIX 108-19E235.
 9. FOR MANUFACTURER'S DETAILS REFER TO VENETIAN IRON WORKS, INC. FILE TM CONTRACT NO. 77K71-82230.

SCALE 3/4"=1'-0"
 EXCEPT AS NOTED

DESIGN	PROJECT	MANAGER	DATE	BY	CHECKED	DATE	BY	CHECKED	DATE
ML BROWN									
CHKD	EA PARQUE	ENGINEER							
APP									


CHATTANOOGA FLOOD PROTECTION
 STRUCTURAL STEEL
 PUMPING STATION NO. 2
 TRASH RACKS & FRAMES
 SOUTH CHICKAMAUGA CREEK PROJECT
 TENNESSEE VALLEY AUTHORITY
 DIVISION OF ENGINEERING DESIGN

SUBMITTED	RECOMMENDED	APPROVED
<i>[Signature]</i>	<i>[Signature]</i>	<i>[Signature]</i>
DESIGN PROJECT MANAGER	NO. PROJECT	DATE
KNOXVILLE	2-8-77	BI C 108-19E235 RI


INSPECTED AND APPROVED FOR ISSUE	DATE
PRINT	SIZE

TECHNICAL INFORMATION CENTER
 KNOXVILLE


A
B
C
D
E
F
G
H
J
K

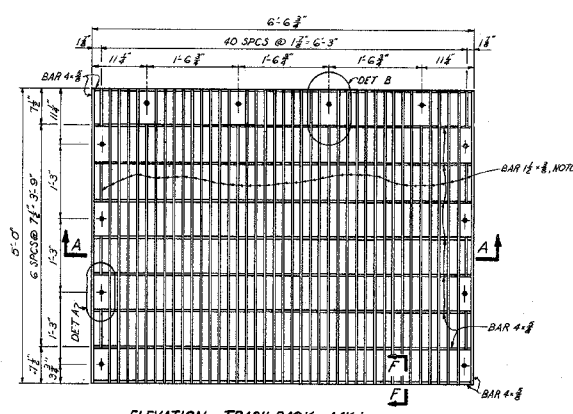


ELEVATION - TRASH RACK - MK 1
2 REQUIRED
1'-10"

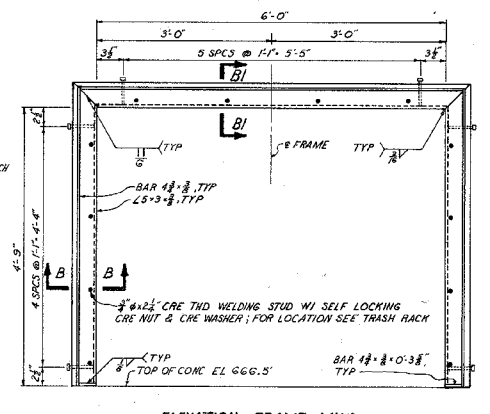


ELEVATION - FRAME - MK 2
2 REQUIRED
1'-10"

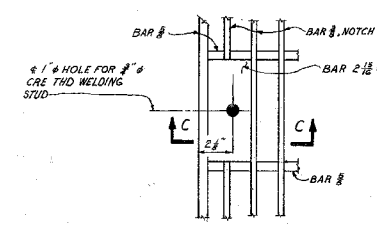


DET A

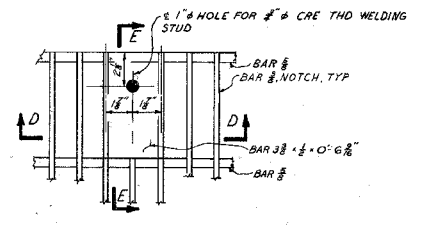


DET B

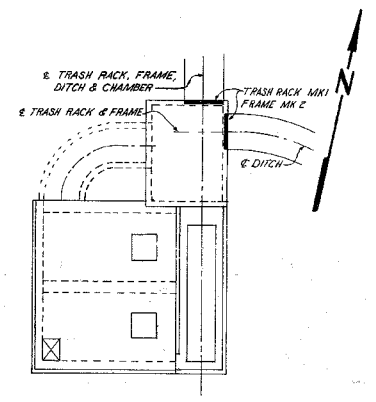


KEY PLAN
N.T.S.

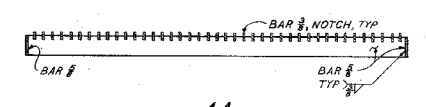


A-A
1'-10"

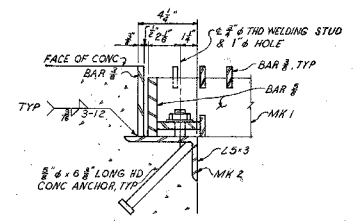


B-B
B-B SIMILAR

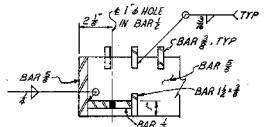


C-C

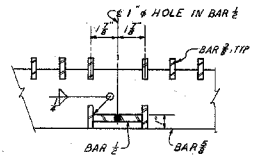

D-D

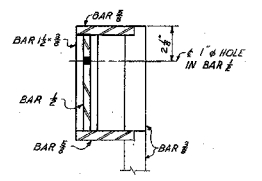

E-E

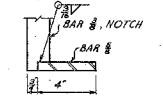

F-F

- NOTES:
1. STRUCTURAL SHAPES, PLATES AND BARS TO BE ASTM A-36.
 2. ALL WELDS BY FABRICATOR TO BE IN ACCORDANCE WITH LATEST AWS CODE.
 3. WELDING ELECTRODES TO BE AWS A5.1 E70 SERIES.
 4. ALL WELDED JOINTS TO BE SEAM WELDED.
 5. CONCRETE HEADED STUD ANCHORS TO BE ASTM A108.
 6. THREADED STUD WELDING FASTENERS SHALL BE KSM PRODUCT INC. STANDARD WELDING STUDS OR EQUAL.
 7. ALL SELF-LOCKING NUTS TO BE ANCO OR EQUAL.
 8. ALL MARK NUMBERS TO HAVE PREFIX 108-19E240.
 9. FOR MANUFACTURER'S DETAILS REFER TO VENETIAN IRON WORKS, INC. FILE TYN CONTRACT NO. 77K71-022230.

SCALE 3/4"=1'-0"
EXCEPT AS NOTED

CORRECTED DIMENSION MK 1	
DESIGNER	DATE
CHKD	DATE
APP'D	DATE
CHATTANOOGA FLOOD PROTECTION	
STRUCTURAL STEEL	
PUMPING STATION NO. 3	
TRASH RACKS & FRAMES	
SOUTH CHICKAMAUGA CREEK PROJECT	
TENNESSEE VALLEY AUTHORITY	
DIVISION OF ENGINEERING DESIGN	
SUBMITTED	RECOMMENDED
APPROVED	APPROVED
DESIGN PROJECT MANAGER	DATE
KNOXVILLE 2-8-77 81 C 108-19E240 R1	
RECORD DRAWING AS CONSTRUCTED	
DATE	

INSPECTED AND APPROVED FOR ISSUE	DATE
DESIGN PROJECT MANAGER	DATE
CHKD	DATE
APP'D	DATE
DATE	DATE
DATE	DATE
108-19E240 R1