

TENNESSEE VALLEY AUTHORITY - DIVISION OF ENGINEERING DESIGN

CONTRACT REFERENCE OR REQUISITION NO.	ITEM	CLASSIFICATION	DESCRIPTION	QUANTITY	UNITS	MARK NO.
C			48" D PRECAST CONCRETE PIPE, ASTM C76-72a, CLASS V, 4'-0" LONG WITH COMPRESSION TYPE RUBBER GASKETS, ASTM C443-72a	173	PCS	101-19E209-1
C			DUCTILE IRON MANHOLE STEPS, NEENAH R-1982-J, AS MFD BY NEENAH FOUNDRY CO., NEENAH, WISCONSIN, OR EQUAL	46	PCS	-2
C			CAST IRON MANHOLE FRAME & COVER, NEENAH R-1794-V, AS MFD BY NEENAH FOUNDRY CO., NEENAH, WISCONSIN, OR EQUAL	2		-3

NOTE: ALL QUANTITIES ARE NET

MF  
RO

CIVIL BILL OF MATERIAL

PROJECT SOUTH CHICKAMAUGA CREEK - LEVEE, CHANNEL & DETENTION BASIN

DWG NO. 101-19E209-1, 2 & 3

TVA 10573A (DED-11-75)

0		3-30-78	JLM	HAM	HAM	JWW			TJA	GLB	KNOXVILLE, TENN	DATE 3-30-78
REV NO.	ECN NO.	DATE	MADE	CHKD	SUPV	ENGR	INSP	SUBM	RECM	APPD	SH 1 OF 1	81 C 101-19BM209 RO

TENNESSEE VALLEY AUTHORITY - DIVISION OF ENGINEERING DESIGN

CONTRACT REFERENCE OR REQUISITION NO.	ITEM	CLASSIFICATION	DESCRIPTION	QUANTITY	UNITS	MARK NO.
C			CAST IRON GRATING, NEENAH R-4890, AS MFD BY NEENAH FOUNDRY CO., NEENAH, WISCONSIN, OR EQUAL	1		101-19E212-1
C			*36" D PRECAST CONCRETE PIPE, ASTM C76-72a CLASS III, 4'-0" LONG WITH COMPRESSION TYPE RUBBER GASKETS, ASTM C443-72a	85 PCS		-2
C			*24" D PRECAST CONCRETE PIPE, ASTM C76-72a CLASS III, 4'-0" LONG WITH COMPRESSION TYPE RUBBER GASKETS, ASTM C443-72a	30 PCS		-3
C			CAST IRON GRATING, NEENAH R-4891-A, AS MFD BY NEENAH FOUNDRY CO., NEENAH, WISCONSIN, OR EQUAL	2		-4
C			DUCTILE IRON MANHOLE STEPS, NEENAH R-1982-J, AS MFD BY NEENAH FOUNDRY CO., NEENAH, WISCONSIN, OR EQUAL	24 PCS		-5

\* IF STEEL PIPE IS USED FOR TUNNELING UNDER EXISTING ROADS, QUANTITIES OF CONCRETE PIPE REQUIRED WILL BE REDUCED.

NOTE : ALL QUANTITIES ARE NET

MR  
RO  
RI

TVA 10573A (DED-11-75)

										CIVIL BILL OF MATERIAL	
										PROJECT SOUTH CHICKAMAUGA CREEK-LEYEE CHANNEL & DETENTION BASIN	
1		7-25-78	JLM	JWR	JWN	ELS					DWG NO. 101-19E212-1 & 2
0		7-18-78	JLM	HAM	HAM	JWAF	ELS				KNOXVILLE, TENN DATE 7-18-78
REV NO.	ECN NO.	DATE	MADE	CHKD	SUPV	ENGR	INSP	SUBM	RECM	APPD	SH 1 OF 1 81 C 101-19BM212R1



TENNESSEE VALLEY AUTHORITY - DIVISION OF ENGINEERING DESIGN

CONTRACT REFERENCE OR REQUISITION NO.	ITEM	CLASSIFICATION	DESCRIPTION	QUANTITY	UNITS	MARK NO.
C			TYPE I PVC SEALS	179	LF	
C			TYPE II PVC SEALS	350	LF	
C			4" D STD WT BLACK STEEL, 22" LONG	14 PCS		101-19E225 - 4

NOTE: ALL QUANTITIES ARE NET.

MF  
20

CIVIL BILL OF MATERIAL

PROJECT SOUTH CHICKAMAUGA  
CREEK-PUMPING STATION NO. 1

-----

DWG NO. 101-19E225-1 THRU 4

TVA 10573A (DED-11-75)

0		6-24-77	E.P.C.	JLM	HAM	JWW						KNOXVILLE, TENN	DATE	6-24-77
REV NO.	ECN NO.	DATE	MADE	CHKD	SUPV	ENGR	INSP	SUBM	RECM	APPD	SH 1 OF 1	C	101-19BM225 R	



TENNESSEE VALLEY AUTHORITY - DIVISION OF ENGINEERING DESIGN

CONTRACT REFERENCE OR REQUISITION NO.	ITEM	CLASSIFICATION	DESCRIPTION	QUANTITY	UNITS	MARK NO.							
C			CAST IRON GRATING, NEENAH R-4825, AS MFD BY NEENAH FOUNDRY CO., NEENAH, WISCONSIN, OR EQUAL	1		101-19E230 -1							
C			15" D PRECAST CONCRETE PIPE, ASTM C76-72a, CLASS V, 4'-0" LONG WITH COMPRESSION TYPE RUBBER GASKETS, ASTM C443-72a	7 PCS		-2							
NOTE: ALL QUANTITIES ARE NET													
				CIVIL BILL OF MATERIAL									
				PROJECT SOUTH CHICKAMAUGA CREEK-PUMPING STATION NO. 1 FINAL GRADING									
				DWG NO. 101-19E230-1 & 2									
0		3-31-78	JLM HAM HAM JWP ELS			KNOXVILLE, TENN DATE 3-31-78							
REV NO.	ECN NO.	DATE	MADE	CHKD	SUPV	ENGR	INSP	SUBM	RECM	APPD	SH / OF /	81 C	101-19BM230 RD

TVA 10573A (DED-11-75)

TENNESSEE VALLEY AUTHORITY - DIVISION OF ENGINEERING DESIGN

CONTRACT REFERENCE OR REQUISITION NO.	ITEM	CLASSIFICATION	DESCRIPTION	QUANTITY	UNITS	MARK NO.
C			Cast iron manhole steps, Neenah R-1982-J, as mfd by Neenah Foundry Co., Neenah, Wisconsin, or equal	17 pcs		101-19E-235 -1
C			4" D std wt black steel pipe, 9" long	6 pcs		-2
C			54" D precast concrete pipe, ASTM C 76-72 a, Class III, 4'-0" long with compression type rubber gaskets, ASTM C 443-72 a	6 pcs		-3
C			54" D precast concrete pipe adapter section 21" long (see 101-19E 235-5, detail G5). Strength to conform to ASTM C 76-72 a, Class III	1		-4
C			Type II PVC seals	1200	lf	

Note: All quantities are net

MF  
RO

CIVIL BILL OF MATERIAL

PROJECT SOUTH CHICKAMAUGA  
CREEK-PUMPING STATION NO. 2

DWG NO. 101-19E 235-1 THRU 5

KNOXVILLE, TENN DATE 6-1-77

SH 1 OF 1 81 C 101-19BM235 RO

TVA 10573A (DED-11-75)

0		6-1-77	V.F.V.	RBR	HAM	JNW	ELS				
REV NO.	ECN NO.	DATE	MADE	CHKD	SUPV	ENGR	INSP	SUBM	RECM	APPD	

TENNESSEE VALLEY AUTHORITY - DIVISION OF ENGINEERING DESIGN

CONTRACT REFERENCE OR REQUISITION NO.	ITEM	CLASSIFICATION	DESCRIPTION	QUANTITY	UNITS	MARK NO.
C			Cast iron manhole steps, Neenah R-1982-J, as mfd by Neenah Foundry Co., Neenah, Wisconsin, or equal	17 pcs		101-19E 240-1
C			4" D std wt black steel pipe, 9" long	4 pcs		-2
C			36" D precast concrete pipe, ASTM C76-72a, Class III, 4'-0" long with compression type rubber gaskets, ASTM C 443-72 a	12 pcs		-3
C			36" D precast concrete pipe adapter section 21" long (see 101-19E 240-4, detail G4). Strength to conform to ASTM C76-72 a, Class III	1		-4
C			Type II PVC seals	900	lf	

Note: All quantities are net

MF  
RO



CIVIL BILL OF MATERIAL

PROJECT SOUTH CHICKAMAUGA CREEK-PUMPING STATION NO. 3

DWG NO. 101-19E 240-1 THRU 4

TVA 10573A (DED-11-75)





0		6-1-77	V.F.V.	RBR	HAM	JWW	ELS					KNOXVILLE, TENN	DATE	6-1-77
REV NO.	ECN NO.	DATE	MADE	CHKD	SUPV	ENGR	INSP	SUBM	RECM	APPD	SH	1	OF	1
											81	C	101-19BM240	RO

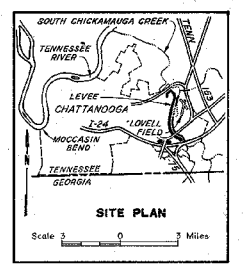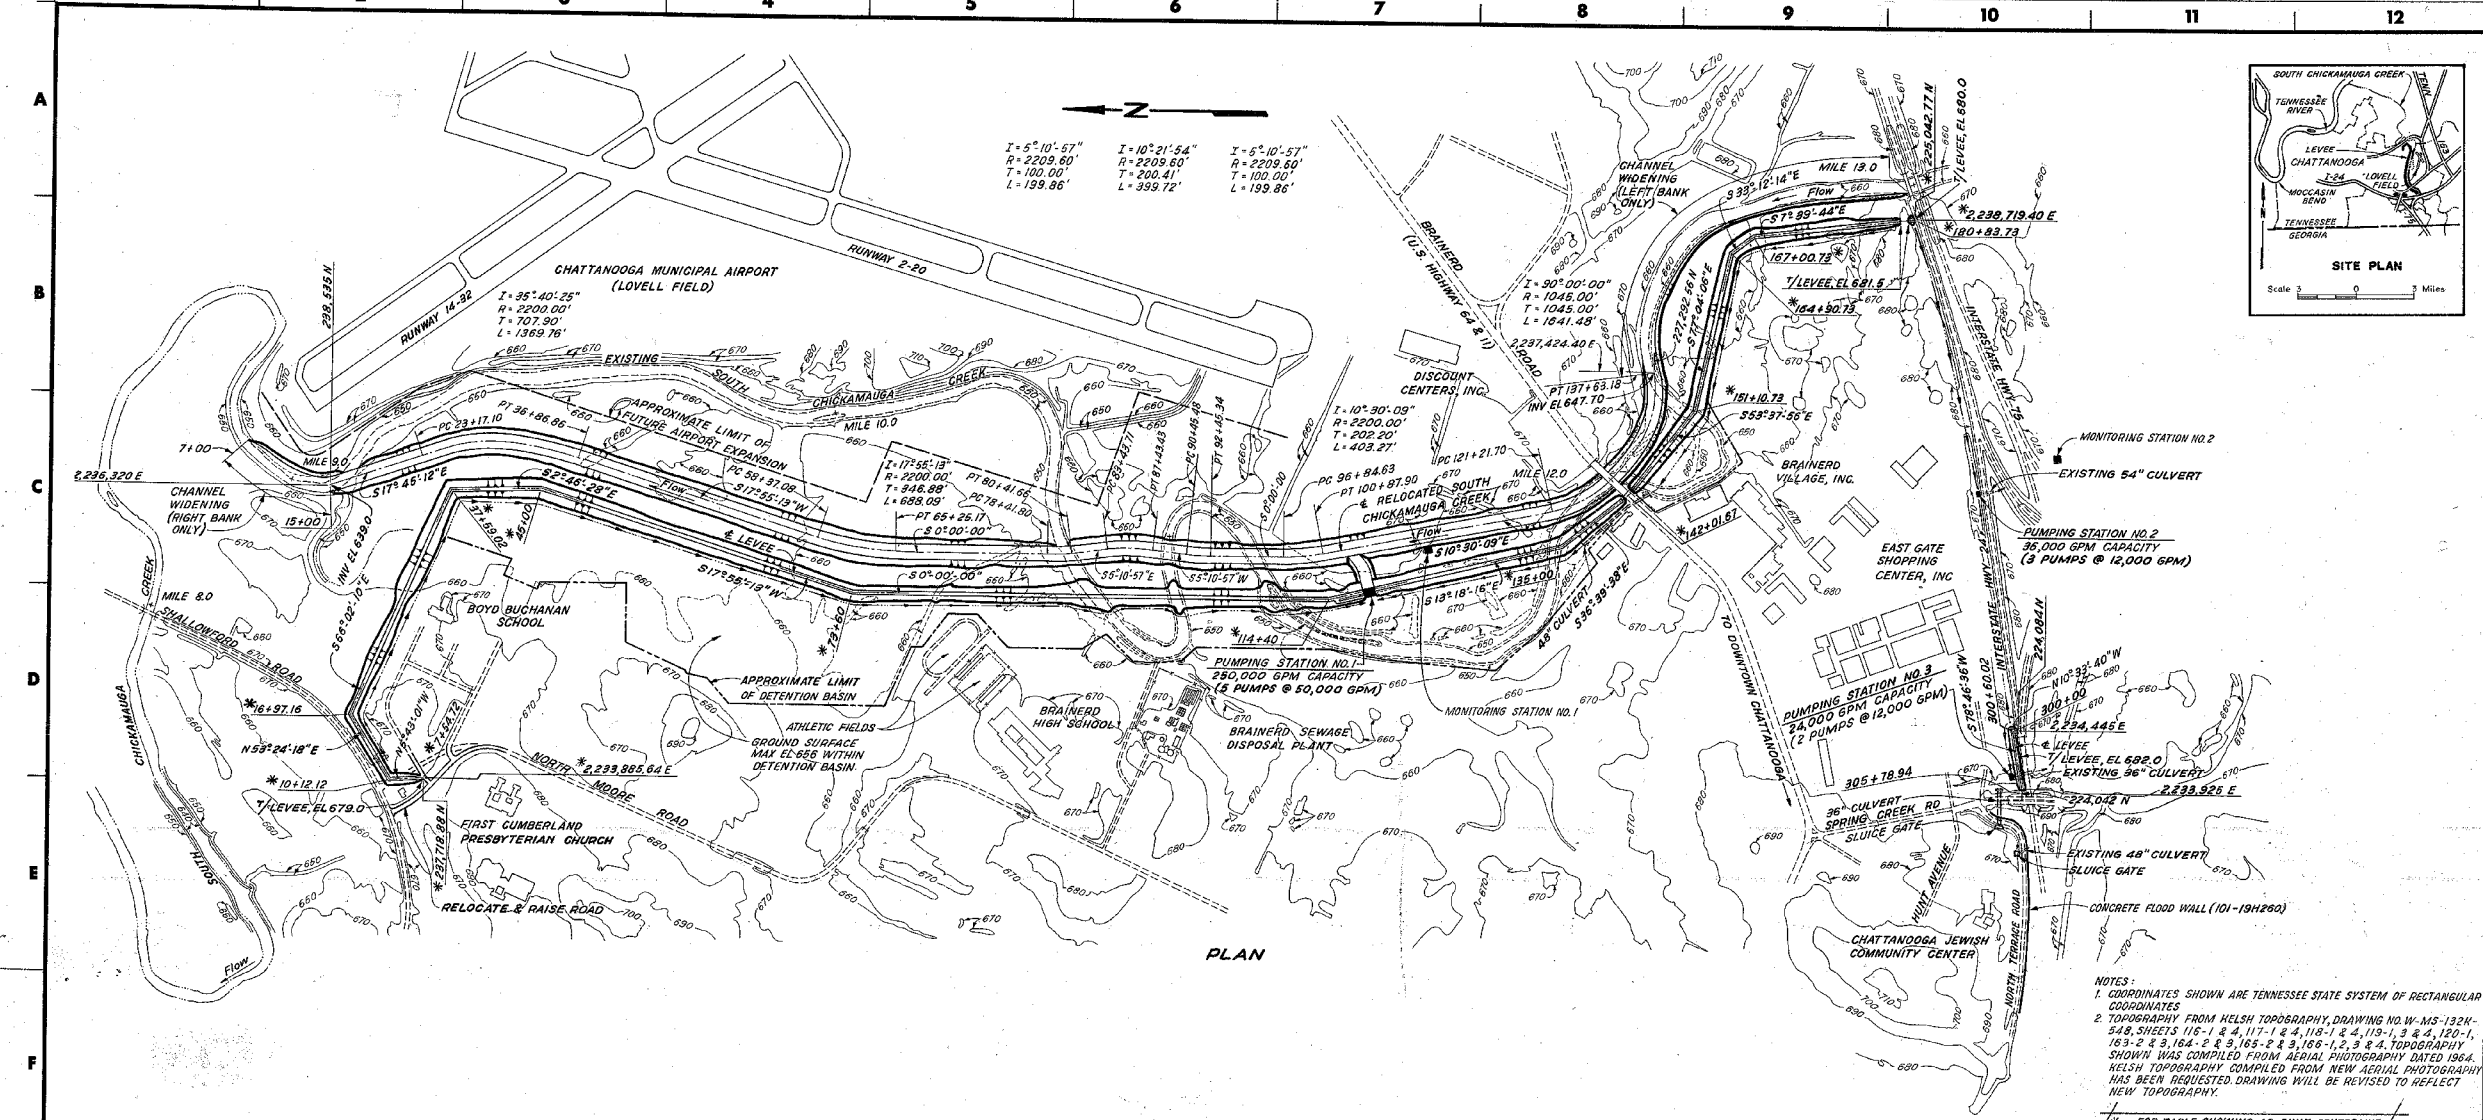

**NOTES:**


- COORDINATES SHOWN ARE TENNESSEE STATE SYSTEM OF RECTANGULAR COORDINATES
- TOPOGRAPHY FROM HELSH TOPOGRAPHY, DRAWING NO. W-MS-1324-548, SHEETS 116-1 & 4, 117-1 & 4, 118-1 & 4, 119-1, 3 & 4, 120-1, 123-2 & 3, 124-2 & 3, 125-2 & 3, 126-1, 2 & 3, 127-1, 2 & 3, 128-1, 2 & 3, 129-1, 2 & 3. TOPOGRAPHY SHOWN WAS COMPILED FROM AERIAL PHOTOGRAPHY DATED 1964. HELSH TOPOGRAPHY COMPILED FROM NEW AERIAL PHOTOGRAPHY HAS BEEN REQUESTED DRAWING WILL BE REVISED TO REFLECT NEW TOPOGRAPHY.




SEE TABLE SHOWING AS-BUILT CENTERLINE OF LEVEE SEE 101-19E205-1

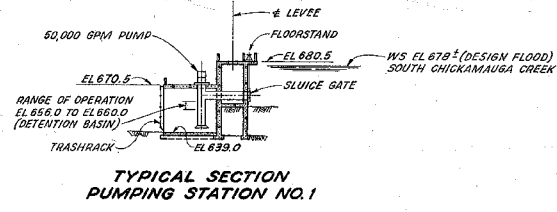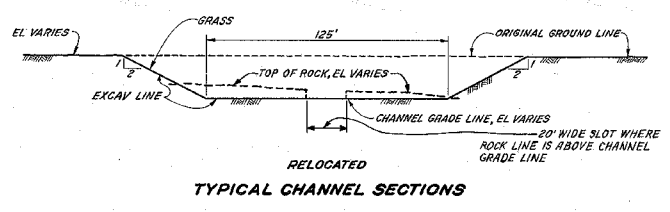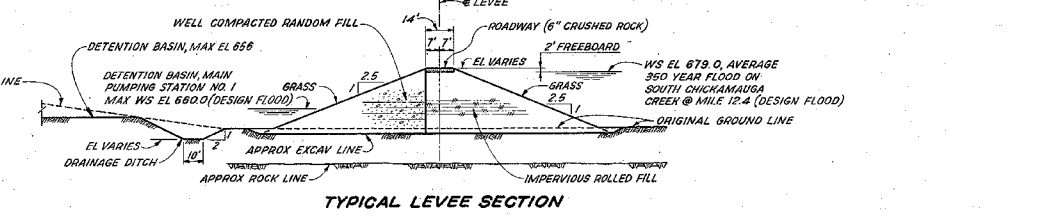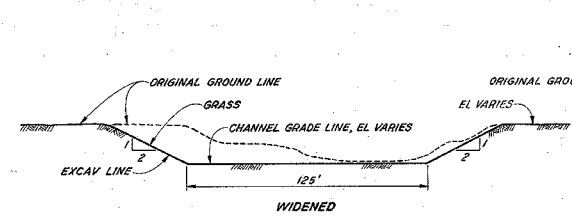

7	FINAL FIELD REV.	1-3-65	JAM	PMI	WMB	10/1
6	REVISED ALIGNMENT & STATIONS OF LEVEE AT RELOCATED NORTH MOORE ROAD, D2	11-6-70	JAM	WMB	WMB	10/1
5	REVISED ALIGNMENT & STATIONS OF LEVEE AT RELOCATED NORTH MOORE ROAD, D2; REMOVED LEVEE AT HUNT AVENUE; RELOCATED 8\"/>					
4	REVISED ALIGNMENT & STATIONS OF RELOCATED SOUTH CHICKAMAUGA CREEK	11-25-71	JAM	WMB	WMB	10/1
3	REVISED ALIGNMENT & STATIONS OF LEVEES; REMOVED HOLD, C12	11-26-76	JAM	WMB	WMB	10/1
2	DELETED NOTE 3; ADDED HOLD, C12; MONITORING STATIONS B, C, D, E, F, G, H, I, J, K, L, M, N, O, P, Q, R, S, T, U, V, W, X, Y, Z; REMOVED 30\"/>					
1	REMOVED RDWY & BRIDGE TO PUMPING STA NO. 1, REV TYP CHANNEL SECTION, MINOR REV.	11-26-77	JAM	WMB	WMB	10/1

CHATTANOOGA FLOOD PROTECTION ALL FEATURES		
GENERAL PLANS & SECTIONS		
SOUTH CHICKAMAUGA CREEK PROJECT TENNESSEE VALLEY AUTHORITY DIVISION OF ENGINEERING DESIGN		
SUBMITTED	RECOMMENDED	APPROVED
BY: J. L. MAXEY	BY: J. L. MAXEY	BY: J. L. MAXEY
CHECKED: H. A. BRANNON	CHECKED: H. A. BRANNON	CHECKED: H. A. BRANNON
DATE: 2-17-74	DATE: 2-17-74	DATE: 2-17-74
INSPECTED AND APPROVED FOR ISSUE		
KNOXVILLE 101-19E200 R7		

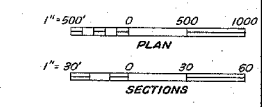

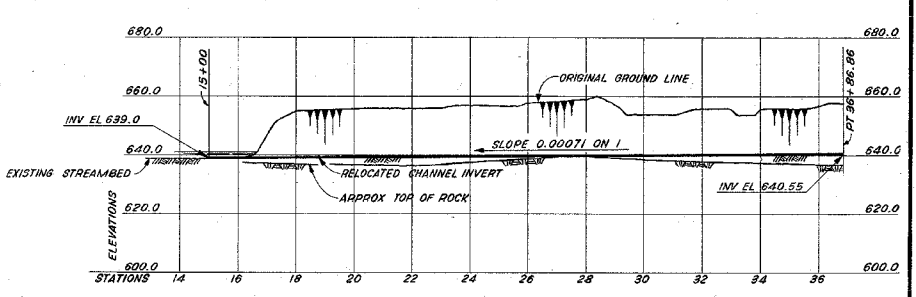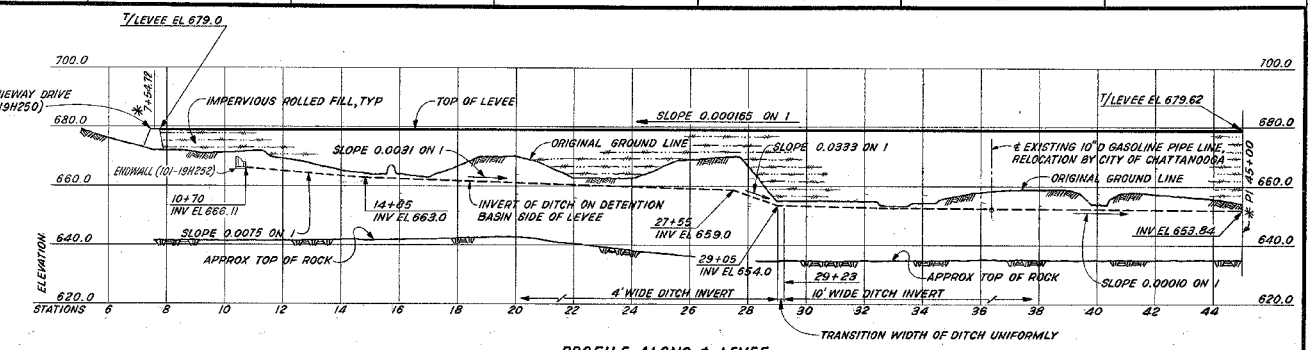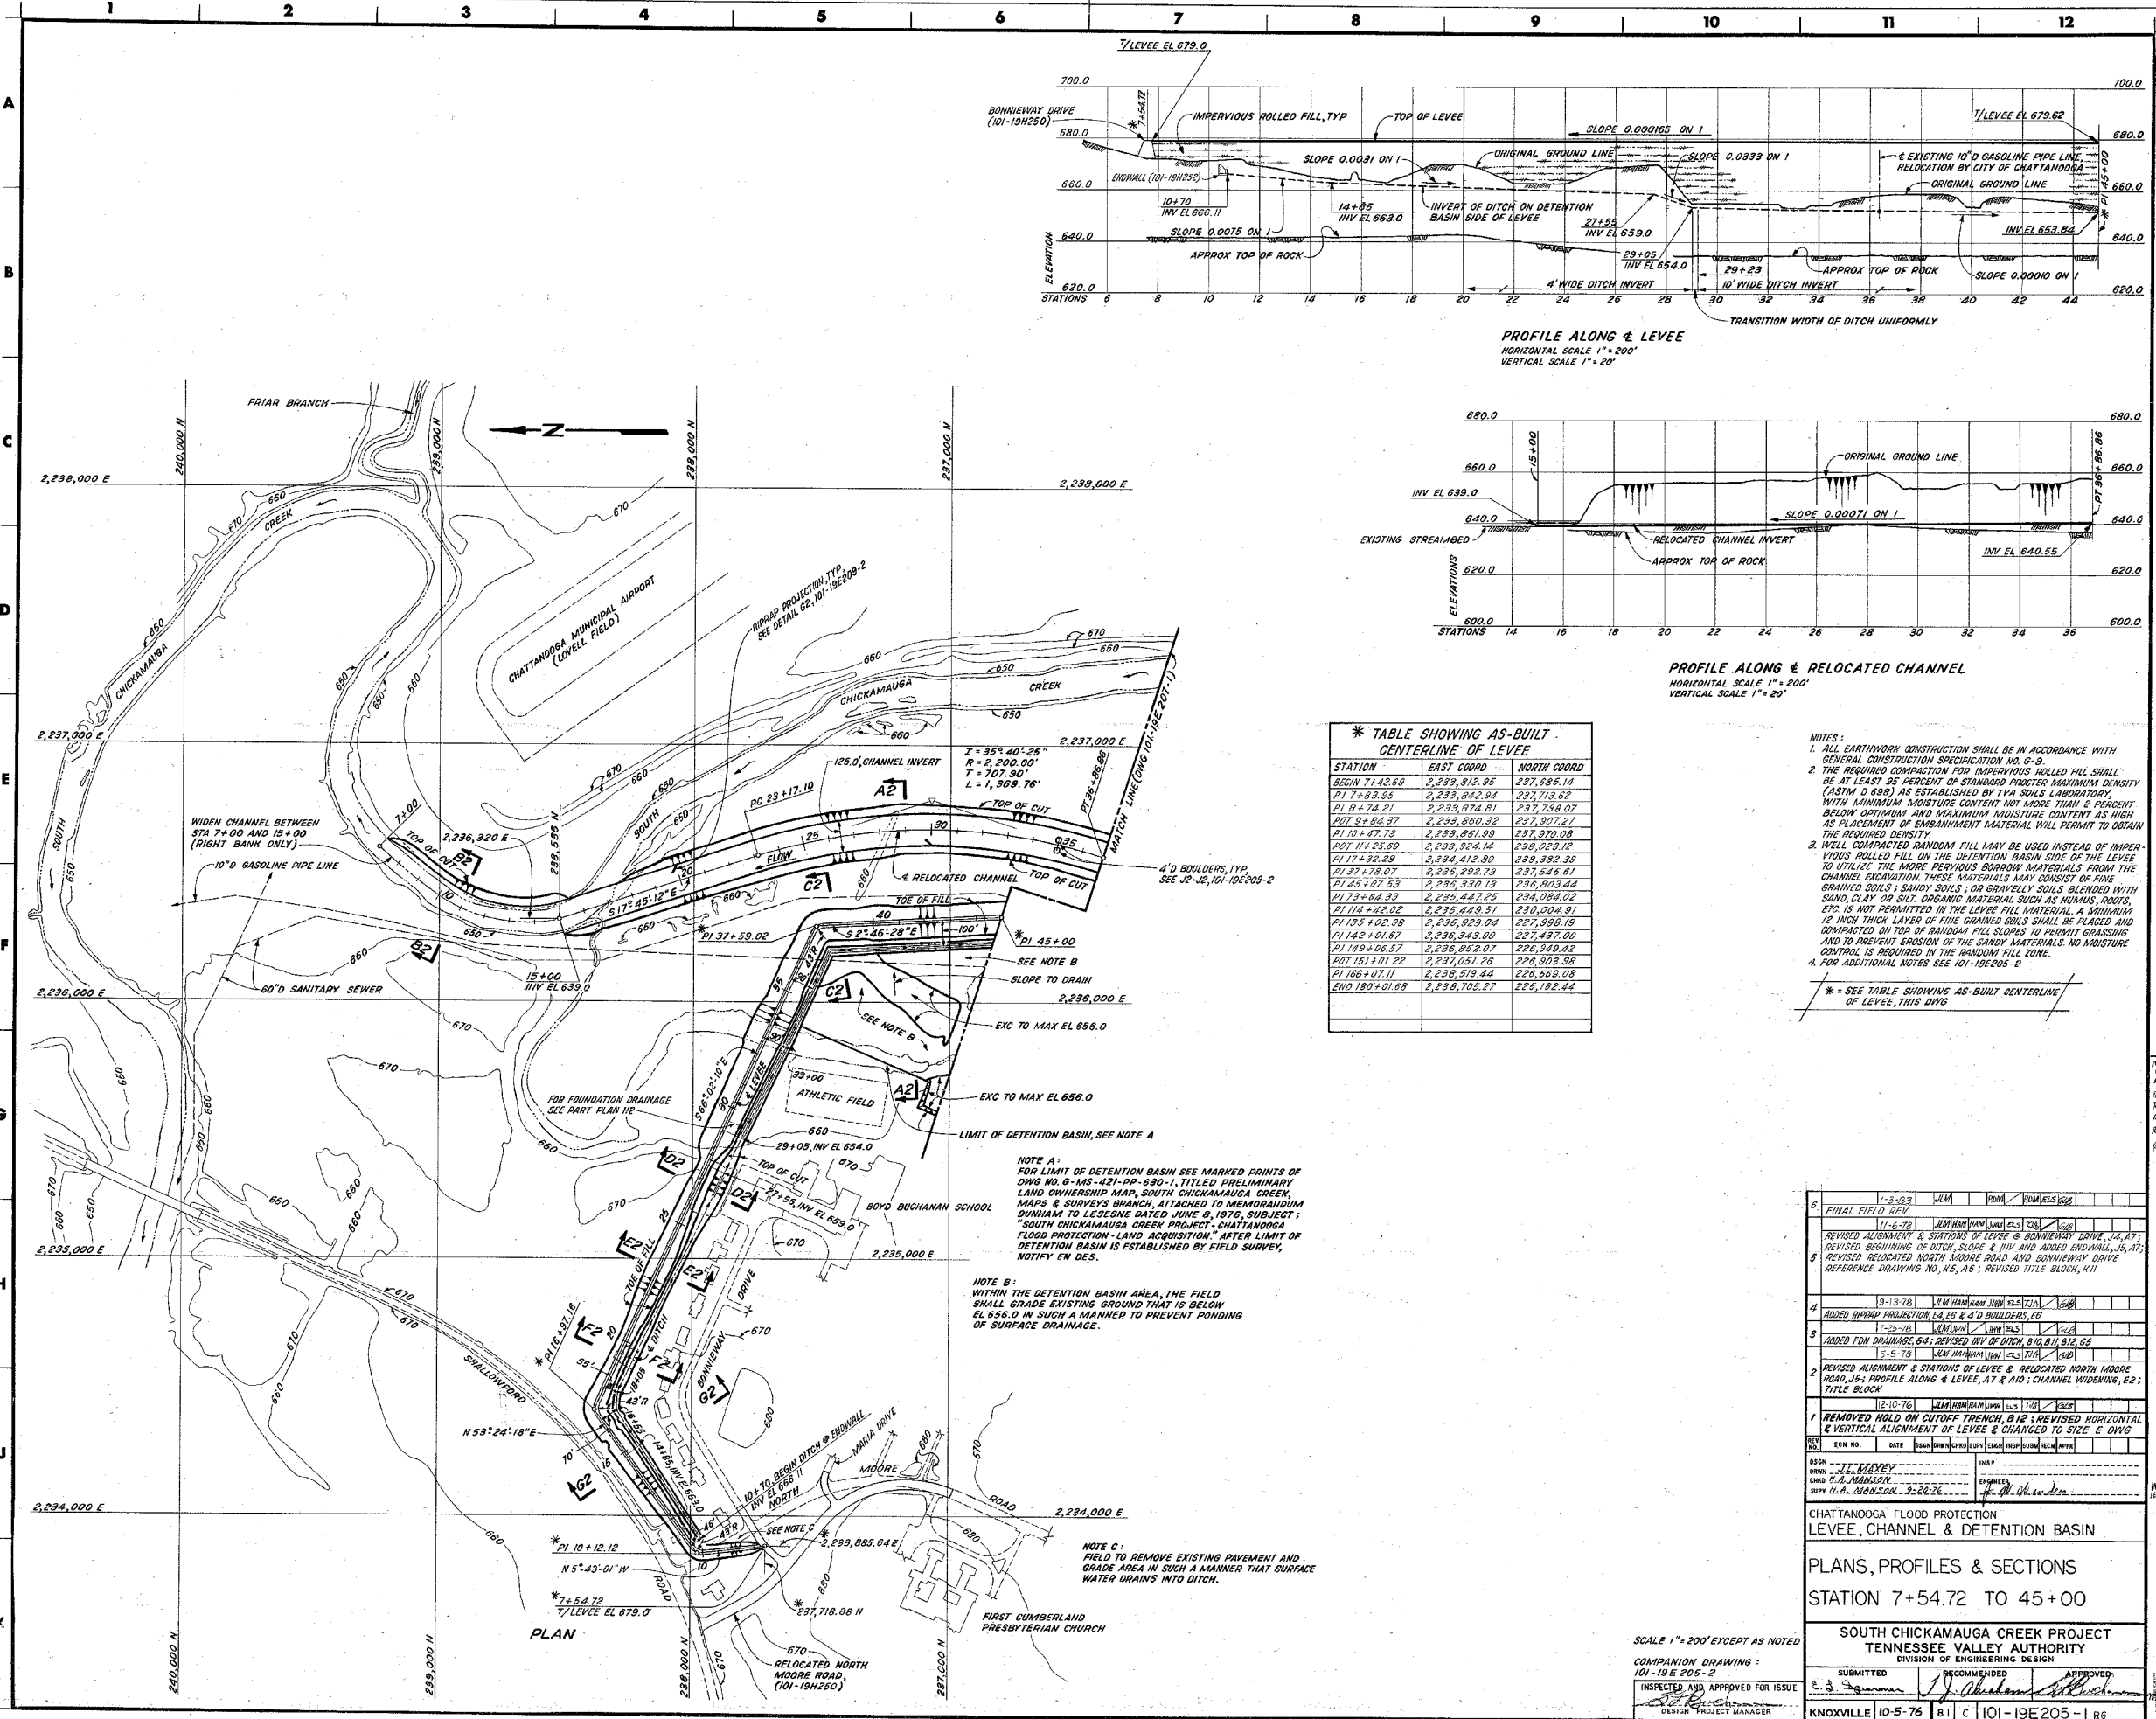

**\* TABLE SHOWING AS-BUILT CENTERLINE OF LEVEE**

STATION	EAST COORD	NORTH COORD
BEGIN 7+42.68	2,233,812.95	237,685.14
PI 7+53.25	2,233,842.84	237,713.62
PI 8+74.21	2,233,874.81	237,738.07
PI 9+84.37	2,233,860.32	237,907.27
PI 10+47.73	2,233,861.09	237,970.08
PI 11+25.89	2,233,924.14	238,023.12
PI 12+32.29	2,234,412.89	238,382.39
PI 13+78.07	2,236,292.79	237,545.67
PI 14+07.53	2,236,330.19	236,903.44
PI 15+64.32	2,235,447.25	234,084.02
PI 16+42.02	2,235,449.51	234,004.91
PI 17+02.98	2,236,923.04	227,998.19
PI 18+01.67	2,236,343.00	227,487.00
PI 19+06.57	2,236,852.07	226,349.42
PI 20+07.11	2,237,051.25	226,303.98
PI 21+01.09	2,236,519.44	226,569.08
END 18+01.09	2,238,705.27	229,192.44

**NOTES:**

- ALL EARTHWORK CONSTRUCTION SHALL BE IN ACCORDANCE WITH GENERAL CONSTRUCTION SPECIFICATION NO. G-9.
- THE REQUIRED COMPACTION FOR IMPERVIOUS ROLLED FILL SHALL BE AT LEAST 95 PERCENT OF STANDARD PROCTOR MAXIMUM DENSITY (ASTM D 698) AS ESTABLISHED BY TVA SOILS LABORATORY WITH MINIMUM MOISTURE CONTENT NOT MORE THAN 2 PERCENT BELOW OPTIMUM AND MAXIMUM MOISTURE CONTENT AS HIGH AS PLACEMENT OF EMBANKMENT MATERIAL WILL PERMIT TO OBTAIN THE REQUIRED DENSITY.
- WELL COMPACTED RANDOM FILL MAY BE USED INSTEAD OF IMPERVIOUS ROLLED FILL ON THE DETENTION BASIN SIDE OF THE LEVEE TO UTILIZE THE MORE PREVIOUS BORROW MATERIALS FROM THE CHANNEL EXCAVATION. THESE MATERIALS MAY CONSIST OF FINE GRAINED SOILS & SANDY SOILS; OR GRAVELLY SOILS BLENDED WITH SAND, CLAY OR SILT ORGANIC MATERIAL SUCH AS HUMUS, ROOTS, ETC. IS NOT PERMITTED IN THE LEVEE FILL MATERIAL. A MINIMUM 12 INCH THICK LAYER OF FINE GRAINED SOILS SHALL BE PLACED AND COMPACTED ON TOP OF RANDOM FILL SLOPES TO PERMIT GRASSING AND TO PREVENT EROSION OF THE SANDY MATERIALS. NO MOISTURE CONTROL IS REQUIRED IN THE RANDOM FILL ZONE.
- FOR ADDITIONAL NOTES SEE 101-19E205-2

\* SEE TABLE SHOWING AS-BUILT CENTERLINE OF LEVEE, THIS DWG

**NOTE A:**  
FOR LIMIT OF DETENTION BASIN SEE MARKED PRINTS OF DWG NO. G-MS-421-PP-830-1, TITLED PRELIMINARY LAND OWNERSHIP MAP, SOUTH CHICKAMAUGA CREEK, MAPS & SURVEYS BRANCH, ATTACHED TO MEMORANDUM DUNHAM TO LESGNE DATED JUNE 8, 1976, SUBJECT: "SOUTH CHICKAMAUGA CREEK PROJECT - CHATTANOOGA FLOOD PROTECTION - LAND ACQUISITION". AFTER LIMIT OF DETENTION BASIN IS ESTABLISHED BY FIELD SURVEY, NOTIFY EN DES.

**NOTE B:**  
WITHIN THE DETENTION BASIN AREA, THE FIELD SHALL GRADE EXISTING GROUND THAT IS BELOW EL 656.0 IN SUCH A MANNER TO PREVENT PONDING OF SURFACE DRAINAGE.

**NOTE C:**  
FIELD TO REMOVE EXISTING PAVEMENT AND GRADE AREA IN SUCH A MANNER THAT SURFACE WATER DRAINS INTO DITCH.

NO.	DATE	BY	FOR	REVISION
6	1-3-83	WAM	WAM	FINAL FIELD REV
5	11-2-78	WAM	WAM	REVISED ALIGNMENT & STATIONS OF LEVEE & RELOCATED CHANNEL, B12, B13; REVISED BEGINNING OF DITCH, SLOPE & INV AND ADDED ENVIALL, B15, B17; REVISED RELOCATED NORTH MOORE ROAD AND BONNIEWAY DRIVE REFERENCE DRAWING NO. H5, A6; REVISED TITLE BLOCK, K11
4	9-13-78	WAM	WAM	ADDED RIPRAP PROJECTION, E4, E6 & 4' D BOULDERS, E8
3	7-28-78	WAM	WAM	ADDED FILL DRAINAGE, B4; REVISED INV OF DITCH, B10, B11, B12, B5
2	1-5-78	WAM	WAM	REVISED ALIGNMENT & STATIONS OF LEVEE & RELOCATED NORTH MOORE ROAD, J5; PROFILE ALONG LEVEE, A7 & A10; CHANNEL WORKING, E2; TITLE BLOCK
1	12-10-76	WAM	WAM	REMOVED HOLD ON CUTOFF TRENCH, B12; REVISED HORIZONTAL & VERTICAL ALIGNMENT OF LEVEE & CHANGED TO SIZE E DWG

CHATTANOOGA FLOOD PROTECTION  
LEVEE, CHANNEL & DETENTION BASIN

PLANS, PROFILES & SECTIONS  
STATION 7+54.72 TO 45+00

SOUTH CHICKAMAUGA CREEK PROJECT  
TENNESSEE VALLEY AUTHORITY  
DIVISION OF ENGINEERING DESIGN




SUBMITTED: [Signature] APPROVED: [Signature]

INSPECTED AND APPROVED FOR ISSUE: [Signature] DESIGN PROJECT MANAGER

KNOXVILLE 10-5-76 | 81 C | 101-19E205-1 R6

SCALE 1" = 200' EXCEPT AS NOTED  
COMPANION DRAWING:  
101-19E205-2



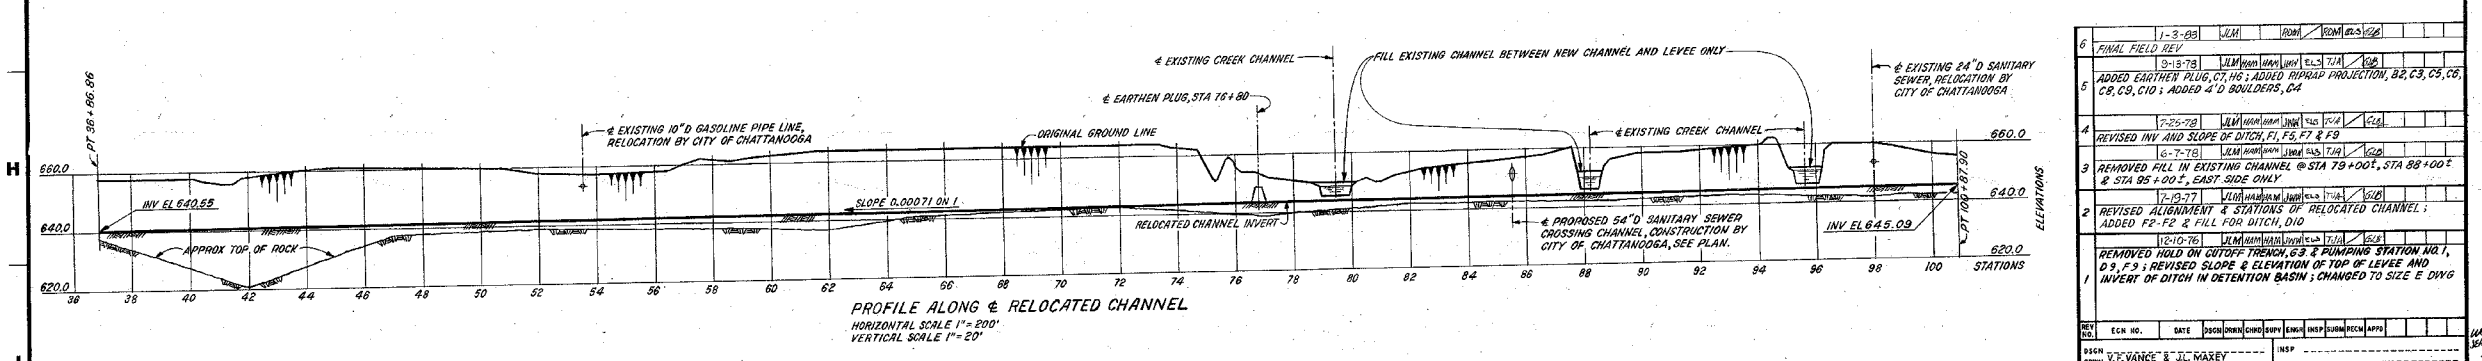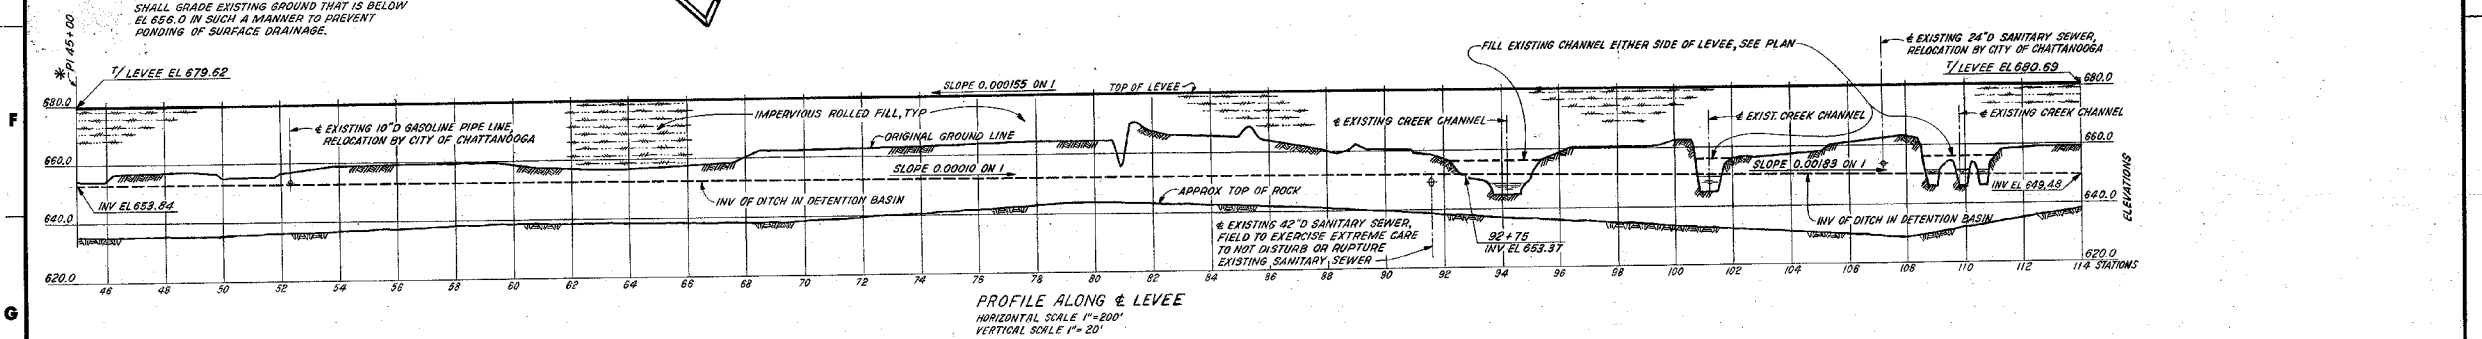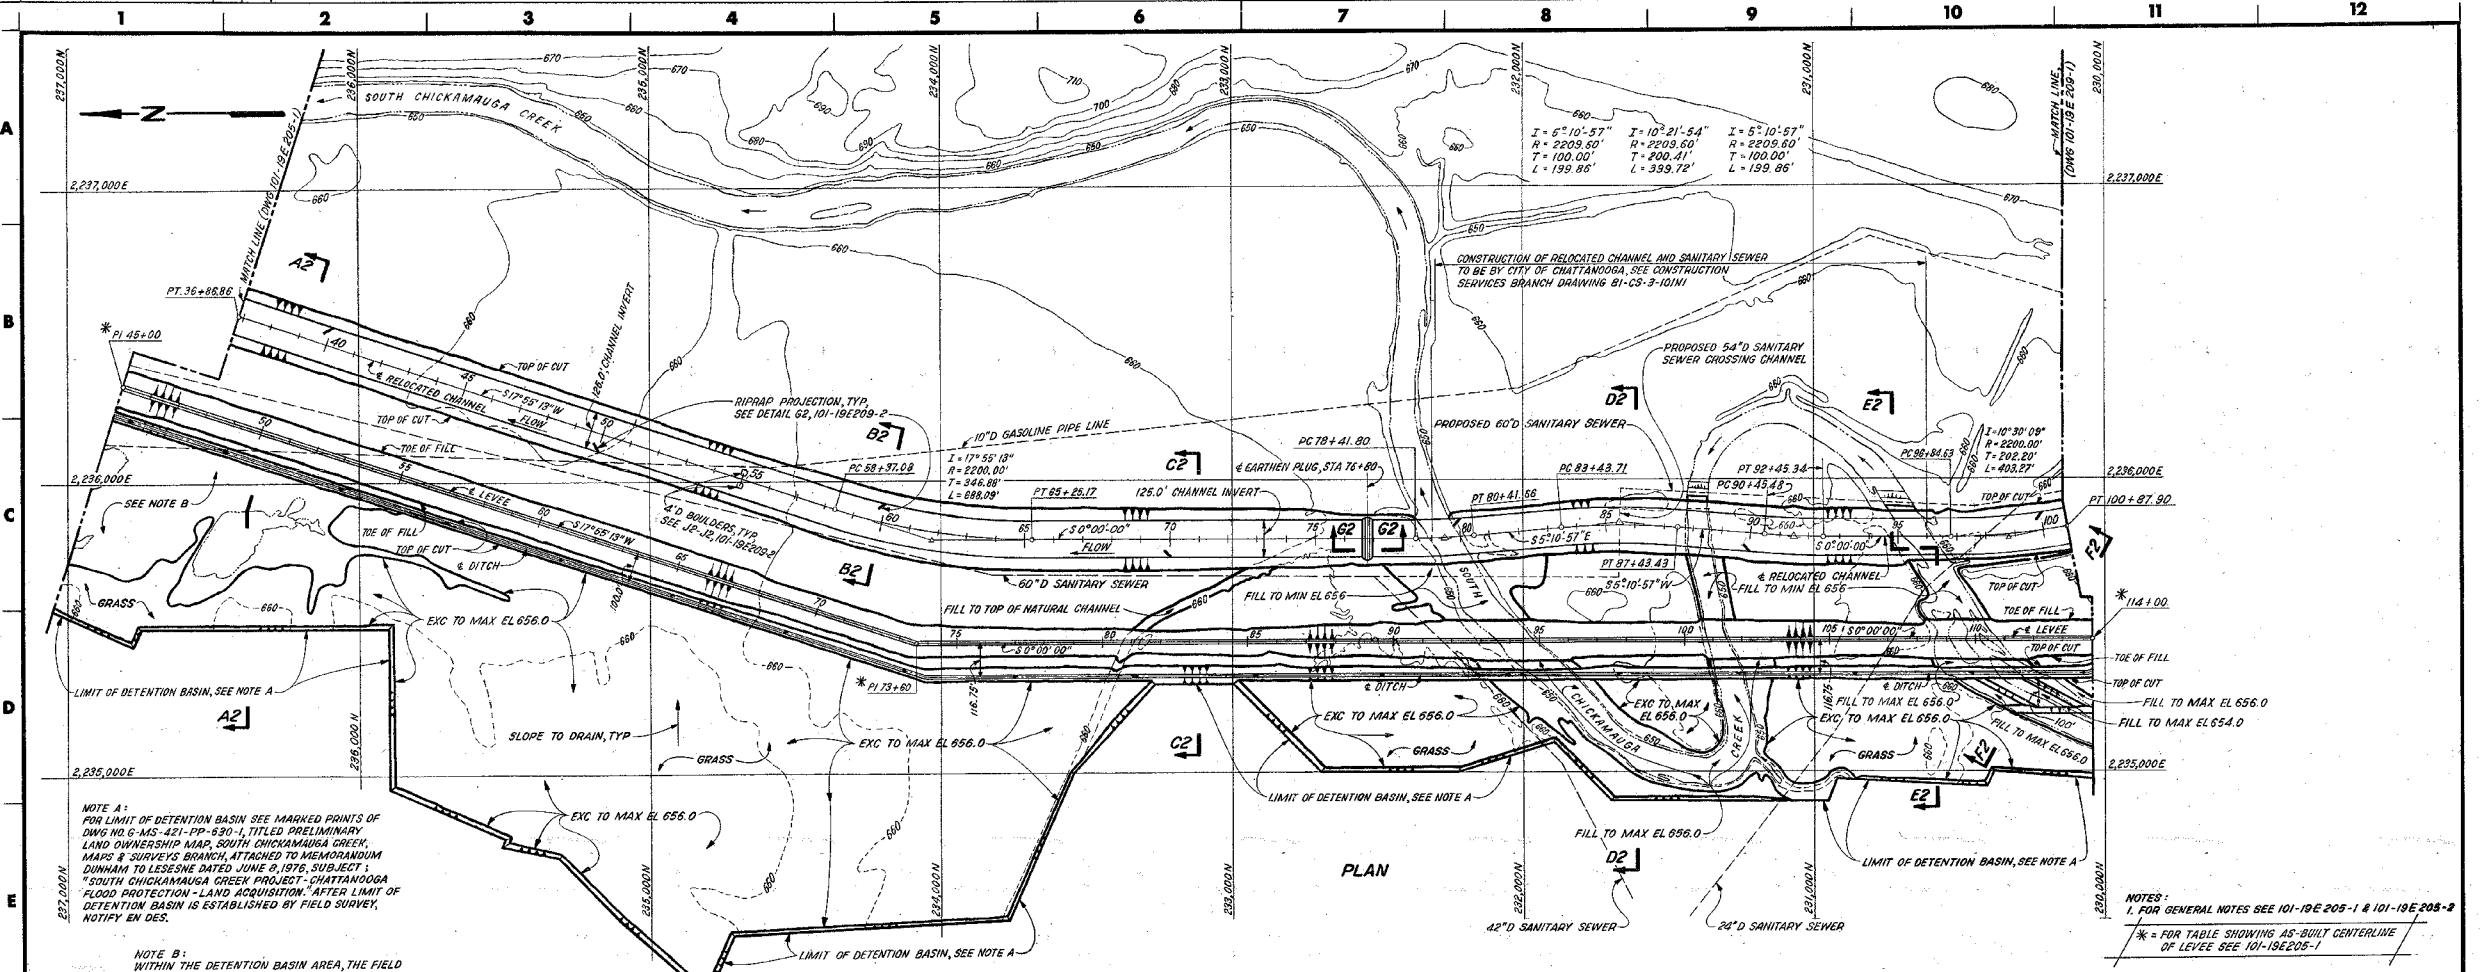

**CHATTANOOGA FLOOD PROTECTION  
LEVEE, CHANNEL & DETENTION BASIN**

**PLANS, PROFILES & SECTIONS  
STATION 45+00 TO 114+00**

**SOUTH CHICKAMAUGA CREEK PROJECT  
TENNESSEE VALLEY AUTHORITY  
DIVISION OF ENGINEERING DESIGN**

REVISION	NO.	DATE	BY	CHKD	APPD
6	FINAL FIELD REV	1-3-08	JULI	ROM	WMA/MS/S
5	ADDED EARTHEN PLUG, CT, HS; ADDED RIPRAP PROJECTION, B2, C3, C5, C6, C8, C9, C10; ADDED 4' D BOULDERS, C4	10-13-78	WMA	WMA	WMA
4	REVISED INV AND SLOPE OF DITCH, F1, F5, F7 & F9	7-25-78	WMA	WMA	WMA
3	REMOVED FILL IN EXISTING CHANNEL @ STA 79+00', STA 88+00' & STA 85+00', EAST SIDE ONLY	6-7-78	WMA	WMA	WMA
2	REVISED ALIGNMENT & STATIONS OF RELOCATED CHANNEL; ADDED FP-F2 & FILL FOR DITCH, D10	1-10-77	WMA	WMA	WMA
1	REMOVED HOLD ON CUTOFF TRENCH, G3 & PUMPING STATION NO. 1, D.9, F.3; REVISED SLOPE & ELEVATION OF TOP OF LEVEE AND INVERT OF DITCH IN DETENTION BASIN; CHANGED TO SIZE E DIVG	12-10-76	WMA	WMA	WMA

SCALE 1" = 200' EXCEPT AS NOTED

COMpanion DRAWING 101-19E207-2

INSPECTED AND APPROVED FOR ISSUE

PRINTED AT THE TENNESSEE VALLEY AUTHORITY PRINTING SHOP, KNOXVILLE, TENN.

NO. OF PRINTS: 12

DATE: 10-13-78





BY: J. H. MANNING

CHATTANOOGA FLOOD PROTECTION  
LEVEE, CHANNEL & DETENTION BASIN  
STATION 45+00 TO 114+00  
SOUTH CHICKAMAUGA CREEK PROJECT  
TENNESSEE VALLEY AUTHORITY  
DIVISION OF ENGINEERING DESIGN  
KNOXVILLE 10-5-78 81 c 101-19E 207-1 re








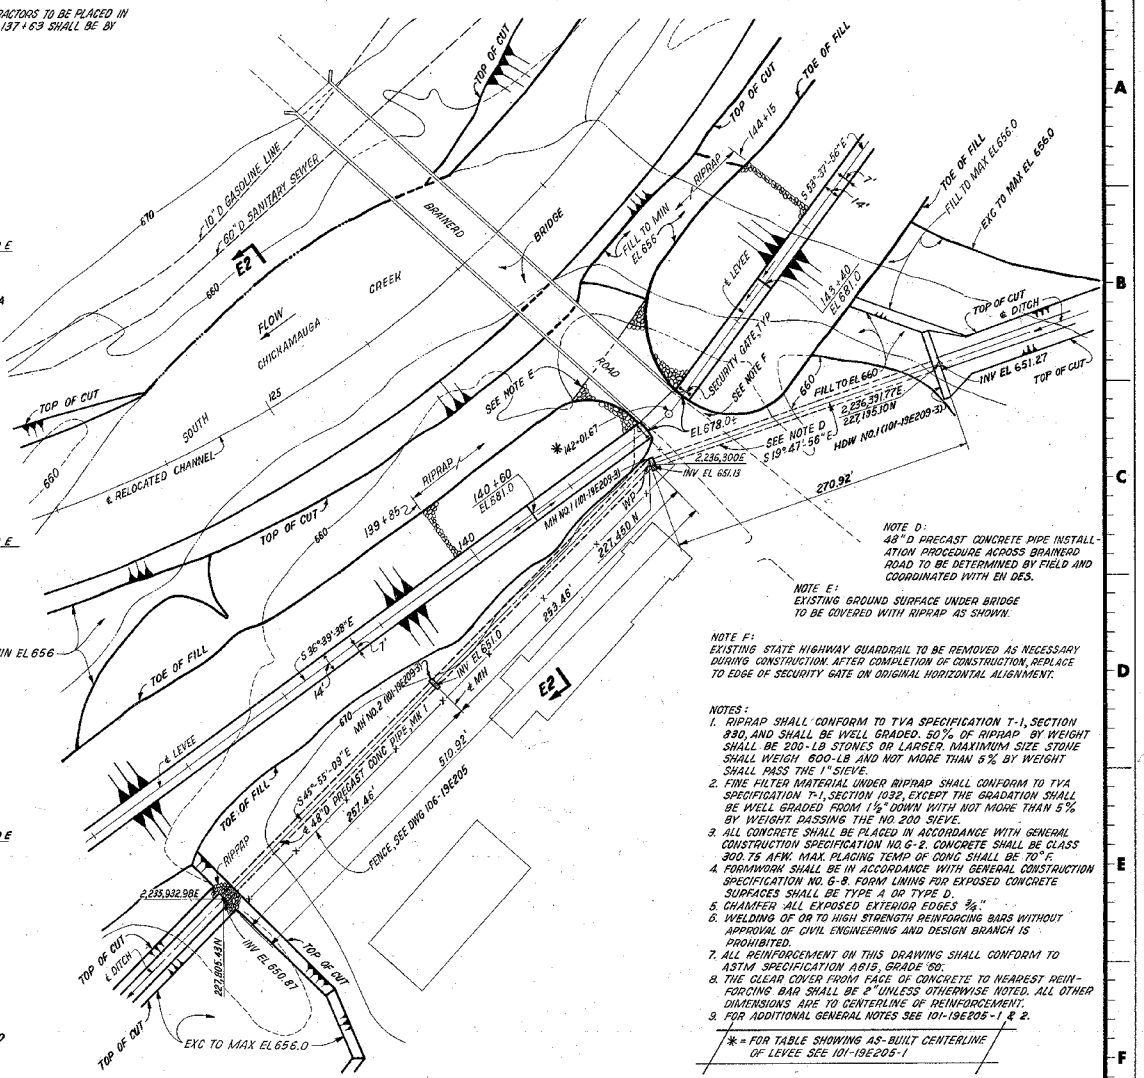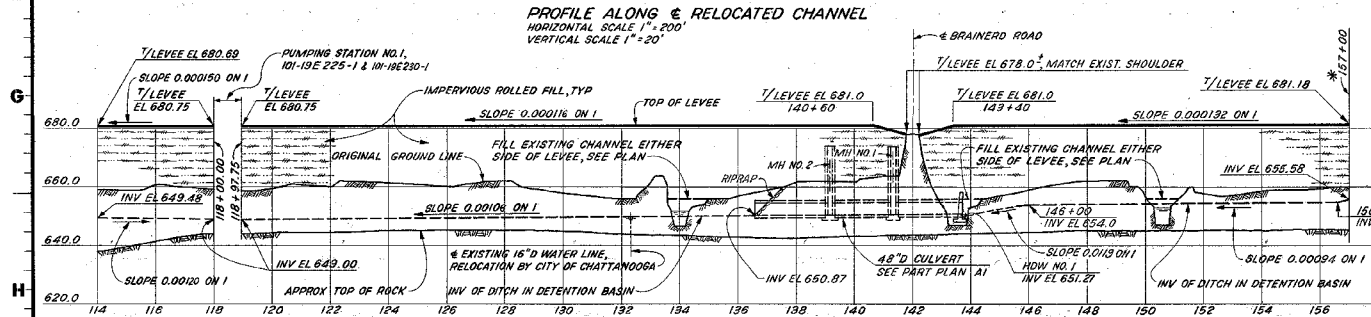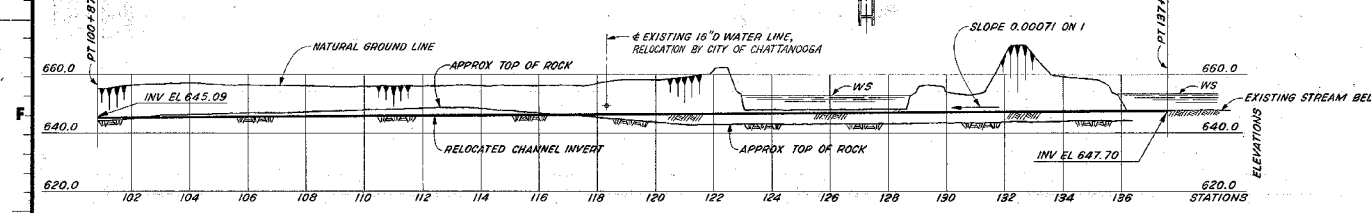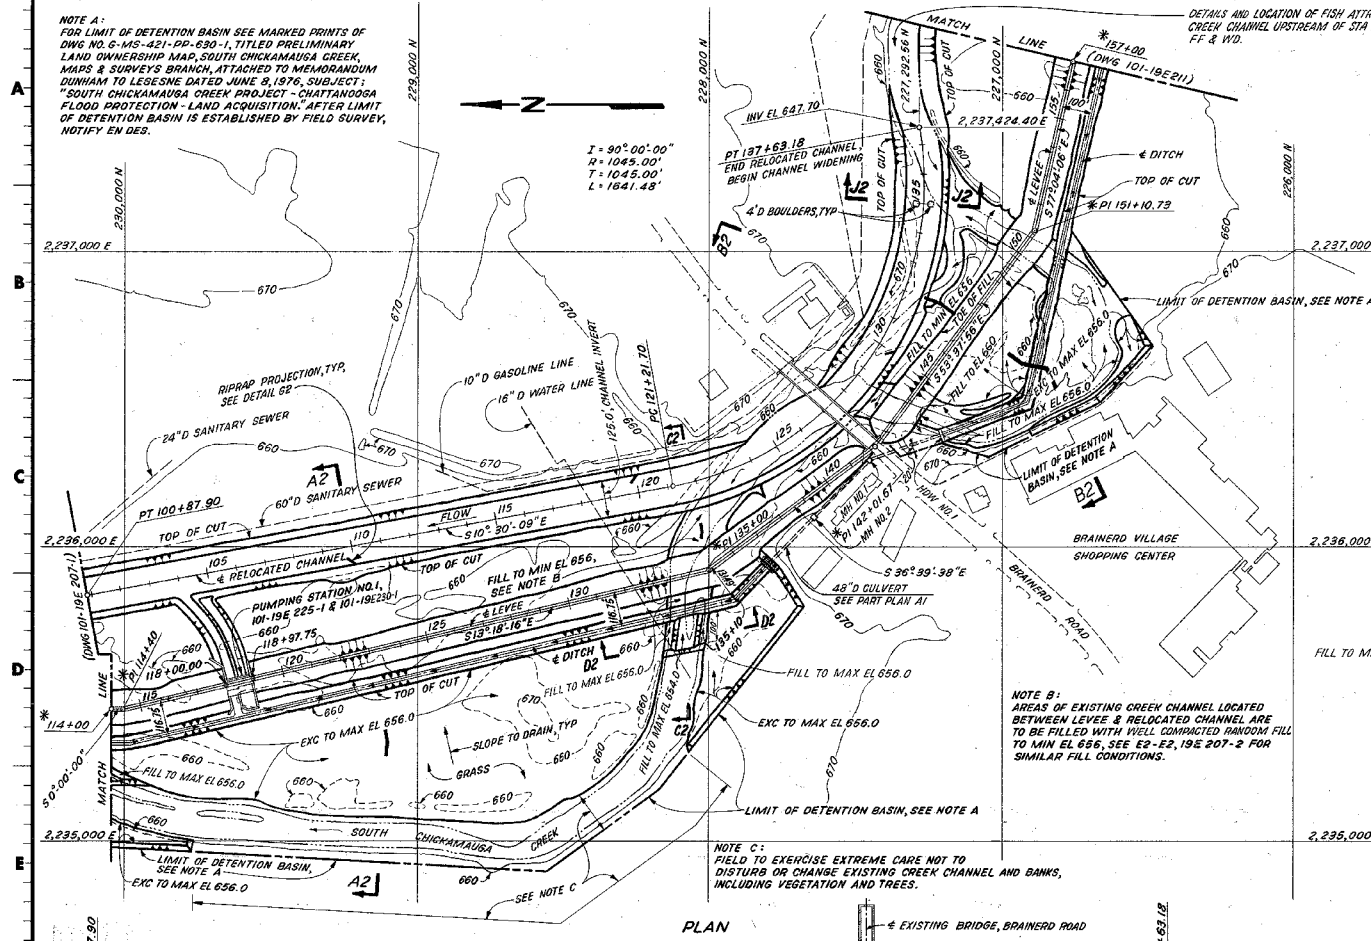

PART PLAN A1  
1" = 30'

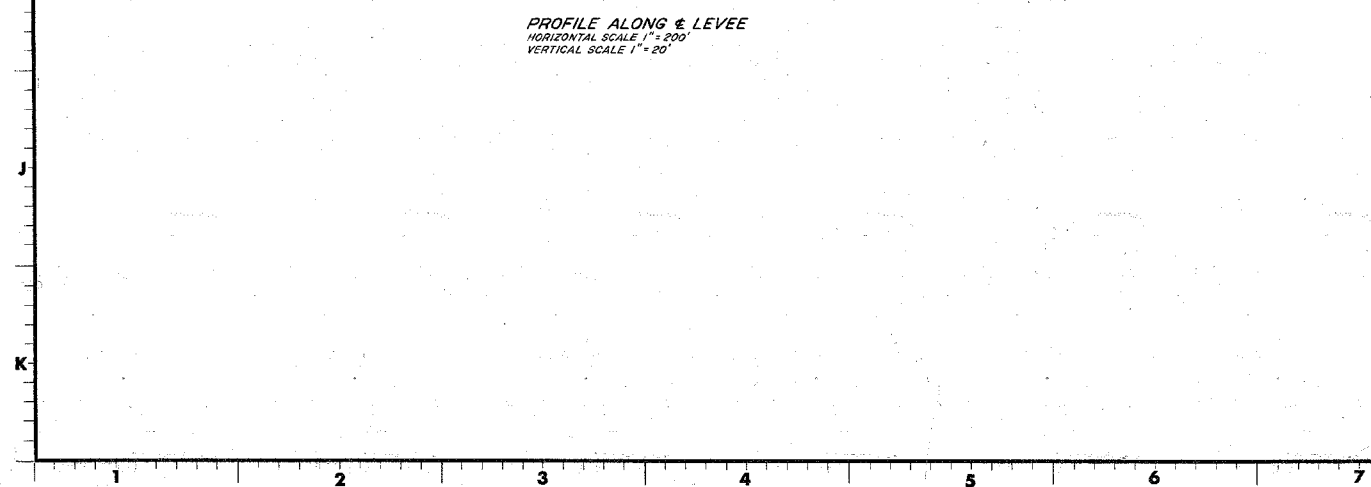

PROFILE ALONG LEVEE  
HORIZONTAL SCALE 1" = 200'  
VERTICAL SCALE 1" = 20'

- NOTE A: FOR LIMIT OF DETENTION BASIN SEE MARKED PRINTS OF DWG NO. 6-MS-421-PP-830-1, TITLED PRELIMINARY LAND OWNERSHIP MAP, SOUTH CHICKAMAUGA CREEK, MAINS & SURVEYS BRANCH, ATTACHED TO MEMORANDUM DUNHAM TO LESSEES DATED WING 8/1976, SUBJECT: "SOUTH CHICKAMAUGA CREEK PROJECT - CHATTANOOGA FLOOD PROTECTION - LAND ACQUISITION." AFTER LIMIT OF DETENTION BASIN IS ESTABLISHED BY FIELD SURVEY, NOTIFY EN DES.
- NOTE B: AREAS OF EXISTING CREEK CHANNEL LOCATED BETWEEN LEVEE & RELOCATED CHANNEL ARE TO BE FILLED WITH WELL COMPACTED RANDOM FILL TO MIN EL 656, SEE E2-E2, 19E 207-2 FOR SIMILAR FILL CONDITIONS.
- NOTE C: FIELD TO EXERCISE EXTREME CARE NOT TO DISTURB OR CHANGE EXISTING CREEK CHANNEL AND DAMS, INCLUDING VEGETATION AND TREES.
- NOTE D: PRECAST CONCRETE PIPE INSTALLATION PROCEDURE ACROSS BRAINERD ROAD TO BE DETERMINED BY FIELD AND COORDINATED WITH EN DES.
- NOTE E: EXISTING GROUND SURFACE UNDER BRIDGE TO BE COVERED WITH RIPRAP AS SHOWN.
- NOTE F: EXISTING STATE HIGHWAY GUARDRAIL TO BE REMOVED AS NECESSARY DURING CONSTRUCTION. AFTER COMPLETION OF CONSTRUCTION, REPLACE TO EDGE OF SECURITY GATE ON ORIGINAL HORIZONTAL ALIGNMENT.
- NOTES:
1. RIPRAP SHALL CONFORM TO TYVA SPECIFICATION T-1, SECTION 830, AND SHALL BE WELL GRADED, 50% OF RIPRAP BY WEIGHT SHALL BE 200-LB STONES OR LARGER, MAXIMUM SIZE STONE SHALL WEIGH 600-LB AND NOT MORE THAN 5% BY WEIGHT SHALL PASS THE 1" SIEVE.
  2. FINE FILTER MATERIAL UNDER RIPRAP SHALL CONFORM TO TYVA SPECIFICATION T-1, SECTION 1039, EXCEPT THE GRADATION SHALL BE WELL GRADED FROM 1/2" DOWN WITH NOT MORE THAN 5% BY WEIGHT PASSING THE NO. 200 SIEVE.
  3. ALL CONCRETE SHALL BE PLACED IN ACCORDANCE WITH GENERAL CONSTRUCTION SPECIFICATION NO. G-2. CONCRETE SHALL BE CLASS 300.75 AFK. MAX. PLACING TEMP OF CONG SHALL BE 70°F.
  4. FORMWORK SHALL BE IN ACCORDANCE WITH GENERAL CONSTRUCTION SPECIFICATION NO. G-8. FORM LINING FOR EXPOSED CONCRETE SURFACES SHALL BE TYPE A OR TYPE D.
  5. CHAMFER ALL EXPOSED EXTERIOR EDGES 3/8".
  6. WELDING OF OR TO HIGH STRENGTH REINFORCING BARS WITHOUT APPROVAL OF CIVIL ENGINEERING AND DESIGN BRANCH IS PROHIBITED.
  7. ALL REINFORCEMENT ON THIS DRAWING SHALL CONFORM TO ASTM SPECIFICATION A615, GRADE 60.
  8. THE CLEAR COVER FROM FACE OF CONCRETE TO NEAREST REINFORCING BAR SHALL BE 2" UNLESS OTHERWISE NOTED. ALL OTHER DIMENSIONS ARE TO CENTERLINE OF REINFORCEMENT.
  9. FOR ADDITIONAL GENERAL NOTES SEE 101-19E205-1 & 2.
- \* = FOR TABLE SHOWING AS-BUILT CENTERLINE OF LEVEE SEE 101-19E205-1

1-3-83	REV	BY	CHKD	DATE	DESCRIPTION
4	FINAL FIELD REV				
5	REV PLAN, PART PLAN A1 & PROFILE ALONG LEVEE				
2	REVISED INVERT AND SLOPE OF DITCH IN DETENTION BASIN, H5, G6 & H8				
1	ADDED RIPRAP PROJECTION C2, C3 BE 4' 4" BOULDERS, G5 & NOTE A7				

CHATTANOOGA FLOOD PROTECTION  
LEVEE, CHANNEL & DETENTION BASIN

PLANS, PROFILES & SECTIONS  
STATION 114+00 TO 157+00

SOUTH CHICKAMAUGA CREEK PROJECT  
TENNESSEE VALLEY AUTHORITY  
DIVISION OF ENGINEERING DESIGN

SUBMITTED: [Signature]  
RECOMMENDED: [Signature]  
APPROVED: [Signature]

DESIGN PROJECT MANAGER: [Signature]  
KNOXVILLE 3-30-78 81 c 101-19E209-1 R4


SCALE 1" = 200' EXCEPT AS NOTED

COMPANION DRAWINGS:  
101-19E209-1 THRU 3

REFERENCE DRAWING:  
19E205 - BILL OF MATERIAL

INSPECTED AND APPROVED FOR ISSUE

PRINTED AT THE TENNESSEE VALLEY AUTHORITY PRINTING PLANT, KNOXVILLE, TENNESSEE

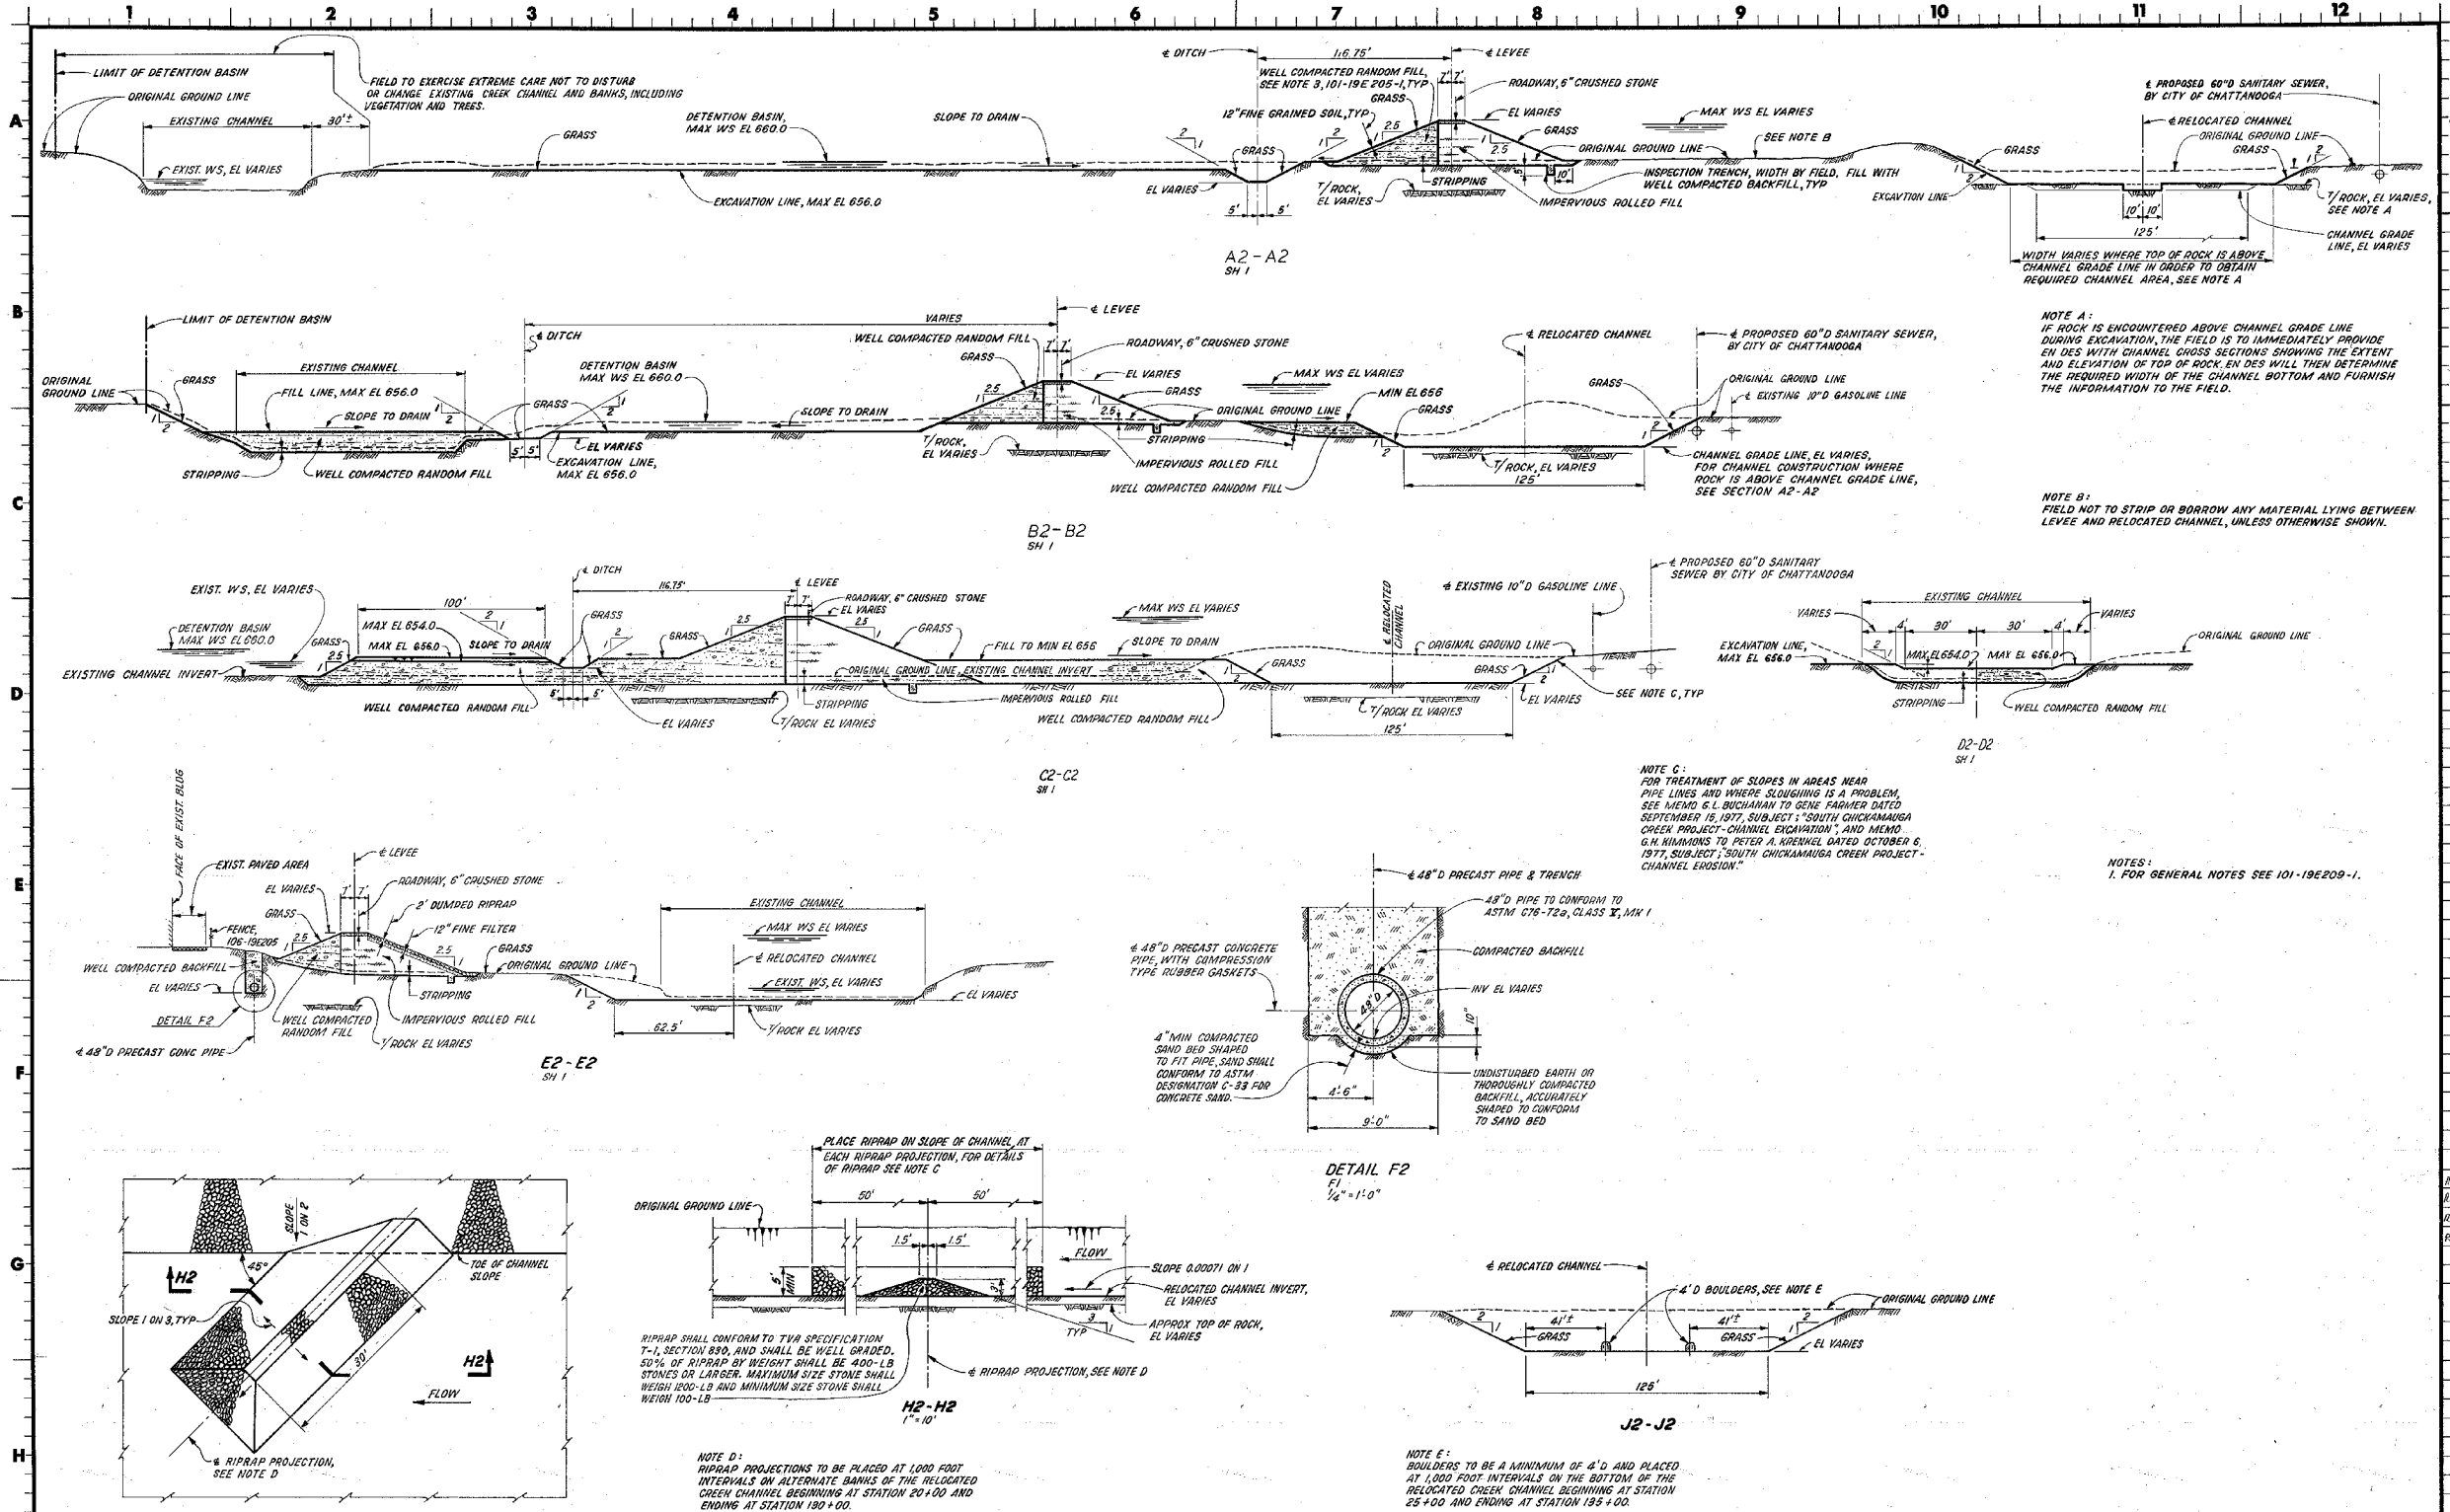

**NOTE A:**  
IF ROCK IS ENCOUNTERED ABOVE CHANNEL GRADE LINE DURING EXCAVATION, THE FIELD IS TO IMMEDIATELY PROVIDE ENDS WITH CHANNEL CROSS SECTIONS SHOWING THE EXTENT AND ELEVATION OF TOP OF ROCK; ENDS WILL THEN DETERMINE THE REQUIRED WIDTH OF THE CHANNEL BOTTOM AND FURNISH THE INFORMATION TO THE FIELD.

**NOTE B:**  
FIELD NOT TO STRIP OR BORROW ANY MATERIAL LYING BETWEEN LEVEE AND RELOCATED CHANNEL, UNLESS OTHERWISE SHOWN.

**NOTE C:**  
FOR TREATMENT OF SLOPES IN AREAS NEAR PIPE LINES AND WHERE SLOUGHING IS A PROBLEM, SEE MEMO G.L. BUCHANAN TO GENE FARMER DATED SEPTEMBER 19, 1977, SUBJECT: "SOUTH CHICKAMAUGA CREEK PROJECT - CHANNEL EXCAVATION"; AND MEMO G.H. KIRKMAN TO PETER A. KIRKMAN DATED OCTOBER 6, 1977, SUBJECT: "SOUTH CHICKAMAUGA CREEK PROJECT - CHANNEL EROSION."

**NOTES:**  
1. FOR GENERAL NOTES SEE 101-19E209-1.

**NOTE D:**  
RIPRAP PROJECTIONS TO BE PLACED AT 100 FOOT INTERVALS ON ALTERNATE BANKS OF THE RELOCATED CREEK CHANNEL BEGINNING AT STATION 20+00 AND ENDING AT STATION 190+00.

**NOTE E:**  
BOULDERS TO BE A MINIMUM OF 4'-0" AND PLACED AT 100 FOOT INTERVALS ON THE BOTTOM OF THE RELOCATED CREEK CHANNEL BEGINNING AT STATION 25+00 AND ENDING AT STATION 135+00.

SCALE 1"=30' EXCEPT AS NOTED

REV	DATE	BY	CHKD	APP'D
2	8-28-79	PLW	WJM	WJM
1	3-13-78	PLW	WJM	WJM
1	ADDED DETAIL G2, H2, J2 AND NOTES D & E			
NO.	REV. NO.	DATE	ISSUED BY	REVISION
0000	01			
0001	02			
0002	03			
0003	04			
0004	05			
0005	06			
0006	07			
0007	08			
0008	09			
0009	10			
0010	11			
0011	12			

CHATTANOOGA FLOOD PROTECTION  
LEVEE, CHANNEL & DETENTION BASIN

PLANS, PROFILES & SECTIONS  
STATION 114+00 TO 157+00

SOUTH CHICKAMAUGA CREEK PROJECT  
TENNESSEE VALLEY AUTHORITY  
DIVISION OF ENGINEERING DESIGN

SUBMITTED: *E. J. ...* RECOMMENDED: *H. ...* APPROVED: *H. ...*

DESIGN PROJECT MANAGER: **KNOXVILLE 3-30-78 81 c 101-19E209-2 R2**

INSPECTED AND APPROVED FOR ISSUE

DESIGN PROJECT MANAGER: **KNOXVILLE 3-30-78 81 c 101-19E209-2 R2**

PRINT: H 1/2 1

SIZE: F 3

RE OR PROJ: WE EE CE AD CO ED MD HY SW BL PA

PRINTS: RECD-R

STRAIGHT REINFORCEMENT BAR LIST

(FOR FIELD INFORMATION ONLY)

MADE J. L. MAXEY  
CHKD HAM

FOR DWG. NO. 101-19E209-3 R0


SHEET NO 1 OF 1

DATE 10-31-77



PROJECT SOUTH CHICKAMAUGA CREEK

BUILDING MANHOLES & HEADWALLS

BAR SIZE	BAR LENGTH	NO. REQ'D	BAR SIZE	BAR LENGTH	NO. REQ'D	BAR SIZE	BAR LENGTH	NO. REQ'D
8	11-6	90	4	19	2	4	5-6	3
			4	18-9	2	4	5-3	5
			4	18-6	2	4	5	4
6	55-6	42	4	18-3	6	4	4-9	7
6	27	4	4	18	8	4	4-6	96
6	25-6	8	4	17-9	2	4	4	6
6	25-3	4	4	17-3	2	4	3-9	4
6	13-3	128	4	14-6	6	4	3-3	5
6	11-6	60	4	14-3	2	4	3	1
6	8-6	2	4	14	4	4	2-9	7
6	8	2	4	13-6	4	4	2-6	4
6	7-6	2	4	13-3	4	4	2-3	2
6	7-3	79	4	13	6	4	1-9	2
6	7	7	4	9-6	10	4	1-6	13
6	6	32	4	9	10	4	1-3	1
6	3-3	2	4	7-6	10	4	1	8
6	2-6	2	4	7-3	8			
6	2-3	1	4	7	3			
			4	6-9	34			
			4	6-6	3			
4	31-6	26	4	6-3	3			
4	22-6	28	4	6	7			
4	19-3	4	4	5-9	7			

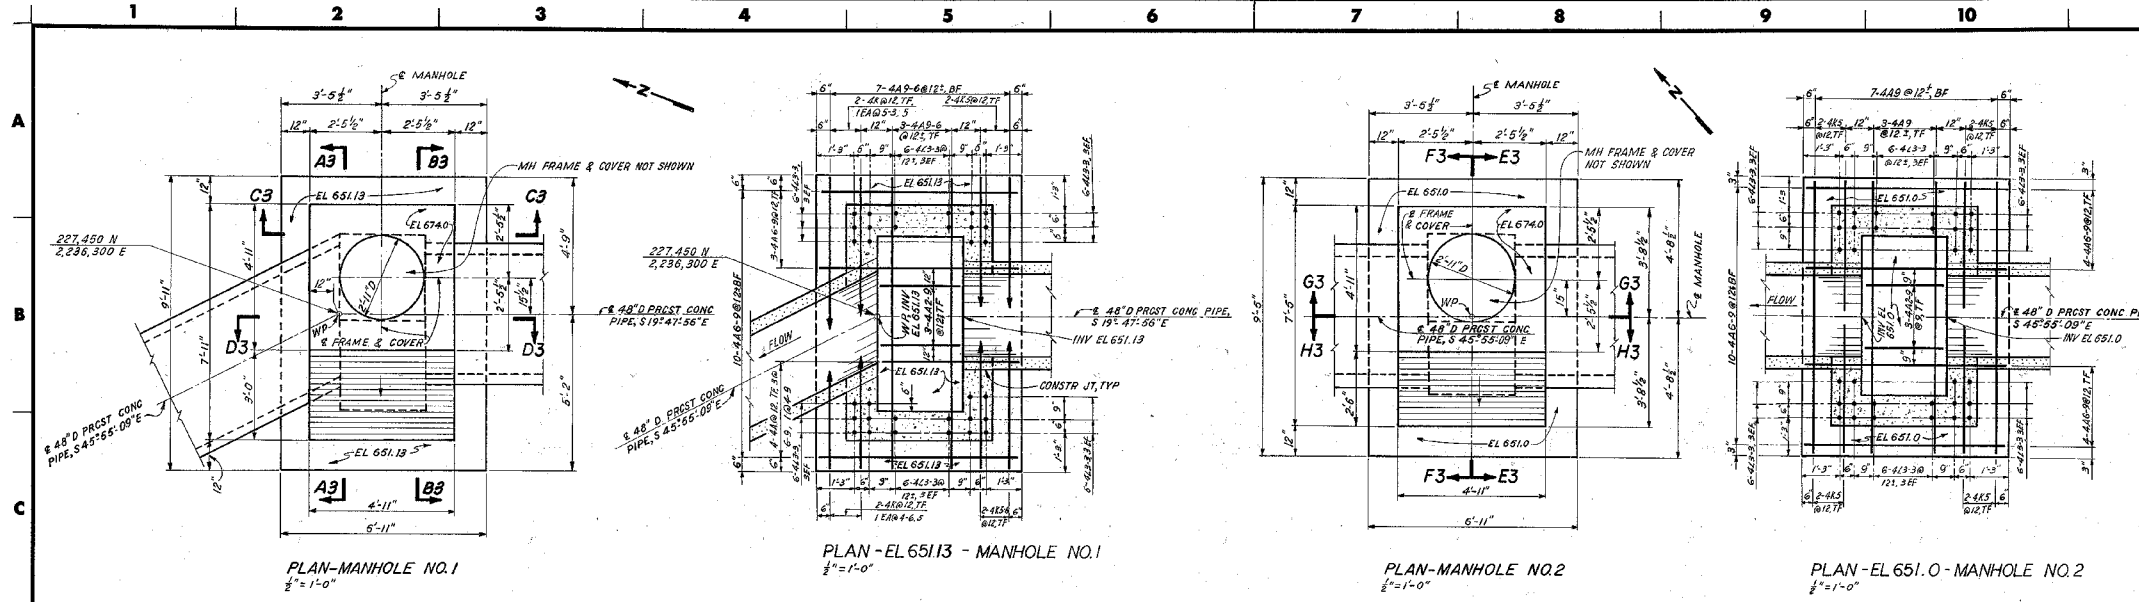

BENT BAR LIST						
BAR MARK	NO	BENDING DIMENSIONS				
		a	b	c	e	f
4U6	2	0-4	4-6			EX
4U6-6	2	1-0	4-6			EX
4U7	4	1-0	4-6			EX
4U7-3	4	1-3	4-6			EX
4U7-9	2	1-6	4-6			EX
4U11	8	3-3	4-6			EX
4U11-3	6	3-8	4-6			EX
4U11-6	2	3-6	4-6			EX
4U11-9	6	3-8	4-6			EX
4U12	4	3-0	4-6			EX
4U12-3	2	3-0	4-6			EX
4U12-6	6	3-0	4-6			EX
4U12-9	2	3-0	4-6			EX
4U13	6	3-0	4-6			EX
4U13-3	4	3-0	4-6			EX
4U13-6	2	3-0	4-6			EX
4U13-9	2	3-0	4-6			EX
4U19	10	4-8	4-6			EX
4L1-3	72	2-3				EX
4L1-6	2	2-6				EX
4L1-9	2	2-6				EX
4L1-12	2	2-6				EX
4L1-99	2	2-6				EX
4L2-02	2	2-6				EX
4L2-05	2	2-6				EX
4L2-08	2	2-6				EX
4L2-98	2	2-6				EX
4L3-01	2	2-6				EX
4L3-04	2	2-6				EX
4L3-07	2	2-6				EX
4L3-100	2	2-6				EX

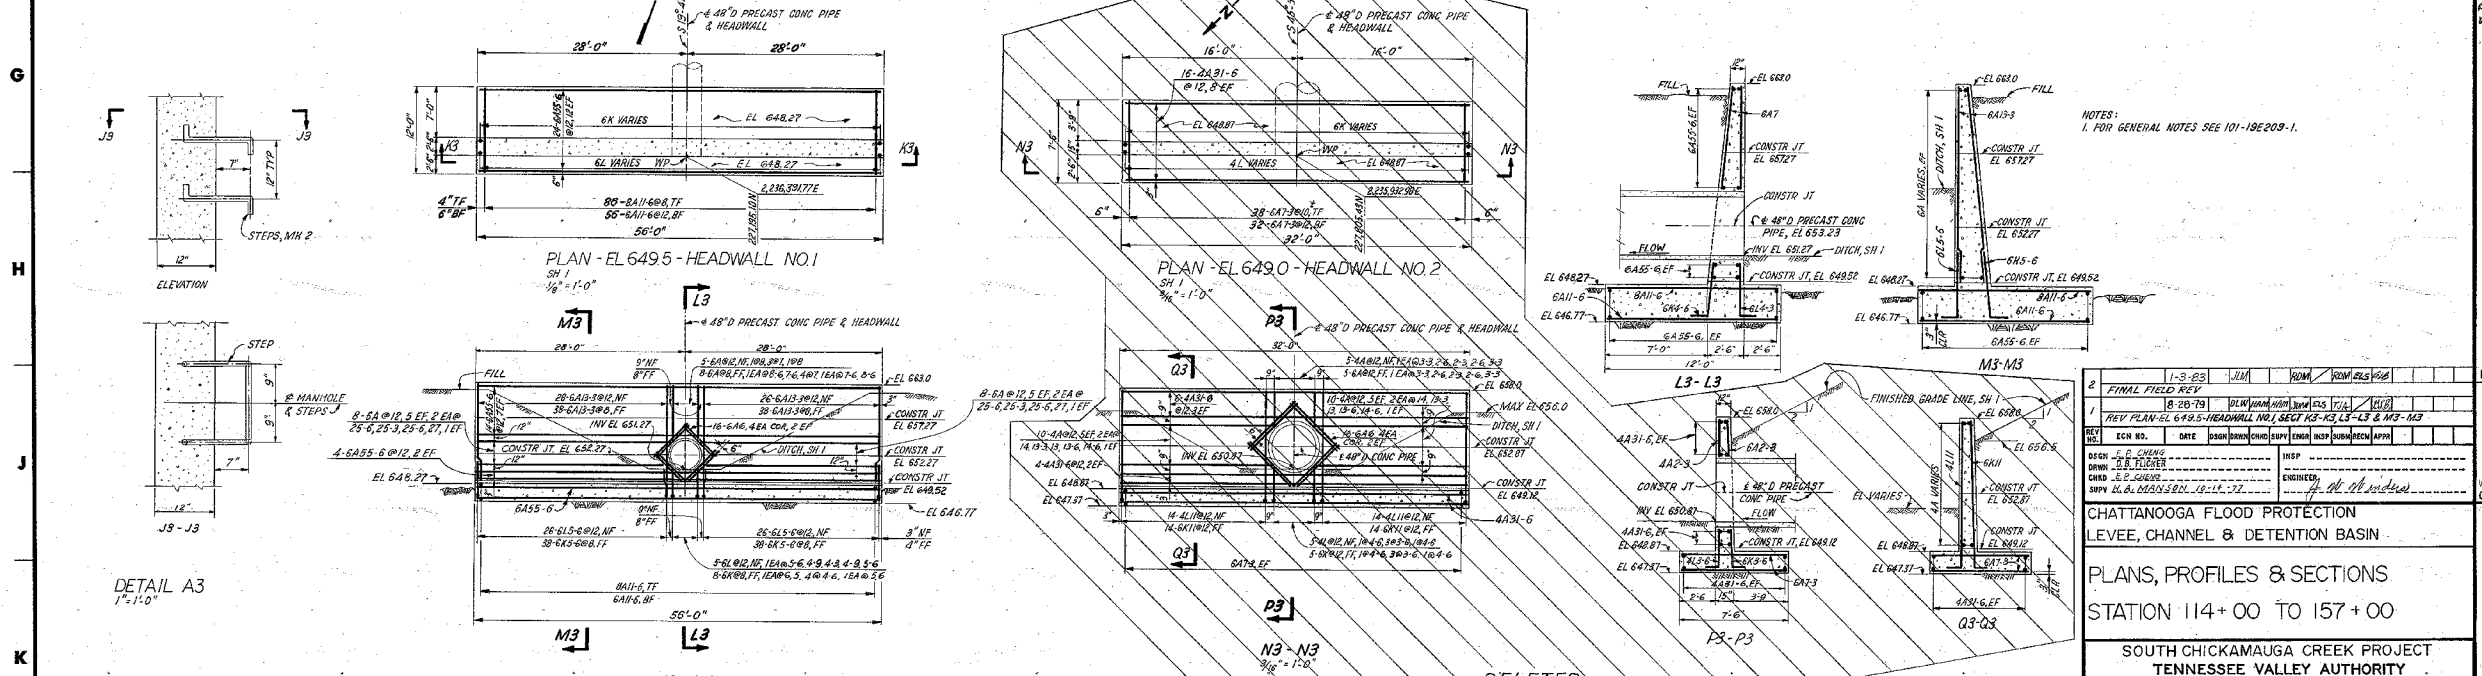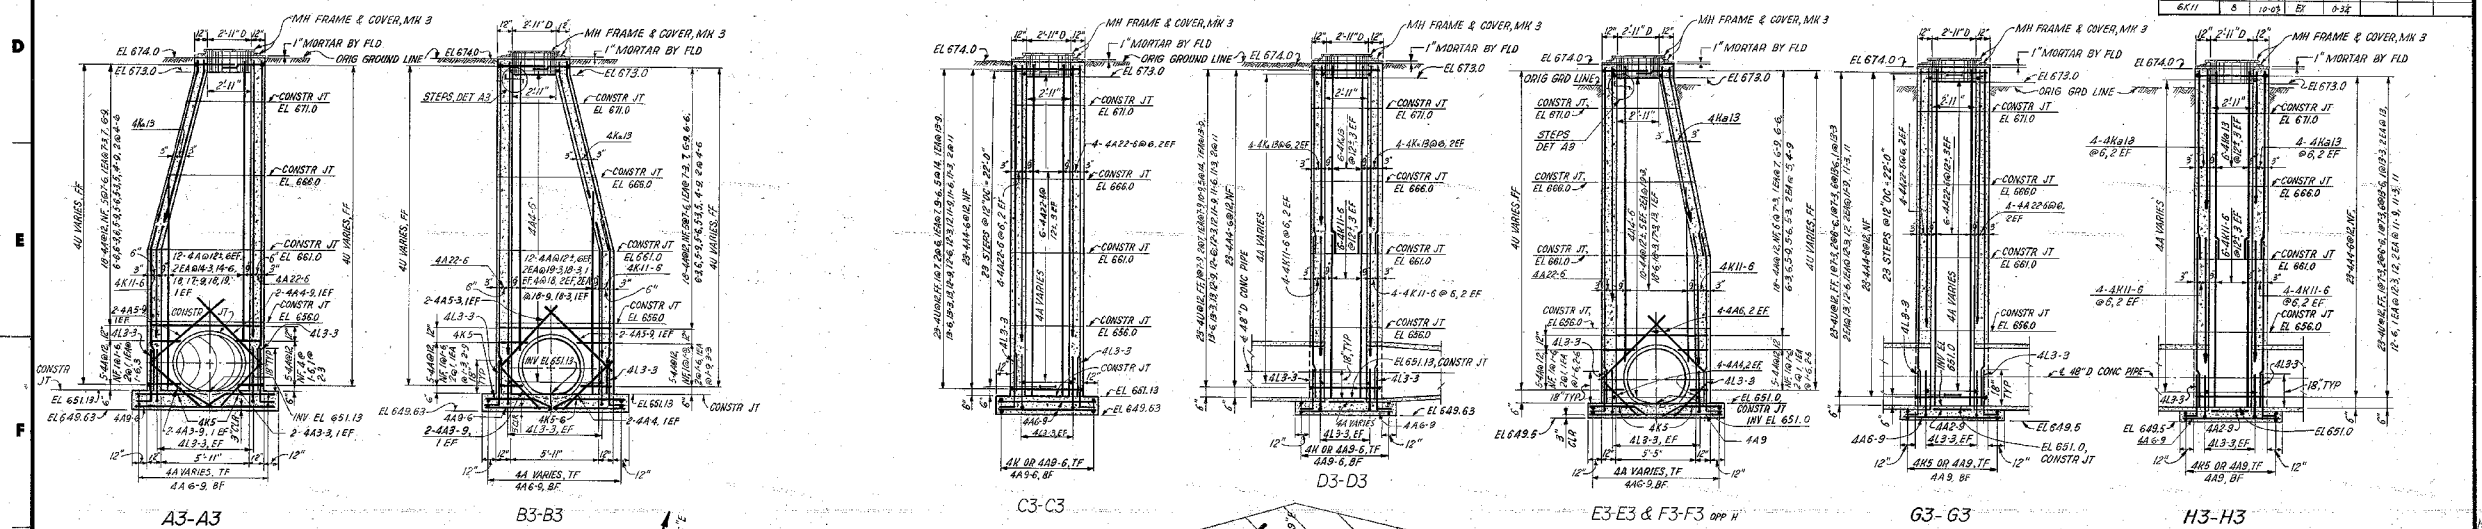

NOTES:  
1. FOR GENERAL NOTES SEE 101-19E209-1.





2	FINAL FIELD REV	1-3-83	JUN	ROM	WOMERS	506
1	REV PLAN-EL 649.5 HEADWALL NO. 1, PLAN-EL 649.0 HEADWALL NO. 2, ELEVATION L3-L3, M3-M3, N3-N3	1-3-83	JUN	ROM	WOMERS	506
DESIGN	BY	DATE	APP'D	DATE	APP'D	DATE
CHD	BY	DATE	APP'D	DATE	APP'D	DATE
CHKD	BY	DATE	APP'D	DATE	APP'D	DATE
APP'D	BY	DATE	APP'D	DATE	APP'D	DATE

CHATTANOOGA FLOOD PROTECTION  
LEVEE, CHANNEL & DETENTION BASIN  
PLANS, PROFILES & SECTIONS  
STATION 114+00 TO 157+00  
SOUTH CHICKAMAUGA CREEK PROJECT  
TENNESSEE VALLEY AUTHORITY  
DIVISION OF ENGINEERING DESIGN

SUBMITTED: [Signature]  
RECOMMENDED: [Signature]  
APPROVED: [Signature]

INSPECTED AND APPROVED FOR ISSUE  
KNOXVILLE 3-30-78 81 c 101-19E209-3 R2

RECORD DRAWING AS CONSTRUCTED  
Knoxville, Tennessee 37901  
DATE: 10/19/81

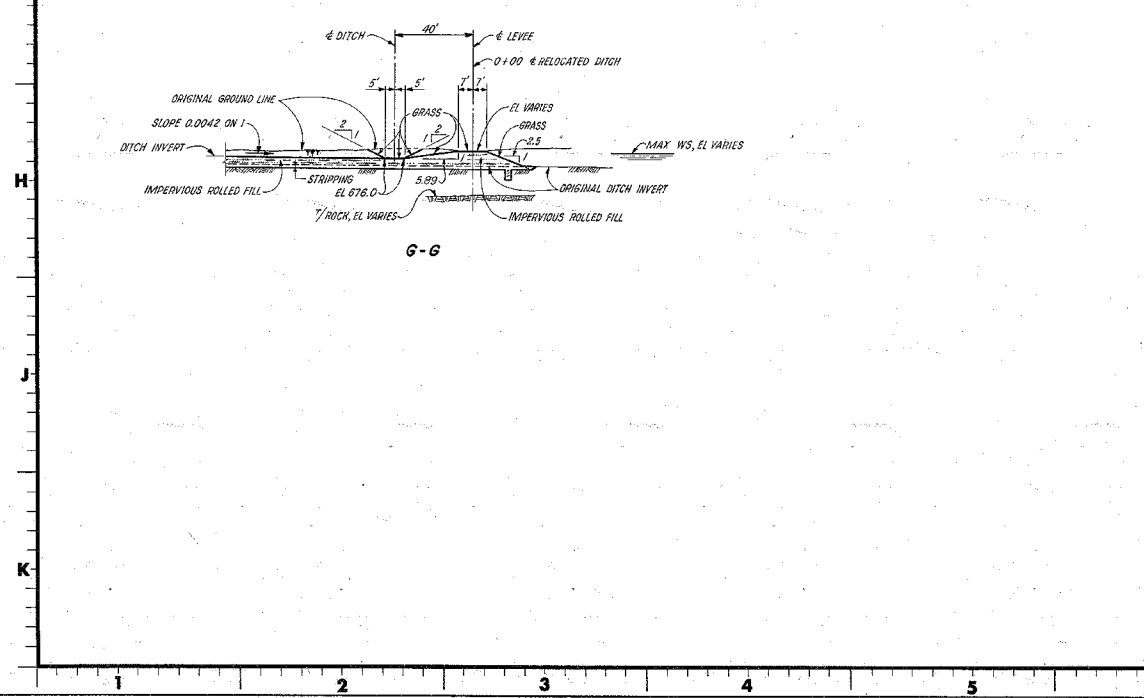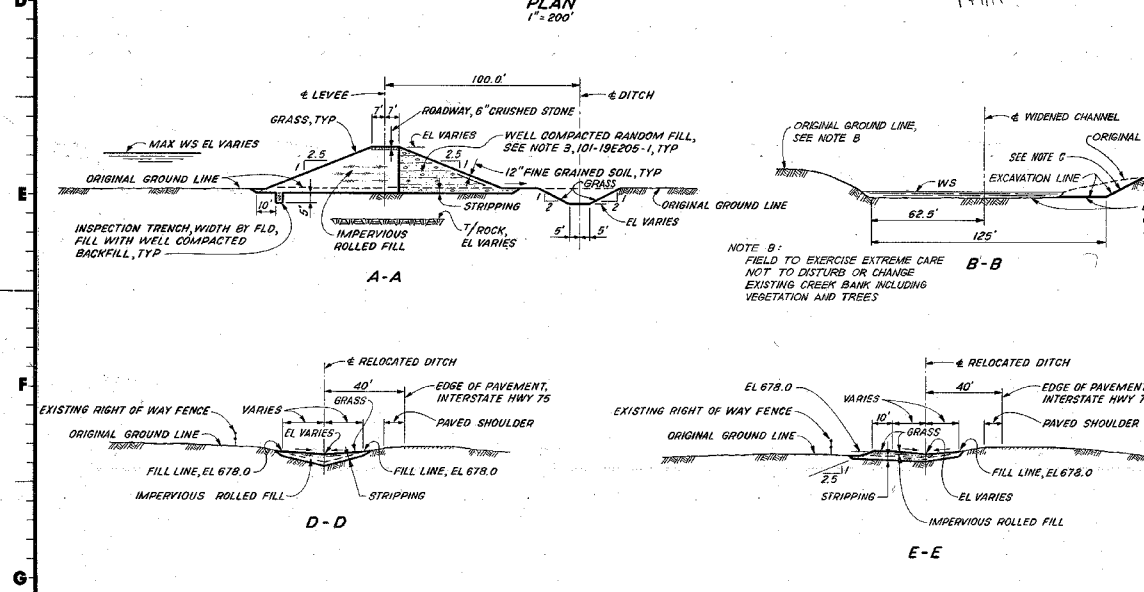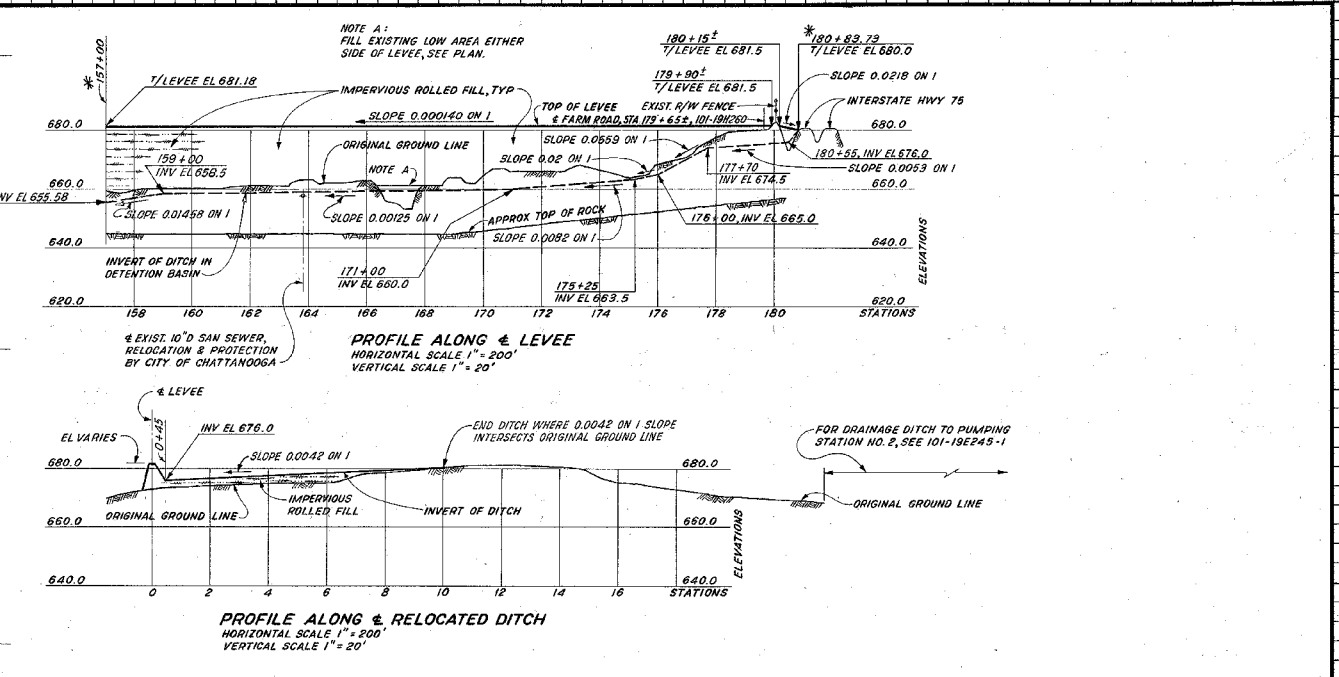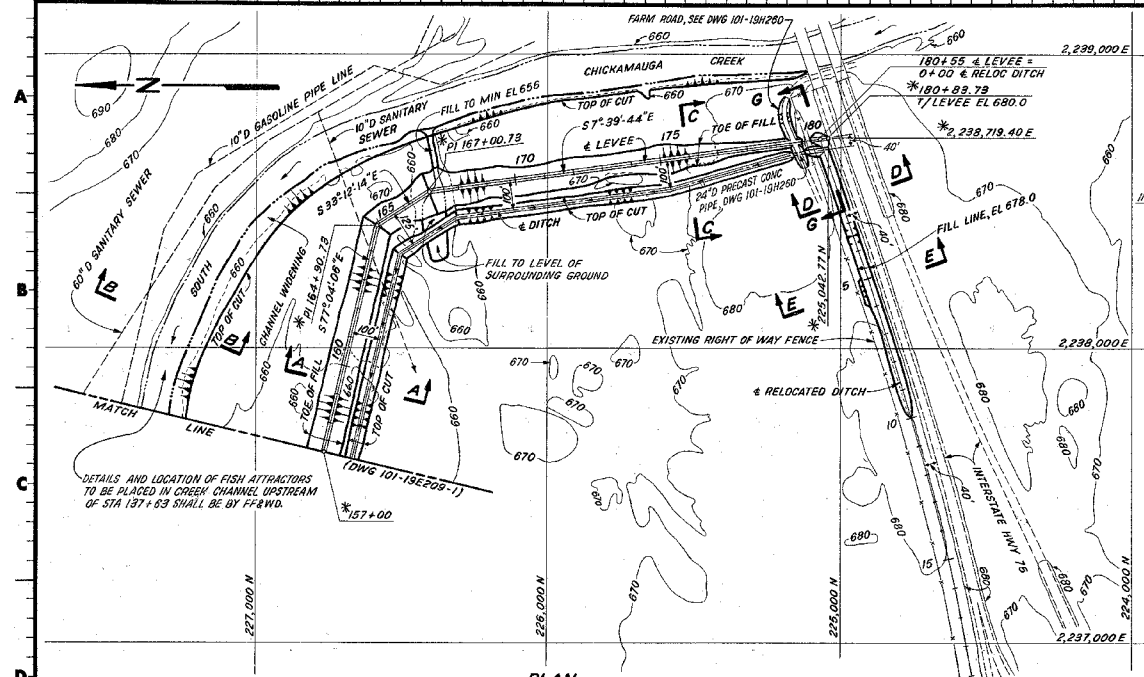

NOTE C:  
FOR TREATMENT OF SLOPES IN AREAS NEAR PIPE LINES AND WHERE SLOUGHING IS A PROBLEM, SEE MEMO G.L. BUCHANAN TO GENE FARMER DATED SEPTEMBER 15, 1977, SUBJECT: SOUTH CHICKAMAUGA CREEK PROJECT - CHANNEL EXCAVATION AND MEMO G.L. BUCHANAN TO RICKY A. KREWEEL DATED OCTOBER 6, 1977, SUBJECT: SOUTH CHICKAMAUGA CREEK PROJECT - CHANNEL EROSION.

\* = FOR TABLE SHOWING AS-BUILT CENTERLINE OF LEVEE SEE 101-19E205-1

NOTES:  
1. FOR GENERAL NOTES SEE 101-19E205-1 & 101-19E205-2.

4	1-9-88	MM	MM	MM	MM	MM	MM	MM	MM
4	FINAL FIELD REV								
	12-21-78	MM	MM	MM	MM	MM	MM	MM	MM
	REVISED ALIGNMENT OF DITCH IN DETENTION BASIN & ADDED 24" CONC PIPE, A4; DELETED PART OF RELOCATED DITCH, C5; REVISED SLOPE & INVERT OF DITCH IN DETENTION BASIN, A9, A10, B9; REVISED INVERT & SLOPE OF RELOCATED DITCH, C7 THRU C10; REVISED C-C; DELETED F-F, F8; ADDED G-G								
2	11-1-78	MM	MM	MM	MM	MM	MM	MM	MM
	REVISED NOTE, B3 AND REVISED INVERT & SLOPE OF DITCH IN DETENTION BASIN, B6, B7 & B8								
1	12-15-78	MM	MM	MM	MM	MM	MM	MM	MM
	ADDED NOTE, D1								
DESIGNER	J.L. MAXEY	CHECKED	E.B. CHEN	DATE	12-15-78	SCALE	AS SHOWN	PROJECT	CHATTANOOGA FLOOD PROTECTION
DRWN	J.L. MAXEY	INSP							
CHKD	E.B. CHEN	ENGR							
APPV	A.A. BUCHANAN	101-19E205-1							

CHATTANOOGA FLOOD PROTECTION  
LEVEE, CHANNEL & DETENTION BASIN

PLANS, PROFILES & SECTIONS  
STATION 157+00 TO 180+83.73






SOUTH CHICKAMAUGA CREEK PROJECT  
TENNESSEE VALLEY AUTHORITY  
DIVISION OF ENGINEERING DESIGN

INSPECTED AND APPROVED FOR ISSUE: [Signature]  
DESIGN PROJECT MANAGER: [Signature]

NOV 11 1978  
KNOXVILLE 6-7-78 81 c 101-19E211 R4

SCALE 1" = 30' EXCEPT AS NOTED

PRINT	H	12	1						
SIZE	F	S							
BY OR PROJ	BY	EL	CL	PS	CO	ED	NO	HP	BY
DATE	11/11/78								

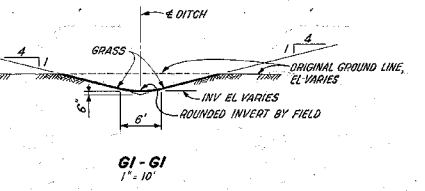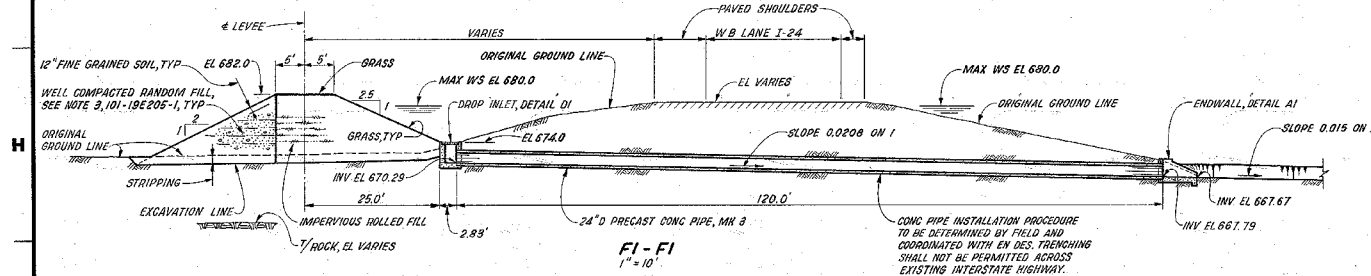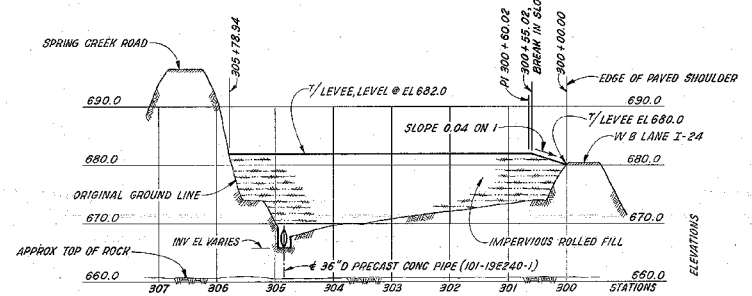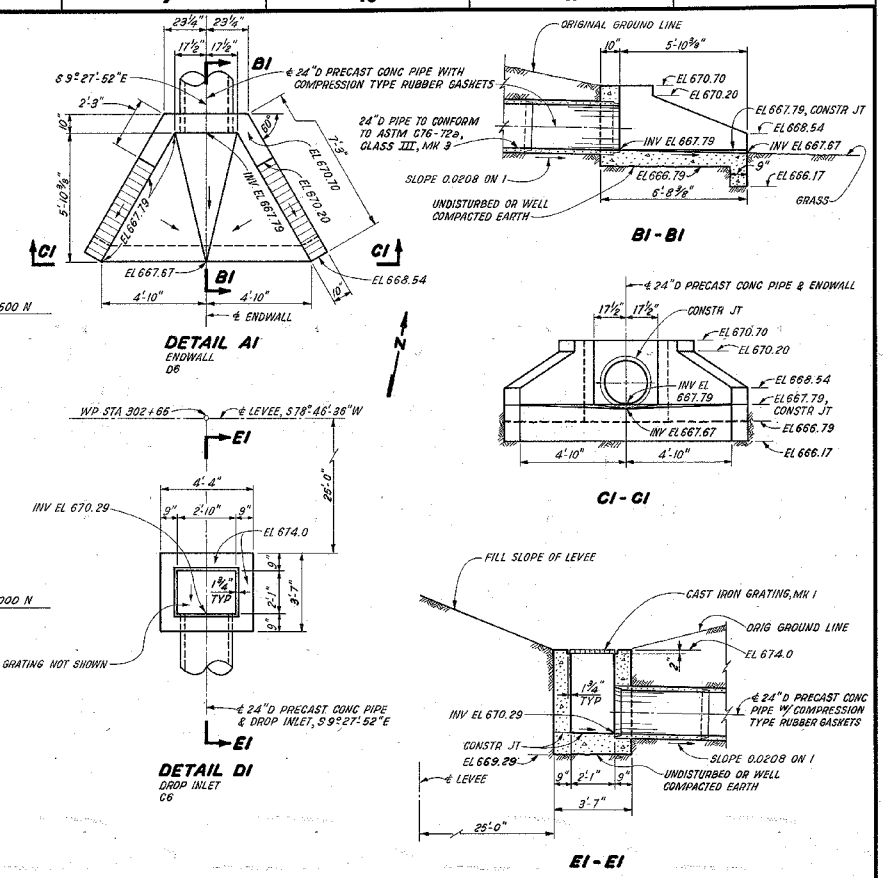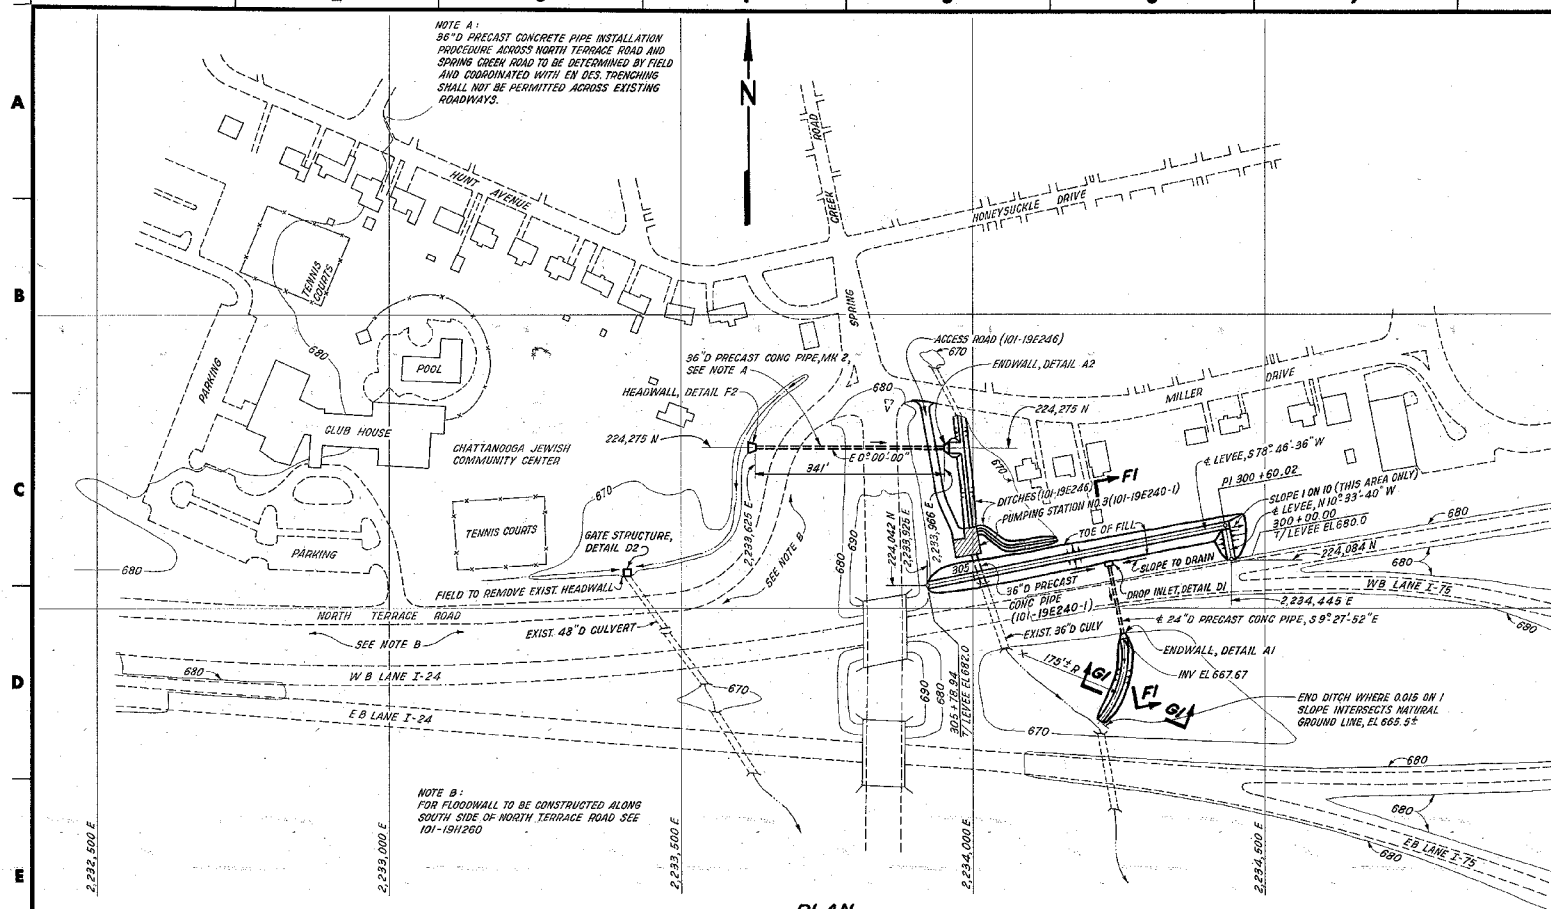

- NOTES:**
1. ALL CONCRETE SHALL BE PLACED IN ACCORDANCE WITH GENERAL CONSTRUCTION SPECIFICATION NO. G-2. CONCRETE SHALL BE CLASS 300.75 AFW.
  2. FORMWORK SHALL BE IN ACCORDANCE WITH GENERAL CONSTRUCTION SPECIFICATION NO. B-8. FORM LINING FOR EXPOSED CONCRETE SURFACES SHALL BE TYPE A OR TYPE D.
  3. CHAMFER ALL EXPOSED EXTERIOR EDGES 3/4".
  4. FOR ADDITIONAL NOTES SEE 101-19E205-1 & 2.

REV. NO.	DATE	DESCRIPTION	BY	CHECKED	APPROVED
1	7-22-78	REMOVED HOLD ON ENDWALL, B5; REVISED DIMENSION, C4; REVISED COORDINATE, C5	JL. MAYHEE	JL. MAYHEE	JL. MAYHEE
2	7-27-78	REMOVED HOLD ON ENDWALL, B5; REVISED DIMENSION, C4; REVISED COORDINATE, C5	JL. MAYHEE	JL. MAYHEE	JL. MAYHEE

CHATTANOOGA FLOOD PROTECTION  
LEVEE, CHANNEL & DETENTION BASIN

PLANS, PROFILES & SECTIONS  
STATION 300+00 TO 305+78.94  
MISC STRUCTURES-OUTLINE

SOUTH CHICKAMAUGA CREEK PROJECT  
TENNESSEE VALLEY AUTHORITY  
DIVISION OF ENGINEERING DESIGN

SUBMITTED: E. J. DAVENPORT  
RECOMMENDED: J. H. WILSON  
APPROVED: J. H. WILSON

INSPECTED AND APPROVED FOR ISSUE

KNOXVILLE 7-5-78 81 C 101-19E212-1 R1













SCALE 3/8" = 1'-0" EXCEPT AS NOTED

COMPANION DRAWINGS:  
101-19E212-1 & 2

REFERENCE DRAWINGS:  
101-19E212-1 - BILL OF MATERIAL


PRINTED AT THE OFFICE OF THE ENGINEER



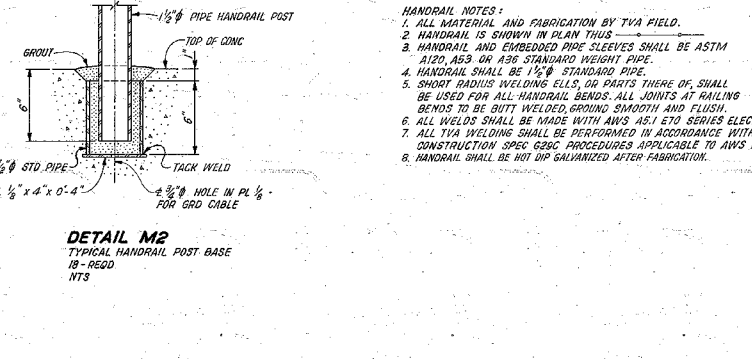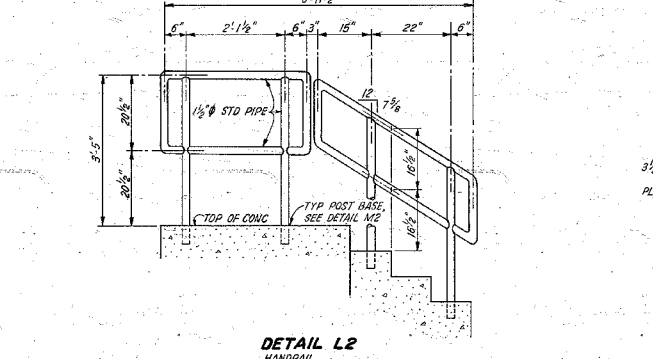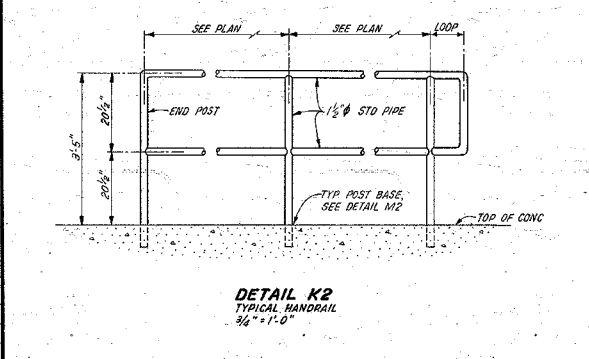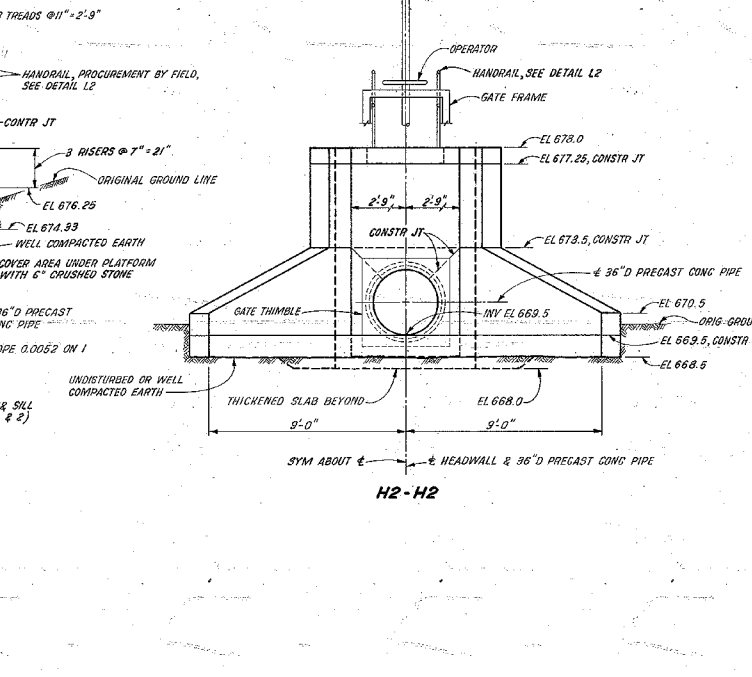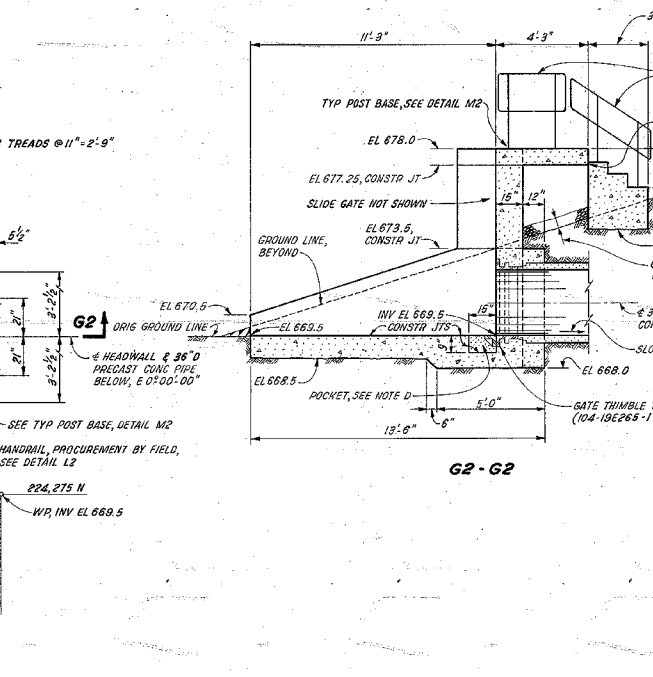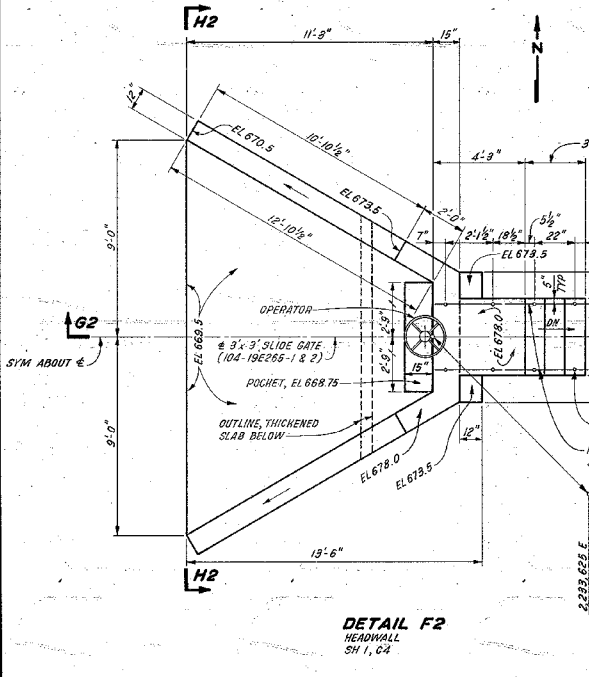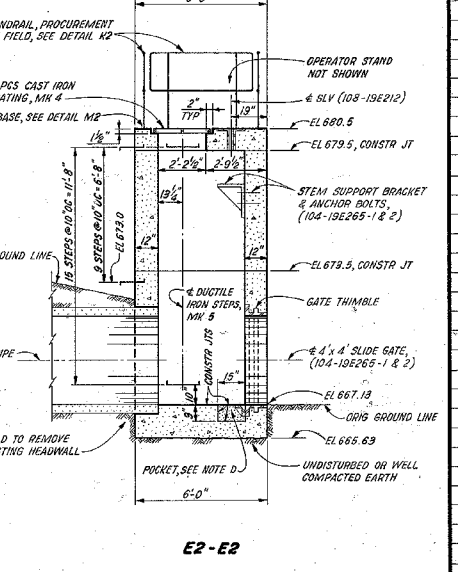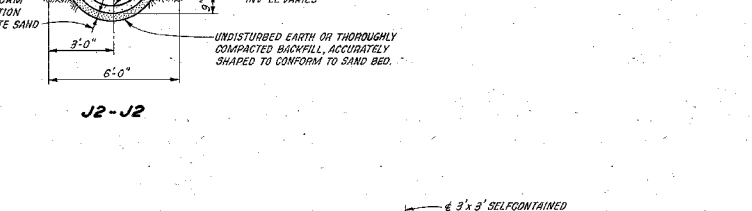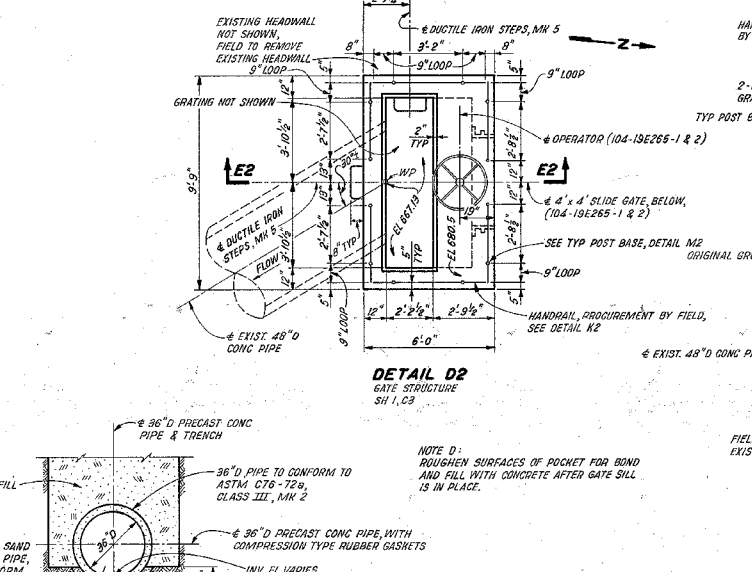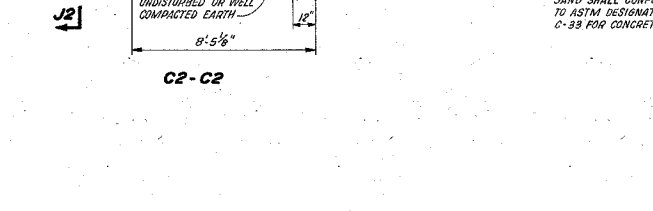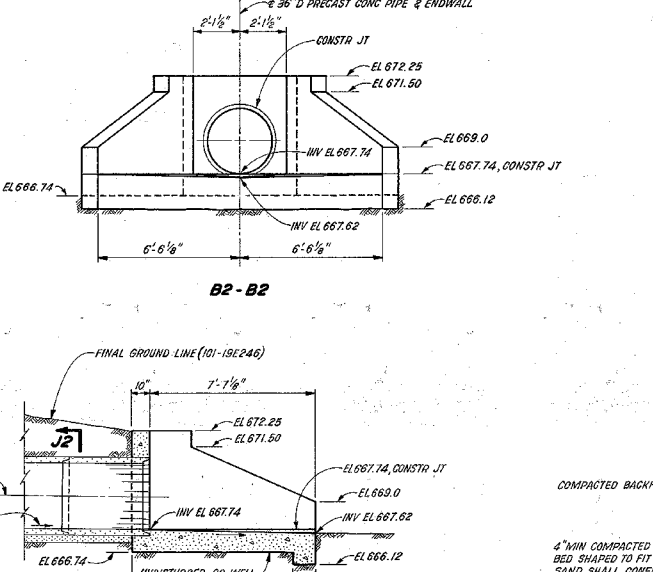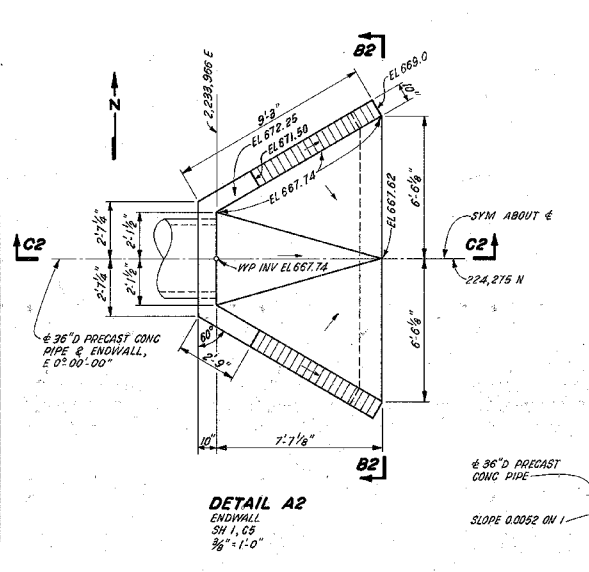

- HANDRAIL NOTES:**
1. ALL MATERIAL AND FABRICATION BY TVA FIELD.
  2. HANDRAIL IS SHOWN IN PLAN THUS.
  3. HANDRAIL AND EMBEDDED PIPE SLEEVES SHALL BE ASTM A192, A53 OR A36 STANDARD WEIGHT PIPE.
  4. HANDRAIL SHALL BE 1 1/2" STANDARD PIPE.
  5. SHORT RADIUS WELDING ELLS, OR PARTS THERE OF, SHALL BE USED FOR ALL HANDRAIL BENDS. ALL JOINTS AT RAILING BENDS TO BE BUTT WELDED, GRIND SMOOTH AND FLUSH.
  6. ALL WELDS SHALL BE MADE WITH AWS A51 E70 SERIES ELECTRODES.
  7. ALL TVA WELDING SHALL BE PERFORMED IN ACCORDANCE WITH TVA CONSTRUCTION SPEC SPEC PROC PROCEDURES APPLICABLE TO AWS D11.
  8. HANDRAIL SHALL BE HOT DIP GALVANIZED AFTER FABRICATION.

REVISED HANDRAIL, AS	17-5-78	JLM/MLM/HAM/MLM/MLM/MLM/MLM/MLM	10/24/28
REMOVED H2-D ON DETAIL A2, B2-B2 & C2-C2, G2	17-5-78	JLM/MLM/HAM/MLM/MLM/MLM/MLM/MLM	10/24/28
DATE	17-5-78	DESIGNED BY	JLM
CHECKED BY	MLM	INSP	MLM
DATE	17-5-78	ENGINEER	JLM
DATE	17-5-78	APP'D BY	JLM
DATE	17-5-78	DATE	17-5-78
SCALE 3/8" = 1'-0"		EXCEPT AS NOTED	
CHATTANOOGA FLOOD PROTECTION LEVEE, CHANNEL & DETENTION BASIN			
PLANS, PROFILES & SECTIONS STATION 300+00 TO 305+78.94 MISC STRUCTURES - OUTLINE			
SOUTH CHICKAMAUGA CREEK PROJECT TENNESSEE VALLEY AUTHORITY DIVISION OF ENGINEERING DESIGN			
SUBMITTED	RECOMMENDED	APPROVED	
KNOXVILLE 7-5-78		81 c 101-19E212-2 R2	

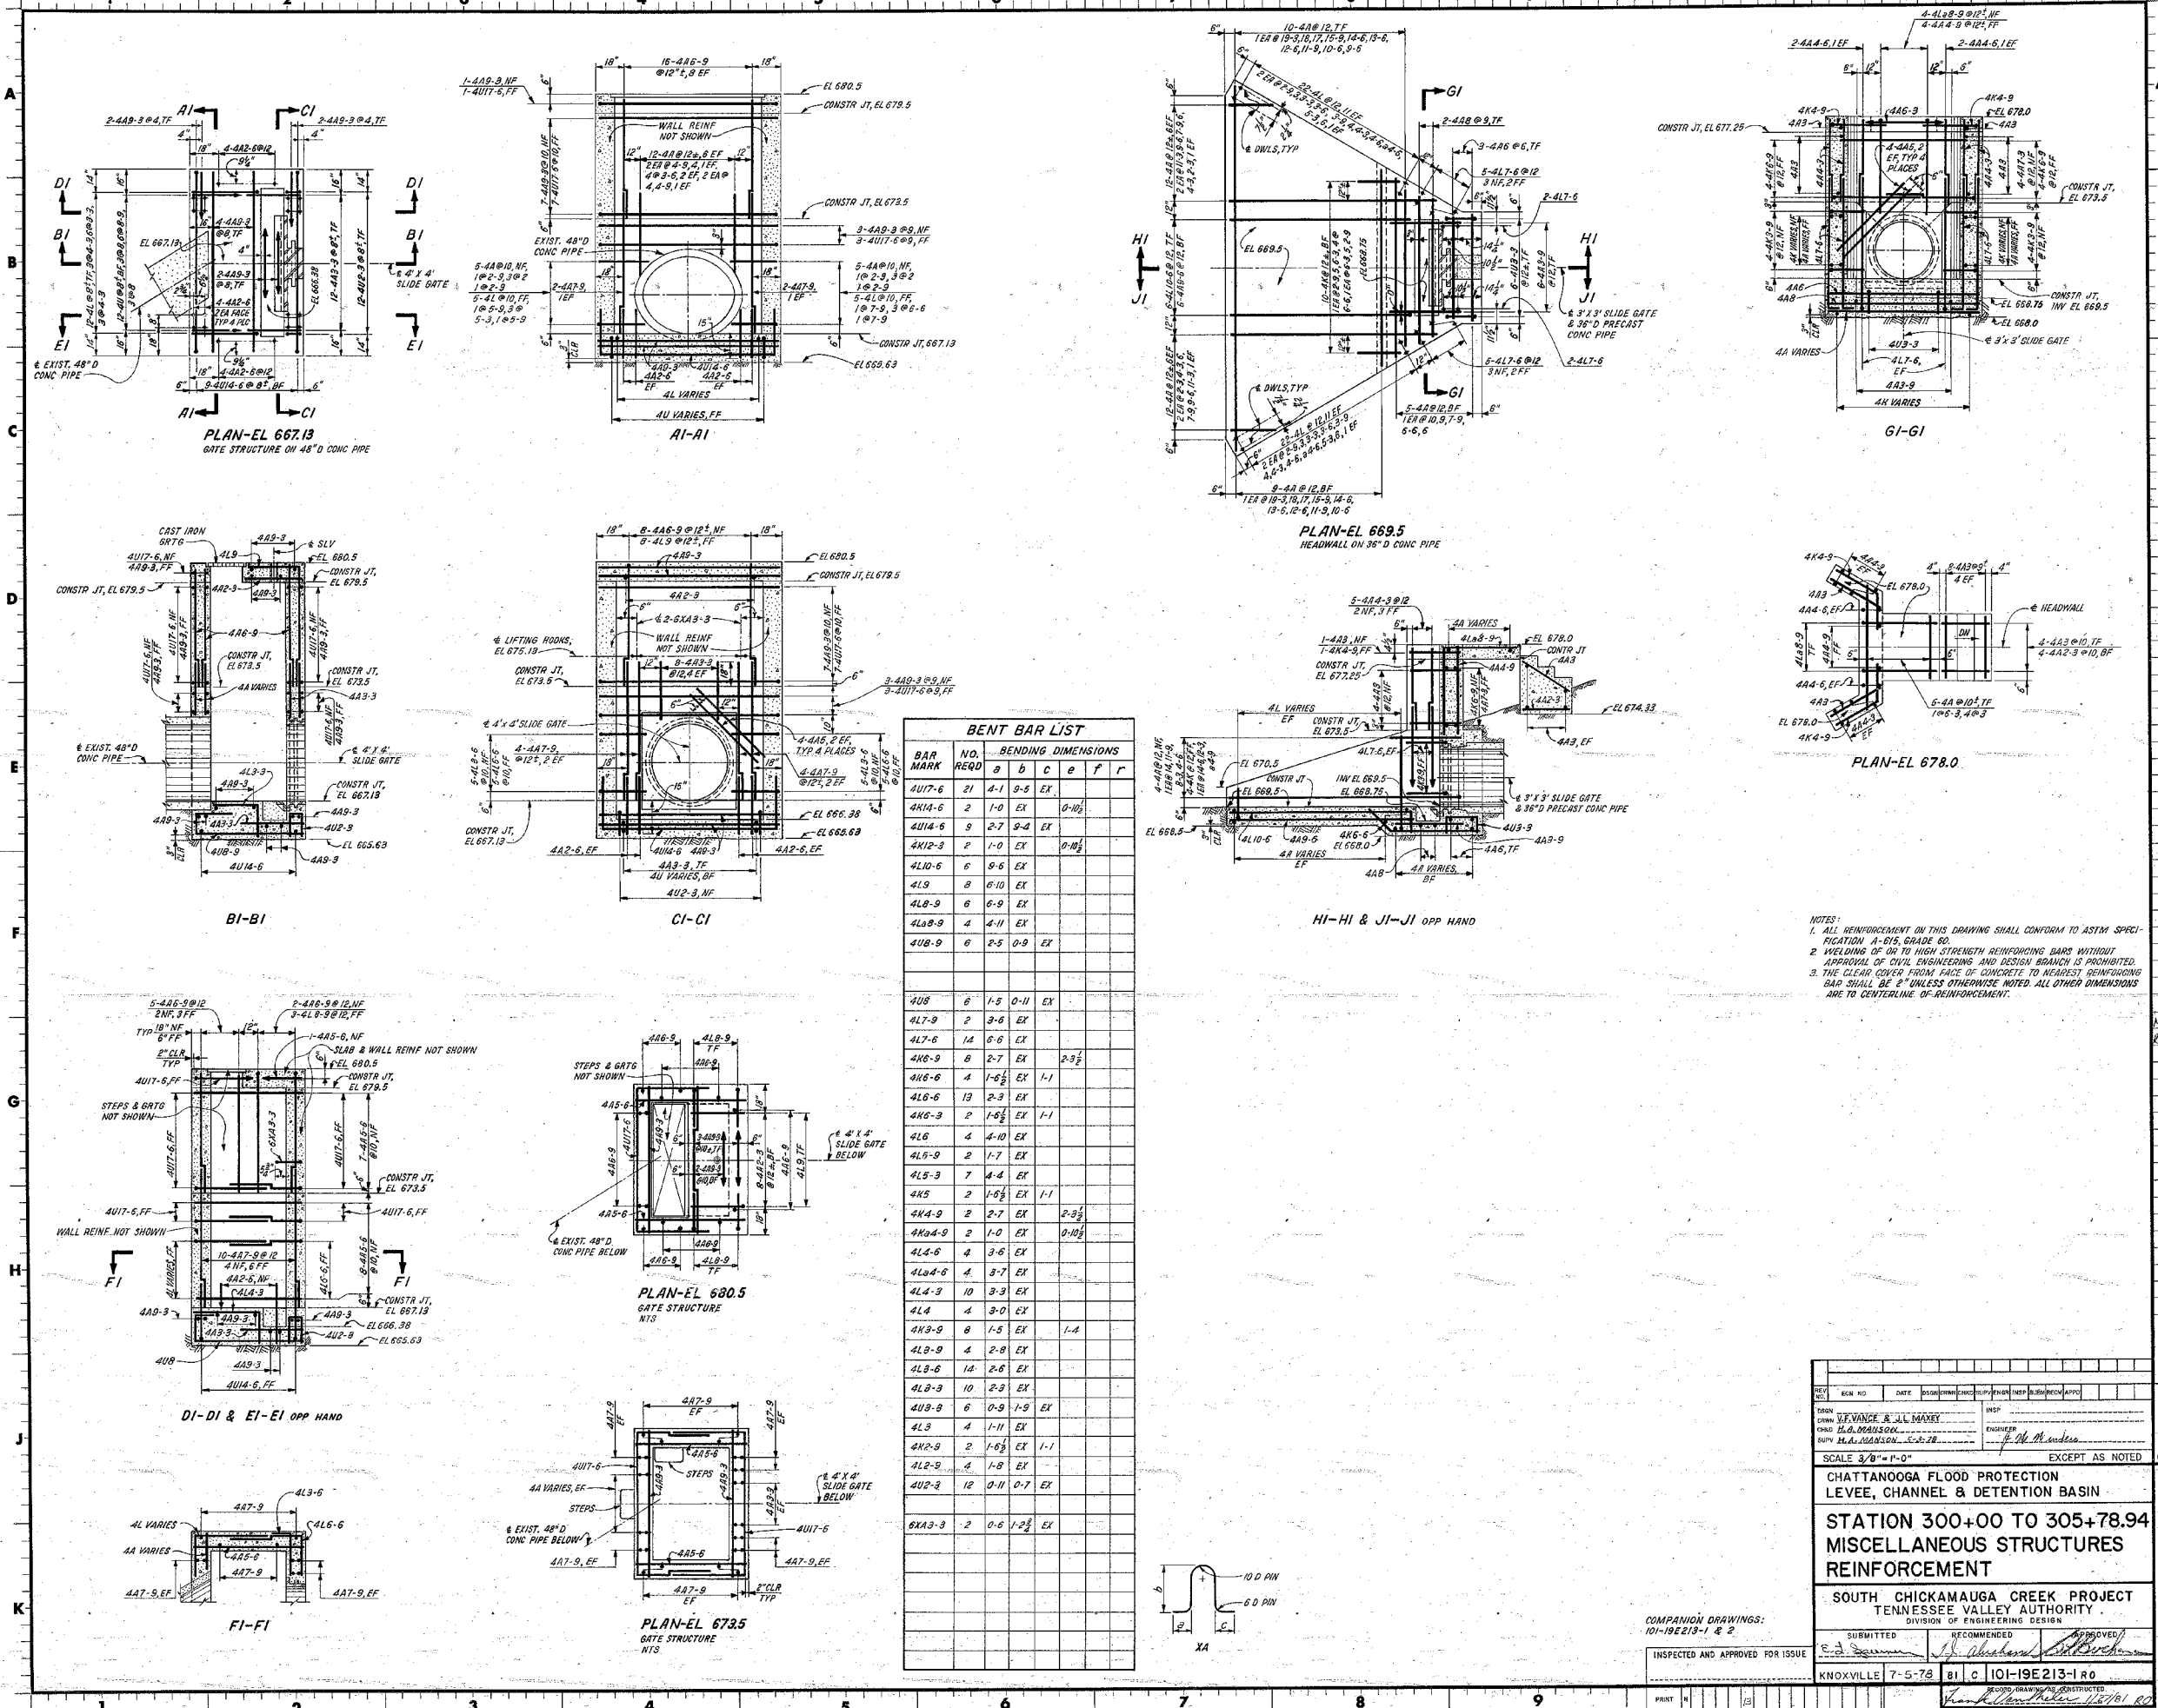

BENT BAR LIST						
BAR MARK	NO.	REQD.	a	b	c	f
4U7-6	21	4-1	9-5	EX.		
4K14-6	2	1-0	EX.	0-10 1/2		
4U14-6	9	2-7	9-4	EX.		
4K12-3	2	1-0	EX.	0-10 1/2		
4K10-6	6	9-6	EX.			
4L9	8	6-10	EX.			
4L8-9	6	6-9	EX.			
4L8-9-9	4	4-11	EX.			
4U8-9	6	2-5	0-9	EX.		
4U8	6	1-5	0-11	EX.		
4L7-9	2	3-6	EX.			
4L7-6	14	6-6	EX.			
4K6-9	8	2-7	EX.	2-3 1/2		
4K6-6	4	1-6 1/2	EX.	1-1		
4L6-6	13	2-3	EX.			
4K6-3	2	1-6 1/2	EX.	1-1		
4L6	4	4-10	EX.			
4L5-9	2	1-7	EX.			
4L5-3	7	4-4	EX.			
4K5	2	1-6 1/2	EX.	1-1		
4K4-9	2	2-7	EX.	2-3 1/2		
4K4-9	2	1-0	EX.	0-10 1/2		
4L4-6	4	3-6	EX.			
4L4-4	4	3-7	EX.			
4L4-3	10	3-3	EX.			
4L4	4	3-0	EX.			
4K3-9	8	1-5	EX.	1-4		
4L3-6	14	2-6	EX.			
4L3-3	10	2-3	EX.			
4U3-8	6	0-9	1-9	EX.		
4L3	4	1-11	EX.			
4K2-9	2	1-6 1/2	EX.	1-1		
4L2-9	4	1-8	EX.			
4U2-3	12	0-11	0-7	EX.		
5XA3-3	2	0-6	1-2 1/2	EX.		

NOTES:  
 1. ALL REINFORCEMENT ON THIS DRAWING SHALL CONFORM TO ASTM SPECIFICATION A-36, GRADE 60.  
 2. WELDING OF OR TO HIGH STRENGTH REINFORCING BARS WITHOUT APPROVAL OF CIVIL ENGINEERING AND DESIGN BRANCH IS PROHIBITED.  
 3. THE CLEAR COVER FROM FACE OF CONCRETE TO NEAREST REINFORCING BAR SHALL BE 4" UNLESS OTHERWISE NOTED. ALL OTHER DIMENSIONS ARE TO CENTERLINE OF REINFORCEMENT.

CHATTANOOGA FLOOD PROTECTION  
 LEVEE, CHANNEL & DETENTION BASIN

STATION 300+00 TO 305+78.94  
 MISCELLANEOUS STRUCTURES  
 REINFORCEMENT


SOUTH CHICKAMAUGA CREEK PROJECT  
 TENNESSEE VALLEY AUTHORITY  
 DIVISION OF ENGINEERING DESIGN

SCALE 3/8" = 1'-0" EXCEPT AS NOTED

INSPECTED AND APPROVED FOR ISSUE


DATE: 7-5-78

PROJECT NO: 101-19E213-1-R0

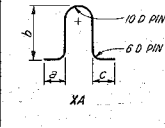


COMPANION DRAWINGS:  
 101-19E213-1 & 2




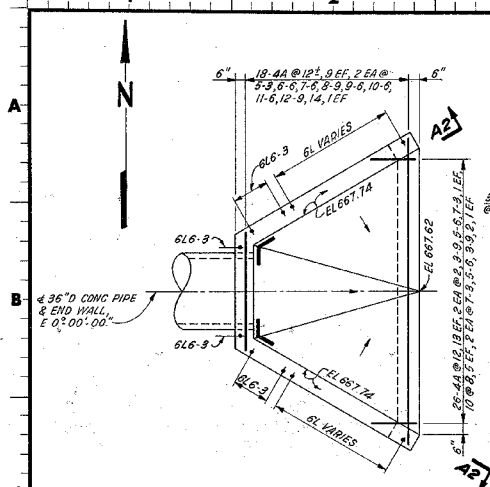


PLAN - EL 667.74  
END WALL - 36" D CULVERT

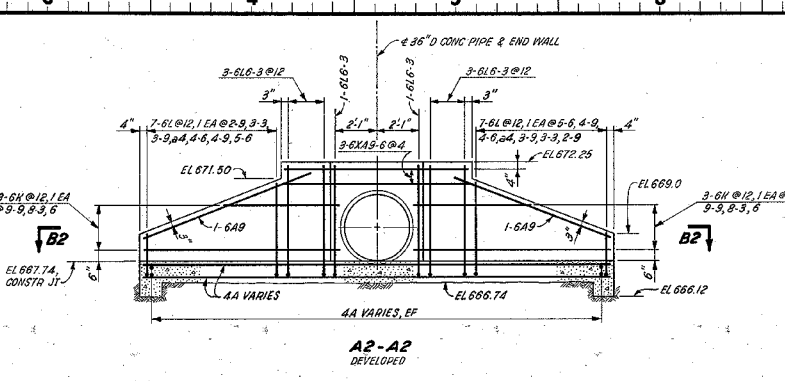


A2-A2  
DEVELOPED

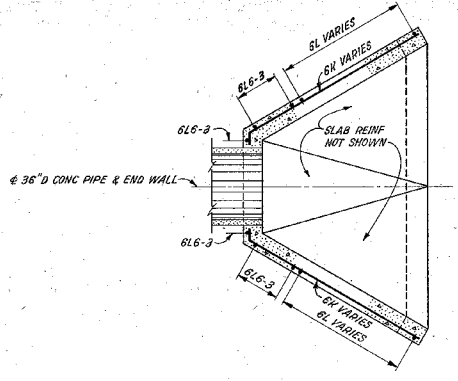


B2-B2

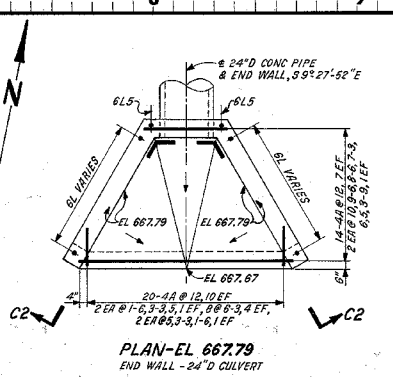


PLAN - EL 667.79  
END WALL - 24" D CULVERT

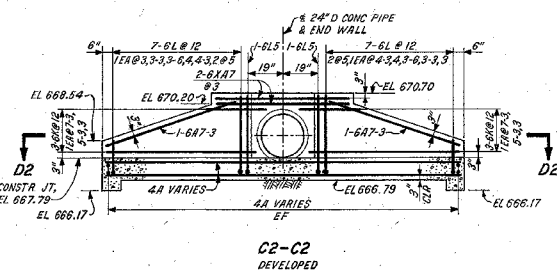


C2-C2  
DEVELOPED

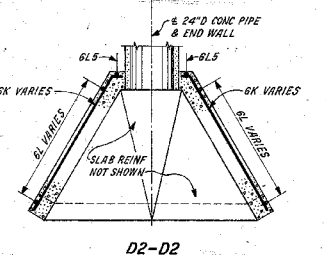

D2-D2

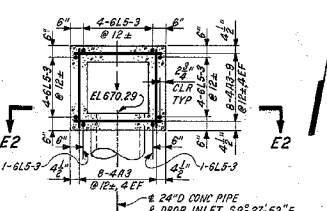


PLAN - EL 670.5  
DROP INLET - 24" D CULVERT

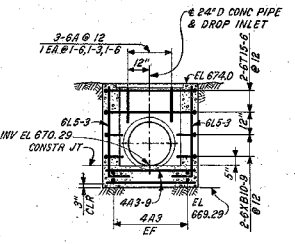

E2-E2

BENT BAR LIST						
BAR MARK	NO. REQD	BENDING DIMENSIONS				
		a	b	c	e	f
6K9-9	2	0-11	EX	0-10		
6K9-6	3	2-5	4-11	EX	2-1	
6K8-3	2	0-7	EX	0-6		
6L6-3	6	5-1	EX			
6N6	2	0-11	EX	0-10		
6L5-6	2	4-3	EX			
6T15-6	2	3-3	4-0			
6X10-3	2	0-5	3-3	4-0	EX	
6K7-3	2	2-6	EX	0-5 1/2		
6K7-7	2	1-11	3-6	EX	1-8 1/2	
6K5-3	2	0-5	EX	0-4 1/2		
6L5-3	14	4-3	EX			
6L5	6	3-6	EX			
6L4-3	2	3-3	EX			
6L4	2	2-10	EX			
6L3-6	2	2-6	EX			
6L3-3	4	2-3	EX			
6K3	2	1-0	EX	0-10 1/2		
6L3	2	1-9	EX			
6L4-9	2	3-10	EX			
6L4-6	2	3-6	EX			
6L4-4	2	3-1	EX			
6L3-9	2	2-8	EX			
6L2-9	2	1-9	EX			

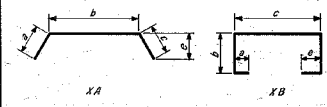

NOTES:  
1. FOR GENERAL NOTES SEE 101-19E213-1.

1	7-25-78	REMOVED HOLD, CC & REVISED BENT BAR LIST
REV	NO.	DATE
DESIGN	J.L. MAJEY	
CHECKED	H.A. MADSEN	
APPROVED	J.M. MADSEN	
SCALE 3/8"=1'-0" EXCEPT AS NOTED		
CHATTANOOGA FLOOD PROTECTION LEVEE, CHANNEL & DETENTION BASIN		
STATION 300+00 TO 305+78.94		
MISCELLANEOUS STRUCTURES REINFORCEMENT		
SOUTH CHICKAMAUGA CREEK PROJECT TENNESSEE VALLEY AUTHORITY		
SUBMITTED	RECOMMENDED	APPROVED
	J.M. Madson	
DIVISION OF ENGINEERING DESIGN		
INSPECTED AND APPROVED FOR ISSUE	KNOXVILLE	7-5-78
PROJECT NO.	101-19E213-2 R1	

INSPECTED AND APPROVED FOR ISSUE

PRINT	1	3
SCALE	1	3

RECORD DRAWING TO BE CONSTRUCTED

STRAIGHT REINFORCEMENT BAR LIST

(FOR FIELD INFORMATION ONLY)

MADE J.L. MAXEY

FOR DWG. NO. 101-19E213-2 RI

CHKD: HAM 4-26-78 Ro  
 11 JWW 7-20-78 R1

SHEET NO 1 OF 1

DATE 4-14-78



PROJECT SOUTH CHICKAMAUGA CREEK

BUILDING MISCELLANEOUS STRUCTURES

BAR SIZE	BAR LENGTH	NO. REQ'D	BAR SIZE	BAR LENGTH	NO. REQ'D	BAR SIZE	BAR LENGTH	NO. REQ'D
<del>6</del>	<del>33-6</del>	<del>30</del>	4	1-6	4			
<del>6</del>	<del>15-3</del>	<del>8</del>						
<del>6</del>	<del>15</del>	<del>4</del>	4	14	2			
<del>6</del>	<del>9</del>	<del>60</del>	4	12-9	2			
<del>6</del>	<del>8-6</del>	<del>4</del>	4	11-6	2			
<del>6</del>	<del>7</del>	<del>68</del>	4	10-6	2			
<del>6</del>	<del>6-6</del>	<del>4</del>						
<del>6</del>	<del>5</del>	<del>4</del>	4	8-9	2			
<del>6</del>	<del>4-3</del>	<del>4</del>	4	8	10			
6	1-6	2	4	7-6	2			
6	1-3	1						
6	7-3	2	4	6-6	2			
6	9	2	4	5-6	4			
4	10	2	4	5-3	2			
4	9-6	4						
4	8-6	2	4	2	4			
4	7-3	8						
4	6-3	8						
4	6	2						
4	5	6						
4	3-9	14						
4	3-3	4						
4	3	8						





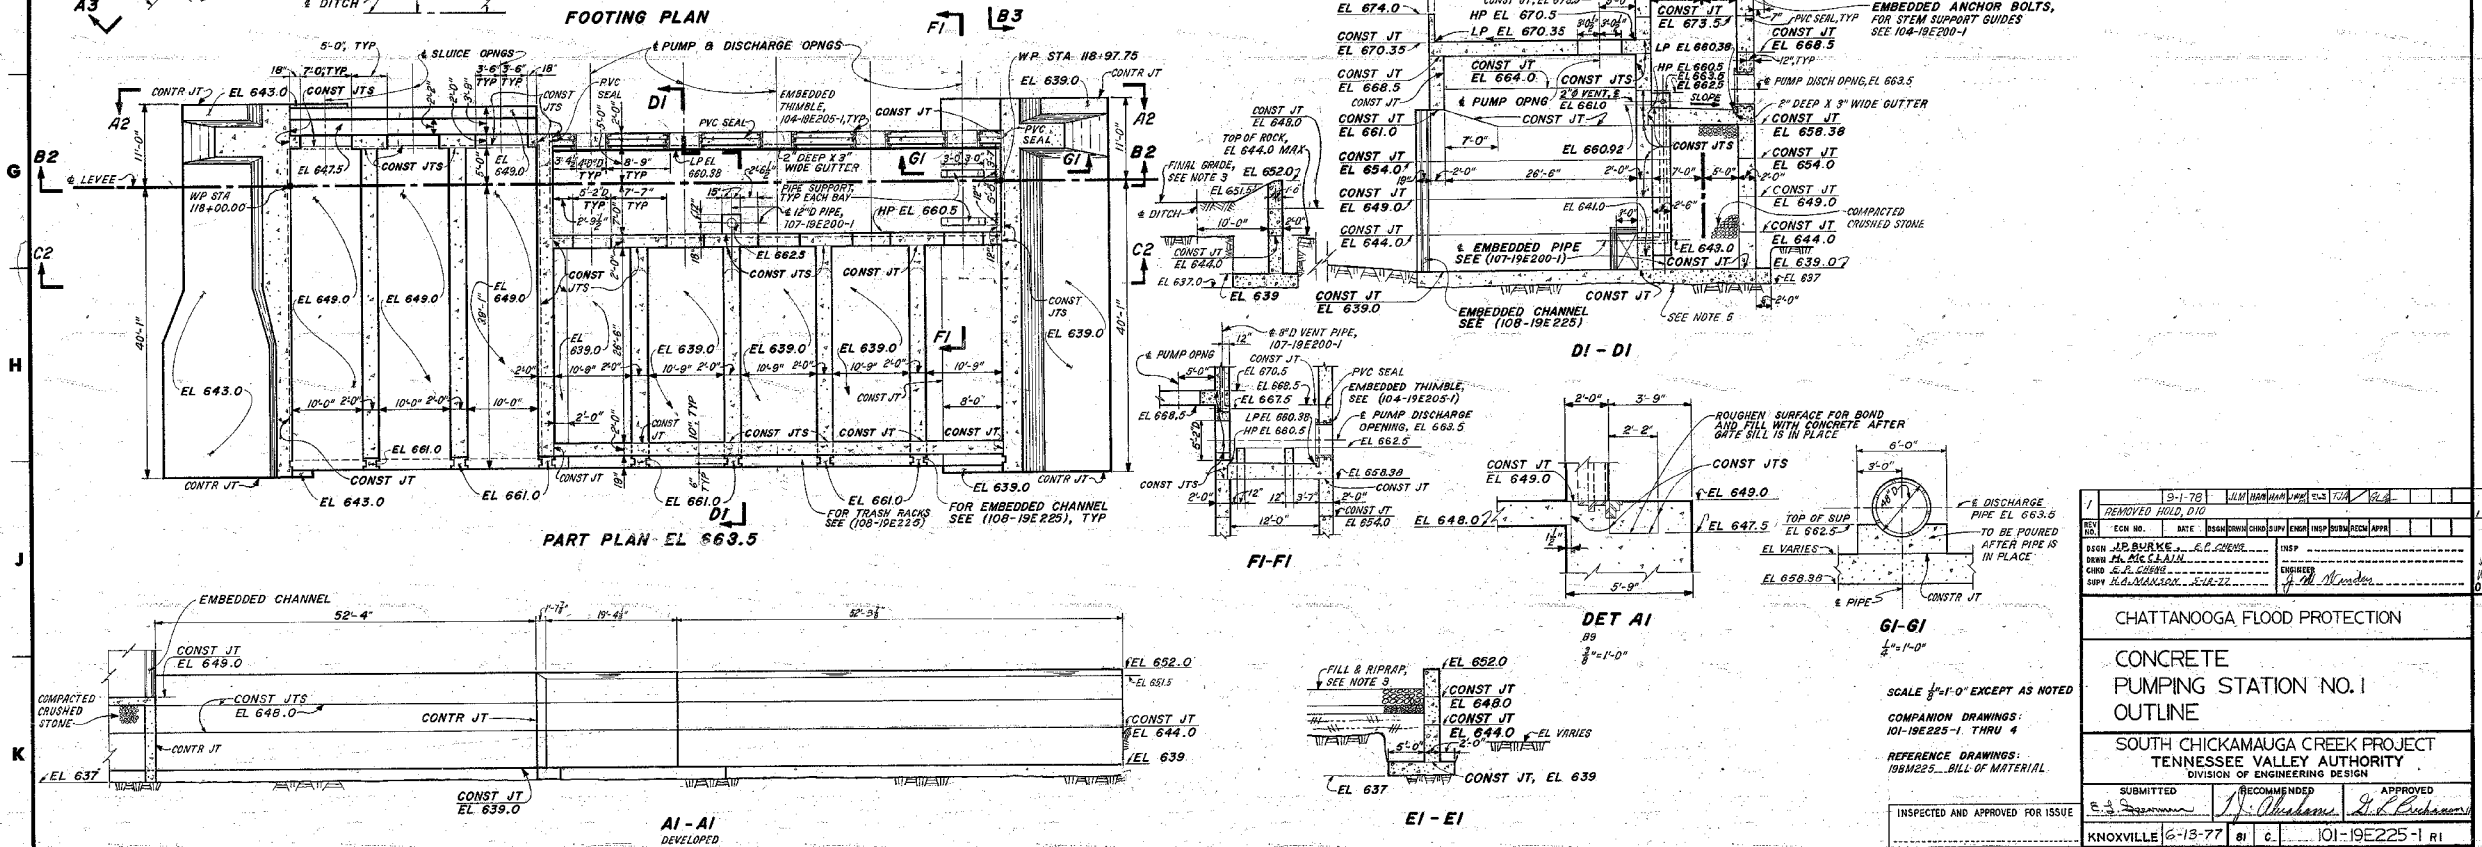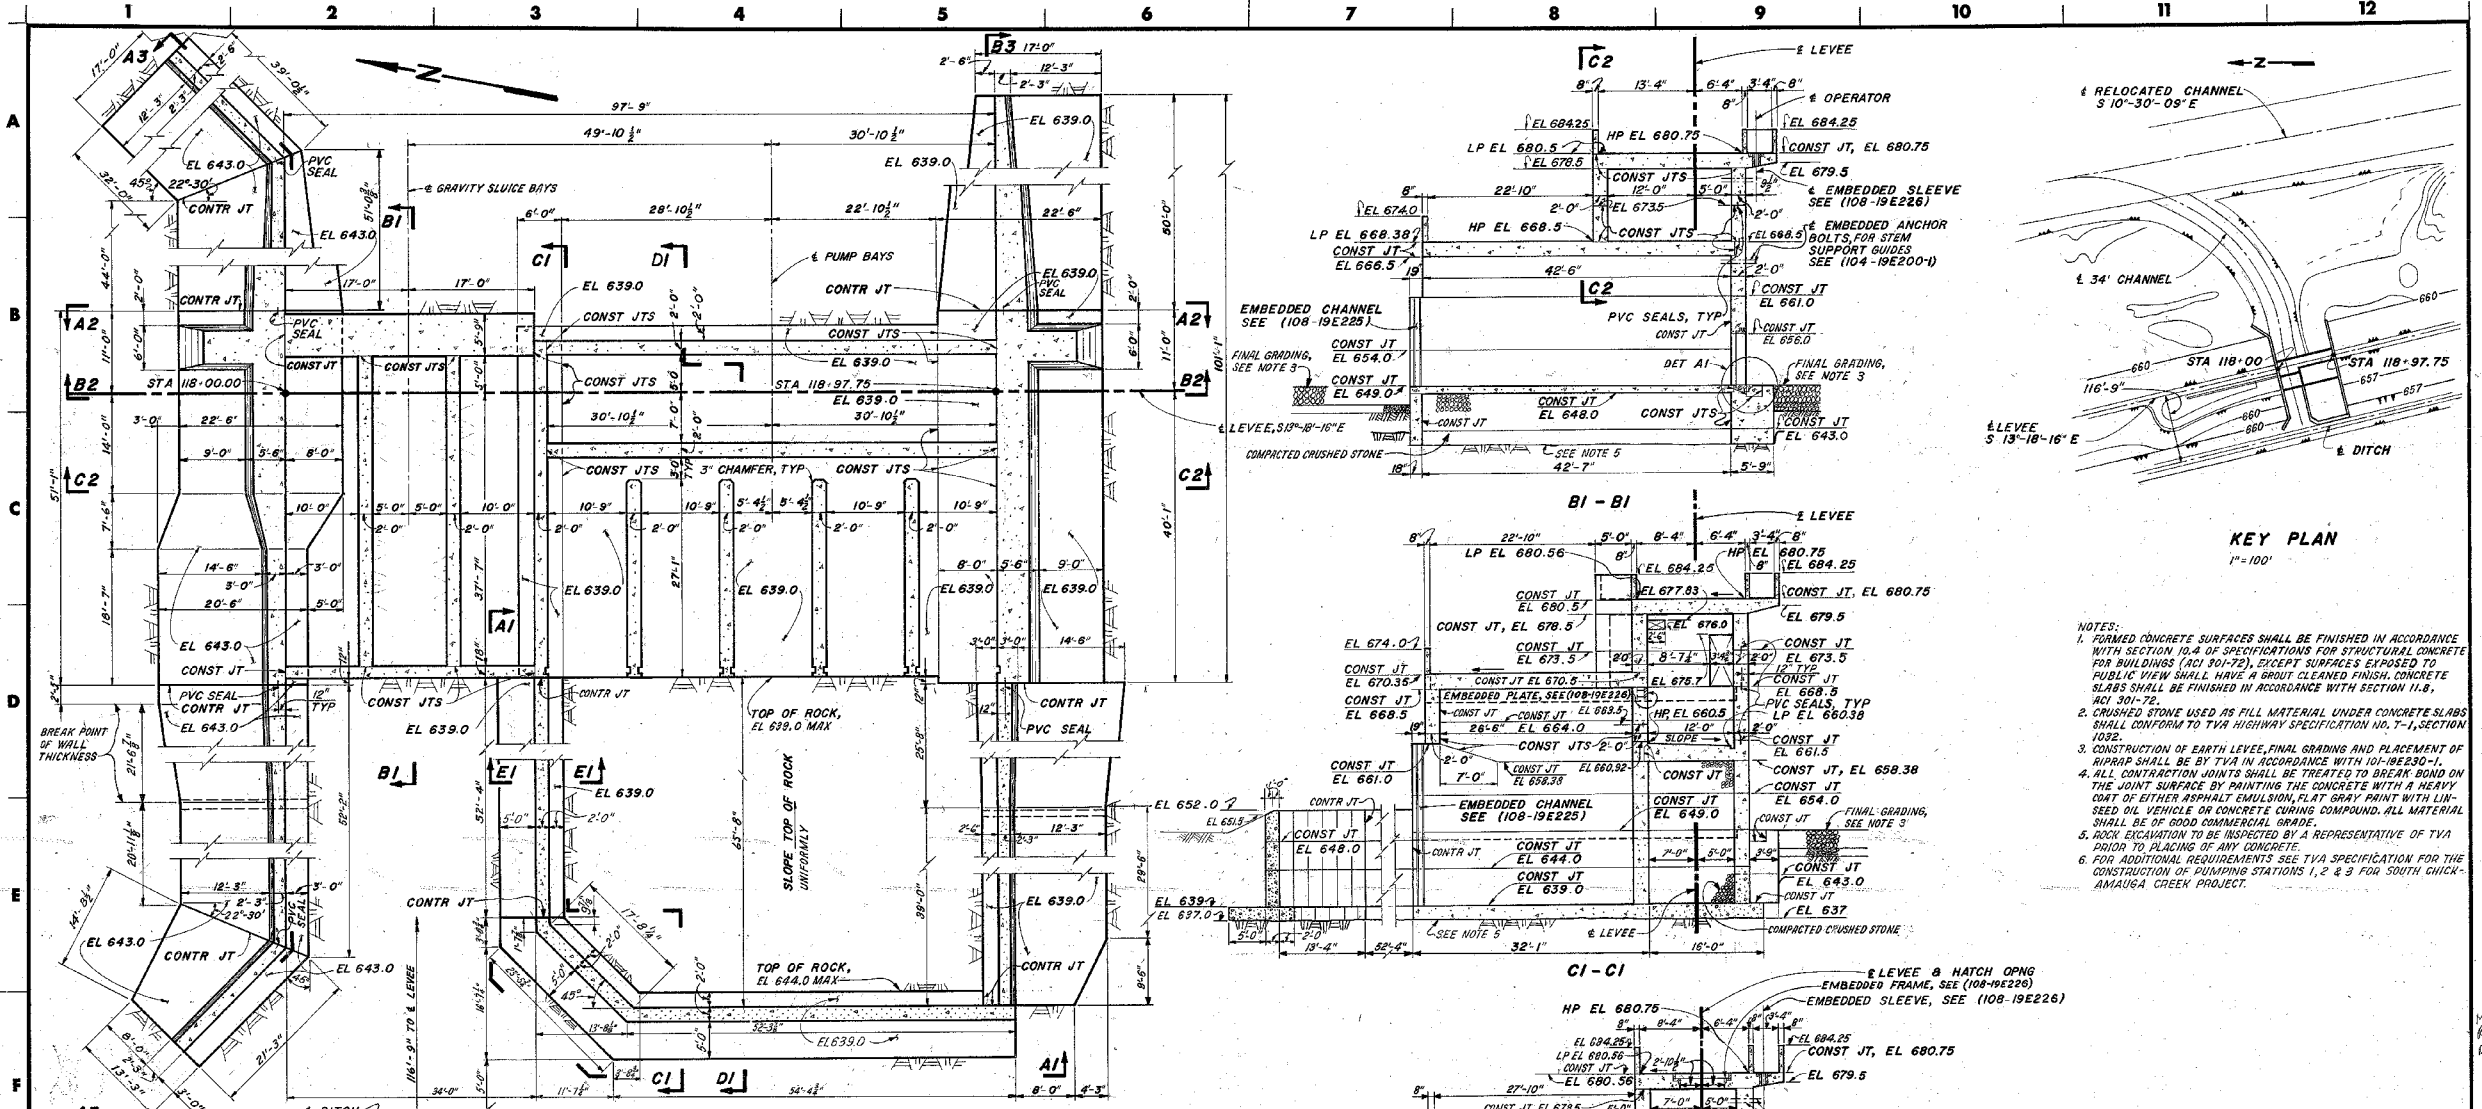

1	REMOVED HOLD, DTD	3-1-75	J.M. BURKE	REVISION
2	REVISION	DATE	DESIGNED	CHECKED
3	REVISION	DATE	DESIGNED	CHECKED
4	REVISION	DATE	DESIGNED	CHECKED
5	REVISION	DATE	DESIGNED	CHECKED

**CHATTANOOGA FLOOD PROTECTION**


**CONCRETE PUMPING STATION NO. 1 OUTLINE**

**SOUTH CHICKAMAUGA CREEK PROJECT**  
TENNESSEE VALLEY AUTHORITY  
DIVISION OF ENGINEERING DESIGN

SUBMITTED: *[Signature]* RECOMMENDED: *[Signature]* APPROVED: *[Signature]*

KNOXVILLE 6-13-77 81 c. 101-19225-1 R1

INSPECTED AND APPROVED FOR ISSUE	<i>[Signature]</i>
PRINT	11 14 2
SIZE	P
BY OR PROJ	ME EC AC CP DP MD BY SW BK PA
PRINTS	REQD-4

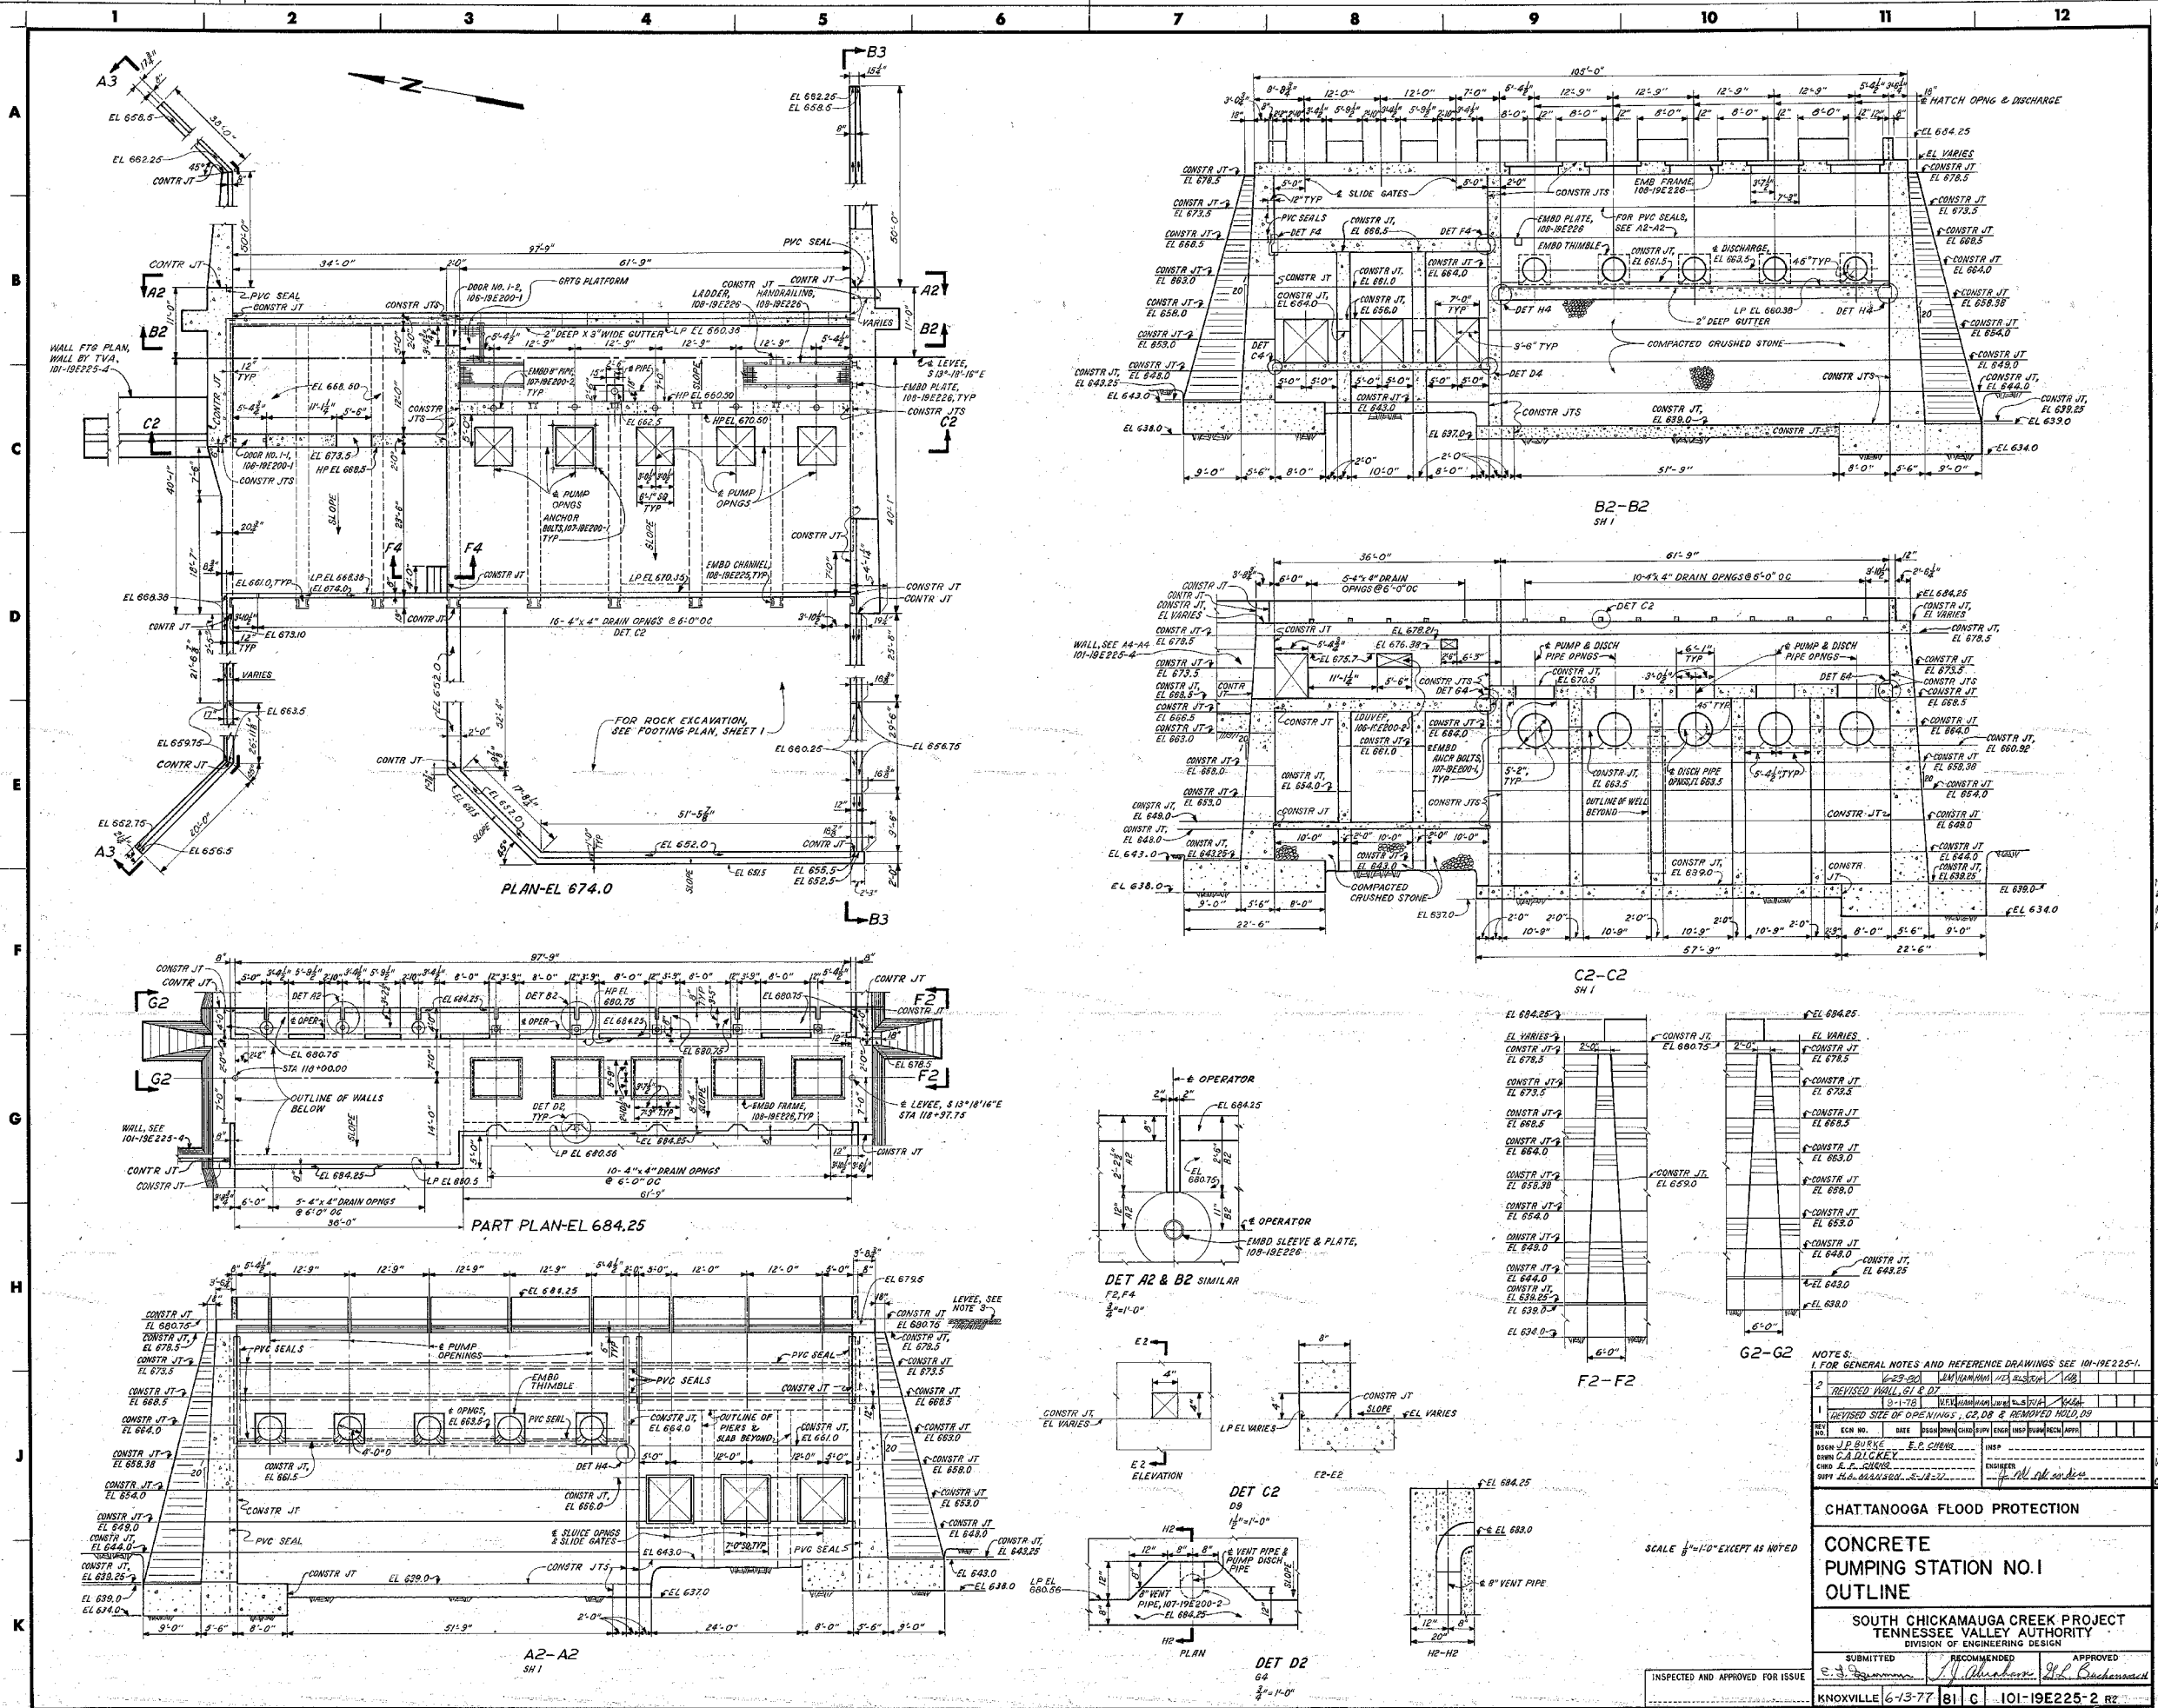

NOTES:  
 1. FOR GENERAL NOTES AND REFERENCE DRAWINGS SEE 101-19E225-1.  
 2. REVISED WALL, G1 & D7  
 3. REVISED SIZE OF OPENINGS, C2, D8 & REMOVED HOLD, D9

NO.	DATE	BY	CHKD	APP'D	DESCRIPTION
1	10-1-78	W. H. HARRIS	J. S. L. SMITH	J. S. L. SMITH	REVISED WALL, G1 & D7
2	10-1-78	W. H. HARRIS	J. S. L. SMITH	J. S. L. SMITH	REVISED SIZE OF OPENINGS, C2, D8 & REMOVED HOLD, D9

DESIGN: J. P. BURKE, E. C. GIBBS  
 CHECK: G. A. CALVEY  
 SUPERVISOR: J. L. CHURCH

CHATANOOGA FLOOD PROTECTION  
 CONCRETE PUMPING STATION NO. 1  
 OUTLINE

SOUTH CHICKAMAUGA CREEK PROJECT  
 TENNESSEE VALLEY AUTHORITY  
 DIVISION OF ENGINEERING DESIGN

SUBMITTED: J. P. BURKE  
 RECOMMENDED: J. L. CHURCH  
 APPROVED: J. S. L. SMITH

INSPECTED AND APPROVED FOR ISSUE: [Signature]  
 KNOXVILLE 6-13-77

PROJECT NO. 101-19E225-2 R2  
 SHEET NO. 81 C

SCALE 1/4"=1'-0" EXCEPT AS NOTED



PRINTED AT: [Blank]  
 DATE: 1/22/77  
 SIZE: [Blank]  
 SHEET NO.: 81 C  
 PROJECT NO.: 101-19E225-2 R2  
 DRAWN BY: [Blank]  
 CHECKED BY: [Blank]  
 DATE: 1/27/81









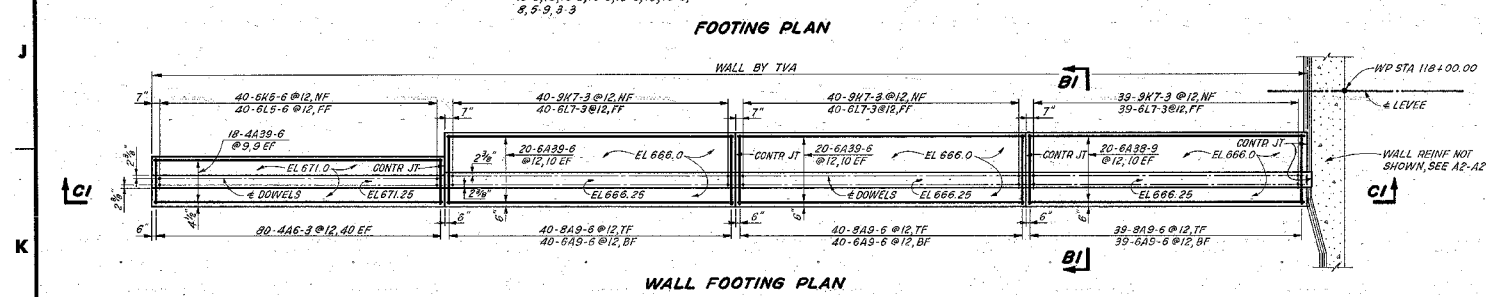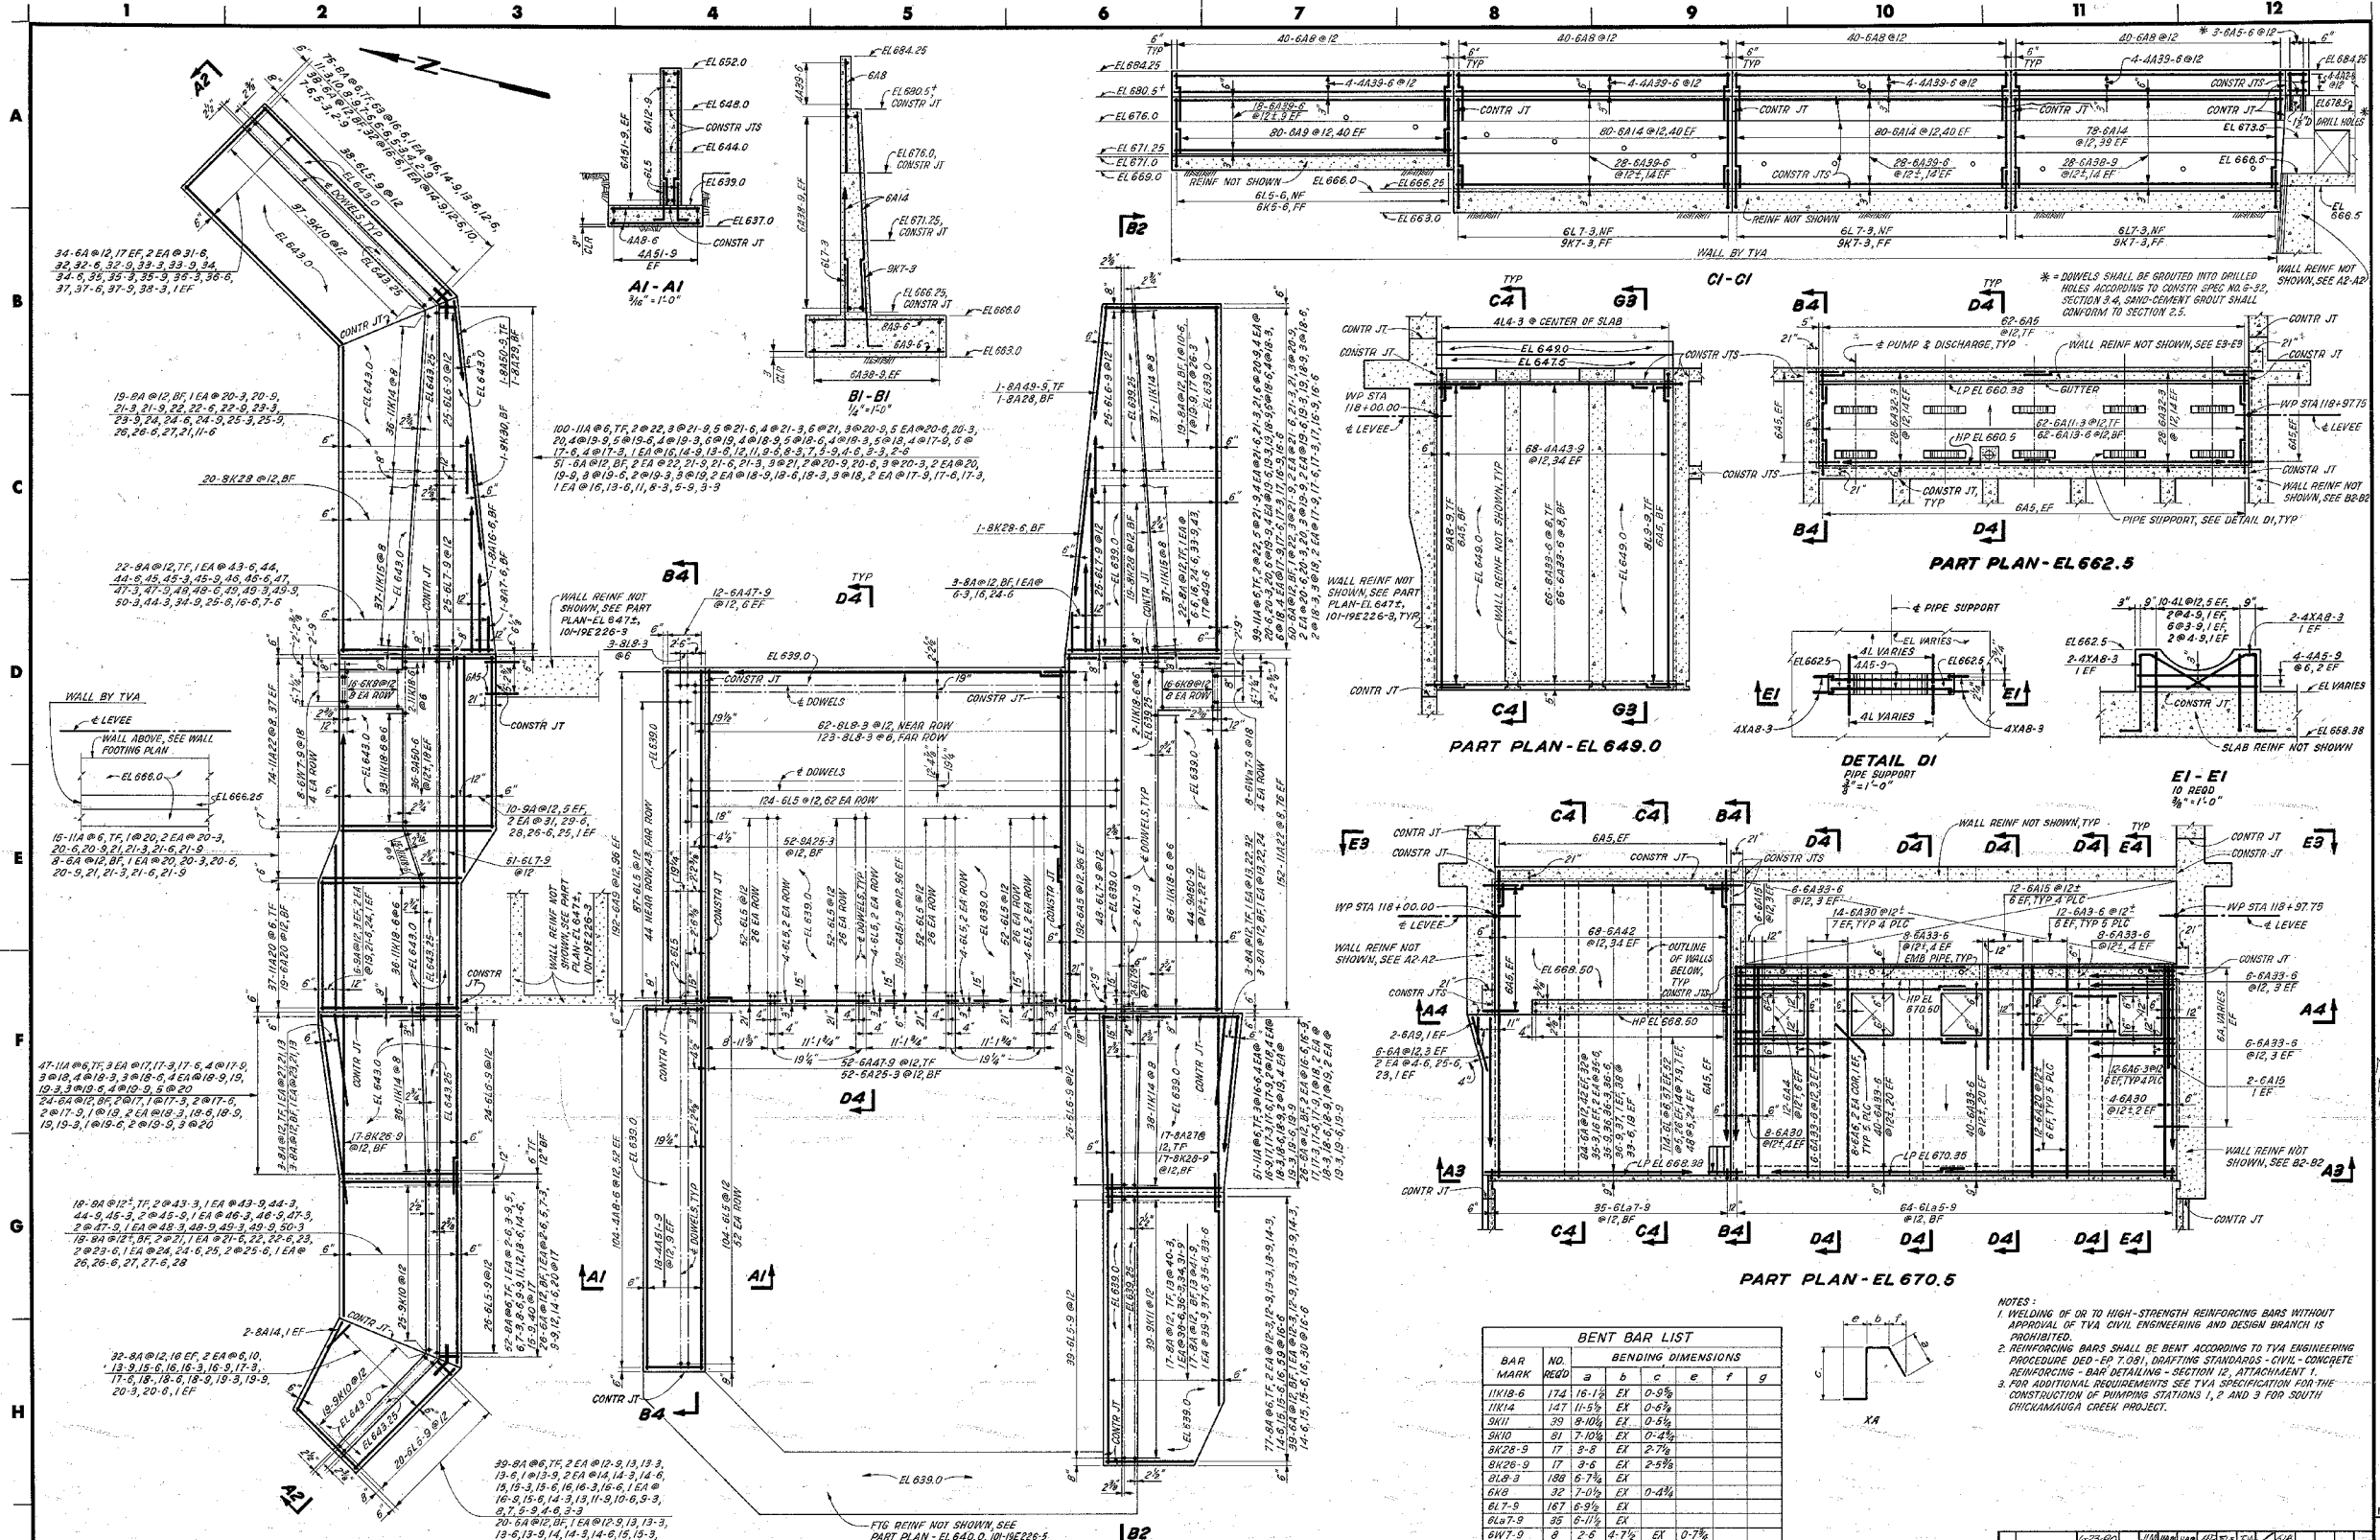


BENT BAR LIST						
BAR MARK	NO.	REQD.	a	b	c	d
11K18-6	174	16-12	EX	0-3%		
11K14	147	11-5	EX	0-6%		
SK11	39	8-10	EX	0-6%		
SK10	81	7-10	EX	0-4%		
SK28-9	17	3-8	EX	2-7%		
SK26-9	17	3-8	EX	2-5%		
SK2-3	188	6-7	EX	0-3%		
SK19	32	7-0	EX	0-4%		
ELT-9	167	6-9	EX			
BL7-9	35	6-11	EX			
6W7-9	8	2-6	EX	0-7%		
6W4-9	8	2-6	EX	0-6%		
SK7-3	119	6-4	EX	0-3%		
SK7-3	119	6-4	EX			
BL-9	100	5-9	EX			
BL-9	129	4-10	EX			
BL5-3	64	4-11	EX	0-2%		
BL5-6	40	4-9	EX	0-2%		
BL5-6	40	4-9	EX			
4A2-3	40	3-2	EX	3-7	EX	2-9
4L4-9	40	3-8	EX			
4L9-9	60	2-9	EX			
11K19	74	12-5	EX	0-7%		
6W28	39	3-8	EX	2-7%		
SK28-6	1	4-0	EX	2-10		
SK30	1	5-7	EX	4-0		

NOTES:  
 1. WELDING OF OR TO HIGH-STRENGTH REINFORCING BARS WITHOUT APPROVAL OF TVA CIVIL ENGINEERING AND DESIGN BRANCH IS PROHIBITED.  
 2. REINFORCING BARS SHALL BE BENT ACCORDING TO TVA ENGINEERING PROCEDURE DEP-EP 7.081, DRAFTING STANDARDS - CIVIL - CONCRETE REINFORCING - BAR DETAILING - SECTION 12, ATTACHMENT 1.  
 3. FOR ADDITIONAL REQUIREMENTS SEE TVA SPECIFICATION FOR THE CONSTRUCTION OF PUMPING STATIONS 1, 2 AND 3 FOR SOUTH CHICKAMAUGA CREEK PROJECT.

CHATTANOOGA FLOOD PROTECTION  
 CONCRETE PUMPING STATION NO. 1  
 REINFORCEMENT  
 SOUTH CHICKAMAUGA CREEK PROJECT  
 TENNESSEE VALLEY AUTHORITY  
 DIVISION OF ENGINEERING DESIGN


INSPECTED AND APPROVED FOR ISSUE  
 KNOXVILLE 6-24-77  
 81 c 101-19E226-1 R1

A  
B  
C  
D  
E  
F  
G  
H  
J  
K

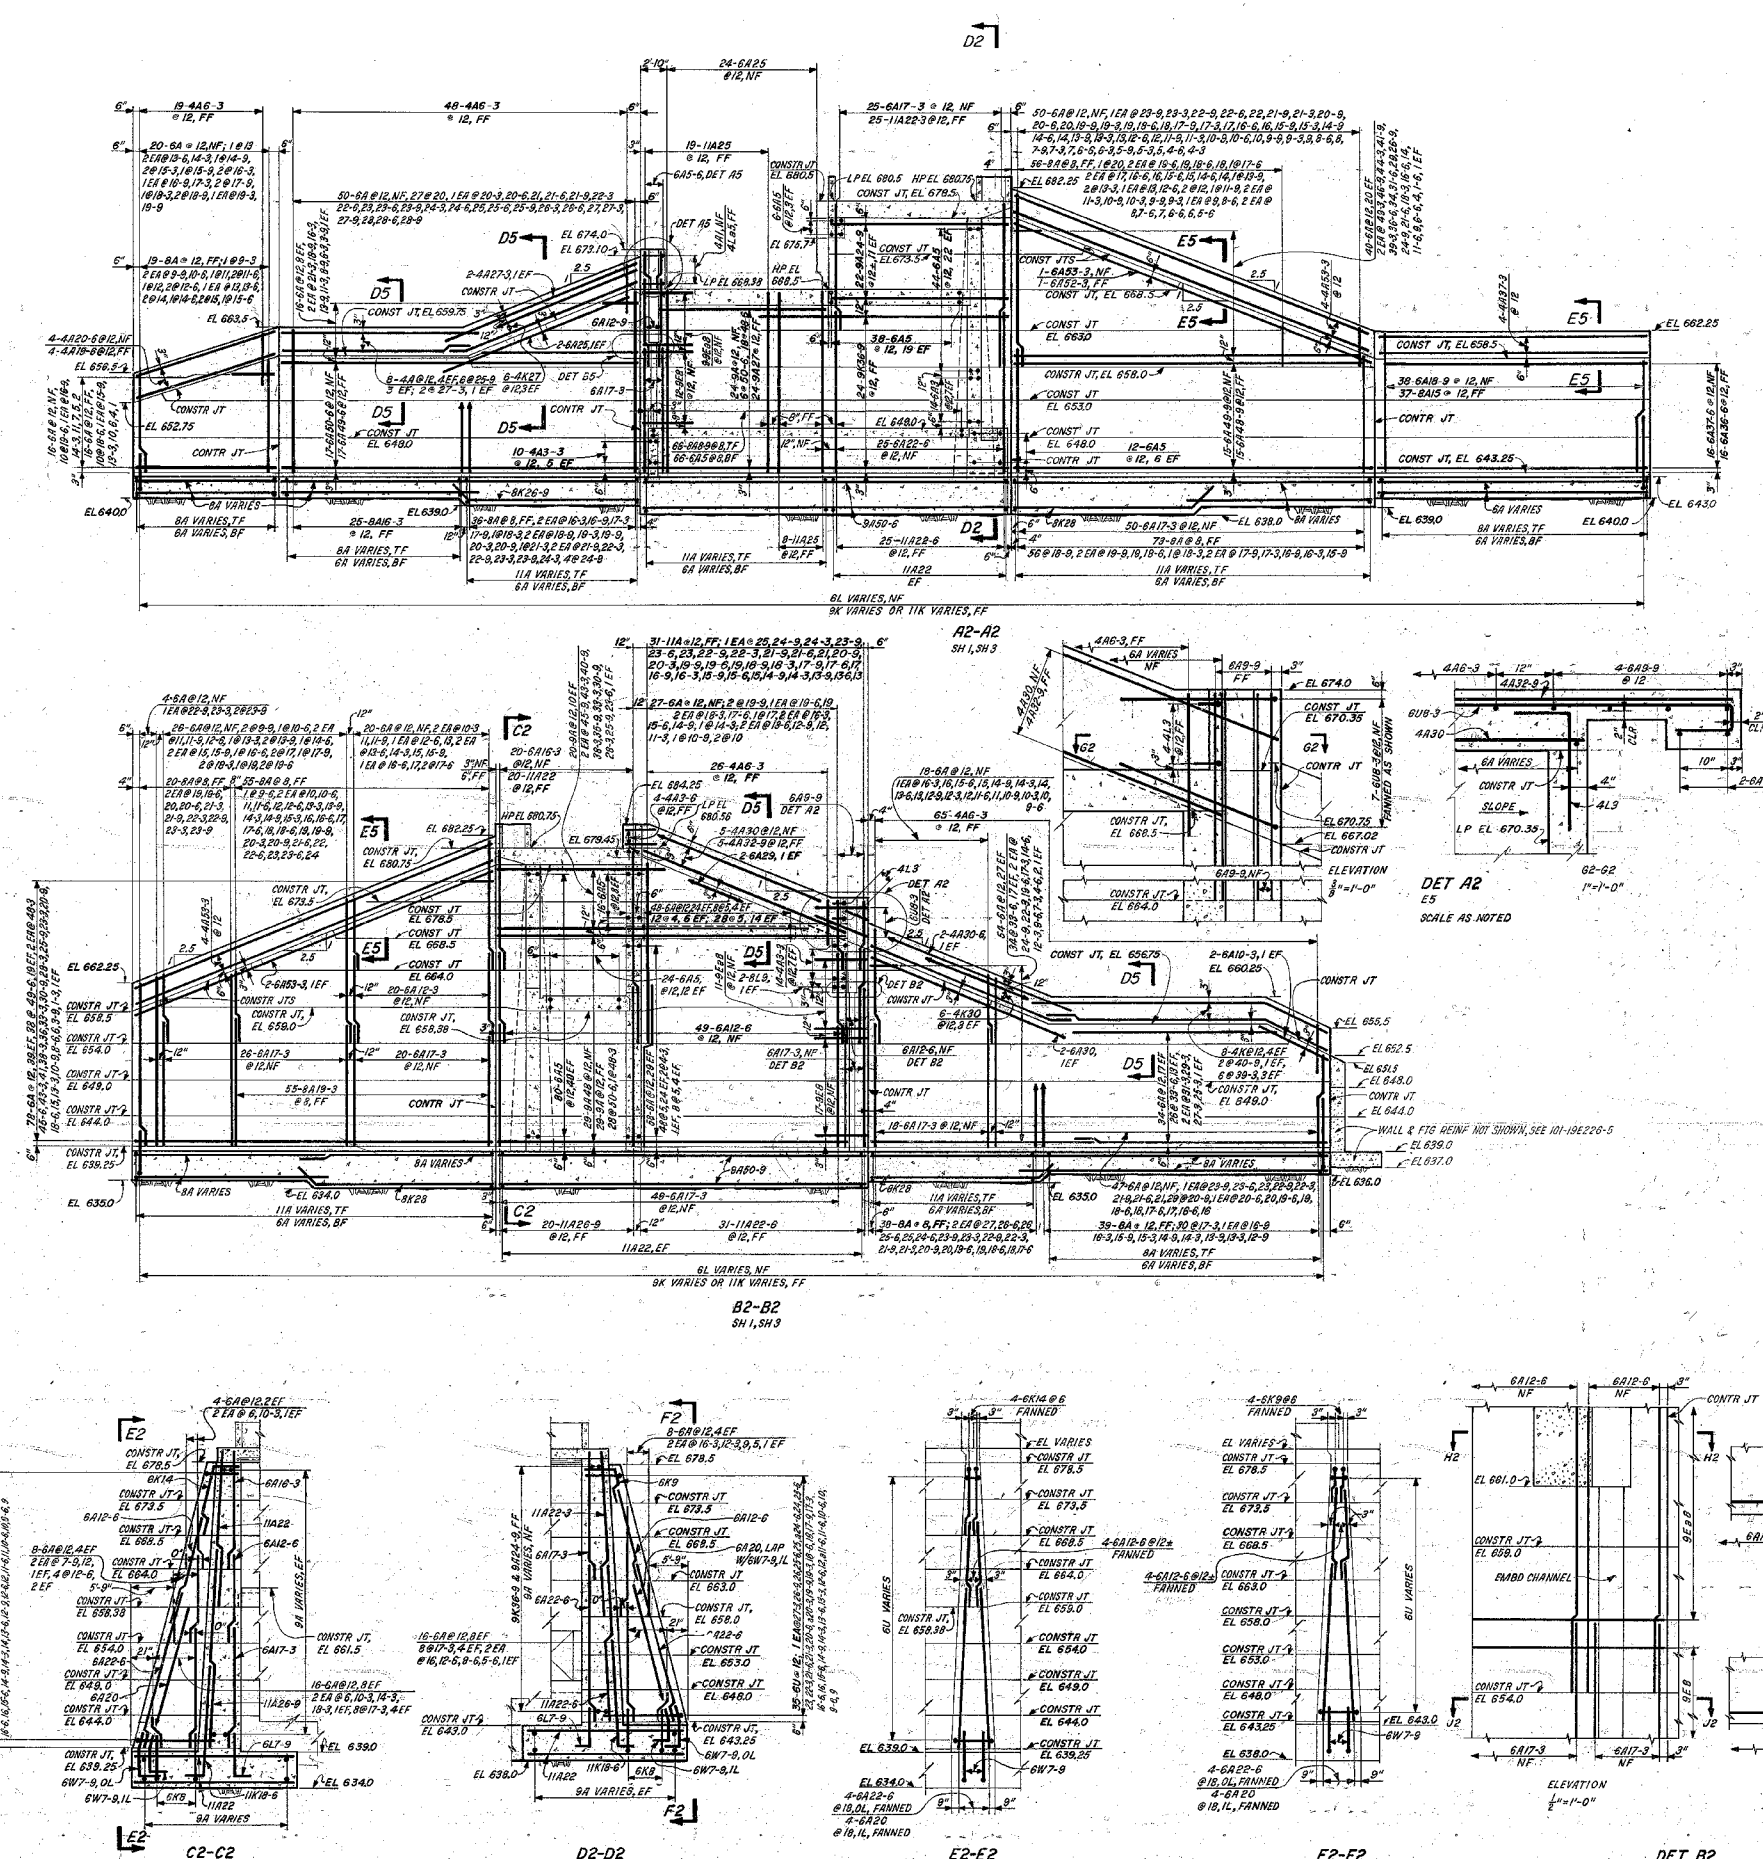


BENT BAR LIST						
BAR MARK	NO.	BENDING DIMENSIONS				
		a	b	c	e	f
8K30-9	24	24-0	EX	7-0		
9E8	28	0-11	0-3	1-1/2	EX	0-3
9E9	18	0-5	0-9	1-7/8	EX	0-7/8
8L9	2	7-6	EX			
6U27-6	1	11-1	5-8	EX		
6U27-3	2	10-11	5-7	EX		
6U20-9	2	10-9	5-6	EX		
6U20	2	10-6	5-4	EX		
6U25-6	2	10-3	5-3	EX		
6U25	2	10-0	5-2	EX		
6U24-6	1	9-11	5-1	EX		
6U24-6	1	9-10	5-0	EX		
6U24	2	8-9	4-11	EX		
6U23-6	2	8-6	4-9	EX		
6U23	2	8-3	4-8	EX		
6U22-3	2	8-0	4-7	EX		
6U22	1	8-0	4-6	EX		
6U21-6	2	8-9	4-5	EX		
6U21-3	2	8-7	4-4	EX		
6U20-6	2	8-4	4-3	EX		
6U20-3	1	8-2	4-1	EX		
6U19-9	2	8-0	4-0	EX		
6U19-3	2	7-9	3-11	EX		
6U18-6	2	7-8	3-10	EX		
6U18-3	1	7-4	3-9	EX		
6U18	1	7-4	3-8	EX		
6U17-9	2	7-3	3-7	EX		
6U17-3	2	7-0	3-6	EX		
6U16-9	1	6-10	3-5	EX		
6U16-6	2	6-8	3-4	EX		
6U16	2	6-8	3-3	EX		
6U15-6	2	6-3	3-2	EX		
6U14-9	2	6-0	3-0	EX		
6U14-3	2	5-10	2-11	EX		
6K14	4	4-9	EX	2-3		
6U14	1	3-9	2-10	EX		
6U13-6	2	3-7	2-9	EX		
6U13-3	1	3-5	2-8	EX		
6U12-9	1	3-3	2-7	EX		
6U12-6	2	3-2	2-6	EX		
6U12	2	3-0	2-5	EX		
6U11-6	2	2-8	2-3	EX		
6U11-3	1	2-8	2-4	EX		

BENT BAR LIST CONT'D								
BAR MARK	NO.	BENDING DIMENSIONS						
		a	b	c	e	f	g	
6U11	1	4-8	2-2	EX				
6U10-6	2	4-4	2-1	EX				
6U10	2	4-2	2-0	EX				
6U9-6	2	4-0	1-10	EX				
6U9	4	4-0	EX	1-3				
6U8-9	2	3-9	1-9	EX				
6U8-3	7	0-11	0-6	EX				
6L5	14	2-9	EX					
4K40-9	2	10-4	EX	4-7				
4K39-3	6	10-4	EX	4-7				
4K30	6	27-4	EX	10-2				
4K27	6	25-6	EX	8-9				
4L5	65	1-5	EX					
4L3	4	2-0	EX					

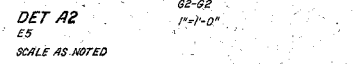

DET A2  
SCALE AS NOTED

NOTES:  
1. FOR GENERAL NOTES AND REFERENCE DRAWINGS SEE 101-19E226-1.

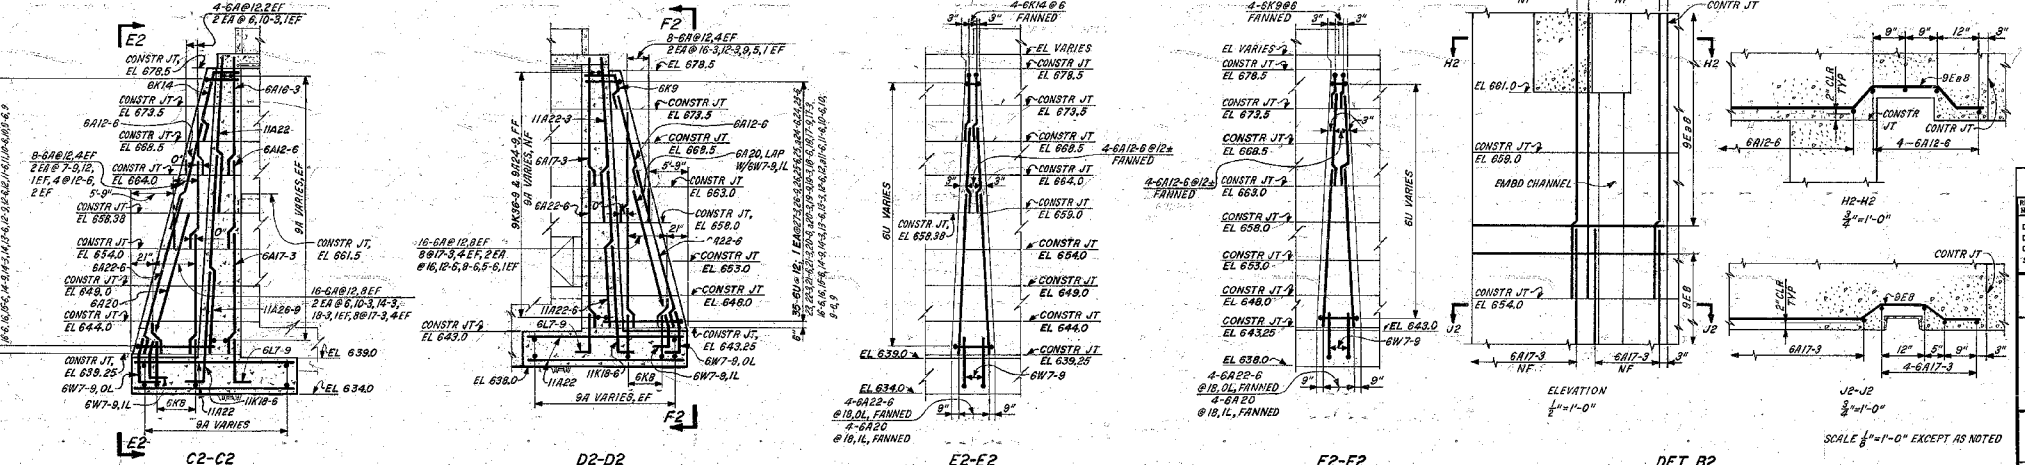


REV	NO.	DATE	BY	CHKD	APP'D
05	1	10/1/01	J.P. CHENS	H.S.P.	
06	1	10/1/01	J.P. CHENS	H.S.P.	
07	1	10/1/01	J.P. CHENS	H.S.P.	
08	1	10/1/01	J.P. CHENS	H.S.P.	

CHATTANOOGA FLOOD PROTECTION  
CONCRETE PUMPING STATION NO 1 REINFORCEMENT  
SOUTH CHICKAMAUGA CREEK PROJECT  
TENNESSEE VALLEY AUTHORITY  
DIVISION OF ENGINEERING DESIGN

SUBMITTED: [Signature]  
RECOMMENDED: [Signature]  
APPROVED: [Signature]

INSPECTED AND APPROVED FOR ISSUE  
KNOXVILLE 6-24-77 81 C 101-19E226-2 RO

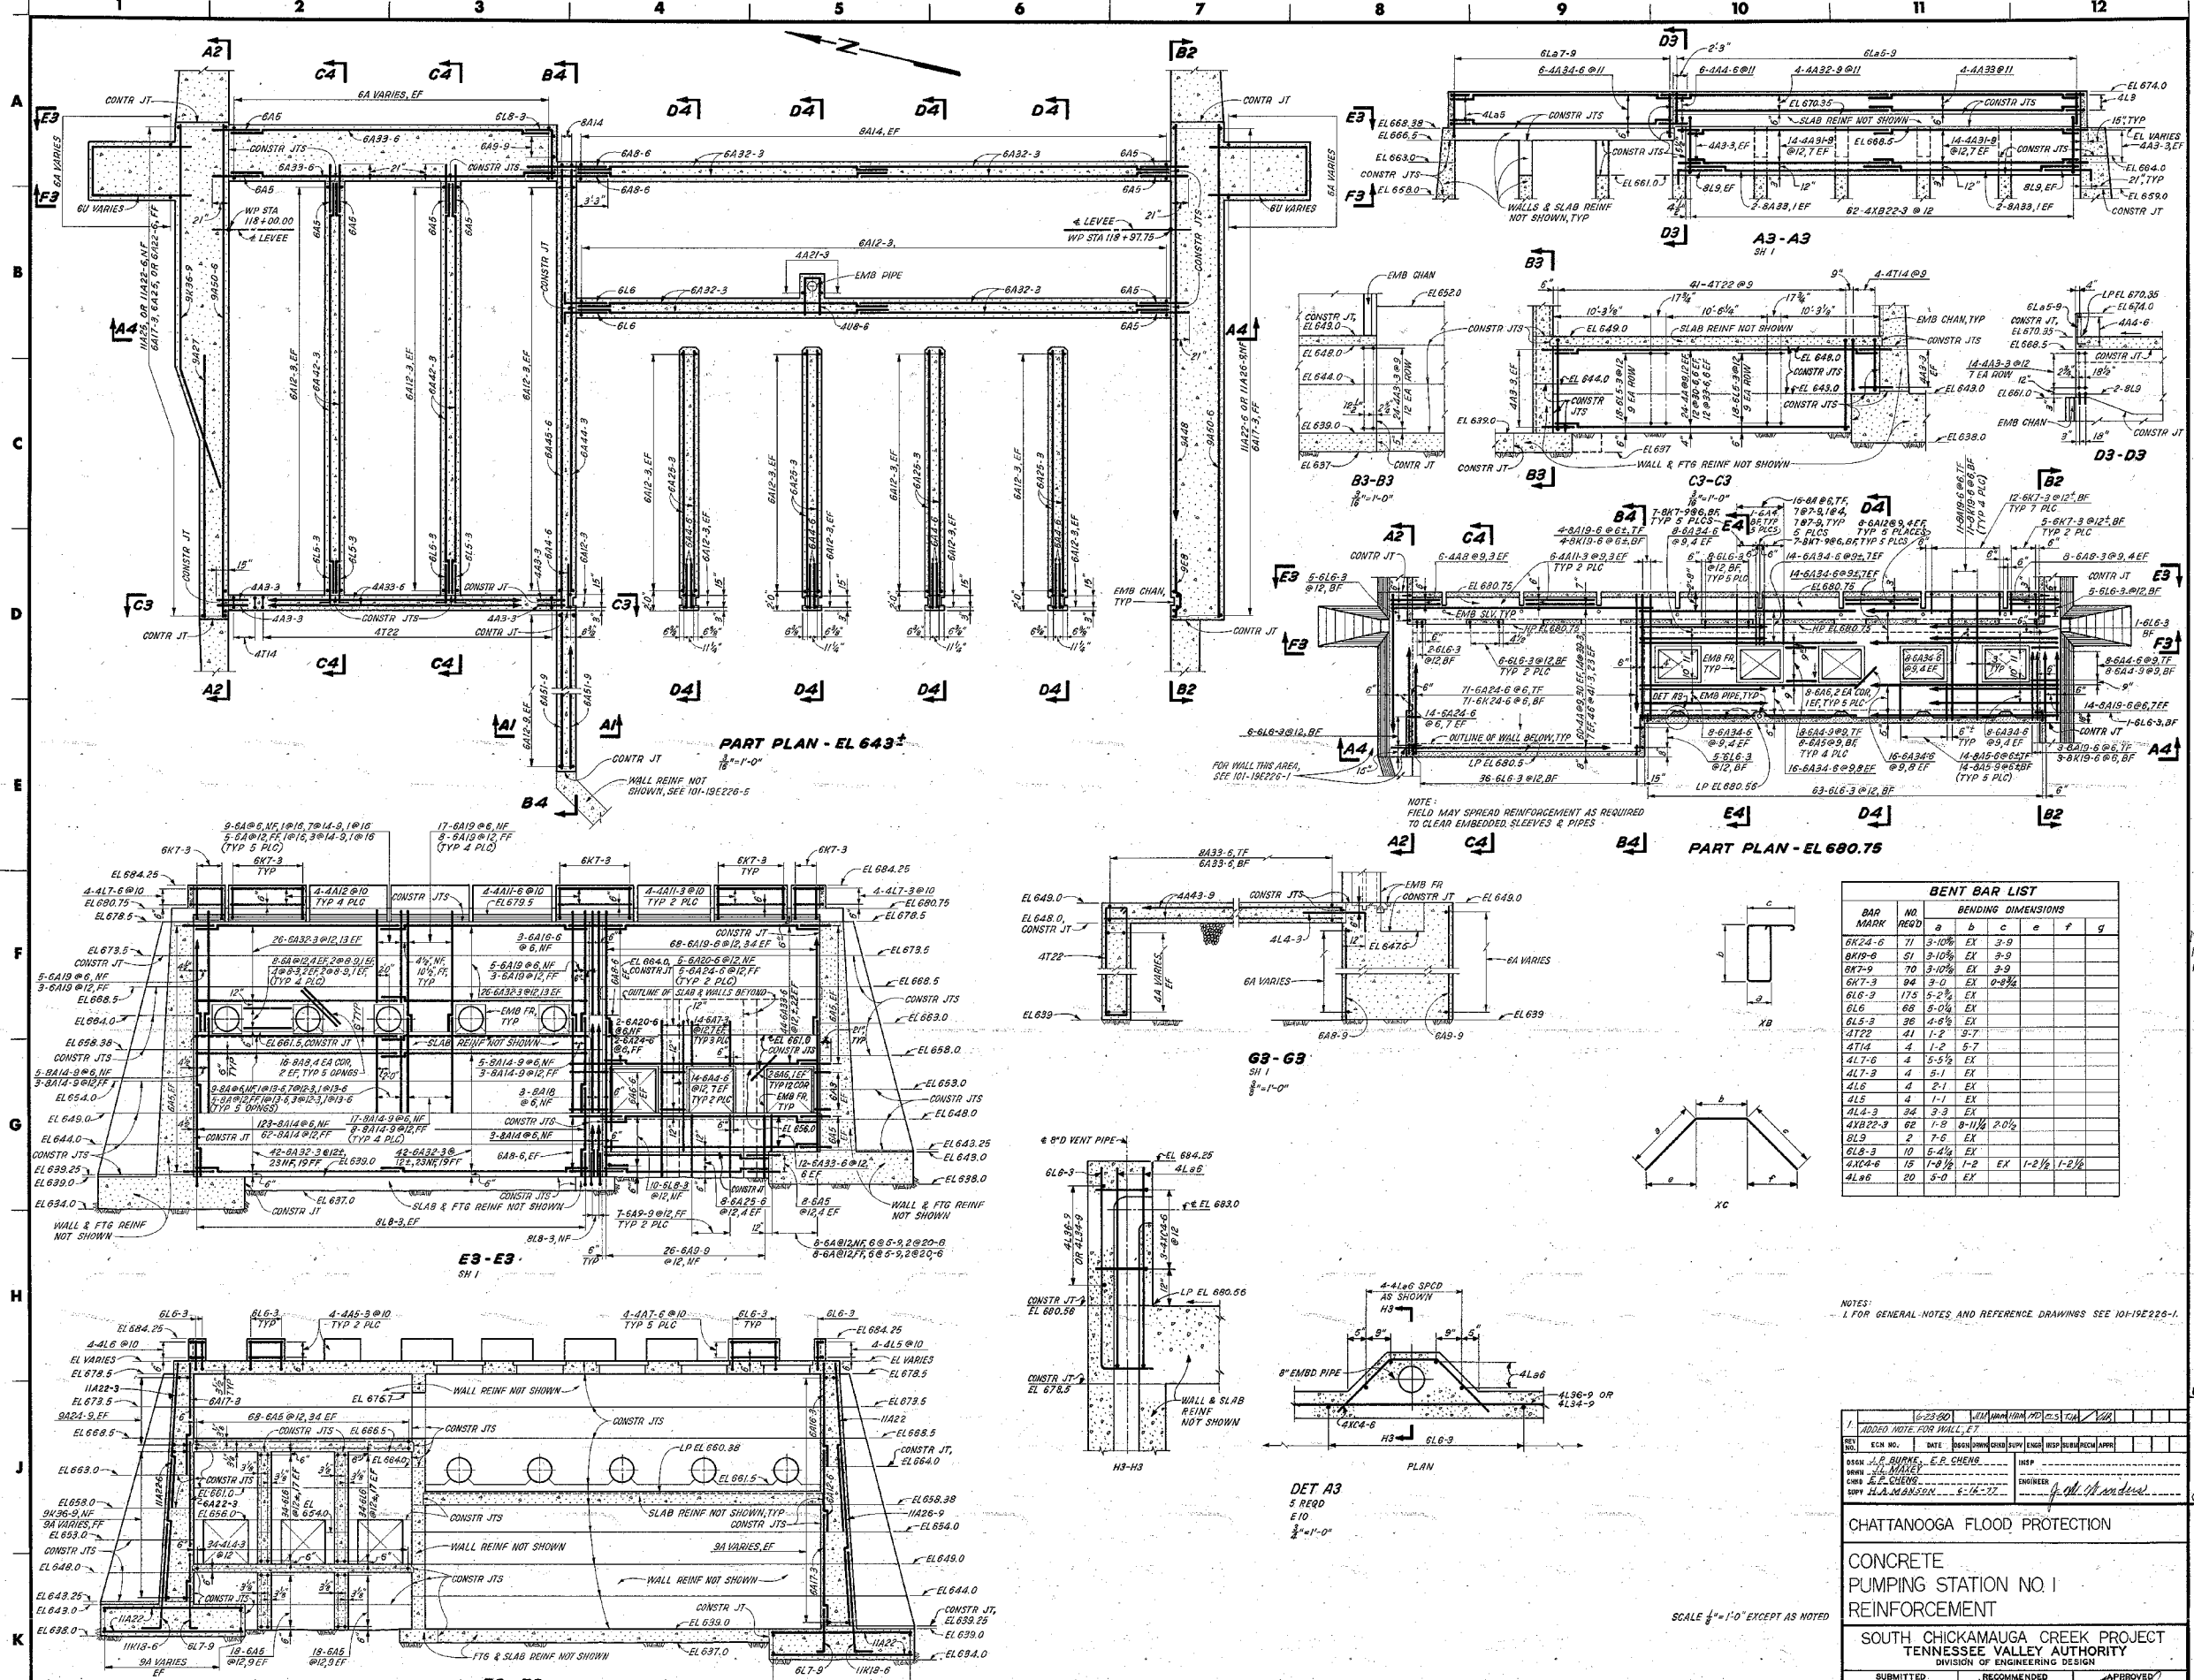

PART PLAN - EL 643

PART PLAN - EL 680.75

E3-E3

F3-F3

G3-G3

DET A3

BENT BAR LIST						
BAR MARK	NO REQD	BENDING DIMENSIONS				
		a	b	c	e	f
6K7-3	71	3-10 1/2	EX	3-9		
6K10-6	51	3-10 1/2	EX	3-9		
6K7-9	70	3-10 1/2	EX	3-9		
6K7-3	94	3-0	EX	0-3 1/2		
6L6-3	175	5-2 1/2	EX			
6L6	68	5-0 1/2	EX			
6L5-3	36	4-8 1/2	EX			
4T22	41	1-2	EX	5-7		
4T14	4	1-2	EX	5-7		
4L7-6	4	5-5 1/2	EX			
4L7-3	4	5-1	EX			
4L6	4	2-1	EX			
4L5	4	1-1	EX			
4L4-3	34	3-3	EX			
4X22-3	92	1-5	EX	2-0 1/2		
6L9	2	7-6	EX			
6L8-3	10	5-4 1/2	EX			
4A2-6	15	1-8 1/2	EX	1-2 1/2	1-2 1/2	
4L6	20	5-0	EX			

NOTES:  
1. FOR GENERAL NOTES AND REFERENCE DRAWINGS SEE 101-19226-1.



CHATTANOOGA FLOOD PROTECTION  
CONCRETE PUMPING STATION NO. 1 REINFORCEMENT  
SOUTH CHICKAMAUGA CREEK PROJECT  
TENNESSEE VALLEY AUTHORITY  
DIVISION OF ENGINEERING DESIGN

INSPECTED AND APPROVED FOR ISSUE: *[Signature]*  
SUBMITTED: *[Signature]* RECOMMENDED: *[Signature]* APPROVED: *[Signature]*  
KNOXVILLE 6-24-77 81 c 101-19226-3RI


SCALE 1/4"=1'-0" EXCEPT AS NOTED

INSPECTED AND APPROVED FOR ISSUE

PRINT H  
SIZE F  
OR OR PROJ ME EE DE AD CD ED MD RP SW BK PA  
PRINTS: RMD-8

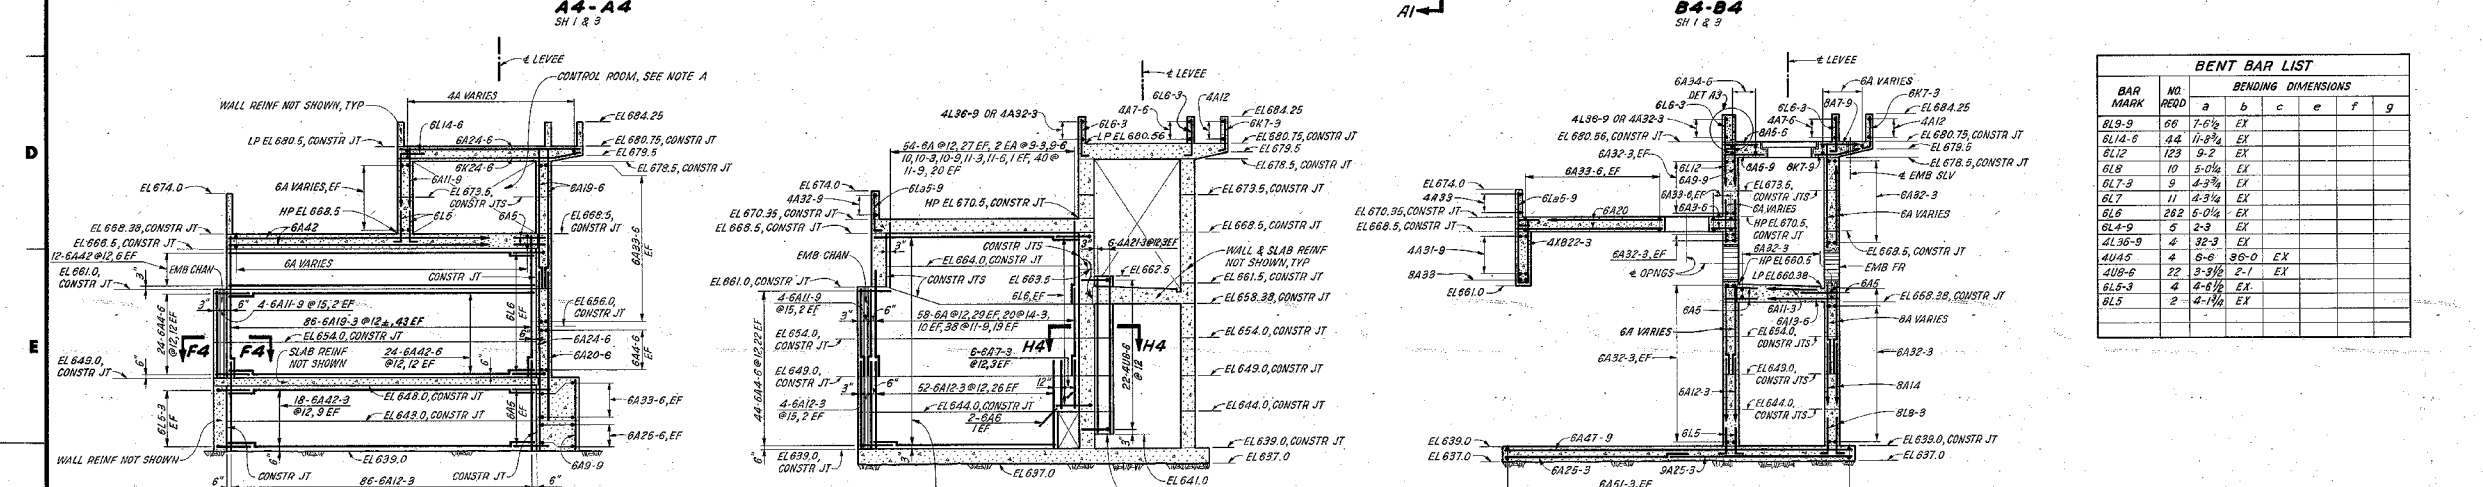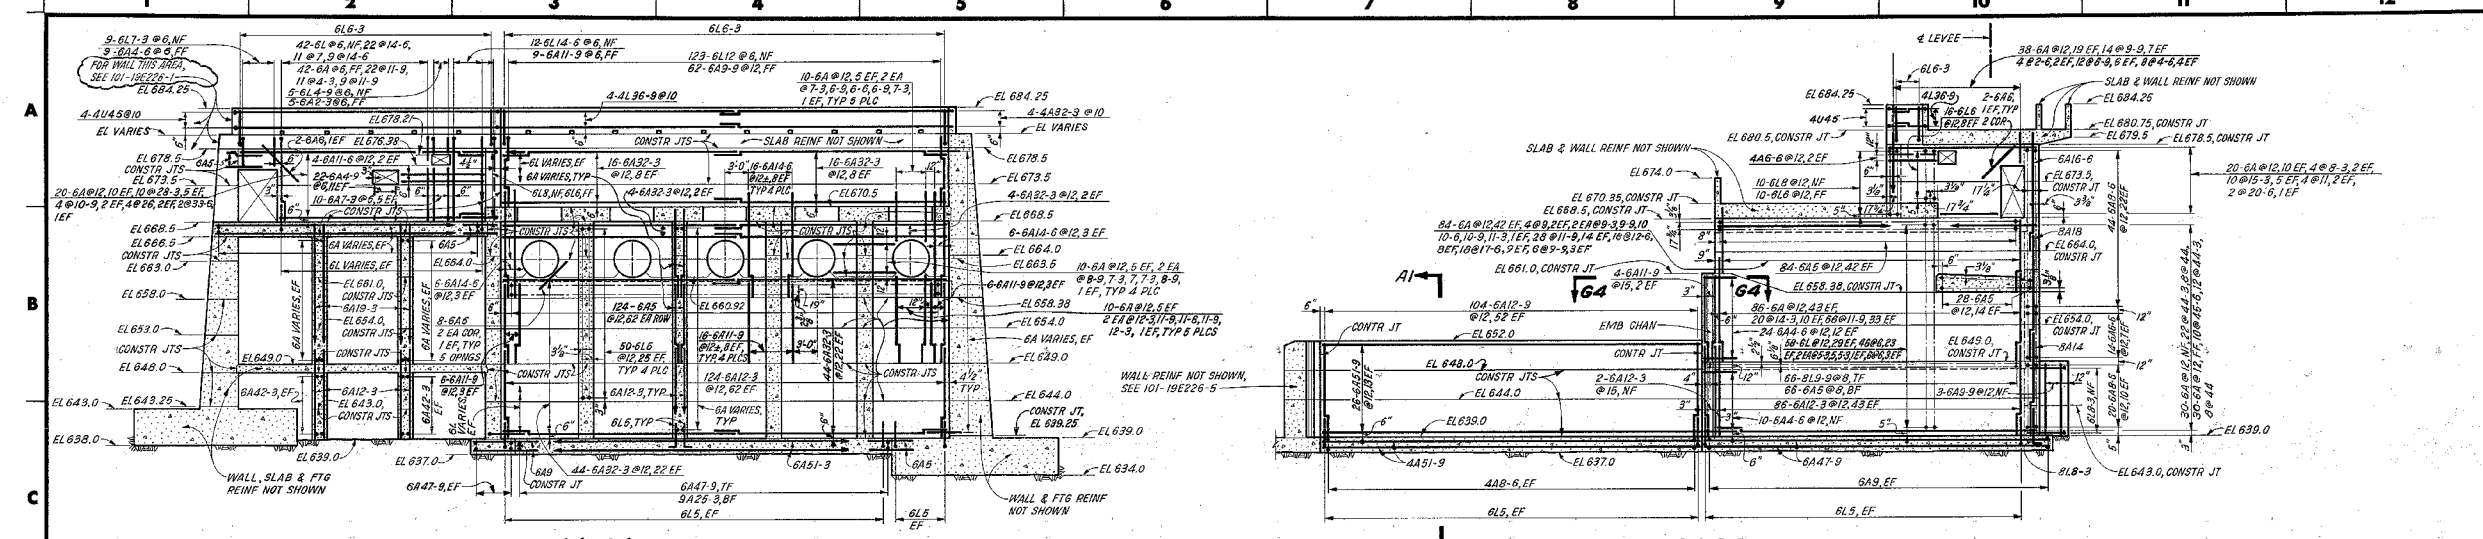

BAR MARK		BENDING DIMENSIONS						
NO	REDD	a	b	c	e	f	g	
BL9-9	06	7'-6 1/2	EX					
BL14-6	14	11'-8 1/4	EX					
BL12	123	9'-2	EX					
BL9	10	5'-0 1/4	EX					
BL7-9	9	4'-3 3/4	EX					
BL7	11	4'-3 1/4	EX					
BL6	282	5'-0 1/4	EX					
BL4-9	5	2'-3	EX					
BL36-9	4	32'-3	EX					
BL40-5	4	6'-6	30'-0	EX				
BL8-6	22	3'-3 1/2	2'-1	EX				
BL5-3	4	4'-8 1/2	EX					
BL5	2	4'-1 1/4	EX					

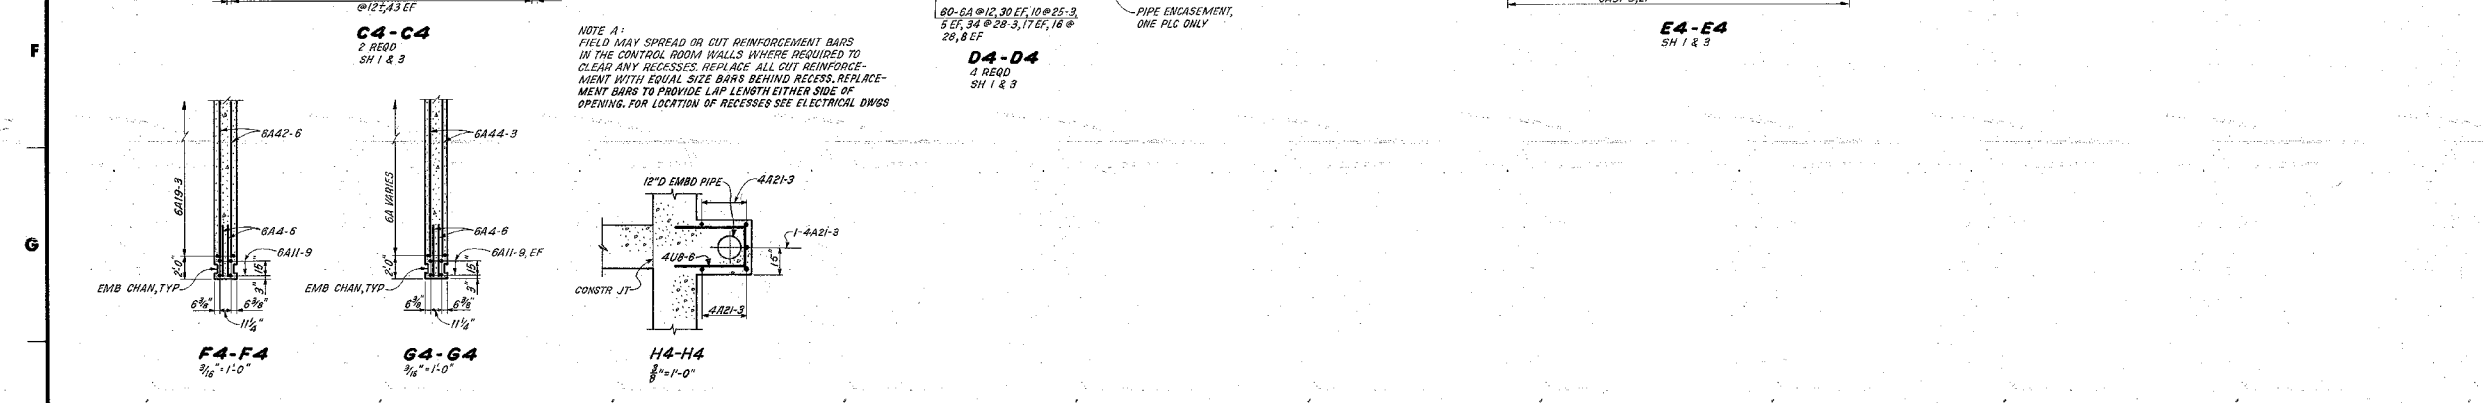

NOTE A:  
FIELD MAY SPREAD OR CUT REINFORCEMENT BARS IN THE CONTROL ROOM WALLS WHERE REQUIRED TO CLEAR ANY RECESSES; REPLACE ALL CUT REINFORCEMENT WITH EQUAL SIZE BARS BEHIND RECESSES. REPLACEMENT BARS TO PROVIDE LAP LENGTH EITHER SIDE OF OPENING. FOR LOCATION OF RECESSES SEE ELECTRICAL DWGS

NOTES:  
1. FOR GENERAL NOTES AND REFERENCE DRAWINGS SEE 101-19E226-1.

2	6-25-80	REVISED	ADD	ADD	ADD	ADD	ADD	ADD	ADD
1	9-1-78	REVISED	ADD	ADD	ADD	ADD	ADD	ADD	ADD
REV	NO.	DATE	BY	CHKD	APPD	APPD	APPD	APPD	APPD
DESIGN	J.P. BROWN	J.P. BROWN							
CHKD	J.P. BROWN	J.P. BROWN							
SUPV	H.A. MANABON	5-16-77							





CHATTANOOGA FLOOD PROTECTION  
CONCRETE PUMPING STATION NO. 1  
REINFORCEMENT  
SOUTH CHICKAMAUGA CREEK PROJECT  
TENNESSEE VALLEY AUTHORITY  
DIVISION OF ENGINEERING DESIGN

INSPECTED AND APPROVED FOR ISSUE  
KNOXVILLE 6-24-77  
RECORD NUMBER AS CONSTRUCTED  
101-19E226-4 R2

PRINT	NO.	DATE	BY	CHKD	APPD
1	1	6-24-77	J.P. BROWN	J.P. BROWN	J.P. BROWN
SIZE	AS SHOWN				





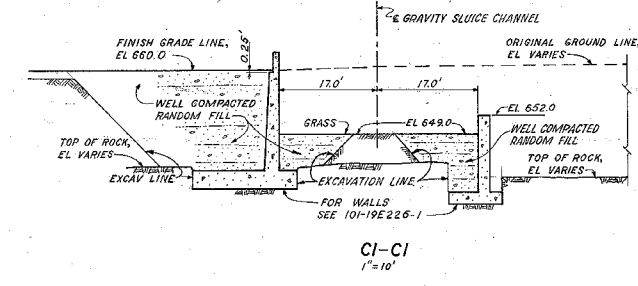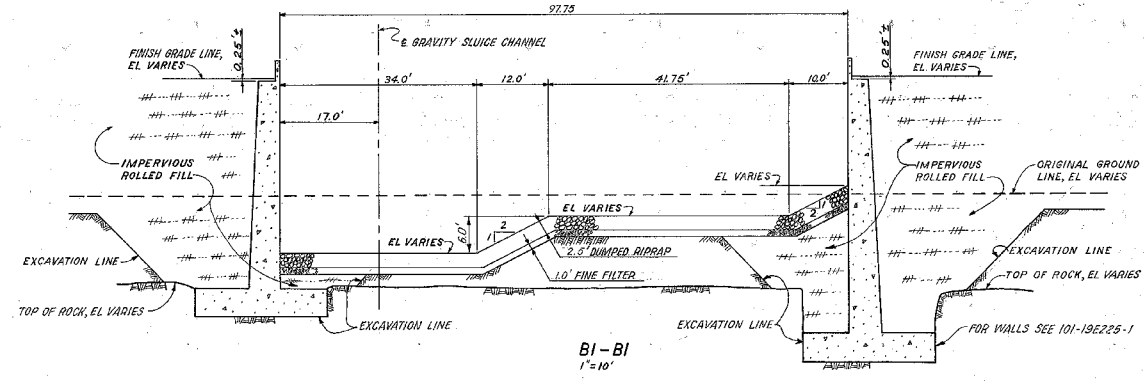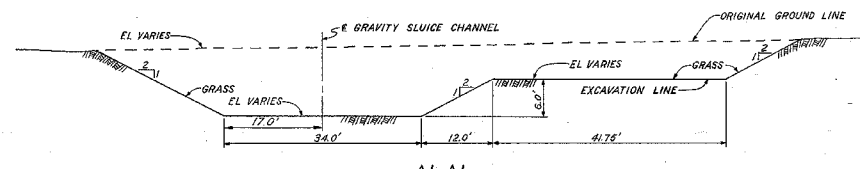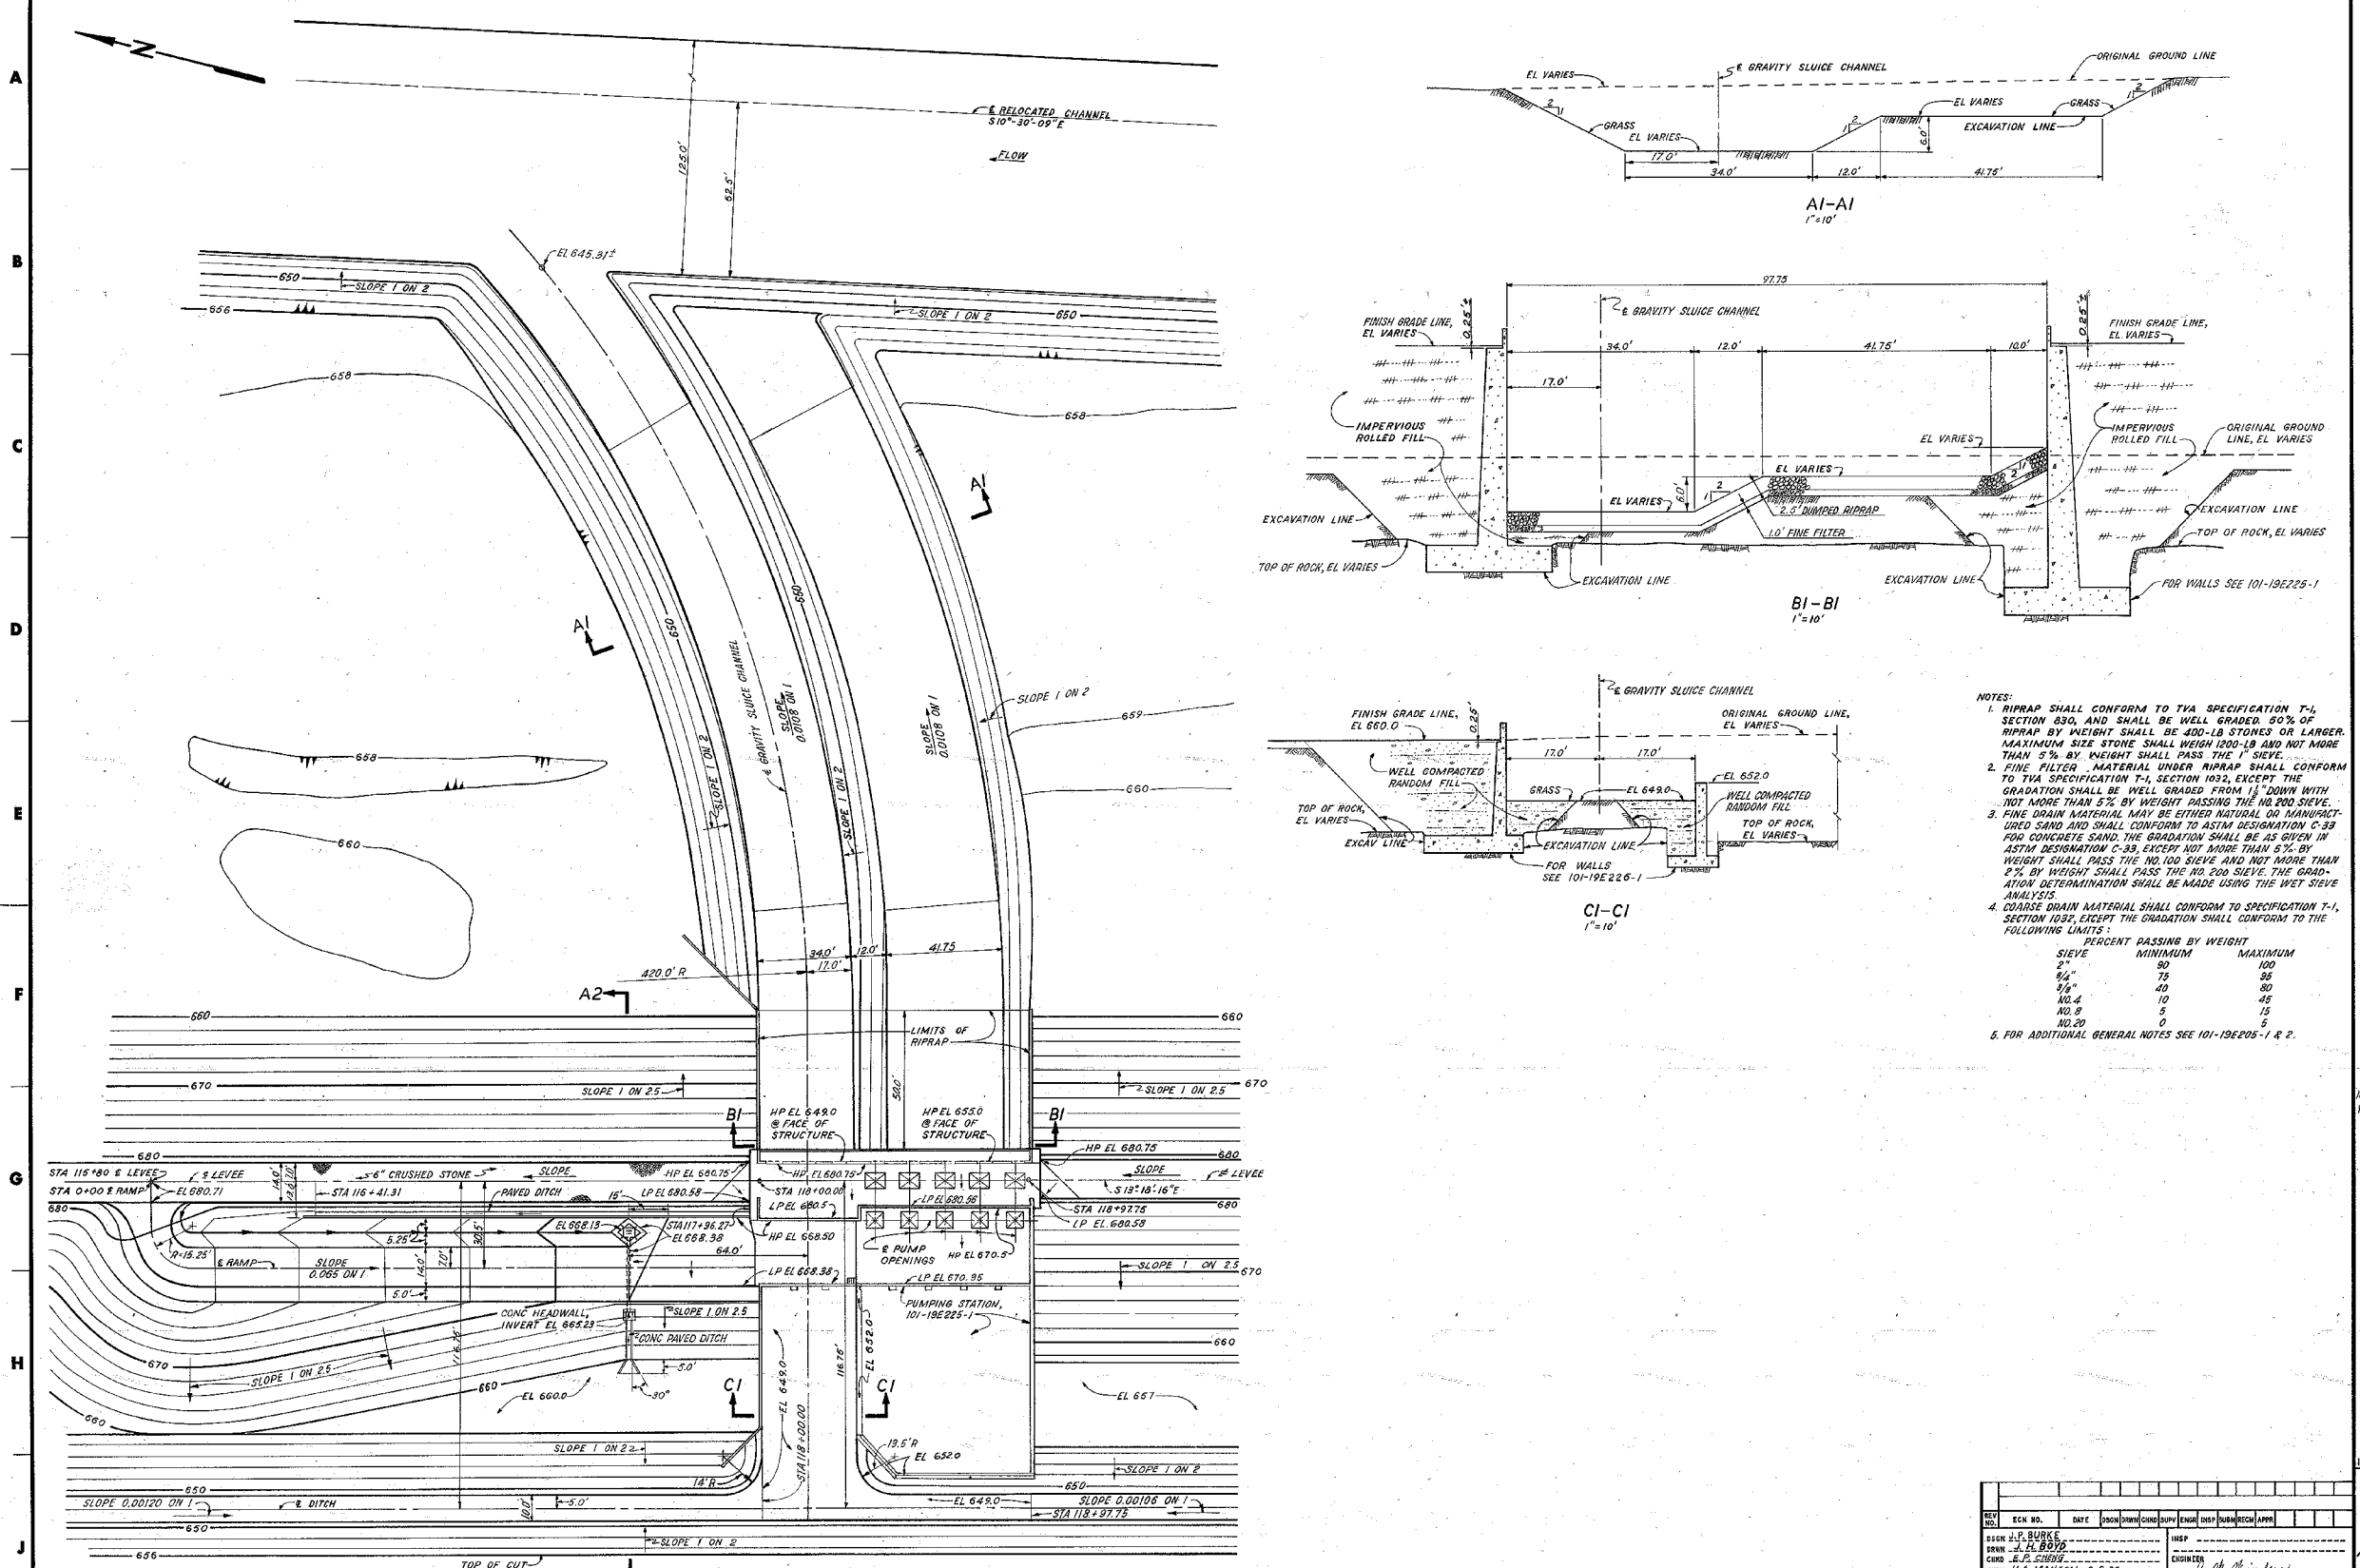

- NOTES:
1. RIPRAP SHALL CONFORM TO TYPICAL SPECIFICATION T-1, SECTION 830, AND SHALL BE WELL GRADED. 90% OF RIPRAP BY WEIGHT SHALL BE 400-LB STONES OR LARGER. MAXIMUM SIZE STONE SHALL WEIGH 1200-LB AND NOT MORE THAN 5% BY WEIGHT SHALL PASS THE 1" SIEVE.
  2. FINE FILTER MATERIAL UNDER RIPRAP SHALL CONFORM TO TYPICAL SPECIFICATION T-1, SECTION 1032, EXCEPT THE GRADATION SHALL BE WELL GRADED FROM 1/8" DOWN WITH NOT MORE THAN 5% BY WEIGHT PASSING THE NO. 200 SIEVE.
  3. FINE DRAIN MATERIAL MAY BE EITHER NATURAL OR MANUFACTURED SAND AND SHALL CONFORM TO ASTM DESIGNATION C-39 FOR CONCRETE SAND. THE GRADATION SHALL BE AS GIVEN IN ASTM DESIGNATION C-39, EXCEPT NOT MORE THAN 5% BY WEIGHT SHALL PASS THE NO. 100 SIEVE AND NOT MORE THAN 2% BY WEIGHT SHALL PASS THE NO. 200 SIEVE. THE GRADATION DETERMINATION SHALL BE MADE USING THE WET SIEVE ANALYSIS.
  4. COARSE DRAIN MATERIAL SHALL CONFORM TO SPECIFICATION T-1, SECTION 1032, EXCEPT THE GRADATION SHALL CONFORM TO THE FOLLOWING LIMITS:
- | SIEVE  | PERCENT PASSING BY WEIGHT |         |
|--------|---------------------------|---------|
|        | MINIMUM                   | MAXIMUM |
| 2"     | 90                        | 100     |
| 3/4"   | 75                        | 95      |
| 3/8"   | 40                        | 80      |
| NO. 4  | 10                        | 45      |
| NO. 9  | 5                         | 15      |
| NO. 20 | 0                         | 5       |
5. FOR ADDITIONAL GENERAL NOTES SEE 101-19E205-1 & 2.


PLAN

SCALE 1"=20' EXCEPT AS NOTED  
 COMPANION DRAWINGS:  
 101-19E230-1 & 2  
 REFERENCE DRAWINGS:  
 101-19E230-1 BILL OF MATERIAL










REV. NO.	ECH. NO.	DATE	ISSUED	BY	CHKD.	APP. BY	APP. DATE
DRAWN BY: J.P. BURKE				INSP. BY:			
CHECKED BY: E.P. CROSBY				ENGR. BY: J. W. BURKE			
CHATTANOOGA FLOOD PROTECTION PUMPING STATION NO. 1 FINAL GRADING AND DRAINAGE STRUCTURES PLAN & SECTIONS SOUTH CHICKAMAUGA CREEK PROJECT TENNESSEE VALLEY AUTHORITY DIVISION OF ENGINEERING DESIGN							
SUBMITTED		RECOMMENDED		APPROVED			
E.P. Crosby		J. W. Burke		J. W. Burke			
INSPECTED AND APPROVED FOR ISSUE				KNOXVILLE 3-31-78			
PROJECT NO. 101-19E230-1				SHEET NO. 1			
DATE 3-31-78				BY J.P. BURKE			

PRINT	11	10	9	8	7	6	5	4	3	2	1
SIZE	11	10	9	8	7	6	5	4	3	2	1
ON OR PROJ. NO.	EL. 23	05	ED	NO	BY	EL. PA.					
PRINTS	RECD-R										



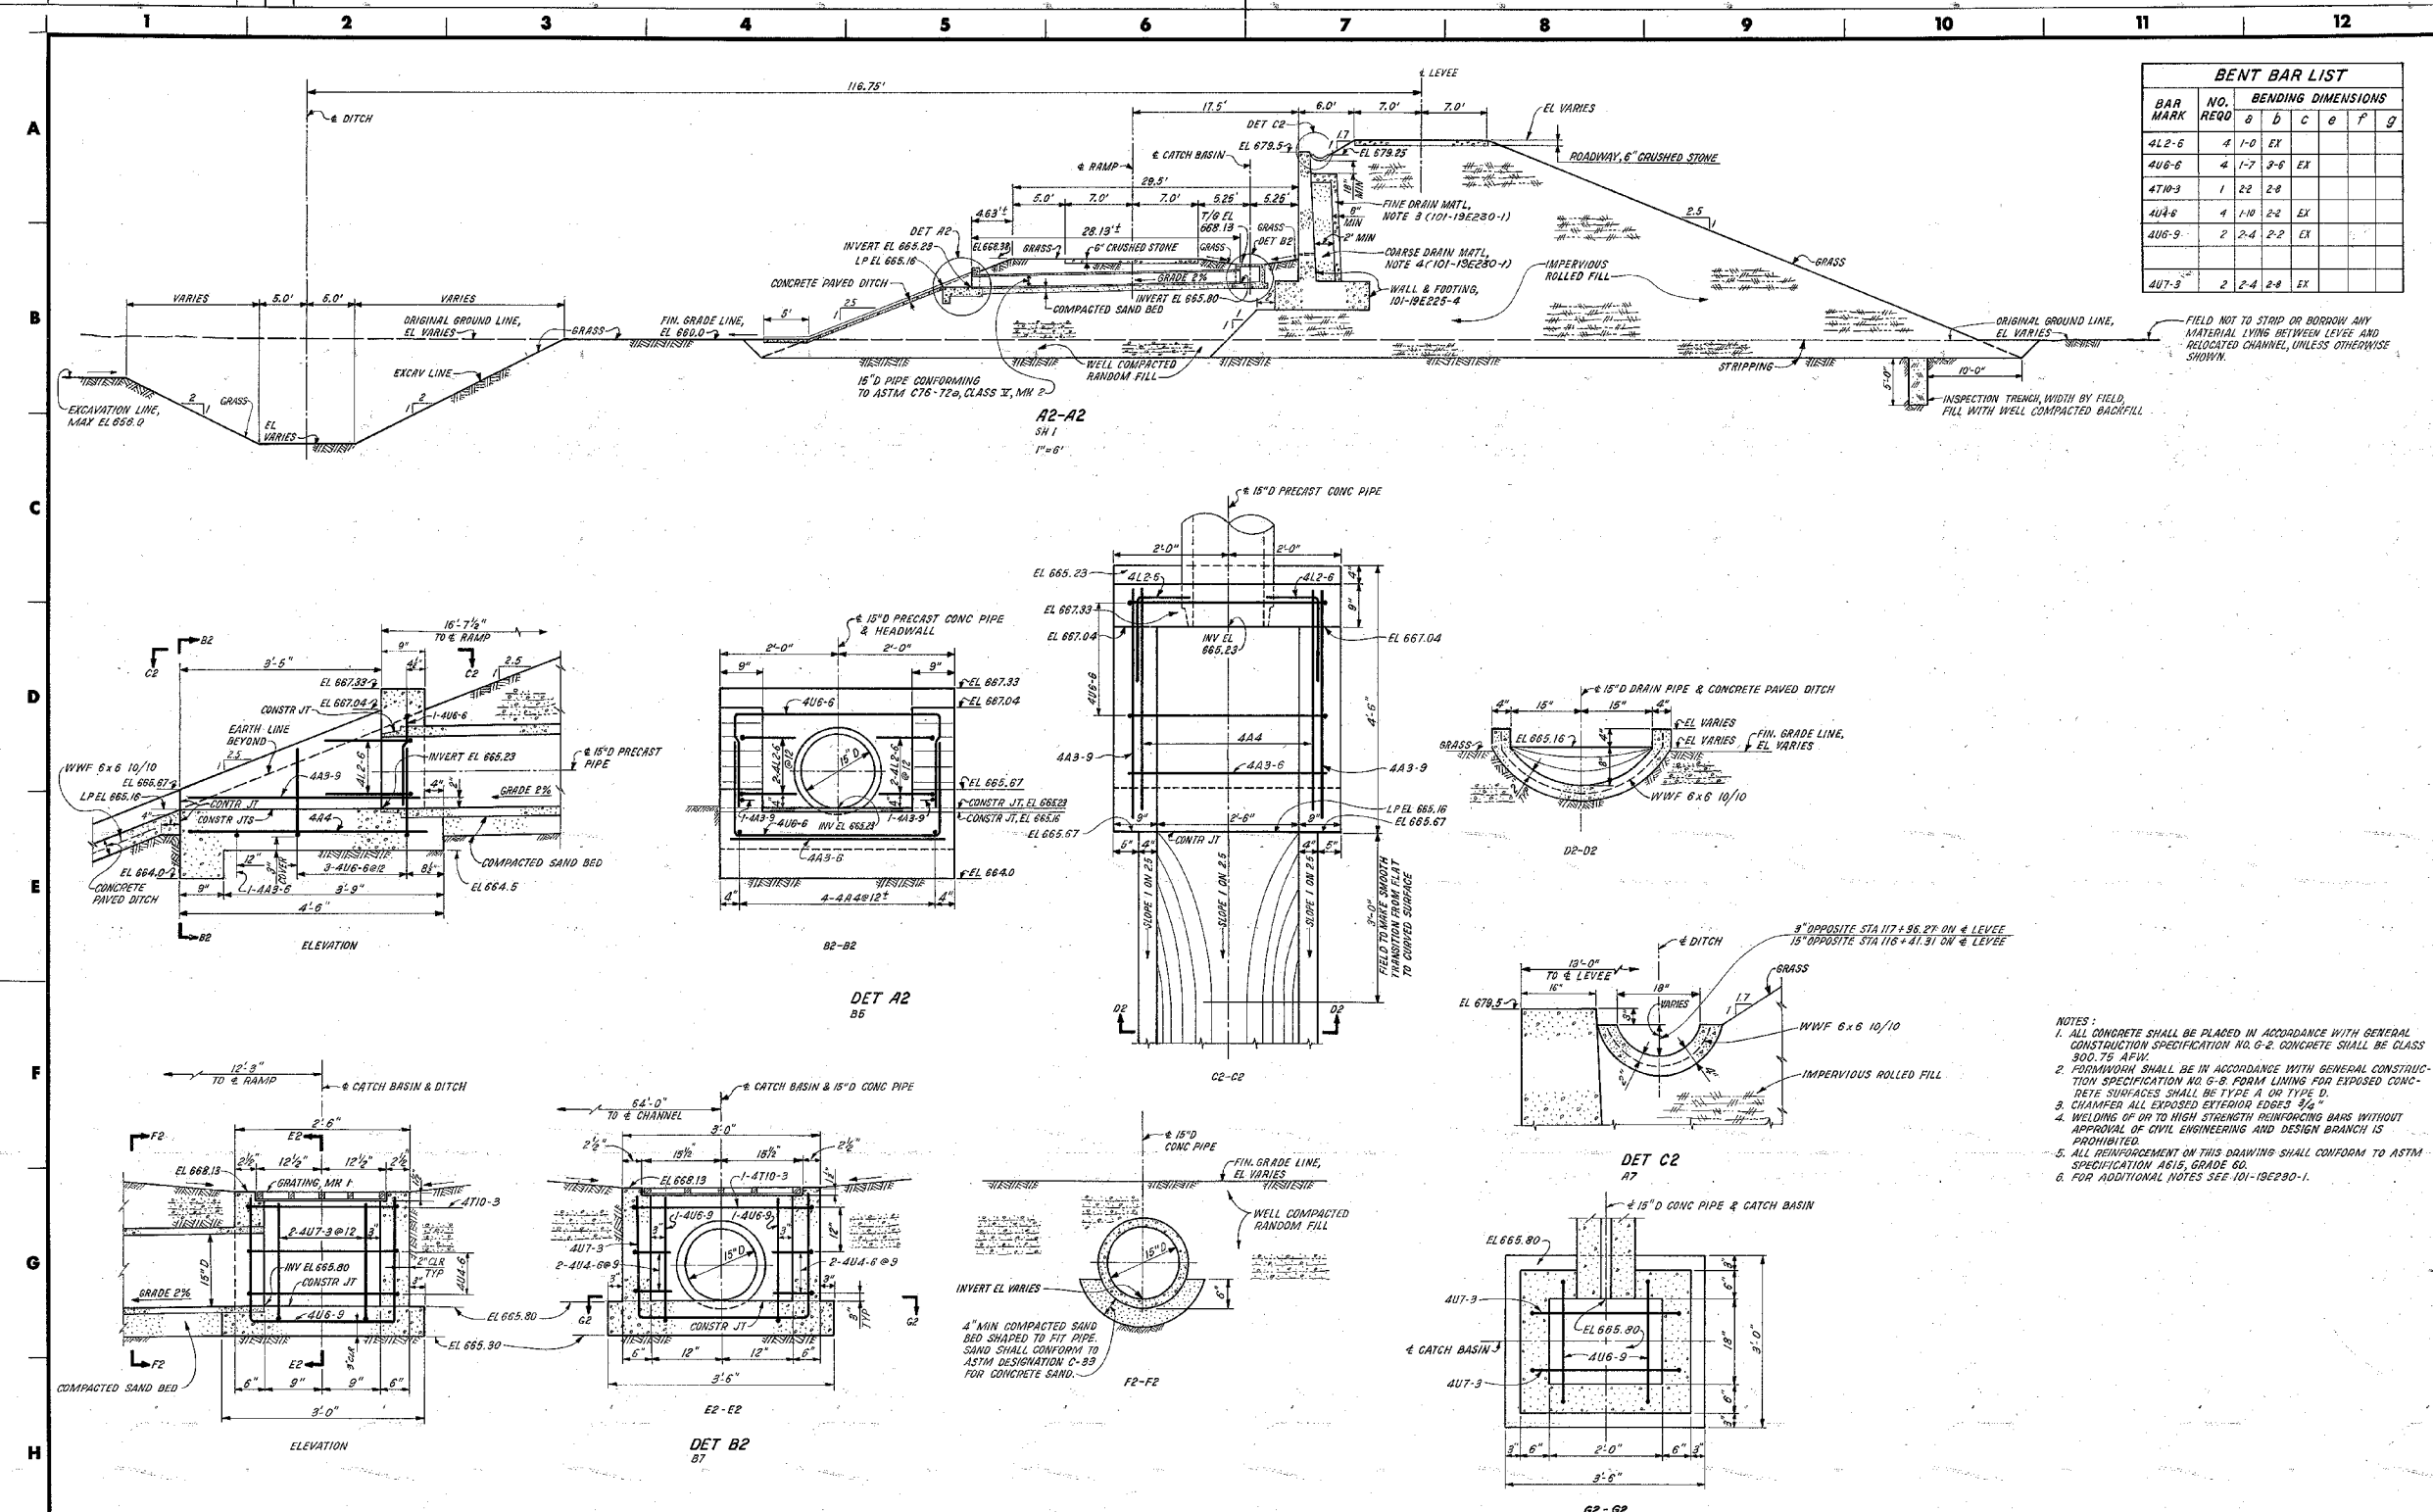

BENT BAR LIST						
BAR MARK	NO.	BENDING DIMENSIONS				
		a	b	c	e	f
4L2-6	4	1-0	EX			
4U6-6	4	1-7	EX			
4T10-3	1	2-2	EX			
4A4-6	4	1-10	EX			
4U6-9	2	2-4	EX			
4U7-3	2	2-4	EX			

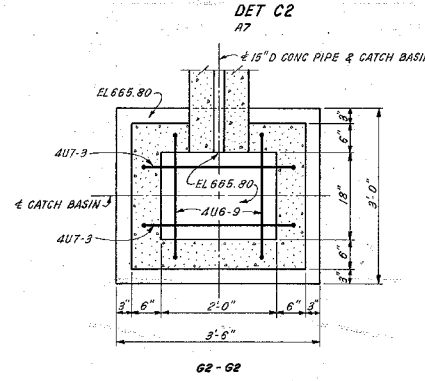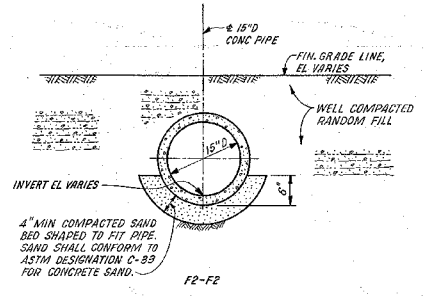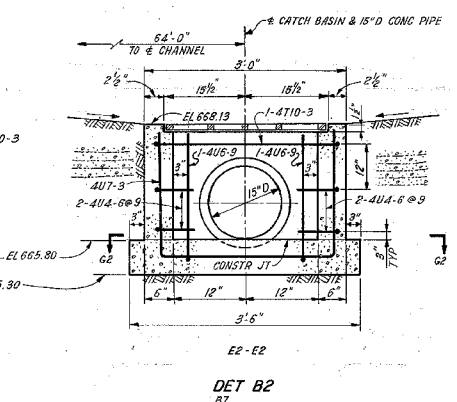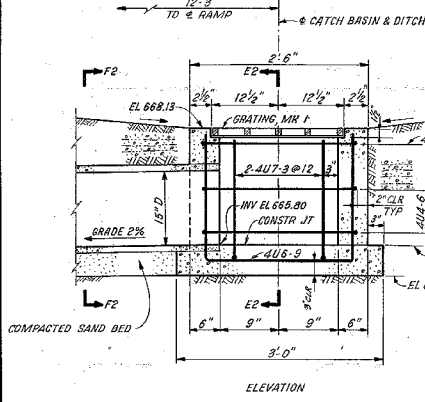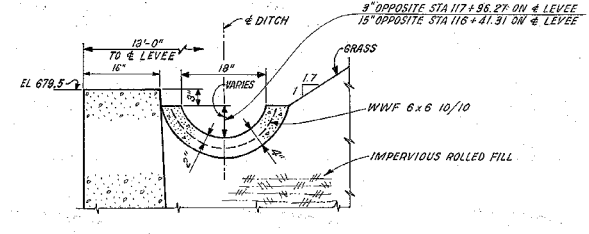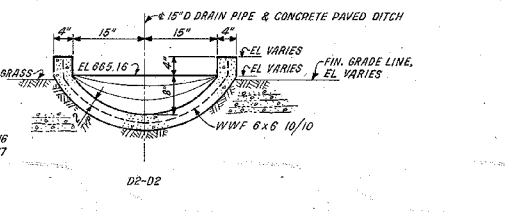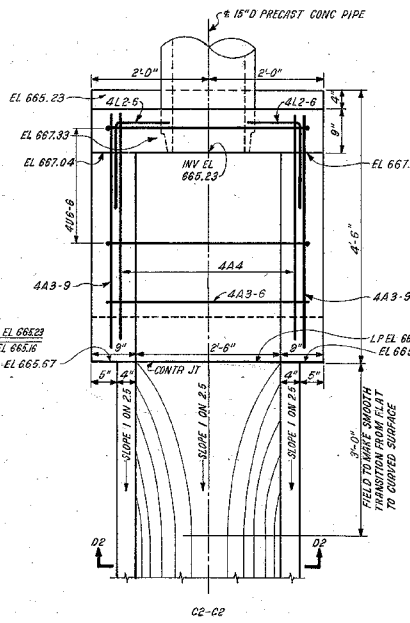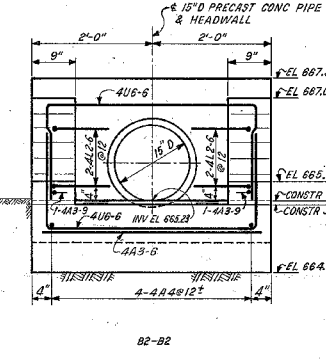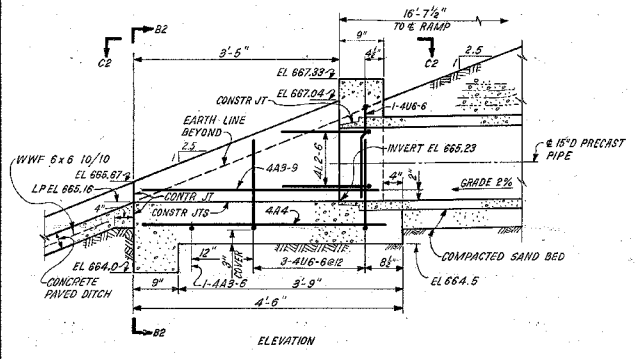


- NOTES:
1. ALL CONCRETE SHALL BE PLACED IN ACCORDANCE WITH GENERAL CONSTRUCTION SPECIFICATION NO. G-2. CONCRETE SHALL BE CLASS 300.75 AFW.
  2. FORMWORK SHALL BE IN ACCORDANCE WITH GENERAL CONSTRUCTION SPECIFICATION NO. G-8. FORM LINING FOR EXPOSED CONCRETE SURFACES SHALL BE TYPE A OR TYPE D.
  3. CHAMFER ALL EXPOSED EXTERIOR EDGES 3/4".
  4. WELDING OF OR TO HIGH STRENGTH REINFORCING BARS WITHOUT APPROVAL OF CIVIL ENGINEERING AND DESIGN BRANCH IS PROHIBITED.
  5. ALL REINFORCEMENT ON THIS DRAWING SHALL CONFORM TO ASTM SPECIFICATION A615, GRADE 60.
  6. FOR ADDITIONAL NOTES SEE 101-19E230-1.

1-3-03		DATE	DESIGNED	DRAWN	CHECKED	INSP.	APPROVED
FINAL FIELD REV							
REV	NO.	DATE	BY	CHKD	APPD	REASON	
1	1	3-31-78	J.P. BURKE				
2	2		M.P. YANCEY				
3	3		C.H. GIBSON				
4	4		C.A. GIBSON				
CHATTANOOGA FLOOD PROTECTION PUMPING STATION NO. 1			FINAL GRADING AND DRAINAGE STRUCTURES PLAN & SECTIONS				
SOUTH CHICKAMAUGA CREEK PROJECT TENNESSEE VALLEY AUTHORITY DIVISION OF ENGINEERING DESIGN			SUBMITTED: E.J. GIBSON RECOMMENDED: J.P. BURKE APPROVED: J.P. BURKE				
INSPECTED AND APPROVED FOR ISSUE			KNOXVILLE 3-31-78 B1 C 101-19E230-2 R1				

SCALE 1"=1'-0" EXCEPT AS NOTED

PRINT	H	D	P						
SIZE	F	8 1/2	11						
BY OR FOR	BY	DATE	BY	DATE	BY	DATE	BY	DATE	BY





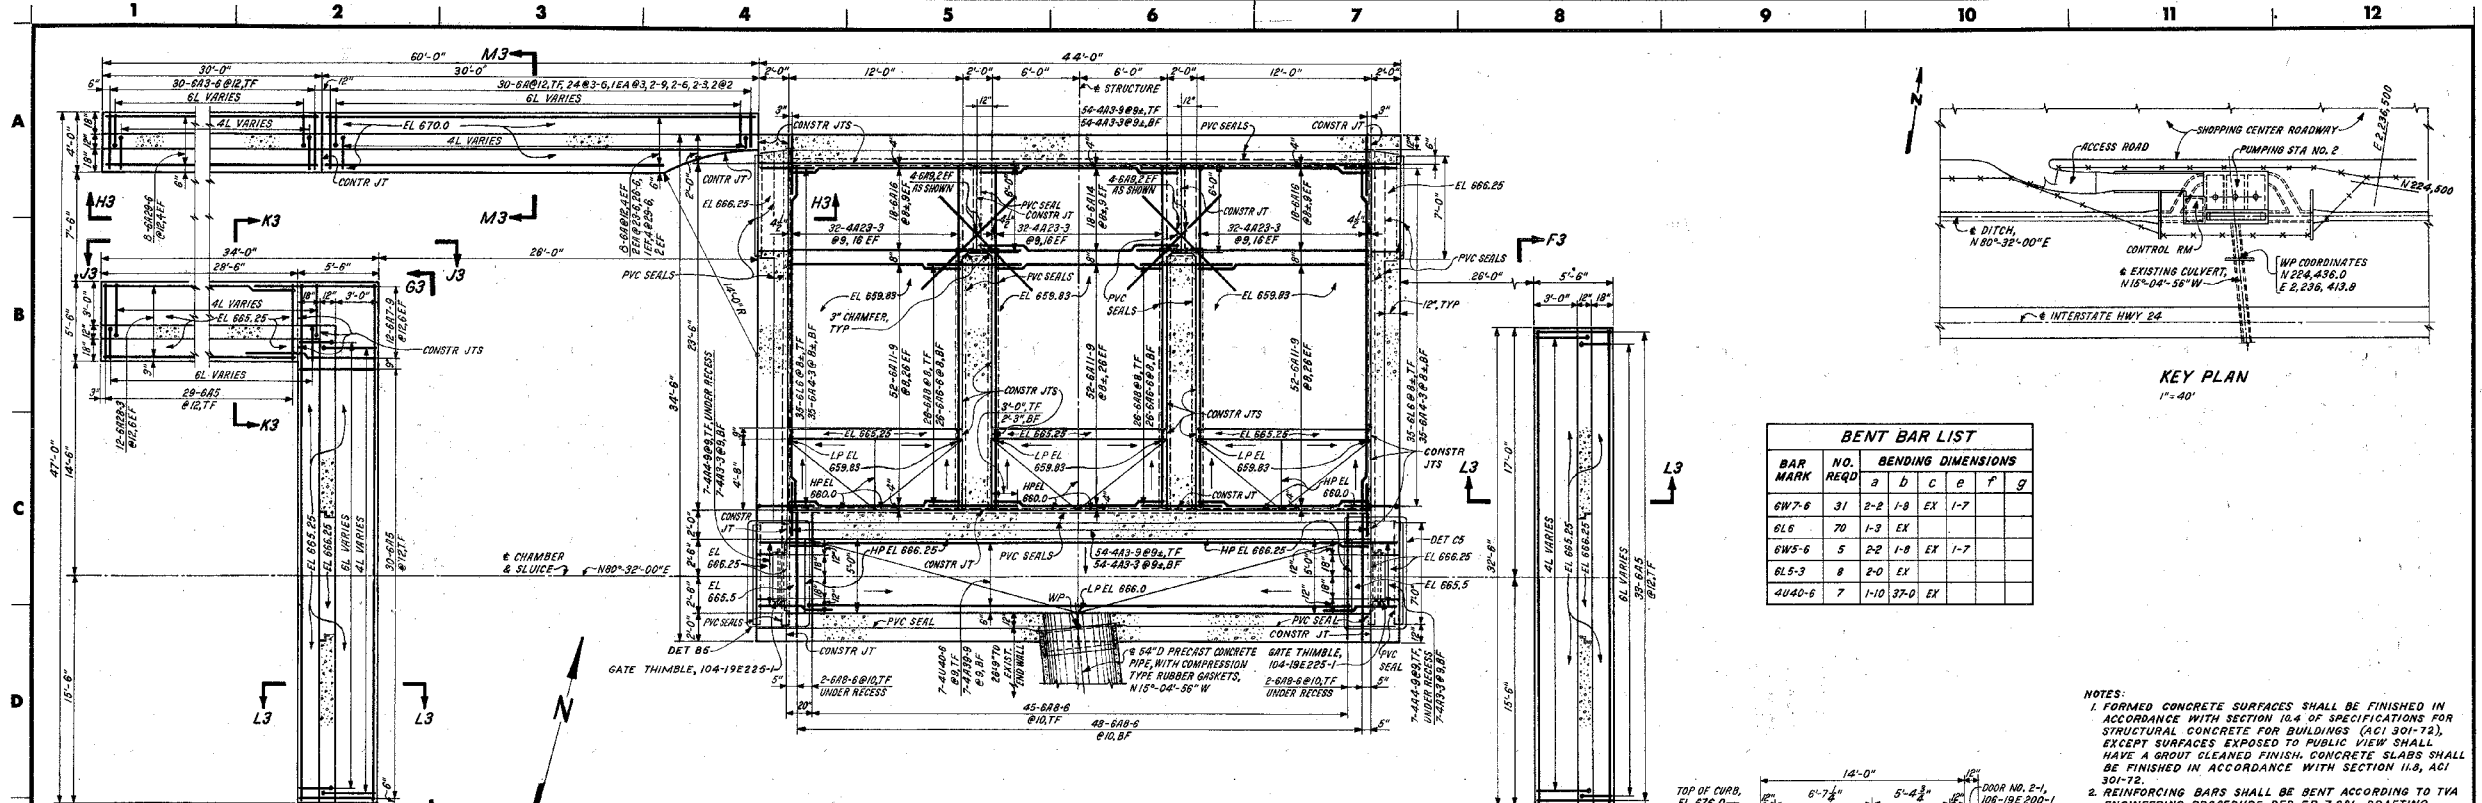

**BENT BAR LIST**

BAR MARK	NO. REQD	a	b	c	e	f	g
6W7-6	31	2-8	1-8	EX	1-7		
6L6	70	1-3	EX				
6W5-6	5	2-2	1-8	EX	1-7		
6L5-3	8	2-0	EX				
4U40-6	7	1-10	37-0	EX			

- NOTES:**
- FORMED CONCRETE SURFACES SHALL BE FINISHED IN ACCORDANCE WITH SECTION 16.4 OF SPECIFICATIONS FOR STRUCTURAL CONCRETE FOR BUILDINGS (ACI 301-72), EXCEPT SURFACES EXPOSED TO PUBLIC VIEW SHALL HAVE A GROUT CLEANED FINISH. CONCRETE SLABS SHALL BE FINISHED IN ACCORDANCE WITH SECTION 11.6, ACI 301-72.
  - REINFORCING BARS SHALL BE BENT ACCORDING TO TVA ENGINEERING PROCEDURE DEP-EP 7.001, DRAFTING STANDARDS-CIVIL-CONCRETE REINFORCING-BAR DETAILING-SECTION 12, ATTACHMENT 1.
  - CRUSHED STONE USED AS FILL MATERIAL UNDER CONCRETE SLABS SHALL CONFORM TO TVA HIGHWAY SPECIFICATION NO. 7-1, SECTION 1032.
  - FINAL GRADING BY TVA IN ACCORDANCE WITH DRAWING NO. 91-C-101-19E245-1 & 2.
  - ALL CONTRACTOR JOINTS SHALL BE TREATED TO BREAK BOND ON THE JOINT SURFACE BY PRIME COATING WITH A HEAVY COAT OF EITHER ASPHALT EMULSION, FLAT GRAY PRIMER WITH LINSEED OIL VEHICLE OR CONCRETE CURING COMPOUND. ALL MATERIAL SHALL BE OF GOOD COMMERCIAL GRADE.
  - FOR ADDITIONAL REQUIREMENTS SEE TVA SPECIFICATION FOR THE CONSTRUCTION OF PUMPING STATIONS 1, 2 AND 3 FOR SOUTH CHICKAMAUGA CREEK PROJECT.

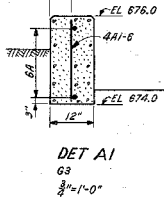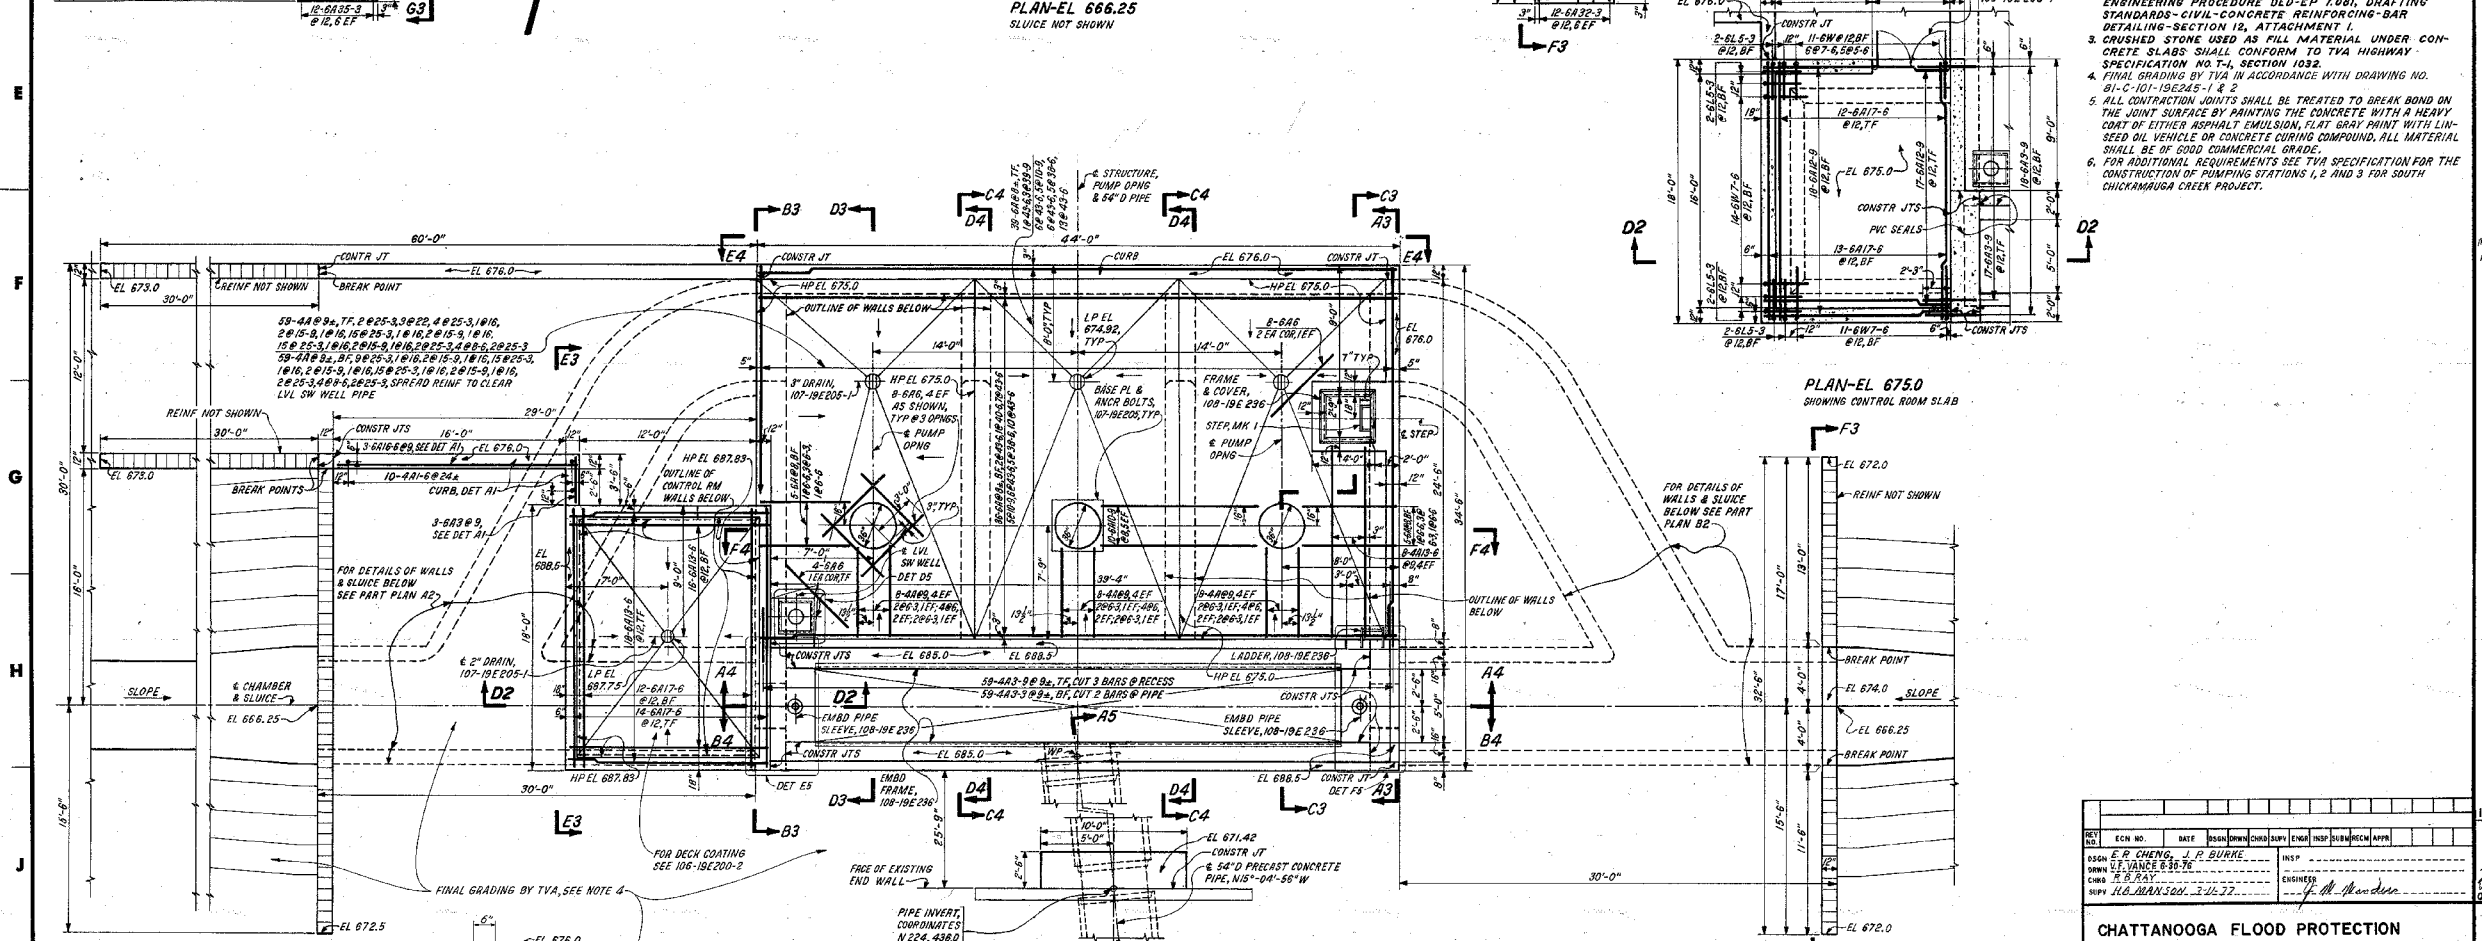

PLAN-EL 688.5

REV	NO.	DATE	BY	CHKD	APPD	REASON
1	1	11/10/22	J.P. BURKE	J.P. BURKE		ISSUED FOR PERMIT
2	2	11/10/22	J.P. BURKE	J.P. BURKE		REVISED PER COMMENTS
3	3	11/10/22	J.P. BURKE	J.P. BURKE		REVISED PER COMMENTS
4	4	11/10/22	J.P. BURKE	J.P. BURKE		REVISED PER COMMENTS



**CHATTANOOGA FLOOD PROTECTION**  
**CONCRETE PUMPING STATION NO. 2**  
**OUTLINE & REINFORCEMENT**  
 SOUTH CHICKAMAUGA CREEK PROJECT  
 TENNESSEE VALLEY AUTHORITY  
 DIVISION OF ENGINEERING DESIGN

DESIGNED BY	PROJECT MANAGER	INSPECTED AND APPROVED FOR ISSUE
DATE	DATE	DATE
NO. OF SHEETS	TOTAL SHEETS	SCALE



SCALE 1/4"=1'-0" EXCEPT AS NOTED  
 COMPANION DRAWINGS:  
 101-19E 235-1 THRU 5  
 REFERENCE DRAWINGS:  
 198M235.....BILL OF MATERIAL

NO.	DATE	BY	CHKD	APPD
1	11/10/22	J.P. BURKE	J.P. BURKE	
2	11/10/22	J.P. BURKE	J.P. BURKE	
3	11/10/22	J.P. BURKE	J.P. BURKE	
4	11/10/22	J.P. BURKE	J.P. BURKE	





A  
B  
C  
D  
E  
F  
G  
H  
J  
K

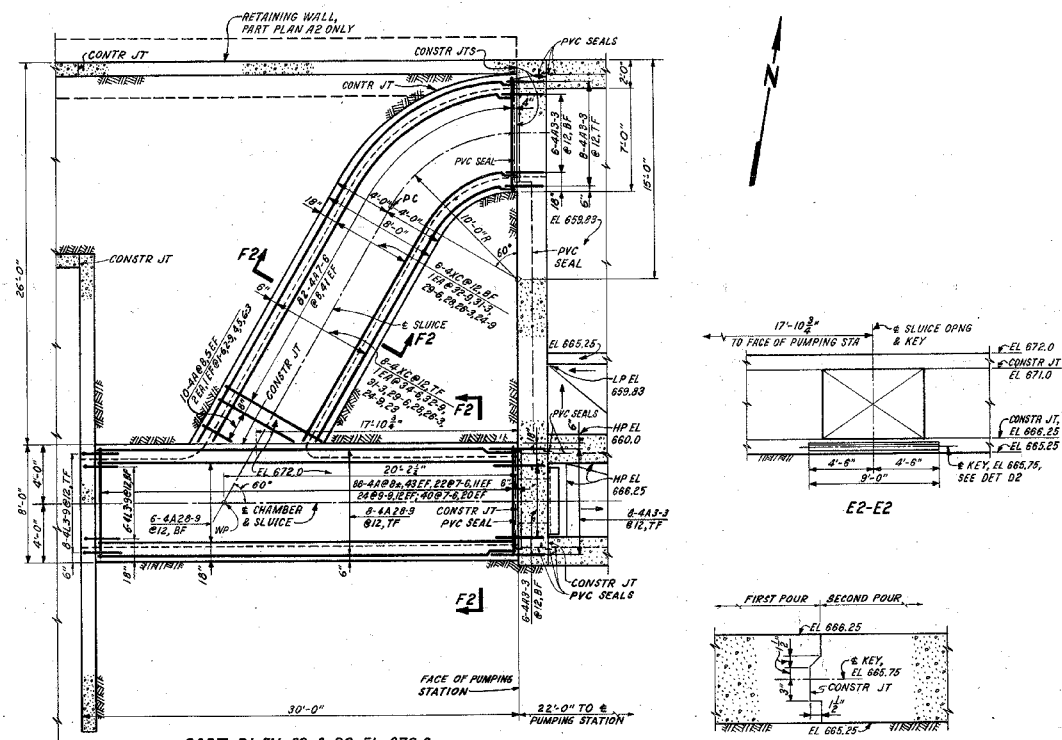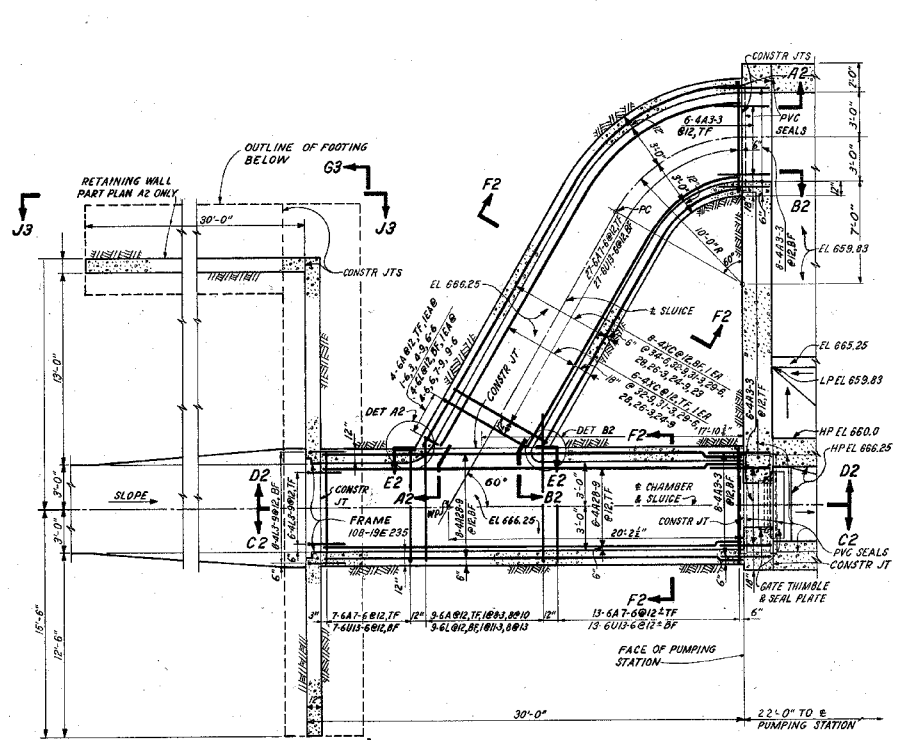

BENT BAR LIST						
BAR MARK	NO. REQD	BENDING DIMENSIONS				
		a	b	c	e	f
6L14-9	16	12-6			EX	
6L19-6	94	3-1	7-8		EX	
6L13	16	3-1			EX	
6L11-3	2	3-1			EX	
6L9-6	2	3-1			EX	
6L8-6	216	8-7			EX	
6L7-9	2	3-1			EX	
6L7-6	11	5-2			EX	
6L6	2	3-1			EX	
6K5-6	8	1-8	EX	1-2		
6L4-6	2	3-1			EX	
4XC35	10	20-9	EX			10-8
4XC36-6	4	20-9	EX			13-6
4XC34	10	20-2	EX			13-2
4XC39-9	8	19-9	EX			12-6
4XC31-3	8	19-3	EX			11-6
4XC20-6	8	18-6	EX			10-6
4XC28	8	18-0	EX			9-6
4XC29-3	8	17-3	EX			8-6
4XC24-9	8	17-0	EX			7-6
4XC23-6	10	16-6	EX			6-6
4XC23	4	16-9	EX			6-6
4XC22-9	10	16-2	EX			6-2
4XA4-3	10	1-6	EX	0-7	1-4	
4XB4	10	1-8	EX	1-11		3-5
4L3-9	110	1-6	EX			

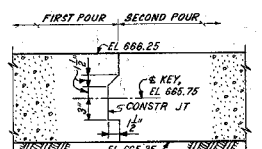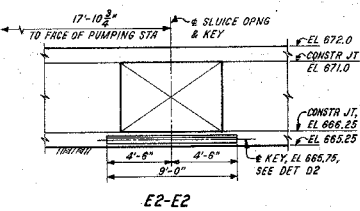




DET D2  
B9  
1/2"=1'-0"

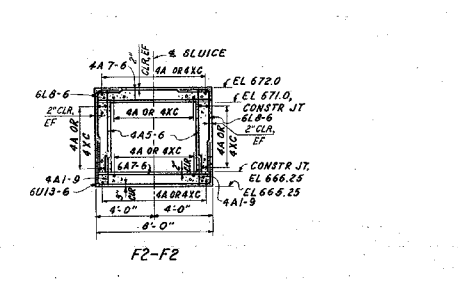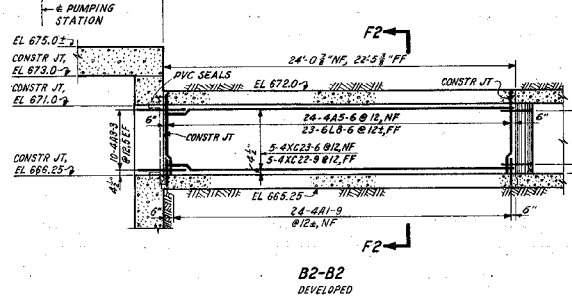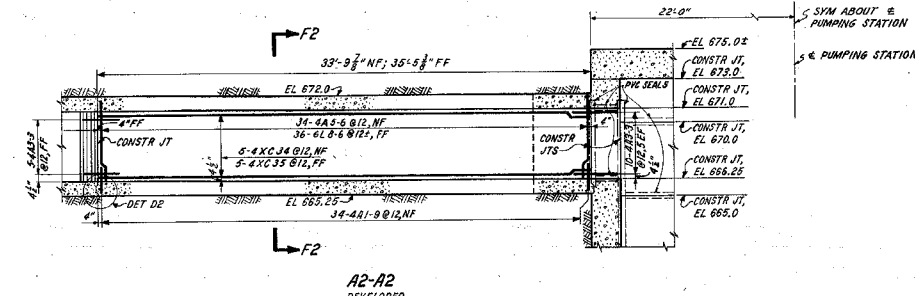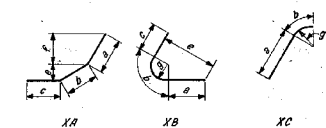

A2-A2 DEVELOPED

B2-B2 DEVELOPED

F2-F2

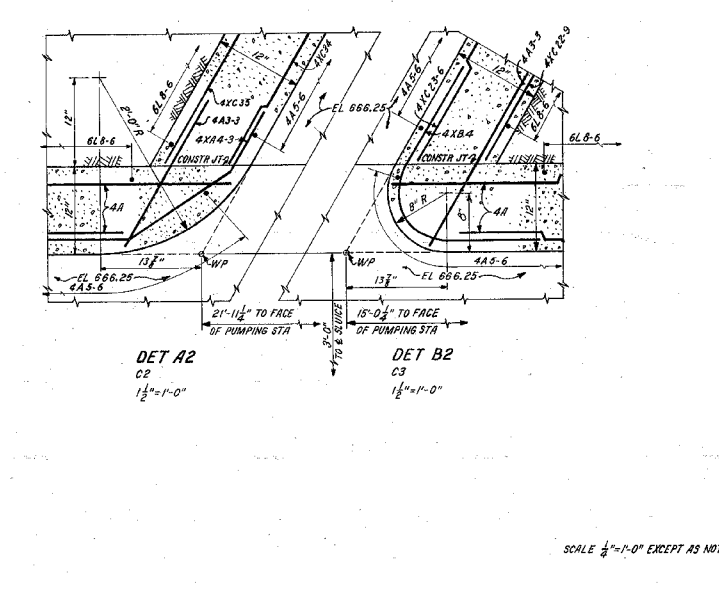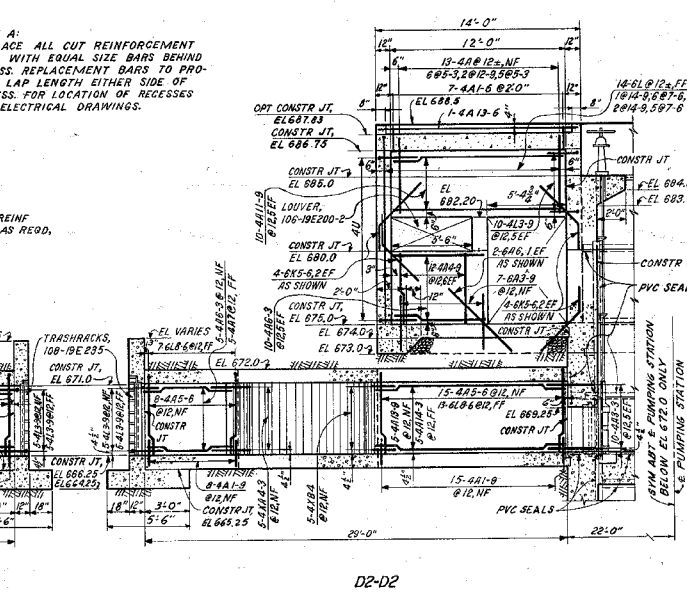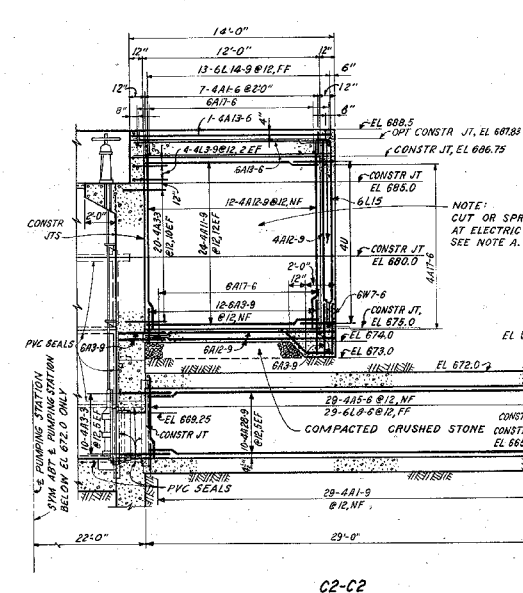

C2-C2

D2-D2

DET A2  
C2  
1/2"=1'-0"

DET B2  
C3  
1/2"=1'-0"

NOTE A:  
REPLACE ALL CUT REINFORCEMENT BARS WITH EQUAL SIZE BARS BEHIND RECESS. REPLACEMENT BARS TO PROVIDE LAP LENGTH EITHER SIDE OF RECESS. FOR LOCATION OF RECESSES SEE ELECTRICAL DRAWINGS.


NOTE:  
CUT OR SPREAD REINF AT ELECTRIC BOX AS RECD. SEE NOTE A.

NOTES:  
1. FOR GENERAL NOTES AND REFERENCE DRAWINGS SEE 101-19E235-1.


SCALE 1/2"=1'-0" EXCEPT AS NOTED

CHATTANOOGA FLOOD PROTECTION	
CONCRETE PUMPING STATION NO. 2	
OUTLINE & REINFORCEMENT	
SOUTH CHICKAMAUGA CREEK PROJECT	
TENNESSEE VALLEY AUTHORITY	
DIVISION OF ENGINEERING DESIGN	
SUBMITTED	RECOMMENDED
DESIGNED BY	APPROVED
DATE	
KNOXVILLE 5-6-77 81 C 101-19E 235-2 R1	


INSPECTED AND APPROVED FOR ISSUE	DESIGN PROJECT MANAGER
DATE	
SCALE	
PRINTED	

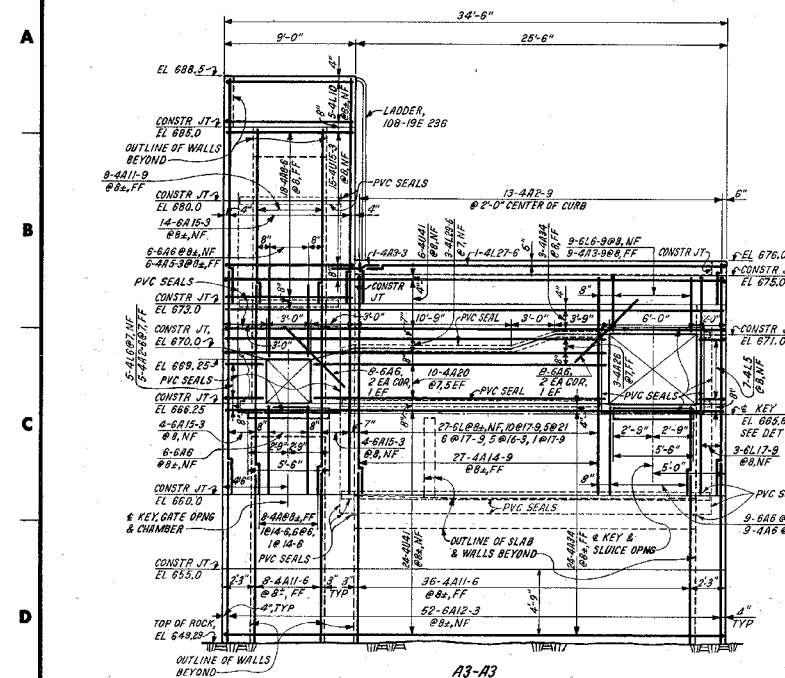


A3-A3  
SLUICE NOT SHOWN  
SH 1

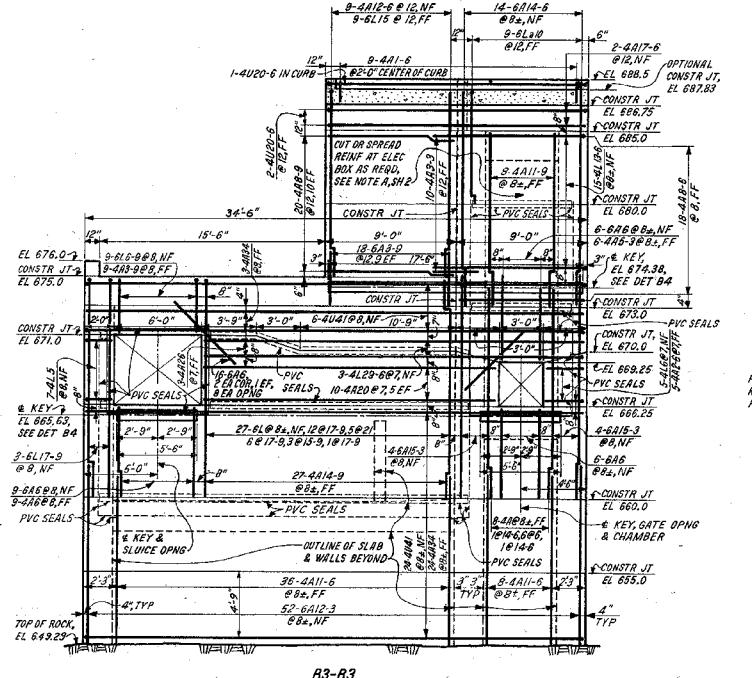


B3-B3  
SLUICE NOT SHOWN  
SH 1

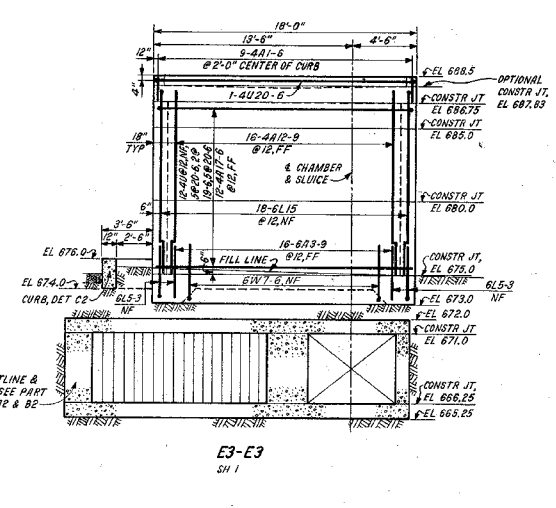


E3-E3  
SH 1

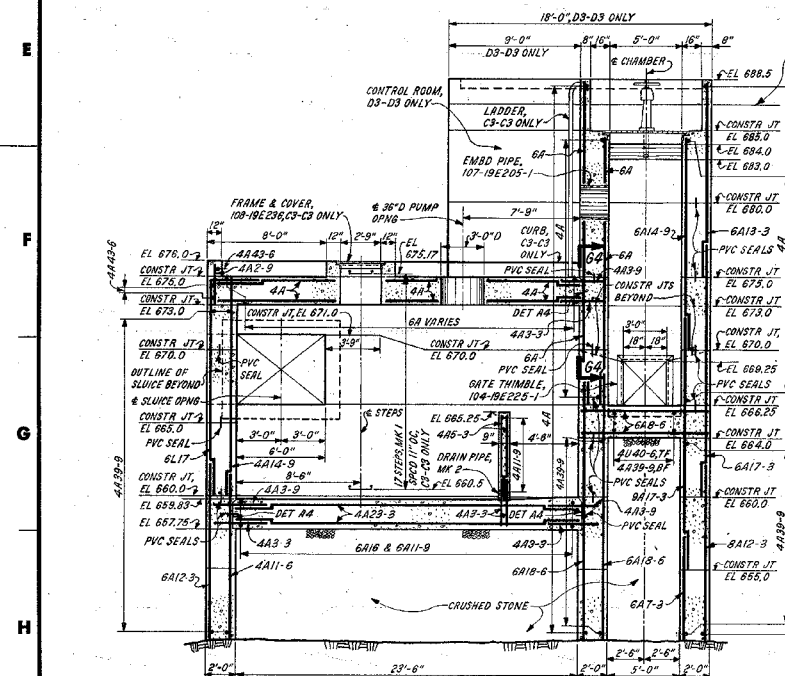


C3-C3 & D3-D3  
OPP H  
SH 1

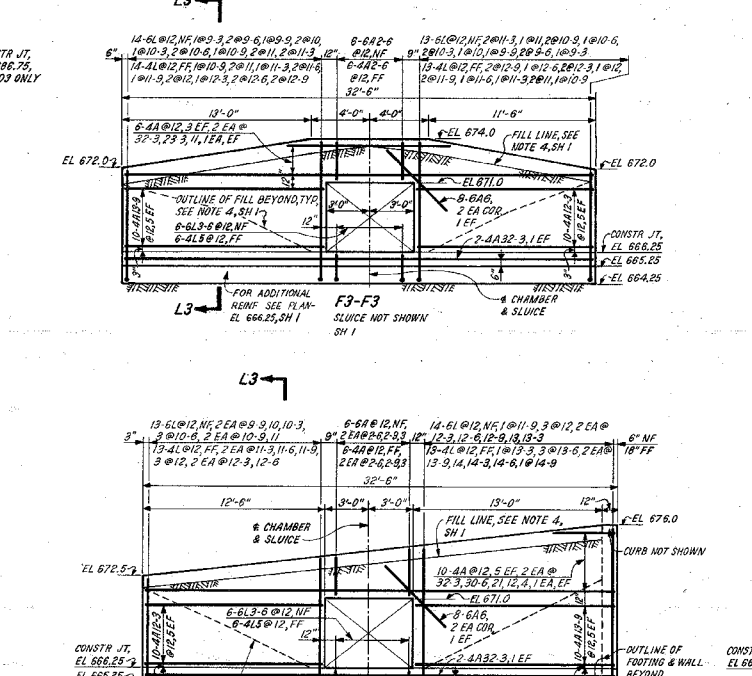


F3-F3  
SLUICE NOT SHOWN  
SH 1

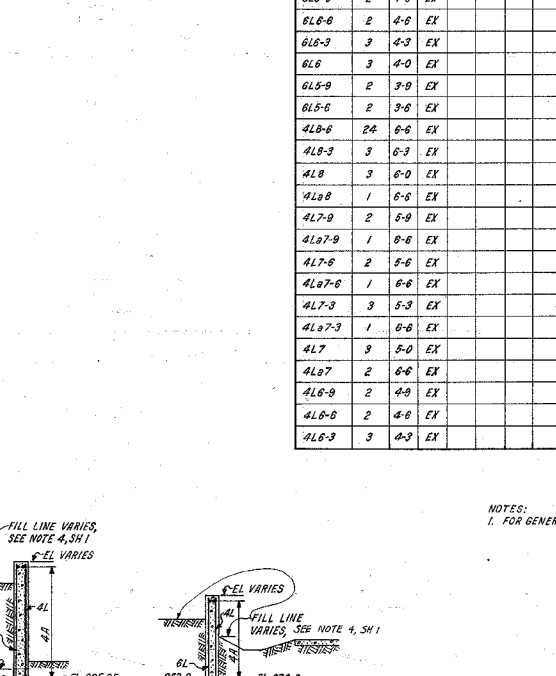


L3-L3  
SH 1

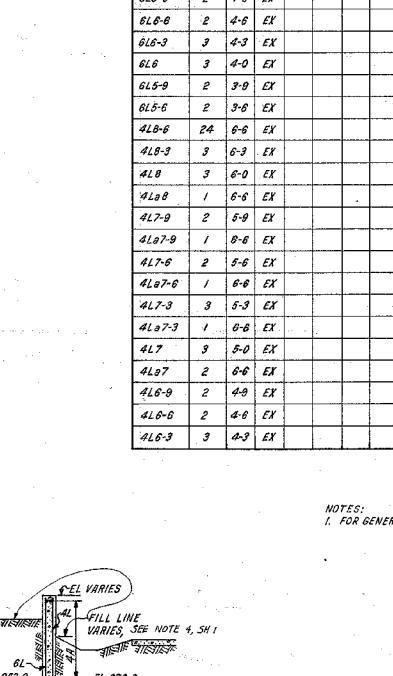


M3-M3  
SH 1

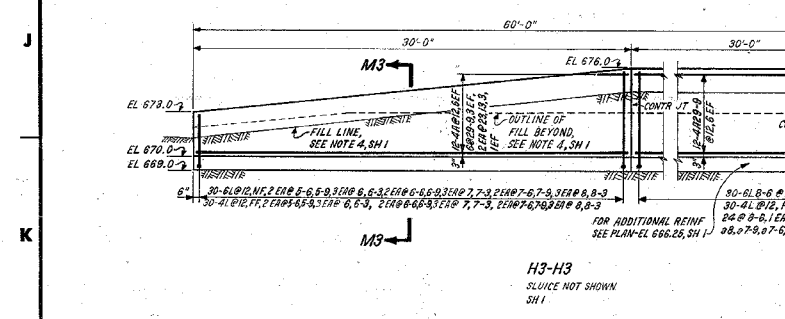

H3-H3  
SLUICE NOT SHOWN  
SH 1

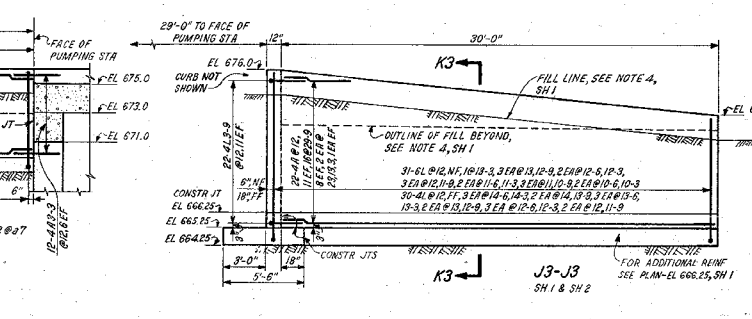

J3-J3  
SH 1 & SH 2

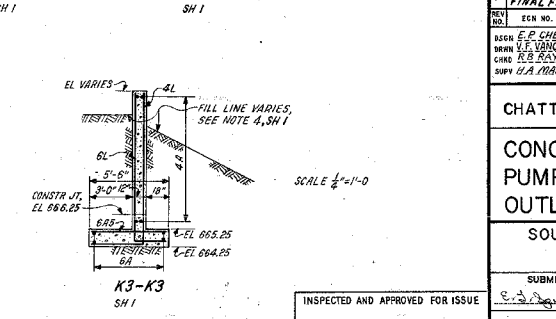

K3-K3  
SH 1

BENT BAR LIST									
BAR MARK	NO. REQD	BENDING DIMENSIONS							
		a	b	c	d	e	f	g	
6L21	10	14-10	EX						
6L17-9	42	14-10	EX						
6L16-3	5	14-10	EX						
6L15-9	3	14-10	EX						
6L15	27	12-8	EX						
6L13-3	3	11-3	EX						
6L13	5	11-0	EX						
6L12-9	5	10-9	EX						
6L12-6	4	10-6	EX						
6L12-3	4	10-3	EX						
6L12	6	10-0	EX						
6L11-9	4	9-9	EX						
6L11-6	2	9-6	EX						
6L11-3	6	9-3	EX						
6L11	8	9-0	EX						
6L10-9	8	9-9	EX						
6L10-6	8	9-6	EX						
6L10-3	7	9-3	EX						
6L10	5	9-0	EX						
6L10	9	7-8	EX						
6L9-9	4	7-8	EX						
6L9-6	4	7-6	EX						
6L9-3	2	7-3	EX						
6L8-9	18	3-7	EX						
6L8-6	12	1-8	EX						
4U41	80	3-7	30-4	EX					
4L29-6	6	20-0	EX						
4L27-6	1	20-0	EX						
4U20-6	14	1-7	17-6	EX					
4U19-6	2	0-7	17-6	EX					
4U18-3	15	3-6	8-5	EX					
4L16-9	1	11-3	EX						
4L16-6	5	11-0	EX						
4L16-3	5	10-9	EX						
4L16	4	10-6	EX						
4L15-9	19	10-3	EX						
4L15-6	6	10-0	EX						
4L15-3	4	9-9	EX						
4L15	8	9-6	EX						
4L14-9	8	9-0	EX						
4L14-6	8	8-9	EX						
4L14-3	8	8-6	EX						
4L14	7	8-3	EX						
4L13-9	5	8-0	EX						
4L13-6	4	7-9	EX						
4L13-3	4	7-6	EX						
4L13	2	7-3	EX						
4L12-9	6	9-3	EX						
4L12-6	8	9-0	EX						
4L12-3	8	8-9	EX						
4L12	8	8-6	EX						
4L11-9	7	8-3	EX						
4L11-6	5	8-0	EX						
4L11-3	4	7-9	EX						
4L11	4	7-6	EX						
4L10-9	2	7-3	EX						
4L10	5	8-6	EX						
4L6	10	2-6	EX						
4L5	26	1-6	EX						
4L3-9	22	1-6	EX						

BENT BAR LIST									
BAR MARK	NO. REQD	BENDING DIMENSIONS							
		a	b	c	d	e	f	g	
4L6	3	4-0	EX						
4L5-9	2	3-9	EX						
4L5-6	2	3-6	EX						



BENT BAR LIST									
BAR MARK	NO. REQD	BENDING DIMENSIONS							
		a	b	c	d	e	f	g	
6L8	3	8-0	EX						
6L7-9	2	5-9	EX						
6L7-6	2	5-6	EX						
6L7-3	3	5-3	EX						
6L7	3	5-0	EX						
6L6-9	2	4-9	EX						
6L6-6	2	4-6	EX						
6L6-3	3	4-3	EX						
6L6	3	4-0	EX						
6L5-9	2	3-9	EX						
6L5-6	2	3-6	EX						
6L5-3	2	3-3	EX						
6L5	2	3-0	EX						
4L8-6	2	6-6	EX						
4L8-3	3	6-3	EX						
4L8	3	6-0	EX						
4L8	1	6-6	EX						
4L7-9	2	5-9	EX						
4L7-6	1	6-6	EX						
4L7-3	3	6-3	EX						
4L7	3	6-0	EX						
4L7	2	6-6	EX						
4L6-9	2	4-9	EX						
4L6-6	2	4-6	EX						
4L6-3	3	4-3	EX						

NOTES:  
1. FOR GENERAL NOTES AND REFERENCE DRAWINGS SEE 101-19E235-1.



1	FINAL FIELD REV	1-3-88	DLW/JAM	DAW	DRM/MSK	MSK
REV	NO.	DATE	BY	CHKD	APPD	APPD
1	1	1-3-88	E.P. CHENG	J.P. BURKE		
CHATTANOOGA FLOOD PROTECTION						
CONCRETE PUMPING STATION NO. 2						
OUTLINE & REINFORCEMENT						
SOUTH CHICKAMAUGA CREEK PROJECT						
TENNESSEE VALLEY AUTHORITY						
DIVISION OF ENGINEERING DESIGN						
SUBMITTED			RECOMMENDED		APPROVED	
KNOXVILLE 5-6-77			BI C 101-19E235-3 RI		Frank Van Miller 10/1/81 RI	

INSPECTED AND APPROVED FOR ISSUE	DATE	BY
PRINT	1	1
SIZE	1	1
SH OR PROJ	ME	CE
CE	AD	CO
CO	ED	MO
MO	SI	SW
SW	EL	PA
PA	CH	ENR
ENR	REC	RD


BENT BAR LIST						
BAR MARK	NO. REQD	a	b	c	e	f
6L17	44	14-8	EX			
4L12-3	104	10-10	EX			
4L5	36	1-6	EX			
4L3-9	5	1-6	EX			

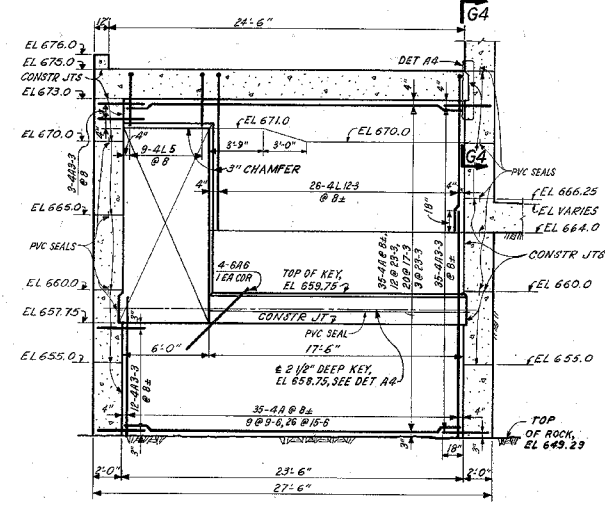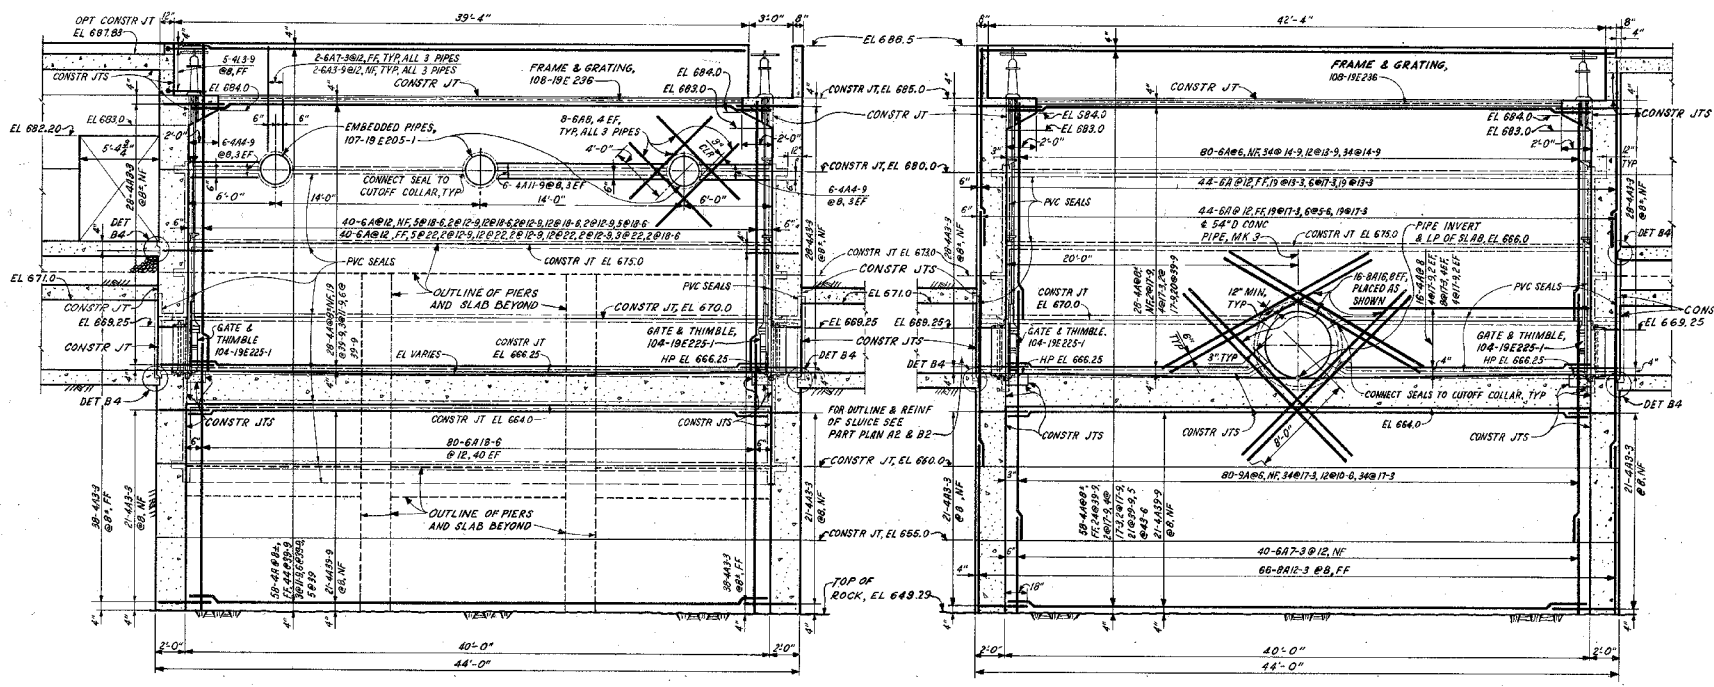


C4-C4 & D4-D4 OPP HAND  
2 REQD  
SLAB EL 659.83 NOT SHOWN  
SH 1

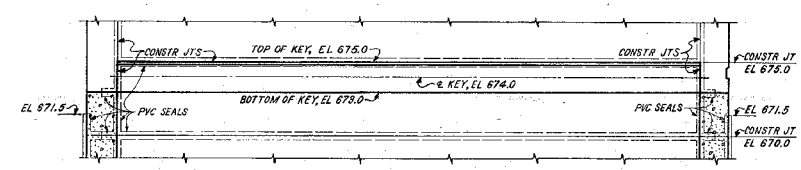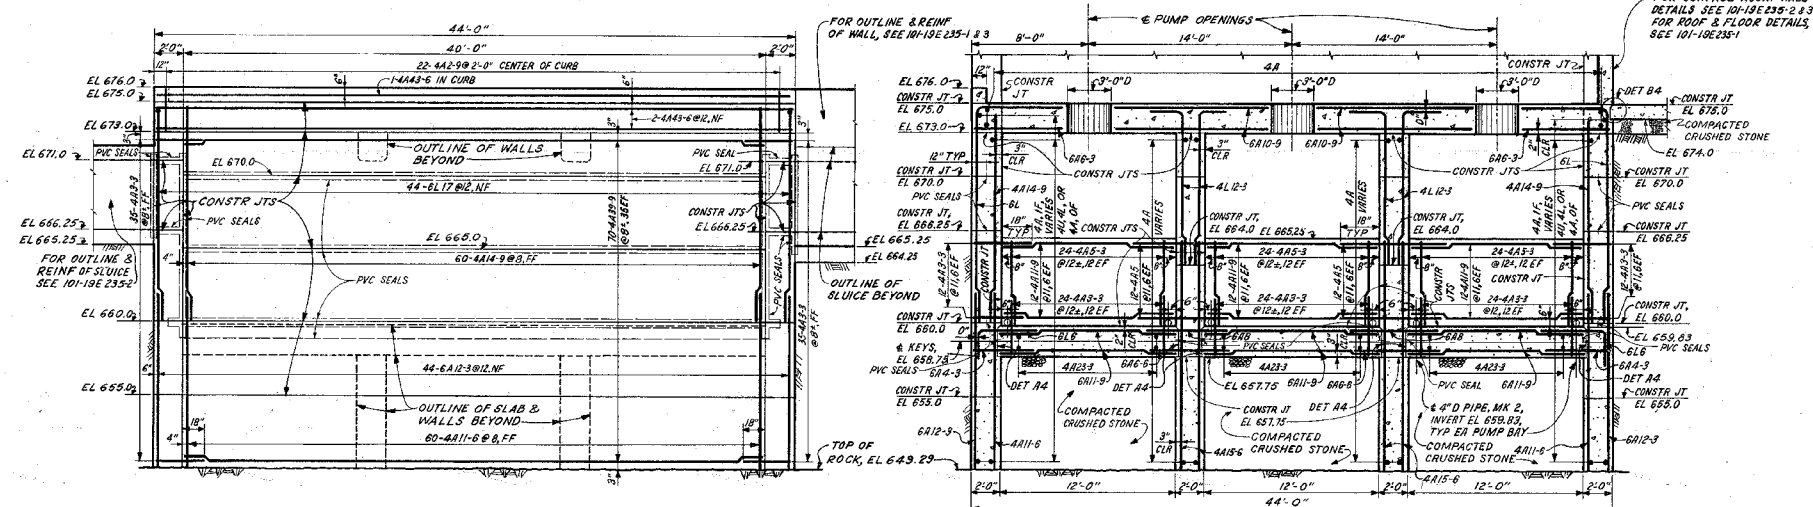

G4-G4  
EL 670.0 SLAB NOT SHOWN  
SH 3

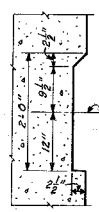

DET A4  
1/2"=1'-0"

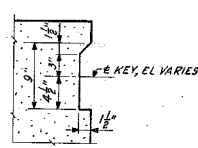

DET B4  
1/2"=1'-0"

NOTES:  
1. FOR GENERAL NOTES AND REFERENCE DRAWINGS SEE 101-19E235-1.

1	FINAL FIELD REV	DATE	DESIGN	CHECK	INSP	CONSTR	APPR
NO.	NO.						
DESIGN	E.P. CHEN	EL	J.P. BURKE	INSP			
CHECK	A.B. RAY	EL		ENGINEER			
SUPV	C.A. QUARREN	EL					

CHATTAHOOGA FLOOD PROTECTION  
CONCRETE  
PUMPING STATION NO.2  
OUTLINE & REINFORCEMENT  
SOUTH CHICKAMAUGA CREEK PROJECT  
TENNESSEE VALLEY AUTHORITY  
DIVISION OF ENGINEERING DESIGN

SUBMITTED: [Signature]  
RECOMMENDED: [Signature]  
APPROVED: [Signature]  
KNOXVILLE 5-6-77 81 c 101-19E235-4 RI

INSPECTED AND APPROVED FOR ISSUE  
DESIGN PROJECT MANAGER  
KNOXVILLE 5-6-77

PRINT NO. 1/1 2  
SIZE F  
BR OR PROJ. IN. L. E. AU. CO. EQ. NO. OF SH. U. R. L.  
PRINTS MADE - 0













SCALE 1/2"=1'-0" EXCEPT AS NOTED



6'x5' Box ties to 54" cross drain at upstr. invert - El. 666.0

BENT BAR LIST						
BAR MARK	NO. REQD	BENDING DIMENSIONS				
		a	b	c	d	e
6XD12-3	16	3-9	0-7 1/2	3-9 1/2	EX	3-4
6C11-3	6					2-9 1/2
4U11-8	4	3-7	4-5 1/2	EX		
4U10	2	2-10	4-5 1/2	EX		
4U8-3	2	2-0	4-5 1/2	EX		

A  
B  
C  
D  
E  
F  
G  
H  
J  
K

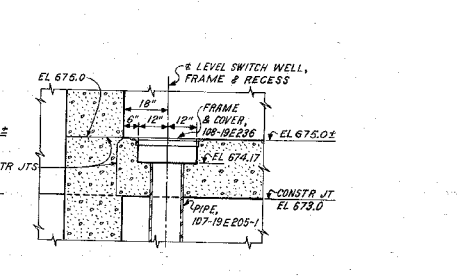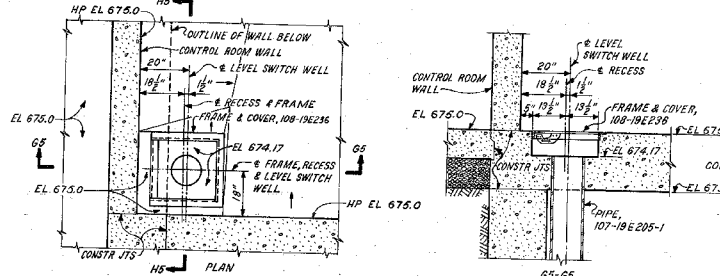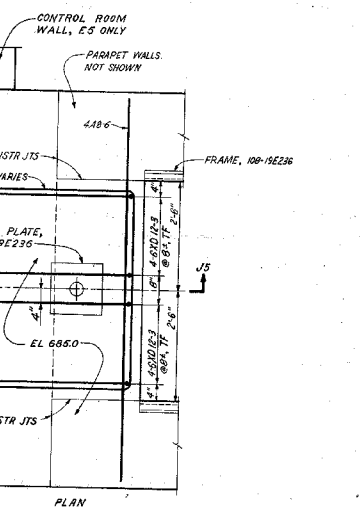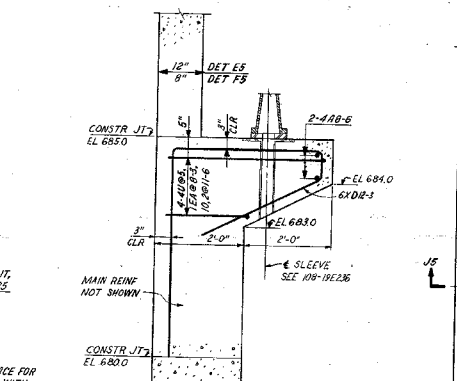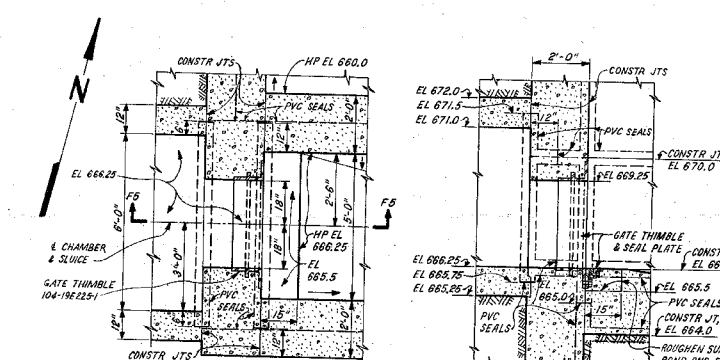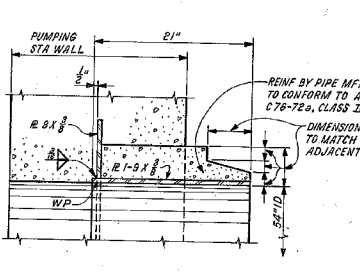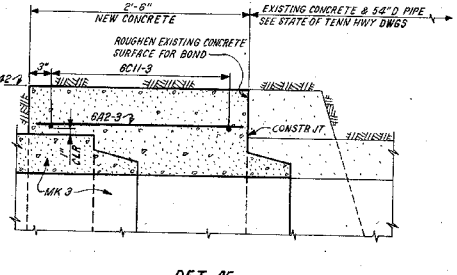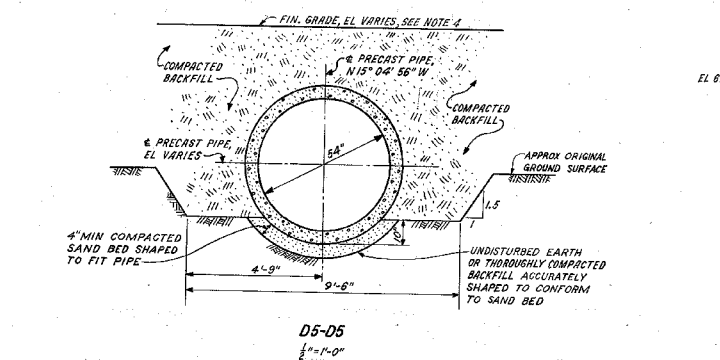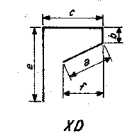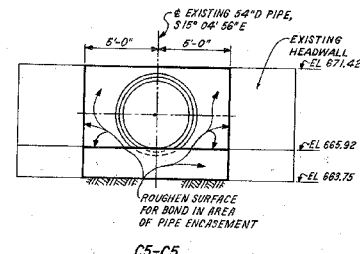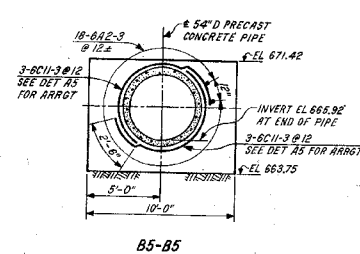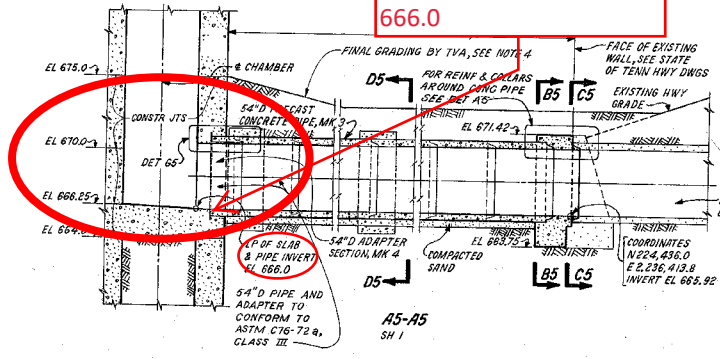


NOTES:  
1. FOR GENERAL NOTES AND REFERENCE DRAWINGS SEE 101-19E235-1.

CHATTANOOGA FLOOD PROTECTION  
CONCRETE PUMPING STATION NO. 2  
OUTLINE & REINFORCEMENT  
SOUTH CHICKAMAUGA CREEK PROJECT  
TENNESSEE VALLEY AUTHORITY  
DIVISION OF ENGINEERING DESIGN


INSPECTED AND APPROVED FOR ISSUE: [Signature]  
KNOXVILLE 5-6-77 81 c 101-19E235-5 81

REVISIONS: [Table with columns for NO., DATE, DESCRIPTION, BY, CHECKED, APPROVED]


SCALE 1/2"=1'-0" EXCEPT AS NOTED

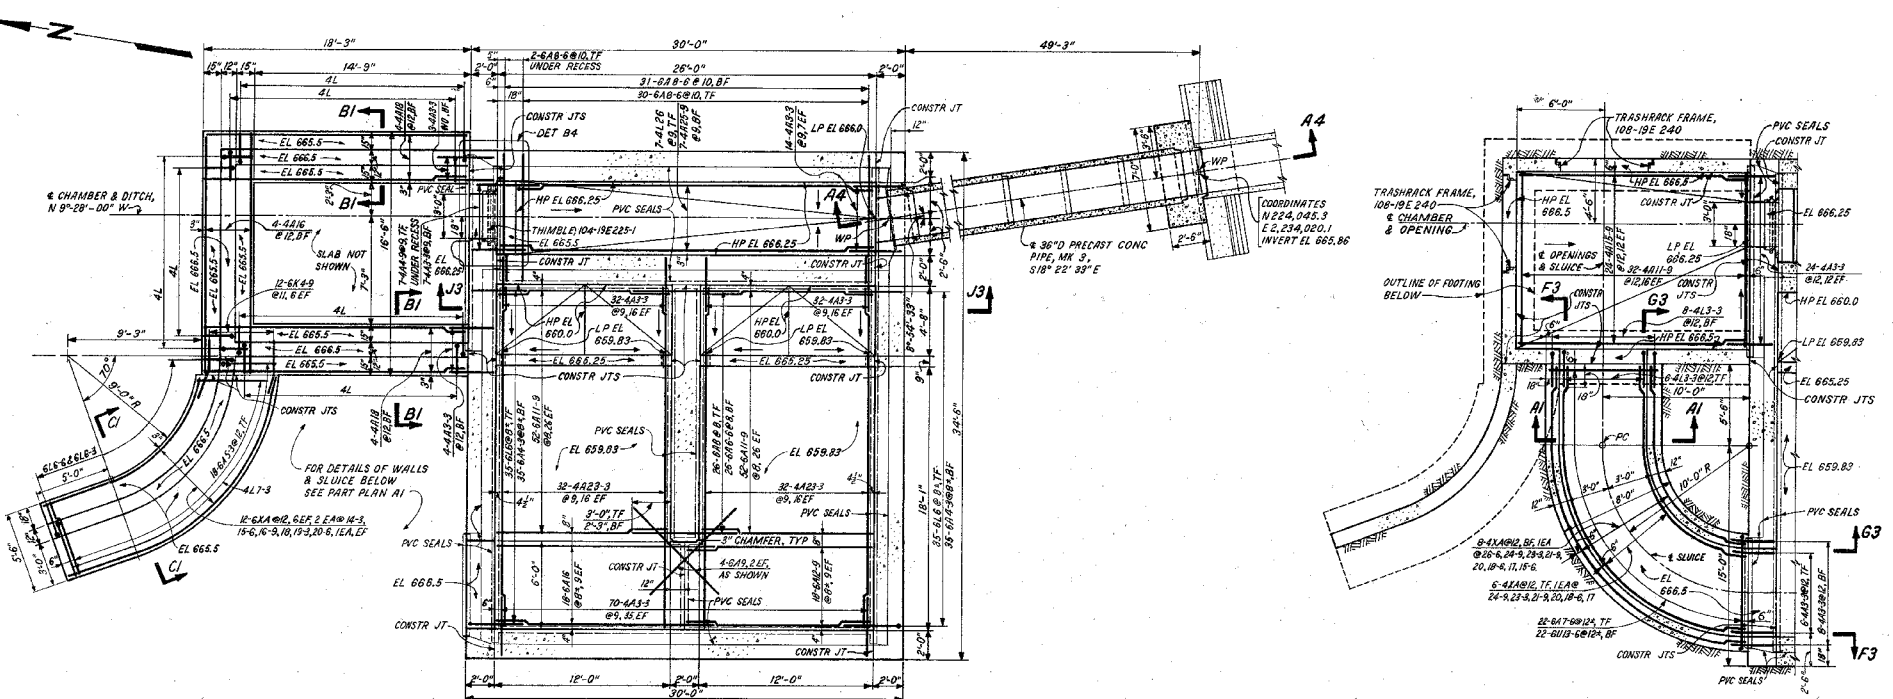

PLAN-EL 666.5  
SLUICE NOT SHOWN

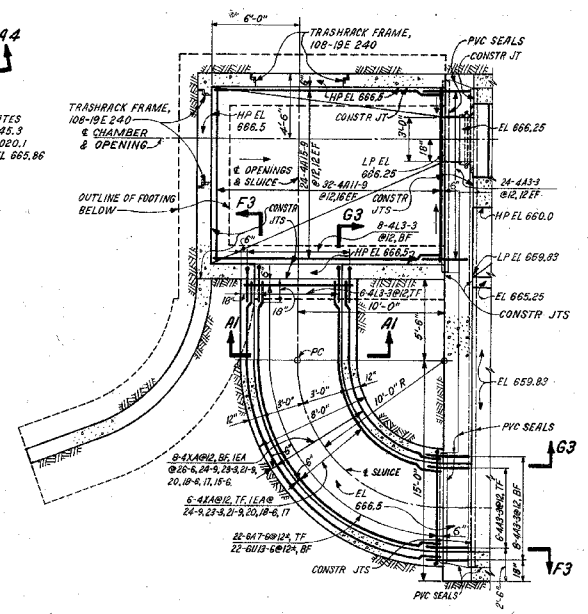


PART PLAN A1-EL 666.5  
SHOWING SLAB & FLOOR OF SLUICE

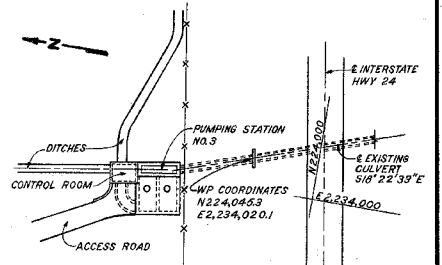


KEY PLAN  
1"=40'

- NOTES:
- FORMED CONCRETE SURFACES SHALL BE FINISHED IN ACCORDANCE WITH SECTION 10.4 OF SPECIFICATIONS FOR STRUCTURAL CONCRETE FOR BUILDINGS (ACI 304-73), EXCEPT SURFACES EXPOSED TO PUBLIC VIEW SHALL HAVE A BROUT CLEANED FINISH. CONCRETE SLABS SHALL BE FINISHED IN ACCORDANCE WITH SECTION 11.6, ACI 304-73.
  - REINFORCING BARS SHALL BE BENT ACCORDING TO TVA ENGINEERING PROCEDURE DED-EP 7.08, DRAFTING STANDARDS-CIVIL-CONCRETE REINFORCING-BAR DETAILING-SECTION 12, ATTACHMENT 1.
  - CRUSHED STONE USED AS FILL MATERIAL UNDER CONCRETE SLABS SHALL CONFORM TO TVA HIGHWAY SPECIFICATION NO. T-1, SECTION 103.2.
  - FINAL GRADING BY TVA IN ACCORDANCE WITH DRAWING NO. 81-C-101-19E245-1 & 2.
  - FOR ADDITIONAL REQUIREMENTS SEE TVA SPECIFICATION FOR THE CONSTRUCTION OF PUMPING STATIONS 1, 2 & 3 FOR SOUTH CHICKAMAUGA CREEK PROJECT.

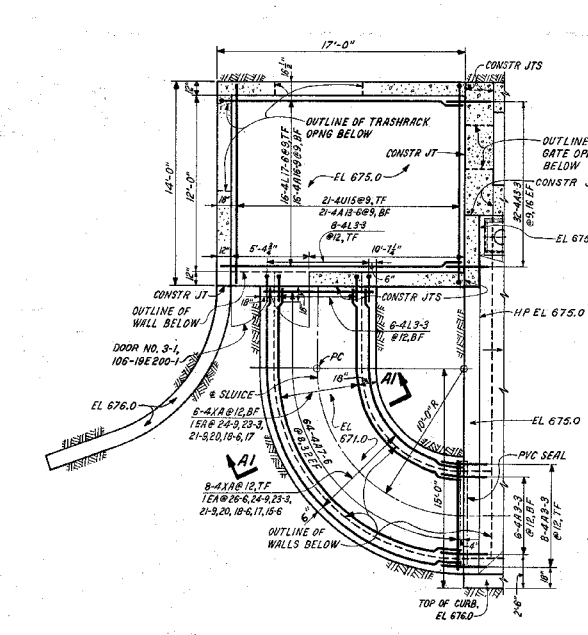


PART PLAN BI-EL 675.0+  
SHOWING CONTROL ROOM SLAB & ROOF OF SLUICE

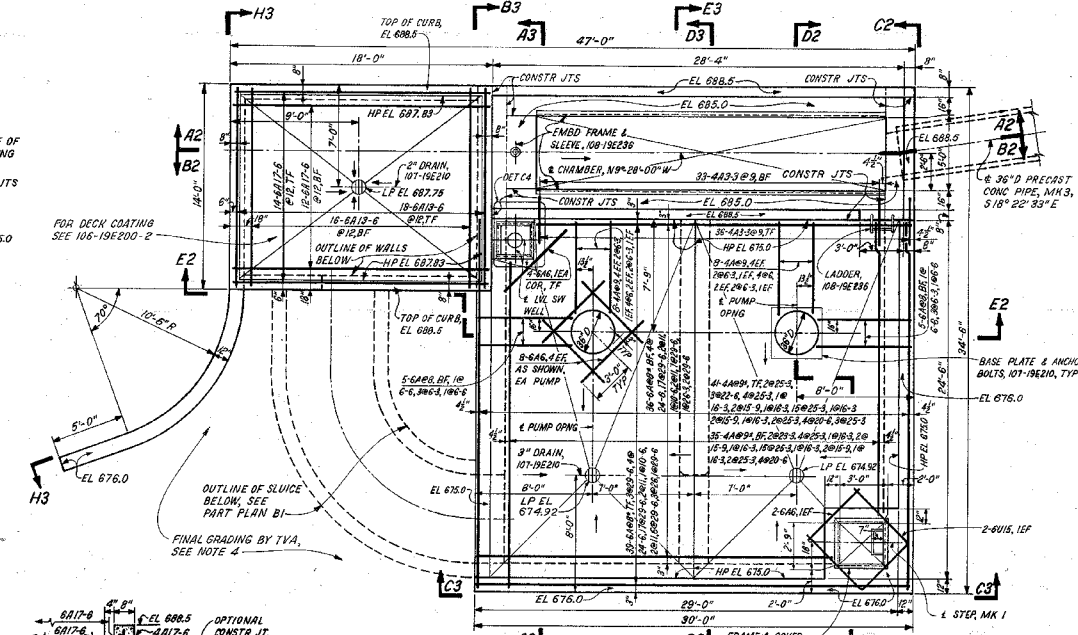


PLAN-EL 688.5

BENT BAR LIST								
BAR MARK	NO. REQD	BENDING DIMENSIONS						
		a	b	c	e	f	g	
6XA20-6	2	4-9	EX					14-3
6XA19-3	2	4-9	EX					13-3
6XA18	2	4-9	EX					12-3
6XA16-9	2	4-9	EX					11-3
6XA15-6	2	4-9	EX					10-3
6U15	2	5-4	4-7	EX				
6XA14-3	2	4-9	EX					9-3
6U13-6	22	3-1	7-8	EX				
6L6	70	1-3	EX					
6K4-9	12	2-7	EX	2-6				
4XA26-6	2	5-6	EX					13-6
4L26	7	2-6	EX					
4XA24-9	4	5-6	EX					12-6
4XA23-3	4	5-6	EX					11-6
4XA21-9	4	5-6	EX					10-6
4XA20	4	5-6	EX					9-6
4XA18-6	4	5-6	EX					8-6
4L17-6	18	18-9	EX					
4XA17	4	5-6	EX					7-6
4XA15-6	2	5-6	EX					6-6
4U15	21	0-10	13-6	EX				
4L3-3	28	2-3	EX					


REFERENCE DRAWING:  
19B1240.....BILL OF MATERIAL

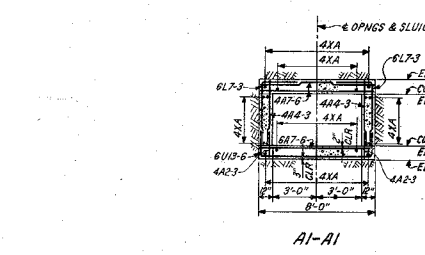

A1-A1

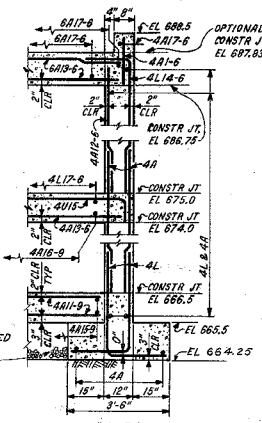

BI-B1  
1/2"=1'-0"

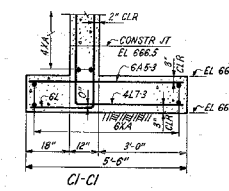

CI-CI  
1/2"=1'-0"

REV	DATE	BY	CHKD	APPD	REASON
1	10/19/24	R. BAY			ISSUED FOR CONSTRUCTION

CHATTANOOGA FLOOD PROTECTION  
CONCRETE  
PUMPING STATION NO. 3  
OUTLINE & REINFORCEMENT  
SOUTH CHICKAMAUGA CREEK PROJECT  
TENNESSEE VALLEY AUTHORITY  
DIVISION OF ENGINEERING DESIGN

DESIGN	PROJECT MANAGER	KNOXVILLE 4-13-77	81	c	101-19E240-1 R0
--------	-----------------	-------------------	----	---	-----------------

SCALE 1/4"=1'-0" EXCEPT AS NOTED

COMPANION DRAWINGS:  
101-19E240-1 THRU 4


INSPECTED AND APPROVED FOR ISSUE

DESIGN PROJECT MANAGER


PRINT

SIZE


NO. OF COPIES

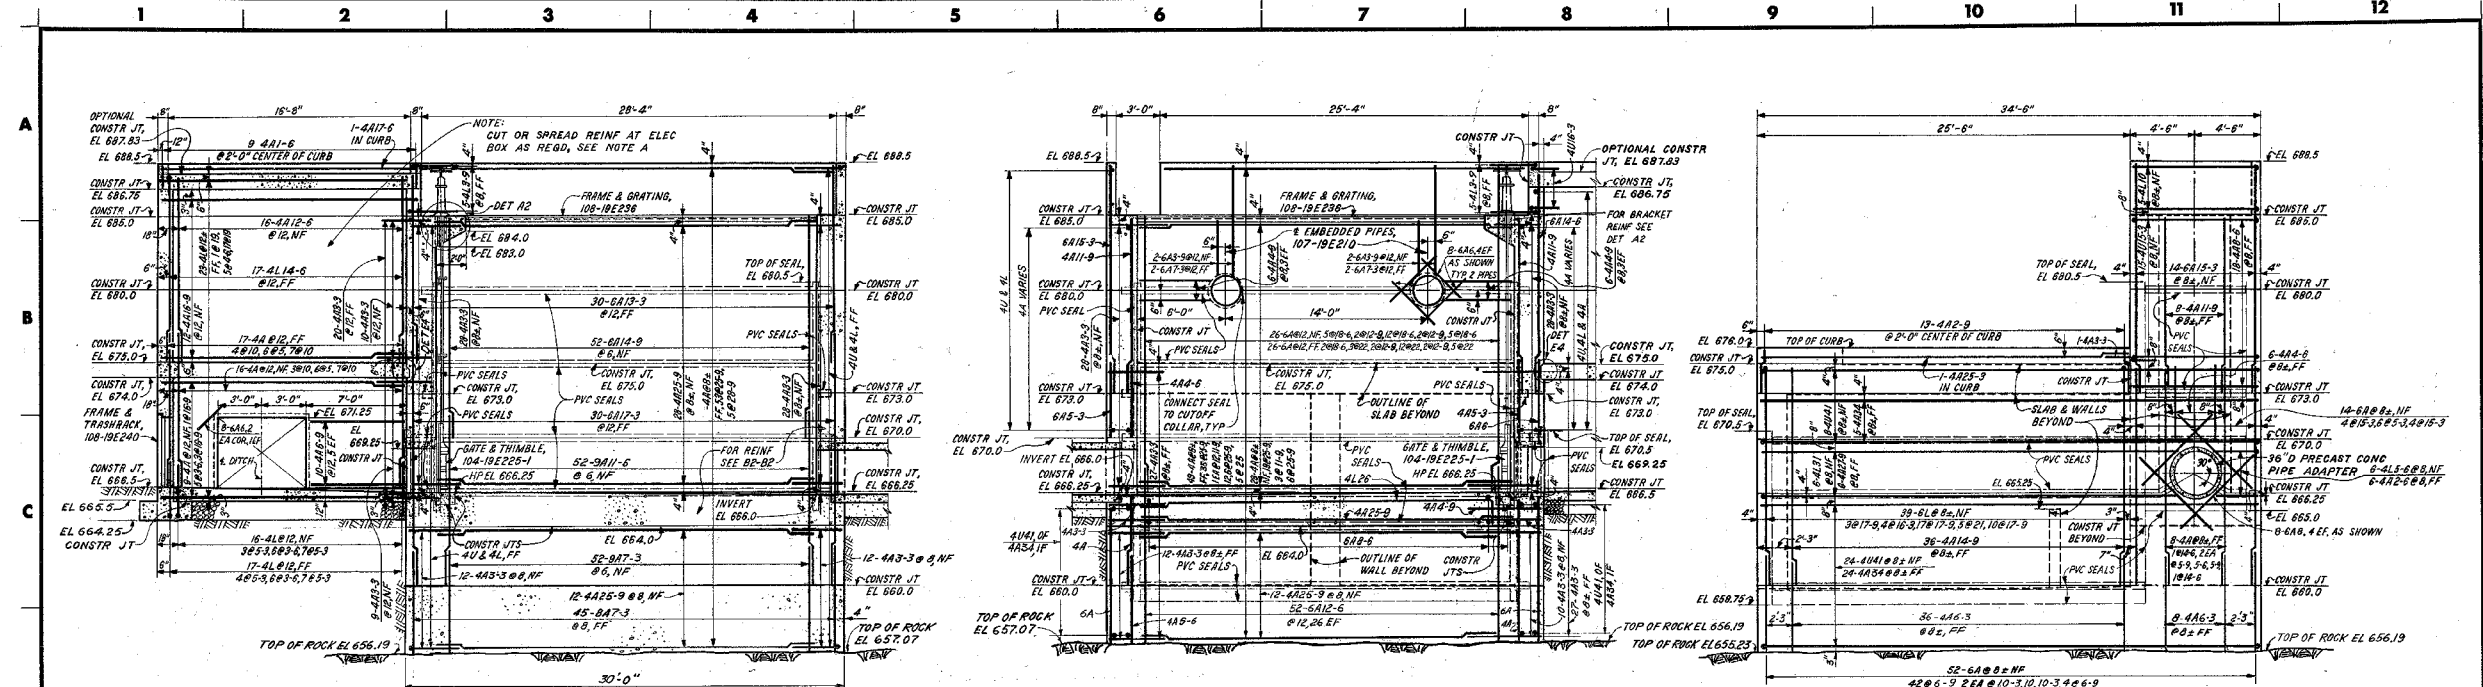

A2-A2 SH 1  
 B2-B2 SH 1  
 C2-C2 SH 1

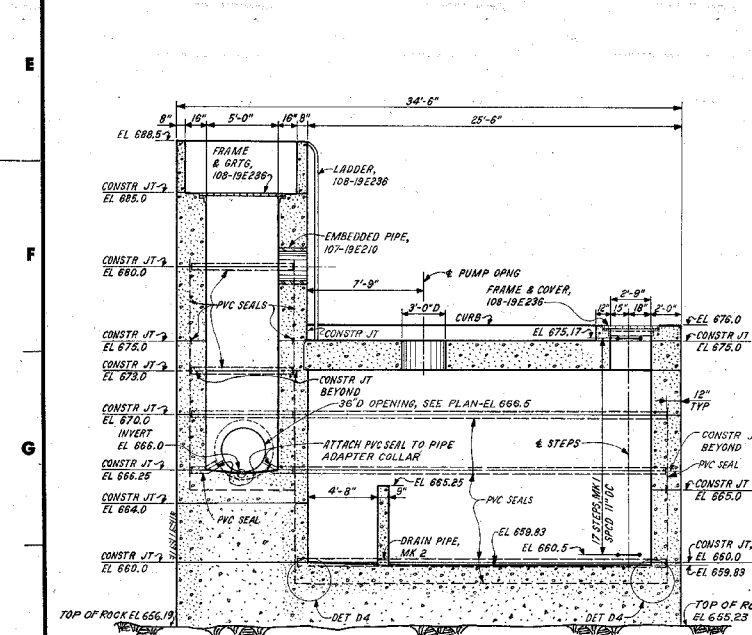


D2-D2 REINF NOT SHOWN SH 1

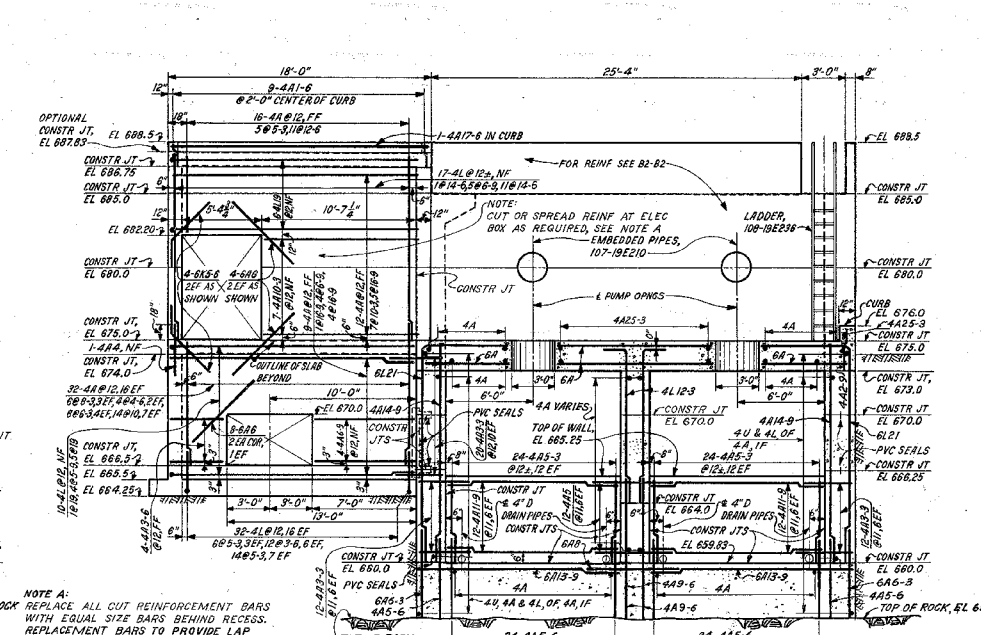

E2-E2 SLICE NOT SHOWN SH 1


**BENT BAR LIST**

BAR MARK	NO. REQD	B	D	C	E	F	G
6L21	5	14-10	EX				
6L17-9	30	14-10	EX				
6L16-3	4	14-10	EX				
6A12-3	8	3-8	0-7	3-6	EX	3-4	
6A5-6	4	1-8	EX	1-2			
4U41	32	3-7	33-11	EX			
4L31	6	27-9	EX				
4L19	30	10-9	EX				
4U15-3	15	3-6	8-5	EX			
4L14-6	20	12-8	EX				
4U11-6	2	3-7	4-5	EX			
4L10	5	8-6	EX				
4U10	1	2-10	4-5	EX			
4U8-3	1	2-10	4-5	EX			
4L8-9	5	3-3	EX				
4L5-9	4	3-6	EX				
4L5-6	6	2-5	EX				
4L5-3	41	3-6	EX				
4L4-6	5	3-6	EX				
4L3-9	10	1-6	EX				
4L3-6	24	1-9	EX				

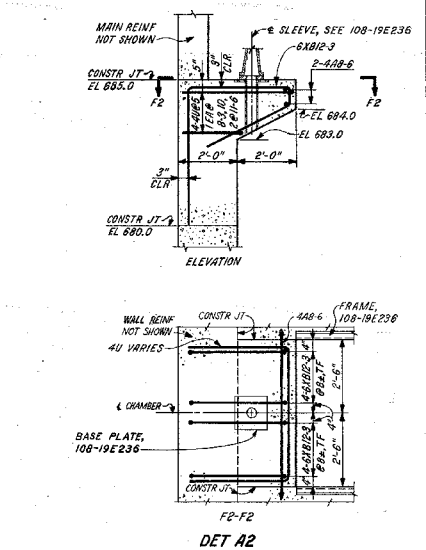

DET A2  
 DET B2

NOTES:  
 1. FOR GENERAL NOTES AND REFERENCE DRAWINGS SEE 101-19E240-1.

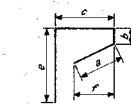


XB

1 FINAL FIELD REV		1-3-03	DLW/JUN	RDW	101-19E240-2
REV	NO.	DATE	ISSUED BY	DESIGNED BY	CHECKED BY
CHATTANOOGA FLOOD PROTECTION					
CONCRETE PUMPING STATION NO. 3					
OUTLINE & REINFORCEMENT					
SOUTH CHICKAMAUGA CREEK PROJECT					
TENNESSEE VALLEY AUTHORITY					
DIVISION OF ENGINEERING DESIGN					
SUBMITTED		RECOMMENDED		APPROVED	
E. J. CHENG		J. P. BURKE		[Signature]	
DESIGNED BY		CHECKED BY		ENGINEER	
E. J. CHENG		J. P. BURKE		[Signature]	
KNOXVILLE 4-19-77 81 C 101-19E240-2 RI					


SCALE 1/2"=1'-0" EXCEPT AS NOTED

INSPECTED AND APPROVED FOR ISSUE	
DESIGN	PROJECT MANAGER
PRINT	1 1/2 2
SIZE	8 1/2 x 11
B OR PROJ LINE OR AD OR ED OR SH OR PA	
PRINTS REG-D	




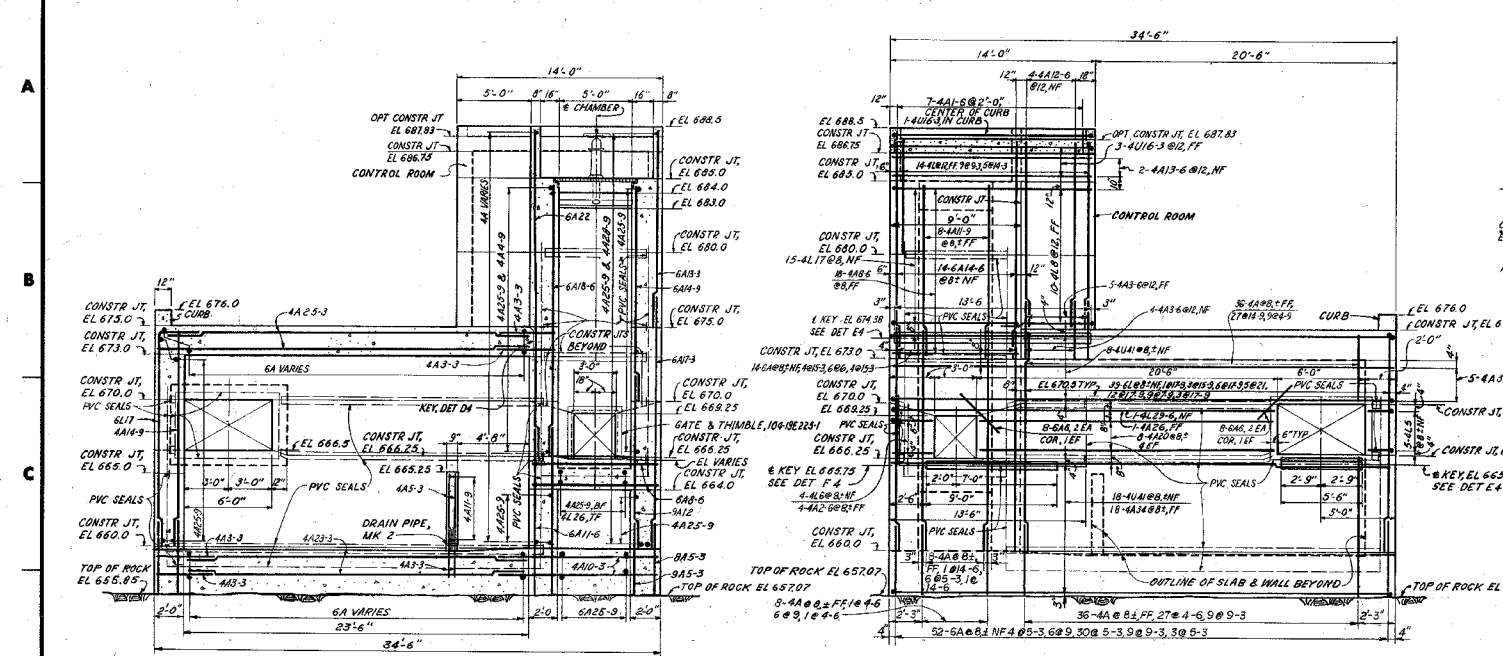


A3-A3 SH 1  
B3-B3 SH 1

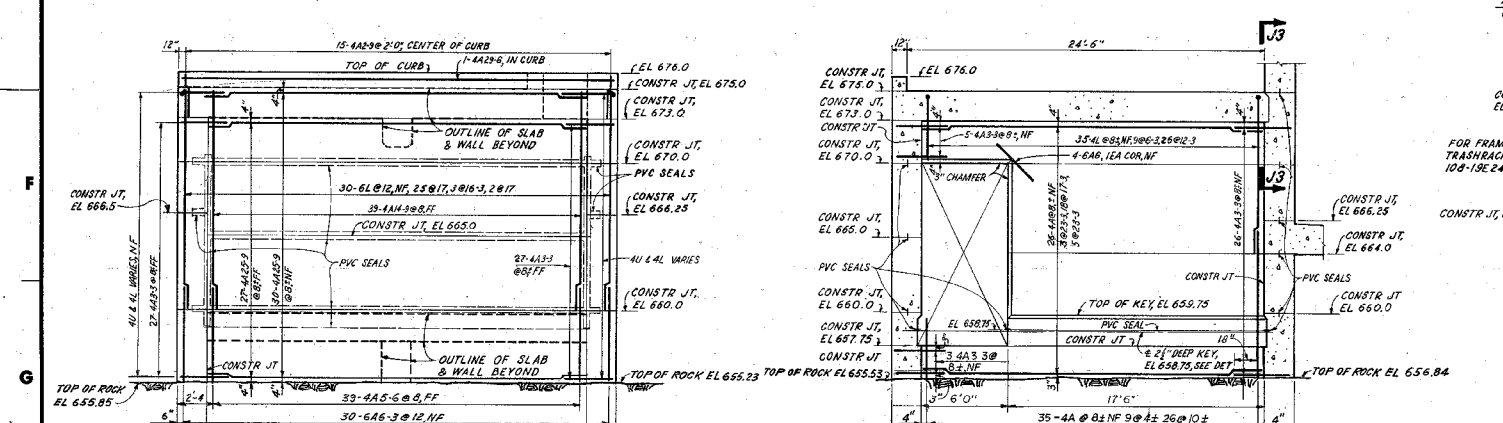


C3-C3 SH 1  
D3-D3 & E3-E3 OPP HAND  
SLAB EL 659.83 NOT SHOWN  
SH 1

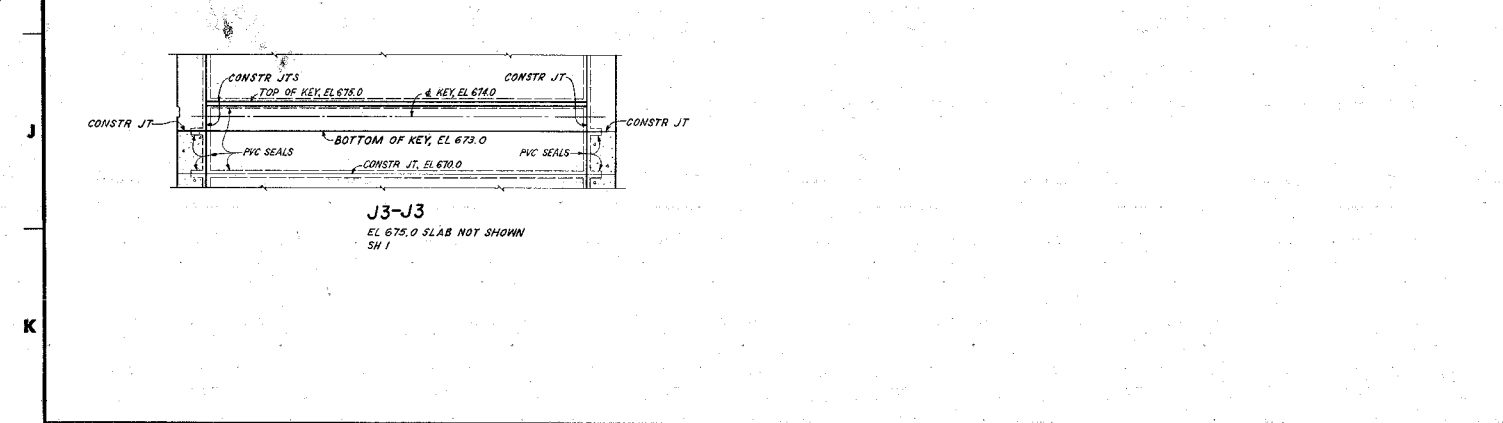

J3-J3  
EL 675.0 SLAB NOT SHOWN  
SH 1

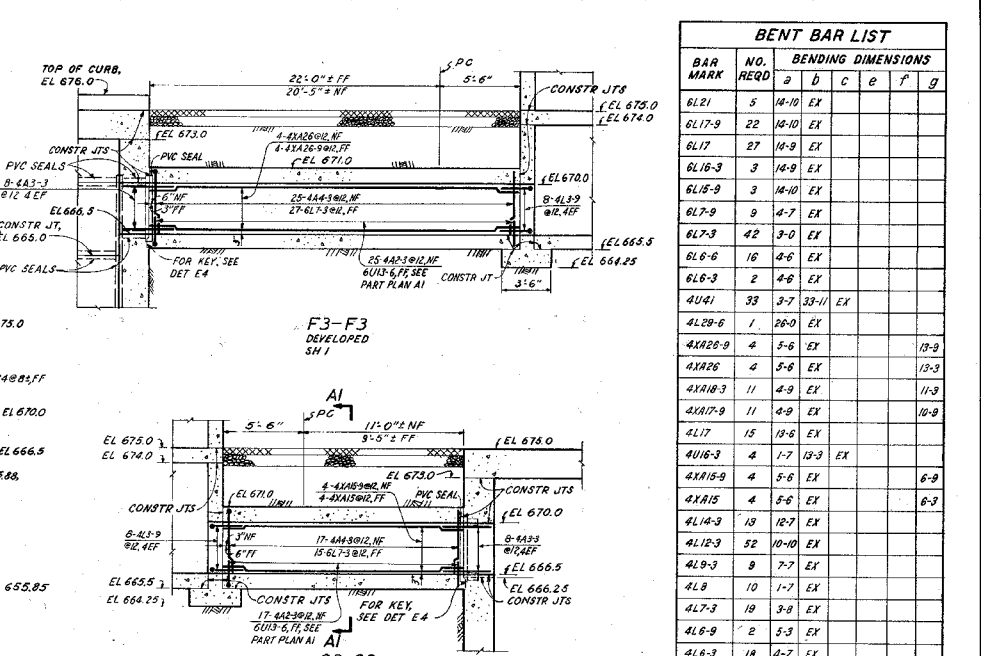

F3-F3 DEVELOPED SH 1  
G3-G3 DEVELOPED SH 1

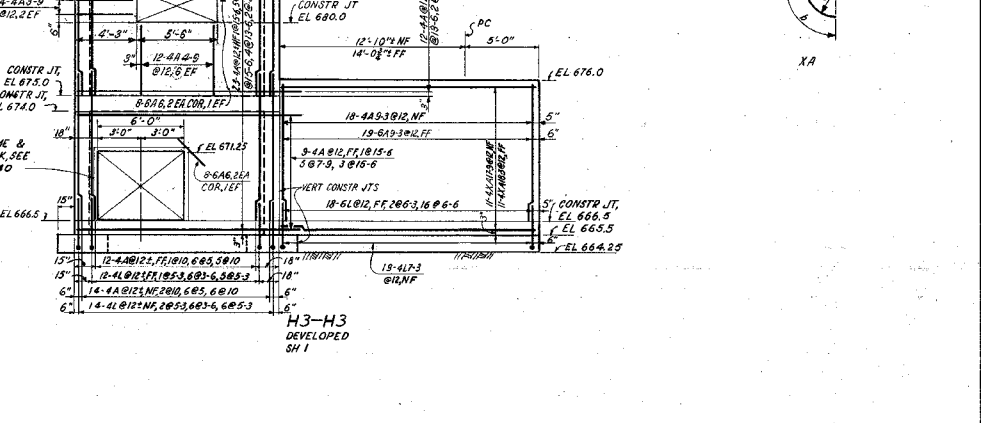

H3-H3 DEVELOPED SH 1

BENT BAR LIST									
BAR MARK	NO.	BENDING DIMENSIONS							
		a	b	c	d	e	f	g	h
6L21	5	14-10	EX						
6L17-9	22	14-10	EX						
6L17	27	14-9	EX						
6L16-3	3	14-9	EX						
6L15-9	3	14-10	EX						
6L7-9	9	4-7	EX						
6L7-3	42	3-0	EX						
6L6-6	16	4-6	EX						
6L6-3	2	4-6	EX						
4U41	33	3-7	3U-11	EX					
4L29-6	1	26-0	EX						
4X20-9	4	5-6	EX						13-3
4X26	4	5-6	EX						13-3
4X18-3	11	4-9	EX						11-3
4X17-9	11	4-9	EX						10-9
4L17	15	13-6	EX						
4U16-3	4	1-7	13-3	EX					
4X15-9	4	5-6	EX						6-9
4X15	4	5-6	EX						6-3
4L14-3	13	12-7	EX						
4L12-3	52	10-10	EX						
4L9-3	9	7-7	EX						
4L8	10	1-7	EX						
4L7-3	18	3-8	EX						
4L6-9	2	5-3	EX						
4L6-3	18	4-7	EX						
4L5	4	2-6	EX						
4L5-3	14	3-6	EX						
4L5	5	1-6	EX						
4L3-9	16	1-6	EX						
4L3-6	12	1-9	EX						

NOTES:  
1. FOR GENERAL NOTES AND REFERENCE DRAWINGS SEE 101-19240-1.

2 FINAL FIELD REV 10-11-78

1 REVISED SIZE OF LOUVER OPENING, E.G. REVISED BENT BAR LIST, C&D, H

REVISIONS:

NO.	DATE	BY	CHKD.	APP'D.	DESCRIPTION
1	10-11-78	E. R. CHENEY	J. P. BURKE		REVISED SIZE OF LOUVER OPENING, E.G. REVISED BENT BAR LIST, C&D, H
2	10-11-78	B. B. RAY			
3	10-11-78	H. A. MANNISON			

SCALE 1/4" = 1'-0"

INSPECTED AND APPROVED FOR ISSUE: [Signature]

DESIGN PROJECT MANAGER: [Signature]

CHATTANOOGA FLOOD PROTECTION

CONCRETE PUMPING STATION NO. 3 OUTLINE & REINFORCEMENT


SOUTH CHICKAMAUGA CREEK PROJECT TENNESSEE VALLEY AUTHORITY DIVISION OF ENGINEERING DESIGN

SUBMITTED: [Signature] RECOMMENDED: [Signature] APPROVED: [Signature]

KNOXVILLE 4-19-77 81 C 101-19240-3 R2

RECORD DRAWING AS CONSTRUCTED

Frank [Signature] 10/1/78

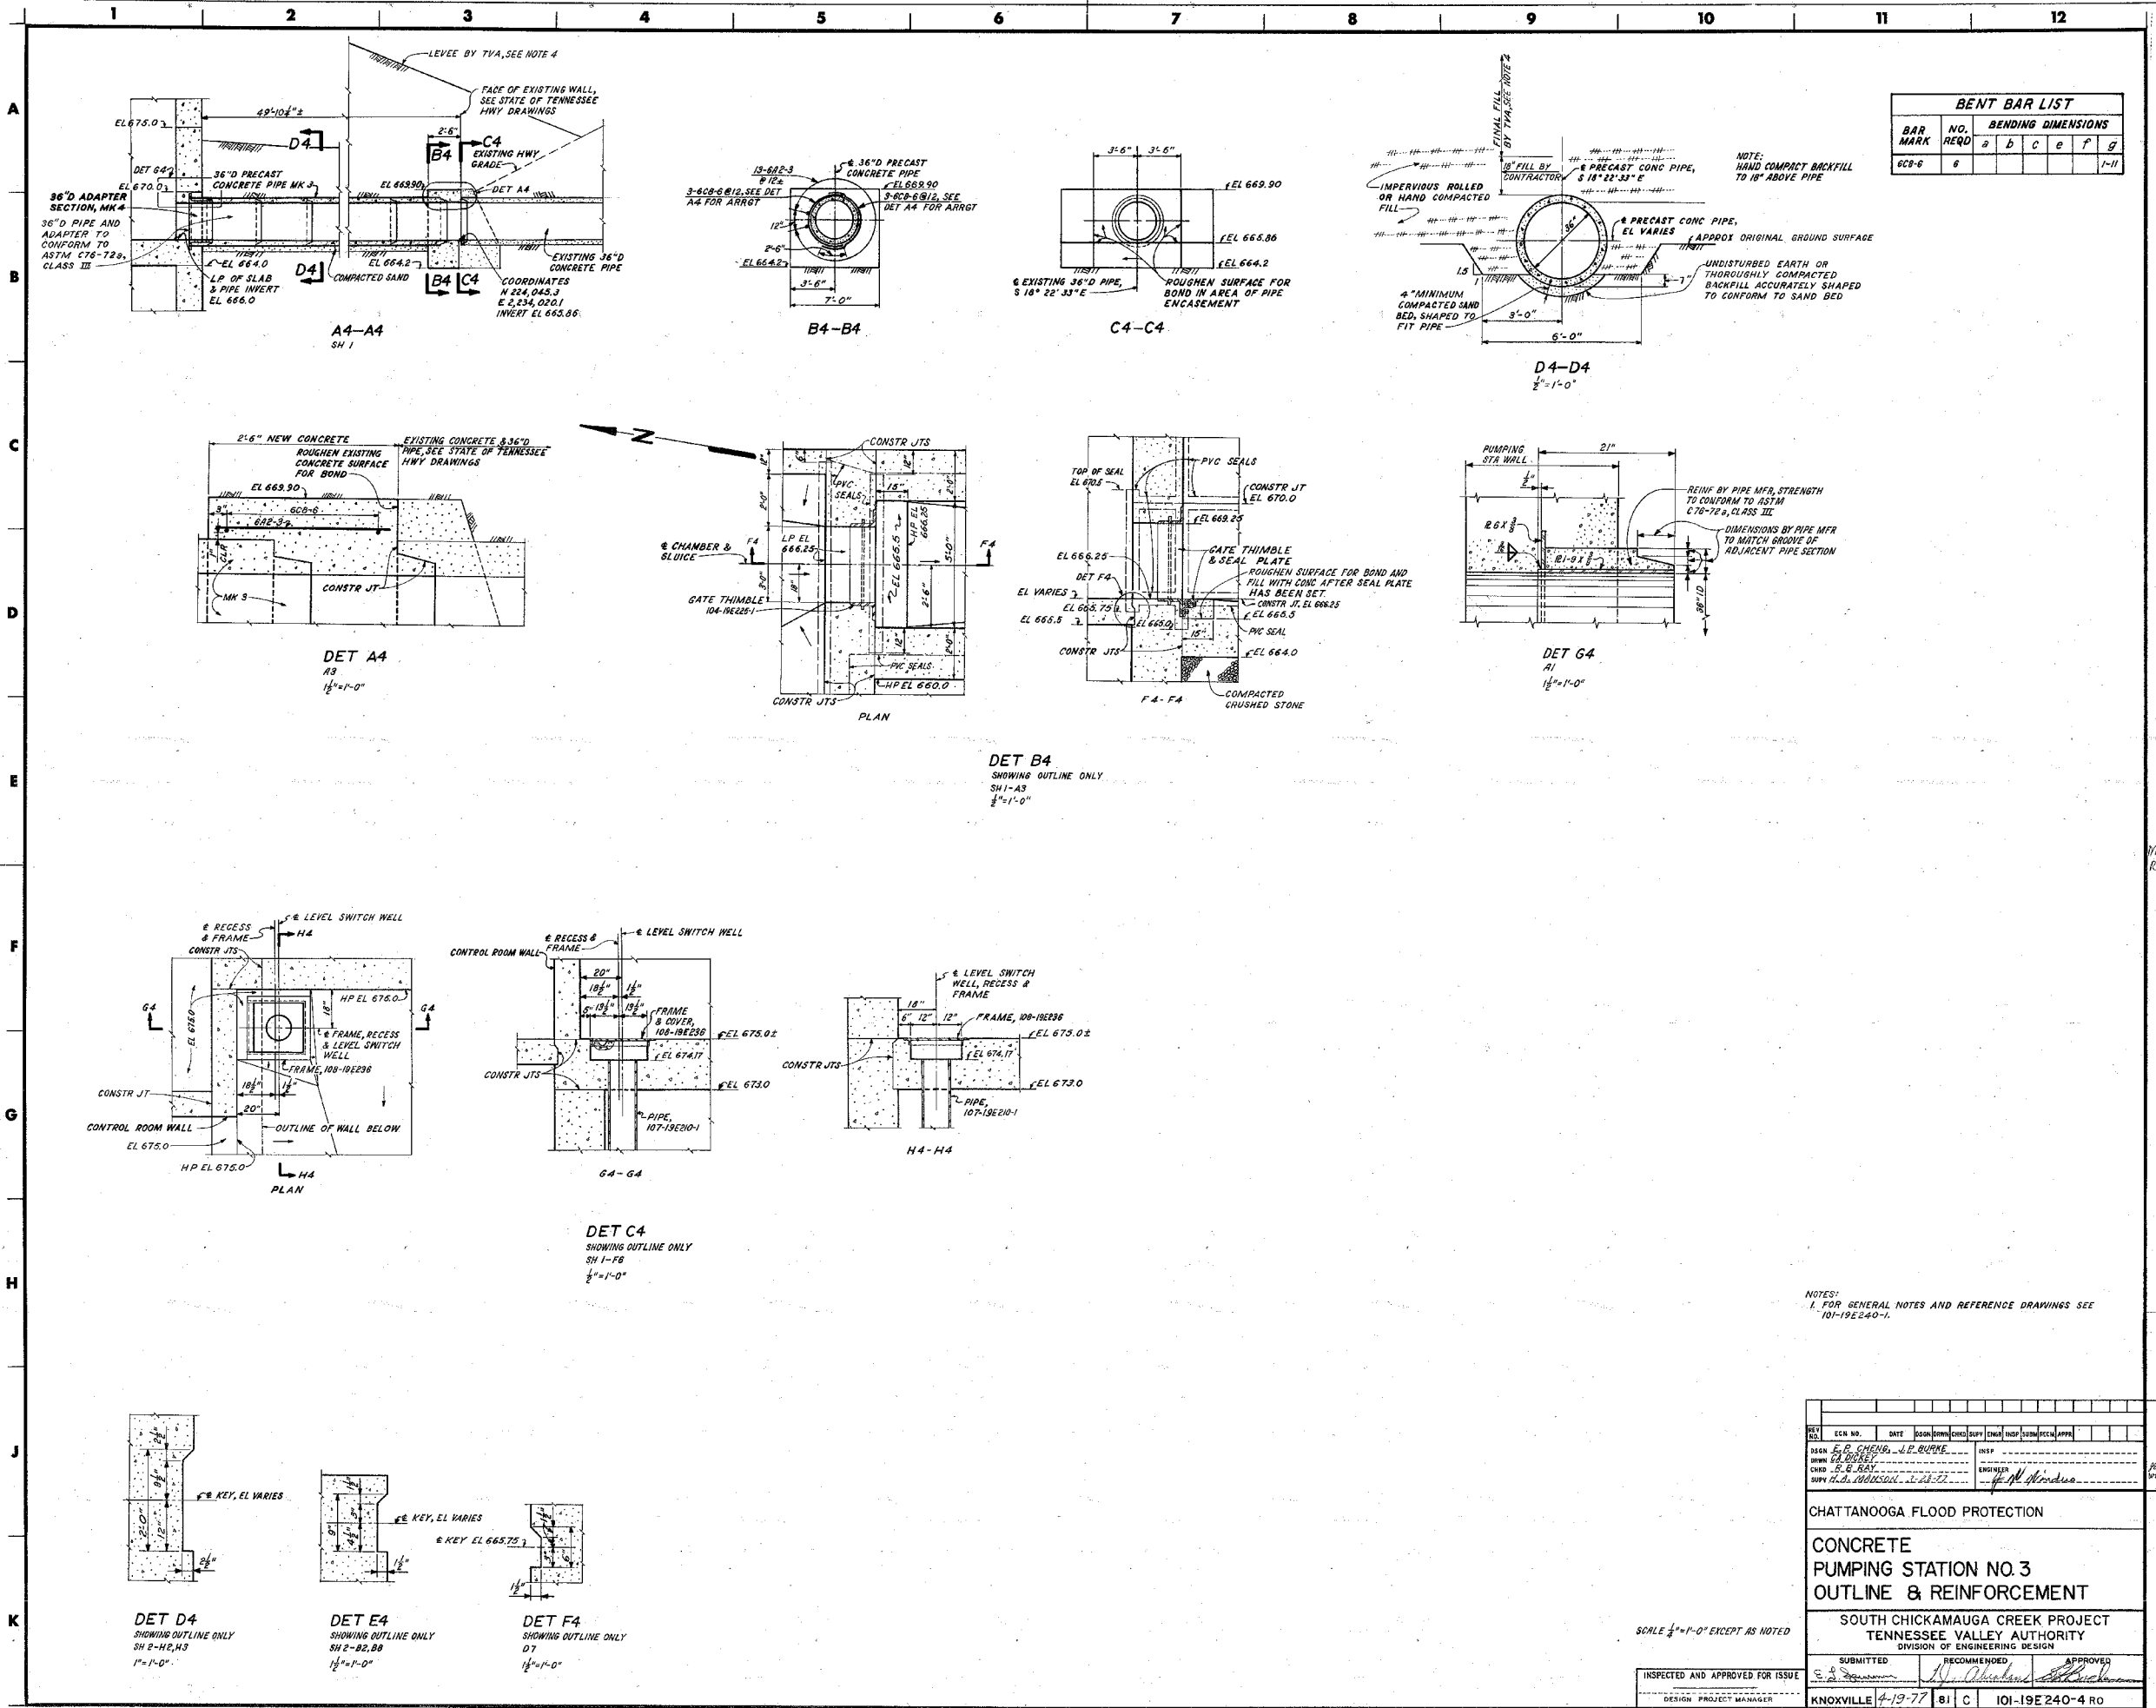

BENT BAR LIST							
BAR MARK	NO. REQD	BENDING DIMENSIONS					
		a	b	c	e	f	g
6C8-6	6						1-11

NOTE:  
HAND COMPACT BACKFILL TO 18" ABOVE PIPE

NOTE:  
IMPERVIOUS ROLLED OR HAND COMPACTED FILL

NOTE:  
PRECAST CONC PIPE, EL VARIES

NOTE:  
UNDISTURBED EARTH OR THOROUGHLY COMPACTED BACKFILL ACCURATELY SHAPED TO CONFORM TO SAND BED

NOTES:  
1. FOR GENERAL NOTES AND REFERENCE DRAWINGS SEE 101-19E240-1.

REV	DATE	BY	CHKD	APP'D	REASON
1	10/27/77	E.P. CHENG	J.P. BUCKE		
2					
3					

CHATTANOOGA FLOOD PROTECTION  
**CONCRETE PUMPING STATION NO. 3**  
**OUTLINE & REINFORCEMENT**  
 SOUTH CHICKAMAUGA CREEK PROJECT  
 TENNESSEE VALLEY AUTHORITY  
 DIVISION OF ENGINEERING DESIGN

SCALE 1/2" = 1'-0" EXCEPT AS NOTED


INSPECTED AND APPROVED FOR ISSUE	DESIGN PROJECT MANAGER	NOVEMBER 4-19-77	81 C	101-19E240-4 RO
----------------------------------	------------------------	------------------	------	-----------------

REVISIONS

A  
B  
C  
D  
E  
F  
G  
H  
J  
K




NOTE A:  
THE FIELD SHALL REPLACE ANY EXISTING PAVEMENT AND CURB DIVIDERS THAT ARE REMOVED FOR THE CONSTRUCTION OF THE NEW GULLY'S AND PUMPING STATION. THE NEW PAVEMENT AND DIVIDERS SHALL MATCH EXISTING MATERIAL IN QUALITY AND WORKMANSHIP.

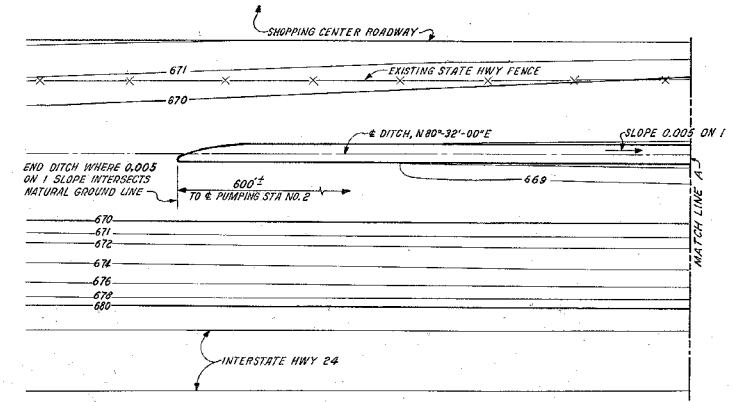


PLAN


- NOTES:
1. ALL CONCRETE SHALL BE PLACED IN ACCORDANCE WITH GENERAL CONSTRUCTION SPECIFICATION NO. 6-2. CONCRETE SHALL BE CLASS 300.75 AFW.
  2. FORMWORK SHALL BE IN ACCORDANCE WITH GENERAL CONSTRUCTION SPECIFICATION NO. 6-3. FORM LINING FOR EXPOSED CONCRETE SURFACES SHALL BE TYPE A OR TYPE D.
  3. CHAMFER ALL EXPOSED EXTERIOR EDGES  $\frac{3}{4}$ ".
  4. WELDING OF OR TO HIGH STRENGTH REINFORCING BARS WITHOUT APPROVAL OF CIVIL ENGINEERING AND DESIGN BRANCH IS PROHIBITED.
  5. ALL REINFORCEMENT ON THIS DRAWING SHALL CONFORM TO ASTM SPECIFICATION A615, GRADE 60.
  6. FOR ADDITIONAL NOTES SEE 101-19E205-1 & 2.

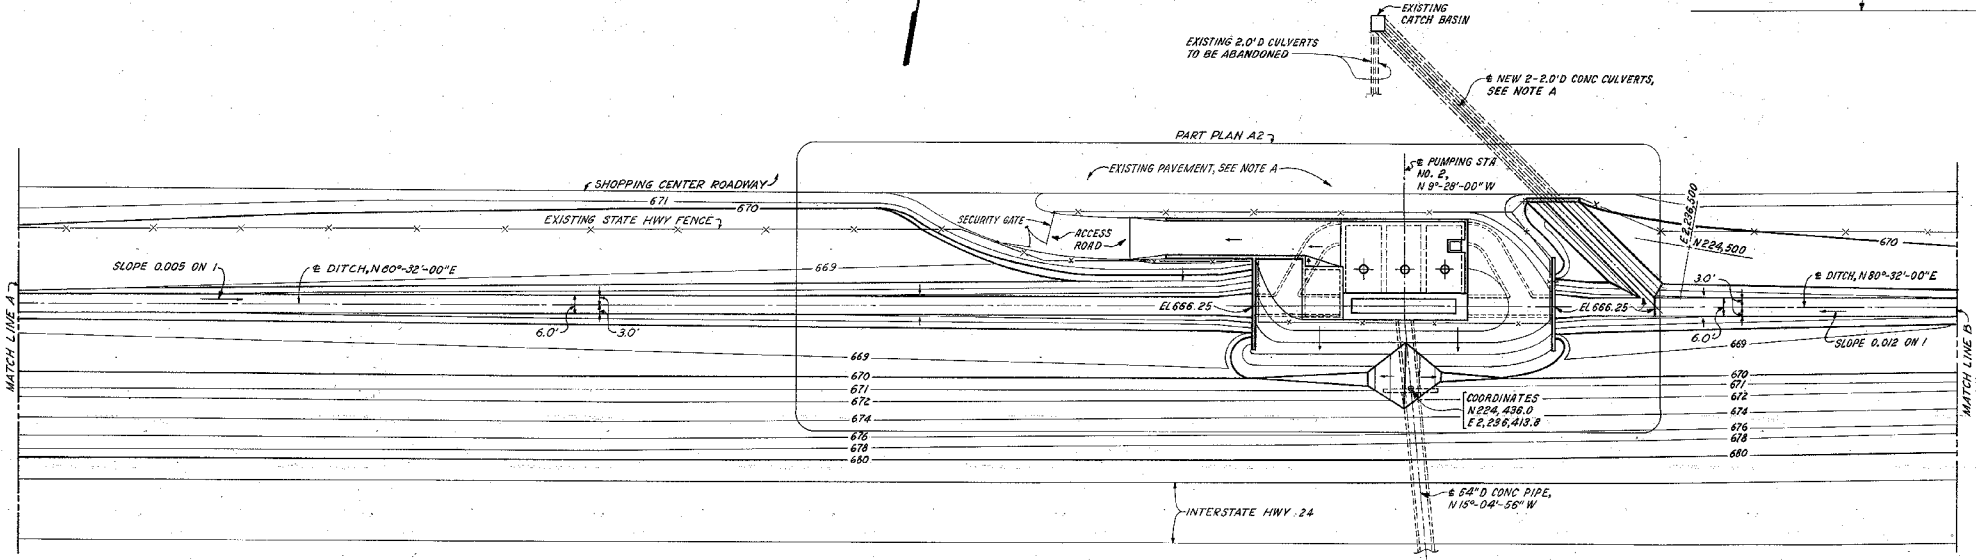

PLAN

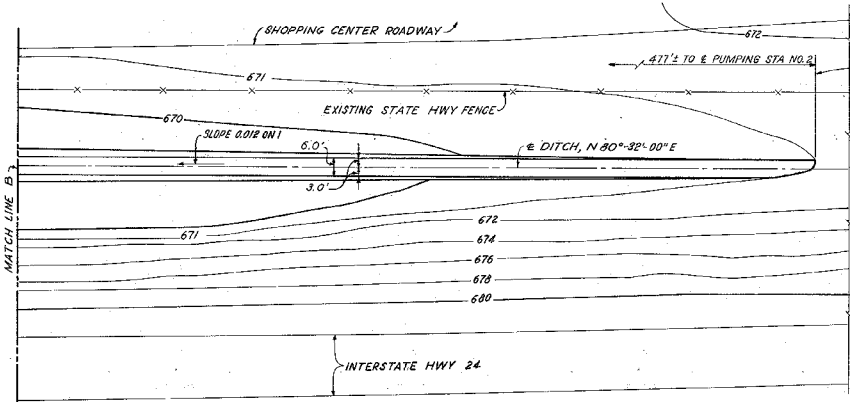

PLAN

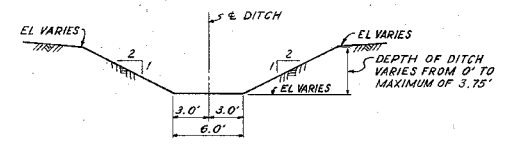


TYPICAL SECTION THRU DITCH  
1" = 5'

SCALE 1" = 20' EXCEPT AS NOTED  
COMPANION DRAWINGS:  
101-19E245-1 & 2

REV	NO.	ECN NO.	DATE	DESIGN	CHKD	ENGR	INSP	INSTR	APPR
055N									
DESIGNER: E.A. DICKEY			CHECKED: E.A. DICKEY			INSP: J.M. MANSON			APPR: J.M. MANSON
CHATTANOOGA FLOOD PROTECTION PUMPING STATION NO. 2									
FINAL GRADING AND DRAINAGE STRUCTURES PLAN & SECTIONS									
SOUTH CHICKAMAUGA CREEK PROJECT TENNESSEE VALLEY AUTHORITY DIVISION OF ENGINEERING DESIGN									
SUBMITTED: E.A. Dickey			RECOMMENDED: J.M. Manson			APPROVED: J.M. Manson			
DESIGN PROJECT MANAGER: E.A. Dickey			KNOXVILLE 3-31-78			BI C 101-19E245-1 RO			
PRINT: H 1/8 3			SIZE: F 3			RECORD DRAWING AS CONSTRUCTED: J.M. Manson 11/27/81 RO			





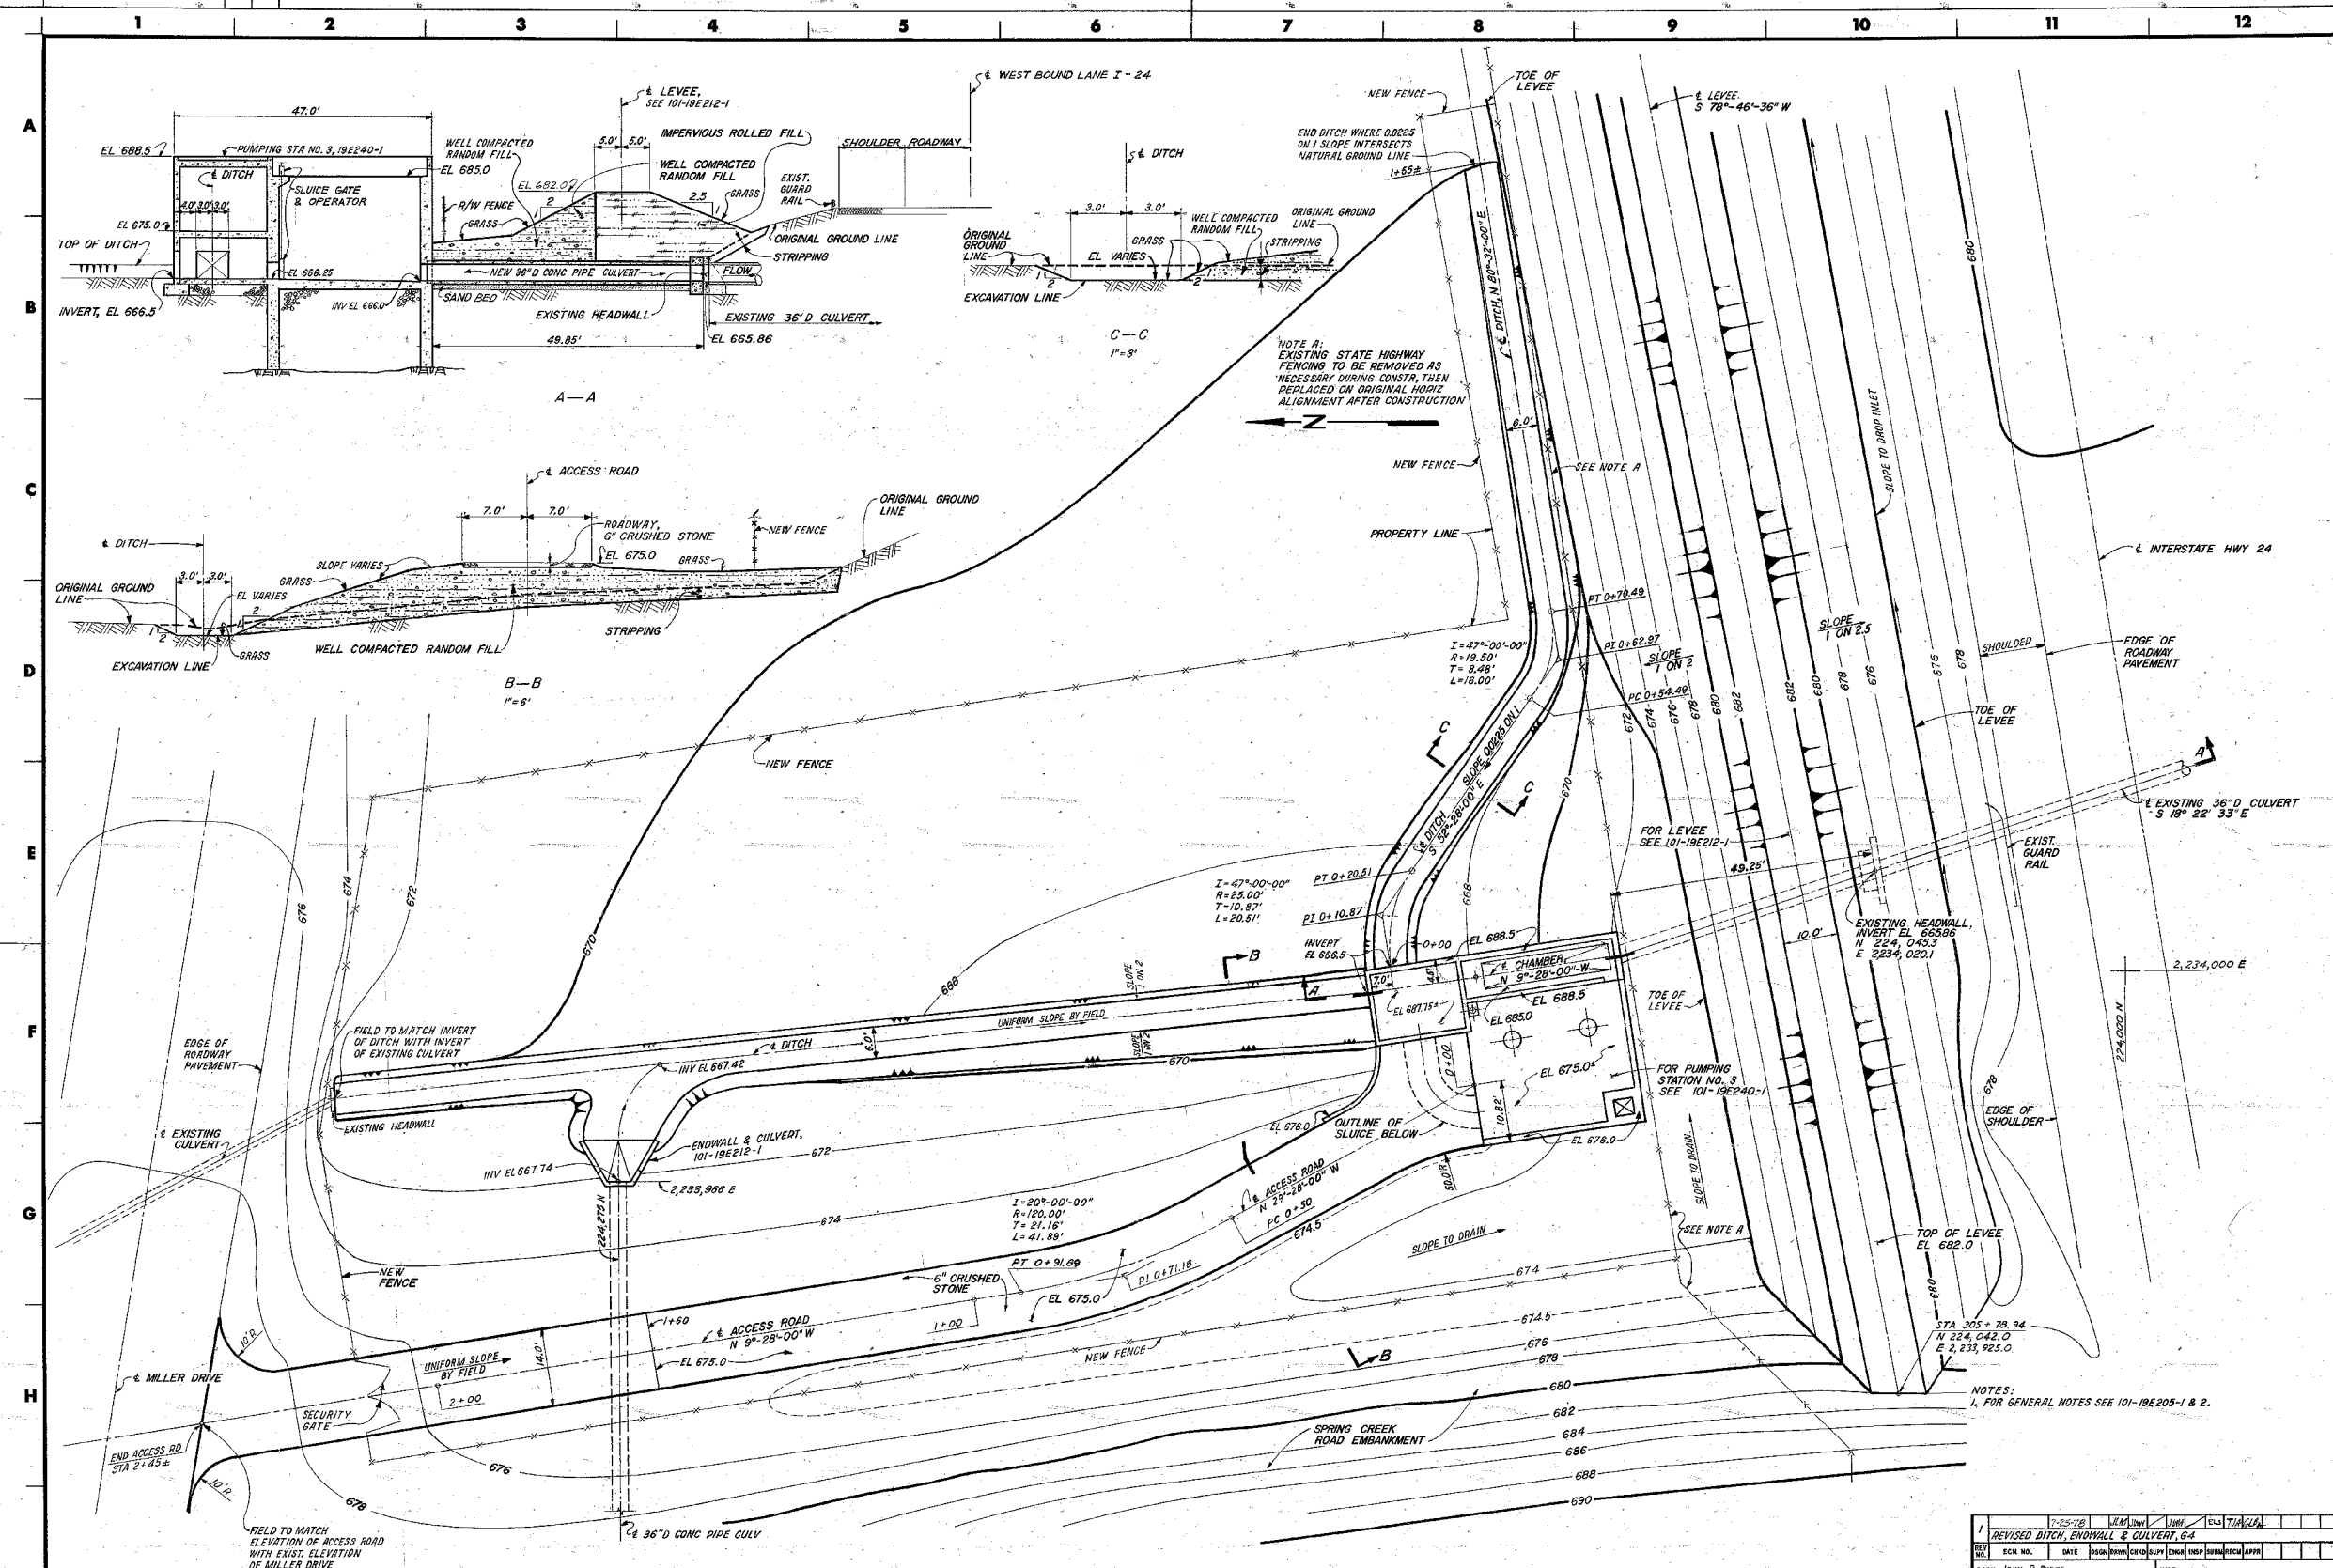

PLAN

1	REVISED DITCH, ENDWALL & CULVERT, C4	DATE	BY	CHECKED	DATE	BY	CHECKED
2							
3							
4							
5							
6							
7							
8							
9							
10							
11							
12							

CHATTANOOGA FLOOD PROTECTION  
PUMPING STATION NO. 3

**FINAL GRADING  
PLAN & SECTIONS**

SOUTH CHICKAMAUGA CREEK PROJECT  
TENNESSEE VALLEY AUTHORITY  
DIVISION OF ENGINEERING DESIGN

INSPECTED AND APPROVED FOR ISSUE	RECOMMENDED	APPROVED
<i>[Signature]</i>	<i>[Signature]</i>	<i>[Signature]</i>
KNOXVILLE	6-7-78	101-19E246 RI

SCALE 1"=10' EXCEPT AS NOTED

PRINT	IN	2	7
SIZE	F		
BY OR PROJ	BY	DATE	BY
PRINTED	REVISION	DATE	BY

CONCRETE	CURB
LOCATION	ITEM NO. 390 LIN. FT.
10+30-2+42.57 R	1142.57
10+30-14+29.52 L	407.42
14+51.52-17+25.20 L	352.22
17+47.20-22+11.13 L	478.20
BONNIEWAY DRIVE	369.00
MARIA AVENUE	174.00
TOTAL	2923.41 *

LENGTH OF PROJECT	
END OF PROJECT	22+11.13
BEGINNING OF PROJECT	10+00
NET LENGTH IN FEET	1,211.13'
NET LENGTH IN MILES	0.23
BONNIEWAY DR. EXTENSION	209.50'
MARIA AVE. EXTENSION	112'

ITEM NO.	SURFACING				
	225 STAB CR STONE BASE 10" TONS	302 BIT PRIME COAT TONS	308 CR STONE BIT CONC. BASE-2" TONS	308b TACK COAT TONS	346 ASPHALTIC CONC SURF 1" TONS
LOCATION					
10+00-22+11.13	3995	10	760	3.00	380
BONNIEWAY DR.	(400)	.90	(75)	0.25	(40)
MARIA AVENUE	(215)	0.5	(45)	0.15	(25)
PVT DRIVEWAYS	(150)	0.60	(45)	0.20	(25)
TOTAL	(4,760)	12.0	(925)	3.60	(470)

INDEX TO DRAWINGS	
TITLE	SHEET NO.
SUMMARY OF QUANTITIES	250
GRADING & PAVING-TYPICAL SECTION & DETAILS	251
PLAN	252
PROFILE AND GRADING PLAN	253
FINISHED PAVEMENT PROFILES	254-1 - 254-2
DRAINAGE PROFILES & TURNING RADIUS PROFILES	255
STANDARD CATCH BASIN *	256-1
CATCH BASIN & GRATE	256-2
CONC. ENDWALLS & INLETS FOR PIPE CULVERTS	256-3
TRAFFIC CONTROL DEVICES, PAVEMENT STRIPING, AND DROP CURB DETAILS	257
CROSS SECTIONS	258-1 - 258-5

GRADING		
ITEM NO.	120 UNCLASS EXCAV. CU YDS	123 EARTH BOR EXCAV CU YDS
STATION TO STATION		
10+30-22+11.13	893	7,374
BONNIEWAY DRIVE	0	455
MARIA AVENUE	0	409
12+50-17+50 L	0	4,798
TOTAL	893	13,536

DRAINAGE STRUCTURES										
ITEM NO.	LOCATION	TYPE	602 PIPE LIN. FT.			CONC. CU YDS	REINF STEEL LBS	CAST IRON LBS	CITY STD CATCH BASIN-EA	129 STR EXCAV CU YDS
			12"	15"	18"					
19+20 R N. MOORE RD (1)		CB	100'						30	
18+20 R N. MOORE RD (2)		CB		56'					35	
18+20 L N. MOORE RD (3)		CB		115'					50	
4+09.91 R MARIA AVE (4)		CB		216'					80	
FIELD ENTRANCE (5)		CB-TVA37			2.16		(430)		20	
3+37.97 L BONNIEWAY DR (6)		CB		85'					5	
3+37.97 R BONNIEWAY DR (7)		CB		22'					105	
NW CORNER C.W. WEST R (JB)				(165)	2.00	(130)			20	
HEAD OF DITCH		ENDWALL TVA-4		(65)	0.90	20			15	
10+60 R N MOORE RD (9)		CB	45'						10	
10+60 L N MOORE RD (10)		CB	32'						40	
EXIST CB SHALLOWFORD RD (11)									86'	
EXIST CB 2+52 R BONNIEWAY DR (12)									40	
3+37.97 R BONNIEWAY DR (7)									40	
TOTAL			263	387	(337)	(5.06)	(150)	(860)	8	410

\* CITY OF CHATTANOOGA

GRASSING			
ITEM NO.	180 SEEDING SQ. YDS.	182 MULCHING SQ. YDS.	183 SODDING SQ. FT.
LOCATION			
BONNIEWAY			1240
10+30-22+11.13 R	1925	1925	730
MARIA			730
12+50-17+50 L	16,127	16,127	
10+30-22+11.13 R & L			7170
TOTAL	18,052	18,052	9140

REMOVAL OF STRUCTURES & PAVEMENT			
ITEM NO.	110	134	
LOCATION	REMOVAL OF STR	REMOVAL PAVEMENT SQ YDS	
80' L STA 18+00			CATCH BASIN
110' L STA 16+00			CATCH BASIN
190' L STA 15+00			CATCH BASIN
EXT. N. MOORE RD. LEVEE TO STA 22+11.13		4600	REMOVAL OF PAVEMENT
EXT. N. MOORE RD LEVEE TO STA 22+11.13	2000'		REMOVAL OF EXIST. CURB & GUTTER

TRAFFIC SIGNS			
LOCATION	DESCRIPTION	UNIT	QUANTITY
4+40 R BONNIEWAY	STOP SIGN (R1-1) *	EACH	1
4+45 R MARIA	STOP SIGN (R1-1) *	EACH	1
12+50 L N MOORE ROAD	SIGNAL AH (W3-3)	EACH	1
15+00 L N MOORE ROAD	RIGHT LANE MUST TURN RIGHT (R3-7)	EACH	1
18+00 L N MOORE ROAD	RIGHT LANE MUST TURN RIGHT (R3-7)	EACH	1

DROP CURB ENTRANCE		
ITEM NO.	395 CONC SIDEWALK SQ. YDS.	
LOCATION	PVT DRIVE WIDTH, FT	
19+23L N MOORE ROAD	16'	12.5
20+95L N MOORE ROAD	18'	13.5
2+98L BONNIEWAY DRIVE	14'	11.5
3+86.64R BONNIEWAY DRIVE	14'	11.5
3+85 R MARIA AVENUE	16'	12.5
TOTAL		61.5

\* REFERS TO MANUAL ON UNIFORM TRAFFIC CONTROL DEVICES

DESIGN	H. L. PETTY	INSPECTOR	J. R. ...
DRAWN	J. R. ...	ENGINEER	E. B. Logan
CHECKED	J. R. ...		
SUPV	J. R. ...		

NORTH MOORE ROAD RELOCATION


SUMMARY OF QUANTITIES

SOUTH CHICKAMAUGA CREEK PROJECT  
TENNESSEE VALLEY AUTHORITY  
DIVISION OF ENGINEERING DESIGN

SUBMITTED	RECOMMENDED	APPROVED
Robert J. ...	J. D. ...	J. R. ...
KNOXVILLE	12-4-78	81 HR 101-19H250 RI


MT  
 20  
 RI



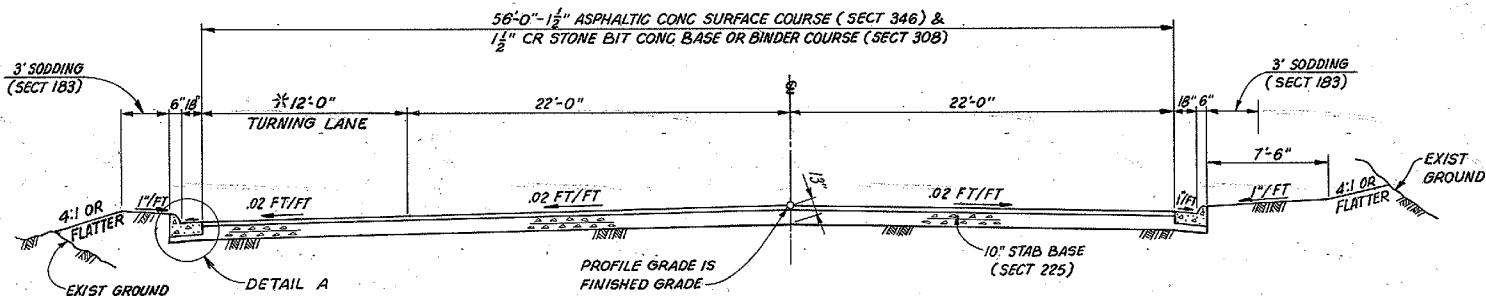


TANGENT SECTION


\* VARIES FROM 0'-0" TO 12'-0"

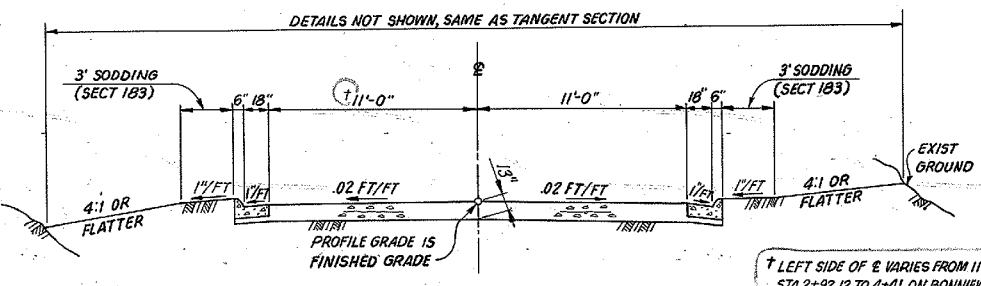


MARTA AVE & BONNIEWAY DR  
NTS

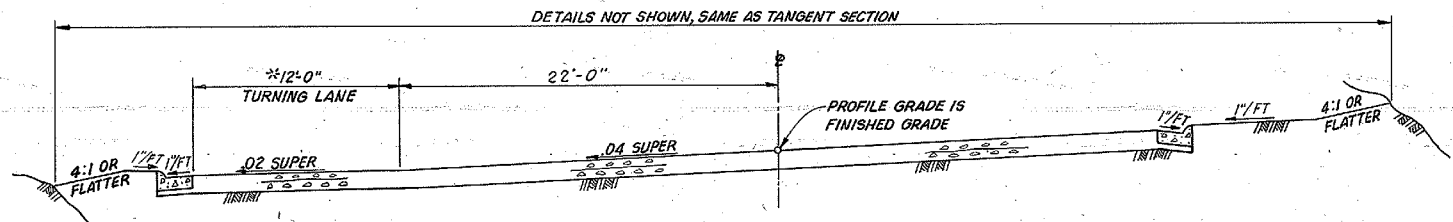


SUPERELEVATED SECTION (L)

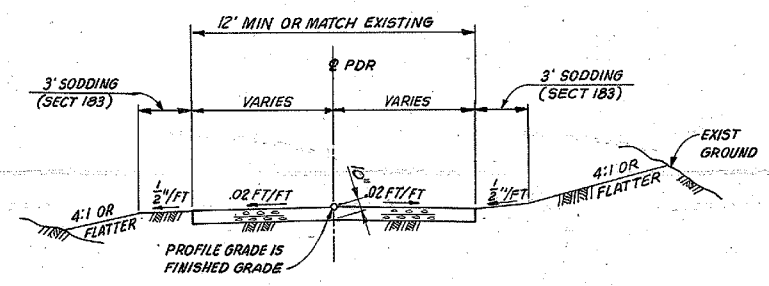


PRIVATE DRIVE  
NTS

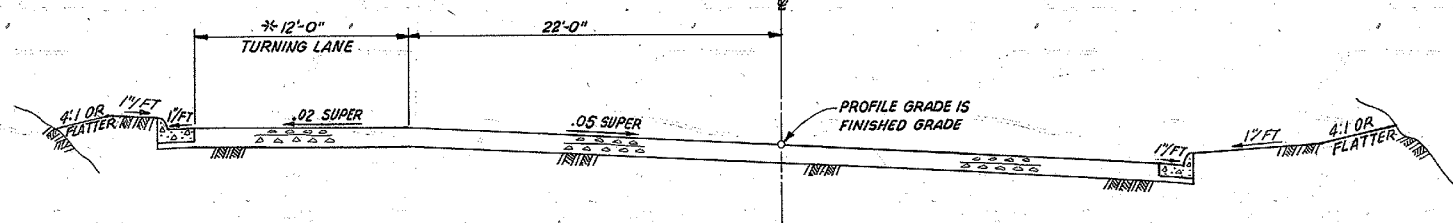


SUPERELEVATED SECTION (R)

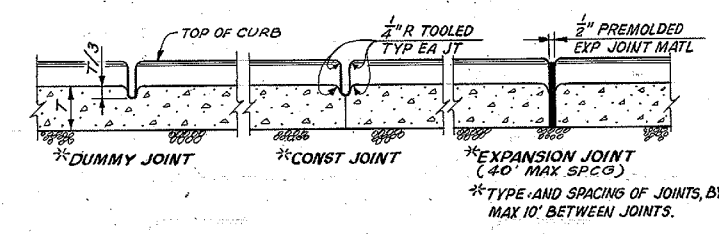


CURB & GUTTER JOINT DETAIL  
NTS

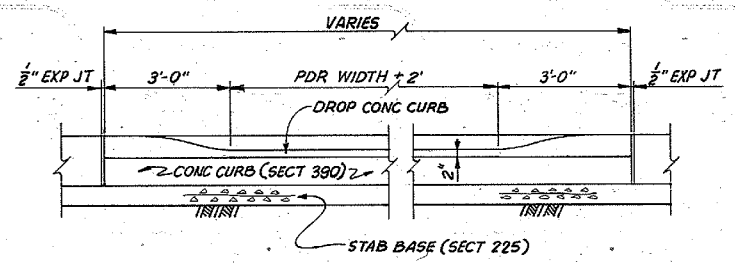

PRIVATE DR, SIDEWALK, CURB & GUTTER DETAILS  
NTS

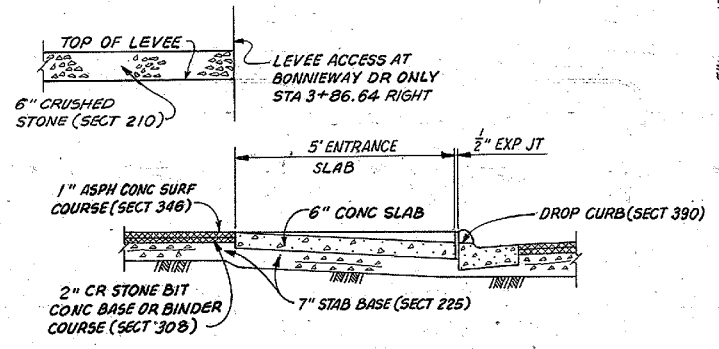

SECTION

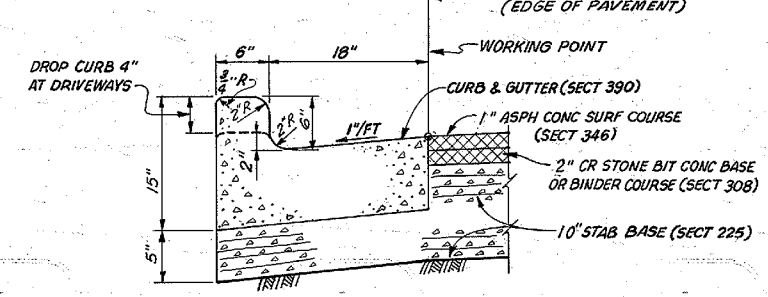


DETAIL A  
PAVEMENT, CURB & GUTTER  
NTS

SCALE: 1" = 5'-0"  
EXCEPT AS NOTED

NOTES:  
1. FOR NOTES & REFERENCE DWGS SEE 101-19H252.

101-19H252		REVISED BONNIEWAY DR; ADDED LEFT TURN LANE	
REV. NO.	DATE	DESIGN	CHKD
1		H. L. PETTY	J. R. SOK
2		V. B. LEE	
3		W. H. LEE	
4		W. H. LEE	
5		W. H. LEE	
6		W. H. LEE	
NORTH MOORE ROAD RELOCATION		GRADING & PAVING-TYPICAL SECTIONS & DETAILS	
SOUTH CHICKAMAUGA CREEK PROJECT TENNESSEE VALLEY AUTHORITY DIVISION OF ENGINEERING DESIGN			
INSPECTED AND APPROVED FOR ISSUE	APPROVED	APPROVED	
Robert J. Bowman	Robert J. Bowman	Robert J. Bowman	
KNOXVILLE	12-4-78	81 HR	101-19H251 RI
RECORD DRAWING AS CONSTRUCTED			

- NOTES:
1. ALL WORK SHALL BE IN ACCORDANCE WITH HIGHWAY SPECIFICATION T-1, EXCEPT AS NOTED.
  2. GRASSING - SEEDING OF HIGHWAY SHOULDERS AND DITCH LINES SHALL BE TYPE 6a MIXTURE FOR SPRING SEEDING AND TYPE 8 MIXTURE FOR FALL SEEDING. SEEDING OF CUT AND FILL SLOPES AND OTHER DISTURBED AREAS SHALL BE TYPE 6e MIXTURE FOR SPRING SEEDING AND TYPE 8 MIXTURE FOR FALL SEEDING. IF TEMPORARY COVER IS NEEDED BEFORE SEEDING DATES USE TYPE 9 MIXTURE FOR WINTER SEEDING AND TYPE 10a MIXTURE FOR SUMMER SEEDING. ALL SEEDED AREAS SHALL BE LIMED, FERTILIZED, AND MULCHED IN ACCORDANCE WITH SECTIONS 180 AND 182 RESPECTIVELY.
  3. EARTH EMBANKMENTS SHALL BE CONSTRUCTED IN LAYERS APPROXIMATELY 6" THICK AND SHALL BE COMPACTED TO 95% OR MORE OF OPTIMUM DENSITY IN ACCORDANCE WITH SPECIFICATIONS SECTION 120.11. FOUNDATION PREPARATION FOR ALL EMBANKMENTS SHALL CONSIST OF REMOVAL OF ALL ORGANIC TOPSOIL TO A DEPTH THAT WILL REMOVE ALL ROOTS, AND EXCAVATION TO A DEPTH THAT WILL ASSURE A FOUNDATION THAT WILL SUPPORT HEAVY EARTHMOVING EQUIPMENT WITHOUT RUTTING INTO THE GROUND AND WITHOUT LATERAL HEAVING OF THE GROUND.
  4. EXCAVATION AND BACKFILL FOR PIPE CULVERTS SHALL CONFORM TO SECTION 125.
  5. EXISTING PAVEMENT, CURB AND GUTTER, CATCH BASINS AND PIPES WHICH ARE TO BE ABANDONED SHALL BE REMOVED AND SATISFACTORILY DISPOSED OF AND THE AREA GRADED TO DRAIN AND GRASSED. IN LIEU OF REMOVAL, ABANDONED PIPES MAY BE LEFT IN PLACE AND PLUGGED TO PREVENT UNDERGROUND SEEPAGE.
  6. REMOVAL OF EXISTING PAVEMENT SHALL CONFORM TO SECTION 134. REMOVAL OF EXISTING CATCH BASINS AND CURB & GUTTER SECTIONS SHALL CONFORM TO SECTION 110.
  7. FOR TRAFFIC SIGNS AND PAVEMENT MARKING DETAILS SEE DRAWING 101-19H257.
  8. FOR LEVEE AND DITCH DETAILS SEE DRAWING 101-19E205-1.
  9. THE PRIVATE ENTRANCE INTO THE CHURCH PROPERTY ON THE RIGHT IS NOT TO BE DISTURBED. NEW CURB AND GUTTER CONSTRUCTION SHALL END AT STATION 21+42.57.

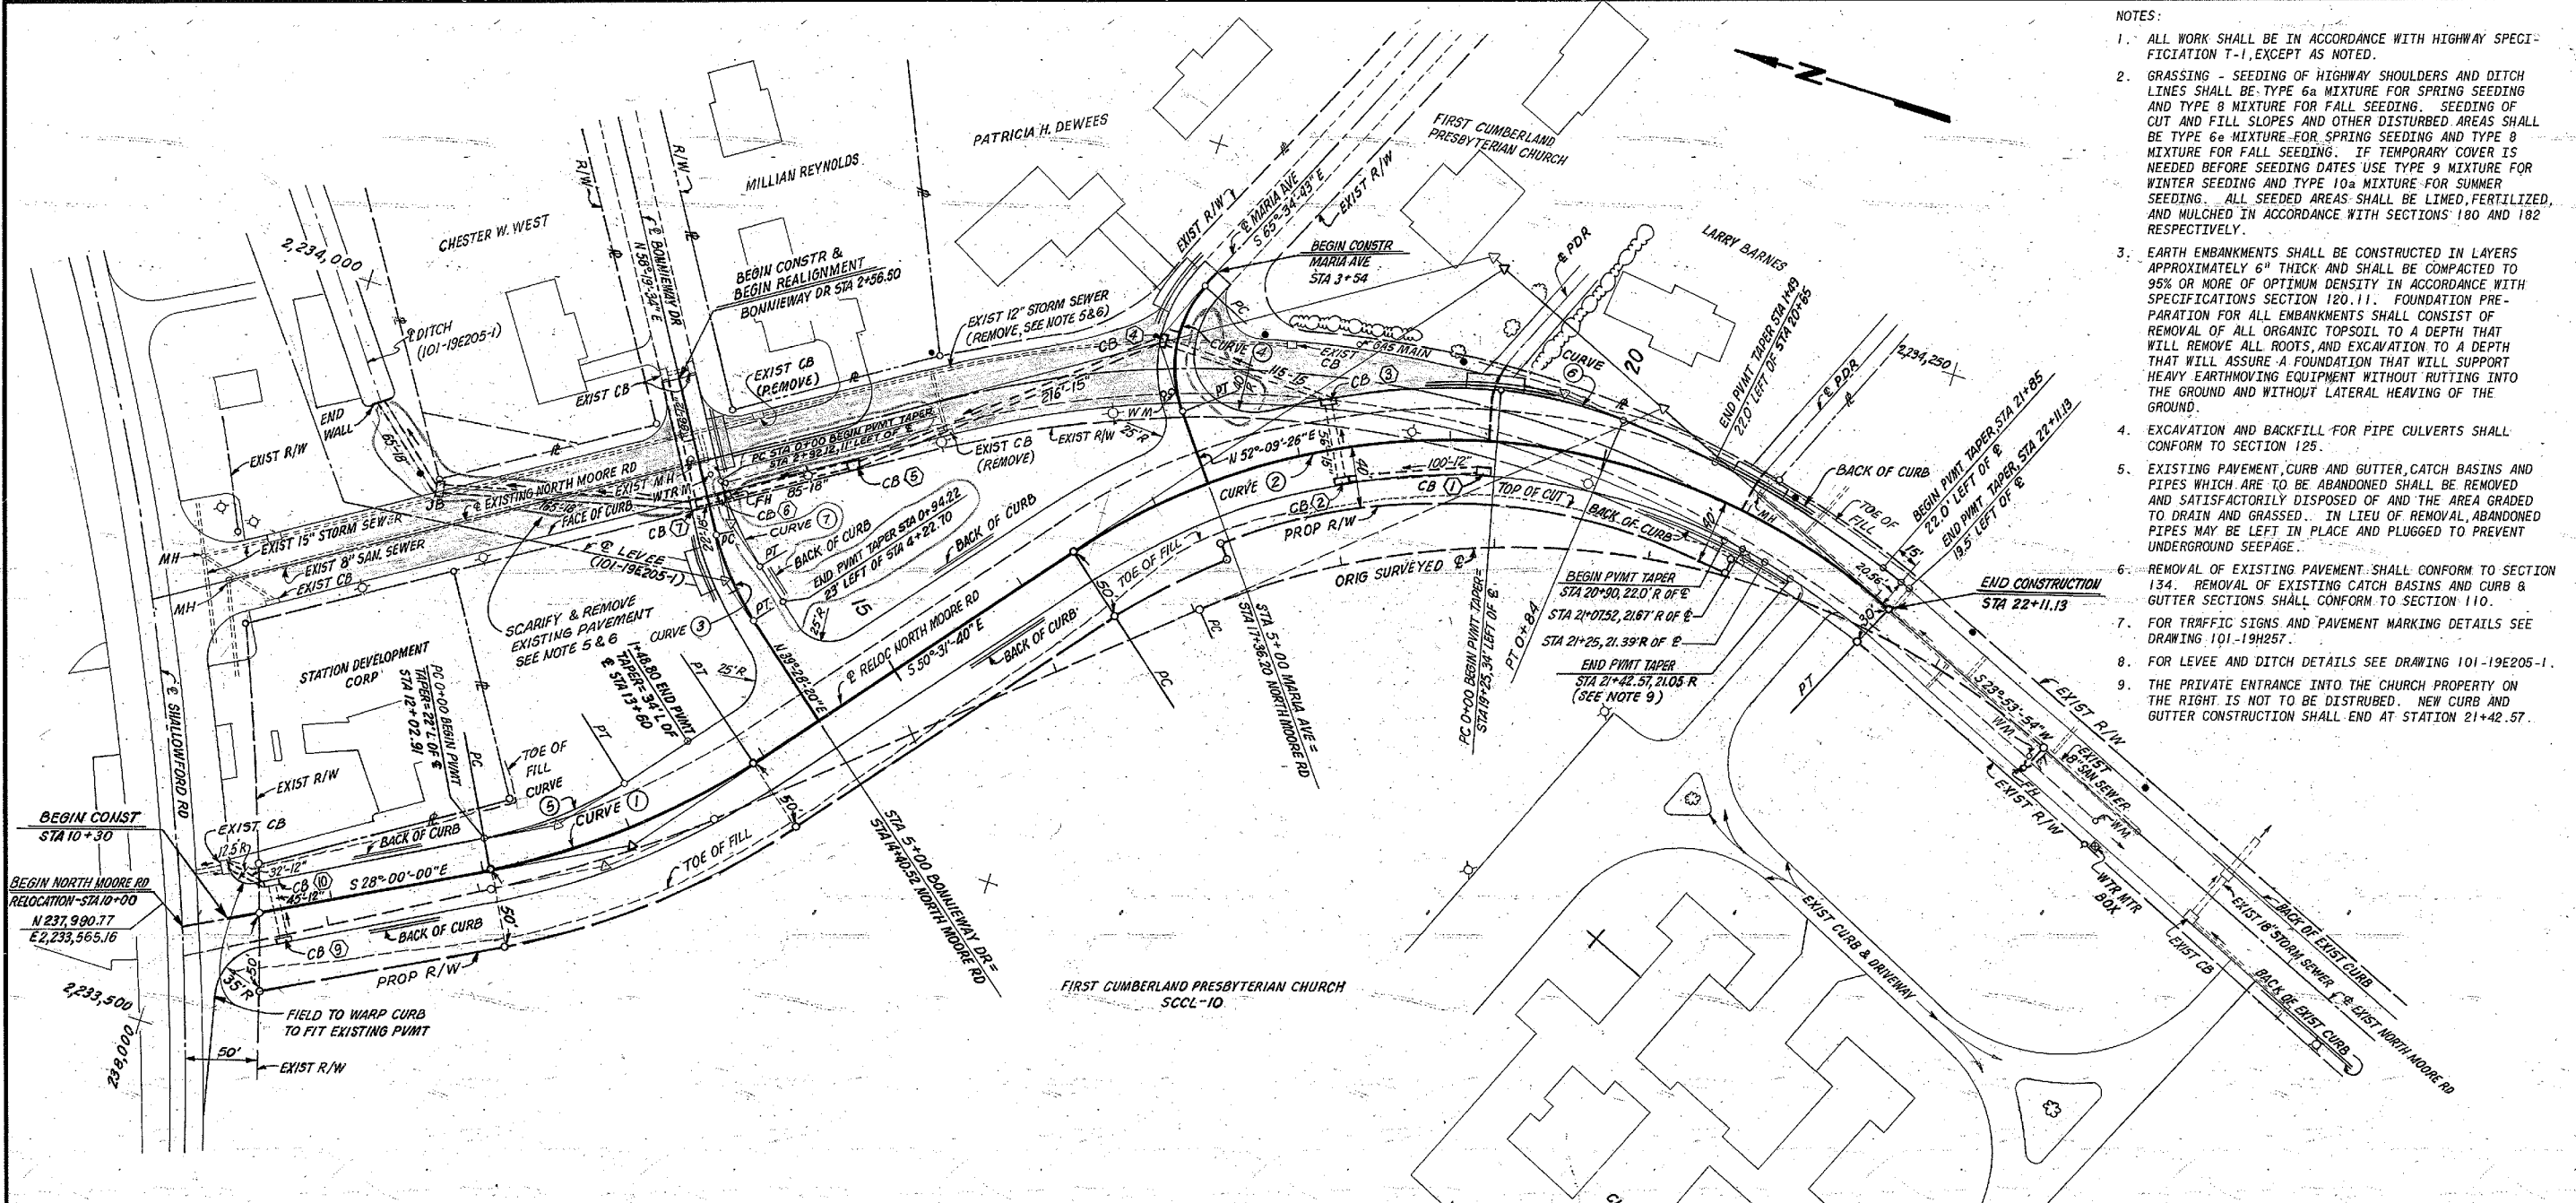

CURVE DATA

Curve No.	Station	PI	N	E	PC	PT	Δ	D	R	T	L
1	12+98.00	12+98.00	237,727.65	2,233,705.06	12+02.91	13+90.64	22°-31'-40"	12°-00'-00"	47.74'	95.09'	187.73'
2	19+73.32	19+73.32	237,296.79	2,234,228.25	16+38.62	22+11.13	74°-25'-34"	13°-00'-00"	440.74'	334.70'	572.51'
3	3+92.54	3+92.54	237,718.88	2,233,885.64	3+61.82	4+22.70	18°-51'-14"	30°-58'-14"	185.0'	30.72'	60.88'
4	4+10.19	4+10.19	237,500.73	2,234,116.38	3+61.87	4+48.81	62°-15'-51"	71°-37'-11"	80.0'	48.32'	86.94'
5	0+50	0+50	237,727.65	2,233,705.06	0+00	0+98.88	20°-59'-35"	21°-13'-52"	269.87'	50.0'	98.88'
6	0+42.5	0+42.5	237,237.15	2,234,161.55	0+00	84+00	19°-00'-37"	22°-34'-19"	253.83'	42.5'	84.22'
7	0+30.72	0+30.72	237,729.99	2,233,924.59	0+00	0+60.88	18°-51'-14"	30°-58'-13"	185.0'	30.72'	60.88'

SCALE 1"=50'

REV	NO.	DATE	BY	CHKD	APPD


DESIGN: H.L. PETTY  
 CHECKED: J. R. LEE  
 SURVEY: W.M. HARRIS  
 ENGINEER: E. B. Logan

NORTH MOORE ROAD RELOCATION


PLAN

SOUTH CHICKAMAUGA CR PROJECT  
 TENNESSEE VALLEY AUTHORITY  
 DIVISION OF ENGINEERING DESIGN


INSPECTED AND APPROVED FOR ISSUE: [Signature]  
 KNOXVILLE 12-4-78 81 HR 101-19H252 RI

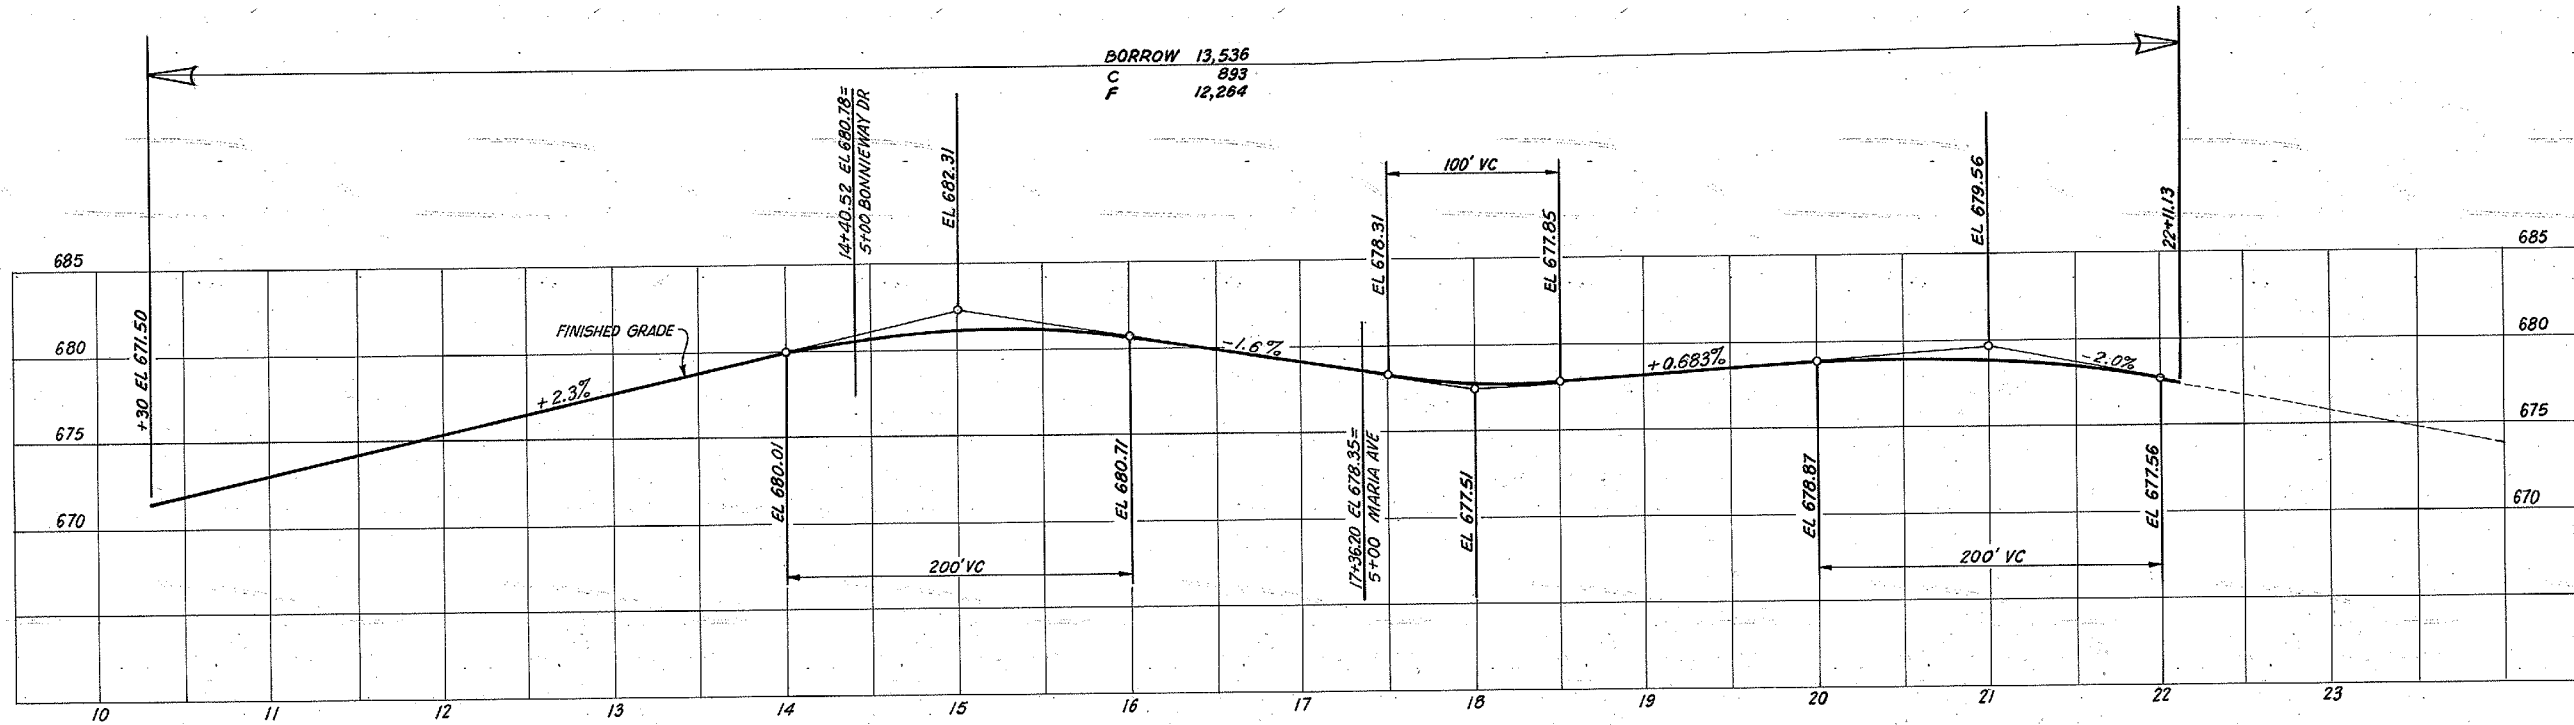


PROFILE-NORTH MOORE RD

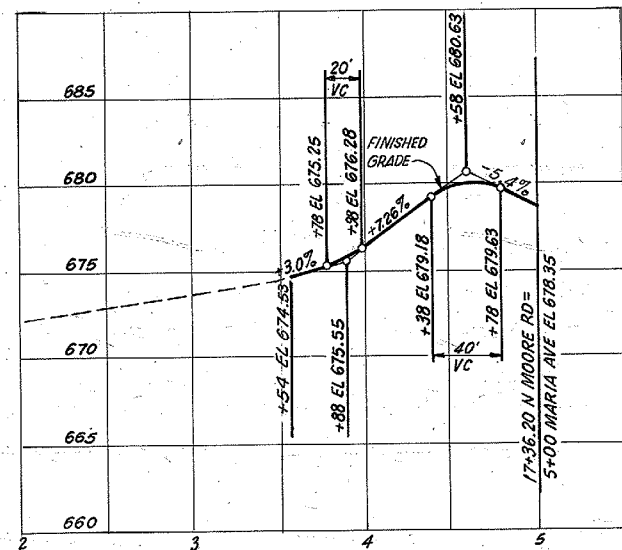

PROFILE-MARIA AVE

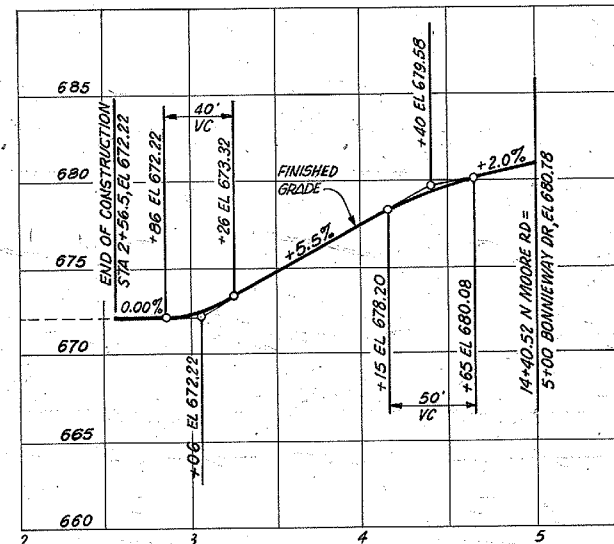

PROFILE-BONNEWAY DR


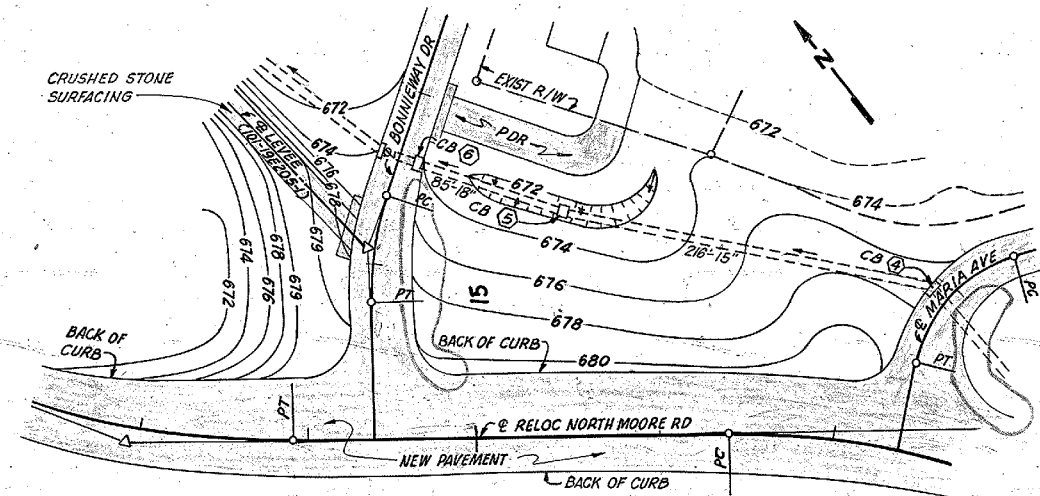


PLAN-GRADING  
SCALE: 1"=50'

NOTES:  
1. CONTOURS: DASHED CONTOURS REPRESENT EXISTING GROUND, SOLID CONTOURS REPRESENT FINISHED GRADING.  
2. FOR ADDITIONAL NOTES AND REFERENCE DRAWINGS SEE 101-19H252.

SCALE: 1"=5' VERT  
1"=50' HORIZ  
EXCEPT AS NOTED




REVISED INTERSECTIONS AT BONNEWAY AND MARIA	
REV. NO.	DATE
DESIGN	HL PETTY
DRAWN	V.R. LEE
CHECKED	W.M. GASTON
SUPV.	E. P. Logan
NORTH MOORE ROAD RELOCATION	
PROFILES & GRADING PLAN	
SOUTH CHICKAMAUGA CREEK PROJECT TENNESSEE VALLEY AUTHORITY DIVISION OF ENGINEERING DESIGN	
SUBMITTED	RECOMMENDED
INSPECTED AND APPROVED FOR ISSUE	APPROVED
KNOXVILLE	12-4-78
81 HR	101-19H253 RI

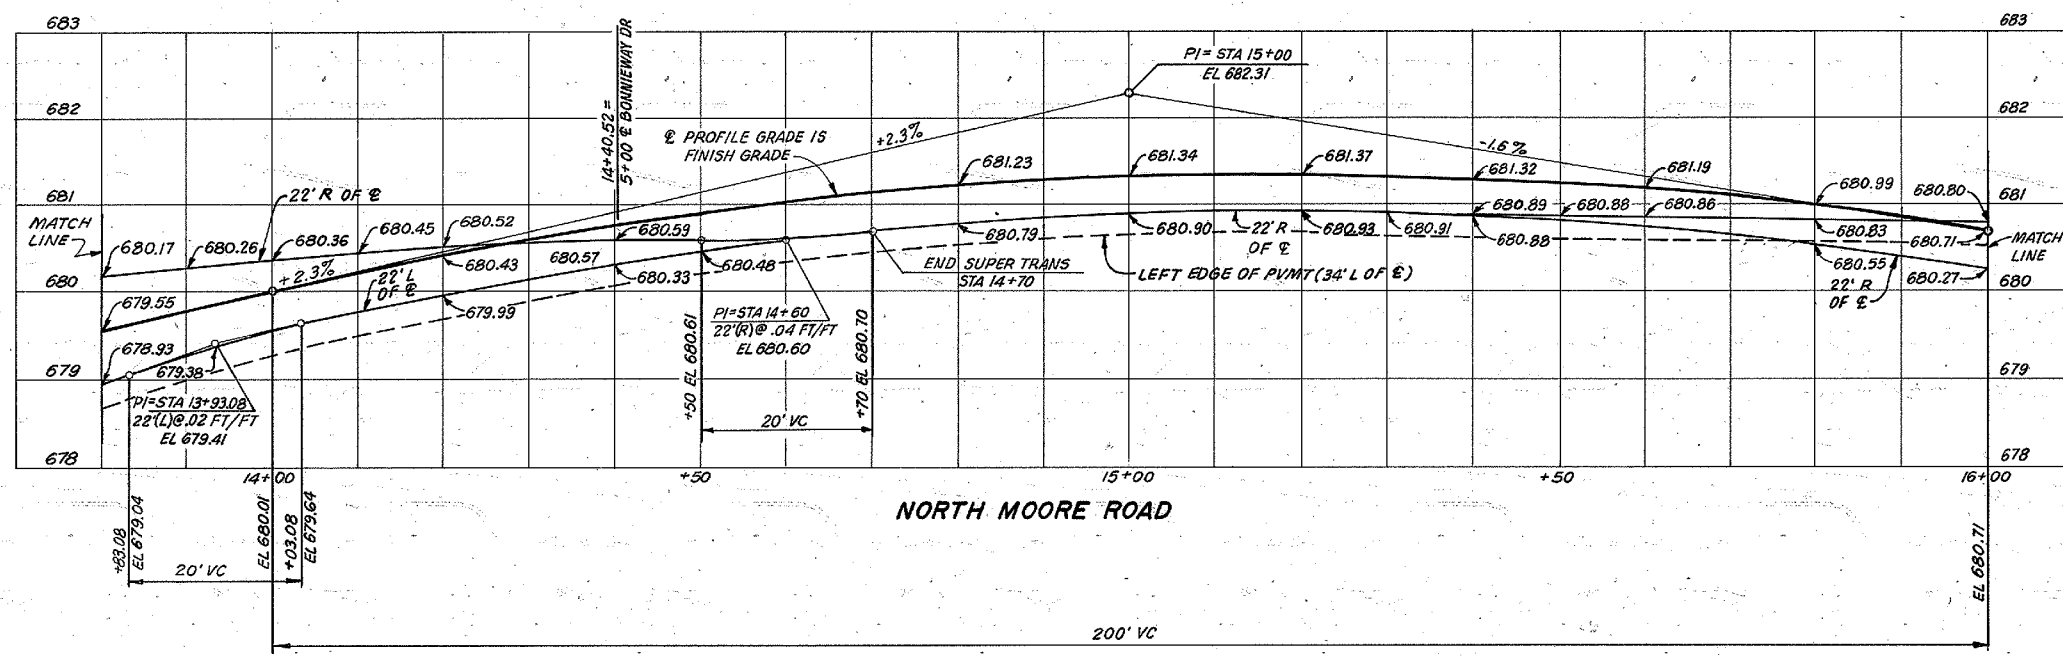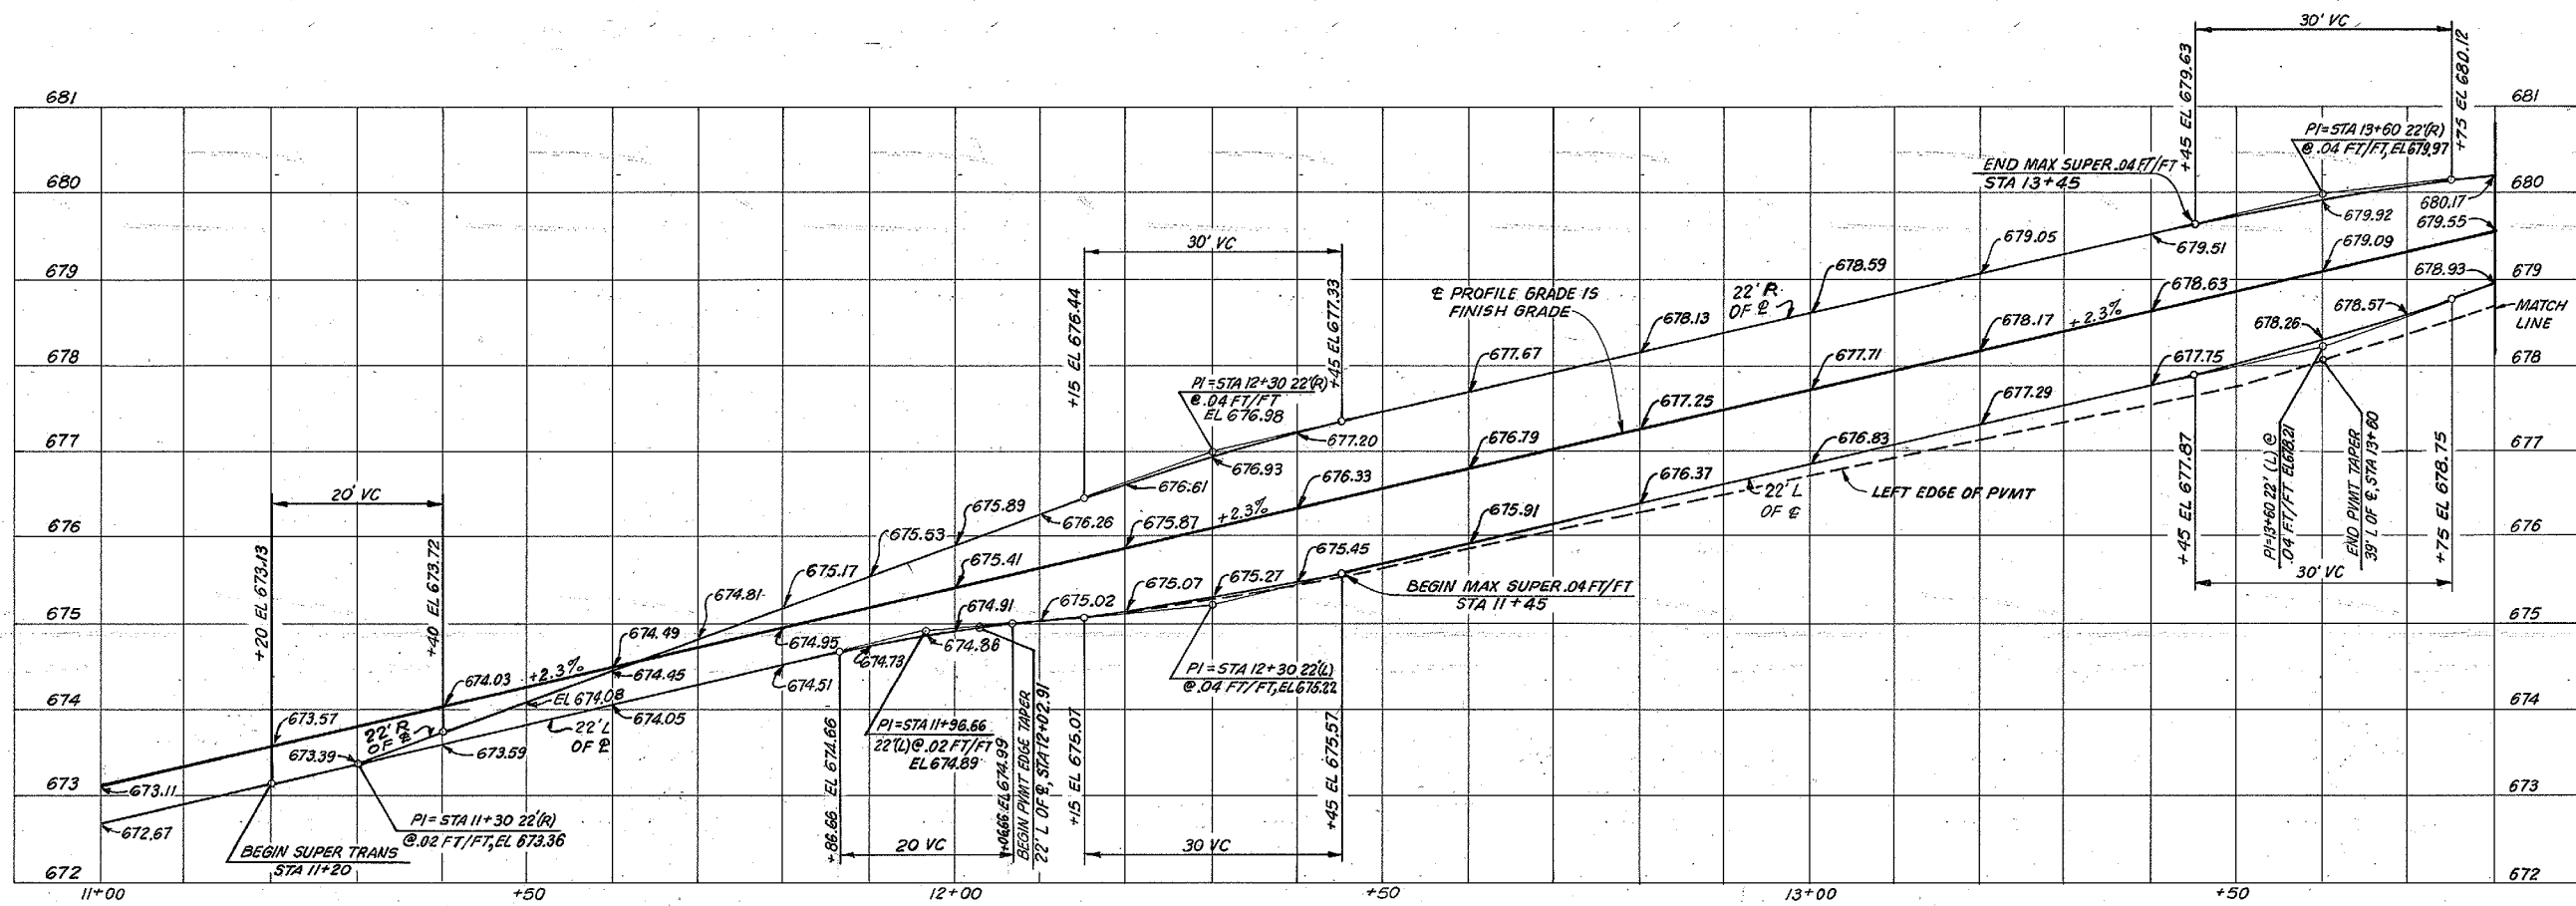

**NORTH MOORE ROAD**

NOTES:  
FOR NOTES AND REFERENCE DRAWINGS SEE 101-19H252.

REV NO.	ECN NO.	DATE	ISSN	CHKD	APPD	ENGR	INSPE	DESIGN	REC'D	APPD
DRWN	H.L. PETTY		INSP		Sov					
CHKD	J.R. LEE		ENGR		E. B. Logan					
SUPV	Wm. M. ...		ENGR							
<b>NORTH MOORE ROAD RELOCATION</b>										
<b>FINISHED PAVEMENT PROFILE</b>										
SOUTH CHICKAMAUGA CREEK PROJECT TENNESSEE VALLEY AUTHORITY DIVISION OF ENGINEERING DESIGN										
INSPECTED AND APPROVED FOR ISSUE			SUBMITTED		RECOMMENDED		APPROVED			
KNOXVILLE 12-4-78			H.L. Petty		J.R. Lee		E. B. Logan			
RECORD DRAWING AS CONSTRUCTED										

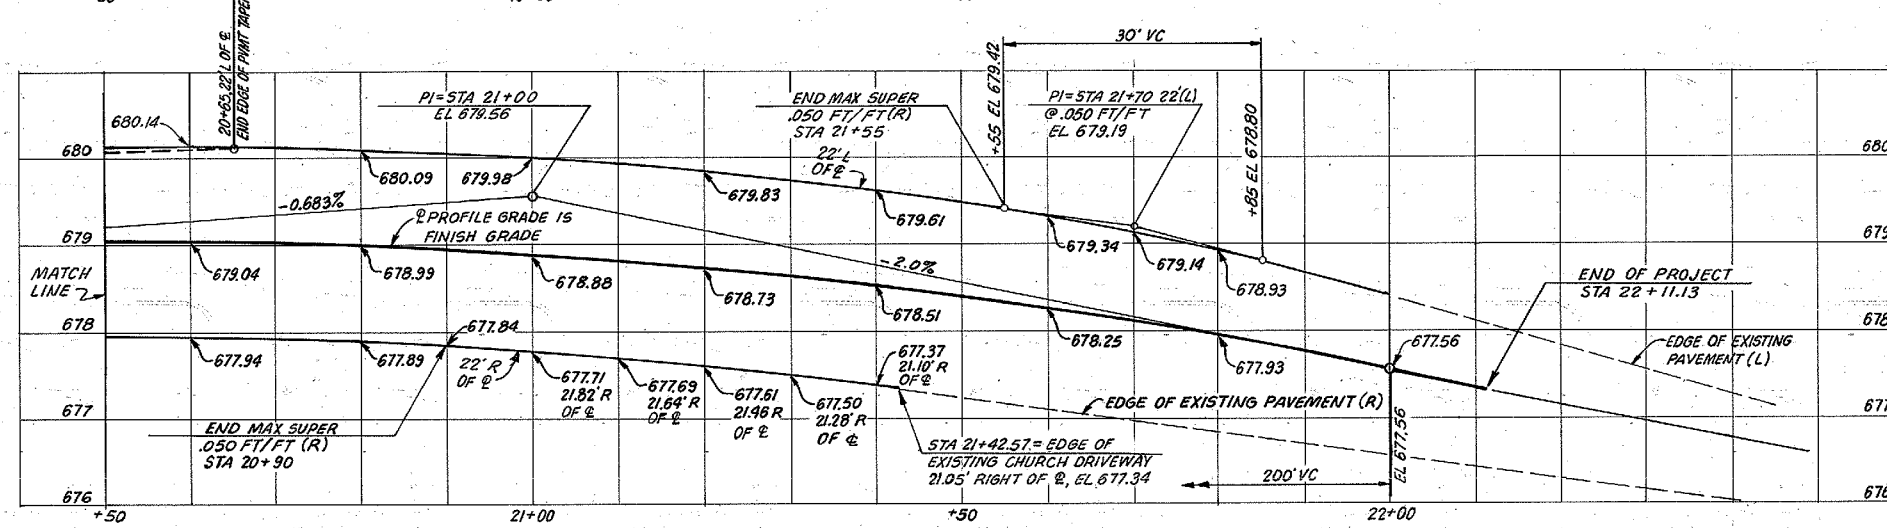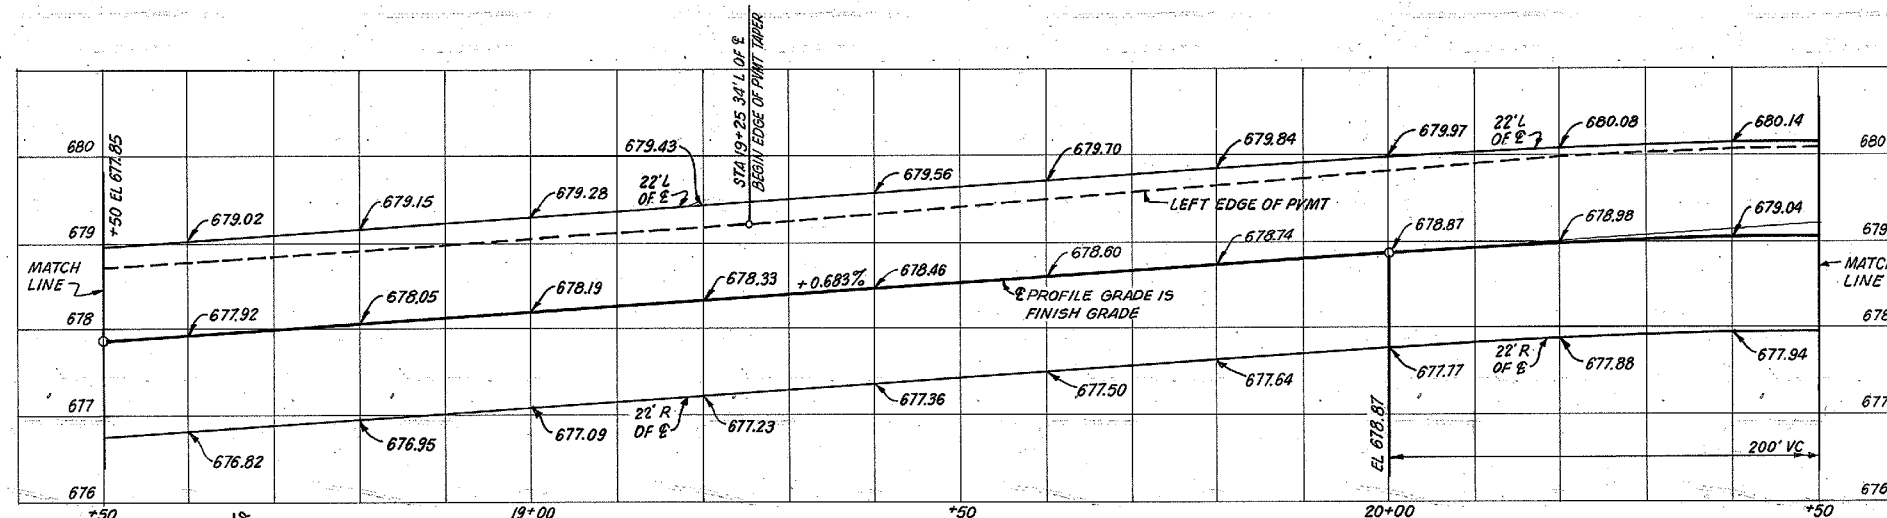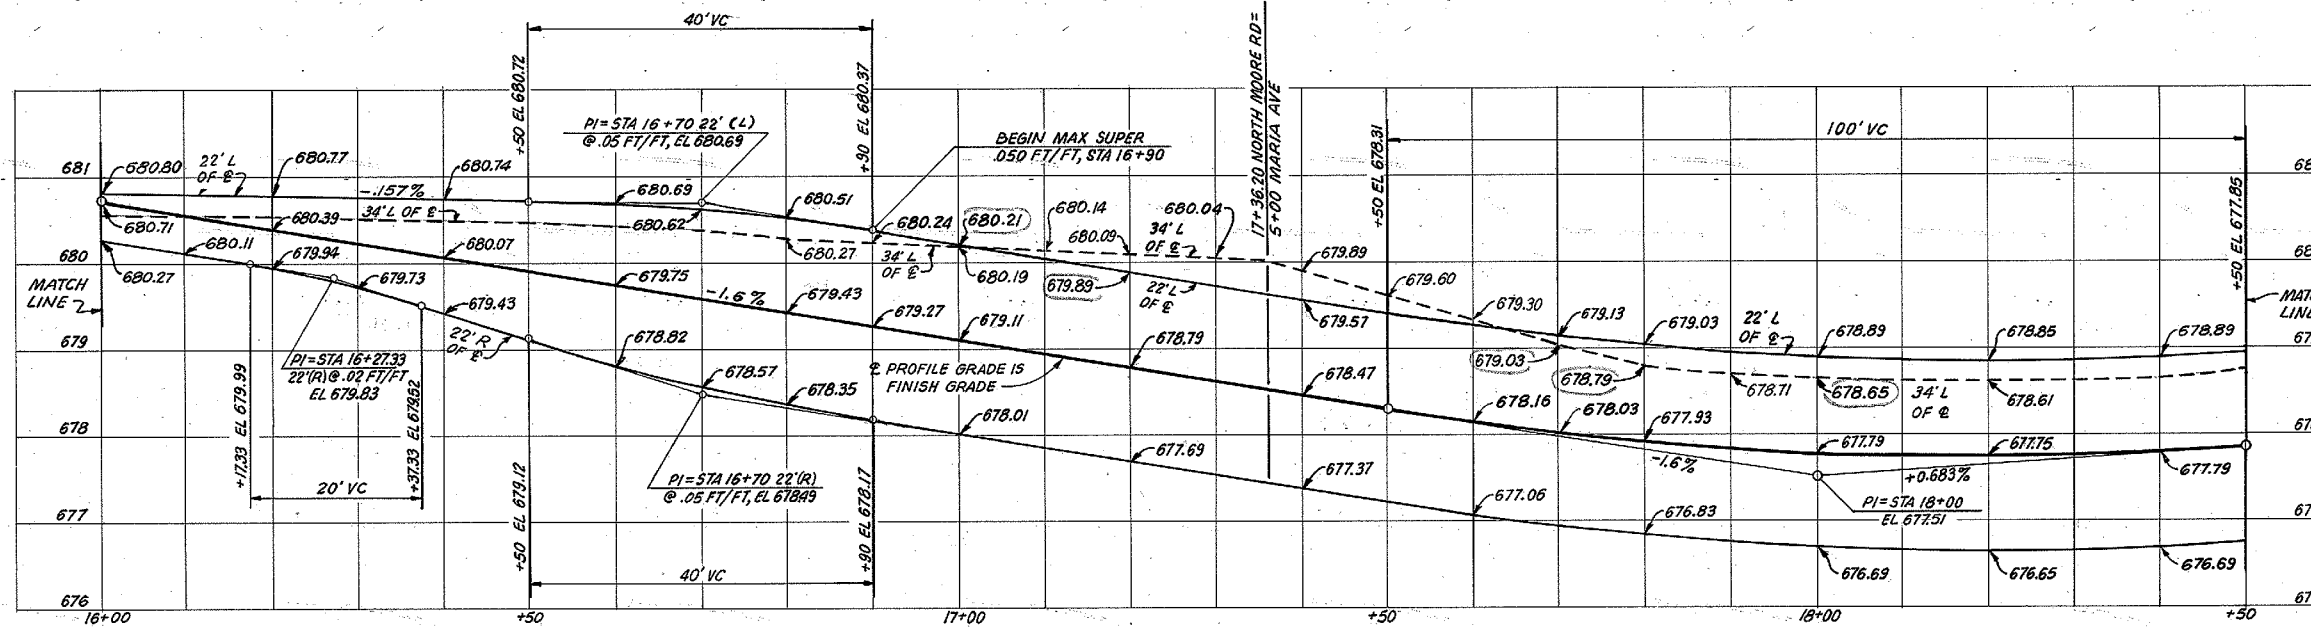

NORTH MOORE ROAD




NOTES:  
FOR NOTES AND REFERENCE DRAWINGS SEE 101-19H 252.

SCALE { 1"=1'-0" VERT  
1"=10'-0" HORIZ





REV. NO.		DATE		BY		CHKD		APPD	
H.L. PETTY		12-7-78		R. J. BROWN		W. M. MARTIN		S. B. JOHNSON	
<p style="text-align: center;"><b>NORTH MOORE ROAD RELOCATION</b></p> <p style="text-align: center;"><b>FINISHED PAVEMENT PROFILE</b></p> <p style="text-align: center;">SOUTH CHICKAMAUGA CREEK PROJECT TENNESSEE VALLEY AUTHORITY DIVISION OF ENGINEERING DESIGN</p>									
SUBMITTED			RECOMMENDED			APPROVED			
Robert J. Brown			R. J. Brown			S. B. Johnson			
KNOXVILLE 12-7-78 81 HR 101-19H254-2 RI									

1	2	3	4	5	6
---	---	---	---	---	---

PRINT	IN	SCALE	DATE	BY	CHKD	APPD

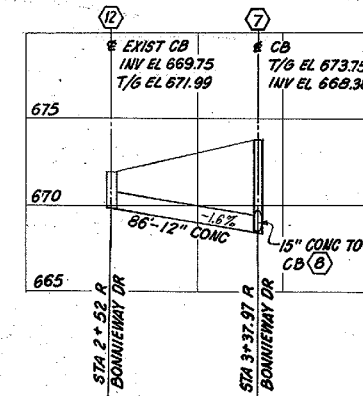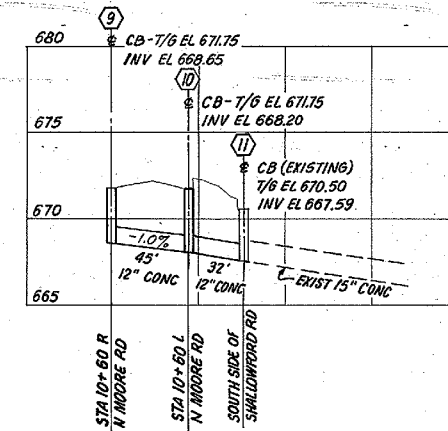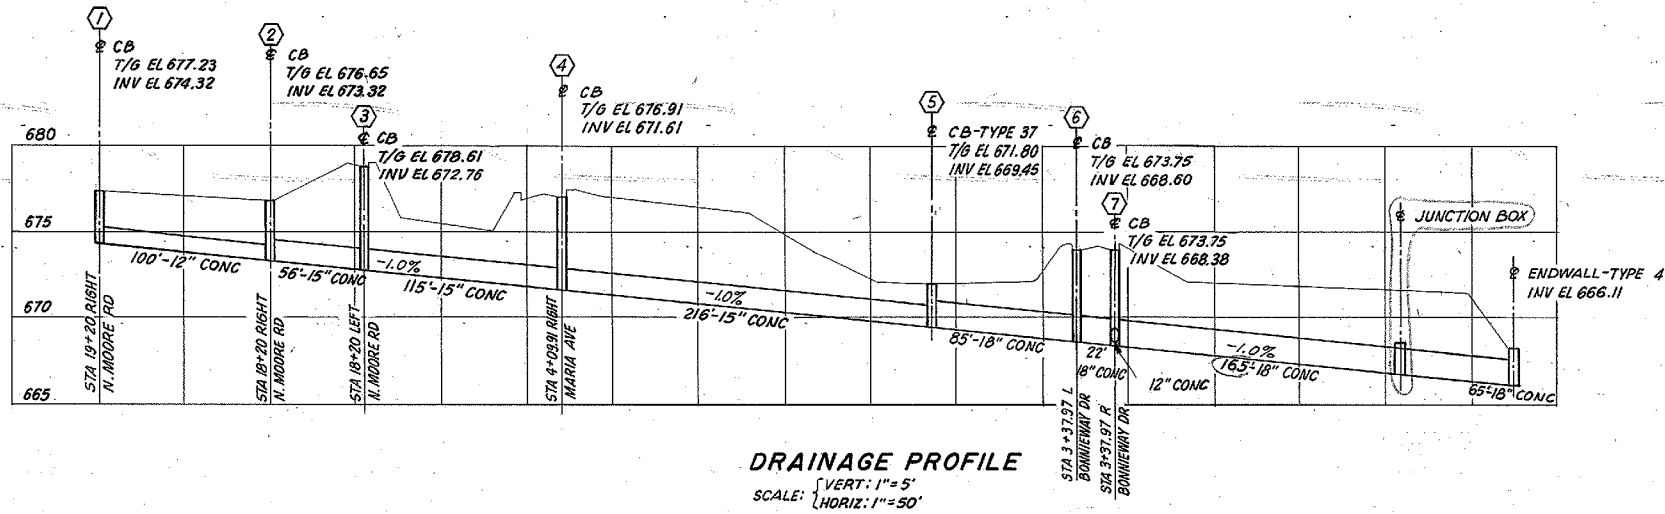

- NOTES:  
 1. FOR CITY OF CHATTANOOGA STANDARD CATCH BASIN DETAILS SEE 101-19H256-1.  
 2. FOR TVA-TYPE 37 CATCH BASIN DETAILS SEE 101-19H256-2.  
 3. FOR TVA-TYPE 4 ENDWALL DETAILS SEE 101-19H256-3.  
 4. FOR ADDITIONAL NOTES AND REFERENCE DRAWINGS SEE 101-19H252.  
 5. ALL CATCH BASINS SHOWN ARE CITY OF CHATTANOOGA STANDARD CATCH BASINS EXCEPT AS NOTED.

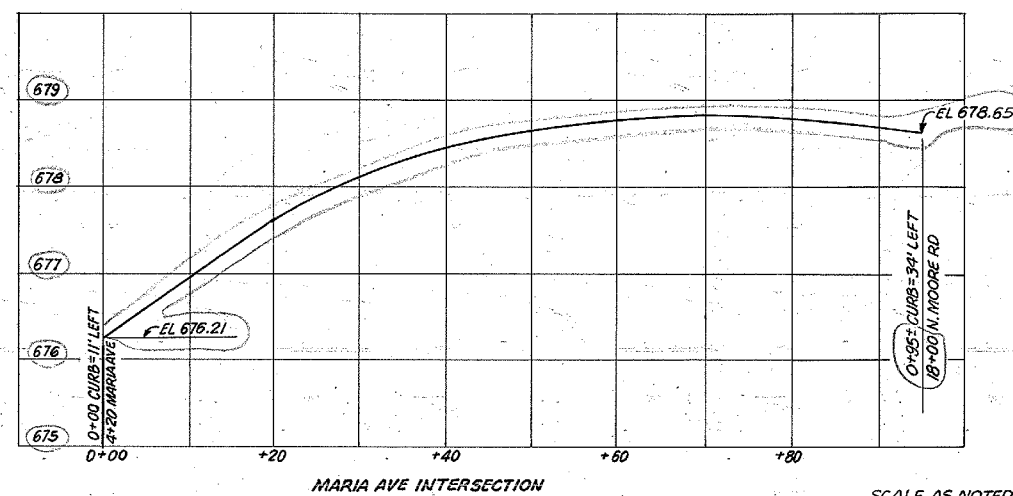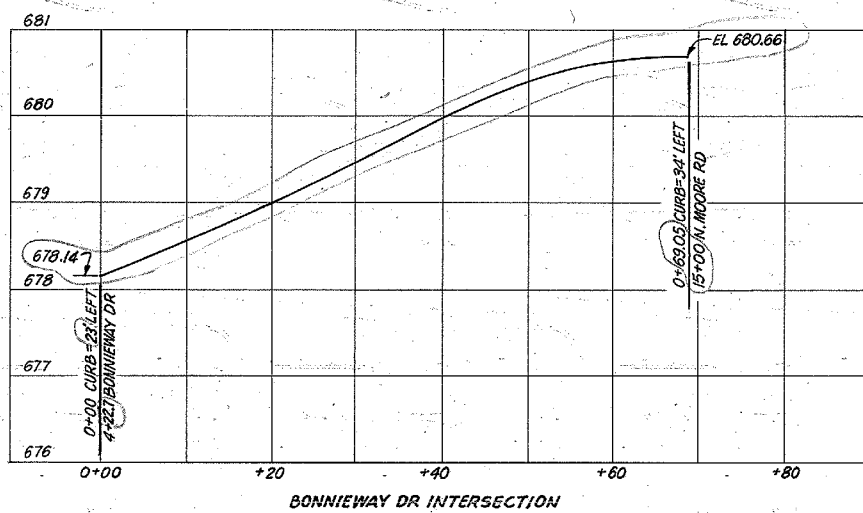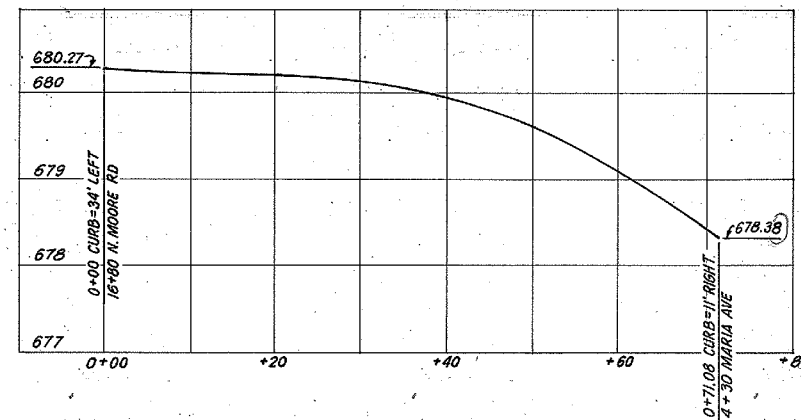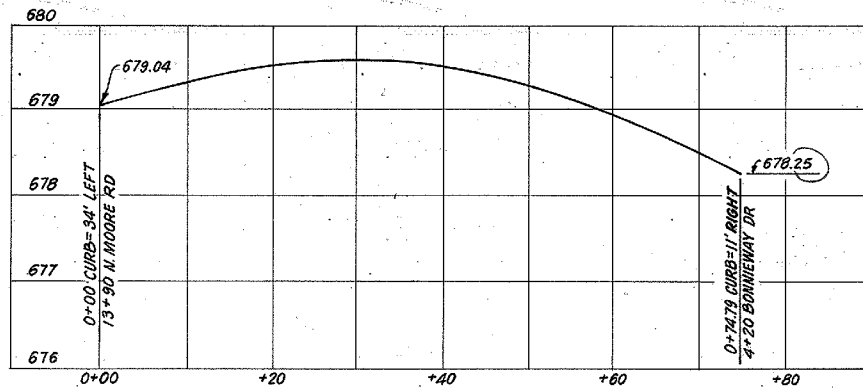


**TURNING RADIUS PROFILES FOR CURBS**  
 SCALE: VERT: 1"=5'  
 HORIZ: 1"=10'

SCALE AS NOTED


REV	DATE	BY	CHKD	APPD
1	12-4-78	H.L. PETTY	J.P. FOX	E.L. SUGAN
NORTH MOORE ROAD RELOCATION DRAINAGE PROFILES AND TURNING RADIUS PROFILES SOUTH CHICKAMAUGA CREEK PROJECT TENNESSEE VALLEY AUTHORITY DIVISION OF ENGINEERING DESIGN				
INSPECTED AND APPROVED FOR ISSUE		SUBMITTED: <i>[Signature]</i> RECOMMENDED: <i>[Signature]</i> APPROVED: <i>[Signature]</i>		
KNOXVILLE 12-4-78 81 HR 101-19H255 RI		RECORD DRAWING AS CONSTRUCTED		

PRINT	1	2	3	4	5	6	7	8	9	10	11	12	13	14	15	16	17	18	19	20	21	22	23	24	25	26	27	28	29	30	31	32	33	34	35	36	37	38	39	40	41	42	43	44	45	46	47	48	49	50
-------	---	---	---	---	---	---	---	---	---	----	----	



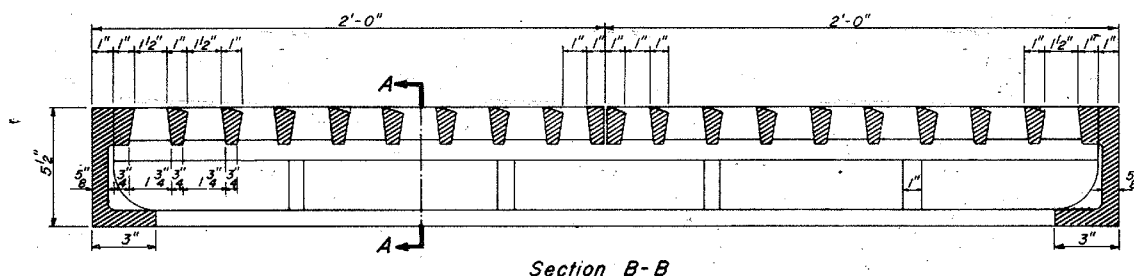


Section B-B

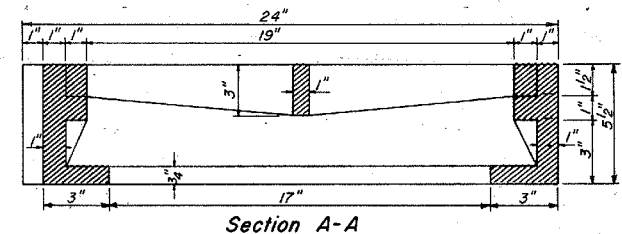


Section A-A

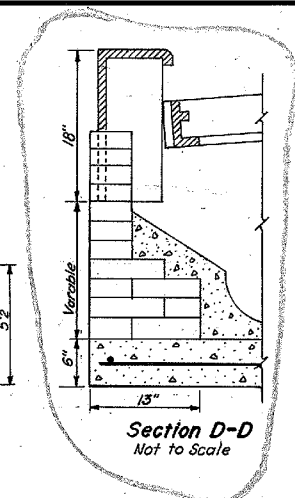


Section D-D  
Not to Scale

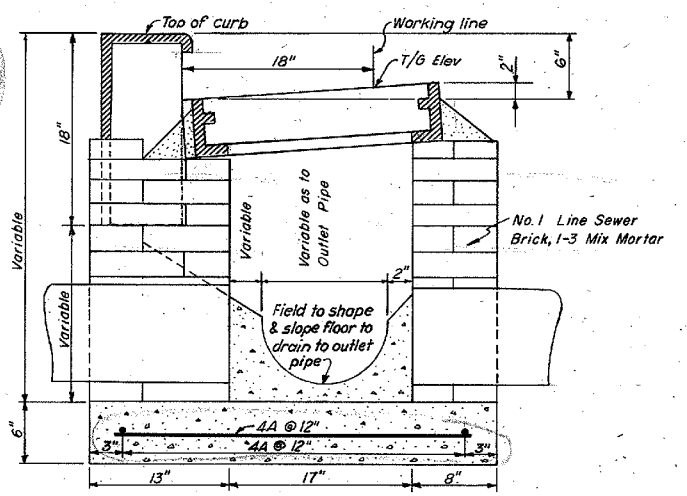


Section C-C  
Scale: 1 1/2" = 1'-0"

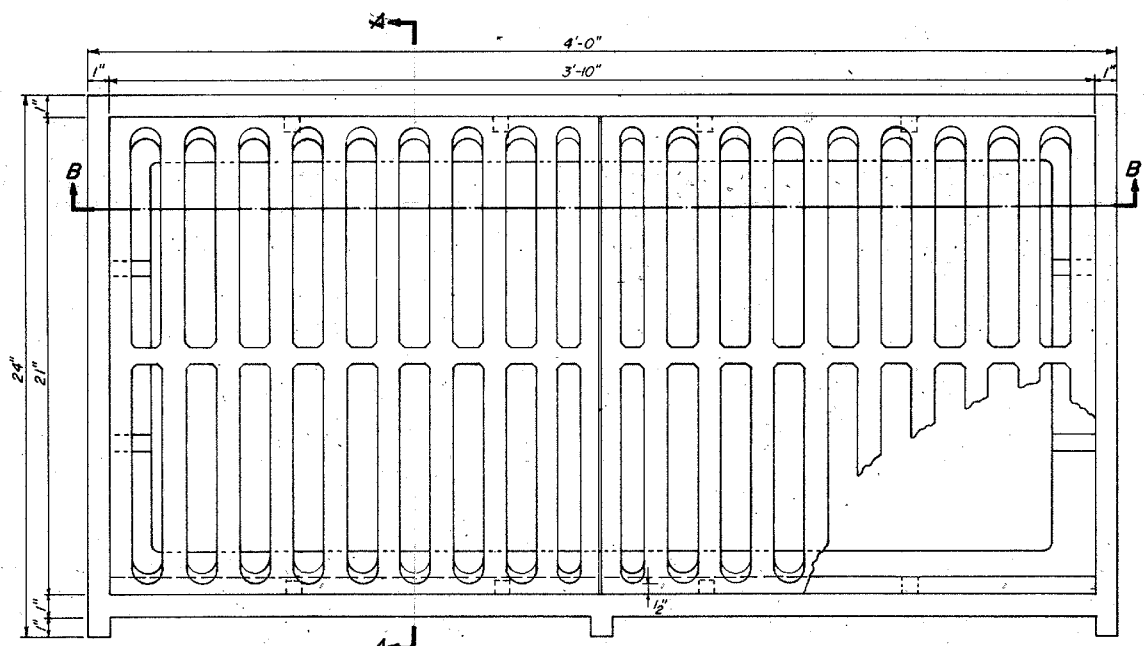


Plan  
Frame & Grate  
Scale: 3" = 1'-0"

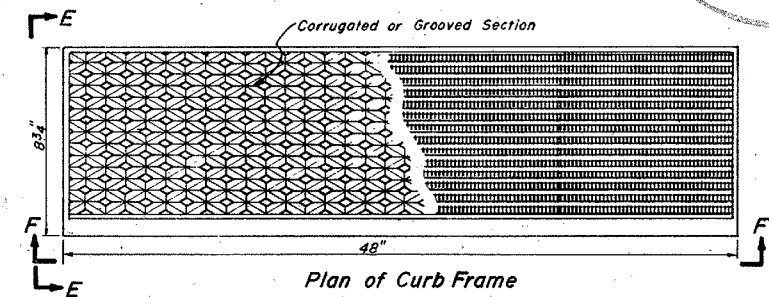


Plan of Curb Frame

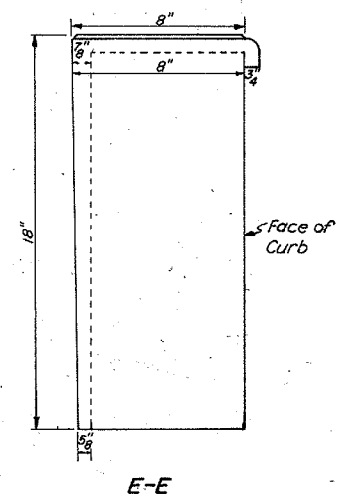


E-E

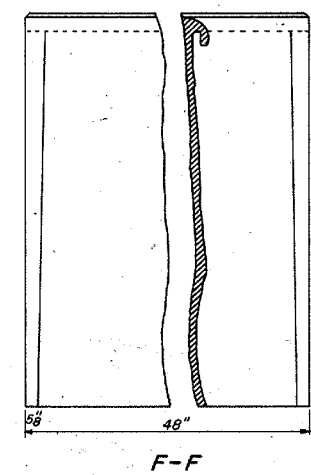


F-F

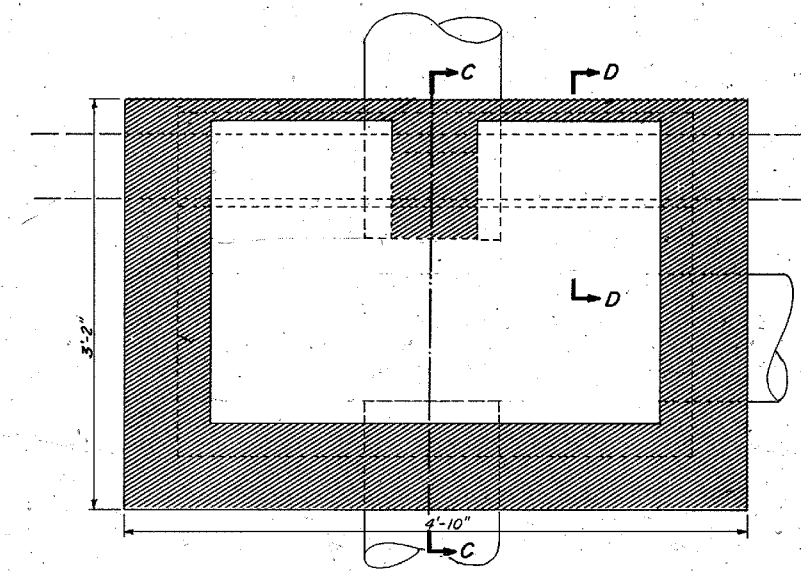

Plan of Inlet  
Frame & Grates Removed  
Scale: 1 1/2" = 1'-0"

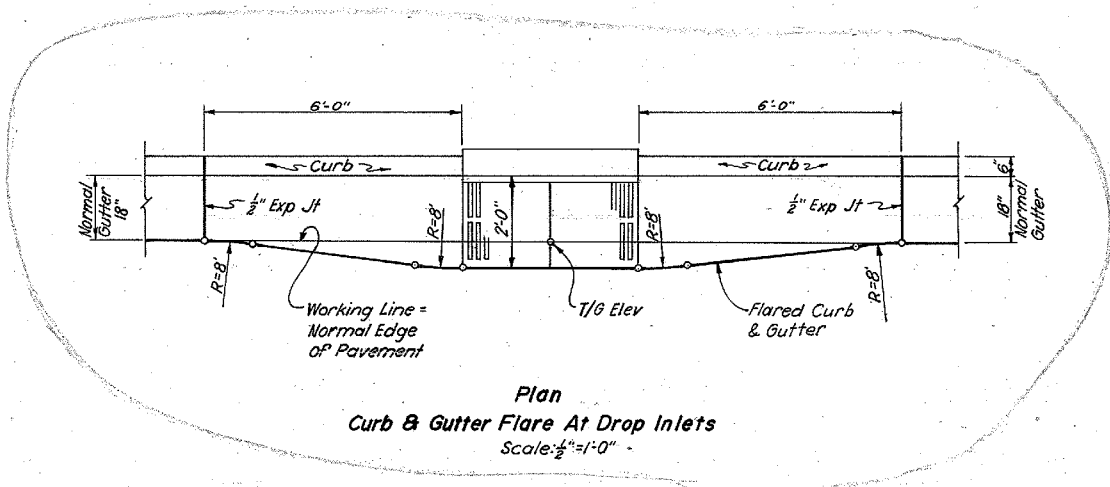

Plan  
Curb & Gutter Flare At Drop Inlets  
Scale: 1/2" = 1'-0"

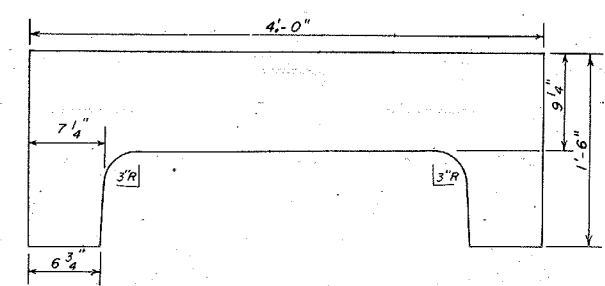








Alternate Back View Of Curb  
Frame  
Scale: 1 1/2" = 1'-0"

- NOTES:
1. ALL MATERIALS REQUIRED FOR CONSTRUCTION OF THIS TYPE CATCH BASIN SHALL CONFORM TO THE CITY OF CHATTANOOGA STANDARDS & SPECS & SHALL BE OF THE SAME MANUFACTURE AS USED CURRENTLY BY THE CITY.
  2. FOR ADDITIONAL NOTES AND REFERENCE DRAWINGS SEE 101-19H252.

Scale as noted

101-19H256-01		18 18	
ADD CURB & GUTTER FLARE, SECTION D-D, MINOR REVISIONS			
REV	NO.	DATE	BY
DSGN	H. L. PETTY	INSP	R. S.
DRWN	V. R. LEE	ENGR	E. A. Pagan
CHKD	W. M. WALKER	ENGR	
SUPV	W. M. WALKER		
NORTH MOORE ROAD RELOCATION			
STANDARD CATCH BASIN			
CITY OF CHATTANOOGA			
SOUTH CHICKAMAUGA CR PROJECT			
TENNESSEE VALLEY AUTHORITY			
DIVISION OF ENGINEERING DESIGN			
SUBMITTED	RECOMMENDED	APPROVED	
Robert J. Bowman	W. M. Walker	E. A. Pagan	
KNOXVILLE	12-4-78	81 HR	101-19H256-1 R1
RECORD DRAWING AS CONSTRUCTED			



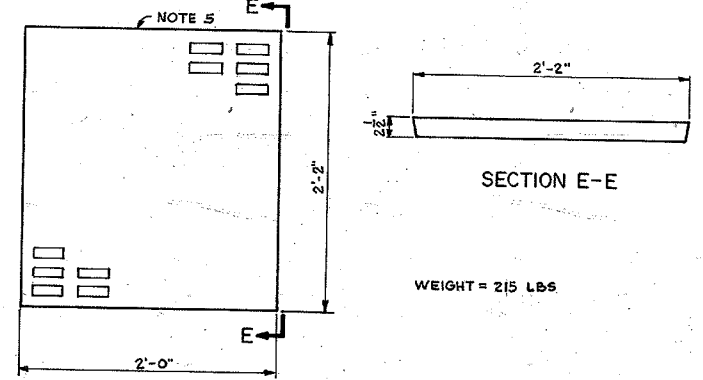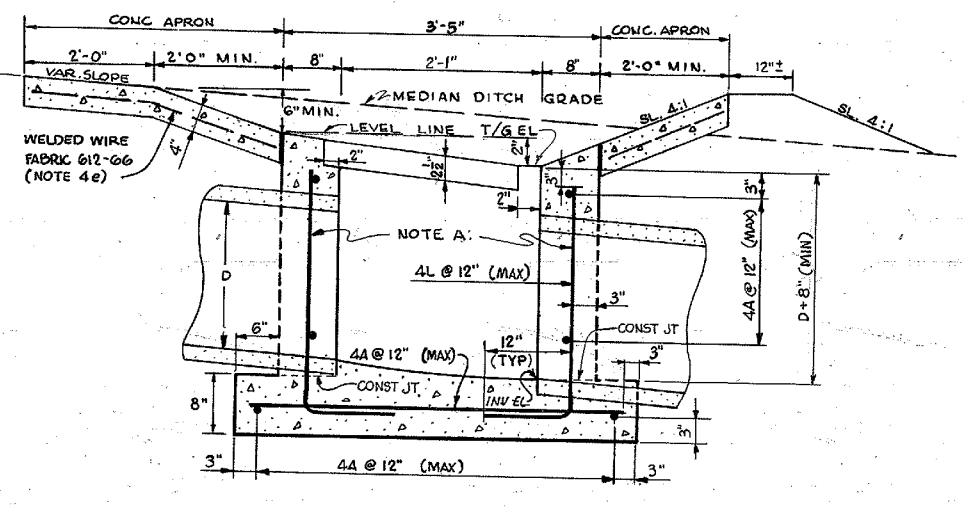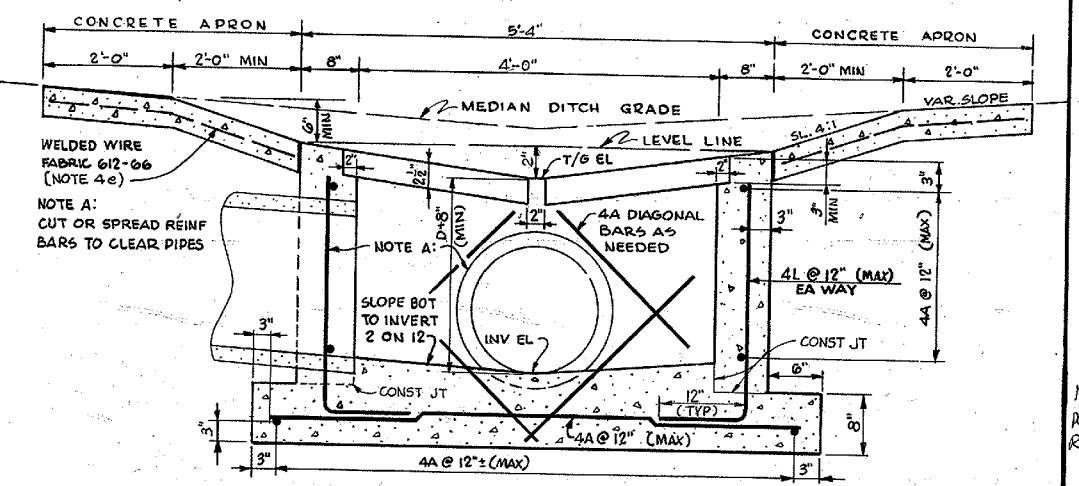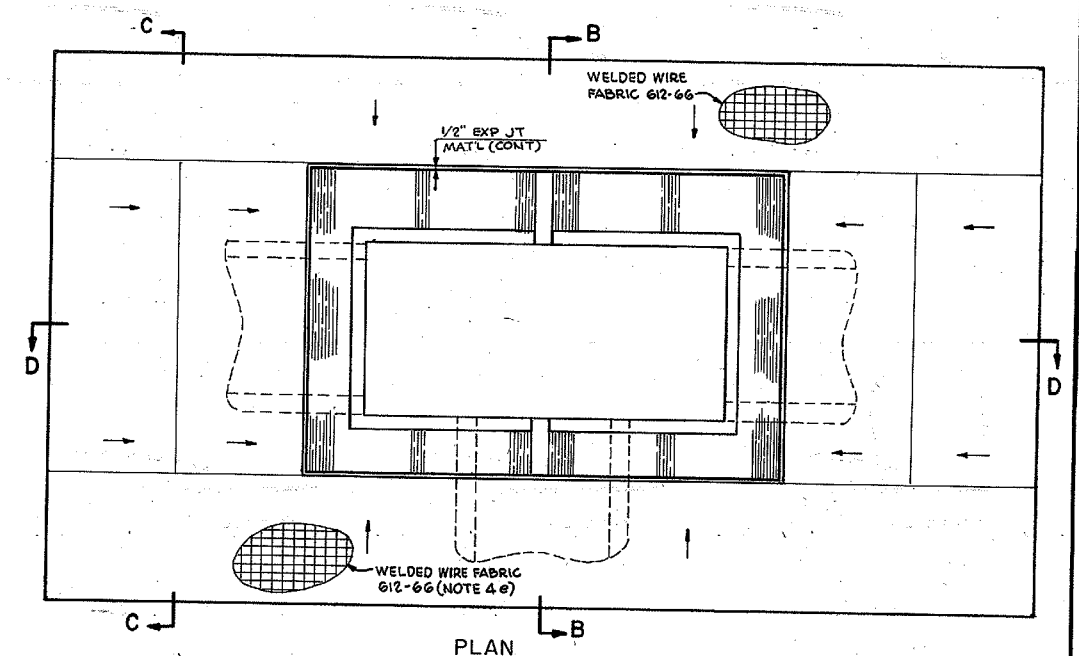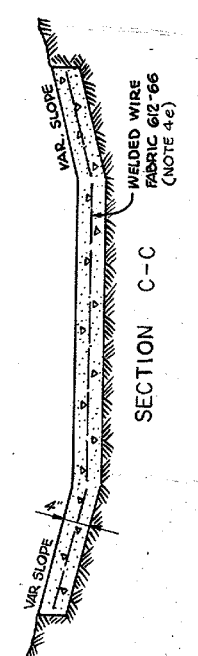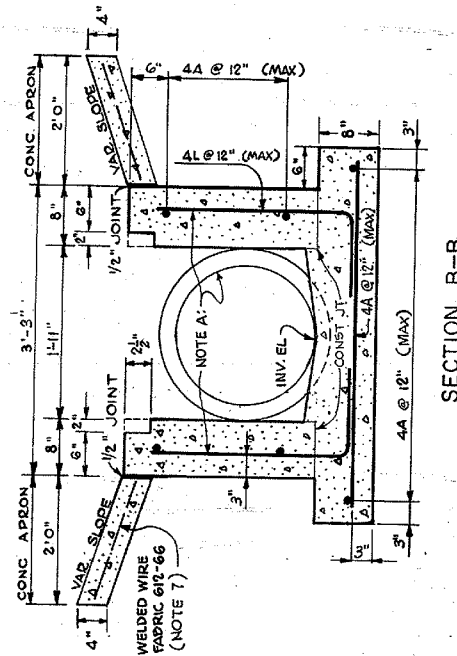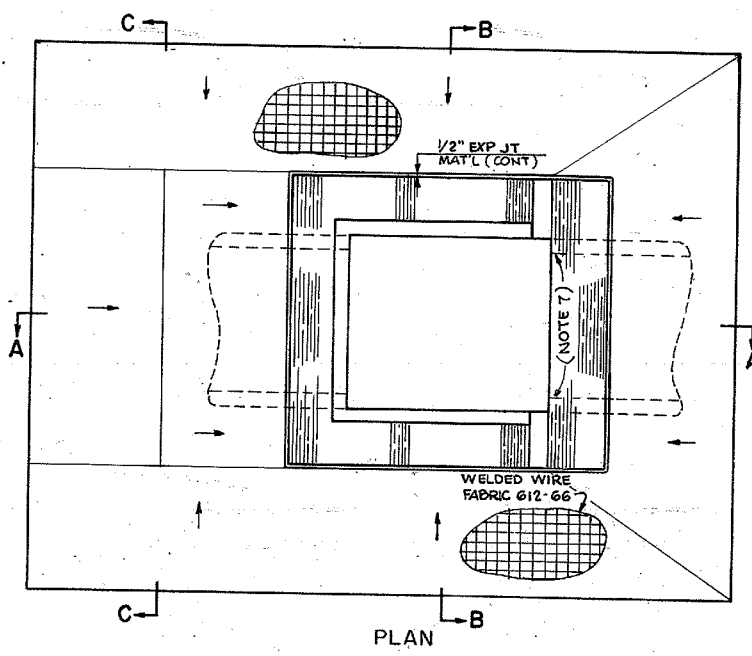

**No. 36 CATCH BASIN**  
For Median Drain on  
Straight Grade

**No. 37 CATCH BASIN**  
For Median Drain  
At Sag Point


**Estimated Quantities\***

DIAMETER PIPE "D"	CL. A CONCRETE	Cu. Yd. No. 36 C.B.	Cu. Yd. No. 37 C.B.
12"	0.70	0.98	
15"	0.77	1.07	
18"	0.84	1.16	
24"	0.98	1.35	
Each Add'l. Ft. of Depth	0.28	0.37	

**Pipe Deductions**

DIAMETER	CONC. Cu. Yd.
12"	0.03
15"	0.05
18"	0.07
24"	0.11

\* QUANTITIES FOR CONCRETE APRON BY FIELD.

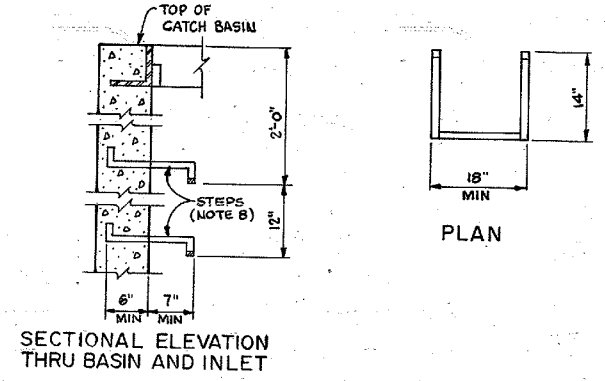

**DETAIL-BASIN AND INLET STEPS**  
REQUIRED FOR BASIN & INLETS THAT ARE GREATER THAN 3'-0" IN DEPTH

- NOTES:**
- ALL WORK SHALL BE IN ACCORDANCE WITH HIGHWAY SPECIFICATION NO. T1, UNLESS OTHERWISE NOTED.
  - EXCAVATION AND BACKFILL FOR PIPE CULVERTS SHALL CONFORM TO SECTION 125.
  - CONCRETE SHALL BE CLASS "A" IN ACCORDANCE WITH SECTION 400.
  - REINFORCEMENT
    - ALL REINFORCEMENT SHALL BE GRADE 60 IN ACCORDANCE WITH SECTION 418.
    - ALL REINFORCEMENT TO BE FURNISHED AND BENT BY FIELD.
    - PLACE ALL REINFORCEMENT IN WALLS AND SLABS 3" MINIMUM FROM FACE OF CONCRETE TO THE NEAREST REINFORCING BAR.
    - LAP SPLICES SHALL BE 12" MINIMUM WHERE REQUIRED.
    - WELDED WIRE FABRIC SHALL CONFORM TO ASTM-A185 PLAIN FINISH AND SHALL HAVE A MINIMUM LAP DISTANCE OF 8".
  - USE NEENAH NO. R 4822-F GRADE TYPE A OR EQUAL.
  - ALL EXPOSED EDGES SHALL BE CHAMFERED 3/4".
  - THE CONNECTION OF PIPE TO STRUCTURE SHALL BE NEAT AND SECURE WHERE ENTIRE END OF PIPE DOES NOT EXTEND TO INSIDE FACE OF STRUCTURE THE WALL OF THE STRUCTURE SHALL BE EXTENDED WITH SMOOTH RIGID CIRCULAR FORMS EXACTLY FITTING THE INNER CIRCUMFERENCE OF THE PIPE WHERE A PORTION OF PIPE EXTENDS BEYOND THE REQUIRED INSIDE FACE OF STRUCTURE IT SHALL BE CUT OFF SMOOTH AND FLUSH THEREWITH WHERE BELL AND SPIGOT PIPE IS USED THE BELL END IS TO BE PLACED UPSTREAM WITH THE END OF THE PIPE FLUSH WITH FACE OF WALL UNLESS OTHERWISE DIRECTED BY THE ENGINEER.
  - BASIN AND INLET STEPS SHALL CONFORM TO TYPE R-1982J AS MANUFACTURED BY NEENAH ROUNDRY CO. OR EQUAL. ALTERNATE TO CONFORM TO TVA HAZARD CONTROL STANDARD NO. 502.

15-25-73 (M.P. 101-1919H256-2) (REVISED)

**MAJOR REVISION: REV. CASTING DET. BASIN & INLET STEPS, NOTES.**

REV.	DATE	BY	CHKD.	APP.
1		H.L. BETTY		
2		V.L. LEE		
3		W.M. HANCOCK		
4		W.M. HANCOCK		

DESIGN: H.L. BETTY  
DRAWN: V.L. LEE  
CHECKED: W.M. HANCOCK  
SUPERVISOR: W.M. HANCOCK


**NORTH MOORE ROAD RELOCATION**

**CATCH BASINS AND GRATE**




**SOUTH CHICKAMAUGA CREEK PROJECT**  
TENNESSEE VALLEY AUTHORITY  
DIVISION OF ENGINEERING DESIGN

SUBMITTED: Robert G. Bowman  
RECOMMENDED: R.D. Stewart  
APPROVED: J.A. Elms




KNOXVILLE 12-4-78 81 HR 101-1919H256-2 RI

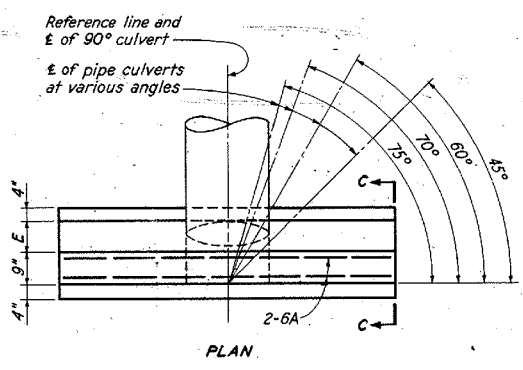

DIMENSIONS FOR TYPE 1 ENDWALL													QUANTITIES FOR ONE TYPE 1 ENDWALL		
DIA	ANG	A	B	C	D	E	F	H	J	J <sub>1</sub>	N	N <sub>1</sub>	P	CONCRETE CU YDS	STEEL LBS
18"	90°	2'-0"	2'-6"	1'-3"	1'-0"	6"	6'-0"	5'-8"	3'-0"	3'-0"	2'-3"	2'-3"	1'-6"	1.00	17.0
18"	75°	2'-0"	2'-6"	1'-3"	1'-0"	6"	6'-1"	5'-9"	3'-0"	3'-1"	2'-3"	2'-4"	1'-6"	1.01	17.5
18"	60°	2'-0"	2'-6"	1'-3"	1'-0"	6"	6'-2"	5'-10"	3'-0"	3'-2"	2'-2"	2'-4"	1'-8"	1.02	17.5
18"	45°	2'-0"	2'-6"	1'-3"	1'-0"	6"	6'-7"	6'-3"	3'-1"	3'-6"	2'-2"	2'-7"	1'-10"	1.09	19.0
24"	90°	2'-2"	3'-0"	1'-5"	1'-1"	8"	7'-10"	7'-6"	3'-11"	3'-11"	2'-11"	2'-11"	2'-0"	1.59	22.5
24"	75°	2'-2"	3'-0"	1'-5"	1'-1"	8"	8'-0"	7'-8"	3'-11"	4'-1"	2'-11"	3'-1"	2'-0"	1.62	23.0
24"	60°	2'-2"	3'-0"	1'-5"	1'-1"	8"	8'-2"	7'-10"	4'-0"	4'-2"	2'-11"	3'-1"	2'-2"	1.65	23.5
24"	45°	2'-2"	3'-0"	1'-5"	1'-1"	8"	8'-6"	8'-2"	4'-0"	4'-6"	2'-10"	3'-4"	2'-4"	1.71	24.5
30"	90°	2'-4"	3'-6"	1'-7"	1'-2"	10"	9'-6"	9'-2"	4'-9"	4'-9"	3'-6"	3'-6"	2'-6"	2.29	27.5
30"	75°	2'-4"	3'-6"	1'-7"	1'-2"	10"	9'-8"	9'-4"	4'-9"	4'-11"	3'-6"	3'-8"	2'-6"	2.33	28.0
30"	60°	2'-4"	3'-6"	1'-7"	1'-2"	10"	9'-11"	9'-7"	4'-10"	5'-1"	3'-6"	3'-9"	2'-8"	2.39	29.0
30"	45°	2'-4"	3'-6"	1'-7"	1'-2"	10"	10'-4"	10'-0"	4'-10"	5'-6"	3'-5"	4'-11"	2'-10"	2.48	30.0
30"	45°	2'-4"	3'-6"	1'-7"	1'-2"	10"	11'-10"	11'-6"	5'-11"	6'-9"	3'-4"	5'-0"	3'-6"	2.82	34.5

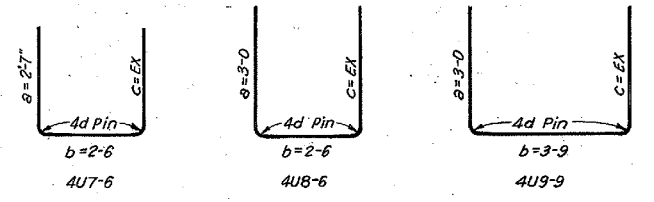
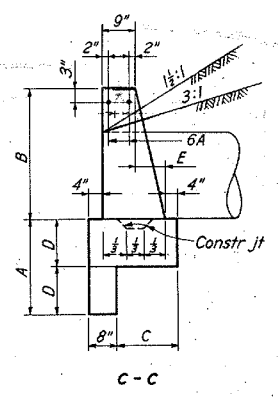
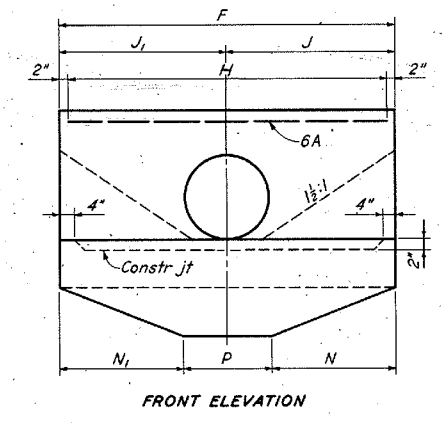


DIMENSIONS FOR TYPE 3 ENDWALL							QUANTITIES FOR ONE TYPE 3 ENDWALL	
PIPE SIZE	WALL	FOOTING	CONCRETE CU YDS	STEEL LBS				
12"	0.79	3'-6"	9"	1'-0"	1'-3"	2'-1"	0.46	20
15"	1.23	3'-9"	9"	1'-5"	1'-3"	2'-6"	0.58	"
18"	1.77	4'-0"	9"	1'-9"	1'-3"	2'-10"	0.69	"
24"	3.14	4'-6"	10"	2'-6"	1'-6"	3'-8"	1.09	"
30"	4.91	5'-2"	10"	3'-3"	1'-6"	4'-5"	1.43	"

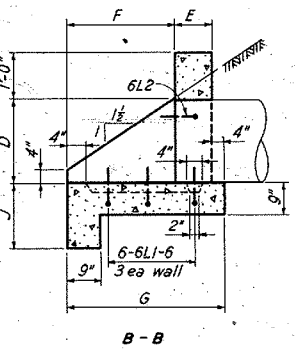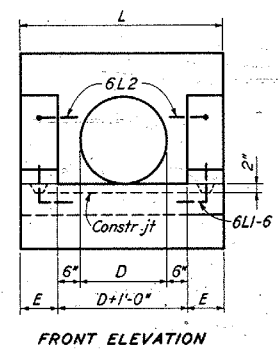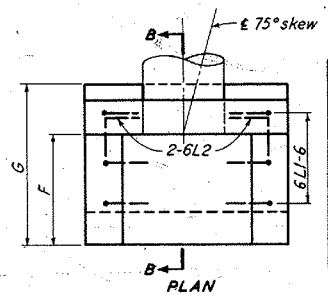


TYPE 3 ENDWALL

DIMENSIONS FOR TYPE 4 ENDWALL							QUANTITIES FOR ONE TYPE 4 ENDWALL	
PIPE SIZE	WALL	FOOTING	CONCRETE CU YDS	STEEL LBS				
12"	0.79	3'-6"	9"	2'-0"	1'-3"	3'-1"	0.55	20
15"	1.23	3'-9"	9"	2'-0"	1'-3"	3'-10"	0.72	"
18"	1.77	4'-0"	9"	3'-6"	1'-3"	4'-7"	0.90	"
24"	3.14	4'-8"	10"	5'-0"	1'-6"	6'-2"	1.49	"
30"	4.91	5'-2"	10"	6'-6"	1'-6"	7'-8"	2.06	"

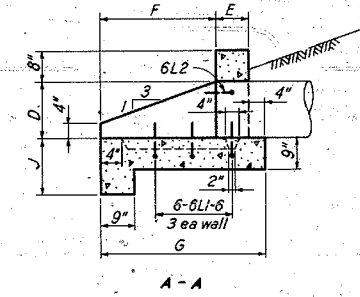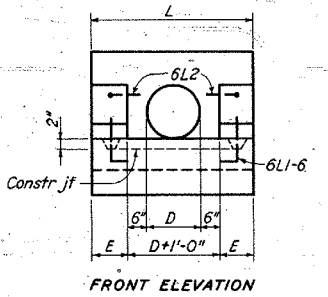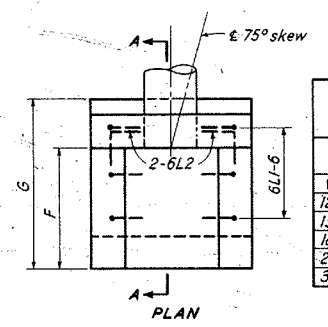


TYPE 4 ENDWALL

DIMENSIONS FOR TYPE 2 ENDWALL								QUANTITIES FOR ONE TYPE 2 ENDWALL	
D	H	F	L	T	M	B		CONCRETE CU YDS	STEEL LBS
18"	2'-6"	4'-6"	6'-3"	0'-8"	2'-8"	1'-0"	0.91	None	
24"	3'-0"	7'-0"	6'-6"	0'-9"	4'-5"	1'-3"	1.57	6	
30"	3'-6"	10'-0"	7'-0"	0'-10"	6'-8"	1'-9"	2.58	6	
3'-1"	3'-0"	3'-6"	11'-0"	13'-3"	0'-10"	6'-8"	1'-9"	3.05	6

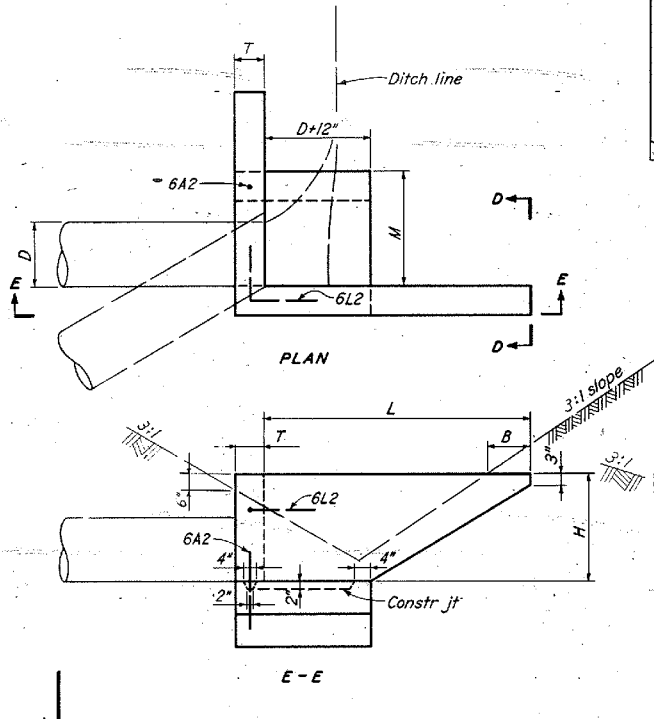


TYPE 2 ENDWALL Not to Scale

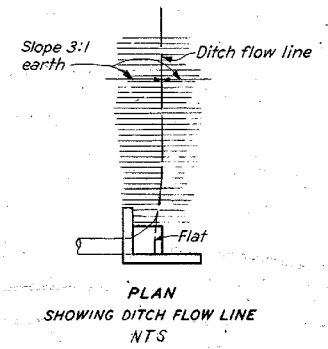


**NOTES:**  
**SPECIFICATIONS:** Construction of these structures to be in accordance with Highway Specification - No. 11. **EXCAVATION, FOUNDATION, AND BACKFILL:** Section 125. **CONCRETE:** Section 400, Class B concrete, type II portland cement. **REINFORCING STEEL:** Section 418. **CHAMFER:** All exposed edges shall be chamfered 1/4". **ENDWALL TYPES:** Types 3 and 4 may be used for pipes skewed from 75° to 90°. Use dimensions and quantities given for 90° pipes. For all other skews use walls of type 1 and 2 only. **CONNECTION TO PIPE:** The connection of pipe to endwalls shall be neat and secure. Where entire end of pipe does not extend to front face of endwall, the barrel of the culvert shall be extended with smooth, rigid, circular forms exactly fitting the inner circumference of the pipe. Where a portion of pipe extends beyond the required front face of endwall, it shall be cut off smooth and flush therewith. Where bell and spigot pipe is used, the bell end is to be placed upstream with the end of the pipe flush with face of wall, unless otherwise directed by the Engineer. **ENDWALL IN ROCK:** Where solid rock is encountered the apron and cut-off wall shall be omitted and the endwall otherwise modified as required. Provide adequate construction keyways between concrete and the rock fdns. for additional notes & reference dwgs see 101-19H252.

Scale 1/8" = 1'-0"  
 Except as noted

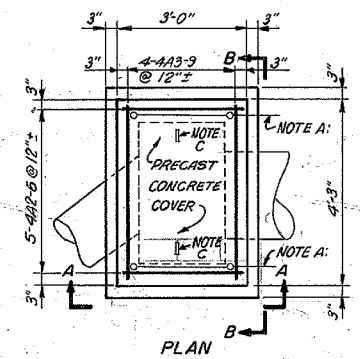





**NOTE A:** DRILL 4-5/8" DIA HOLES THRU PRECAST COVER AND INTO WALLS AND PLACE #4 REINF INTO HOLES TO STABILIZE COVER UNTIL BACKFILL HAS BEEN COMPLETED, BY FIELD.  
**NOTE B:** CUT OR BEND BARS TO CLEAR PIPES.  
**NOTE C:** LIFTING COVER HOOKS BY FIELD.

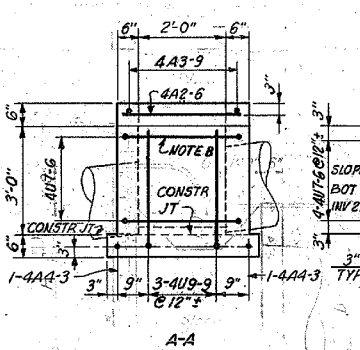


JUNCTION BOX I REQD NTS

REMOVED SURVEY MARKER, ADDED JUNCTION BOX, BAR BEND DETAILS			
REV. NO.	DATE	DESIGN	CHKD
DESIGN	CHKD	INSPECTION	APPROVED
DESIGN	CHKD	INSPECTION	APPROVED
DESIGN	CHKD	INSPECTION	APPROVED
<b>NORTH MOORE ROAD RELOCATION</b>			
<b>CONCRETE ENDWALLS AND INLETS FOR PIPE CULVERTS</b>			
<b>SOUTH CHICKAMAUGA CREEK PROJECT</b>			
<b>TENNESSEE VALLEY AUTHORITY</b>			
<small>DIVISION OF ENGINEERING DESIGN</small>			
SUBMITTED		RECOMMENDED	
INSPECTED AND APPROVED FOR ISSUE		APPROVED	
KNOXVILLE 12-4-78 81 HR 101-19H256-3.R1			

PRINTS RECD-R  
 BR of PROJ  
 DWG SIZE  
 F H  
 ME  
 EC  
 CD  
 AD  
 CD  
 ED  
 MD  
 BF  
 SW  
 BL  
 PA

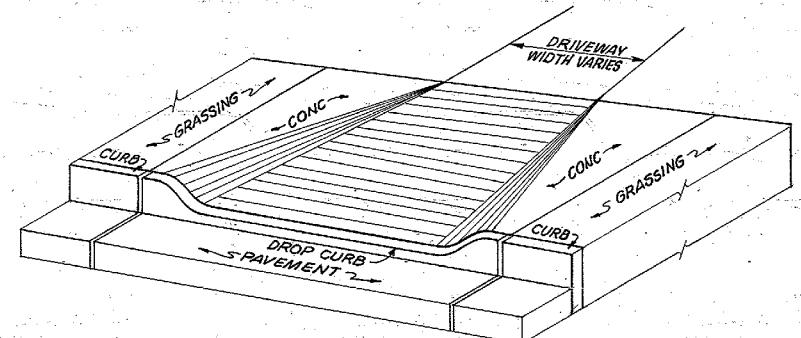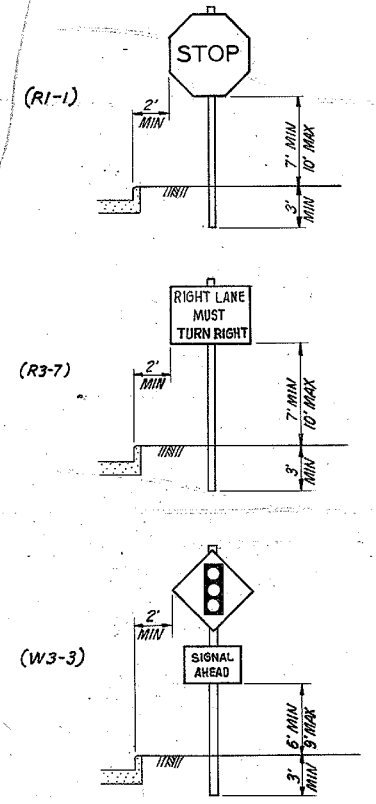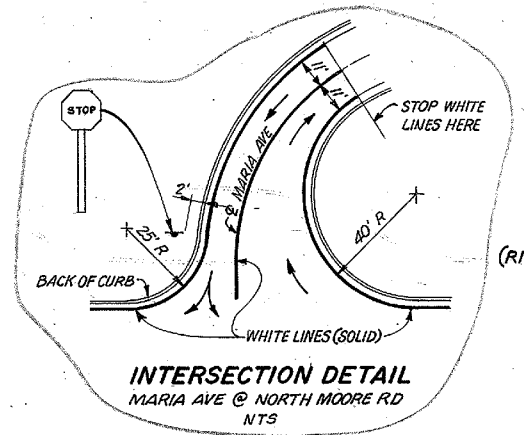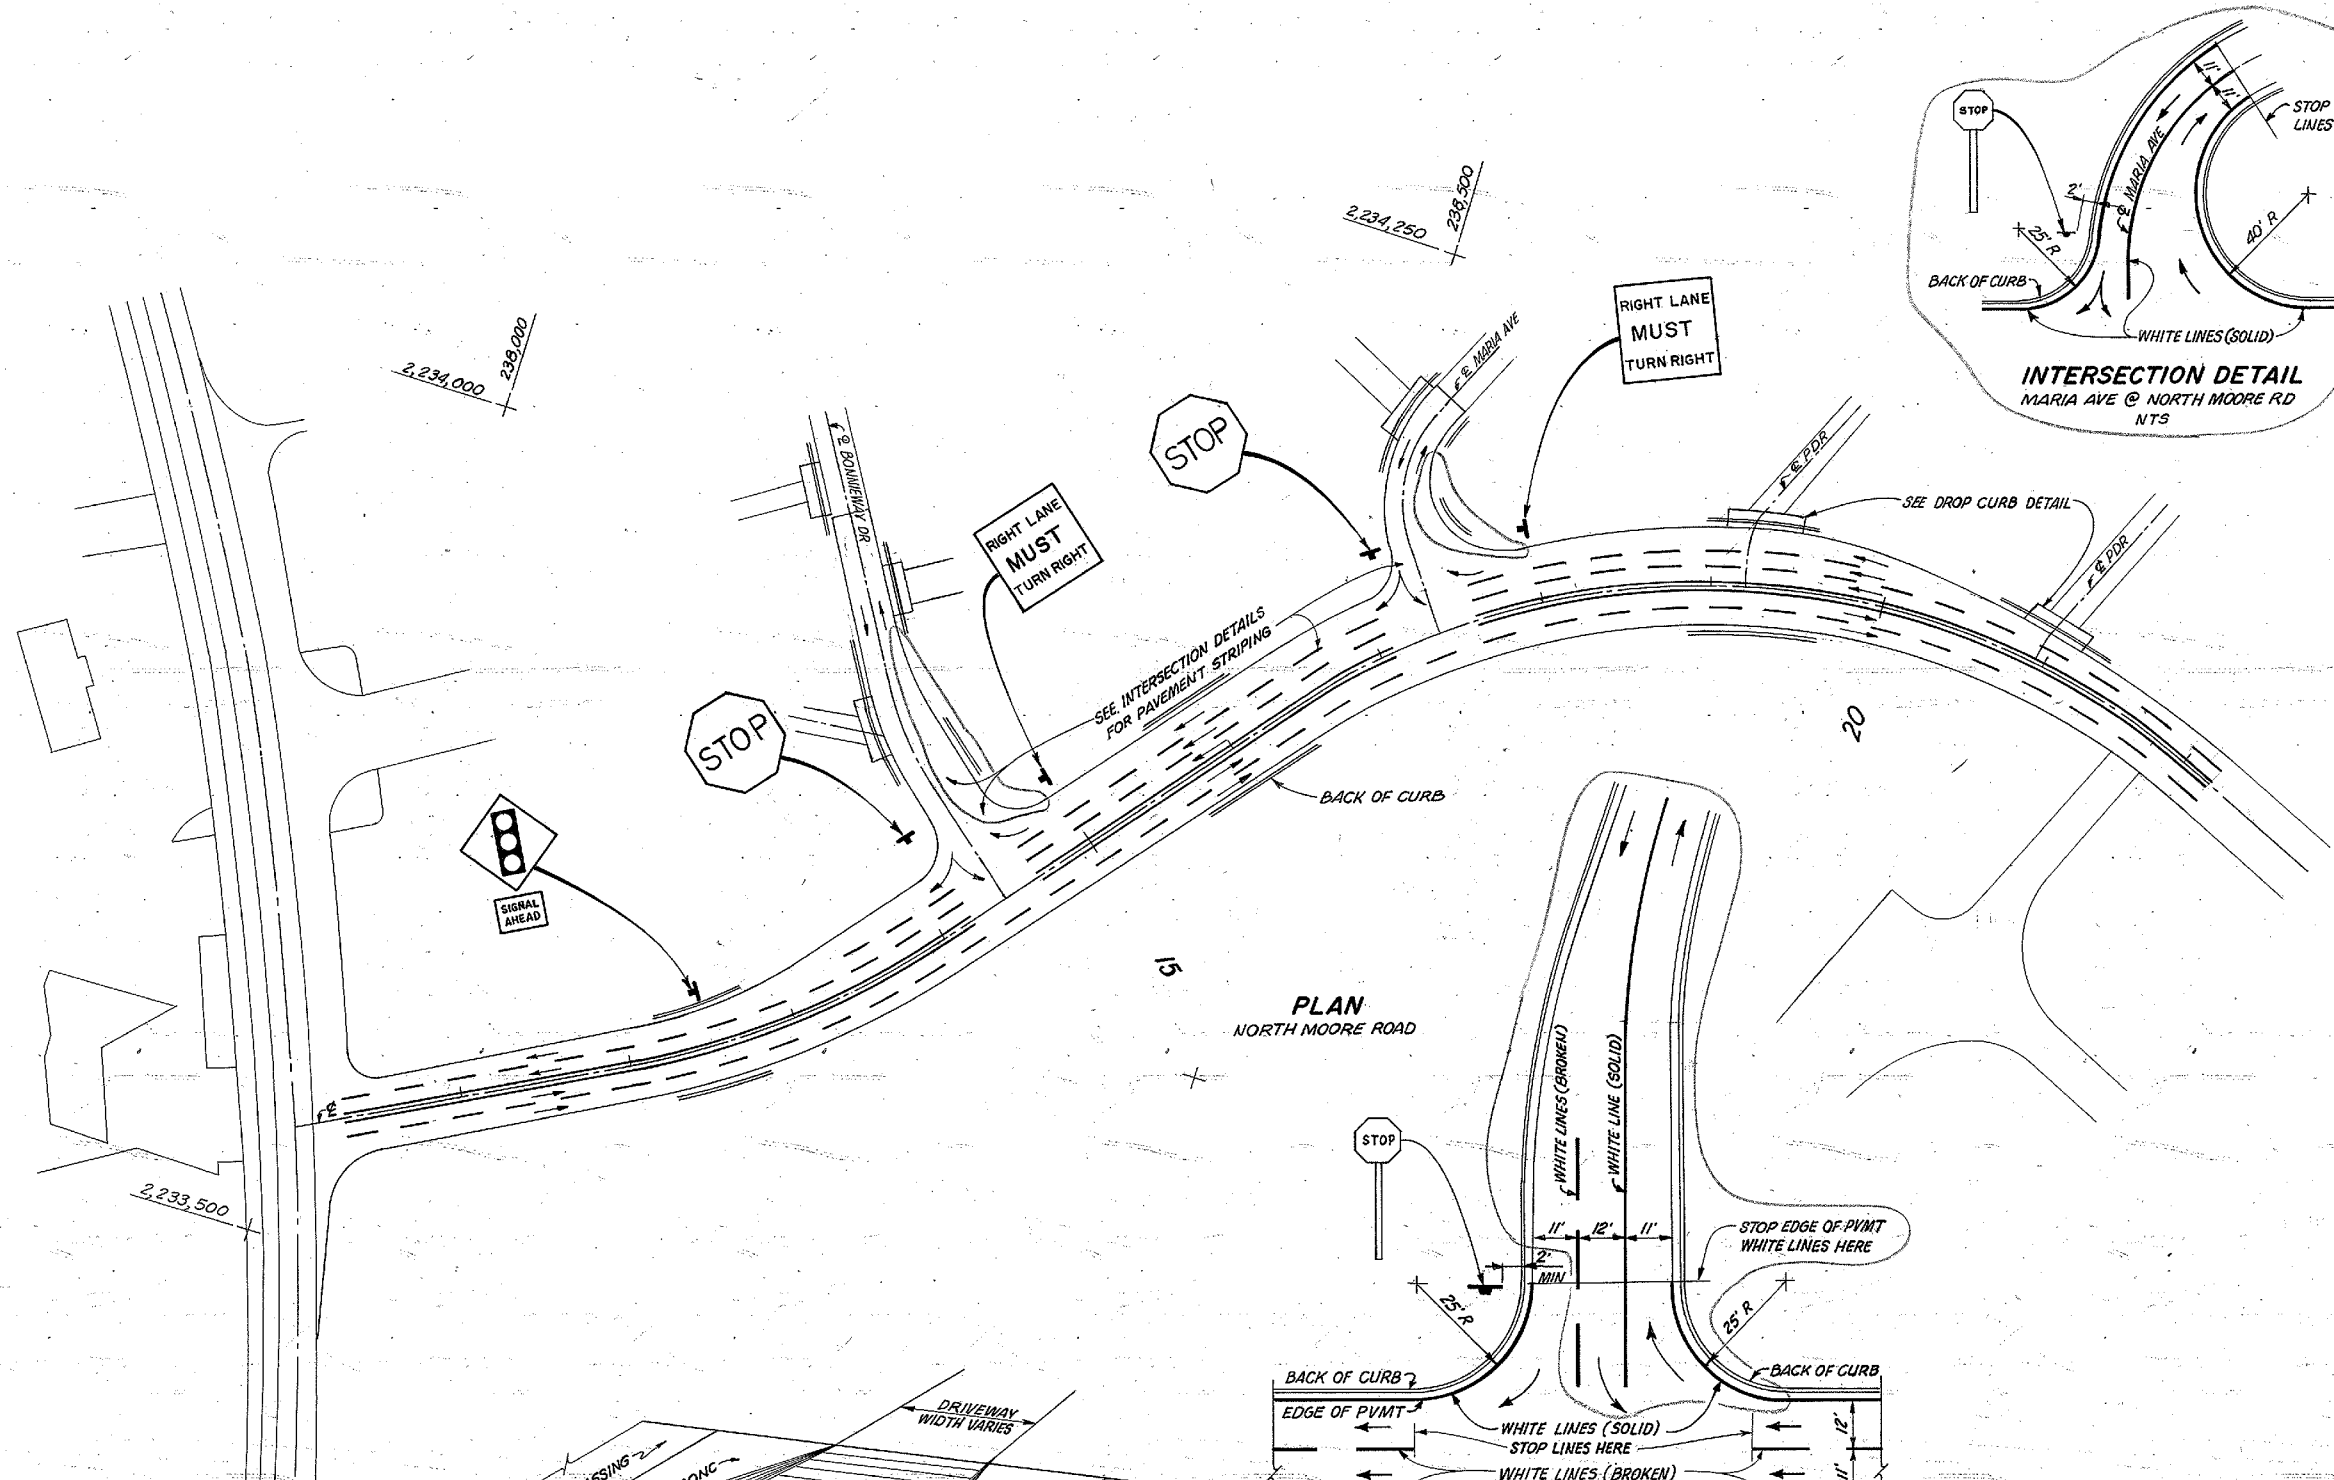

**DROP CURB DETAIL**  
NTS (SEE 19H251)

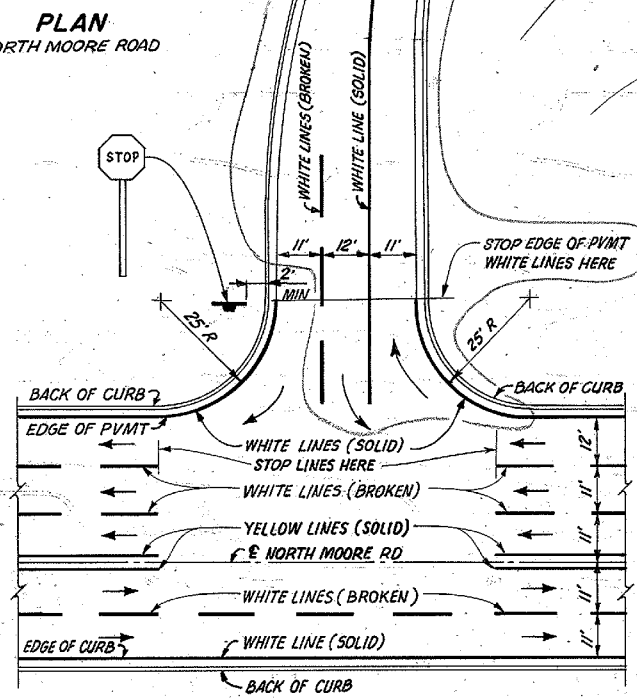

**INTERSECTION DETAIL**  
BONNIEJEWAY DR @ NORTH MOORE RD  
SCALE 1" = 20'

SCALE: 1" = 50'  
EXCEPT AS NOTED

- NOTES:**
1. FOR TRAFFIC SIGN AND PAVEMENT STRIPING DETAILS SEE "MANUAL ON UNIFORM TRAFFIC CONTROL DEVICES" (D6, 1-1971)
  2. ALL MATERIALS REQUIRED FOR SIGNING AND STRIPING SHALL CONFORM TO CITY OF CHATTANOOGA STANDARDS AND SPECIFICATIONS AND SHALL BE OF THE SAME MANUFACTURE AS USED CURRENTLY BY THE CITY.
  3. FOR ADDITIONAL NOTES AND REFERENCE DRAWINGS SEE 101-19H252.


10-9-78									
REVISED INTERSECTIONS	NO.	DATE	DESIGN	CONC	SUPV	ENGR	INSP	INSTR	APPR
DSGN	H.L. PETTY		INSP		J.R. LEE				
CHD	W. R. LEE		ENGR		W. R. LEE				
SUPV	W. R. LEE		ENGR		W. R. LEE				
NORTH MOORE ROAD RELOCATION									
TRAFFIC CONTROL DEVICES PAVEMENT STRIPING AND DROP CURB DETAILS									
SOUTH CHICKAMAUGA CREEK PROJECT TENNESSEE VALLEY AUTHORITY DIVISION OF ENGINEERING DESIGN									
SUBMITTED		RECOMMENDED		APPROVED					
[Signature]		[Signature]		[Signature]					
KNOXVILLE 12-4-78 81 HR 101-19H257 RI									
RECORD DRAWING AS CONSTRUCTED									

1	2	3	4	5	6
---	---	---	---	---	---

XX



BY	DATE
DESIGNED	1997/14
CHECKED	
DATE	
REVISIONS	
NO.	DESCRIPTION
1	
2	
3	
4	
5	

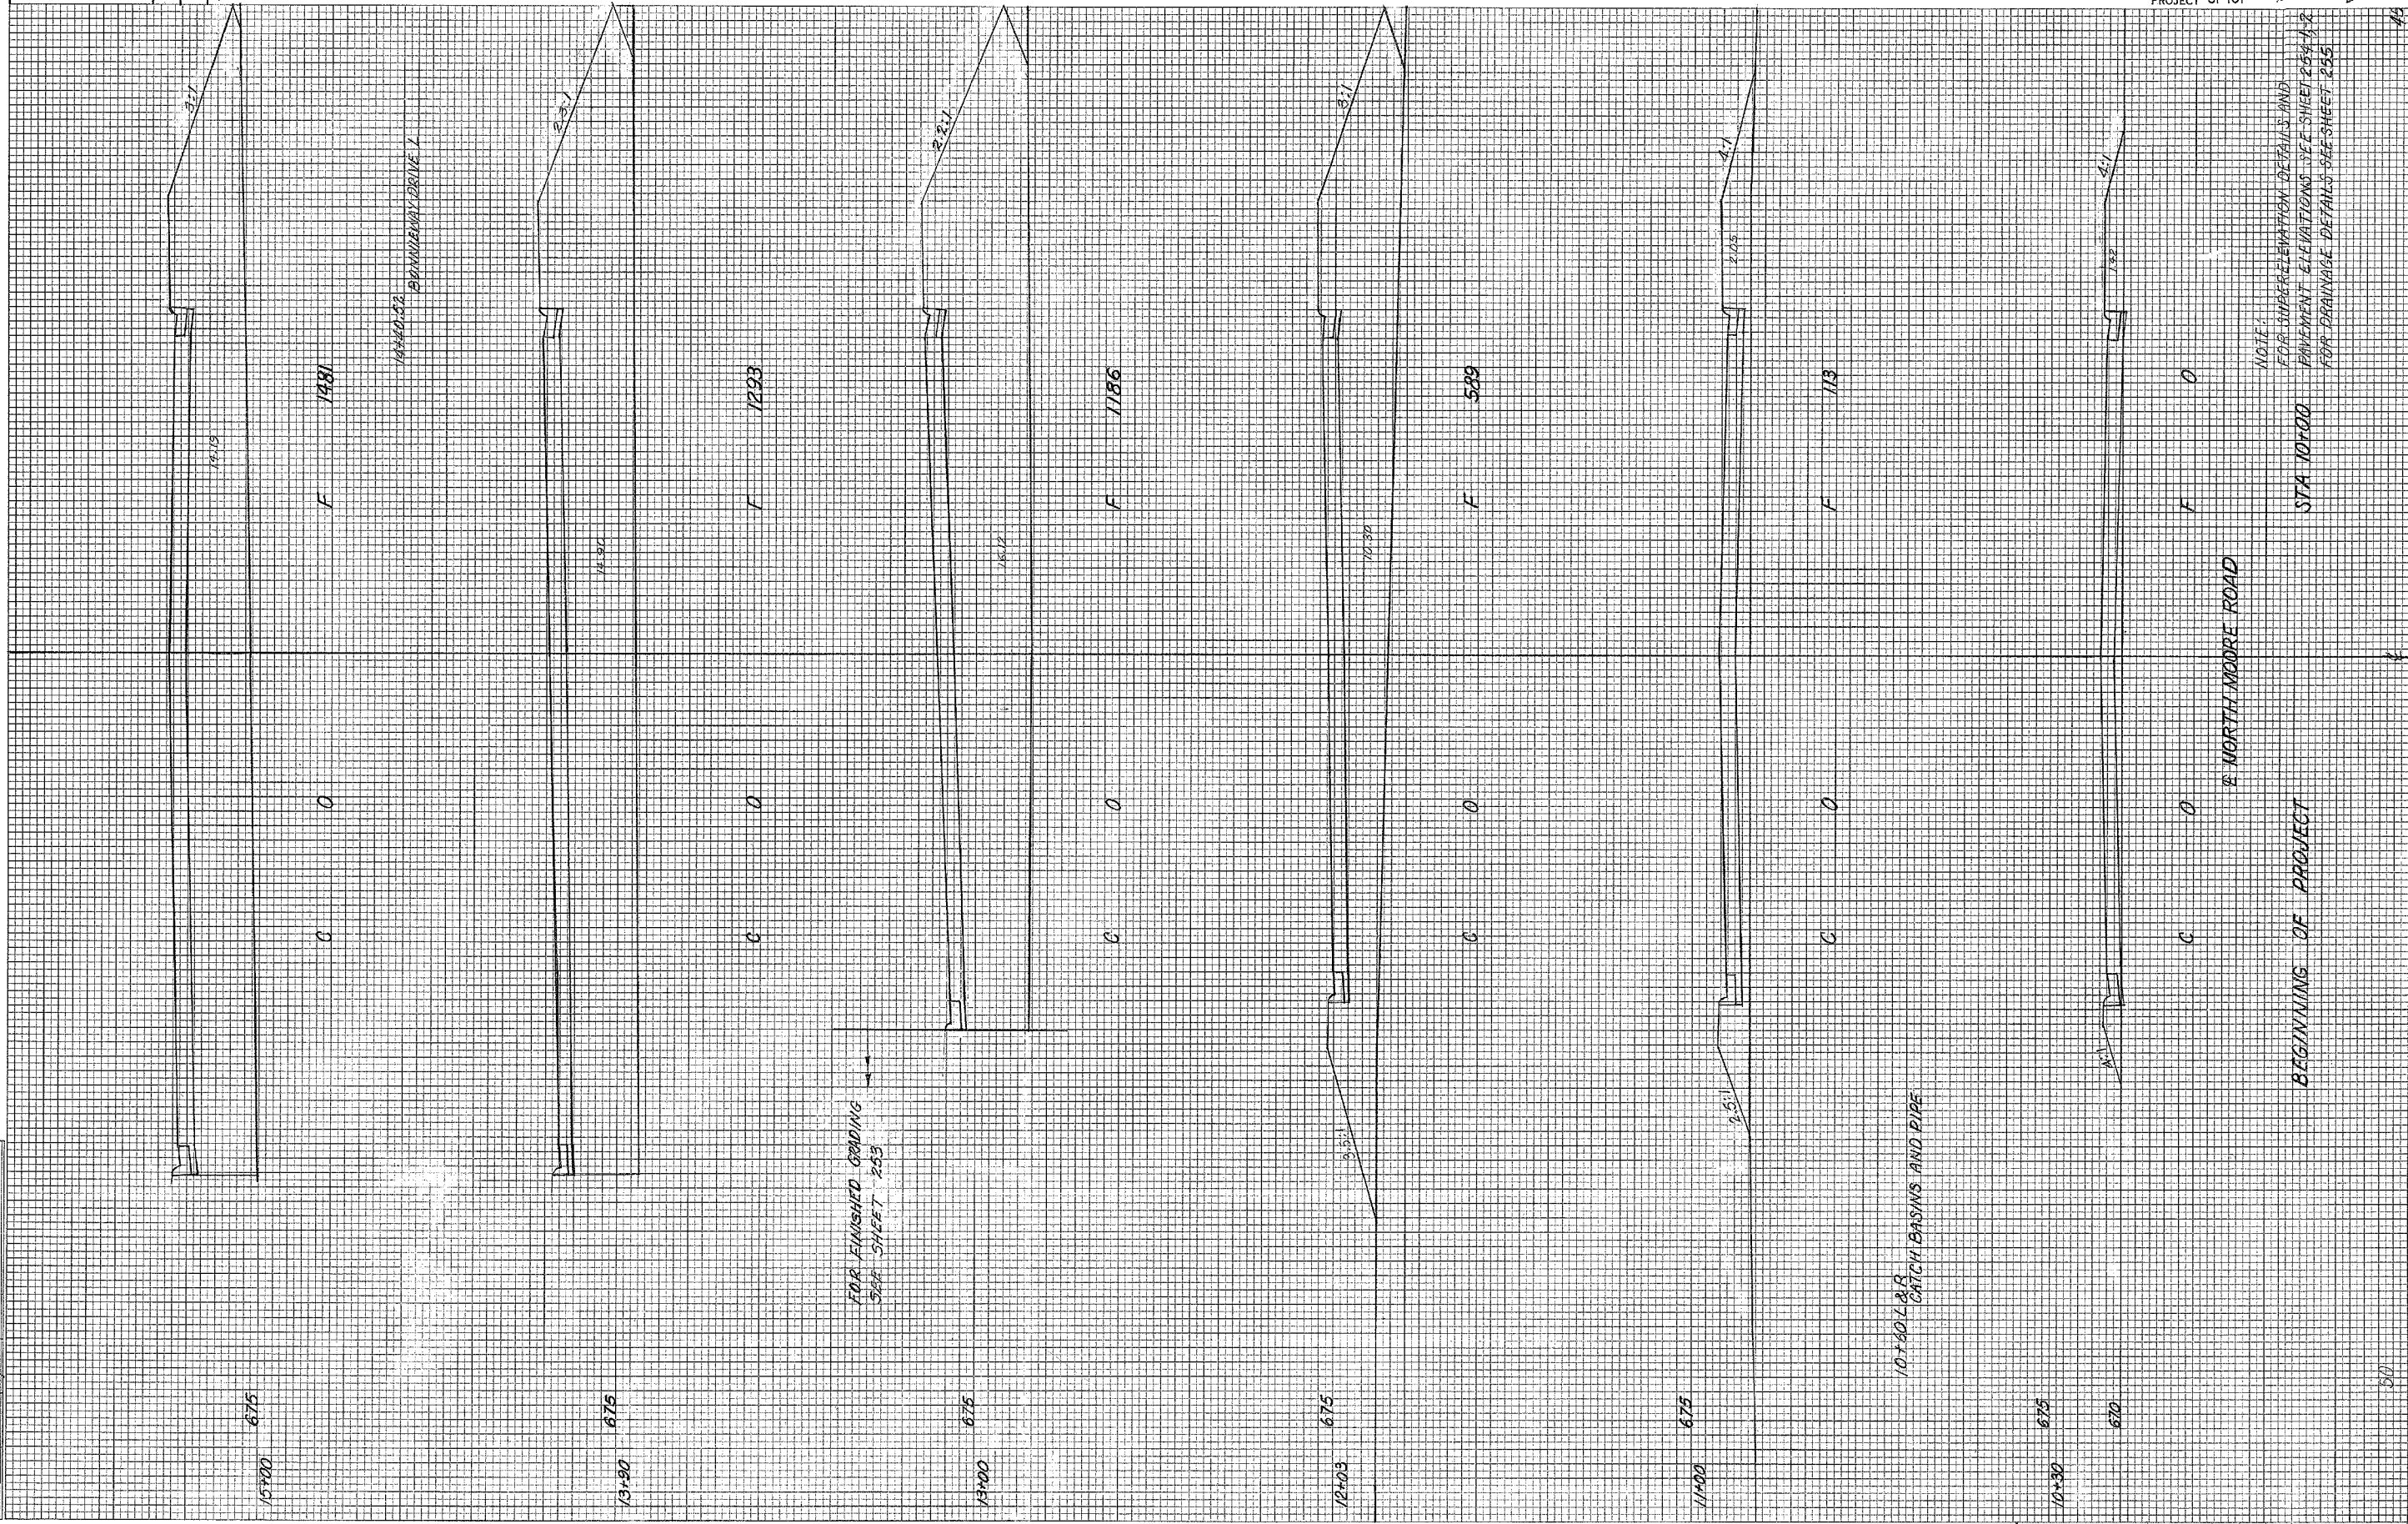

F 1331

F 1293

F 1186

F 589

F 113

F 0

675

675

670

FOR FINISHED GRADING  
SEE SHEET 253

10" x 60" L & S  
CATCH BASINS AND PIPE

E NORTH MOORE ROAD


BEGINNING OF PROJECT

NOTE:  
FOR SUPERELEVATION DETAILS AND  
PAVEMENT ELEVATIONS SEE SHEET 254-1 & 2  
FOR DRAINAGE DETAILS SEE SHEET 255

STA 101000



BY	CHECKED	DATE
PLOTTED	12.1.07	12/1/07
APPROVED	12.1.07	12/1/07
VOLUMES	1	2
REVISIONS		

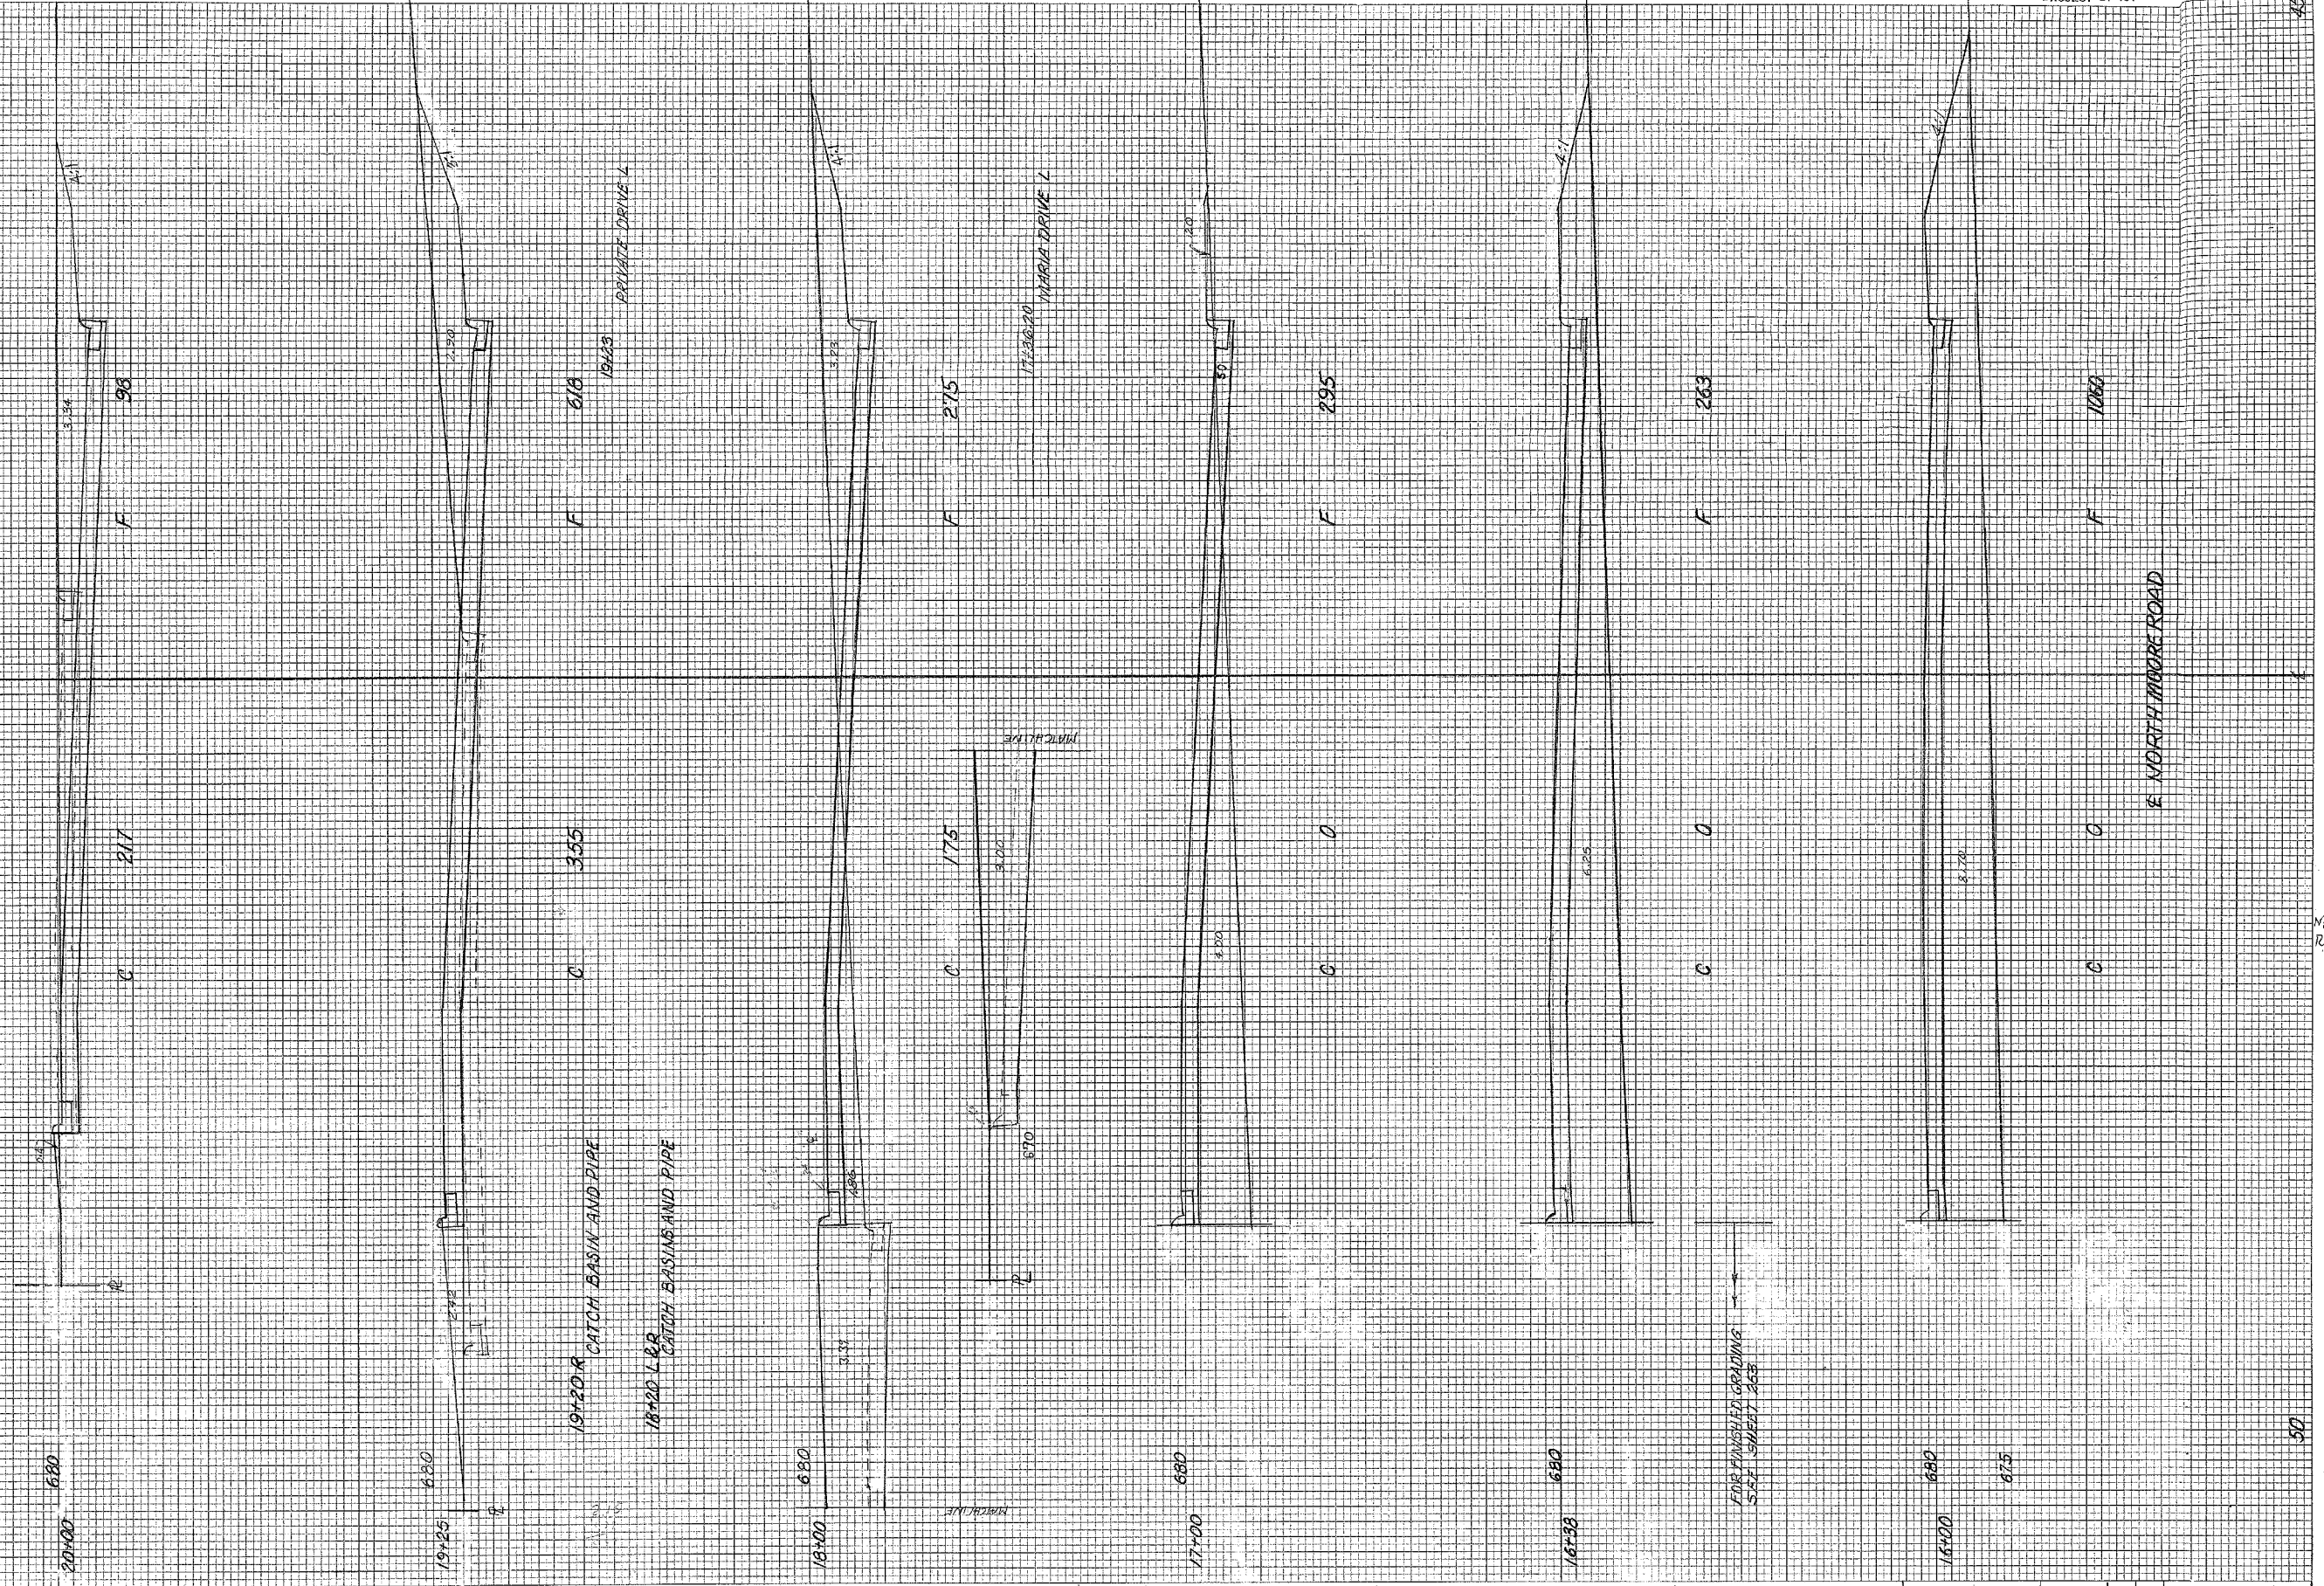



NOTED	BY	CHECKED	DATE
1/18/81	1/18/81	1/18/81	1/18/81
1/18/81	1/18/81	1/18/81	1/18/81
KRE 252 3061\*

END OF PROJECT

STA 22+11.3

22+11.3 680

21+85 680

21+65.7 680

20+90 680

675

E NORTHMOORE ROAD

20+95 PRIVATE DRIVE L


END NEW CLURE CONSTRUCTION RIGHT

EXIST. PAVT.

50

MT RO

76

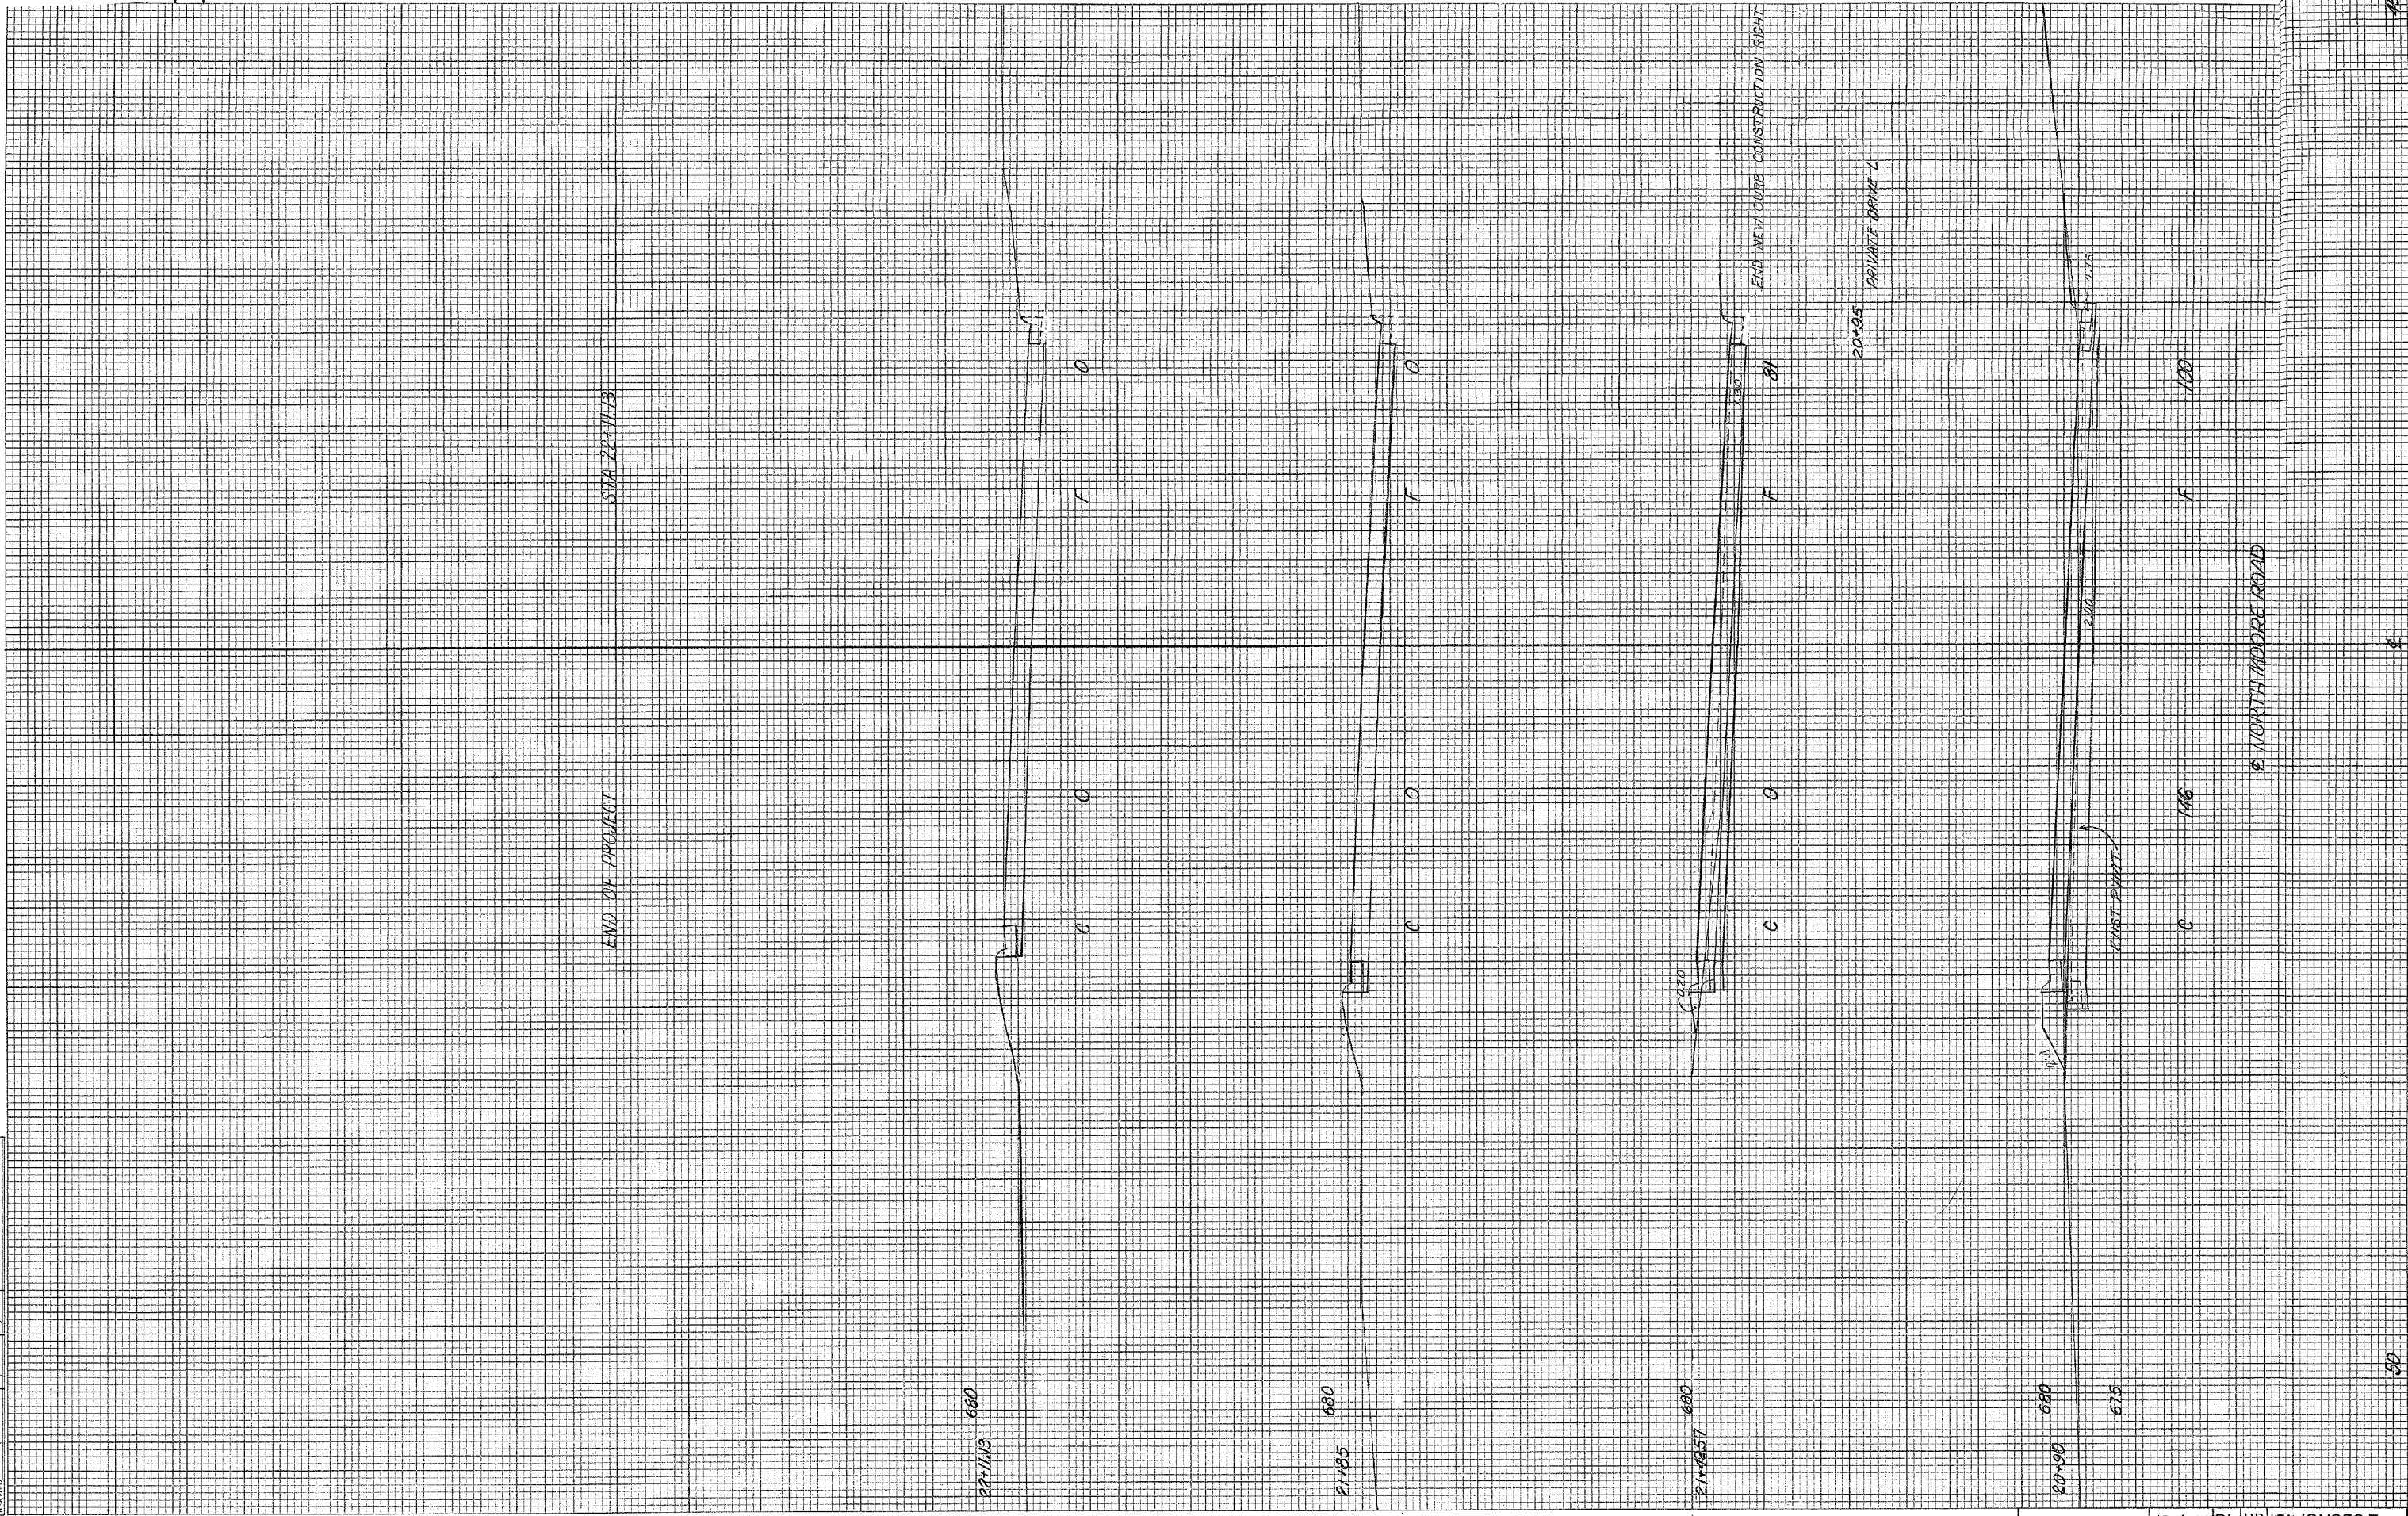



BY	CHECKED	DATE
J.B. LEV	J.B. LEV	10/11/78
AREA		
QUANTITIES		
REVISIONS		

END OF PROJECT

CUT=0

STA 4+66

FILL= 216 CU YDS.

FOR CONTOURS SEE  
GRADING PLAN 511-253

214

5.80

F 200

C 0

S. 2

650

NORTH STRAVER RD

NORTH STRAVER RD

MATCH

6.75

680

680

F 128

C 0

4+09.91 R  
CATCH BASIN AND PIPE

680

680

UNSTABLE ELEMENT

SEE 511-253

F 19

C 0

3+80  
DEWATERING

675

675

F 0

C 0

675

675

670

670

F 0

C 0

MARIA AVENUE

BEGINNING OF PROJECT


STA 3+54



BY	DATE
DESIGNED	10/17/78
CHECKED	10/17/78
DATE	
BY	
DATE	
BY	
DATE	
BY	
DATE	


END OF PROJECT  
CUT = 0

STA 4+86  
FILL = 387 CU YDS.

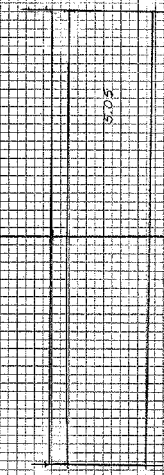

C 0  
F 175


4+66  
680

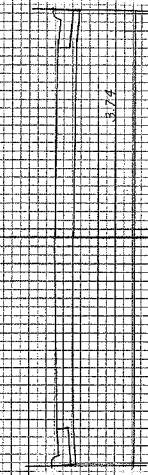

C 0  
F 115

4+23  
680


STAGGER LEVÉE ACCESS R

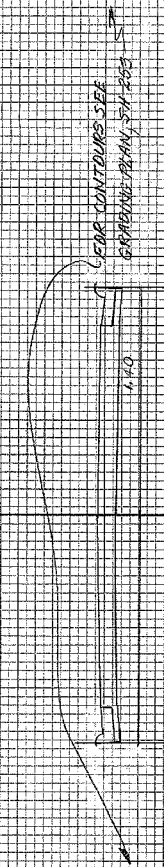

C 0  
F 56

3+62  
680

3+37.97 R&L  
CATCH BASINS AND PIPES

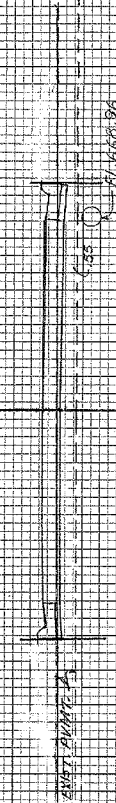

C 0  
F 11

3+00  
680

2+42 PRIVATE DRIVE A



C 0  
F 0

2+56.5  
680


675

24-47.97 R&L  
EXISTING CATCH BASIN  
AND PIPE


4 BONNEWAY DRIVE

BEGINNING OF PROJECT

STA 2+56.5

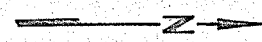

PRELIMINARY LAND OWNERSHIP MAP  
NO. 6-MS-421-P-630-1

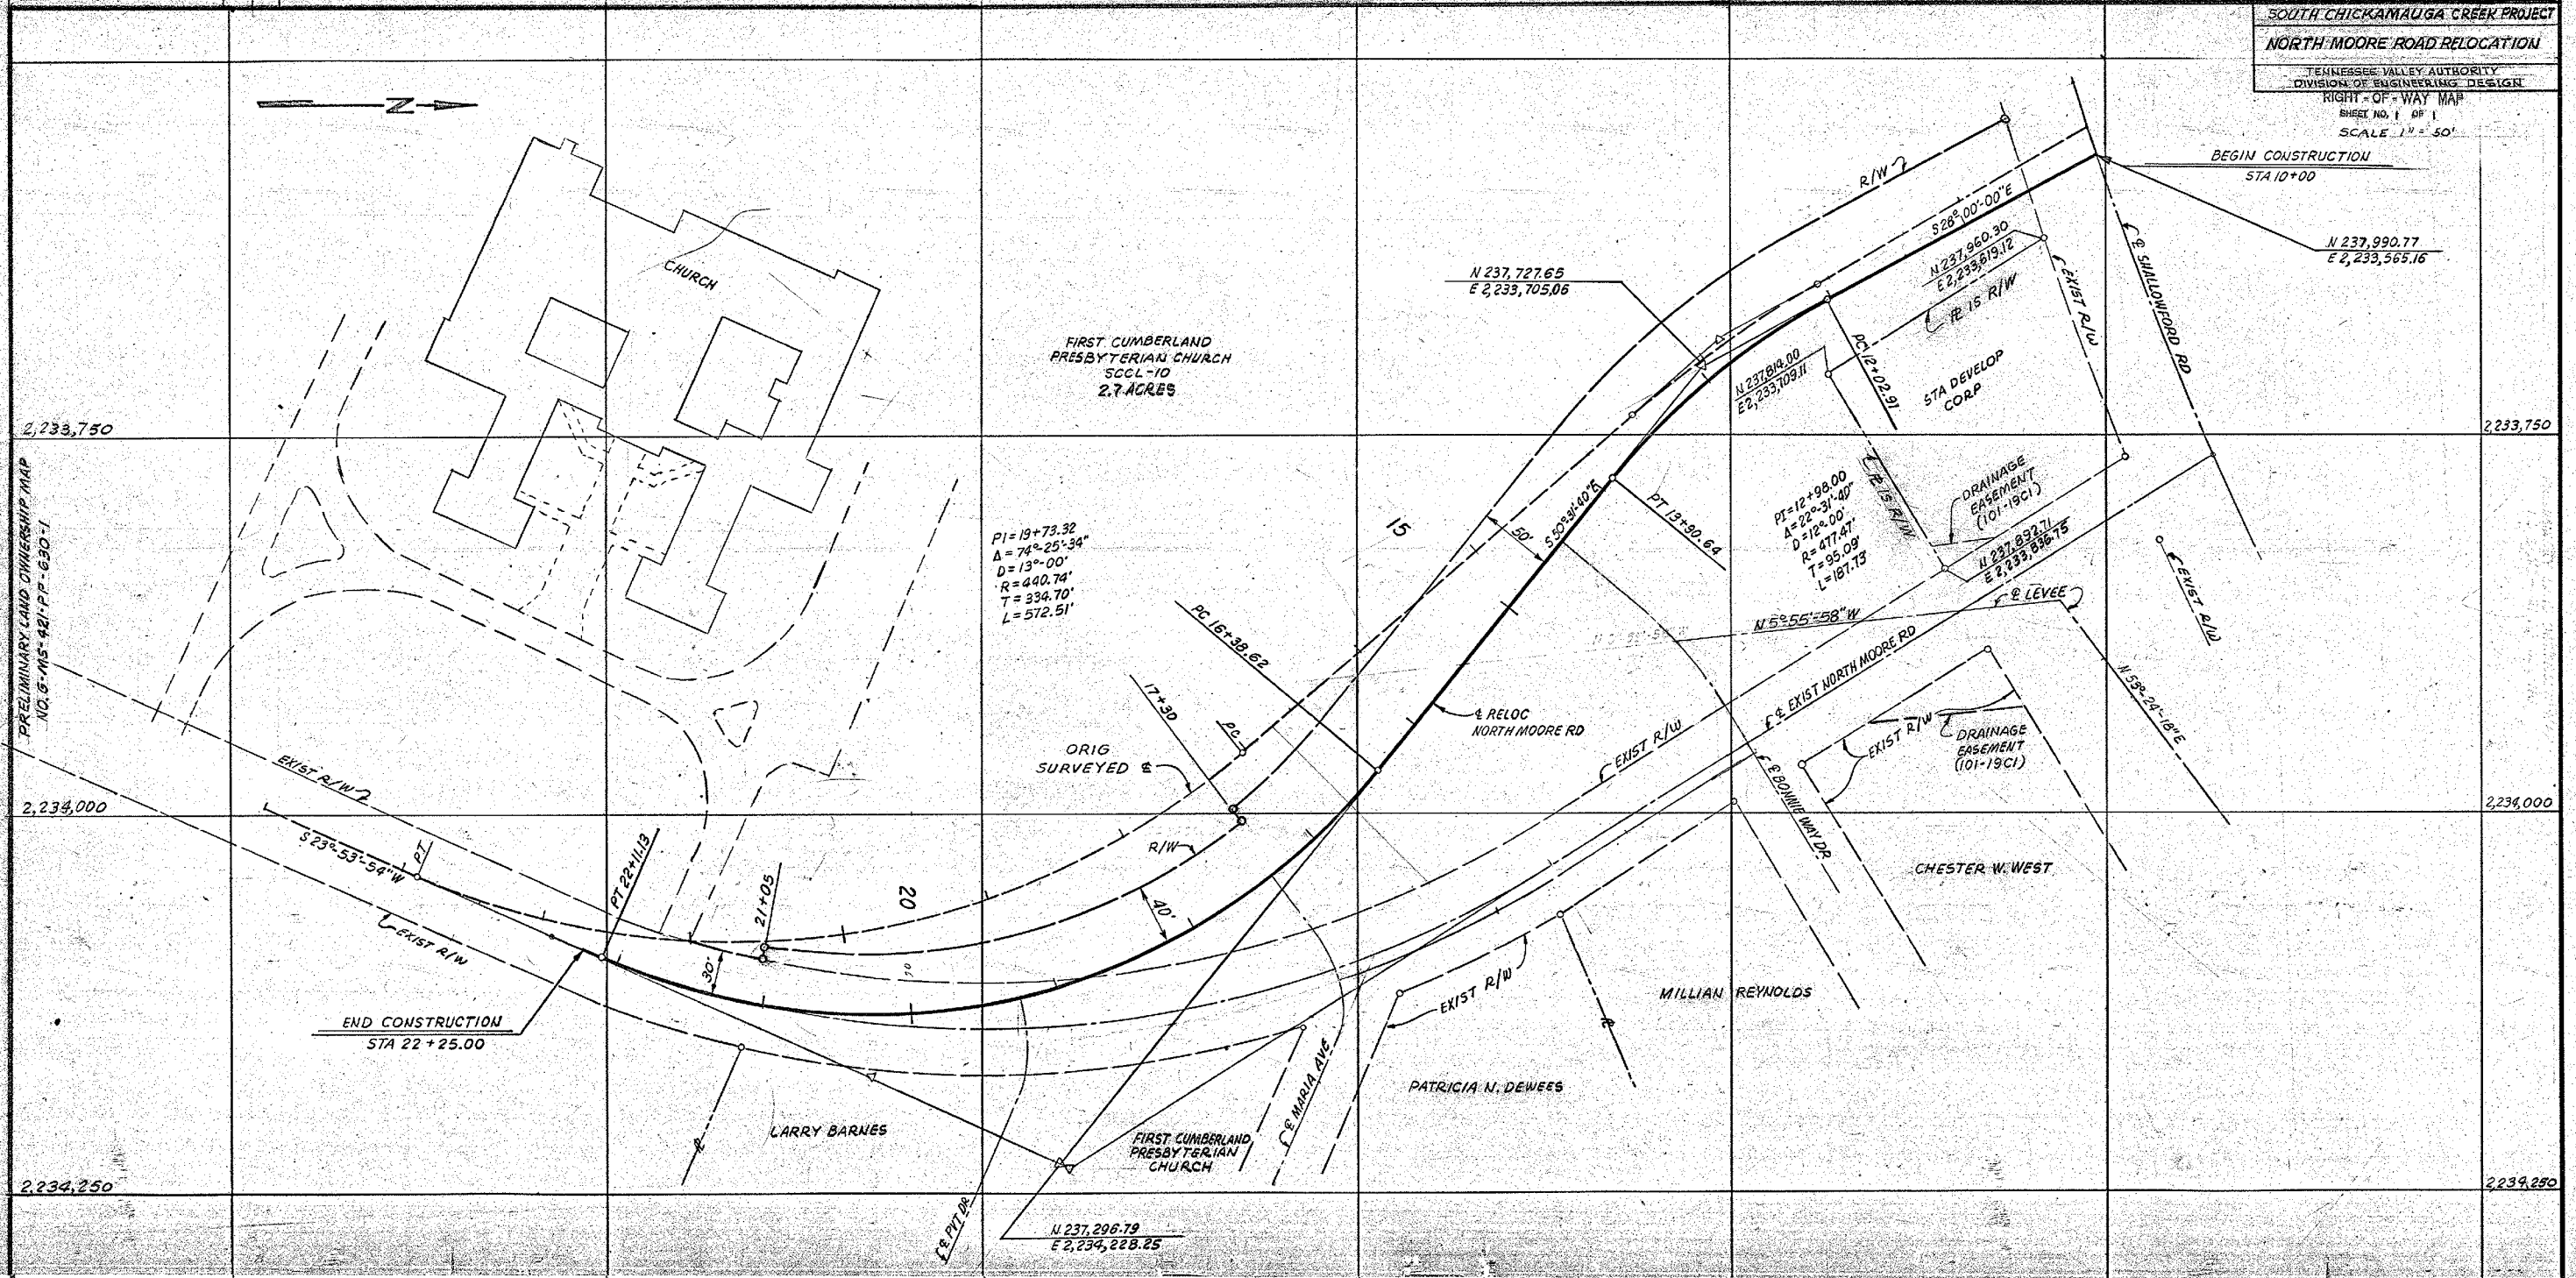

BEGIN CONSTRUCTION  
STA 10+00

END CONSTRUCTION  
STA 22+25.00

N 237,990.77  
E 2,233,565.16

N 237,727.65  
E 2,233,705.06

PT=12+98.00  
A=22°31'40"  
D=122.00'  
R=177.41'  
T=95.09'  
L=187.13

PI=19+73.32  
A=74°25'34"  
D=13°00'  
R=440.74'  
T=334.70'  
L=572.51'

FIRST CUMBERLAND  
PRESBYTERIAN CHURCH  
SCCL-10  
2.7 ACRES

CHESTER W. WEST

MILLIAN REYNOLDS

PATRICIA N. DEWEES

LARRY BARNES

FIRST CUMBERLAND  
PRESBYTERIAN  
CHURCH



CITY OF CHATTANOOGA  
HAMILTON COUNTY, TENNESSEE

DRAWN: V.R. LEE  
CHECKED: R.B.R.  
INSP: E.C. B...  
R.R. J.D.



OSBORNE FARM ROAD ACROSS LEVEE  
SOUTH CHICKAMAUGA CREEK PROJECT  
TENNESSEE VALLEY AUTHORITY  
DIVISION OF ENGINEERING DESIGN

SCALES: PLAN - 1"=50'  
HORIZ - 1"=50'  
PROFILE - VERT: 1"=10'

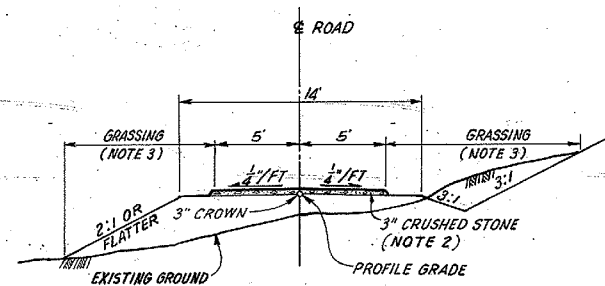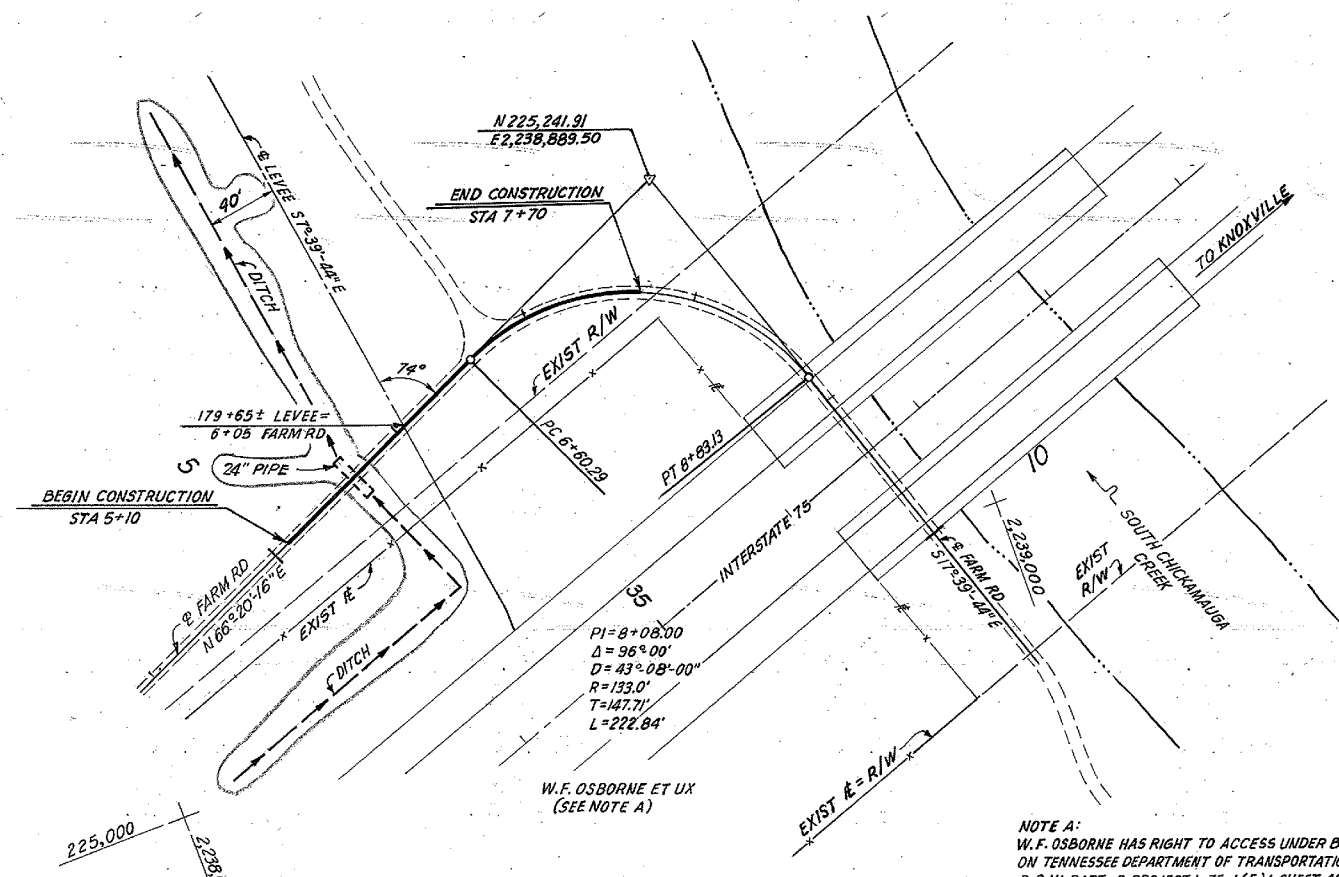

TYPICAL SECTION  
NTS

LENGTH OF PROJECT = .05 MILE


ITEM NO	DESCRIPTION	QUANTITY
123	EARTH BORROW EXCAVATION	350 C.Y.
180 & 182	SEEDING & MULCHING	580 S.Y.
210	CRUSHED STONE	39 TONS
129	STRUCTURAL EXCAVATION	20 C.Y.
402	CLASS B CONCRETE	318 C.Y.
418	REINFORCING STEEL	45 LBS
602	24" CONCRETE PIPE	28 L.F.


INDEX TO SHEETS	
TITLE	SHEET NO
PLAN AND PROFILE	101-19H260

- NOTES:
1. ALL CONSTRUCTION TO BE IN ACCORDANCE WITH THE HIGHWAY T-1 SPECIFICATIONS UNLESS OTHERWISE NOTED
  2. SURFACING SHALL BE 3" OF CRUSHED STONE PLACED IN ACCORDANCE WITH SECTION 210.
  3. GRASSING: ALL CUT AND FILL SLOPES AND DISTURBED AREAS SHALL BE SEEDED, TYPE 7 MIXTURE, SHOULDERS AND DITCH SLOPES SHALL BE SEEDED WITH TYPE 5 MIXTURE. ALL GRASSED AREAS SHALL BE FERTILIZED AND MULCHED IN ACCORDANCE WITH SECTION 180 & 182 RESPECTIVELY.

NOTE A:  
W.F. OSBORNE HAS RIGHT TO ACCESS UNDER BRIDGE GRANTED ON TENNESSEE DEPARTMENT OF TRANSPORTATION PLANS FOR R.O.W. PART-2 PROJECT 1-75-1(5)1 SHEET 4B OF 244.

CITY OF CHATTANOOGA  
HAMILTON COUNTY, TENN

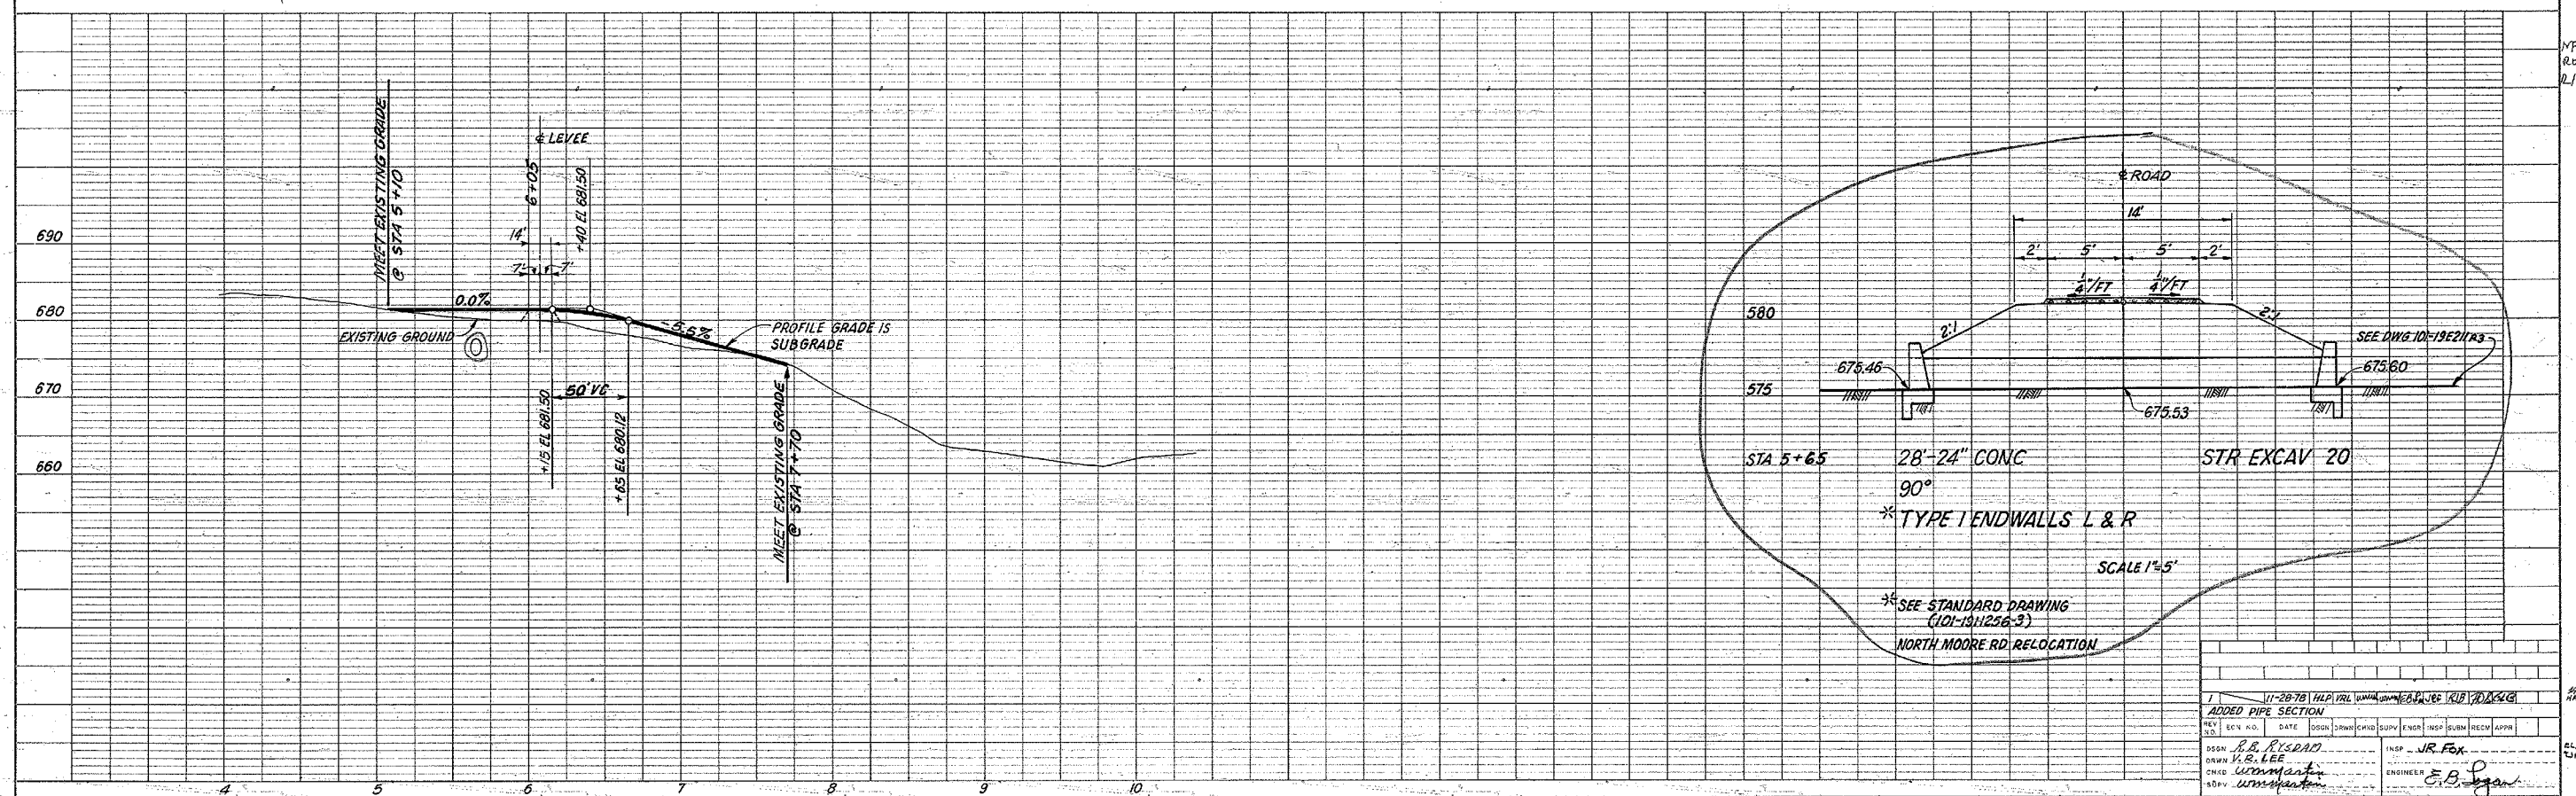

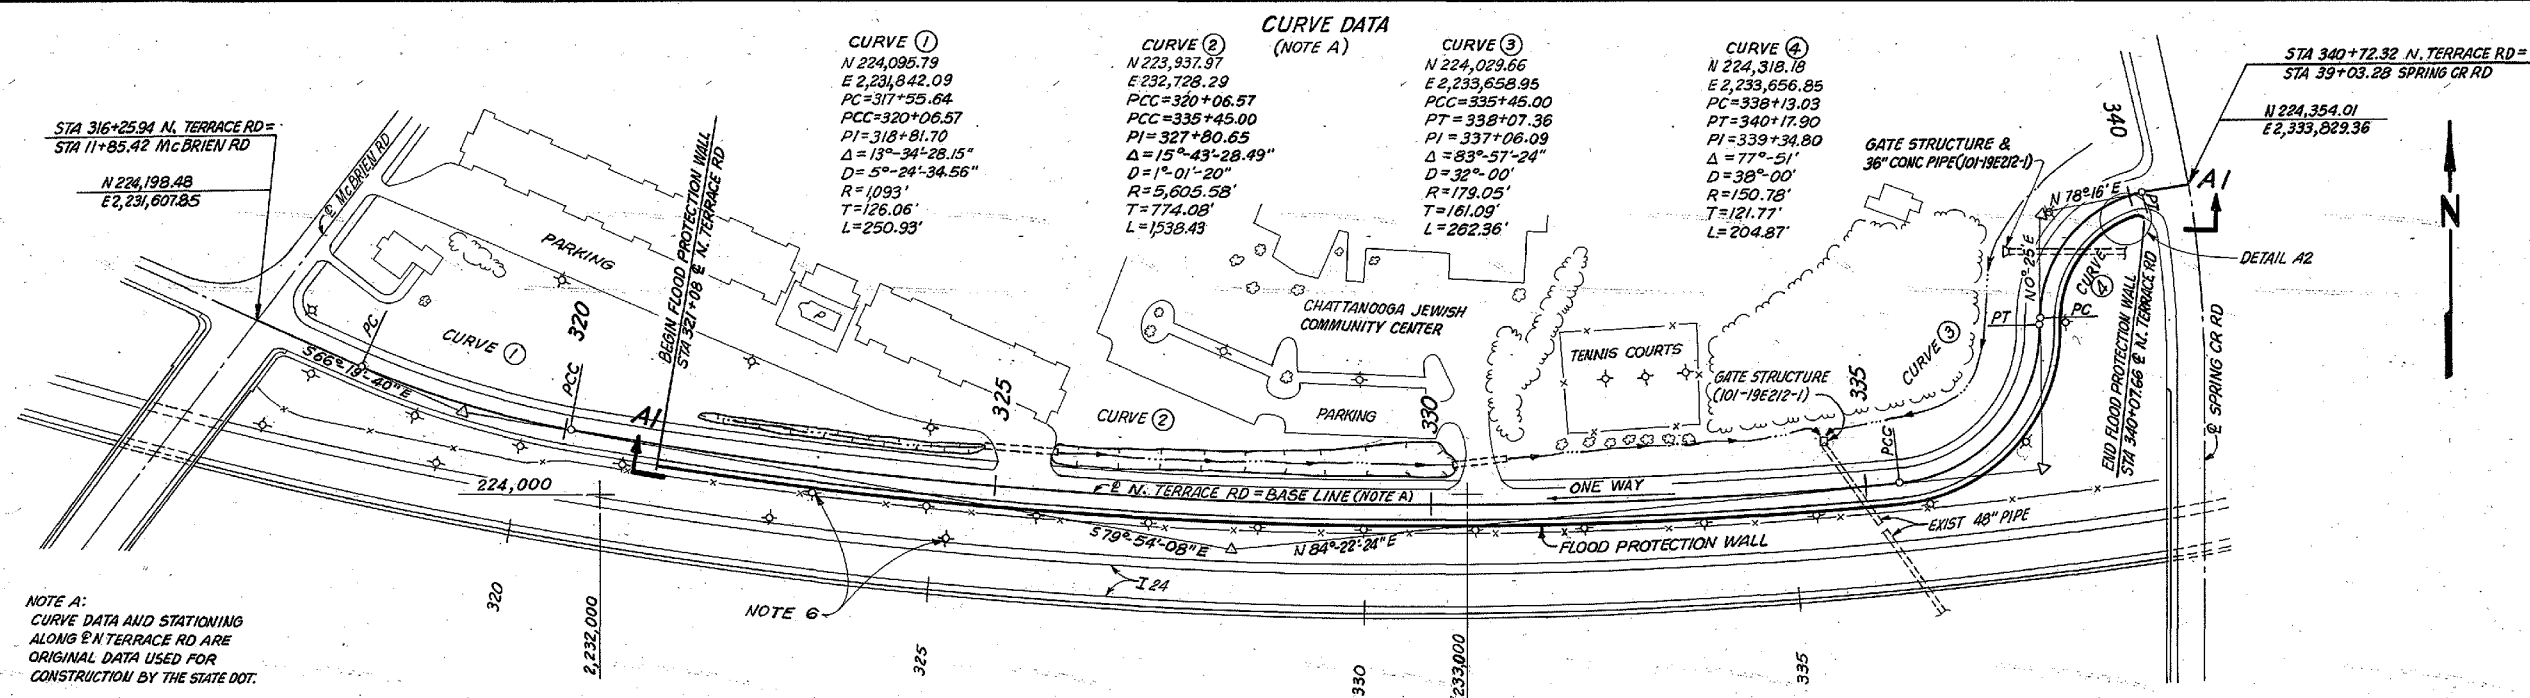


**CURVE DATA (NOTE A)**

CURVE	PC	PCC	PT	PI	Δ	D	R	T	L		
CURVE ①	N 224,095.79	E 2,231,842.09	PC=317+55.64	PCC=320+06.57	PT=318+81.70	PI=318+81.70	Δ=13°-34'-28.15"	D=5°-24'-34.56"	R=1093'	T=126.06'	L=250.93'
CURVE ②	N 223,937.97	E 2,232,728.29	PC=320+06.57	PCC=335+45.00	PT=327+80.65	PI=327+80.65	Δ=15°-43'-28.49"	D=1°-01'-20"	R=5,605.58'	T=774.08'	L=1538.43'
CURVE ③	N 224,029.66	E 2,233,658.95	PC=335+45.00	PCC=338+07.36	PT=337+06.09	PI=337+06.09	Δ=83°-57'-24"	D=32°-00'	R=179.05'	T=161.09'	L=262.36'
CURVE ④	N 224,318.18	E 2,233,656.85	PC=338+07.36	PCC=340+17.90	PT=340+17.90	PI=339+34.80	Δ=77°-51'	D=38°-00'	R=150.78'	T=121.77'	L=204.87'

NOTE A:  
CURVE DATA AND STATIONING  
ALONG N. TERRACE RD ARE  
ORIGINAL DATA USED FOR  
CONSTRUCTION BY THE STATE DOT.

PLAN  
SCALE: 1"=100'

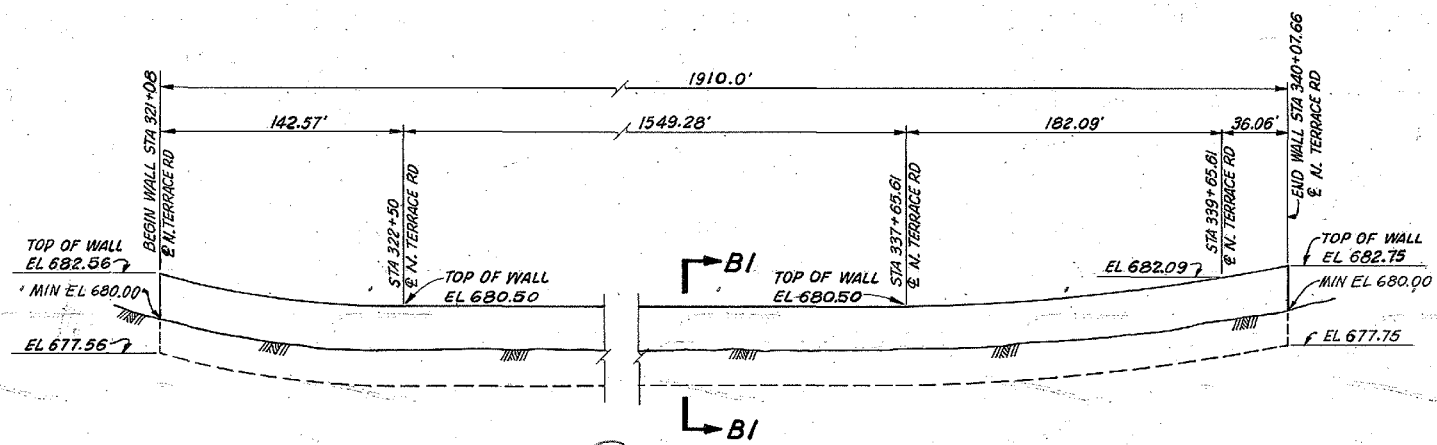


**SUMMARY OF QUANTITIES**

ITEM NO	DESCRIPTION	QUANTITY
129	EXCAVATION FOR STRUCTURE	560 C.Y.
180 & 182	SEEDING & MULCHING	1,060 S.Y.
225	STABILIZED BASE	250 TONS
302	BITUMINOUS TACK COAT	.75 TON
345	ASPHALTIC CONC SURF COURSE	190 TONS
418	REINFORCEMENT STEEL	12,300 LBS
	TYPE I PVC SEAL	260 L.F.

\* PER GEN CONSTR SPEC NO. G-2

- NOTES:
- SPECIFICATIONS: ALL WORK SHALL BE IN ACCORDANCE WITH THE T-1 HIGHWAY SPECIFICATIONS, EXCEPT AS NOTED.
  - GRASSING: ALL DISTURBED AREAS SHALL BE SEEDED WITH TYPE 6a MIXTURE (SPRING SEEDING), TYPE 7a MIXTURE (SUMMER SEEDING), OR TYPE 8 MIXTURE (FALL SEEDING). SEEDING AND FERTILIZING AND MULCHING SHALL BE IN ACCORDANCE WITH SECTION 180 AND 182, RESPECTIVELY, OF T-1 SPECS.
  - FLOOD PROTECT WALL CONSTRUCTION SELECTS TO USE AN AUTOMATIC CURBING MACHINE WITH CONTINUOUS CURB ELEMENT IN CONTACT WITH THE FLOOD PROTECT WALL. THE REINFORCEMENT STEEL AND REVER JOINTS MAY BE EXEMPTED.
  - EARTH BACKFILL: EARTH BACKFILL SHALL BE PLACED AND THOROUGHLY COMPACTED PER SECTION 120.
  - SURFACING: STABILIZED BASE SHALL BE PLACED IN ACCORDANCE WITH SECTION 225, ASPHALTIC CONCRETE SURFACE COURSE PER SECTION 345, AND BIT TACK COAT PER SECTION 302 OF THE T-1 SPECS.
  - UTILITY POLES: THOSE UTILITY POLES (S) THAT CONFLICT WITH THE CONSTRUCTION OF THE FLOOD PROTECTION WALL SHALL BE RELOCATED BY OTHERS.

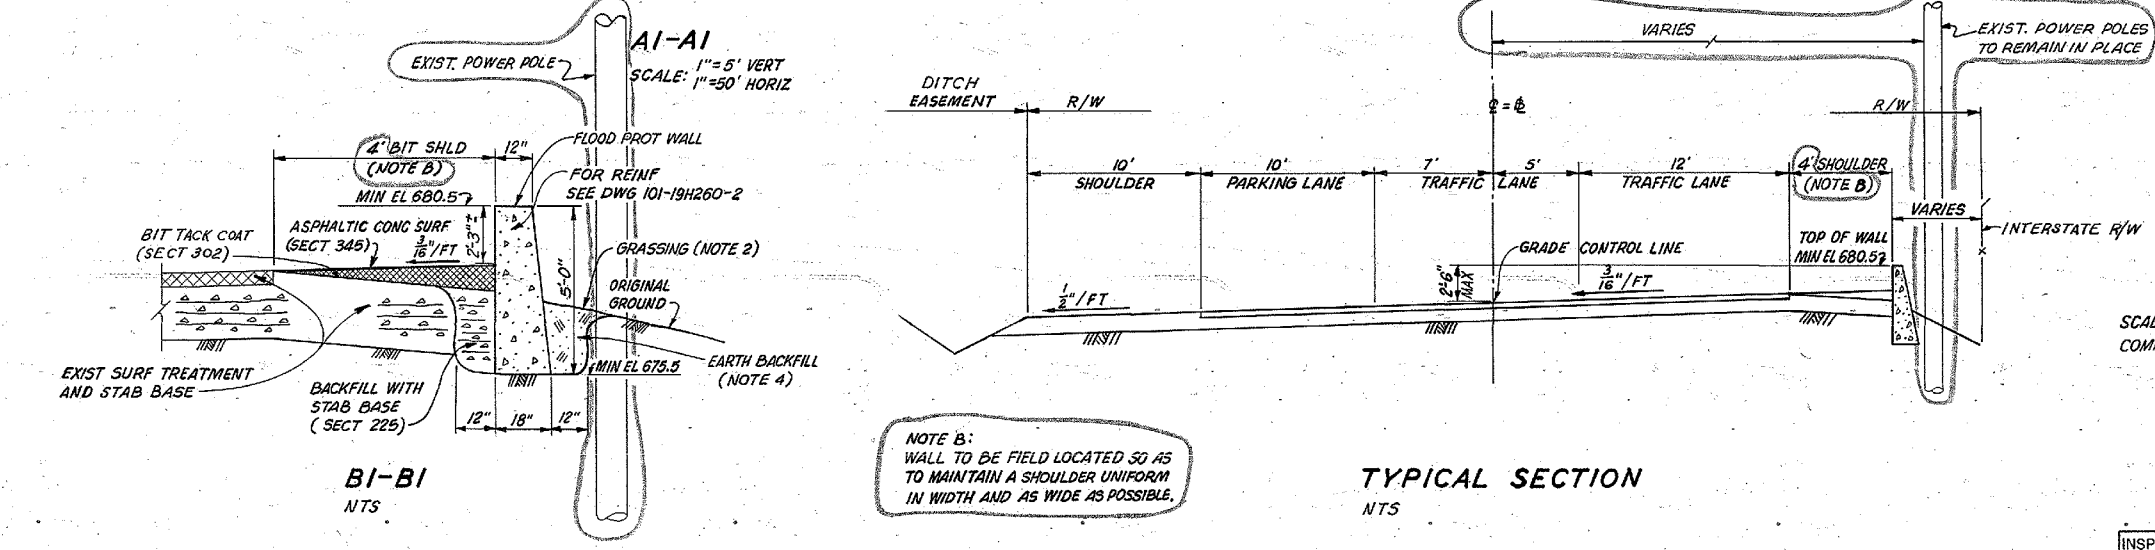

TYPICAL SECTION  
NTS

SCALE AS NOTED  
COMPANION DWG: 101-19H260-2

REVISED WALL LOCATION	DATE	DESIGN	CHECK	INSP	APPD

DESIGN: J.R. Lee  
CHECK: J.M. - umyaki  
INSP: J.R. Lee  
APPD: E.B. Logan

NORTH TERRACE ROAD  
FLOOD PROTECTION WALL

PLAN AND SECTIONS

SOUTH CHICKAMAUGA CREEK PROJECT  
TENNESSEE VALLEY AUTHORITY  
DIVISION OF ENGINEERING DESIGN

INSPECTED AND APPROVED FOR ISSUE: [Signature]  
SUBMITTED: [Signature] RECOMMENDED: [Signature] APPROVED: [Signature]











KNOXVILLE 8-10-78 81 HR 101-19H260-1R1  
RECORD DRAWING AS CONSTRUCTED







A  
B  
C  
D  
E  
F  
G  
H  
J  
K

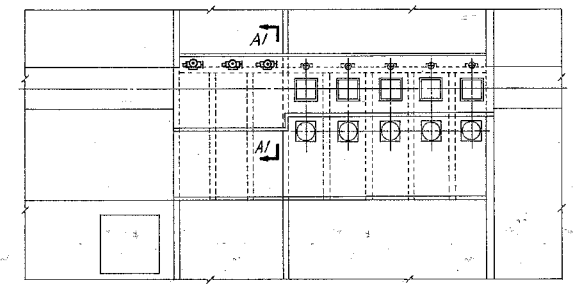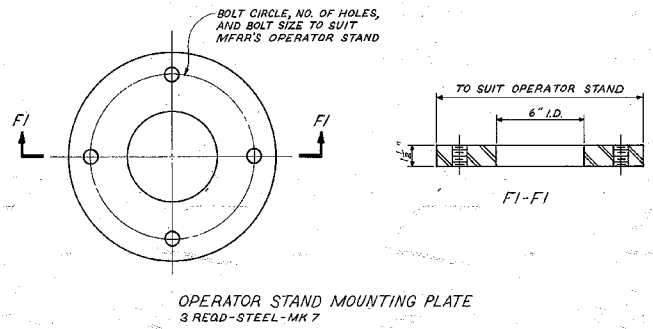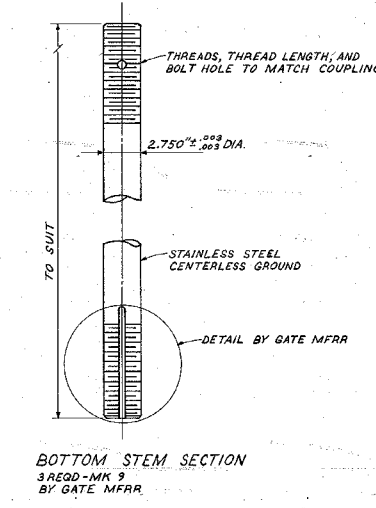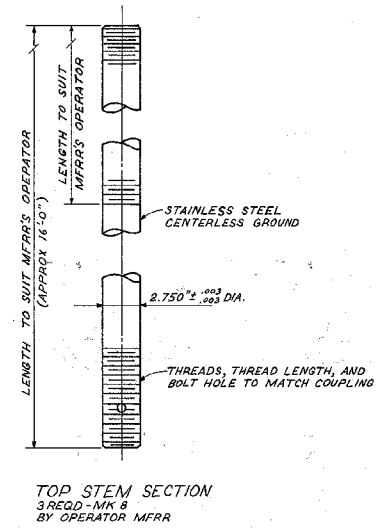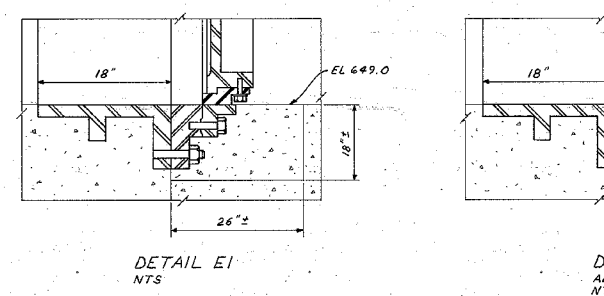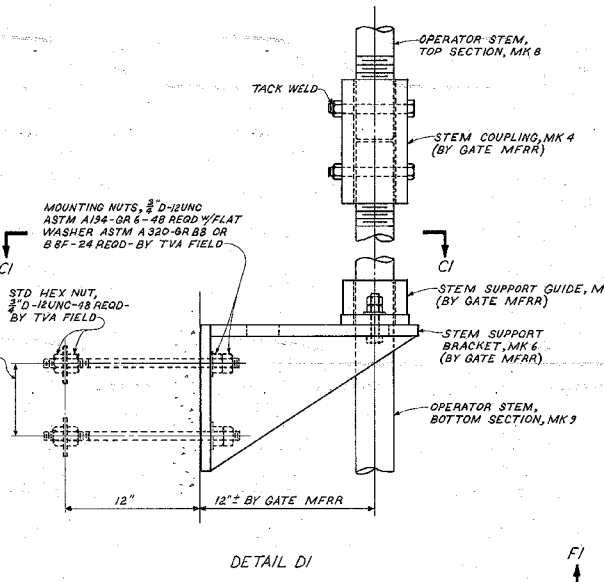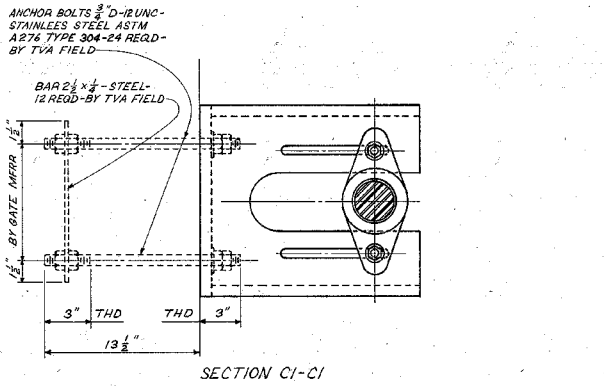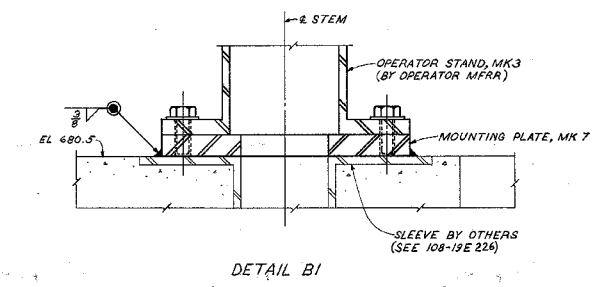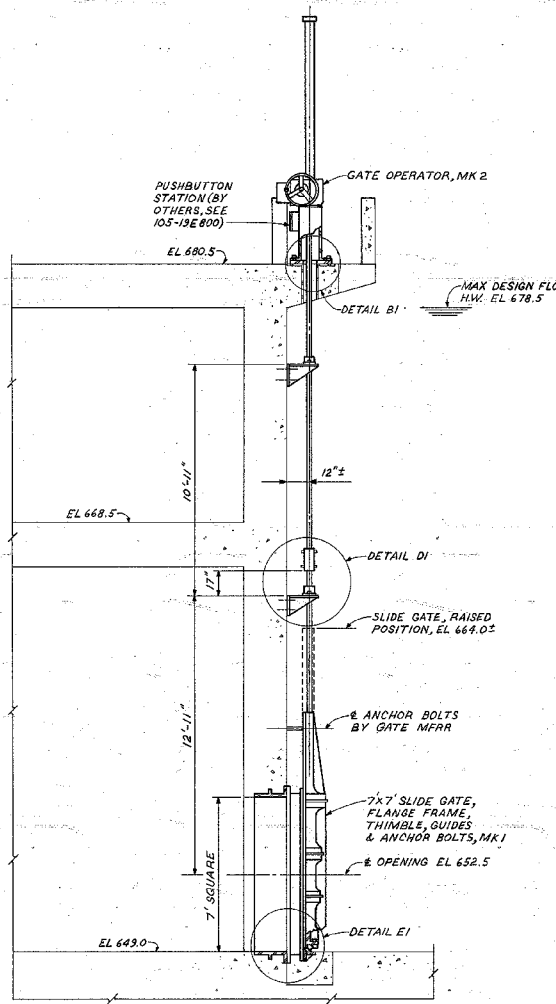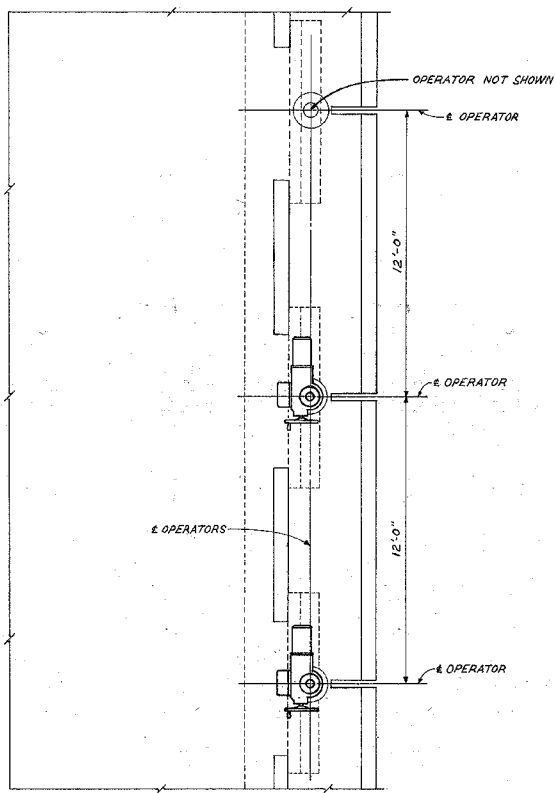

**GENERAL NOTES:**

- DIMENSIONS FOLLOWED BY ± MAY BE MODIFIED WITHIN THE SCOPE OF THE DESIGN AS REQUIRED TO SUIT THE DETAILS OF FURNISHED EQUIPMENT.
- UNLESS OTHERWISE SPECIFIED MACHINED TOLERANCES FOR FEET, INCHES, AND FRACTIONS 1/64" AND DECIMAL DIMENSIONS ±0.010".
- UNLESS OTHERWISE SPECIFIED MACHINED SURFACES 125 OR LESS MICRO-INCHES ARITHMETIC MEAN AVERAGE.
- SLIDE GATE TRAVEL IS 7'-0". STEM THREADS DESIGNED FOR A MINIMUM OF 3" OVERTRAVEL IN BOTH DIRECTIONS.
- INSIDE DIAMETER OF STEM SUPPORT GUIDE 1/16" LARGER THAN STEM DIAMETER.

**PARTS:**

HUNDREDS ON THIS DRAWING HAVE THE PREFIX 104-19E200-1

1 - SLIDE GATE ASSEMBLY - 3 REQD  
 MK 1 - GATE OPERATOR, SELF-CONTAINED, WEATHERPROOF, ELECTRIC-MOTOR OPERATED WORM GEAR STEM SCREW LIFT WITH INTEGRAL ROTARY SEARDED LIMIT SWITCH, AUXILIARY HANDWHEEL, AND STEM COVER - 3 REQD  
 MK 2 - OPERATOR FLOOR STAND WITH MOUNTING BOLTS - 3 REQD  
 MK 3 - STEM COUPLING, THREADED AND BOLTED - 3 REQD  
 MK 4 - STEM SUPPORT GUIDE, ONE-PIECE CAST IRON WITH BRONZE-SLEEVE BUSHING AND MOUNTING BOLTS WITH TWO HEX NUTS EACH - 3 REQD  
 MK 5 - STEM SUPPORT BRACKET, CAST IRON, FULLY ADJUSTABLE, 4-BOLT WALL MOUNTED TYPE - 3 REQD  
 MK 6 THROUGH MK 9 DETAILED ON THIS DRAWING.

**FIELD NOTES:**











- FURNISH ANCHOR BOLTS AND NUTS AS SHOWN IN DETAIL "D1" AND SECTION "C1-C1".
- FIELD TO INSTALL AND ALIGN SLIDE GATE, STEM, AND OPERATOR PER MANUFACTURER'S DRAWINGS AND INSTRUCTIONS.
- ALL SLIDE GATE FASTENERS TORQUED IN ACCORDANCE WITH GATE MANUFACTURER'S RECOMMENDATIONS.

SCALE 3/4"=1'-0"

INSPECTED AND APPROVED FOR ISSUE	DATE	DESIGNED	CHECKED	BY	EXAMINED	INSTRUMENTED	RECORDED	APPROVED
<i>[Signature]</i>	9-16-76	<i>[Signature]</i>	<i>[Signature]</i>	<i>[Signature]</i>	<i>[Signature]</i>	<i>[Signature]</i>	<i>[Signature]</i>	<i>[Signature]</i>
KNOXVILLE 9-16-76 81 H 104-19E200-1 R0								

RECORD DRAWING AS CONSTRUCTED

A  
B  
C  
D  
E  
F  
G  
H  
J  
K

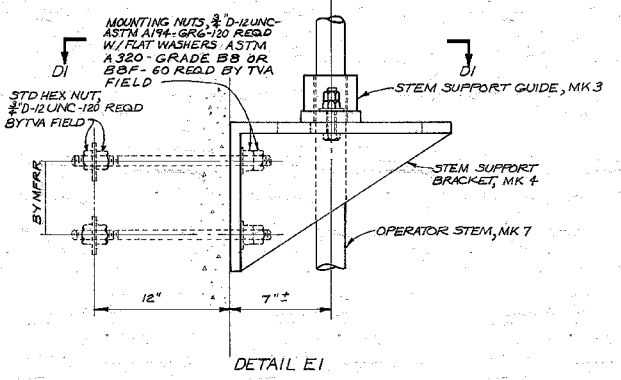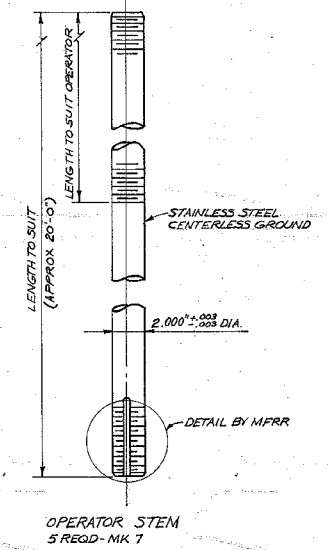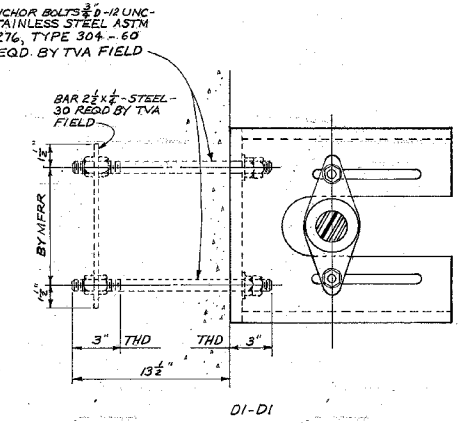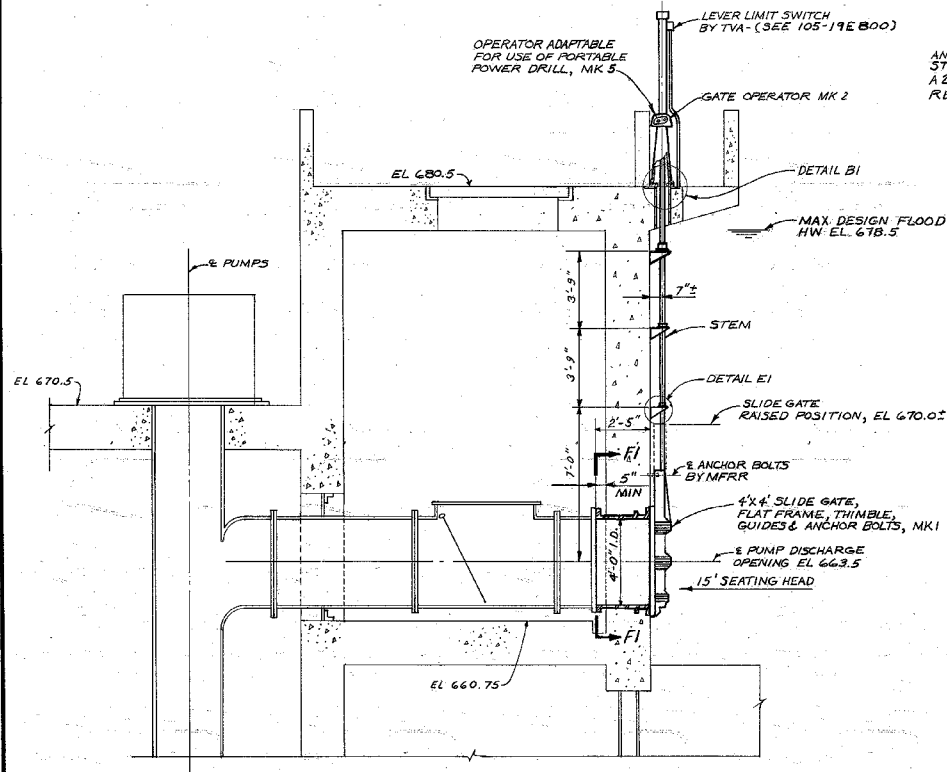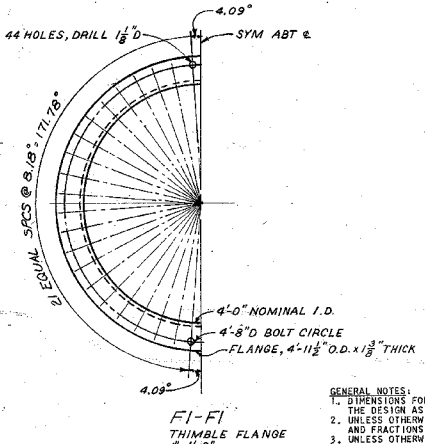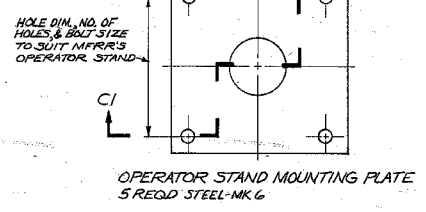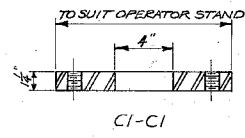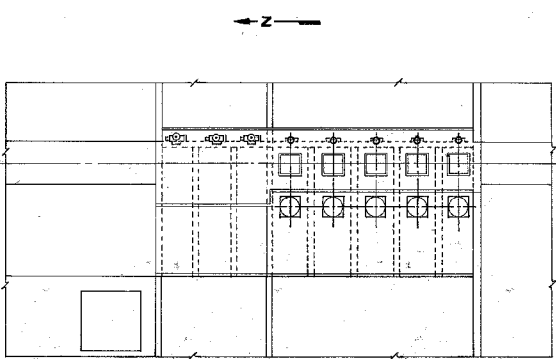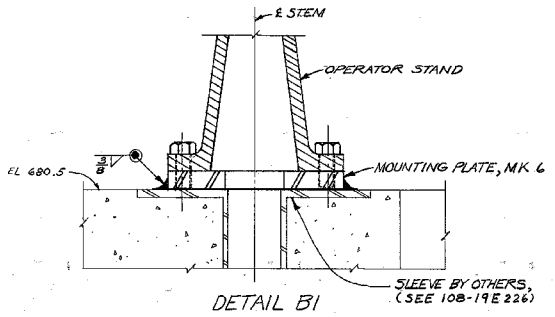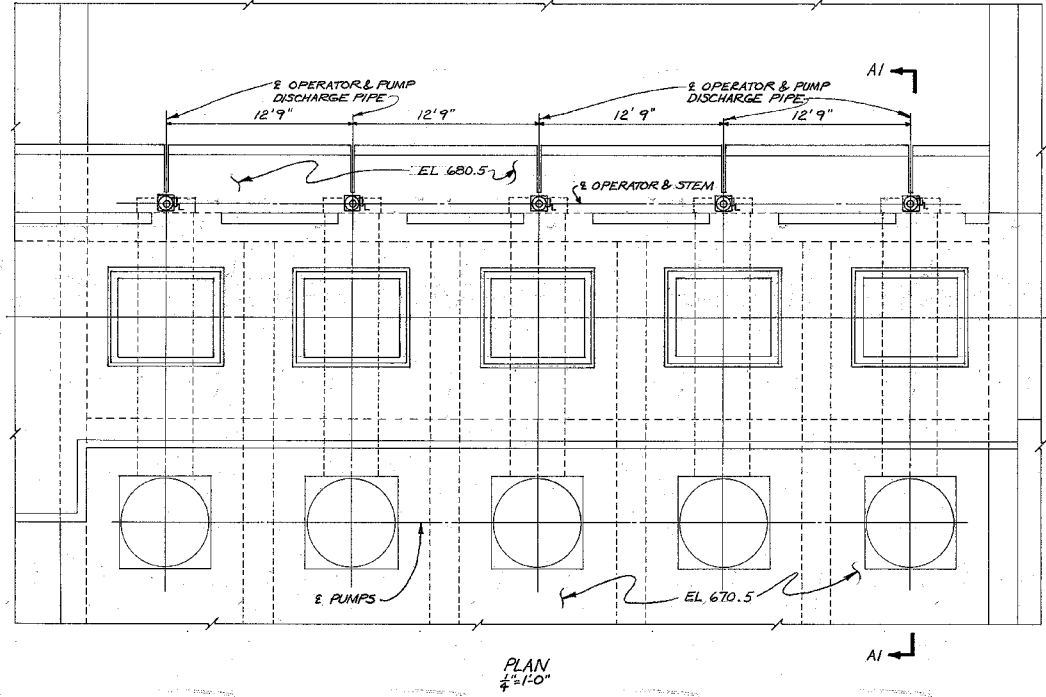

GENERAL NOTES:

- DIMENSIONS FOLLOWED BY \* MAY BE MODIFIED WITHIN THE SCOPE OF THE DESIGN AS REQUIRED TO SUIT THE DETAILS OF FURNISHED EQUIPMENT.
- UNLESS OTHERWISE SPECIFIED MACHINED TOLERANCES FOR FEET, INCHES, AND FRACTIONS ± 1/64" AND DECIMAL DIMENSIONS ± 0.010".
- UNLESS OTHERWISE SPECIFIED MACHINED SURFACES 125 OR LESS MICRO-INCHES ARITHMETIC MEAN AVERAGE.
- SLIDE GATE TRAVEL IS 4'-0" STEMS DESIGNED FOR A MINIMUM OF 3" OVERTRAVEL IN BOTH DIRECTIONS.
- LIMIT SWITCH ON GATE OPERATOR SERVES AS AN INTERLOCK SO THAT THE PUMP CANNOT OPERATE UNLESS GATE IS FULLY OPEN.
- A PORTABLE POWER DRILL WITH SLIP CLUTCH IS USED TO DRIVE THE OPERATORS.
- INSIDE DIAMETER OF STEM SUPPORT GUIDE 1/16" LARGER THAN STEM DIAMETER.
- THE WALL THIMBLE IS AN "M" TYPE WITH A STANDARD ANSI PIPE FLANGE AS SHOWN IN SECTION A1-A1 AND F1-F1.

DATES:

REVISIONS ON THIS DRAWING HAVE THE PREFIX 104-19E205-1.

MK 1 - SLIDE GATE ASSEMBLY - 5 REQD

MK 2 - GATE OPERATOR, ENCLOSED GEAR, PEDESTAL MOUNTED, HAND CRANK TYPE WITH POSITION COUNTER, INDICATOR, STOP NUTS, STEM COVER, AND FLOOR MOUNTING BOLTS WITH TWO HEX NUTS EACH - 15 REQD

MK 3 - STEM SUPPORT GUIDE, ONE-PIECE CAST IRON WITH BRONZE-SLEEVE BUSHING AND MOUNTING BOLTS WITH TWO HEX NUTS EACH - 15 REQD

MK 4 - STEM SUPPORT BRACKET, CAST IRON, FULLY ADJUSTABLE, 4-BOLT WALL MOUNTED TYPE - 15 REQD

MK 5 - PORTABLE POWER DRILL WITH ADJUSTABLE SLIP CLUTCH - 1 REQD.

MK 6 AND MK 7 DETAILED ON THIS DRAWING.


FIELD NOTES:

- FIELD TO FURNISH ANCHOR BOLTS AND NUTS AS SHOWN IN DETAIL "E1" AND SECTION "DI-DI".
- FIELD TO INSTALL AND ALIGN SLIDE GATE, STEM, AND OPERATOR PER MANUFACTURER'S DRAWINGS AND INSTRUCTIONS.
- ALL SLIDE GATE FASTENERS TORQUED IN ACCORDANCE WITH GATE MANUFACTURER'S RECOMMENDATIONS.
- FIELD TO INSTALL LEVER LIMIT SWITCH ON THE OPERATOR STEM COVER.

SCALE 3"=1'-0"

NO.	ECN NO.	DATE	DESIGN	PERM	CHG	APP	ISS	DISP	FORM	REC'D	APP'D
DESIGN	T.M. SUAREZ										
DRWN	J.B. ANDERSON	9-22-76									
CHKD	J.B. ANDERSON										
APP'D	J.B. ANDERSON										
CHATTANOOGA FLOOD PROTECTION PUMPING STATION 1											
4'x4' SLIDE GATE ARRANGEMENT & DETAILS											
SOUTH CHICKAMAUGA CREEK PROJECT TENNESSEE VALLEY AUTHORITY DIVISION OF ENGINEERING DESIGN											
INSPECTED AND APPROVED FOR ISSUE			SUBMITTED			RECOMMENDED			APPROVED		
J.B. Anderson			J.B. Anderson			J.B. Anderson			J.B. Anderson		
KNOXVILLE 9-22-76			KNOXVILLE 9-22-76			KNOXVILLE 9-22-76			KNOXVILLE 9-22-76		
RECORD DRAWING AS CONSTRUCTED											

PRINT	H	1	2	6
SIZE	#			
RECORD DRAWING AS CONSTRUCTED				

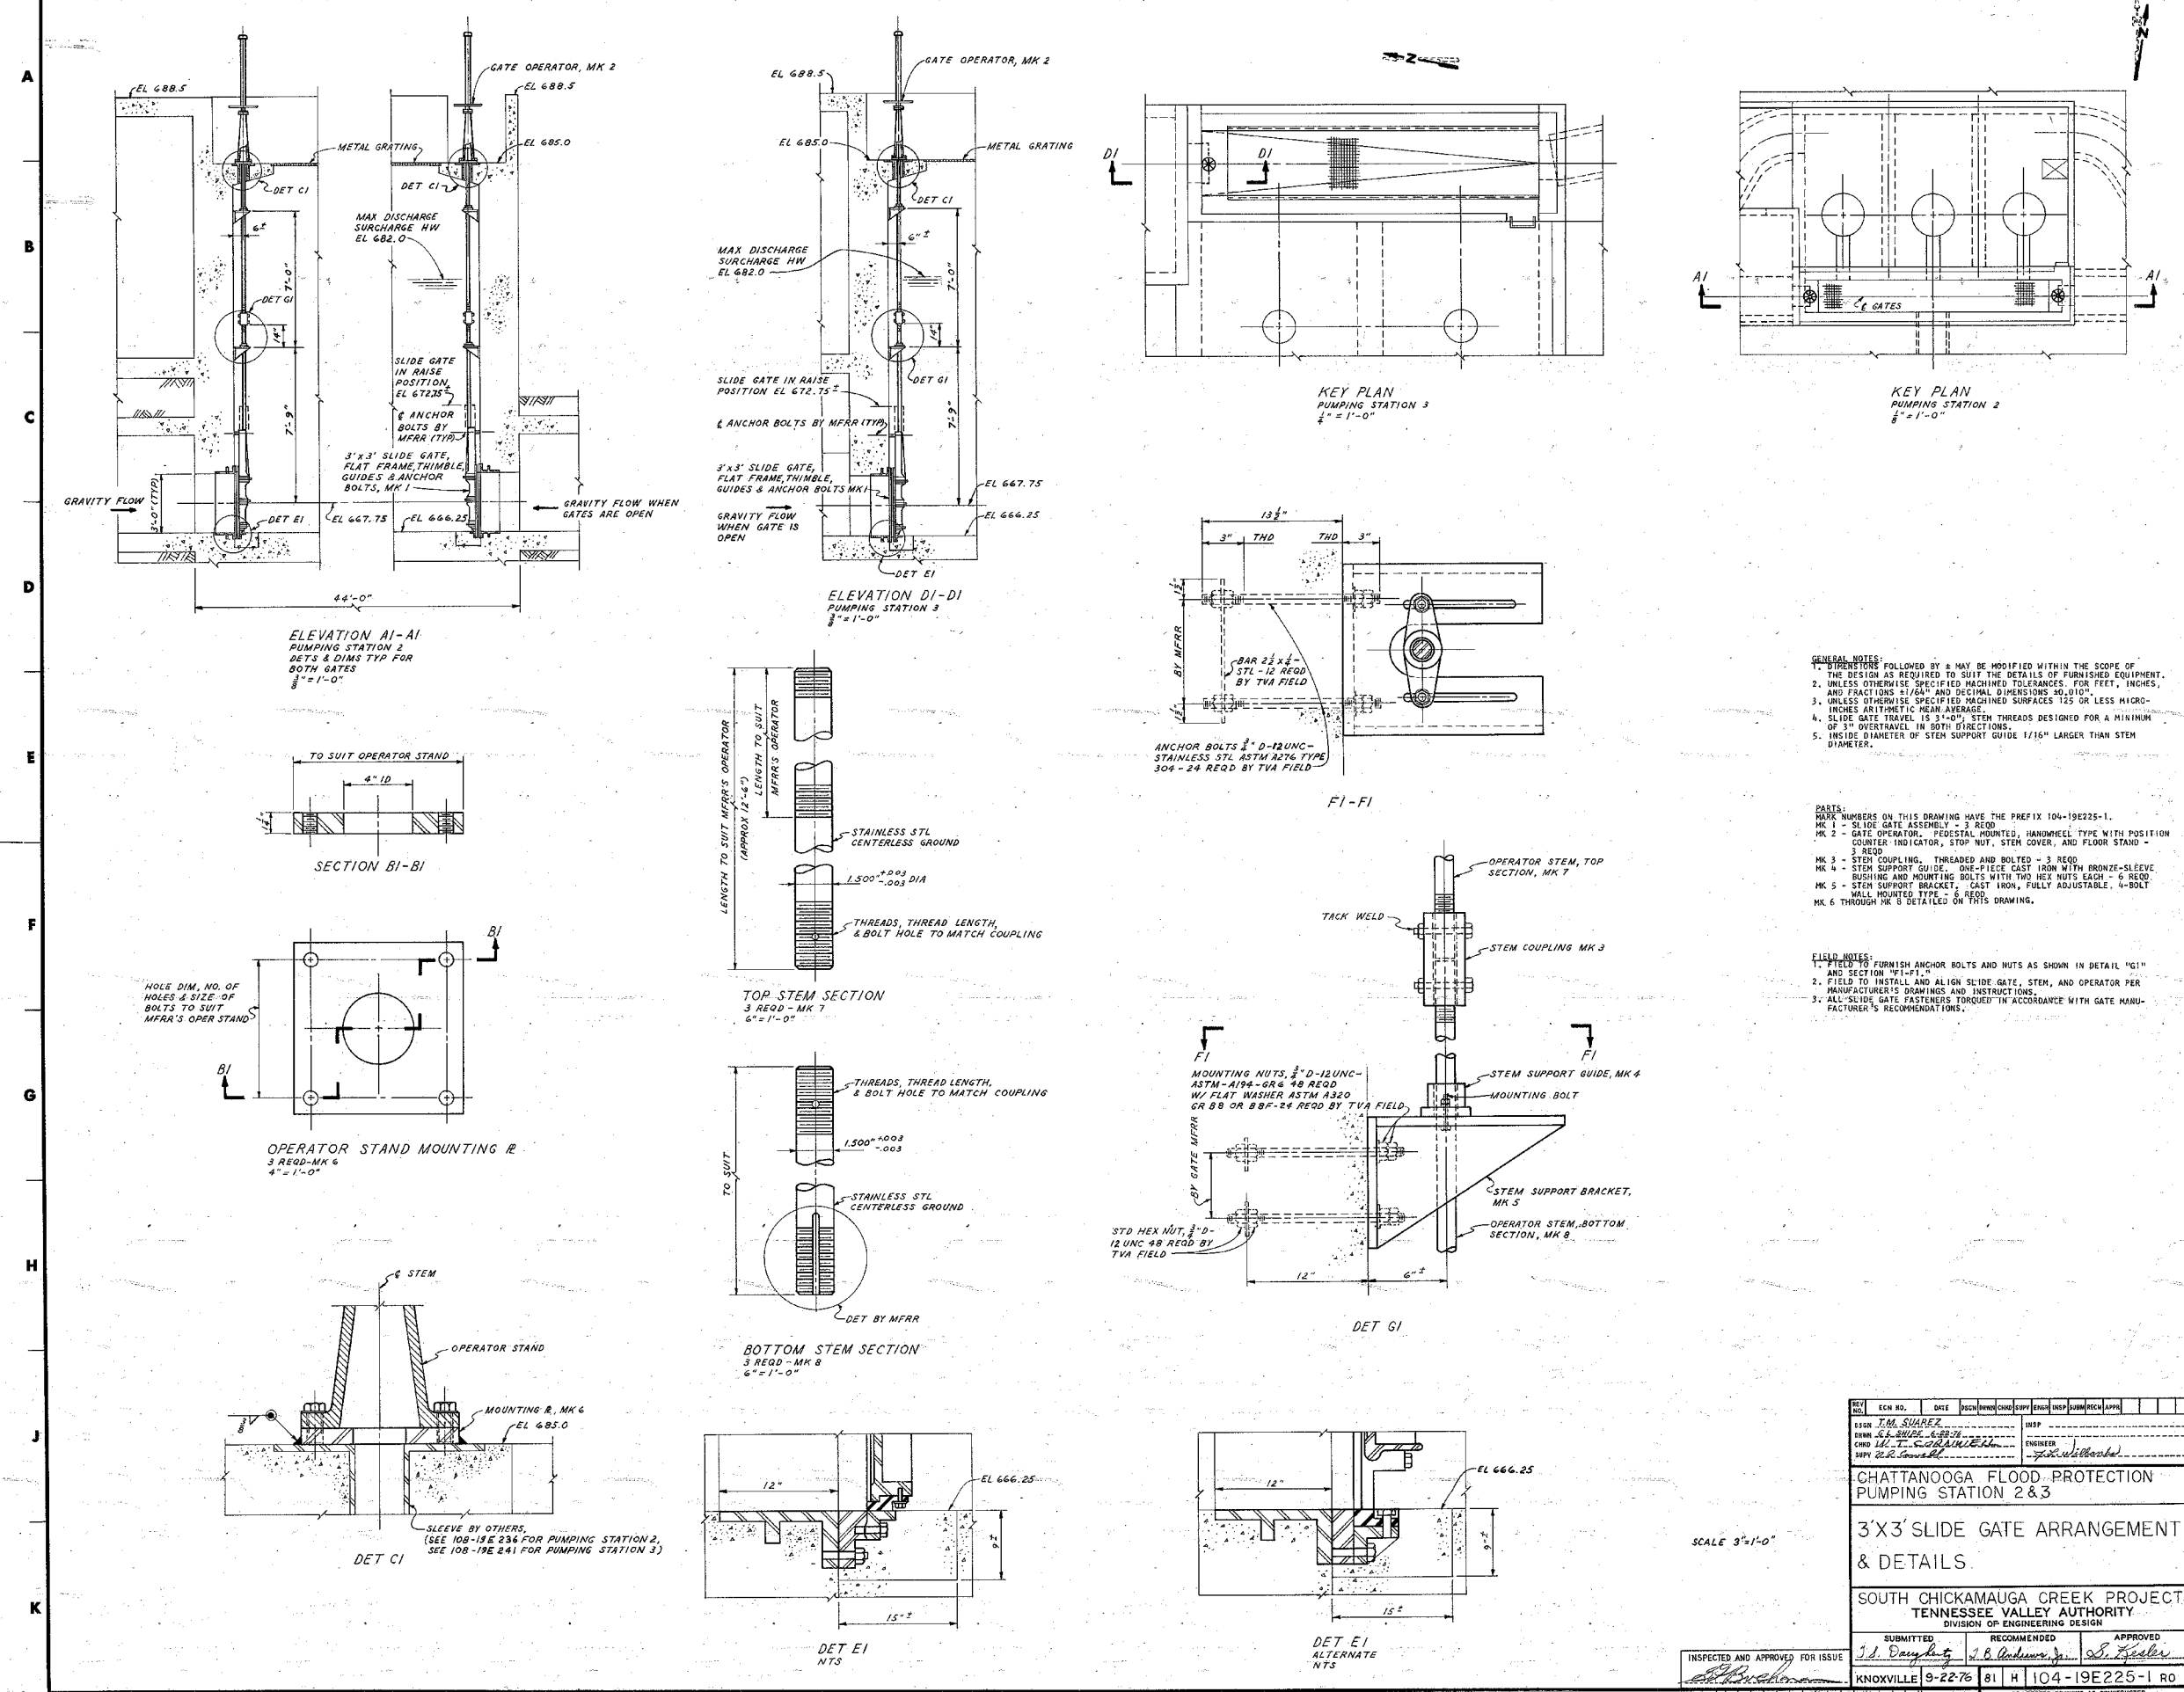

**GENERAL NOTES:**  
 1. DIRECTIONS FOLLOWED BY & MAY BE MODIFIED WITHIN THE SCOPE OF THE DESIGN AS REQUIRED TO SUIT THE DETAILS OF FURNISHED EQUIPMENT.  
 2. UNLESS OTHERWISE SPECIFIED MACHINED TOLERANCES: FOR FEET, INCHES, AND FRACTIONS  $\pm .004''$  AND DECIMAL DIMENSIONS  $\pm .010''$ .  
 3. UNLESS OTHERWISE SPECIFIED MACHINED SURFACES  $\frac{1}{25}$  OR LESS MICRO-INCHES ARITHMETIC MEAN AVERAGE.  
 4. SLIDE GATE TRAVEL IS  $3'-0''$ . STEM THREADS DESIGNED FOR A MINIMUM OF  $3''$  OVERTRAVEL IN BOTH DIRECTIONS.  
 5. INSIDE DIAMETER OF STEM SUPPORT GUIDE  $1/16''$  LARGER THAN STEM DIAMETER.


**PARTS:**  
 MARK NUMBERS ON THIS DRAWING HAVE THE PREFIX 104-19E225-1.  
 MK 1 - SLIDE GATE ASSEMBLY - 3 REQ  
 MK 2 - GATE OPERATOR, PEDESTAL MOUNTED, HANDWHEEL TYPE WITH POSITION COUNTER INDICATOR, STOP NUT, STEM COVER, AND FLOOR STAND - 3 REQ  
 MK 3 - STEM COUPLING, THREADED AND BOLTED - 3 REQ  
 MK 4 - STEM SUPPORT GUIDE, ONE-PIECE CAST IRON WITH BRONZE-SLEEVE BUSHING AND MOUNTING BOLTS WITH TWO HEX NUTS EACH - 6 REQ  
 MK 5 - STEM SUPPORT BRACKET, CAST IRON, FULLY ADJUSTABLE, 4-BOLT WALL MOUNTED TYPE - 6 REQ  
 MK 6 THROUGH MK 8 DETAILED ON THIS DRAWING.

**FIELD NOTES:**  
 1. FIELD TO FURNISH ANCHOR BOLTS AND NUTS AS SHOWN IN DETAIL "G1" AND SECTION "F1-F1".  
 2. FIELD TO INSTALL AND ALIGN SLIDE GATE, STEM, AND OPERATOR PER MANUFACTURER'S DRAWINGS AND INSTRUCTIONS.  
 3. ALL SLIDE GATE FASTENERS TORQUED IN ACCORDANCE WITH GATE MANUFACTURER'S RECOMMENDATIONS.


REV	ECN NO.	DATE	DESIGNED	CHECKED	ENGR	INSP	SUBMIT	RECA	APPD
0508	J.M. SUAREZ								
0509	J.M. SUAREZ								
0510	J.M. SUAREZ								
0511	J.M. SUAREZ								
0512	J.M. SUAREZ								
CHATTANOOGA FLOOD PROTECTION PUMPING STATION 2&3									
3'X3' SLIDE GATE ARRANGEMENT & DETAILS									
SOUTH CHICKAMAUGA CREEK PROJECT, TENNESSEE VALLEY AUTHORITY, DIVISION OF ENGINEERING DESIGN									
SUBMITTED					RECOMMENDED				
INSPECTED AND APPROVED FOR ISSUE					APPROVED				
KNOXVILLE 9-22-76					81 H 104-19E225-1 RO				
RECORD DRAWING AS CONSTRUCTED									

SCALE 3/4"=1'-0"


PRINT	1	2	3	4	5	6	7	8	9	10	11	12
SIZE												
PRINTED PER ORDER OF THE ENGINEER												

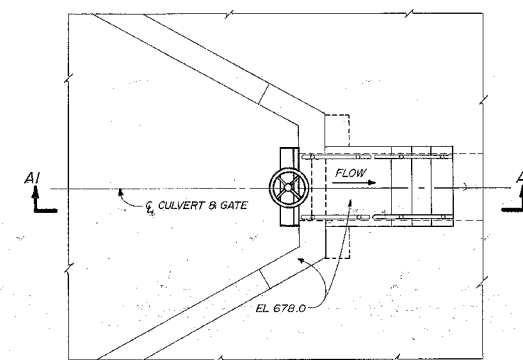


PLAN  
3'X3' SLIDE GATE

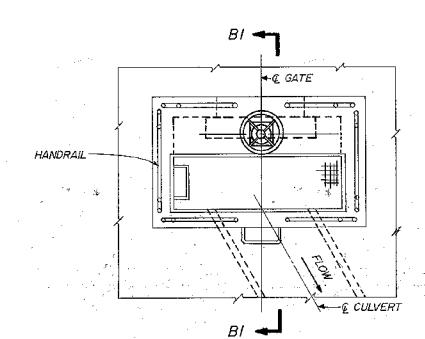


PLAN  
4'X4' SLIDE GATE

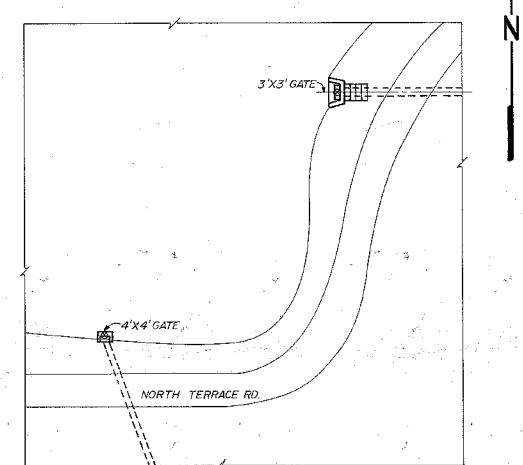


KEY PLAN  
FOR LOCATION SEE DWG 104-19E212-1  
1" = 40'

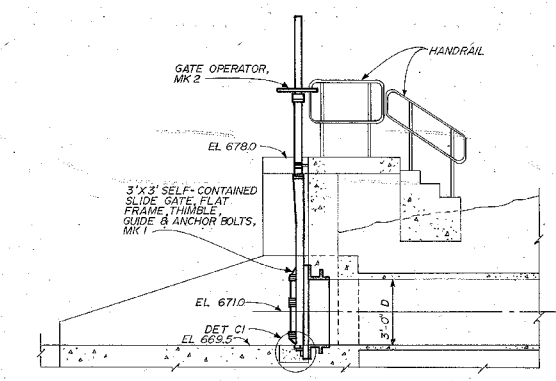


A-I-AI

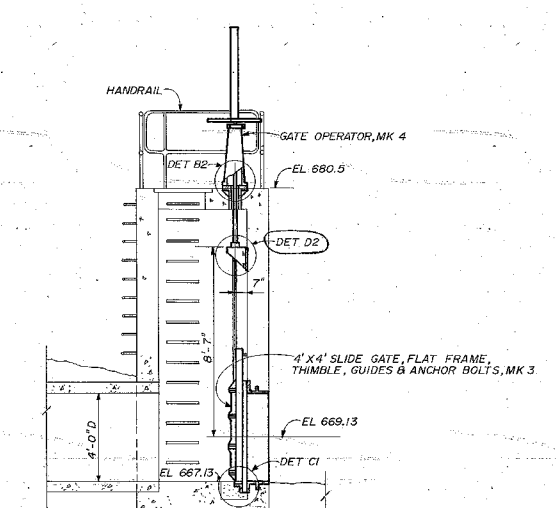

B-I-BI

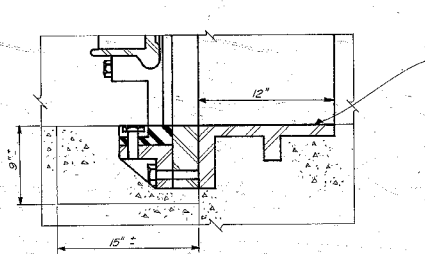

DET C1  
NTS

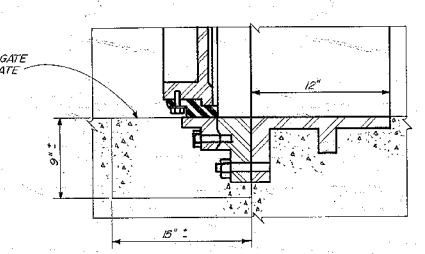

DET C1  
ALTERNATE  
NTS

- GENERAL NOTES:
1. DIMENSIONS FOLLOWED BY ± MAY BE MODIFIED WITHIN THE SCOPE OF THE DESIGN AS REQUIRED TO SUIT THE DETAILS OF FURNISHED EQUIPMENT.
  2. UNLESS OTHERWISE SPECIFIED MACHINED TOLERANCES FOR FEET, INCHES, AND FRACTIONS ±1/64" AND DECIMAL DIMENSIONS ±0.010".
  3. UNLESS OTHERWISE SPECIFIED MACHINED SURFACES 125 OR LESS MICRO-INCHES ARITHMETIC MEAN AVERAGE.
  4. SLIDE GATE TRAVEL IS 3'-0" FOR MK 1 AND 4'-0" FOR MK 2; STEM THREADED SECTION FOR A MINIMUM OF 2" OVERHANG IN BOTH DIRECTIONS.
  5. INSIDE DIAMETER OF STEM SUPPORT GUIDE 1/16" LARGER THAN STEM DIAMETER.

- PARTS:
- MARK NUMBERS ON THIS DRAWING HAVE THE PREFIX 104-19E265.
- MK 1 - SELF-CONTAINED SLIDE GATE ASSEMBLY - 1 REQD.
  - MK 2 - GATE OPERATOR, Yoke Mounted, HANDWHEEL TYPE WITH POSITION COUNTER INDICATOR, STOP NUT, AND STEM COVER - 1 REQD.
  - MK 3 - SLIDE GATE ASSEMBLY - 1 REQD.
  - MK 4 - GATE OPERATOR, pedestal mounted, HANDWHEEL TYPE WITH POSITION COUNTER INDICATOR, STOP NUT, STEM COVER, AND FLOOR STAND - 1 REQD.
  - MK 5 - STEM SUPPORT GUIDE, ONE-PIECE CAST IRON WITH BRONZE-SLEEVE BUSHING AND MOUNTING BOLTS WITH TWO HEX NUTS EACH - 1 REQD.
  - MK 6 - STEM SUPPORT BRACKET, CAST IRON, FULLY ADJUSTABLE, 4 BOLT WALL MOUNTED TYPE - 1 REQD.
  - MK 7 THROUGH MK 9 DETAILED ON SHEET 2 OF THIS DRAWING.

- FIELD NOTES:
1. FIELD TO FURNISH ANCHOR BOLTS AND NUTS AS SHOWN IN DETAIL "C2" AND SECTION "D2-D2."
  2. FIELD TO INSTALL AND ALIGN SLIDE GATE, STEM, AND OPERATOR PER MANUFACTURER'S DRAWINGS AND INSTRUCTIONS.
  3. ALL SLIDE GATE FASTENERS TORQUED IN ACCORDANCE WITH GATE MANUFACTURER'S RECOMMENDATIONS.


REVISED & REDRAWN		DATE: 5-31-79	
DESIGNER: TM SUAREZ	INSPECTOR: [Signature]	DATE: 8-22-78	SCALE: 3/8" = 1'-0" EXCEPT AS NOTED
CHATTANOOGA FLOOD PROTECTION LEVEE INSTALLATIONS			
3'X3' AND 4'X4' SLIDE GATE ARRANGEMENT & DETAILS			
SOUTH CHICKAMAUGA CREEK PROJECT TENNESSEE VALLEY AUTHORITY DIVISION OF ENGINEERING DESIGN			
SUBMITTED: [Signature]	RECOMMENDED: [Signature]	APPROVED: [Signature]	
KNOXVILLE 9-22-78		104-19E265-1 RI	

COMPANION DRAWING:  
104-19E265-2

INSPECTED AND APPROVED FOR ISSUE  
[Signature]

PRINT	1	5
SIZE	11	0


TECHNICAL REPRESENTATIVE'S  
ROSKOPF

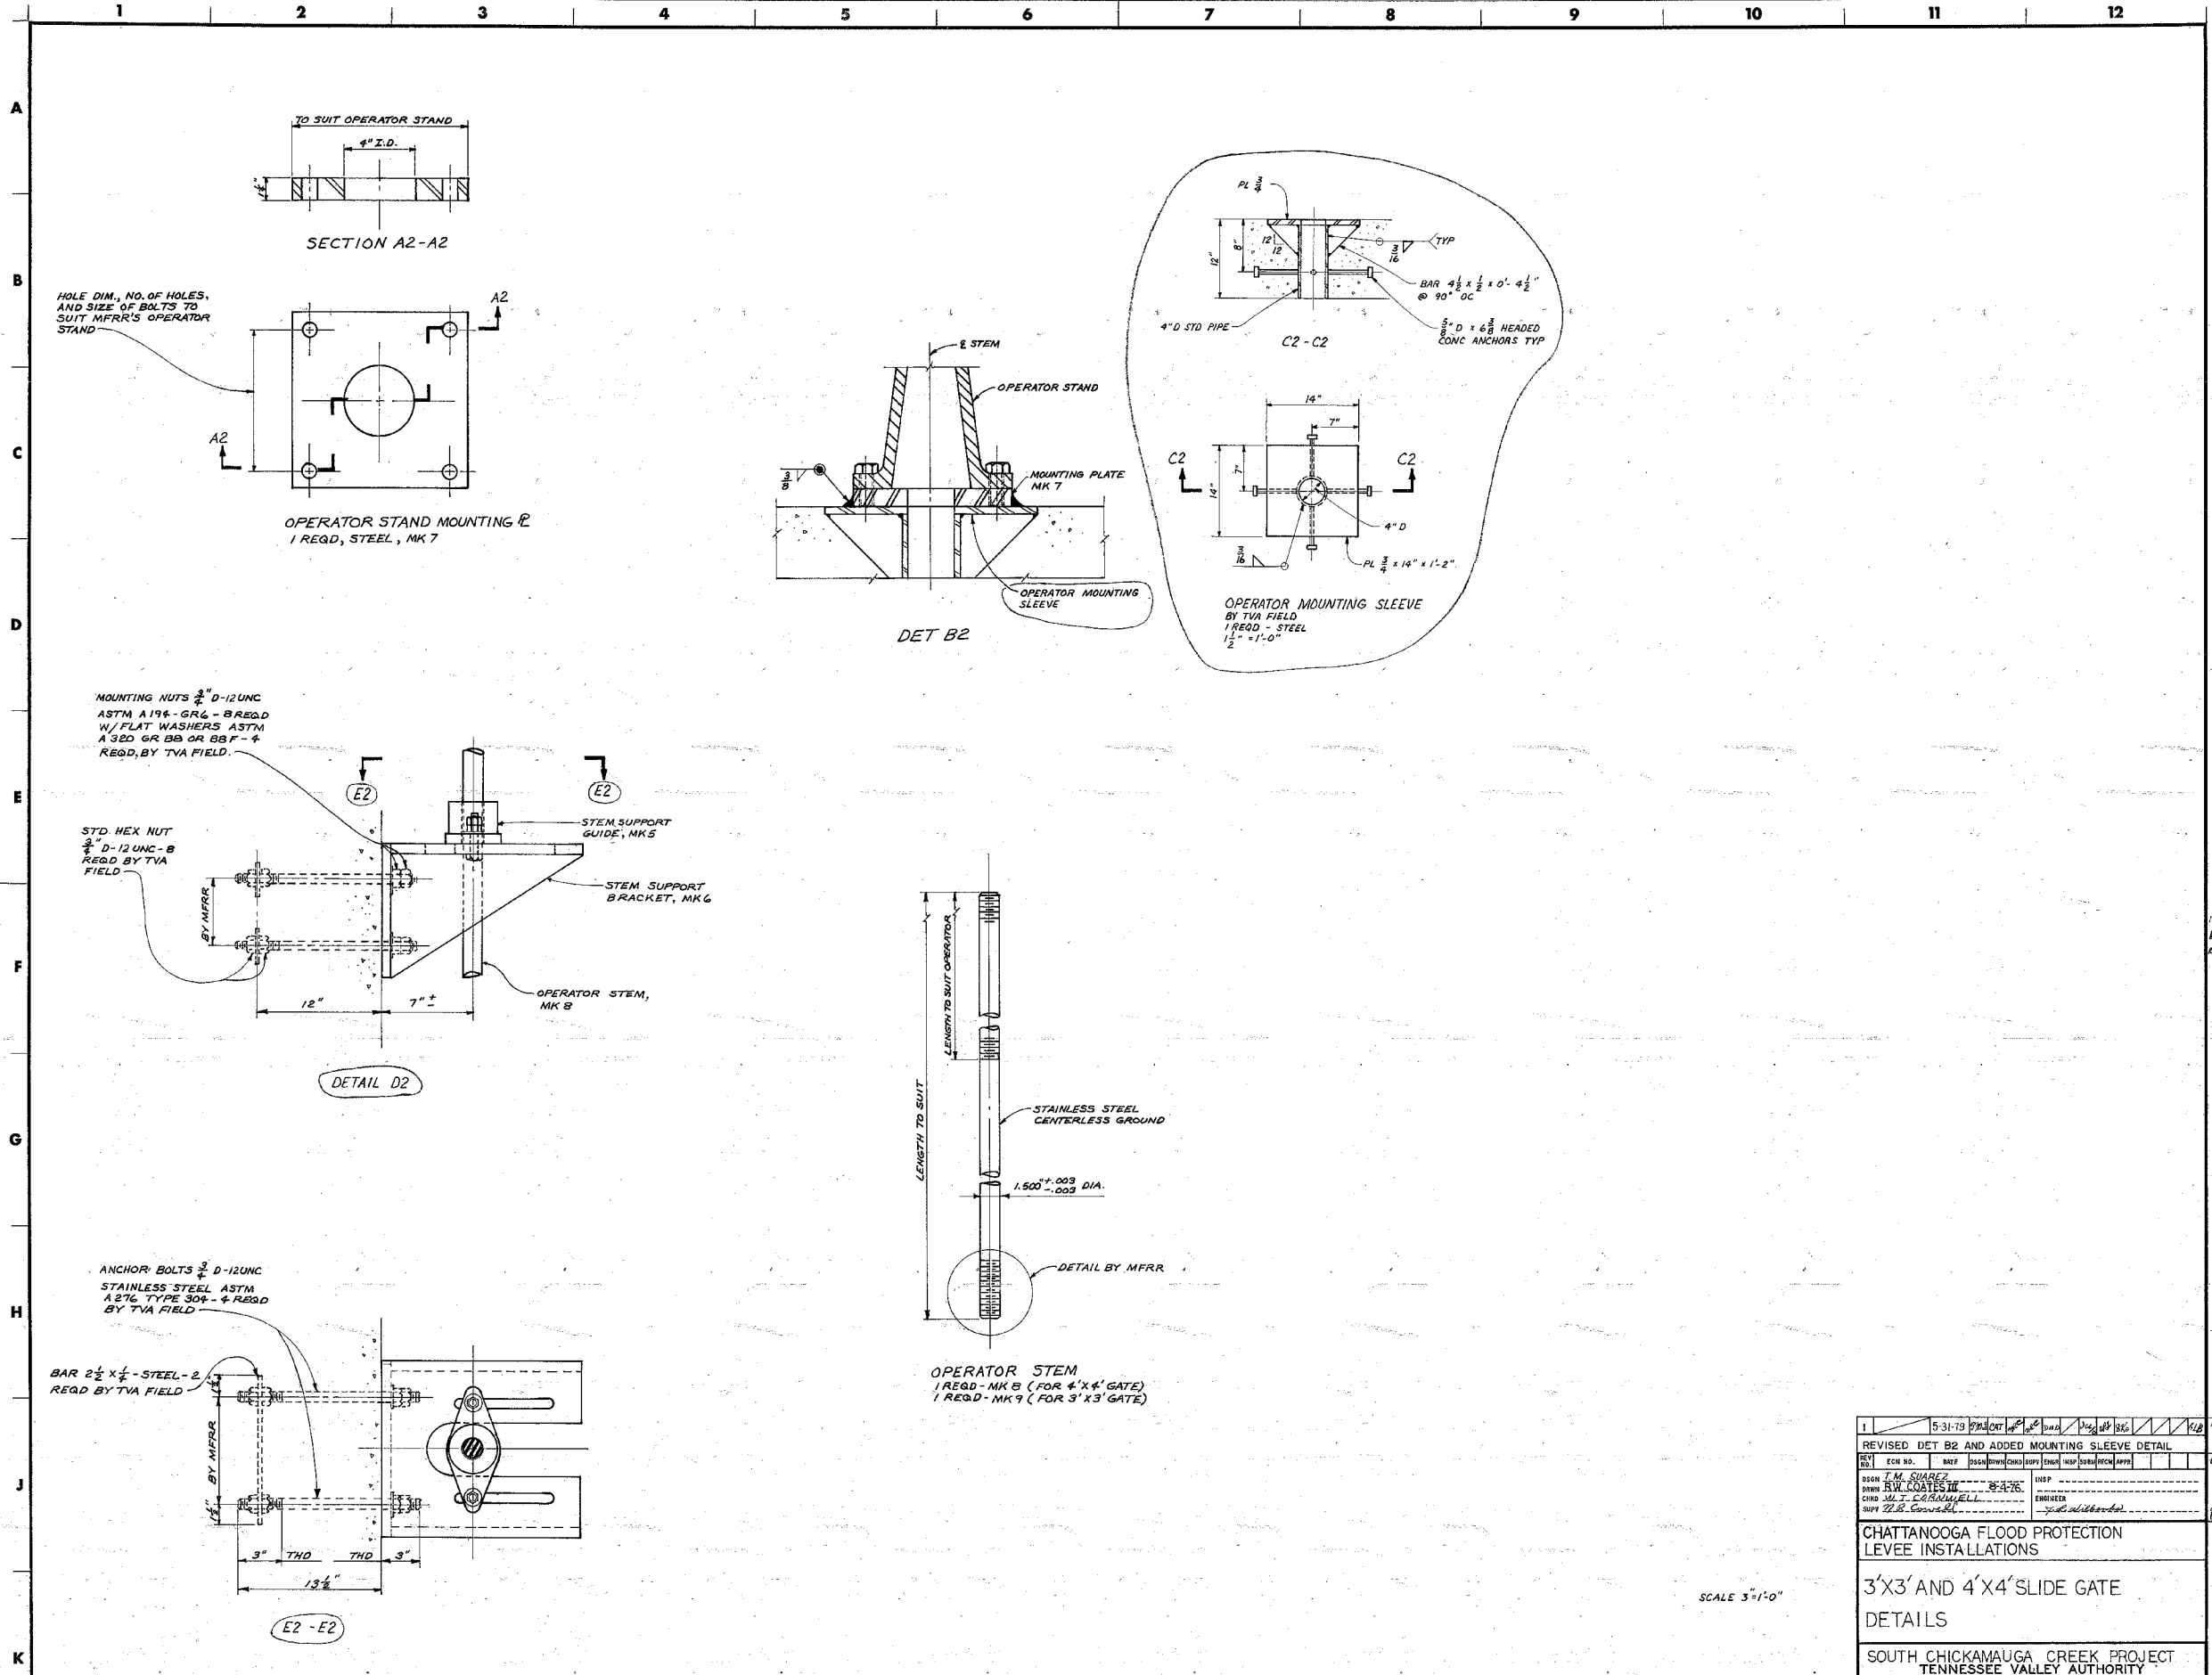





SCALE 3/4"=1'-0"

1	5-31-73	REVISED DET B2 AND ADDED MOUNTING SLEEVE DETAIL																
DESIGN	T.M. SUAREZ																	
DRAWN	R.V. COATES JR.																	
CHECKED	M.T. CORNWELL																	
DATE	9-22-76																	
CHATTANOOGA FLOOD PROTECTION LEVEE INSTALLATIONS																		
3'X3' AND 4'X4' SLIDE GATE DETAILS																		
SOUTH CHICKAMAUGA CREEK PROJECT TENNESSEE VALLEY AUTHORITY DIVISION OF ENGINEERING DESIGN																		
SUBMITTED			RECOMMENDED			APPROVED												
J.D. Doughty			J.B. Anderson, Jr.			S. Feiler												
KNOXVILLE 9-22-76 18 H 104-19E265-2 RI																		
RECORD DRAWING AS CONSTRUCTED																		

INSPECTED AND APPROVED FOR ISSUE	
PRINT	1 5
SIZE	0
PRINTS REQD - 1	

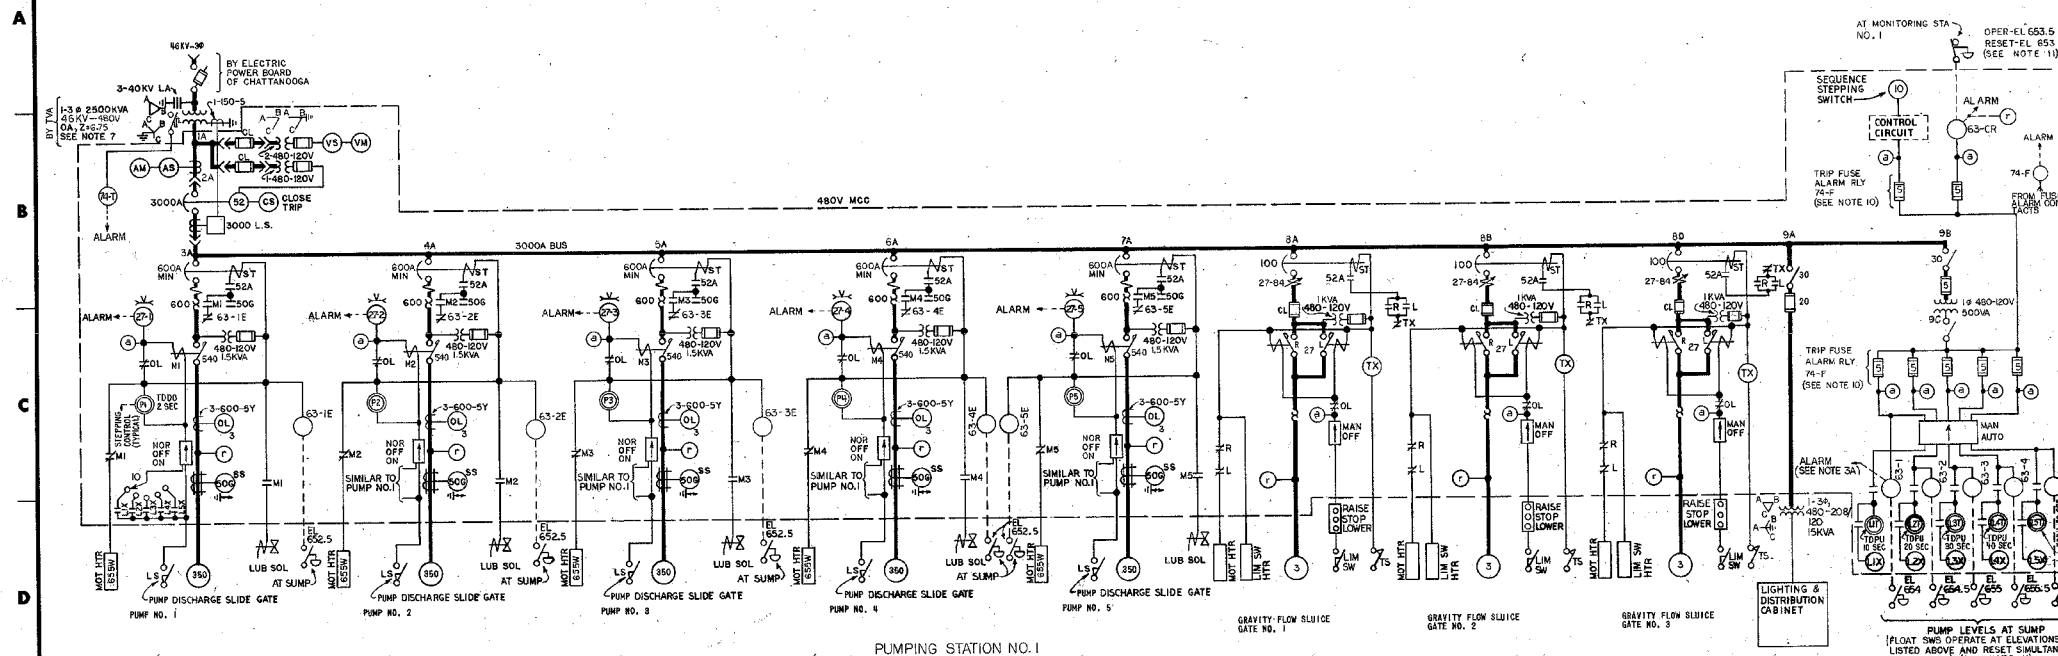

- NOTES:
- WHEN THE COMMON PUMP CONTROL SWITCH IS IN AUTO POSITION AT ANY STATION PUMPS AT THAT PUMPING STATION WILL BE STARTED WITH RISING WATER LEVEL AS MEASURED BY LEVEL SENSORS LOCATED IN THE SUMPS AT EACH STATION - ONE SENSOR FOR EACH PUMP. AT STATION NO. 1, THESE SENSORS ARE SET TO OPERATE AT EL 654 THROUGH EL 656 AT 0.6' INCREMENTS. AT STATION NO. 2, THE SENSORS ARE SET TO OPERATE AT EL 662, 663.5, AND 670. AT PUMPING STATION NO. 3, THE SENSORS ARE SET TO OPERATE AT EL 662 AND EL 663.5. ALL PUMPS IN OPERATION AT STATIONS 1, 2, AND 3 WILL SHUT OFF SIMULTANEOUSLY AT EL 653.5, EL 660, AND EL 666 RESPECTIVELY WITH FALLING WATER LEVEL. A STEERING SCHEME EXERCISED AFTER EACH PUMPING CYCLE AT THE THREE STATIONS WILL ALTERNATE THE PUMPS SUCH THAT THE SENSORS OPERATING AT THE LOWEST LEVELS WILL OPERATE THE PUMPS USED THE LOWEST ON THE PREVIOUS PUMPING CYCLE. SUFFICIENT TIME DELAY OF 10 SEC BETWEEN STARTING ANY TWO PUMPS WILL PREVENT SIMULTANEOUS STARTING. AT STATION NO. 1, THE PUMPS ARE ELECTRICALLY INTERLOCKED TO PREVENT OPERATION IF THEIR INDIVIDUAL PUMP DISCHARGE SLUICE GATES ARE NOT FULLY OPEN. IF ANY PUMPS AT STATIONS 1, 2, & 3 ARE STILL OPERATING AT EL 652.5, 667 AND 667 RESPECTIVELY, A BACKUP LEVEL SWITCH WILL TRIP THE INDIVIDUAL PUMP BREAKER.
  - WHEN MONITORING STATIONS NO.1 OR NO.2 SENSE CREEK LEVEL ABOVE EL.653.5 OR EL.667.5 RESPECTIVELY, THE APPROPRIATE GRAVITY FLOW SLUICE GATES ARE TO BE CLOSED AND THE AFFECTED PUMPING STATIONS PLACED IN AUTOMATIC CONTROL THROUGH THE COMMON CONTROL SWITCH LOCATED AT EACH STATION.
  - REMOTE ALARMS ARE GROUPED AS FOLLOWS:
    - CREEK LEVEL ABOVE EL.653.5 BY SENSORS AT MONITORING STATION NO.1 OR SLUICE LEVEL AT PUMPING STATION NO.1 ABOVE EL.654 WITH THE COMMON PUMP CONTROL SWITCH IN MANUAL POSITION.
    - CREEK LEVEL ABOVE EL.667.5 BY SENSORS AT MONITORING STATION NO.2 OR SLUICE LEVEL AT PUMPING STATION NO.2 ABOVE EL.669 WITH THE COMMON PUMP CONTROL SWITCH IN MANUAL POSITION.
    - ABNORMAL CONDITION AT ANY OF THE THREE PUMPING STATIONS AS DETECTED BY DEVICE 27 (THERMAL OVERLOAD TROUBLE CONTROL TRANSFORMER FUSE BLOWN, OPEN BREAKER OR LOSS OF VOLTAGE FOR ALL PUMPS) OR BLOWN FUSE IN THE PUMP SEQUENCING CONTROL CIRCUITS ADDITIONALLY STATION 1 ADDITIONAL INCLUDES THE MAIN TRANSFORMER ALARMS FOR HIGH TEMP LOW LIQUID LEVEL AND PRESSURE RELIEF VALVE OPERATION.
  - DISCONNECT SWITCHES ON THE AUXILIARY BOARD ARE HEAVY DUTY TYPE RATED 600V AND CAPABLE OF INTERRUPTING NOT LESS THAN 18 TIMES THEIR RATED CURRENT.
  - ALL 480V FUSES TO BE TIME DELAY CLASS J.
  - ALL BREAKERS ARE 3-POLE RATED 600V INTERRUPTING RATING:
    - AT STATION #1 DRAWOUT - 50,000 RMS SYM AT 480V MOLDED CASE & MOLDED CASE/CL FUSE COMBINATION - 50,000 RMS SYM AT 480V
    - AT STATIONS #2 & 3 DRAWOUT - 38,000 RMS SYM AT 480V MOLDED CASE - 14,000 RMS SYM AT 480V
  - THE TRANSFORMER IS TO BE PROVIDED WITH A NO-LOAD TAP CHANGER PER ANSI STANDARD C57.12.0, THE TRANSFORMER RATINGS MUST NOT BE INCREASED BY THE ADDITION OF FORCED COOLING.
  - BRANCH CIRCUIT GROUND RELAYS ARE SET TO TRIP AT 5 AMP PRIMARY GROUND CURRENT.
  - VENDOR TO ESTABLISH FRONT VIEW AND COMPARTMENT ASSIGNMENTS BASED ON PHYSICAL REQUIREMENTS. THE PANELS DO NOT HAVE TO BE FLUSH MOUNTED.
  - FUSES ARE RATED AT 5 AMPERES AND ARE SIGNAL ACTUATING TYPE, RATED AT 125 VAC BUSS TYPE FNA, OR EQUAL. THESE FUSES ARE USED IN CONJUNCTION WITH SIGNAL FUSE BLOCK, 4 POLE, BUSS TYPE 3839 OR EQUAL.
  - FLOAT SWITCHES SHOWN ARE SYMBOLIC OF THE FUNCTION BEING PERFORMED AND DO NOT NECESSARILY REPRESENT EQUIPMENT INSTALLED.

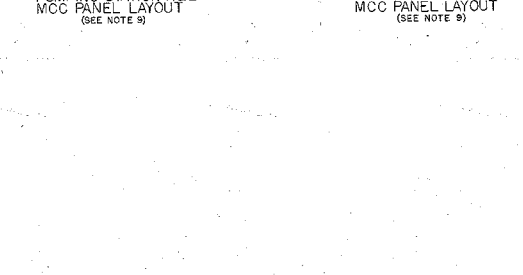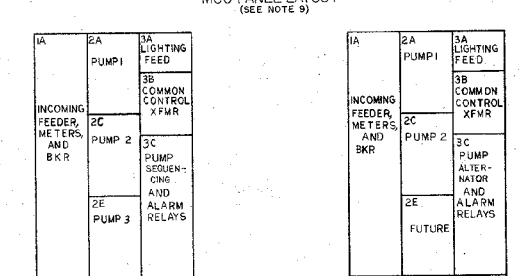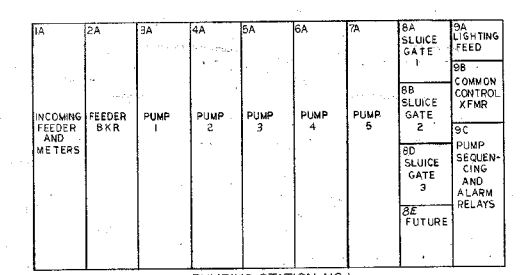
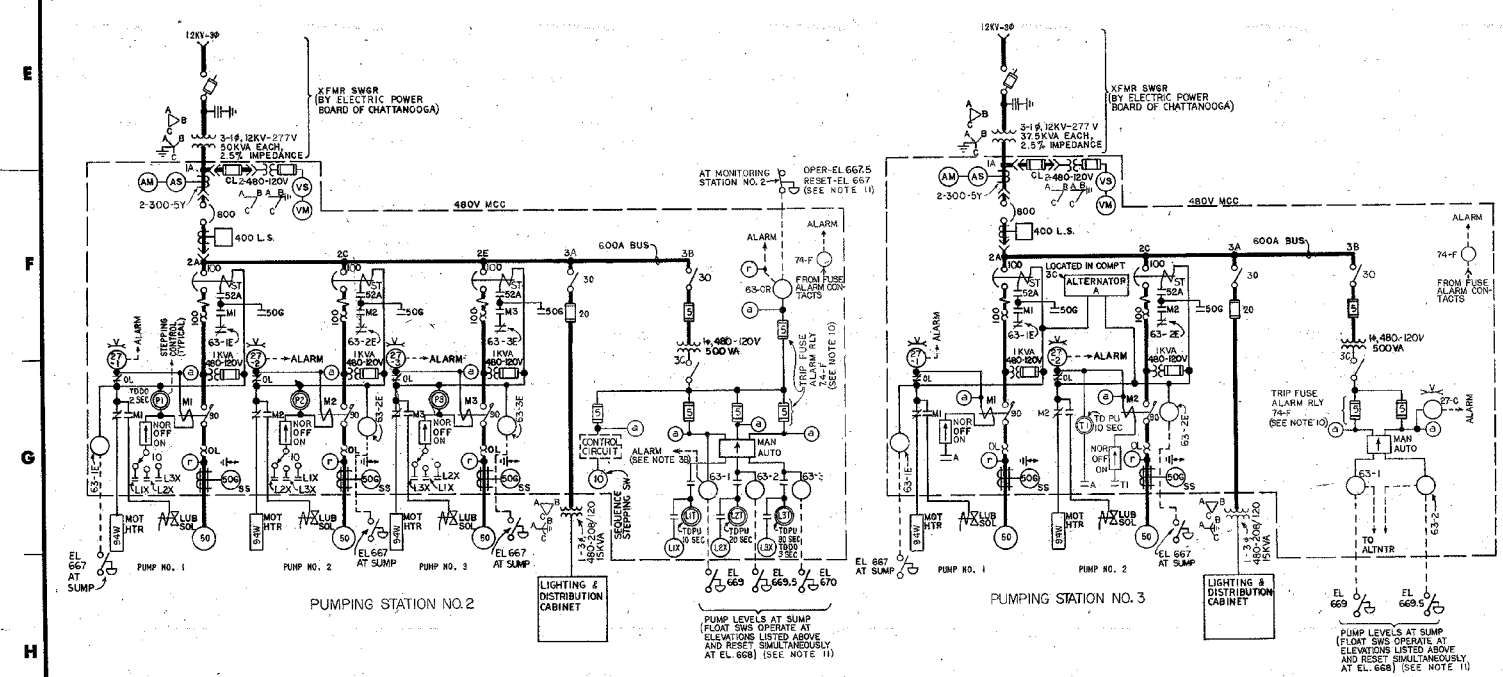






A  
B  
C  
D  
E  
F  
G  
H  
J  
K

NOTES:  
1. FOR GENERAL NOTES SEE DWG 105-19E500  
2. FOR FURTHER DETAILS AND AS PURCHASED STATUS, SEE CONTROL POWER SYSTEMS INC. DRAWING R-41600, TVA CONTRACT 77K3-821901.

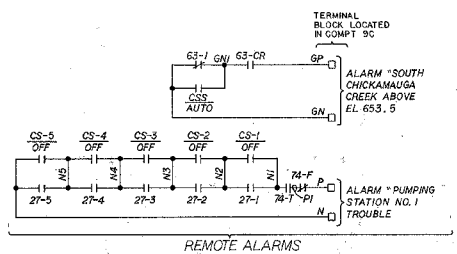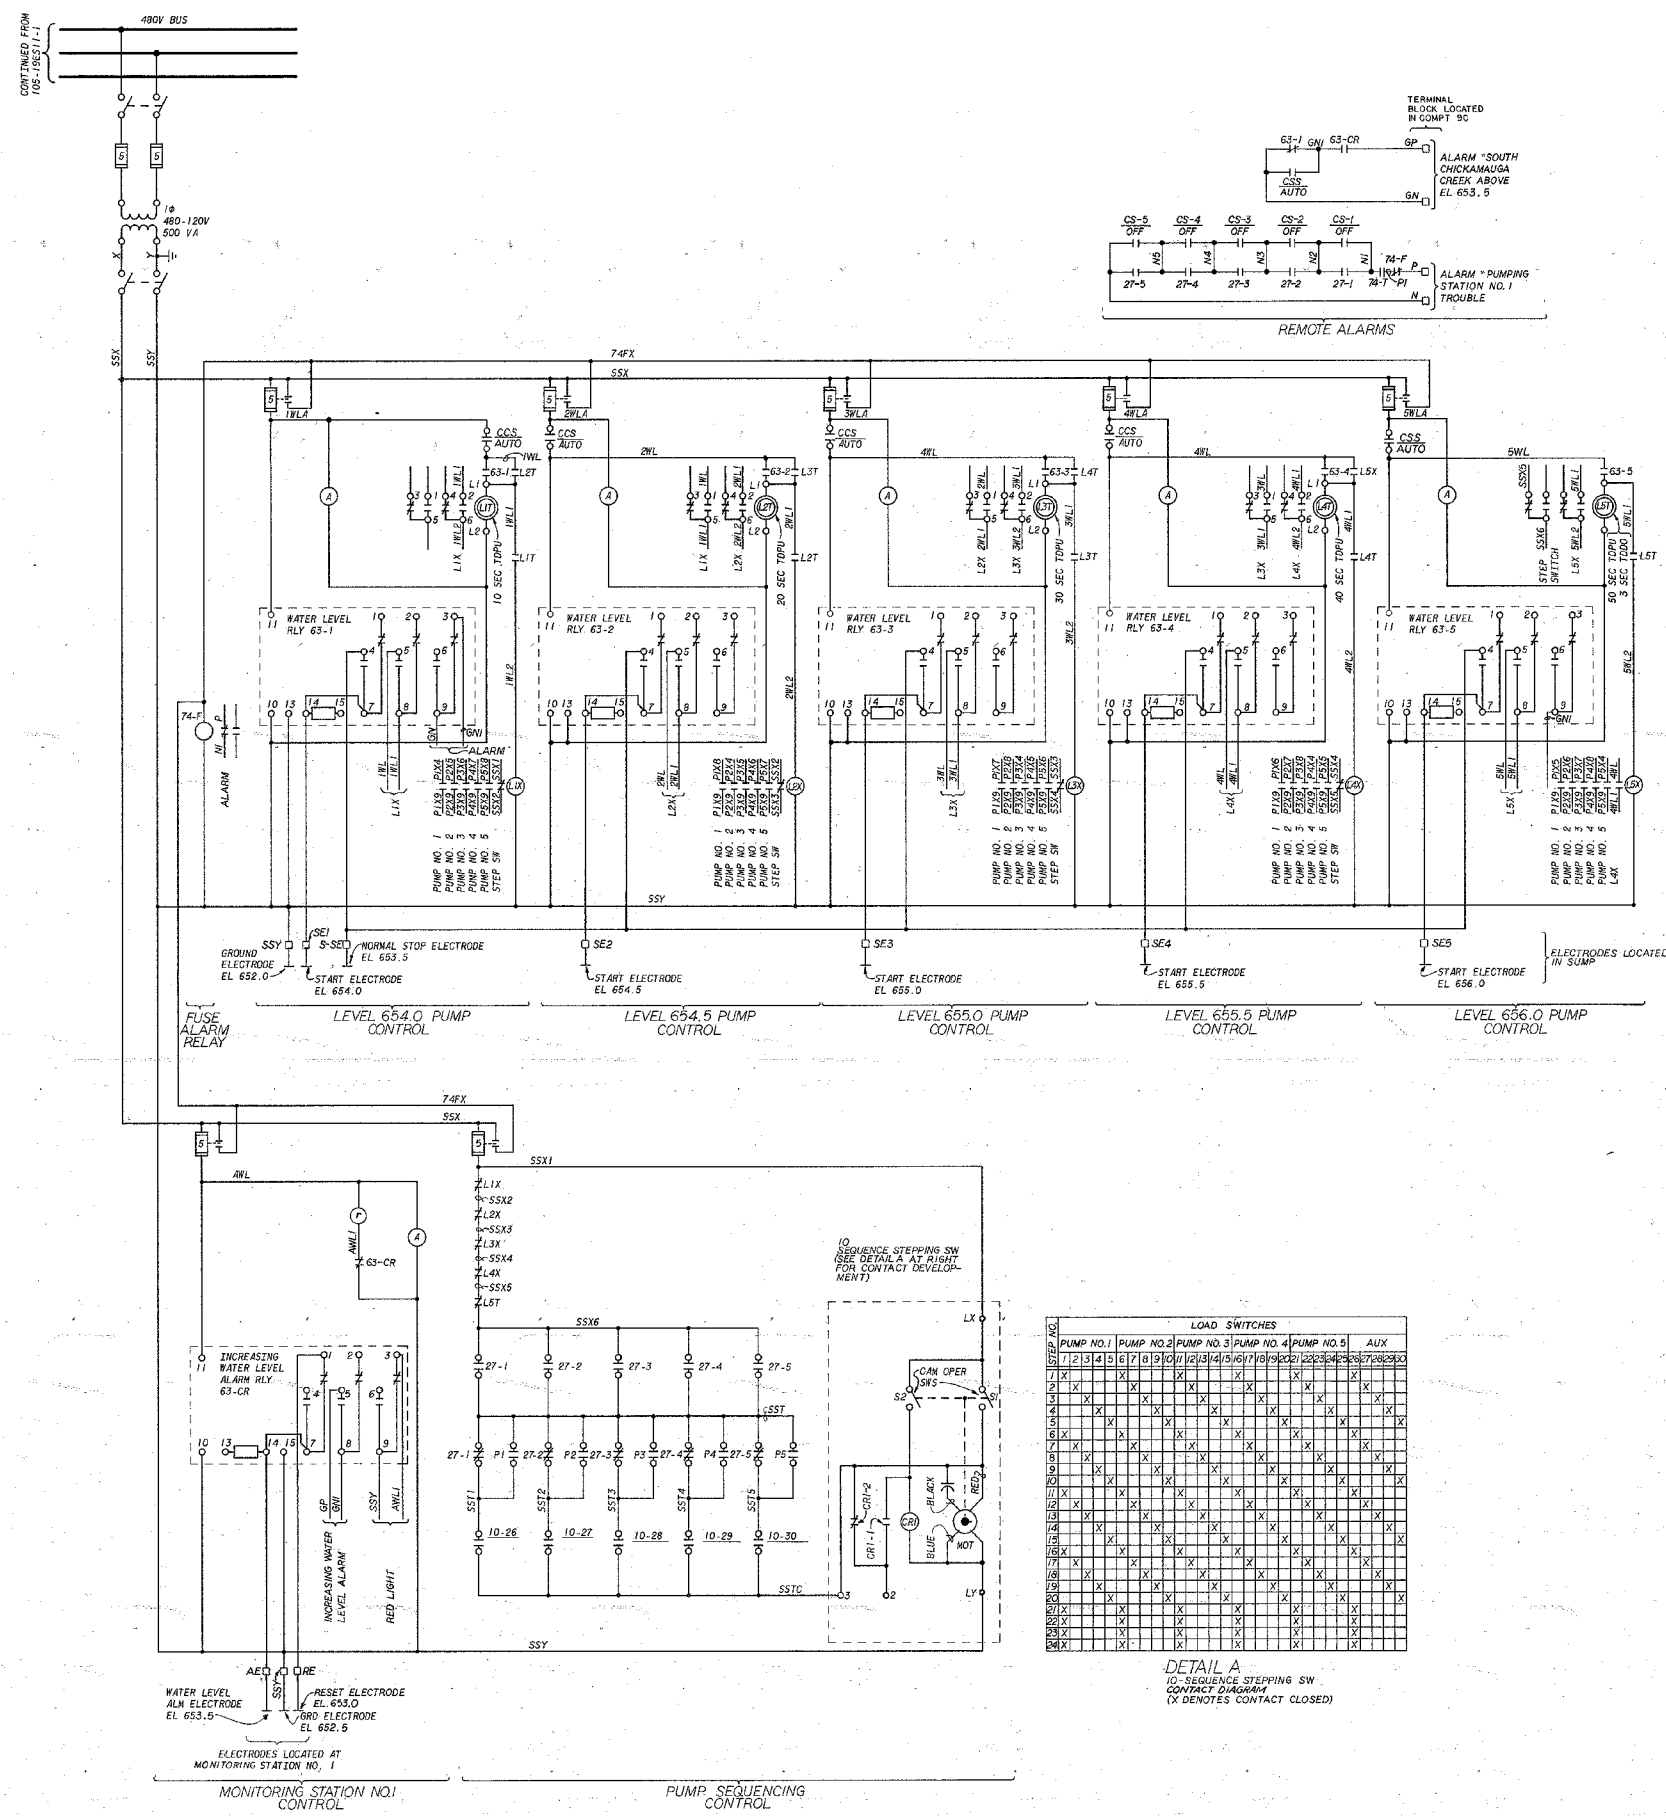

LOAD SWITCHES

STEP	PUMP NO. 1	PUMP NO. 2	PUMP NO. 3	PUMP NO. 4	PUMP NO. 5	AUX
1	X					
2	X	X	X	X	X	X
3	X	X	X	X	X	X
DETAIL A  
10-SEQUENCE STEPPING SW  
CONTACT DIAGRAM  
(X DENOTES CONTACT CLOSED)


REFERENCE DWGS:  
105-19E500 --- SINGLE LINE  
COMPANION DWGS:  
105-19E511 --- PUMPING STA. NO. 1  
SCHEMATIC SH. 1

MINOR CHANGES	
REV. NO.	DATE
DESIGNER	DATE
CHECKED	DATE
APPROVED	DATE
CHATTANOOGA FLOOD PROTECTION PUMPING STATION NO. 1	
WIRING DIAGRAMS A-C AUXILIARY POWER SCHEMATIC DIAGRAMS	
SOUTH CHICKAMAUGA CREEK PROJECT TENNESSEE VALLEY AUTHORITY DIVISION OF ENGINEERING DESIGN	
INSPECTED AND APPROVED FOR ISSUE	APPROVED
DATE	DATE
BY	BY
KNOXVILLE 1/31/77 81 E 105-19E511-2 R1	

INSPECTED AND APPROVED FOR ISSUE  
G. L. Buchanan  
DATE 1/31/77  
BY

11/16/77

A  
B  
C  
D  
E  
F  
G  
H  
J  
K

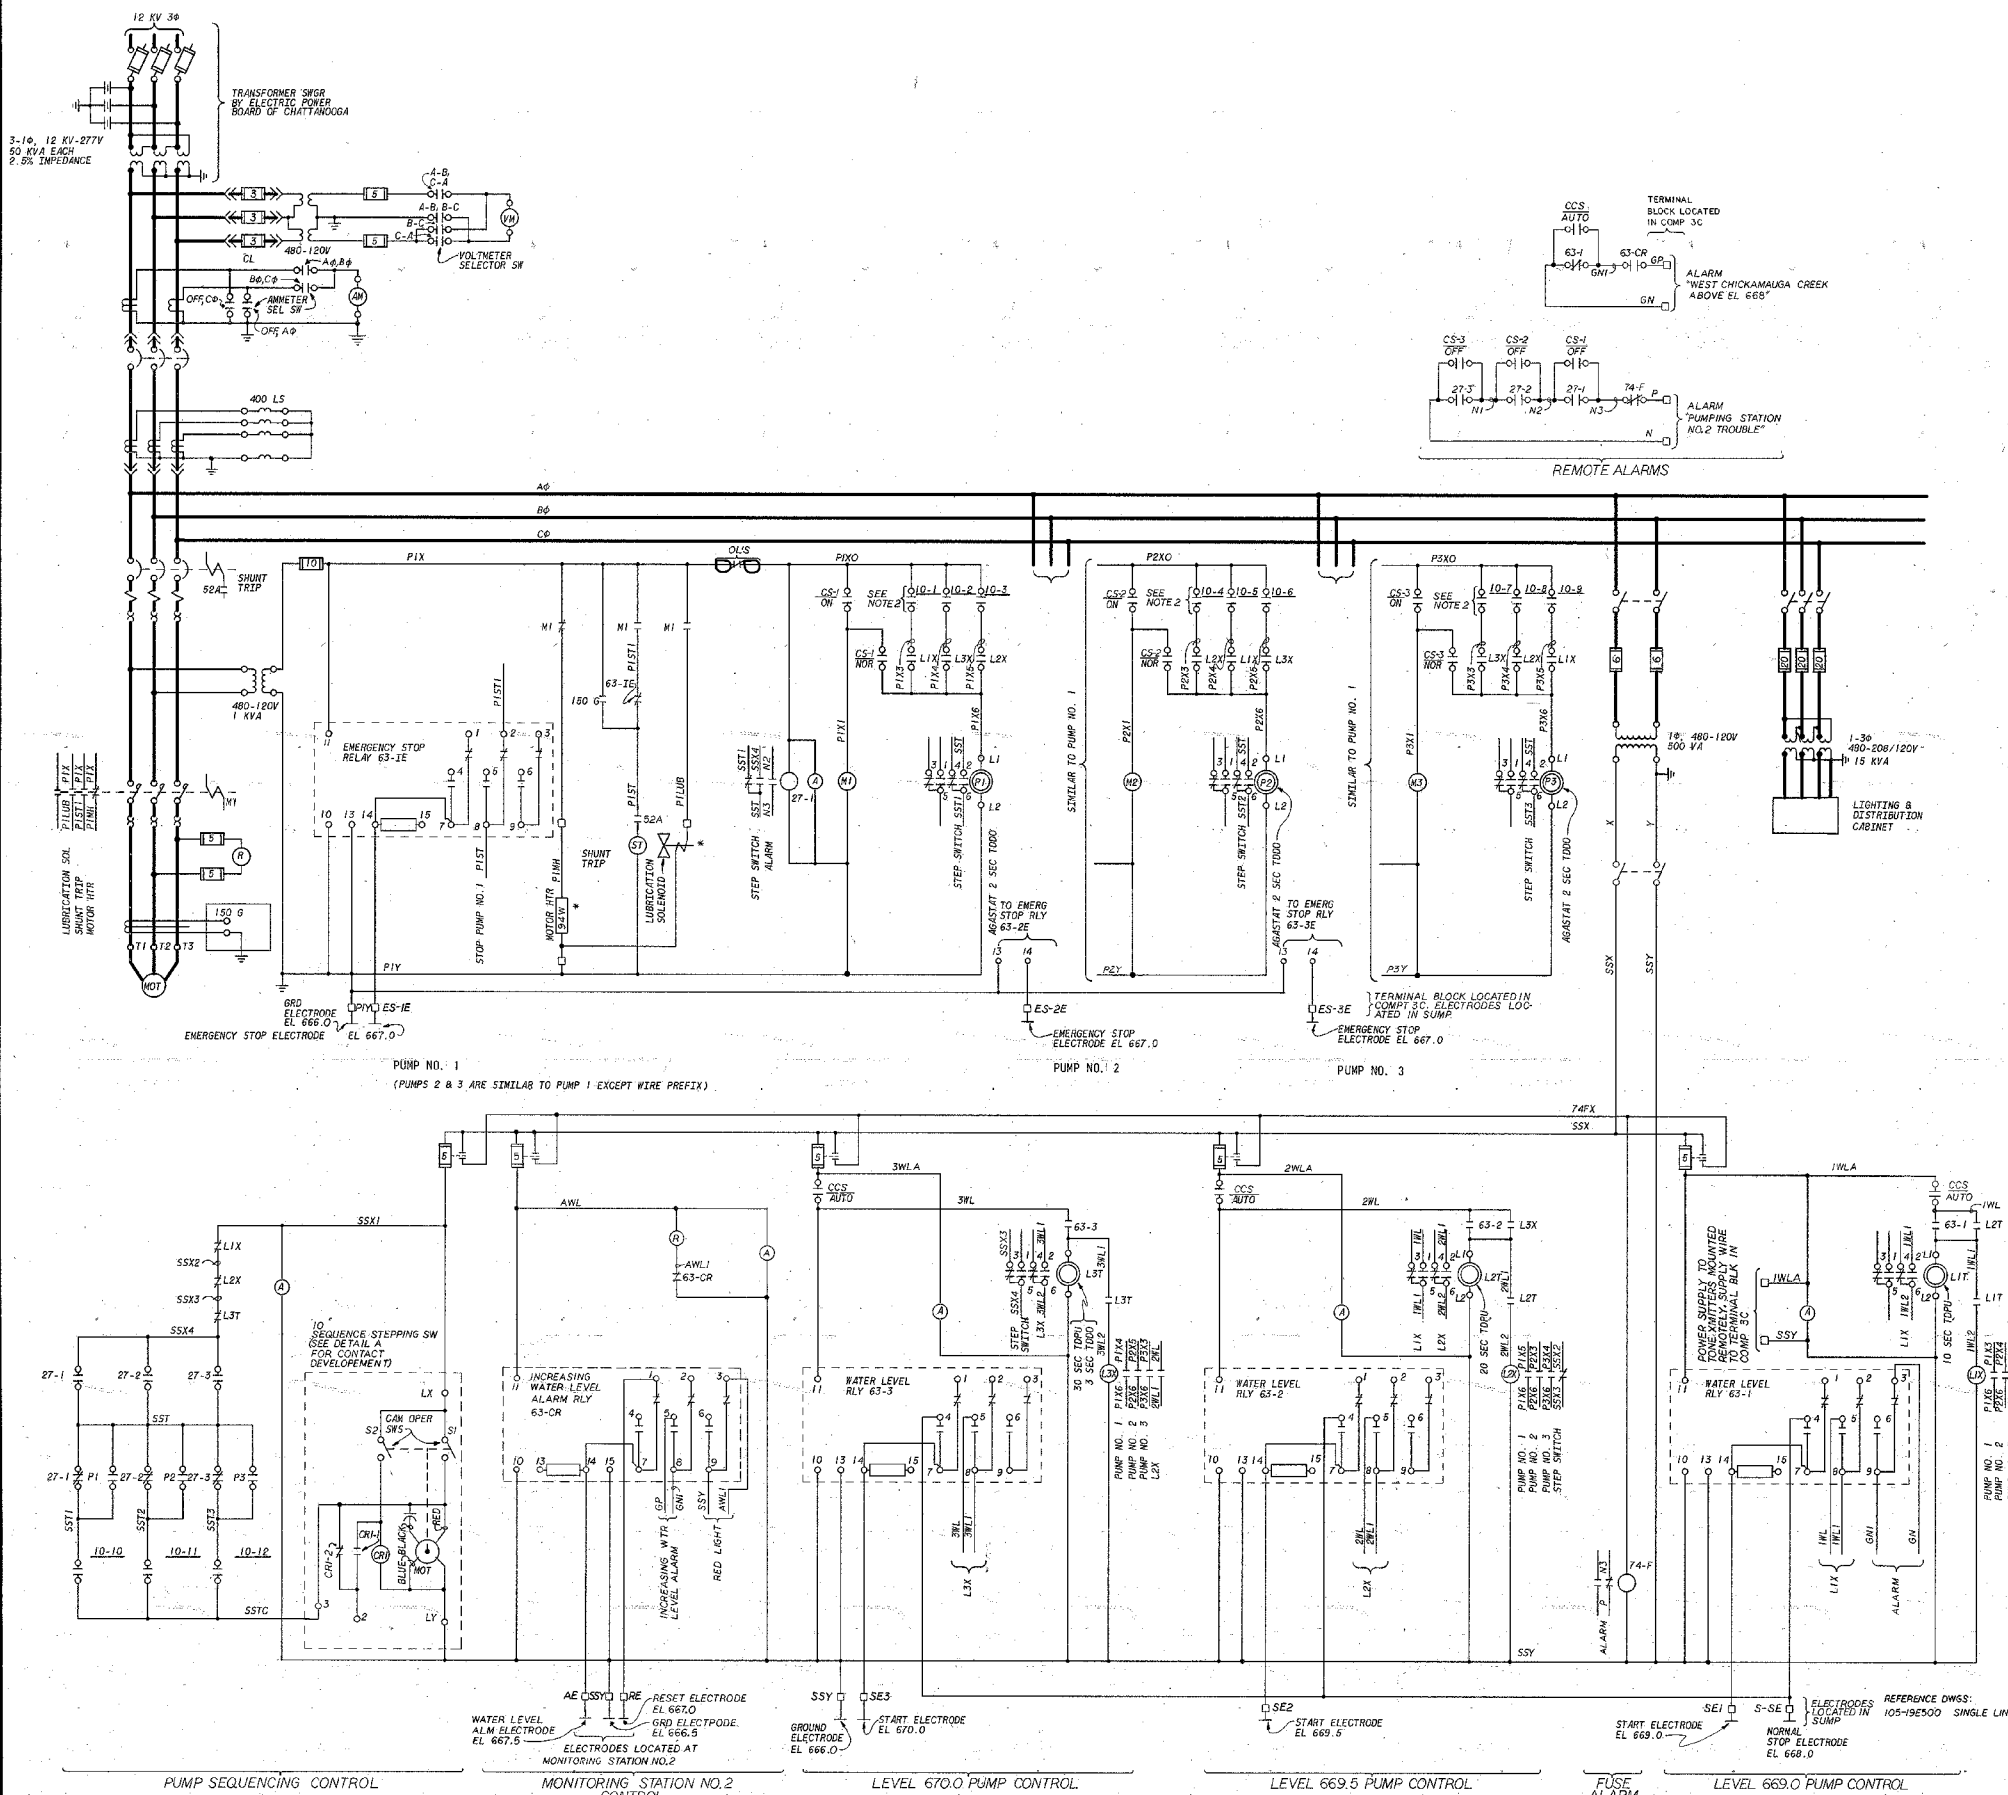

- NOTES:
- ASTERISKS (\*) INDICATE CONTROL EQUIPMENT LOCATED REMOTE FROM THE MOTOR CONTROL CENTER. RECTANGULAR SYMBOLS (□) INDICATE WIRING THAT THE MOTOR CONTROL CENTER VENDOR IS TO MAKE AVAILABLE AT TERMINAL BLOCKS IN THE RESPECTIVE COMPARTMENT (UNLESS OTHERWISE NOTED) FOR TVA CABLES.
  - THE CONTACTS OF SEQUENCE STEPPING SWITCH ARE LABELLED 10-1, 10-2, ETC. FOR CONTACT DIAGRAM OF SEQUENCE STEPPING SWITCH SEE DETAIL A.
  - FOR FURTHER DETAILS AND AS PURCHASED STATUS, SEE CONTROL POWER SYSTEMS INC. DRAWING R-41604, TVA CONTRACT 77K3-821901.

LOAD SWITCH

NO.	PUMP NO. 1	PUMP NO. 2	PUMP NO. 3	AUX.
1	X	X	X	X
2	X	X	X	X
DETAIL A  
10-SEQUENCE STEPPING SW CONTACT DIAGRAM (X DENOTES CONTACT CLOSED)

REVISIONS

NO.	DATE	BY	DESCRIPTION
1	7-10-78	...	...




CHATTANOOGA FLOOD PROTECTION PUMPING STATION NO. 2  
WIRING DIAGRAMS  
A-C AUXILIARY POWER  
SCHEMATIC DIAGRAMS  
SOUTH CHICKAMAUGA CREEK PROJECT  
TENNESSEE VALLEY AUTHORITY  
DIVISION OF ENGINEERING DESIGN

SUBMITTED: Robert E. Stewart  
RECOMMENDED: R. H. ...  
APPROVED: John E. ...

INSPECTED AND APPROVED FOR ISSUE: G. L. ...  
KNOXVILLE 1-31-77 81 E 105-19E512 RI


ME R.O. A1



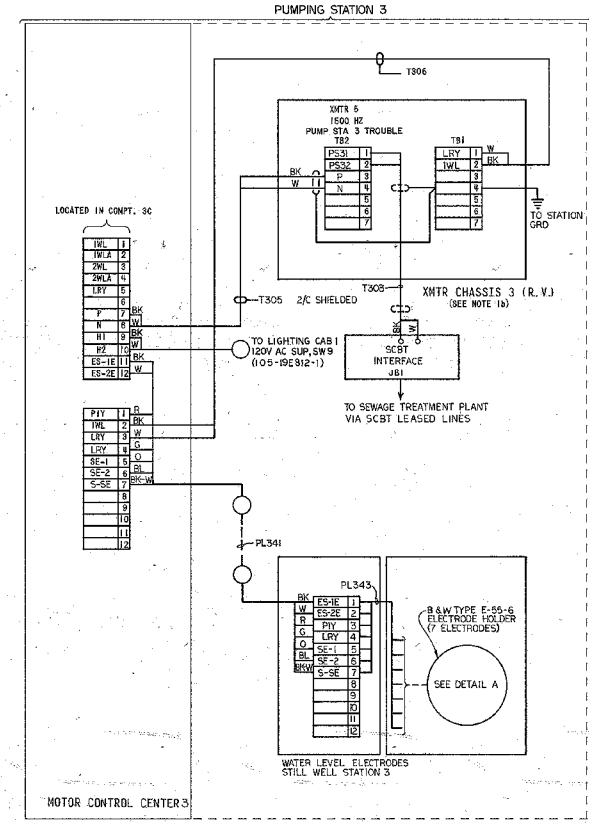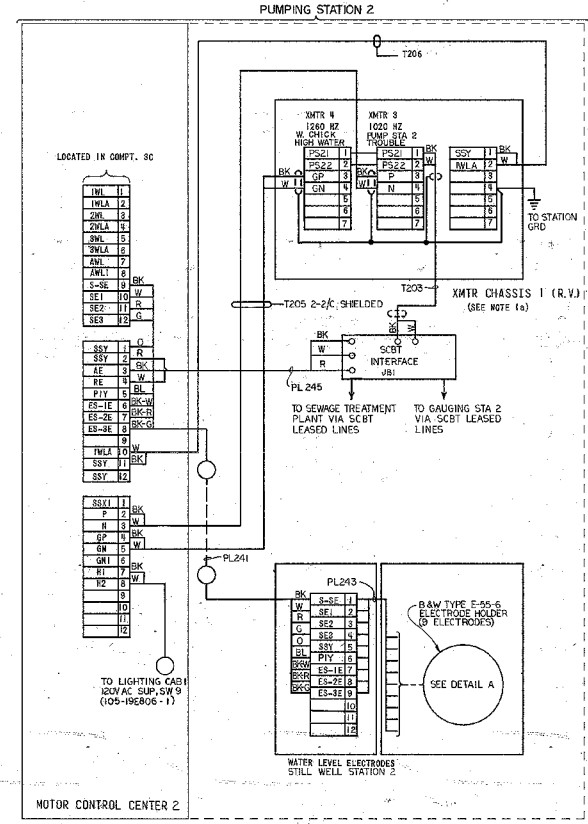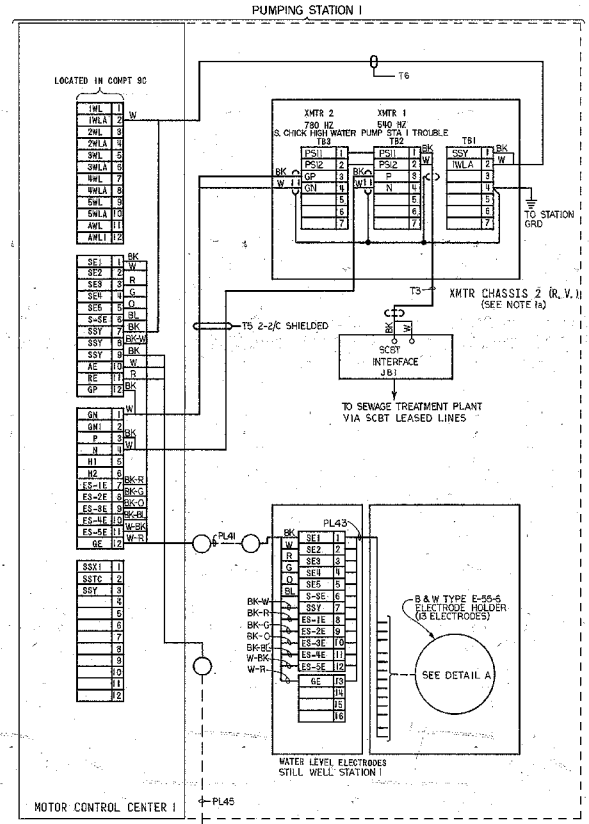


- NOTES:
- FOR XMTR AND PWR SUPPLY INTERVALS SEE TVA CONTRACT NO. 77K15-822428-1.
    - a) DWG NO. CB-21923-1
    - b) DWG NO. CB-21924-1
  - FOR REC. AND PWR SUPPLY INTERVALS SEE TVA CONTRACT NO. 77K15-822428-1. DWG NO. CB-21925-1.
  - FIELD TO LOCATE AND MOUNT PWR SUPPLY, SWITCHES, AND ALARM BELL PER TVA DWG 105-19E514.
  - FOR MISC. L.S. & S. DETAILS, SEE TVA CONTRACT NO. 77K15-822428-2, R-41658, R-41656 & R-41678.
  - FOR ANNUNCIATOR PANEL DETAILS, SEE TVA CONTRACT NO. 77K15-822428-2. FIELD TO REPLACE EXISTING NAMEPLATE ENGRAVING WITH SPARE NAMEPLATES ENGRAVED AS SHOWN.
  - SCBT IS SOUTH CENTRAL BELL TELEPHONE.

REFERENCE DWGS:  
 105-19E511-1-2  
 105-19E512  
 105-19E513  
 101-19E220

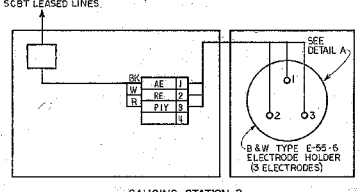

ELECTRODE NO.	WIRE NO.	ELEC. NO.	WIRE NO.	ELEC. NO.	WIRE NO.	ELEC. NO.	WIRE NO.	ELEC. NO.	WIRE NO.	ELEC. NO.
1	SE1	654	S-SE	668	ES-IE	667	SSY	662	AE	667.0
2	SE2	654.5	SE1	669	ES-2E	667	AE	663.5	RE	667.0
3	SE3	655	SE2	669.5	PIY	666.0	RE	663.0	SSY	666.0
4	SE4	656.5	SE3	670	LRY	666.0				
5	SE5	656	SSY	666.0	SE-1	669				
6	S-SE	663.5	PIY	666.0	SE-2	669.5				
7	SSY	662	W-IE	667	S-SE	668				
8	ES-IE	652.5	ES-2E	667						
9	ES-2E	662.5	ES-3E	667						
10	ES-3E	662.5								
11	ES-4E	662.5								
12	ES-5E	662.5								
13	GE	652								

\* GROUND ELECTRODE

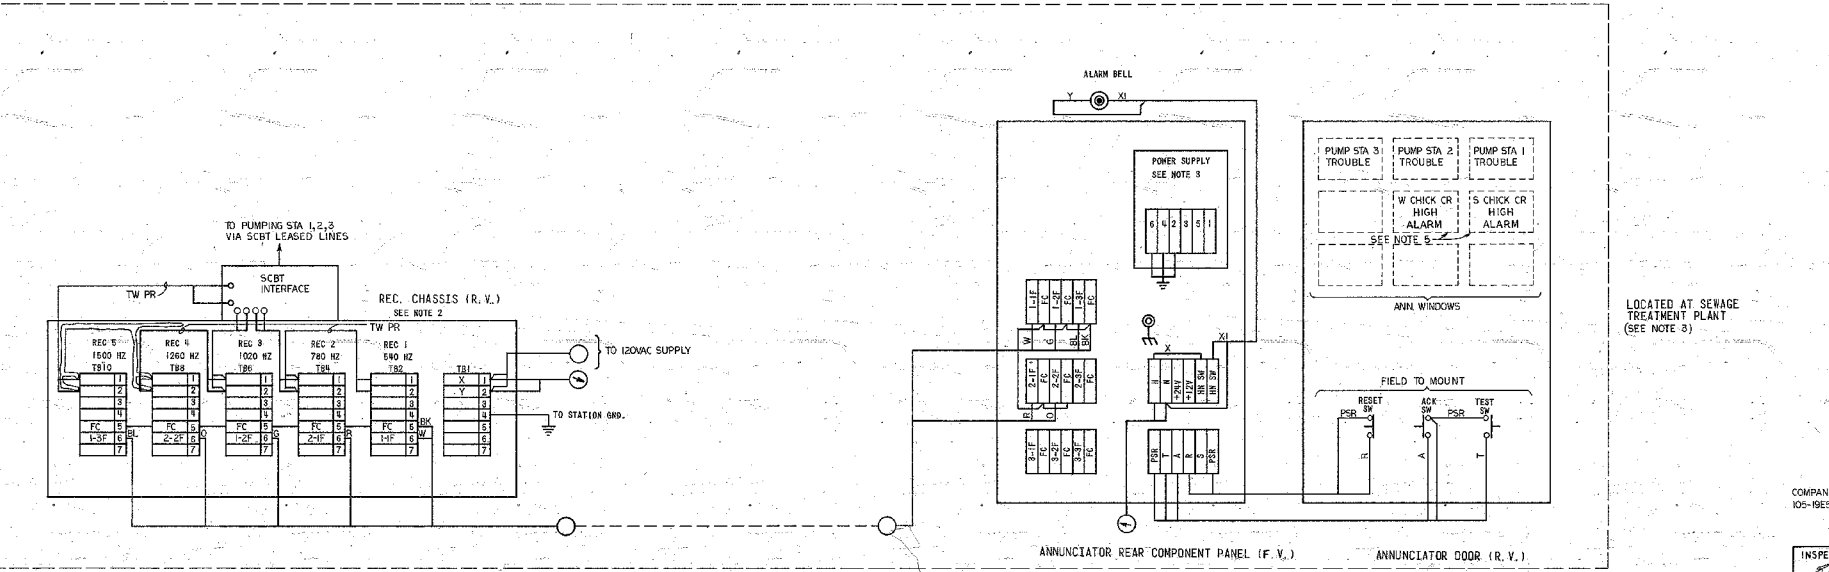


2	1925-87	10/11/78	10/11/78	10/11/78	10/11/78	10/11/78	10/11/78	10/11/78	10/11/78	10/11/78
MINOR REVISION										
SCALE EXCEPT AS NOTED										
CHATTANOOGA FLOOD PROTECTION PUMP STA 1, 2, 3 & SEWAGE TREATMENT PLANT										
WIRING DIAGRAMS CONTROL AND ALARM EQPT CONNECTION DIAGRAM										
SOUTH CHICKAMAUGA CREEK PROJECT TENNESSEE VALLEY AUTHORITY DIVISION OF ENGINEERING DESIGN										
SUBMITTED: Robert J. Stewart, RECOMMENDED: R. H. Warden, APPROVED: John B. Holliday										
KNOXVILLE 1-25-78 81 E 105-19E520-1 A2										

COMPANION DWGS: 105-19E520-2

INSPECTED AND APPROVED FOR ISSUE

PRINT SHEET 21

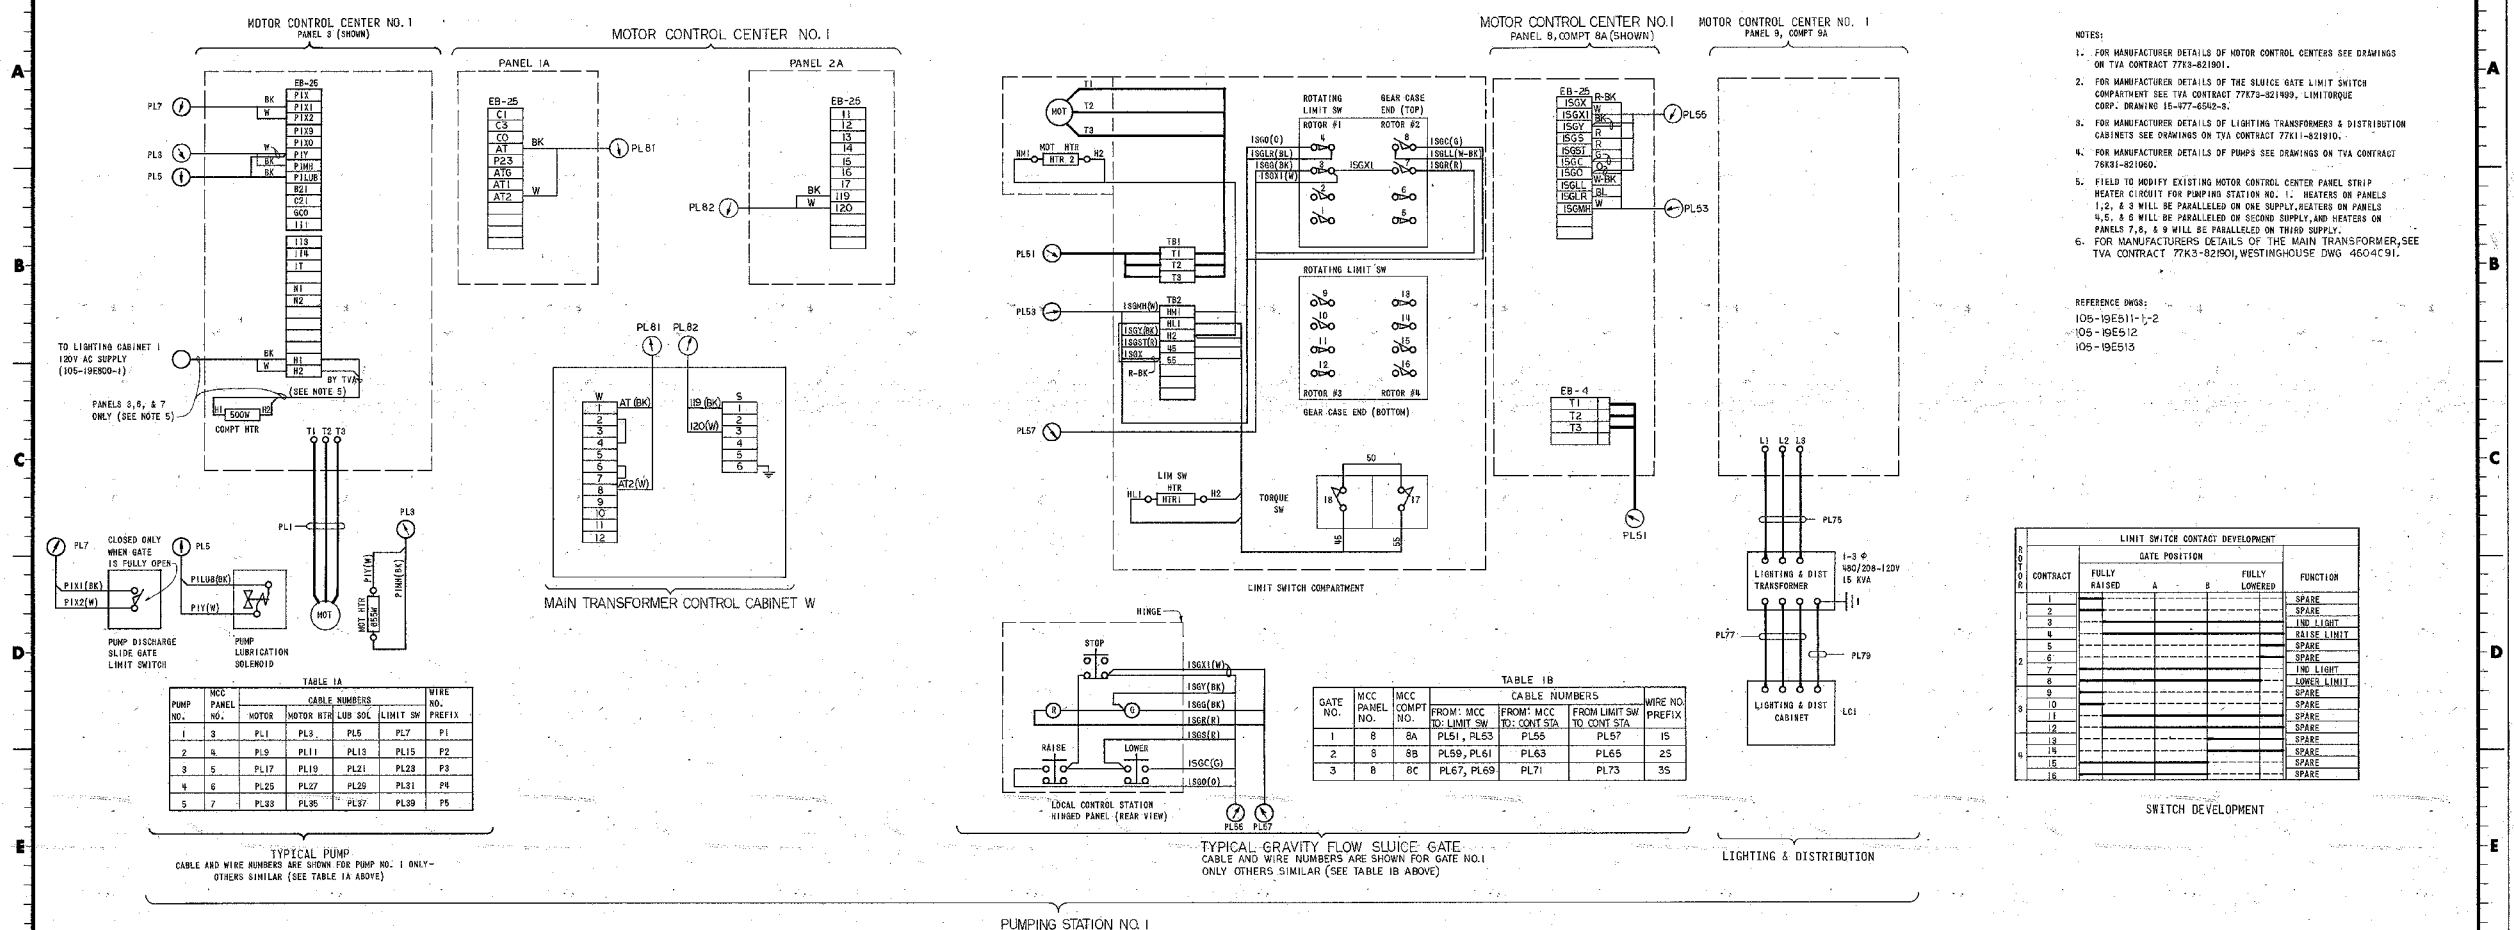

NOTES:


- FOR MANUFACTURER DETAILS OF MOTOR CONTROL CENTERS SEE DRAWINGS ON TVA CONTRACT 77K3-821901.
- FOR MANUFACTURER DETAILS OF THE SLUICE GATE LIMIT SWITCH COMPARTMENT SEE TVA CONTRACT 77K78-821909, LIMIT TORQUE CORR. DRAWING 15-77-6204-2.
- FOR MANUFACTURER DETAILS OF LIGHTING TRANSFORMERS & DISTRIBUTION CABINETS SEE DRAWINGS ON TVA CONTRACT 77K11-821910.
- FOR MANUFACTURER DETAILS OF PUMPS SEE DRAWINGS ON TVA CONTRACT 76K31-821060.
- FIELD TO MODIFY EXISTING MOTOR CONTROL CENTER PANEL STRIP HEATER CIRCUIT FOR PUMPING STATION NO. 1. HEATERS ON PANELS 1, 2, & 3 WILL BE PARALLELED ON ONE SUPPLY HEATERS ON PANELS 4, 5, & 6 WILL BE PARALLELED ON TRIP SUPPLY, AND HEATERS ON PANELS 7, 8, & 9 WILL BE PARALLELED ON TRIP SUPPLY.
- FOR MANUFACTURER DETAILS OF THE MAIN TRANSFORMER, SEE TVA CONTRACT 77K3-821901, WESTINGHOUSE DWG 4604C91.

REFERENCE DWGS:  
105-19E511-1, 2  
105-19E512  
105-19E515

**LIMIT SWITCH CONTACT DEVELOPMENT**

CONTRACT	GATE POSITION		FUNCTION
	FULLY RAISED	FULLY LOWERED	
1			SPARE
2			SPARE
3			IND. LIGHT
4			RAISE LIMIT
5			SPARE
6			SPARE
7			IND. LIGHT
8			LOWER LIMIT
9			SPARE
10			SPARE
11			SPARE
12			SPARE
13			SPARE
14			SPARE
15			SPARE
16			SPARE

**SWITCH DEVELOPMENT**

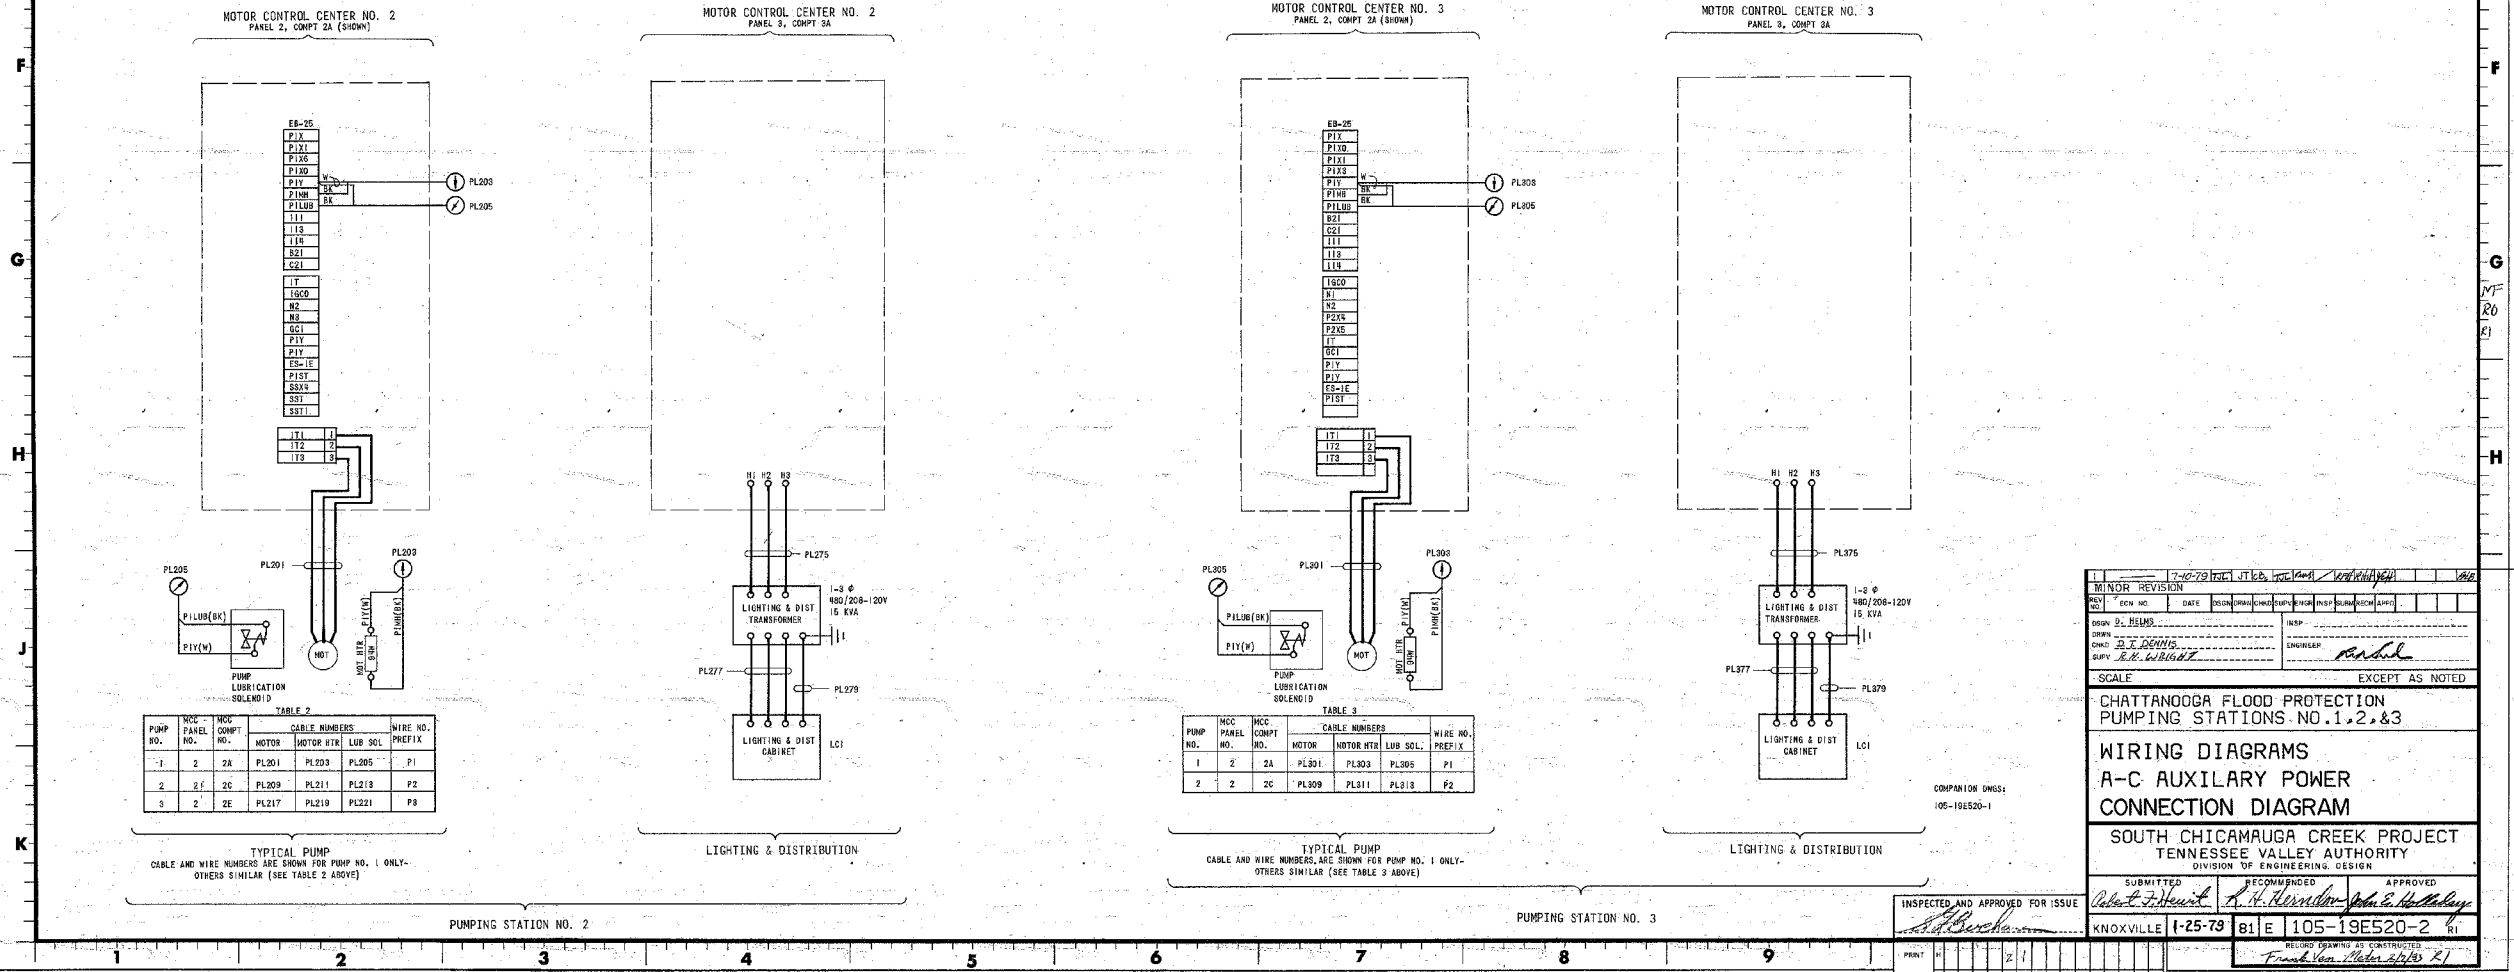

7-10-79 INCL. 1, 2, 3, 99, 100

MINOR REVISION

REV	DATE	DESCRIPTION
1		

SCALE: EXCEPT AS NOTED

**CHATTANOOGA FLOOD PROTECTION PUMPING STATIONS NO. 1, 2, & 3**

**WIRING DIAGRAMS A-C AUXILIARY POWER CONNECTION DIAGRAM**

**SOUTH CHICAMAUGA CREEK PROJECT TENNESSEE VALLEY AUTHORITY**  
DIVISION OF ENGINEERING DESIGN

INSPECTED AND APPROVED FOR ISSUE: *[Signature]*

RECOMMENDED: *[Signature]*


APPROVED: *[Signature]*

KNOXVILLE 1-25-79 81E 105-19E520-2


COMPANION DWGS: 105-19E520-1

SIZE	DATE	BY	CHKD	APP'D



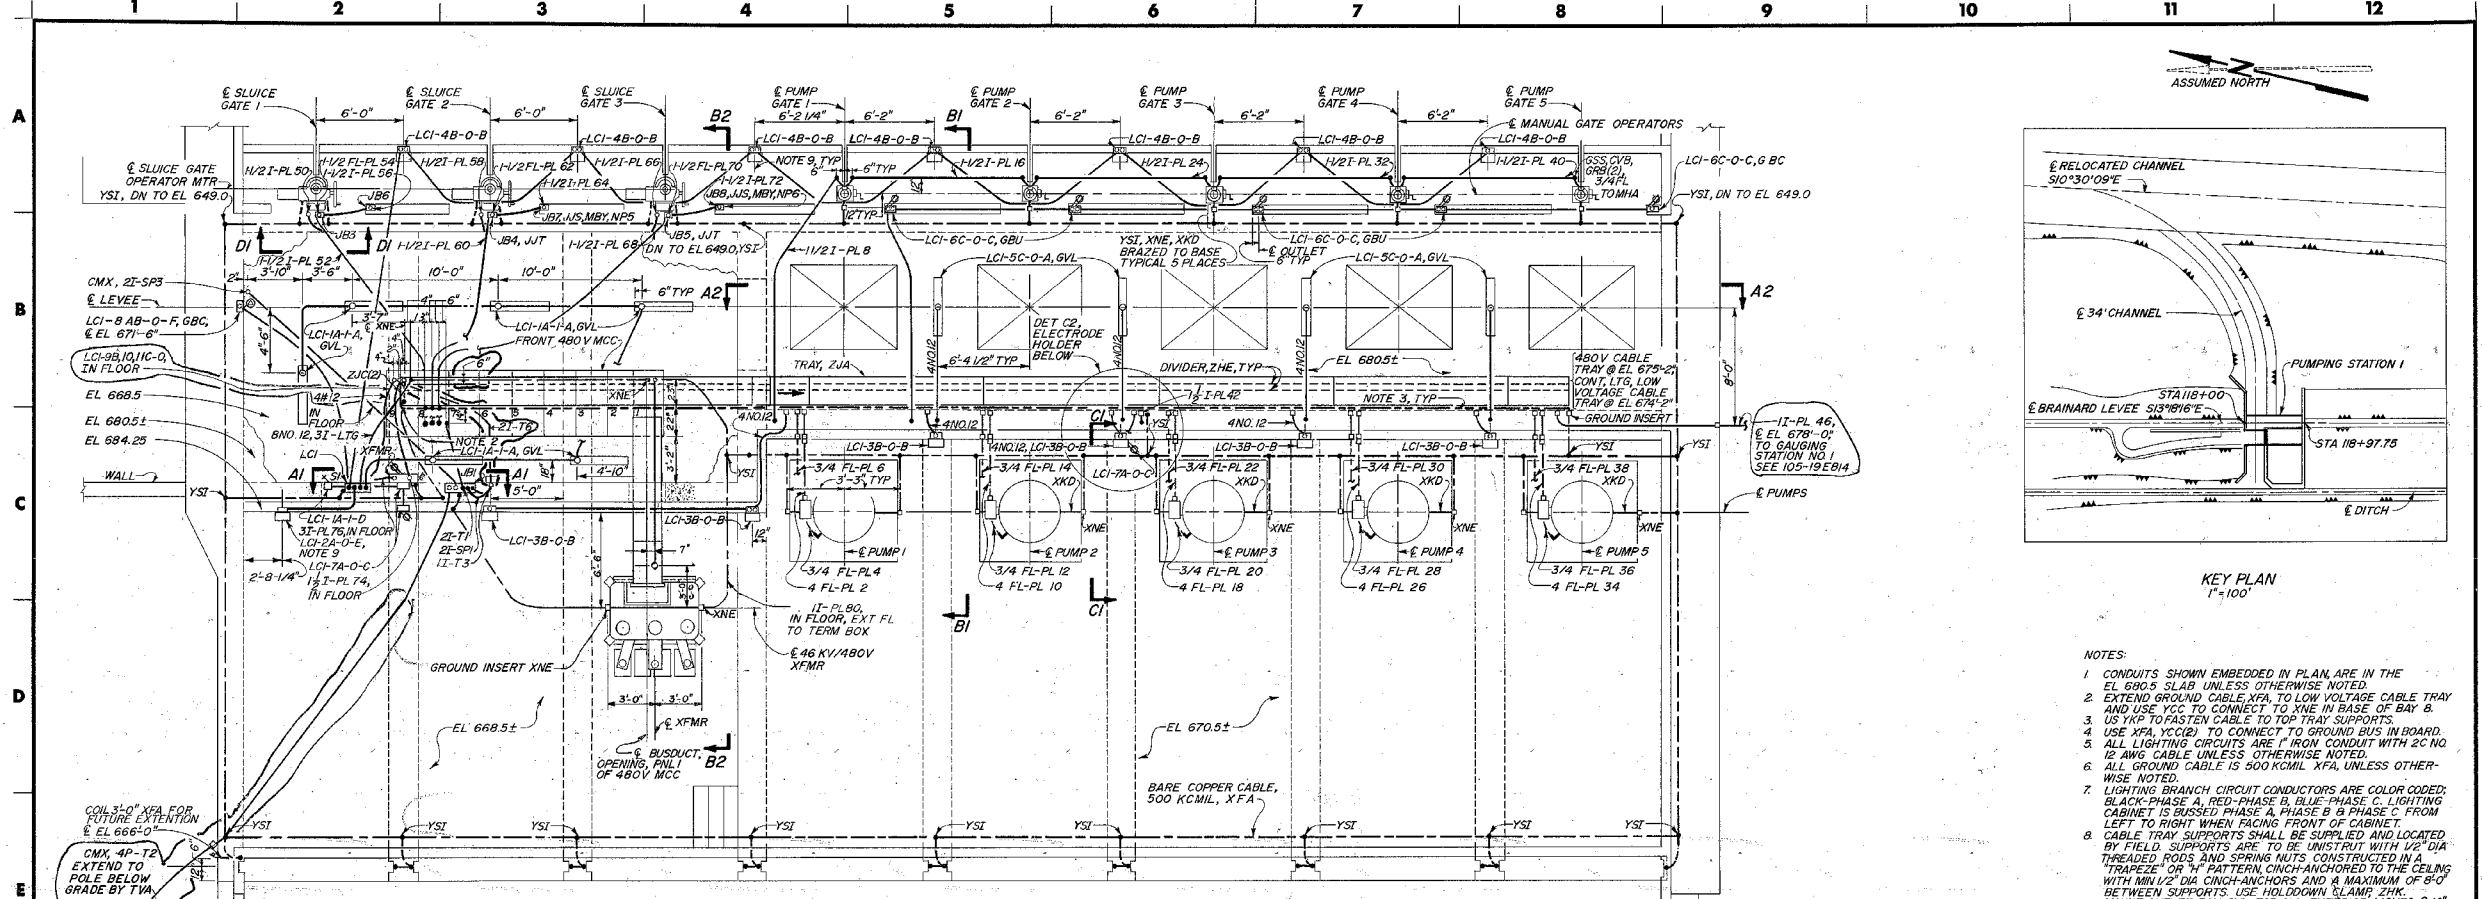


PLAN EL 680.5

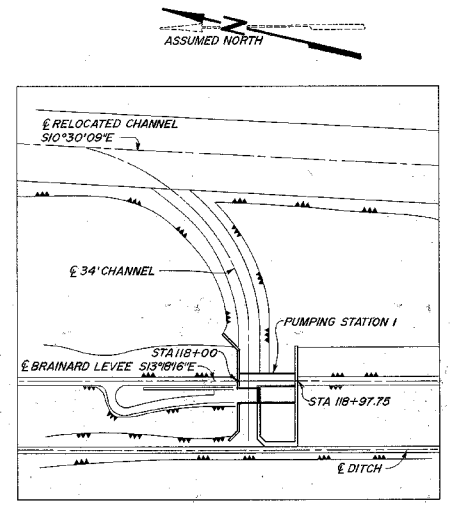


KEY PLAN  
1"=100'

- NOTES:
- CONDUITS SHOWN EMBEDDED IN PLAN, ARE IN THE EL 680.5 SLAB UNLESS OTHERWISE NOTED.
  - EXTEND GROUND CABLE, XFA, TO LOW VOLTAGE CABLE TRAY AND USE YCC TO CONNECT TO XNE IN BASE OF BAY B.
  - USE YKP TO FASTEN CABLE TO TOP TRAY SUPPORTS.
  - USE XFA, YCC(B) TO CONNECT TO GROUND BUS IN BOARD.
  - ALL LIGHTING CIRCUITS ARE 1" IRON CONDUIT WITH 2C NO 12 AWG CABLE UNLESS OTHERWISE NOTED.
  - ALL GROUND CABLE IS 500 KCMIL, XFA UNLESS OTHERWISE NOTED.
  - LIGHTING BRANCH CIRCUIT CONDUCTORS ARE COLOR CODED: BLACK-PHASE A, RED-PHASE B, BLUE-PHASE C. LIGHTING CABINET IS BUSSED PHASE A, PHASE B, PHASE C FROM LEFT TO RIGHT WHEN FACING FRONT OF CABINET.
  - CABLE TRAY SUPPORTS SHALL BE SUPPLIED AND LOCATED BY FIELD. SUPPORTS ARE TO BE UNISTRUT WITH 1/2" DIA THREADED RODS AND SPRING NUTS CONSTRUCTED IN A "TRAPEZOID" OR "T" PATTERN, CINCH-ANCHORED TO THE CEILING WITH MIN 1/2" DIA CINCH-ANCHORS AND A MAXIMUM OF 8'-0" BETWEEN SUPPORTS. USE HOLDDOWN CLAMP ZHK.
  - MOUNT OUTLET BOX, GVL, FOR ALL EXTERIOR LIGHTS & 10" BELOW TOP OF WALL.
  - THE CIRCUIT INDEX CARD LOCATED ON LCI SHALL BE LABELED PER DETAIL E1.
  - INSTALLATION FOR PUMP GATE LIMIT SWITCHES 2 THRU 4 IS SIMILAR TO PUMP GATE LIMIT SWITCH 1 AS SHOWN IN B-11. SEE CONDUIT & CABLE SCHEDULES.
  - FIELD TO GROUND ALL STRUCTURAL STEEL, EQUIPMENT FRAMES, AND MISC STEEL.
- REFERENCE DRAWINGS:  
105-19C800... CONDUIT & CABLE SCHEDULE  
105-19B800... BILL OF MATERIAL


- SYMBOLS:
- EXPOSED CONDUIT TURNING DOWN
  - EMBEDDED CONDUIT TURNING UP
  - 120V AC DUPLEX OUTLET
  - 208V AC OUTLET
  - SINGLE POLE SWITCH

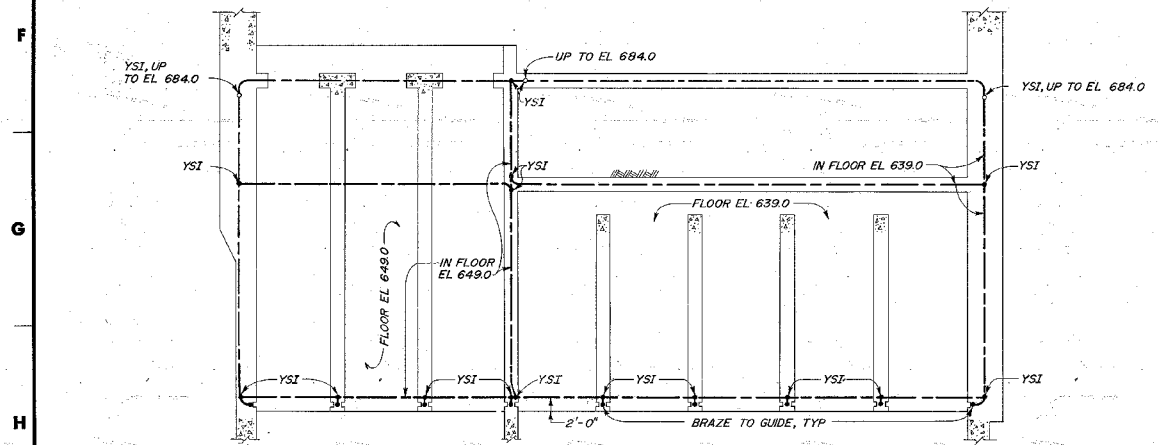


PLAN EL 649.0  
1/8"=1'-0"

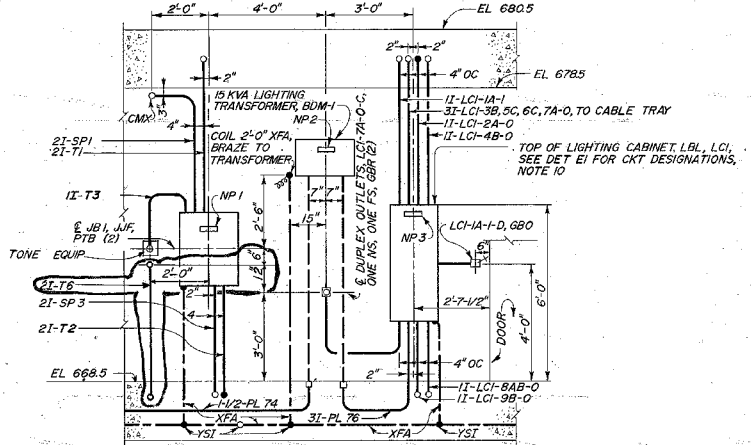


A1-A1  
1/2"=1'-0"

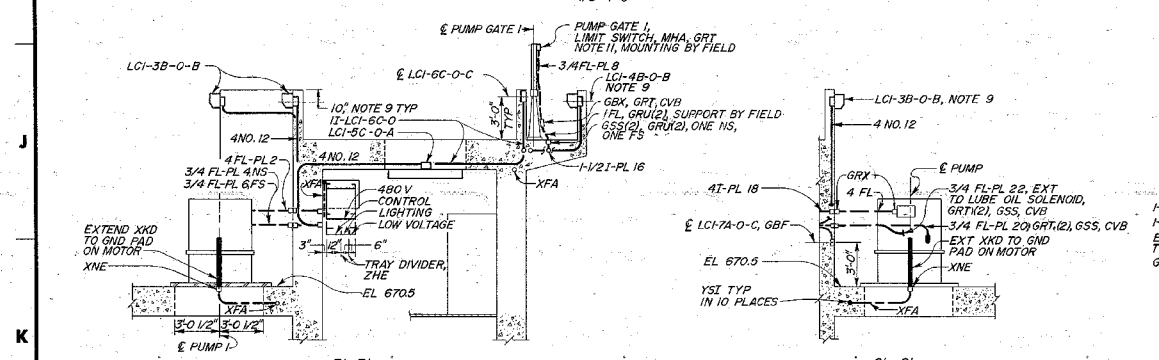

BI-BI

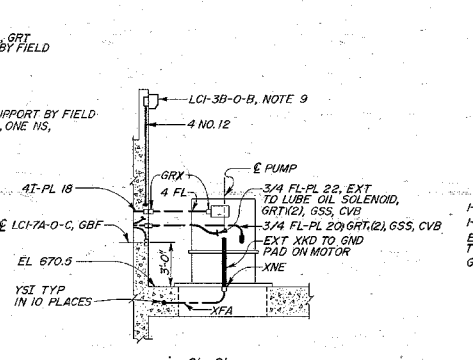

CI-CI  
TYPICAL PUMP MOTOR INSTALLATION

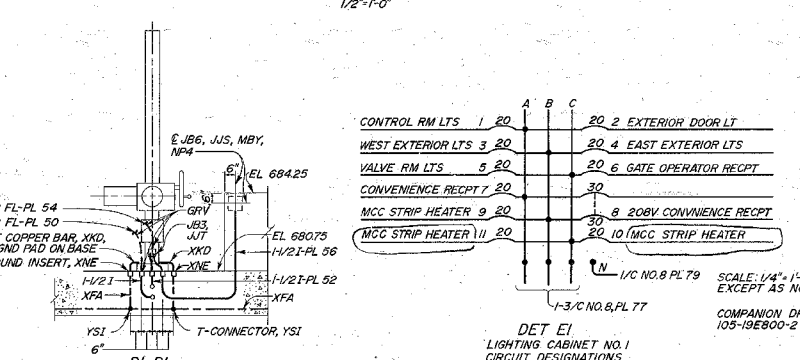

DI-DI  
TYPICAL MOTOR OPERATED GATE CONNECTION  
3/8"=1'-0"

CONTROL RM LTS	1	20	20	2	EXTERIOR DOOR LT
WEST EXTERIOR LTS	3	20	20	4	EAST EXTERIOR LTS
VALVE RM LTS	5	20	20	6	GATE OPERATOR RECEPT
CONVENIENCE RECEPT	7	20	30	8	ROBY CONVENIENCE RECEPT
MCC STRIP HEATER	9	20	20	10	MCC STRIP HEATER

INSPECTED AND APPROVED FOR ISSUE

SCALE: 1/4"=1'-0"  
EXCEPT AS NOTED

COMPANION DRAWING:  
105-19E800-2

3	19-2-78	BY	PKS/SLT/RWS	REVISED	10/24/78
2	MINOR REVISION	11-3-77	EQ	SLT	10/24/77
1	MINOR REVISION	6-14-77	BCA	PKS/SLT/RWS	10/24/77

CHATTAHOOGA FLOOD PROTECTION  
PUMPING STATION NO. 1




CONDUIT & GROUNDING & LIGHTING  
GENERAL ARRANGEMENT  
PLAN & DETAILS

SOUTH CHICKAMAUGA CREEK PROJECT  
TENNESSEE VALLEY AUTHORITY  
DIVISION OF ENGINEERING DESIGN

SUBMITTED	RECOMMENDED	APPROVED
W.H. Wainwright	George S. Wainwright	John C. Wainwright
KNOXVILLE 1-25-77	BI	E 105-19E800-1

RECORD DRAWING AS SUBMITTED 7-24-83  
E. RANK, VAN METER, P.S.

A  
B  
C  
D  
E  
F  
G  
H  
J  
K

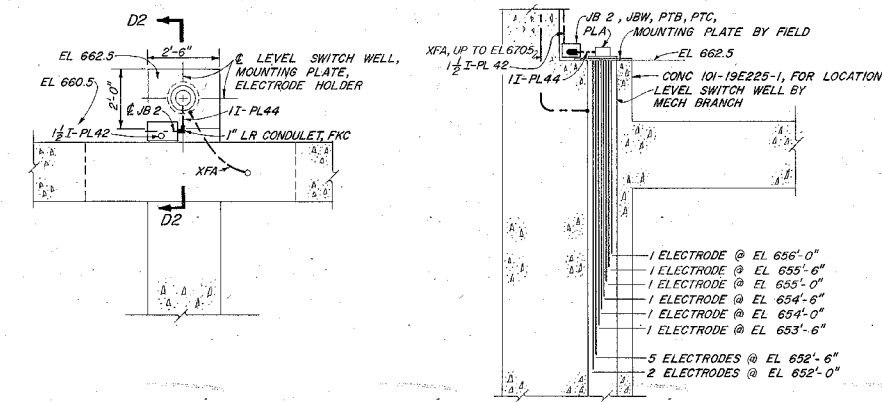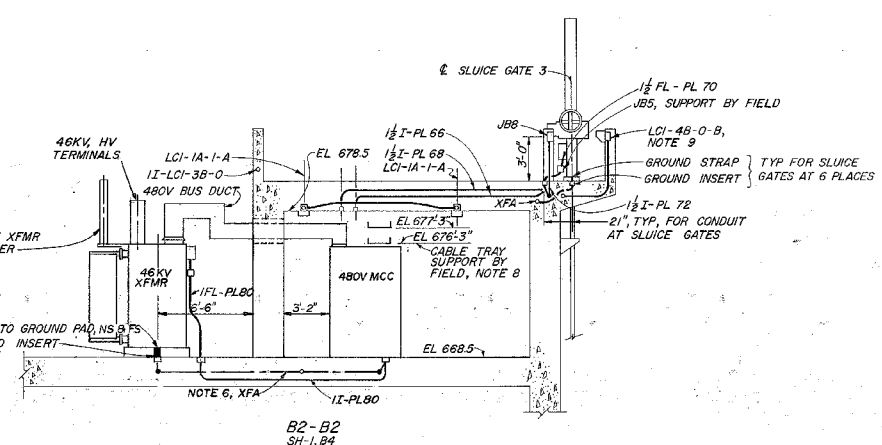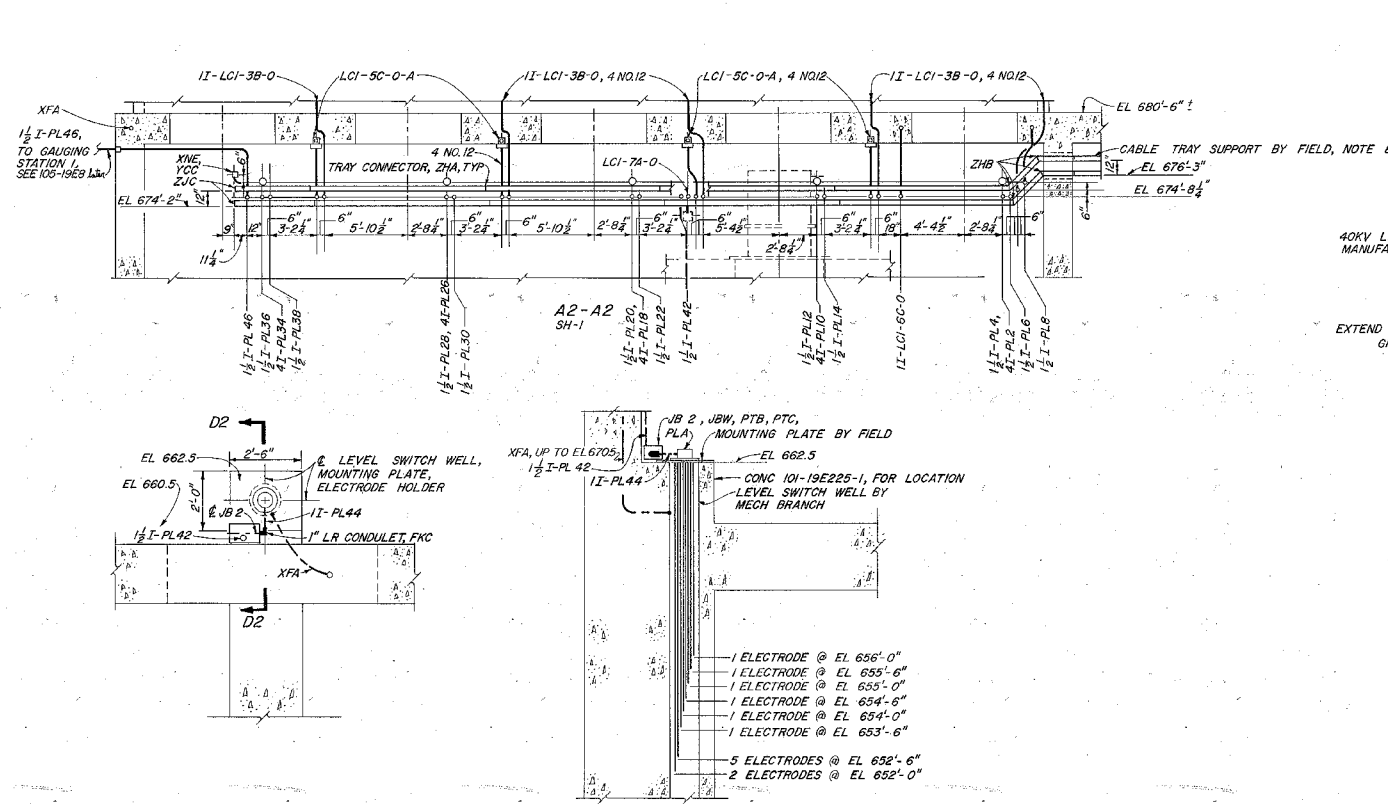

FOR NOTES AND REFERENCES SEE 105-19E800-1

NAME PLATE INDEX

NO.	TYPE	FIRST LINE	SECOND LINE	THIRD LINE
1	A	TEL TERM CAB.		JBI
2	A	LIGHTING CABINET	480V/208V/120V XFMR	LCI
3	A	SLUICE GATE 1	LOCAL CONT STA	JBB
4	A	SLUICE GATE 2	LOCAL CONT STA	JBB
5	A	SLUICE GATE 3	LOCAL CONT STA	JBB

JUNCTION BOX INDEX

NO.	MK	SIZE (INCHES)	LOCATION	USAGE	NP. NO.
1	JUF	30 24 9	SECT A1-A1 TELEPHONE TERM CAB		1
2	JWB	12 6 6	SECT D2-D2 TERM BOX, R. 41, PL 43		1
3	JUT	6 6 6	SECT D1-D1 PULL BOX		1
4	JUT	6 6 6	PLAN EL 660.5 PULL BOX		1
5	JUT	6 6 6	PLAN EL 660.5 PULL BOX		1
6	JWS	6 6 6	SECT D1-D1 LOCAL CONT STA, SLUICE GATE 1		4
7	JWS	6 6 6	PLAN EL 660.5 LOCAL CONT STA, SLUICE GATE 2		5
8	JWS	6 6 6	PLAN EL 660.5 LOCAL CONT STA, SLUICE GATE 3		6

LIGHTING FIXTURE SCHEDULE

DESCRIPTION	FIXTURE TYPES						MK LTR TOTALS
	A	B	C	D	E	F	
WALL LIGHT, 100W, HIGH PRESS. SODIUM, HOPHANE, 486-120							13
WALL LIGHT 100W, HIGH PRESS. SODIUM WITH PHOTO CONTROL, HOPHANE, 487-120							1
FLUORESCENT UNIT 2-40W, SURFACE MOUNTED, DAY BRITE, 48240-1							10
LAMP 100W, HIGH PRESS. SODIUM, MUGUL BASE, 120V, GE LW100/BU							20
DUPLEX RECEPTACLE, 2P-20A BY GROUNDING, HUBBELL 5302, FOR 120V USE							8
RECEPTACLE, 2P-3W GROUNDING, HUBBELL 9330, FOR 208V USE							1
COVER PLATE WITH SPRING DOOR COVER, FOR USE WITH LRB-8, CAST ALUMINUM, CROUSE HINDS-10309							1
TUMBLER SWITCH, 1P, 20A, 277V, HUBBELL 1221							1
SWITCH PLATE, HINGED COVER, CAST ALUMINUM, HUBBELL 1420							1
RECEPTACLE COVER, CAST ALUMINUM, SPRING DOORS WITH GASKET, FOR USE WITH LRB-7, HUBBELL 5206							8

\* SEE TVA DWG NO. GE 4 304 360

SCALE: 1" = 1' 0" EXCEPT AS NOTED

COMPANION DRAWING: 105-19E800-1

NO.	DATE	BY	CHKD	APP'D	REVISION
1	11-3-77	OC	NEW	WMS	MINOR REVISION
2	16-14-77	IS	CA	WMS	REVISION

CHATANOOGA FLOOD PROTECTION PUMPING STATION NO. 1

CONDUIT & GROUNDING & LIGHTING GENERAL ARRANGEMENT PLAN & DETAILS


SOUTH CHICKAMAUGA CREEK PROJECT TENNESSEE VALLEY AUTHORITY DIVISION OF ENGINEERING DESIGN

INSPECTED AND APPROVED FOR ISSUE: *[Signature]*


NO. 105-19E800-2 R2

WF  
ED  
R1  
R2


A  
B  
C  
D  
E  
F  
G  
H  
J  
K

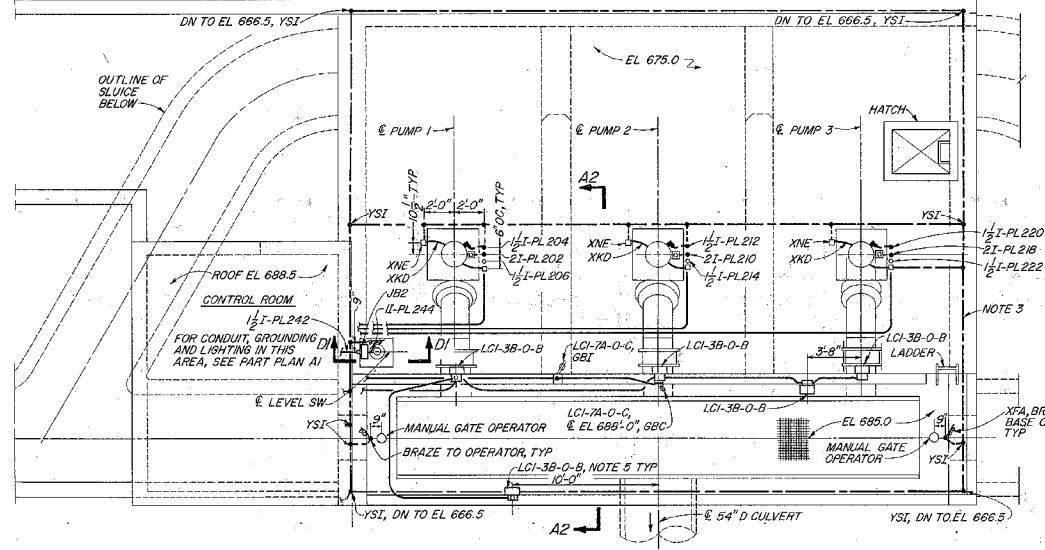

PLAN EL 688.5

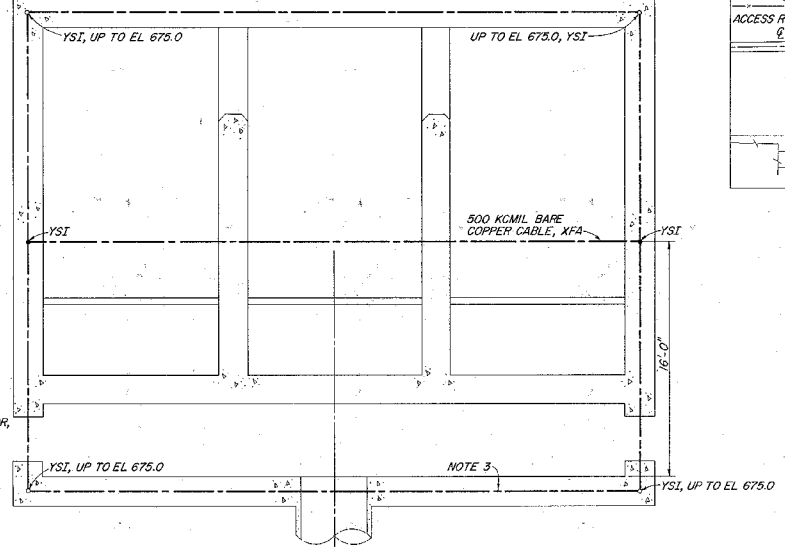


PLAN EL 666.5

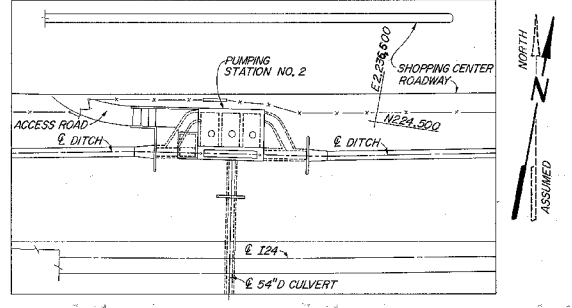


KEY PLAN  
1"=40'

- NOTES:
1. USE XFA, YCC, TO CONNECT TO GROUND BUS IN BOARD.
  2. ALL LIGHTING CIRCUITS ARE 1" IRON CONDUIT WITH 20 NO. 12 AWG CABLE UNLESS OTHERWISE NOTED.
  3. ALL GROUND CABLE IS 500KCMIL XFA UNLESS OTHERWISE NOTED.
  4. LIGHTING BRANCH CIRCUIT CONDUCTORS ARE COLOR CODED; BLACK-PHASE A, RED-PHASE B, BLUE-PHASE C. LIGHTING CABINET IS BUSSED PHASE A, PHASE B & PHASE C FROM LEFT TO RIGHT, WHEN FACING FRONT OF CABINET.
  5. MOUNT OUTLET BOX, GVL, FOR EXTERIOR LIGHTS @ 10" BELOW TOP OF WALL UNLESS OTHERWISE NOTED.
  6. THE CIRCUIT INDEX CARD LOCATED ON LCI SHALL BE LABELED PER DETAIL E1.
  7. FIELD TO GROUND ALL STRUCTURAL STEEL, EQUIPMENT FRAMES, AND MISC. STEEL.
- REFERENCE DRAWINGS:  
105-19C800 - CONDUIT & CABLE SCHEDULE  
105-19B806 - BILL OF MATERIAL


- SYMBOLS:
- EXPOSED CONDUIT TURNING DOWN
  - EMBEDDED CONDUIT TURNING UP
  - ⊕ 120V AC DUPLEX OUTLET
  - ⊙ 208V AC SINGLE OUTLET
  - ⊕ SINGLE POLE SWITCH

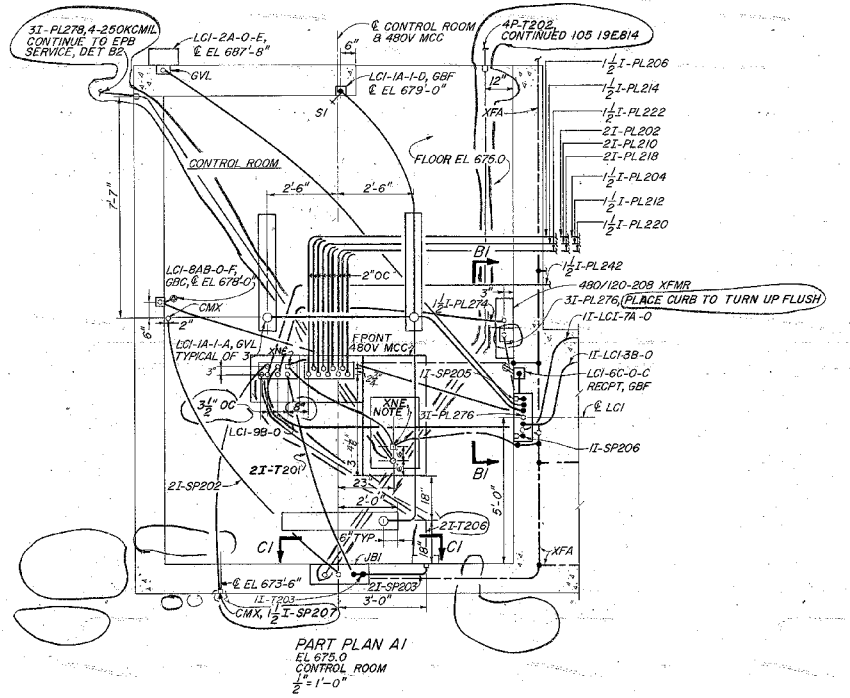

PART PLAN A1  
EL 675.0  
CONTROL ROOM  
2"=1'-0"

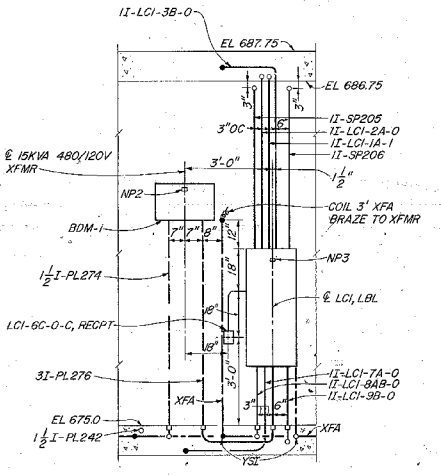

BI-BI  
1/2"=1'-0"

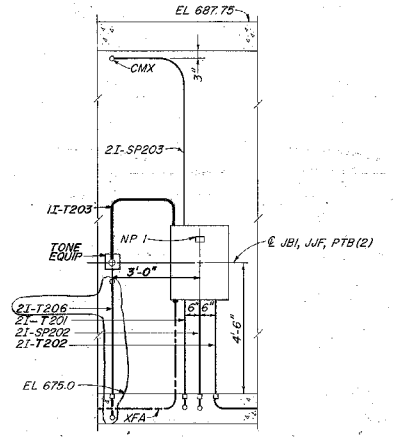


CI-CI  
1/2"=1'-0"

	A	B	C	
CONTROL RM LTS 1	20	20	20	2 EXTERIOR DOOR LT
EXTERIOR LTS 3	20	20	20	4
	20	20	20	6 CONT RM CONVENIENCE RECPT
EXTERIOR CONVENIENCE RECPT 7	20	20	20	
MCC STRIP HEATER 9	20	20	20	8 208V CONVENIENCE RECPT
	20	20	20	10

1-3/C NO. 8, PL. 277

DET E1  
LIGHTING CABINET NO. 1  
CIRCUIT DESIGNATIONS  
NTS

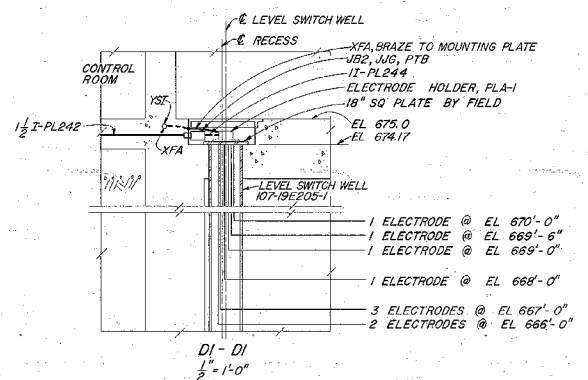

DI-DI  
1/2"=1'-0"

SCALE: 1/4"=1'-0"  
EXCEPT AS NOTED

COMPANION DRAWING:  
105-19E806-2

REV	DATE	BY	CHKD	DESCRIPTION
3	10-5-78	JK	JK	REVISED
2	11-2-77	DCL	JK	MINOR REVISION
1	10-14-77	BCA	JK	MINOR REVISION

CHATTANOOGA FLOOD PROTECTION  
PUMPING STATION NO. 2


CONDUIT & GROUNDING & LIGHTING  
GENERAL ARRANGEMENT  
PLAN & DETAILS

SOUTH CHICKAMAUGA CREEK PROJECT  
TENNESSEE VALLEY AUTHORITY  
DIVISION OF ENGINEERING DESIGN


INSPECTED AND APPROVED FOR ISSUE: *[Signature]*  
DATE: 1-25-77

RECORDED AS CONSTRUCTED: 7 PL. 23  
PRINTED: 1-25-77

A  
B  
C  
D  
E  
F  
G  
H  
J  
K

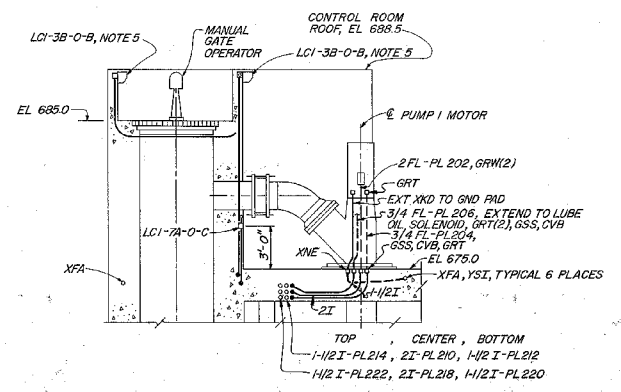

A2-A2  
TYPICAL PUMP MOTOR INSTALLATION  
SH 1,C4

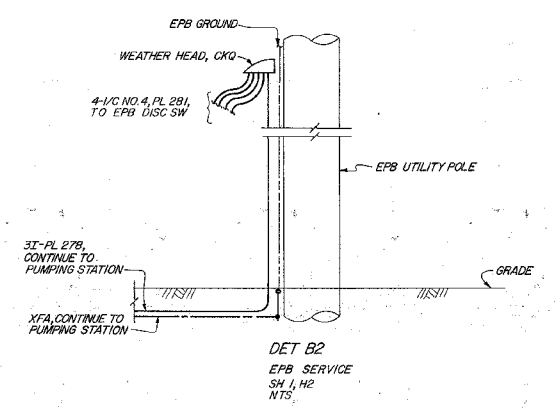

FOR NOTES AND REFERENCES  
SEE 105-19E806-1.

NAME PLATE INDEX

NO.	TYPE	FIRST LINE	SECOND LINE	THIRD LINE	HP NO.
1	A	TELEPHONE TERM CAB		JB1	1
2	A		480V/120-208V XFMR		
3	A		LC1	3 @ 2.4W/120-208V	

JUNCTION BOX INDEX

NO.	MK	SIZE (INCHES)			LOCATION	USAGE	HP NO.
		H	W	D			
1	JJF	30	24	8	SECT C1-C1	TELEPHONE TERM CAB	1
2	JJG	12	6	4	SECT D1-D1	TERM BOX, PL241, PL243	

LIGHTING FIXTURE SCHEDULE

DESCRIPTION	FIXTURE TYPES	FIXTURE TOTALS						MK TP TOTALS
		A	B	C	D	E	F	
WALL LIGHT 100W, HIGH PRESS. SODIUM, HOLOPHANE, 486-120.	LOK1		1					5
WALL LIGHT 100W, HIGH PRESS. SODIUM, WITH PHOTO CONTROL, HOLOPHANE, 487-120.	LOK2					1		1
FLUORESCENT UNIT 2-40W, SURFACE MOUNTED, DAY BRITE, 48240-4.	LHD	1						3
LAMP 40 W COOL WHITE, RAPID START, GE F40 CW.	LPA1	2						6
LAMP 100W, HIGH PRESS. SODIUM, MAGUL BASE, 120 V, GE LU100/BU.	LPP1		1			1		6
DUPLEX RECEPTACLE 2P 20A, 3W GROUNDING, HUBBELL 5362, FOR 120V USE.	LRB7			1				3
RECEPTACLE, 2P-3W GROUNDING, HUBBELL 9330, FOR 208V USE.	LRB8						1	1
COVER PLATE WITH SPRING DOOR COVER, FOR USE WITH LR B-8, CAST ALUMINUM, CROUSE-HINDS DS-10306.	LRB9						1	1
TUMBLER SWITCH, 1P, 20A, 277V, HUBBELL 1221.	LSE				1			1
SWITCH PLATE HINGED COVER, CAST ALUMINUM, HUBBELL 7450.	LVD					1		1
RECEPTACLE COVER, CAST ALUMINUM SPRING DOORS WITH GASKET, FOR USE WITH LRB-7, HUBBELL 5206.	LVD			1				3


SCALE 1/8" = 1'-0"  
EXCEPT AS NOTED

COMPANION DRAWING:  
105-19E806-1


MINOR REVISION														
NO.	DATE	BY	CHKD	APPD	DATE	BY	CHKD	APPD	DATE					
1	6-19-77	W.H. Harwood	H.C. Priddy	J.P. Kelly										
CHATTANOOGA FLOOD PROTECTION PUMPING STATION NO.2 CONDUIT & GROUNDING & LIGHTING GENERAL ARRANGEMENT PLAN & DETAILS SOUTH CHICKAMAUGA CREEK PROJECT TENNESSEE VALLEY AUTHORITY DIVISION OF ENGINEERING DESIGN														
SUBMITTED					RECOMMENDED					APPROVED				
INSPECTED AND APPROVED FOR ISSUE W.H. Harwood H.C. Priddy J.P. Kelly														
KNOXVILLE 1-25-77 81 E 105-19E806-2 R 1														
RECORD DRAWING AS CONSTRUCTED 7 FEB 83														
SCALE: 1/8" = 1'-0"														

\* SEE TVA DWG GE 4 30A 360


A  
B  
C  
D  
E  
F  
G  
H  
J  
K

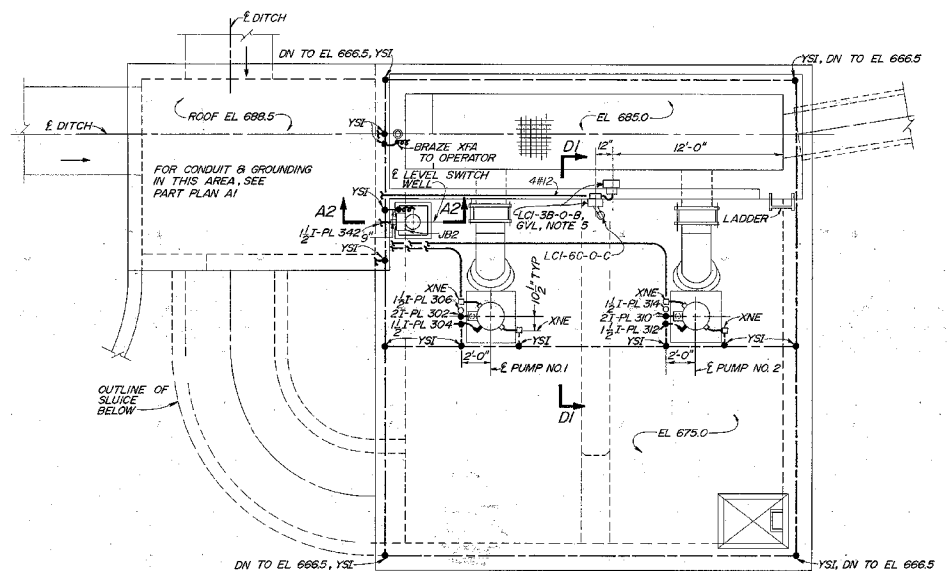

PLAN EL 688.5



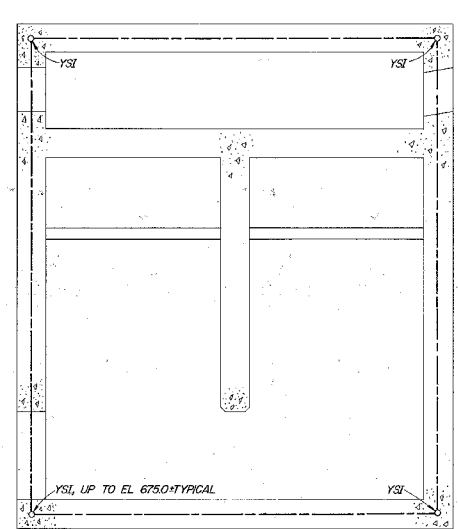


PLAN EL 666.5



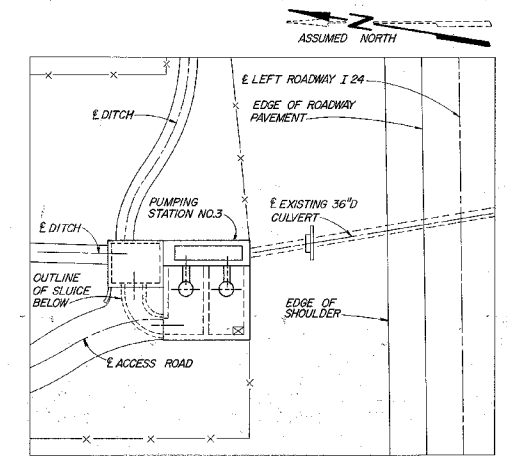


KEY PLAN  
1" = 20'-0"

- NOTES:
1. USE XFA, YCC TO CONNECT TO GROUND BUS IN BOARD.
  2. ALL LIGHTING CIRCUITS ARE 1" IRON CONDUIT WITH 2C NO. 12 AWG CABLE UNLESS OTHERWISE NOTED.
  3. ALL GROUND CABLE IS 550KCMIL, XFA UNLESS OTHERWISE NOTED.
  4. LIGHTING BRANCH CIRCUIT CONDUCTORS ARE COLOR CODED; BLACK-PHASE A, RED-PHASE B, BLUE-PHASE C. LIGHTING CABINET IS BUSSED PHASE A, PHASE B & PHASE C FROM LEFT TO RIGHT WHEN FACING FRONT CABINET.
  5. MOUNT OUTLET BOX, GVL, FOR EXTERIOR LIGHTS 8" BELOW WALL UNLESS OTHERWISE NOTED.
  6. THE CIRCUIT INDEX CARD LOCATED ON LCI SHALL BE LABELED PER DETAIL E1.
  7. FIELD TO GROUND ALL STRUCTURAL STEEL, EQUIPMENT FRAMING, AND MISC. STEEL.
- REFERENCE DRAWINGS:  
105-19C-800-CONDUIT & CABLE SCHEDULE  
105-19B-912-BILL OF MATERIAL

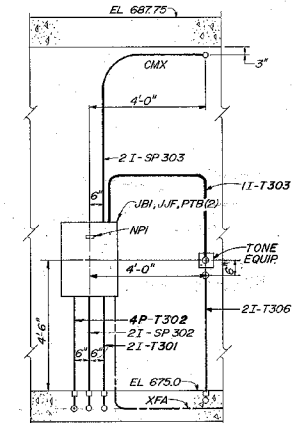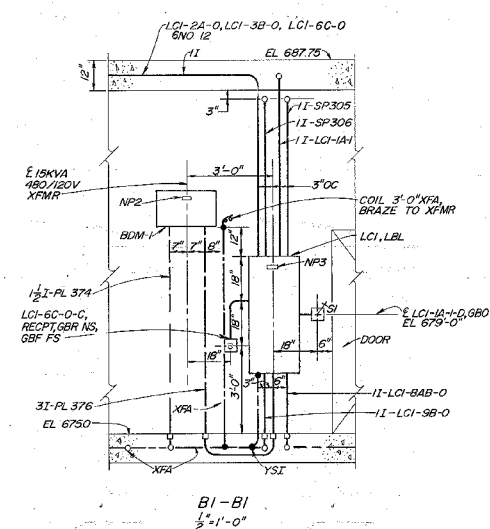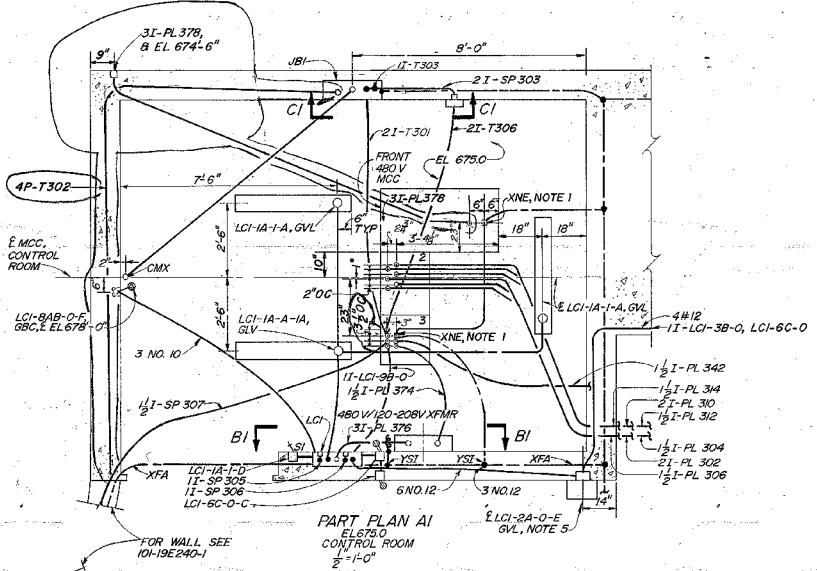

- SYMBOLS:
- EXPOSED CONDUIT TURNING DOWN
  - EMBEDDED CONDUIT TURNING UP
  - 120V AC DUPLEX OUTLET
  - 208V AC SINGLE OUTLET
  - SINGLE POLE SWITCH

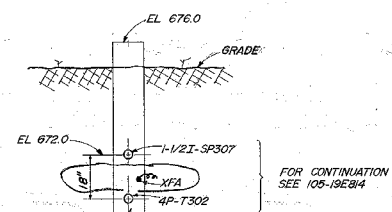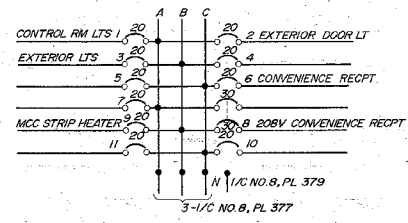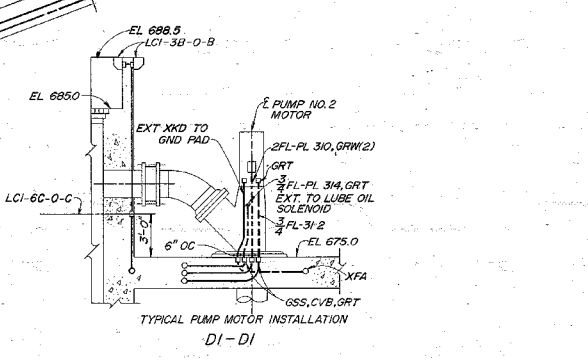

SCALE: 1/4" = 1'-0"  
EXCEPT AS NOTED  
COMPANION DRAWING:  
105-19E812-2

NO.	DATE	BY	CHKD	APP'D	REVISION
1	11-25-77	W.H. Wainwright	J. E. H. H. H.		RELOCATED PL 378, T 302
2	11-25-77	W.H. Wainwright	J. E. H. H. H.		MAJOR REVISION
3	11-25-77	W.H. Wainwright	J. E. H. H. H.		MINOR REVISION

CHATTAHOOGA FLOOD PROTECTION  
PUMPING STATION NO. 3

CONDUIT & GROUNDING & LIGHTING  
GENERAL ARRANGEMENT  
PLAN & DETAILS

SOUTH CHICKAMAUGA CREEK PROJECT  
TENNESSEE VALLEY AUTHORITY  
DIVISION OF ENGINEERING DESIGN

SUBMITTED: W.H. Wainwright  
RECOMMENDED: J. E. H. H. H.  
APPROVED: J. E. H. H. H.

NO. 105-19E812-1  
DATE: 1-25-77  
BY: W.H. Wainwright


INSPECTED AND APPROVED FOR ISSUE

PRINT


SIZE	DATE	BY	CHKD	APP'D
1/4"	1-25-77	W.H. Wainwright	J. E. H. H. H.	



A  
B  
C  
D  
E  
F  
G  
H  
J  
K

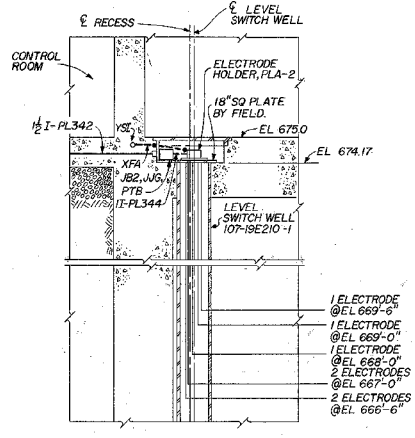

A2-A2  
SH 1, B3  
2 = 1'-0"

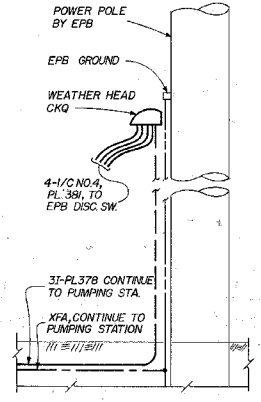

DET B2  
EPB SERVICE  
SH 1, E2  
NTS

- 1 ELECTRODE @ EL. 669'-0"
- 1 ELECTRODE @ EL. 669'-0"
- 1 ELECTRODE @ EL. 669'-0"
- 2 ELECTRODES @ EL. 667'-0"
- 2 ELECTRODES @ EL. 666'-6"

FOR NOTES AND REFERENCES SEE 105-19E812-1.

NAME PLATE INDEX

NP NO.	TYPE	FIRST LINE	SECOND LINE	THIRD LINE
1	A	TELEPHONE TERM CAB		JBI
2	A	480V 120-208V XFMR		
3	A	LCI	3 # 4W, 120-208V	

\*SEE T14 DWG NO GE 30A360

JUNCTION BOX INDEX

NO.	MARK	SIZE (INCHES)			LOCATION	USAGE	NP NO.
		H	W	D			
1	JJF	30	24	8	SECT CI-CI	TELEPHONE TERM CAB.	1
2	JJB	12	6	4	SECT A2-A2	TERMINAL BOX PL 341, PL 343	

LIGHTING FIXTURE SCHEDULE

DESCRIPTION	MARK	FIXTURE TYPES						MARK	LTR	TOTALS
		A	B	C	D	E	F			
WALL LIGHT, 100W, HIGH PRESS. SODIUM, HOLOPHANE, 486-120	LOK1		1						2	
WALL LIGHT, 100W, HIGH PRESS. SODIUM, WITH PHOTO CONTROL, HOLOPHANE, 487-120	LOK2				1				1	
FLORESCENT UNIT 2-40W, SURFACE MOUNTED, DAY BRITE, 48240-4	LHD	1							3	
LAMP, 40W COOL WHITE, RAPID START, GE F40 CW.	LPA-1	2							6	
LAMP, 100W, HIGH PRESS. SODIUM, MDCIL BASE, 120V, GE LU100/BU	LPP-1		1						3	
DUPLEX RECEPTACLE, 2P, 20A, 3W GROUNDING, HUBBELL 5362, FOR 120 V USE.	LRF-1			1					2	
RECEPTACLE, 2P-3W GROUNDING, HUBBELL 9330, FOR 208V USE.	LRB-6					1			1	
COVER PLATE WITH SPRING DOOR COVER, FOR USE WITH LRB-6, CAST ALUMINUM, CROUSE-HINDS DS-10306.	LRB-9						1		1	
TUMBLER SWITCH, 1P, 20A, 277V, HUBBELL 1221.	LSE				1				1	
SWITCH PLATE, HINGED COVER CAST ALUMINUM, HUBBELL 7420.	LVD						1		1	
RECEPTACLE COVER, CAST ALUMINUM, SPRING DOORS WITH GASKET FOR USE WITH LRB-7 HUBBELL 5206.	LVO							1	2	

SCALE: 1/4" = 1'-0"  
EXCEPT AS NOTED  
COMPANION DRAWING:  
105-19E812-1

1		6/29/77		REVISION		DATE		BY		APP	
MINOR REVISION.											
DESIGN	DRWN	CHKD	APP	ENGR							
J.R.T. KING	J.A. WINTER	J.L. KING		R.W. STEWART							
CHATTANOOGA FLOOD PROTECTION											
PUMPING STATION NO. 3											
CONDUIT & GROUNDING & LIGHTING											
GENERAL ARRANGEMENT											
PLAN & DETAILS											
SOUTH CHICKAMAUGA CREEK PROJECT											
TENNESSEE VALLEY AUTHORITY											
DIVISION OF ENGINEERING DESIGN											
SUBMITTED		RECOMMENDED		APPROVED							
W.H. DANWOOD		George D. Williams		John C. Williams							
KNOXVILLE		1-25-77		81 E		105-19E812-2		R1			

INSPECTED AND APPROVED FOR ISSUE

PRINT

SIZE

SCALE


DATE

BY


APP






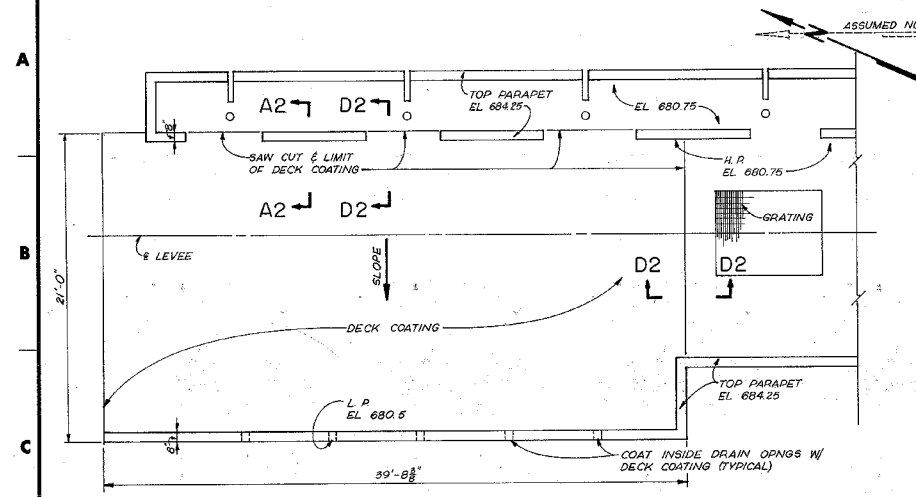


PART PLAN - EL 684.25  
PUMPING STATION NO. 1

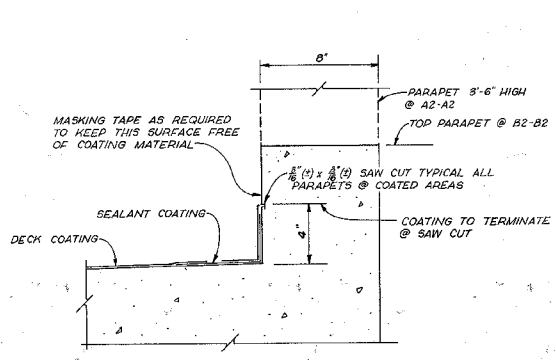


SECTION A2-A2 & B2-B2  
3'-1'-0"

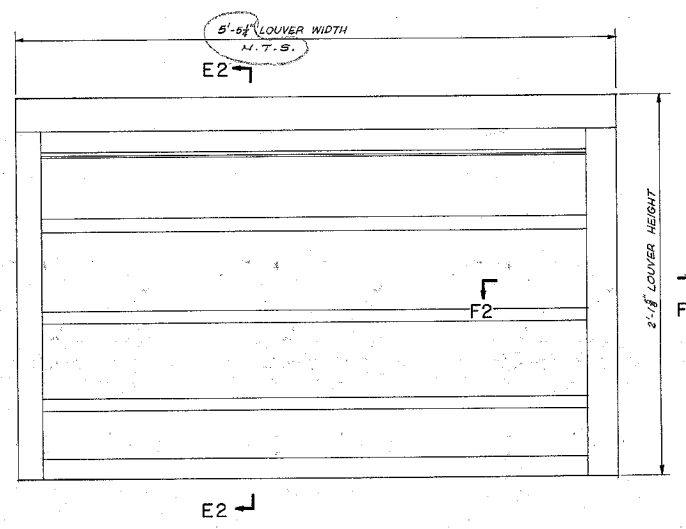


ELEVATION LOUVER - TYPE A

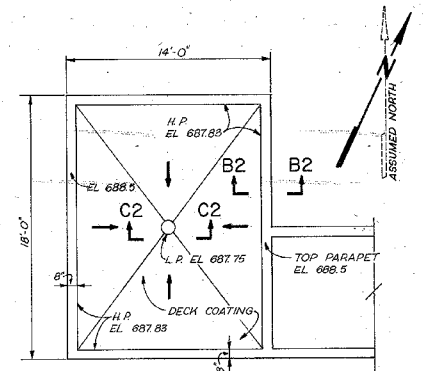


PART PLAN - EL 688.5  
PUMPING STATION NO. 2

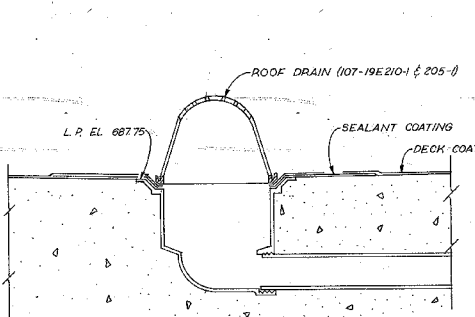


SECTION C2-C2  
3'-1'-0"

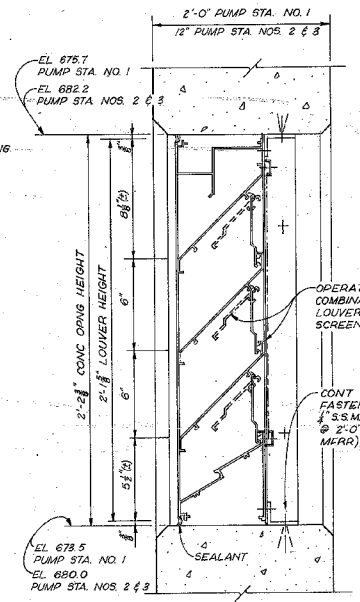


SECTION E2-E2

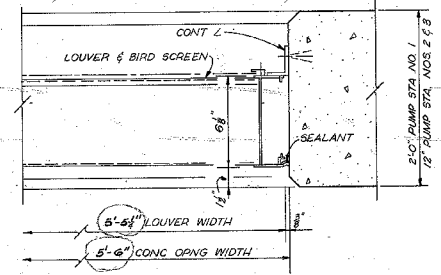

SECTION F2-F2

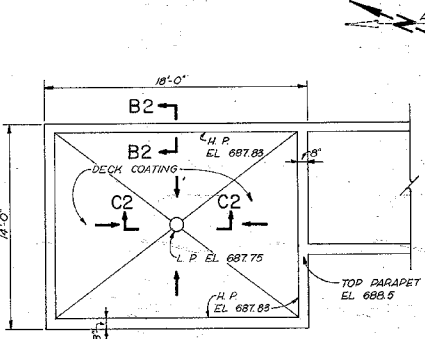

PART PLAN - EL 688.5  
PUMPING STATION NO. 3

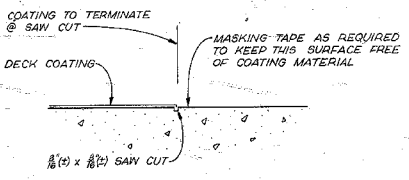

SECTION D2-D2  
3'-1'-0"

LOUVER SCHEDULE			
QUANTITY	TYPE	LOCATION	DRAWING REFERENCE NO.
1	A	PUMPING STATION NO. 1	101-19E225-2
1	A	PUMPING STATION NO. 2	101-19E235-2
1	A	PUMPING STATION NO. 3	101-19E240-3
3 TOTAL REQUIRED			

LOUVER DETAILS  
3'-1'-0"



CONTROL ROOM ROOF PLANS

SCALE: 1/4" = 1'-0"  
EXCEPT AS NOTED

INSPECTED AND APPROVED FOR ISSUE  
*[Signature]*

DATE	BY	REVISION
3-22-77	81 A	106-19E200-2

CHATTANOOGA FLOOD PROTECTION PUMPING STATION NOS. 1, 2 & 3	
ARCHITECTURAL ROOF PLANS & DETAILS LOUVER DETAILS	
SOUTH CHICKAMAUGA CREEK PROJECT TENNESSEE VALLEY AUTHORITY DIVISION OF ENGINEERING DESIGN	
SUBMITTED	APPROVED
<i>[Signature]</i>	<i>[Signature]</i>
KNOXVILLE 3-22-77 81 A 106-19E200-2	

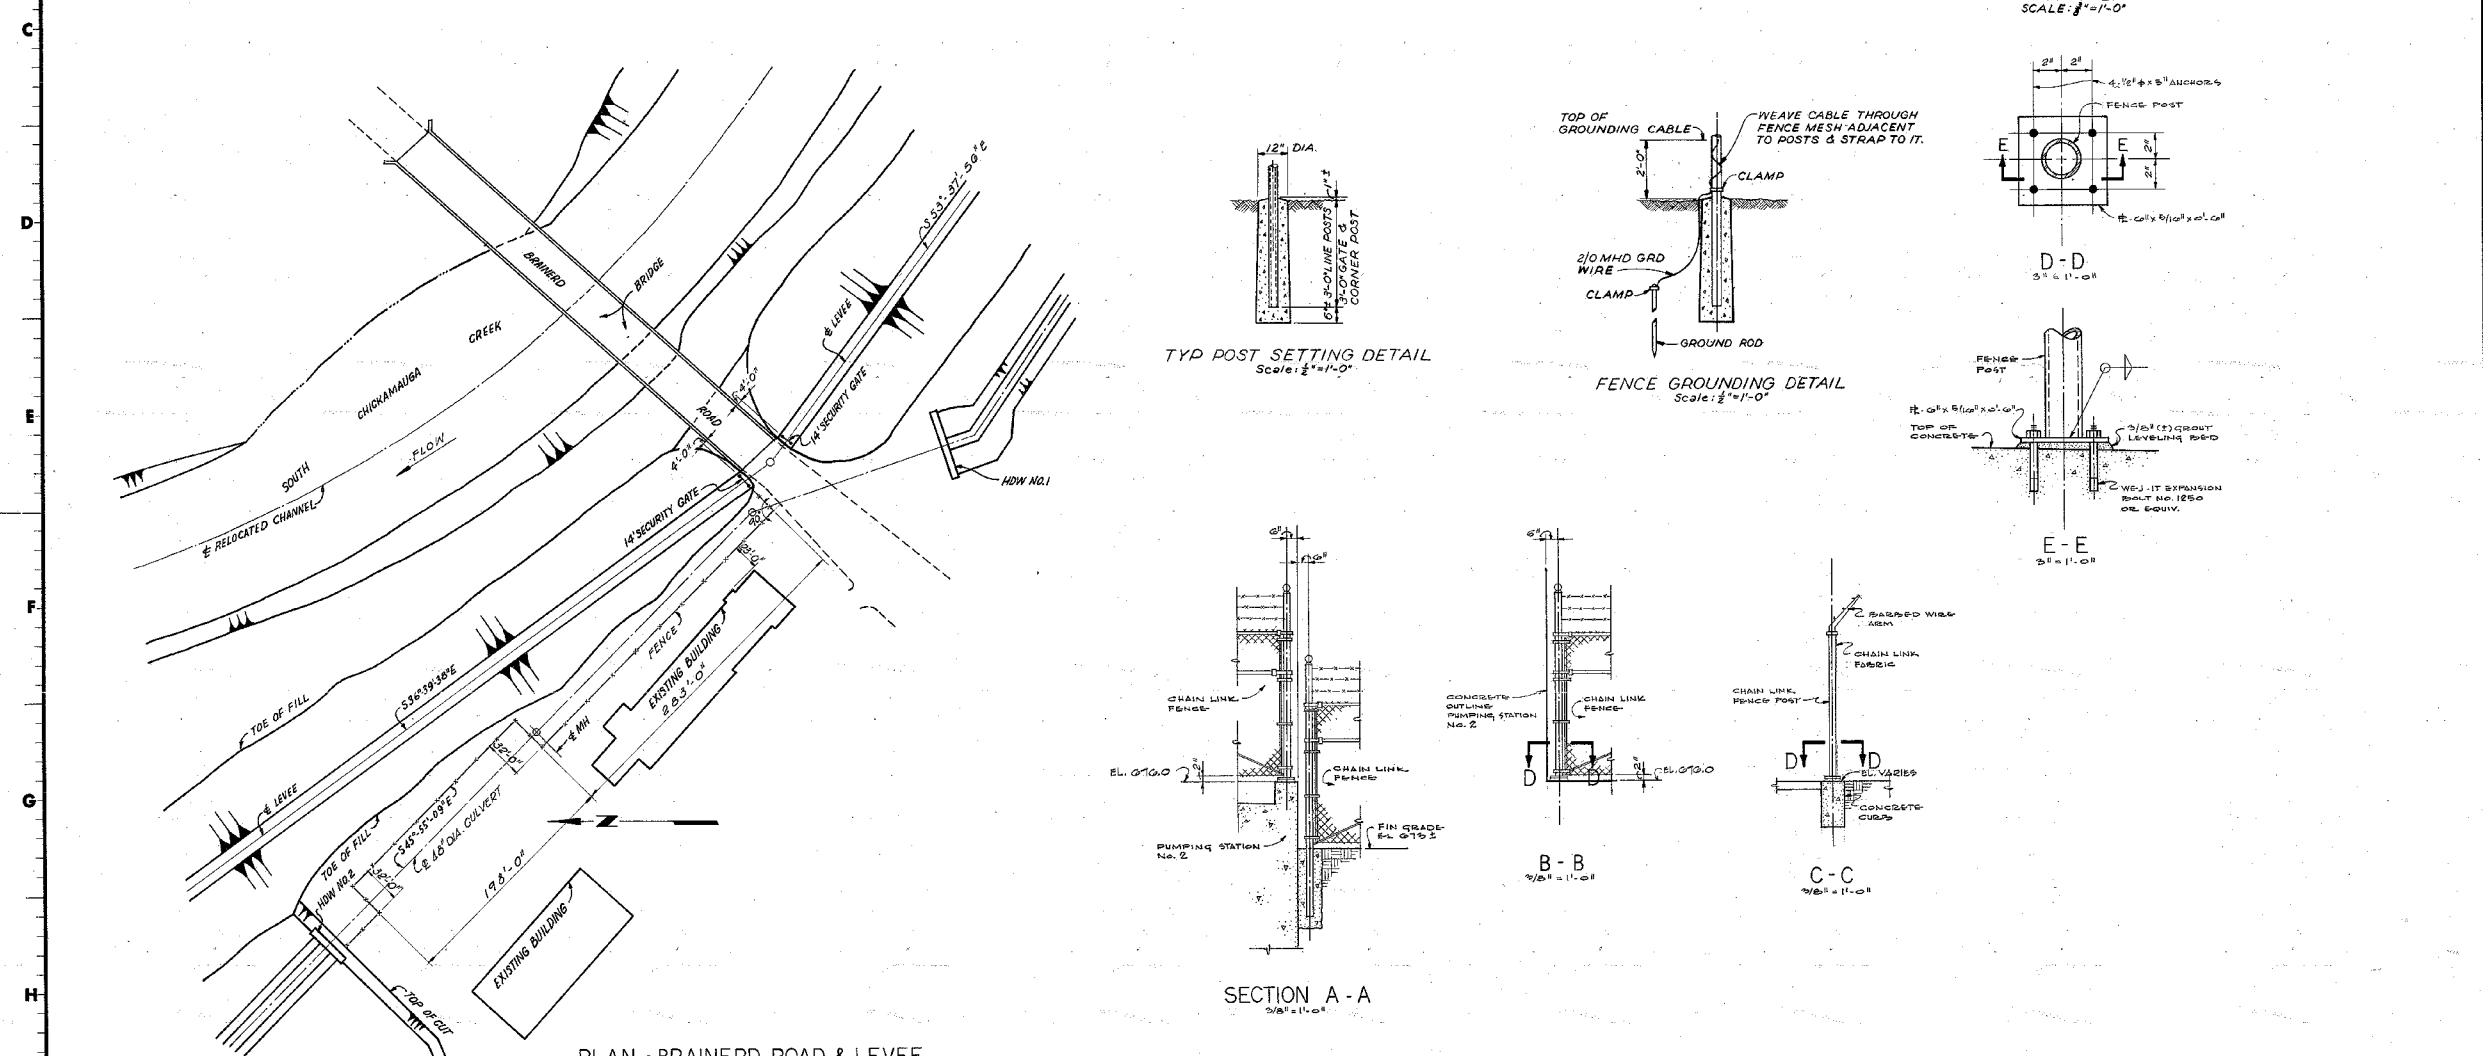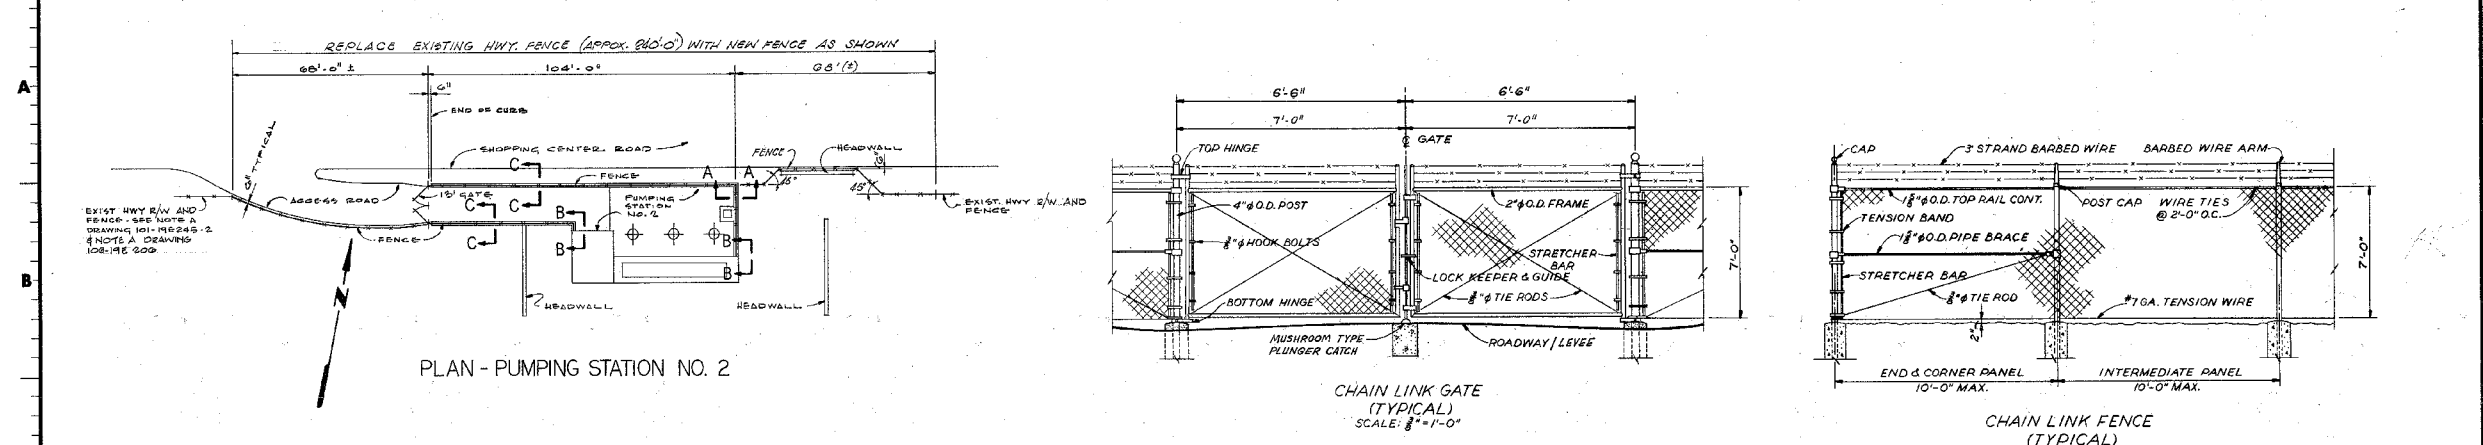

REV NO.	CON NO.	DATE	DESCRIPTION	DESIGNED BY	CHECKED BY	INSP. BY	APPROVED BY	DATE
SCALE 1" = 20'-0" EXCEPT AS NOTED CHATTANOOGA FLOOD PROTECTION CHAIN LINK FENCE ARCHITECTURAL PLANS & DETAILS SOUTH CHICKAMAUGA CREEK PROJECT TENNESSEE VALLEY AUTHORITY DIVISION OF ENGINEERING DESIGN SUBMITTED BY: <i>[Signature]</i> RECOMMENDED BY: <i>[Signature]</i> APPROVED BY: <i>[Signature]</i> KNOXVILLE 6-9-78 81A 106-19E205 R0 REPRODUCED DRAWING AS CONSTRUCTED								


COMPANION DRAWING:  
106-19E206

INSPECTED AND APPROVED FOR ISSUE  
*[Signature]*

PRINT	H	2	2
SZ	F	3	3

REPRODUCED DRAWING AS CONSTRUCTED



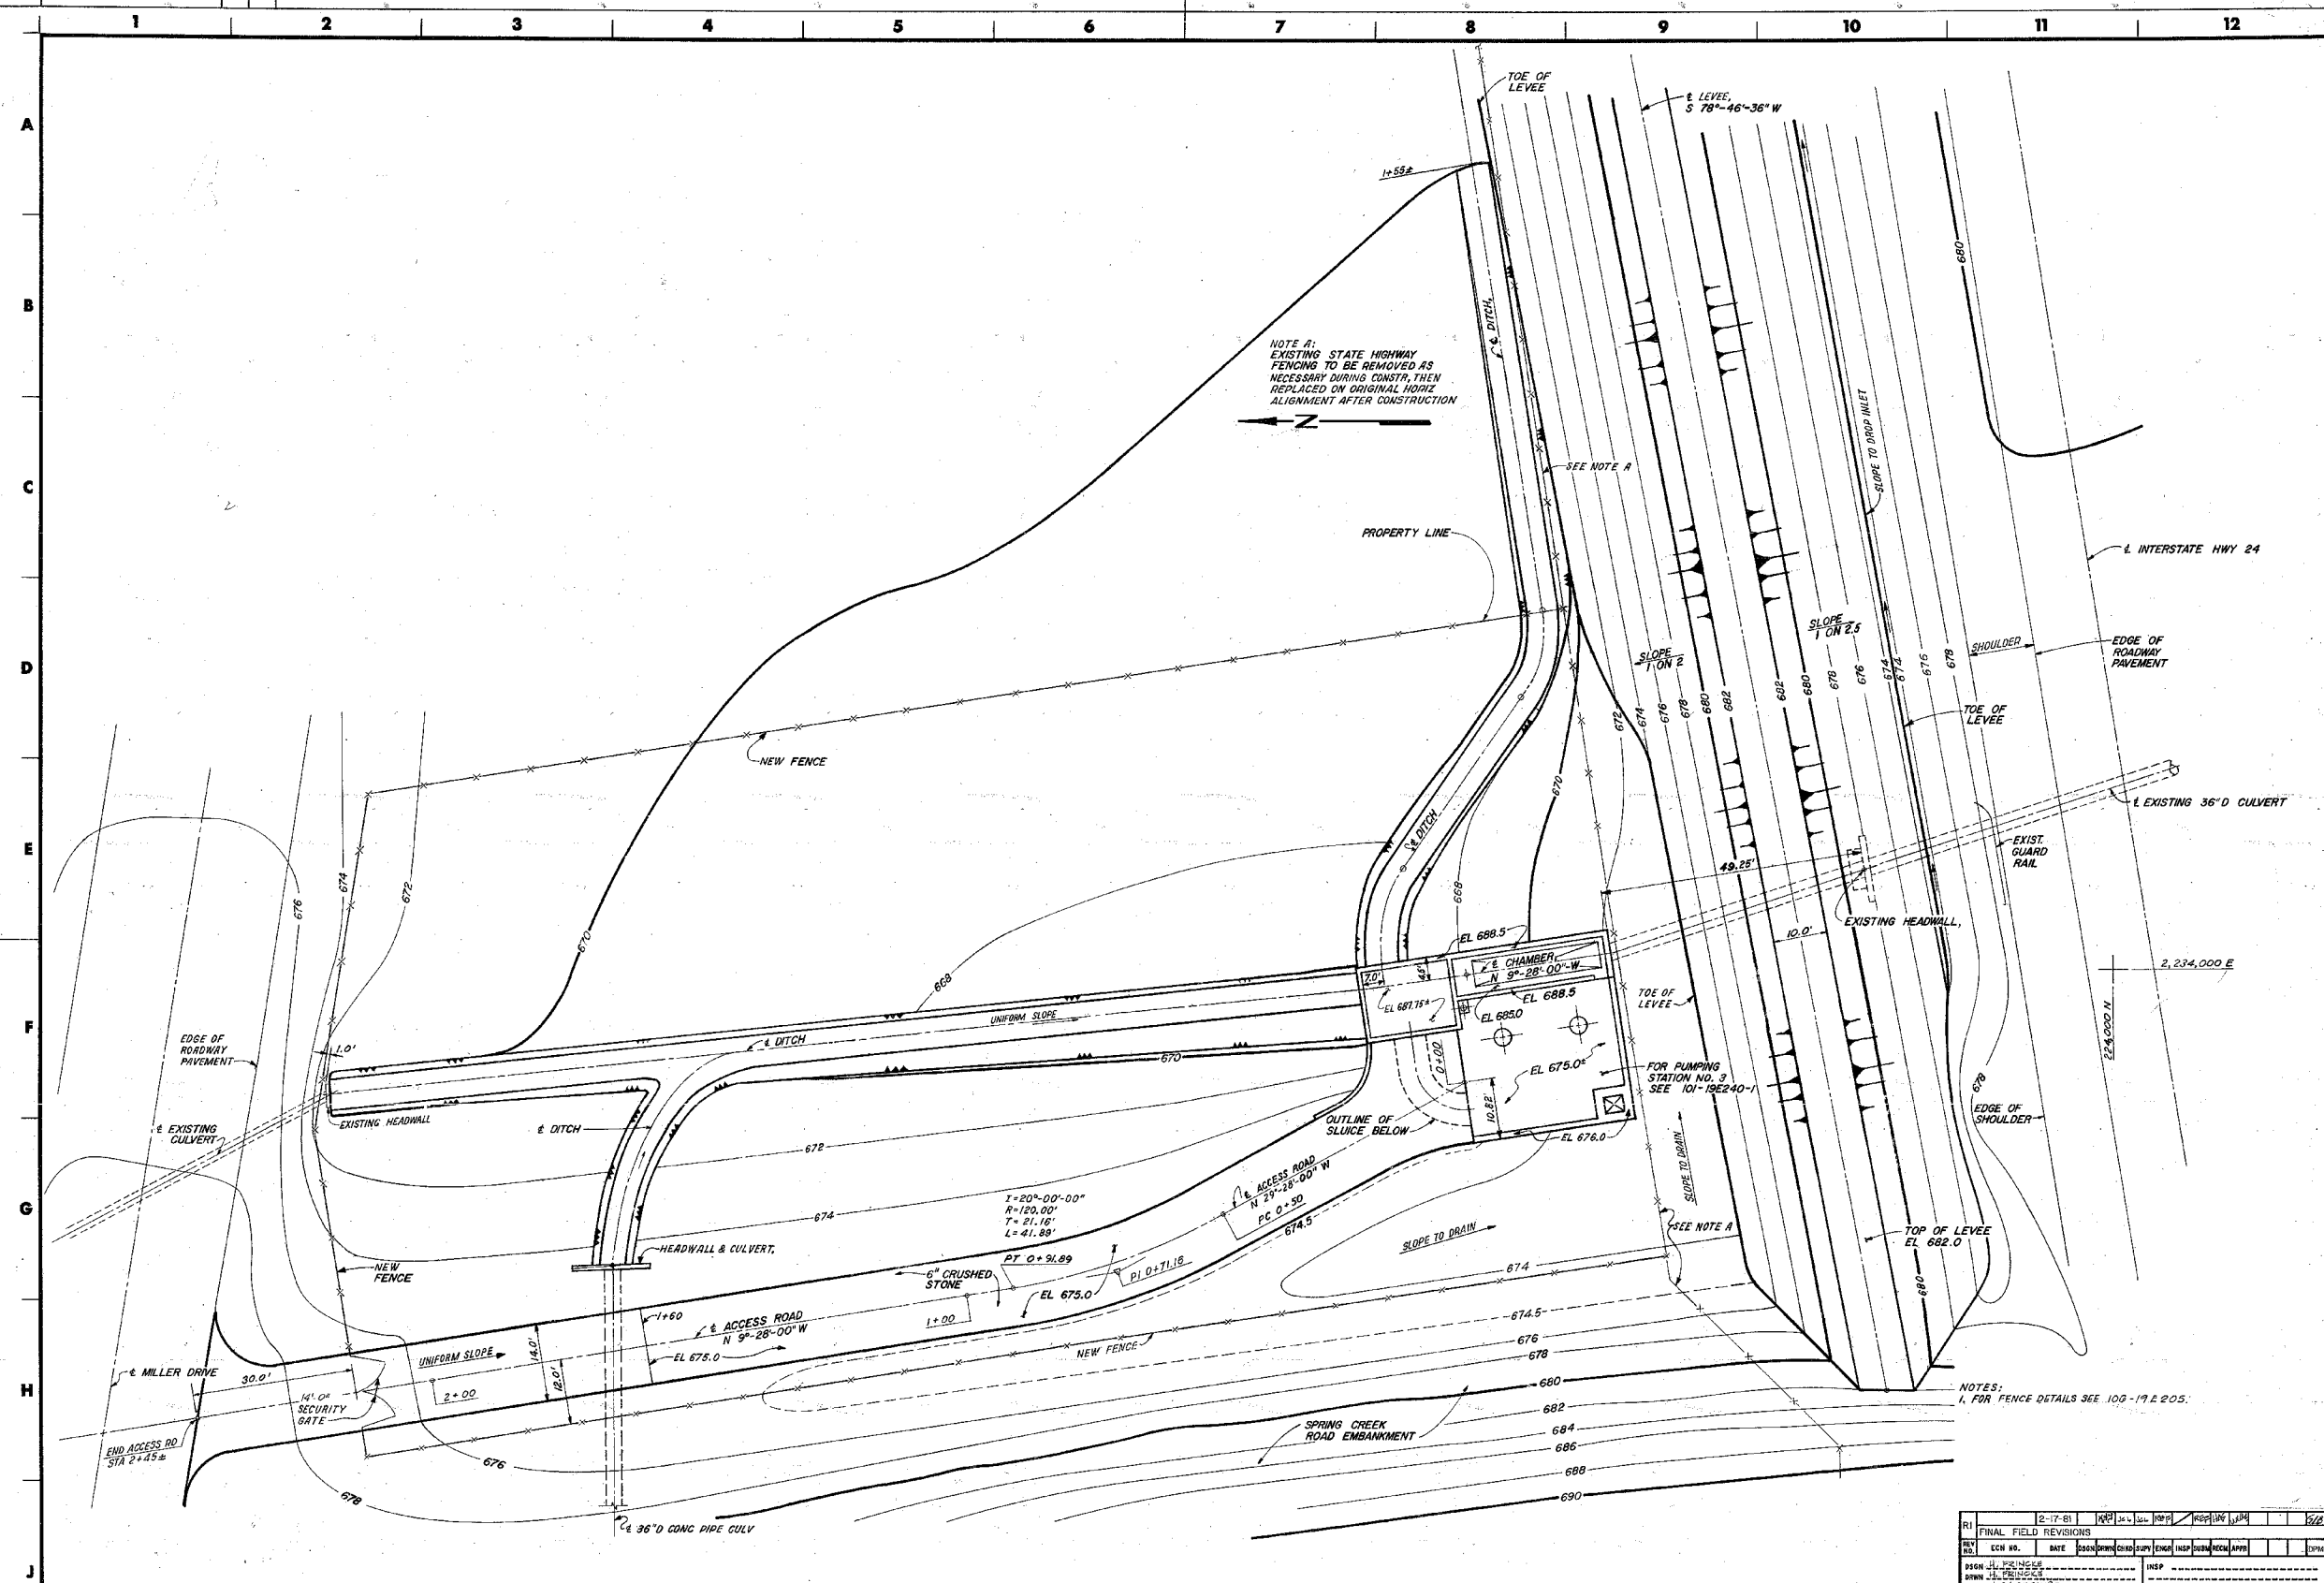

PLAN

NOTES:  
1. FOR FENCE DETAILS SEE 100-19E205.

RI	2-17-81	REVISED	DATE	BY	CHKD	APPD	DATE	BY	CHKD	APPD	DATE
NO.	1										
DESIGN	J. H. HARRIS			INSPECTION	J. H. HARRIS			DATE	10-17-81		
CHKD	J. H. HARRIS			ARCHITECT	J. H. HARRIS			DATE	10-17-81		
SUPV	J. H. HARRIS			DATE	10-17-81						

CHATTAHOOGA FLOOD PROTECTION  
CHAIN LINK FENCE

ARCHITECTURAL  
PLAN-PUMPING STATION NO. 3

SOUTH CHICKAMAUGA CREEK PROJECT  
TENNESSEE VALLEY AUTHORITY  
DIVISION OF ENGINEERING DESIGN

SUBMITTED: J. H. HARRIS  
RECOMMENDED: J. H. HARRIS  
APPROVED: J. H. HARRIS


KNOXVILLE 5-9-78 81 A 106-19E206 RI

SCALE 1"=10' EXCEPT AS NOTED  
COMPANION DRAWING:  
100-19E205


INSPECTED AND APPROVED FOR ISSUE

RECORDED DRAWING AS CONSTRUCTED  
JAN 27, 1981

PRINT IN 1 2 3 4 5 6 7 8 9 10 11 12  
SIZE F 3 3 3 3 3 3 3 3 3 3 3 3  
PRINTS MADE 3 3 3 3 3 3 3 3 3 3 3 3

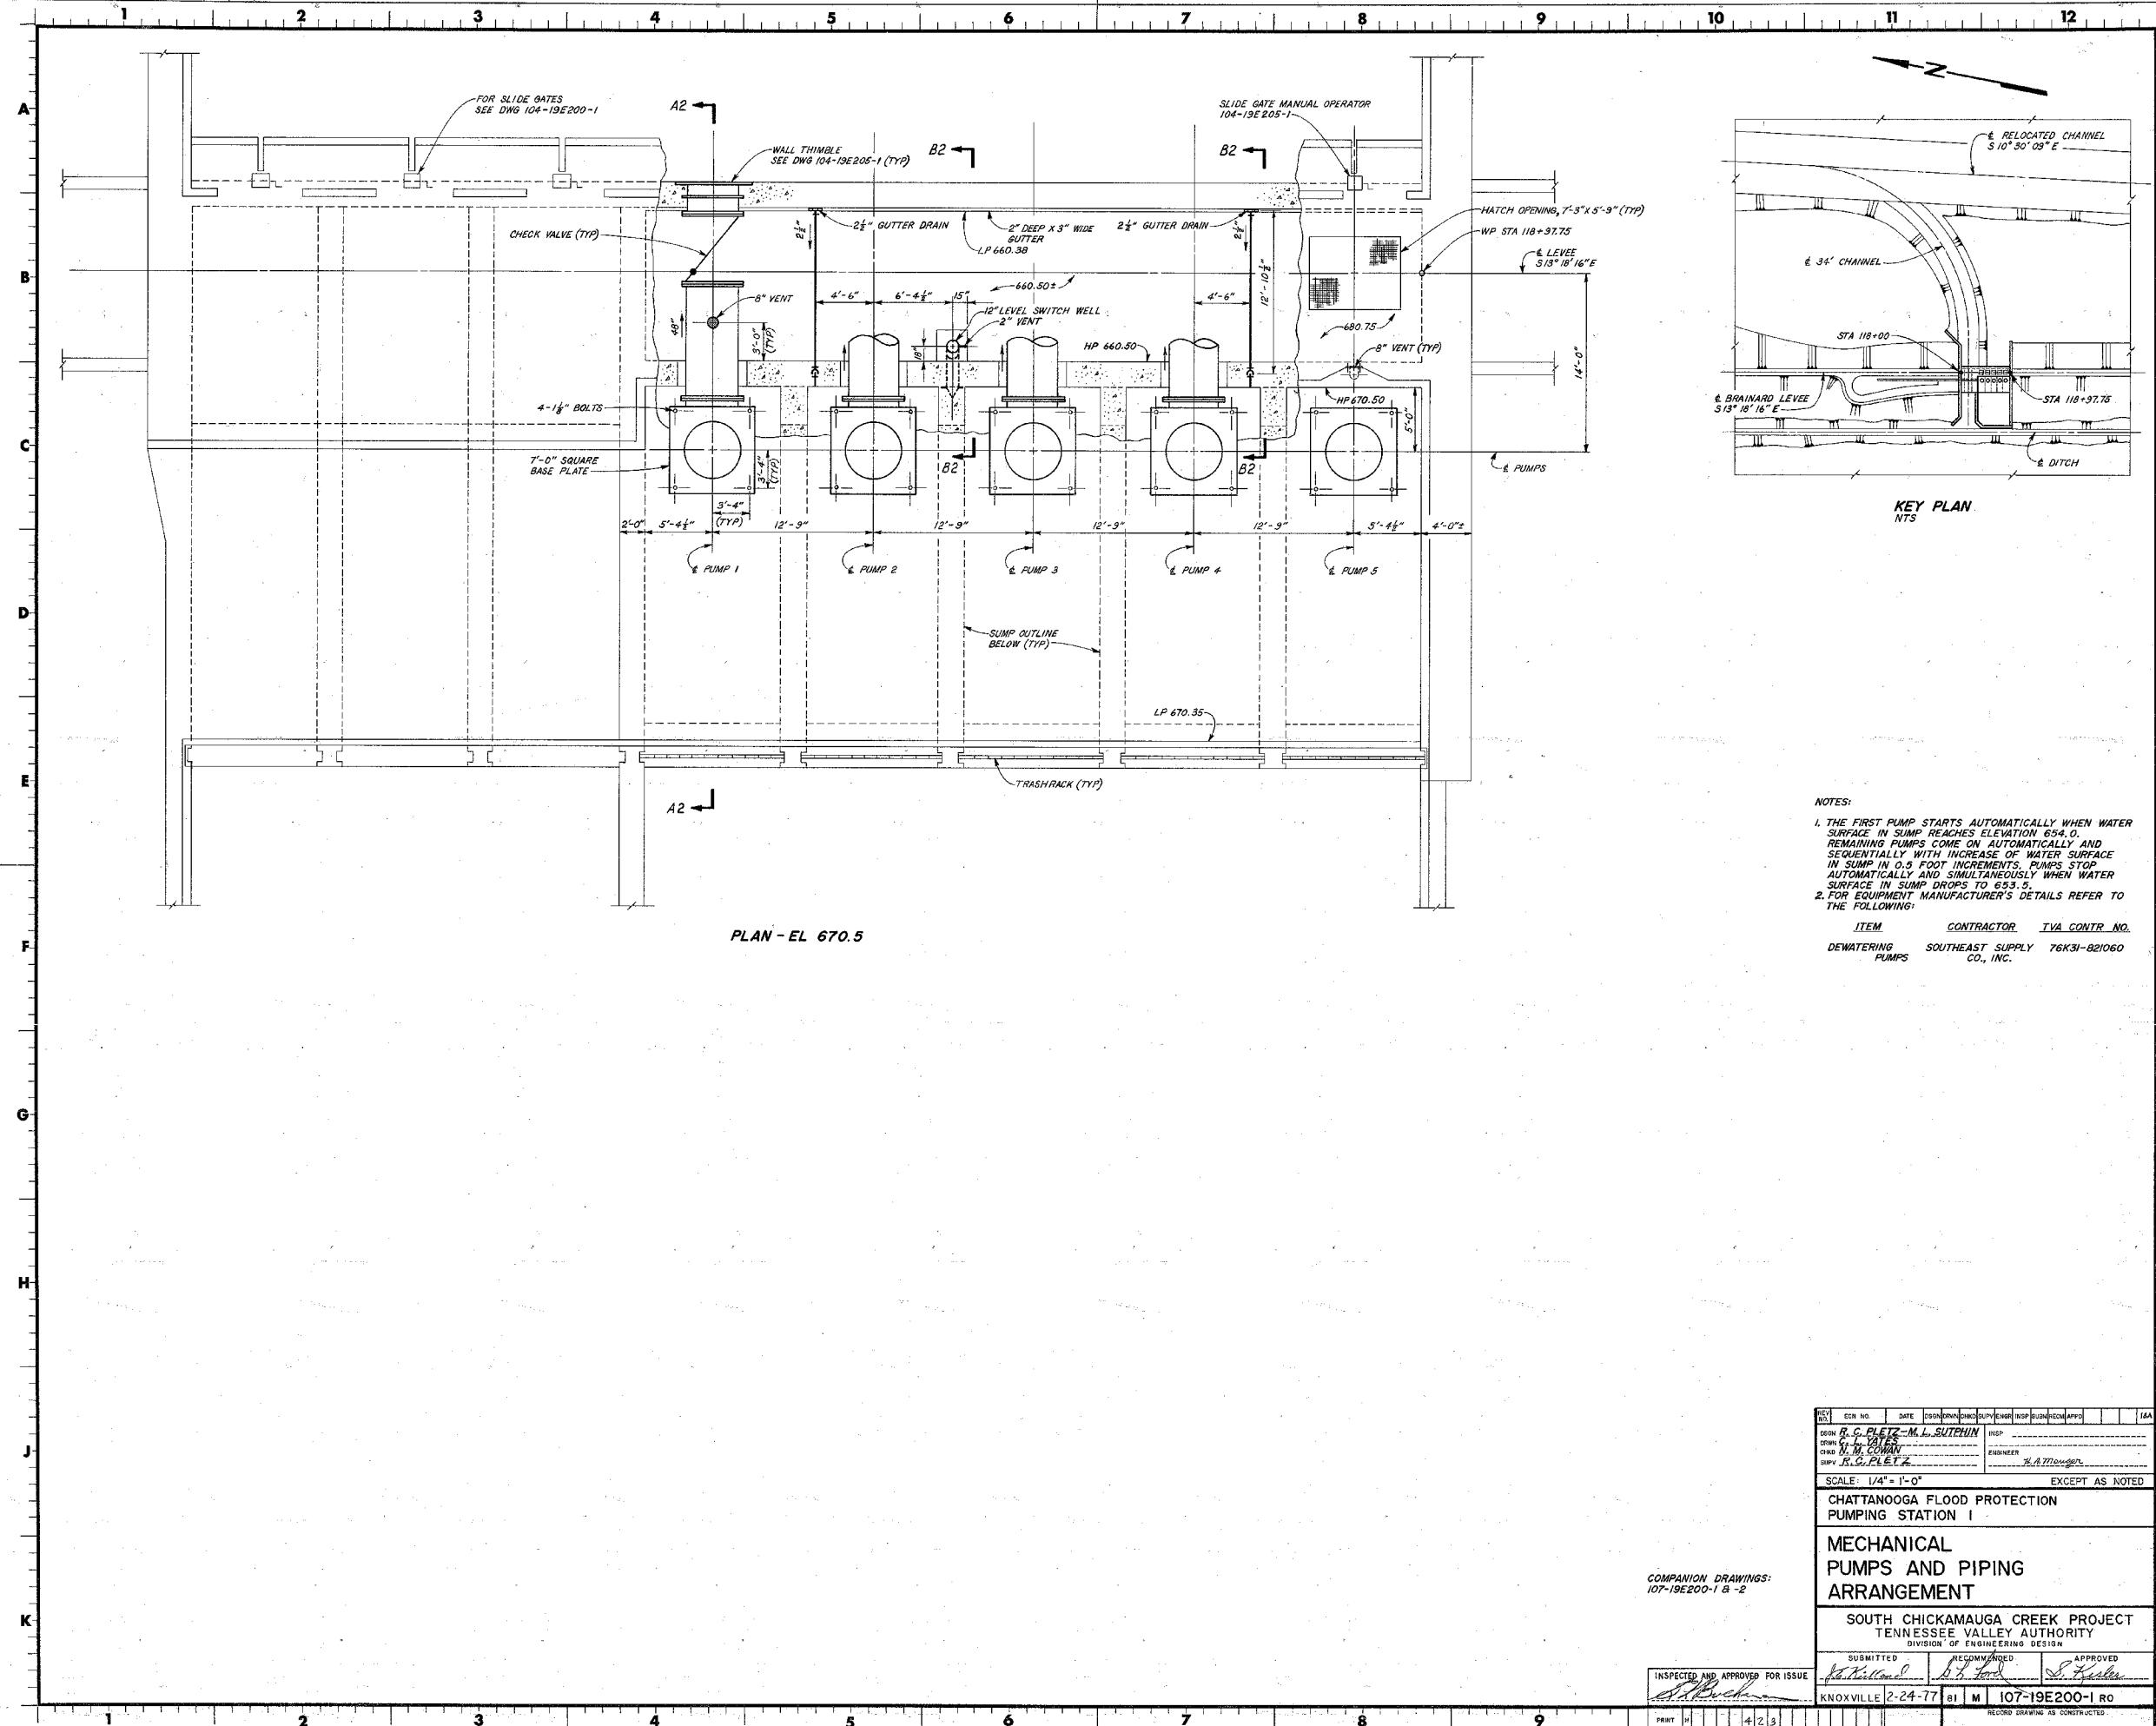

PLAN - EL 670.5

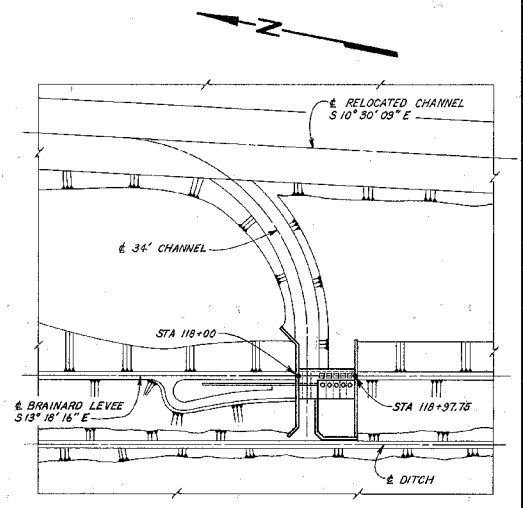

KEY PLAN  
NTS

NOTES:  
 1. THE FIRST PUMP STARTS AUTOMATICALLY WHEN WATER SURFACE IN SUMP REACHES ELEVATION 654.0. REMAINING PUMPS COME ON AUTOMATICALLY AND SEQUENTIALLY WITH INCREASE OF WATER SURFACE IN SUMP IN 0.5 FOOT INCREMENTS. PUMPS STOP AUTOMATICALLY AND SIMULTANEOUSLY WHEN WATER SURFACE IN SUMP DROPS TO 653.5.  
 2. FOR EQUIPMENT MANUFACTURER'S DETAILS REFER TO THE FOLLOWING:

ITEM	CONTRACTOR	I.V.A. CONTR. NO.
DEWATERING PUMPS	SOUTHEAST SUPPLY CO., INC.	76K31-821060


COMPANION DRAWINGS:  
107-19E200-1 B -2

INSPECTED AND APPROVED FOR ISSUE  
*[Signature]*

DESIGNER <b>R. C. PLETZ - M. L. SUTPHIN</b>	DATE	SCALE: 1/4" = 1'-0"	EXCEPT AS NOTED
CHECKED BY <b>R. C. PLETZ</b>	DATE	CHATTANOOGA FLOOD PROTECTION PUMPING STATION I	
MECHANICAL PUMPS AND PIPING ARRANGEMENT			
SOUTH CHICKAMAUGA CREEK PROJECT TENNESSEE VALLEY AUTHORITY DIVISION OF ENGINEERING DESIGN			
SUBMITTED <i>[Signature]</i>	RECOMMENDED <i>[Signature]</i>	APPROVED <i>[Signature]</i>	
KNOXVILLE 2-24-77		M 107-19E200-1 RO	

PRINT	SIZE	NO. OF COPIES	DATE
		423	

*[Handwritten signature]*  
M.F.  
E2

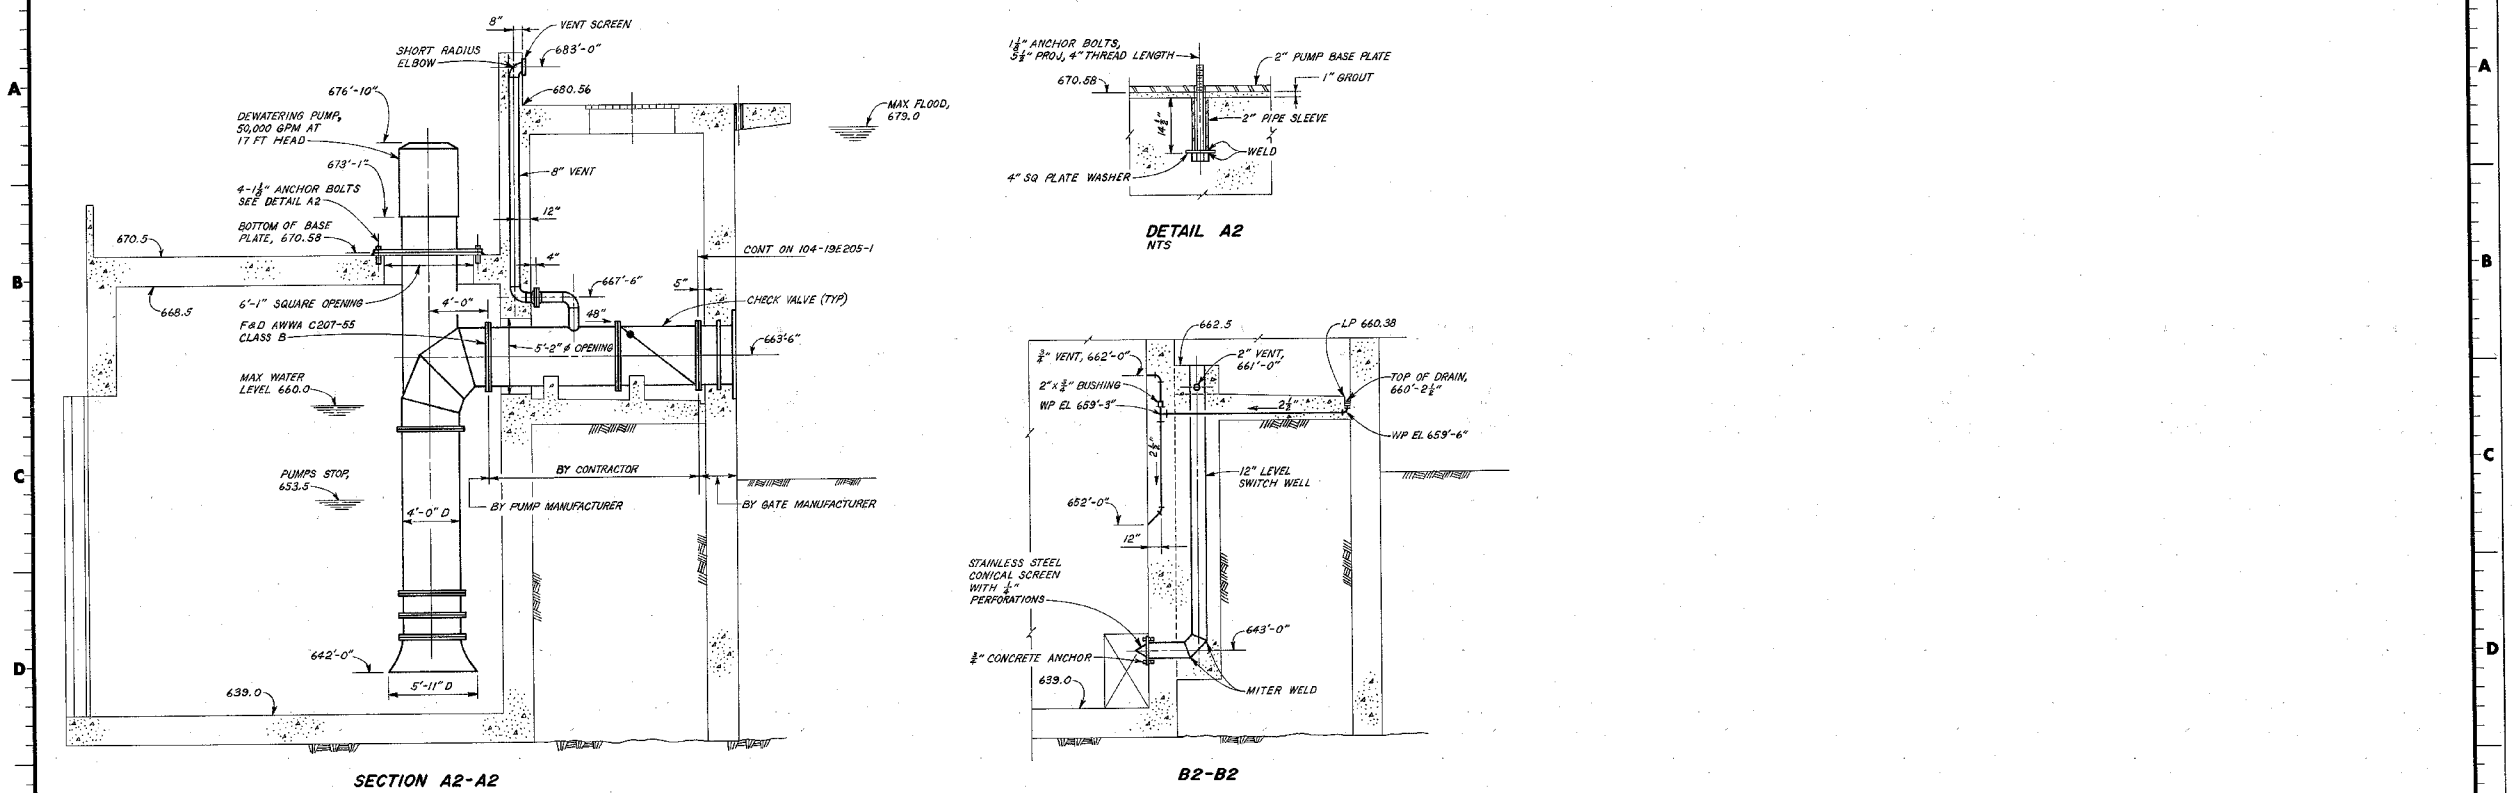

SECTION A2-A2

DETAIL A2  
NTS

B2-B2








MFR  
R0

NO.	REV. NO.	DATE	BY	CHKD.	APP'D.	DATE	SCALE	EXCEPT AS NOTED
							1/4" = 1'-0"	
CHATTANOOGA FLOOD PROTECTION PUMPING STATION I MECHANICAL PUMPS AND PIPING ARRANGEMENT SOUTH CHICKAMAUGA CREEK PROJECT TENNESSEE VALLEY AUTHORITY DIVISION OF ENGINEERING DESIGN								
SUBMITTED			RECOMMENDED			APPROVED		
<i>[Signature]</i>			<i>[Signature]</i>			<i>[Signature]</i>		
KNOXVILLE 2-24-77 81 M 107-19E200-2 R0 RECORD DRAWING AS CONSTRUCTED								

INSPECTED AND APPROVED FOR ISSUE  
*[Signature]*

PAGE	NO.	OF	TOTAL
4	2	3	

TECHNICAL SUPPLY CENTER  
KNOXVILLE

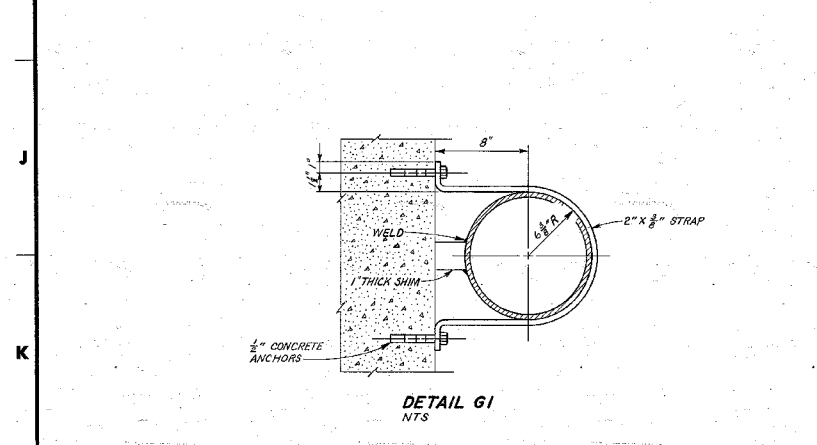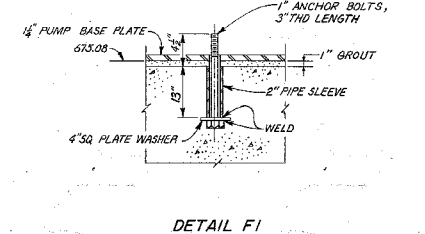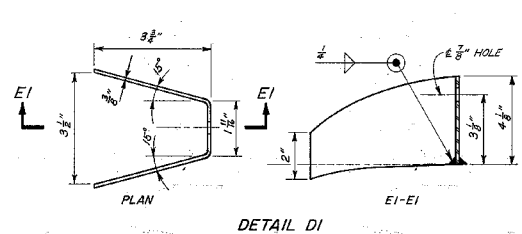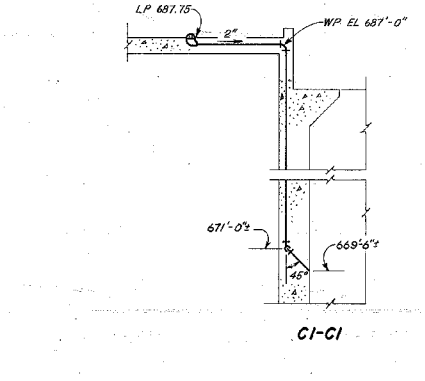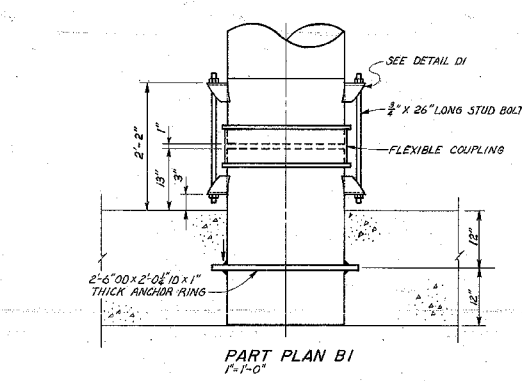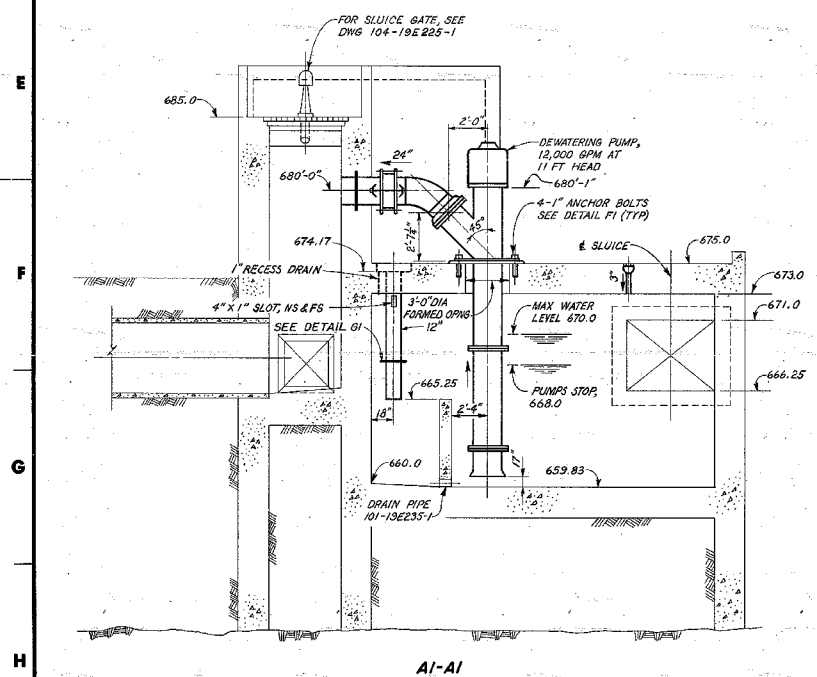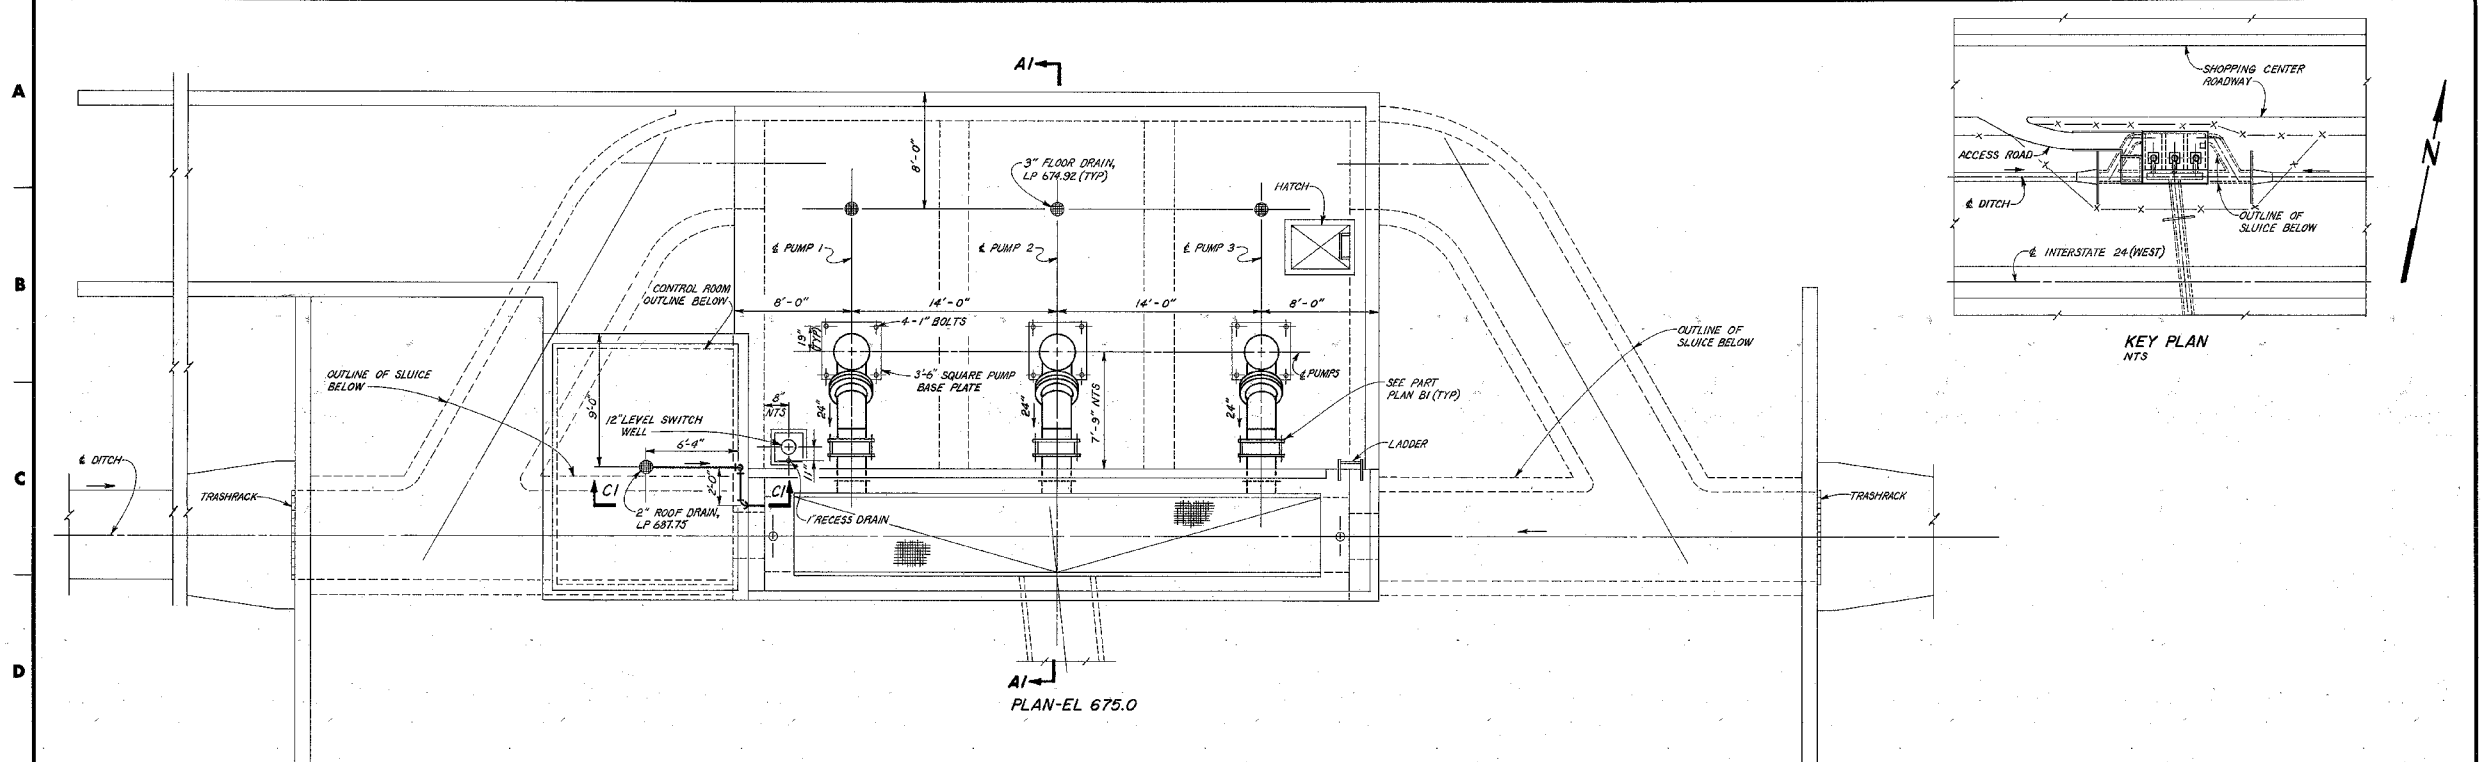


NOTES:  
1. THE FIRST PUMP STARTS AUTOMATICALLY WHEN WATER SURFACE IN SUMP REACHES ELEVATION 668.0. REMAINING PUMPS COME ON AUTOMATICALLY AND SEQUENTIALLY WITH INCREASE OF WATER SURFACE IN SUMP IN 0.5 FOOT INCREMENTS. PUMPS STOP AUTOMATICALLY AND SIMULTANEOUSLY WHEN WATER SURFACE IN SUMP DROPS TO ELEVATION 666.0.  
2. FOR DETAILS OF PUMPS REFER TO SOUTHEAST SUPPLY CO., INC., FILE, TVA CONTRACT 76K31-821060.

SCALE 1/4" = 1'-0"  
EXCEPT AS NOTED


REV	NO.	DATE	BY	CHKD	APP'D	REASON
1	1	2-24-77	B. C. PLETZ	M. J. SUTPHIN		
CHATTANOOGA FLOOD PROTECTION PUMPING STATION 2 MECHANICAL PUMPS AND PIPING ARRANGEMENT SOUTH CHICKAMAUGA CREEK PROJECT TENNESSEE VALLEY AUTHORITY DIVISION OF ENGINEERING DESIGN						
SUBMITTED			RECOMMENDED		APPROVED	
[Signature]			[Signature]		[Signature]	
KNOXVILLE 2-24-77			BI M		I07-19E205-1 R0	

INSPECTED AND APPROVED FOR ISSUE	[Signature]
DATE	4-23
SIZE	11
BY	ON PROJ
PRINTS	RECD-1-2


A  
B  
C  
D  
E  
F  
G  
H  
J  
K

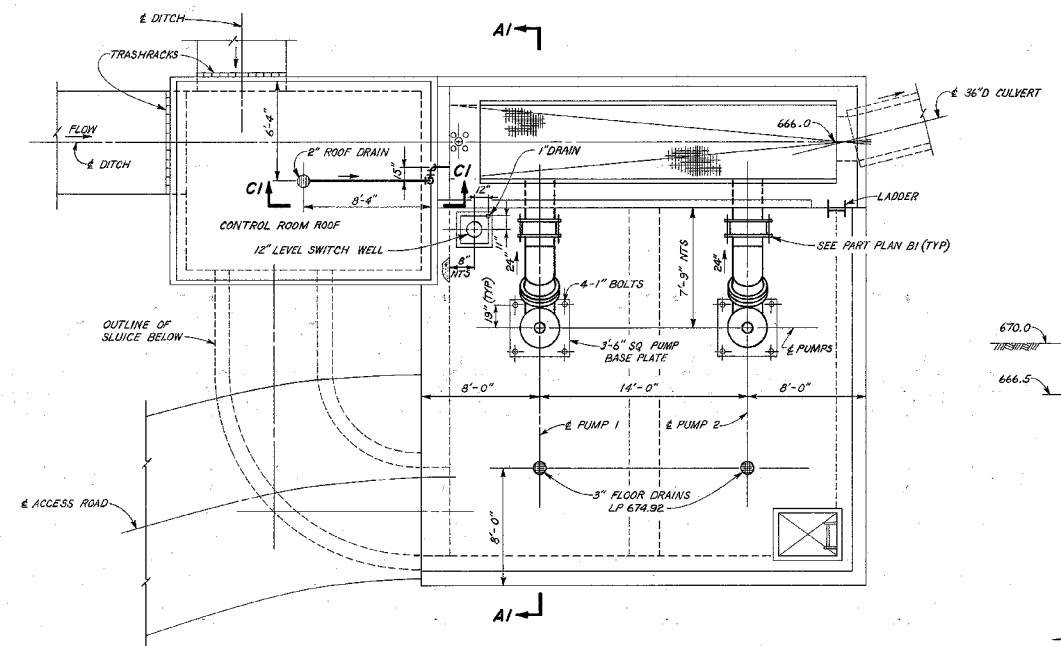


PLAN EL 675.0

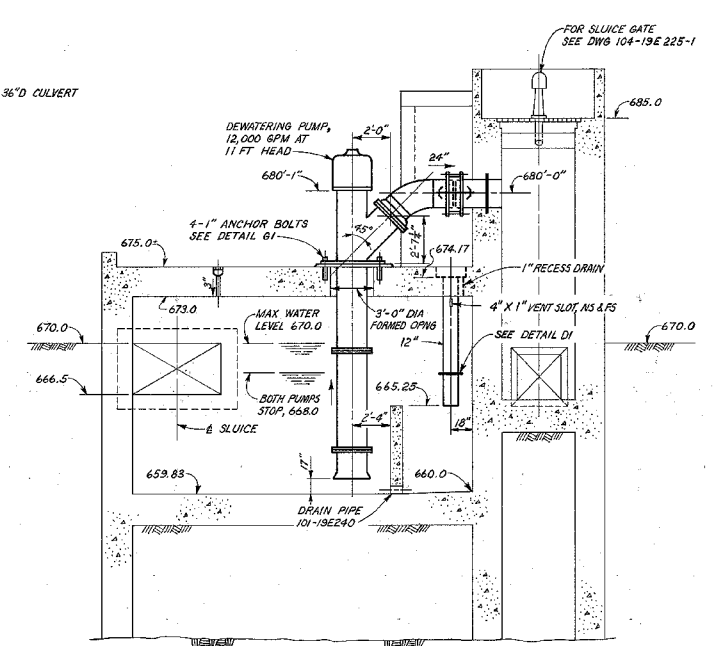


AI-AI

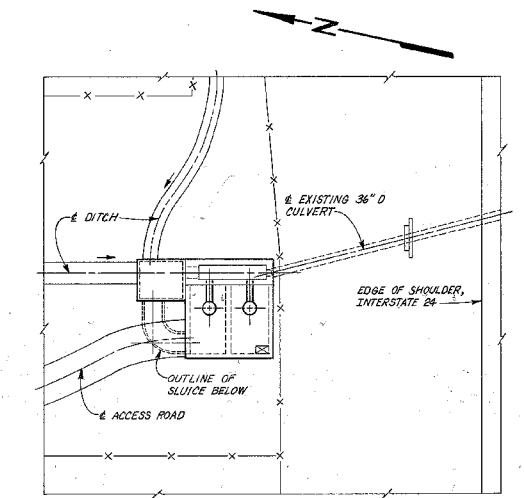


KEY PLAN  
NTS

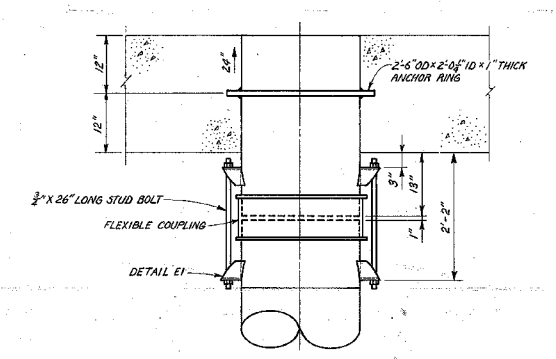


PART PLAN B1  
1'-1'-0"

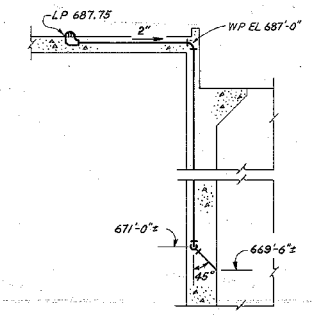


CI-CI

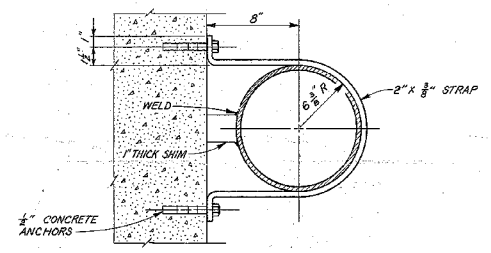

DETAIL D1  
NTS

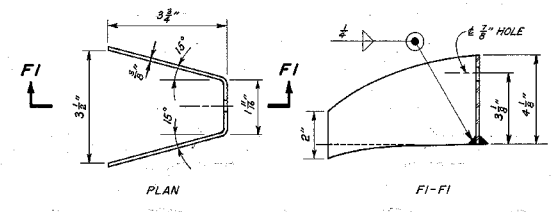

DETAIL E1  
NTS

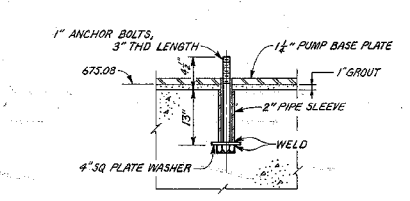

DETAIL G1  
NTS

- NOTES
1. THE FIRST PUMP STARTS AUTOMATICALLY WHEN WATER SURFACE IN SUMP REACHES ELEVATION 669.0. THE SECOND PUMP STARTS AUTOMATICALLY WHEN WATER SURFACE IN SUMP REACHES ELEVATION 669.5. PUMPS SHUTOFF AUTOMATICALLY AND SIMULTANEOUSLY WHEN WATER SURFACE IN SUMP RECEDES TO ELEVATION 668.0.
  2. FOR DETAILS OF PUMPS REFER TO SOUTHEAST SUPPLY CO., INC. FILE, TVA CONTRACT 76K31-821060.

MF  
RD

SCALE 1/4"=1'-0"  
EXCEPT AS NOTED

REV	NO.	DATE	BY	CHKD	APPD	REASON
001	1	2-24-77	J. C. PLETZ	M. L. SUTPHIN		
002	2		J. C. PLETZ			
003	3		J. C. PLETZ			
004	4		J. C. PLETZ			

CHATTANOOGA FLOOD PROTECTION PUMPING STATION 3	
MECHANICAL PUMPS AND PIPING ARRANGEMENT	
SOUTH CHICKAMAUGA CREEK PROJECT TENNESSEE VALLEY AUTHORITY DIVISION OF ENGINEERING DESIGN	
SUBMITTED	RECOMMENDED
APPROVED	APPROVED
KNOXVILLE 2-24-77 BI M 107-19E210-1 RO	
RECORD DRAWING AS CONSTRUCTED	


INSPECTED AND APPROVED FOR ISSUE

PRINT	4	2	3
SIZE			


RECORD DRAWING AS CONSTRUCTED





LEGEND	
MATERIAL	SYM.
EXISTING TREES	
PROPOSED TREES	
PROPOSED SHRUBS	

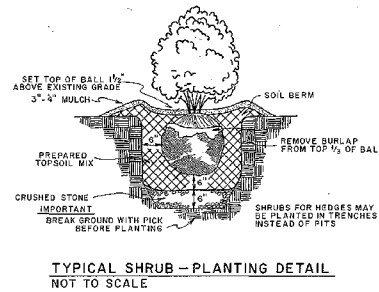


TYPICAL SHRUB-PLANTING DETAIL  
NOT TO SCALE

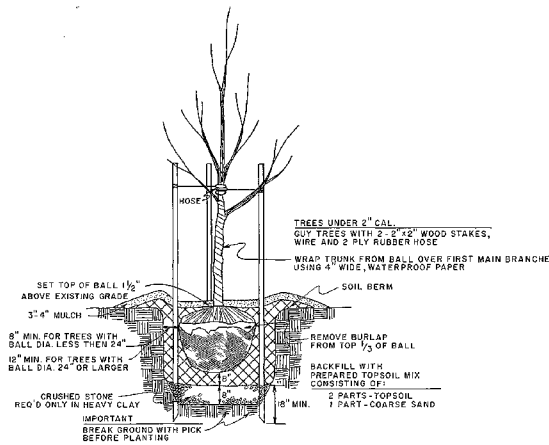

TYPICAL TREE-PLANTING DETAIL  
NOT TO SCALE

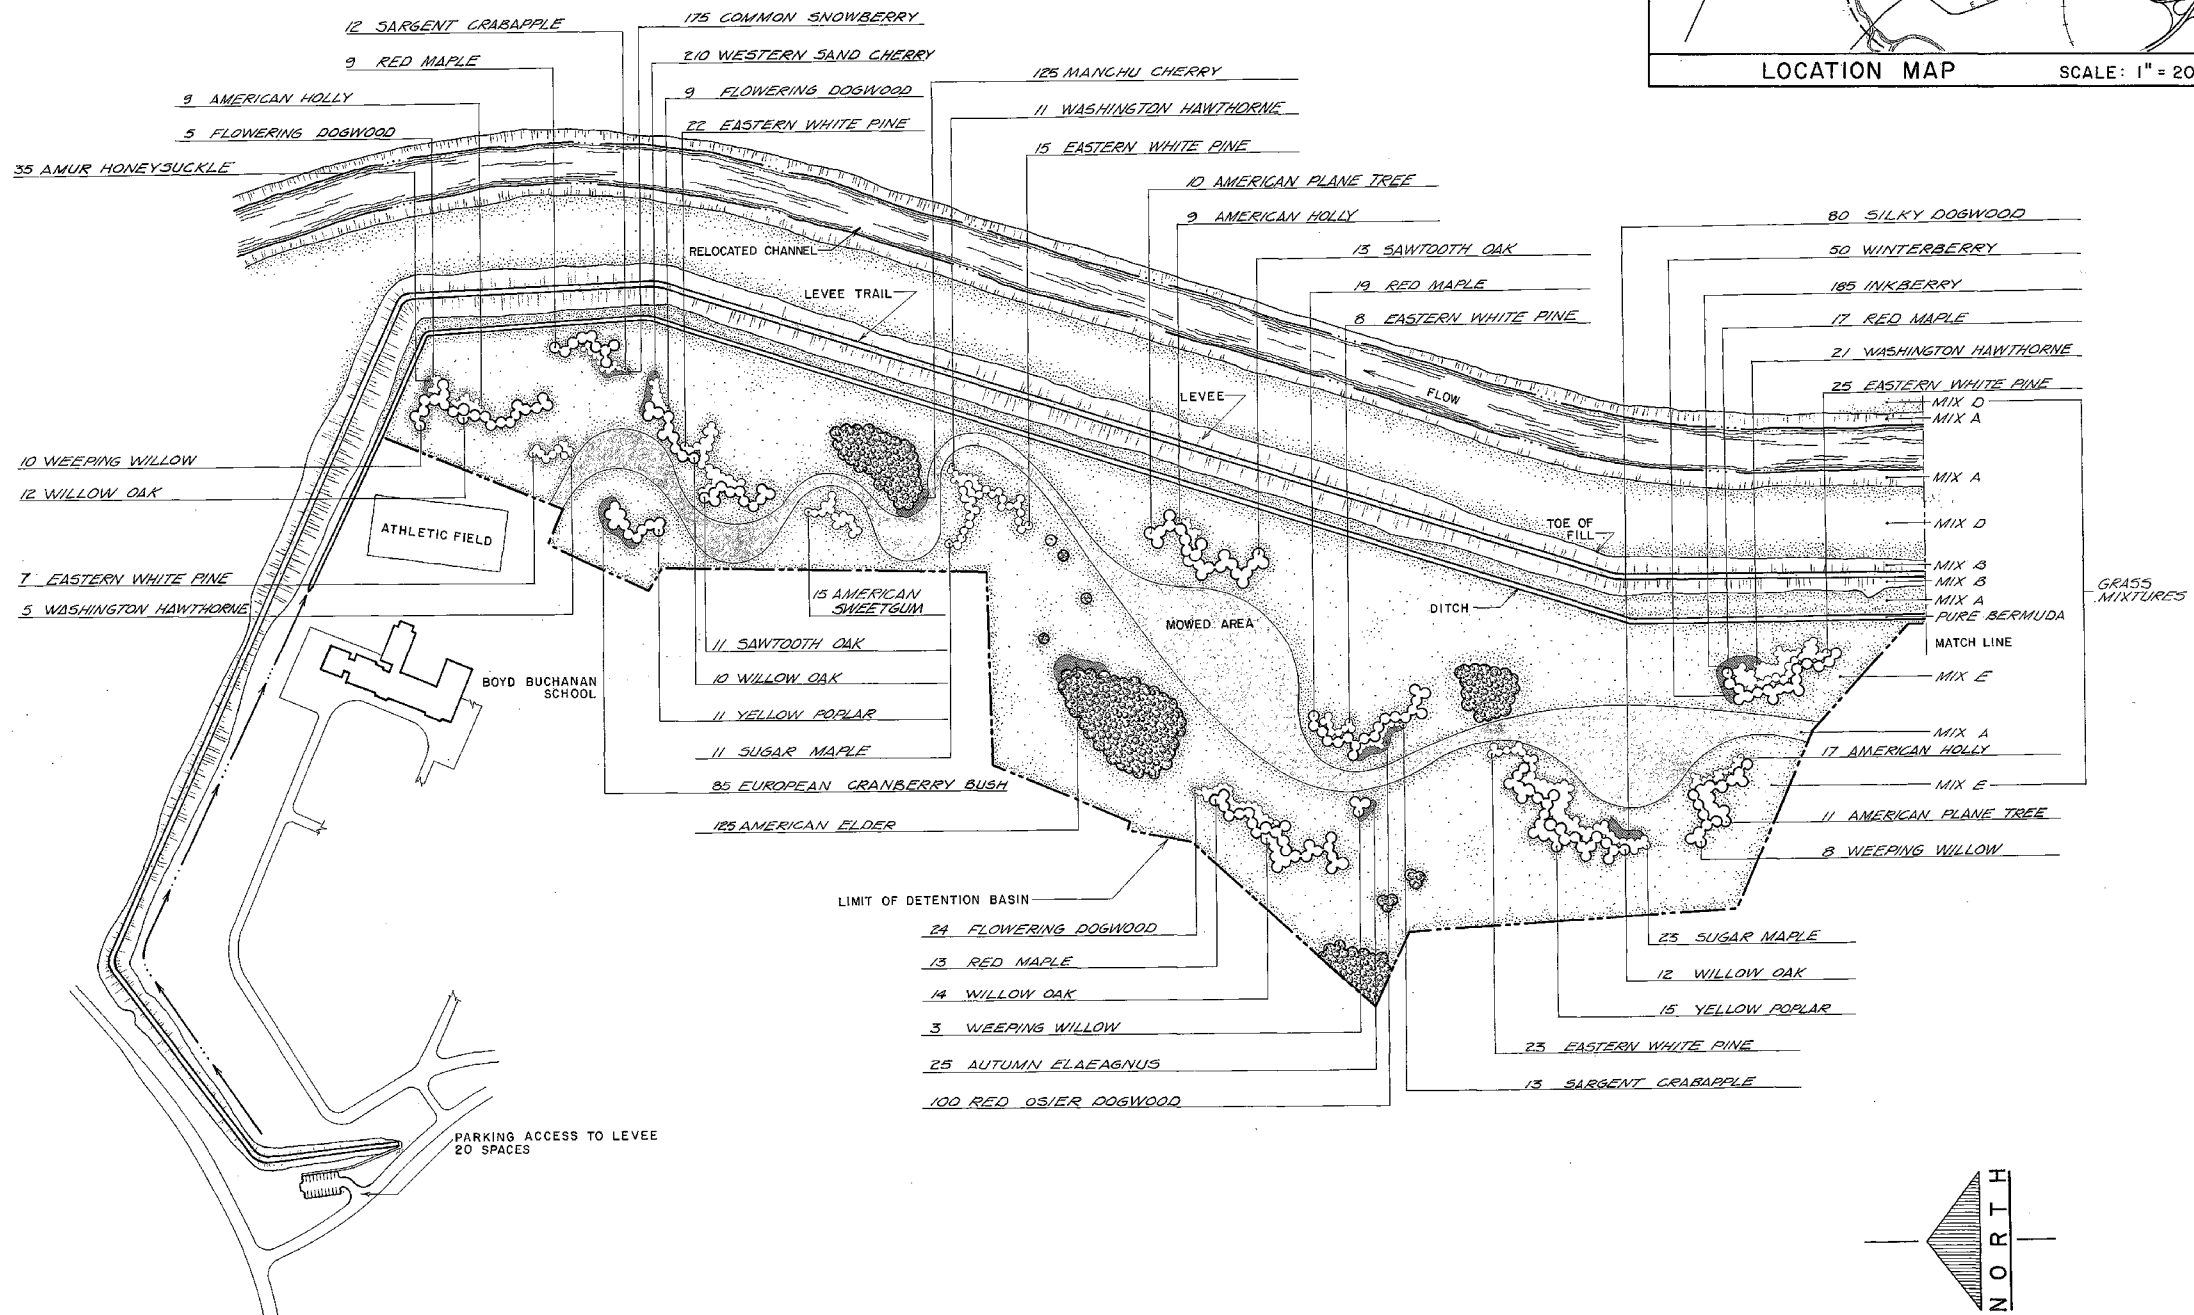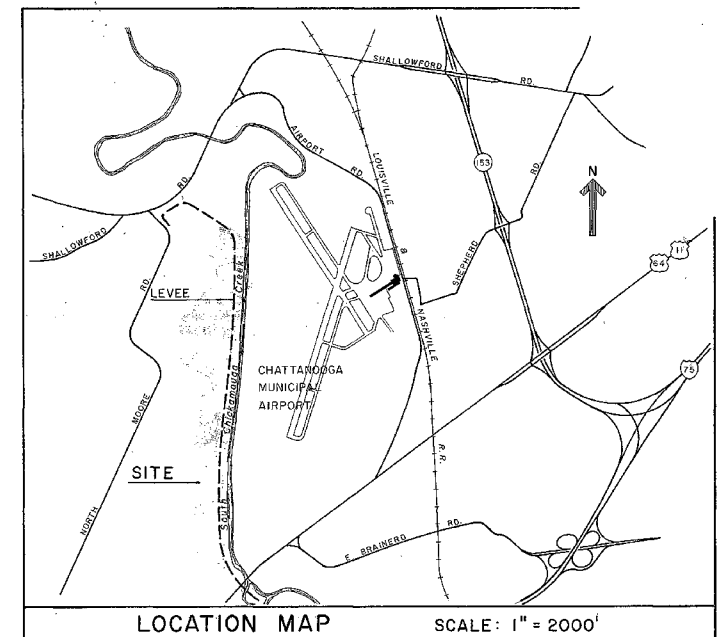

LEGEND	
MATERIAL	SYM.
EXISTING TREES	
PROPOSED TREES	
PROPOSED SHRUBS	
BALL AND BURLAP	
MOWED AREA	


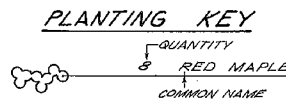


PLANT LIST							
ITEM	BOTANICAL NAME	COMMON NAME	SIZE	ROOT	SPACING	QUANTITY	REMARKS
<b>TREES</b>							
1	ALER RUBRUM	RED MAPLE	6'-8'	3" x 3"	30'	58	
2	ACER SACCHARUM	SUGAR MAPLE	6'-8'	3" x 3"	22'	34	
3	BETULA NIGRA	RIVER BIRCH	6'-8'	3" x 3"	22'	41	
4	CORNUS FLORIDA	FLOWERING DOGWOOD	4'-6"	3" x 3"	15'	88	WHITE FLOWERING
5	GRATAEGUS PHAENOPYRUM	WASHINGTON HAWTHORNE	4'-6"	3" x 3"	15'	46	
6	ILEX OPACA	AMERICAN HOLLY	24"-30"	3" x 3"	15'	44	
7	LIRIODENDRON STYRACIFLUA	AMERICAN SWEETGUM	6'-8'	3" x 3"	22'-30'	36	
8	LIRIODENDRON TULIPIFERA	YELLOW POPLAR	6'-8'	3" x 3"	30'	35	
9	MALUS SARGENTII	SARGENT CRABAPPLE	4'-6"	3" x 3"	15'	45	
10	PINUS STROBUS	EASTERN WHITE PINE	6'-8'	3" x 3"	22'	149	DENSE FOLIAGE
11	PLATANUS OCCIDENTALIS	AMERICAN PLANE TREE	6'-8'	3" x 3"	30'	34	
12	QUERCUS ALUTISSIMA	SAWTOOTH OAK	6'-8'	3" x 3"	30'	24	
13	QUERCUS PHellos	WILLOW OAK	6'-8'	3" x 3"	30'	65	
14	SALIX BABYLONICA	WEeping WILLOW	6'-8'	3" x 3"	30'	56	
<b>SHRUBS</b>							
15	CORNUS AMOMUM	SILKY DOGWOOD	18"-24"	3" x 3"	5'	85	
16	CORNUS STOLONIFERA	RED OSIER DOGWOOD	18"-24"	3" x 3"	5'	100	
17	ELAEAGNUS UMBELLATUS	AUTUMN ELAEAGNUS	18"-24"	3" x 3"	6'	25	
18	ILEX GLABRA	INKBERRY	18"-24"	3" x 3"	4'	285	
19	ILEX VERTICILLATA	WINTERBERRY	18"-24"	3" x 3"	5'	86	
20	LONICERA MAACKI	AMUR HONEYSUCKLE	18"-24"	3" x 3"	6'	55	
21	PRUNUS BESSEYI	WESTERN SAND CHERRY	18"-24"	3" x 3"	3'-6"	310	
22	PRUNUS TOMENTOSA	MANCHURI CHERRY	18"-24"	3" x 3"	4'	125	
23	SAMBUCUS CANADENSIS	AMERICAN ELDER	18"-24"	3" x 3"	6'	125	
24	SYMPHORICARPOS ALBUS	COMMON SNOWBERRY	15"-18"	3" x 3"	5'	175	
25	VIBURNUM DILATATUM	LINDEN VIBURNUM	18"-24"	3" x 3"	7'	DELETE	
26	VIBURNUM OPULUS	EUROPEAN CRANBERRY BUSH	18"-24"	3" x 3"	6'	85	
27	VIBURNUM SIEBOLDII	SIEBOLD VIBURNUM	18"-24"	3" x 3"	6'	20	
<b>GRASS MIXTURES</b>							
A	CYNODON DACTYLON	BERMUDA GRASS	40 *				PLANTING SEASON MAY 15 - JULY 15
B	LESPEDEZA STIPULACEA	KOREAN LESPEDEZA	12 = 50 TOTAL				MAY 15 - JULY 15
C	CORNILLA VARIA	CROWN VETCH	30 = 50 TOTAL				MARCH 15 - MAY 15
D	FESTUCA RUPESTRIS COMMUTATA	CHEWINGS FESCUE	30 = 60 TOTAL				AUG. 15 - OCT. 15
E	BREMCHLOA OPHIOUROIDES	CENTPEDE GRASS	DELETE				MAY 15 - JULY 15
F	TRIFOLIUM REPENS	WHITE CLOVER	DELETE				AUG. 15 - OCT. 15
G	LESPEDEZA CUNEATA	DWARF SEREGIA "INTERSTATE"	20 *				MARCH 15 - MAY 15
H	DACTYLIS GLUMERATA	ORCHARD GRASS	20 *				AUG. 15 - OCT. 15
I	TRIFOLIUM REPENS	WHITE CLOVER	15 *				AUG. 15 - OCT. 15
J	TRIFOLIUM INCARNATUM	CRIMSON CLOVER	15 = 70 TOTAL				AUG. 15 - OCT. 15
K	PHLEUM PRATENSE	TIMOTHY GRASS	20 *				AUG. 15 - OCT. 15
L	PDA TRIVIALIS	SABRE BLUEGRASS	30 *				AUG. 15 - OCT. 15
M	TRIFOLIUM HYBRIDUM	ALSIKE CLOVER	20 = 70 TOTAL				AUG. 15 - OCT. 15


SEEDING NOTES

- SEEDING OF DESIGNATED AREAS SHALL FOLLOW IMMEDIATELY BEHIND CONSTRUCTION. PLACING OF SEED, COMMERCIAL FERTILIZER AND AGRICULTURE LIMESTONE SHALL CONFORM TO HIGHWAY SPECIFICATION NO. 71, SECTION 180. SOIL PREPARATION SHALL BE TO A DEPTH OF 2" IN ACCORDANCE WITH PARAGRAPH 180.04.
- BERMUDA GRASS SEED TO BE HULLED.
- KOREAN LESPEDEZA AND DWARF SEREGIA SEED TO BE SCARIFIED.
- CROWN VETCH SEED TO BE SCARIFIED AND INOCULATED.
- LIME AREAS TO BE PLANTED AT RATE OF 3 1/2 TONS PER ACRE.
- FERTILIZE WITH 14-19-19 AT RATE OF 400 POUNDS PER ACRE.
- STRAW MULCH ALL PLANTED AREAS AT RATE OF 60 BALES PER ACRE.

NOTE: BARE ROOT OR CONTAINER GROWN MATERIAL MAY BE SUBSTITUTED FOR BALLED AND BURLAPED SHRUBS AND SMALL TREES (UP TO 4'-6").

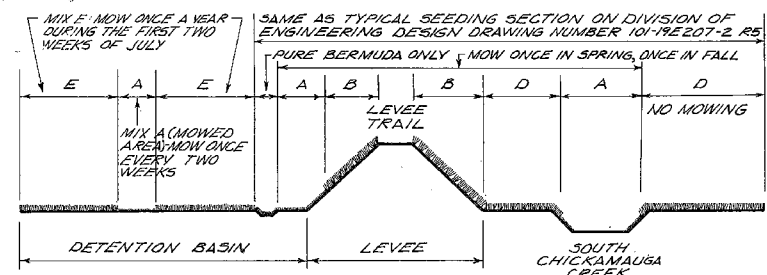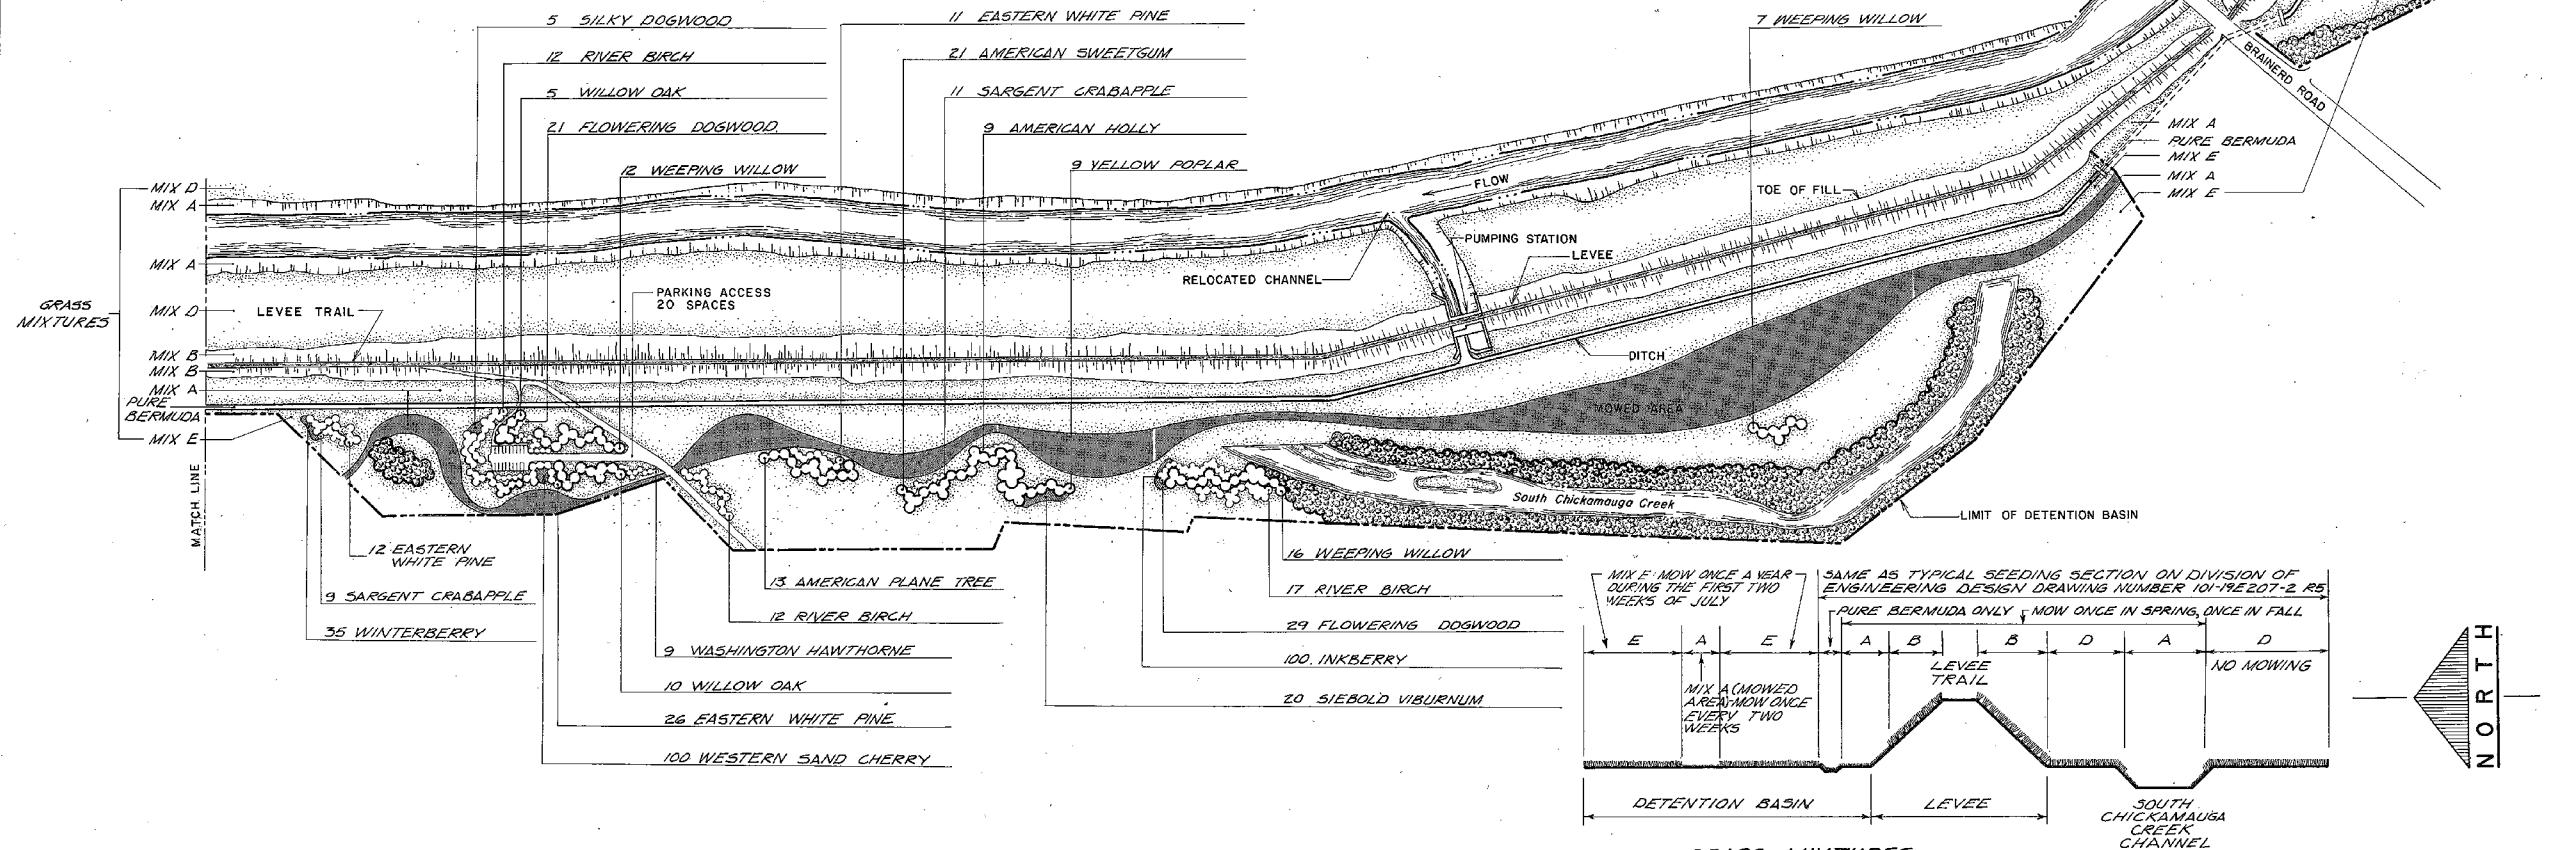

GRASS MIXTURES  
TYPICAL SECTION - VIEW DOWNSTREAM  
NOTE: NO MOWING BETWEEN APRIL 15 AND JUNE 30 EXCEPT FOR SHADED AREA OF MIX A DESIGNATED MOWED AREA.

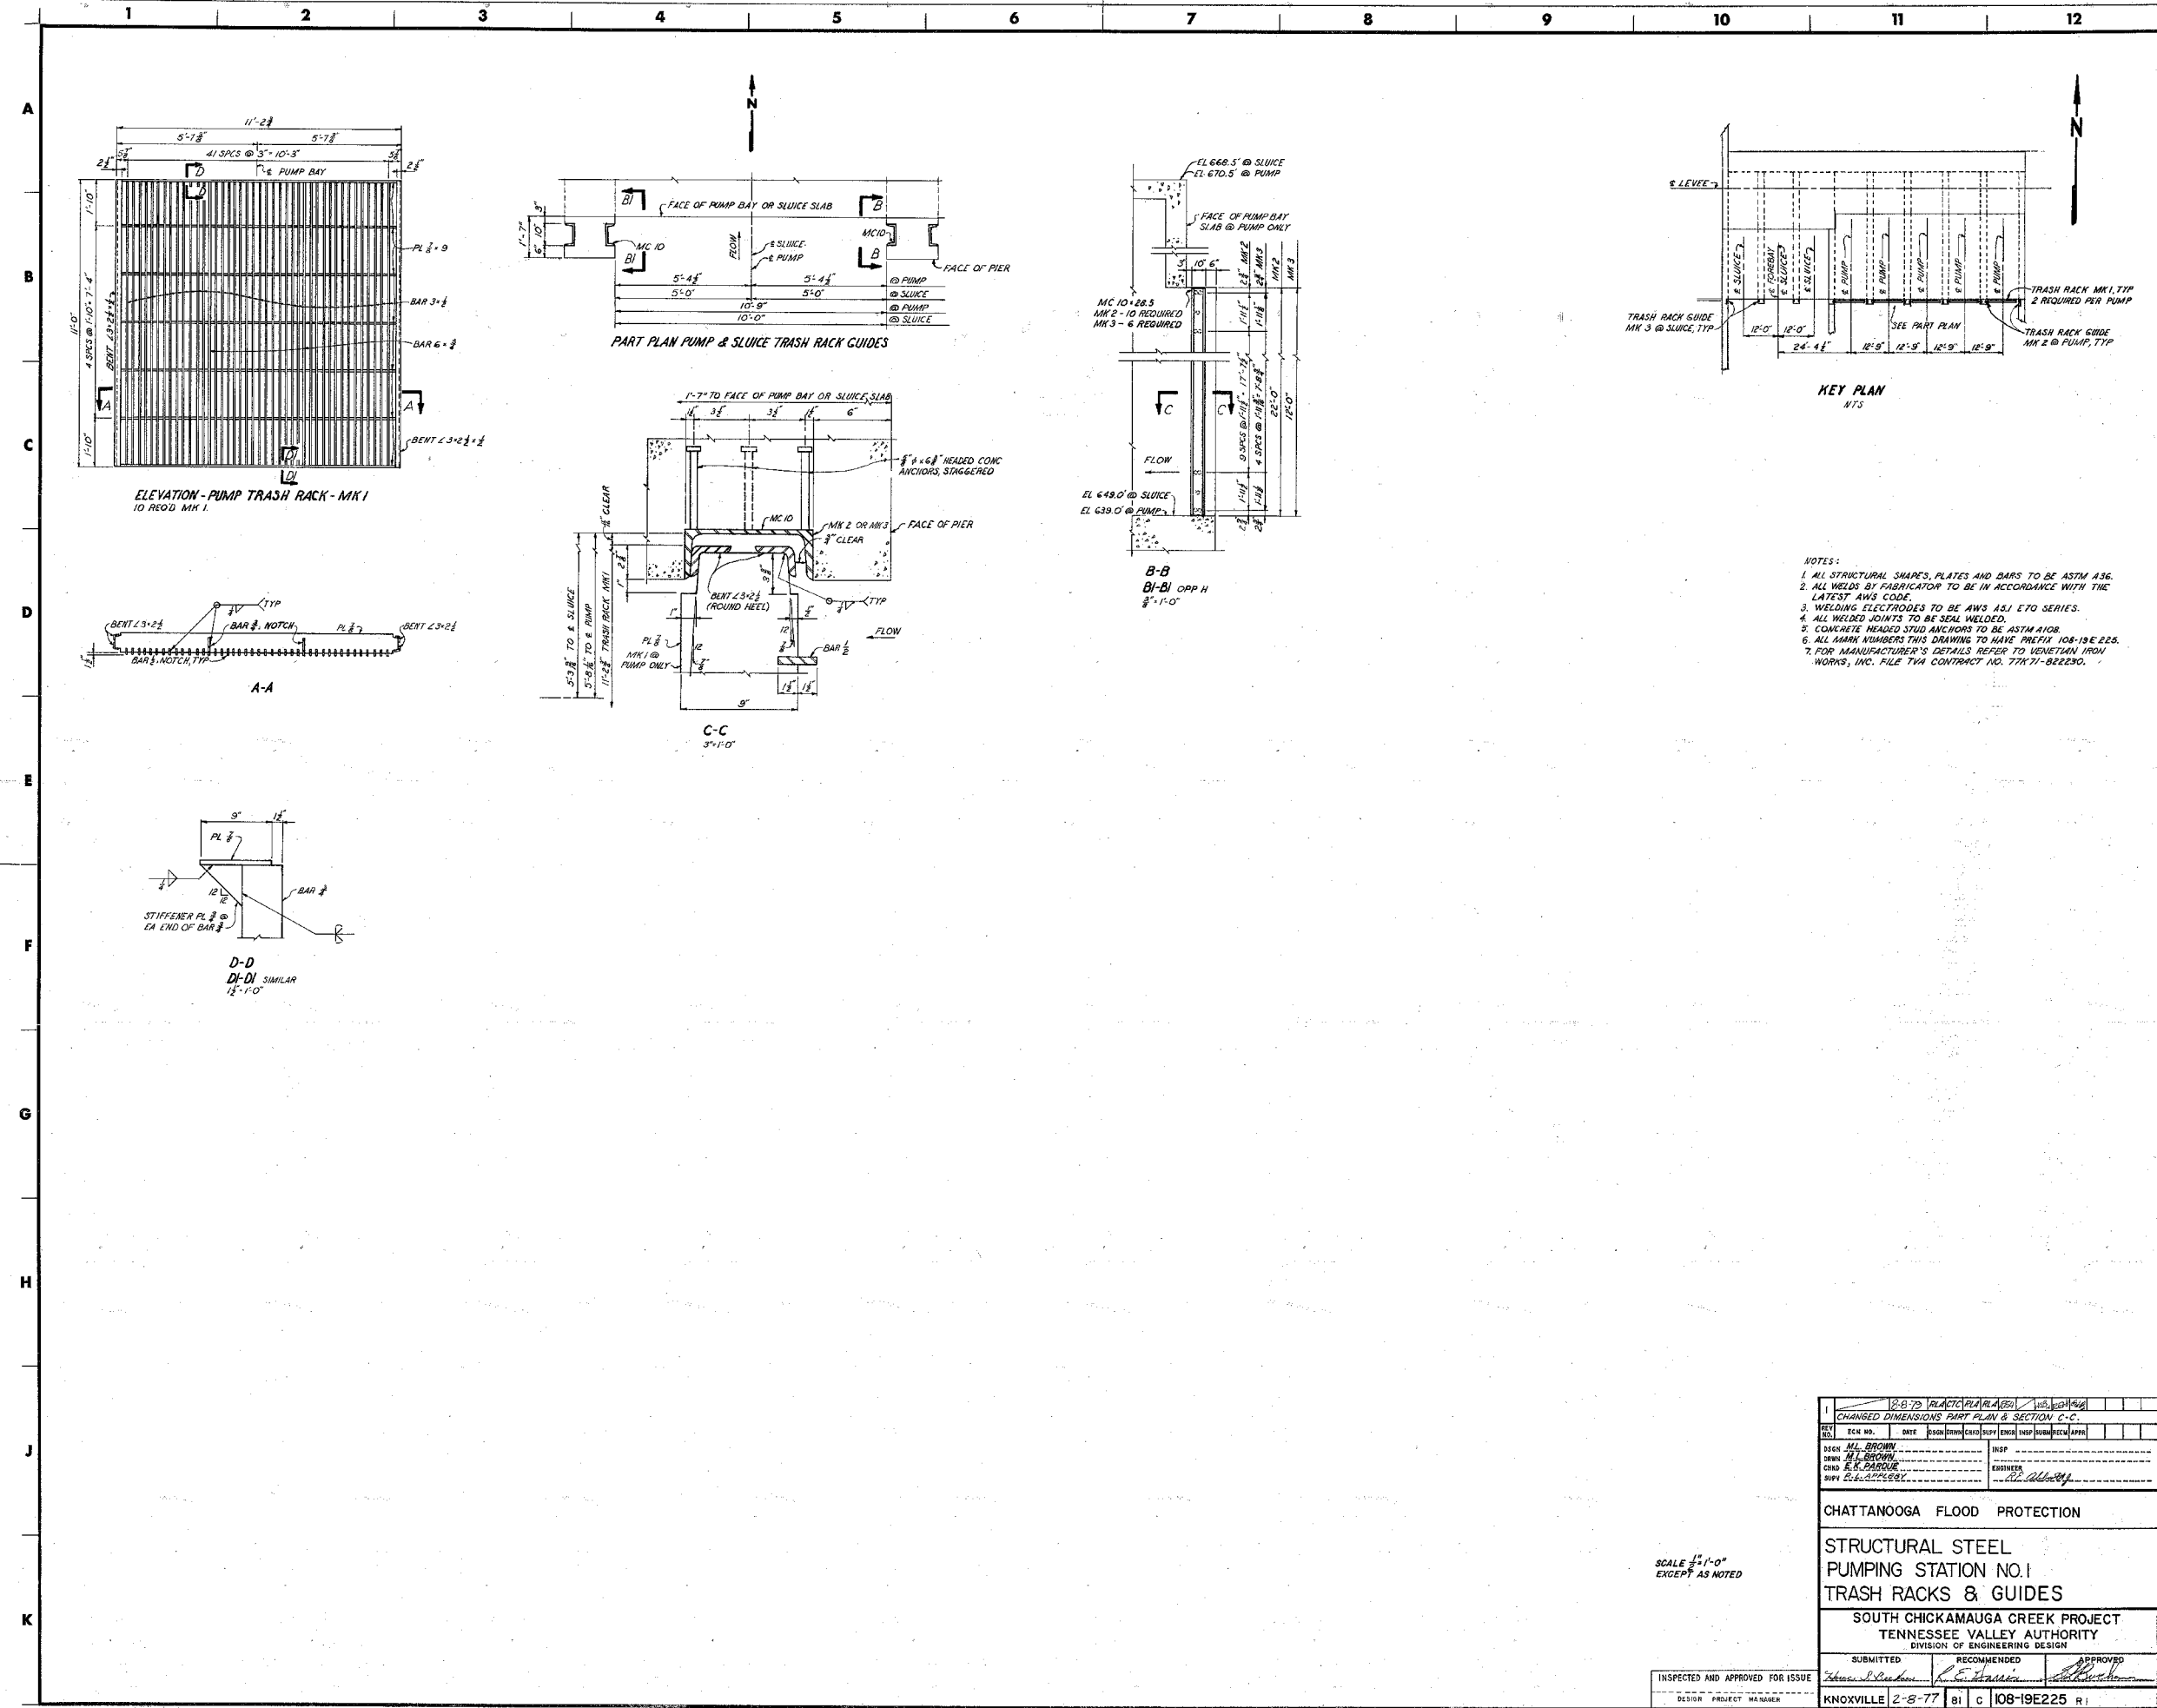




- NOTES:
1. ALL STRUCTURAL SHAPES, PLATES AND BARS TO BE ASTM A56.
  2. ALL WELDS BY FABRICATOR TO BE IN ACCORDANCE WITH THE LATEST AWS CODE.
  3. WELDING ELECTRODES TO BE AWS A51 E70 SERIES.
  4. ALL WELDED JOINTS TO BE SEAL WELDED.
  5. CONCRETE HEADED STUD ANCHORS TO BE ASTM A108.
  6. ALL MARK NUMBERS THIS DRAWING TO HAVE PREFIX 108-19E 225.
  7. FOR MANUFACTURER'S DETAILS REFER TO VENETIAN IRON WORKS, INC. FILE T74 CONTRACT NO. T74-71-82250.

SCALE 1/4" = 1'-0"  
EXCEPT AS NOTED

INSPECTED AND APPROVED FOR ISSUE		DESIGNER PROJECT MANAGER	
PRINT	SIZE	OR FOR PROJ	ME EL CE AD CO ES NO BF SW BL PA
PRINTS	REQD	PRINTS	REQD

DESIGNER	PROJECT MANAGER	DATE	NO.
DESIGNER	PROJECT MANAGER	DATE	NO.

CHATTANOOGA FLOOD PROTECTION		
STRUCTURAL STEEL		
PUMPING STATION NO. 1		
TRASH RACKS & GUIDES		
SOUTH CHICKAMAUGA CREEK PROJECT		
TENNESSEE VALLEY AUTHORITY		
DIVISION OF ENGINEERING DESIGN		
SUBMITTED	RECOMMENDED	APPROVED
DESIGNER	PROJECT MANAGER	DATE
DESIGNER	PROJECT MANAGER	DATE

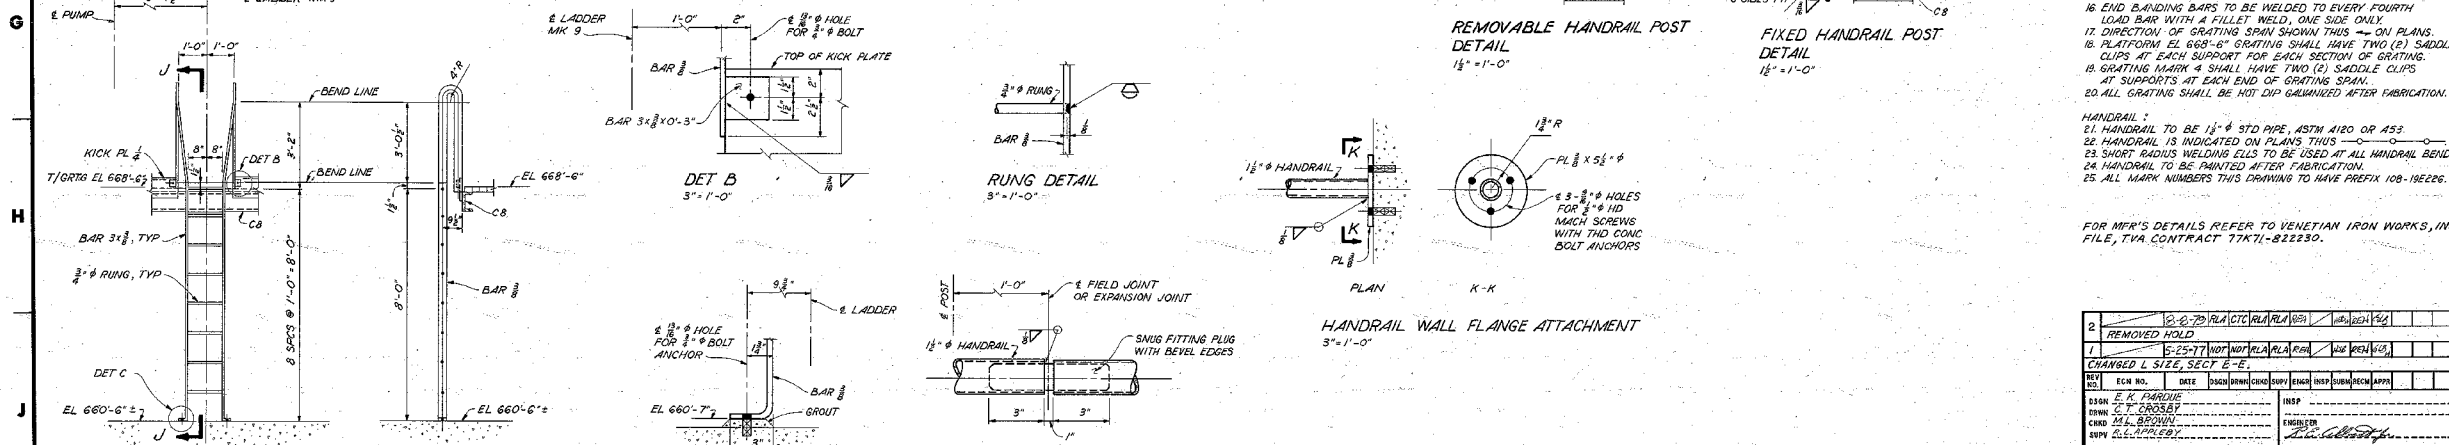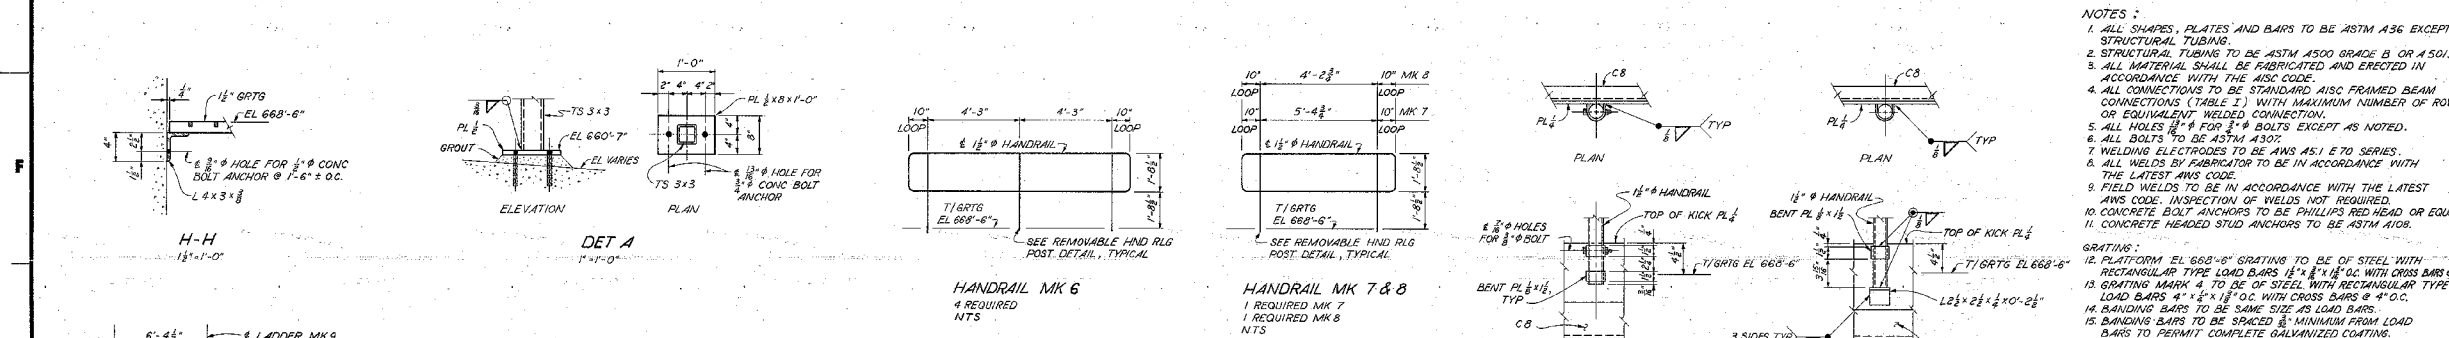
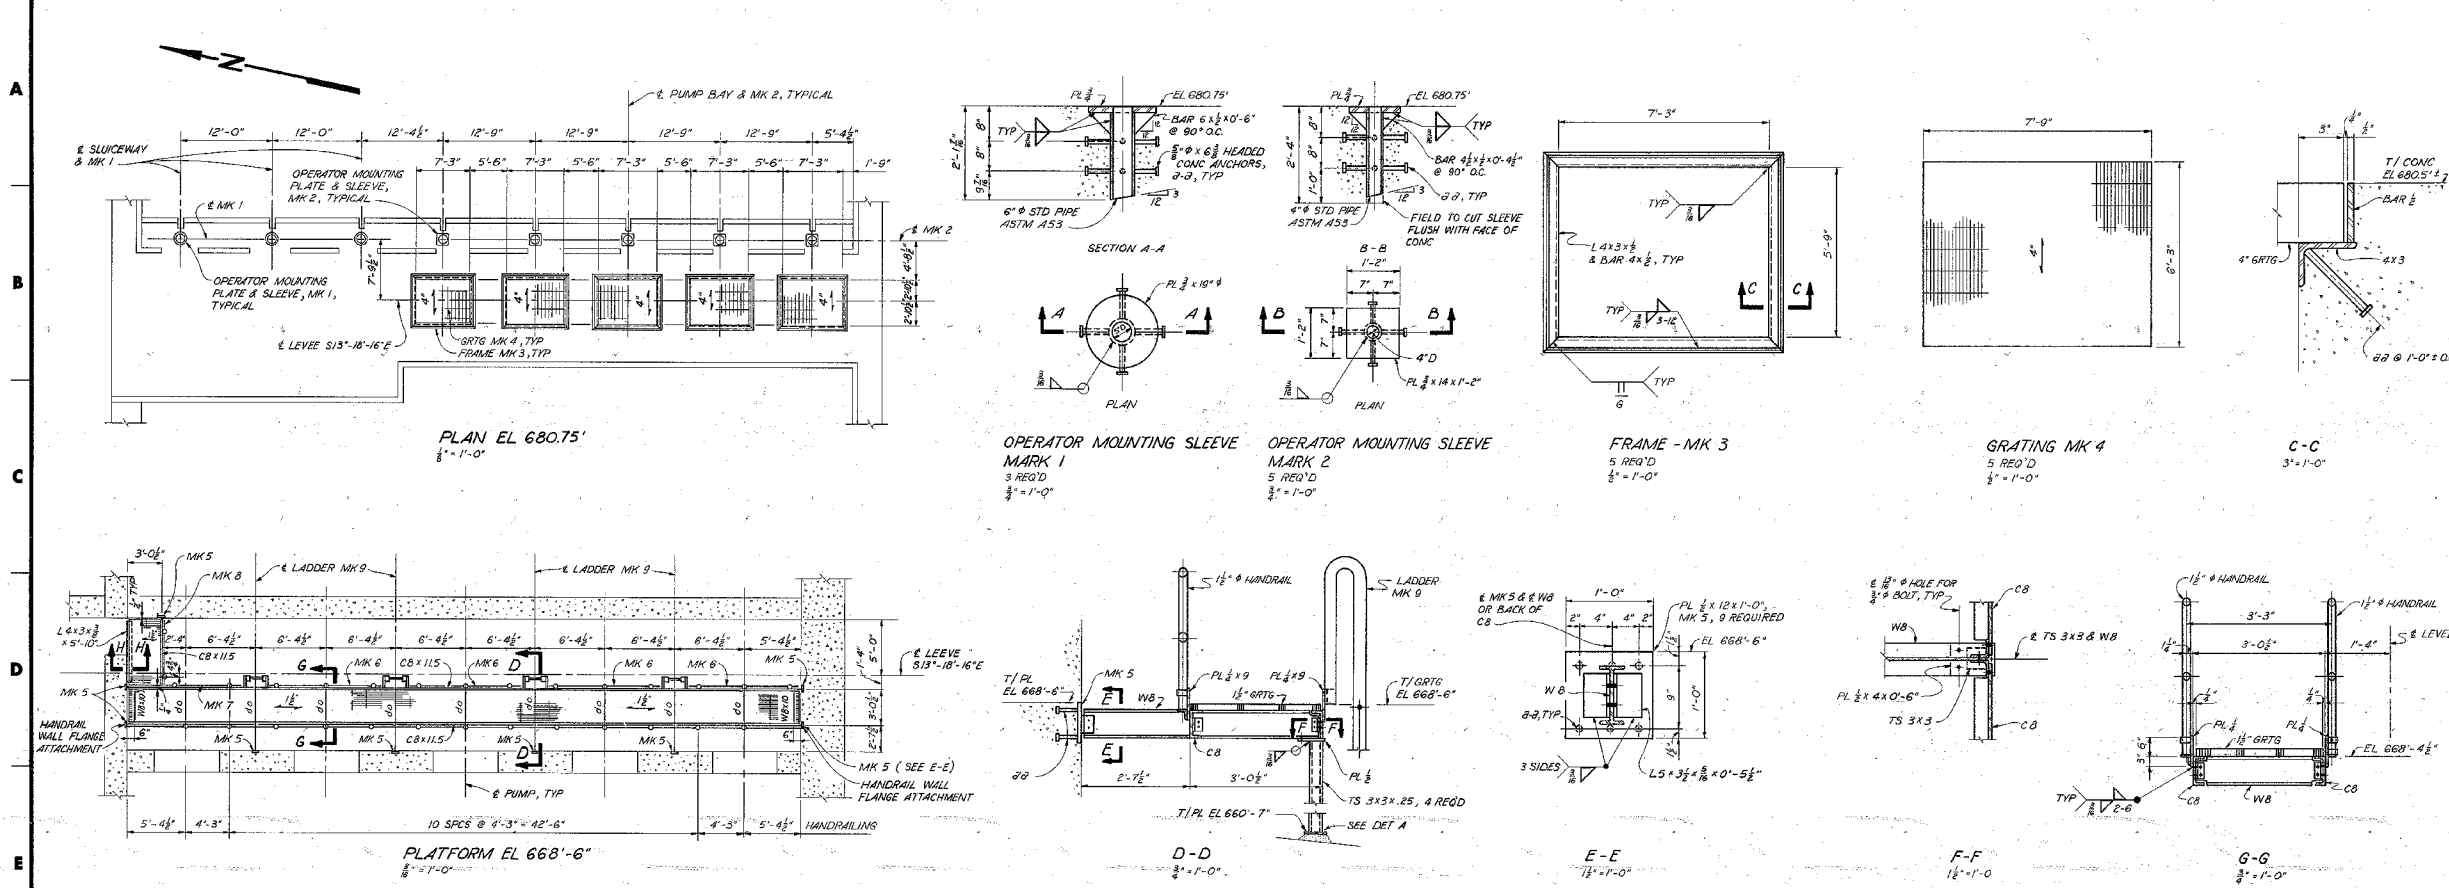


- NOTES:**
1. ALL SHAPES, PLATES AND BARS TO BE ASTM A36 EXCEPT STRUCTURAL TUBING.
  2. STRUCTURAL TUBING TO BE ASTM A500 GRADE B OR A 501.
  3. ALL MATERIAL SHALL BE FABRICATED AND ERECTED IN ACCORDANCE WITH THE AISC CODE.
  4. ALL CONNECTIONS TO BE STANDARD AISC FRAMED BEAM CONNECTIONS (TABLE I) WITH MAXIMUM NUMBER OF ROWS OR EQUIVALENT WELDED CONNECTION.
  5. ALL WELDS TO BE IN ACCORDANCE WITH THE LATEST AWS CODE.
  6. ALL BOLTS TO BE ASTM A307.
  7. WELDING ELECTRODES TO BE AWS A5.1 E70 SERIES.
  8. ALL WELDS BY FABRICATOR TO BE IN ACCORDANCE WITH THE LATEST AWS CODE.
  9. FIELD WELDS TO BE IN ACCORDANCE WITH THE LATEST AWS CODE. INSPECTION OF WELDS NOT REQUIRED.
  10. CONCRETE BOLT ANCHORS TO BE PHILLIPS BED HEAD OR EQUAL.
  11. CONCRETE HEADED STUD ANCHORS TO BE ASTM A193.
- GRATING:**
12. PLATFORM EL 668'-6" GRATING TO BE OF STEEL WITH RECTANGULAR TYPE LOAD BARS 1 1/2" x 1 1/2" O.C. WITH CROSS BARS #4X.
  13. GRATING MARK 4 TO BE OF STEEL WITH RECTANGULAR TYPE LOAD BARS 4" x 2" O.C. WITH CROSS BARS #4 O.C.
  14. HANDING BARS TO BE SAME SIZE AS LOAD BARS.
  15. BANDING BARS TO BE SPACED 6" MINIMUM FROM LOAD BARS TO PERMIT COMPLETE GALVANIZED COATING.
  16. END BANDING BARS TO BE WELDED TO EVERY FOURTH LOAD BAR WITH A FILLET WELD, ONE SIDE ONLY.
  17. DIRECTION OF GRATING SPAN SHOWN THIS - ON PLANS.
  18. PLATFORM EL 668'-6" GRATING SHALL HAVE TWO (2) SADDLE LOAD BARS AT EACH SUPPORT FOR EACH SECTION OF GRATING.
  19. GRATING MARK 4 SHALL HAVE TWO (2) SADDLE CLIPS AT SUPPORTS AT EACH END OF GRATING SPAN.
  20. ALL GRATING SHALL BE HOT DIP GALVANIZED AFTER FABRICATION.
- HANDRAIL:**
21. HANDRAIL TO BE 1 1/2" STD PIPE, ASTM A193 OR A53.
  22. HANDRAIL IS INDICATED ON PLANS THIS - ON PLANS.
  23. SHORT RADIUS WELDING ELLS TO BE USED AT ALL HANDRAIL BENDS.
  24. HANDRAIL TO BE PAINTED AFTER FABRICATION.
  25. ALL MARK NUMBERS THIS DRAWING TO HAVE PREFIX 108-19E226.

FOR MFR'S DETAILS REFER TO VENETIAN IRON WORKS, INC FILE, TVA CONTRACT 77K1-82230.

2	REMOVED HOLD	2/26
1	CHANGED L SIZE, SECT E-E	2/26
REV	DATE	DESCRIPTION
1	2/26	CHANGED L SIZE, SECT E-E
DESIGN	BY	DATE
CHKD	BY	DATE
APPV	BY	DATE
CHATTANOOGA FLOOD PROTECTION MISCELLANEOUS STEEL PUMPING STATION NO.1 PLATFORM, FRAMES & GRATING SOUTH CHICKAMAUGA CREEK PROJECT TENNESSEE VALLEY AUTHORITY DIVISION OF ENGINEERING DESIGN		
INSPECTED AND APPROVED FOR ISSUE	DATE	BY
KNOXVILLE	2-8-77	RE
PRINT	SCALE	BY
SIZE	SCALE	BY
SECOND DRAWING AS CONSTRUCTED 108-19E226 R2		

INSPECTED AND APPROVED FOR ISSUE	DATE	BY
KNOXVILLE	2-8-77	RE
PRINT	SCALE	BY
SIZE	SCALE	BY
SECOND DRAWING AS CONSTRUCTED 108-19E226 R2		

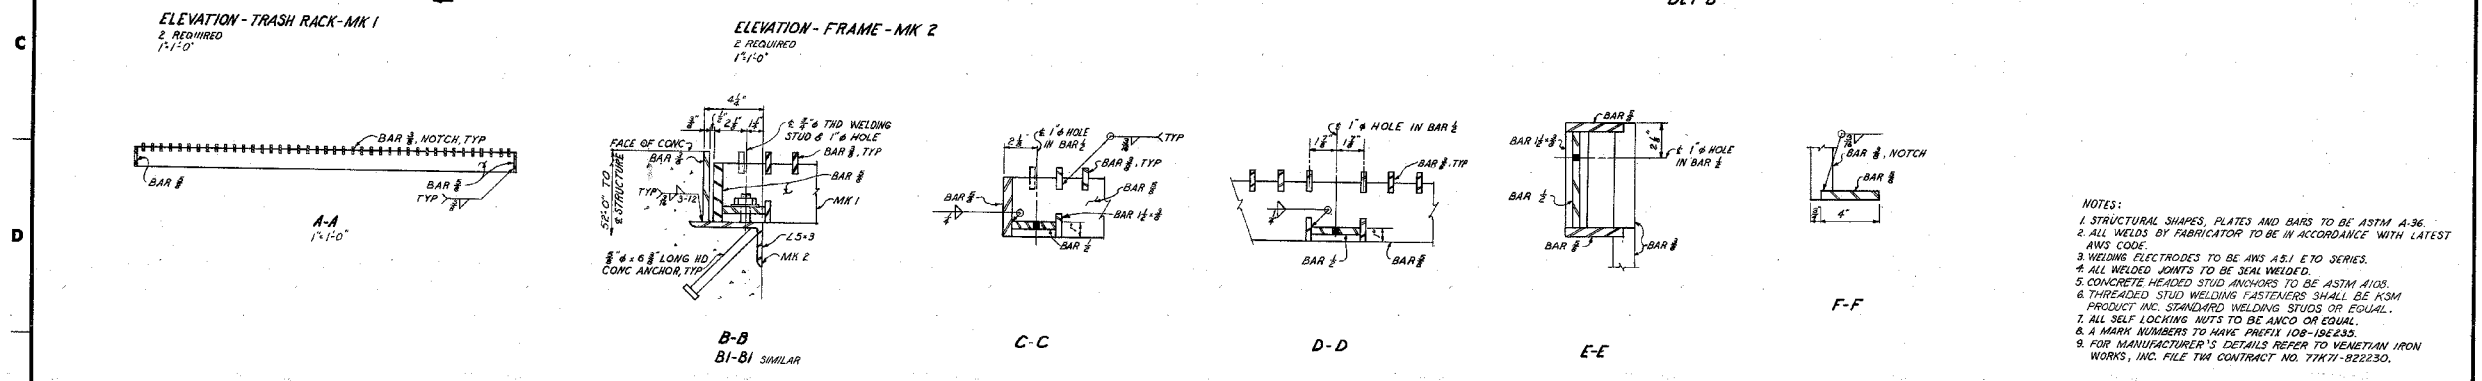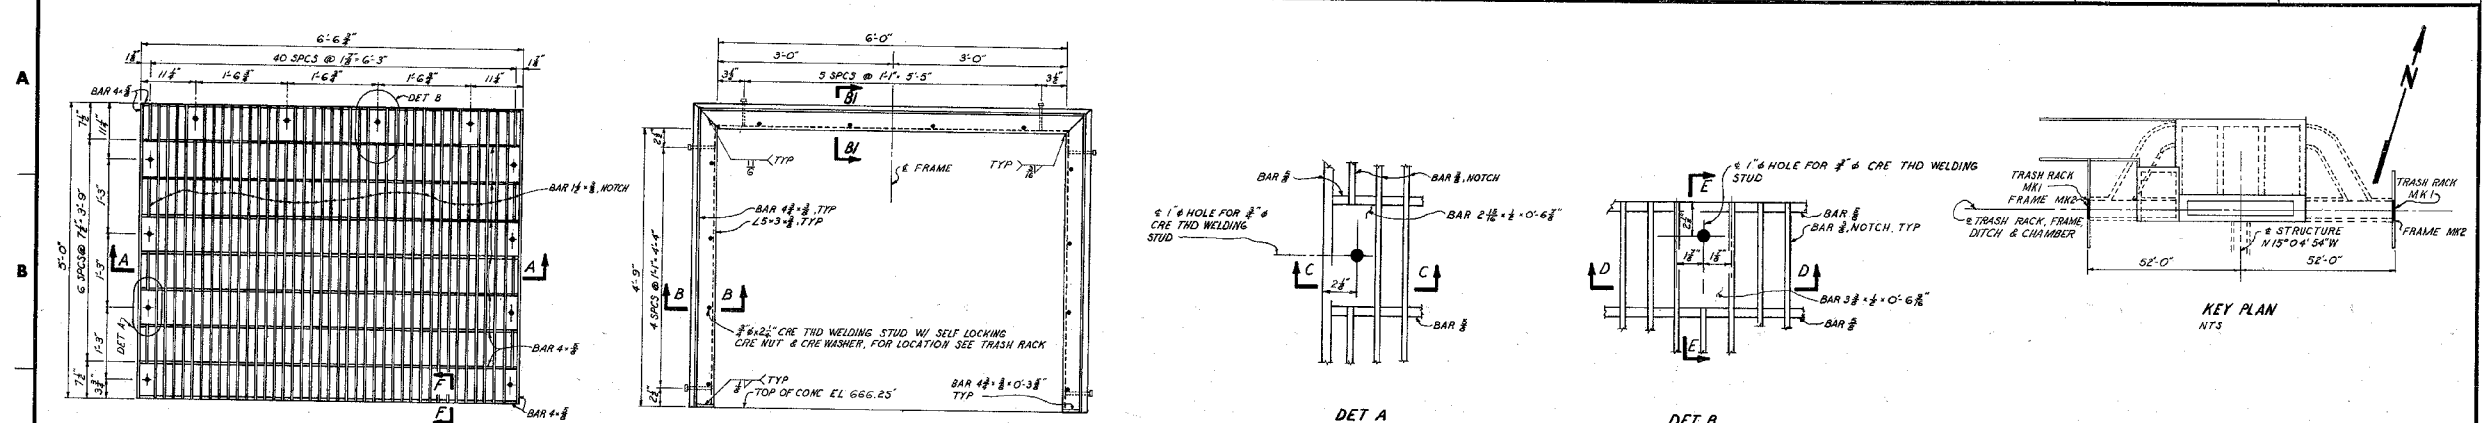

- NOTES:
1. STRUCTURAL SHAPES, PLATES AND BARS TO BE ASTM A-36.
  2. ALL WELDS BY FABRICATOR TO BE IN ACCORDANCE WITH LATEST AWS CODE.
  3. WELDING ELECTRODES TO BE AWS A5.1 E70 SERIES.
  4. ALL WELDED JOINTS TO BE SEAL WELDED.
  5. CONCRETE HEADED STUD ANCHORS TO BE ASTM A193.
  6. THREADED STUD WELDING FASTENERS SHALL BE KSM PRODUCT INC. STANDARD WELDING STUDS OR EQUAL.
  7. ALL SELF-LOCKING NUTS TO BE ANCO OR EQUAL.
  8. A MARK NUMBERS TO HAVE PREFIX 108-19E235.
  9. FOR MANUFACTURER'S DETAILS REFER TO VENETIAN IRON WORKS, INC. FILE TM CONTRACT NO. 77A71-82230.


SCALE 3/4"=1'-0"  
EXCEPT AS NOTED

DESIGN	PROJECT	MANAGER	DATE	SCALE	NO.	REV.	BY	CHKD	APP'D					
CHATTANOOGA FLOOD PROTECTION STRUCTURAL STEEL PUMPING STATION NO. 2 TRASH RACKS & FRAMES SOUTH CHICKAMAUGA CREEK PROJECT TENNESSEE VALLEY AUTHORITY DIVISION OF ENGINEERING DESIGN														
SUBMITTED					RECOMMENDED					APPROVED				
KNOXVILLE 2-8-77 BI C 108-19E235 RI RECORD DRAWING AS CONSTRUCTED Frank Van Meter, P.E.														

INSPECTED AND APPROVED FOR ISSUE	DESIGN PROJECT MANAGER	NO.	DATE
		52	
PRINT	SIZE	OR OR PRINT THE EC CE AD CO ED MD BY SW BL FA	PRINTS: 8/23-8-1

11  
10  
9  
8  
7  
6  
5  
4  
3  
2  
1



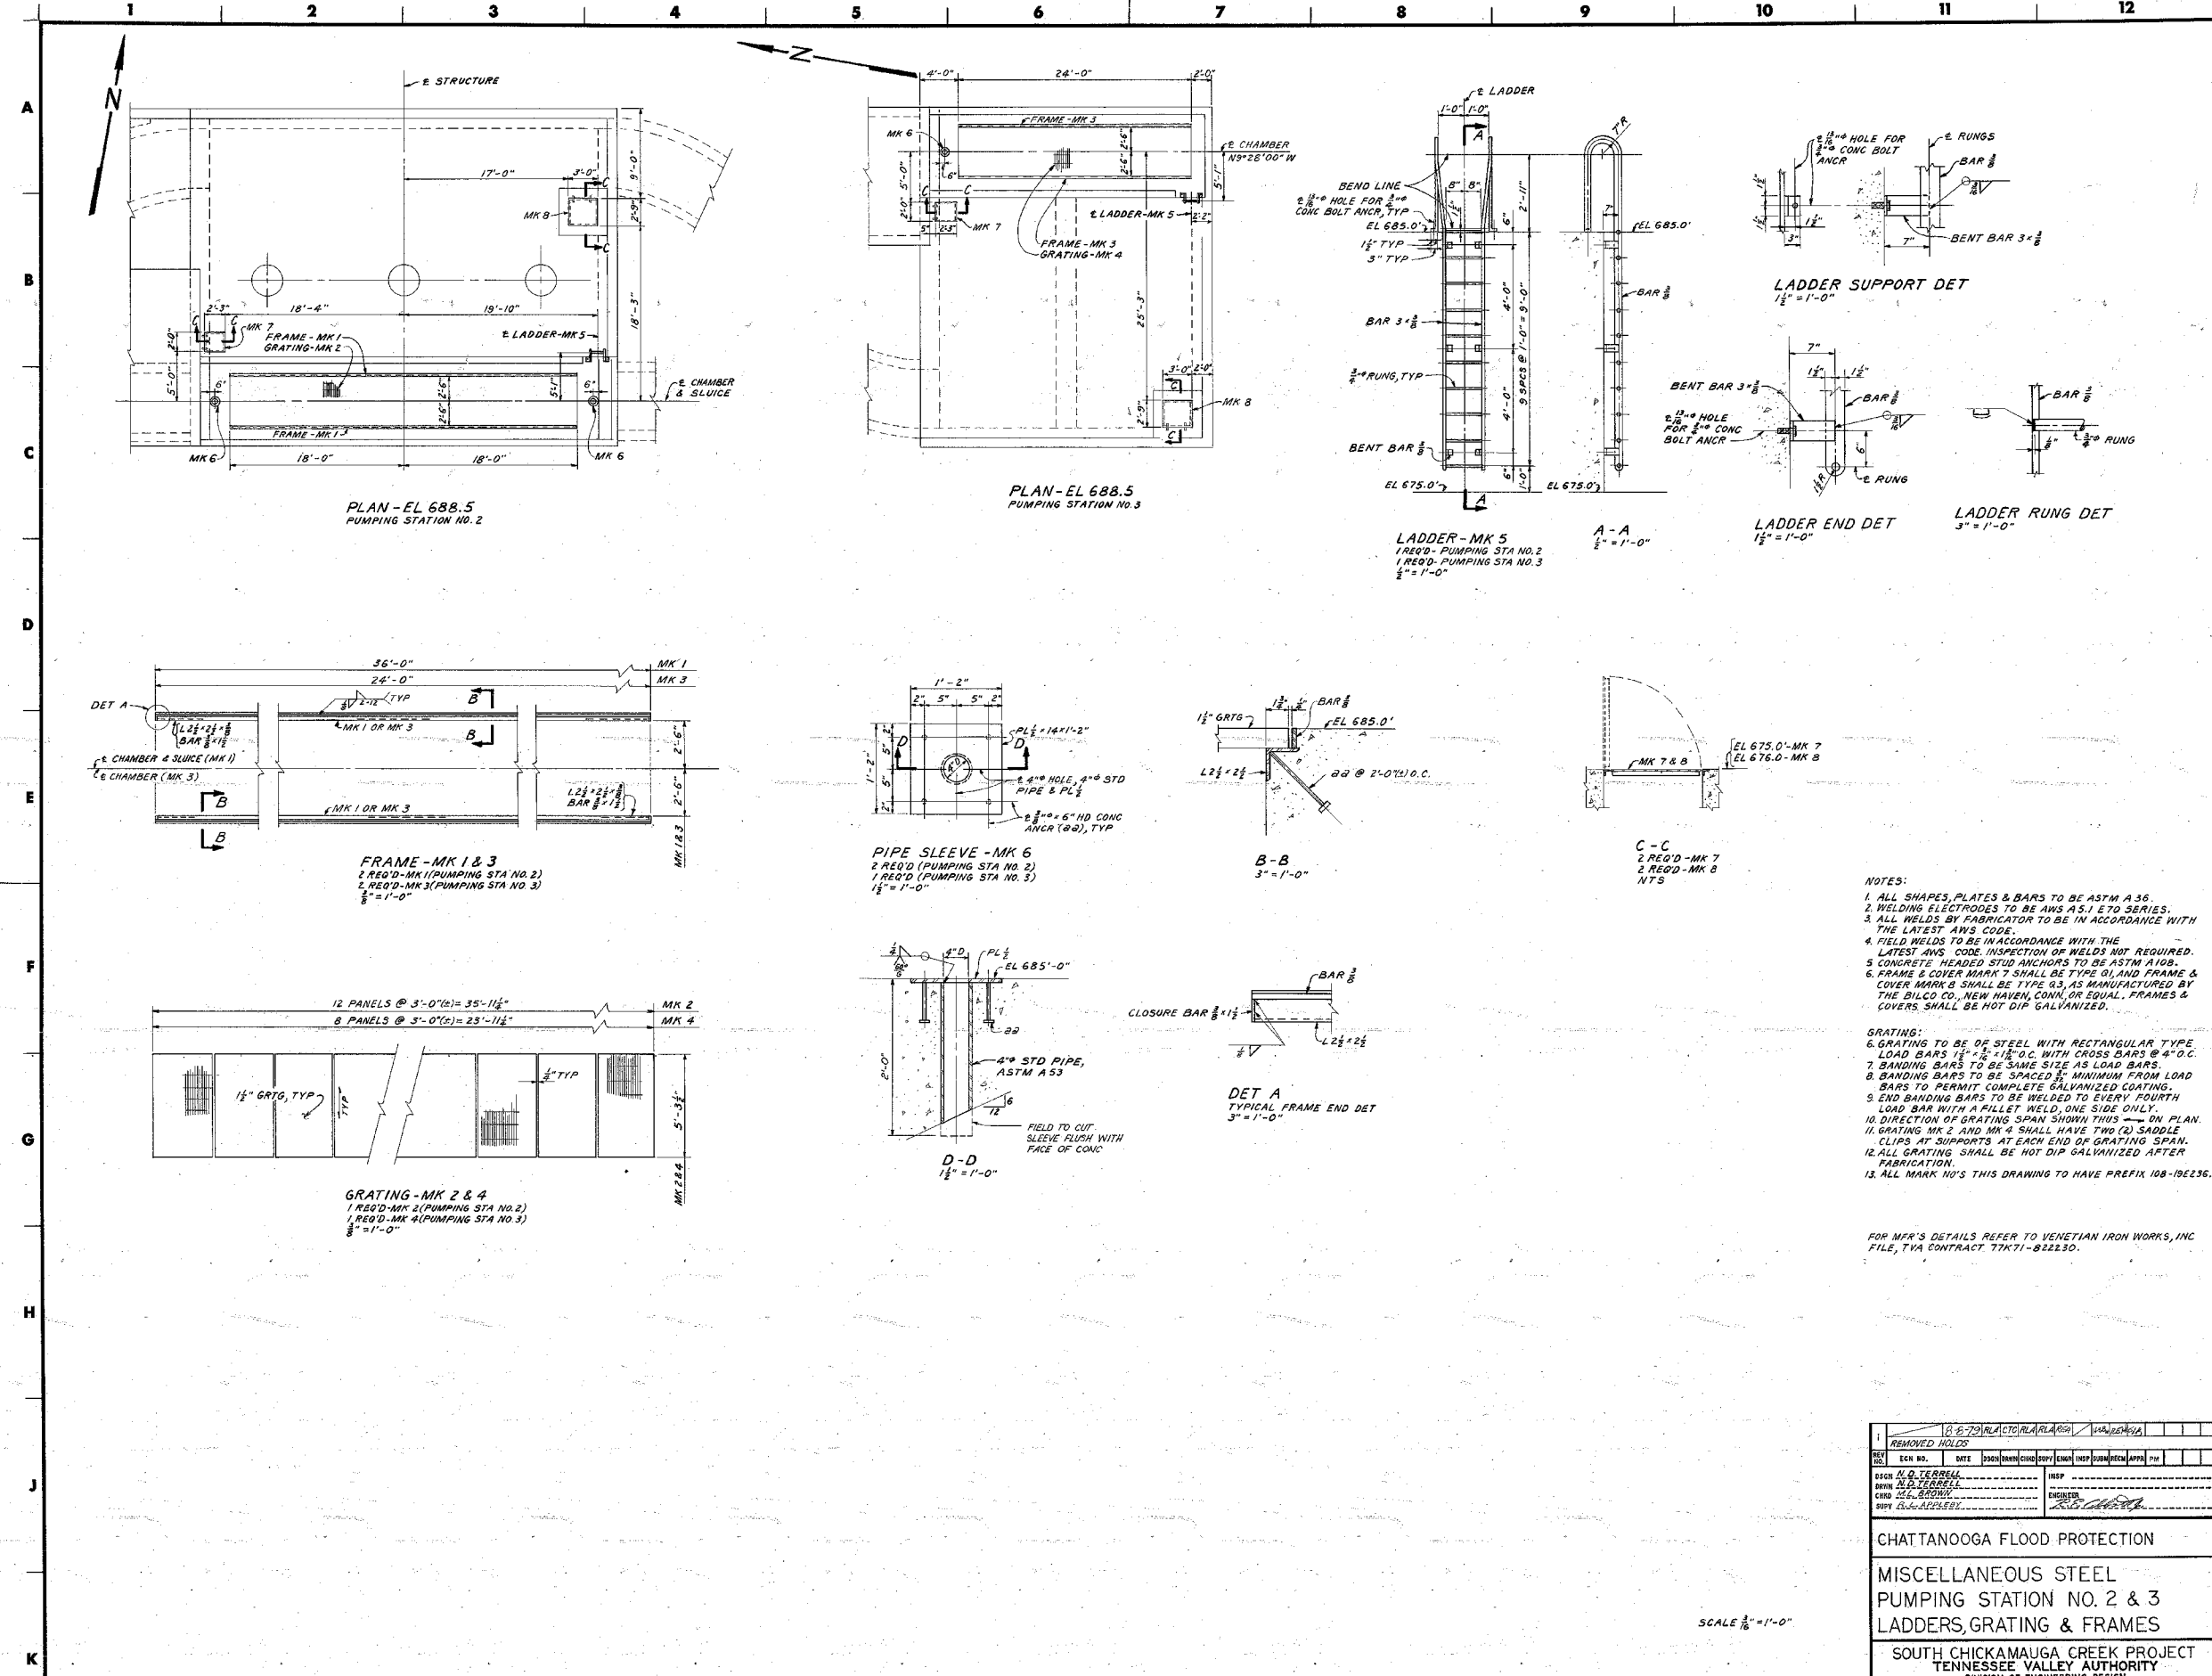


- NOTES:**
1. ALL SHAPES, PLATES & BARS TO BE ASTM A 36.
  2. WELDING ELECTRODES TO BE AWS A 5.1 E70 SERIES.
  3. ALL WELDS BY FABRICATOR TO BE IN ACCORDANCE WITH THE LATEST AWS CODE.
  4. FIELD WELDS TO BE IN ACCORDANCE WITH THE LATEST AWS CODE. INSPECTION OF WELDS NOT REQUIRED.
  5. CONCRETE HEADED STUD ANCHORS TO BE ASTM A 108.
  6. FRAME & COVER MARK 1 SHALL BE TYPE Q1, AND FRAME & COVER MARK 2 SHALL BE TYPE Q3, AS MANUFACTURED BY THE BILCO CO., NEW HAVEN, CONN. OR EQUAL. FRAMES & COVERS SHALL BE HOT DIP GALVANIZED.
- GRATING:**
6. GRATING TO BE OF STEEL WITH RECTANGULAR TYPE.
  7. LOAD BARS 1 1/2" x 1/2" x 1/8" O.C. WITH CROSS BARS @ 4" O.C.
  8. BANDING BARS TO BE SAME SIZE AS LOAD BARS.
  9. BANDING BARS TO BE SPACED 1/2" MINIMUM FROM LOAD BARS TO PERMIT COMPLETE GALVANIZED COATING.
  10. END BANDING BARS TO BE WELDED TO EVERY FOURTH LOAD BAR WITH A FILLET WELD, ONE SIDE ONLY.
  11. DIRECTION OF GRATING SPAN SHOWN THIS ON PLAN.
  12. GRATING MK 2 AND MK 4 SHALL HAVE TWO (2) SADDLE CLIPS AT SUPPORTS AT EACH END OF GRATING SPAN.
  13. ALL GRATING SHALL BE HOT DIP GALVANIZED AFTER FABRICATION.
  14. ALL MARK NO'S THIS DRAWING TO HAVE PREFIX 108-19E236.

FOR MFR'S DETAILS REFER TO VENETIAN IRON WORKS, INC FILE, TVA CONTRACT 77K71-822230.


SCALE 3/8" = 1'-0"

REMOVED HOLDS		DATE		BY		APPV	
NO.	DATE	BY	APPV	NO.	DATE	BY	APPV
DESIGN: D. TERRELL				CHECK: J. B. BROWN			
DRAWN: J. B. BROWN				SUPERVISOR: J. B. BROWN			
CNO: J. B. BROWN				SUPERVISOR: J. B. BROWN			
SUPV: J. B. BROWN				SUPERVISOR: J. B. BROWN			
SUBMITTED: J. B. BROWN				RECOMMENDED: J. B. BROWN			
APPROVED: J. B. BROWN				APPROVED: J. B. BROWN			
CHATTANOOGA FLOOD PROTECTION MISCELLANEOUS STEEL PUMPING STATION NO. 2 & 3 LADDERS, GRATING & FRAMES SOUTH CHICKAMAUGA CREEK PROJECT TENNESSEE VALLEY AUTHORITY DIVISION OF ENGINEERING DESIGN							
INSPECTED AND APPROVED FOR ISSUE: J. B. BROWN				KNOXVILLE 2-B-77			
PRINT: H				SIZE: F			
NO. OR PROJ. NO.				RECORD DRAWING AS CONSTRUCTED			


A  
B  
C  
D  
E  
F  
G  
H  
J  
K

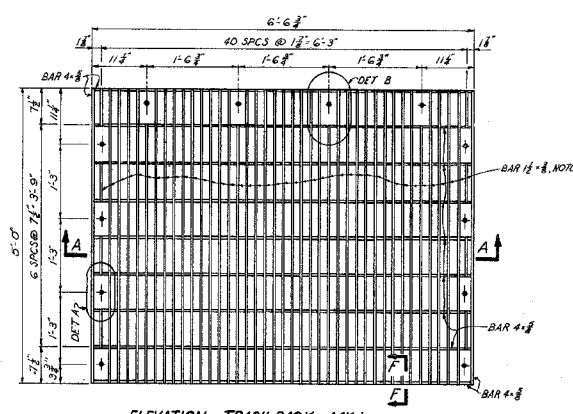


ELEVATION - TRASH RACK - MK 1  
2 REQUIRED  
1'-10"

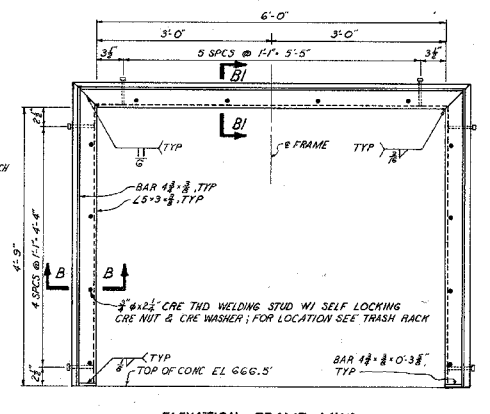


ELEVATION - FRAME - MK 2  
2 REQUIRED  
1'-10"

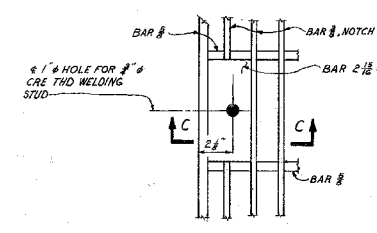


DET A

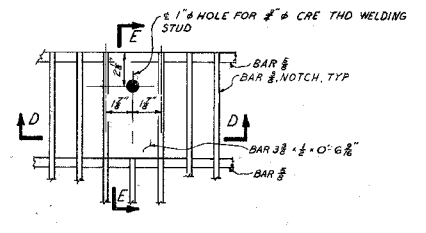


DET B

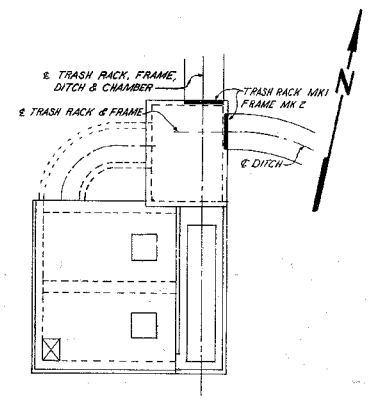


KEY PLAN  
MK 1

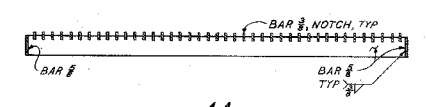


A-A  
1'-10"

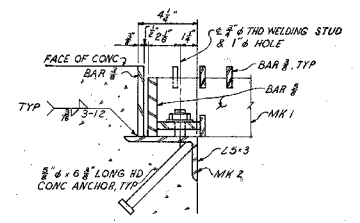


B-B  
B-B SIMILAR

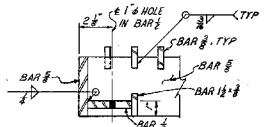


C-C

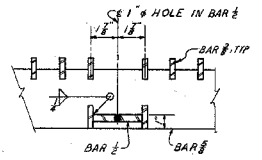

D-D

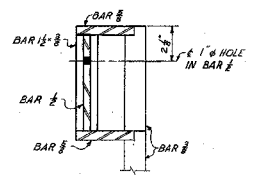

E-E

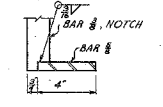

F-F

- NOTES:
1. STRUCTURAL SHAPES, PLATES AND BARS TO BE ASTM A-36.
  2. ALL WELDS BY FABRICATOR TO BE IN ACCORDANCE WITH LATEST AWS CODE.
  3. WELDING ELECTRODES TO BE AWS A5.1 E70 SERIES.
  4. ALL WELDED JOINTS TO BE SEAM WELDED.
  5. CONCRETE HEADED STUD ANCHORS TO BE ASTM A193.
  6. THREADED STUD WELDING FASTENERS SHALL BE KSM PRODUCT INC. STANDARD WELDING STUDS OR EQUAL.
  7. ALL SELF-LOCKING NUTS TO BE ANCO OR EQUAL.
  8. ALL MARK NUMBERS TO HAVE PREFIX 108-19E240.
  9. FOR MANUFACTURER'S DETAILS REFER TO VENETIAN IRON WORKS, INC. FILE TYN CONTRACT NO. 77K71-022230.

SCALE 3/4"=1'-0"  
EXCEPT AS NOTED

CORRECTED DIMENSION MK 1	
DESIGNER	DATE
CHKD	DATE
APP'D	DATE
CHATTANOOGA FLOOD PROTECTION	
STRUCTURAL STEEL	
PUMPING STATION NO. 3	
TRASH RACKS & FRAMES	
SOUTH CHICKAMAUGA CREEK PROJECT	
TENNESSEE VALLEY AUTHORITY	
DIVISION OF ENGINEERING DESIGN	
SUBMITTED	RECOMMENDED
APPROVED	APPROVED
DESIGN PROJECT MANAGER	DATE
KNOXVILLE	2-8-77
108-19E240 R1	
RECORD DRAWING AS CONSTRUCTED	
1-27-81	

INSPECTED AND APPROVED FOR ISSUE	DESIGN PROJECT MANAGER
DATE	DATE
CHKD	APP'D
DATE	DATE
KNOXVILLE	
2-8-77	
108-19E240 R1	
RECORD DRAWING AS CONSTRUCTED	
1-27-81	

108-19E240 R1