



STATE OF TENNESSEE
DEPARTMENT OF TRANSPORTATION
BRIDGE INSPECTION AND REPAIR OFFICE
SUITE 1200, JAMES K. POLK BUILDING
NASHVILLE, TENNESSEE 37243-0338

GERALD F. NICELY
COMMISSIONER

PHIL BREDESEN
GOVERNOR

April 13, 2004

Mr. Frank Sealant
Utility Section
6601 Centennial Blvd.
Nashville, Tennessee 37243-0360

Re: Proposed Sewer Line
Installation Under Subject Bridge
Bridge 19-I0065-10.25
Davidson County

Dear Mr. Sealant;

We are enclosing three copies of the proposed sewer line installation under Interstate 65 in Davidson County. These drawings are marked "APPROVED".

If you have any questions, please contact our office.

Yours truly,

A handwritten signature in black ink, which appears to read "Joseph C. Seger", is written over the typed name "Wayne Seger".

(for)
Wayne Seger
Civil Engineering Manager 2
Bridge Inspection and Repair Office

WS:jcs

Enclosure

cc: Mr. J. C. Scott



GRESHAM
SMITH AND
PARTNERS

Letter of Transmittal

Date: April 7, 2004

GS&P Project No.: 22050.00

To: Mr. Joe Scott
Tennessee Dept. Of Transportation
505 Deadrick Street
James K. Polk Bldg., Suite 1200
Nashville, TN. 37243-0338

Subject:
METRO ASH MONOFILL
Nashville, Tennessee

☒ Attached ☐ Under Separate Cover Sent Via — Courier

☒ Prints ☐ Tracings/Plots ☐ Specifications ☐ Shop Drawings ☐ Copy of Letter ☐ Samples ☐ Correspondence


Copies	Date	Description	For Your Use	As Requested	For Review And Comment	Approved As Submitted	Approved As Noted	Not Approved Revise & Resubmit	Rejected
4	01/28/04	Sheets C7, C8 & C9 for your review and approval			X				

☐ Approval Requested ☐ Please Sign for Approval and Return By

Additional Information: We are seeking your review and subsequent approval. Please forward to Mr. Frank Sealand, TDOT.

Copy J. Repsher
K. Barnhill



Signed: _____

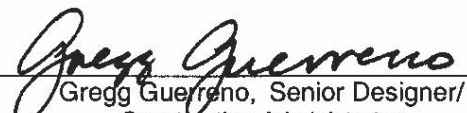
Gregg Guerrero, Senior Designer/
Construction Administrator


If there are any questions regarding the above information, please contact this office.

Design Services For The Built Environment

1400 Nashville City Center / 511 Union Street / Nashville, Tennessee 37219-1733 / Phone 615.770.8100 / www.gspnet.com

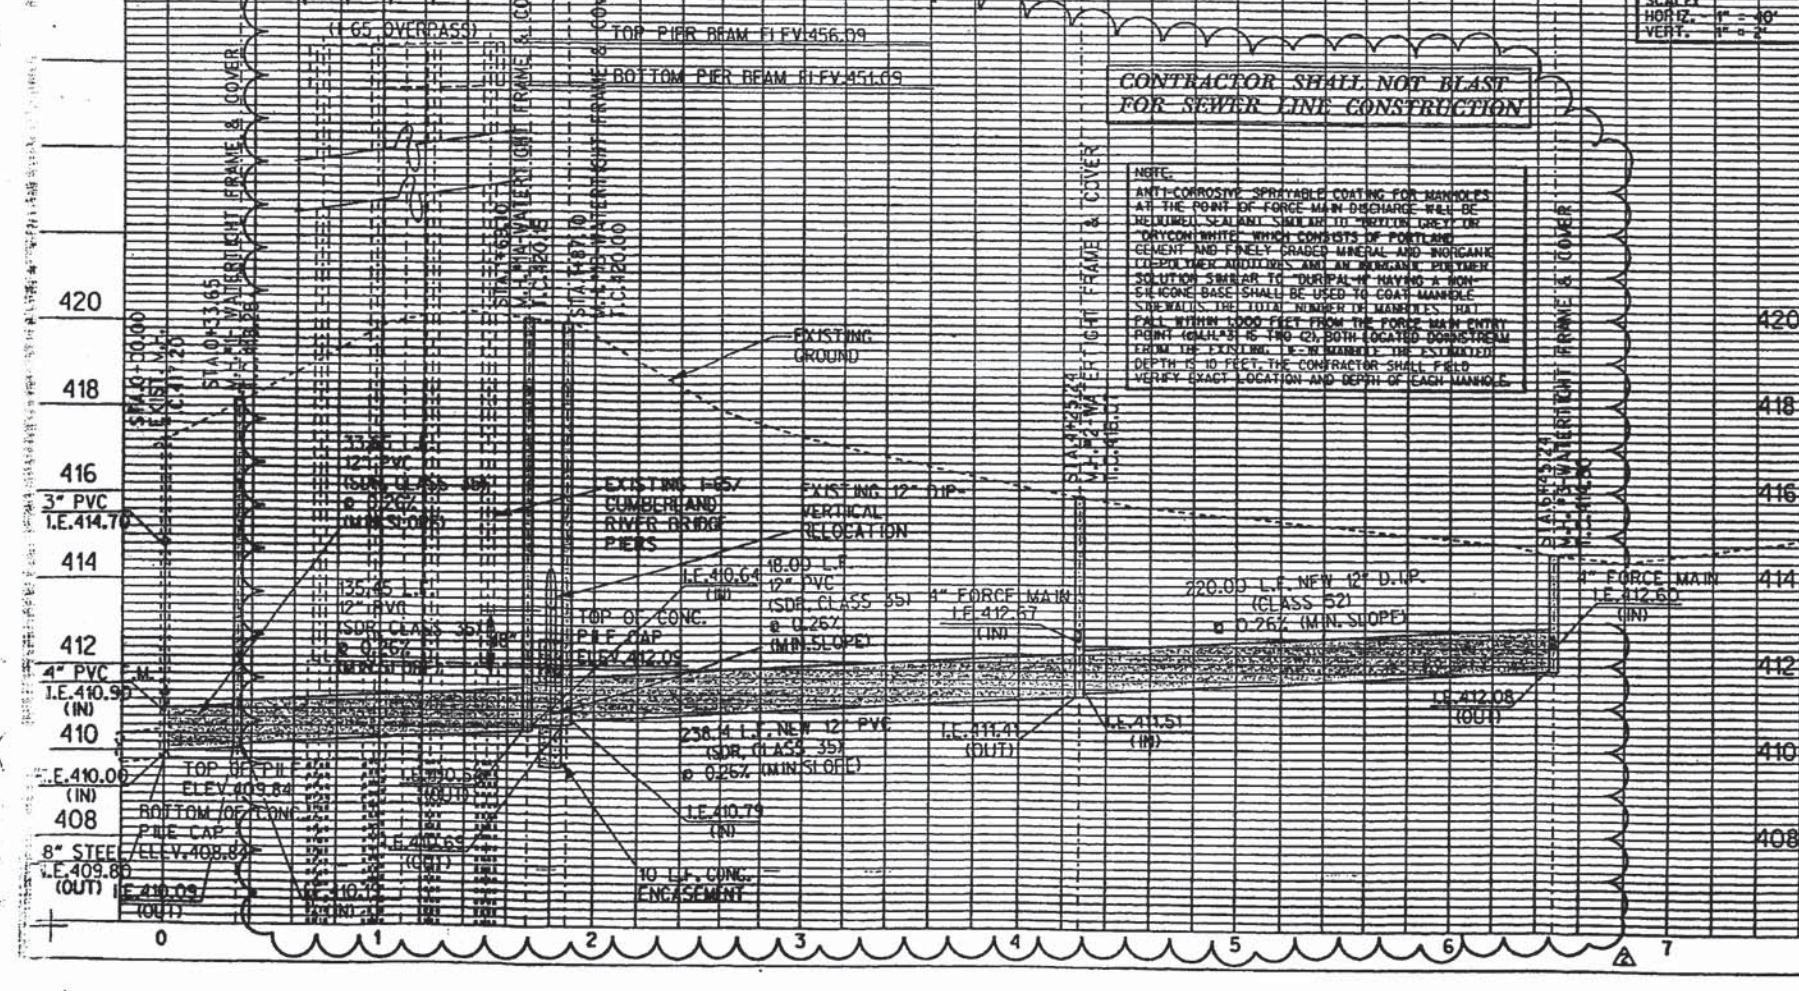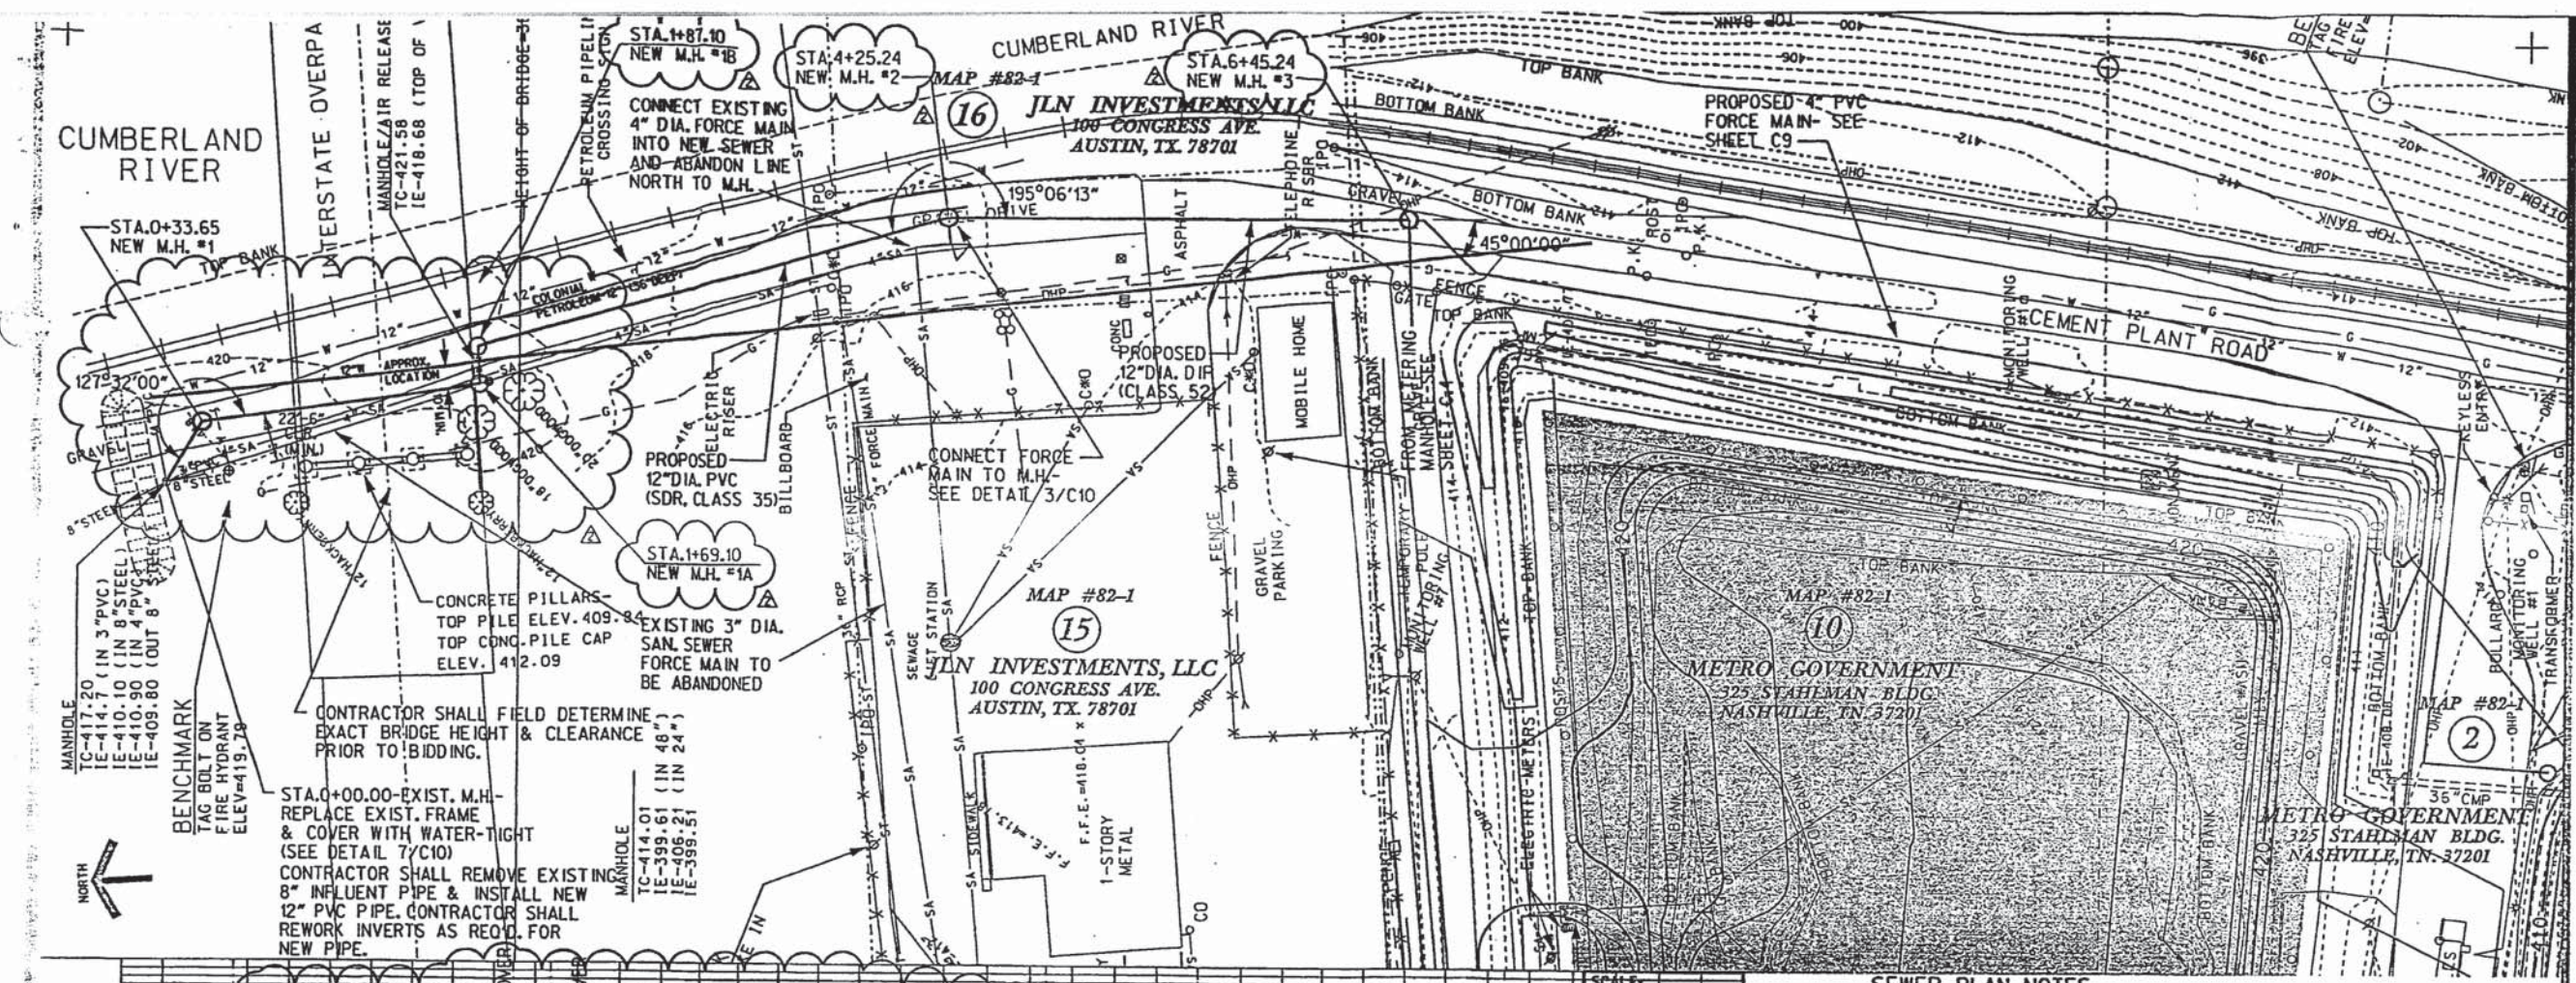

- ### SEWER PLAN NOTES
1. ALL WATER AND SEWER CONSTRUCTION SHALL BE IN ACCORDANCE WITH SPECIFICATIONS OF THE METROPOLITAN DEPARTMENT OF WATER AND SEWER SERVICES.
 2. THE CONTRACTOR IS RESPONSIBLE FOR REIMBURSING THE METROPOLITAN DEPARTMENT OF WATER AND SEWER SERVICES THE COST OF INSPECTION.
 3. THE CONTRACTOR IS TO PROVIDE AND MAINTAIN THE CONSTRUCTION IDENTIFICATION SIGN FOR PRIVATE DEVELOPMENT APPROVED.
 4. AFTER COMPLETION OF THE SANITARY SEWERS, THE DEVELOPER IS RESPONSIBLE FOR THE TELEVISIONING OF THE LINES PRIOR TO FINAL ACCEPTANCE. THE VIDEO TAPING MUST BE COORDINATED WITH THE METRO WATER SERVICES INSPECTION SECTION. ALL COSTS WILL BE BORNE BY THE DEVELOPER.
 5. ALL CONNECTIONS TO EXISTING MANHOLES SHALL BE CORING AND RESILIENT CONNECTOR METHOD.
 6. UPON COMPLETION OF CONSTRUCTION OF WATER AND /OR SEWER, THE ENGINEER SHALL PROVIDE THE DEPARTMENT WITH A COMPLETE SET OF AS-BUILT PLANS OR MOST ERASABLE MYLARS IN REVERSE AND IN DIGITAL DWG FORMAT. SEWER PLANS SHALL BE SEALED BY A SURVEYOR (R/S) AND SHALL INCLUDE ACTUAL FIELD ANGLES BETWEEN LINES, ALL ACTUAL SERVICE LINES AND TEE LOCATIONS, THE DISTANCE OF THE END OF THE SERVICE LINE TO PROPERTY CORNERS AND LINES AND/OR STATION AND OFFSET FROM SEWER CENTERLINE TO END OF SERVICE LINE. THE DEPTH TO TOP OF THE END OF THE SERVICE LINE, AND SHALL REFLECT ALL ALIGNMENT AND GRADE CHANGES. WATER PLANS SHALL BE SEALED BY A LICENSED ENGINEER OR R/S, AND WILL INCLUDE OFFSET DISTANCE FROM THE ROADWAY CENTERLINE OR PROPERTY LINE RIGHT-OF-WAY, LINE DEPTH, LOCATIONS OF HYDRANTS, VALVES, REDUCERS, TEES AND PRESSURE REDUCING DEVICES WHERE APPLICABLE. ALL DRAWINGS MUST BE COMPLETED AND SUBMITTED PRIOR TO ACCEPTANCE OF THE SEWERS OR WATER MAINS INTO THE PUBLIC SYSTEM AND ANY CONNECTIONS BEING MADE THERE TO.

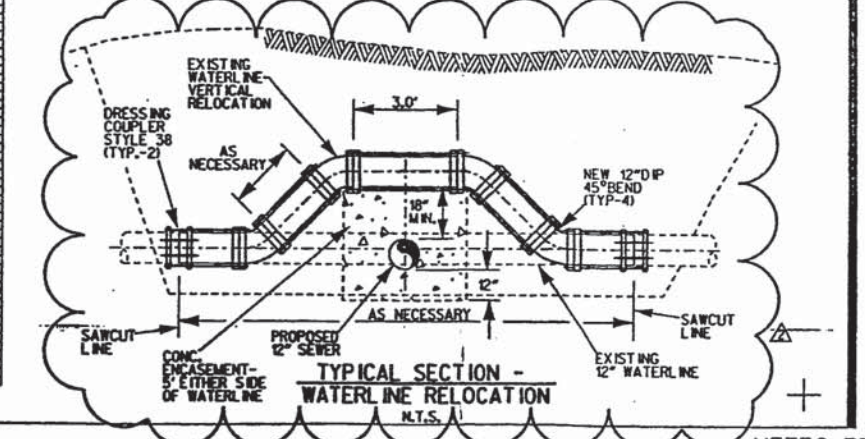

G S & P

Design Services
For The Built Environment

Atlanta
Birmingham
Charlotte
Dallas
Fort Lauderdale
Jacksonville
Louisville
Nashville
Richmond
Silver Spring
Tampa


GRESHAM SMITH AND PARTNERS

1480 Nashville City Center
511 Union Street
Nashville, Tennessee 37219
615.776.8188
WWW.GSPNET.COM

CONSTRUCTION PLANS FOR

METRO THERMAL ASH MONOFILL CLOSURE

FOR THE
METROPOLITAN GOVERNMENT
OF NASHVILLE AND DAVIDSON
COUNTY, TENNESSEE
DEPARTMENT OF PUBLIC WORKS

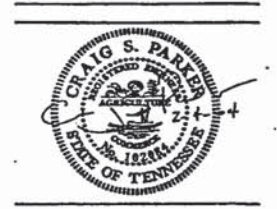

REVISION		
No.	Date	Revision
1	08-26-03	MISC. REVISIONS
2	01-28-04	MISC. REVISIONS

SANITARY SEWER PLAN & PROFILE

C.7

FILE: 02200041000000.dwg
PROJECT: 220000.00
DATE: 08.19.02

METRO PROJECT NO. 02-SL-201



Design Services
For The Built
Environment

Atlanta
Birmingham
Charlotte
Dallas
Fort Lauderdale
Jacksonville
Louisville
Nashville
Richmond
Silver Spring
Tampa

GRESHAM
SMITH AND
PARTNERS
1400 Nashville City Center
511 Union Street
Nashville, Tennessee 37215
615-259-8188
WWW.GSPNET.COM

CONSTRUCTION
PLANS
FOR

METRO THERMAL ASH MONOFILL CLOSURE

FOR THE
METROPOLITAN GOVERNMENT
OF NASHVILLE AND DAVIDSON
COUNTY, TENNESSEE
DEPARTMENT OF PUBLIC WORKS



REVISION

No.	Date	Revision
1	08-26-03	MISC. REVISION
2	02-03-04	MISC. REVISION

SANITARY SEWER
PLAN & PROFILE

C.8

FILE: 22080-08
PROJECT: 02-SL-2
DATE: 09.19.02

METRO PROJECT NO. 02-SL-2

