GIRDER 423A

1-PL-12x5/8x1'-0 1/2-ab(FILL)<T

1-PL-12x5/8x10'-0-b

1-PL-12x1'2x48'-6-c

NO PAINT TOP OF TOP FLG.

1-PL-12x1'8x47'-6-g

1-PL-12x1x11'-0-f

1-PL12x1/4x1'-0 1/2-aa(FILL)<T

1-PL-12x1x10'-0 3/16-d

1-PL-12x1x10'-0-h

1-PL-12x1x1-aa(FILL)

1-BR-5x3/8x4'-11-K

1-BR-5x3/8x4'-11-ah

1-WEB PL 61 3/8x3/8x68'-6 3/16-a

1-PL-12x1'8x2'-1 1/2-n
14-325 7/8"ø x 5 3/4 (FULLY TORQED)
14-HW

2-PL-13x3/8x4'-7 1/2-m
28-325 7/8"ø x 2 1/2 (FINGER TIGHT)
28-HW

1-BR 5'4x1'4x2'-1 1/2-p

1-PL-12x1 1/8x2'-1 1/2-n
14-325 7/8"ø x 5 3/4 (FULLY TORQED)
14-HW

10'-0

48'-6

10'-0 3/16

5'-0

13@4'-4 = 4'-4

3'-9 1/16 | 5@3'-9 = 18'-9 | 4'-6 1/16 | 4@4'-6 = 18'-0 | 5@3'-9 = 18'-9 | 2'-3 1/8

2'-5 3/4 | 22'-6 1/16 | 22'-6 1/16 | 21'-0 1/8 | -1/16 +0

11'-0 | 47'-6 | 10'-0

68'-6 END TO END @ BOTT. FLG. -1/8 -1/8

COMP. SEE GN1

MT

AT

RA

P

m

2-P

aa

ah

K

SEC. "A-A"

SEC. "B-B"

(TYP. FOR INTERMEDIATE STIFF.)

CAMBER DIAGRAM

90°

45°

BOTT. OF WEB PL.

34'-3 | 34'-3

68'-6

3/16

For location of details shown on this sheet refer to diagram.

E402

F LINE
SPAN E11

INST.	S2	NO.	DESCRIPTION	MARK	REMARKS
		1	1	GIRDER	423A	5'-6x1'-0x68'-6

REQUIRED LIST

NOTE:

CLIP ALL STIFF. AS SHOWN 3/4" BY 3/4"

FOR OTHER NOTES SEE GN1

MATERIAL - ASTM-A36

RIVETS OR BOLTS - 7/8"ø-325

OPEN HOLES - 15/16"ø

A325 FIELD BOLTS

SHOP CONTACT SURFACES - N.P.

WELDING - AS NOTED

PAINT - 1 COAT TT-P-615d TYPE II U.N. - SEE NOTE "X"

NOTE X

BOTH SIDES OF MATERIAL ADJACENT TO ALL OPEN HOLES MUST BE FREE OF BURRS, LOOSE SCALE AND PAINT, FOR A DISTANCE OF 3 INCHES FROM THE GROUP OF HOLES.

CUSTOMER: TENNESSEE DEPT. OF HIGHWAYS
ARKANSAS STATE HIGHWAY COMMISSION

STRUCTURE: EAST APPROACH - MISS. RIVER BRIDGE
PROJ. I-40-1(116)0 - MEMPHIS - TENN.

BETHLEHEM STEEL CORPORATION
FABRICATED STEEL CONSTRUCTION
LEETSDALE WORKS

CHICAGO DRAFTING ROOM
MADE BY GCY DATE IN CHARGE FJK
CHECKED BY [illegible] DATE 2-5-71 SHOP NO. 1

CONTRACT CE 6472-000 DRAWING NO. 423

REVISION: NO | DATE | INIT

SUBMITTAL DATE

M-48-28(2)

GIRDER 424A

1-PL-12x1x1'-0½-a a(FILL) <T

1-PL-12x1x10'-0-b

1-PL-12x1'2x36'9-c

No PAINT TOP OF TOP FLG.

1-PL-12x1x10'-0-f

1-PL-12x5/8x45'-8 15/16-g

1-PL-12x1x10'-0-aa(FILL) <T

1-PL-12x1'4x10'-0-aa(FILL)

1-PL-12x5/8x10'-0-af

1-PL-12x1'4x10'-0 8/16-d

1-PL-12x1'4x10=11'-11 15/16-h

1-PL-12x1'8x2'-1½-n
14-325 7/8"Øx6¼ (FULLY TORQED)
14-HW

2-PL-13x3/8x4'-7½-m
28-325 7/8"Øx2½ (FINGER TIGHT)
28-HW

1-BR-5x3/8x4'-11-a h

1-WEB PL 61/4x3/8x66'-1 9/16-a

1-BR-5x3/8x4'-11-FS-K

1-BR-5x3/8x4'-11-NS-ad

K-FS
ad-NS

5'-0

13@4=4'-4

1'-10 7/8

5@3'-6=17'-6

4'-6 1/16

4@4'-6=18'-0

3'-9 1/16

5@3'-9=18'-9

2'-4

19'-4 7/8

22'-6 1/16

22'-6 1/16

10'-0

45'-9

11'-0

66'-9 END TO END @ BOTT. FLG.

Comp. SEE GN1

RT

MT

S1

S2

RA

P

M

aa

ab

ah

ad

K

Typ.

Typ. For Intermediate Stiff.

Clip All Stiff. As Shown 3/4"Bx3/4"

For Gen Notes See GN1

Sec. "A-A"

Sec. "B-B"

Tight Fit

Camber Diagram

33'-4½ 33'-4½ 66'-9

90°

Bott. of Web Pl.

1'-4½ 1'-4 1'-4½ 1'-9 1'-4½ 1'-4

1'-0 11/16

11/16

Note X

BOTH SIDES OF MATERIAL ADJACENT TO ALL OPEN HOLES MUST BE FREE OF BURRS, LOOSE SCALE AND PAINT, FOR A DISTANCE OF 3 INCHES FROM THE GROUP OF HOLES.

Note:

MATERIAL - ASTM-A36

RIVETS OR BOLTS - 7/8"Ø - A325

OPEN HOLES - 15/16"Ø

A325 FIELD BOLTS

SHOP CONTACT SURFACES - N.P.,
WELDING - AS NOTED

PAINT - 1 COAT TT-P-615d, TYPE II
U.N. - SEE NOTE X"

E LINE
SPAN E11

INST.	S2	NO.	DESCRIPTION	MARK	REMARKS
		1	1 GIRDER	424A	x1'0x

REQUIRED LIST

CUSTOMER: TENNESSEE DEPT. OF HIGHWAYS
ARKANSAS STATE HIGHWAY COMMISSION
STRUCTURE: EAST APPROACH - MISS. RIVER BRIDGE
PROJ. I-40-1(116)0 - MEMPHIS - TENN.

BETHLEHEM STEEL CORPORATION
FABRICATED STEEL CONSTRUCTION
LEETSDALE WORKS

MADE BY GCY DATE IN CHARGE FJK
CHECKED BY Hab DATE 2-8-71 SHOP NO.

CONTRACT CE G472-000 DRAWING NO. 424

REVISION: 4-5-71 Hab

SUBMITTAL / DATE

For location of details shown on this sheet refer to diagrams.

E402

MICROFILMED

36663 11-67

11-48-2

NO PAINT TOP OF TOP FLANGE

1-aa. (FILL) ⊄

1-PL-12x1x10'-0-f

1-PL 12x1x1'-0 1/2 aa. (FILL) ⊄

1-PL-12x1x10'-0-b

1-PL-12x1 5/8x42'-2 15/16-c

1-PL-12x1 5/8x10'-0-h

1-PL-12x1 1/4x10'-0 1/16-5.3

1-PL-12x1 1/4x10'-11 15/16-d

1-PL-12x1 1/4x10'-0 1/16 sec (FILL)

1-aa (FILL) ⊄

1-PL-12x1'2x33'-3-g

Comp. SEE GN1

Comp. SEE GN1

Comp. SEE GN1

1-PL-12x1 1/8x2'-1 1/2-m
14-.325 7/8"ø x6 1/4 (FULLY TORQED)
14-HW

2-PL-13x3/4x4'-7 1/2-m
28-.325 7/8"ø x 2 1/2 (FINGER TIGHT)
28-HW

2-P

2-S

1-m

1-BR 5x3/8x4'-11-ah

1-BR 5x3/8x4'-11-HNS
1-BR 5x3/8x4'-11-ad-FS

1-ab

HN-NS
ad-FS

ah

5'-0

13@4=4'-4

RA

aa

Typ

P

1-aa. (FILL) ⊄ 6 1/16x3/8x63'-3 1/16-a

5/16

3/4 60° G

3/8 60° G

RT

MT

2 1/2

1

B

A

1'-2 13/16 | 3'-6 | 3'-6 | 11'-3 | 4@4'-6=18'-0 | 4'-6 1/16 | 11'-3 | 5@3'-9=18'-9 | 3'-9 1/16 | 2'-10 | 2'-10 | 2'-10 | 1'-6 1/16

8'-2 13/16 | 22'-6 1/16 | 22'-6 1/16 | 10'-0 1/16

10'-0 | 42'-3 | 11'-0

63'-3 END TO END @ BOTT. FLG.

-1/16 +0

-1/8

RA

aa

1-BR 5 1/4x1'4x2'-1 1/2-p

1-PL-12x1 1/8x2'-1 1/2-n
14-.325 7/8"ø x6 1/4 (FULLY TORQED)
14-HW

1-PL 12'2x3/8x2'-0 1/4-ab

GIRDER 426A

WP

12 | 11/4

Typ 1/4

3 | 3 | 6 1/2 | 1'-0 1/8 | 1'-0 1/8 | 6 1/2 | 3 | 3

SEC. "A-A"

SEC. "B-B"

Typ. Intermediate Stiff)

5'-0

4'-11

Typ.-U.N.

ah

K

ad

2'-9 1/2

2'-1 1/4

5 3/32

3 11/16 | 3 1/16 | 3 2/32 | 3 2/32 | 3 3/32 | 3 3/32 | 5 3/32

TIGHT FIT

CAMBER DIAGRAM

90°

1/16

Bott. of Web PL.

31'-7 1/2 | 31'-7 1/2

63'-3

-1/8 | -1/8

ELECTRODES - E70XX LOW HYDROGEN

NOTE "X"

BOTH SIDES OF MATERIAL ADJACENT TO ALL OPEN HOLES MUST BE FREE OF BURRS, LOOSE SCALE AND PAINT, FOR A DISTANCE OF 3 INCHES FROM THE GROUP OF HOLES.

NOTE

CLIP ALL STIFF. AS SHOWN 3/4 by 3/4

FOR GEN NOTES SEE GN1

MATERIAL - ASTM-A36

~~RIVETS OR~~ BOLTS 7/8"ø - A325

OPEN HOLES 15/16

A325 FIELD BOLTS -

SHOP CONTACT SURFACES - N.P.

WELDING - AS NOTED

PAINT - 1 COAT TT-P 615d TYPE II U.N - SEE NOTE "X"

LINE C
SPAN E11

	1	1	GIRDER	426A	5'-6x1'-0x64'-6
INST.	S2	NO.	DESCRIPTION	MARK	REMARKS
			REQUIRED LIST		

CUSTOMER: TENNESSEE DEPT. OF HIGHWAYS
ARKANSAS STATE HIGHWAY COMMISSION

STRUCTURE: EAST APPROACH - MISS. RIVER BRIDGE
PROJ. I-40-1(116)0 - MEMPHIS - TENN.

BETHLEHEM STEEL CORPORATION
FABRICATED STEEL CONSTRUCTION

CHICAGO DRAFTING ROOM LEESDALE WORKS
MADE BY GCY DATE IN CHARGE FJK
CHECKED BY Hab DATE 2-17-71 SHOP NO.
CONTRACT CE 6472-000 DRAWING NO. 426

REVISION: 1 4-5-71 Hab (NO | DATE | INIT.)

SUBMITTAL / DATE: 1 2 3 4 5 6 7 8 9 0

For location of details shown on this sheet refer to diagrams: E402

24663 11-69

11-48-31 (12)

GIRDER 427A

NO PAINT TOP OF TOP FLANGE

1-aa (FILL)

1-PL-12x1x10'-0-b

1-PL-12x1'2x31'-3-c

1-PL-12x5/8x10'-0-d

1-PL-12x1'4x10'-0 3/8-f

1-PL-12x1'4x10'-0-e

1-PL-12x1'4x9'-11 15/16-s

1-PL 12x1x1'-0 2aa (FILL)

1-PL-12x1x10'-0-g

1-PL-12x1 5/8x41'-2 15/16-h

1-BR 5x3/8x4'-11-a h

1-BR 5x3/8x4'-11-W-F5

1-BR 5x3/8x4'-11-K-NS

1-BR 5x3/8x4'-11-Y-F5

1-BR 5x3/8x6'-6 5/16-a

1-aa

1-ab

1-ad

2-P

1-PL-13x3/4x9'-7 1/2-m

28-325 7/8"ø x 2 1/2 (FINGER TIGHT)

28-HW

1-PL-12x1'4x1'-4 2aa (FILL)

1-PL-12x1 1/8x2'-1 1/2-n

14-325 7/8"ø x 64 (FULLY TORQED)

14-HW

1-BR 5/4x1/4 x 2'-1 1/2-p

1-PL-12x1 1/8x2'-1 1/2-n

14-325 7/8"ø x 64 (FULLY TORQED)

14-HW

1-PL 17x3/8x2'-8 1/2-ab

1-PL 17x3/8x2'-9 1/2-ad

Comp. SEE GN1

5'-0

13@4=4'-4

10@5 3/8=4'-5 3/4

2'-9 1/16

2'-7 9/16

2'-7 4

4'-11

TYP. UN

TIGHT FIT

SEC. "A-A"

SEC. "B-B"

SEC. C-C

SEC. D-D

SIMILAR

IN SEC. C-C & D-D

SEC. B-B

SEC. C-C

SEC. D-D

IN SEC. B-B

E-SEC. B-B

W-SEC. C-C

V-SEC. D-D

4@4'-6=18'-0

4'-6 1/16

5@3'-9=18'-9

3'-9 1/16

5 1

4@3'-1 3/4=12'-7

1'-3 1/16

2'-4 13/16

22'-6 1/16

41'-3

61'-3

10'-0

13'-10 1/16

+0 -1/16

-1/8

CAMBER DIAGRAM

30'-7 1/2

BOTT. OF WEB PL.

90°

5/16

LINE B

SPAN E11

INST.	S2	1	1	GIRDER	427A	
		NO.		DESCRIPTION	MARK	REMARKS
		REQUIRED LIST				

NOTE

CLIP ALL STIFF. AS SHOWN 3/4 by 3/4

FOR GEN NOTES SEE GN1

MATERIAL - ASTM-A36

RIVETS OR BOLTS 7/8"ø - A325

OPEN HOLES 15/16"ø

A325 FIELD BOLTS -

SHOP CONTACT SURFACES - N.P.

WELDING - AS NOTED

PAINT - 1 COAT TT-P 615d TYPE II U.N. SEE NOTE "X" S

ELECTRODES - E70XX LOW HYDROGEN

NOTE "X"

BOTH SIDES OF MATERIAL ADJACENT TO ALL OPEN HOLES MUST BE FREE OF BURRS, LOOSE SCALE AND PAINT, FOR A DISTANCE OF 3 INCHES FROM THE GROUP OF HOLES.

For location of details shown on this sheet refer to diagrams.

E402

CUSTOMER: TENNESSEE DEPT. OF HIGHWAYS / ARKANSAS STATE HIGHWAY COMMISSION

STRUCTURE: EAST APPROACH - MISS. RIVER BRIDGE

PROJ. I-40-1(116)0 - MEMPHIS - TENN.

BETHLEHEM STEEL CORPORATION

FABRICATED STEEL CONSTRUCTION

CHICAGO DRAFTING ROOM LEETSDALE WORKS

MADE BY GCY DATE IN CHARGE FJK

CHECKED BY [illegible] DATE 2-18-71 SHOP NO.

CONTRACT CE G472-000 DRAWING NO. 427

REVISION NO 1 DATE 4-5-71 INIT. Wb

SUBMITTAL DATE

36663 11-68

MICROFILMED

11-18-82 (12)

NO PAINT TOP OF TOP FLANGE

1-Pl-12x1'2x61'-8-a

1-Pl 12x1⅝x51'-11½-b

1-Pl 12x1⅝x9'-11½-c

1-Pl 12x1⅝x1'-0(Fill)-aa

1-Pl-12x1⅛x2'-1½-m
14-325 ⅞ø x 5¾ (FULLY TORQED)
14-HW

2-Pl-13x⅜x4'-7½-m
28-325 ⅞ø x 2½ (FINGER TIGHT)
28-HW

1-Pl 12x1⅛x1'-0½ab(Fill)

1-WEBPL 6⅛x⅜x62'-1 — K

1-BR 5x⅜x9'-11-ah

1-BR 5x⅜x4'-11½-g-NS
1-BR 5x⅜x4'-11½-f-FS

1-BR 5¼x1¼x2'-1½-p

1-Pl-12x1⅛x2'-1½-n
14-325 ⅞ø x 5¾ (FULLY TORQED)
14-HW

1-Pl-12x⅜x4'-9-as-NS
1-Pl-12x⅜x4'-9-at-FS
(FULLY TORQED)

4 @ 4'-6 = 18'-0
4'-6⅛
3'-9
4 @ 3'-9⅛ = 15'-0¼
3'-9
5 @ 3'-1½ = 15'-7½
1'-3⅝

22'-6⅛
22'-6
16'-11⅛
10'-0
51'-6
61'-11⅞

SEC D-D

SEC. "A-A" (TYP INTER. STIFF)

SEC. "B-B" SEC. C-C (SIMILAR)

CAMBER DIAGRAM

ELECTRODES - E70XX LOW HYDROGEN

NOTE "X"

BOTH SIDES OF MATERIAL ADJACENT TO ALL OPEN HOLES MUST BE FREE OF BURRS, LOOSE SCALE AND PAINT, FOR A DISTANCE OF 3 INCHES FROM THE GROUP OF HOLES.

NOTE

CLIP ALL STIFF. AS SHOWN ¾ by ¾

FOR GEN NOTES SEE GN1

MATERIAL - ASTM-A36
~~RIVETS OR~~ BOLTS ⅞"ø-A325
OPEN HOLES 15/16ø
A325 FIELD BOLTS -
SHOP CONTACT SURFACES - N.P.
WELDING - AS NOTED
PAINT - 1 COAT TT-P 615d TYPE II UN- SEE NOTE "X"

LINE A'
SPAN E11

INST.	S2	NO.	DESCRIPTION	MARK	REMARKS
		1	1 GIRDER	428A	
			REQUIRED LIST		

NO	DATE	REVISION	INIT.
1	4-5-71	Web	

SUBMITTAL DATE 1 2 3 4 5 6 7 8 9 0

CUSTOMER TENNESSEE DEPT. OF HIGHWAYS
ARKANSAS STATE HIGHWAY COMMISSION
STRUCTURE EAST APPROACH - MISS. RIVER BRIDGE
PROJ. I-40-1(116)0 - MEMPHIS - TENN.

BETHLEHEM STEEL CORPORATION
FABRICATED STEEL CONSTRUCTION

CHICAGO DRAFTING ROOM LEETSDALE WORKS
MADE BY GCY DATE IN CHARGE FJK
CHECKED BY Web DATE 2-19-71 SHOP NO.
CONTRACT CE G472-000 DRAWING NO. 428

For location of details shown on this sheet refer to diagrams
E402

MICROFILMED

36663 11-69

M-48-3(12)

NO PAINT TOP OF TOP FLANGE

10'-0 | 42'-0¼ | 10'-0 3/16

1-Pl 12x1x1'-0½ ac (FILL) <T

1-Pl-12x1⅛x10'-0-b

1-Pl-12x1⅛x10'-0 3/16-d

1-Pl-12x9/16x42'-0¼-c

comp. SEE GN1

5/16 60°

5/16

(MT)

(RT)

5'-0

13@4'-4

4 | 4

1-MEA 8.6 0.16 x 5 3/8 x 62'-0 1/6-a

1-BR 5 3/8 x 4'-11-ah

1-BR 5 3/8 x 4'-11-aK

1-BR 5 3/8 x 4'-11-am

1-Pl-12x1⅛x4'-11 ac (FILL)

1-Pl-12x1⅛x9'-11 15/16-f

1-Pl-12x1⅝x42'-0⅛-g

1-ac (FILL) <T

S1

S2

1'-5 13/16 | 4@4'-5 3/4 = 17'-11 | 5@3'-9¼ = 18'-10¼ | 3'-8 5/16 | 5@3'-9 = 18'-9 | 1'-3 7/8

19'-4 13/16 | 22'-6 1/16 | 20'-0 7/8

10'-0 | 42'-0¼ | 10'-0

62'-0¼

-⅛ | -⅛

RA | P

1-Pl-12x1⅛x2'-1½-n
14-.325 7/8"ø x 5 3/4 (FULLY TORQED)
14-HW

2-Pl-13x3 3/4x4'-7½-m
28-.325 7/8"ø x 2½ (FINGER TIGHT)
28-HW

2-P | n

1-Pl-12x1⅛x4'-11 ac (FILL)

1-BR 5¼x1¼x2'-11½-P

1-Pl-12x1⅛x2'-1½-n
14-.325 7/8"ø x 5 3/4 (FULLY TORQED)
14-HW

aK

am

12

SEC. "A-A"

(TYP. INTER. STIFF.)

SEC. "B-B"
SEC. C-C

TYP-UN

ah

aK-SEC. B-B
am-SEC. C-C

2'-9⅝ | 2'-9½ | 4'-11

CAMBER DIAGRAM

90°

BOTT. OF WEB PL.

31'-0⅛ | 31'-0⅛

62'-0¼

3/16

-⅛ | -⅛

For location of details shown on this sheet refer to diagrams

E402

ELECTRODES - E70XX
LOW HYDROGEN

NOTE "X"

BOTH SIDES OF MATERIAL ADJACENT TO ALL OPEN HOLES MUST BE FREE OF BURRS, LOOSE SCALE AND PAINT, FOR A DISTANCE OF 3 INCHES FROM THE GROUP OF HOLES.

NOTE

CLIP ALL STIFF. AS SHOWN ¾ by ¾

FOR GEN NOTES SEE GN1

MATERIAL - ASTM-A36
~~RIVETS OR~~ BOLTS 7/8"ø - A325
OPEN HOLES 15/16"ø
A325 FIELD BOLTS -
SHOP CONTACT SURFACES - N.P.
WELDING - AS NOTED
PAINT - 1-COAT T-P 615d TYPE II U.N. - SEE NOTE "X" S

LINE A
SPAN E11

1	1	GIRDER	429A	
S2	NO.	DESCRIPTION	MARK	REMARKS
INST.	REQUIRED LIST			

REVISION

NO	DATE	INIT
1	4-5-71	Hab

SUBMITTAL DATE | 1 2 3 4 5 6 7 8 9 0

CUSTOMER TENNESSEE DEPT. OF HIGHWAYS
ARKANSAS STATE HIGHWAY COMMISSION
STRUCTURE EAST APPROACH - MISS. RIVER BRIDGE
PROJ. I-40-1(116)0 - MEMPHIS - TENN.

BETHLEHEM STEEL CORPORATION
FABRICATED STEEL CONSTRUCTION

CHICAGO DRAFTING ROOM EASTSDALE WORKS
MADE BY GCY DATE IN CHARGE FJK
CHECKED BY Hab DATE 2-19-71 SHOP NO.
CONTRACT CE 6472-000 DRAWING NO. 429

36663 11-69

MICROFILMED

M-48-34 (12)

NO PAINT TOP OF TOP FLG.

1-Fill 12×1×1'-0½-S TACK WELD

1-PL 12×1⅛×9'-11⅞-b

1-PL 12×9/16×59'-7⅞-c

1-Fill -S TACK WELD

1-PL 12×1⅛×11'-0-d

1-PL 12×1×15'-10-g

1-Bar 5×⅜×4'-11-h

1-Bar 5×⅜×4'-11-k

1-Web PL 61⅜×⅜×69'-8¾-a

1-Bar 5×⅜×4'-11-t

1-PL 12×1¾×42'-10⅝-f

1-Bar ah

1-Bar 5½×⅜×5'-0½ (M.S.) (-n) (M.E.) (-p)

1-Sole PL.* 402C Det. on Sht.* 402

RA

5'-0

13@4=4'-4

5@3'-9=18'-9

5@4'-6⅜=22'-6⅝

5@4'-2⅝=20'-10⅝

2'-6⅛ 2'-10⅜ ℄ BRG.

21'-3⅞ 22'-6⅝ 25'-10⅛

11'-0⅛ 42'-10⅛ 15'-10

68'-10⅞

69'-8¾ % Bot. Flg.

9⅞

GIRDER - 403A

SPAN E12 - LINE A

CAMBER DIAGRAM

INST.	SI	NO.	DESCRIPTION	MARK	REMARKS
	1	1	GIRDER	403A	5-5½×⅞×69'-7
			REQUIRED LIST		

SEC. A-A (TYP. INTER STIFF.)

SEC. "B-B" SEC. D-D

SEC. "C-C"

For location of details shown on this sheet refer to diagrams

E402

NOTE

¾"×¾" CLIP ALL STIFF. AS SHOWN

ELECTRODES - E70XX LOW HYDROGEN

FOR GENERAL NOTES SEE GN1

NOTE X

Both sides of material adjacent to all open holes must be free of burrs, loose scale, and paint for a distance of 3" from the group of holes.

MATERIAL ASTM-A36

RIVETS OR BOLTS

OPEN HOLES 15/16"ø

A325 FIELD BOLTS

SHOP/CONTACT SURFACES N.P

WELDING: AS NOTED

MILLING: AS NOTED

PAINT

1 Coat TT P 615d Type II

U.N. See Note "X"

NO	DATE	INIT.	REVISION
3	4-5-71	Hab	
2	3-15	K	

SUBMITTAL DATE 1 2 3 4 5 6 7 8 9 0

CUSTOMER TENNESSEE DEPT. OF HIGHWAYS / ARKANSAS STATE HIGHWAY COMMISSION

STRUCTURE EAST APPROACH - U.S. RIVER BRIDGE

PROJ. I-40 1(11)6 - MEMPHIS - TENN.

BETHLEHEM STEEL CORPORATION

FABRICATED STEEL CONSTRUCTION

LEETSDALE WORKS

CHICAGO DRAFTING ROOM MADE BY E.D. DATE 1-13-71 IN CHARGE FJK

CHECKED BY Hab DATE 2-12-71 SHOP NO.

CONTRACT CEG472-000 DRAWING NO. 403

36663 11-68

11-48-8 (14)

MICROFILMED

No Paint Top of Top Flg.

68'-4 13/16

1-PL 12 x 1/2 x 68'-4 13/16 - b

1-FILL 12 x 1 5/8 x 1'-0 - g (TACK WELD)

1-FILL 12 x 1 x 1'-6 1/2 - V (TACK WELD)

1-PL 12 x 1 1/8 x 11'-0 - c

1-PL 12 x 1 3/4 x 42'-10 1/2 - d

1-PL 12 x 1 x 14'-7 5/8 - f

1-Sole PL # 402C Det on Sht. #402

1-Web PL 6 5/8 x 3/8 x 68'-4 - a

1-Bar 5 x 3/8 x 4'-11 - h

1-Bar 5 x 3/8 x 4'-11 1/2 (N.S.) - k (F.S.) - p

1-Bar 5 x 3/8 x 4'-11 - m (N.S.) - s (F.S.)

1-Bar 5 1/2 x 3/4 x 5'-0 1/8 - w (N.S.) - t (F.S.)

1-Bar ah

5'-0

13@4 = 4'-4

RA

3'-9 1/4 | 5@3'-9 = 18'-9 | 4@4'-6 = 18'-0 | 4@4'-2 1/2 = 16'-10 | 2'-0 | 2'-10 15/16 ± Bag.

1'-9 7/16 | 22'-6 1/4 | 22'-6 1/4 | 21'-8 5/16 | 9 3/4

11'-0 1/16 | 42'-10 9/16 | 14'-7 5/8

67'-8 1/2

68'-6 1/4 % Bott. Flg.

GIRDER - 404A

Camber Diagram

90°

1 5/16 | 33'-10 1/4 | 33'-10 1/4 | 9 3/4 ± Brg.

68'-6 1/4

1 - 1 3/8

Pier # E12 - Line A'

Sec. A-A (Typ. Inter. Stiff.)

Sec. "B-B"

Sec. D-D

Sec. F-F

Sec. "C-C"

MILL TO BEAR

TIGHT FIT

For location of details shown on this sheet refer to diagrams

E402

NOTE

3/4" x 3/4" CLIP ALL STIFF. AS SHOWN

ELECTRODES - E70XX LOW HYDROGEN

FOR GENERAL NOTES SEE GN1

NOTE X

Both sides of material adjacent to all open holes must be free of burrs, loose scale, and paint for a distance of 3" from the group of holes.

	1	1	GIRDER	404A	5'-2 x 11'-0 x 68'-5
SI	NO.	DESCRIPTION	MARK	REMARKS
INST.	REQUIRED LIST			

MATERIAL ASTM - A36

RIVETS OR BOLTS

OPEN HOLES 15/16" ϕ

A325 FIELD BOLTS

SHOP CONTACT SURFACES N.P.

PAINT

WELDING } As Noted

MILLING }

(Paint Shop Note "X")

SUBMITTAL 1 2 3 4 5 6 7 8 9 0

DATE

REVISION

NO | DATE | INIT

1 | 4-5-71 | Mab

CUSTOMER

TENNESSEE DEPARTMENT OF HIGHWAYS


STRUCTURE EAST [illegible] BRIDGE

PROJECT [illegible] - TENN.

BETHLEHEM STEEL CORPORATION

FABRICATED STEEL CONSTRUCTION

CHICAGO DRAFTING ROOM LEETSDALE WORKS

MADE BY E.O. DATE 1-15-71 IN CHARGE FJK

CHECKED BY MKO DATE 2-16-71 SHOP NO

CONTRACT CEG 472-000 DRAWING NO 404

36663 (7-67)

MICROFILMED

11-48-9 (14)

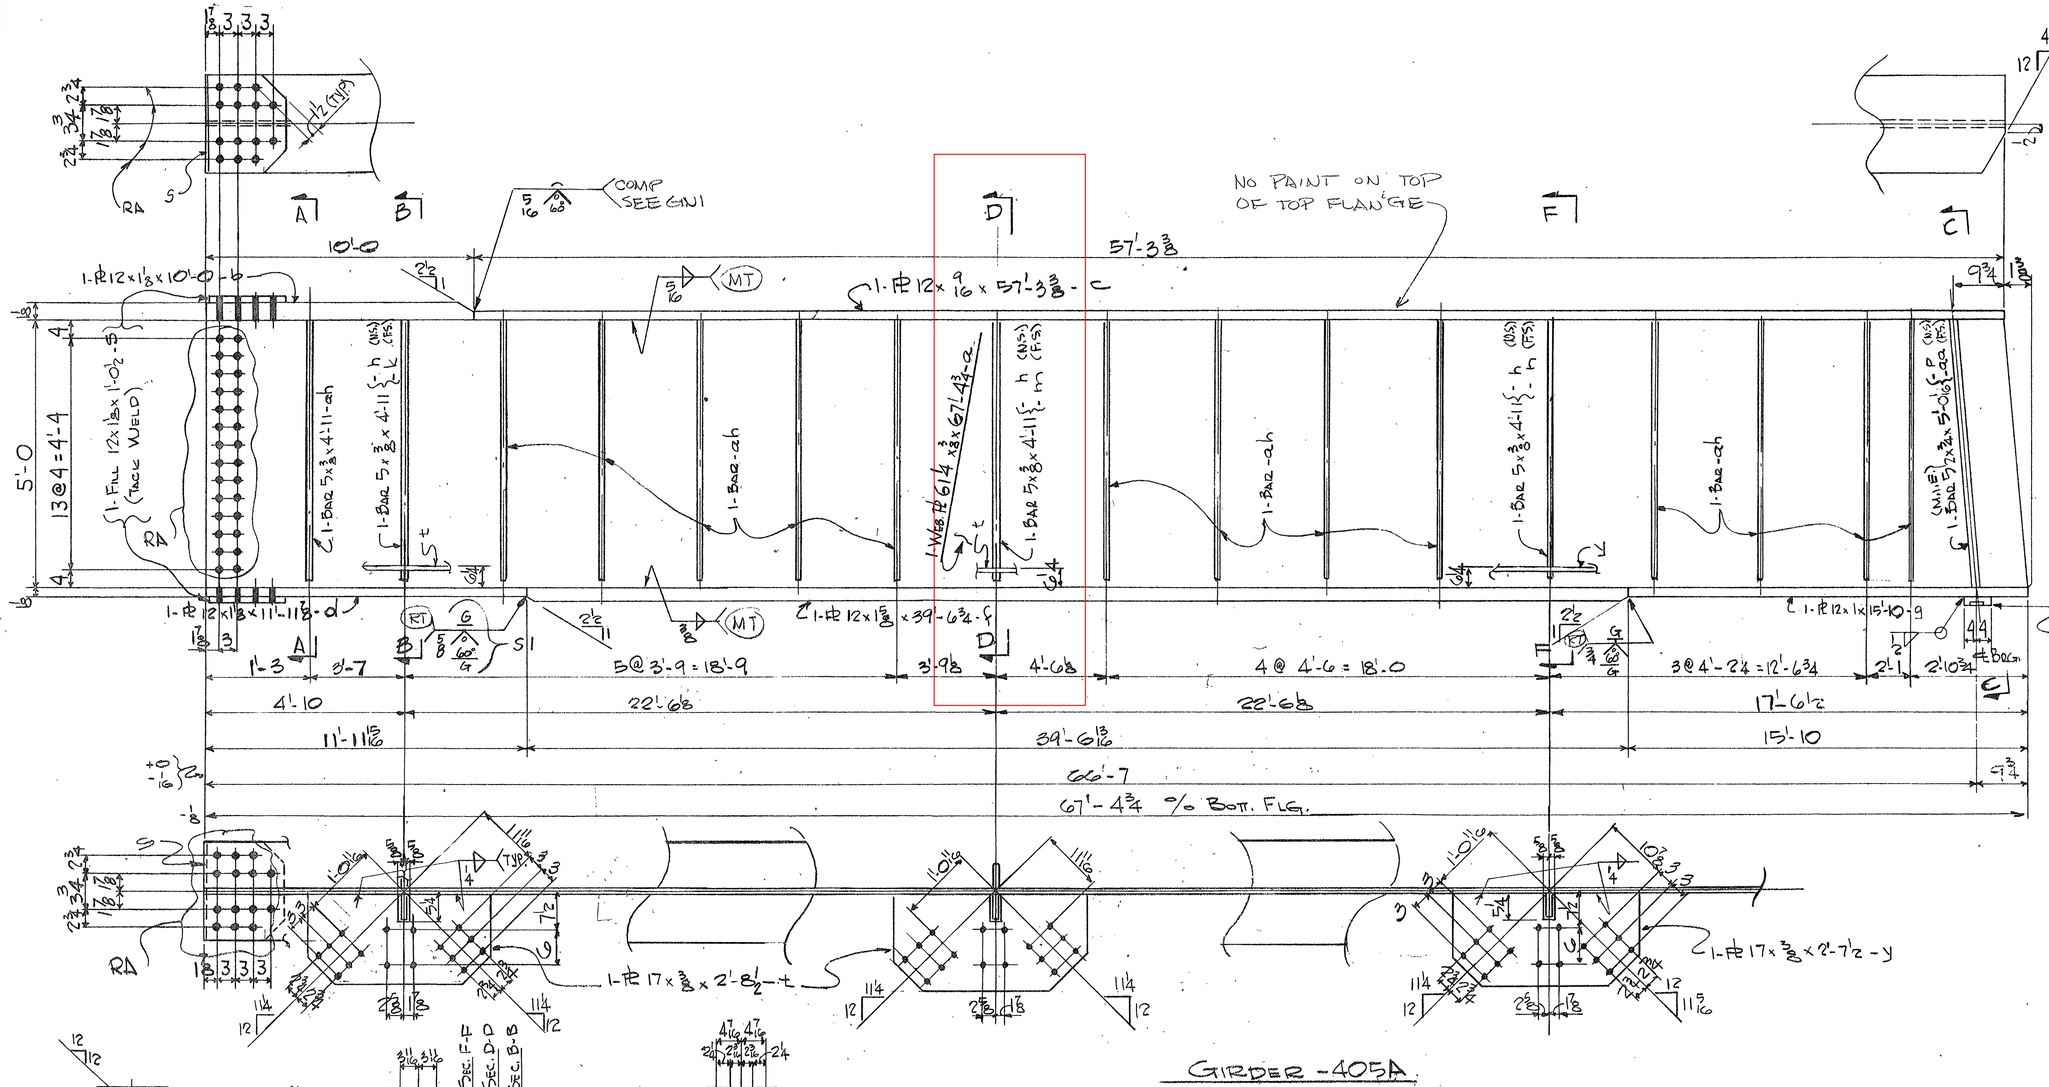

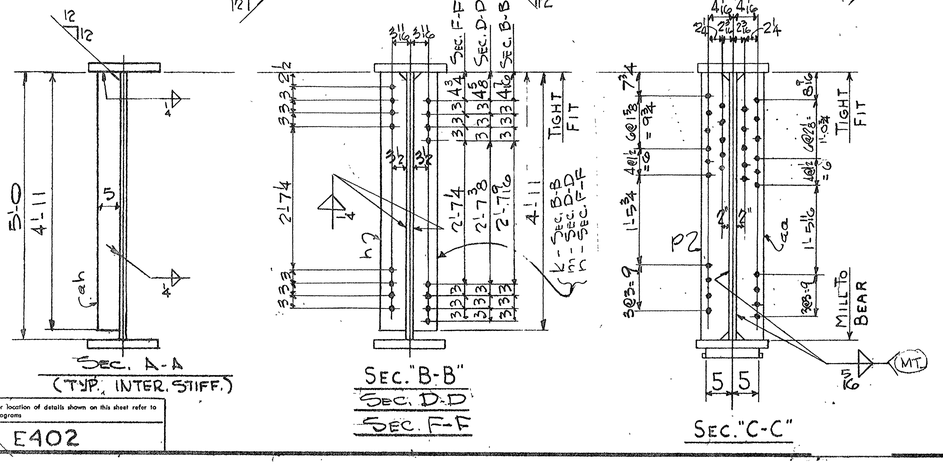

GIRDER -405A

Pier # E12 - Line B

	1	1	GIRDER	405A	67'-6
	SI	NO.	DESCRIPTION	MARK	REMARKS
INST.			REQUIRED LIST		

NOTE
¾" x ¾" CLIP ALL STIFF. AS SHOWN

ELECTRODES - E70XX LOW HYDROGEN

MATERIAL ASTM-A36
RIVETS OR BOLTS
OPEN HOLES 15/16" ϕ
.875 (FIELD) BOLTS
SHOP CONTACT SURFACES N.P.
WELDING } AS NOTED
MILLING }
PAINT
1 Coat TT-P 615c Type II, U.N. - See Note "N" S

For general notes see GN1

NOTE X
Both sides of material adjacent to all open holes must be free of burrs, loose scale, and paint for a distance of 3" from the group of holes.

NO	DATE	INIT.	REVISION
1	4-5-71	Hab	

SUBMITTAL 1 2 3 4 5 6 7 8 9 0
DATE

CUSTOMER
TENNESSEE DEPT. OF HIGHWAYS
ARKANSAS STATE HIGHWAY COMMISSION
STRUCTURE
EAST APPROACH - U.S. RIVER BRIDGE
PROJ. I-40-1(116)6 - MEMPHIS - TENN.

BETHLEHEM STEEL CORPORATION
FABRICATED STEEL CONSTRUCTION
CHICAGO DRAFTING ROOM ✓ LEETSDALE WORKS
MADE BY E.DEL DATE 1-18-71 IN CHARGE FJK
CHECKED BY Hab DATE 2-4-71 SHOP NO
CONTRACT CEG 472-000 DRAWING NO 405

For location of details shown on this sheet refer to diagrams
E402

MICROFILMED

M-48-10

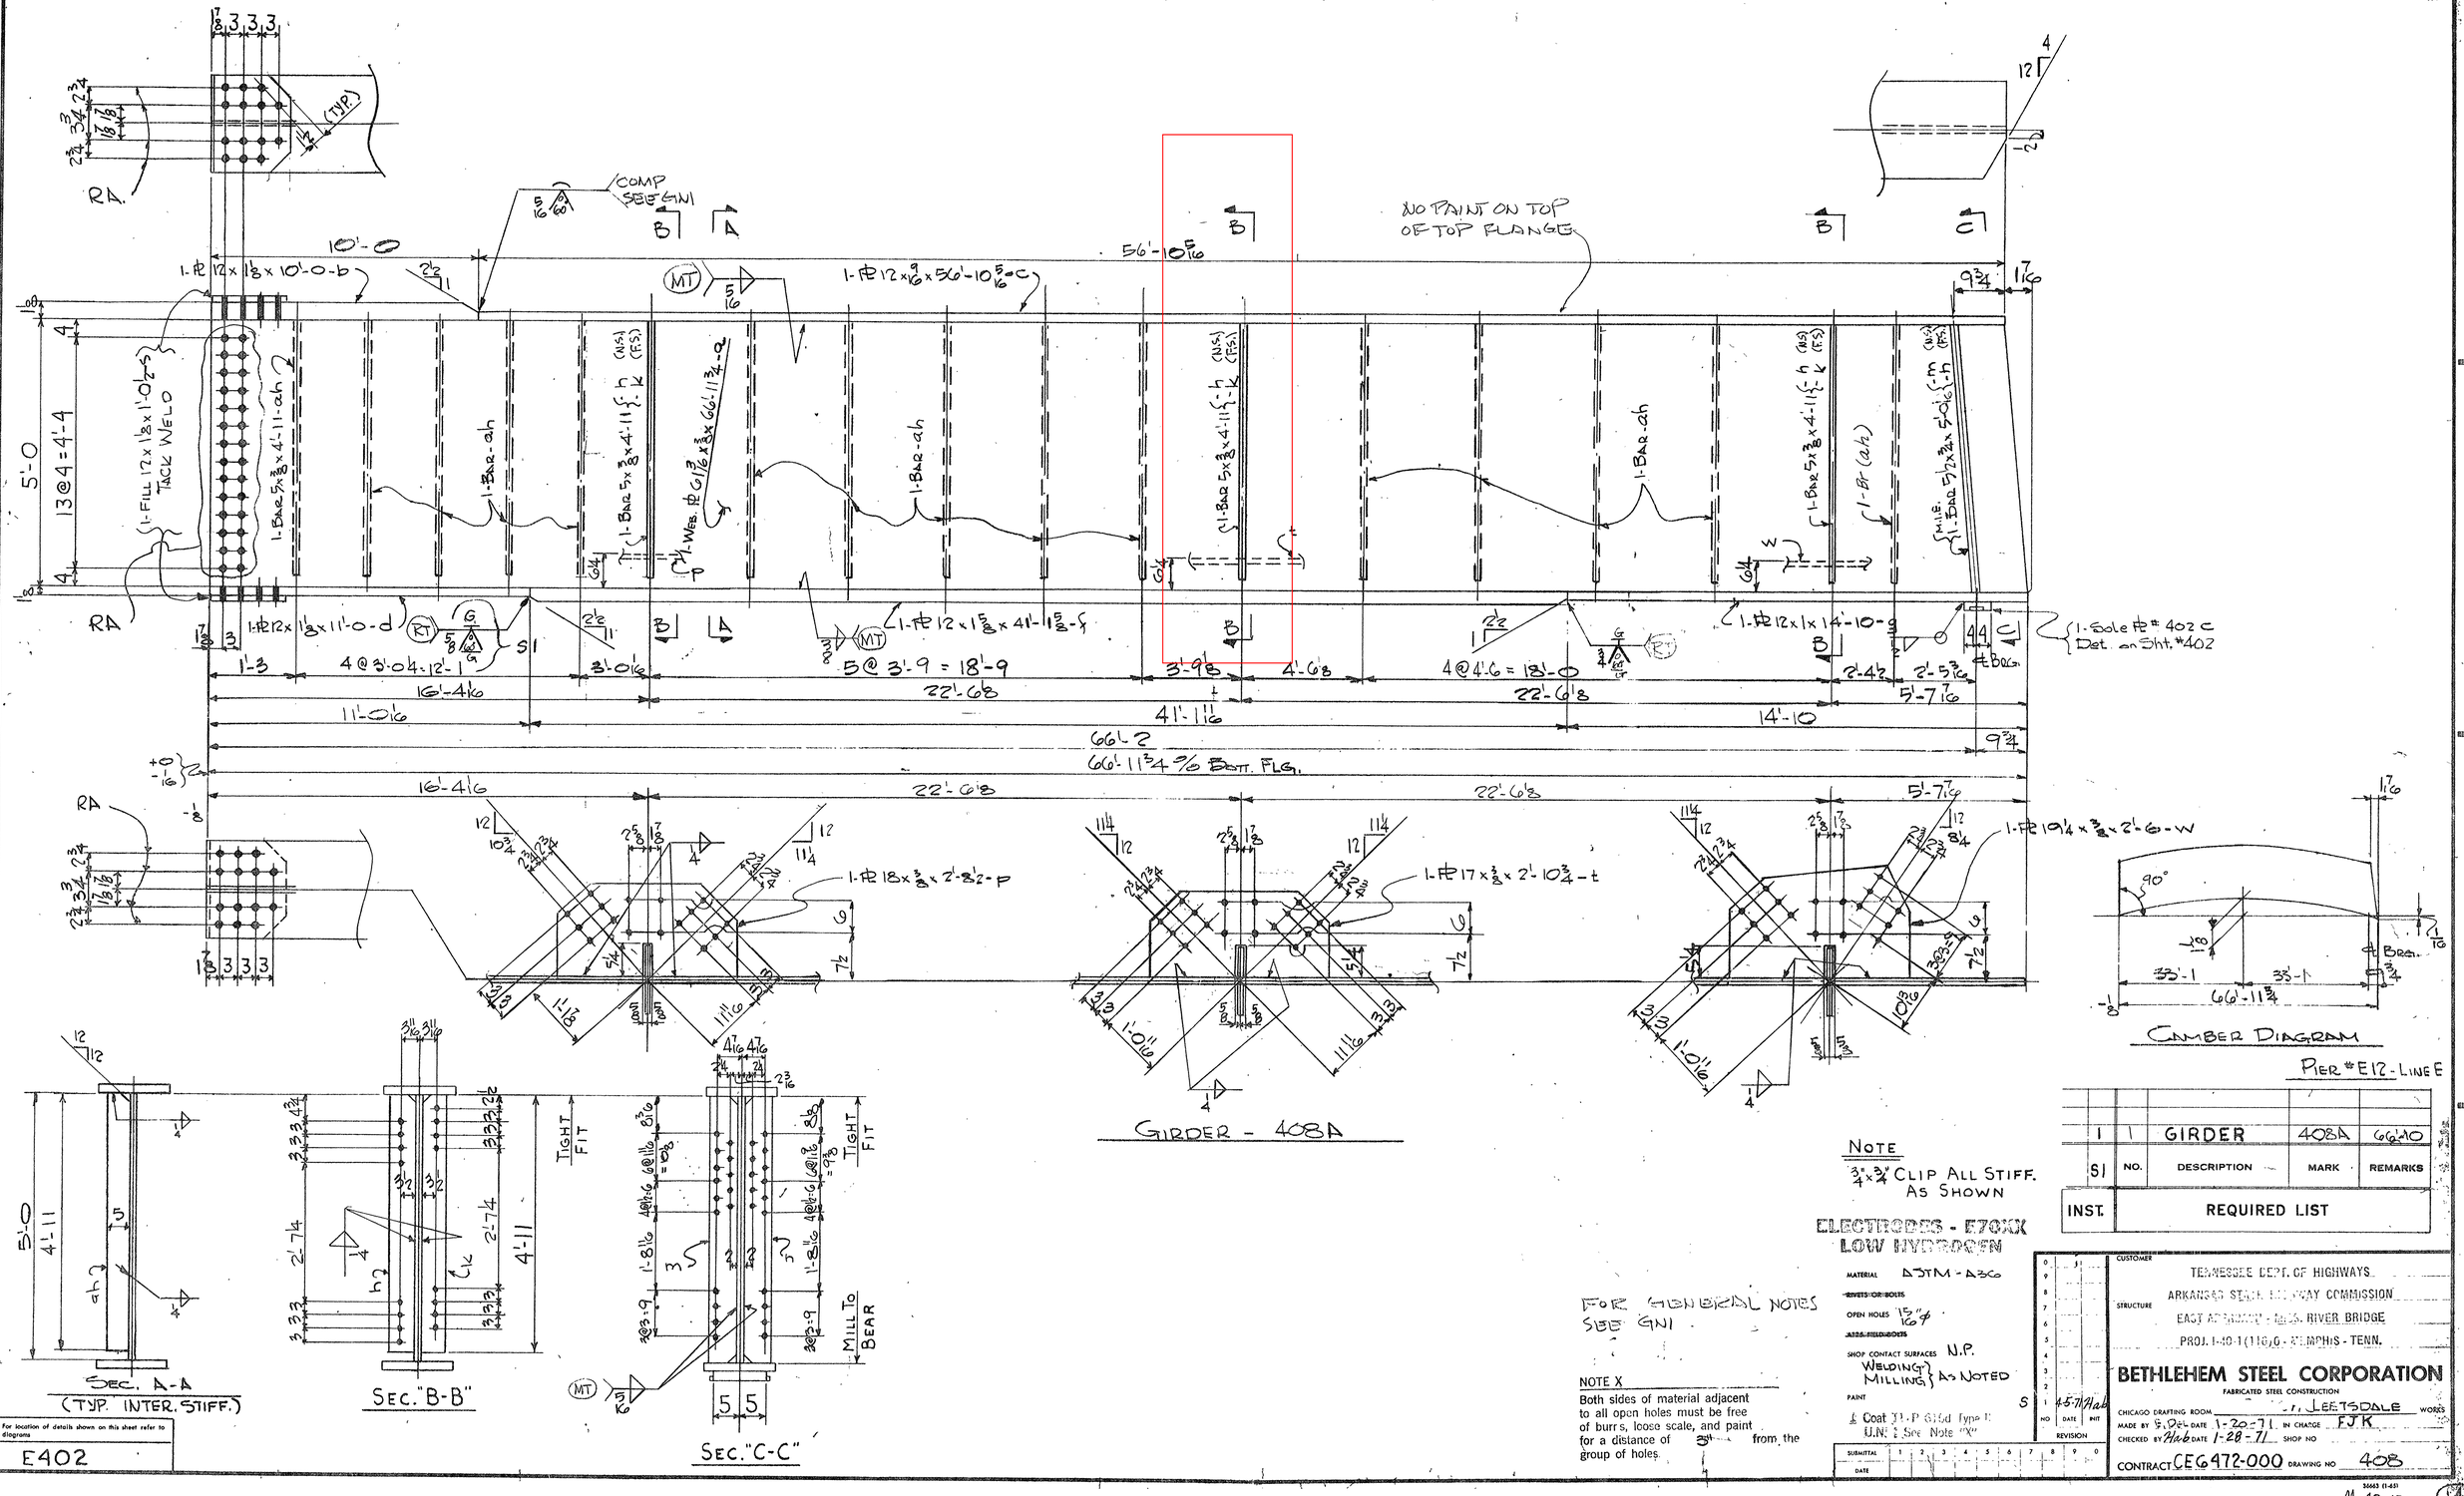

PIER # E12 - LINE E

INST.	SI	NO.	DESCRIPTION	MARK	REMARKS
		1	1	GIRDER	408A	66'10
REQUIRED LIST					

NOTE

3/4" x 3/4" CLIP ALL STIFF. AS SHOWN

ELECTRODES - E70XX LOW HYDROGEN

MATERIAL A3TM - A36

~~RIVETS OR BOLTS~~

OPEN HOLES 15/16" ϕ

~~A325 FIELD BOLTS~~

SHOP CONTACT SURFACES N.P.

WELDING } AS NOTED
MILLING }

PAINT S

Coat 3 D.F.T. Std. Type I U.N.O. See Note "X"

FOR GENERAL NOTES SEE GN1.

NOTE X

Both sides of material adjacent to all open holes must be free of burrs, loose scale, and paint for a distance of 3" from the group of holes.

SUBMITTAL DATE	1	2	3	4	5	6	7	8	9	0

NO	DATE	INIT	REVISION
1	4-5-71	Rab	

CUSTOMER TENNESSEE DEPT. OF HIGHWAYS
ARKANSAS STATE HIGHWAY COMMISSION
STRUCTURE EAST ARKANSAS - MISS. RIVER BRIDGE
PROJ. I-40-1(116)6 - MEMPHIS - TENN.

BETHLEHEM STEEL CORPORATION
FABRICATED STEEL CONSTRUCTION
CHICAGO DRAFTING ROOM ... LEESTSDALE WORKS
MADE BY E.D.L. DATE 1-20-71 IN CHARGE F.J.K.
CHECKED BY Rab DATE 1-28-71 SHOP NO.
CONTRACT CEG 472-000 DRAWING NO. 408

For location of details shown on this sheet refer to diagrams

E402

30663 (1-69)

MICROFILMED

M-48-13

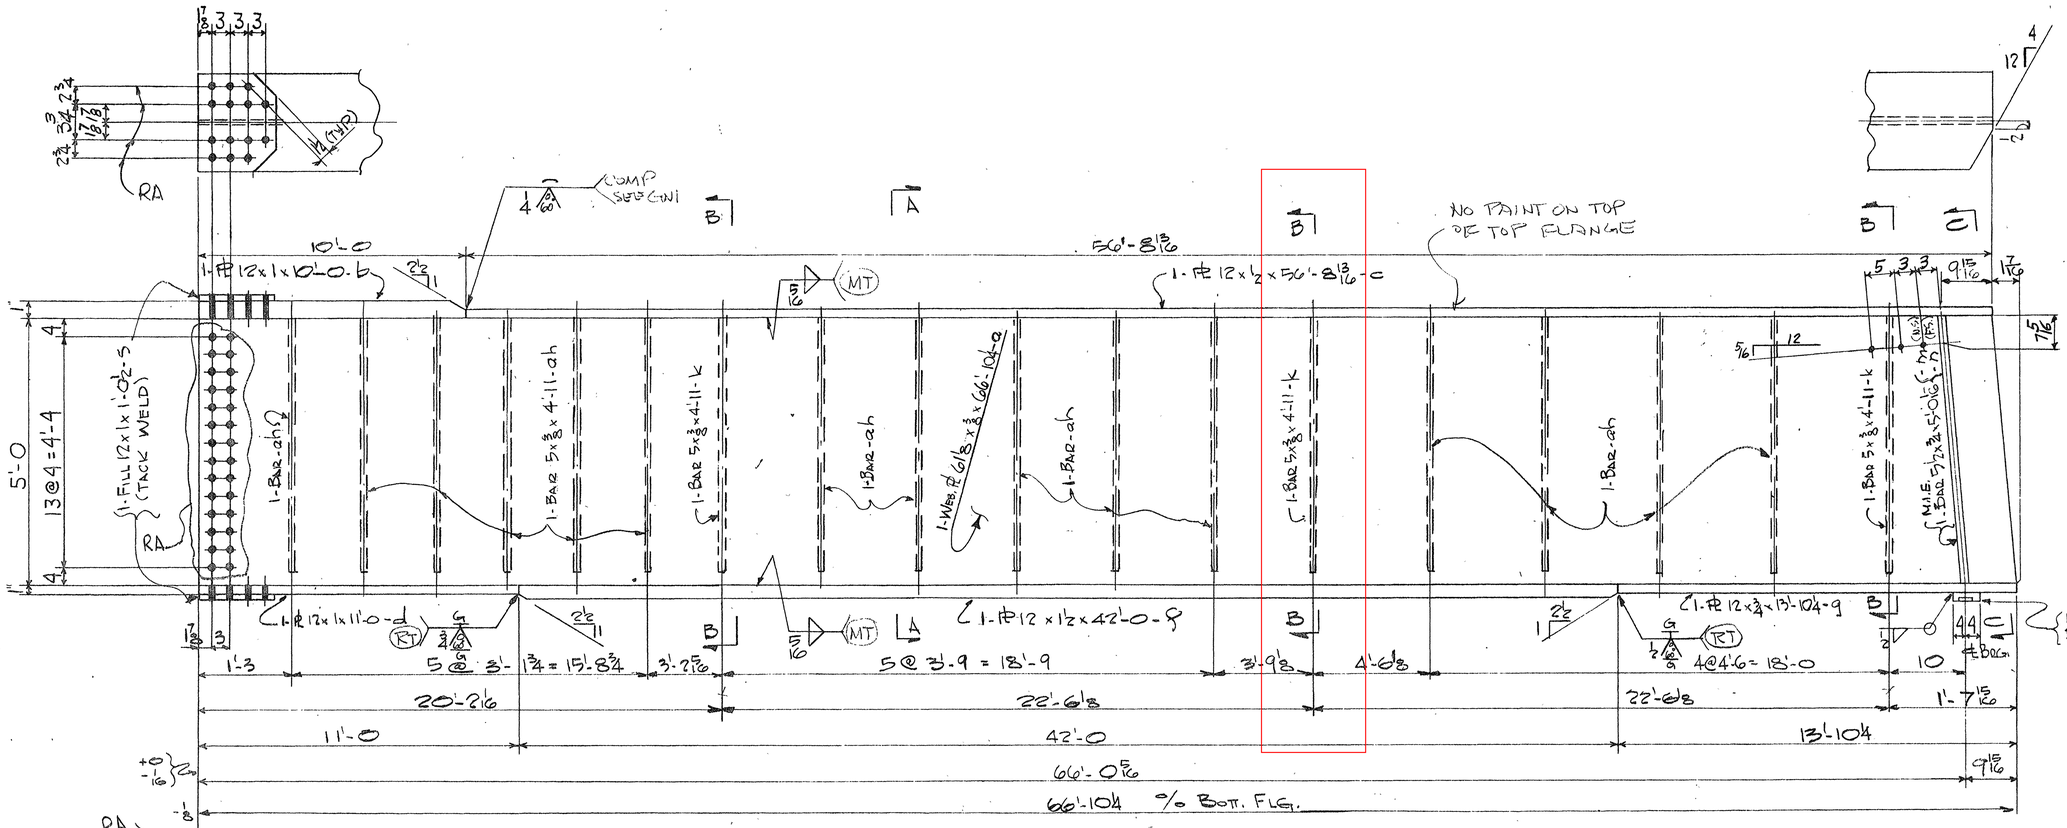

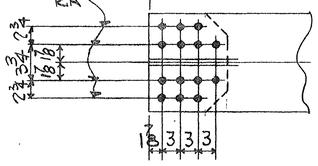

GIRDER - 409A

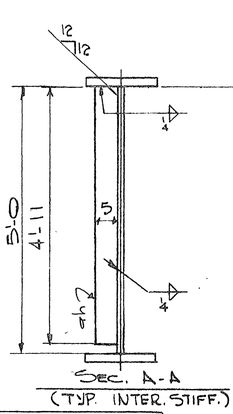

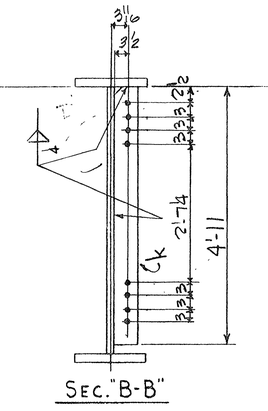

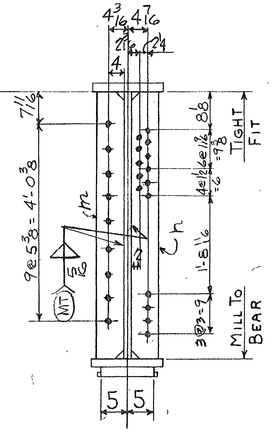

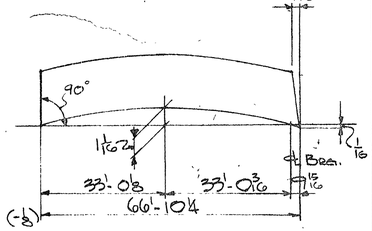

PIER # E12-LINE F

	1	1	GIRDER	409A	66'-11
	SI	NO.	DESCRIPTION	MARK	REMARKS
INST.		REQUIRED LIST			

NOTE
3/4" x 3/4" CLIP ALL STIFF. AS SHOWN
ELECTRODES - E70XX LOW HYDROGEN

FOR GENERAL NOTES SEE GN1

NOTE X
Both sides of material adjacent to all open holes must be free of burrs, loose scale, and paint for a distance of 3" from the group of holes.

MATERIAL	ASTM-A36
~~RIVET OR BOLTS~~	
OPEN HOLES	15/16 ϕ
~~ADD FIELD BOLTS~~	
SHOP CONTACT SURFACES	N.P.
WELDING / MILLING	AS NOTED
PAINT	1 Coat TI-O 61Red Type II D.F. See Note "X"

SUBMITTAL	1	2	3	4	5	6	7	8	9	0
DATE										

NO	DATE	INIT	REVISION
2			
1	3/15	K	

CUSTOMER TENNESSEE DEPT. OF HIGHWAYS
ARKANSAS STATE HIGHWAY COMMISSION
STRUCTURE EAST APPROACH - [illegible] RIVER BRIDGE
PROJ. I-40 [illegible] - MEMPHIS - TENN.

BETHLEHEM STEEL CORPORATION
FABRICATED STEEL CONSTRUCTION
CHICAGO DRAFTING ROOM LEETSDALE WORKS
MADE BY BJDEL DATE 1-19-71 IN CHARGE FJK
CHECKED BY [illegible] DATE 1-29-71 SHOP NO.
CONTRACT CEG472-000 DRAWING NO. 409

For location of details shown on this sheet refer to diagrams.
E402

36665 (E-63)

11-48-14

14

-NO PAINT TOP OF TOP FLG FULL LENGTH OF GIRDER-

42'-3⅜ | 43'-0

1-PL 12x1x42'-3⅜-b

1-PL 12x1x43'-0-n

1-PL 12x1¼x1'-0½-P

1-PL-ac
14-A325 ⅞"ϕ S.
14-HW
FULLY TORQUED

2-Br-ad

2-PL 12x⅜x4'-7½ ab
28-A325 ⅞"ϕ x 2½
28-HW
FINGER TIGHT

2-Br 5¼ x 1¼ x 2'-1½ ad

1-PL 12x1¼x2'-2½-ac
14-A325 ⅞"ϕ S.
14-HW
FULLY TORQUED

RA

ad

ac-F.S.

3@4=4'-4

5'-0

5'-0

WP

1-Br 5½x⅜x 5'-0-h-NS (MID)
1-Br 5½x⅜x 5'-0-k-FS (MID)

1-Br 5x⅜x4'-11-ax-NS

1-Br-ah

1-PL 12x⅜x42'-7⅞-a

1-Br-ah

1-Br-ah

1-Br 5x⅜x4'-11-m-NS

1-Br-ah

1-Br-ah

1-Br-ah

4'-2-25% FT

10% FT

1-PL 12x⅜x42'-7⅞-aa

1-Bar-m-NS

1-Bar-ah

1-Bar-ah

1-Bar-ah

1-Bar-ah

1-Bar-m-NS

1-Bar-ah

1-Bar-ah

1-Bar-ah

1-Bar-ah

1-PL 12x1¼x8'-3 13/16-g

1-PL 12x1x18'-7⅞-c
1-Sole PL 402c
Det. On SHT 402

1-PL 12x2⅜x37'-11-d

1-PL 12x2⅜x20'-3¾-f

5@5'-11½=19'-9½

5@4'-9=23'-9

6@3'-11½=23'-9

4@3'-0⅛"=12'-2"

1'-1⅜

24'-3

18'-8

37'-11⅜

23'-9

23'-9

20'-3⅜

13'-3⅜

8'-3⅜

+⅜ -1/16

84'-6⅜ ℄ BRG TO END @ BOTT

85'-2⅜ ℄ BOTT. FLG.

℄ BRG PIER #6

42'-7½

℄ WEB SPLICE

42'-7⅜

3 3 3 4 3 3 3

RA

2¾

17/16

3¾

2¾

1¼

ad

ac-F.S. TYP

GIRDER 460A

SEC. A-A

SEC. B-B

SEC. C-C
INTERM. STIFF. TYP.

For location of details shown on this sheet refer to diagrams.

E401

CAMBER DIAGRAM

85'-3⅜

4'-11½

42'-7⅜

84'-6⅜

For Gen. Notes See Sht GN1

NOTE X

Both sides of material adjacent to all open holes must be free of burrs, loose scale, and paint for a distance of 3" from the group of holes.

ELECTRODES - E70XX LOW HYDROGEN

NOTE: ¾"x¾" Clip All Stiff As Shown.

MATERIAL ASTM. A-36
BOLTS A325 ⅞"ϕ
OPEN HOLES 15/16"ϕ See Gen. Notes
A325 FIELD BOLTS
SHOP CONTACT SURFACES N.P.
WELDING - As Noted
MILLING - As Noted
PAINT 1 Coat TT-P 615d Type II U.N. - See Note "X"

		SPAN E7	LINE A	
	1	GIRDER	460A	86' 6
INST.	55 NO.	DESCRIPTION	MARK	REMARKS
		REQUIRED LIST		

CUSTOMER TENNESSEE DEPT. OF HIGHWAYS
ARKANSAS STATE HIGHWAY COMMISSION
STRUCTURE EAST APPROACH - MISS. RIVER BRIDGE
PROJ. I-40-1(116)0 - MEMPHIS - TENN.

BETHLEHEM STEEL CORPORATION
FABRICATED STEEL CONSTRUCTION

CHICAGO DRAFTING ROOM LEETSDALE WORKS
MADE BY J.K.M. DATE 2-16-71 IN CHARGE F.J.K.
CHECKED BY [illegible] DATE 3-8-71 SHOP NO.
CONTRACT CEG472-000 DRAWING NO. 460

REVISION NO 5 | DATE 4-15 | INIT [illegible]

SUBMITTAL 1 2 3 4 5 6 7 8 9 0
DATE

11-48-87

MICROFILMED

-No Paint Top of Top Flg. Full Length of Girder-

7'-1 5/2"

10'-0 3/8"

5'-0

4@ 4'-4

5@ 4'-9 = 23'-9

6@ 3'-11 1/2" = 23'-9

24'-5

16'-8

54'-9

80'-8 3/8" ℄ Brg. To End @ Bott.

81'-4 3/8" o/o Bott. Flg.

℄ Brg Pier #6

40'-7 3/8"

Girder 461A

40'-9

℄ Shop Web Spl.

Comp. See GN1

Sec. A-A

Sec. B-B

Sec. C-C
Intermediate Stiff. Typ

Camber Diagram

81'-5 5/8"

80'-8 7/8"

40'-9

℄ Span

For location of details shown on this sheet refer to diagrams

E 401

For Gen Notes See GN1

NOTE X

Both sides of material adjacent to all open holes must be free of burrs, loose scale, and paint for a distance of 3" from the group of holes.

ELECTRODES - E70XX LOW HYDROGEN

Note: 3"x3"x3/8" Clip All Stiff As Shown.

MATERIAL A.S.T.M. A-36

BOLTS A325-3/4"ø

OPEN HOLES 1 5/16"ø See Gen Notes

A325 FIELD BOLTS —

SHOP CONTACT SURFACES N.P.

WELDING: As Noted

MILLING: As Noted

PAINT 1 Coat IT-P 615d Type II

U.N.: See Note "X"

Span E7 Line B

INST.	NO.	DESCRIPTION	MARK	REMARKS
	1	1 GIRDER	461A	
53		REQUIRED LIST		

CUSTOMER: TENNESSEE DEPT. OF HIGHWAYS
ARKANSAS STATE HIGHWAY COMMISSION

STRUCTURE: EAST APPROACH - MISS. RIVER BRIDGE
PROJ. I-40-1(116)0 - MEMPHIS - TENN.

BETHLEHEM STEEL CORPORATION
FABRICATED STEEL CONSTRUCTION

CHICAGO DRAFTING ROOM LEETSDALE WORKS
MADE BY JKM DATE 3-16-71 IN CHARGE F.J.K.
CHECKED BY [illegible] DATE 3-8-71 SHOP NO.

CONTRACT CEG472-000 DRAWING NO. 461

REVISION: NO. 5 | DATE | INIT

SUBSEQUENT DATE: 1 2 3 4 5 6 7 8 9 0

MICROFILMED

11-18-88

— No Paint Top of Top Flg. Full Length of Girder —

GIRDER - 464A

Sec. A-A

Sec. B-B
Intermediate Stiff Typ

Sec. C-C

Camber Diagram

For location of details shown on this sheet refer to diagrams
E401

For General Notes See GN1

NOTE X
Both sides of material adjacent to all open holes must be free of burrs, loose scale, and paint for a distance of 3" from the group of holes.

ELECTRODES - E70XX LOW HYDROGEN

Note: 3/4 x 3/4" Clip All Stiff As Shown.

MATERIAL A.S.T.M. A-36
BOLTS A325 3/4"ø
OPEN HOLES 15/16 See Gen. Notes
A325 FIELD BOLTS —
SHOP CONTACT SURFACES N.P
WELDING: As Noted
MILLING: As Noted
PAINT
1 Coat F1-P blbd Type II U.N. See Note "X"

Span E7 Line E

	1	1	GIRDER	464A	
	55	NO	DESCRIPTION	MARK	REMARKS
INST.			REQUIRED LIST		

SUBMITTAL 1 2 3 4 5 6 7 8 9 0
DATE

S1 4-5 PJ
NO | DATE | INIT
REVISION

CUSTOMER TENNESSEE DEPT. OF HIGHWAYS
ARKANSAS STATE HIGHWAY COMMISSION
STRUCTURE EAST APPROACH - MISS RIVER BRIDGE
PROJ. I-40-1(116)0 - MEMPHIS - TENN.

BETHLEHEM STEEL CORPORATION
FABRICATED STEEL CONSTRUCTION
CHICAGO DRAFTING ROOM LEETSDALE WORKS
MADE BY J.V.M. DATE 2-23-71 IN CHARGE F.J.K.
CHECKED BY DATE 3-8-71 SHOP NO.
CONTRACT CEG472-000 DRAWING NO 464

36683 (1-69)
11-48-91

MICROFILMED

NO PAINT TOP OF TOP FLG FULL LENGTH OF GIRDER

66'-1 7/16

1-PL 12 x 9/16 x 66'-1 7/16 - b

1-PL 12x7/16x1'-0 1/2 - m FILL

1-PL - ac
14 - A325 3/4" x 4 3/4
14 - HW
FULLY TORQUED

2-BAR-ad

RA

13@4 = 4'-4

5'-0

1-BAR 5 1/2 x 3/4 x 5'-0 - g NOS (MIE)
1-BAR 5 1/2 x 3/4 x 5'-0 - h FS (NIE)

1-BAR 5 x 3/4 x 4'-11 - ah

1-WEB PL 61 1/4 x 3/8 x 66'-1 7/16 - a

1-BAR 5 x 3/4 x 4'-11 - k

1-PL 12 x 1 3/4 x 41'-4 15/16 - d

1-PL 12 x 1 x 16'-8 - c
1 SOLE PL 402C
DET ON SHT #402

1-PL 12 x 1 1/4 x 7'-11 13/16 - f

2-BARS 5 1/4 x 1/4 x 2'-1 1/2 - ad

1-PL 12 x 1 1/4 x 2'-1 1/2 ac
14 - A325 7/8" x 5
14 - HW
FULLY TORQUED

5@3'-11 1/2 = 19'-9 1/2
24'-5

3@4'-9 = 23'-9
23'-9
41'-5

4@3'-11 1/2 = 15'-10
17'-10 7/8
7'-11 7/8

2'-0 7/8

65'-4 7/8 ℄ BRG. TO END @ BOTT. FLG.
66'-0 7/8 O/O BOT. FLG.

℄ BRG TIET E6

GIRDER 465A

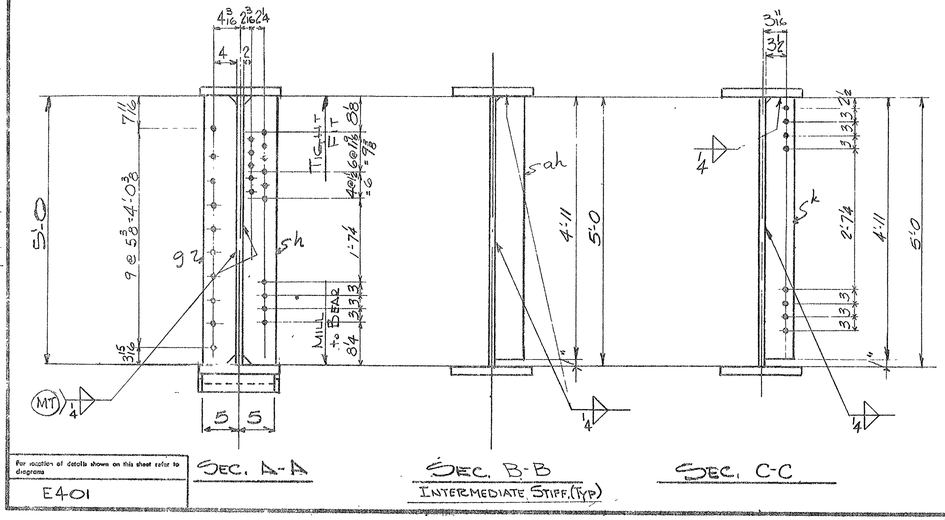

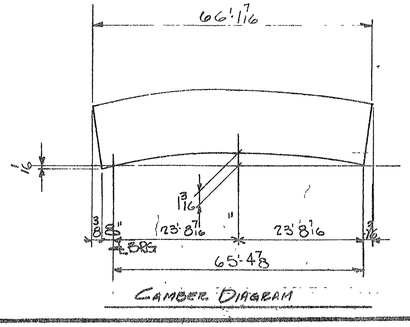

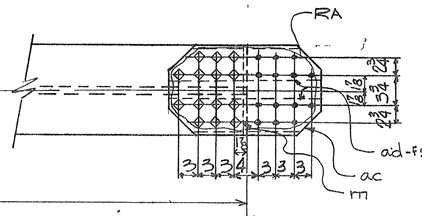

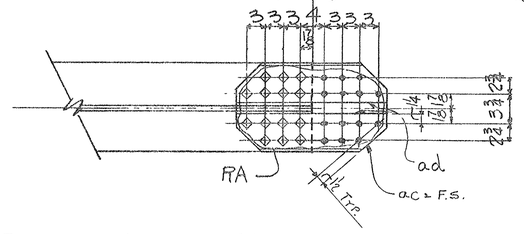

FOR GENERAL NOTES SEE GN1

NOTE X
Both sides of material adjacent to all open holes must be free of burrs, loose scale, and paint for a distance of 3" from the group of holes.

ELECTRODES - E70XX LOW HYDROGEN

NOTE: 3/4" x 3/4" CLIP ALL STIFF AS SHOWN.

MATERIAL ASTM A-36
RIVETS OR BOLTS A325 - 7/8"ø
OPEN HOLES 15/16" - SEE GEN. NOTES
A325 FIELD BOLTS —
SHOP CONTACT SURFACES N.P.
WELDING: AS NOTED
MILLING: AS NOTED
PAINT 1 Coat TT-P 615d Type II U.N. - See Note "X"

INST.	SS	NO.	DESCRIPTION	MARK	REMARKS
			SPAN E7 LINE F		
	1	1	GIRDER	465A	
			REQUIRED LIST		

REVISION NO	DATE	INIT
51	4 5	PJ

SUBMITTAL DATE: 1 2 3 4 5 6 7 8 9 0

CUSTOMER: TENNESSEE DEPT. OF HIGHWAYS
ARKANSAS STATE HIGHWAY COMMISSION
STRUCTURE: EAST APPROACH - MISS. RIVER BRIDGE
PROJ. I-40-1(116)0 - MEMPHIS - TENN.

BETHLEHEM STEEL CORPORATION
FABRICATED STEEL CONSTRUCTION
LEETSDALE WORKS

CHICAGO DRAFTING ROOM
MADE BY J.K.M. DATE 2-17-71 IN CHARGE F.J.K.
CHECKED BY [illegible] DATE 3-8-71 SHOP NO.

CONTRACT CEG472-000 DRAWING NO. 465

For location of details shown on this sheet refer to diagrams
E401

MICROFILMED

M-48-92

NOTE.
NO PAINT TOP OF TOP FLG

GIRDER - 472A

SPAN 8 - LINE F

1	1	GIRDER	472A	79-6
NO	NO	DESCRIPTION	MARK	REMARKS
INST.		REQUIRED LIST		

ELECTRODES - E70XX
LOW HYDROGEN

NOTES:
Both sides of material adjacent to all open holes must be free of burrs, loose scale, and paint for a distance of 3" from the group of holes

GEN NOTES: SEE SHT. GN1

Note
3/4"x3" CLIP ALL STIFF AS SHOWN.

MATERIAL ASTM-A36
BNGS OR BOLTS
OPEN HOLES 13/16"ø
SHOP CONTACT SURFACES NP
WELDING } AS NOTED
MILLING }
PAINT
1 Coat TT-P 615d Type I.
D.F.T. : See Note "X"

CUSTOMER
TENNESSEE DEPT. OF HIGHWAYS
ARKANSAS STATE HIGHWAY COMMISSION
STRUCTURE
EAST APPROACH - MISS. RIVER BRIDGE
PROJ. I-40-1(116)0 - MEMPHIS - TENN.

BETHLEHEM STEEL CORPORATION
FABRICATED STEEL CONSTRUCTION
LEETSDALE WORKS

CHICAGO DRAFTING ROOM
MADE BY E.DEL DATE 2-22-71 IN CHARGE F.J.K.
CHECKED BY Rub DATE 3-4-71 SHOP NO

CONTRACT C.E6472-000 DRAWING NO 472

REVISION NO | DATE | INIT

SUBMITTAL DATE 1 2 3 4 5 6 7 8 9 0

For location of details shown on this sheet refer to diagrams
E401

SEC. A-A
(TYP INTER. STIFF.)

SEC. B-B

CAMBER DIAGRAM

MICROFILMED

M-472.0-79

NOTE:
NO PAINT TOP OF TOP FLG.

12'-0 | 53'-0 | 12'-5 13/16

1-FILL 12 x 5/8 x 1'-0 1/2 - s (TACK WELD)
COMP SEE GN1
1-PL 12 x 5/8 x 12'-0 - b
1-PL 12 x 3/4 x 53'-0 - c
1-FILL 12 x 5/8 x 1'-0 1/2 - t (TACK WELD)
1-PL 12 x 1/4 x 12'-5 13/16 - d
RA
1-PL k
2-BR m
2-PL 15 3/8 x 4'-7 1/2 - n
1-BAR 5 x 3/8 x 4'-11 - ah
1-BAR 5 x 3/8 x 4'-11 ag (NS) ab (FS)
1-WEB PL 61/2 x 3/8 x 77'-5 13/16 - a
1-PL 12 x 1 1/2 x 12'-0 - f
1-PL 12 x 2 1/2 x 53'-0 - g
2-PL 5 1/4 x 1 1/4 x 2'-1 1/2 - m
1-PL 12 x 1 1/4 x 2'-1 1/2 - k
(BOLT ALL SPL. PL'S BACK FOR SHIPMENT (BOTH ENDS))
1-PL 12 x 1 1/2 x 12'-5 13/16 - h
2-BR m
1-PL k
2-PL n
13@4'-4 = 54'-0
13@4'-4

2'-2 3/8 | 3@3'-7 = 10'-9 | 4'-1 3/4 | 4@4'-1 3/8 = 16'-6 1/2 | 4'-1 3/4 | 4'-11 3/4 | 3@4'-11 1/2 = 14'-10 1/2 | 4'-11 3/4 | 3@4'-2 = 12'-6 | 2'-3 15/16
12'-11 3/8 | 24'-10 | 24'-10 | 14'-9 15/16
12'-0 15/16 | 53'-0 1/8 | 12'-5 5/8
77'-5 13/16 ℄ BOTT FLG.

1-PL K 3/4 x 3/8 x 2'-8 1/4 - p TYP.
1-PL p

ELECTRODES - E70XX
LOW HYDROGEN

NOTE X
Both sides of material adjacent to all open holes must be free of burrs, loose scale, and paint for a distance of 3" from the group of holes

GEN NOTES: SEE SHT. GN1

NOTE:
3/4 x 3/8 CLIP ALL STIFF. AS SHOWN.

MATERIAL ASTM-A36
RIVETS OR BOLTS
OPEN HOLES 13/16 ø
SHOP CONTACT SURFACES WELDING N.P. MILLING AS NOTED
PAINT
1 coat TT-P 615d Type II
U.N. * See Note "X"

GIRDER - 473A

SPAN B - LINE E

NO.	DESCRIPTION	MARK	REMARKS
1	GIRDER	473A	79'-6
QTY	REQUIRED LIST		

CUSTOMER: TENNESSEE DEPT. OF HIGHWAYS / ARKANSAS STATE HIGHWAY COMMISSION
STRUCTURE: EAST APPROACH - MISS. RIVER BRIDGE.
PROJ. I-40-1(116)0 - MEMPHIS - TENN.

BETHLEHEM STEEL CORPORATION
FABRICATED STEEL CONSTRUCTION
CHICAGO DRAFTING ROOM LEETSDALE WORKS
MADE BY L.DEL DATE 2-23-71 IN CHARGE F.T.P.
CHECKED BY Hale DATE 3-4-71 SHOP NO.
CONTRACT CEG-471-000 DRAWING NO 473

REVISION: NO. 1 DATE 4-6 INIT

SUBMITTAL 0 1 2 3 4 5 6 7 8 9 0
DATE

SEC. A-A (TYP INTER. STIFF.)

SEC. B-B

CAMBER DIAGRAM
80° 10' | 90° | 90° 00'
19'-4 7/16 | 19'-4 7/16
38'-8 3/8 | 38'-8 15/16
77'-5 13/16

For location of details shown on this sheet refer to diagram.
E401F

MICROFILMED

NOTE:
NO PAINT TOP OF TOP FLG

67'-0

1-PL 12 x ¾ x 67'-0 - b

1-FILL 12 x ⅜ x 1'-0½ - t (TACK WELD)

1-PL 12 x 1 x 10'-5 15/16 - c

1-FILL 12 x ⅜ x 1'-0½ - w (TACK WELD)
10'-5 15/16

1-PL 12 x 1½ x 14'-0 - d

1-PL 12 x 2½ x 53'-0 - f

1-PL 12 x 1¾ x 10'-5 9/16 - g

1-WEB PLG 1½ x ⅜ x 77'-5 13/16 a

1-BAR 5 x ⅜ x 4'-11 - aa

1-BAR 5 x ⅜ x 4'-11 - ab

1-BAR - ah

2-PL 13 x ⅜ x 4'-7½ - m (BOLT BACK FOR SHIPMENT ON FS. OF WEB (BOTH ENDS))

2-BR. 5½ x 1¼ x 2'-1½ - k

1-PL 12 x 1¼ x 2'-1½ - h

(BOLT ALL FLG. SPL. PL'S BACK on OUTSIDE of FLG for SHIPMENT (BOTH ENDS))

2-PL - k

1-PL - h

2-PL - m

2-BR - k

1-PL - n

1-PL 16¼ x ⅜ x 2'-8¼ - n

1-PL 16¼ x ⅜ x 2'-8¼ - p

1-PL 16¼ x ⅜ x 2'-8¼ - s

COMP. SEE GN1

SPAN B - LINE B

INST.	NO	DESCRIPTION	MARK	REMARKS
	1	1 GIRDER	476A	79'-6
	56	REQUIRED LIST		

ELECTRODES - E70XX LOW HYDROGEN

GEN NOTE: SEE SHT. GN1

NOTE: 3"x3" CLIP ALL STIFF AS SHOWN.

MATERIAL ASTM - A36
RIVETS OR BOLTS
OPEN HOLES 15/16
ABRASIVE BLAST
SHOP CONTACT SURFACES WELDING NP
MILLING AS NOTED
PAINT

CUSTOMER TENNESSEE DEPT. OF HIGHWAYS
ARKANSAS STATE HIGHWAY COMMISSION
STRUCTURE EAST APPROACH - MISS. RIVER BRIDGE
PROJ. I-40-1(116)0 - MEMPHIS - TENN.

BETHLEHEM STEEL CORPORATION
FABRICATED STEEL CONSTRUCTION

CHICAGO DRAFTING ROOM LEETSDALE WORKS
MADE BY LiDEL DATE 2-25-71 IN CHARGE F.J.K.
CHECKED BY Mab DATE 3-5-71 SHOP NO.

CONTRACT CEG472-000 DRAWING NO 476

REVISION: NO 51 DATE 4-6 INIT B

SUBMITTAL 1 2 3 4 5 6 7 8 9 0
DATE

34665 (1-67)

SEC. A-A (TYP. INTER. STIFF.)

SEC. B-B

GIRDER — 476A

CAMBER DIAGRAM

For location of details shown on this sheet refer to diagrams E401

MICROFILMED

M-48-103

NOTE:
NO PAINT TOP OF TOP FLG

1-PL 12 x 5/8 x 1'-0 1/2 - s (TACK WELD)
1-PL 12 x 5/8 x 12'-6 - b
1-PL 12 x 3/4 x 52'-6 - c
1-PL 12 x 9/16 x 12'-5 15/16 - d
1-FILL PL 12 x 7/16 x 1'-0 1/2 - t (TACK WELD)
1-PL 12 x 1 1/4 x 12'-6 - f
1-PL 12 x 2 1/2 x 52'-6 - g
1-PL 12 x 1 1/2 x 12'-5 15/16 - h
1-PL 12 x 7/8 x 77'-5 13/16 - a
1-PL - k
2-PL - m
2-PL - n
2-BAR 5 x 3/8 x 4'-11 - ah
1-BAR 5 x 3/8 x 4'-11 - P
1-BAR - ah
1-BAR - P
2-BAR 5 3/4 x 1 1/4 x 2'-1 1/2 - m
1-PL 12 x 1 1/4 x 2'-1 1/2 - k
2-BAR 13 x 3/8 x 4'-7 1/2 - n
2-BAR - m
1-PL - k

5'-0
13 @ 4" = 4'-4
13 @ 4 = 4'-4

2'-2 3/8 | 4 @ 4'-0 3/8 = 16'-2 1/2 | 4'-1 | 4'-11 3/4 | 3 @ 4'-11 1/2 = 14'-10 1/2 | 4'-11 3/4 | 4'-1 3/4 | 4 @ 4'-1 5/8 = 16'-6 1/2 | 4'-1 3/4 | 3'-1 3/4 | 2'-2 3/8

22'-5 3/8 | 24'-10 | 24'-10 | 5'-3 5/8
12'-6 1/16 | 52'-6 3/8 | 12'-5 5/8
77'-5 13/16 % BOTT FLG.

(BOLT ALL SPL. PL'S BACK FOR SHIPMENT (BOTH ENDS)

RA

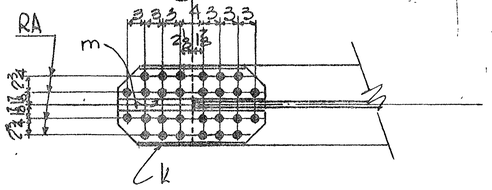

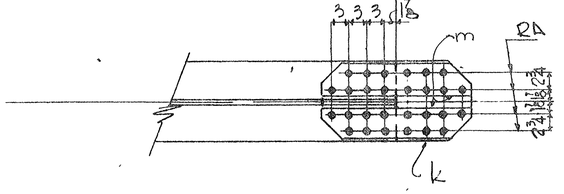

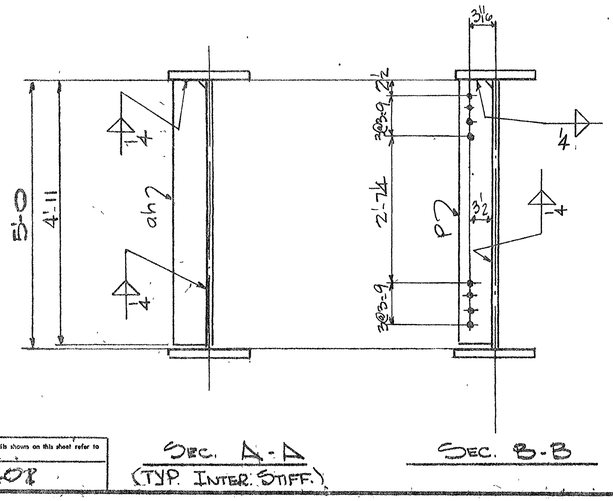

SEC. A-A
(TYP. INTER. STIFF.)

SEC. B-B

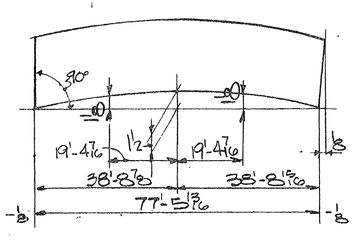

CAMBER DIAGRAM

ELECTRODES - E70XX
LOW HYDROGEN

... type of material ship with ... all ... must be used ... bars, ... and paint ... a ... of ... 3" from ... edges.

GEN NOTES: SEE SHT. GN1

NOTE:
3/4" x 3/4" CLIP ALL STIFF AS SHOWN.

	1	GIRDER	477A	79-6
SIZE	NO.	DESCRIPTION	MARK	REMARKS
INST.		REQUIRED LIST		

SPAN 8 - LINE A

MATERIAL ASTM - A36
RIVETS OR BOLTS
OPEN HOLES 15/16" ø
SHOP CONTACT SURFACES WELDING, MILLING } AS NOTED N.P.
PAINT
Sand 21-F SLED Type II
D.N. - See Note "P"

REVISION: NO. 5 | DATE 4-6 | INIT B'

SUBMITTAL | DATE

CUSTOMER TENNESSEE DEPT. OF HIGHWAYS
ARKANSAS STATE HIGHWAY COMMISSION
STRUCTURE EAST APPROACH - MISS. RIVER BRIDGE
PROJ. I-40-1(116)0 - MEMPHIS - TENN.

BETHLEHEM STEEL CORPORATION
FABRICATED STEEL CONSTRUCTION
CHICAGO DRAFTING ROOM LEETSDALE WORKS
MADE BY E.DEL DATE 2-26-71 IN CHARGE F.J.K.
CHECKED BY Hab DATE 3-5-71 SHOP NO.
CONTRACT CEG 472-000 DRAWING NO. 477

For location of details shown on this sheet refer to diagrams. E407

M-48-104

MICROFILMED

NO PAINT TOP OF TOP FL'G FULL LENGTH

1-PL 18 x 3/8 x 0'-9 1/2 ag ⊲T

RA

COMP SEE GN1

7'-6 | 14'-0 | 65'-7

1-PL 18 x 3/8 x 7'-6 c

1-PL 18 x 1 x 14'-0 d

1-PL 18 x 1 3/4 x 65'-7 f

1-BR 5 x 3/8 x 4'-11 ah

1-BR ah

1-WEB PL 60 15/16 x 3/8 x 55'-1 q

MT

1-BR 5

1-PL 18 x 14 x 7'-5 15/16 g

1-PL 18 x 24 x 13'-11 7/8 h

1-PL 18 x 3/8 x 16'-3 3/8 y

1-PL 18 x 3/8 x 32'-11 7/8 -K

5'-2 5/8 | 5'-0 | 13 @ 4 = 4'-4 | 4

1'-1 7/8 | 2'-5 1/2 | 2'-5 1/2 | 5 @ 3'-9 = 18'-9 | 3'-9 1/16 | 5 @ 4'-6 = 22'-6

6'-0 7/8 | 7'-6 | 22'-6 | 14'-0 | 16'-3 1/2 | 22'-6 | 33'-0

55'-0 1/16 END TO ℄ WEB SHE

59'-0 TO END @ BOTT

51'-0 15/16

110'-0 15/16 % BOTT. FL'G

+0 -1/16 -1/8

MATCH LINE

GIRDER 444A

SECT A-A
(TYP. INTERMEDIATE STIFF)

SECT B-B
SECT. B'-B'

NOTE A
Both sides of material adjacent to all open holes must be free of burrs, loose scale, and paint for a distance of ___ from the edge of hole or group of holes.

MATERIAL	SEE DRWG 444 BB
RIVETS OR BOLTS	
OPEN HOLES	
A325 FIELD BOLTS	
SHOP CONTACT SURFACES	
PAINT	

SPAN E9 · LINE F

For location of details shown on this sheet refer to diagrams

E401

CUSTOMER TENNESSEE DEPT OF HIGHWAYS
ARKANSAS STATE HIGHWAY COMMISSION
STRUCTURE EAST APPROACH - MISS RIVER BRIDGE
PROJ I-40-1(116)0 - MEMPHIS - TENN.

BETHLEHEM STEEL CORPORATION
FABRICATED STEEL CONSTRUCTION

CHICAGO DRAFTING ROOM — LEETSDALE WORKS
MADE BY SAE DATE 2-10-71 IN CHARGE FJK
CHECKED BY ☐ DATE 3-3-71 SHOP NO. 1
CONTRACT CE6472-000 DRAWING NO. 444 AB

REVISION: NO 5 | DATE 4-5 | INIT B

SUBMITTAL 1 2 3 4 5 6 7 8 9 0
DATE

MICROFILMED

M-48:59

36663 (1-63)

NO PAINT TOP OF TOP FLG FULL LENGTH

65'-7

13'-0

10'-0 3/8

1-PL 18x1x13'-0-m

1-PL 18x7/8x10'-0 3/8 P

1-PL 18x1 1/2x1'-7 1/2-ab
12-HSB 7/8"ϕ x 3 1/2
12-HW
(FULLY TORQUED)

1-BR 8x 9/16 x 1'-7 1/2-ac-FS

1-PL ag F.S.

RA

COMP SEE GN1

3/4 60°

1 1/2

1-BR ah

1-BR s

1-PL-y

1-PL 18x24x12'-11 7/8 m

1-PL 18x14x9'-11 7/8-w

4:12 25% R.T.

10" R.T.

1-BR 6 0 15/16 x 3/8 x 55'-0 9/16 b

5 @ 4'-6 = 22'-6

4'-6 1/16

4 @ 4'-6 = 18'-0

22'-6 1/16

5 @ 3'-9 = 18'-9

22'-6

3'-9

4 @ 3'-2 9/16 = 12'-10 4

13'-11 15/16

13'-0

9'-11 15/16

1'-1 11/16

13 @ 4 = 4'-4

5'-0

ag

ab

ac

af

ad

RA

2-PLS 13x3/8x4'-7 1/2-aa
28-HSB 7/8"ϕ x 2 1/2
28-HW
(FINGER TIGHTEN)

1-PL 18x5/8x2'-1 1/2-ad-FS
16-HSB 7/8"ϕ x 3 3/4
16-HW
(FULLY TORQUED)

1-BR 8x5/8x2'-1 1/2-af

RA

33'-0

55'-1 1/16

51'-0 15/16

16'-3 1/2

55'-0 1/2 ℄ WEB SHR TO END @ BOTT

59'-0

110'-0 15/16 % BOTT FL'G

+0
-1/16

-1/8

℄ WEB SHR

MATCH LINE

RT

GIRDER 444A

FOR GEN NOTES SEE SHT GN1

			1	1	GIRDER	444A	5'-7x1/16x111-4
			S4	NO.	DESCRIPTION	MARK	REMARKS
INST.			REQUIRED LIST				

3/4 x 3'-7 CLIP ALL STIFF AS SHOWN

SPAN E9- ; LINE F

MATERIAL ASTM-A36
BOLTS 7/8"ϕ
OPEN HOLES 15/16" SEE GEN NOTES
A325 FIELD BOLTS —
SHOP CONTACT SURFACES NP
WELDING AS NOTED
PAINT 1 Coat TT.P 615d Type II
U.N. : See Note X

CUSTOMER TENNESSEE DEPT OF HIGHWAYS
ARKANSAS STATE HIGHWAY COMMISSION
STRUCTURE EAST APPROACH-MISS RIVER BRIDGE
PROJ I-40-1(11G)0 - MEMPHIS - TENN.

BETHLEHEM STEEL CORPORATION
FABRICATED STEEL CONSTRUCTION
CHICAGO DRAFTING ROOM LEETSDALE WORKS
MADE BY SAK DATE IN CHARGE F.J.K
CHECKED BY DATE 3-3-71 SHOP NO.
CONTRACT CE6472-000 DRAWING NO. 444 BB

S1 4-5-71 NO DATE INIT REVISION

SUBMITTAL 1 2 3 4 5 6 7 8 9 0
DATE

For location of details shown on this sheet refer to diagrams.
E401

MICROFILMED

36663 11-67

11-48-60

NO PAINT TOP OF TOP FLG FULL LENGTH

GIRDER 445A

SPAN E9 LINE E

SECT A-A
(TYP INTERMEDIATE STIFF)

SECT B-B

NOTE X
Both faces of material adjacent to slip critical holes must be free of burrs, loose scale, and paint for a distance of from the group of holes.

MATERIAL	SEE DRWG 445 BB
RIVETS OR BOLTS	
OPEN HOLES	
A325 FIELD BOLTS	
SHOP CONTACT SURFACES	
PAINT	

CUSTOMER TENNESSEE DEPT OF HIGHWAYS
ARKANSAS STATE HIGHWAY COMMISSION
STRUCTURE EAST APPROACH - MISS RIVER BRIDGE
PROJ I-40-1(116)0 - MEMPHIS - TENN.

BETHLEHEM STEEL CORPORATION
FABRICATED STEEL CONSTRUCTION

CHICAGO DRAFTING ROOM — LEETSDALE, WORKS
MADE BY SAE DATE 2-11-71 IN CHARGE FJK
CHECKED BY DATE 3-3-71 SHOP NO.
CONTRACT CE6472-000 DRAWING NO. 445AB

SUBMITTAL DATE | REVISION NO 51 | DATE 45 | INT. BJ

For location of details shown on this sheet refer to diagrams
E401

MICROFILMED

M-48-61

NO PAINT TOP OF TOP FLG'S FULL LENGTH

61'-9

12'-0

12'-0 3/8

COMP SEE GN1

COMP SEE GN1

1-PL 18 x 1 x 12'-0-w

1-PL 18 x 7/8 x 12'-0 3/8-y

4'-2-25% RT

10" RT

1-BR ah

1-BR ah

1-BR ah

1-BR ah

1-BR ah

1-BR ah

1-BR ah

1-BR {ts NS / s-FS

1-BR {ts NS / s-FS

1 WEB PL 60 3/8 x 53'-1 9/16 L

ag

ag

at

ab

ac

af

ad

RA

RA

4'-6 1/16

4 @ 4'-6 = 18'-0

22'-6 1/16

5 @ 3'-9 = 18'-9

22'-6

3'-9

4 @ 3'-2 9/16 = 12'-10 1/4

13'-11 15/16

11'-11 15/16

1'-1 11/16

15'-5 1/4

12'-0

30'-10 1/2

53'-1 1/2

53'-1 7/16 ℄ WEB SPL TO END @ BOTT

59'-0

106'-2 15/16 % AT BOTT

+0 / -1/16

-1/8

℄ WEB SPL

1-PL-ba

1-PL 18 x 24 x 11'-11 7/8-n

1-PL 18 x 14 x 11'-11 7/8-p

2-PLS 13 x 3/8 x 4'-7 1/2-aa
28 HSB 7/8"ϕ x 2 1/2
28 HW
(FINGER TIGHTEN)

1-PL 18 x 5/8 x 0'-9 1/2 at

1-BR 8 x 9/16 x 1'-7 1/2 ac-FS.

1-PL 18 x 1/2 x 1'-7 1/2-ab
12-HSB 7/8"ϕ x 3 3/4
12-HW
(FULLY TORQUED)

1-PL 18 x 5/8 x 2'-1 1/2 ad-FS.
16-HSB 7/8"ϕ x 4
16-HW
(FULLY TORQUED)

1-BR 8 x 5/8 x 2'-1 1/2-af

1-PL 18 x 4 x 1'-0 1/2 ak

RT

1-PL ag

1-PL ag

1'-0 11/16

11 1/16

MATCH LINE

GIRDER 445A

CAMBER DIAGRAM

FOR GEN NOTES SEE SHT GN1

3/4 x 3/4 CLIP ALL STIFF AS SHOWN

			1	1	GIRDER	445A	55x23x107-4
			S4	NO.	DESCRIPTION	MARK	REMARKS
INST.			REQUIRED LIST				

SPAN E9 - LINE E

MATERIAL ASTM-A36
BOLTS 7/8"ϕ
OPEN HOLES 15/16"ϕ SEE GEN NOTES
A325 FIELD BOLTS
SHOP CONTACT SURFACES NP
WELDING: AS NOTED
PAINT 1 Coat TT-P 615d Type II U.N.: See Note "X"

CUSTOMER TENNESSEE DEPT OF HIGHWAYS
ARKANSAS STATE HIGHWAY COMMISSION
STRUCTURE EAST APPROACH-MISS RIVER BRIDGE
PROJ I-40-1(11)6 0 - MEMPHIS - TENN.

BETHLEHEM STEEL CORPORATION
FABRICATED STEEL CONSTRUCTION
LEETSDALE WORKS

CHICAGO DRAFTING ROOM
MADE BY SAE DATE 4-11-71 IN CHARGE FJK
CHECKED BY DJ DATE 5-4-71 SHOP NO

CONTRACT CE6472-000 DRAWING NO. 445 BB

NO	DATE	INIT
5	4-5	DJ

REVISION

SUBMITTAL / DATE

36663 11-69

For location of details shown on this sheet refer to diagrams.

E401

MICROFILMED

M-48-62

NO PAINT TOP OF TOP FL'G FULL LENGTH

1-PL 18×3/8×0'-9½ as ⊂T

9'-5 15/16 | 11'-0 | 48'-3

1-PL 18×7/8×9'-5 15/16 C/A

COMP SEE GN1

1-PL 18×1×11'-0 d

1-PL 18×1¼×48'-3 f

as

5'-0 = 13@4 = 4'-4

RA

4-BR 5×3/8×4'-11 ah

1-BR ah

1-WEB PL 60 1/16×3/8×47'-4 15/16 a

1-BR 5×3/8×4'-11 ah TENS. S-FS

ag

1-PL 18×1⅛×9'-5 7/8 K C/A

an

1-PL 18×1¾×10'-11 7/8 m

1-PL 18×2¼×48'-2 7/8 m

3@3'-9 = 11'-3

5@4'-6 = 22'-6

13'-2 7/8

22'-6

22'-6 1/16

9'-5 15/16

11'-0

48'-3

47-4 1/16 END TO ℄ WEB SPL

35'-8 7/8

59'-0

94'-8 7/8 % BOTT. FL'G

1-PL 18×⅞×1'-0½ am ⊂T

RA

1-PL 17×3/8×2'-8½-ag

TYP

MATCH LINE

GIRDER 448A

SECT A-A
(TYP. INTERMEDIATE STIFF)

SECT B-B

SPAN E9 LINE B

MATERIAL
RIVETS OR BOLTS
OPEN HOLES
A325 FIELD BOLTS
SHOP CONTACT SURFACES
PAINT

SEE DRWG 448 BB

NO	DATE	INIT.	REVISION
5	4-5	EJ	

SUBMITTAL DATE | 1 | 2 | 3 | 4 | 5 | 6 | 7 | 8 | 9 | 0

CUSTOMER TENNESSEE DEPT OF HIGHWAYS
ARKANSAS STATE HIGHWAY COMMISSION
STRUCTURE EAST APPROACH - MISS. RIVER BRIDGE
PROJ I-40-1(116)0 - MEMPHIS - TENN.

BETHLEHEM STEEL CORPORATION
FABRICATED STEEL CONSTRUCTION
CHICAGO DRAFTING ROOM LEETSDALE WORKS
MADE BY SAK DATE 2-17-71 IN CHARGE FJK
CHECKED BY EJ DATE 3-9-71 SHOP NO.
CONTRACT CE6472-000 DRAWING NO. 448AB

For location of details shown on this sheet refer to diagrams.

E401

M-48-67

MICROFILMED

NO PAINT TOP OF TOP FL'G FULL LENGTH

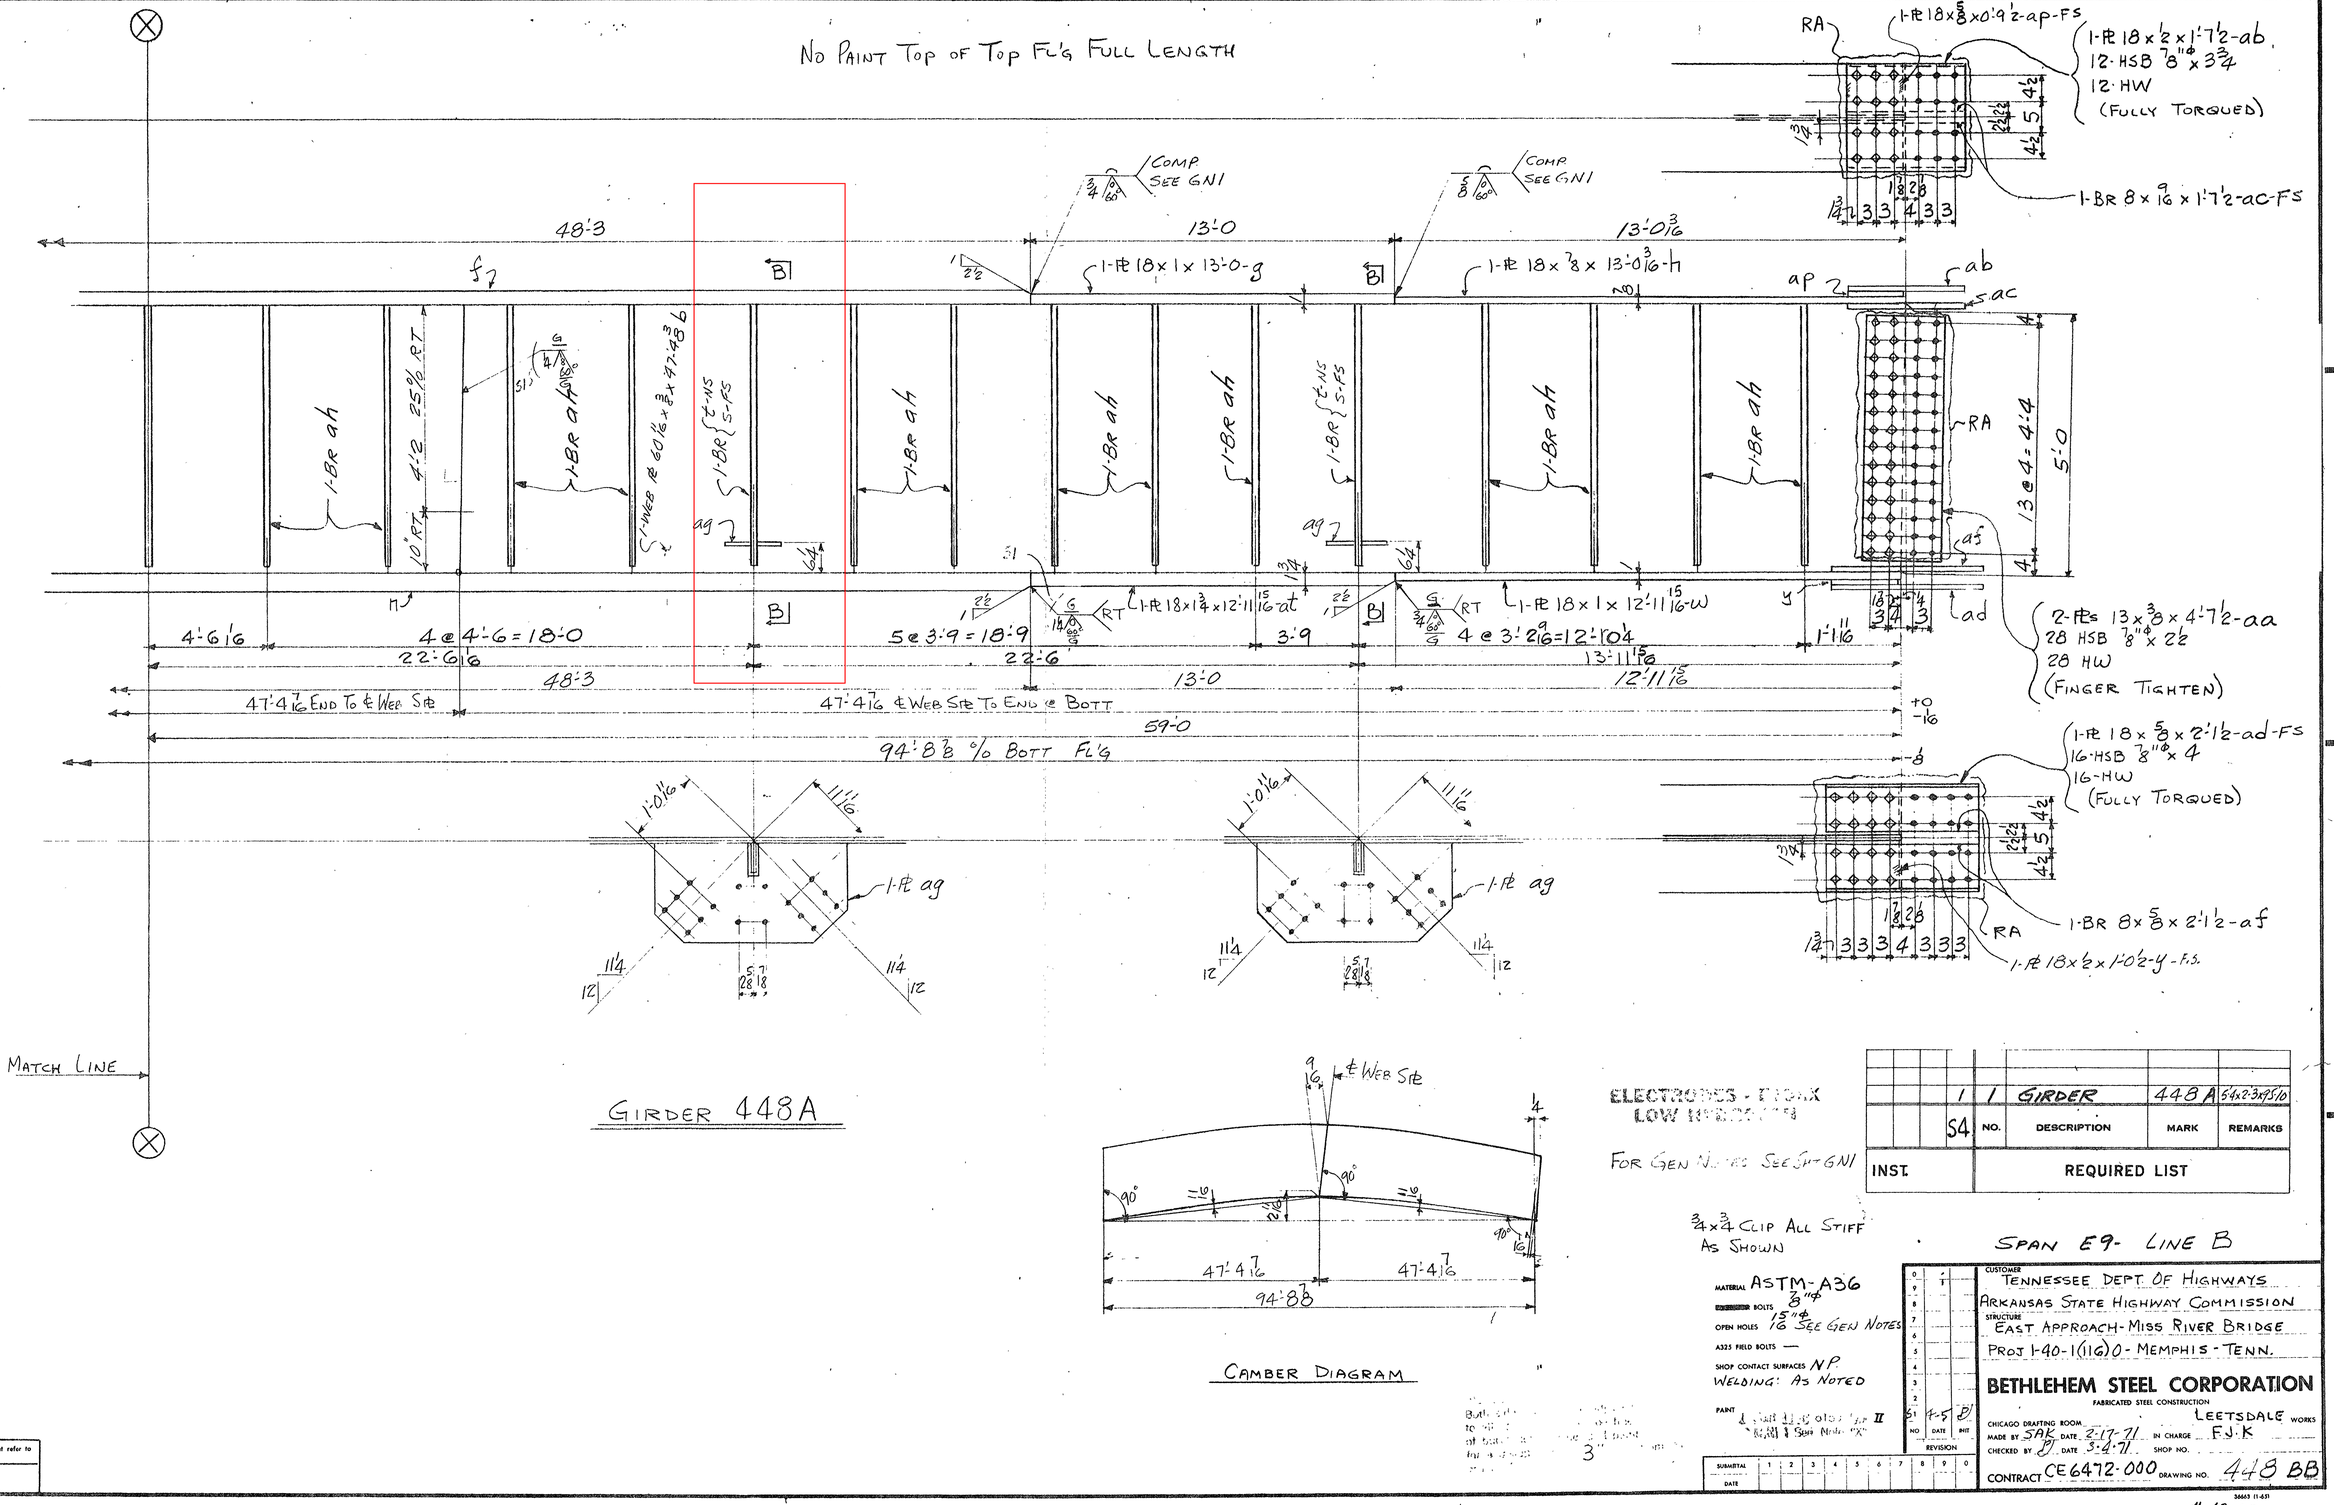

			1	1	GIRDER	448A	54x23x95/10
		S4	NO.		DESCRIPTION	MARK	REMARKS
INST.			REQUIRED LIST				

ELECTRODES - E70XX LOW HYDROGEN

FOR GEN NOTES SEE SHT GN1

3/4 x 3/4 CLIP ALL STIFF AS SHOWN

SPAN E9- LINE B

MATERIAL ASTM-A36
BOLTS 7/8" ϕ
OPEN HOLES 15/16" ϕ SEE GEN NOTES
A325 FIELD BOLTS —
SHOP CONTACT SURFACES N.P.
WELDING: AS NOTED
PAINT ... SYSTEM II

SUBMITTAL	1	2	3	4	5	6	7	8	9	0
DATE										

NO	DATE	INIT
1	4-5	BJ

REVISION

CUSTOMER TENNESSEE DEPT. OF HIGHWAYS
ARKANSAS STATE HIGHWAY COMMISSION
STRUCTURE EAST APPROACH-MISS RIVER BRIDGE
PROJ I-40-1(11G)0 - MEMPHIS - TENN.

BETHLEHEM STEEL CORPORATION
FABRICATED STEEL CONSTRUCTION
LEETSDALE WORKS

CHICAGO DRAFTING ROOM
MADE BY SAK DATE 2-17-71 IN CHARGE F.J.K
CHECKED BY BJ DATE 3-4-71 SHOP NO.
CONTRACT CE6472-000 DRAWING NO. 448 BB

36663 11-631

For location of details shown on this sheet refer to diagrams.
E401

MICROFILMED

11-48-68

NO PAINT ON TOP OF TOP FL'G FULL LENGTH

90'-11⅛ % TOP FL'G

1-PL 18 x ⅜ x 90'-11⅛-C

1-PL 18 x ⅞ x 0'-9½-M

1-PL 18 x 1 x 10'-5 15/16-d

1-PL 18 x 1½ x 9'-11 15/16-f

1-PL 18 x 2 x 45'-4⅞-g

1-WEB PL 60 9/16 x ⅜ x 45'-5 7/8-a

1-BR a/h

1-BR 5 x ⅜ x 4'-11 a/h

1-BR 5 x ⅜ x 4'-11 S

1-BR S

RA

M

MT

RT 6/10 = 3/5

5 @ 4'-6 = 22'-6

22'-6

45'-5

10'-0

10'-5 15/16

9'-4⅞

3'-9

3'-9

1'-10⅞

4'-6 1/16

22'-6 1/16

45'-5 7/16 END TO ℄ WEB STR

31'-10⅞

90'-10⅞ % BOTT FL'G

59'-0 T. END @ BOTT

MATCH LINE

GIRDER 449A

SECT A-A
(TYP. INTERMEDIATE STIFF)

SECT B-B

SPAN E9 LINE A

MATERIAL
RIVETS OR BOLTS
OPEN HOLES
A325 FIELD BOLTS
SHOP CONTACT SURFACES
PAINT
SEE DRW'G 449 BB

REVISION
NO | DATE | INIT
S1 | 4-5-71 | PJ

SUBMITTAL DATE | 0 1 2 3 4 5 6 7 8 9

CUSTOMER TENNESSEE DEPT OF HIGHWAYS
ARKANSAS STATE HIGHWAY COMMISSION
STRUCTURE EAST APPROACH - MISS RIVER BRIDGE
PROJ I-40-1(116)0 - MEMPHIS - TENN.

BETHLEHEM STEEL CORPORATION
FABRICATED STEEL CONSTRUCTION
CHICAGO DRAFTING ROOM LEETSDALE WORKS
MADE BY SAK DATE 2-18-71 IN CHARGE FJE
CHECKED BY [illegible] DATE 3-4-71 SHOP NO.
CONTRACT CE6472-000 DRAWING NO 449AB

38663 (1-65)

For location of details shown on this sheet refer to diagrams.
E401

MICROFILMED

11-48-69

NO PAINT TOP OF TOP FLG FULL LENGTH

90'-11⅛ ℄ TOP FLG

1-BR ah

1-BR S

1-WEB PL 60⅛ x ⅜ x 45'-5⅜ b

10 RT 4'-2 25% RT

5 G 60° 1/16

4'-6 1/16

4 @ 4'-6 = 18'-0

22'-6 1/16

45'-5

45'-5 7/16 ℄ WEB SHL TO END

5 @ 3'-9 = 18'-9

22'-6

1-PL 18 x 1½ x 11'-11 15/16 h

3'-9

12'-0

4 @ 3'-2 9/16 = 12'-10 4

13'-11 15/16

12'-11 15/16

45'-5 7/16 ℄ WEB SHL TO END @ BOTT

59'-0

90'-10 7/8 ℄ BOTT FLG

1-PL 18 x ⅞ x 12'-11 15/16 k

1'-1 11/16

MATCH LINE

GIRDER 449A

1-PL 18 x ½ x 0'-9½ p-FS

1-PL 18 x ½ x 1'-7½ -ab
12-HSB ⅞"ϕ x 3¾
12-HW
(FULLY TORQUED)

1-BR 8 x 9/16 x 1'-7½ ac-FS

RA

P

ab

ac

4

13 @ 4 = 4'-4

5'-0

RA

as

ad

2-PLFS 13 x ⅜ x 4'-7½ -aa
28 HSB ⅞"ϕ x 2½
28 HW
(FINGER TIGHTEN)

+0
-16

1-PL 18 x ⅝ x 2'-1½ -ad-FS
16-HSB ⅞"ϕ x 4
16-HW
(FULLY TORQUED)

1-BR 8 x ⅝ x 2'-1½ -af

RA

1-PL 18 x ½ x 1'-0½ -t-FS

51 G 1/16 60° G RT

℄ WEB SHL

½

¼

90°

0-6

2½

90°

0-6

90°

45'-5 7/16

45'-5 7/16

90'-10⅞

CAMBER DIAGRAM

ELECTRODES - E70XX
LOW HYDROGEN

FOR GEN NOTES SEE SHT GN1

			1	1	GIRDER	449 A	54x146x92-0
			S4	NO.	DESCRIPTION	MARK	REMARKS
INST.			REQUIRED LIST			

3"x3"x¼ CLIP ALL STIFF AS SHOWN

SPAN E9- LINE A

MATERIAL ASTM-A36
BOLTS ⅞"ϕ
OPEN HOLES 15/16"ϕ SEE GEN NOTES
A325 FIELD BOLTS —
SHOP CONTACT SURFACES N.P.
WELDING: AS NOTED
PAINT

51 4-5-81
NO DATE INIT
REVISION

SUBMITTAL
DATE

CUSTOMER TENNESSEE DEPT OF HIGHWAYS
ARKANSAS STATE HIGHWAY COMMISSION
STRUCTURE EAST APPROACH-MISS RIVER BRIDGE
PROJ I-40-1(116)0 - MEMPHIS - TENN.

BETHLEHEM STEEL CORPORATION
FABRICATED STEEL CONSTRUCTION
LEETSDALE WORKS

CHICAGO DRAFTING ROOM
MADE BY SNK DATE 3-18-71 IN CHARGE FJK
CHECKED BY DATE 3-24-71 SHOP NO

CONTRACT CE6472-000 DRAWING NO 449 BB

20603 (1-65)

M-48-70

For location of details shown on this sheet refer to diagrams.

E401

MICROFILMED

NO PAINT ON TOP OF TOP FLG FULL LENGTH.

COMP — TENSION

10'-0 | 10'-0 | 12'-1 5/8 | 10'-0 | 11'-0 | 25'-0

1-PL 12 x 1 3/8 x 1'-0 1/2 ba <T

1-PL 12 x 1 3/8 x 10'-0-C

1-PL 12 x 1 1/16 x 10'-0-d

1-PL 12 x 1/2 x 12'-1 5/8-f

1-PL 12 x 5/8 x 10'-0-g

1-PL 12 x 1/4 x 10'-11 15/16-h

1-PL 12 x 2 1/2 x 24'-11 7/8-k

1-BR 5 x 3/8 x 4'-11 ah

1-WEB PL 60 1/16 x 3/8 x 43'-6 11/16-a

1-BR 5 x 3/8 x 4'-11-t

1-BR-t

1-WEB PL 60 1/4 x 3/8 x 43'-7-b

1-BR-5 x 3/8 x 4'-11-s

1-BR 5 1/2 x 1 15/16 x 5'-0 (MIE) P-NS T-FS

1-PL 12 x 7/8 x 32'-1 5/8-m

1-PL-c | 1-PL-h | 1-PL-k | 1-SOLE PL-402B DETAILED ON SNT 402

5'-2 3/4 | 5'-0 | 13 @ 4'-4 | 4'-0

4 @ 4'-3 5/8 = 17'-2 1/2 | 4 @ 4'-3 5/8 = 17'-2 1/2 | 5 @ 3'-7 = 17'-11

4'-3 9/16 | 3'-7 1/16 SPL SPLICE | 2'-0 13/16 | 2'-0 13/16 | 4'-1 5/8

19'-11 1/8 | 21'-6 1/16 | 21'-6 1/16

10'-0 | 32'-1 5/8 | 11'-0 | 25'-0

43'-6 3/4 | 43'-6 13/16 ℄ WEB SPL TO END @ BOTT

67'-1 5/8

87'-1 9/16 % BOTT. FLG.

℄ BRG & MATCH LINE (PIER 10)

GIRDER 430A

SEC. A-A (TYP. INTERM STIFF @ TENSION)

SEC. B-B

SEC. C-C

SEC D-D (TYP INTER. STIFF @ COMP)

SEC. F-F

For location of details shown on this sheet refer to diagrams: E 402

MATERIAL
BIVETS OR BOLTS
OPEN HOLES
A325 FIELD BOLTS
SHOP CONTACT SURFACES
PAINT
SEE 430BB

SPAN E10-E11
LINE "F"
PIER # 10

CUSTOMER: TENNESSEE DEPT. OF HIGHWAYS / ARKANSAS STATE HIGHWAY COMMISSION
STRUCTURE: EAST APPROACH - MISS. RIVER BRIDGE / PROJ. I-40-1(116)0 - MEMPHIS - TENN.

BETHLEHEM STEEL CORPORATION
FABRICATED STEEL CONSTRUCTION
LEETSDALE WORKS

CHICAGO DRAFTING ROOM
MADE BY SAK DATE 1-27-71 IN CHARGE F.J.K.
CHECKED BY DATE 2-22-71 SHOP NO

CONTRACT CEG472-000 DRAWING NO 430 NB

REVISION: NO 5 — DATE 4-5-71 — INIT. Nab

SUBMITTAL / DATE

36663 11-431

111-48-350

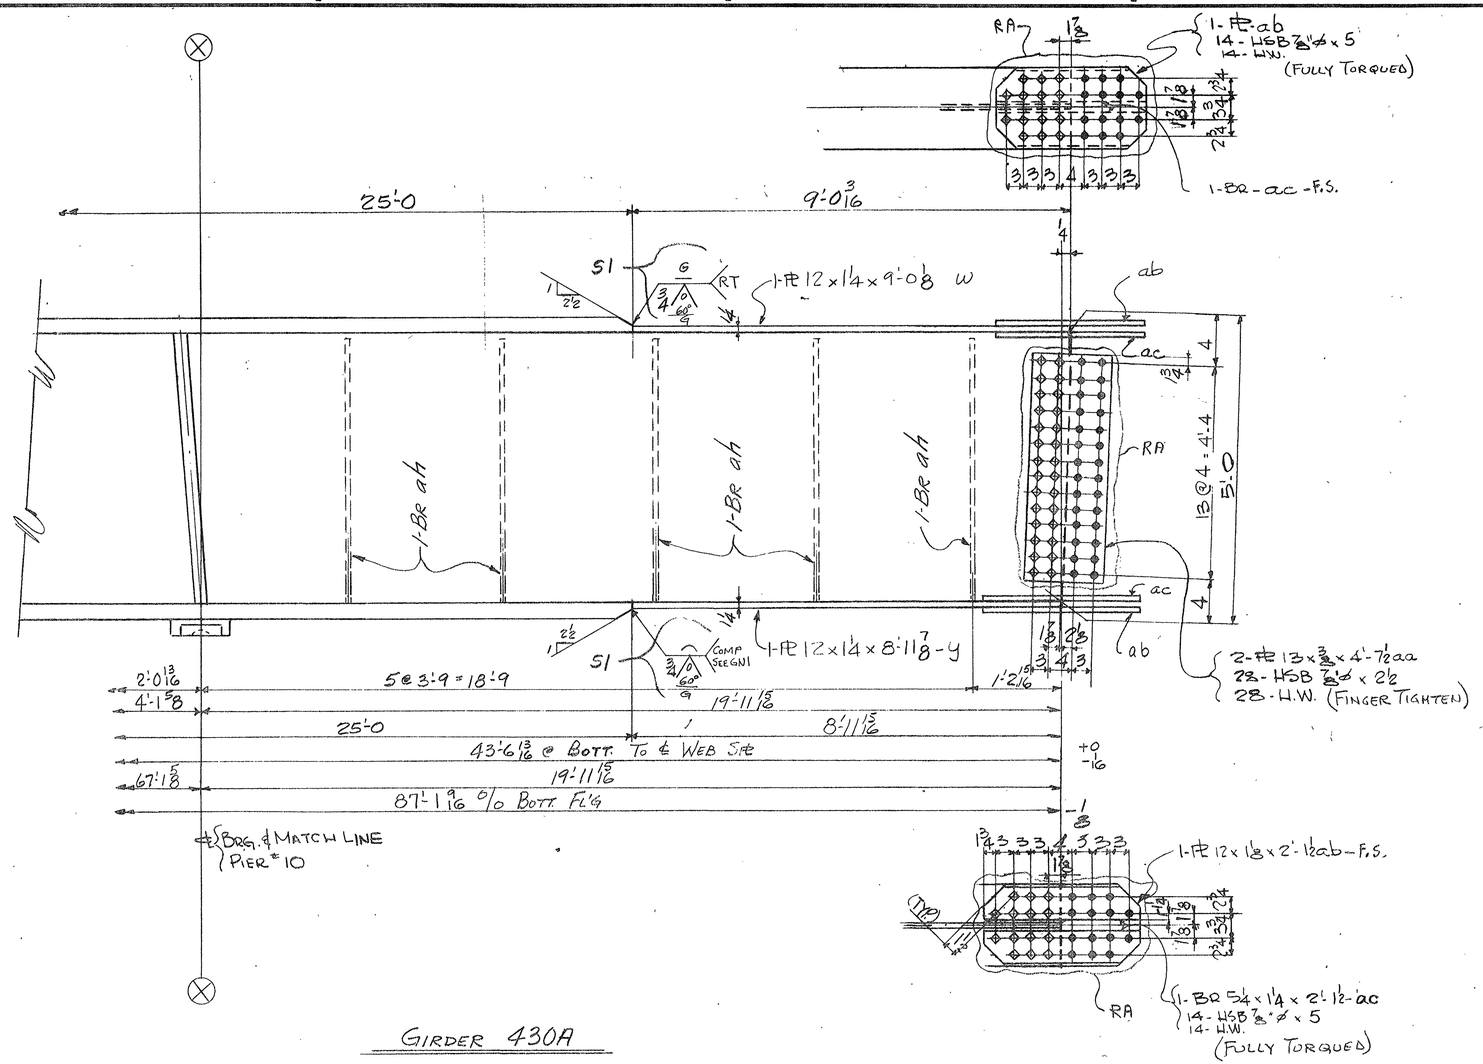

GIRDER 430A

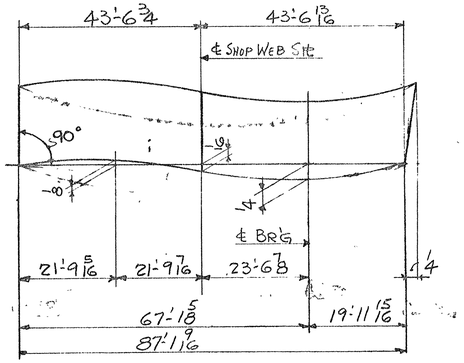

CAMBER DIAGRAM

(SHOP WEB PL SPLICE SHALL BE WELDED BEFORE CUTTING PLATE)

SPAN E10 - E11

PIER 10 - LINE "F"

	1	1	GIRDER	430A	58x10x88'3
	S2	NO.	DESCRIPTION	MARK	REMARKS
INST.		REQUIRED LIST			

FOR GEN. NOTES SEE SHEET GN1

3/4 x 3/4" CLIP ALL STIFF. AS SHOWN

ELECTRODES - E70XX LOW HYDROGEN

NOTE X

Both sides of material adjacent to all open holes must be free of burrs, loose scale, and paint for a distance of 3" from the group of holes.

MATERIAL ASTM-A36

RIVETS OR BOLTS 7/8" ø

OPEN HOLES 15/16" SEE GEN. NOTES

A325 FIELD BOLTS —

SHOP CONTACT SURFACES N.P

WELDING AS NOTED

MILLING AS NOTED

PAINT

1 Coat II-P 615d Type II S

U.N. 1 See Note 4 X 1

NO	DATE	INIT	REVISION
1	4-5-71	PJK	

SUBMITTAL DATE 1 2 3 4 5 6 7 8 9 0

CUSTOMER: TENNESSEE DEPT. OF HIGHWAYS; ARKANSAS STATE HIGHWAY COMMISSION

STRUCTURE: EAST APPROACH - MISS. RIVER BRIDGE

PROJ. I-40-1(116)0 - MEMPHIS - TENN.

BETHLEHEM STEEL CORPORATION

FABRICATED STEEL CONSTRUCTION

CHICAGO DRAFTING ROOM — LEETSDALE WORKS

MADE BY SAK DATE — IN CHARGE PJK

CHECKED BY — DATE 2-22-71 SHOP NO

CONTRACT CEG472-000 DRAWING NO 430 BB

36663 (7-69)

11-48-B6

For location of details shown on this sheet refer to diagrams

E402

MICROFILMED

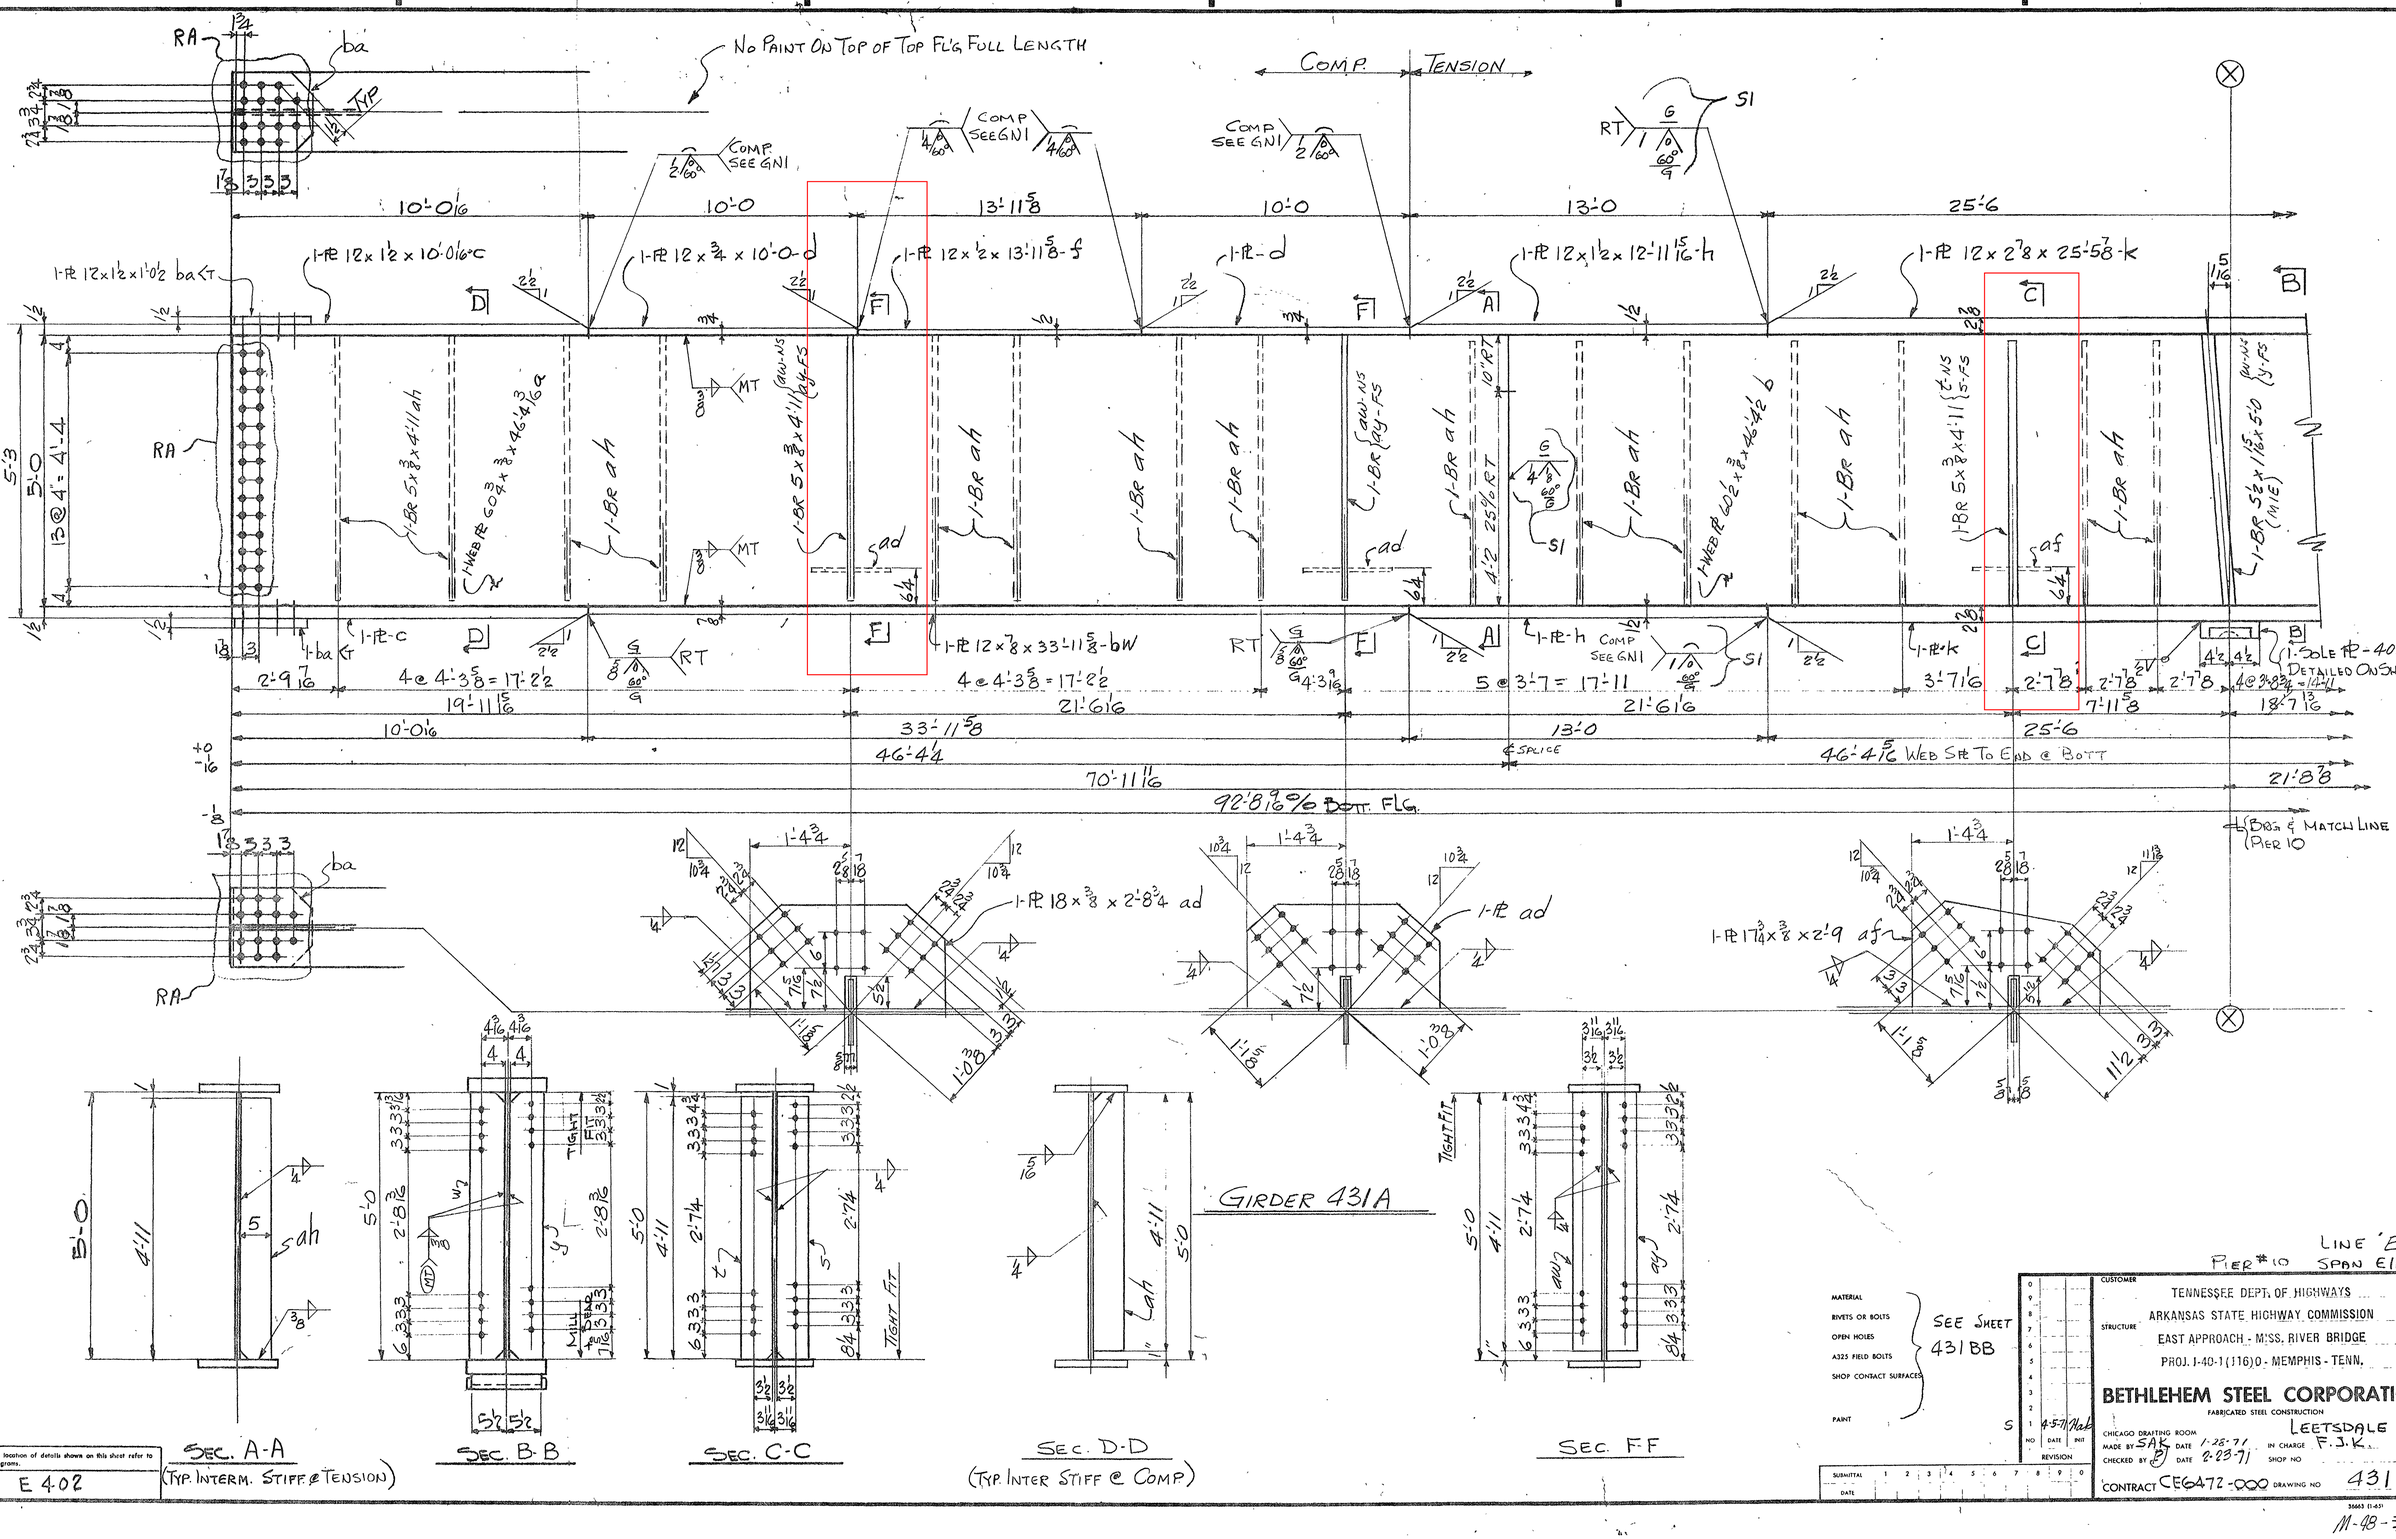
RA
ba
TYP
No Paint On Top of Top Flg Full Length
COMP
TENSION
COMP SEE GN1
1-PL 12x1½x1'0½ bar
1-PL 12x1½x10'0 16-c
1-PL 12x¾x10'-0-d
1-PL 12x½x13'11⅝-f
1-PL-d
1-PL 12x1½x12'-11 15/16-h
1-PL 12x2⅞x25'-5⅞-k
1-BR 5x⅜x4'-11 ah
1-BR 5x⅜x4'-11 (SAW-NS 5-FS) ad
1-BR 5x⅜x4'-11 (SAW-NS 5-FS) af
1-BR 5⅝x1⅝x5'-0 (SAW-NS 5-FS) (M1E)
1-PL 602'x⅜x46'-4⅜ a
1-PL 602'x⅜x46'-4⅜ b
1-PL 12x⅞x33'-11⅝-bW
1-PL-c
1-PL-h
1-PL-k
1-SOLE PL-402B
DETAILED ON SHT 402
5'-3
5'-0
13@4"=4'-4
10'-0 16
10'-0
13'-11⅝
13'-0
25'-6
2'-9 7/16
4@4'-3⅝=17'-2½
5@3'-7=17'-11
3'-7 1/16
2'-7⅞
4@3'-8¾=14'-11
18'-7 13/16
19'-11 15/16
21'-6 1/16
7'-11⅝
33'-11⅝
46'-4¼
70'-11 11/16
92'-8 9/16" BOTT. FLG.
46'-4⅝ WEB SPL TO END @ BOTT
21'-8⅞
13'-0 ℄ SPLICE
℄ BRG & MATCH LINE (PIER 10)
1-PL 18x⅞x2'-8¾ ad
1-PL ad
1-PL 17¾x⅜x2'-9 af
GIRDER 431A
SEC. A-A (TYP. INTERM. STIFF @ TENSION)
SEC. B-B
SEC. C-C
SEC. D-D (TYP. INTER STIFF @ COMP)
SEC. F-F
MATERIAL
RIVETS OR BOLTS
OPEN HOLES
A325 FIELD BOLTS
SHOP CONTACT SURFACES
PAINT
SEE SHEET 431 BB
For location of details shown on this sheet refer to diagrams.
E 4-02
LINE "E"
PIER #10 SPAN E10-E11
CUSTOMER TENNESSEE DEPT. OF HIGHWAYS
STRUCTURE ARKANSAS STATE HIGHWAY COMMISSION
EAST APPROACH - MISS. RIVER BRIDGE
PROJ. I-40-1(116)0 - MEMPHIS - TENN.
BETHLEHEM STEEL CORPORATION
FABRICATED STEEL CONSTRUCTION
CHICAGO DRAFTING ROOM LEETSDALE WORKS
MADE BY SAK DATE 1-28-71 IN CHARGE F.J.K.
CHECKED BY DATE 2-23-71 SHOP NO
CONTRACT CEG472-000 DRAWING NO 431 AB
NO DATE REVISION
4-5-71 Rev
SUBMITTAL DATE
36663 (1-63)
M-48-37
MICROFILMED

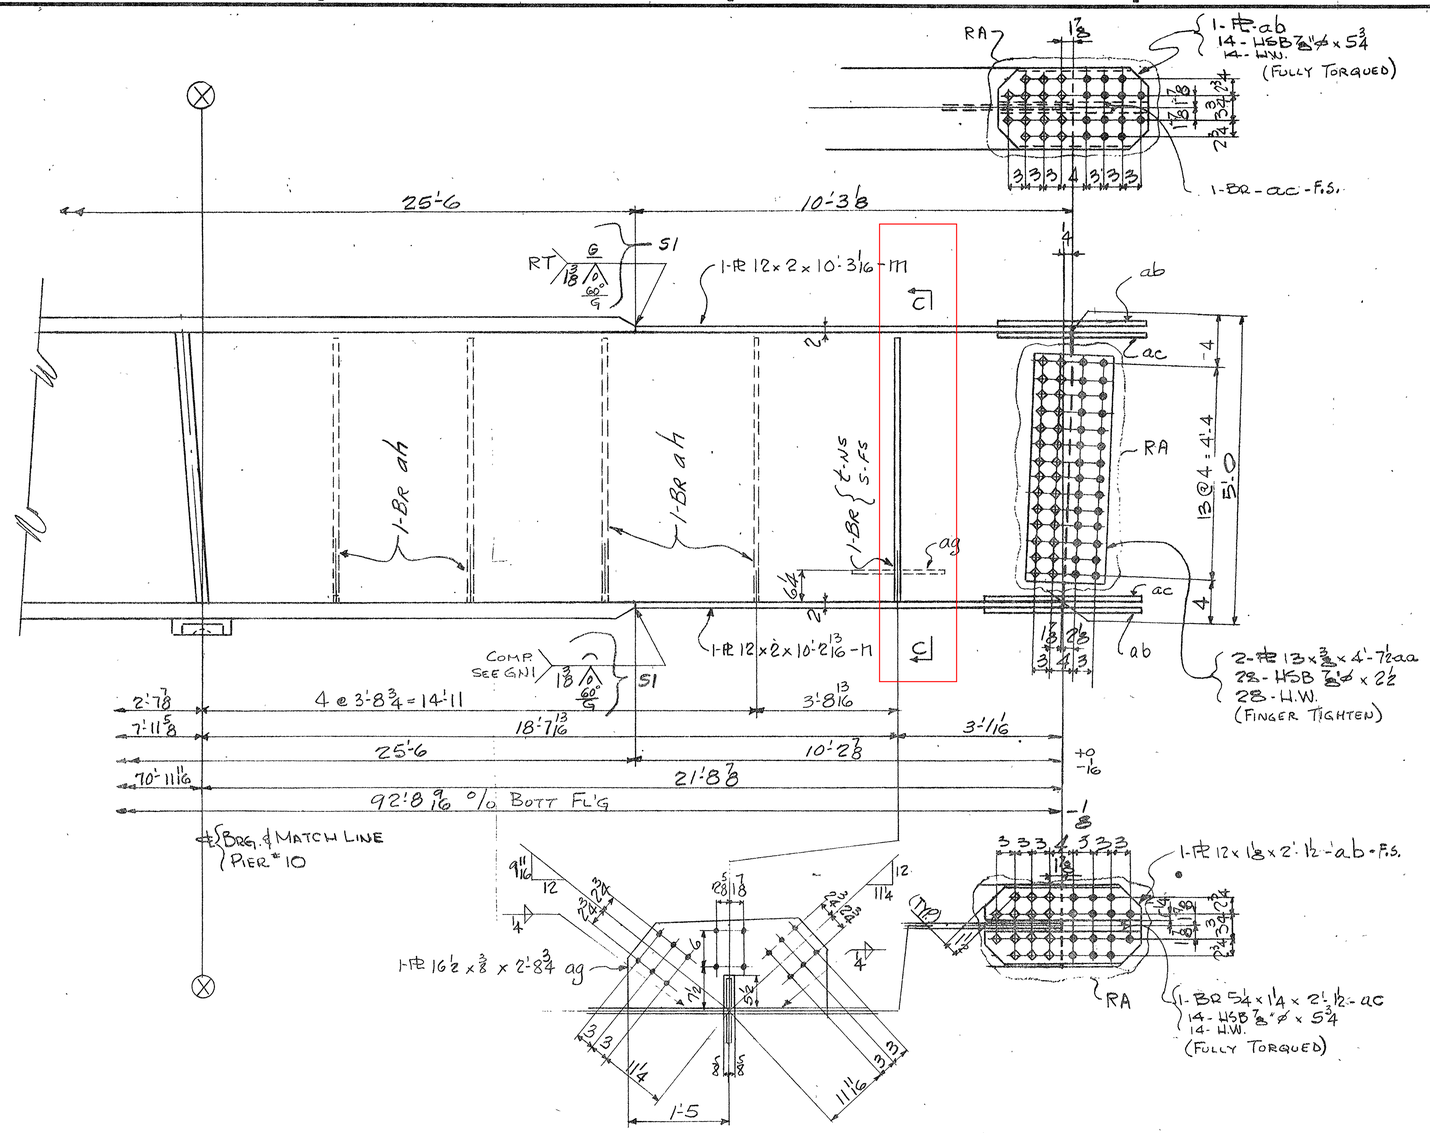

GIRDER 431A

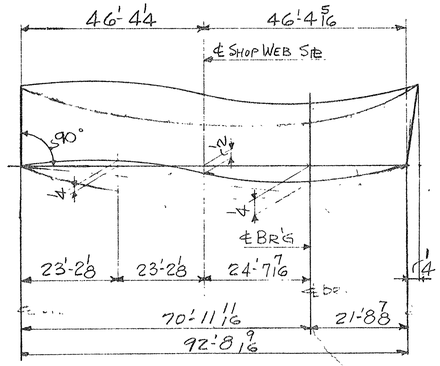

CAMBER DIAGRAM

(SHOP WEB & SPLICE SHALL BE WELDED BEFORE CUTTING PLATE)

SPAN E10-E11

PIER 10 - LINE E

FOR GEN. NOTES SEE SHEET GN1

1	1	GIRDER	431A	54x1-10x93-10
52	NO.	DESCRIPTION	MARK	REMARKS
INST.		REQUIRED LIST		

ELECTRODES - E70XX LOW HYDROGEN

1 3/4 x 3/4 " CLIP ALL STIFF. AS SHOWN

MATERIAL A5TM-A36

BOLTS 3/4"ø

OPEN HOLES 15/16 SEE GEN NOTES

A325 FIELD BOLTS

SHOP CONTACT SURFACES N.P.

WELDING: AS NOTED

MILLING AS NOTED

PAINT 1 Coat IT-F 615d Type II @ D.N.T. See Note "X"

NOTE X

Both sides of material adjacent to all open holes must be free of burrs, loose scale, and paint for a distance of 3" from the group of holes.

NO	DATE	INIT
1	4-5-71	Hcb

REVISION

SUBMITTAL	1	2	3	4	5	6	7	8	9	0
DATE										

CUSTOMER TENNESSEE DEPT. OF HIGHWAYS

ARKANSAS STATE HIGHWAY COMMISSION

STRUCTURE EAST APPROACH - MISS. RIVER BRIDGE

PROJ. I-40-1(116)0 - MEMPHIS - TENN.

BETHLEHEM STEEL CORPORATION

FABRICATED STEEL CONSTRUCTION

CHICAGO DRAFTING ROOM LEETSDALE WORKS

MADE BY SAE DATE 1-25-71 IN CHARGE F.J.K.

CHECKED BY DJ DATE 2-23-71 SHOP NO.

CONTRACT CEG477-000 DRAWING NO. 431 BB

For location of details shown on this sheet refer to diagrams.

E402

MICROFILMED

NO PAINT ON TOP OF TOP FLG FULL LENGTH

COMP — TENSION

10'-0 1/16 | 10'-0 | 16'-9 5/8 | 10'-0 | 13'-0 | 26'-9

1-PL 12 x 1 1/8 x 1'-0 1/2 bar T | 1-PL 12 x 12 x 10'-0 1/16-c | 1-PL 12 x 3/4 x 10'-0-d | 1-PL 12 x 1/2 x 16'-9 5/8-f | 1-PL-d | 1-PL 12 x 1 1/2 x 12'-11 15/16-h | 1-PL 12 x 3 x 26'-8 7/8-k

RA | 1-BR 5 x 3/8 x 4'-11-ah | 1-WEB PL 60 1/4 x 3/8 x 49'-1 3/4-a | 1-BR-ah | 1-BR 5 x 3/8 x 4'-11 (45°-NS & 45°-FS) | 1-BR-ah | 1-BR-ah | 1-BR-45°-NS 1-BR-45°-FS | 4'-2 - 25% RT | 1-BR-ah | 1-BR-ah | 1-WEB PL 60 1/16 x 3/8 x 49'-2 | 1-BR 5 x 3/8 x 4'-11 (45°-NS & 45°-FS) | 1-BR-ah | 1-BR-ah | 1-BR 52 1/2 x 15/16 x 5'-0 (MILE) (45°-NS & 45°-FS)

5'-3 | 5'-0 | 13 @ 4" = 4'-4 | 3/8 | 1/2

1-BA | 1-PL-C | 1-PL-D | 1-PL-F | 1-PL-A | 1-PL-K | 1-SOLE PL-402B DETAILED ON SHT 402

2'-9 7/16 | 4 @ 4'-3 5/8 = 17'-2 1/2 | 4'-3 9/16 | 4 @ 4'-3 5/8 = 17'-2 1/2 | 5 @ 3'-7 = 17'-11 | 3'-7 1/16 | 2'-11 3/8 | 2'-11 3/8 | 2'-11 3/8 | 2'-11 1/2 | 3'-8 3/8

19'-11 15/16 | 21'-6 1/16 | 21'-6 1/16 | 26'-9 | 11'-9 5/8 | 14'-9 7/8

10'-0 1/16 | 49'-1 13/16 | 36'-9 5/8 | 13'-0 | 49'-1 13/16 @ WEB SPL TO END @ BOTT. | 23'-5 15/16

74'-9 11/16 | 98'-3 5/8 @ BOTT. FLG.

+0 / -1/16 / -1/8

1-PL 12 3/4 x 3/8 x 2'-1 - ad | 1-PL-ad | 1-PL-ad | 1-PL 21 1/4 x 3/8 x 3'-0 1/4 af

9'-2 15/16 | 1'-0 1/2 | 1'-0 1/2 | 21'-6 1/16 | 1'-0 1/2 | 1'-0 1/2 | 21'-6 1/6 | 22'-6 5/8

1'-9 | BRG & MATCH LINE AT PIER 10

GIRDER 432A

SEC. A-A (TYP. INTERM. STIFFNER @ COMP)

SEC. B-B

SEC. C-C

SEC. D-D (TYP INTERM STIFF @ TENSION)

SEC. F-F

LINE "D" PIER 10 SPAN E1'-E11

MATERIAL
RIVETS OR BOLTS
OPEN HOLES
A325 FIELD BOLTS
SHOP CONTACT SURFACES
PAINT
SEE SHEET 432BB

For location of details shown on this sheet refer to diagrams: E 402

CUSTOMER: TENNESSEE DEPT. OF HIGHWAYS
ARKANSAS STATE HIGHWAY COMMISSION
STRUCTURE: EAST APPROACH - MISS. RIVER BRIDGE
PROJ. I-40-1(116)0 - MEMPHIS - TENN.

BETHLEHEM STEEL CORPORATION
FABRICATED STEEL CONSTRUCTION
CHICAGO DRAFTING ROOM LEETSDALE WORKS
MADE BY SAK DATE 2-2-71 IN CHARGE F.J.K.
CHECKED BY DJ DATE 2-23-71 SHOP NO.
CONTRACT CEG472-000 DRAWING NO. 432 NB

REVISION: NO. 1 DATE 4-5-71 INIT. Hab

SUBMITTAL DATE

M-48-39

MICROFILMED

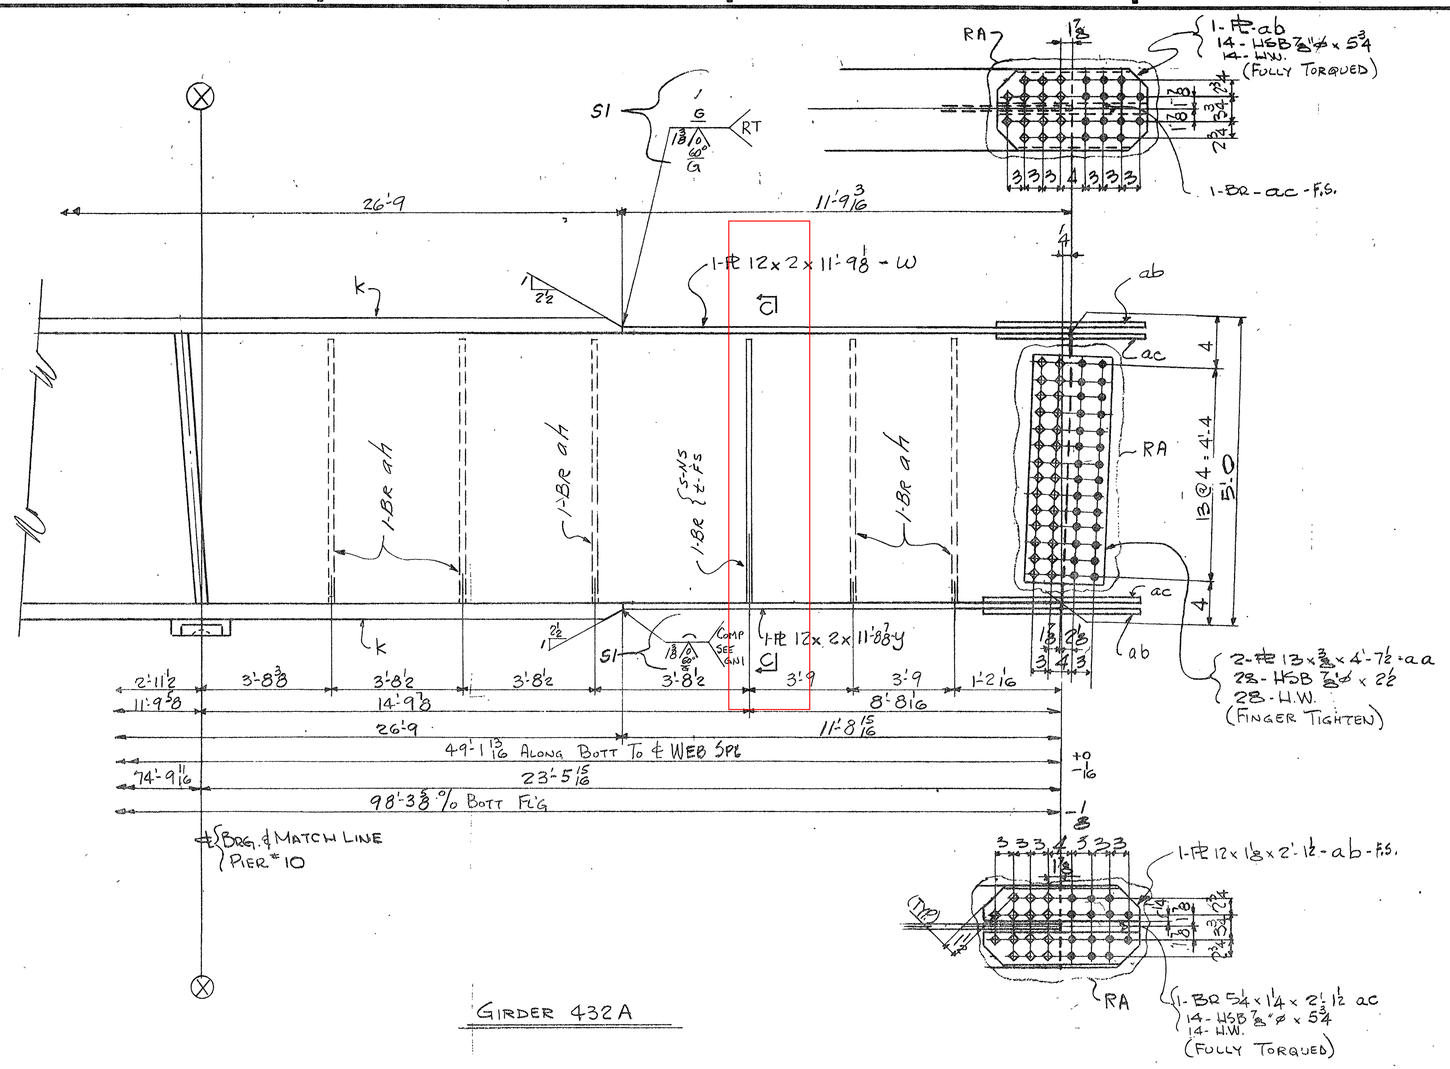

GIRDER 432 A

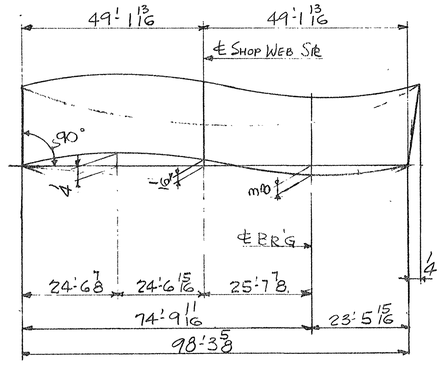

CAMBER DIAGRAM

(SHOP WEB PL SPL SHALL BE WELDED BEFORE CUTTING PL)

SPAN E10-E11

PIER 10 - LINE D

FOR GEN NOTES SEE SHEET GN1

3/4 x 3/4" CLIP ALL STIFF. AS SHOWN

	1	1	GIRDER	432 A
S2	NO.	DESCRIPTION	MARK	REMARKS
INST.		REQUIRED LIST		

MATERIAL ASTM-A36

BOLTS 7/8" ø

OPEN HOLES 15/16" ø See Gen Note

A325 FIELD BOLTS —

SHOP CONTACT SURFACES NP

WELDING: As Noted

MILLING: As Noted

PAINT 1 Coat ZT-P 615c Type II

U.N.: See Note DN

NOTE 3

Both sides of material adjacent to all open holes must be free of burrs, loose scale, and paint for a distance of 3" from the group of holes.

NO	DATE	INIT.	REVISION
1	4-5-71	Jlab	

SUBMITAL DATE 1 2 3 4 5 6 7 8 9 0

CUSTOMER TENNESSEE DEPT. OF HIGHWAYS

ARKANSAS STATE HIGHWAY COMMISSION

STRUCTURE EAST APPROACH - MISS. RIVER BRIDGE

PROJ. I-40-1(116)0 - MEMPHIS - TENN.

BETHLEHEM STEEL CORPORATION

FABRICATED STEEL CONSTRUCTION

CHICAGO DRAFTING ROOM LEETSDALE WORKS

MADE BY SAK DATE 2-2-71 IN CHARGE F.J.K.

CHECKED BY [illegible] DATE 2-23-71 SHOP NO.

CONTRACT CEG477-000 DRAWING NO. 432 BD

36663 (1-63)

For location of details shown on this sheet refer to diagrams

E402 1

MICROFILMED

M-48-40

NO PAINT ON TOP OF TOP FL'G FULL LENGTH

COMP | TENSION

10'-0 1/16 | 10'-0 | 19'-7 5/8 | 10'-0 | 13'-0 | 28'-6

1-PL 12 x 1 3/8 x 1'-0 1/2 ba ◁T | 1-PL 12 x 1 3/8 x 10'-0 1/16 C | 1-PL 12 x 11/16 x 10'-0 d | 1-PL 12 x 1/2 x 19'-7 5/8 f | 1-PL 12 x 7/8 x 10'-0 g | 1-PL 12 x 1 3/4 x 12'-11 15/16 h | 1-PL 12 x 3/4 x 28'-5 7/8 k

COMP. SEE GN 1

RA | ba | 1/2P | 1 1/8 | 3 3/4 | 3 3/4 | 3 3/4 | 3 3/4

5'-2 3/4 | 5'-0 | 13 @ 4'-4 | 4 | 4 | 1 3/8 | 1 3/8

1-BR 5 x 3/8 x 4'-11 ah | 1-BR ah | 1-WEB PL 60 1/2 x 3/8 x 51'-11 1/4 a | 1-BR 5 x 3/8 x 4'-11 {S-NS / 2-FS} | 1-BR ah | 1-BR ah | 1-BR {S-NS / 2-FS} | 1-BR ah | 4'-2 - 65% RT | 10" RT

1-BAR ah | 1-WEB PL 60 1/2 x 3/8 x 51'-11 1/2 b | 1-BR ah | 1-BR 5 x 3/8 x 4'-11 {AS-NS / 1 at FS} | 1-BR ah | 1-BR ah | 1-BR 5 3/4 x 1/2 x 5'-0 {S-NS / M-FS} (MHE)

1-ba ◁T | 1-PL 12 x 1 3/8 x 49'-7 3/8 w

2'-9 3/8 | 4 @ 4'-3 5/8 = 17'-2 1/2 | 4 @ 4'-3 5/8 = 17'-2 1/2 | 4'-3 9/16 | 5 @ 3'-7 = 17'-11 | 1-PL 12 x 1 3/4 x 12'-11 7/8 m | 3'-7 1/16 | 4 @ 3'-1 1/2 = 12'-6 | 3'-1 1/16 | 1-SOLE PL 402B (DETAILED ON SHT 402)

19'-11 3/8 | 21'-6 1/16 | 21'-6 1/16 | 15'-7 1/16 | 10'-11 13/16

49'-7 1/16 | 13'-0 | 28'-6

51'-11 5/16 | 51'-11 5/16 ℄ WEB SPL TO END @ BOTT.

78'-7 1/16 | 25'-2 15/16

103'-10 5/8 % BOTT. FLG.

+0 -1/16 | -1/8

9'-2 7/8 | 21'-6 1/16 | 21'-6 1/16 | 26'-4 1/16

1-PL 18 1/2 x 3/8 x 2'-10 3/4 af

1-ad | 1-ad

1'-0 1/2 | 1'-0 1/2 | 1'-0 1/2 | 1'-0 1/2

(℄ BR'G & MATCH LINE PIER 10)

1'-5

SEC. A-A
(TYP. INTERM. STIFFNER @ COMP.)

SEC. B-B

SEC. C-C

SEC. D-D
(TYP INTER STIFF @ TENSION)

SEC. F-F

GIRDER 433A

LINE "C"
PIER # 10 SPAN E10-E11

For location of details shown on this sheet refer to diagrams
E 402

MATERIAL
RIVETS OR BOLTS
OPEN HOLES
A325 FIELD BOLTS
SHOP CONTACT SURFACES
PAINT
} SEE SHEET 433 BB

NO	DATE	INIT	REVISION
0	4-5-71	PAB	

SUBMITTAL DATE

CUSTOMER: TENNESSEE DEPT. OF HIGHWAYS
ARKANSAS STATE HIGHWAY COMMISSION
STRUCTURE: EAST APPROACH - MISS. RIVER BRIDGE
PROJ. I-40-1(116)0 - MEMPHIS - TENN.

BETHLEHEM STEEL CORPORATION
FABRICATED STEEL CONSTRUCTION
CHICAGO DRAFTING ROOM — LEETSDALE WORKS
MADE BY SAE DATE 2-3-71 IN CHARGE F.J.K.
CHECKED BY DO DATE 2-23-71 SHOP NO.
CONTRACT CE6472-000 DRAWING NO. 433 BB

36603 (1-67)

M-48-41

MICROFILMED

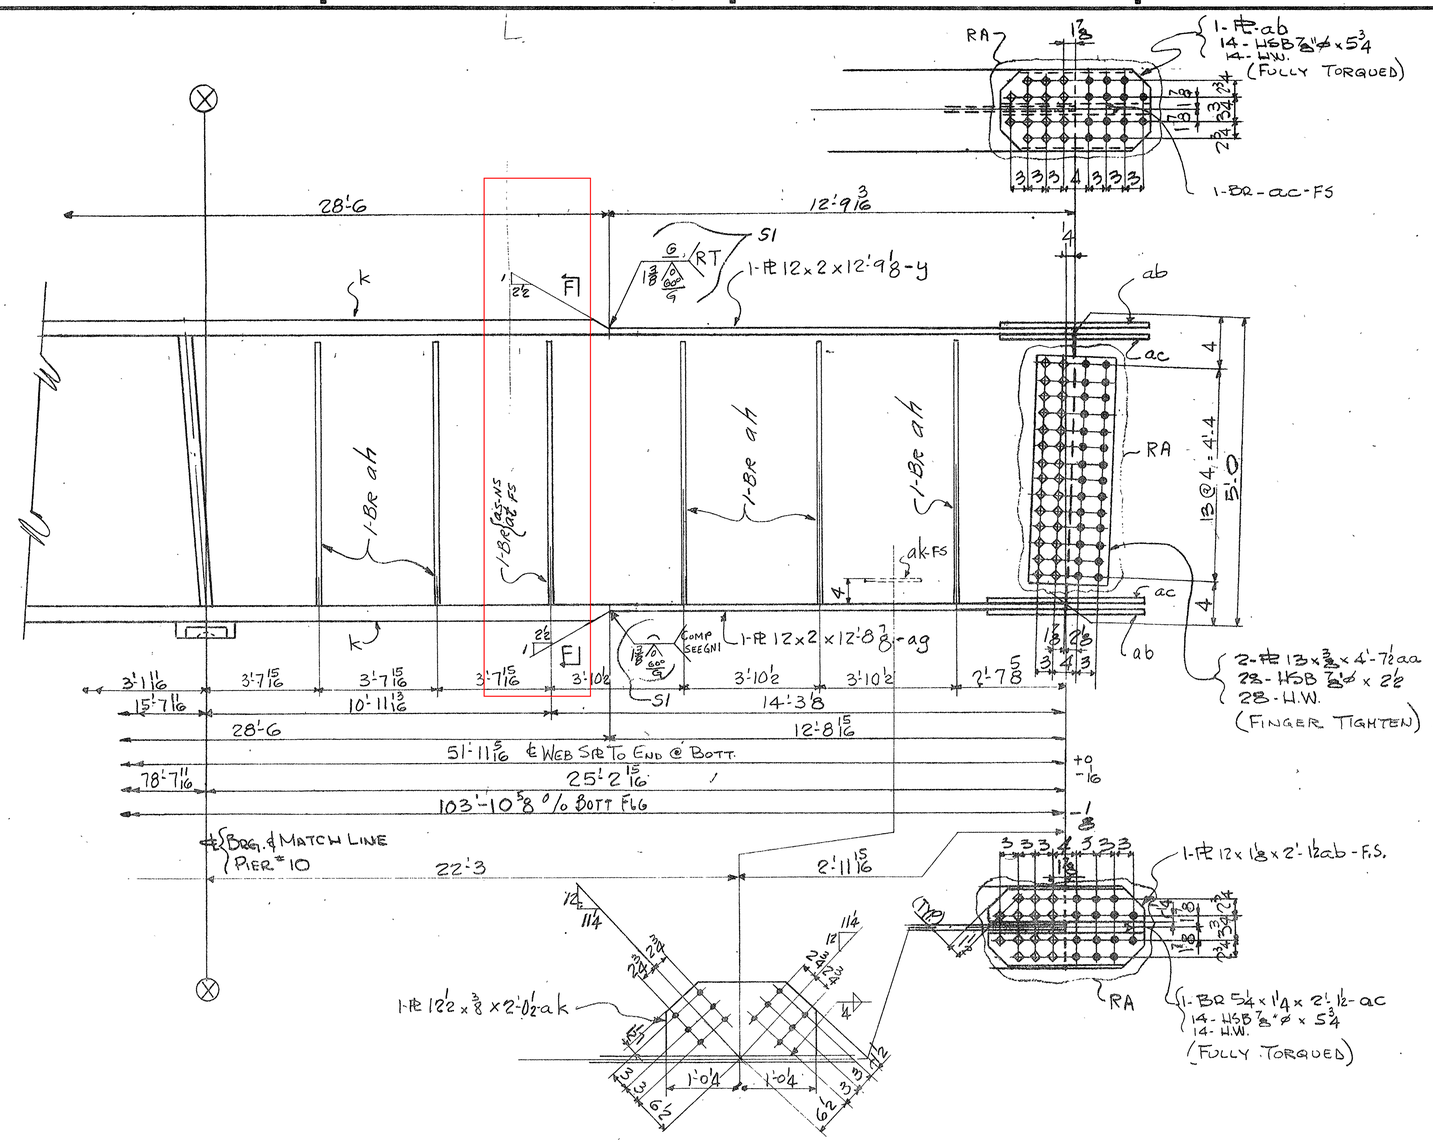

GIRDER 433A

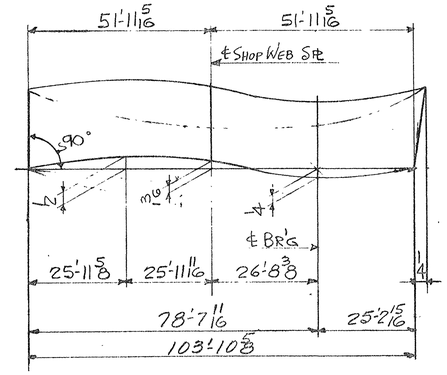

CAMBER DIAGRAM
(SHOP WEB SPL SHALL BE WELDED BEFORE CUTTING ℄)

SPAN E10-E11
PIER 10 - LINE C

INST.		REQUIRED LIST		
	S2	NO. DESCRIPTION	MARK	REMARKS
	1	1 GIRDER	433A	5'0"x2'-3"x105'-0"

FOR GEN NOTES SEE SHT GN1

1 1¾ x ¾" CLIP ALL STIFF. AS SHOWN

ELECTRODES - E70XX
LOW HYDROGEN

NOTE X
... sides of material adjacent ... open holes must be free ... burrs, loose scale, and paint ... for a distance of 3" from the ... edge of hole.

MATERIAL ASTM-A36
BOLTS ⅞"ø
OPEN HOLES 15/16 SEE GEN NOTES
A325 FIELD BOLTS
SHOP CONTACT SURFACES N.P
WELDING: AS NOTED
MILLING: AS NOTED
PAINT ... S

NO	DATE	INIT.	REVISION
1	4-5-71	Hab	

SUBMITTAL / DATE: 1 2 3 4 5 6 7 8 9 0

CUSTOMER: TENNESSEE DEPT. OF HIGHWAYS
ARKANSAS STATE HIGHWAY COMMISSION
STRUCTURE: EAST APPROACH - MISS. RIVER BRIDGE
PROJ. I-40-1(116)0 - MEMPHIS - TENN.

BETHLEHEM STEEL CORPORATION
FABRICATED STEEL CONSTRUCTION

CHICAGO DRAFTING ROOM LEETSDALE WORKS
MADE BY SAR DATE IN CHARGE F.S.V.
CHECKED BY [illegible] DATE 2-23-71 SHOP NO.
CONTRACT CE6472-000 DRAWING NO. 433-BB

For location of details shown on this sheet refer to diagrams
E402

36663 11-69

11-48-42

NO PAINT ON TOP OF TOP FLG FULL LENGTH

COMP | TENSION

10'-0⅛ | 33'-5⅜ | 10'-0 | 13'-0 | 28'-6

1-PL 12x1x10'-0⅛ c

1-PL 12x½x33'-5⅜ d

1-PL 12x⅞x10'-0 f

1-PL 12x1¾x12'-11 15/16 g

1-PL 12x3½x28'-5⅞ h

1-PL 12x½x1'-0½ ba

1-BR 5x⅜x4'-11 ah

1-WEB PL 60⅜x⅜x54'-10 4-a

1-BR 5x⅜x4'-11 {S-NS / 2-FS

1-BR ah

1-BR 5x⅝x4'-11 {GAS-NS / 2-FS

1-WEB PL 60⅜x⅜x54'-10 9/16-b

1-BR 5½x15/16x5'-0

5'-0 | 13@4'-4 = 4'-4 | 5'-0

4'-2-25% RT

10" RT

2'-9 9/16 | 4 @ 4'-3⅝ = 17'-2½ | 4 @ 4'-3⅝ = 17'-2½ | 4'-3 9/16 | 5 @ 3'-7 = 17'-11 | 3'-7 1/16 | 5 @ 3'-2 15/16 = 16'-2 11/16 | 3'-3 | 4½ | 4½

19'-11 15/16 | 21'-6 1/16 | 21'-6 1/16 | 19'-5 1/16

53'-5¾ | 13'-0 | 28'-6

54'-10⅝ | 54'-10⅜ & WEB STR TO END @ BOTT

82'-5¾ | 27'-2 15/16

109'-8 11/16 % BOTT. FLG.

BRGS & MATCH LINE (PIER 10)

1-SOLE PL 4'-0 2B DETAILED ON SHT 402

RA | DD | DD2

1-PL 18x⅜x2'-8¾ - ad | 1-ad | 1-PL 18¼x⅝x2'-9 - af

1'-4 3/16

GIRDER 434A

SEC. A-A (TYP INTERM STIFF @ COMP)

SEC. B-B

SEC. C-C

SEC. D-D

SEC. F-F

SEC. G-G (TYP. INTER. STIFF @ TENSION)

TIGHT FIT | MILL BEND | TIGHT IT | AS FOR D-D AT G FOR F-F

MATERIAL
RIVETS OR BOLTS
OPEN HOLES
A325 FIELD BOLTS
SHOP CONTACT SURFACES
PAINT
SEE SHEET 434BB

For location of details shown on this sheet refer to diagrams.
E 402

LINE B
PIER # 10 SPAN E10-11

CUSTOMER TENNESSEE DEPT. OF HIGHWAYS
ARKANSAS STATE HIGHWAY COMMISSION
STRUCTURE EAST APPROACH - MISS. RIVER BRIDGE
PROJ. I-40-1(116)0 - MEMPHIS - TENN.

BETHLEHEM STEEL CORPORATION
FABRICATED STEEL CONSTRUCTION
CHICAGO DRAFTING ROOM LEETSDALE WORKS
MADE BY S.P.K. DATE 2-5-71 IN CHARGE F.J.K.
CHECKED BY DATE 2-22-71 SHOP NO.
CONTRACT CEG472-000 DRAWING NO. 434 AB

REVISION: NO | DATE | INIT — 1 7-23 FJ 4-6-71 PJG

SUBMITTAL DATE

36653 (1-63)

MICROFILMED

11-48-43

(10)

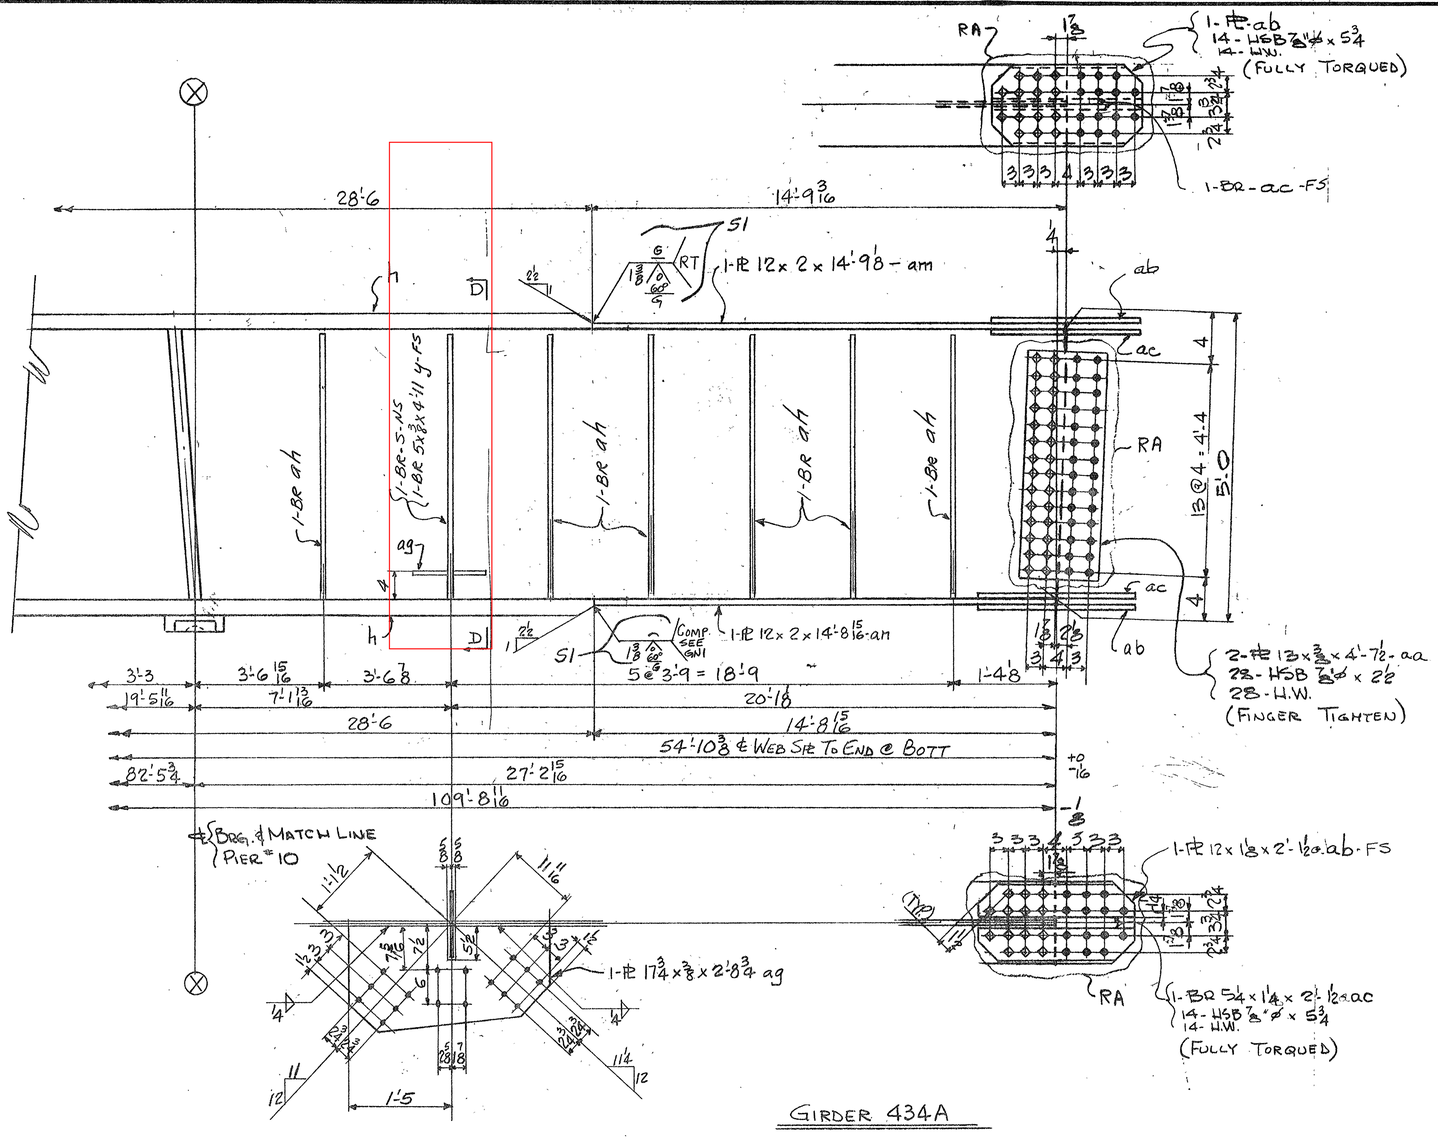

GIRDER 434A

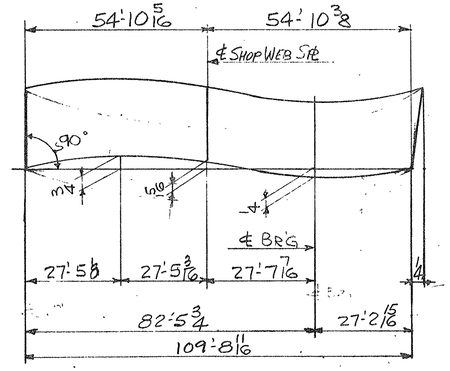

CAMBER DIAGRAM
(SHOP WEB PL SPLICE SHALL BE WELDED BEFORE CUTTING PLATE.)

SPAN E10-E11
PIER 10 - LINE B

FOR GEN. NOTES SEE SHT GN1

1 3/4 x 3/4" CLIP ALL STIFF. AS SHOWN

MATERIAL ASTM-A36
BOLTS 7/8" ø
OPEN HOLES 15/16 SEE GEN NOTES
A325 FIELD BOLTS —
SHOP CONTACT SURFACES N.P
WELDING As Noted
MILLING As Noted
PAINT
1 Coat TT P 615d Type II
U.N. See Note "X"

NOTE X
Both sides of material adjacent to all open holes must be free of burrs, loose scale, and paint for a distance of 3" from the

S2	NO.	DESCRIPTION	MARK	REMARKS
	1	GIRDER	434A	510x2 1/4 x 110'-9
INST.		REQUIRED LIST		

CUSTOMER TENNESSEE DEPT. OF HIGHWAYS
ARKANSAS STATE HIGHWAY COMMISSION
STRUCTURE EAST APPROACH - MISS. RIVER BRIDGE
PROJ. I-40-1(116)0 - MEMPHIS - TENN.

BETHLEHEM STEEL CORPORATION
FABRICATED STEEL CONSTRUCTION

CHICAGO DRAFTING ROOM LEETSDALE WORKS
MADE BY SAK DATE 2-5-71 IN CHARGE P.J.K.
CHECKED BY [illegible] DATE 2-24-71 SHOP NO.
CONTRACT CEG472-000 DRAWING NO. 434 BB

NO	DATE	INT.	REVISION
1	4-6-71	Mab	

SUBMITTAL 1 2 3 4 5 6 7 8 9 0
DATE

For location of details shown on this sheet refer to diagrams
E402

MICROFILMED

38663 (1-63)

M-48-44

(11)

GIRDER - 435A

RA

(TYP.)

NO PAINT ON TOP OF TOP FLG. FULL LENGTH

COMP.

TENSION

1-FILL 12x1⅛x1'-0½-aw (TACK WELD)

1-PL 12x1⅛x10'-0⅛-c

1-PL 12 x ⅝x39'-3⅝-d

1-PL 12x1¾x50'-3 11/16-m

1-FILL 12x½x1'-0½-ad (TACK WELD)

1-PL 12x1⅛x9'-11 15/16

1-PL 12x2⅞x15'-5 7/8-g

1-PL 16 9/16x3⅜x24'-0 1/16-h

1-SOLE PL - 402B DETAILED ON SHT 402

W.P.

Web. B.L.

27'-8¼ ℄ SPL to B.L.

11'-6

12'-6

BRG & MATCH LINE (PIER 10 @ B.L.)

1-BAR 5x⅜x4'-11-ah

1-BAR 5x⅜x4'-11-s

1-BAR 5x⅜x4'-11-ay

1-BAR 5½x15/16x15'-0 (MIN.)

1-WEB PL 61⅛x⅜x57'-7 11/16-a

1-WEB PL 61⅛x⅜x57'-8⅜-b (BENDS)

1-BAR-ah

1-BAR-s

1-BAR-g

1-PL-h

4'-2 25% (RT)

5'-7⅞

5'-0

13@4'-4=41'-4

2'-9 7/16

4@4'-3⅝=17'-2½

19'-11 15/16

21'-6 1/16

4'-3 9/16

5@3'-7=17'-11

3'-7 1/16

3'-3 13/16

5@3'-4=16'-8

23'-3 1/16

3'-3⅜

50'-3¾

9'-0

15'-6

11'-6

86'-3¾

115'-3 1/16 % BOTT. FLG.

(115'-3 11/16 % BOTT. FLG. DEV)

SEC. A-A (TYP INTER STIFF.) (COMP)

SEC. B-B

SEC. C-C

SEC. F-F (DEV)

SEC. D-D

SEC. K-K (DEV.)

SEC. H-H (TYP INTER STIFF) (TENSION)

SEE SHT. 435 BB

MATERIAL	
RIVETS OR BOLTS	
OPEN HOLES	
A325 FIELD BOLTS	
SHOP CONTACT SURFACES	
PAINT	

For location of details shown on this sheet refer to diagrams

E 402

PIER 10 - LINE A

CUSTOMER: TENNESSEE DEPT. OF HIGHWAYS / ARKANSAS STATE HIGHWAY COMMISSION

STRUCTURE: EAST APPROACH - MISS. RIVER BRIDGE

PROJ. I-40-1(116)0 - MEMPHIS - TENN.

BETHLEHEM STEEL CORPORATION

FABRICATED STEEL CONSTRUCTION

LEETSDALE WORKS

CHICAGO DRAFTING ROOM — MADE BY E. DEL — DATE 2-18-71 — CHECKED BY — DATE 2-23-71 — IN CHARGE F.J.K. — SHOP NO

CONTRACT CEG472-000 DRAWING NO 435 AB

NO	DATE	INIT	REVISION
5	4-6-71	Hab	

SUBMITTAL DATE

M-48-45

MICROFILMED

36663 11-61

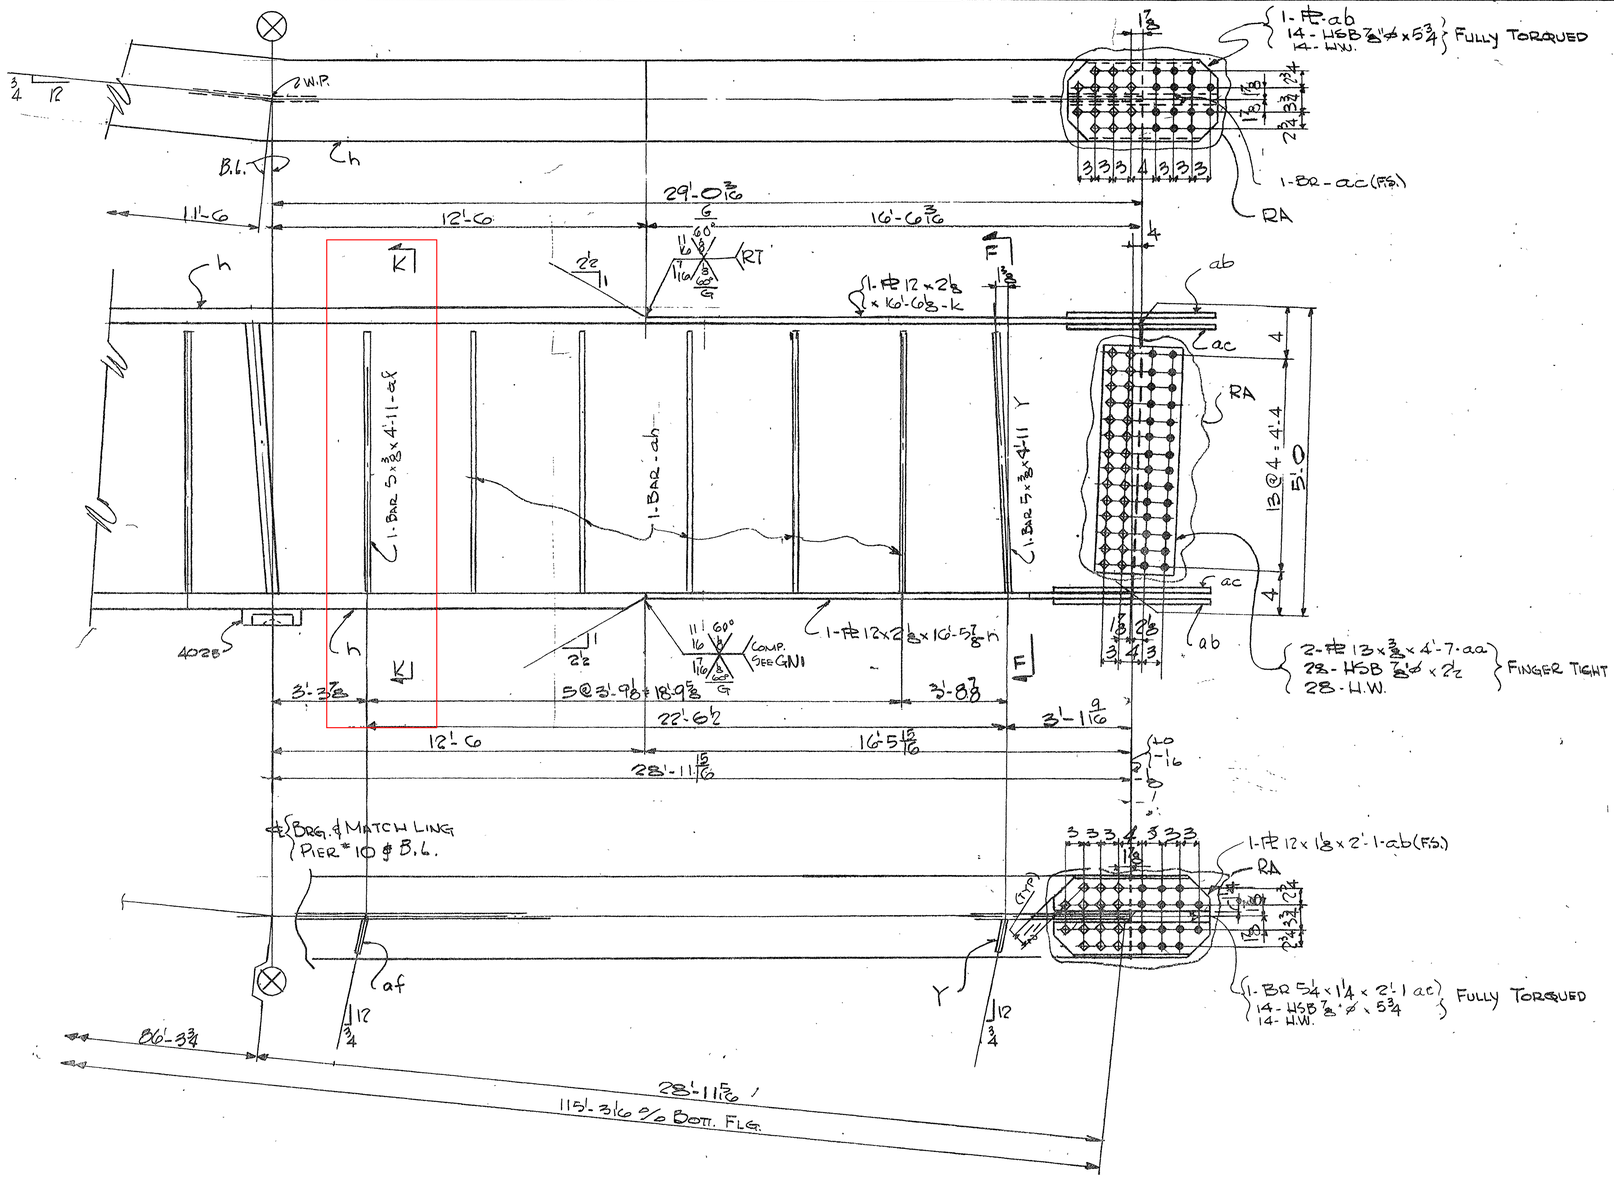

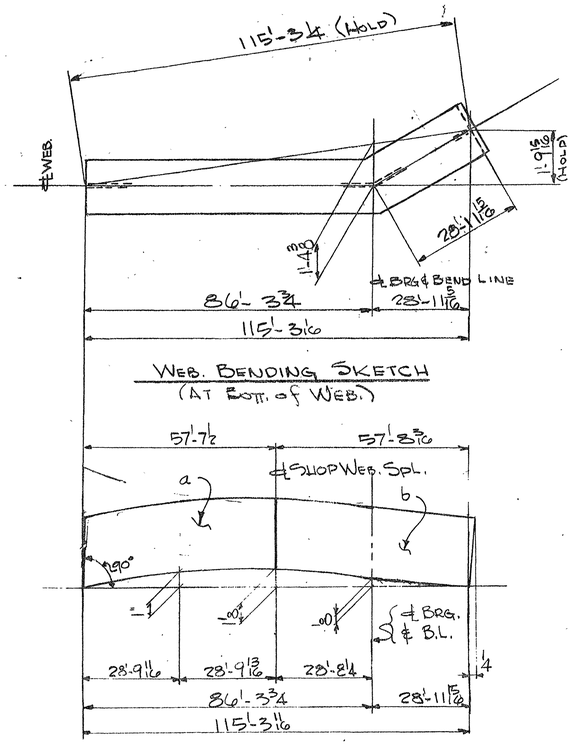

ELECTRODES - E70XX
LOW HYDROGEN

CAMBER DIAGRAM (SHOWN DEV.)

(SHOP WEB SPL. SHALL BE WELDED BEFORE CUTTING ℄)

NOTE X

Both sides of material adjacent to all open holes must be free of burrs, loose scale, and paint for a distance of 3" from the group of holes.

FOR GEN. NOTES SEE SHT. GN1

NOTE. 3/4" CLIP ALL STIFF. AS SHOWN

SPAN 10 - 11 - PIER 10 - LINE A

INST.	S	NO.	DESCRIPTION	MARK	REMARKS
		1	1 GIRDER	435A	5'-3 x 1'-3 x 116'-6
			REQUIRED LIST		

MATERIAL ASTM. A36
RIVETS OR BOLTS 7/8"ø
OPEN HOLES 15/16"ø SEE GEN NOTES
A325 FIELD BOLTS —
SHOP CONTACT SURFACES N.P
WELDING: AS NOTED
MILLING
PAINT
1 Coat JT-P 615d Type II
U.N. : See Note "X"

NO	DATE	INIT	REVISION
0			
9			
8			
7			
6			
5			
4			
3			
2			
1			

SUBMITTAL 1 2 3 4 5 6 7 8 9 0
DATE

CUSTOMER
TENNESSEE DEPT. OF HIGHWAYS
ARKANSAS STATE HIGHWAY COMMISSION
STRUCTURE
EAST APPROACH - MISS. RIVER BRIDGE
PROJ. I-40-1(116)0 - MEMPHIS - TENN.

BETHLEHEM STEEL CORPORATION
FABRICATED STEEL CONSTRUCTION

CHICAGO DRAFTING ROOM LEETSDALE WORKS
MADE BY E.DEL DATE 2-19-71 IN CHARGE P.J.K.
CHECKED BY DATE 2-23-71 SHOP NO.
CONTRACT CEG477-000 DRAWING NO 435 BB

For location of details shown on this sheet refer to diagrams.
E407

36663 (1-65)

MICROFILMED

11-48-46

NO PAINT TOP OF TOP FLG

1-PL 12 x 2'8 x 15'6 b

1-PL 12 x 3'8 x 22'6-C

1-PL 12 x 2'8 x 14'-11'8 d

1-PL ab
14-HSB 7/8"ϕ x 5 3/4
14-HW (FULLY TORQUED)

1-BR ac-FS

15'-6 1/16 | 22'-6 1/8 | 14'-11 15/16

RA

1-BR 5 x 3/8 x 4'-11 ah

1-BR 5 x 3/8 x 4'-11 t

1-BR ah

1-WEB PL 60 1/16 x 3/8 x 53'-0 aa

1-BR 5 1/2 x 1/16 x 5'-0 1/2 (MIE)

1-BR 5 x 3/8 x 4'-11 s

1-BR 5 x 3/8 x 4'-11 k

5'-4 1/4 | 5'-0 | 13@4 = 4'-4

1-PL b | 1-PL c | 1-PL 12 x 2'8 x 14'-11 7/8 f

COMP SEE GN1

1-PL 13 x 3/8 x 4'-7 1/2 aa
28-HSB 7/8"ϕ x 2 1/2
28-HW (FINGER TIGHTEN)

1'-2 3/4 | 1'-2 3/4 | 3'-6 1/4 | 5@3'-6 = 17'-6 | 3'-6 1/4 | 2'-2 1/2 | 3'-2 1/16 | 5@3'-2 3/4 = 16'-1 3/4 | 3'-2 1/16 | 1'-2 13/16

2'-5 1/2 | 26'-9 | 22'-6 1/8

15'-6 1/16 | 27'-0 | 22'-6 1/8 | 14'-11 3/4 | 25'-11 5/16

52'-11 5/16 9/0 BOTT FLG.

℄ PIER E11.

1-BR 5 1/4 x 1'4 x 2'-1/2 ac

1-PL 12 x 1'8 x 2'-1/2 ab
14-HSB 7/8"ϕ x 5 3/4
14-HW (FULLY TORQUED)

SPAN E12
LINE A

GIRDER 410A

SEC. A-A
(TYP FOR INTERMEDIATE STIFFS)

SEC. B-B

SEC. D-D
SEC. C-C
SEC. F-F

CAMBER DIAGRAM

BOTT OF WEB PL
26'-6 | 26'-5 15/16
52'-11 15/16

For location of details shown on this sheet refer to diagrams
E 402

FOR GENERAL NOTES SEE GN1

NOTE X

1. 3" x 3/4" CLIP ALL STIFF. AS SHOWN

MATERIAL ASTM-A36
RIVETS OR BOLTS 7/8"ϕ
OPEN HOLES 15/16"ϕ
A325 FIELD BOLTS
SHOP CONTACT SURFACES N.P.
WELDING: As Noted
MILL: As NOTED
PAINT
1 Coat ZI P Galv
U.N. ℄ See Note X

1	1	GIRDER	410A	5'-1 1/4 x 54'-4
SI	NO.	DESCRIPTION	MARK	REMARKS
INST.	REQUIRED LIST			

CUSTOMER
TENNESSEE DEPT. OF HIGHWAYS
ARKANSAS STATE HIGHWAY COMMISSION
STRUCTURE
EAST APPROACH - MISS. RIVER BRIDGE
PROJ. I-40-1(116)0 - MEMPHIS - TENN.

BETHLEHEM STEEL CORPORATION
FABRICATED STEEL CONSTRUCTION
LEETSDALE WORKS

CHICAGO DRAFTING ROOM
MADE BY SAK DATE 1-18-71 IN CHARGE F.J.K
CHECKED BY Hab DATE 2-16-71 SHOP NO.
CONTRACT CEG472-000 DRAWING NO. 410

NO	DATE	INIT	REVISION
D	3/15	K	

SUBMITTAL 1 2 3 4 5 6 7 8 9 0
DATE

MASTER

MICROFILMED

11-48-15 (13)

No Paint, Top of Top Flg

1-PL 12x2⅜x15'-6 b

1-PL 12x3⅜x22'-6 c

1-PL 12x2⅜x14'-11⅞ d

1-PL ab 14-HSB 7/8"ø x 5¾ 14-HW (Fully Torqued)

1-Br ac-FS

1-PL 12x2⅜x14'-11 11/16 f

2-PL 13x⅜x4'-7⅞ aa 28-HSB 7/8"ø x 2½ 28-HW (Finger Tighten)

1-PL b

1-PL c

1-Sole PL 402B (Detailed on Slit "402")

1-Br 5x⅜x4'-11 ah

1-Br 5x⅜x4'-11 (K-NS M-FS)

1-Br ah

1-Web PL 60½x⅜x53'-10⅛a

1-Br 5½x1⅛x5'-11½ (M-NS P-FS)

1-Br 5x⅜x4'-11 (L-NS S-FS)

1-Br 5¼x1¼x2'-1½ ac

Comp see GN1

& Br's

5 @ 3'-6⅞ = 17'-10⅜

5 @ 3'-2⅝ = 16'-1⅛

5 @ 4'-0 = 20'

13 @ 4 = 4'-4

Pier 11.

℄ Pier 11.

52'-11 15/16 o/o Bott. Flg.

Girder 411 A

Span E12
Line A'
Pier 11

INST.	NO.	DESCRIPTION	MARK	REMARKS
	1	1 Girder	411 A	5'-11x1'-0x54'-1
	S1	REQUIRED LIST		

Sec. A-A
(Typ For Intermediate Stiff)

Sec. B-B

Sec. C-C

Sec. D-D

Camber Diagram

For General Notes See GN1

NOTE X
... 3" from the ...

3"x3"x¼" Clip All Stiff as Shown

Material ASTM-A36
Bolts 7/8"ø
Open Holes 15/16"ø
A325 Field Bolts
Shop Contact Surfaces N.P.
Welding As Noted
Milling As Noted
Paint
1 Coat ... as Noted
U.N.O. See Note "X"

Customer: Tennessee Dept. of Highways
Arkansas State Highway Commission
Structure: East Approach - Miss. River Bridge
Proj. I-40-1(116)0 - Memphis - Tenn.

Bethlehem Steel Corporation
Fabricated Steel Construction
Chicago Grating Room — Leetsdale Works
Made by SJK Date 1-19-71 In Charge F.J.K.
Checked by Mab Date 2-17-71 Shop No
Contract CE6472-000 Drawing No 411

Revision: No. | Date | Init.

Submittal Date: 1 2 3 4 5 6 7 8 9 0

For location of details shown on this sheet refer to diagrams.
E 402

MICROFILMED

36663 11-631

M-48-16 (13)

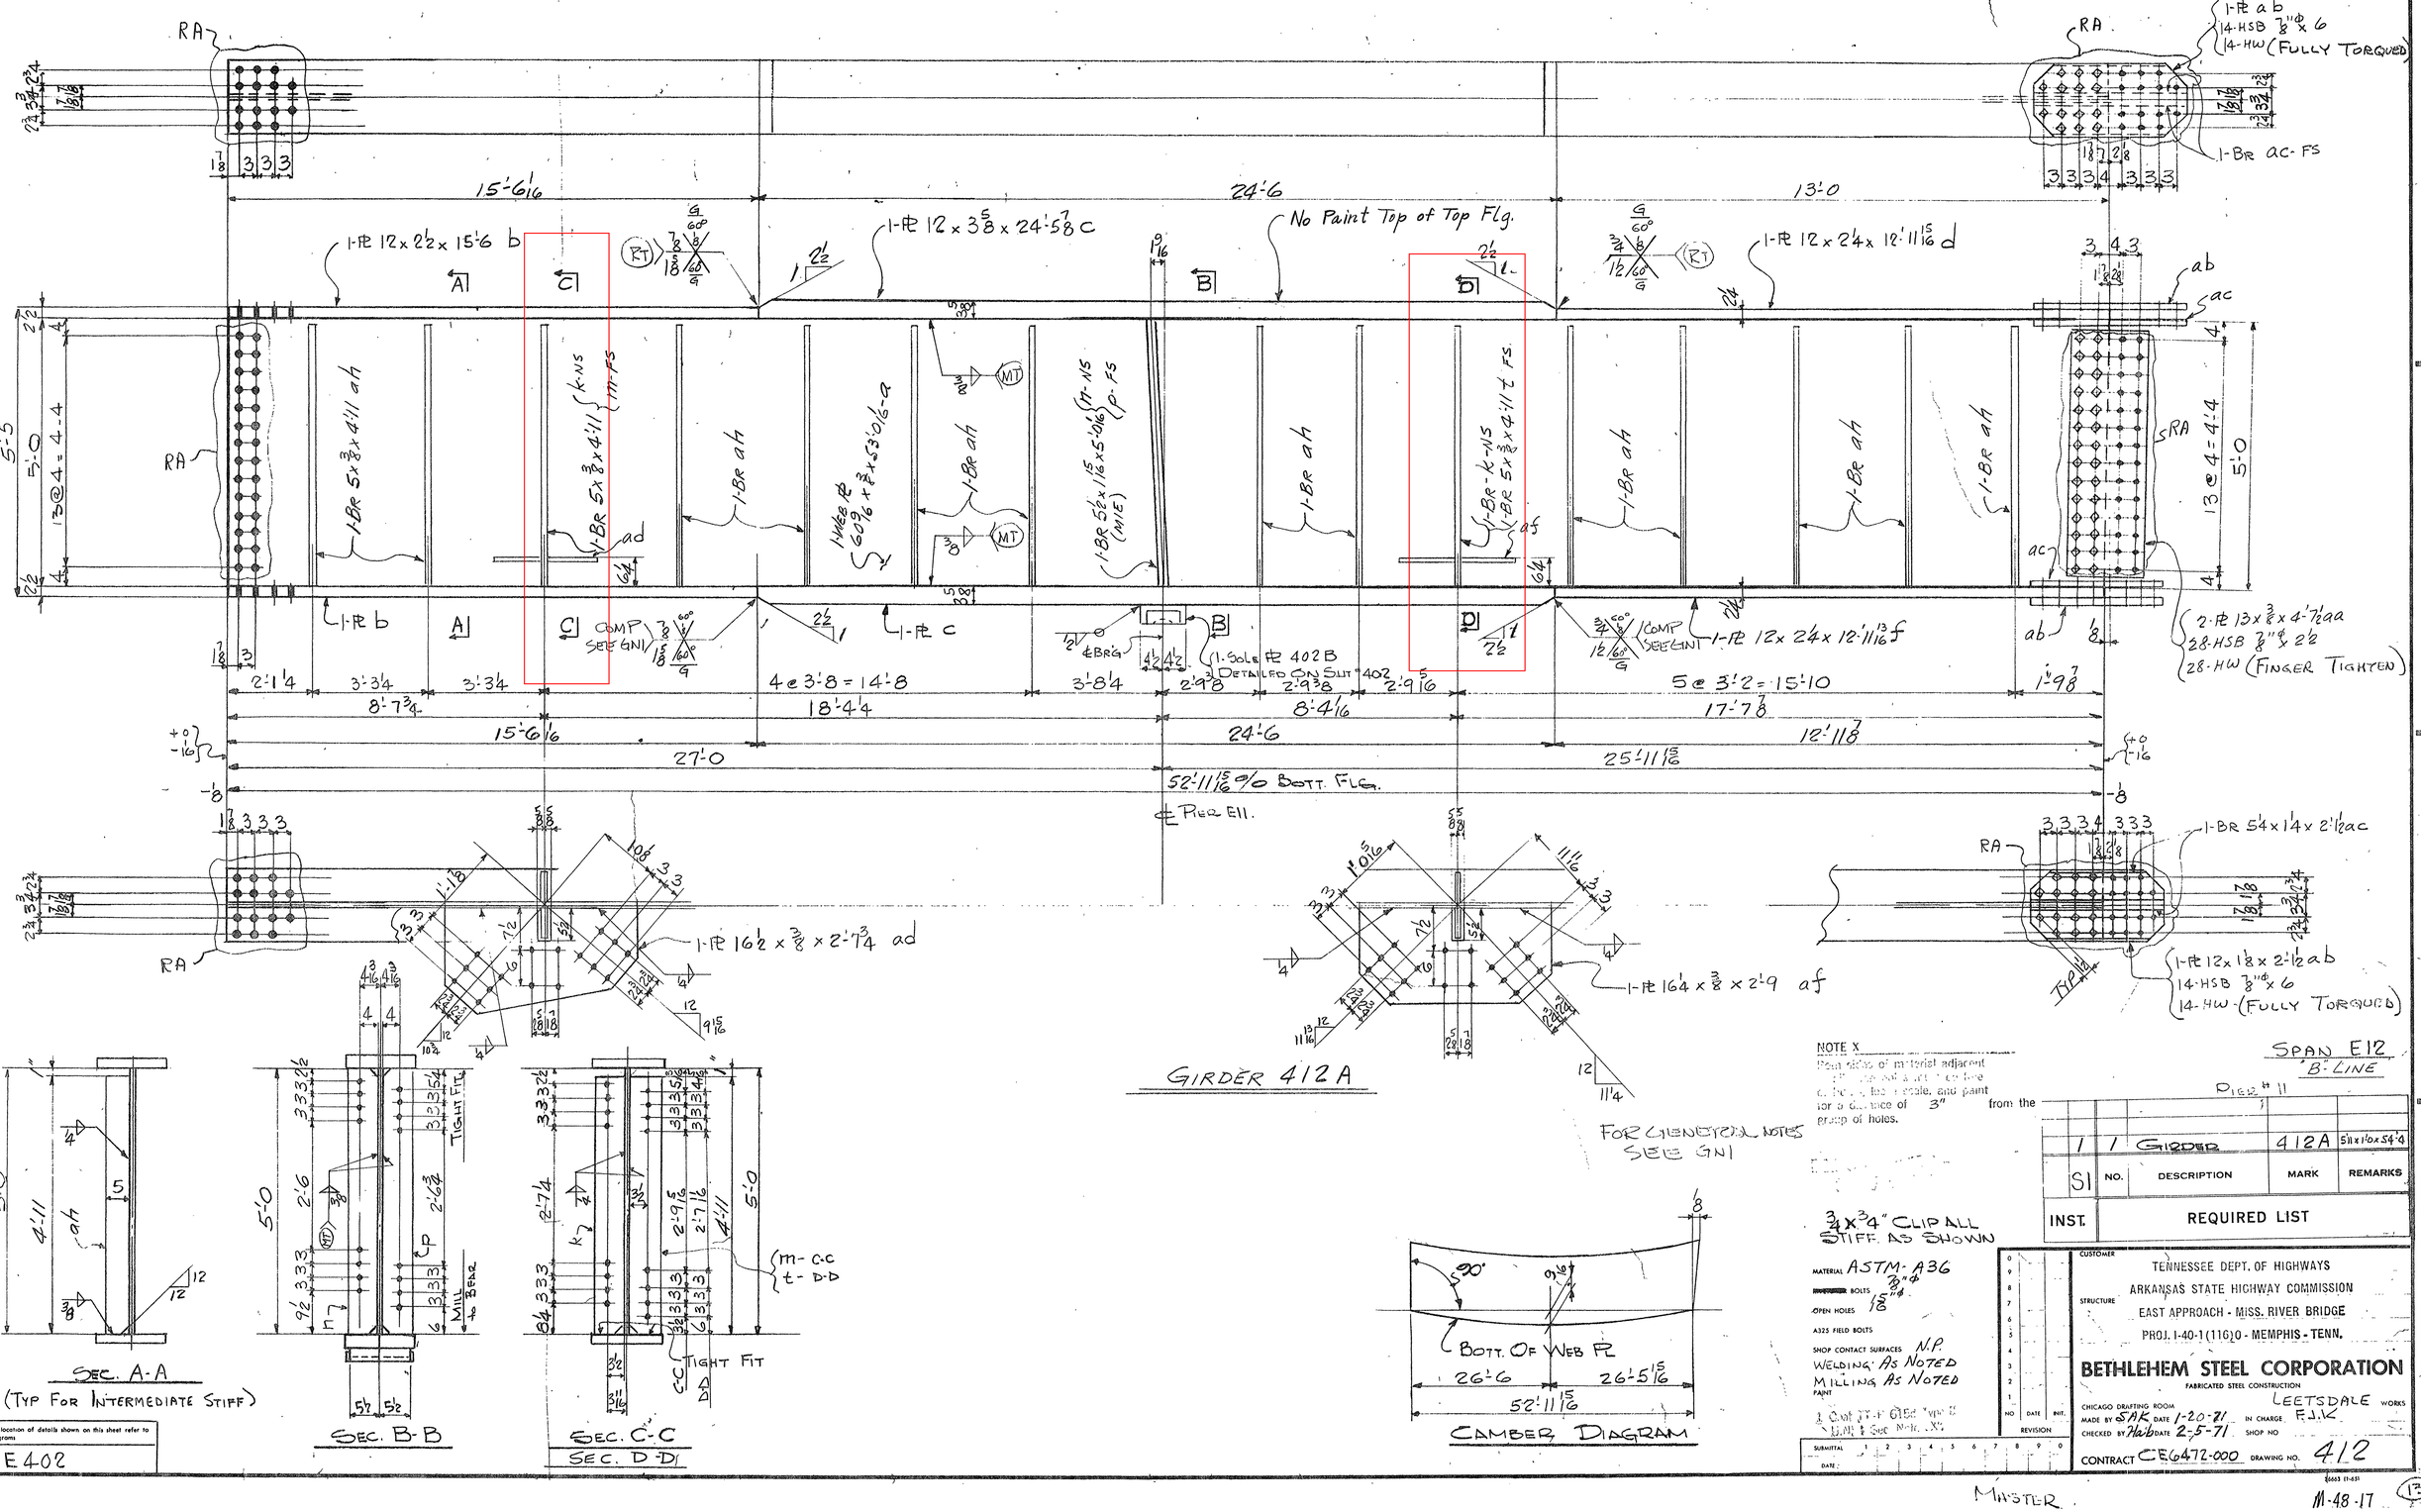

NOTE X

Paint slope of material adjacent to [illegible] and paint for a distance of 3" from the edge of holes.

SPAN E12
'B' LINE
PIER # 11

	1	1 GIRDER	412A	5¼ x 10 x 54'-9
SI	NO.	DESCRIPTION	MARK	REMARKS
INST.	REQUIRED LIST			

¾ x ¾" CLIP ALL STIFF. AS SHOWN

MATERIAL ASTM-A36
BOLTS ⅞" ø
OPEN HOLES 1⅛"
A325 FIELD BOLTS
SHOP CONTACT SURFACES N.P.
WELDING AS NOTED
MILLING AS NOTED
PAINT

1. Omit PL-P 6161 "Typ."
2. Add Mark "X"

REVISION

SUBMITTAL 1 2 3 4 5 6 7 8 9 0
DATE

CUSTOMER TENNESSEE DEPT. OF HIGHWAYS
ARKANSAS STATE HIGHWAY COMMISSION
STRUCTURE EAST APPROACH - MISS. RIVER BRIDGE
PROJ. I-40-1(116)0 - MEMPHIS - TENN.

BETHLEHEM STEEL CORPORATION
FABRICATED STEEL CONSTRUCTION
LEETSDALE WORKS

CHICAGO DRAFTING ROOM
MADE BY SAK DATE 1-20-71 IN CHARGE F.J.K.
CHECKED BY Hall DATE 2-5-71 SHOP NO.
CONTRACT CE6472-000 DRAWING NO. 412

For location of details shown on this sheet refer to diagrams
E402

MICROFILMED

M-48-17

(13)

RA

15'-6 1/16 | 24'-6 | 13'-0 1/16

1-PL 12 x 2 1/2 x 15'-6 b

1-PL 12 x 3 5/8 x 24'-5 7/8 c

No Paint Top of Top Flg.

1-PL 12 x 2 1/4 x 13'-0 - d

1-PL ab
14-HSB 7/8"Φ x 6
14-HW (FULLY TORQUED)

1-BR ac-FS

1-BR 5 x 3/8 x 4'-11 ah

1-BR ah

1-BAR 5 x 3/8 x 4'-11 { k-NS m-FS

1-WEB PL 602 x 3/8 x 5'-3 1/8 q

1-BAR ah

1-BR ah

1-BR 52 x 1/2 x 5'-0 1/2 { n-NS p-FS (MTE)

1-BR ah

1-BR ah

1-BR { k-NS m-FS

1-BR ah

1-BR ah

ad-FS

ae-FS

af-FS

ag-FS

ab

ac

1-PL b

1-PL c

1-PL 12 x 2 1/4 x 12'-11 13/16 f

COMP SEE GNI

E BRG.

(1-SOLE PL 402 B DETAILED ON SHT "402")

1-3 | 3'-8 3/4 | 3'-9 | 3'-9 | 3'-7 1/2 | 3'-7 1/2 | 3'-7 3/4 | 3'-0 1/16 | 3'-0 1/2 | 3'-0 1/2 | 3'-0 1/2 | 4 @ 3'-1 3/4 = 12'-7 | 2'-6 13/16 | 1'-2 7/8

12'-5 3/4 | 14'-6 1/4 | 12'-2 1/16 | 13'-9 7/8

15'-6 1/16 | 24'-6 | 12'-11 7/8

27'-0 | 25'-11 15/16

52'-11 15/16 ø/o BOTT FLG.

℄ PIER E11.

25'-3 1/4 | 23'-5 3/8

1-PL 12 3/4 x 7/8 x 2'-0 3/4 ad

1-PL 16 1/2 x 3/8 x 2'-11 1/4 af

1-PL 12 1/2 x 3/8 x 2'-0 1/4 ag

1-BR 5 1/4 x 1 1/4 x 2'-1 1/2 ac

1-PL 12 x 1 1/8 x 2'-1 1/2 ab
14-HSB 7/8"Φ, 6
14 HW (FULLY TORQUED)

SPAN E12
LINE "C"

GIRDER 413A

SEC. A-A
(TYP FOR INTERMEDIATE STIFF)

SEC. B-B

SEC. C-C

TIGHT FIT

MILL TO BEAR

Both sides of material adjacent to all open holes must be free of burrs, loose scale, and paint for a distance of 3" from the group of holes.

CAMBER DIAGRAM

BOTT. OF WEB PL.

26'-6 | 26'-5 15/16

52'-11 15/16

FOR GENERAL NOTES SEE SHT NI

ELECTRODES - E70XX
LOW HYDROGEN

3/4" x 3/4" CLIP ALL STIFF. AS SHOWN

MATERIAL ASTM-A36
BOLTS 7/8"Φ
OPEN HOLES 15/16"Ø
A325 FIELD BOLTS
SHOP CONTACT SURFACES N.P.
WELDING: AS NOTED
MILLING: AS NOTED
PAINT
1 Coat IT-P 61[illegible] Type II
N.N. & See Note 3K.

1	7	GIRDER	413A	51"x2 1/2"x 54'-0"
SI	NO.	DESCRIPTION	MARK	REMARKS
INST.		REQUIRED LIST		

PIER # 11

CUSTOMER TENNESSEE DEPT. OF HIGHWAYS
ARKANSAS STATE HIGHWAY COMMISSION
STRUCTURE EAST APPROACH - MISS. RIVER BRIDGE
PROJ. I-40-1(116)0 - MEMPHIS - TENN.

BETHLEHEM STEEL CORPORATION
FABRICATED STEEL CONSTRUCTION
CHICAGO DRAFTING ROOM LEETSDALE WORKS
MADE BY SAK DATE 1-21-71 IN CHARGE EJK
CHECKED BY Hab DATE 2-1-71 SHOP NO.
CONTRACT CE6472-000 DRAWING NO. 413

REVISION NO. | DATE | INIT

SUBMITTAL 1 2 3 4 5 6 7 8 9 0
DATE

For location of details shown on this sheet refer to diagrams
E 402

MICROFILMED

MASTER

11-48-18

GIRDER 414 A

1-PL 12 x 2½ x 16'-0 b

1-PL 12 x 3⅝ x 23'-11⅞ c

No Paint Top of Top Flg.

1-PL 12 x 24 x 13'-0 - d

1-PL a b
14-HSB ⅞" Ø x 6
14-HW (FULLY TORQUED)

1-BR ac-FS

16'-0 1/16 | 24'-0 | 13'-0 1/16

RA

1-BR 5 x ⅜ x 4'-11 ah

1-BR ah

1-BR 5 x ⅜ x 4'-11 {K-NS / M-FS}

1-WEB PL 60½ x ⅜ x 53'-2⅞ a

1-BR 56 x 1⅝ x 5'-0½ {M-NS / P-FS} (M1E)

1-BR {K-NS / M-FS}

1-PL b

1-PL c

1-PL 12 x 24 x 12'-11 13/16 d

1-SOLE PL 402B DETAILED ON SHT. 402

COMP SEE GN1

EBR'G

ad | af | ab | ac

2-PL 13 x ⅜ x 4'-7½ aa
28-HSB ⅞" Ø x 2½
28-HW (FINGER TIGHTEN)

13 @ 4 = 4'-4

5'-0

3'-9 1/16 | 5 @ 3'-0 1/8 = 15'-0 5/8 | 3'-6 3/4 | 3'-6 3/4 | 3'-6 1/16 | 3'-2 1/2 | 3'-2 3/8 | 3'-2 3/16 | 3'-2 3/8 | 3'-2 3/8 | 3'-9 | 3'-9 | 2'-5 7/8

16'-3 13/16 | 16'-0 1/16 | 10'-8 3/16 | 24'-0 | 16'-0 1/16 | 12'-11 7/8

27'-0 | 25'-11 5/8

52'-11 15/16 ø/o BOTT. FLG.

21'-11'4

PIER E11.

1-PL 17½ x ⅜ x 2'-7 af

1-PL 12½ x ⅜ x 2'-0'4 ad

1-BR 5'4 x 1'4 x 2'-1½ ac

1-PL 12 x 18 x 2'-1½ ab
14-HSB ⅞" Ø x 6
14-HW (FULLY TORQUED)

SPAN E12
D-LINE

SEC. A-A
(TYP FOR INTERMEDIATE STIFF)

SEC. B-B

SEC. C-C

TIGHT FIT

MILL TO BEAR

CAMBER DIAGRAM

BOTT. OF WEB PL

26'-6 | 26'-5 15/16

52'-11 15/16

NOTE X

FOR GENERAL NOTES SEE GN1

3/8 x 3/4" CLIP ALL STIFF AS SHOWN

MATERIAL ASTM-A36
BOLTS ⅞" Ø
OPEN HOLES 15/16" Ø
A325 FIELD BOLTS
SHOP CONTACT SURFACES N.A
WELDING AS NOTED
MILLING AS NOTED
PAINT SEE N.N.

DESIGN 11

INST.	NO.	DESCRIPTION	MARK	REMARKS
	1	GIRDER	414 A	5'11x2'11x5'4

REQUIRED LIST

CUSTOMER TENNESSEE DEPT. OF HIGHWAYS
ARKANSAS STATE HIGHWAY COMMISSION
STRUCTURE EAST APPROACH - MISS. RIVER BRIDGE
PROJ. I-40-1(116)0 - MEMPHIS - TENN.

BETHLEHEM STEEL CORPORATION
FABRICATED STEEL CONSTRUCTION
CHICAGO DRAFTING ROOM LEETSDALE WORKS
MADE BY SJK DATE 1-22-71 IN CHARGE FJK
CHECKED BY HAB DATE 2-2-71 SHOP NO
CONTRACT CE6472-000 DRAWING NO 414

REVISION NO | DATE | INIT

SUBMITTAL 1 2 3 4 5 6 7 8 9 0
DATE

For location of details shown on this sheet refer to diagrams
E 402

MICROFILMED

36663 11-65

11-48-19

MINISTER

GIRDER 415A

SPAN E12
E-LINE

INST.	NO.	DESCRIPTION	MARK	REMARKS
SI	1	GIRDER	415A	5-11x2-11x54-4

REQUIRED LIST

CUSTOMER: TENNESSEE DEPT. OF HIGHWAYS
STRUCTURE: ARKANSAS STATE, HIGHWAY COMMISSION
EAST APPROACH - MISS. RIVER BRIDGE
PROJ. I-40-1(116)0 - MEMPHIS - TENN.

BETHLEHEM STEEL CORPORATION
FABRICATED STEEL CONSTRUCTION
LEETSDALE WORKS

CHICAGO DRAFTING ROOM
MADE BY SAK DATE 1-25-71 IN CHARGE F.J.K
CHECKED BY [illegible] DATE 2-3-71 SHOP NO
CONTRACT CE6472-000 DRAWING NO. 415

REVISION: NO | DATE | INIT

SUBMITTAL DATE: 1 2 3 4 5 6 7 8 9 0

For location of details shown on this sheet refer to diagrams: E 402

FOR GENERAL NOTES SEE GN1

[illegible] ECCW [illegible]

3/4x3/4" CLIP ALL STIFF AS SHOWN

MATERIAL ASTM-A36
[illegible] BOLTS 7/8" ϕ
OPEN HOLES 15/16" ϕ
A325 FIELD BOLTS
SHOP CONTACT SURFACES
WELDING: AS NOTED
MILLING AS NOTED
PAINT

ROUTE A
[illegible] sides of material adjacent [illegible] shall be free [illegible] burrs, loose scale, and paint for a distance of 3" from the group of holes.

SEC. A-A
(TYP FOR INTERMEDIATE STIFF)

SEC. B-B

SEC. C-C

CAMBER DIAGRAM

For general notes see GN1

MICROFILMED

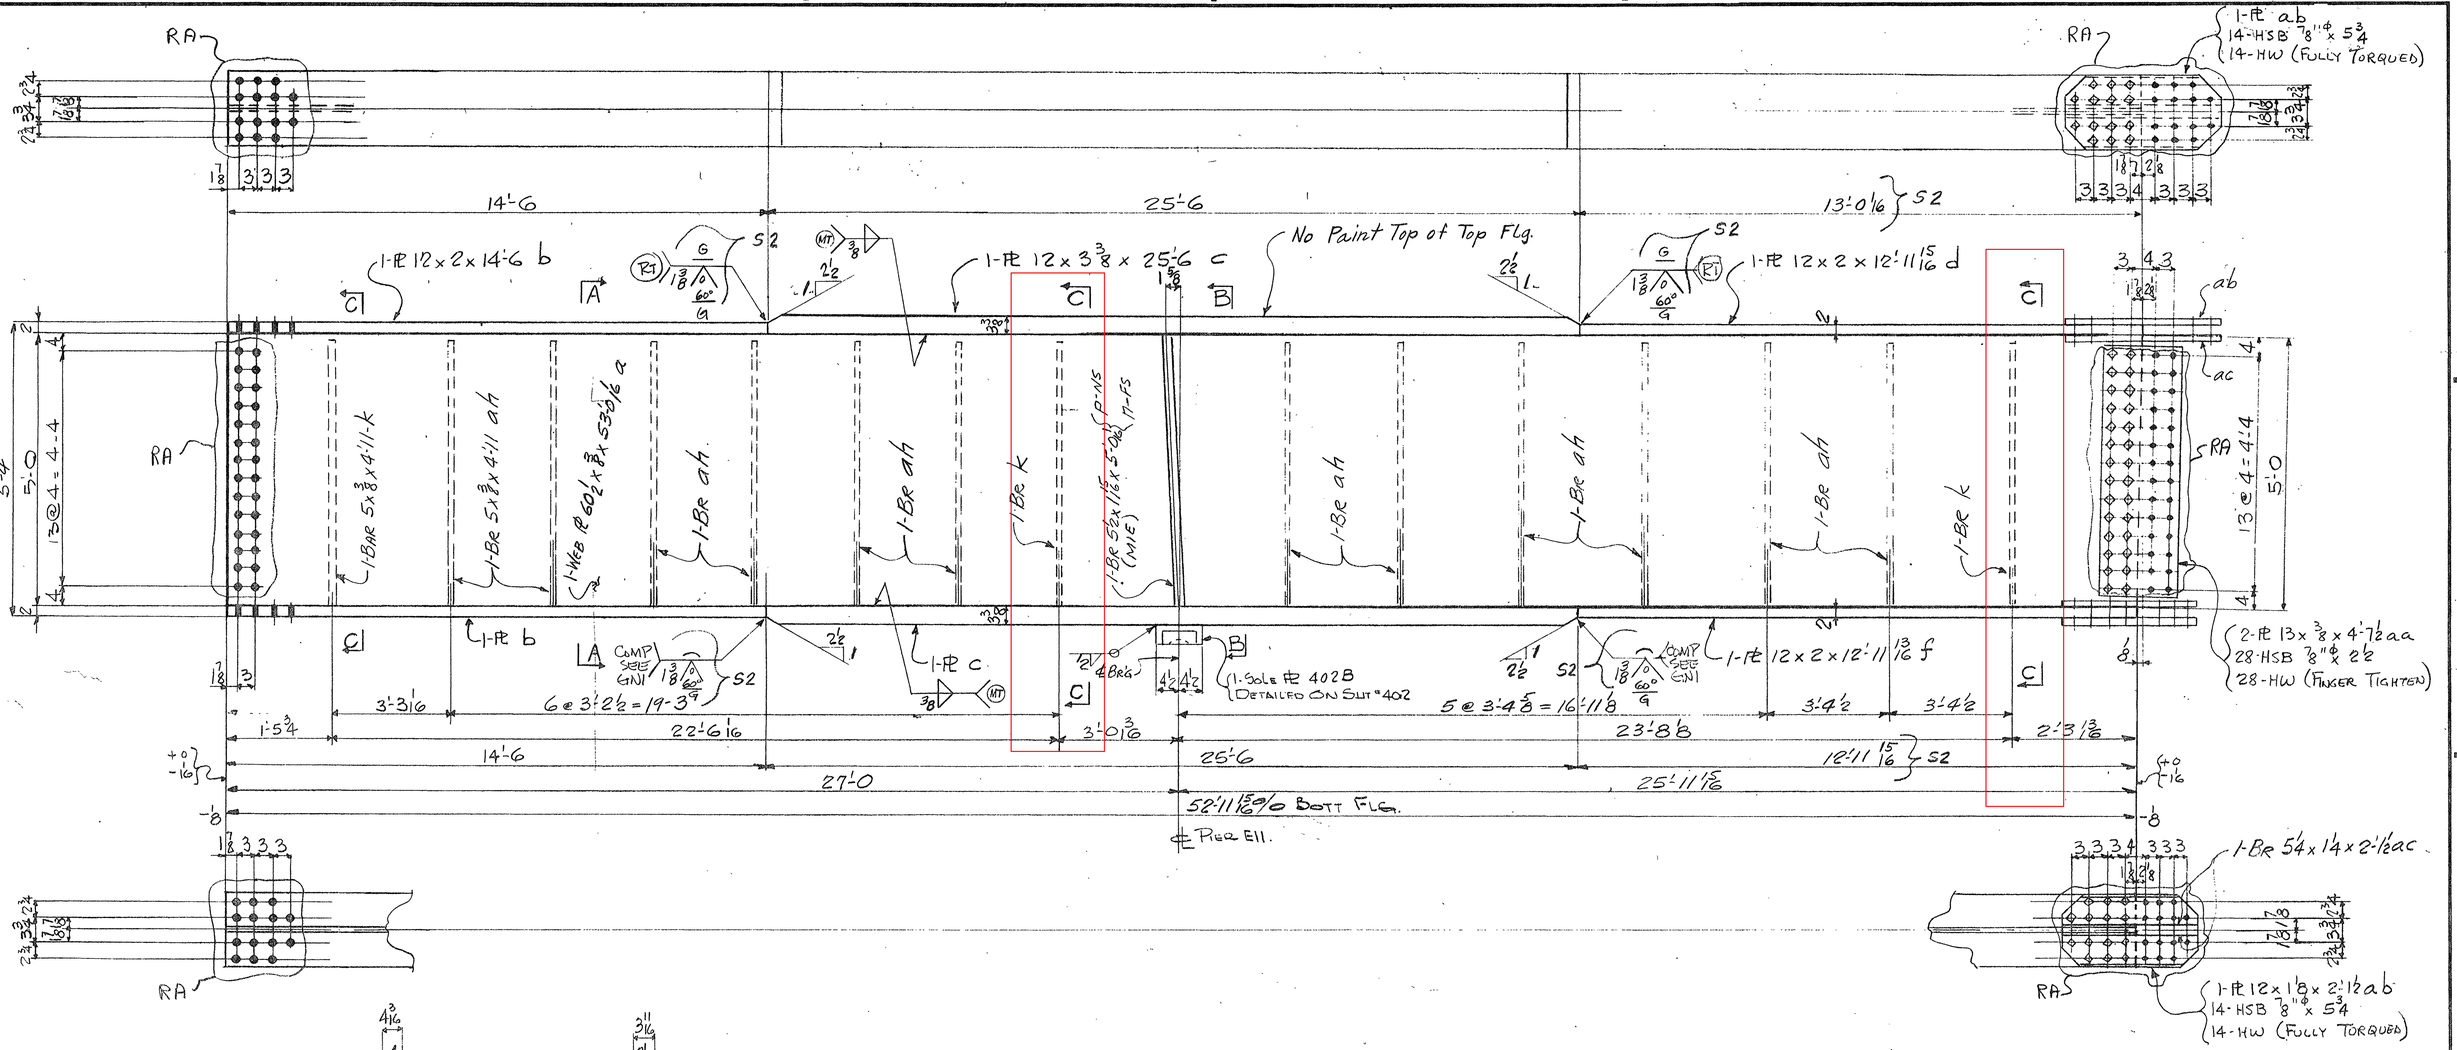

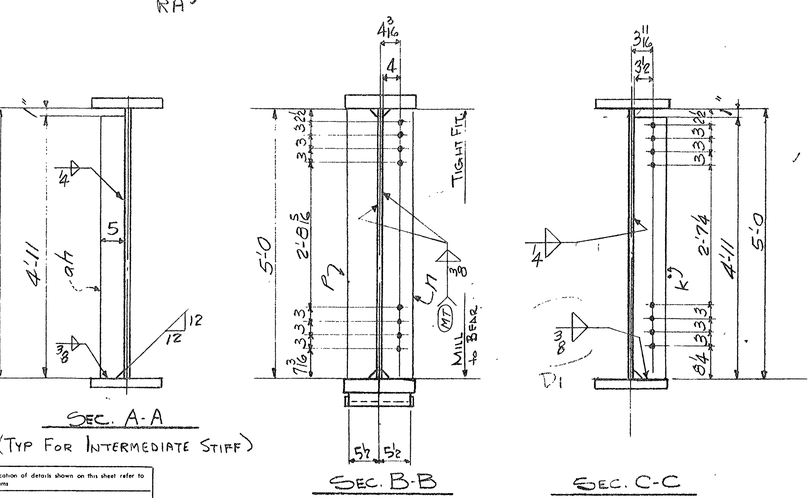

GIRDER 416A

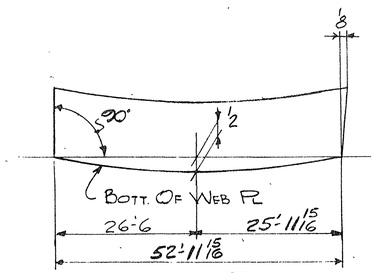

SPAN E12
F. LINE

FOR GENERAL NOTES SEE GN1

3 4x3 4" CLIP ALL STIFF. AS SHOWN

MATERIAL ASTM-A36
BOLTS 7/8"Φ
OPEN HOLES 15/16"Φ
A325 FIELD BOLTS
SHOP CONTACT SURFACES N.P
WELDING: AS NOTED
MILLING: AS NOTED
PAINT

INST.	NO.	DESCRIPTION	MARK	REMARKS
	1	GIRDER	416A	5'11x10 1/2 x 54'-4

REQUIRED LIST

REVISION

NO	DATE	INIT
2	4-5-71	Mab
1	3-15-71	K

CUSTOMER TENNESSEE DEPT. OF HIGHWAYS
ARKANSAS STATE HIGHWAY COMMISSION
STRUCTURE EAST APPROACH - MISS. RIVER BRIDGE
PROJ. I-40-3(116)0 - MEMPHIS - TENN.

BETHLEHEM STEEL CORPORATION
FABRICATED STEEL CONSTRUCTION
CHICAGO DRAFTING ROOM LEETSDALE WORKS
MADE BY SAK DATE IN CHARGE F.J.K
CHECKED BY Mab DATE 2-3-71 SHOP NO
CONTRACT CEG472-000 DRAWING NO 416

SUBMITTAL DATE

For location of details shown on this sheet refer to diagrams: E402

36663 11-65

MICROFILMED

11-48-21

(13)

NO PAINT TOP OF TOP FLG FULL LENGTH

11'-11⅞ | 12'-0 | 21'-0 | 8'-0 | 14'-0 1/16

1-PL 18x1x11'-11⅞ b

1-PL 18x2x11'-11 15/16 c

1-PL 18x2¾x20'-11⅞ d

1-PL 18x1⅜x7'-11 15/16 f

1-PL 18x1x14'-0 1/16 g

1-PL 18x1x13'-11⅞ h

1-PL 12x½x1'-0½ y (T)

1-PL 12x¼x1'-0½ w (T)

RA

RT

1-BR 5x⅜x4'-11 ah

1-BR 5x⅜x4'-11 s

1-BR ah

1-BR s

1-WEB PL 62½x⅜x66'-11¾

1-PL 8½x1⅛x5'-0 SK-115 (MISC.)

1-SOLE PL-402A (DET. ON SHT. # 402)

COMP SEE GN1

6@3'-4¾ = 20'-4½

3'-4½

8@3'-1½ = 25'-0

3'-5

7'-11⅞

1'-1⅞

1'-10⅜

3'-11½

5'-9⅞

23'-9

4'-5

2'-2½

4½

33'-11⅞

66'-11¾ % BOTT. FLG.

℄ BRG. PIER # E7

5'-0

13@4" = 4'-4

5'-½

13 @ 4 = 4'-4

NOTE X

Burn holes in material adjacent to all field connections and paint for a distance of 3" from the edge of holes

SECT A-A (TYP INTER. STIFFNER)

SEC. B-B

SECT C-C

SECT C'-C'

For C-C

For C'-C'

Tight Fit

Mill for Bearing

CAMBER DIAGRAM

℄ BRG.

33'-11⅞

32'-11⅞

66'-11¾

GIRDER 466A

FOR GEN NOTES SEE SHEET GN1.

ELECTRODES - E70XX LOW HYDROGEN

¾" x ¾" "CLIP ALL STIFF AS SHOWN"

MATERIAL ASTM-A36

BOLTS 15/16"ϕ

OPEN HOLES 15/16"ϕ SEE GEN. NOTES

A325 FIELD BOLTS —

SHOP CONTACT SURFACES N.P

WELDING: AS NOTED

MILLING: AS NOTED

PAINT

UNLESS OTHERWISE NOTED SEE NOTE "X"

For location of details shown on this sheet refer to diagrams

E401

SPAN E7 PIER # E7 LINE F

1	1	GIRDER	466A	STM-6067-1
$5	NO.	DESCRIPTION	MARK	REMARKS
INST.		REQUIRED LIST		

CUSTOMER TENNESSEE DEPT. OF HIGHWAYS
ARKANSAS STATE HIGHWAY COMMISSION

STRUCTURE EAST APPROACH - MISS. RIVER BRIDGE

PROJ. I-40-1(116)0 - MEMPHIS - TENN.

BETHLEHEM STEEL CORPORATION
FABRICATED STEEL CONSTRUCTION

CHICAGO DRAFTING ROOM LEETSDALE WORKS

MADE BY SAK DATE 2-19-71 IN CHARGE F.J.K.

CHECKED BY [illegible] DATE 3-8-71 SHOP NO.

CONTRACT CEGA77-000 DRAWING NO 466

SUBMITTAL	1	2	3	4	5	6	7	8	9	0
DATE										

NO	DATE	INIT
5	4-5	DJ

REVISION

36663 11-69

11-98-98

MICROFILMED

NO PAINT TOP OF TOP FL'G FULL LENGTH

1-PL 18 x 2 3/8 x 11'-11 7/8 - c

1-PL 18 x 3 x 19'-11 7/8 - d

1-PL 18 x 24 x 9'-11 7/8 - f

1-PL 18 x 14 x 11'-11 13/16 - b

1-PL 18 x 14 x 13'-0 - g

1-PL 18 x 14 x 12'-11 13/16 - h

1-PL 12 x 4 x 1'-0 1/2 MT

1-PL 17 x 2 3/8 x 2'-9 - aa

1-PL 15 1/4 x mill x 2'-8 1/2 - ab

1-PL - MT

1-PL - b

1-PL - c

1-PL - d

1-PL - f

1-PL - h

1-PL - MT

1-PL - aa

1-PL - ab

1-BR 5 x 3/8 x 4'-11 - ah

1-BR 8 1/2 x 1 1/16 x 5'-0 (MILE)

1-WEB PL 60 1/8 x 3/8 x 66'-11 3/4

1-SOLE PL 402A DET. ON SHT. # 402

RA

MT

n

m

aa-FS

ab-FS

5-NS 2-FS

5-NS 4-FS

COMP SEE GN1

RT

3/8 BOTT. FLG.

℄ BRG PIER # E7

6@3'-4 3/4 = 20'-4 1/2

6@3'-0 1/4 = 18'-1 1/2

66'-11 3/4

33'-11 7/8

32'-11 7/8

20'-0

12'-0

10'-0

8'-3

23'-9

21'-2

11'-9 7/8

12'-11 7/8

13@4 = 4'-4

5'-0

SECT A-A
(TYP INTER STIFFNER)

SEC. B-B

SEC. C-C

CAMBER DIAGRAM

GIRDER 467A

FOR GEN NOTES SEE SHEET GN1

ELECTRODES - E70XX LOW HYDROGEN

3/4 x 3/4 "CLIP ALL STIFF AS SHOWN"

MATERIAL ASTM-A36

BOLTS 7/8 H.S.

OPEN HOLES 15/16 H.S. SEE GEN. NOTES

A325 FIELD BOLTS —

SHOP CONTACT SURFACES N.P

WELDING AS NOTED

MILLING AS NOTED

PAINT

(a) (P-P 615a Type II

(b) N.I. See Note "X"

NOTE X

Paint [illegible] adjacent to the face of the [illegible] with paint for a distance of 3" from the face of the [illegible]

For location of details shown on this sheet refer to diagrams

E401

SPAN E7	PIER # E7	LINE E		
1	1	GIRDER	467A	5'-9 x 2'-3 x 67'-0

SS	NO.	DESCRIPTION	MARK	REMARKS
INST		REQUIRED LIST		

NO	DATE	INIT
51	4-5	D

REVISION

SUBMITTAL	1	2	3	4	5	6	7	8	9	0
DATE										

CUSTOMER TENNESSEE DEPT. OF HIGHWAYS
ARKANSAS STATE HIGHWAY COMMISSION

STRUCTURE EAST APPROACH - MISS. RIVER BRIDGE
PROJ. I-40-1(116)0 - MEMPHIS - TENN.

BETHLEHEM STEEL CORPORATION
FABRICATED STEEL CONSTRUCTION

CHICAGO DRAFTING ROOM LEETSDALE WORKS
MADE BY SAK DATE IN CHARGE F.J.K.
CHECKED BY DATE 3-8-71 SHOP NO.

CONTRACT C-6477-000 DRAWING NO. 467

M-48-94

MICROFILMED

No Paint Top of Top Flg. Full Length

1-PL 18x 2 3/8 x 11'-11 7/8 - c

1-PL 18x 38x 19'-11 7/8 - d

1-PL 18x 24x 9'-11 7/8 f

1-PL 18x 14x 11'-11 13/16 - b

1-PL 18x 14x 13'-0 - g

1-PL 18x 1 1/4 x 12'-11 13/16 - aa

11'-11 7/8 | 12'-0 | 20'-0 | 10'-0 | 13'-0 1/16

21'-10 7/8 | 12'-1 | 17'-4 | 15'-7 7/8

33'-11 7/8 | 20'-0 | 10'-0 | 12'-11 7/8

66'-11 3/4 | 32'-11 7/8

23'-11 1/2 | 29'-0 | 3'-2 7/8

6@3'-4 3/4 = 20'-4 1/2 | 4@3'-0 4 = 12'-1 | 4@2'-10 5/8 = 11'-6 1/2 | 4@3'-6 1/2 = 14'-2

13@4'-4 = 4'-4

5'-0 | 5'-2 1/2

1-BR 5x 3/8 x 4'-11 - ah

1-WEB PL 60 13/16 x 3/8 x 66'-11 15/16 - a

1-BR 5x 3/8 x 4'-11 (S-NS) (E-FS)

1-BR 8 1/2 x 1 1/16 x 5'-0 (K-NS) (M-FS) (TAPE)

1-PL 12x 4 x 1'-0 1/2 h-FS <T

1-PL 12 1/2 x 3/8 x 2'-1 1/2 y

1-PL 16 3/4 x 3/8 x 2'-9 1/2 - w

1-PL 13 3/8 x 2'-3 - p

1-PL h <T

1-PL h

1-PL - b

1-PL - c

1-PL - d

1-PL f

(1-Sole PL 402A DET. ON SHT. # 402)

COMP SEE GN1

RT

RA

SECT. A-A (TYP INTER STIFFNER)

SEC. B-B

SEC. C-C

CAMBER DIAGRAM

For Gen Notes See Sheet GN1

ELECTRODES - EXXX LOW HYDROGEN

3/4 x 3/4 "CLIP ALL STIFF AS SHOWN"

MATERIAL ASTM-A36

BOLTS 7/8"Φ

OPEN HOLES 1 1/16"Φ See Gen. Notes

A325 FIELD BOLTS —

SHOP CONTACT SURFACES N.P

WELDING - As Noted

MILLING - As Noted

PAINT 1 Coat TT P 615d Type II U.N. See Note "X"

NOTE X

Bottom edges of the top flange plates to all stiffeners and the top of the web shall be painted with a minimum of 3" from the edge of the flange.

SPAN E7 PIER # E7 LINE D

	1	GIRDER	468A	59x 2'-3 x 67'-0
$5	NO.	DESCRIPTION	MARK	REMARKS
INST.		REQUIRED LIST		

CUSTOMER TENNESSEE DEPT. OF HIGHWAYS

ARKANSAS STATE HIGHWAY COMMISSION

STRUCTURE EAST APPROACH - MISS. RIVER BRIDGE

PROJ. I-40-1(116)0 - MEMPHIS - TENN.

BETHLEHEM STEEL CORPORATION

FABRICATED STEEL CONSTRUCTION

CHICAGO DRAFTING ROOM LEETSDALE WORKS

MADE BY SAS DATE 2-24-71 IN CHARGE F.J.K.

CHECKED BY DATE 3-8-71 SHOP NO

CONTRACT CEGA71-000 DRAWING NO 468

REVISION 51 4-16-71 NO DATE INIT

SUBMITTAL DATE 1 2 3 4 5 6 7 8 9 0

For location of details shown on this sheet refer to diagrams E401

MICROFILMED

11-18-75

NO PAINT TOP OF TOP FLG FULL LENGTH

1-PL 18 x 2 1/2 x 11'-11 7/8 - C

1-PL 18 x 2 3/8 x 10'-11 7/8 - f

1-PL 18 x 1 1/4 x 10'-11 13/16 - b

1-PL 18 x 3 1/4 x 21'-11 7/8 - d

1-PL 18 x 1 3/8 x 10'-11 15/16 g

1-PL 18 x 1 3/8 x 10'-11 13/16 - h

1-PL 12 x 1/8 x 1'-0 1/2 y FS <T

1-PL 12 1/2 x 3/8 x 2'-1 1/2 - aa

1-PL 16 1/2 x 3/8 x 2'-6 3/4 - ab

1-PL 13 x 3/8 x 2'-3 - ac

SECT A-A (TYP INTER STIFFNER)

SEC. B-B

SEC. C-C

GIRDER 469A

CAMBER DIAGRAM

NOTE X
Both sides of material adjacent to all open holes must be free of burrs, loose scale, and paint for a distance of 3" from the group of holes.

FOR GEN NOTES SEE SHEET GN1

ELECTRODES - E70XX LOW HYDROGEN

3/4 x 3/4 "CLIP ALL STIFF AS SHOWN"

MATERIAL ASTM-A36
BOLTS 7/8" ϕ
OPEN HOLES 15/16" ϕ SEE GEN. NOTES
A325 FIELD BOLTS —
SHOP CONTACT SURFACES N.P
WELDING: AS NOTED
MILLING: AS NOTED
PAINT
[illegible] 615d Type I
GEN: See Note "X"

SUBMITTAL	1	2	3	4	5	6	7	8	9	0
DATE										

SPAN E7 PIER #E7 LINE C

SS	NO.	DESCRIPTION	MARK	REMARKS
	1	1 GIRDER	469A	5'10x2'7x67'6"
INST		REQUIRED LIST		

NO	DATE	INIT
5	4-6	JC

REVISION

CUSTOMER TENNESSEE DEPT. OF HIGHWAYS
ARKANSAS STATE HIGHWAY COMMISSION
STRUCTURE EAST APPROACH - MISS. RIVER BRIDGE
PROJ. I-40-1(116)0 - MEMPHIS - TENN.

BETHLEHEM STEEL CORPORATION
FABRICATED STEEL CONSTRUCTION
CHICAGO DRAFTING ROOM LEETSDALE WORKS
MADE BY SAK DATE 2-25-71 IN CHARGE F.J.K.
CHECKED BY [illegible] DATE 3-8-71 SHOP NO
CONTRACT C-EGA72-000 DRAWING NO. 469

For location of details shown on this sheet refer to diagrams
E401

BACKUP FILMED

5683 (1-63)

11-48-96

NO PAINT TOP OF TOP FLG FULL LENGTH

1-PL 18 x 2½ x 10'-11⅞ - c

1-PL 18 x 3⅜ x 22'-0 - d

1-PL 18 x 2⅜ x 10'-11⅞ - f

1-PL 18 x ⅜ x 11'-11⅜ - b

1-PL 18 x ⅜ x 10'-11 15/16 - g

1-PL 18 x ⅜ x 10'-11 15/16 - h

1-PL b

1-PL c

1-PL d

1-PL f

1-PL 17 x ⅜ x 2'-9½ y

1-PL 15½ x ⅜ x 2'-9 - aa

1-PL 12 x ⅜ x 1'-0½ W-FSKT

1-BOLE PL 402A (DET ON SHT. 402)

1-BR 5 x ⅜ x 4'-11 s-ns ± FS

1-WEB PL 60¾ x ⅜ x 66'-11⅞ - q

1-BR 82 x 1/16 x 50 s-ns m-FS

1-BR ah

COMP SEE GN1

RA

MT

TYP

4 @ 3'-3¼ = 13'-1

6 @ 2'-9⅞ = 16'-11¼

6 @ 3'-8 = 22'-0

13 @ 4 = 4'-4

14'-2⅞

19'-9

9'-8

23'-3⅞

11'-11⅞

11'-0

22'-0

33'-11⅞

66'-11¾

32'-11⅞

10'-11⅞

1'-1⅞

2'-9¾

3'-2½

3'-2¾

1'-3⅞

5'-0

5'-2¾

4'-11

4'-4

+0 -1/16

-⅛

⅞ BOTT. FLG.

℄ BRG PIER E7

































































































































































SECT A-A
(TYP INTER. STIFFNER)

SEC. B-B

SEC. C-C

GIRDER 470A

CAMBER DIAGRAM

FOR GEN NOTES SEE SHEET GN1

ELECTRODES - E70XX
LOW HYDROGEN

¾ x ¾ "CLIP ALL STIFF AS SHOWN"

MATERIAL ASTM-A36

BOLTS ⅞"ϕ

OPEN HOLES 15/16"ϕ SEE GEN. NOTES

A325 FIELD BOLTS —

SHOP CONTACT SURFACES N.P

WELDING AS NOTED

MILLING AS NOTED

PAINT

NOTE X
Both sides of material adjacent to all ... shall be free of ... scale, and paint for a distance of 3" from the ... of bolts

SPAN E7	PIER E7	LINE B	
1	1	GIRDER	470A 5'-10 x 2'-3 x 67'-0

$5	NO.	DESCRIPTION	MARK	REMARKS
INST.		REQUIRED LIST		

CUSTOMER TENNESSEE DEPT. OF HIGHWAYS
ARKANSAS STATE HIGHWAY COMMISSION
STRUCTURE EAST APPROACH - MISS. RIVER BRIDGE
PROJ. I-40-1(116)0 - MEMPHIS - TENN.

BETHLEHEM STEEL CORPORATION
FABRICATED STEEL CONSTRUCTION

CHICAGO DRAFTING ROOM LEETSDALE WORKS
MADE BY SAK DATE 2-26-71 IN CHARGE F.J.K.
CHECKED BY DJ DATE 3-8-71 SHOP NO.
CONTRACT CEGA72-000 DRAWING NO. 470

NO	DATE	INIT	REVISION
S1	4-6	DJ	

SUBMITTAL	1	2	3	4	5	6	7	8	9	0
DATE										

For location of details shown on this sheet refer to diagrams

E401

MARKED

11-48-71

No Paint Top of Top Flg Full Length

1-Pl 18 x 14 x 11'-11 13/16 b

1-Pl 18 x 8½ x 11'-11⅞ - c

1-Pl 18 x 34 x 19'-11⅞ - d

1-Pl 18 x 8½ x 10'-11⅞ - f

1-Pl 18 x 14 x 11'-11 15/16 - g

1-Pl 5 x ⅜ x 4'-11 - ah

1-Br 5 x ⅜ x 4'-11 - s

1-Web Pl 60⅛ x ⅜ x 66'-1 7/16

1-Br 86 x 1⅛ x 5'-0 (K-U.S. M.F.S.) M1E

1-Sole Pl 402A Det. on Sht. No 402

1-Pl b

1-Pl c

1-Pl d

1-Pl f

Comp See Gn1

8 @ 2'-11⅜ = 23'-7

.5 @ 3'-6½ = 17'-8½

13 @ 4 = 4'-4

5'-0

66'-11¾ ℄ Brg Pier E7

℄ Bot. Flg.

RA

Girder 471A

Sect A-A (Typ Inter. Stiffner)

Sec. B-B

Sec. C-C

Camber Diagram

For Gen. Notes See Sheet Gn1

ELECTRODES - E70XX LOW HYDROGEN

¾" x ¾" "Clip All Stiff As Shown"

Material ASTM-A36

Field Bolts 7/8" ϕ

Shop Bolts 1 1/8" ϕ See Gen. Notes

A325 Field Bolts —

Shop Contact Surfaces N.P

Welding As Noted

Milling As Noted

Paint Top 2 ft P 615d Type II

U.N.O. See Note "X"

NOTE X

Both sides of mate. adjacent to all spec. holes must be free of burrs, loose mate. and paint for a distance of 3" from the ℄ of group of holes

Milled

For location of details shown on this sheet refer to diagrams

E401

Span E7 Pier E7 Line A

1	1	Girder	471A	5'10x1⅛x67'-0
S5	NO.	DESCRIPTION	MARK	REMARKS
INST.		REQUIRED LIST		

Customer: Tennessee Dept. of Highways

Arkansas State Highway Commission

Structure: East Approach - Miss. River Bridge

Proj. I-40-1(116)0 - Memphis - Tenn.

Bethlehem Steel Corporation

Fabricated Steel Construction

Chicago Drafting Room — Leetsdale Works

Made by SAK Date 3-7-77 In Charge F.J.K.

Checked by ℄ Date 3-8-77 Shop No

Contract CE-A77-000 Drawing No 471

Revision			
51	4-6	℄	
No	Date	Init	

Submittal	1	2	3	4	5	6	7	8	9	0
Date										

36653 (1-63)

Microfilmed

11-48-98

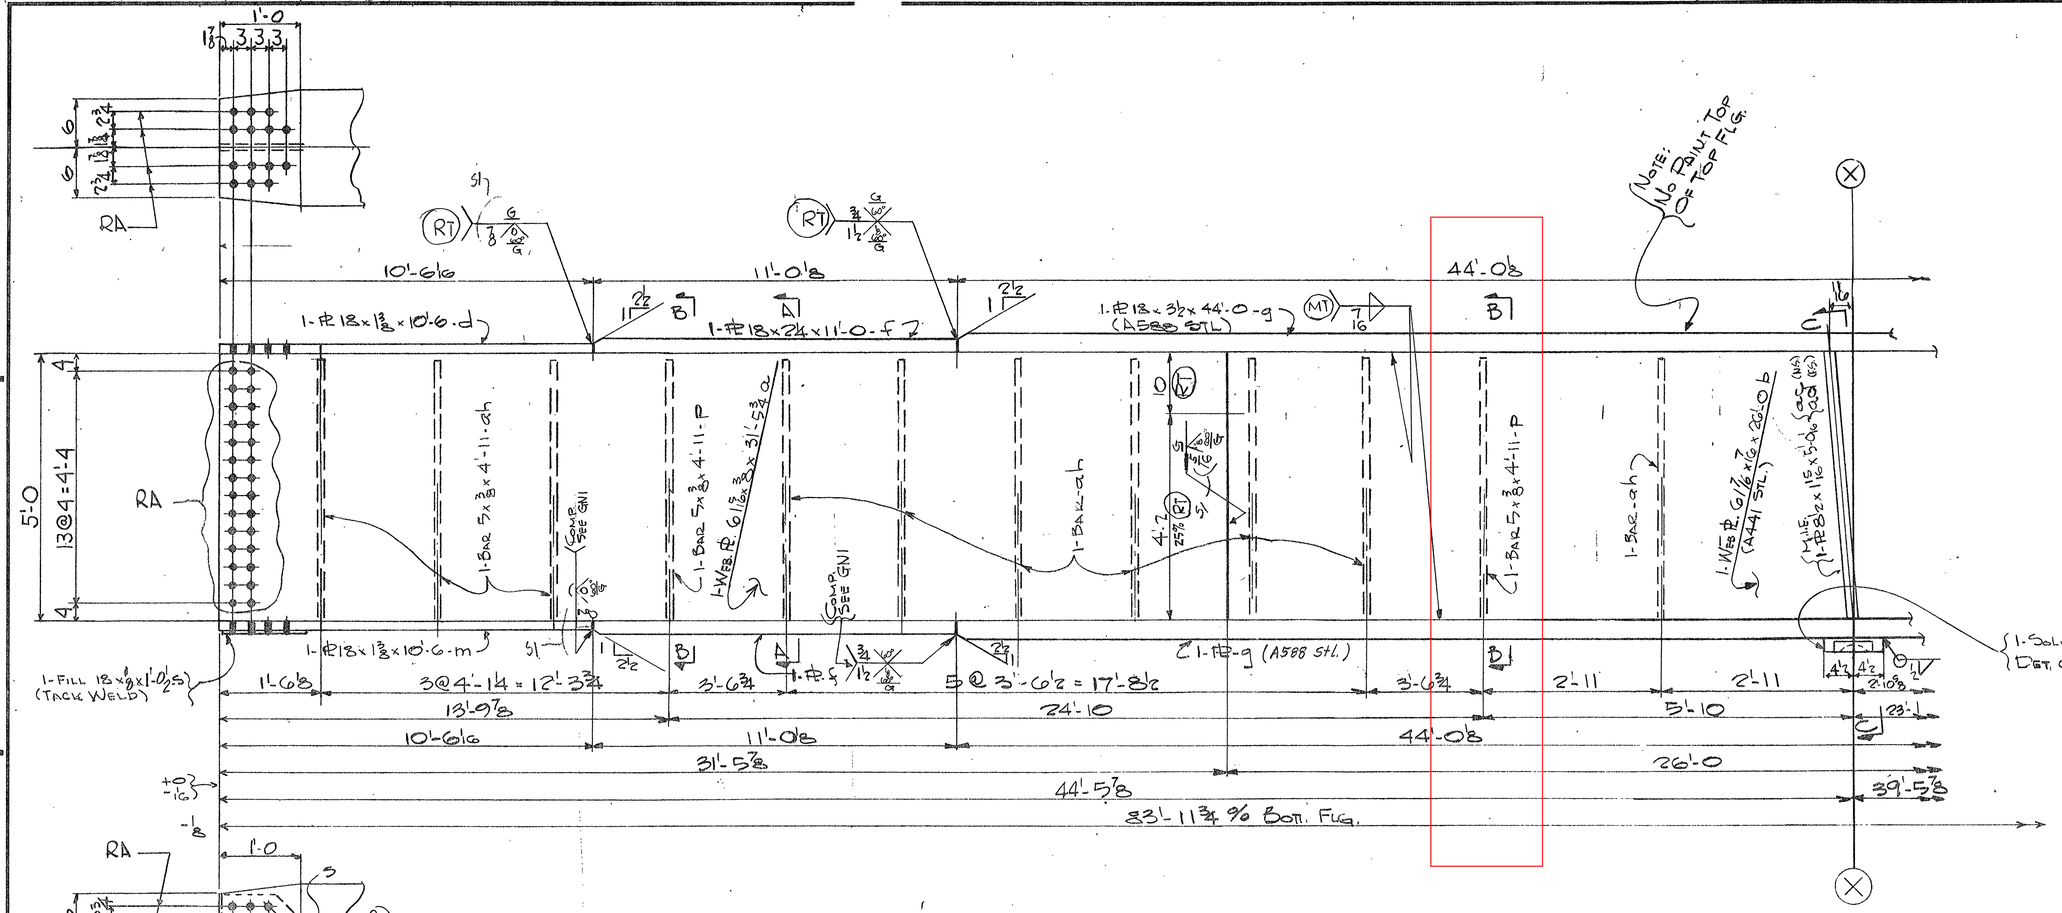

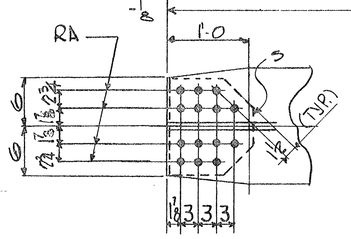

GIRDER - 450A

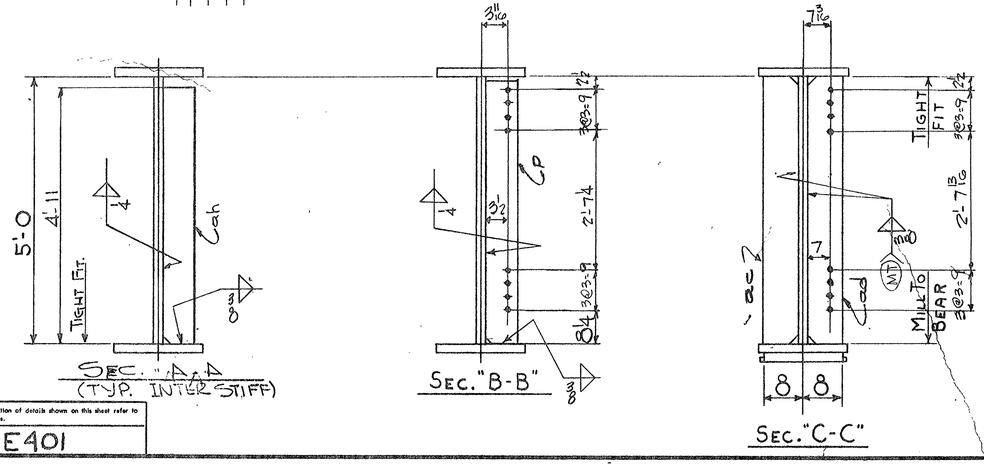

For location of details shown on this sheet refer to diagrams.

E401

MATERIAL
RIVETS OR BOLTS
OPEN HOLES
A325 FIELD BOLTS
SHOP CONTACT SURFACES
PAINT

SEE SHT. # 450 BB

SPAN 8 - LINE F

CUSTOMER: TENNESSEE DEPT. OF HIGHWAYS
ARKANSAS STATE HIGHWAY COMMISSION
STRUCTURE: EAST APPROACH - MISS. RIVER BRIDGE
PROJ. I-40-1(116)0 - MEMPHIS - TENN.

BETHLEHEM STEEL CORPORATION
FABRICATED STEEL CONSTRUCTION

CHICAGO DRAFTING ROOM
MADE BY E.D.S.L. DATE 2-11-71 IN CHARGE FJK
CHECKED BY W.A.L. DATE 2-26-71 SHOP NO.
LEETSDALE WORKS
CONTRACT CEG 972-000 DRAWING NO. 450AB

REVISION: NO | DATE | INIT

SUBMITTAL / DATE: 1 2 3 4 5 6 7 8 9 0

36668 11-69

54

11-18-71

4

MICROFILMED

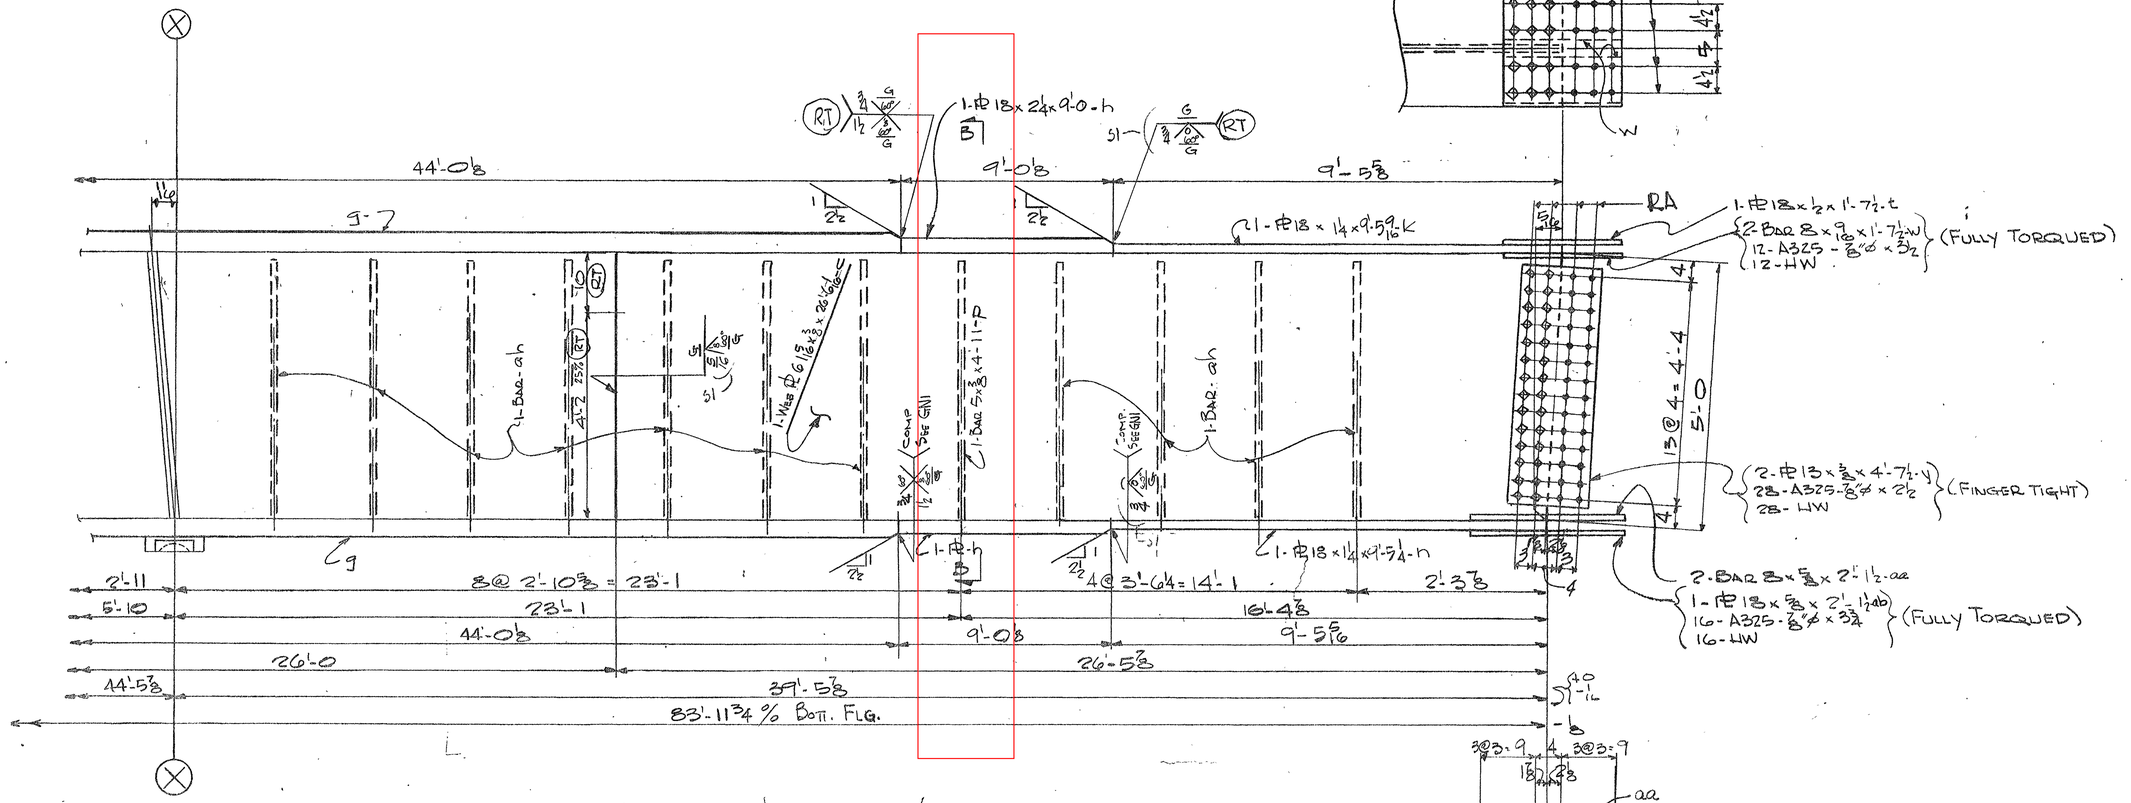

CAMBER DIAGRAM

(WEB PL'S TO BE WELDED TOGETHER BEFORE BURNING WEB)

NOTE X

Both sides of material adjacent to all openings must be free of burrs, loose scale and paint for a distance of 3" from the group of holes

ELECTRODES - E70XX LOW HYDROGEN

NOTE: ¾" x ¾ CLIP ALL STIFF AS SHOWN

MATERIAL: ASTM-A36 U.N.O.

BOLTS A325

OPEN HOLES 15/16 ø

A325 FIELD BOLTS

SHOP CONTACT SURFACES N.P.

PAINT WELDING / MILLING } AS NOTED

1 Coat ZT-P 615d Type II U.N.O. See Note "X"

FOR GEN NOTES SEE GN1

SPAN 8 - LINE F

	1	1	GIRDER	450A	85'-0
	S4	NO.	DESCRIPTION	MARK	REMARKS
INST.		REQUIRED LIST			

CUSTOMER: TENNESSEE DEPT. OF HIGHWAYS / ARKANSAS STATE HIGHWAY COMMISSION

STRUCTURE: EAST APPROACH - MISS. RIVER BRIDGE

PROJ. I-40-1(116)0 - MEMPHIS - TENN.

BETHLEHEM STEEL CORPORATION

FABRICATED STEEL CONSTRUCTION

LIVINGSTON DALE WORKS

CHICAGO DRAFTING ROOM

MADE BY E.DEL DATE 2-11-71 IN CHARGE FJK

CHECKED BY MH DATE 2-26-71 SHOP NO.

CONTRACT CEG 472-000 DRAWING NO. 450 BB

REVISION: NO. 4-5 DATE 5/1 INIT. E

SUBMITTAL DATE

For location of details shown on this sheet refer to diagrams.

E401

M-48-72

5

Note: No paint top of top flg

1-PL 18×3/8×10'-6-d

1-PL 18×2 1/4×11'-0 5/8

1-PL 18×3/2×44'-0-9 (A588 STL)

1-Fill 18×3×1'-0 1/2-ac Tack Weld

1-Bar 5×3/8×4'-11-ah

1-Web PL G 1/2×3/8×3'-5 3/8-a

Comp. (See GN1)

1-Bar 5×3/8×4'-11 P (N.S.) S (F.S.)

1-Bar-ah

1-Web PL G 1/2×7/16×26'-0b (A441 STL)

1-Bar-ah2

1-PL 18×1/2×5'-0 1/2 (N.S.) (F.S.)

1-PL 18×3/8×10'-6-m

1-PL-f

1-PL-g (A588 STL.)

1-Sole PL * 402A Det. On Sht. *402

10'-6 1/16 | 11'-0 3/8 | 44'-0 3/8

1'-7 7/8 | 4'-2 | 4'-2 | 3'-6 3/4 | 5@3'-6 1/2 = 17'-8 1/2 | 3'-6 3/4 | 3'-2 3/4 | 3'-2 3/4 | 3'-2 3/4 | 4'-2 | 4'-2 | 2'-9

9'-11 7/8 | 24'-10 | 9'-8 | 19'-3

10'-6 1/16 | 11'-0 3/8 | 44'-0 3/8

31'-5 3/8 | 26'-0 | 39'-5 3/8

44'-5 7/8

33'-11 3/4 % Bot. Flg.

5'-0 = 13@4 = 4'-4

1-PL 16 1/2×3/8×2'-8-ad

1-PL 16 1/2×3/8×7'-8 1/2-ad

GIRDER - 451A

SPAN 8 - LINE E

Sec. A-A (Typ. Inter. Stiff.)

Sec. "B-B"

Sec. "C-C"

For location of details shown on this sheet refer to diagrams.

E401

	a	b	c
1	✓		
2	✓	✓	
3	✓	✓	
4	✓	✓	
5	✓	✓	
6	✓	✓	
7	✓	✓	
8	✓	✓	
9	✓	✓	
10	✓	✓	
11	✓	✓	
12	✓	✓	
13	✓	✓	
14	✓		

MICROFILMED

Material	See Sht. # 451 BB
Rivets or Bolts	
Open Holes	
A325 Field Bolts	
Shop Contact Surfaces	
Paint	

Submittal	1	2	3	4	5	6	7	8	9	0
Date										

No.	Date	Init.	Revision
51	4-5-72		

Customer: Tennessee Dept. of Highways; Arkansas State Highway Commission

Structure: East Approach - Miss. River Bridge

Proj. I-40-1(116)0 - Memphis - Tenn.

BETHLEHEM STEEL CORPORATION

Fabricated Steel Construction

Chicago Drafting Room — Leetsdale Works

Made by E.Dal Date 2-12-71 In Charge FJK

Checked by Hab Date 3-1-71 Shop No.

Contract CEG472-000 Drawing No. 451 AB

36663 (7-67)

M-48-73

4

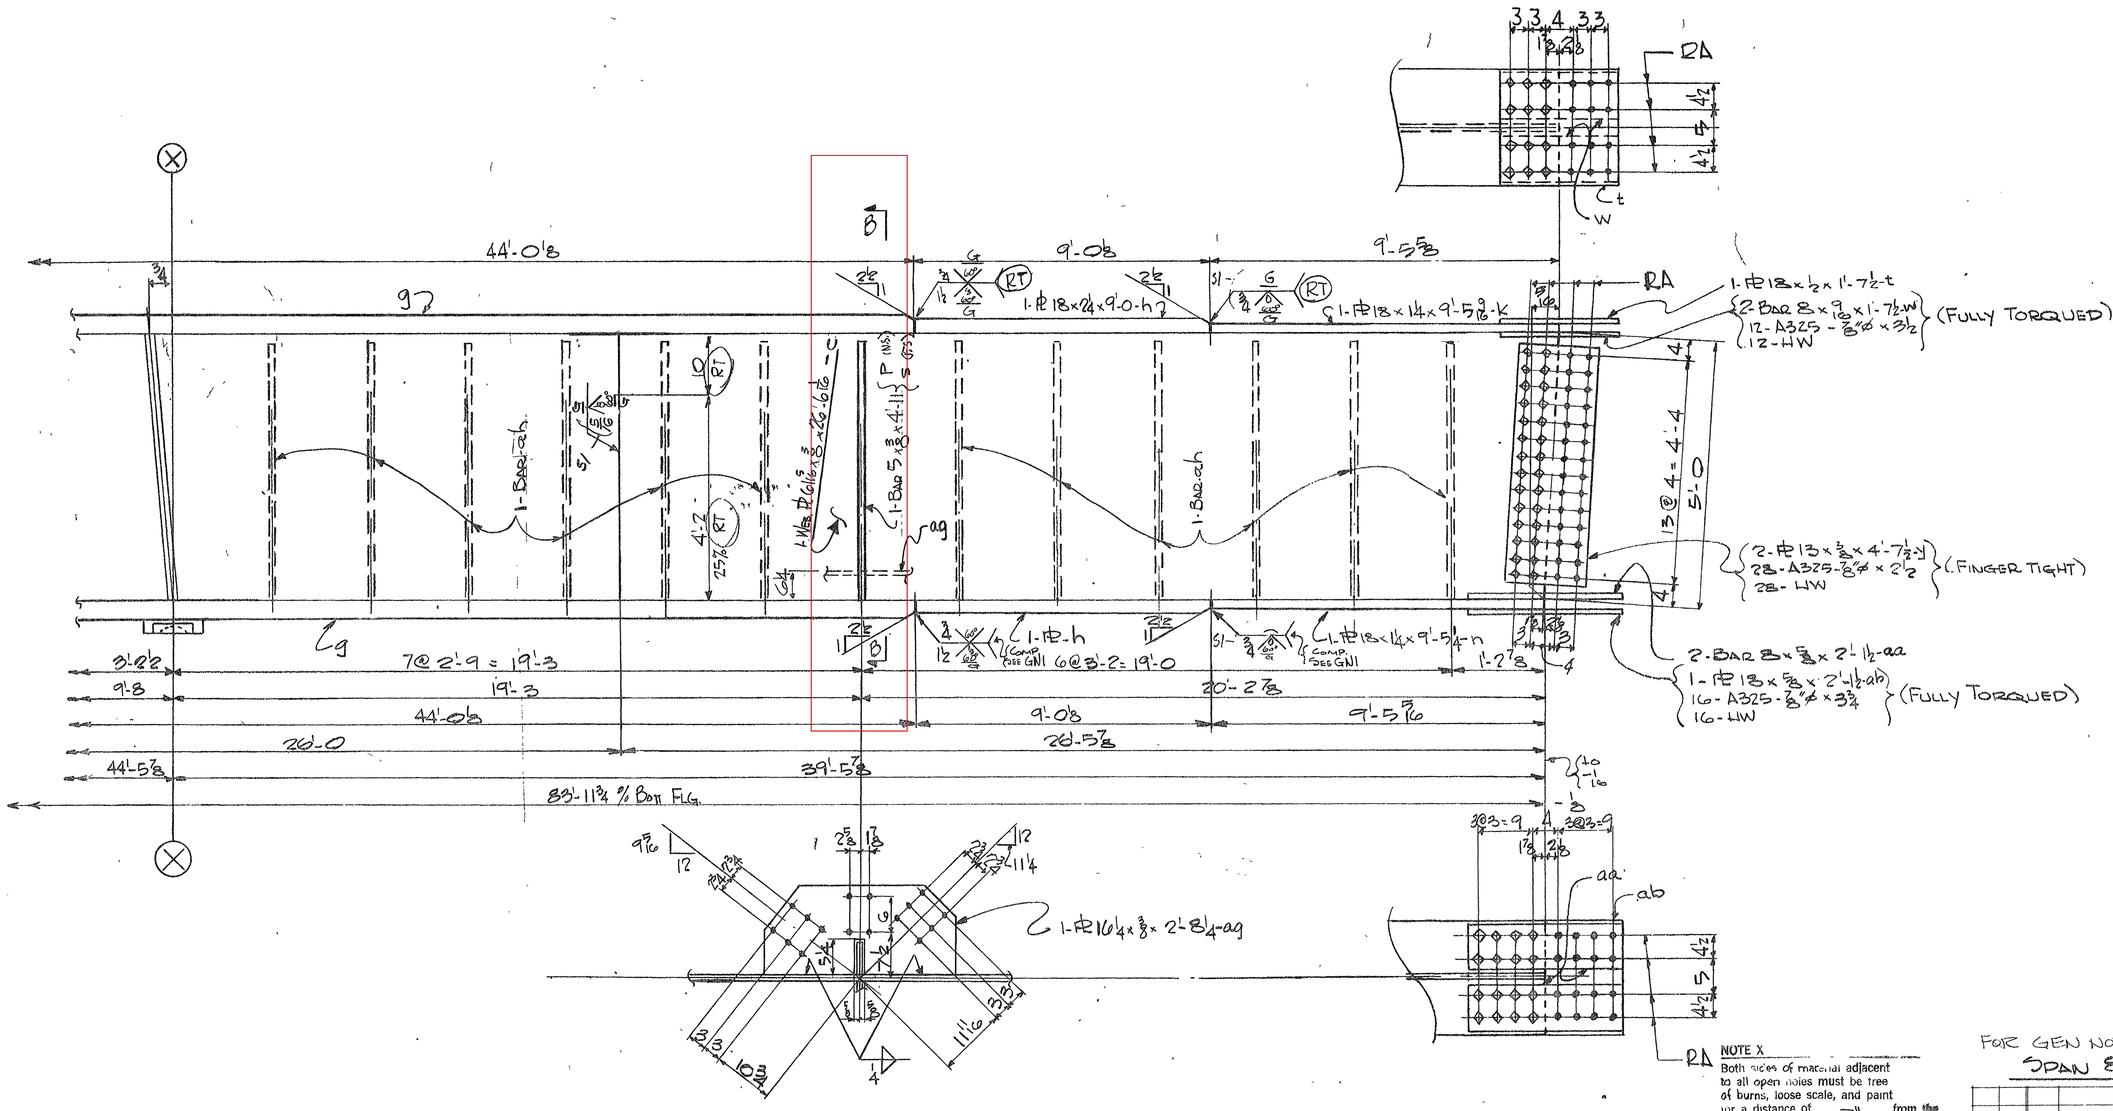

NOTE X
Both sides of material adjacent to all open holes must be free of burns, loose scale, and paint for a distance of 2" from the group of holes.

ELECTRODES - E70XX LOW HYDROGEN

NOTE: ¾"×¾" CLIP ALL STIFF AS SHOWN

MATERIAL ASTM-A36 U.N.
BOLTS A325
OPEN HOLES 15/16"ø
A325 FIELD BOLTS
SHOP CONTACT SURFACES N.P.
WELDING, MILLING } AS NOTED
PAINT
1 Coat) T P 615d Type II U.N. ‡ See Note "X"

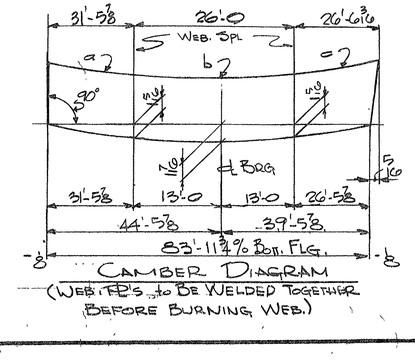

FOR GEN NOTES SEE: GN1
SPAN B - LINE E

INST.	S4	NO	DESCRIPTION	MARK	REMARKS
		1	GIRDER	451A	85'-0
			REQUIRED LIST		

CUSTOMER: TENNESSEE DEPT. OF HIGHWAYS
ARKANSAS STATE HIGHWAY COMMISSION
STRUCTURE: EAST APPROACH - MISS. RIVER BRIDGE
PROJ. I-40-1(116)0 - MEMPHIS - TENN.

BETHLEHEM STEEL CORPORATION
FABRICATED STEEL CONSTRUCTION
LEETSDALE WORKS

CHICAGO DRAFTING ROOM
MADE BY E. DEL DATE 2-12-71 IN CHARGE FJK
CHECKED BY MK DATE 3-1-71 SHOP NO
CONTRACT CEG472-000 DRAWING NO 451 BB

REVISION: 4-5 NO DATE INIT

SUBMITTAL DATE: 1 2 3 4 5 6 7 8 9 0

For location of details shown on this sheet refer to diagrams
E401

MICROFILMED

M-48-74

44'-0⅛

10'-0⅛

8'-5⅝

1-PL 18x2¼x10'-0.h

1-PL 18x1¼x8'-5⅞-k

1-PL 18x½x1'-7½-P
2 BAR 8x⅞x1'-7½-S
12-A325-⅞"ø x 3½
12-HW
(FULLY TORQUED)

2-PL 13x⅜x4'-7½-t
28-A325-⅞"ø x 2½
28-HW
(FINGER TIGHT)

2-BAR 8x⅝x2'-1½-W
1-PL 18x⅝x2'-1½-Y
16-A325-⅞"ø x 3¾
16-HW
(FULLY TORQUED)

1-BAR 5"x⅜x 4'-11½ ab (NS) ac (FS)

1-WEB PL 6⅛x⅜x 26'-1⅞-c

1-BAR ak

1-BAR am

1-BAR ab (NS) ac (FS)

1-PL h

1-PL 18x1¼x8'-5¾-n

COMP. SEE GN1

2'-8 | 2'-6 | 5@2'-7 = 12'-11 | 3'-2¾ | 5@3'-2½ = 16'-0½ | 3'-2¾ | 1'-6⅝

13'-6 | 15'-5 | 22'-6

44'-0⅛ | 10'-0⅛ | 8'-5⅝

26'-0 | 26'-5⅜

44'-5⅜ | 39'-5⅜

83'-11¾ % BOT. FLG

11'-3 | 11'-3

1-PL 19½x⅜x 2'-9½-ak

1-PL 12½x⅜x 2'-04-am

NOTE X

Both sides of material adjacent to all open holes must be free of burrs, loose scale, and paint for a distance of 3" from the group of holes.

ELECTRODES - E70XX LOW HYDROGEN

NOTE: ¾"x¾ CLIP ALL STIFF AS SHOWN

MATERIAL ASTM-A36 U.N.

BOLTS A325

OPEN HOLES 15/16ø

A325 FIELD BOLTS

SHOP CONTACT SURFACES N.P.

PAINT WELDING / MILLING } AS NOTED

1 Coat IT-P 615d Type II - U.N.I. See Note "X"

31'-5⅜ | 26'-0 | 26'-6 13/16

WEB SPL. 2

a2 | b | c2

44'-5⅜ | 39'-5⅜

83'-11¾ % BOT. FLG.

CAMBER DIAGRAM

(WEB PL'S to BE WELDED TOGETHER BEFORE BURNING WEB.)

FOR GEN NOTES SEE GN1

SPAN 8 - LINE D

INST.	NO.	DESCRIPTION	MARK	REMARKS
	1	GIRDER	452A	85'-0
S4		REQUIRED LIST		

SUBMITTAL 1 2 3 4 5 6 7 8 9 0

DATE

REVISION NO | DATE | INIT

5' 7-5

CUSTOMER TENNESSEE DEPT. OF HIGHWAYS

ARKANSAS STATE HIGHWAY COMMISSION

STRUCTURE EAST APPROACH - MISS. RIVER BRIDGE

PROJ. I-40-1(116)0 - MEMPHIS - TENN.

BETHLEHEM STEEL CORPORATION

FABRICATED STEEL CONSTRUCTION

CHICAGO DRAFTING ROOM LEETSDALE WORKS

MADE BY E-DEL DATE 2-16-71 IN CHARGE FJK

CHECKED BY [illegible] DATE 3-2-71 SHOP NO

CONTRACT CEG472-000 DRAWING NO. 452 BB

For location of details shown on this sheet refer to diagrams

E401

MICROFILMED

11-48-73

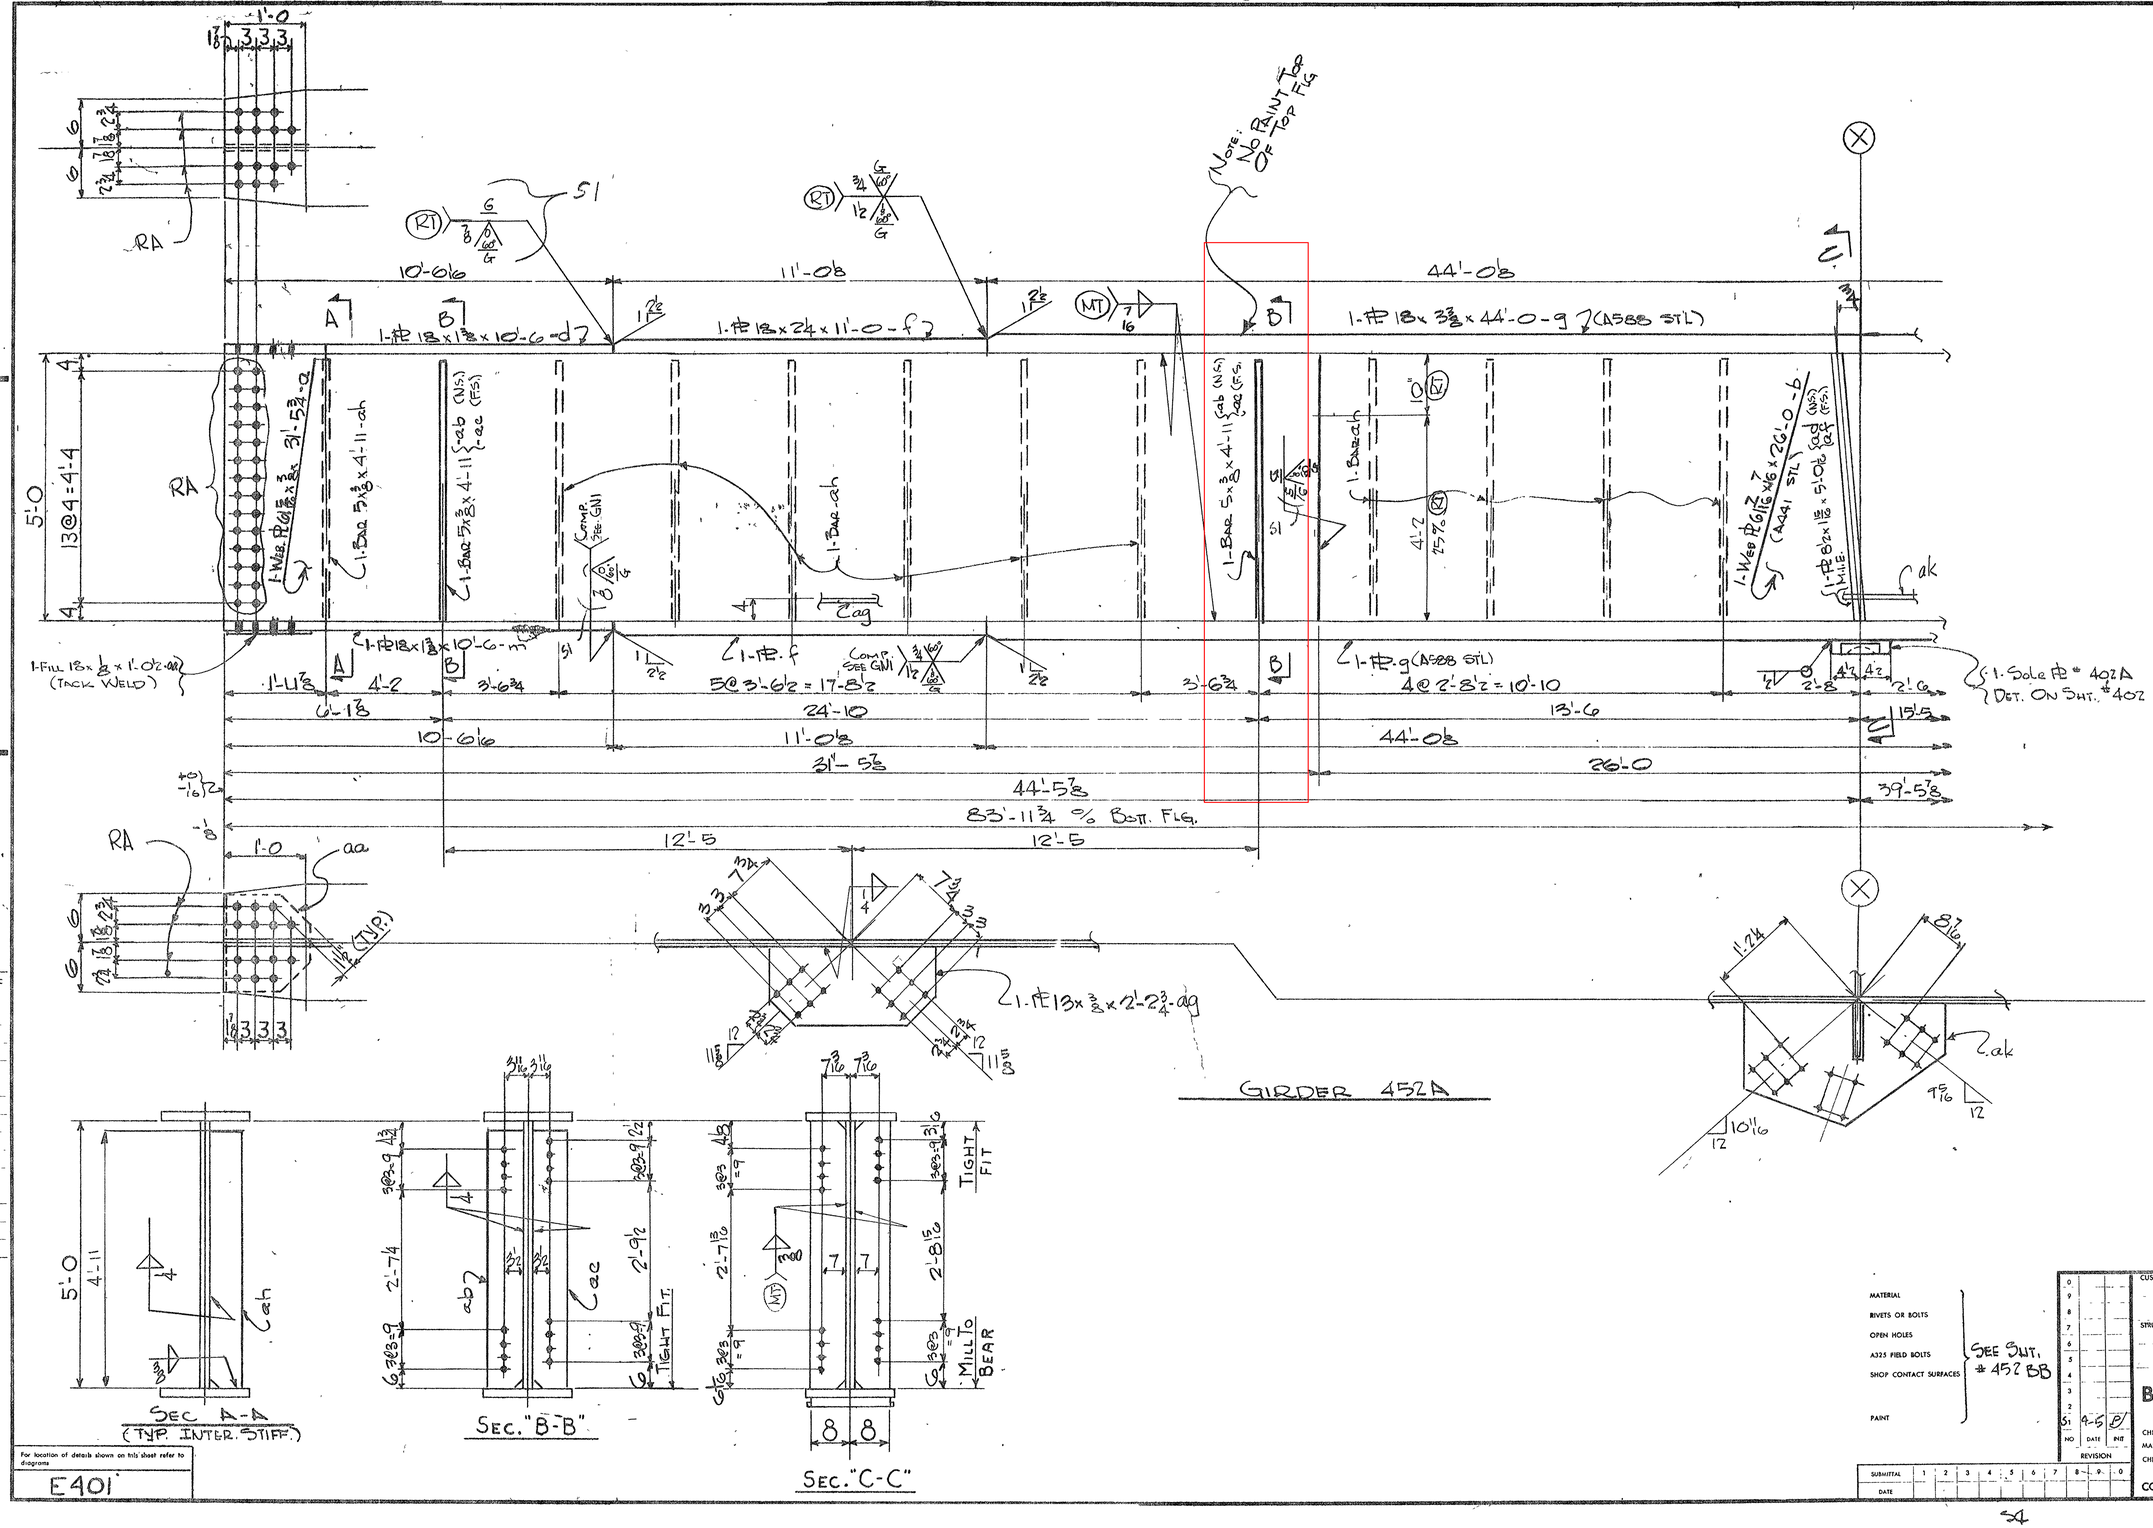

For location of details shown on this sheet refer to diagrams

E401

MATERIAL
RIVETS OR BOLTS
OPEN HOLES
A325 FIELD BOLTS
SHOP CONTACT SURFACES
PAINT
SEE SHT. # 452 BB

NO	DATE	INIT
5	9-5	EJ

REVISION

SUBMITTAL / DATE

CUSTOMER: TENNESSEE DEPT. OF HIGHWAYS
STRUCTURE: ARKANSAS STATE HIGHWAY COMMISSION
EAST APPROACH - MISS. RIVER BRIDGE
PROJ. I-40-1(116)0 - MEMPHIS - TENN.

BETHLEHEM STEEL CORPORATION
FABRICATED STEEL CONSTRUCTION
LEETSDALE WORKS

CHICAGO DRAFTING ROOM
MADE BY F.DEL DATE 2-Ko-71 IN CHARGE FJK
CHECKED BY Hab DATE 3-2-71 SHOP NO.
CONTRACT CEG472-000 DRAWING NO 452 AB

SPAN 8 - LINE D

MICROFILMED

NOTE: NO PAINT ON TOP FLG

1-PL 18 x 1 3/8 x 9'-5 1/2 - d

1-PL 18 x 2 3/8 x 11'-0 - f

1-PL 18 x 3/4 x 11'-0 - g

1-PL 18 x 3 3/8 x 26'-0 - h (A588 STL)

1-FILL 12 x 3/8 x 1'-0 1/2 - ae (TACK WELD)

1-WEB PL 61 1/8 x 3/8 x 31'-5 3/8 - a

1-BAR 5 x 3/4 x 41'-11 1/2 - ad (NS) af (FS)

1-BAR - ah

1-BAR - ah

1-WEB PL 61 1/16 x 7/16 x 26'-0 - b (A441 STL)

1-PL 8 1/2 x 1 1/8 x 5'-0 1/2 - ag (NS) ak (FS) MILL

1-PL 18 x 1 3/8 x 9'-5 1/2 - ab

1-PL - f

1-PL - g

1-PL - h (A588 STL)

1-SOLE PL # 402 A
DET. ON SHT. # 402

1-PL 13 x 3/8 x 2'-2 3/4 - am

1-PL 19 1/2 x 3/8 x 2'-8 1/4 - an

5'-0

13@4 = 4'-4

9'-5 9/16 | 11'-0 1/8 | 11'-0 1/8 | 26'-0 1/8

5@ 3'-6 1/2 = 17'-8 1/2 | 3'-6 3/4 | 2'-10 3/4 | 4@ 2'-10 5/8 = 11'-6 1/2

2'-3 3/8 | 24'-10 | 17'-4

9'-5 9/16 | 11'-0 1/8 | 11'-0 1/8 | 13'-0 1/16 | 11'-7

31'-5 13/16 | 26'-0 1/8 | 13'-0 1/16

44'-5 7/8 | 39'-5 7/8

12'-5 | 12'-5

83'-11 3/4 % BOT. FLG.

SEC. A-A (TYP INTER. STIFF.)

SEC. "B-B"

SEC. "C-C"

GIRDER - 453A

SPAN 'B' - LINE C

MATERIAL	SEE SHT. # 453BB
RIVETS OR BOLTS	
OPEN HOLES	
A325 FIELD BOLTS	
SHOP CONTACT SURFACES	
PAINT	

CUSTOMER: TENNESSEE DEPT. OF HIGHWAYS
ARKANSAS STATE HIGHWAY COMMISSION
STRUCTURE: EAST APPROACH - MISS. RIVER BRIDGE
PROJ. I-40-1(116)0 - MEMPHIS - TENN.

BETHLEHEM STEEL CORPORATION
FABRICATED STEEL CONSTRUCTION

CHICAGO DRAFTING ROOM — LEETSDALE WORKS
MADE BY E.D.E. DATE 2-18-71 — IN CHARGE F.J.K.
CHECKED BY DATE 3-2-71 — SHOP NO.

CONTRACT CEG 972-000 DRAWING NO. 453 AB

REVISION: 51 4-5 FJ (NO | DATE | INIT)

SUBMITTAL DATE: 1 2 3 4 5 6 7 8 9 0

For location of details shown on this sheet refer to diagrams

E401

MICROFILMED

11-18-71

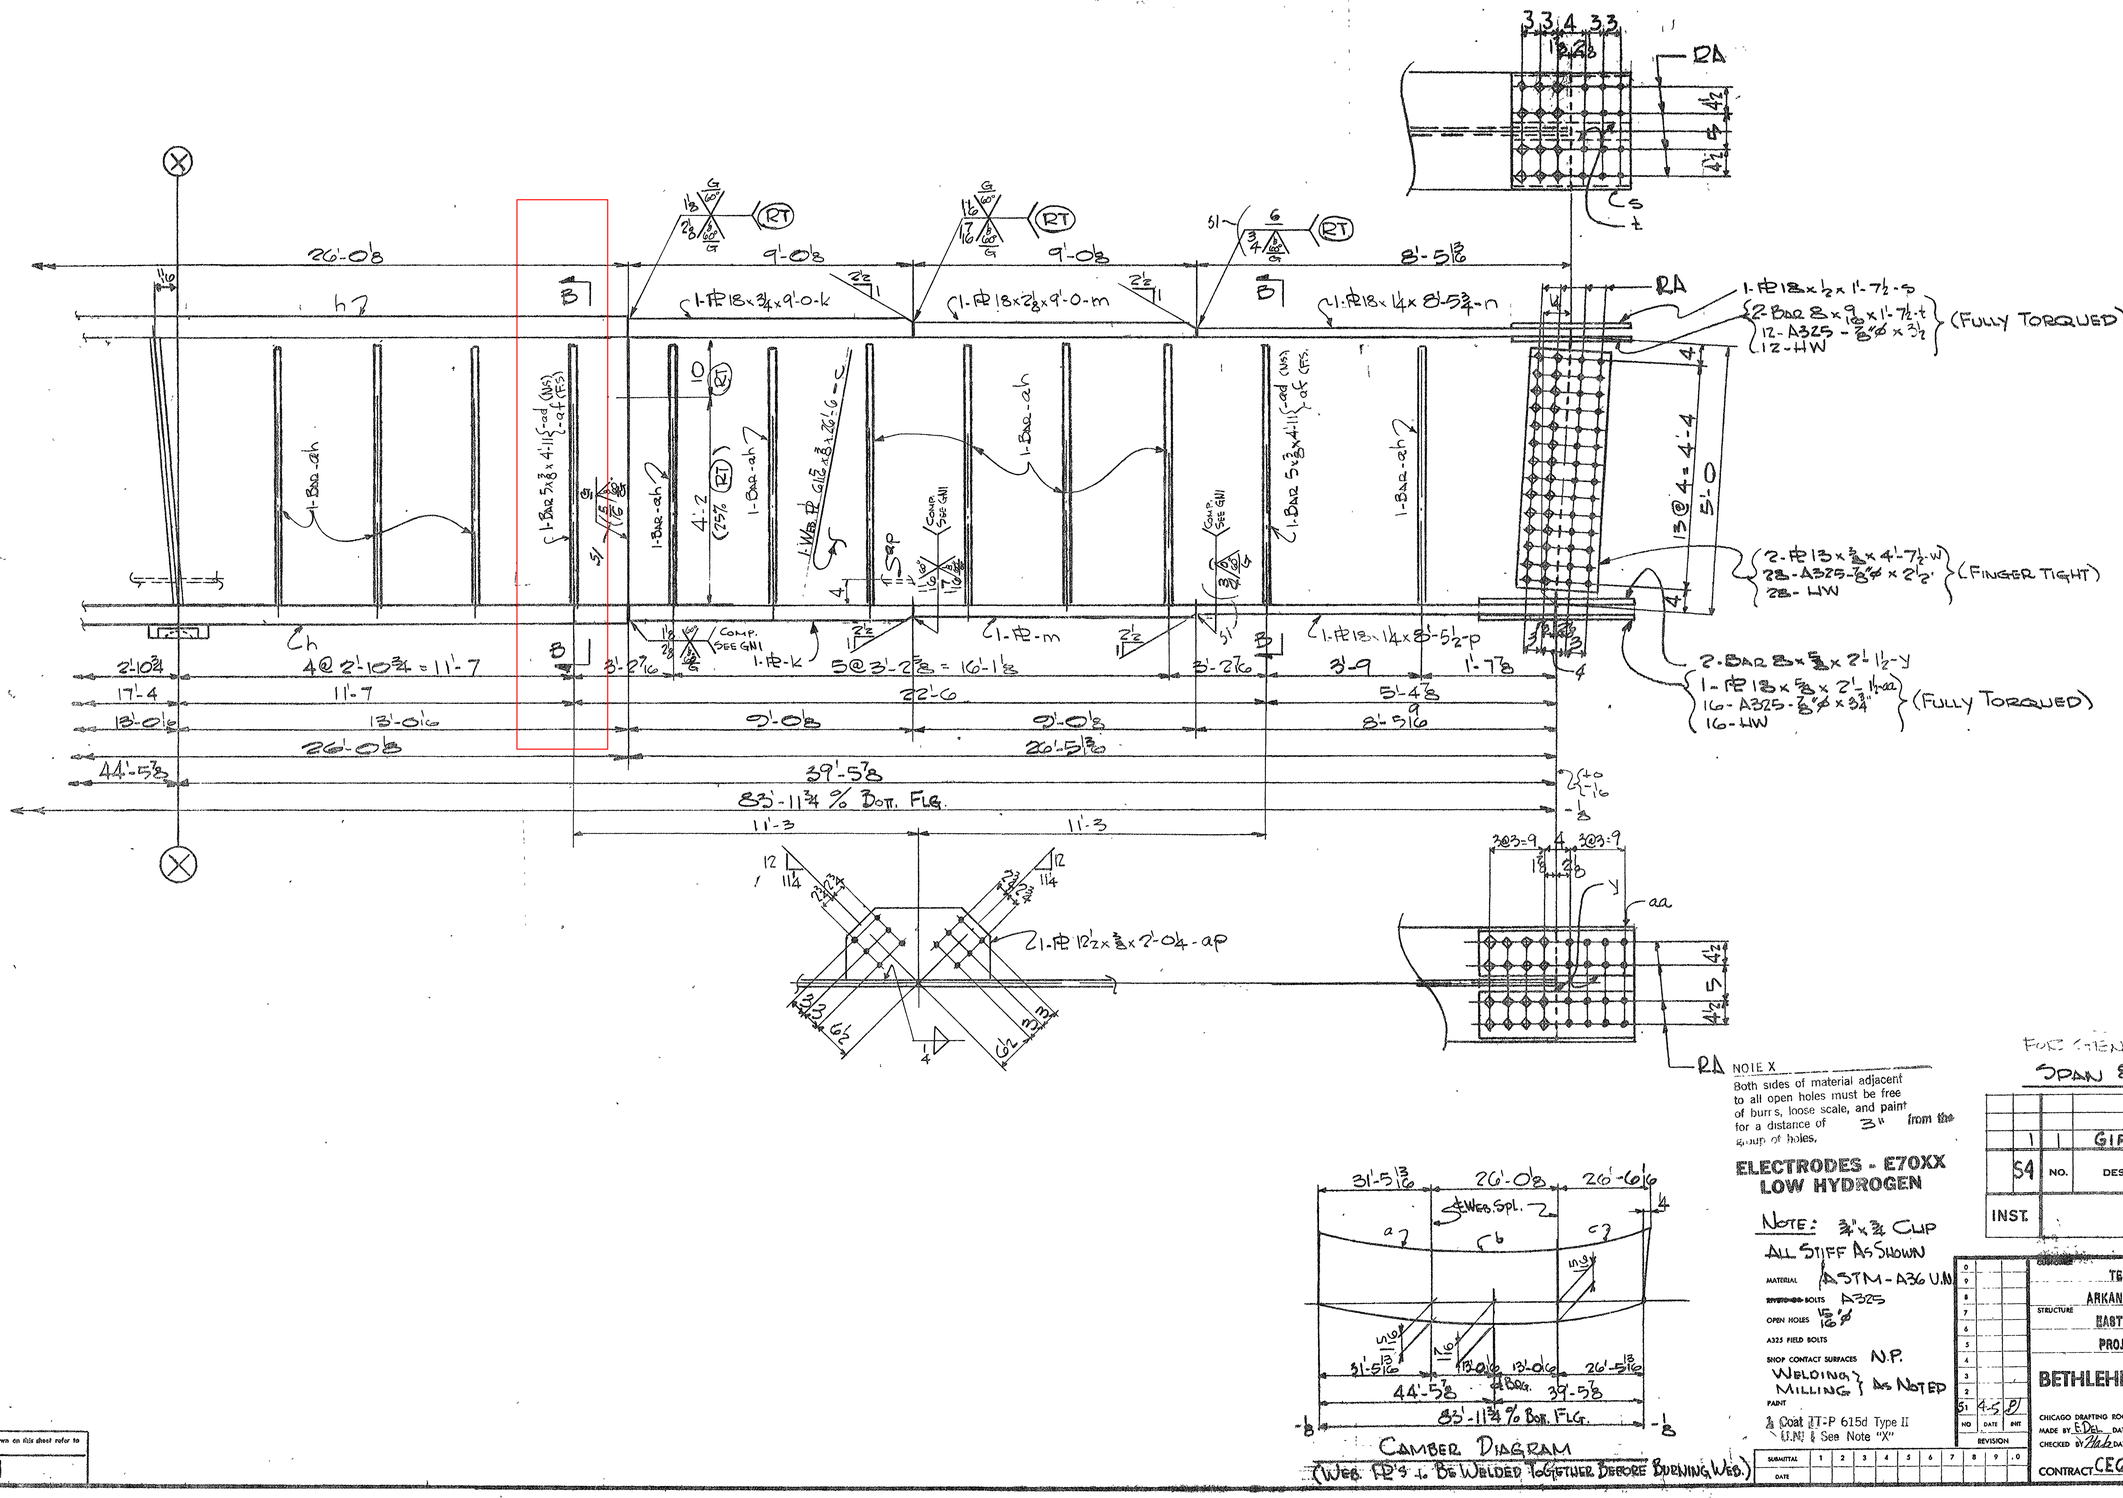

FOR GEN NOTES SEE GN1

SPAN 8 - LINE C

INST.	54	NO.	DESCRIPTION	MARK	REMARKS
		1	GIRDER	453A	850
			REQUIRED LIST		

SUBMITTAL	1	2	3	4	5	6	7	8	9	0
DATE										

REVISION

NO	DATE	INIT
5	4-5	PJ

TENNESSEE DEPT. OF HIGHWAYS
ARKANSAS STATE HIGHWAY COMMISSION
STRUCTURE EAST APPROACH - MISS. RIVER BRIDGE
PROJ. I-40-1(116)0 - MEMPHIS - TENN.

BETHLEHEM STEEL CORPORATION
FABRICATED STEEL CONSTRUCTION

CHICAGO DRAFTING ROOM LEETSDALE WORKS
MADE BY EDel DATE 2-18-71 BY CHARGE FJK
CHECKED BY Mak DATE 3-2-71 SHOP NO.
CONTRACT CEG472-000 DRAWING NO. 453BB

For location of details shown on this sheet refer to diagrams, E401

MICROFILMED

11-18-78

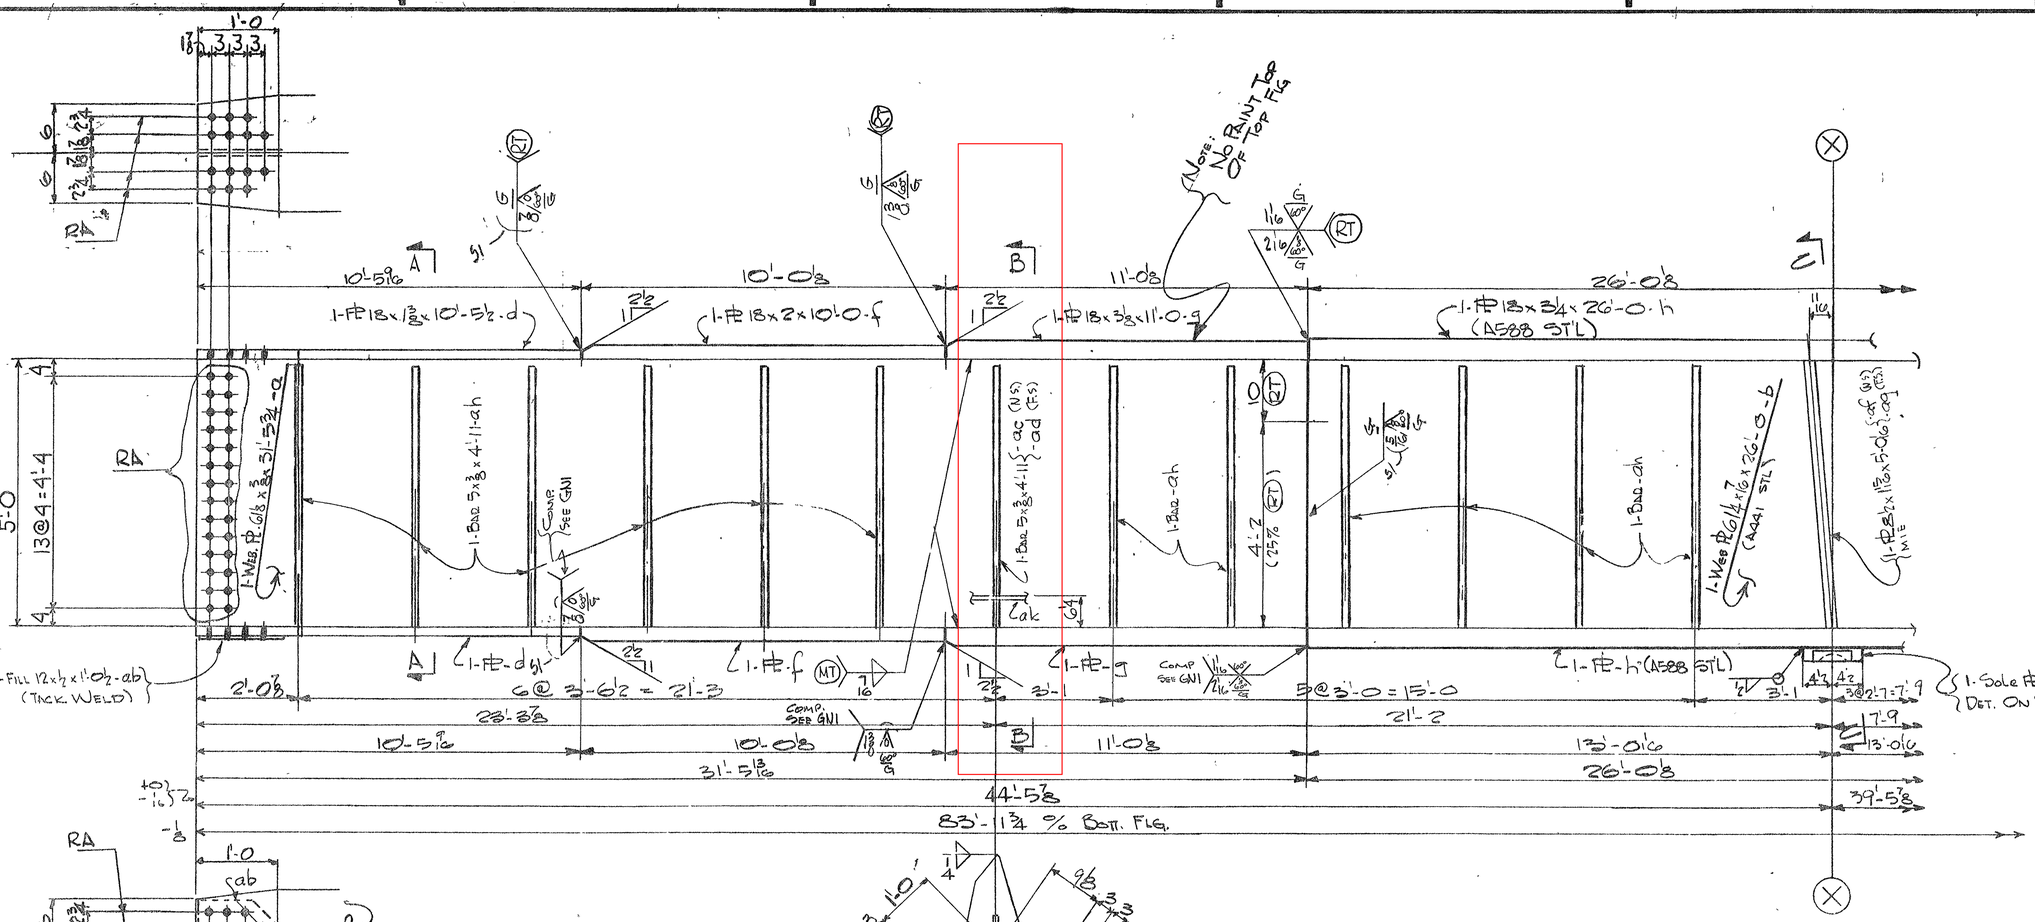

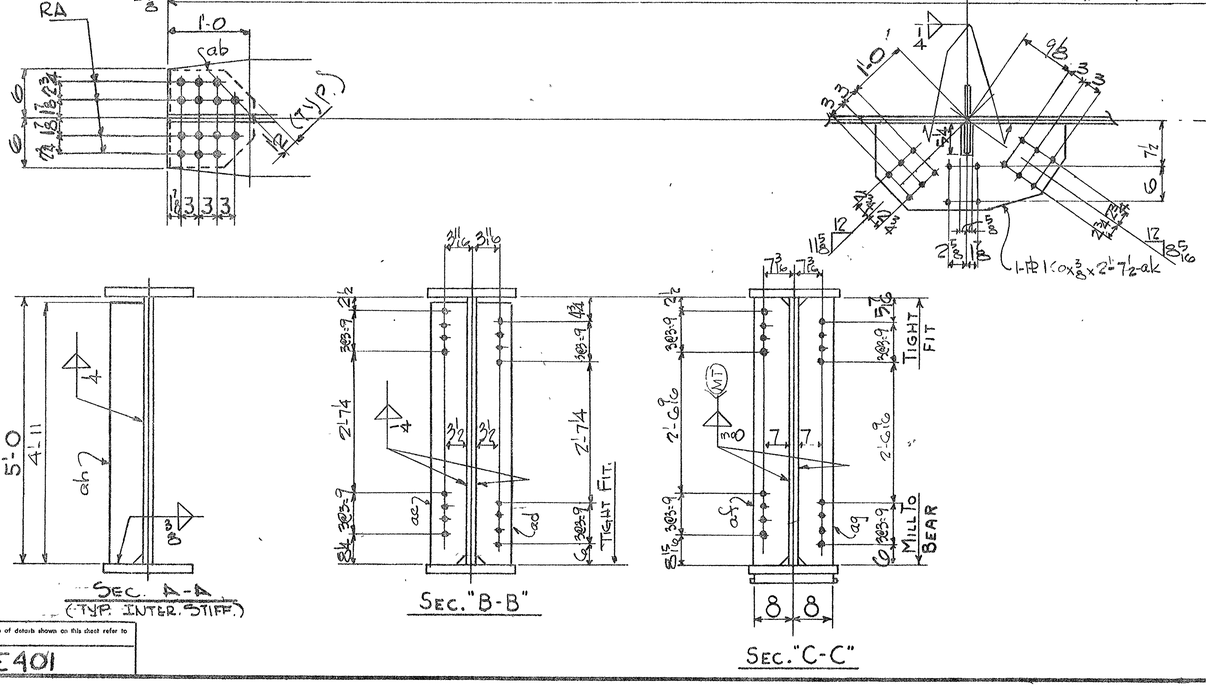

Girder-454A

Span 8-Line B

Material	See Sht. #454-BB
Rivets or Bolts	
Open Holes	
A325 Field Bolts	
Shop Contact Surfaces	
Paint	

For location of details shown on this sheet refer to diagrams

E401

Submittal	1	2	3	4	5	6	7	8	9	0
Date										

No	Date	Init	Revision
5	4-5	BJ	

CUSTOMER: Tennessee Dept. of Highways
Arkansas State Highway Commission
STRUCTURE: East Approach - Miss. River Bridge
Proj. I-40-1(116)0 - Memphis - Tenn.

Bethlehem Steel Corporation
Fabricated Steel Construction

Chicago Drafting Room — Leetsdale Works
Made by EDEL Date 7-18-71 In Charge FJK
Checked by [illegible] Date 8-3-71 Shop No.
Contract CEG472-000 Drawing No. 454AB

MM-498-79 (A)

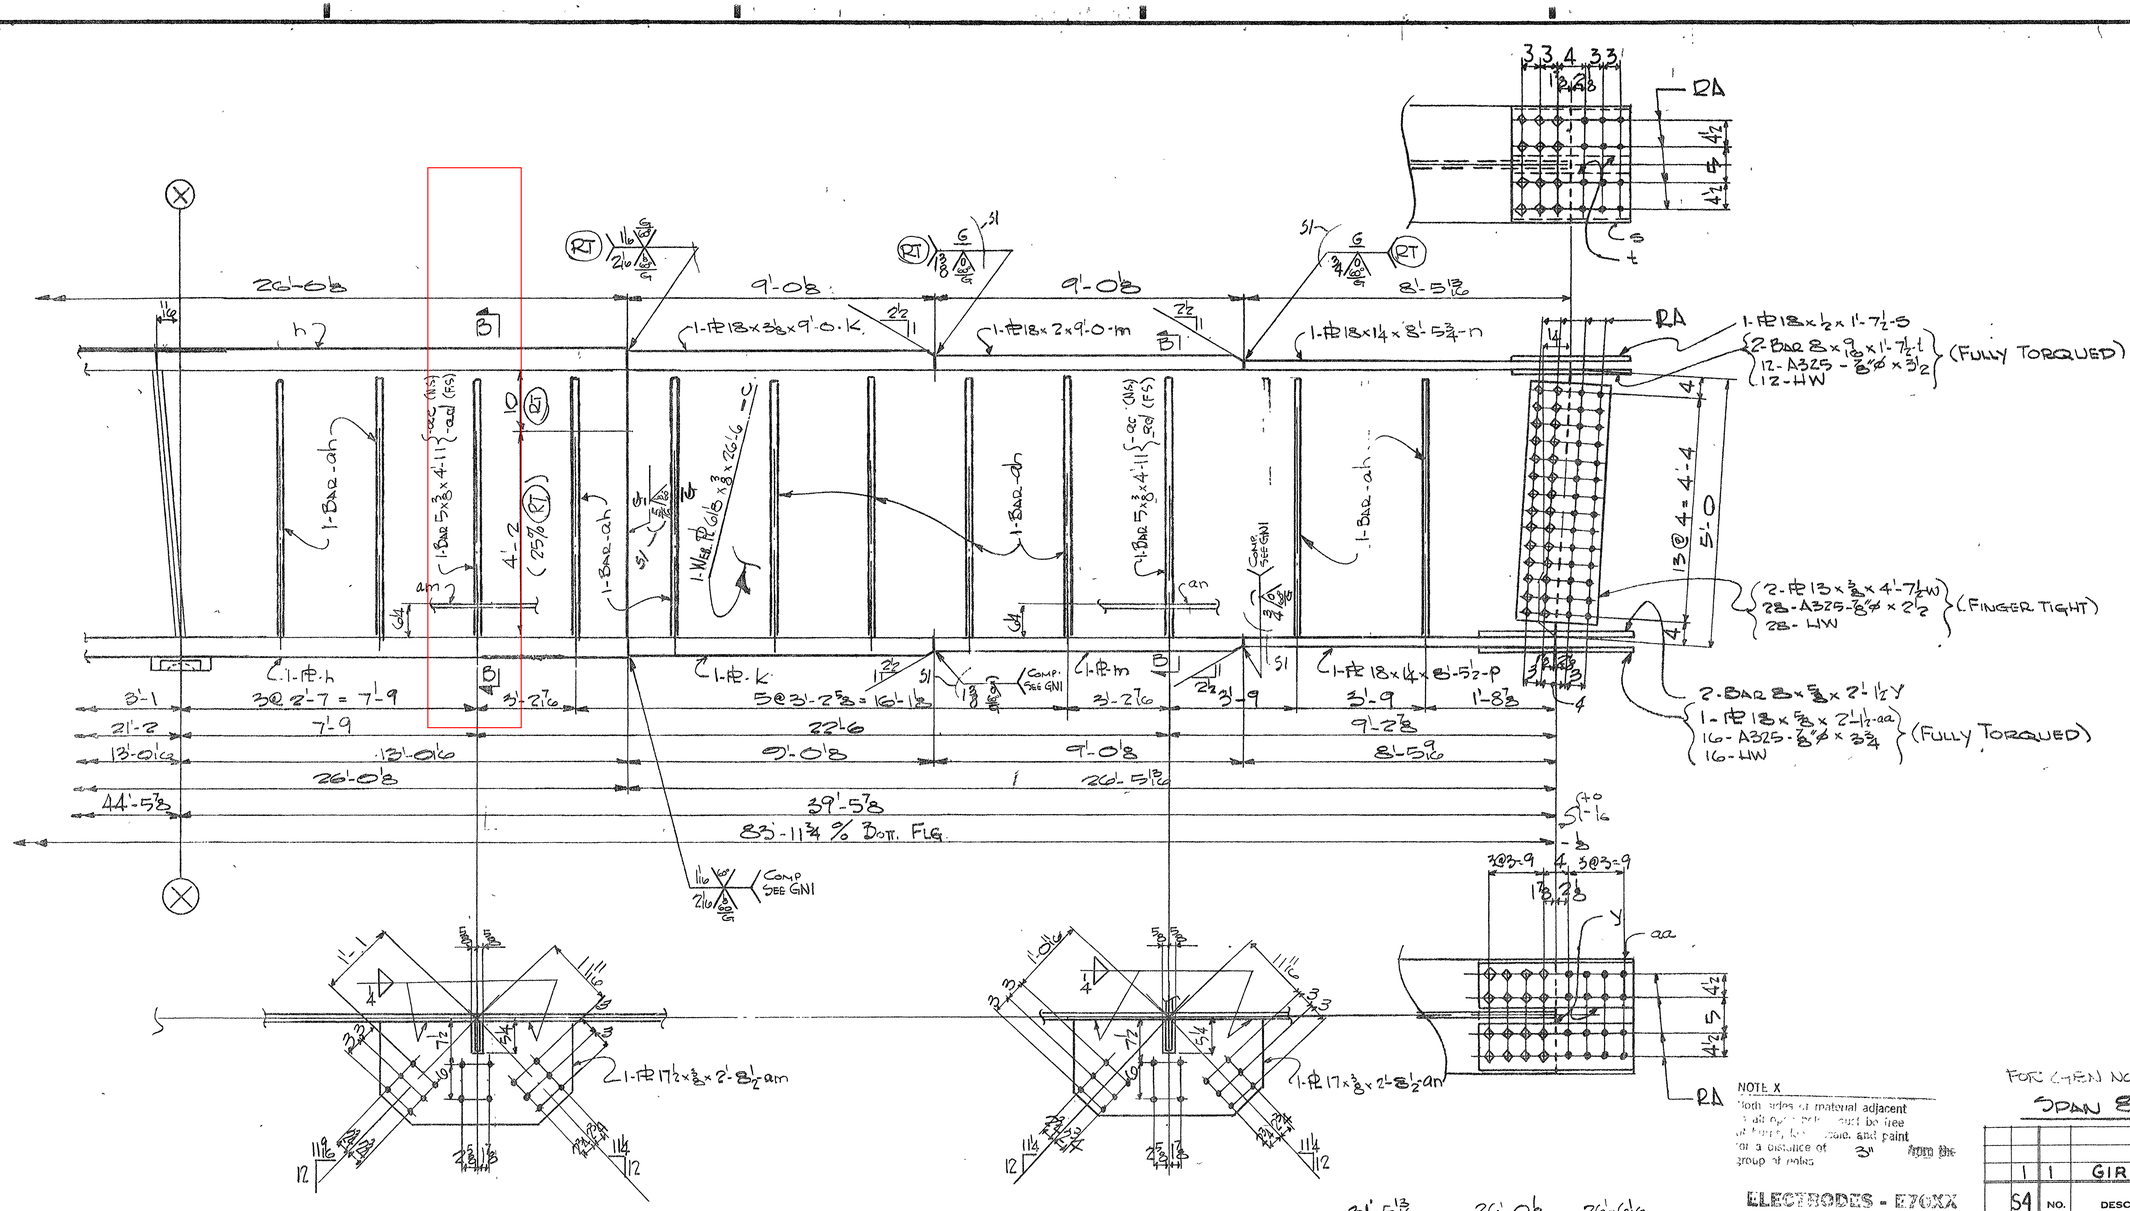

NOTE X
Both sides of material adjacent to all splice plies must be free of burrs, loose scale, and paint for a distance of 3" from the group of holes

ELECTRODES - E70XX LOW HYDROGEN

NOTE: ¾"x¾ CLIP ALL STIFF AS SHOWN

MATERIAL ASTM-A36 U.N.O.
CONNECTOR BOLTS A325
OPEN HOLES 15/16"Ø
A325 FIELD BOLTS
SHOP CONTACT SURFACES N.P.
PAINT WELDING / MILLING } AS NOTED
1 Coat ZRIP 6150 Type II D.N.! See Note "X"

FOR OTHER NOTES SEE GN1

SPAN B - LINE B

INST.	S4	NO.	DESCRIPTION	MARK	REMARKS
		1	1 GIRDER	454A	85'-0
			REQUIRED LIST		

For location of details shown on this sheet refer to diagrams
E401

REVISION	NO	DATE	INIT
	5	9-5	BJ

SUBMITTAL 1 2 3 4 5 6 7 8 9 0
DATE

OWNER TENNESSEE DEPT. OF HIGHWAYS
ARKANSAS STATE HIGHWAY COMMISSION
STRUCTURE EAST APPROACH - MISS. RIVER BRIDGE
PROJ. I-40-1(116)0 - MEMPHIS - TENN.

BETHLEHEM STEEL CORPORATION
FABRICATED STEEL CONSTRUCTION
CHICAGO DRAFTING ROOM 1 LEETSDALE WORKS
MADE BY E.DEL DATE 2-19-71 IN CHARGE FJK
CHECKED BY Mab DATE 3-3-71 SHOP NO.
CONTRACT CEG472-000 DRAWING NO. 454 BB

35663 (1-67)

MICROFILMED

111-98-80 (5)

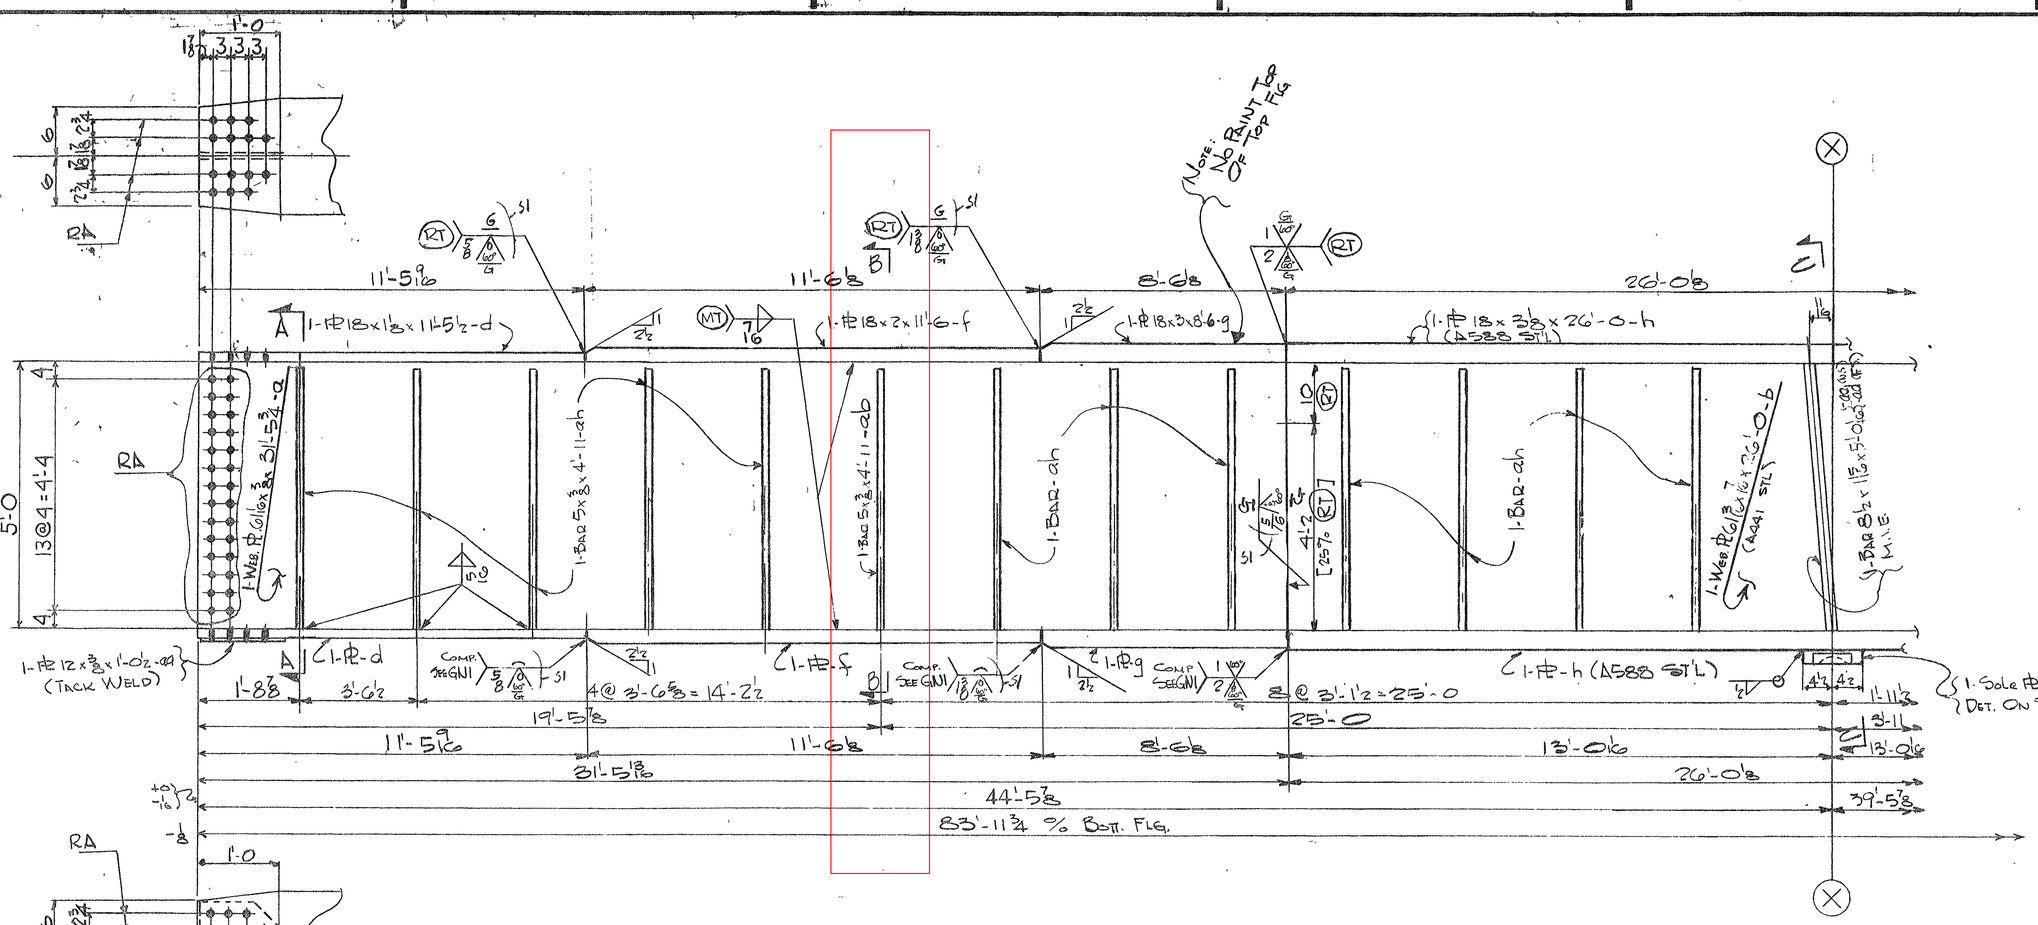

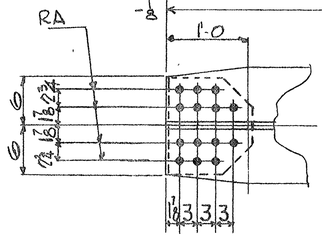

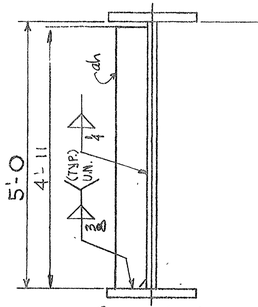

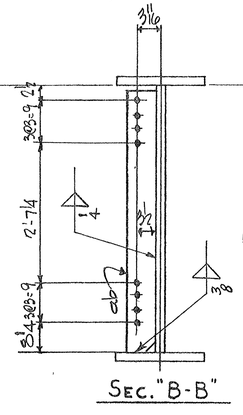

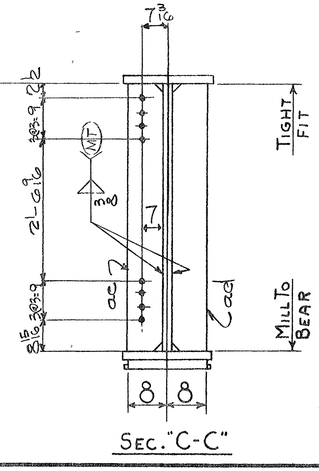

GIRDER - 455A

SPAN 8 - LINE A

For location of details shown on this sheet refer to diagrams

E401

MATERIAL	SEE SHT. #455BB
RIVETS OR BOLTS	
OPEN HOLES	
A325 FIELD BOLTS	
SHOP CONTACT SURFACES	
PAINT	

SUBMITTAL DATE: 1 2 3 4 5 6 7 8 9 0

REVISION: NO | DATE | INIT — 51 | 2-25 | JF

CUSTOMER: TENNESSEE DEPT. OF HIGHWAYS.
ARKANSAS STATE HIGHWAY COMMISSION
STRUCTURE: EAST APPROACH - MISS. RIVER BRIDGE
PROJ. I-40-1(116)0 - MEMPHIS - TENN.

BETHLEHEM STEEL CORPORATION
FABRICATED STEEL CONSTRUCTION
CHICAGO DRAFTING ROOM — LEETSDALE WORKS
MADE BY E. DEL DATE 7-19-71 IN CHARGE FJK
CHECKED BY Hab DATE 3-3-71 SHOP NO
CONTRACT CEG472-000 DRAWING NO 455 AB

36663 11-65

54

11-48-81

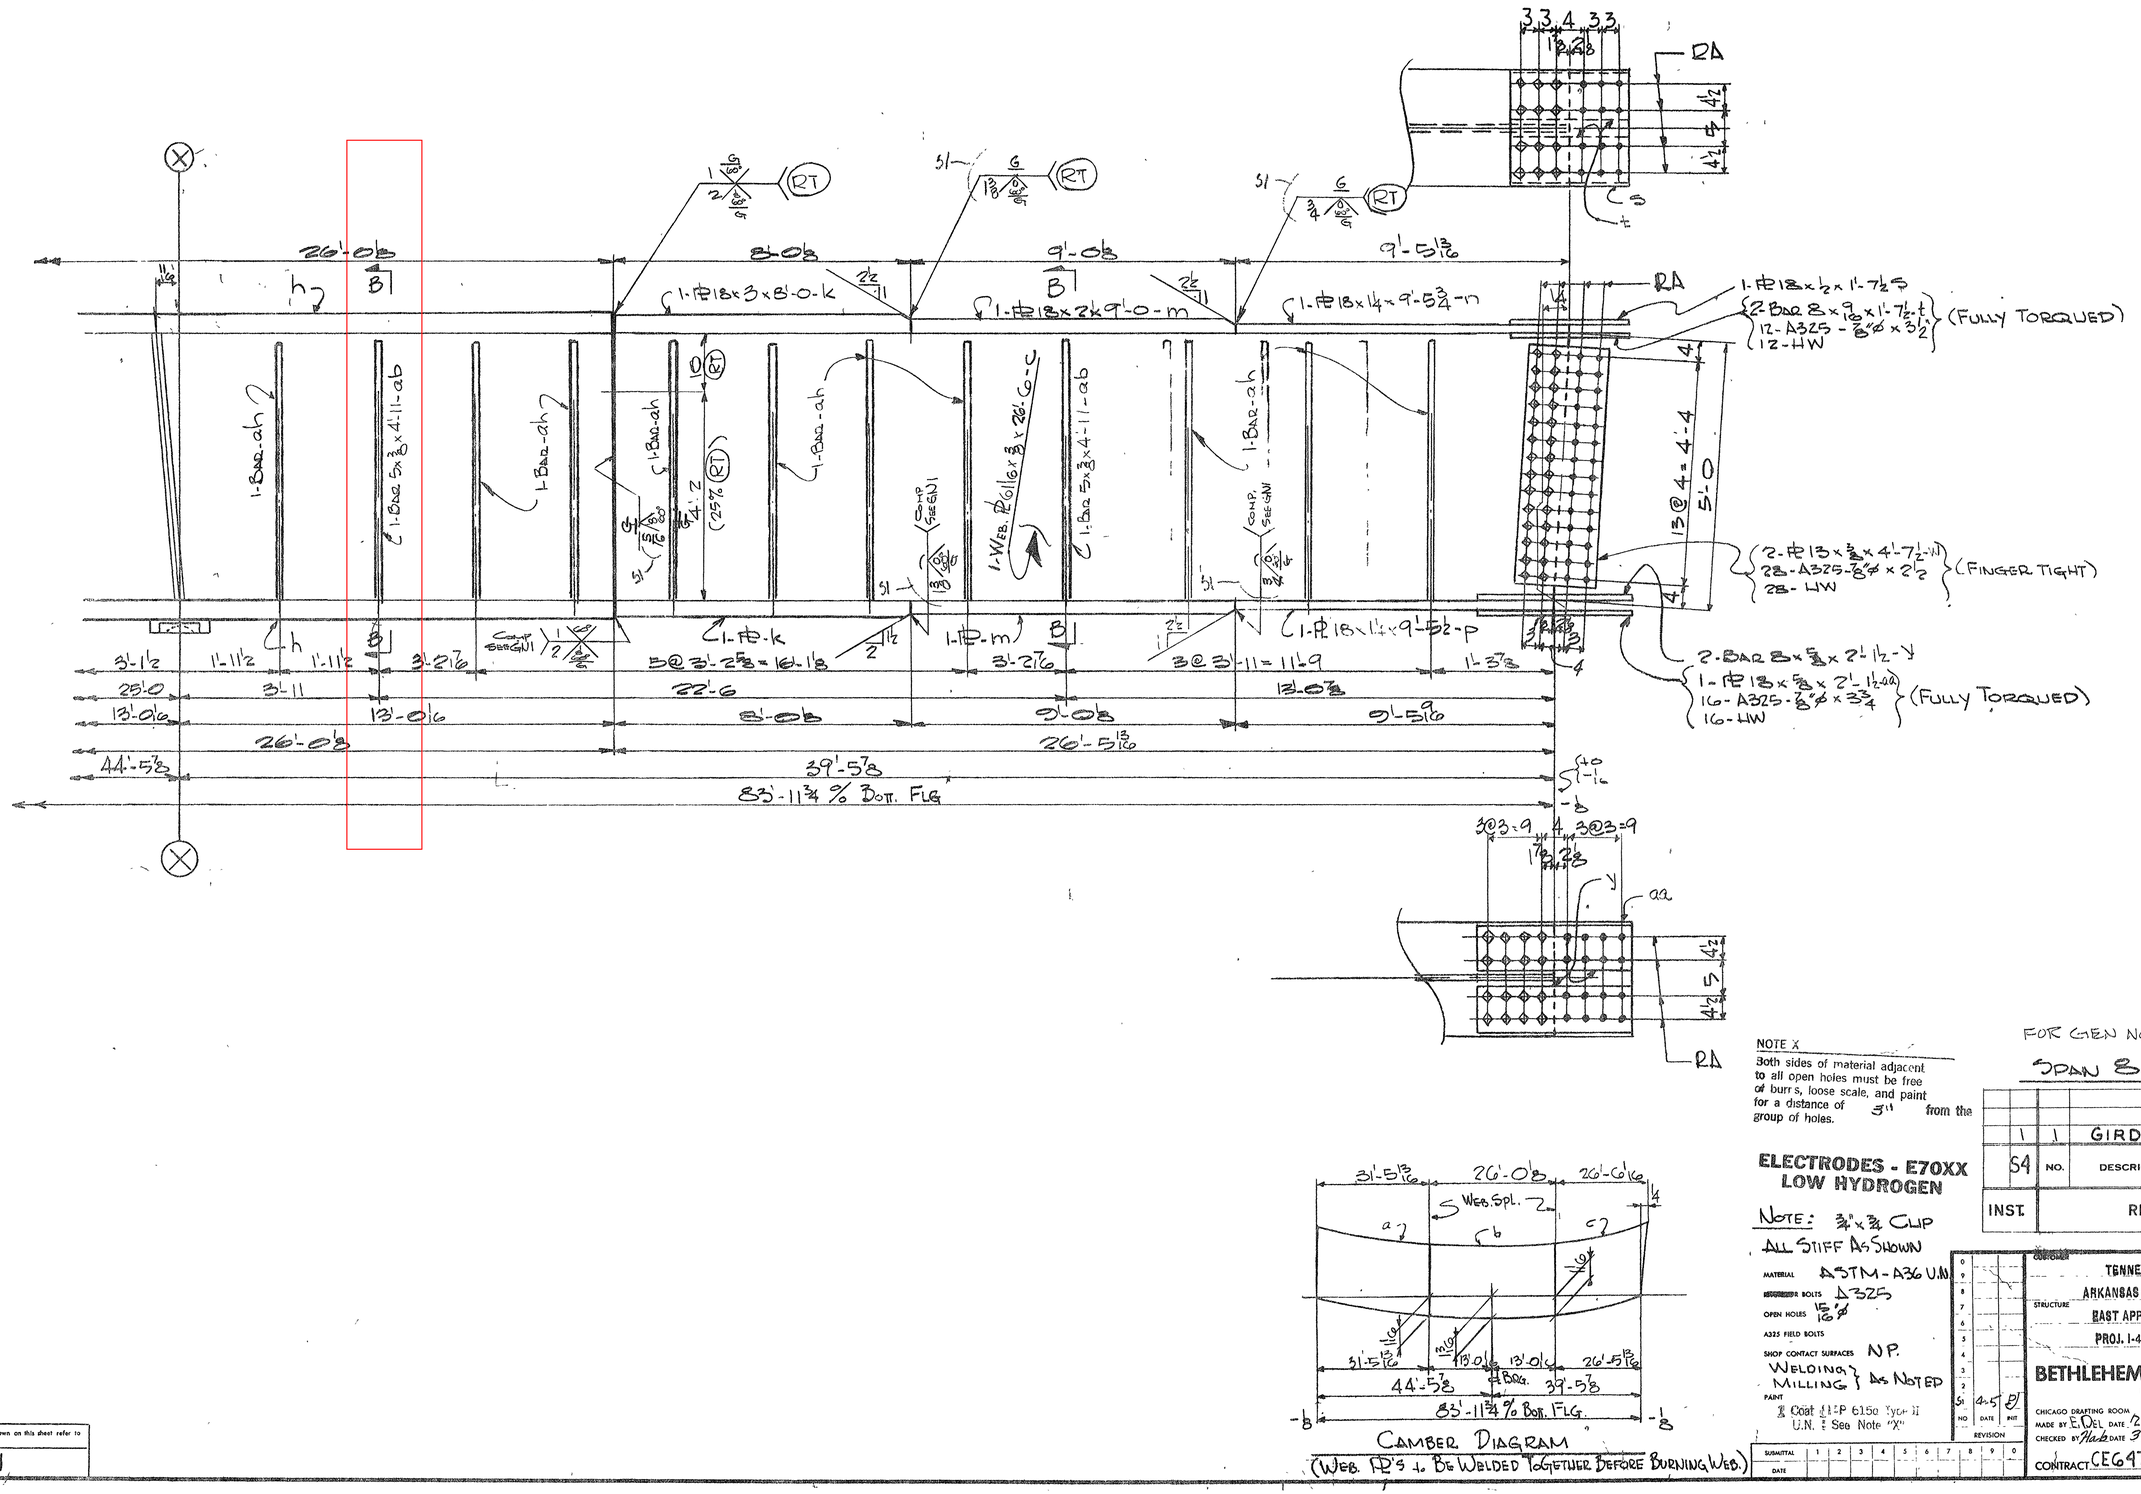

NOTE X
Both sides of material adjacent to all open holes must be free of burrs, loose scale, and paint for a distance of 5" from the group of holes.

ELECTRODES - E70XX LOW HYDROGEN

NOTE: ¾" x ⅜ CLIP ALL STIFF AS SHOWN

MATERIAL ASTM - A36 U.N.
HIGH STRENGTH BOLTS A325
OPEN HOLES 15/16 ø
A325 FIELD BOLTS
SHOP CONTACT SURFACES N.P.
PAINT WELDING } As Noted MILLING }
Coat with P 6150 Type II U.N. ‡ See Note "X"

FOR GEN NOTES SEE GN1

SPAN B - LINE A

INST.	NO.	DESCRIPTION	MARK	REMARKS
	1	1 GIRDER	455A	85'.
	54	REQUIRED LIST		

CUSTOMER: TENNESSEE DEPT. OF HIGHWAYS
ARKANSAS STATE HIGHWAY COMMISSION
STRUCTURE: EAST APPROACH - MISS. RIVER BRIDGE
PROJ. I-40-1(116)0 - MEMPHIS - TENN.

BETHLEHEM STEEL CORPORATION
FABRICATED STEEL CONSTRUCTION
LEETSDALE WORKS

REVISION NO	DATE	INIT
5	4-5	EJ

CHICAGO DRAFTING ROOM
MADE BY E.O'Del DATE 2-19-71 IN CHARGE F.J.K.
CHECKED BY Hab DATE 3-3-71 SHOP NO
CONTRACT CEG472-000 DRAWING NO 455BB

SUBMITTAL 1 2 3 4 5 6 7 8 9 0
DATE

For location of details shown on this sheet refer to diagrams
E401

MICROFILMED

20663 11 69

11-48-82

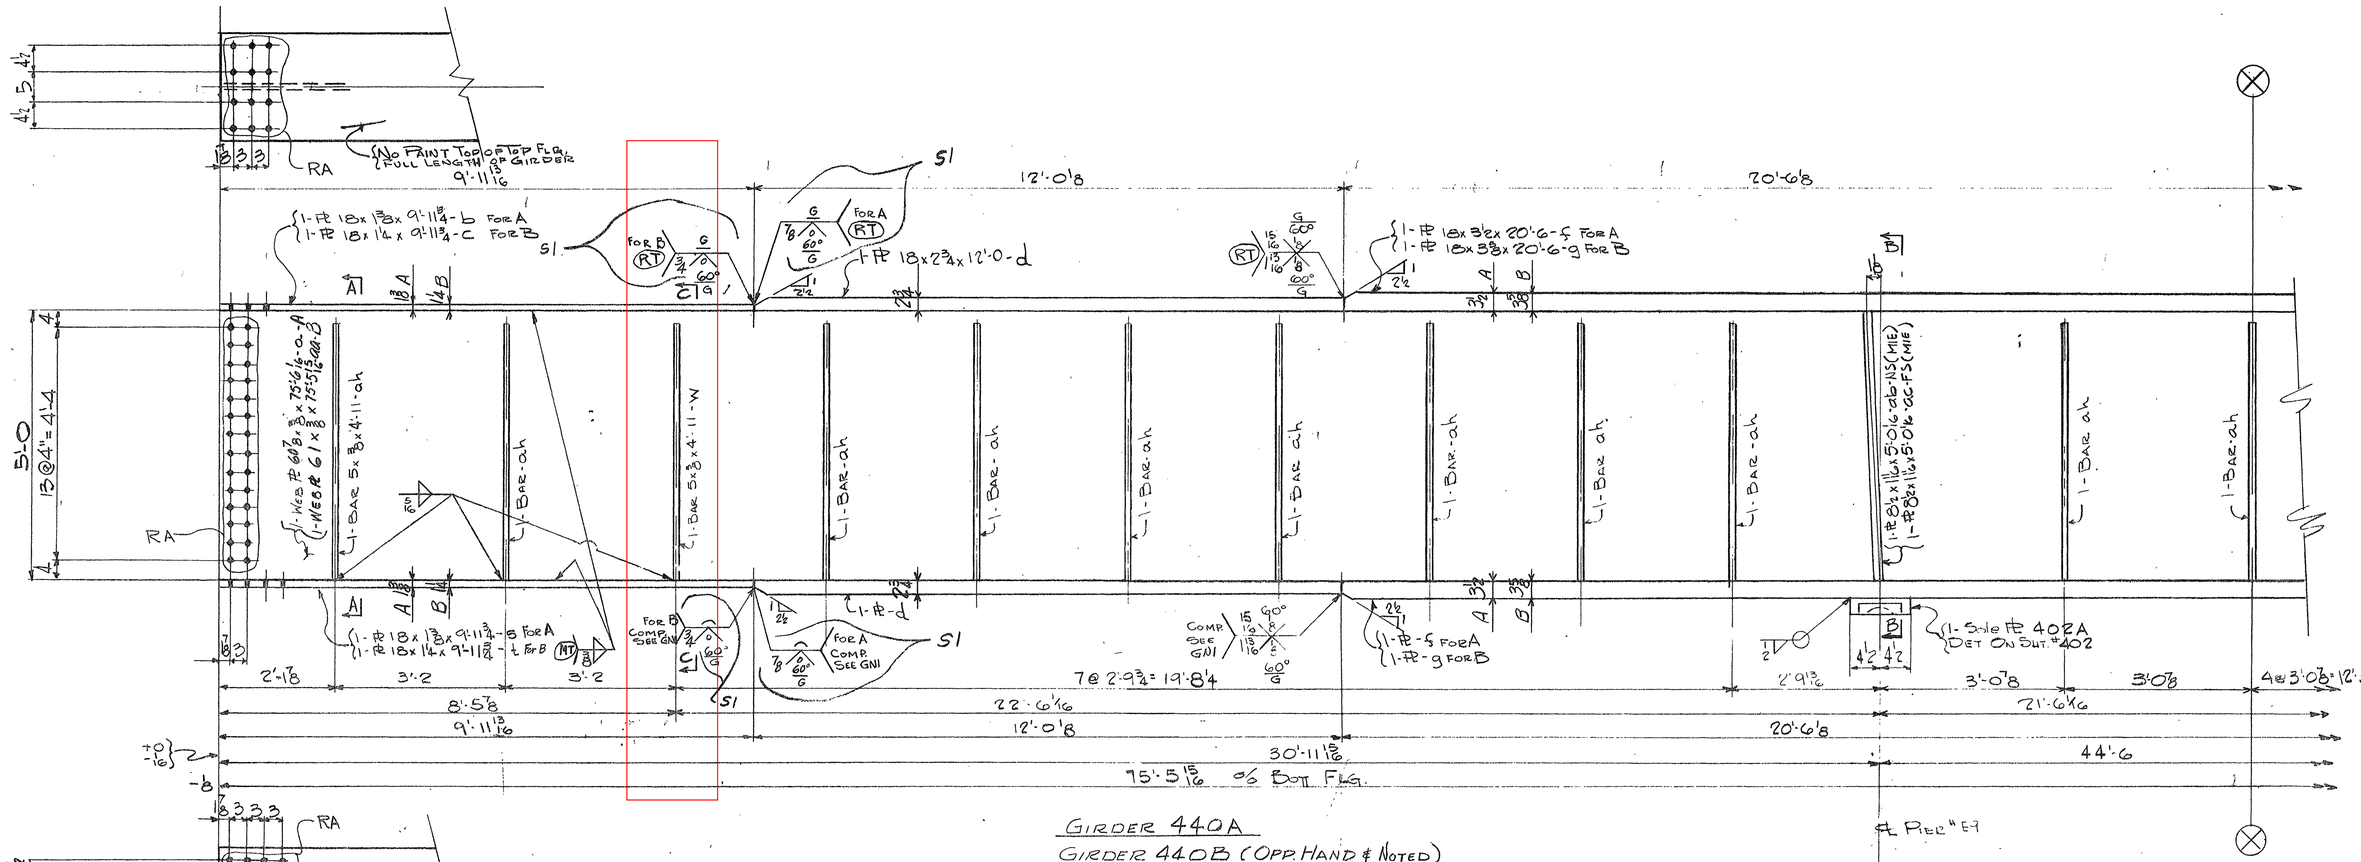

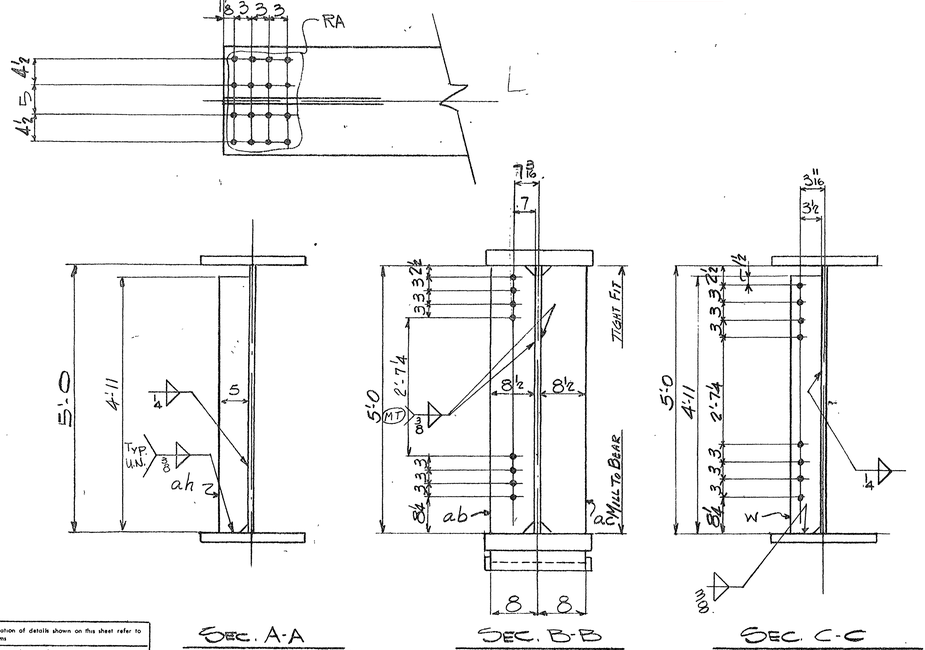

For location of details shown on this sheet refer to diagrams

E401

MATERIAL	See Sht 440BB
RIVETS OR BOLTS	
OPEN HOLES	
A325 FIELD BOLTS	
SHOP CONTACT SURFACES	
PAINT	

NO	DATE	INIT.	REVISION
5	4-6-71	Hab	

SUBMITTAL DATE 1 2 3 4 5 6 7 8 9 0

PIER # 9 LINE A & F

CUSTOMER TENNESSEE DEPT. OF HIGHWAYS
ARKANSAS STATE HIGHWAY COMMISSION

STRUCTURE EAST APPROACH - MISS. RIVER BRIDGE
PROJ. I-40-1(116)0 - MEMPHIS - TENN.

BETHLEHEM STEEL CORPORATION
FABRICATED STEEL CONSTRUCTION

CHICAGO DRAFTING ROOM LEETSDALE WORKS
MADE BY JHM DATE 2-4-71 IN CHARGE F.J.K.
CHECKED BY Hab DATE 2-22-71 SHOP NO

CONTRACT CE6477:006 DRAWING NO 440 AB

M-48-51

MICROFILMED

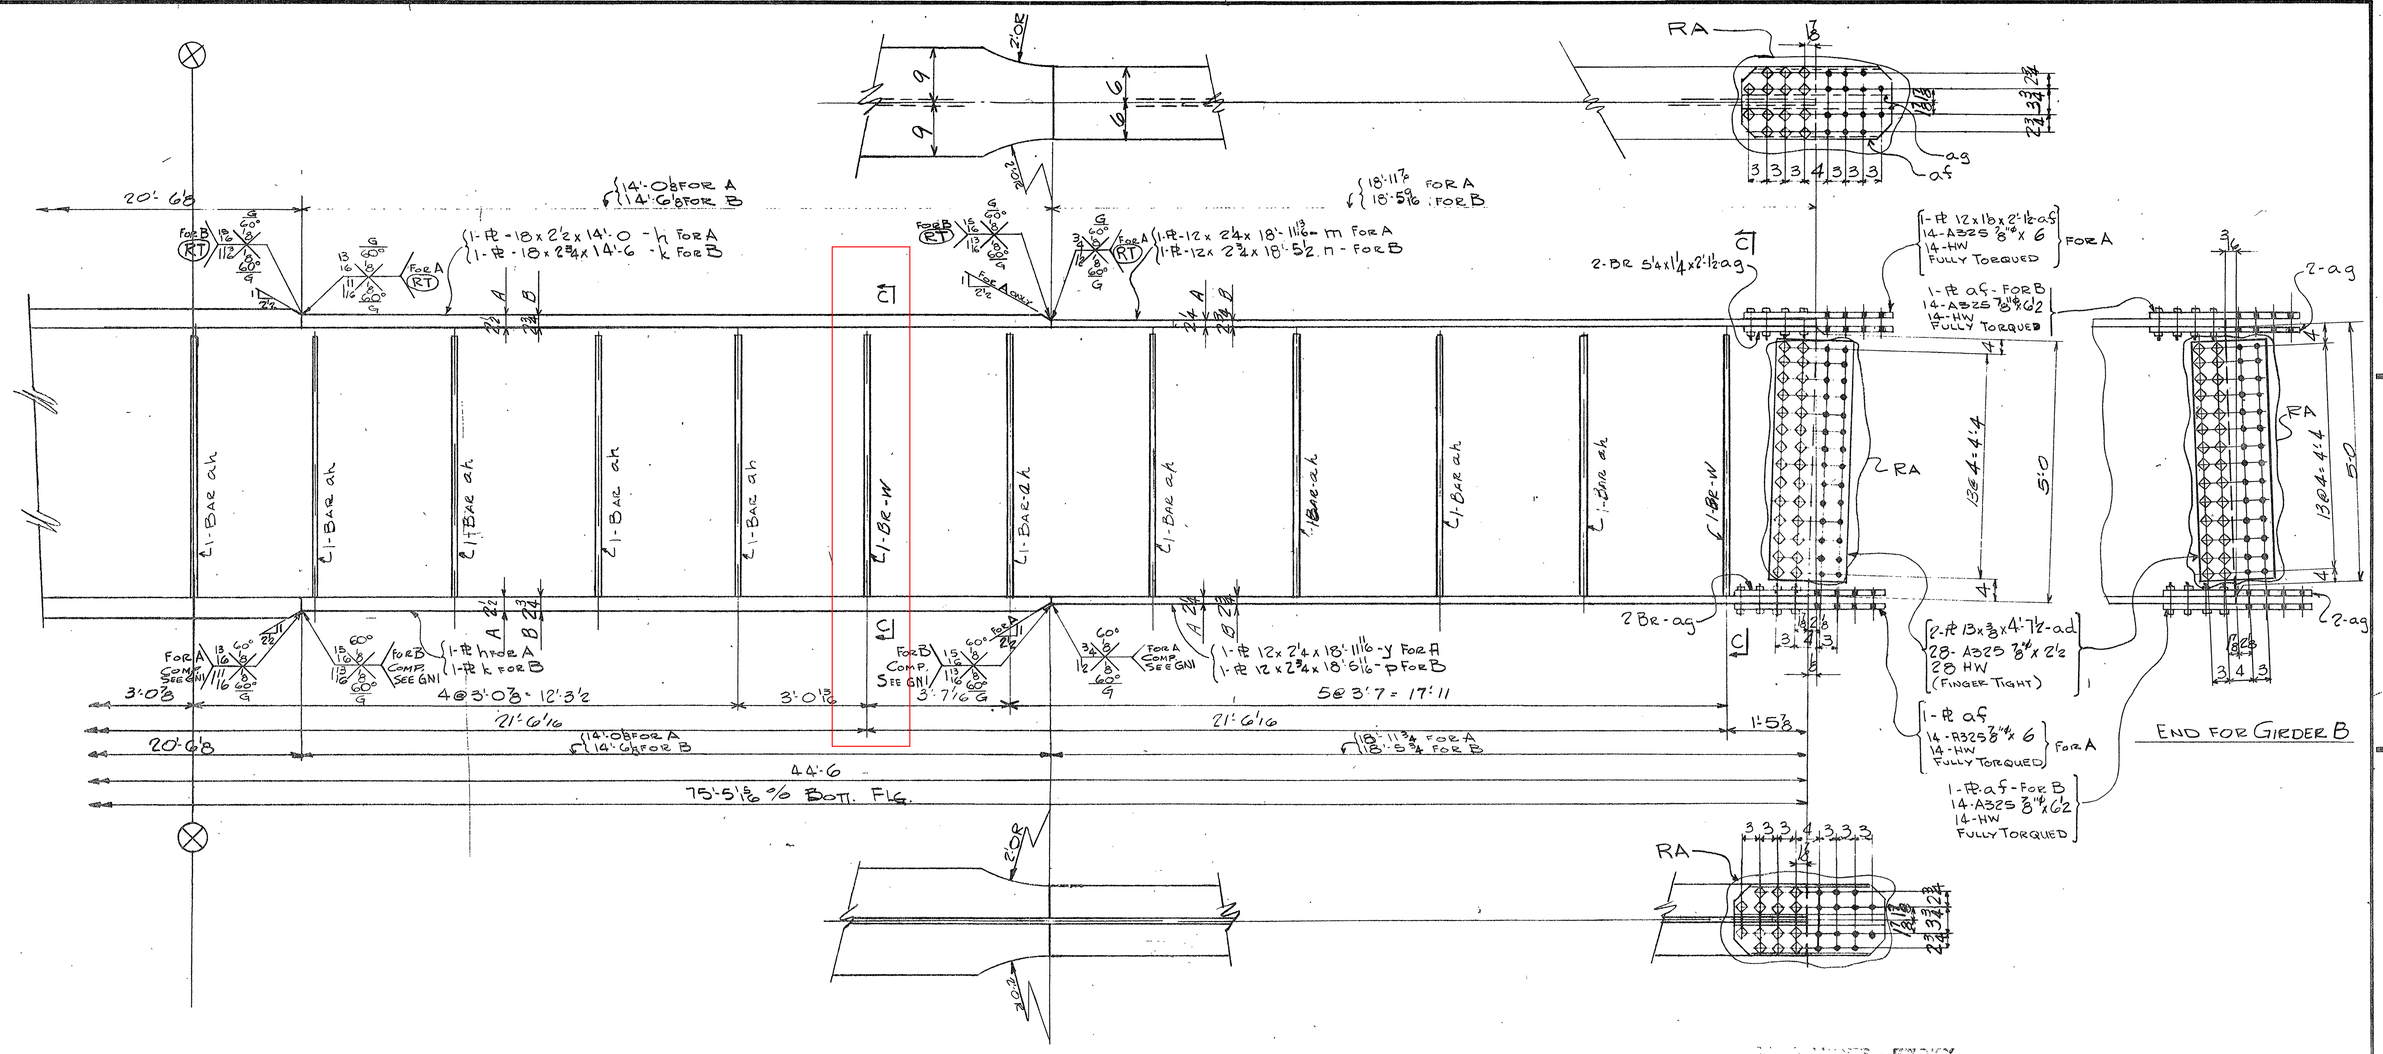

NOTE X

Both sides of material adjacent to all open holes must be free of burrs, loose scale, and paint for a distance of 3" from the edges of holes.

NOTE: 3"x¾"x¾" CLIP ALL STIFF AS SHOWN

FOR GEN NOTES SEE GN1

	1	1	GIRDER	440B	
	1	1	GIRDER	440A	
INST.	83	NO.	DESCRIPTION	MARK	REMARKS
			REQUIRED LIST		

MATERIAL - A.S.T.M. A-36
BOLTS ⅞" A-325
OPEN HOLES 15/16"
A325 FIELD BOLTS —
SHOP CONTACT SURFACES - N.P
WELDING: AS NOTED
MILLING: AS NOTED
PAINT 1 Coat TT-P 615d Type II U.N! See Note 8&9

CUSTOMER: TENNESSEE DEPT. OF HIGHWAYS
ARKANSAS STATE HIGHWAY COMMISSION
STRUCTURE: EAST APPROACH - MISS. RIVER BRIDGE
PROJ. I-40-1(11C)0 - MEMPHIS - TENN.

BETHLEHEM STEEL CORPORATION
FABRICATED STEEL CONSTRUCTION

CHICAGO DRAFTING ROOM LEETSDALE WORKS
MADE BY J.K.M. DATE 8-8-71 IN CHARGE F.J.K.
CHECKED BY Hal DATE 2-22-71 SHOP NO.
CONTRACT CE6472:000 DRAWING NO. 440BB

REVISION: NO. | DATE | INIT

SUBMITTAL DATE: 1 2 3 4 5 6 7 8 9 0

For location of details shown on this sheet refer to diagrams: E4.01

36663 11-69

11-48-52

RA

No Paint Top of Top Flg. Full Length of Girder

9'-11 13/16

12'-0 1/8

20'-6 1/8

1-PL 18 x 1 1/2 x 9'-11 3/4 - b

1-PL 18 x 3 x 12'-0 - c

1-PL 18 x 3 3/4 x 20'-6 - d

1-PL 18 x 1 1/2 x 9'-11 3/4 - h

1-PL 17 1/8 x 3/8 x 2'-8 1/2 - t

1-PL 18 1/2 x 3/8 x 2'-9 - w

1-Stiffener PL 402A Det on Sht #402

1-Web PL 5/16 x 3/8 x 75'-6 - a

1-Bar 5 x 3/8 x 4'-11 - ah

1-Bar 5 x 3/8 x 4'-11 - m-ns

1-Bar 5 x 3/8 x 4'-11 - n-fs

1-PL 8 1/2 x 11/16 x 5'-0 1/16 P-NS (MIE)

1-PL 8 1/2 x 11/16 x 5'-0 1/16 P-FS (MIE)

13 @ 4" = 4'-4

5'-0

Comp. See GN1

7 @ 2'-9 3/4 = 19'-8 1/4

2'-11 5/8

3'-2

3'-2

8'-5 15/16

9'-11 13/16

22'-6 1/16

12'-0 1/8

31'-0

75'-6 9/16 Bott. Flg.

3'-0 3/8

3'-0 3/8

4 @ 3'-0 3/8 = 12'-3 1/2

21'-6 1/16

20'-6 1/8

44'-6

+0 -1/16

-1/8

Girder 441A

RA

R-t

R-w

4 Pier "E"

Sec. A-A (Typ. Inter Stiff)

Sec. B-B

Sec. C-C

Pier # 9 Line E

Material	See Sht. 441BB
Rivets or Bolts	
Open Holes	
A325 Field Bolts	
Shop Contact Surfaces	
Paint	

S 4-67 Hab — NO. DATE INIT — Revision

Submittal 1 2 3 4 5 6 7 8 9 0

Date

CUSTOMER [illegible] of Highways, Arkansas [illegible] Commission

STRUCTURE East A[illegible] [illegible]ven Bridge

Proj. [illegible] Memphis - Tenn.

BETHLEHEM STEEL CORPORATION

FABRICATED STEEL CONSTRUCTION

Chicago Drafting Room Leetsdale Works

Made by J.K.M. Date 2-9-71 In Charge F.J.L.

Checked by Hab Date 2-23-71 Shop No.

Contract CE6477-000 Drawing No. 441AB

For location of details shown on this sheet refer to diagrams E401

Microfilmed

M-48-53

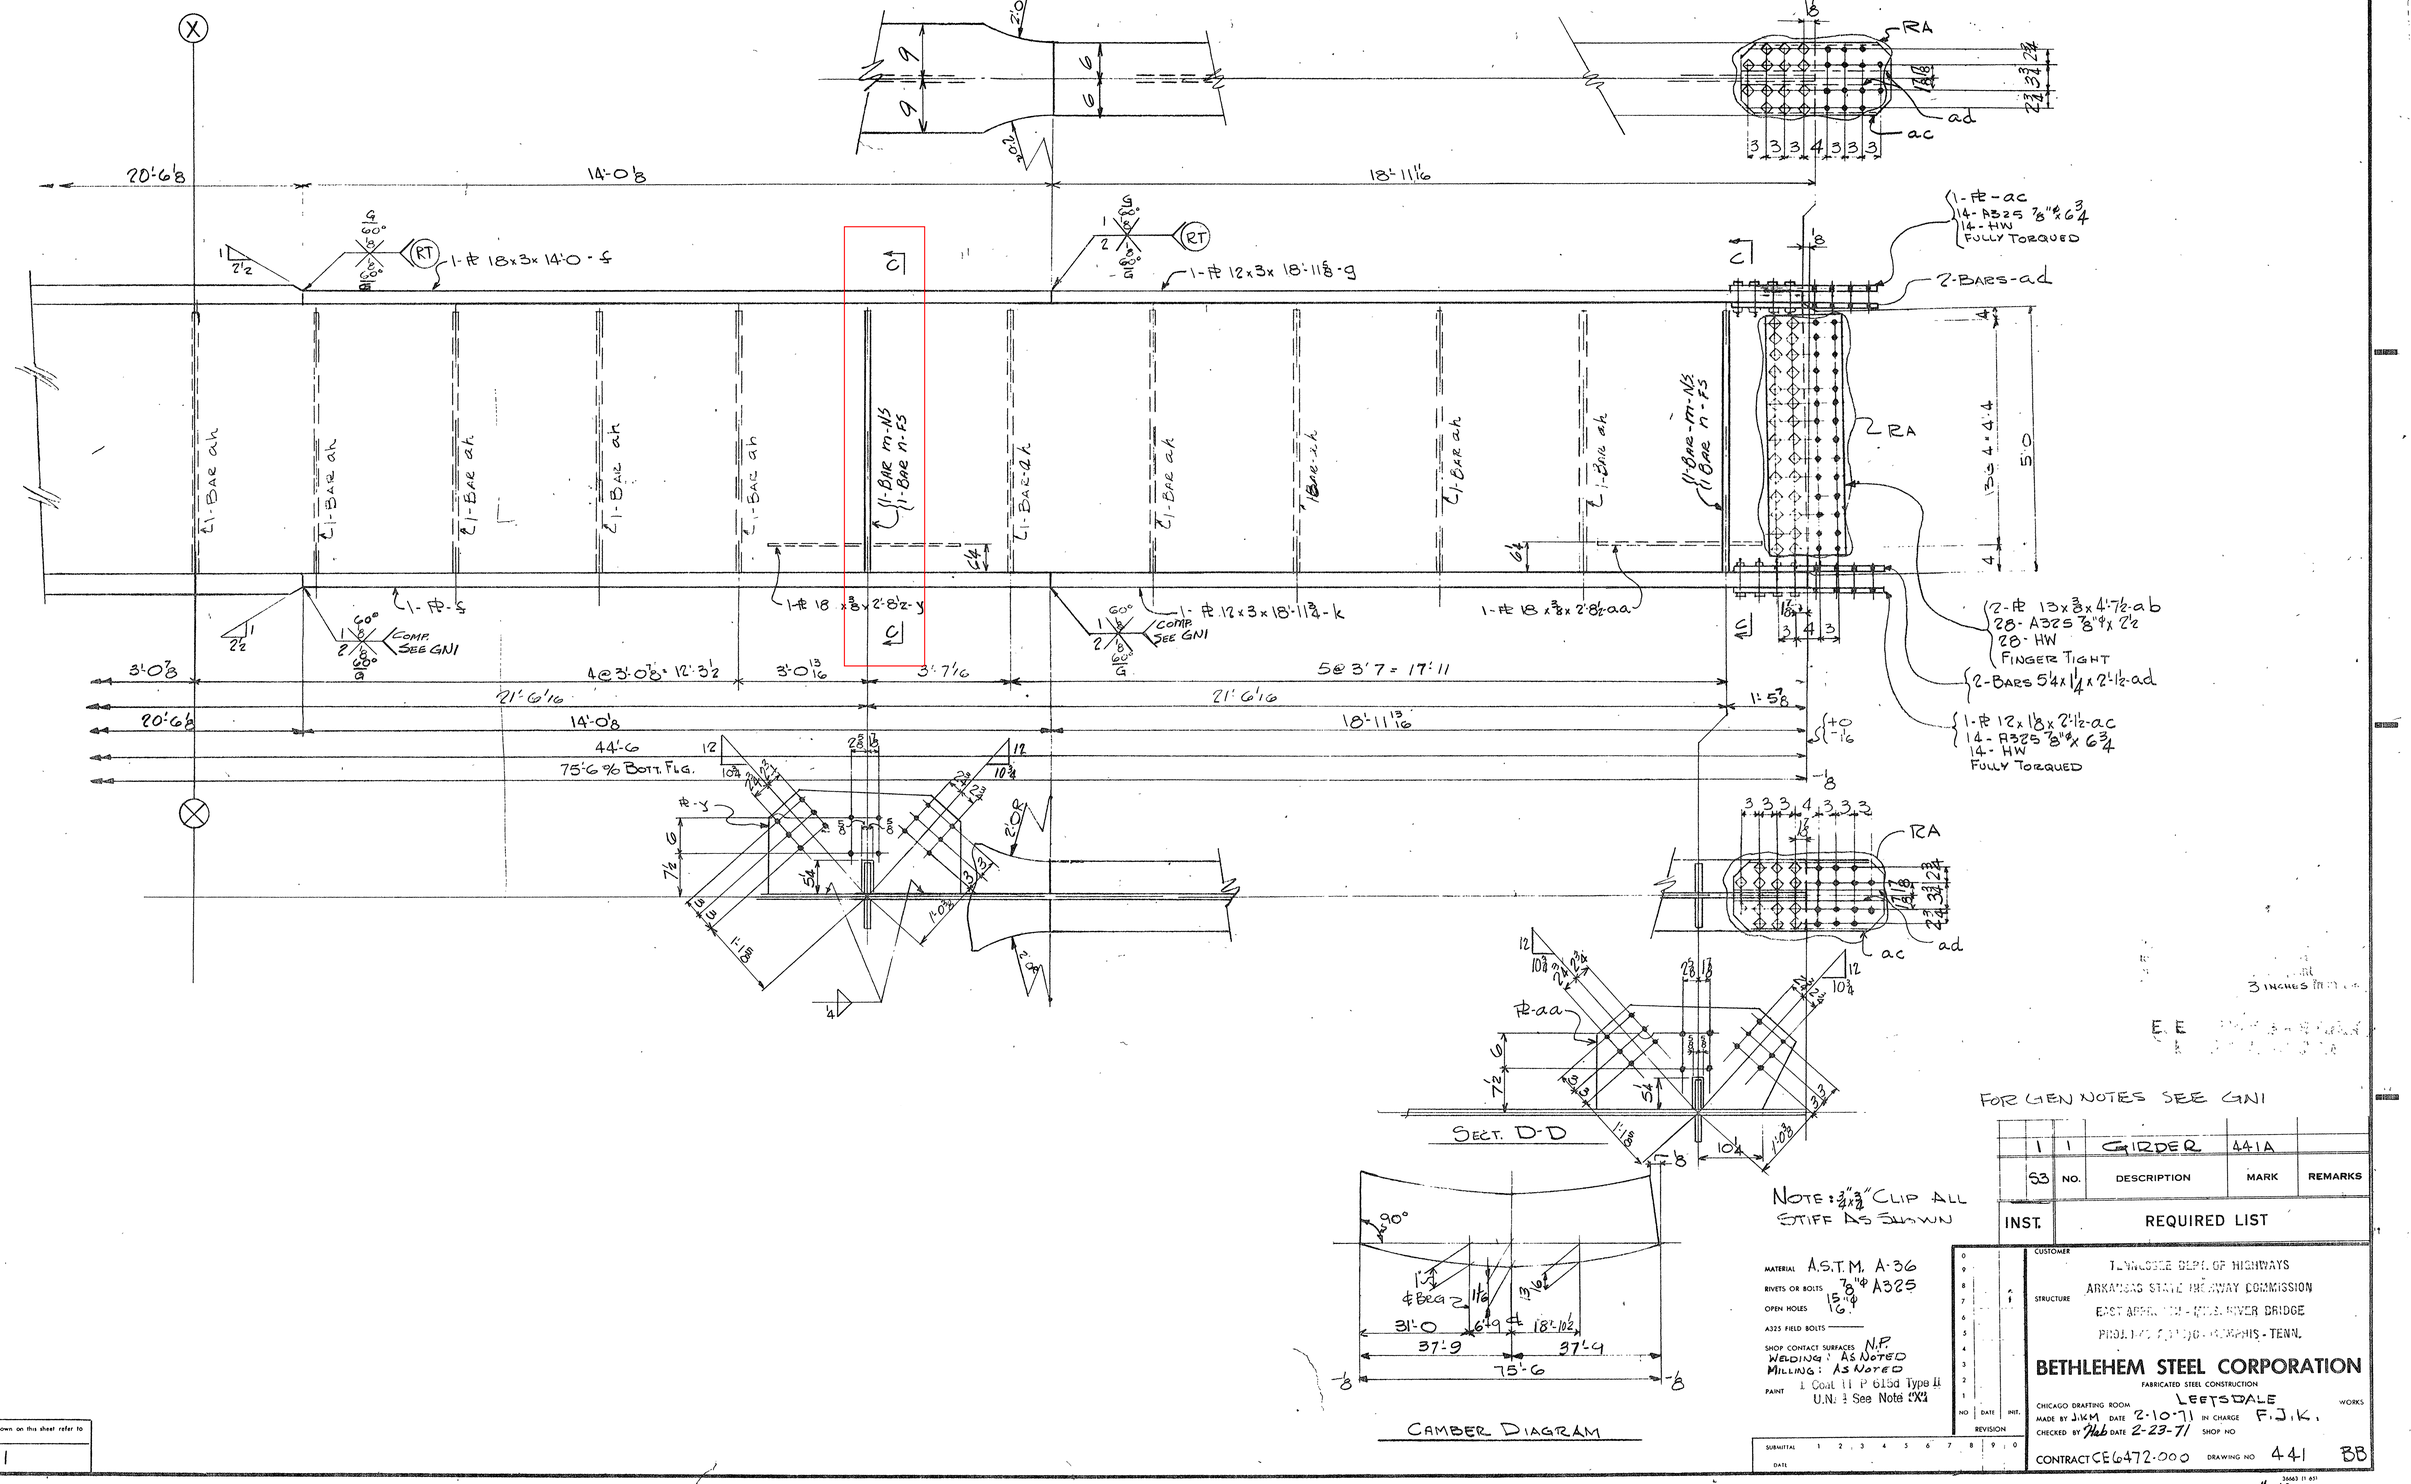

For GEN NOTES SEE GN1

	1	1	GIRDER	441A	
	53	NO.	DESCRIPTION	MARK	REMARKS
INST.			REQUIRED LIST		

NOTE: ¾"x¾" CLIP ALL STIFF AS SHOWN

MATERIAL A.S.T.M. A-36
RIVETS OR BOLTS ⅞" ϕ A325
OPEN HOLES 15/16"
A325 FIELD BOLTS
SHOP CONTACT SURFACES N.P.
WELDING: AS NOTED
MILLING: AS NOTED
PAINT 1 Coat II P 615d Type II U.N. 1 See Note 2(a)

CUSTOMER
TENNESSEE DEPT. OF HIGHWAYS
ARKANSAS STATE HIGHWAY COMMISSION
STRUCTURE EAST APPR. MISS. RIVER BRIDGE
PROJECT I-240(10)-MEMPHIS-TENN.

BETHLEHEM STEEL CORPORATION
FABRICATED STEEL CONSTRUCTION
CHICAGO DRAFTING ROOM LEETSDALE WORKS
MADE BY J.K.M. DATE 2-10-71 IN CHARGE F.J.K.
CHECKED BY Hab DATE 2-23-71 SHOP NO
CONTRACT CE6472-000 DRAWING NO 441 BB

NO	DATE	INIT.	REVISION

SUBMITTAL 1 2 3 4 5 6 7 8 9 0
DATE

For location of details shown on this sheet refer to diagrams
E401

MICROFILMED

11-98-54

NO PAINT TOP OF TOP FLG.











1-BAR - ah

1-BAR - ah

1-BAR - ah

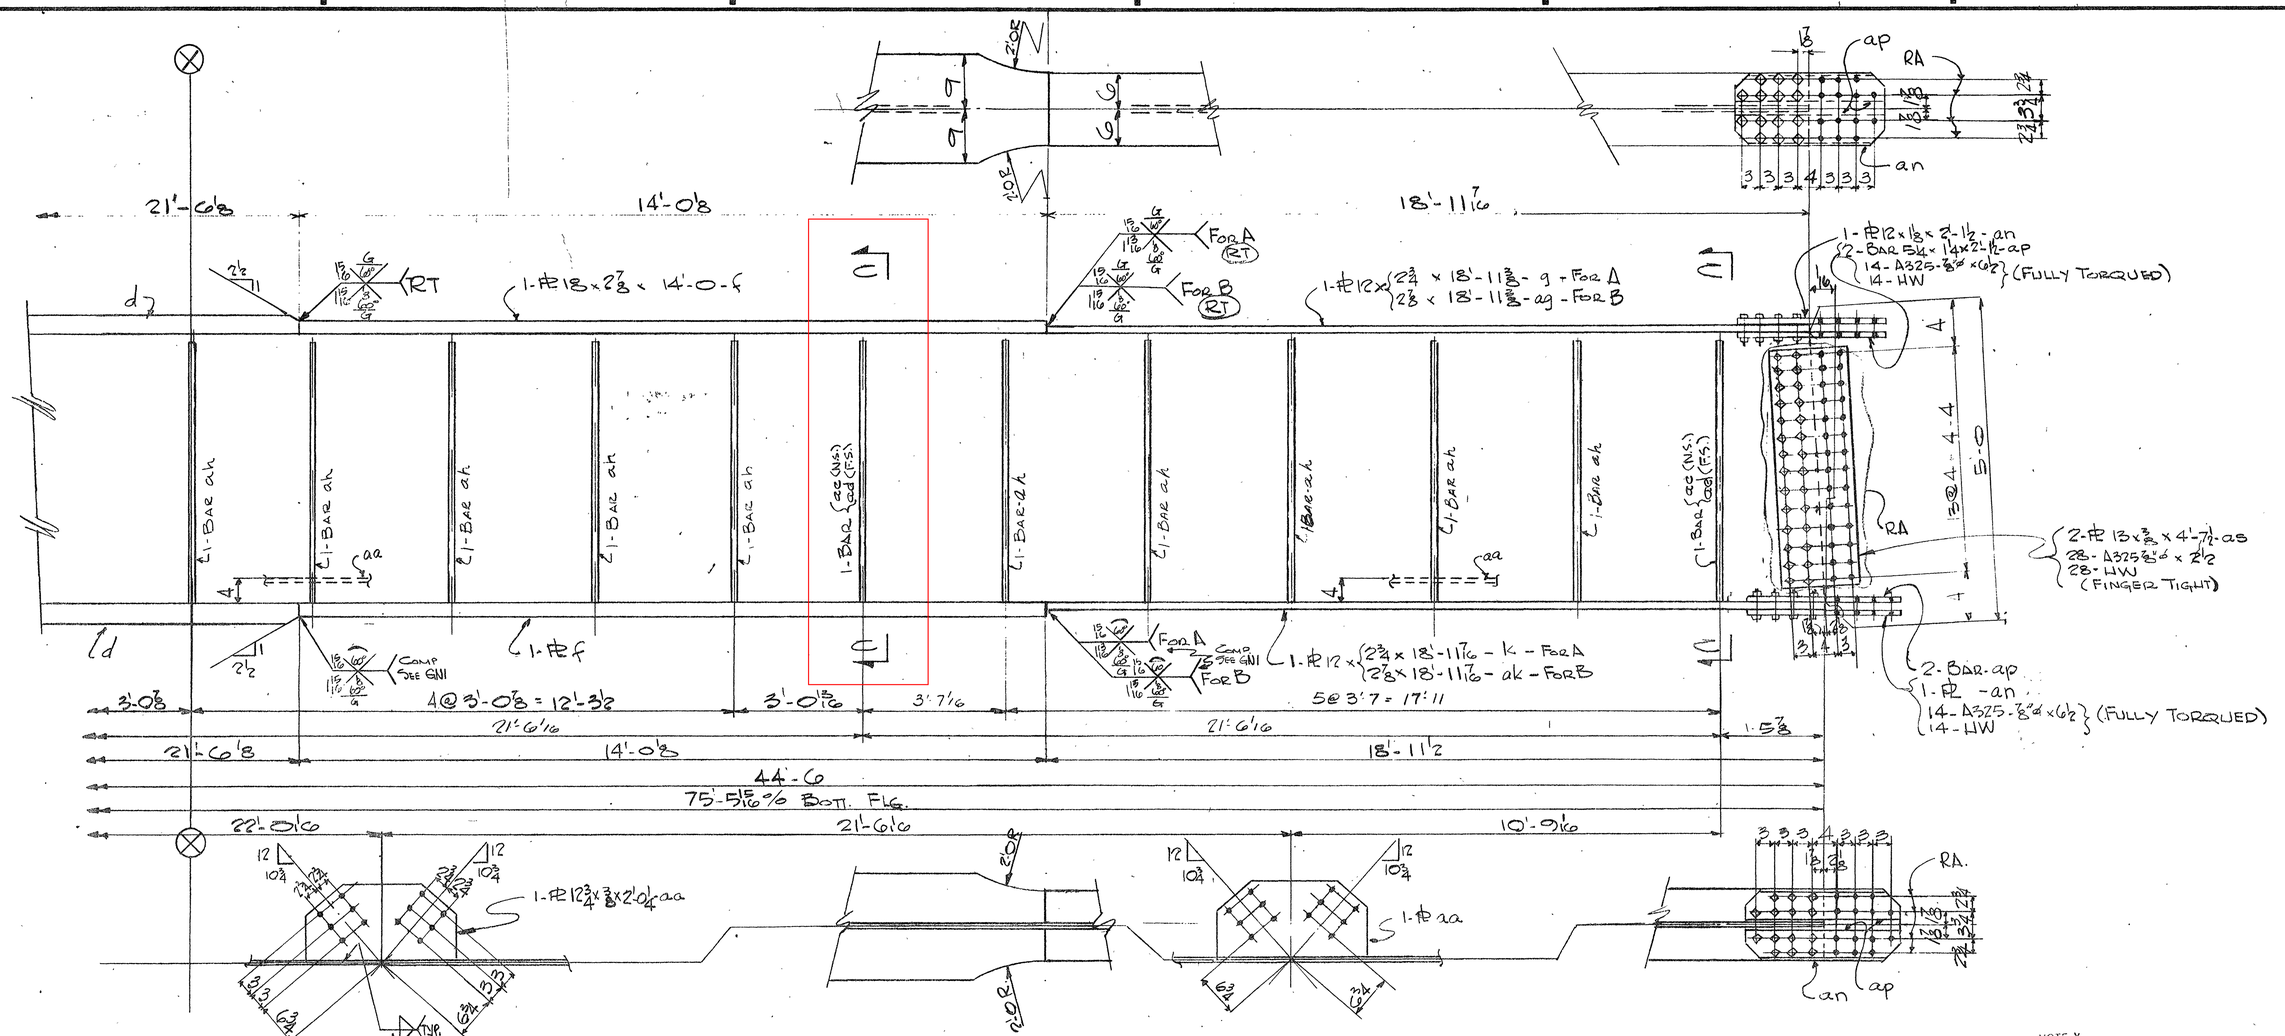

NOTE X
Both sides of material adjacent to all open holes must be free of burrs, loose scale, and paint for a distance of 3" from the group of holes

FOR GEN NOTES SEE GN1

ELECTRODES - E70XX LOW HYDROGEN

NOTE: ¾ x ¾" CLIP ALL STIFF AS SHOWN

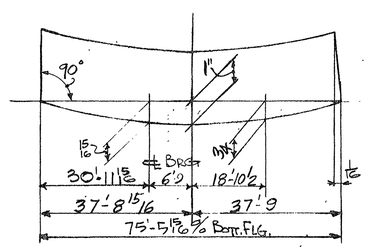

CAMBER DIAGRAM

	NO.	DESCRIPTION	MARK	REMARKS
1	1	GIRDER	442B	5'-6 x 2'-6 x 7/8
1	1	GIRDER	442A	Do
BB				
INST.		REQUIRED LIST		

MATERIAL	ASTM - A36
RIVETS OR BOLTS	⅞" ø A325
OPEN HOLES	15/16" ø
A325 FIELD BOLTS	
SHOP CONTACT SURFACES WELDING	N.P.
SHOP CONTACT SURFACES MILLING	AS NOTED
PAINT	1 Coat ZI-P 6010 Type I (1.0 to 1.5 mils)

CUSTOMER: TENNESSEE DEPT. OF HIGHWAYS
ARKANSAS STATE HIGHWAY COMMISSION
STRUCTURE: EAST APPROACH - MISS. RIVER BRIDGE
PROJ. I-40-1(116)0 - MEMPHIS - TENN.

BETHLEHEM STEEL CORPORATION
FABRICATED STEEL CONSTRUCTION

CHICAGO DRAFTING ROOM — LEESTOWN 2 WORKS
MADE BY C.DEL DATE 2-9-71 — IN CHARGE F.J.K.
CHECKED BY DATE 2-24-71 — SHOP NO.
CONTRACT CE 6472-000 — DRAWING NO. 442 BB

REVISION: NO | DATE | INIT

SUBMITTAL DATE: 1 2 3 4 5 6 7 8 9 0

For location of details shown on this sheet refer to diagrams.
E401

MICROFILMED

M-48-56 Master

36663 (1-65)

RA

No Paint Top of Top Flg Full Length of Girder

8'-11 13/16

12'-0 1/8

21'-6 1/8

1-PL 18 x 1 1/2 x 8'-11 3/4 - b

1-PL 18 x 2 3/8 x 12'-0 - c

1-PL 18 x 3 3/4 x 21'-6 - d

1-Web PL 61 x 3/8 x 75'-6 - a

1-Bar 5 x 3/8 x 4'-11 - ah

1-PL 18 x 1 1/2 x 8'-11 3/4 - h

1-PL 17 x 3/8 x 28 1/2 - t

Comp See GN1

1-PL - c

1-PL - d

1-PL 18 1/2 x 3/8 x 2'-9 - w

1-Sole PL 402A (Det. on Sht. #402)

1-PL 8 1/2 x 1 1/16 x 5'-0 6 - P - NS(MIE)

1-PL 8 1/2 x 1 1/16 x 5'-0 6 - S - FS (MIE)

5'-0

13 @ 4" = 4'-4

2'-1 7/8 | 3'-2 | 3'-2 | 7 @ 2'-9 3/4 = 19'-8 1/4 | 2'-9 1/2 | 3'-0 7/8 | 3'-0 7/8 | 4 @ 3'-0 7/8 = 12'-3 1/2

8'-5 7/8 | 8'-11 13/16 | 22'-6 1/16 | 12'-0 1/8 | 21'-6 1/8 | 21'-6 1/16

30'-11 13/16 | 44'-6

75'-5 13/16 Bott Flg.

GIRDER 443A

℄ Pier "E9"

℄ Match Line

Sec. A-A (Typ. Inter. Stiff.)

Sec. B-B

Sec. C-C

For location of details shown on this sheet refer to diagrams

E401

Material

Rivets or Bolts

Open Holes

A325 Field Bolts

Shop Contact Surfaces

Paint

See Sht 443BB

Pier # 9 Line B

Customer: Tennessee Dept. of Highways

Structure: Arkansas State Highway Commission

East Approach - Mississippi River Bridge

Proj. I-40-1(16)0 - Memphis - Tenn.

Bethlehem Steel Corporation

Fabricated Steel Construction

Chicago Drafting Room Leetsdale Works

Made by J.G.M. Date 2-10-71 In Charge F.J.K.

Checked by Hab Date 2-25-71 Shop No.

Contract CE6417-000 Drawing No. 443AB

No. 1 — Date 4-6-71 — Init Hab — Revision

Submittal — Date

36663 11-61

MICROFILMED

M-48-57

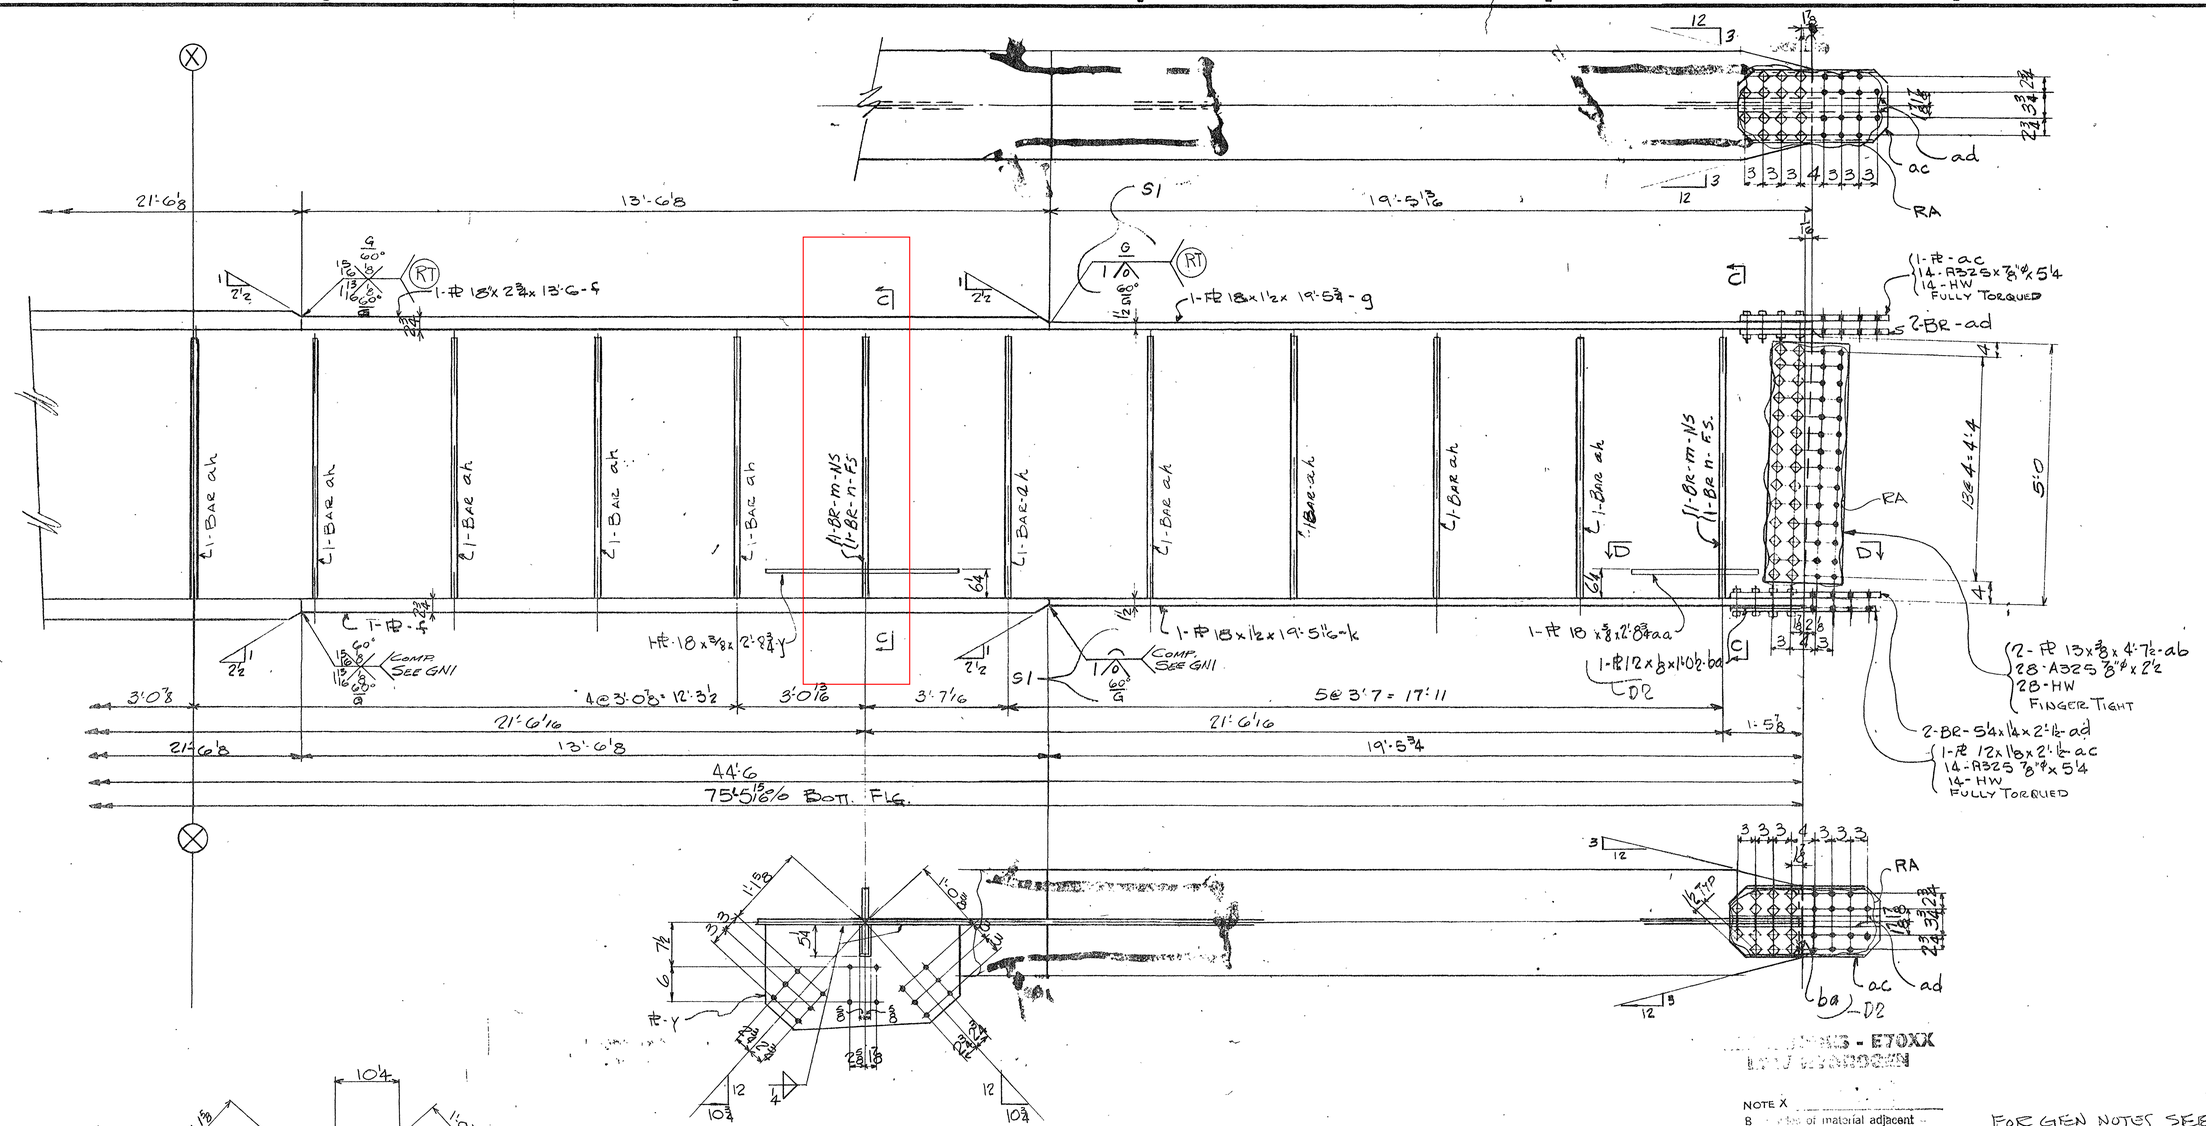

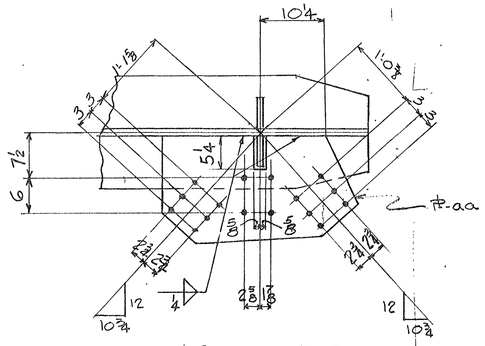

SECTION D-D

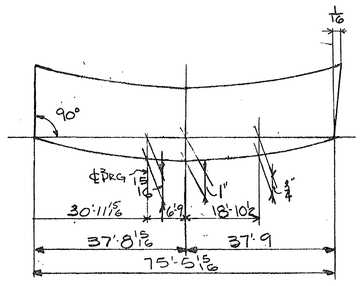

CAMBER DIAGRAM

NOTE X
B[illegible] of material adjacent [illegible] holes must be free of burrs, loose scale, and paint for a distance of 3 IN. from the group of holes.

NOTE: 2¾"x ¾" CLIP ALL STIFF AS SHOWN

FOR GEN NOTES SEE GN1

INST.	NO.	DESCRIPTION	MARK	REMARKS
	1	GIRDER	443A	
	93	REQUIRED LIST		

MATERIAL A.S.T.M. A36
BOLTS A325 ⅞"ø
OPEN HOLES 15/16"ø
A325 FIELD BOLTS —
SHOP CONTACT SURFACES N.P.
WELDING - AS NOTED
MILLING - AS NOTED
PAINT - Coat 11-P 615d Type II
U.N. ! See Note "X"

NO	DATE	BY	REVISION
9	7-23	EJ	
1	4-6-71	Hub	

SUBMITAL 1 2 3 4 5 6 7 8 9 0
DATE

CUSTOMER TENNESSEE DEPT. OF HIGHWAYS
ARKANSAS STATE HIGHWAY COMMISSION
STRUCTURE EAST APPROACH - MISS. RIVER BRIDGE
PROJ. I-40-1(116)0 - MEMPHIS - TENN.

BETHLEHEM STEEL CORPORATION
FABRICATED STEEL CONSTRUCTION
CHICAGO DRAFTING ROOM LEETSDALE WORKS
MADE BY J.K.M DATE 2-11-71 IN CHARGE F.J.K.
CHECKED BY Hub DATE 2-25-71 SHOP NO.
CONTRACT CE6472:000 DRAWING NO. 443 BB

For location of details shown on this sheet refer to diagrams
E4-01

M-48-58

36663 (1-63)

MICROFILMED

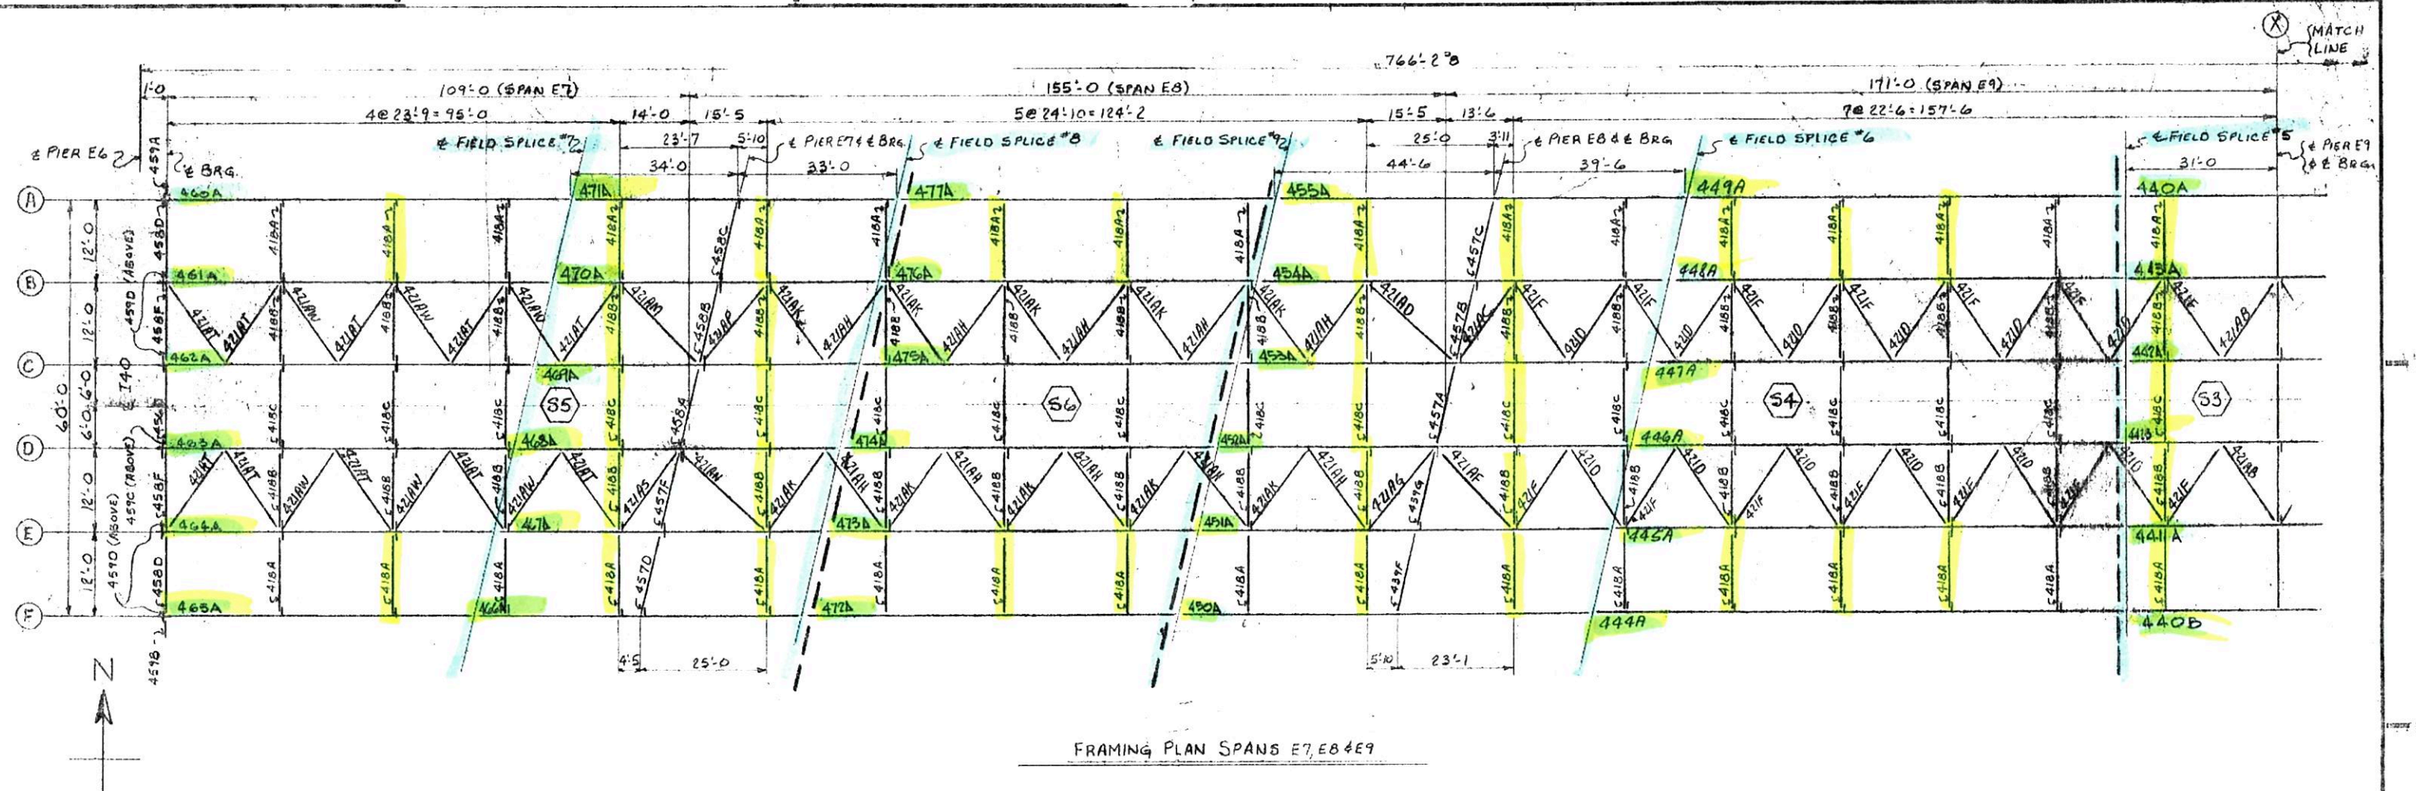

ERECTOR NOTE

1. SHIPPING MARKS ARE PAINTED BY THE SHOP ON THE LEFT END OF THE MEMBER AS DETAILED. THE ERECTOR SHALL ERECT THE MEMBER WITH THE MARK IN THE POSITION SHOWN ON THE DIAGRAM. IF MARK IS SHOWN @ CENTER OF MEMBER, THE MEMBER MAY BE TURNED END FOR END.

2. GIRDERS HAVE BEEN ASSEMBLED IN THE SHOP & SPLICES REAMED.

3. ALL SPLICE MAT'L. MUST BE REASSEMBLED IN CORRECT POSITION IN FIELD TO INSURE PROPER FIT FOR PROPER ERECTION.

4. ALL FIELD CONNECTIONS TO BE HIGH STRENGTH BOLTS WITH 1-A325 WASHER PLACED UNDER THE HEAD OR NUT WHICH EVER IS TURNED IN TIGHTENING.

5. INSTALLATION SHALL BE PREFORMED BY USING THE TURN OF NUT TIGHTENING METHOD AS PER ARTICLE 2.10.20 (D)(4) OF A.A.S.H.O. BRIDGE SPECIFICATIONS.

6. SEE BOLT LIST FOR SIZE AND LOCATION OF BOLTS.

7. TAPES SHALL BE CALIBRATED AT 60° FAHRENHEIT WITH THE U.S. BUREAU OF STANDARDS.

8. ALL SPLICE BOLTS INSTALLED IN SHOP ARE "FINGER" TIGHTENED IN THE SHOP FOR SHIPPING PURPOSES ONLY. AFTER ERECTION, ALL FIELD SPLICE BOLTS ARE TO BE TORQUED AS PER NOTE 5 ABOVE.

WORK THIS SHEET WITH SHEET E402

TENNESSEE DEPT. OF HIGHWAYS
ARKANSAS STATE HIGHWAY COMMISSION
EAST APPROACH - MISS. RIVER BRIDGE
PROJ. I-40-1(11610 - MEMPHIS - TENN.

BETHLEHEM STEEL CORPORATION
FABRICATED STEEL CONSTRUCTION

CHICAGO/BURNS HBR. LEET SPANS
MADE BY LTN DATE 1-7-70 IN CHARGE F.J.K.
CHECKED BY DATE SHOP NO.

CONTRACT CC6472-000 DRAWING NO. E401

REVISION

MICROFILMED

M-48-2

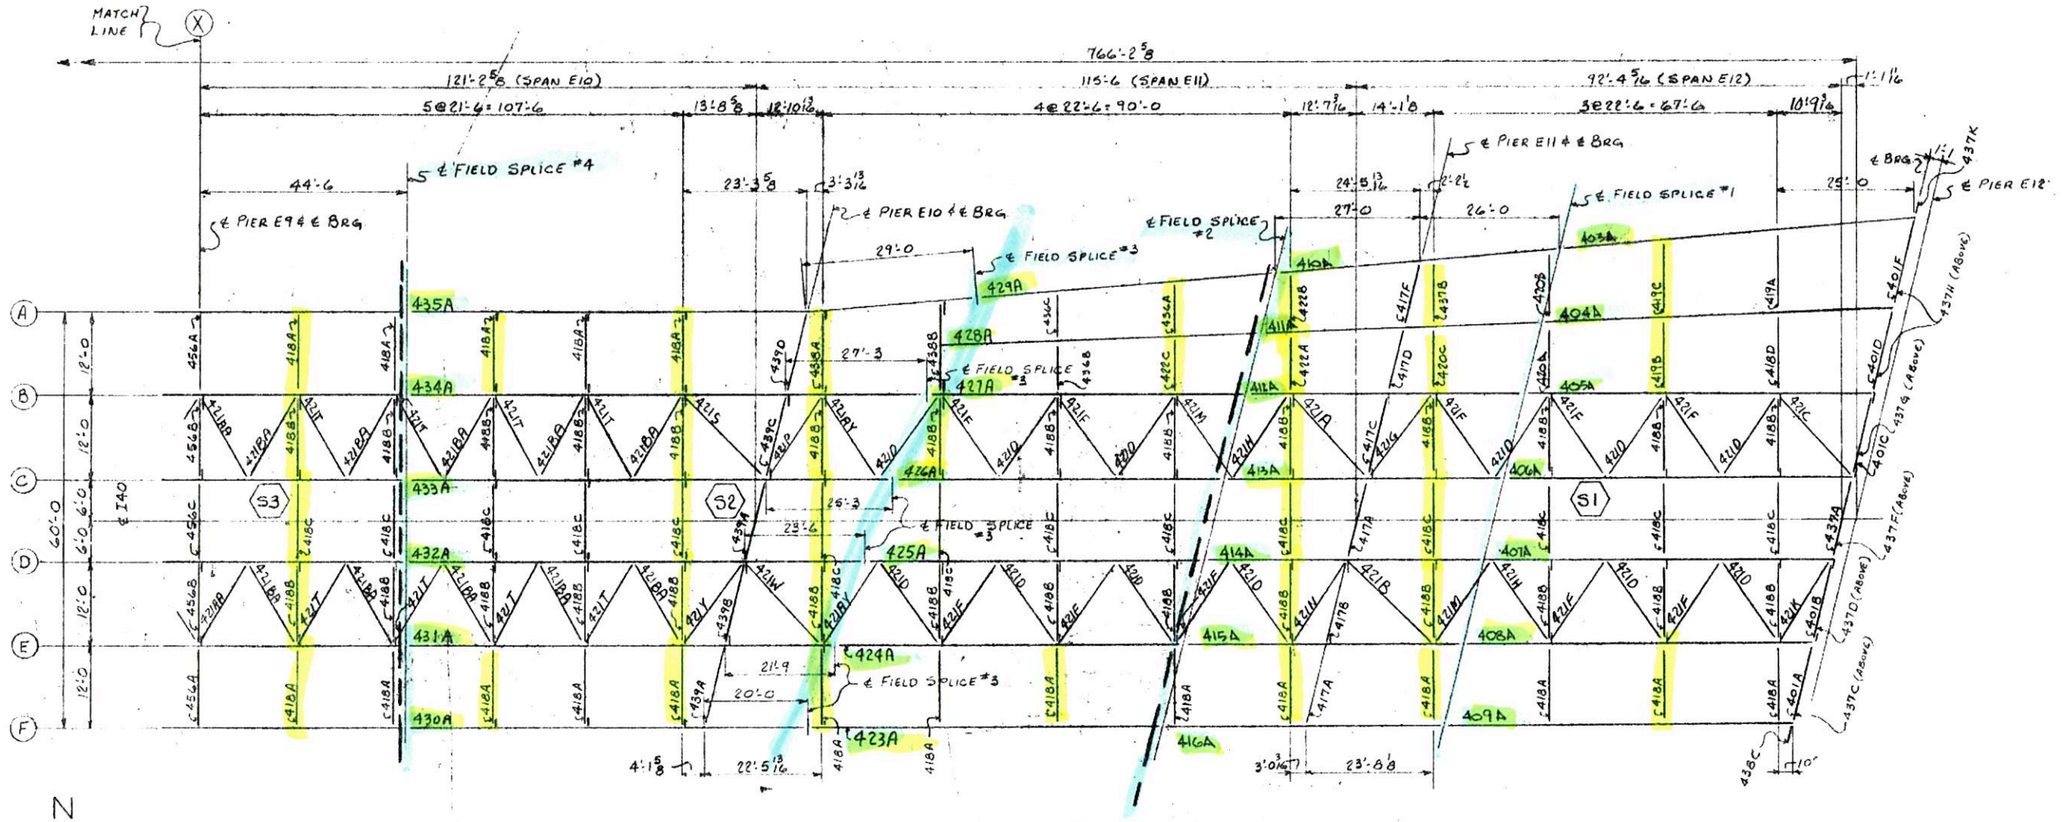

FRAMING PLAN SPANS E10, E11 & E12

WORK THIS SHEET WITH SHEET E401

TENNESSEE DEPT. OF HIGHWAYS
ARKANSAS STATE HIGHWAY COMMISSION
EAST APPROACH - MISS. RIVER BRIDGE
PROJ. I-40-1(136)0 - MEMPHIS - TENN.

BETHLEHEM STEEL CORPORATION
FABRICATED STEEL CONSTRUCTION
CHICAGO DRAFTING ROOM — LEETSDALE, PENNA.
MADE BY ATW DATE 6-7-71 IN CHARGE FJ-K
CHECKED BY K DATE — SHOP NO.
CONTRACT CS 6472-000 DRAWING NO. E402

MATERIAL
RIVETS OR BOLTS
OPEN HOLES
A325 FIELD BOLTS
SNUG CONTACT SURFACES
PAINT

NO.	DATE	REVISION
1		
2		
3		
4		
5		
6		
7		
8		
9		
10		

SUBMITTED
DATE

MODIFIED

For location of details shown on this sheet refer to diagram.

A-18 3

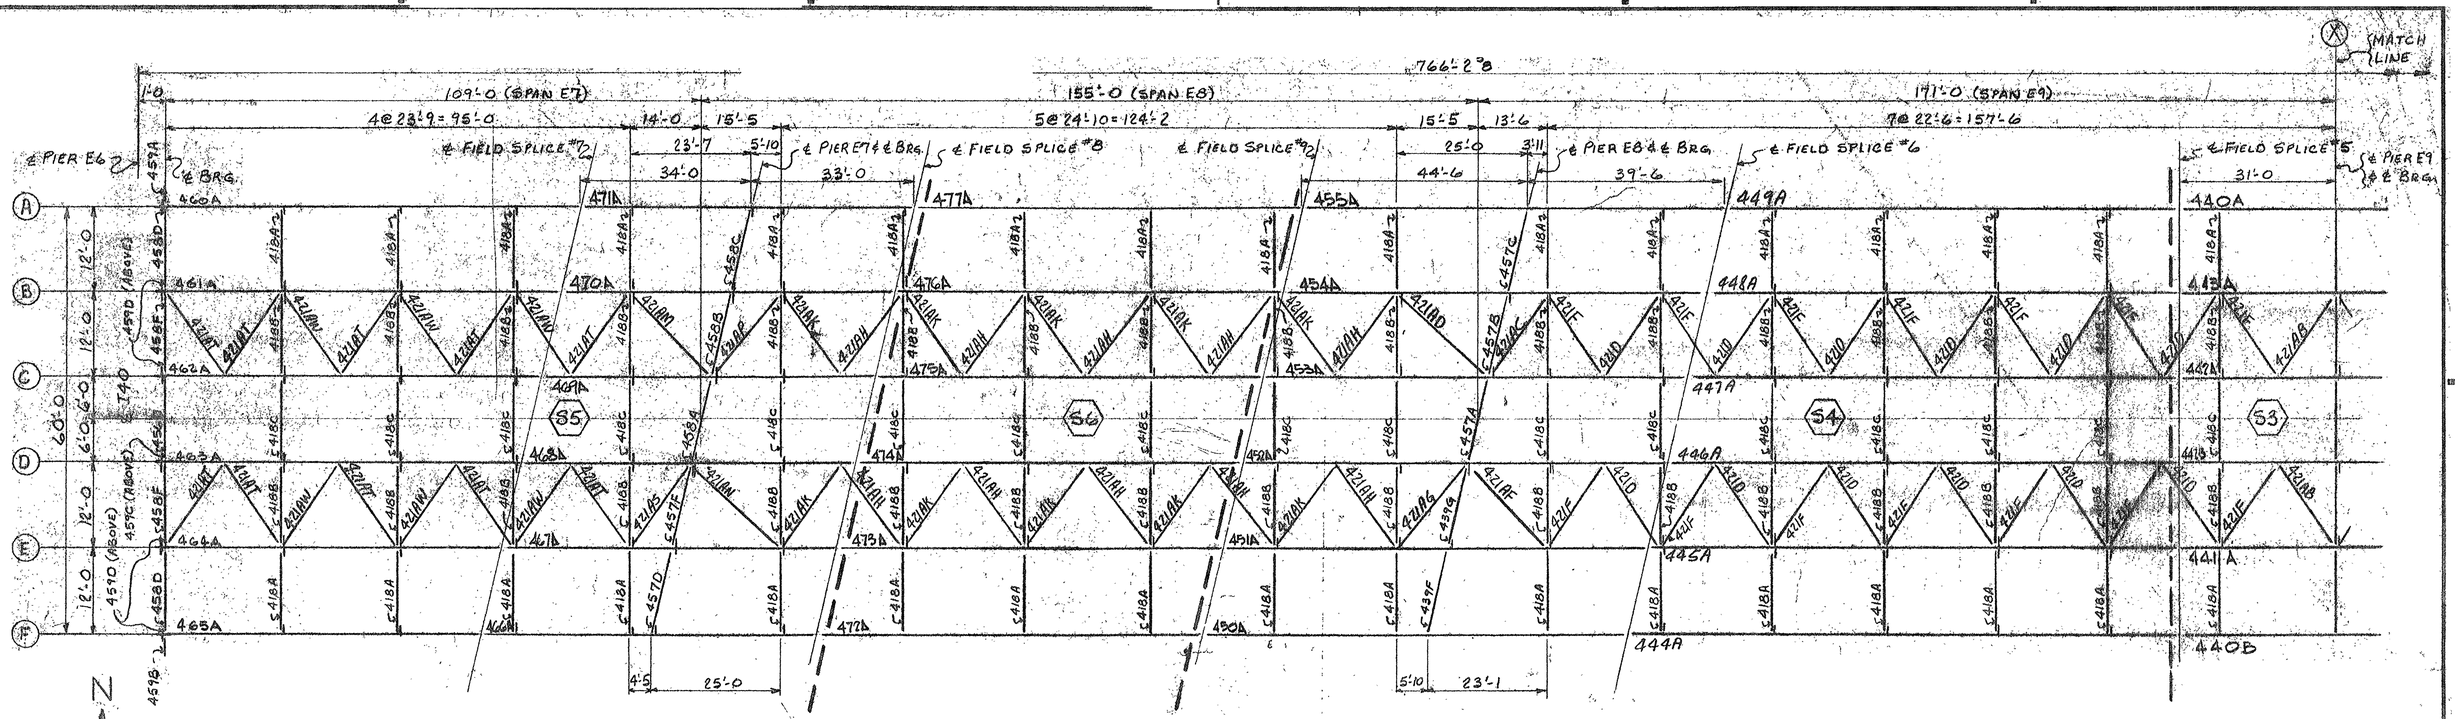

FRAMING PLAN SPANS E7, E8 & E9

N

ERECTOR NOTE

1. SHIPPING MARKS ARE PAINTED BY THE SHOP ON THE LEFT END OF THE MEMBER AS DETAILED. THE ERECTOR SHALL ERECT THE MEMBER WITH THE MARK IN THE POSITION SHOWN ON THE DIAGRAM. IF MARK IS SHOWN @ CENTER OF MEMBER, THE MEMBER MAY BE TURNED END FOR END.

2. GIRDERS HAVE BEEN ASSEMBLED IN THE SHOP & SPLICES REAMED.

3. ALL SPLICE MAT'L. MUST BE REASSEMBLED IN CORRECT POSITION IN FIELD TO INSURE PROPER FIT FOR PROPER ERECTION.

4. ALL FIELD CONNECTIONS TO BE HIGH STRENGTH BOLTS WITH 1-A325 WASHER PLACED UNDER THE HEAD OR NUT WHICH EVER IS TURNED IN TIGHTENING.

5. INSTALLATION SHALL BE PREFORMED BY USING THE TURN OF NUT TIGHTENING METHOD AS PER ARTICLE 2.10.20 (D)(4) OF A.A.S.H.O. BRIDGE SPECIFICATIONS.

6. SEE BOLT LIST FOR SIZE AND LOCATION OF BOLTS.

7. TAPES SHALL BE CALIBRATED AT 60° FAHRENHEIT WITH THE U.S. BUREAU OF STANDARDS.

8. ALL SPLICE BOLTS INSTALLED IN SHOP ARE "FINGER" TIGHTENED IN THE SHOP FOR SHIPPING PURPOSES ONLY. AFTER ERECTION, ALL FIELD SPLICE BOLTS ARE TO BE TORQUED AS PER NOTE 5 ABOVE.

WORK THIS SHEET WITH SHEET E402

MATERIAL
RIVETS OR BOLTS
OPEN HOLES
A325 FIELD BOLTS
SHOP CONTACT SURFACES
PAINT

NO.	DATE	INIT.	REVISION
1			421K

SUBMITTAL DATE

CUSTOMER: TENNESSEE DEPT. OF HIGHWAYS
ARKANSAS STATE HIGHWAY COMMISSION
STRUCTURE: EAST APPROACH - MISS. RIVER BRIDGE
PROJ. I-40-1(116)0 - MEMPHIS - TENN.

BETHLEHEM STEEL CORPORATION
FABRICATED STEEL CONSTRUCTION

CHICAGO DRAFTING PO/DA: LEETSPNS SHEET
MADE BY: LTW DATE: 1-7-70 IN CHARGE: F.J.K.
CHECKED BY: DATE: SHOP NO.
CONTRACT: CC1472-000 DRAWING NO. E401

For location of details shown on this sheet refer to Diagram.

MICROFILMED

M-482

MATCH LINE (X)

766'-2 5/8

121'-2 5/8 (SPAN E10) | 115'-6 (SPAN E11) | 92'-4 5/16 (SPAN E12) | 1'-1 1/16

5@21'-6 = 107'-6 | 13'-8 5/8 | 12'-10 13/16 | 4@22'-6 = 90'-0 | 12'-7 3/16 | 14'-1 1/8 | 3@22'-6 = 67'-6 | 10'-9 3/16

44'-6 | 23'-3 5/8 | 3'-3 13/16 | 24'-5 13/16 | 2'-2 1/2 | 27'-0 | 26'-0 | 25'-0

℄ PIER E9 & ℄ BRG. | ℄ FIELD SPLICE #4 | ℄ PIER E10 & ℄ BRG. | 29'-0 | ℄ FIELD SPLICE #3 | ℄ FIELD SPLICE #2 | ℄ PIER E11 & ℄ BRG. | ℄ FIELD SPLICE #1 | ℄ BRG. | ℄ PIER E12

A 12'-0 | B 12'-0 | C 60'-0 | 6'-0 | 6'-0 | D 12'-0 | E 12'-0 | F 12'-0

℄ I40

435A | 434A | 433A | 432A | 431A | 430A

428A | 427A | 426A | 425A | 424A | 423A

429A | 404A | 405A | 406A | 407A | 408A | 409A | 415A | 414A | 413A | 412A | 411A | 410A | 416A

S3 | S2 | S1

℄ FIELD SPLICE #3 | 27'-3 | 25'-3 | 23'-7 | 21'-9 | 20'-0 | 4'-1 5/8 | 22'-5 13/16 | 3'-0 13/16 | 23'-8 3/8

℄ FIELD SPLICE #3 | ℄ FIELD SPLICE #3

℄ 401A | ℄ 401B | ℄ 401C | ℄ 401D | ℄ 401E | ℄ 401F | ℄ 401G | ℄ 401H | ℄ 401K | ℄ 401L

437K | 437H (ABOVE) | 437G (ABOVE) | 437F (ABOVE) | 437D (ABOVE) | 437C (ABOVE) | 438C | 10"

N

FRAMING PLAN SPANS E10, E11 & E12

WORK THIS SHEET WITH SHEET E401

For location of details shown on this sheet refer to diagrams.

MATERIAL
RIVETS OR BOLTS
OPEN HOLES
A325 FIELD BOLTS
SHOP CONTACT SURFACES
PAINT

NO.	DATE	INIT.	REVISION
0			
9			
8			
7			
6			
5			
4			
3			
2			
1			

SUBMITTAL 1 2 3 4 5 6 7 8 9 0
DATE

CUSTOMER TENNESSEE DEPT. OF HIGHWAYS
ARKANSAS STATE HIGHWAY COMMISSION
STRUCTURE EAST APPROACH - MISS. RIVER BRIDGE
PROJ. I-40-1(136)0 - MEMPHIS - TENN.

BETHLEHEM STEEL CORPORATION
FABRICATED STEEL CONSTRUCTION
LEETSDALE WORKS
CHICAGO DRAFTING ROOM
MADE BY GTW DATE 2-19-71 IN CHARGE F.J.P.
CHECKED BY DATE SHOP NO.
CONTRACT C&F 6472-800 DRAWING NO. E402

Sheet 11 of 23

11-18-3

MICROFILMED

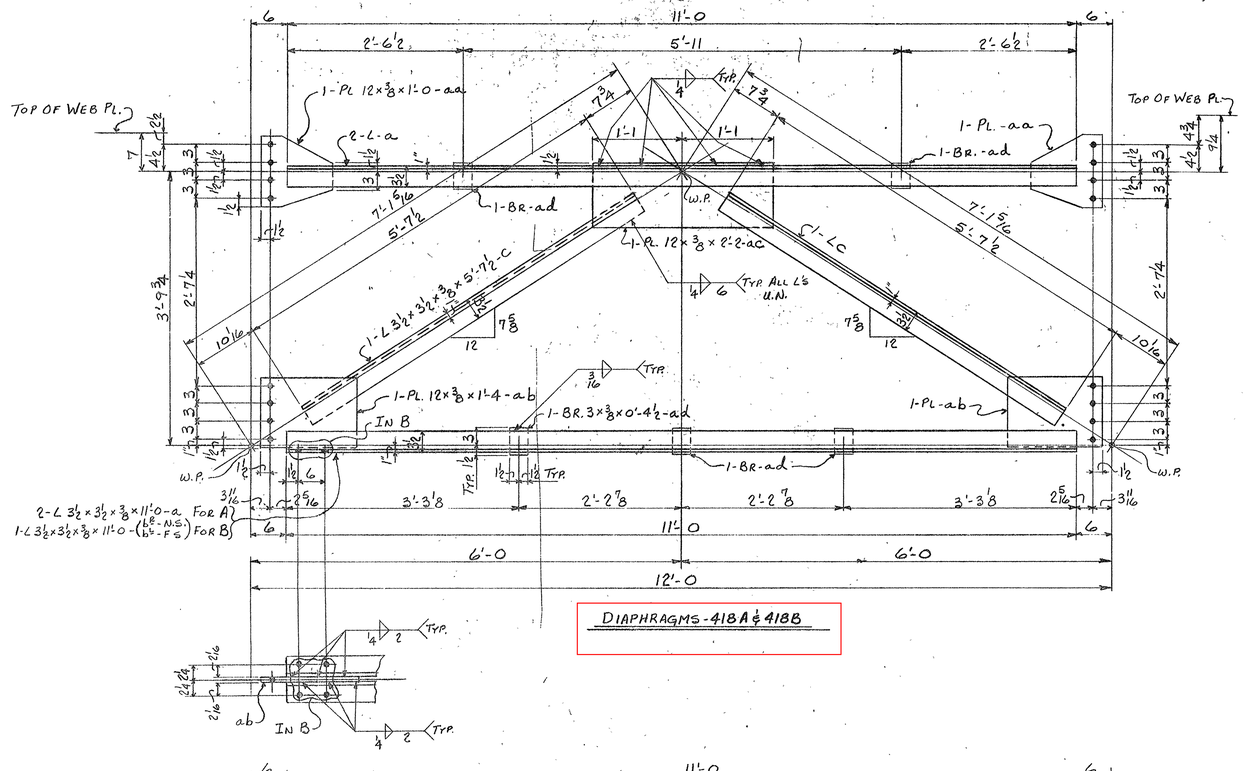

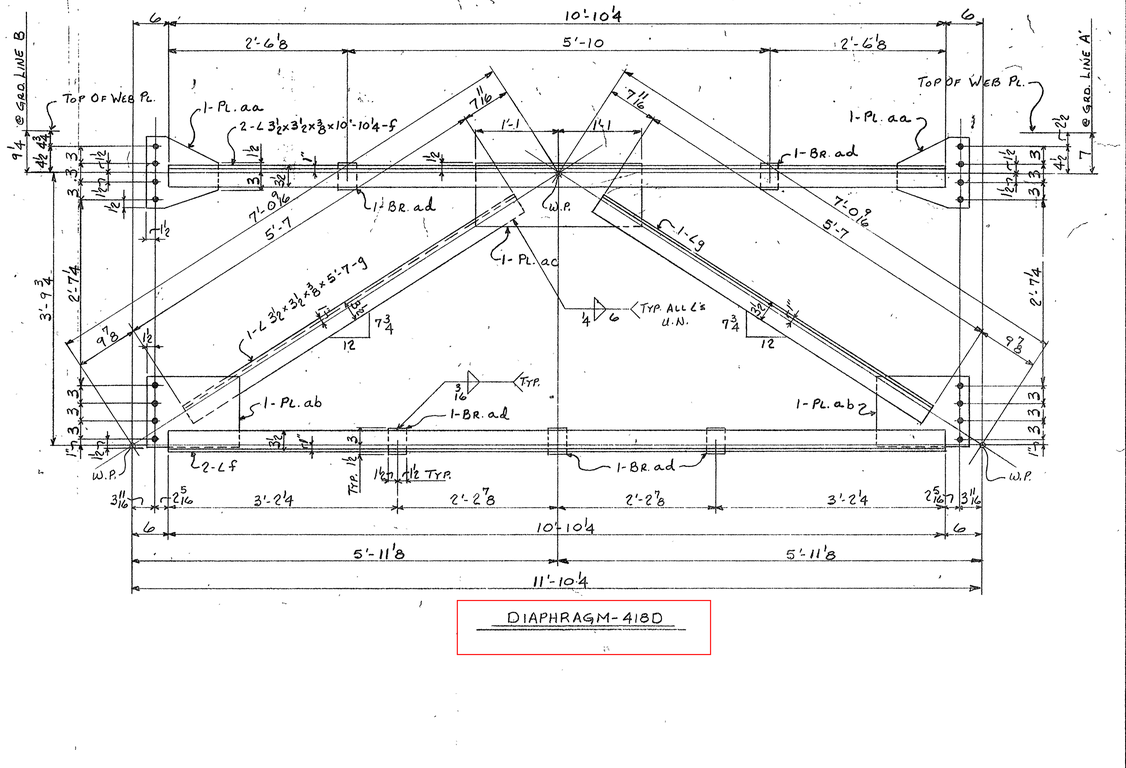

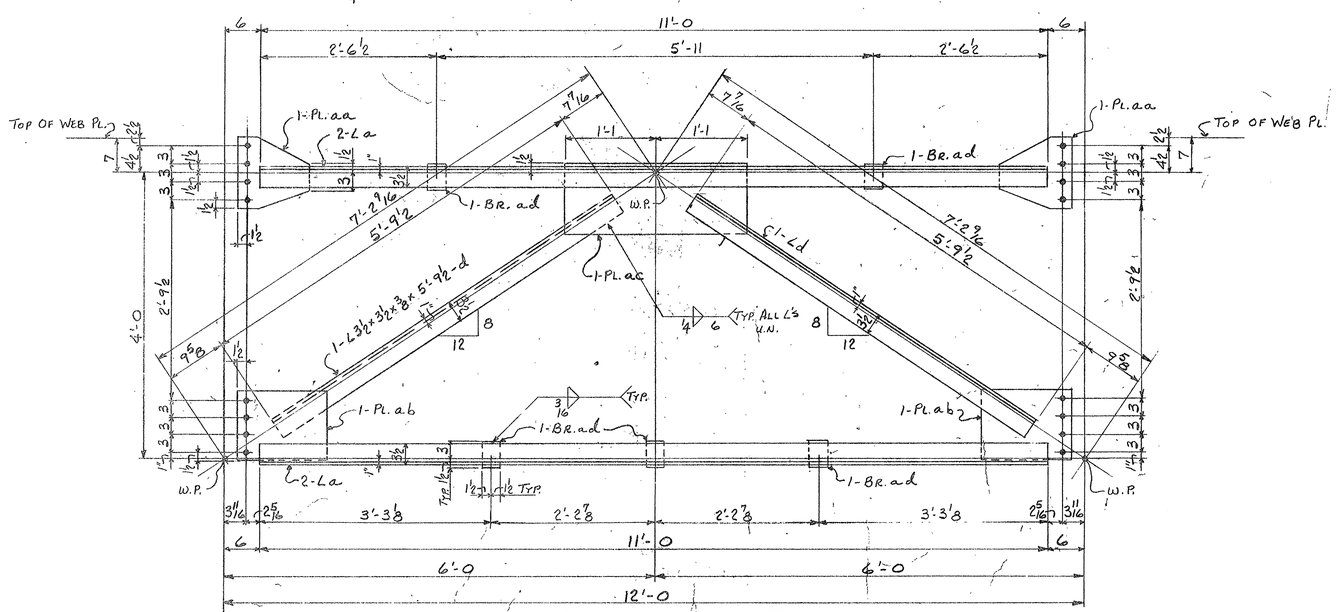

INSTALLMENTS						REQUIRED LIST			
S6	S5	S4	S3	S2	S1	MARK	QTY.	DESCRIPTION	REMARKS
7	10	15	6	10	5	418A	53	DIAPHRAGMS	
7	10	15	6	14	10	418B	62		
3	5	8	3	7	5	418C	31		
					1	418D	1		

NOTE X
Both sides of material adjacent to all open holes must be free of burrs, loose scale, and paint for a distance of 3" from the edge of hole.

E70XX - ELECTRODES LOW HYDROGEN
MATERIAL ~ ASTM-A36
RIVETS OR BOLTS ~
OPEN HOLES ~ 15/16"ø
A325 FIELD BOLTS ~
SHOP CONTACT SURFACES ~ NO PAINT
WELD ~ AS NOTED
PAINT ~ 1 Coat TT-P 615d Type I, U.N. - See Note "X"

FOR GEN. NOTES SEE SHT. GN1

NO.	DATE	REVISION
0		
9		
8		
7		
6		
5		
4		
3		
2		
1		

CUSTOMER: TENNESSEE DEPT. OF HIGHWAYS
ARKANSAS STATE HIGHWAY COMMISSION
STRUCTURE: EAST APPROACH - MISS. RIVER BRIDGE
PROJ. I-40-1(116)0 - MEMPHIS - TENN.
BETHLEHEM STEEL CORPORATION
FABRICATED STEEL CONSTRUCTION
CHICAGO DRAFTING ROOM LEETSDALE WORKS
MADE BY LTZ DATE 1-20-71 IN CHARGE FJK
CHECKED BY LE DATE 2/19/71 SHOP NO.
CONTRACT CE 6472-000 DRAWING NO. 418

SUBMITTAL	1	2	3	4	5	6	7	8	9	0
DATE										

For location of details shown on this sheet refer to diagram.
E401 & E402

MICROFILMED

M-48-23

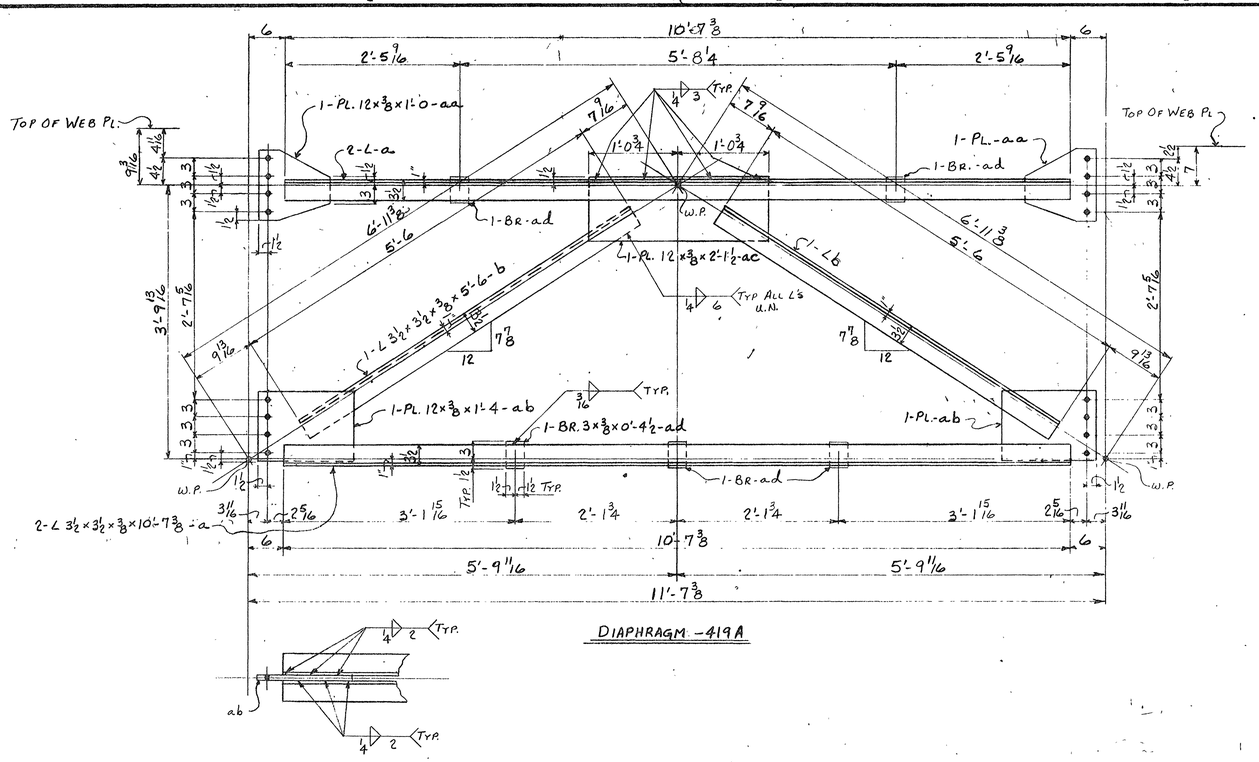

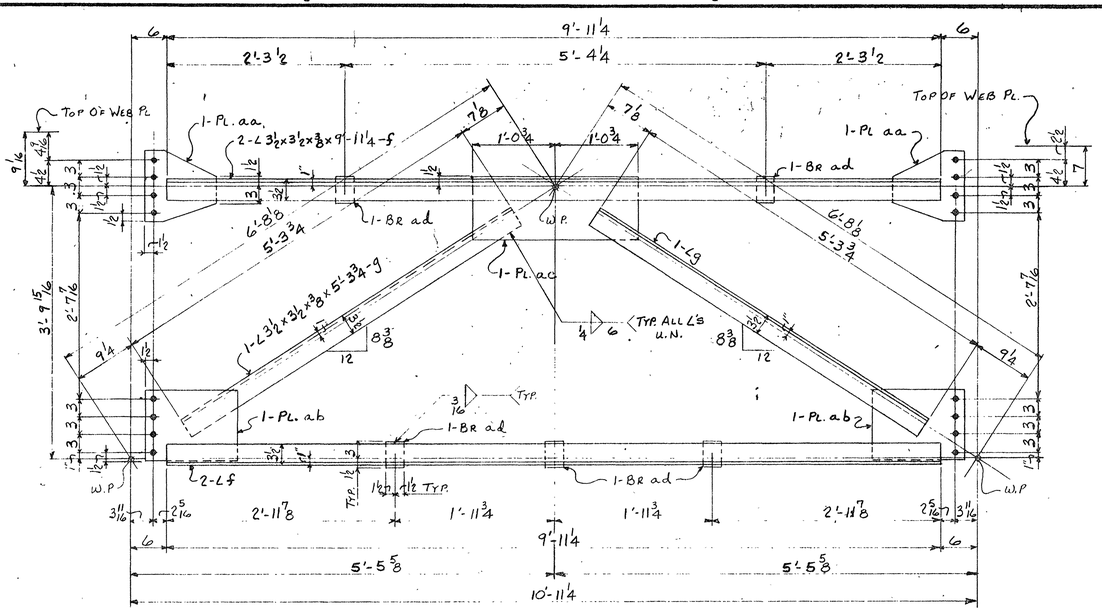

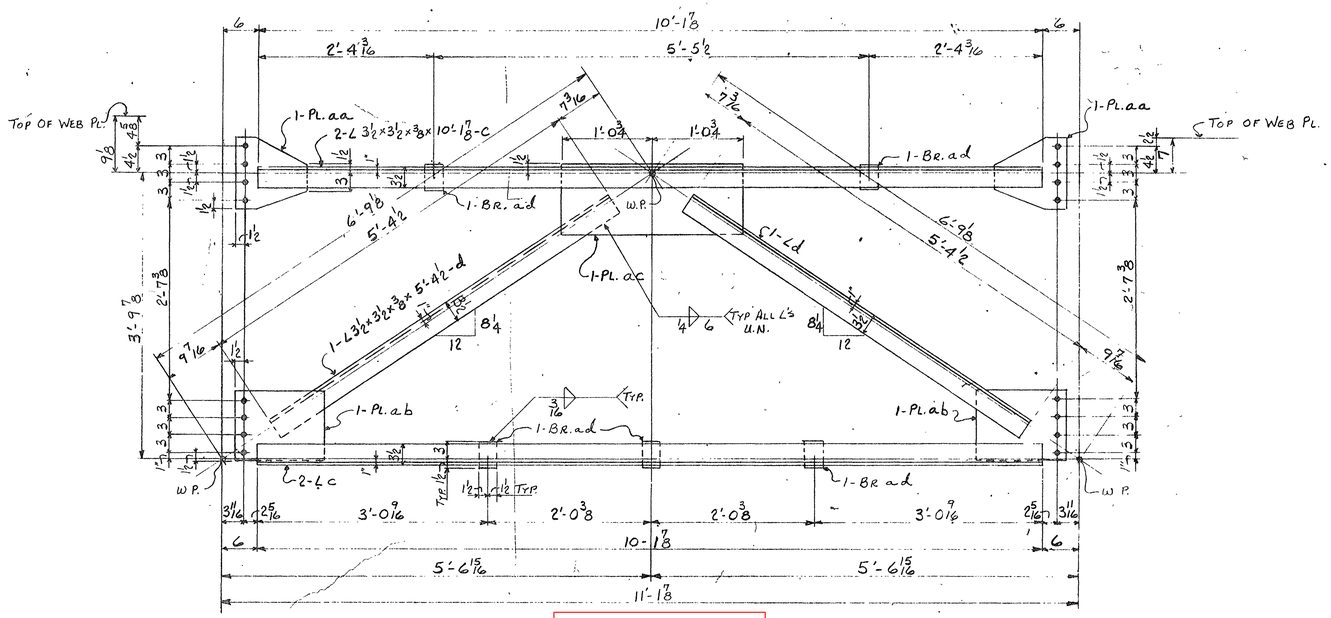

INSTALLMENTS						REQUIRED LIST			
S6	S5	S4	S3	S2	S1	MARK	QTY.	DESCRIPTION	REMARKS
					1	419A	1	DIAPHRAGMS	
					1	419B	1		
					1	419C	1		

FOR GENERAL NOTES SEE SHT. GN1

NOTE X
Both sides of material adjacent to all open holes must be free of burrs, loose scale, and paint for a distance of 3" from the edge of hole.

E70XX-ELECTRODES
LOW HYDROGEN
MATERIAL ~ ASTM-A36
RIVETS OR BOLTS ~
OPEN HOLES ~ 15/16
A325 FIELD BOLTS ~
SHOP CONTACT SURFACES ~ NO PAINT
WELD ~ AS NOTED
PAINT ~ Coat. No. P 615d Type II U.N. * See Note "X"

REVISION			
NO	DATE	INIT

SUBMITTAL	1	2	3	4	5	6	7	8	9	0
DATE										

CUSTOMER
TENNESSEE DEPT. OF HIGHWAYS
ARKANSAS STATE HIGHWAY COMMISSION
STRUCTURE
EAST APPROACH - MISS. RIVER BRIDGE
PROJ. I-40-1(116)0 - MEMPHIS - TENN.

BETHLEHEM STEEL CORPORATION
FABRICATED STEEL CONSTRUCTION

CHICAGO DRAFTING ROOM LEETSDALE WORKS
MADE BY LTW DATE 1-20-71 IN CHARGE FJK
CHECKED BY LE DATE 2/19/71 SHOP NO.
CONTRACT CE 6472-000 DRAWING NO. 419

33433 (Rev.A 1-65)

For location of details shown on this sheet refer to diagrams.
E402

MICROFILMED

M-48-24

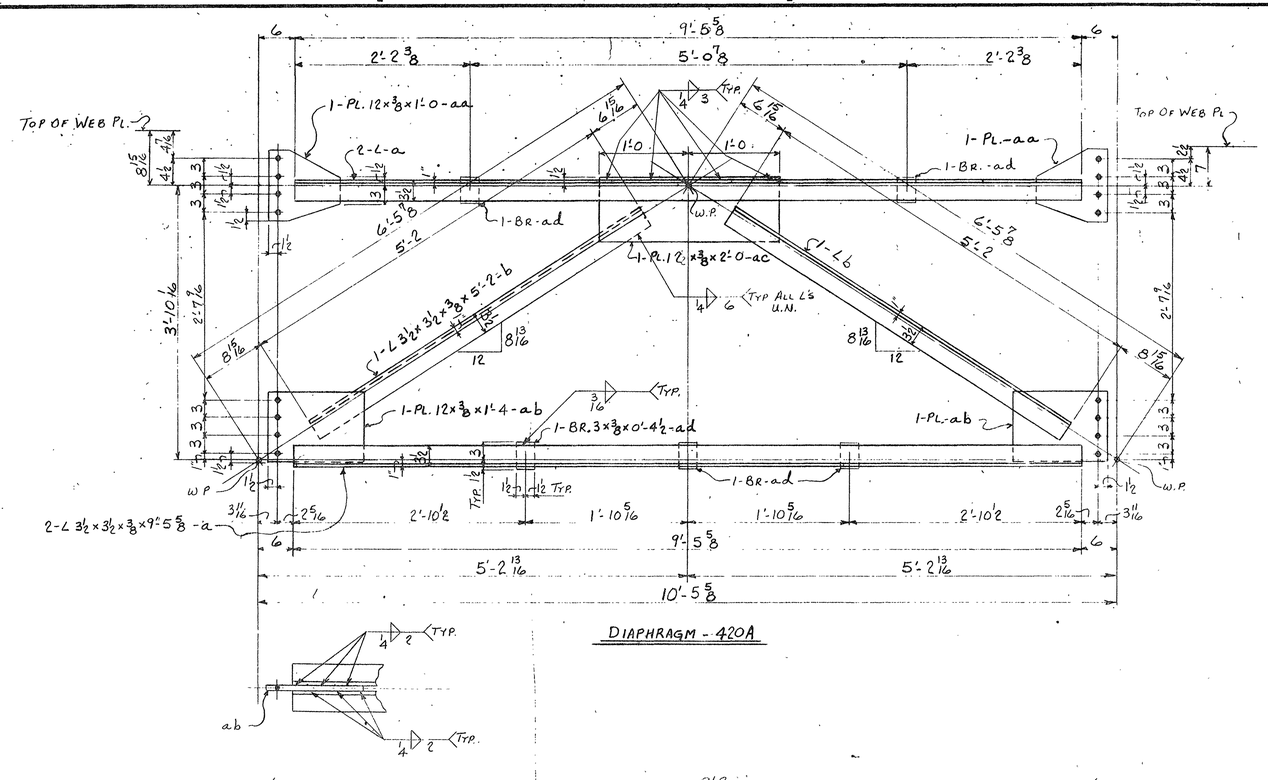

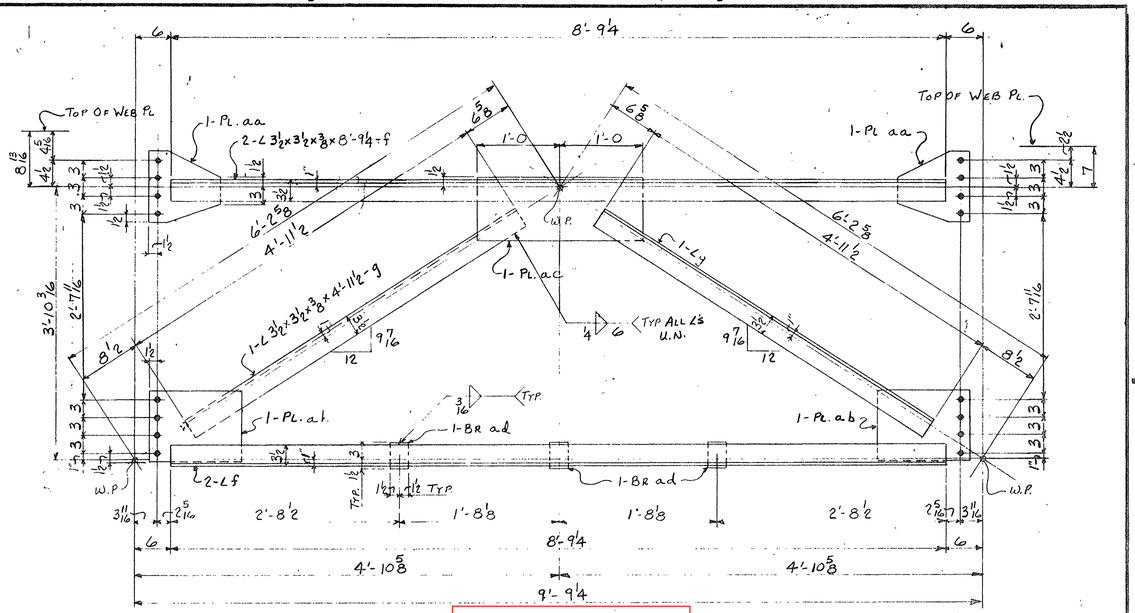

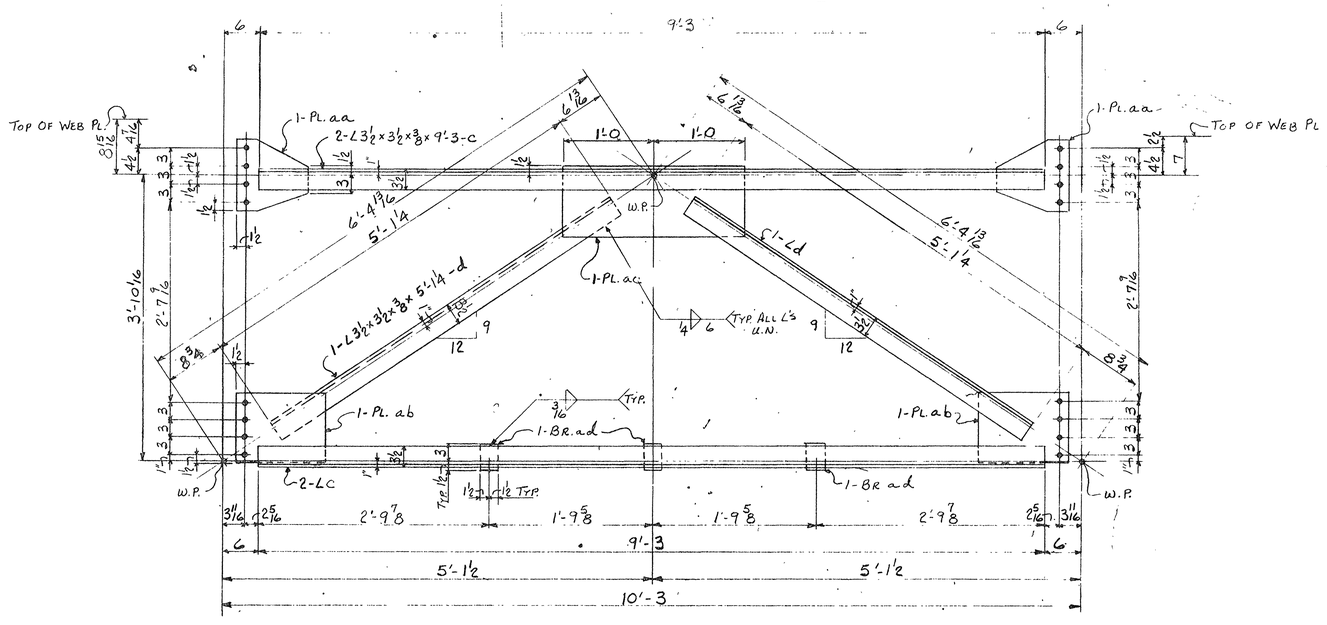

INSTALLMENTS						REQUIRED LIST			
S6	S5	S4	S3	S2	S1	MARK	QTY.	DESCRIPTION	REMARKS
					1	420A	1	DIAPHRAGMS	
					1	420B	1		
					1	420C	1		

FOR GENERAL NOTES SEE SHT GN1

NOTE X
Both sides of material adjacent to all open holes must be free of burrs, loose scale, and paint for a distance of 3" from the edge of holes.

E70XX - ELECTRODES LOW HYDROGEN
MATERIAL ~ ASTM - A36
RIVETS OR BOLTS ~
OPEN HOLES ~ 15/16 1/16
A325 FIELD BOLTS ~
SHOP CONTACT SURFACES ~ NO. PAINT
WELD ~ AS NOTED
PAINT ~ 1 Coat ST-P 615d Type II U.N. - See Note "X"

	a	b	c
g			
f			
c			
d			
f			
g			
h			
k			
n			
p			
s			
t			
w			
y			

For location of details shown on this sheet refer to diagrams.
E402

CUSTOMER TENNESSEE DEPT. OF HIGHWAYS
ARKANSAS STATE HIGHWAY COMMISSION
STRUCTURE EAST APPROACH - M.&O. RIVER BRIDGE
PROJ. I-40-1(116)0 - MEMPHIS - TENN.

BETHLEHEM STEEL CORPORATION
FABRICATED STEEL CONSTRUCTION

CHICAGO DRAFTING ROOM LEETSDALE WORKS
MADE BY ITW DATE 1-20-71 IN CHARGE FJK
CHECKED BY LE DATE 2/19/71 SHOP NO.
CONTRACT CE 6472-000 DRAWING NO. 420

NO.	DATE	INIT.

REVISION

SUBMITTAL	1	2	3	4	5	6	7	8	9	0
DATE										

3343 (Rev.1-67)

M-48-25

MICROFILMED

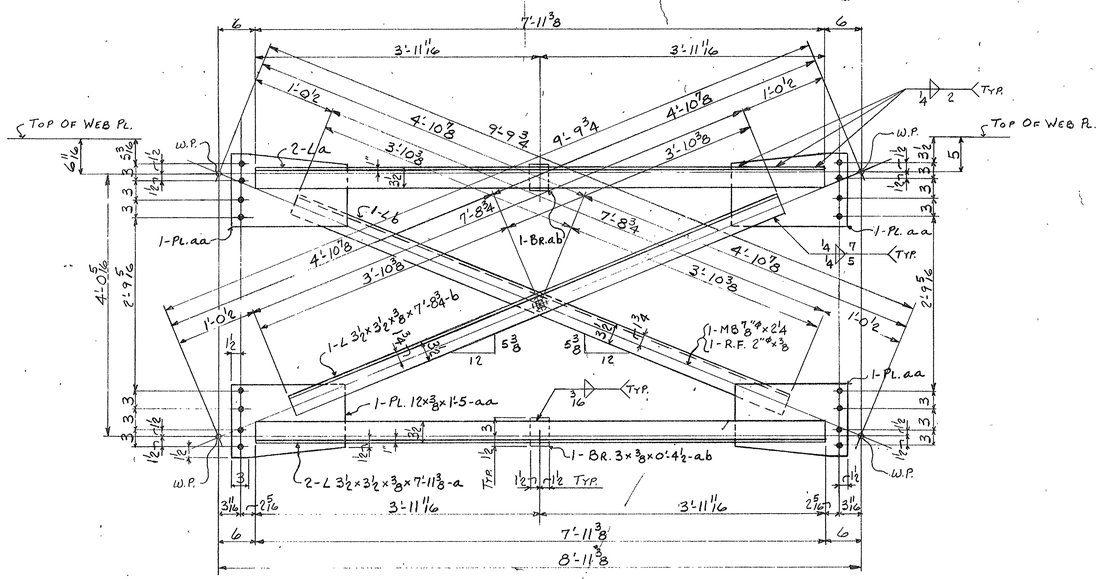

DIAPHRAGM-422A

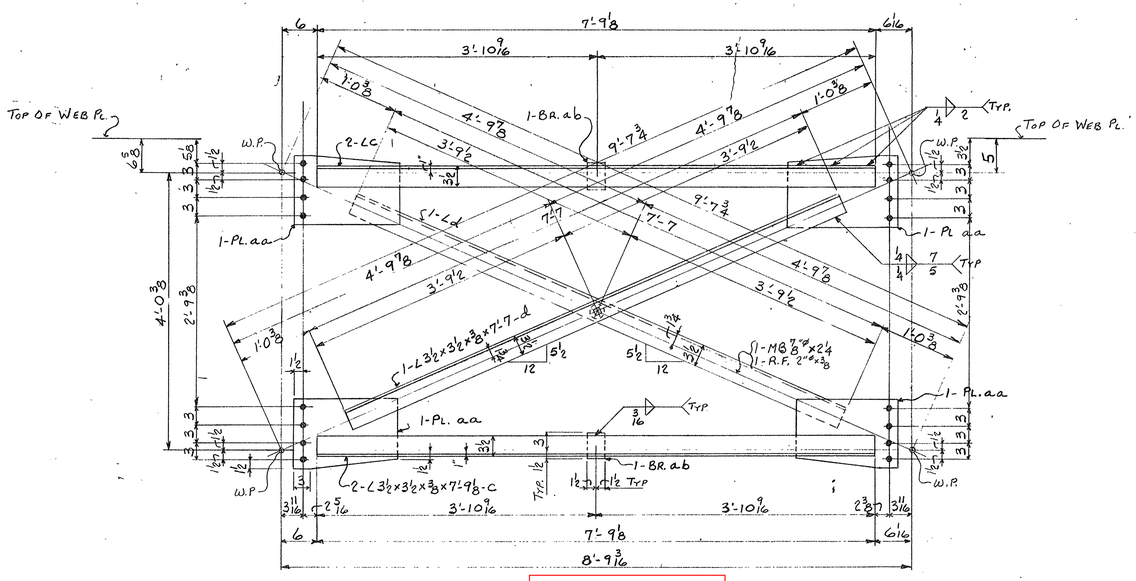

DIAPHRAGM-422B

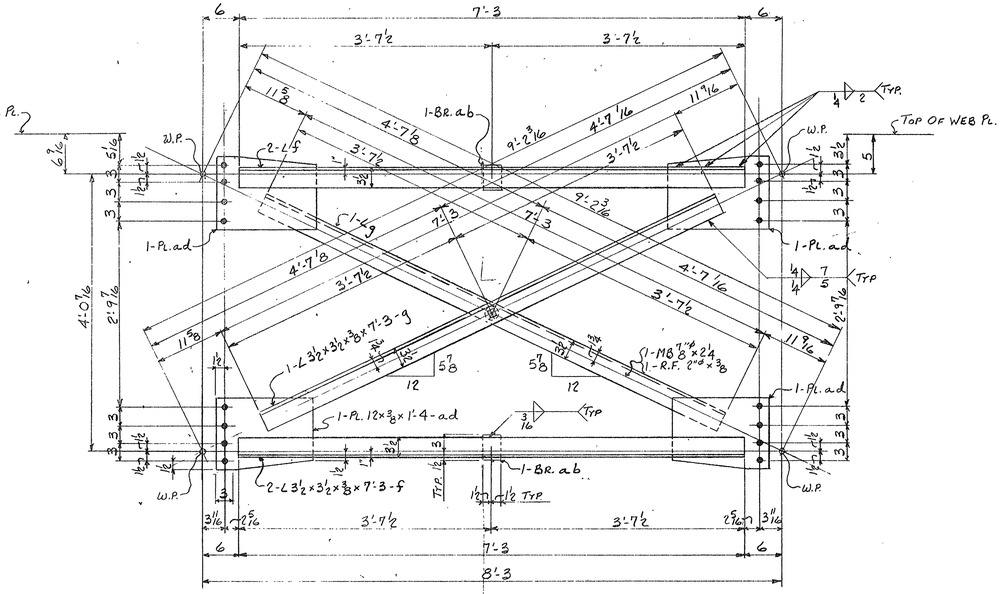

DIAPHRAGMS-422C

INSTALLMENTS						REQUIRED LIST			
S6	S5	S4	S3	S2	S1	MARK	QTY.	DESCRIPTION	REMARKS
					1	422A	1	DIAPHRAGM	
					1	422B	1		
				1		422C	1		1

NOTE X

Both sides of material adjacent to all open holes must be free of burrs, loose scale, and paint for a distance of 3" from the group of holes

FOR GENERAL NOTES SEE SHT. GN1

E70XX ELECTRODES
LOW HYDROGEN

MATERIAL ~ ASTM-A36

RIVETS OR BOLTS ~

OPEN HOLES ~ 15/16"ø

A325 FIELD BOLTS ~

SHOP CONTACT SURFACES ~ NO PAINT

WELD - AS NOTED

PAINT ~ 1 Coat FT-P 615d Type II
U.N. ‡ See Note "X"

NO.	DATE	DIST.
REVISION		

SUBMITTAL	1	2	3	4	5	6	7	8	9	0
DATE										

CUSTOMER TENNESSEE DEPT. OF HIGHWAYS
ARKANSAS STATE HIGHWAY COMMISSION
STRUCTURE EAST APPROACH - M.&S. RIVER BRIDGE
PROJ. I-40-1(116)0 - MEMPHIS - TENN.

BETHLEHEM STEEL CORPORATION
FABRICATED STEEL CONSTRUCTION

CHICAGO DRAFTING ROOM LEETSDALE WORKS
MADE BY LTW DATE 1-21-70 IN CHARGE F.J.K.
CHECKED BY LE DATE 2/23/71 SHOP NO.

CONTRACT CE-6472-000 DRAWING NO. 422

For location of details shown on this sheet refer to diagrams.

E402

35433 (Rev.A 1-63)

M-48-27

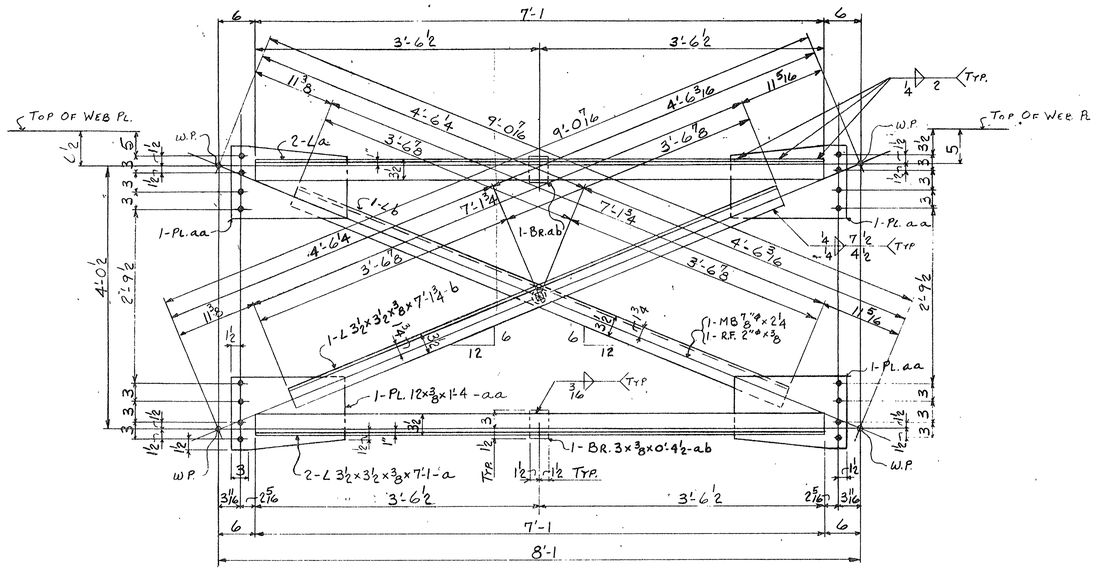

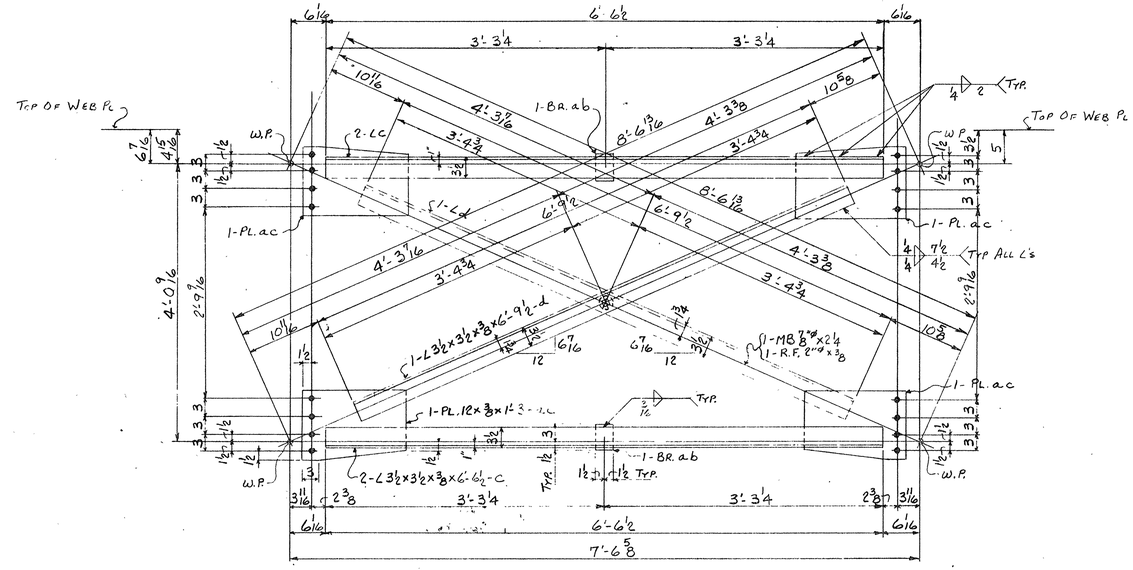

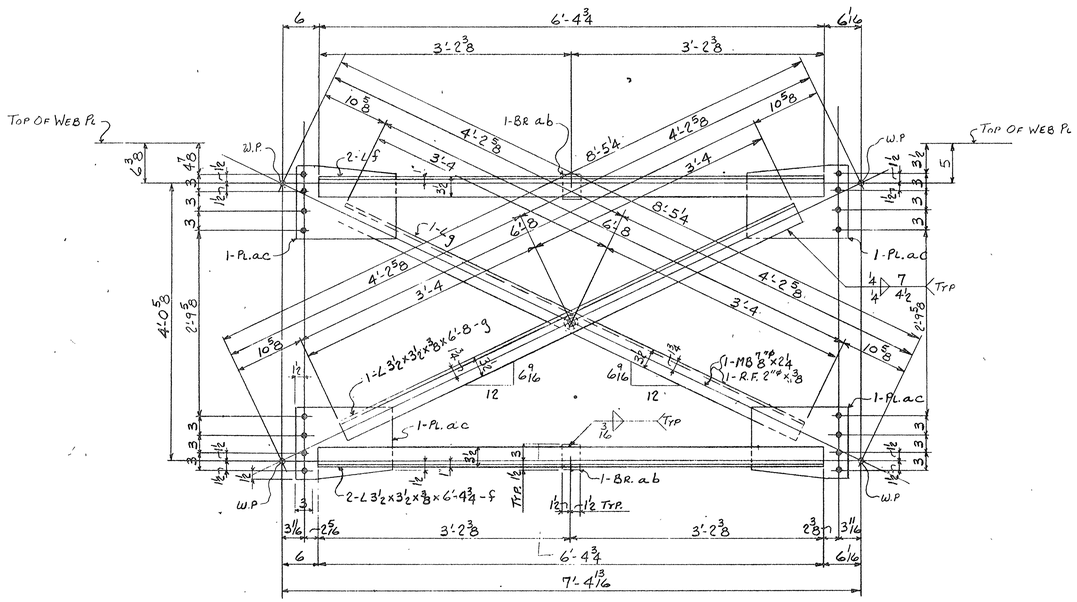

INSTALLMENTS						REQUIRED LIST			
S6	S5	S4	S3	S2	S1	MARK	QTY.	DESCRIPTION	REMARKS
				1		436A	1	DIAPHRAGM	
				1		436B	1		
				1		436C	1		

NOTE
Both sides of web plates and all connection angles to be blast cleaned, scale, and paint for a distance of 3" from the edge of hole.

FOR GENERAL NOTES SEE SHT. GN1

E70XX ELECTRODES
LOW HYDROGEN

MATERIAL ~ ASTM-A36
RIVETS OR BOLTS ~
OPEN HOLES ~ 15/16"ø
A325 FIELD BOLTS ~
SHOP CONTACT SURFACES ~ NO PAINT
WELD - AS NOTED
PAINT ~ 1 Coat IT-P 615d Type ... (DN - See Note "X"

NO.	DATE	INIT.
0		
9		
8		
7		
6		
5		
4		
3		
2		
1		

REVISION

SUBMITTAL	1	2	3	4	5	6	7	8	9	0
DATE										

CUSTOMER
TENNESSEE DEPT. OF HIGHWAYS
ARKANSAS STATE HIGHWAY COMMISSION
STRUCTURE
EAST APPROACH - M.&S. RIVER BRIDGE
PROJ. I-40-1(17)0 - MEMPHIS - TENN.

BETHLEHEM STEEL CORPORATION
FABRICATED STEEL CONSTRUCTION

CHICAGO DRAFTING ROOM LEETSDALE WORKS
MADE BY LT2J DATE 2-4-71 IN CHARGE F.J.K.
CHECKED BY LE DATE 2/26/71 SHOP NO.

CONTRACT CE-6472-000 DRAWING NO. 436

35435 (Rev. A 1-65)

For location of details shown on this sheet refer to diagrams.

E402

MICROFILMED

11-48-47

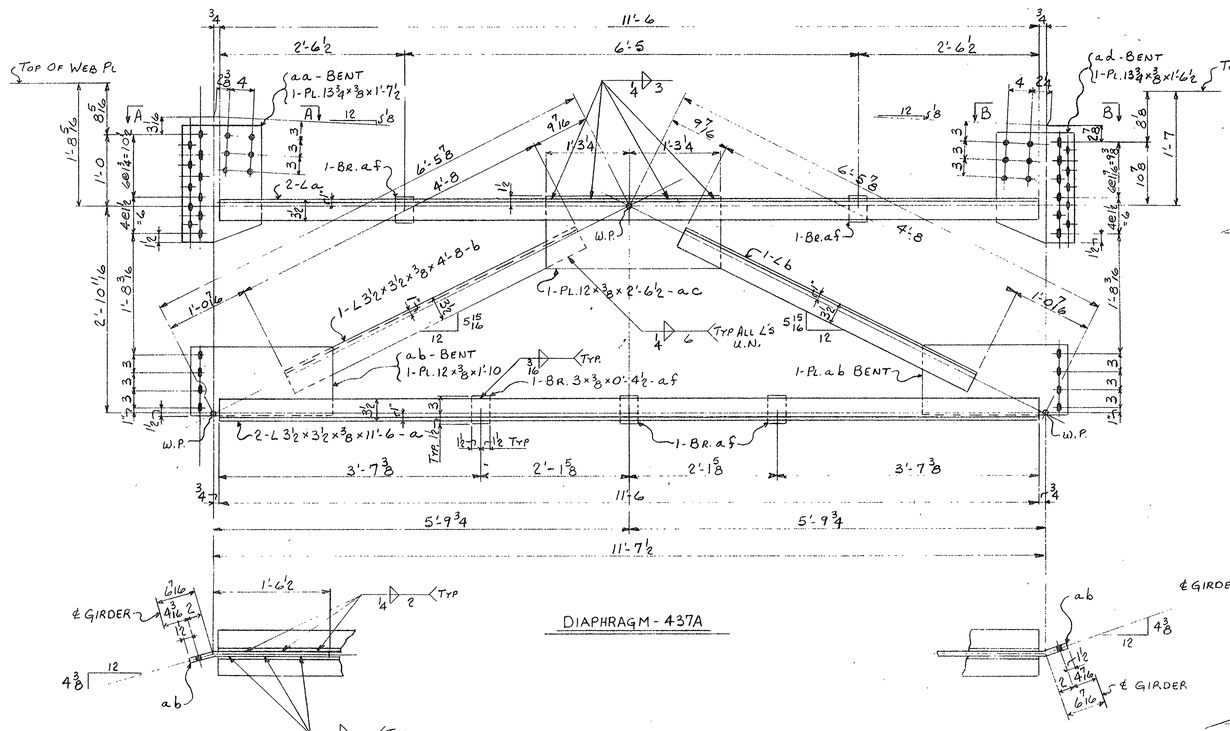

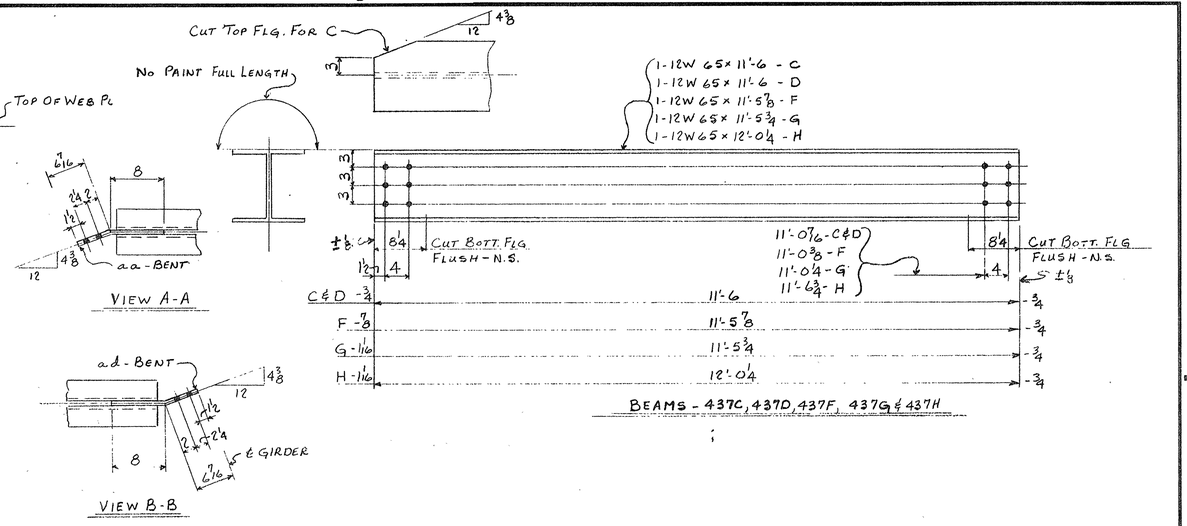

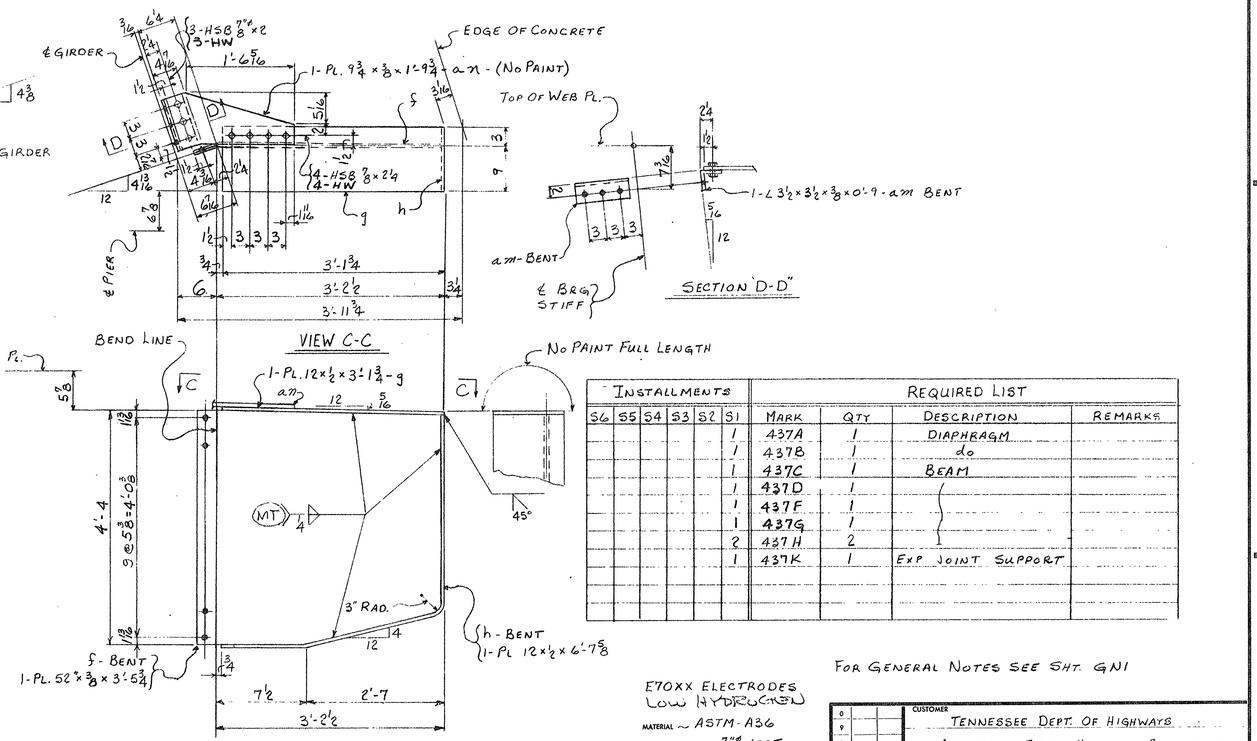

INSTALLMENTS						REQUIRED LIST			
S6	S5	S4	S3	S2	S1	MARK	QTY	DESCRIPTION	REMARKS
					1	437A	1	DIAPHRAGM	
					1	437B	1	do	
					1	437C	1	BEAM	
					1	437D	1		
					1	437F	1		
					1	437G	1		
					2	437H	2		
					1	437K	1	EXP. JOINT SUPPORT	

FOR GENERAL NOTES SEE SHT. GN1

E70XX ELECTRODES
LOW HYDROGEN

MATERIAL ~ ASTM-A36
RIVETS OR BOLTS 7/8" A325
OPEN HOLES ~ 15/16"ø
A325 FIELD BOLTS ~
SHOP CONTACT SURFACES ~ NO PAINT
WELD ~ AS NOTED
PAINT ~ 1 Coat IOZ Std type U.N. See Note M1.

Blast clean and paint for a distance of 3" from the

SUBMITTAL	1	2	3	4	5	6	7	8	9	0
DATE										

NO.	DATE	INIT.	REVISION
0			
9			
8			
7			
6			
5			
4			
3			
2			
1			

CUSTOMER TENNESSEE DEPT. OF HIGHWAYS
ARKANSAS STATE HIGHWAY COMMISSION
STRUCTURE EAST APPROACH - MISS RIVER BRIDGE
PROJ. I-40-1(116)0 - MEMPHIS - TENN.

BETHLEHEM STEEL CORPORATION
FABRICATED STEEL CONSTRUCTION

CHICAGO DRAFTING ROOM LEETSDALE WORKS
MADE BY LTW DATE 1-28-71 IN CHARGE F.J.K.
CHECKED BY LE DATE 2/23/71 SHOP NO.
CONTRACT CE 6472-000 DRAWING NO. 437

For location of details shown on this sheet refer to diagrams

E402

M-48-48

MICROFILMED

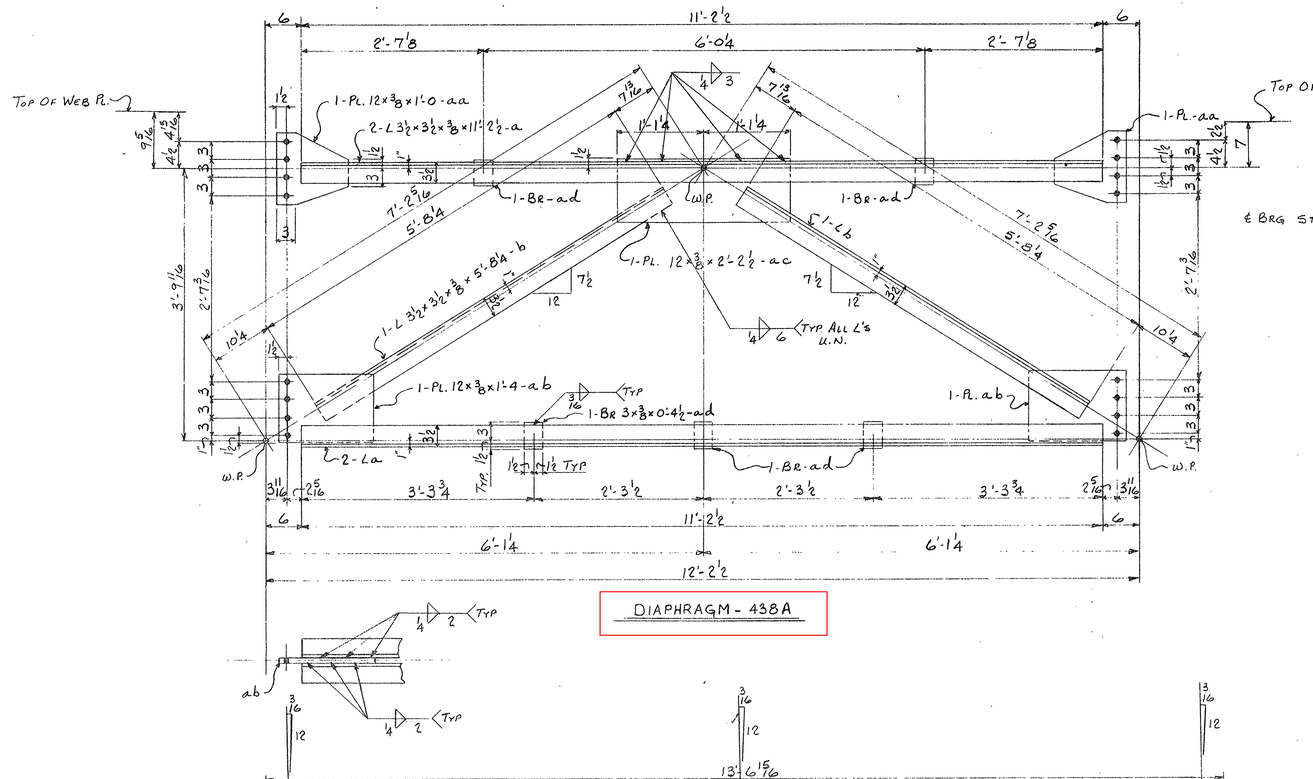

DIAPHRAGM - 438A

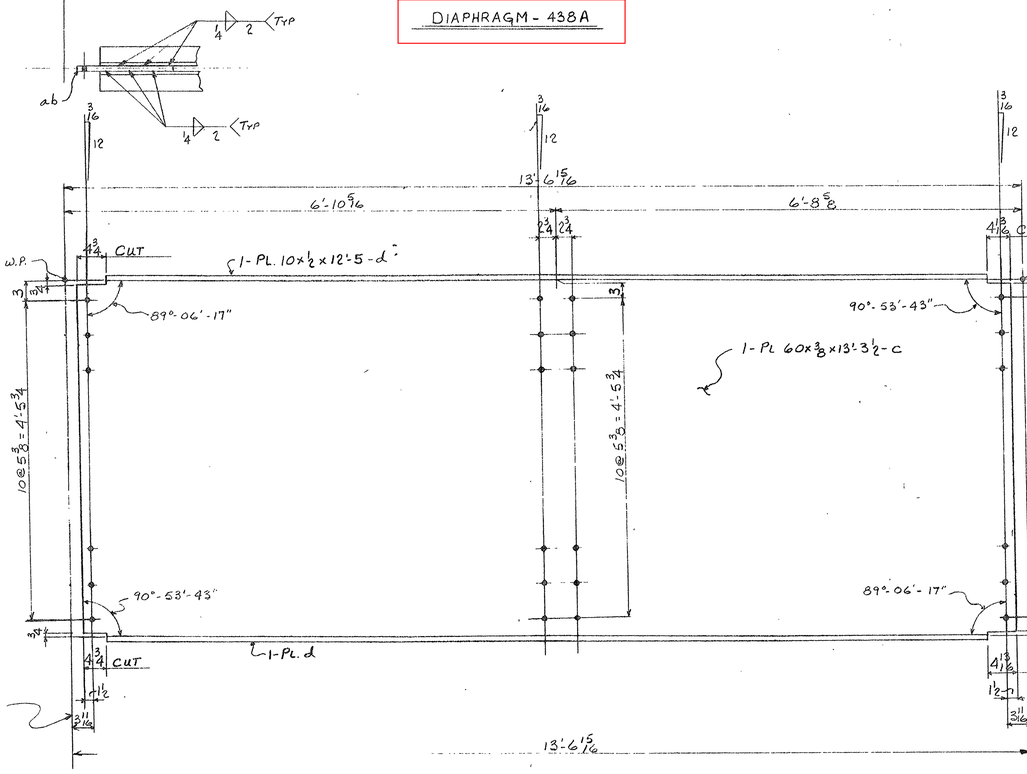

DIAPHRAGM - 438B

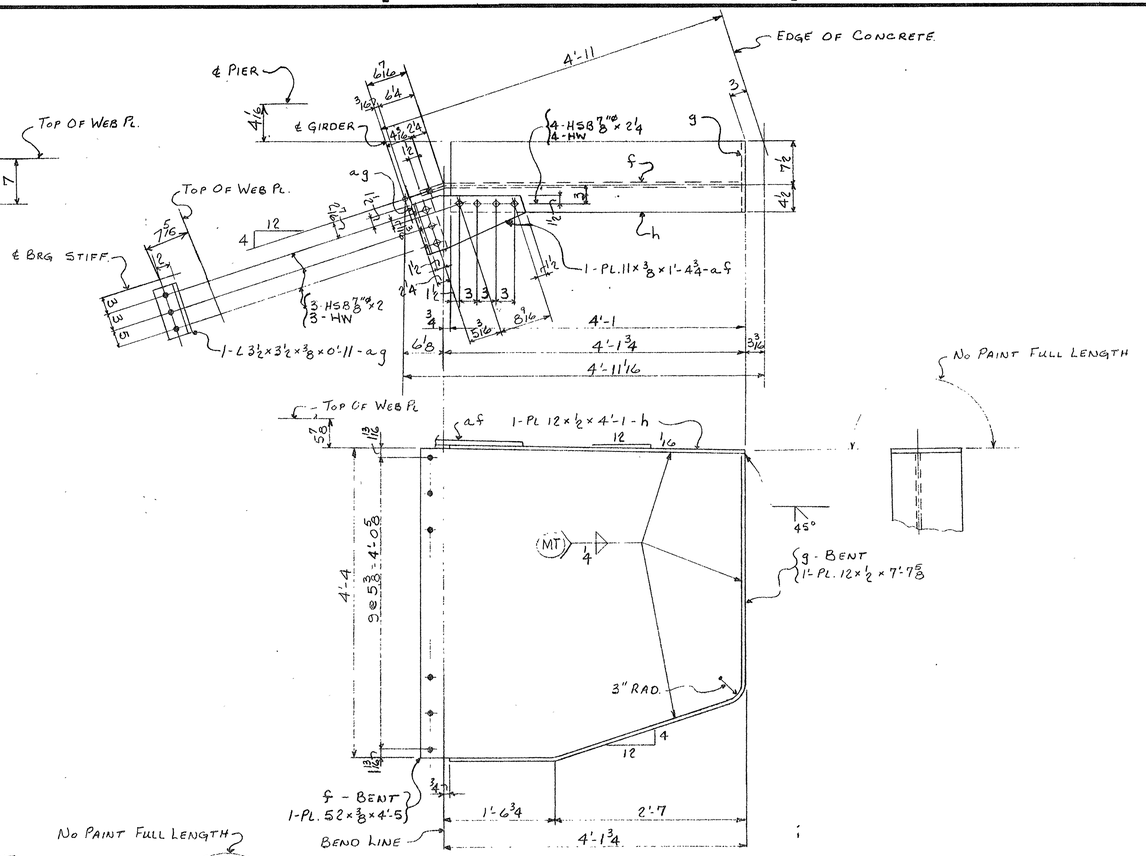

EXPANSION JOINT SUPPORT - 438C

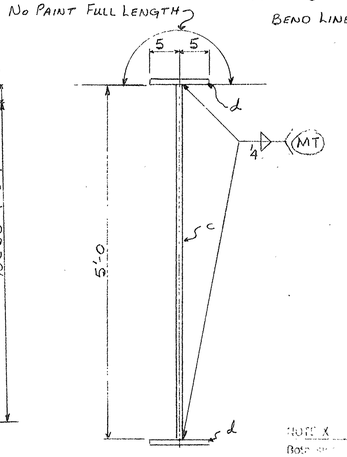

INSTALLMENTS						REQUIRED LIST			
S6	S5	S4	S3	S2	S1	MARK	QTY.	DESCRIPTION	REMARKS
				1		438A	1	DIAPHRAGM	
				1		438B	1	do	
					1	438C	1	EXP JOINT SUPPORT	

NOTE X
Base metal under the [illegible] to be welded shall be preheated to a minimum temperature of 300° F. for a distance of 3 inches from the point of welding.

E70XX ELECTRODES
LOW HYDROGEN

MATERIAL ~ ASTM - A36
RIVETS OR BOLTS ~ 7/8" A325
OPEN HOLES ~ 15/16"
A325 FIELD BOLTS ~
SHOP CONTACT SURFACES ~ NO PAINT
WELD ~ AS NOTED
PAINT ~ 1 Coat Zinc Rich Type II (A.N. 5 See Note "X")

FOR GENERAL NOTES SEE SHT. GN1

For location of details shown on this sheet refer to diagrams
E432

SUBMITTAL	1	2	3	4	5	6	7	8	9	0
DATE										

NO	DATE	INIT.
REVISION		

CUSTOMER TENNESSEE DEPT OF HIGHWAYS
ARKANSAS STATE HIGHWAY COMMISION
STRUCTURE EAST APPROACH - MISS RIVER BRIDGE
PROJ I40-1(116)0 - MEMPHIS TENN.

BETHLEHEM STEEL CORPORATION
FABRICATED STEEL CONSTRUCTION

CHICAGO DRAFTING ROOM _____ LEETSDALE WORKS
MADE BY LTZJ DATE _____ IN CHARGE FJK
CHECKED BY LE DATE 2/23/71 SHOP NO. _____
CONTRACT CE6472-000 DRAWING NO. 438

26663 (1-68)

11-18-69

MICROFILMED

328'-6 32/32 E/L BRG ON GRADE

6 Spas. @ 23'-6 7/8 = 141'-5 4

Diaphragm Line See Section AB

SEE DETAIL T (DWG E504)

330'-0 32/32 E/L BRG ON GRADE

SEE DETAIL S DWG E504

Continued on Sh E503

GA1 GA2 GA3 GA4

NORTH GIRDER INST. G1A ; SOUTH GIRDER INST. G1B

FLOORBEAM & BRACING INST. G1C

STRINGER & STRINGER DIAPHRAGM INST. G1S

NORTH GIRDER INST. G2A ; SOUTH GIRDER INST. G2B

FLOORBEAM & BRACING INST. G2C

STRINGER & STRINGER DIAPHRAGM INST. G2S

FRAMING PLAN

SPAN W28

FLOORBEAM & BRACING INST. G1C

SPAN W29

FLOORBEAM & BRACING INST. G2C

12 Spas. @ 23'-6 7/8 = 282'-10 1/2

12 Spas. @ 23'-6 7/8 = 282'-10 1/2

LATERAL BRACING PLAN

"ERECTOR NOTE"

SLOTTED HOLES HAVE BEEN PROVIDED IN STRINGER BOTTOM FLANGE FOR CONNECTION TO FLOOR BEAMS & EXTENSIONS AT PIER 28. TORQUE A325 (HIGH STRENGTH BOLTS) FULLY WITH ONE WASHER UNDER NUT AND ONE WASHER UNDER HEAD AFTER EXPANSION DAM HAS BEEN SET AND CONCRETE DECK HAS BEEN POURED.

SECTION AA

Diaphragm placement (As shown) Typ.

NOTE:
A325 BOLTS FINGER TIGHTENED IN SHOP. TORQUE FULLY IN FIELD AFTER FULL BEARING AGAINST THE GRD WEB. TO OBTAIN THIS BEARING IT MAY BE NECESSARY TO ADJUST THESE PLATES LATERALLY.

519D3R for Pier W28 519D1 for Others

519D3L for Pier W28 519D1 for Others

519S5 for Pier W28 519S2 for Others

PIER W28 - 519S1
PIERS W29, W30, W31, W32 - 519S3
PIER A - 519S4

Section BB

A325 (HIGH STRENGTH BOLTS) FINGER TIGHTENED BY SHOP. TORQUE FULLY IN FIELD

SECTION - CC
(Typical Stringer Splice)

5 A307 MACH. BOLT (SHOP)

A325 H.S. BOLT (FIELD) (2 - DIAGONALLY ACROSS)

TYPICAL CONNECTION

Section D

Section K

SIGN POST SUPPORTS

Note: For Section DD See Sh E503

TENNESSEE DEPT. OF HIGHWAYS
ARKANSAS STATE HIGHWAY COMMISSION
MISSISSIPPI RIVER BRIDGE - PROJ. I-10 (103)0
MEMPHIS - TENNESSEE
BETHLEHEM STEEL CORPORATION

Detailed Macko

SHEET 004 of 100 DRAWING NO. E 502

11-30-9

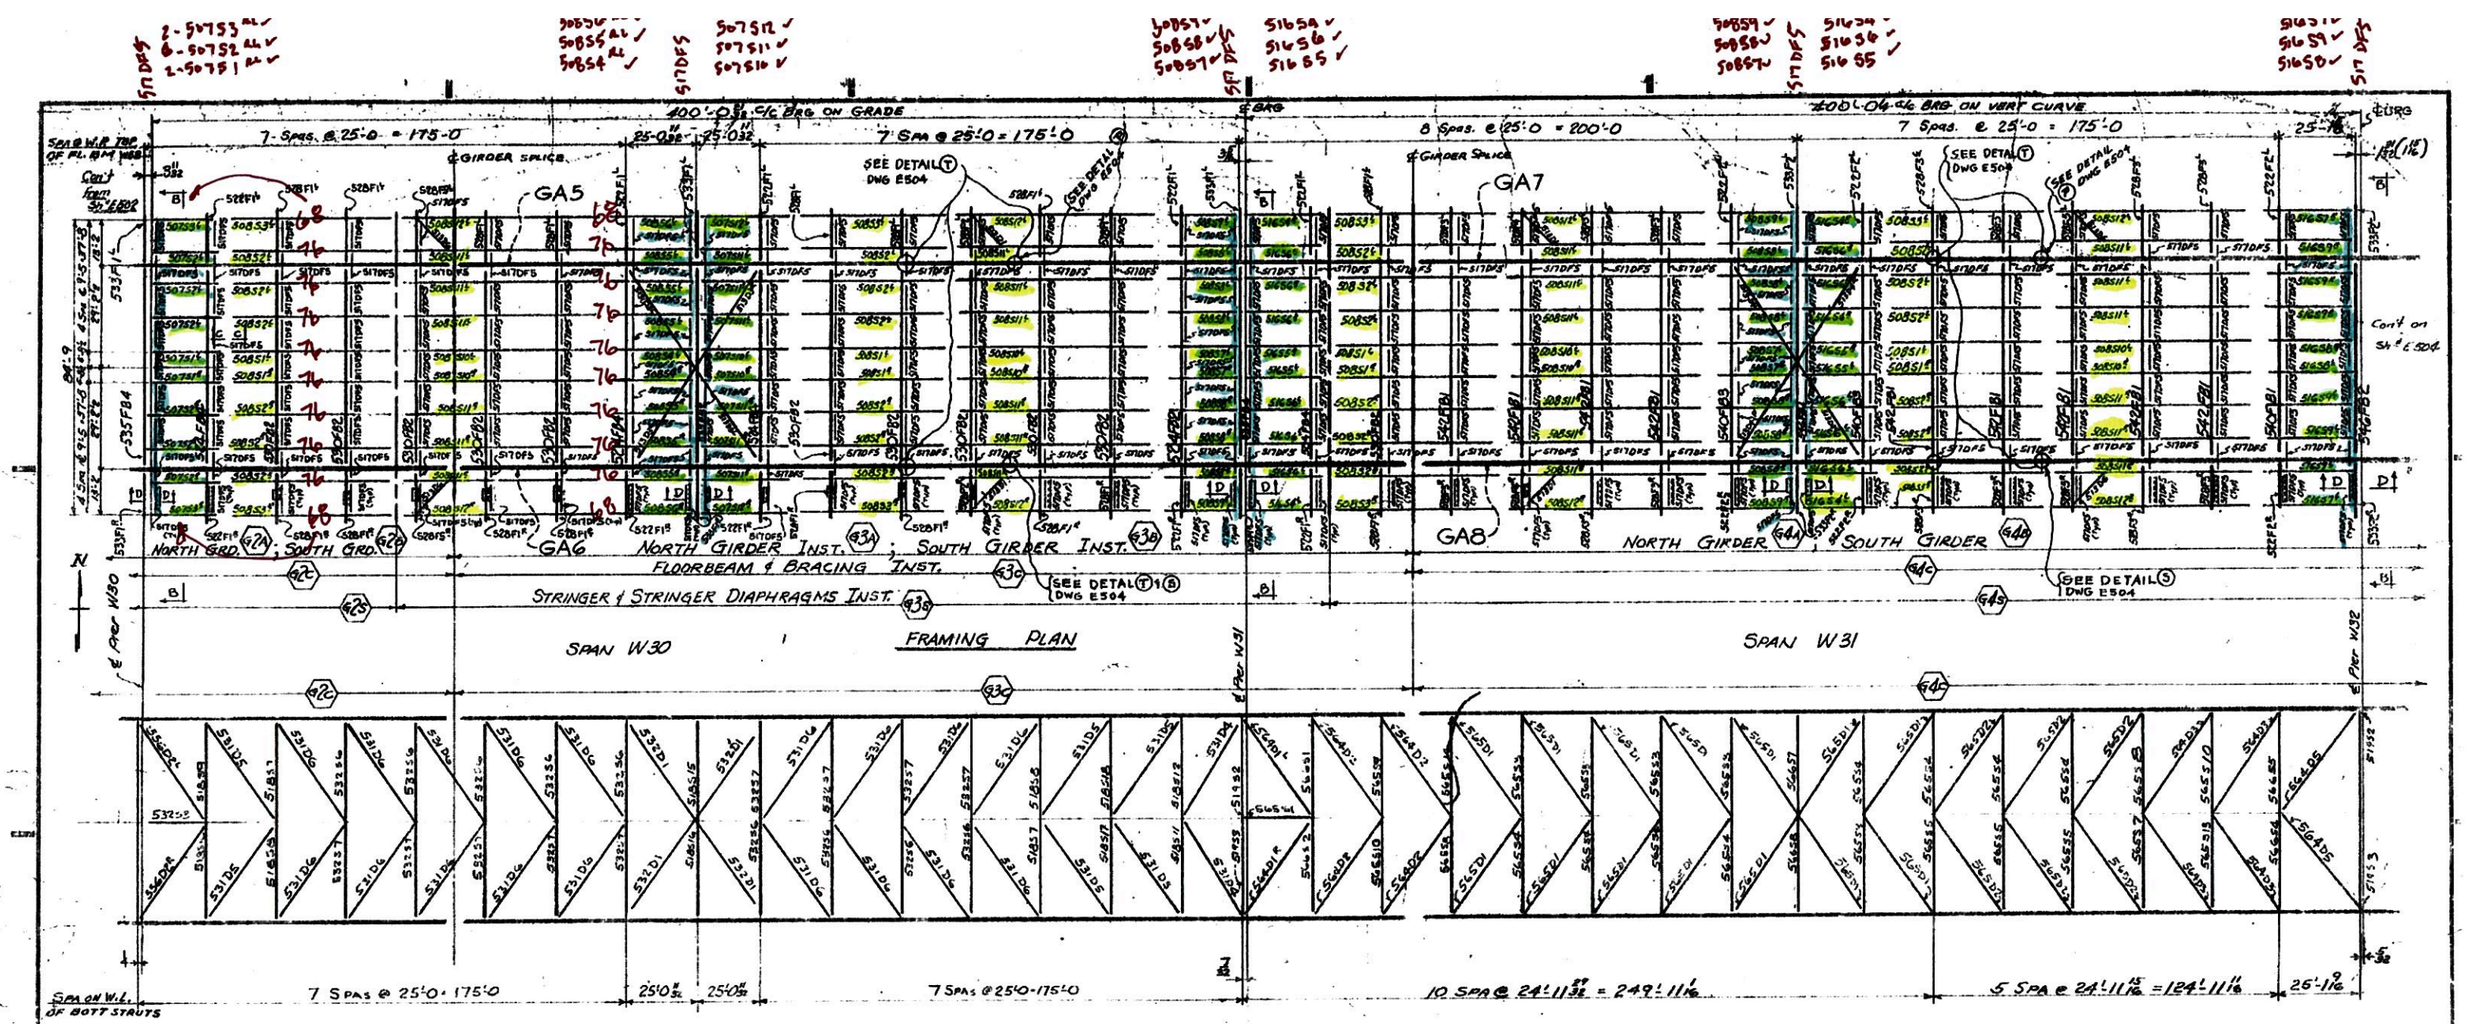

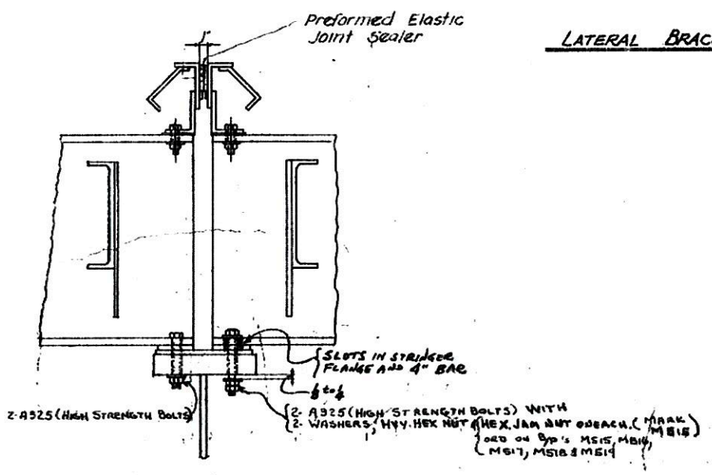

SECTION D-D

LATERAL BRACING PLAN

Note
For Section B-B See Dwg E502

TENNESSEE DEPT OF HIGHWAYS
ARKANSAS STATE HIGHWAY COMMISSION
MISSISSIPPI RIVER BRIDGE - PROJ. I-40 (103)0
MEMPHIS - TENNESSEE
BETHLEHEM STEEL CORPORATION
DESIGNED BY Leetsdale
DRAWN BY AM DATE 8-2-69 CHECKED Hicks
CHECKED BY JS DATE 9/30/70 SHOP NO.
CONTRACT NO. 6289/180 DRAWING NO. E503

M-50-10

1. BURN OFF HITCH PLS PARALLEL TO AND APPROXIMATELY ¼" CLEAR OF GIRDER FLANGE.
2. REMOVE REMAINDER OF HITCH PL MATERIAL & WELD METAL BY GRINDING IN A LONGITUDINAL DIRECTION TO ACHIEVE A SMOOTH SURFACE FLUSH WITH BASE METAL.
3. GRINDING TO BE DONE CAREFULLY SO AS TO AVOID GOUGING OR GRINDING INTO THE FLANGE MATERIAL.

DETAIL Ⓣ
(HITCH PL REMOVAL.)

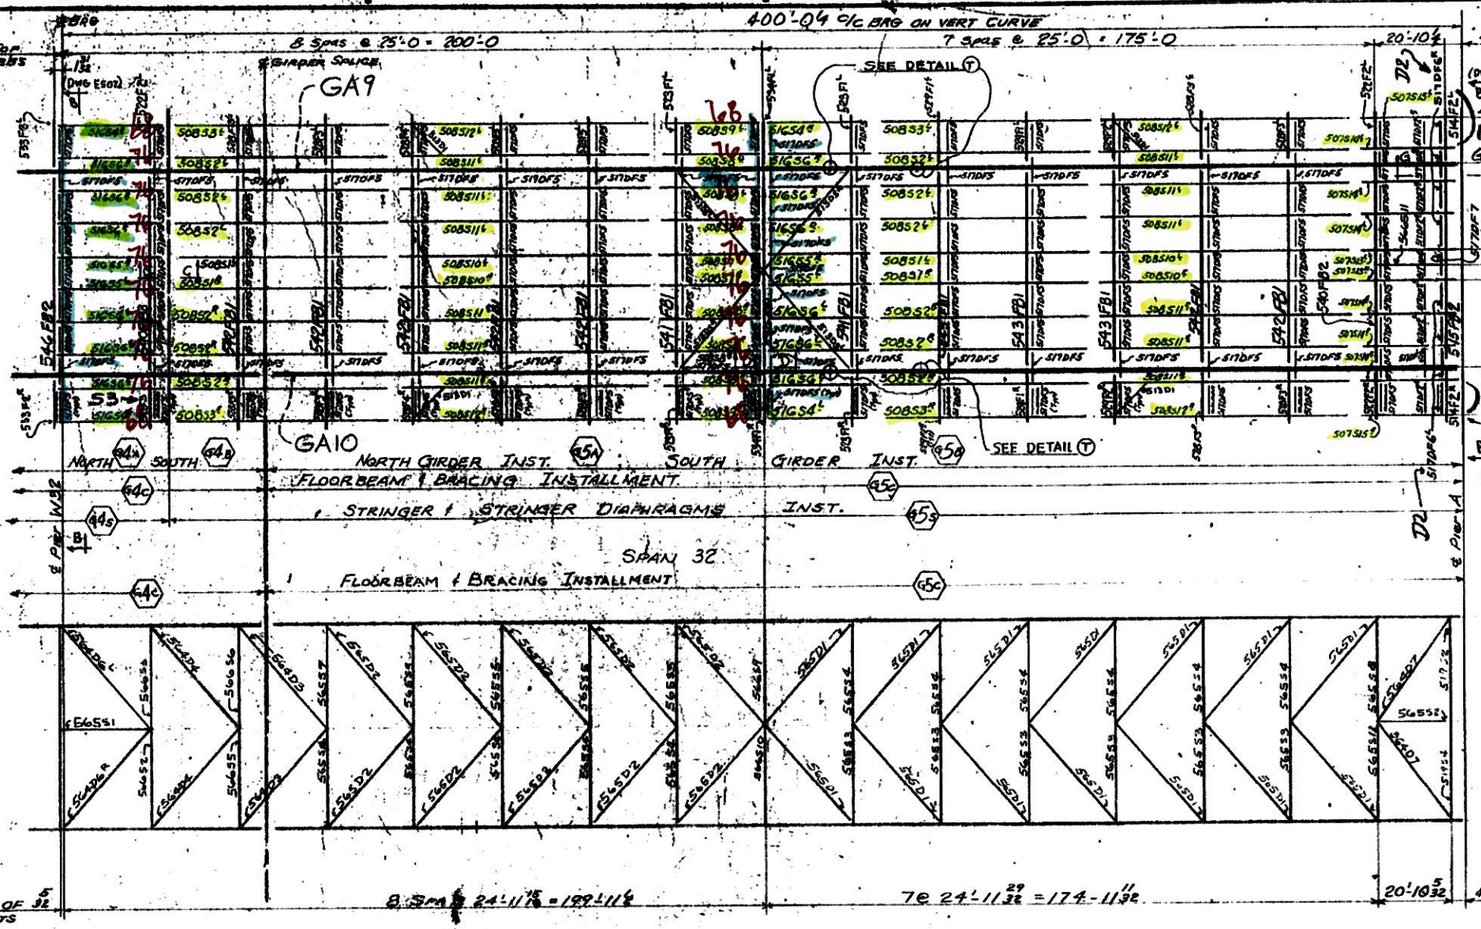

LATERAL BRACING PLAN

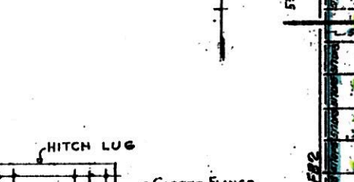

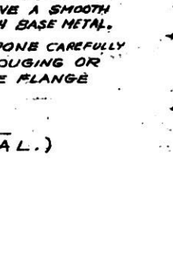

SECTION - GG

DETAIL - P
ROTATION OF FILLS ON TOP FLG. OF NORTH GIRDER AFTER REMOVAL OF LATERAL BRGS.

DETAIL - S
ROTATION OF FILLS ON TOP FLG. OF SOUTH GIRDER AFTER REMOVAL OF LATERAL BRG.

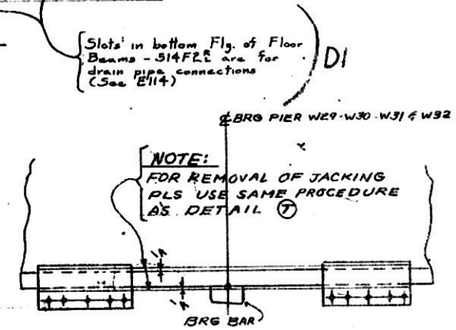

DETAIL - AA
(JACKING PLATES) NORTH & SOUTH GRD

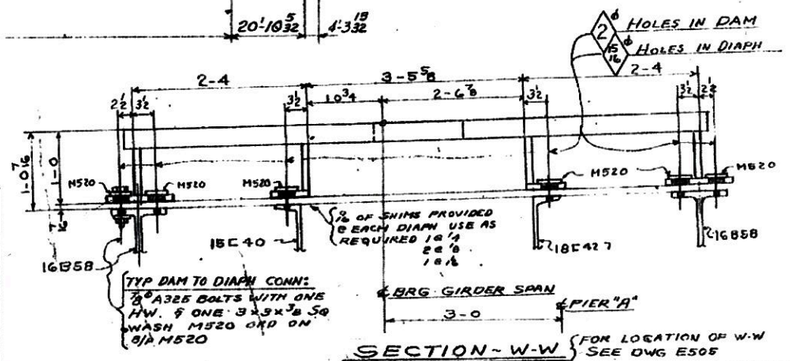

SECTION - W-W {FOR LOCATION OF W-W SEE DWG E505

TENNESSEE DEPT OF HIGHWAYS
ARKANSAS STATE HIGHWAY COMMISSION
MISSISSIPPI RIVER BRIDGE P-20 I-40 (103)9
MEMPHIS TENNESSEE
BETHLEHEM STEEL CORPORATION
FABRICATED STEEL CONSTRUCTION
DETAILED DRAWN BY Leetsdale
CHECKED BY JS DATE 4/23/70 SHOP NO
CONTRACT CE6269-110 DRAWING NO E504

50-11

STRINGER - 507S1E, 507S2E, 507S10E, 507S11E

STRINGER - 507S3E, 507S12E

STRINGER - 507S13E, 507S14E, 507S15E

SECTION A-A

SECTION B-B

SECTION C-C

PAY ITEM 602-04.01

INST.	REQUIRED LIST					
	NO.	DESCRIPTION	MARK	REMARKS
	1	STRINGER (24'-2 7/32")	507S12E	
	1	(4) (do)	507S3E	Ord. Ho.
	3	(4) (do)	507S3E	
	3	(4) (do)	507S3E	Ord. Ho.
	1	(4) (do)	507S3E	
	1	(4) (24'-12 3/32")	507S3E	
	1	(4) (do)	507S3E	Ord. Ho.
	1	STRINGER (27'-6")	507S10E	
	1	(4) (do)	507S10E	Ord. Ho.
	3	(4) (do)	507S11E	
	3	(4) (do)	507S11E	Ord. Ho.
	1	(4) (24'-12 3/32")	507S12E	
	1	(4) (do)	507S12E	Ord. Ho.
	1	(4) (24'-9 27/64")	507S13E	
	1	(4) (do)	507S13E	Ord. Ho.
	3	(4) (do)	507S14E	
	3	(4) (do)	507S14E	Ord. Ho.
	1	(4) (do)	507S15E	
	1	(4) (do)	507S15E	Ord. Ho.

BOTH SIDES OF MATERIAL ADJACENT TO ALL OPEN HOLES MUST BE FREE OF BURRS, LOOSE SCALE AND PAINT FOR A DISTANCE OF 3 INCHES FROM THE EDGE OF HOLE.

| SHOP BILL | | | | |

STRINGER - 508S9¹, 508S8², 508S3²

STRINGER - 508S10¹, 508S11², 508S12²

STRINGER - 508S6², 508S7²

STRINGER - 508S4¹, 508S5², 508S7², 508S8²

SECTION A-A

SECTION B-B

SECTION C-C

Notes:
For Workmanship Notes See Dwg. N501
Holes Marked (RFT) Shall be Drilled Full Size in a Metal Template.

INST.						DESCRIPTION	MARK	
2	2	1	1	1	G	STRINGER(24#×68'-6")	508S9¹	
2	2	1	1	1	G	do (do)	508S8²	
6	6	3	3	3	18	do (do)	508S2²	
6	6	3	3	3	18	do (do)	508S3²	
2	2	1	1	1	G	do (do)	508S6²	
2	2	1	1	1	7	do (do)	508S7²	
			1		1	STRINGER(24#×68'-3")	508S4¹	
			1		1	do (do)	508S5²	

INST.						DESCRIPTION	MARK	REMARKS
1	1	1	1	1	3	STRINGER(24#×68'-2")	508S7¹	
1	1	1	1	1	3	do	508S9²	Ord. Ho
1	1	2	2	2	G	STRINGER(24#×68'-0")	508S10¹	
1	1	2	2	2	G	do (do)	508S12²	Ord. Ho
6	6	18	18	18	18	do (do)	508S11²	
1	1	18	18	18	18	do (do)	508S12²	Ord. Ho
1	1	2	2	2	G	do (24#×72'-7.5")	508S12²	
1	1	2	2	2	G	do (do)	508S12²	Ord. Ho

BOTH SIDES OF MATERIAL ADJACENT TO ALL OPEN HOLES MUST BE FREE OF BURRS, LOOSE SCALE AND PAINT FOR A DISTANCE OF 3 INCHES FROM THE EDGE OF HOLES.

SHOP BILL														FIELD ORDER	
PIECE MARK	ASSEMBLY MARK	NO	GRADE	LENGTH	WEIGHT EACH PIECE	WEIGHT SHOP	LENGTH FT	LENGTH IN	REMARKS	LENGTH FT	LENGTH IN	PIECES	TOTAL
1		60 STRINGERS - 1-508S1¹ & 508S8², 8-508S2² & 508S9², 508S3², 508S6², 508S7²											
2	a²	96	B	24	68		62	5⅜					
4	c507	96	BR	7½		⅜	1	5	508S2				
5	d507	96	BR	7½		⅜	1	5	508S3				
6	f507	24	BR	7½		⅜	1	5	508S1				
7	g507	240	BR	3½		⅜	1	7					
8	h507	180	PLU	19½		⅜	1	1					
9	k507	120	PLU	9		⅜	1	7					
10	an507	120	PL	9		⅜	1	1½					
11	as508	96	STP	3½		⅛	0	9⅛	508S1², 508S2²				
12	at508	48	STP	9		⅛	0	9⅛	508S1², 508S2²				
13													
14		240	MB			⅜	0	2	A307 RHN-RHN - Ord on ⅜ A58 501				
15		1560	325			⅜	0	2½	Ord on ⅜ A58H 504				
16		1520	HW	1 3/8	15/16	3/16							
18	FW	48	WD			¼	11	9	508S1², 508S2²				
19	FW	12	WD			¼	5	8	508S3², 508S6²				
20	TW	48	WD			⅛	2	0					
21		8 STRINGERS - 1-508S6² & 508S8², 3-508S2², 3-508S9²											
22													
23	b²	1	B	24	68		31	2⅜	FOR 508S6				
24	c²	3	B	24	68		31	11⅛	FOR 508S1				
25	an507	8	PL	9		⅜	1	1½					
26	c507	16	BR	7½		⅜	1	5					
27	an508	8	STP	4		⅛	1	0	4 (TW)				
28	an-at8	8	BR	4		⅛	0	0	9				
29	TW	8	WD			⅛	0	0	8				
30		16	MB			⅜	0	0	2 A307 RHN-RHN Ord on ⅜ A-38 501				
31	FW	8	WD			¼	0	6	5				
32	B45	8	WD			5/16	0	9					
34		60 STRINGERS - 1-508S10¹ & 508S11², 1-508S12², 8-508S4¹ & 508S5², 8-508S7² & 508S8²											
35	f²	24	B	24	68		74	11⅞					
36	c507	144	BR	7½		⅜	1	5	2-508S11				
37	d507	144	BR	7½		⅜	1	5	2-508S10				
38	f507	36	BR	7½		⅜	1	5	508S10				
39	g507	240	BR	3½		⅜	1	7					
40	h507	120	PLU	19½		⅜	1	1					
41	k507	120	PLU	9		⅜	1	7					
42	an507	120	PL	9		⅜	1	1½					
43	as508	96	STP	3½		⅛	0	9⅛	508S10², 508S11²				
44	at508	48	STP	9		⅛	0	9⅛	508S10², 508S11²				
45													
46		360	MB			⅜	0	2	ORD ON ⅜ A58 501				
47		576	325			⅜	0	2¾	12-508S11 12-508S12				
48		1584	325			⅜	0	2½	28-508S10 28-508S11 & 508S12				
49		1320	HW	1 3/8	15/16	5/16			ORD ON ⅜ A58H 504				
50	FW	48	WD			¼	17	0	508S10², 508S11²				
51	FW	12	WD			¼	8	6	508S12²				
52		32 STRINGERS - A 508S9² - 1-508S4¹ - 3-508S7¹ - 3-508S7²											
53		3-508S6² - 9-508S5² - 9-508S8² - 9-508S8¹											
54	f²	24	B	24	76		31	2⅜	508S4, 508S5				
55	f²	24	B	24	76		31	11⅛	508S7, 508S6				
56	f507	16	BR	7½		⅜	1	5	2-508S4 & 508S7				
57	c507	48	BR	7½		⅜	1	5	2-508S5 & 508S8				
58	f507	64	BR	7½		⅜	1	5					
60	an508	32	BR	4		⅛	0	4					
61	an507	32	PL	9		⅜	1	1½					
62													
63													
64		68	MB			⅜	0	2½	ADD RHN-RHN (A307) Ord on ⅜ A58 501				
65	FW	32	WD			¼	12	1					
66	B45	32	WD			5/16	0	9					

STRINGER DETAILS

TENNESSEE DEPT OF HIGHWAYS
ARKANSAS STATE HIGHWAY COMMISSION
MISSISSIPPI RIVER BRIDGE - PROJ. I-40 (10)10
MEMPHIS - TENNESSEE

BETHLEHEM STEEL CORPORATION
FABRICATED STEEL CONSTRUCTION

LAYOUT DRAWING ROOM 1 FEET SCALE
MADE BY ER DATE 9/26/69 IN CHARGE PACKO
CHECKED BY JTS DATE 11/24/69 SHOP NO.
CONTRACT DE 6269-120 DRAWING NO. X 508

MICROFILMED

A 323 / E804

11-50-30

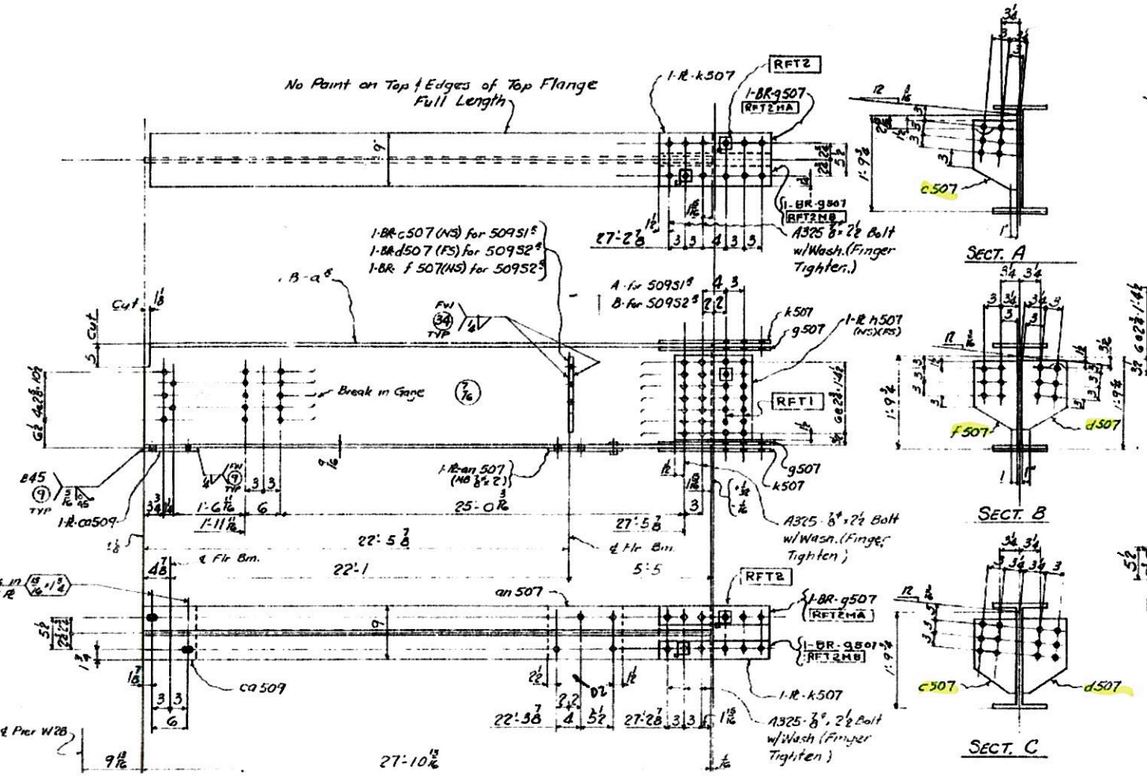

STRINGERS - 50951R, L 50952R, L

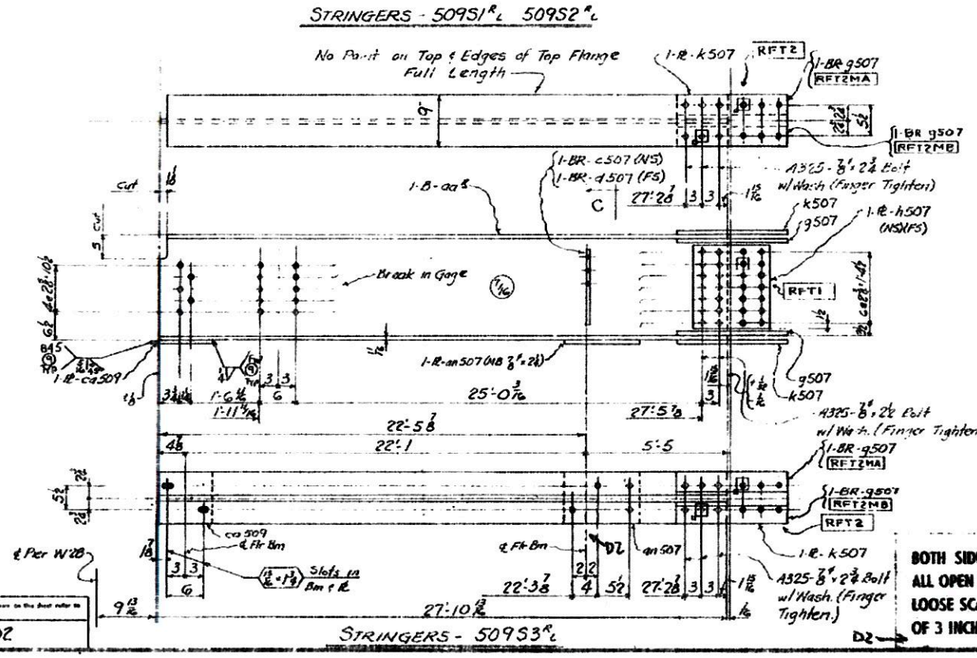

STRINGERS - 50953R, L

BOTH SIDES OF MATERIAL ADJACENT TO ALL OPEN HOLES MUST BE FREE OF BURRS, LOOSE SCALE AND PAINT, FOR A DISTANCE OF 3 INCHES FROM THE GROUP OF HOLES.

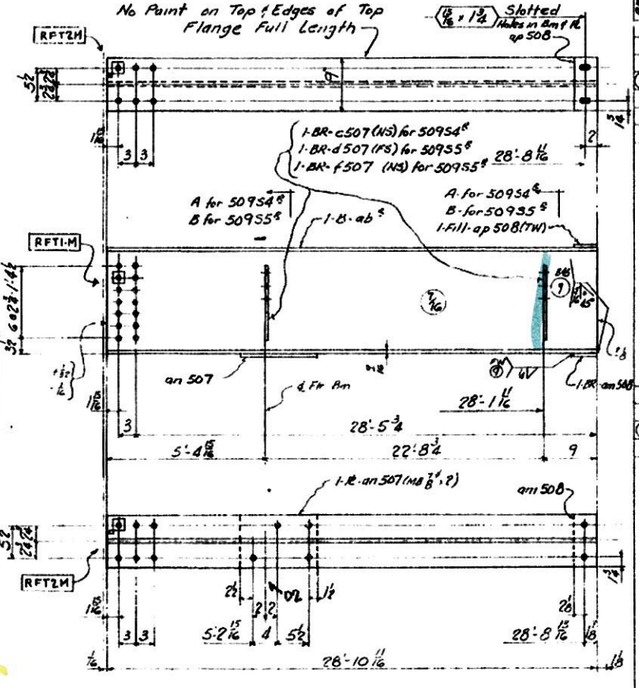

STRINGER - 50954R, L - 50955R, L

Notes:
For Workmanship Notes See Dwg. N501
Holes Marked RFT shall be Drilled Full Size to a Metal Template.
CONNECTIONS TAKING ONLY PART OF THE WHOLE TEMPLATE ARE MARKED RFT1M & RFT2M "M" DENOTING MODIFIED.

Pay Item 602-04.01

INST.				REQUIRED LIST			
		aa	ab	NO	DESCRIPTION	MARK	REMARKS
			1	1	STRINGER (24'-11"-28'-0")	50951R	
			1	1	(L)	50951L	Opp Ha
			1	1	STRINGER (24'-11"-28'-0")	50952R	
			1	1	(L)	50952L	Opp Ha
			3	3	(L)	50953R	
			3	3	(L)	50953L	Opp Ha
			1	2	STRINGER (24'-11"-28'-11")	50954R	
			1	2	(L)	50954L	Opp Ha
			1	2	STRINGER (24'-11"-28'-11")	50955R	
			1	2	(L)	50955L	Opp Ha

SHOP BILL

ASSEMBLY MARK	NO	SHAPE	SECTION SIZE	SECTION SEE OF FORMS	LENGTH	FT	IN	REMARKS
4 - STRINGER - 50951R - 50951L - 50952R - 50952L								
aa R&L	2	B	24	GB		27	10½	
ca509	4	PL	9		⅜	0	9¾	
an507	4	PL	9		⅜	1	1½	
c507	2	BR	7½		⅜	1	5	for 50951L
f507	2	BR	7½		⅜	1	5	for 50952L
k507	8	PLU	9		⅜	1	7	
g507	16	BR	3½		⅜	1	7	
h507	8	PLU	19½		⅜	1	1	
d507	2	BR	7½		⅜	1	5	for 50952R
FW	2	WD			¼	6	5	for 50952L
FW	2	WD			¼	3	7	for 50951R
845	4	WD			5/16	0	9	
	104	325			⅞"	0	2½	Ord on 3/8 A588H 504
	8	MB			⅞"	0	2	RHH, RHN (A307) Ord on 3/8 A36 501
	104	HN	1⅛"	15/16	3/16			Ord on 3/8 A588H 504
6 - STRINGER - 50953R - 50953L								
aa R&L	3	B	24	7G		27	10½	
ca509	6	PL	9		⅜	0	9¾	
an507	6	PL	9		⅜	1	1½	
d507	6	BR	7½		⅜	1	5	
k507	12	PLU	9		⅜	1	7	
g507	24	BR	3½		⅜	1	7	
h507	12	PLU	19½		⅜	1	1	
c507	6	BR	7½		⅜	1	5	
FW	6	WD			¼	6	5	
845	6	WD			5/16	0	9	
	12	MB			⅞"	0	2½	RHH, RHN (A307) Ord on 3/8 A36 501
	72	325			⅞"	0	2½	Ord on 3/8 A588H 504
	84	325			⅞"	0	2½	Ord on 3/8 A588H 504
	154	HN	1⅛"	15/16	3/16			
8 - STRINGER - 50954R, L - 50955R, L								
qb ℄	4	B	24	GB		28	10½	
ap508	8	STP	4		⅛	0	9	(TW)
an507	8	PL	9		⅜	1	1½	
am508	8	PP	4		⅜	0	9	
c507	8	BR	7½		⅜	1	5	for 50954
d507	8	BR	7½		⅜	1	5	for 50955
f507	8	BR	7½		⅜	1	5	for 50955R
FW	4	WD			¼	12	1	for 50955R
FW	4	WD			¼	6	5	for 50954L
845	8	WD			5/16	0	9	
	16	MB			⅞"	0	2	RHH, RHN (A307) Ord on 3/8 A36 501
TW	8	WD			⅛	0	8	

STRINGER DETAIL

MATERIAL - ASTM A36
WORKING HOLES - ⅞"
OPEN HOLES - 13/16" (U.N.)
SHOP CONTACT SURFACES - No PAINT
WELD - AS NOTED
PAINT - AS PER SPECS.

CUSTOMER: TENNESSEE DEP'T OF HIGHWAYS
STRUCTURE: ARKANSAS STATE HIGHWAY COMMISSION
MISSISSIPPI RIVER BRIDGE - PROJ. I-40 (103)0
MEMPHIS - TENNESSEE
BETHLEHEM STEEL CORPORATION
FABRICATED STEEL CONSTRUCTION
LOCATION OF DRAWING ROOM: Leetsdale WORKS
MADE BY: AMS DATE: 11/24/69 IN CHARGE: Macko
CHECKED BY: JJ DATE: 11/24/69 SHOP NO.:
CONTRACT: CE 6269-120 DRAWING NO: 509

M-30-31

For location of details shown on this sheet refer to diagrams
E-502

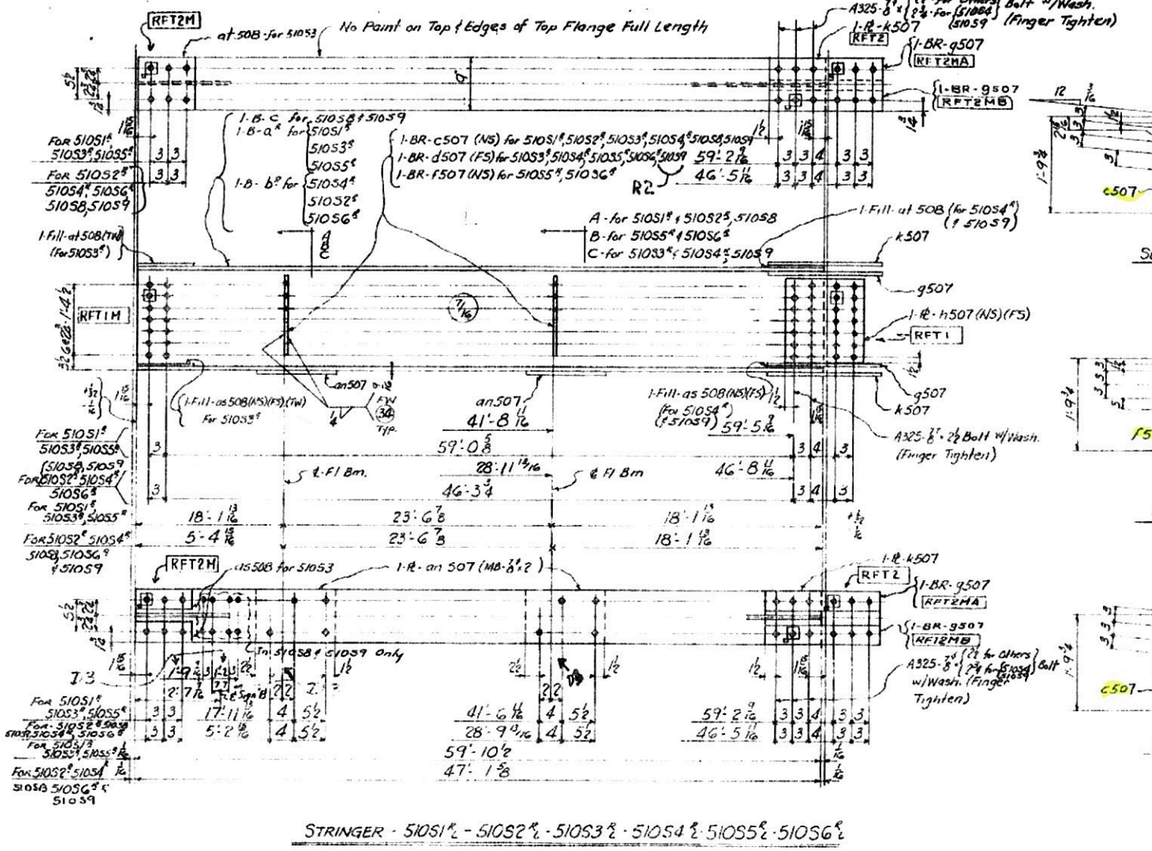

STRINGER - 51051℄ - 51052℄ - 51053℄ - 51054℄ 51055℄ - 51056℄
(do) - 51058 & 51059 (Opp to Sketch)

PAY ITEM 602-04.01

qds	q	s				
2	2	4	STRINGERS (do 12'-6 0")	51051		
2	2	4	(do) (24'-7" to 7")	51051	Opp Ho.	
2	2	4	(do) (24'-7" to 48'-0")	51052		
1	2	3	(ds) (24'-7" to 48'-0")	51052	Opp Ho.	
6	6	12	(db) (24'-1" to 7")	51053		
6	6	12	(do) (24'-1" to 46'-1")	51053	Opp Ho.	
6	6	12	(d) (24'-1" to 48'-0")	51054		
5	6	11	(db) (24'-1" to 48'-0")	51054	Opp Ho	
2	2	4	(d) (24'-1" to 46'-9")	51055		
2	2	4	(d) (24'-1" to 46'-9")	51055	Opp Ho	
2	2	4	(d) (24'-1" to 48'-0")	51056		
2	2	4	(d) (24'-1" to 48'-0")	51056	Opp Ho.	
3	3	6	(d) (24'-1" to 28'-11")	51057		
3	3	6	(d) (24'-1" to 28'-11")	51057	Opp Ho	
1		1	(db) (24'-1" to 48'-0")	51058		
1		1	(db) (24'-1" to 48'-0")	51059	Opp Ho	

PROD. CODE	ASSEMBLY MARK	NO	MARK	SHOP BILL SECTION SIZE	SHOP BILL SECTION NO. OF POUNDS	SHOP BILL LENGTH FT	SHOP BILL LENGTH IN	SHOP BILL REMARKS	MAIL ORDER LENGTH FT	MAIL ORDER LENGTH IN	MAIL ORDER ITEM PAGE	MAIL ORDER ITEM LOC
		80	STRINGERS 4/51051 & 4/51052 & 3/51052 & 3/51056									
		12	51053 & 12/51053 & 11/51054 & 4/51055 & 4/51055 & 4/51055 & 4/51056 & 4/51056 & 4/51059									
	a ℄	32/80	B	24	68		59	10 1/2	51051, 51053, 51055			
	b ℄	32/80	B	24	68		47	1 5/8	51052, 51054, 51056			
	c ℄	2	B	24	68		47	1 8	51058 & 51059			

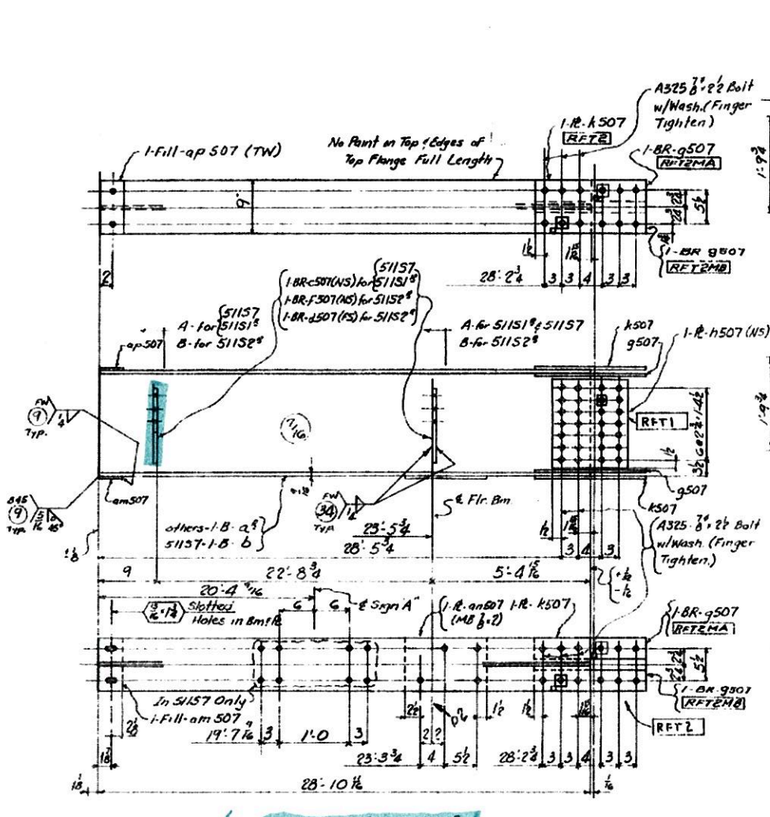

PAY ITEM 602-04.01

INST.			REQUIRED LIST			
	#2	#3	NO.	DESCRIPTION	MARK	REMARKS
	1		1	STRINGERS (28'-11"-29'-9")	51151 R	
	1	1	2	(do) (28'-11"-29'-9")	51151 L	Opp. Ho.
	1	1	2	(do) (28'-11"-29'-9")	51152 R	
	1	1	2	(do) (28'-11"-29'-9")	51152 L	Opp. Ho.
	3	2	5	(do) (28'-11"-29'-9")	51153 R	
	3	3	6	(do) (28'-11"-29'-9")	51153 L	Opp. Ho.
	1	1	2	(do) (28'-11"-29'-9")	51154 R	
	1	1	2	(do) (28'-11"-29'-9")	51154 L	Opp. Ho.
	1	1	2	(do) (28'-11"-29'-9")	51155 R	
	1	1	2	(do) (28'-11"-29'-9")	51155 L	Opp. Ho.
	3	3	6	(do) (28'-11"-29'-9")	51156 R	
	3	3	6	(do) (28'-11"-29'-9")	51156 L	Opp. Ho.
		1	1	(do) (28'-11"-29'-9")	51157	
		1	1	(do) (28'-11"-29'-9")	51158	

Notes:

For Workmanship Notes See Dwg. N501

Holes Marked RFT Shall be Drilled Full Size to a Metal Template.

CONNECTIONS TAKING ONLY PART OF THE WHOLE TEMPLATE ARE MARKED RFT1N & RFT2M. "M" DENOTING MODIFIED.

BOTH SIDES OF MATERIAL ADJACENT TO ALL OPEN HOLES MUST BE FREE OF BURRS, LOOSE SCALE AND PAINT, FOR A DISTANCE OF 3 INCHES FROM THE GROUP OF HOLES. D2

SHOP BILL

Mark	Assembly Mark	No.	Shape	Section: Bar	Section: Bar or Plate	Section: Thick	Length: ft	Length: in	
		8		STRINGERS - 1/51151 R 1/51152 R					
				1-51157					
(1)	a ℄	3/4	B	24	68		28	10 1/2	1/51157
(1)	b	1	B	24	68		28	10 1/2	
	ap507	8	STP	4		3/8	0	9	
	am507	8	BR	4		3/8	0	9	
	c507	8	BR	7 1/2		3/8	1	5	For 51157
	d507	8	BR	7 1/2		3/8	1	5	For 51152
	f507	8	BR	7 1/2		3/8	1	5	
	an507	8	PL	9		3/8	1	1 1/2	
	k507	16	FLU	9		3/8	1	7	
	g507	32	BR	3 1/2		3/8	1	7	
	h507	16	PLU	19 1/2		3/8	1	1	
		208	325			7/8"	0	2 1/2	Ord on 5/P ASHB504
		208	HW	1 1/4"	13/16	3/16			
		16	MB			7/8"	0	2	A307 Galv, RHN Ord on 5/P ASB 501
	TW	8	WD			1/8	0	8	
	FW	4	WD			1/4	6	5	For 51151 & 51157
	FW	4	WD			1/4	12	1	For 51152
	BAS	8	WD			5/16	0	9	
		12		STRINGERS - 5/51153 R 6/51153 L 1/51158					
(1)	c ℄	5/6	B	24	76		28	10 1/2	51153
(1)	d	1	B	24	76		28	10 1/2	51158
	am507	12	BR	4		3/8	0	9	
	c507	24	BR	7 1/2		3/8	1	5	
	d507	24	BR	7 1/2		3/8	1	5	
	an507	12	PL	9		3/8	1	1 1/2	
	k507	24	PLU	9		3/8	1	7	
	g507	48	BR	3 1/2		3/8	1	7	
	h507	24	PLU	19 1/2		3/8	1	1	
		168	325			7/8"	0	2 1/2	
		144	325			3/4"	0	2 3/4	Ord on 5/P ASHB504
		32	HW	1 1/4"	13/16	3/16			
		24	MB			1"	0	2 3/4	A307 Galv, RHN Ord on 5/P ASB 501
	FW	12	WD			1/4	12	1	
	BAS	12	WD			5/16	0	9	
		20		STRINGERS - 7/51154 R 3/51154 L 3/51155 R 7/51155 L 6/51156 R 6/51156 L					
(1)	d ℄	3/4	B	24	68		28	10 1/2	for 51154 & 51155
(1)	g ℄	6/6	B	24	76		28	10 1/2	for 51156
	c507	32	BR	7 1/2		3/8	1	5	2-for 51156 2-for 51156 2-for 51156 2-for 51156
	d507	32	BR	7 1/2		3/8	1	5	
	f507	8	BR	7 1/2		3/8	1	5	for 51155
	ap508	8	STP	4		3/8	0	9	(TW) for 51156 & 51154 & 51155
	am508	20	BR	4		3/8	0	9	
	am507	20	PL	9		3/8	1	1 1/2	
		16	MB			7/8"	0	2	A307 Galv, RHN for 51154 & 51155 Ord on 5/P ASB 501
		24	MB			7/8"	0	2 3/4	A307 Galv, RHN for 51156
	TW	8	WD			1/8	0	8	for 51154 & 51155
	FW	4	WD			1/4	6	5	for 51154
	FW	16	WD			1/4	12	1	for 51155 - 51156
	BAS	20	WD			5/16	0	9	

STRINGER DETAIL

TENNESSEE DEPT OF HIGHWAYS
ARKANSAS STATE HIGHWAY COMMISSION
MISSISSIPPI RIVER BRIDGE - PROJ. I-40 (103)0
MEMPHIS - TENNESSEE

BETHLEHEM STEEL CORPORATION
FABRICATED STEEL CONSTRUCTION

DETAILED DRAWING BOOK Leetsdale WORKS
PLACE IN Elev DATE 10-1-69 IN CHARGE Macko
CHECKED BY JS DATE 11/24/69 SHOP NO.

CONTRACT CE6269-110 DRAWING NO. 511

MATERIAL - ASTM A36
SHOP RIVET HOLES - 7/8"
OPEN HOLES - 15/16" (UN)
SHOP CONTACT SURFACES - No Paint
WELD - As Noted
PAINT - As Per Specs.

M-50-53

WORK PLANNED

E502

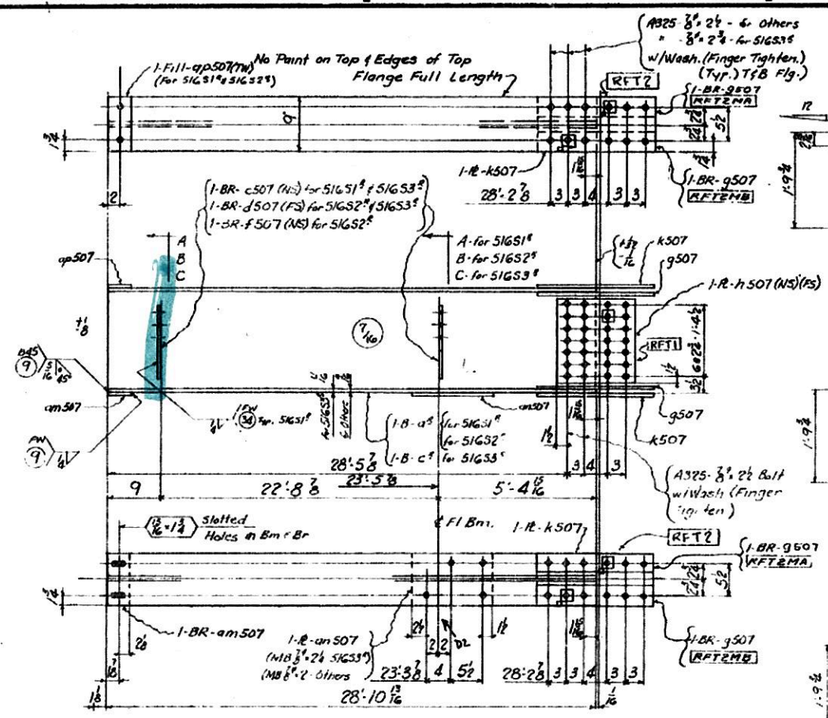

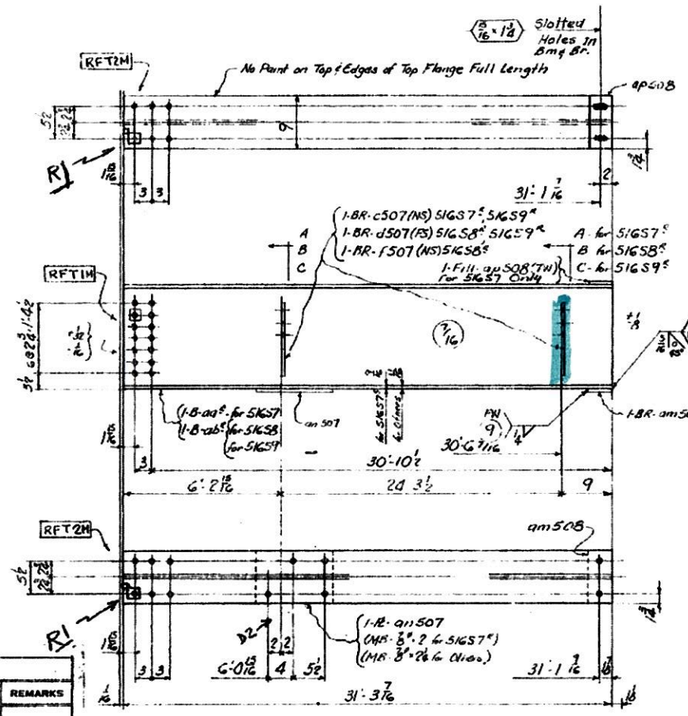

66		am508	10	BR	4		7/8	0	9			
67		an507	10	PL	9		7/8	1	1 1/8			
68												
69			4	MB			7/8"	0	2	RNH-RNH for 51GS7 & (ASD7)	Ord on	
70			16	MB			7/8"	0	2 1/4	RNH-RNH for 51GS8 & 51GS9 (ASD7)	9/ASB501	
71		TW	2	WD			3/8	0	8	for 51GS7 &		
72		FW	2	WD			1/4	6	5	for 51GS7 &		
73		FW	8	WD			1/4	12	1	for 51GS8 / 51GS9		
74		B45	10	WD				0	9			

		ASSEMBLY MARK	NO	SHAPE	SHOP BILL SIZE	SHOP BILL WEIGHT EACH PIECE	SHOP BILL LENGTH FT	SHOP BILL LENGTH IN	SHOP BILL REMARKS	MILL ORDER LENGTH FT	MILL ORDER LENGTH IN	MILL ORDER PAGE	MILL ORDER LINE
	1		10		STRINGERS- 1/51GS1 & 1/51GS1 1/2 & 1/51GS2 & 1/51GS2 1/2 & 3/51GS3 & 3/51GS3 &								
	2												
	3												
	4	a &	3/4	B	24	68		28	10 1/2	51GS1 & & 51GS2 &			
	5	c &	3/4	B	24	76		28	10 1/2	51GS3 &			
•	6	c507	16	BR	7 1/2		7/8	1	5	& 51GS4 & & 51GS5 &			
•	7	d507	16	BR	7 1/2		7/8	1	5	& 51GS4 & & 51GS5 &			
•	8	f507	4	BR	7 1/2		7/8	1	5	for 51GS2 &			
	9	ap507	4	STP	4		1/8	0	9	(TW) for 51GS1 & 51GS2 &			
	10	am507	10	BR	4		7/8	0	9				
	11	an507	10	PL	9		7/8	1	1 1/8				
	12	k507	20	PLU	9		7/8	1	7				
	13	g507	40	BR	3 1/2		7/8	1	7				
	14	h507	40	PLU	19 1/2		7/8	1	1				
	15												
	16												
	17		188	325			7/8"	0	2 1/2	N. for 51GS3 Rg. Others			
	18		72	325			7/8"	0	2 3/4	for 51GS3 &	Ord on 9/ASBH 504		
	19		240	HN	1 1/4"	15/16	5/16						
	20		8	MB			7/8"	0	2	(ASD7) RNH-RNH for 51GS3 &	Ord on 9/ASB 501		
	21		12	MB			7/8"	0	2 1/4	(ASD7) RNH-RNH for 51GS3 &			
	22	TW	4	WD			3/8	0	8	for 51GS1 & 51GS2			
	23	FW	2	WD			1/4	6	5	for 51GS1 &			
	24	FW	8	WD			1/4	12	1	for 51GS2 & 51GS3			
	25	B45	10	WD			5/16	0	9				
	26												
	27												
	28		40		STRINGERS- 4/51GS4 & 4/51GS4 & 4/51GS5 & 4/51GS5 & 12/51GS6 & 12/51GS6 &								
	29												
①	30	d &	1/4	B	24	68		31	1 1/2	51GS4 &			
①	31	f &	5/16	B	24	76		31	1 1/2	51GS5 & & 51GS6 &			
	32												
	33	c507	64	BR	7 1/2		7/8	1	5	& 51GS7 & & 51GS9 &			
	34	d507	64	BR	7 1/2		7/8	1	5	& 51GS7 & & 51GS9 &			
	35	f507	16	BR	7 1/2		7/8	1	5	51GS8 &			
	36	ap507	8	STP	4		1/8	0	9	51GS8 & (TW)			
	37	am507	40	BR	4		7/8	0	9				
	38	an507	40	PL	9		3/8	1	1 1/8				
	39	k507	80	PLU	9		7/8	1	7				
	40	g507	160	BR	3 1/2		7/8	1	7				
	41	h507	80	PLU	19 1/2		7/8	1	1				
	42												
	43		656	325			7/8"	0	2 1/2	Rg. 51GS6 (8'-0 Others) for 51GS5 &			
	44		384	325			7/8"	0	2 3/4	for 51GS5 &	Ord on 9/ASBH 504		
	45		440	HN	1 1/4	15/16	5/16						
	46		16	MB			7/8"	0	2	(ASD7) RNH-RNH for 51GS4 &	Ord on 9/ASB 501		
	47		64	MB			7/8"	0	2 1/4	(ASD7) RNH-RNH for 51GS6 &			
	48	TW	8	WD			3/8	0	8	for 51GS4			
	49	FW	8	WD			1/4	6	5	for 51GS4			
	50	FW	32	WD			1/4	12	1	for 51GS5 & 51GS6			
	51	B45	20	WD			5/16	0	9				
	52												
	53												
	54		10		STRINGERS- 1/51GS7 & 1/51GS7 & 1/51GS8 & 1/51GS8 & 3/51GS9 & 3/51GS9 &								
	55												
	56												
①	57	aa &	1/4	B	24	68		31	3 3/4	51GS7 &			
①	58	ab &	1/4	B	24	76		31	3 3/4	51GS8 & & 51GS9 &			
	59												
	60	c507	16	BR	7 1/2		7/8	1	5	& 51GS7 & & 51GS9 &			
	61	d507	16	BR	7 1/2		7/8	1	5	& 51GS7 & & 51GS9 &			
	62	f507	4	BR	7 1/2		7/8	1	5	51GS8			
	63												
	64												
	65	ap508	2	STP	4		1/8	0	9	(TW) 51GS7 &			

Pay Item - 602-04 01

INST.					REQUIRED LIST				
45s	64s	45s	64s	45s	NO	DESCRIPTION	MARK	REMARKS
				1	1	Stringer (24'-12"-29'-9")	51GS1 &	
				1	1	(4) " do	51GS1 L	Opp Ho.
				1	1	(4) " (24'-No-29'-9)	51GS2 &	
				1	1	(4) " do	51GS2 L	Opp Ho.
				3	3	(4) " do	51GS3 &	
				3	3	(4) " do	51GS3 L	Opp Ho.
1	2	1			4	(4) " (24'-12'-32'-0)	51GS4 &	
1	2	1			4	(4) " do	51GS4 L	Opp Ho.
1	2	1			4	(4) " (24'-16'-32'-0)	51GS5 &	
1	2	1			4	(4) " do	51GS5 L	Opp Ho.
3	6	3			12	(4) " do	51GS6 &	
3	6	3			12	(4) " do	51GS6 L	Opp Ho.
	1				1	(4) " (24'-12'-31'-4)	51GS7 &	
	1				1	(4) " do	51GS7 L	Opp Ho.
	1				1	(4) " (24'-16'-31'-4)	51GS8 &	
	1				1	(4) " do	51GS8 L	Opp Ho.
	3				3	(4) " do	51GS9 &	
	3				3	(4) " do	51GS9 L	Opp Ho.

Notes:

For Workmanship Notes See Dwg. N501

Holes Marked RFT Shall be Drilled Full Size to Metal Template.

CONNECTIONS TAKING ONLY PART OF THE WHOLE TEMPLATE ARE MARKED RFT1M & RFT2M. "M" DENOTING MODIFIED.

BOTH SIDES OF MATERIAL ADJACENT TO ALL OPEN HOLES MUST BE FREE OF BURRS. LOOSE SCALE AND PAINT FOR A DISTANCE OF 3 INCHES FROM THE GROUP OF HOLES.

D2

MATERIAL - ASTM-A36
BOLTS - 7/8"
OPEN HOLES - 15/16" (uN)
SHOP CONTACT SURFACES - No Paint
WELD - As Noted
PAINT - As per Specs

STRINGER DETAILS

TENNESSEE DEPT OF HIGHWAYS
ARKANSAS STATE HIGHWAY COMMISSION
MISSISSIPPI RIVER BRIDGE PROJ. I-40 (103)0
MEMPHIS - TENNESSEE

BETHLEHEM STEEL CORPORATION
FABRICATED STEEL CONSTRUCTION

DETAILING DRAWING ROOM Leetsdale WORKS
MADE BY Htm DATE 10-6-69 CHECKED BY JJS DATE 11/24/69 SHOP NO.
CONTRACT CEG6267-120 DRAWING NO. 5/G 1

For location of details shown on this sheet refer to diagrams

E-502 · E-503 · E-504

MICROFILMED

M-50-30

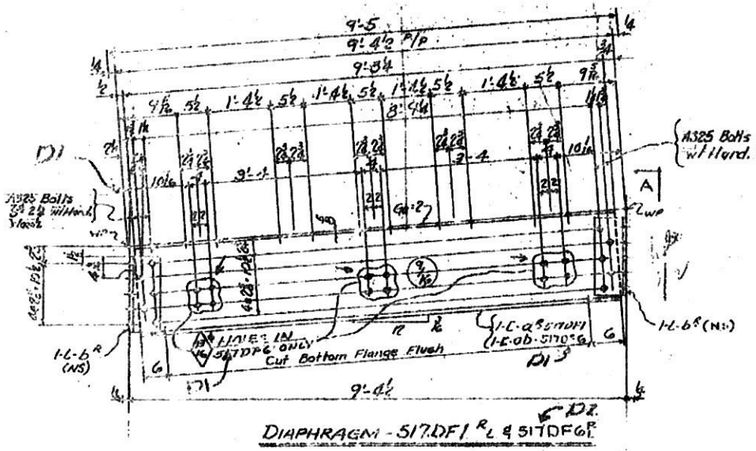

DIAPHRAGM - 517DF1 R,L & 517DF6 R,L

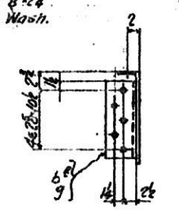

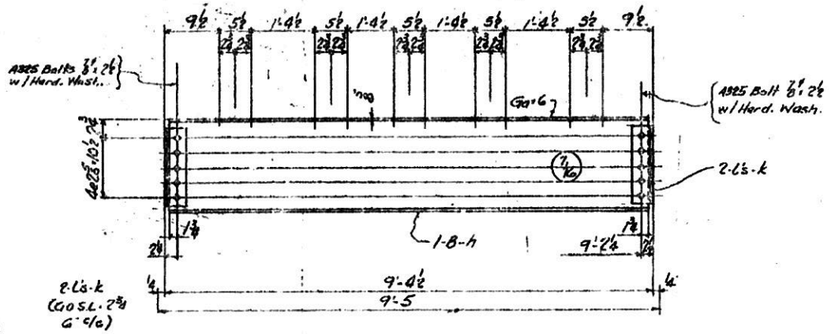

DIAPHRAGM - 517DF4

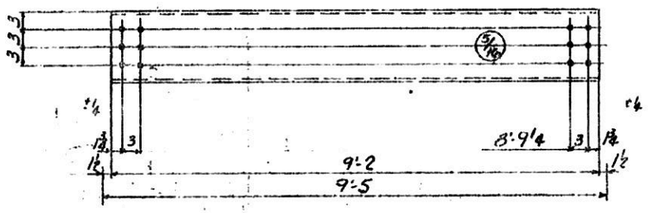

DIAPHRAGM - 517DF5

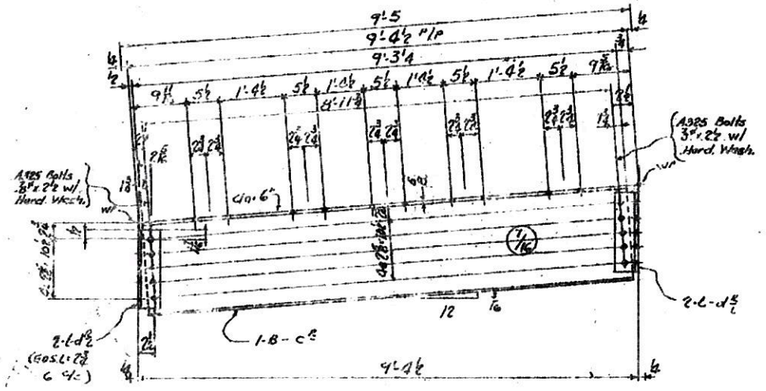

DIAPHRAGM 517DF2 R,L

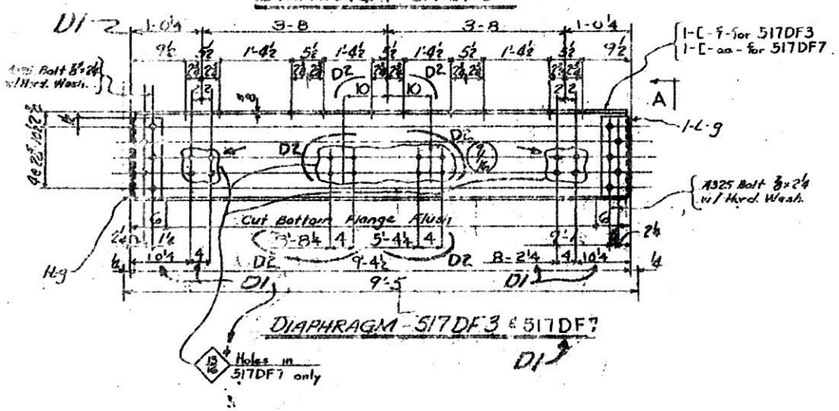

DIAPHRAGM - 517DF3 & 517DF7

PAY ITEM 602-01.01

INST.	REQUIRED LIST				
	NO.	DESCRIPTION	MARK	REMARKS
D1	4	DIAPHRAGMS	517DF1 R	
	4	(4)	517DF1 L	Opp. Hd.
	4	(4)	517DF2 R	
	4	(4)	517DF2 L	Opp. Hd.
D1	1	(1)	517DF5	
	1	(1)	517DF4	
	1	(1)	517DF3	
D1	4	do	517DF6 L	OPP HD
	1	do	517DF7	

Mark	No.	Size	Grade	Length	Weight	Bend	Hole	Remarks
	16			DIAPHRAGMS				517DF1 R & 517DF6 R
	16			DIAPHRAGMS				517DF1 L & 517DF6 L
	160	325					0	24 Diag. on 9" P
	160	HW				3/16		
	16			DIAPHRAGMS				517DF2 R & 517DF5
	16			DIAPHRAGMS				517DF2 L & 517DF5
	160	325					0	24 Diag. on 9" P
	160	HW				3/16		
	2			DIAPHRAGMS				517DF3 & 517DF4
aa	1	C	15	40			9	3¼ 517DF7
f	1	C	15	40			9	3½ 517DF3
g	4	L	5	5		⅝	1	1½
	20	325					0	24 Diag. on 9" P
	20	HW				3/16		
	2			DIAPHRAGMS				517DF3
h	2	B	16	58			9	3½
k	8	L	4	3'-4		⅝	1	1½
	20	325					0	24 Diag. on 9" P
	20	HW				3/16		

Note:
FOR WORKMANSHIP NOTES SEE DWG. N501
HOLES TO BE DRILLED OR PUNCHED FULL SIZE

DIAPHRAGM DETAILS

TENNESSEE DEPT OF HIGHWAYS
ARKANSAS STATE HIGHWAY COMMISSION
MISSISSIPPI RIVER BRIDGE - MEMPHIS (1963)
ARKANSAS - TENNESSEE
BETHLEHEM STEEL CORPORATION
Contract No. 517

ASTM - A36
1 COAT As Per Spec.

MICROFILMED