TENNESSEE D.O.T.
DESIGN DIVISION
FILE NO.

TYPE	YEAR	PROJECT NO.	SHEET NO.
CONST.	2007	CM-098-3(14)	126
As built	2010		

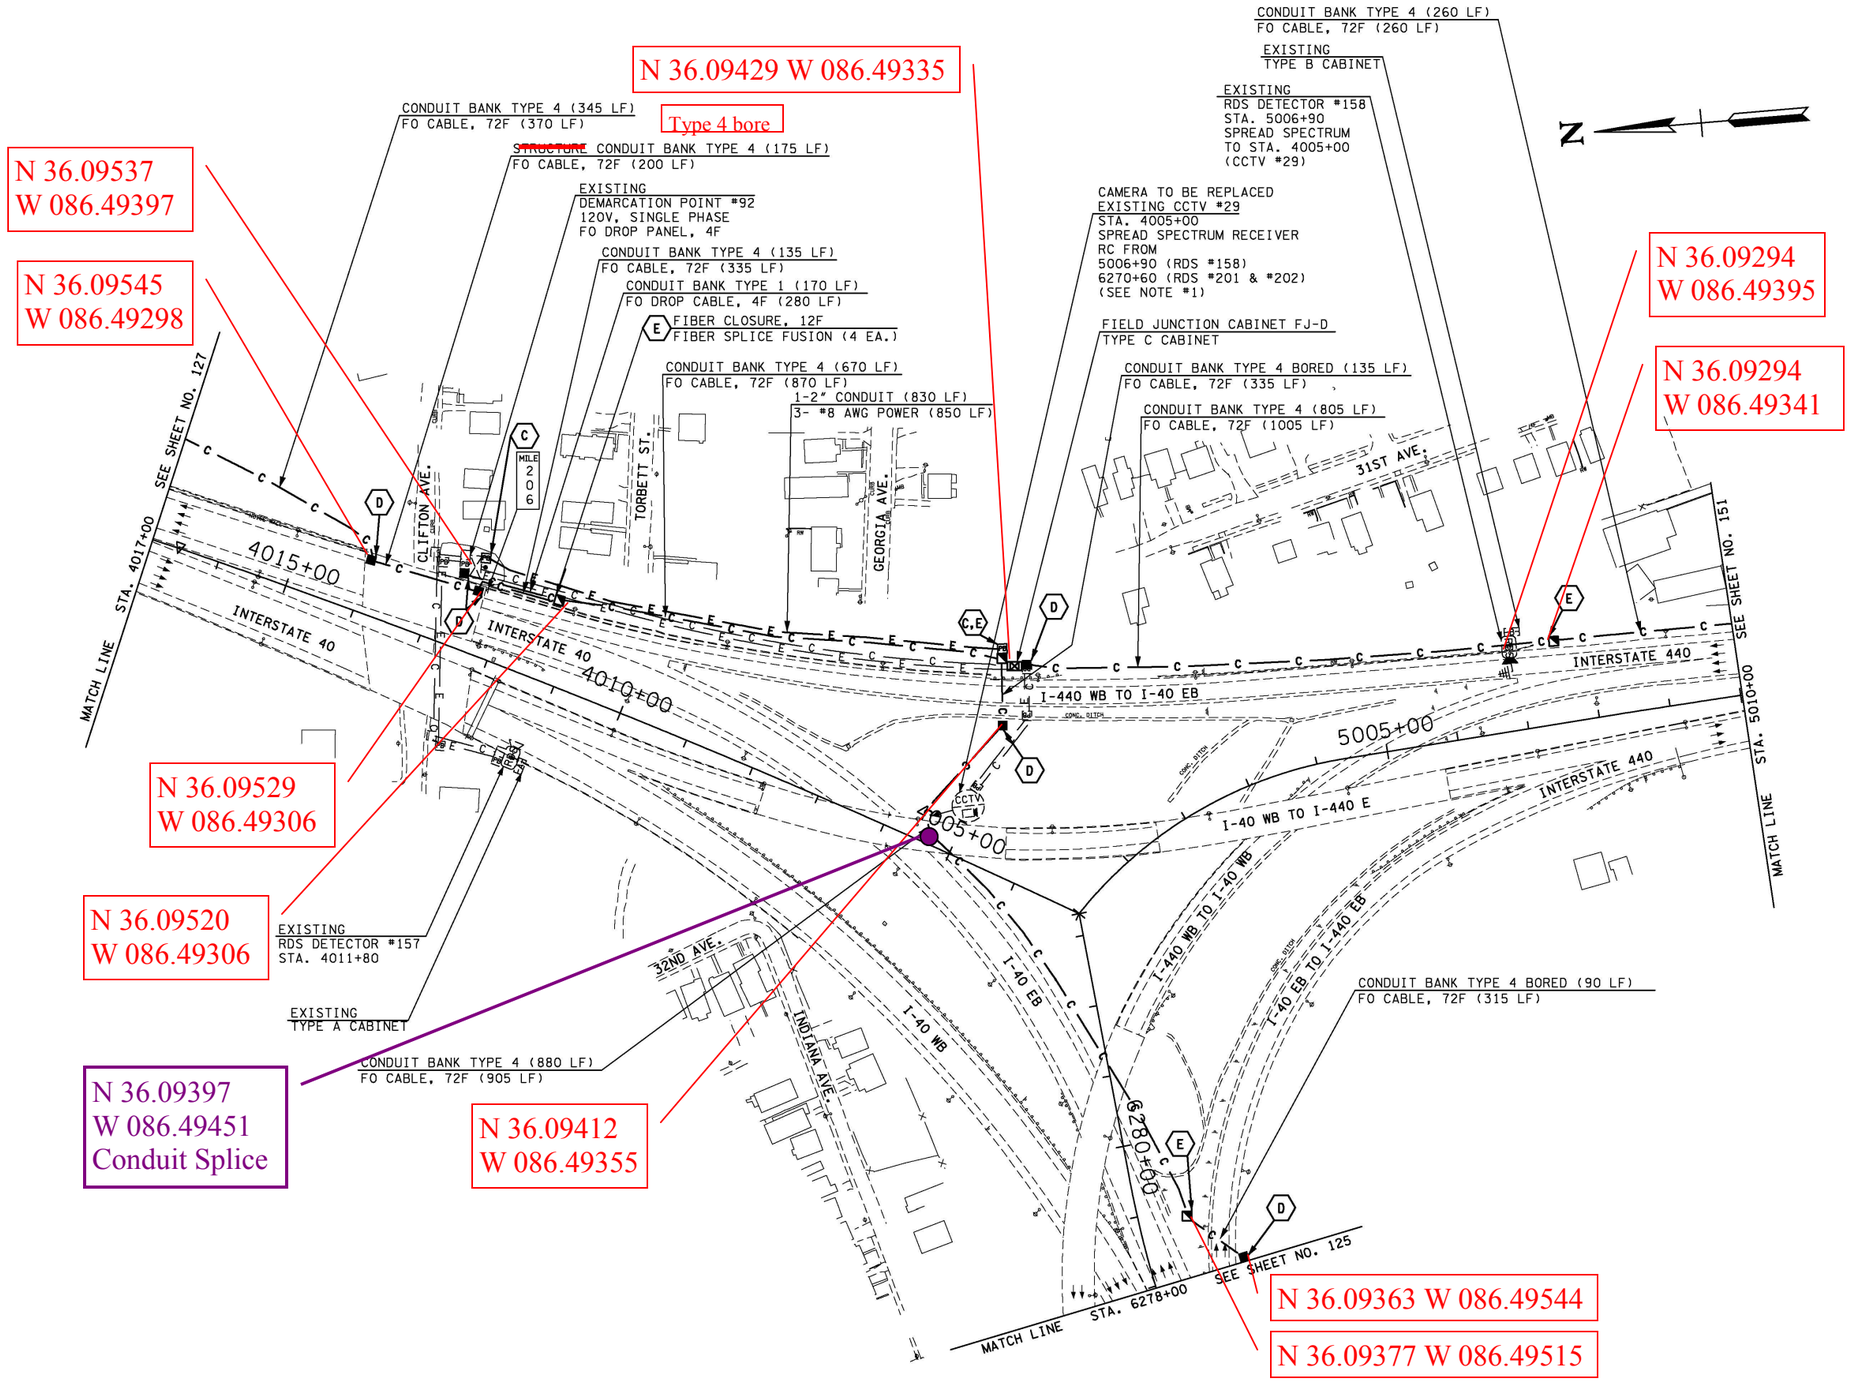

NOTE: 1. CCTV #29 TO BE REPLACED WITH A NEW CCTV, BRACKETS, WIRING, AND CONTROL EQUIPMENT.

STATE OF TENNESSEE
DEPARTMENT OF TRANSPORTATION

ITS LAYOUT
I-40/I-440
STA. 6278+00 TO
STA. 4017+00
(I-40)
TO STA. 5010+00
(I-440)
SCALE: 1"=100'

TENNESSEE D.O.T.
DESIGN DIVISION
FILE NO.

TYPE	YEAR	PROJECT NO.	SHEET NO.
CONST.	2007	CM-098-3(14)	151
As built	2010	.	.
.	.	.	.
.	.	.	.

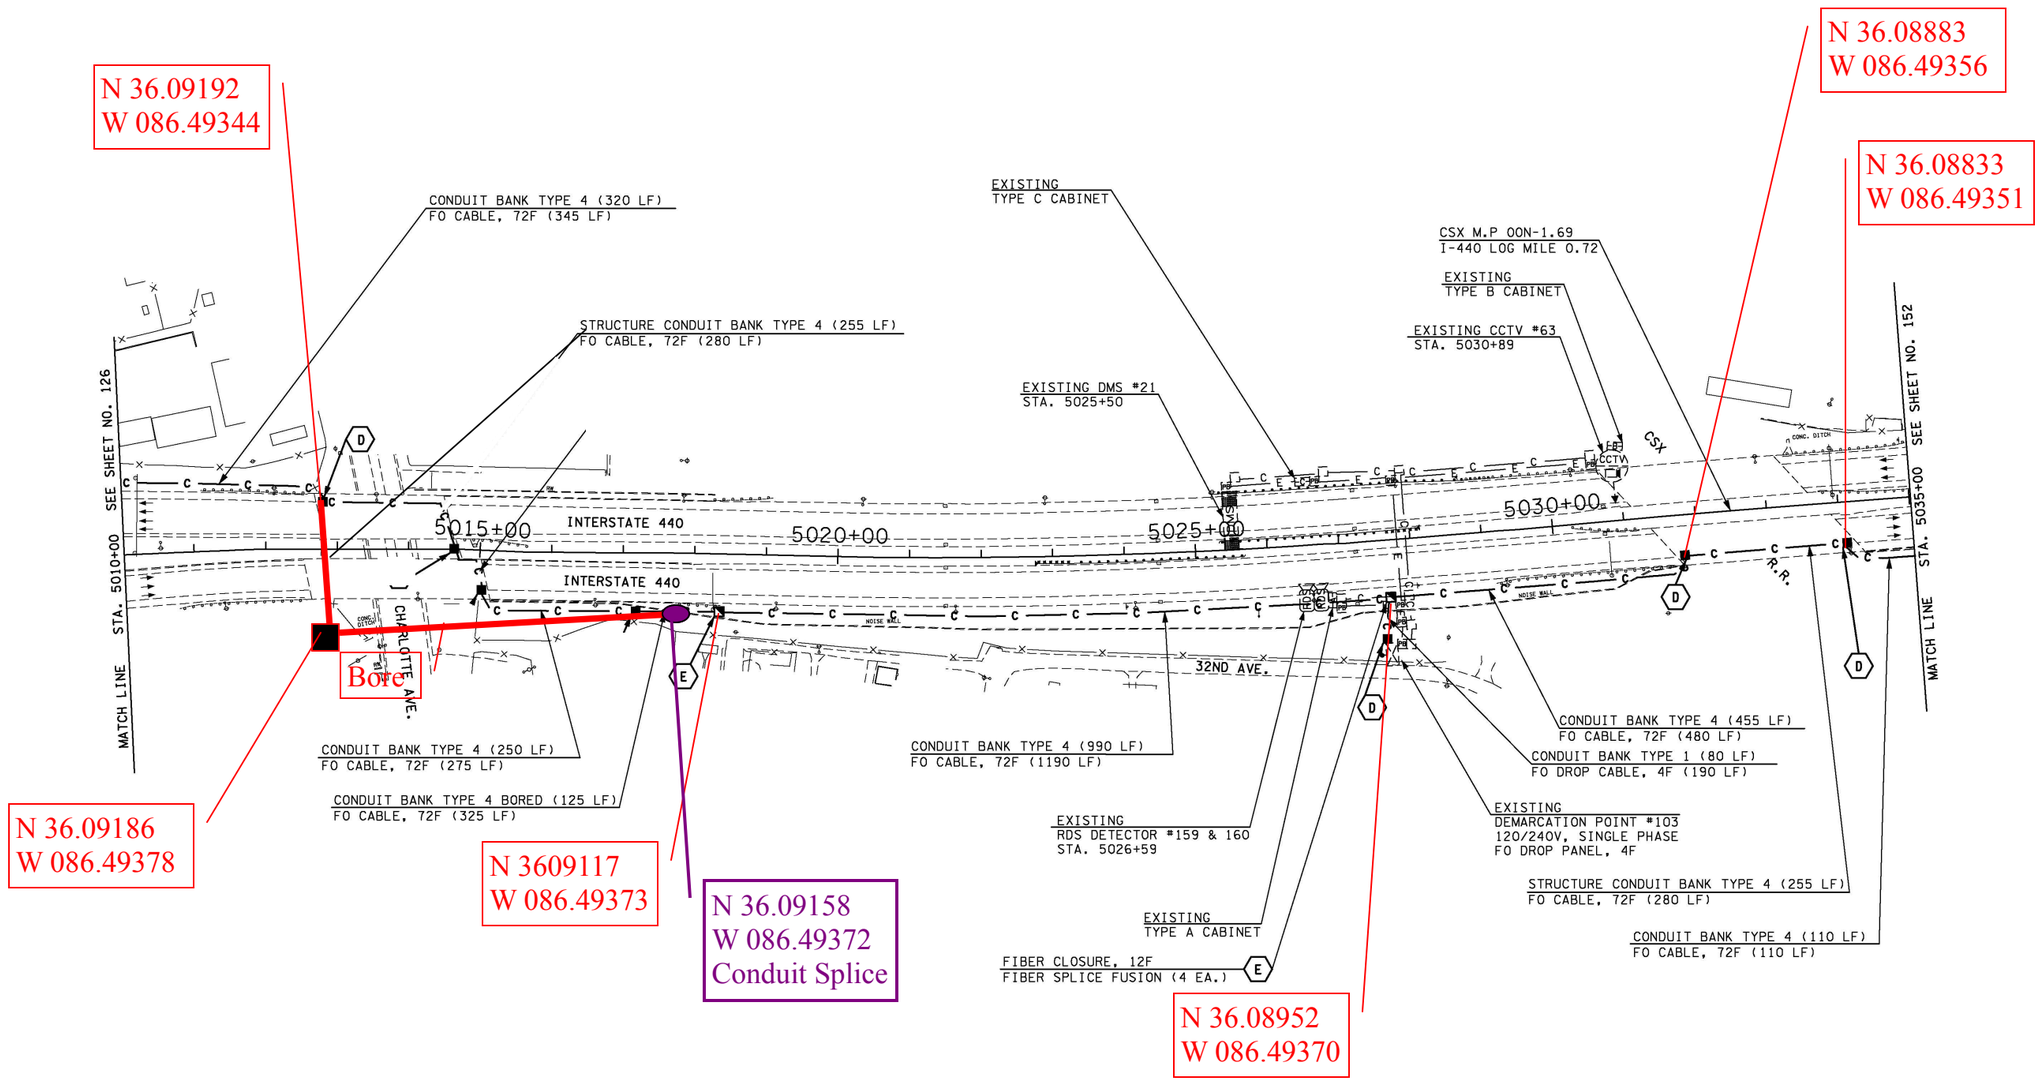

STATE OF TENNESSEE
DEPARTMENT OF TRANSPORTATION

ITS LAYOUT
I-440
STA. 5010+00 TO
STA. 5035+00

SCALE: 1"=100'

TENNESSEE D.O.T.
DESIGN DIVISION
FILE NO.

TYPE	YEAR	PROJECT NO.	SHEET NO.
CONST.	2007	CM-098-3(14)	152
As built	2010		

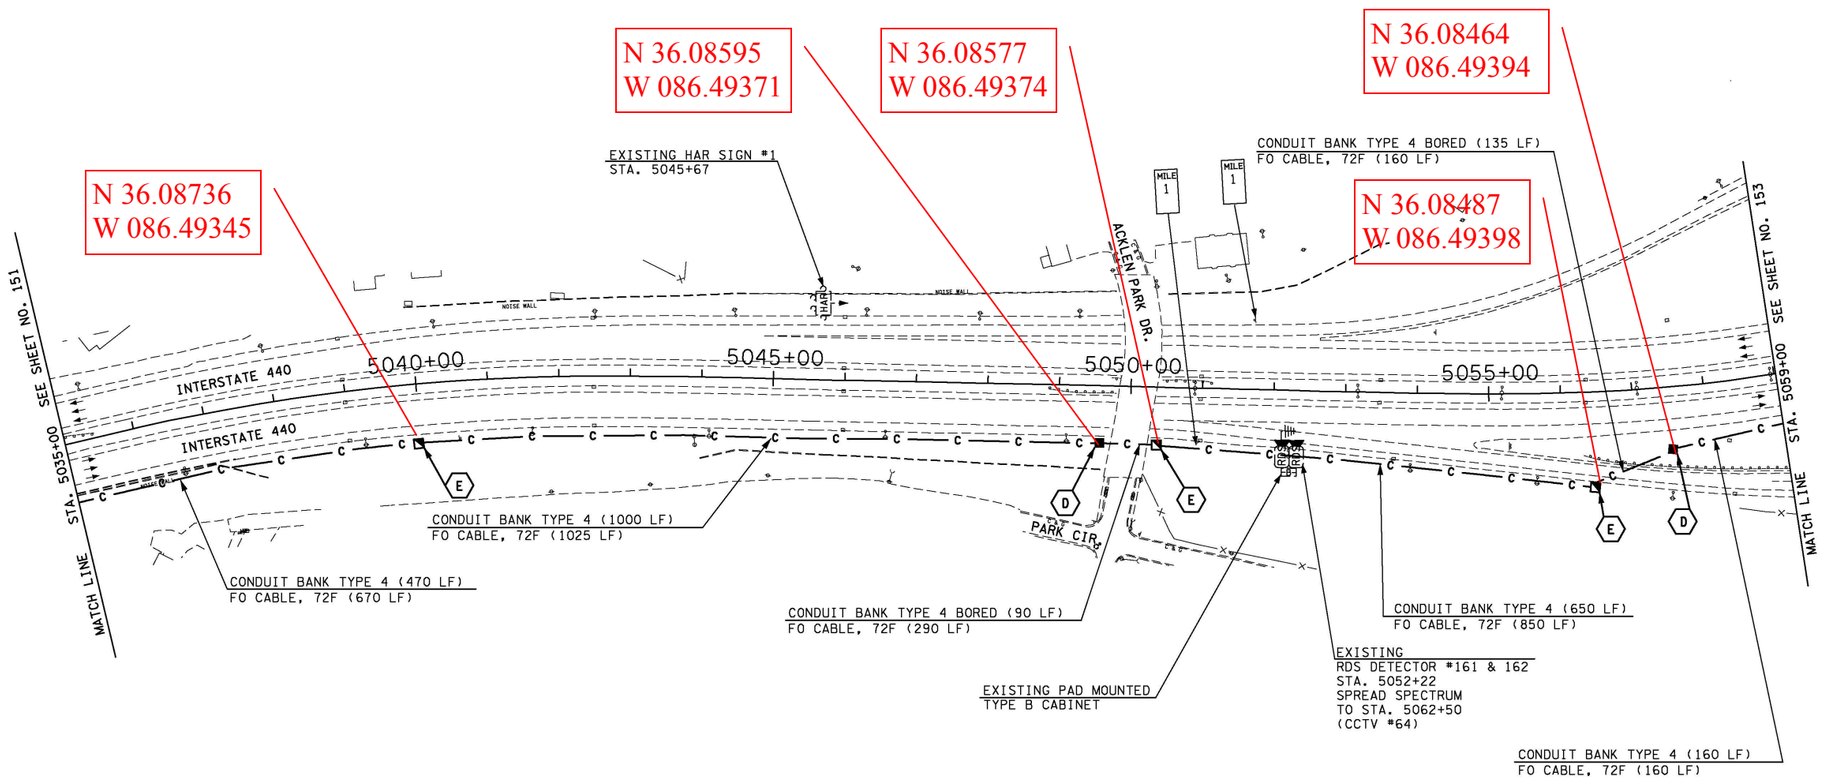

STATE OF TENNESSEE
DEPARTMENT OF TRANSPORTATION

ITS LAYOUT
I-440
STA. 5035+00 TO
STA. 5059+00

SCALE: 1"=100'

TENNESSEE D.O.T.
DESIGN DIVISION
FILE NO.

TYPE	YEAR	PROJECT NO.	SHEET NO.
CONST.	2007	CM-098-3(14)	153
As built	2010		

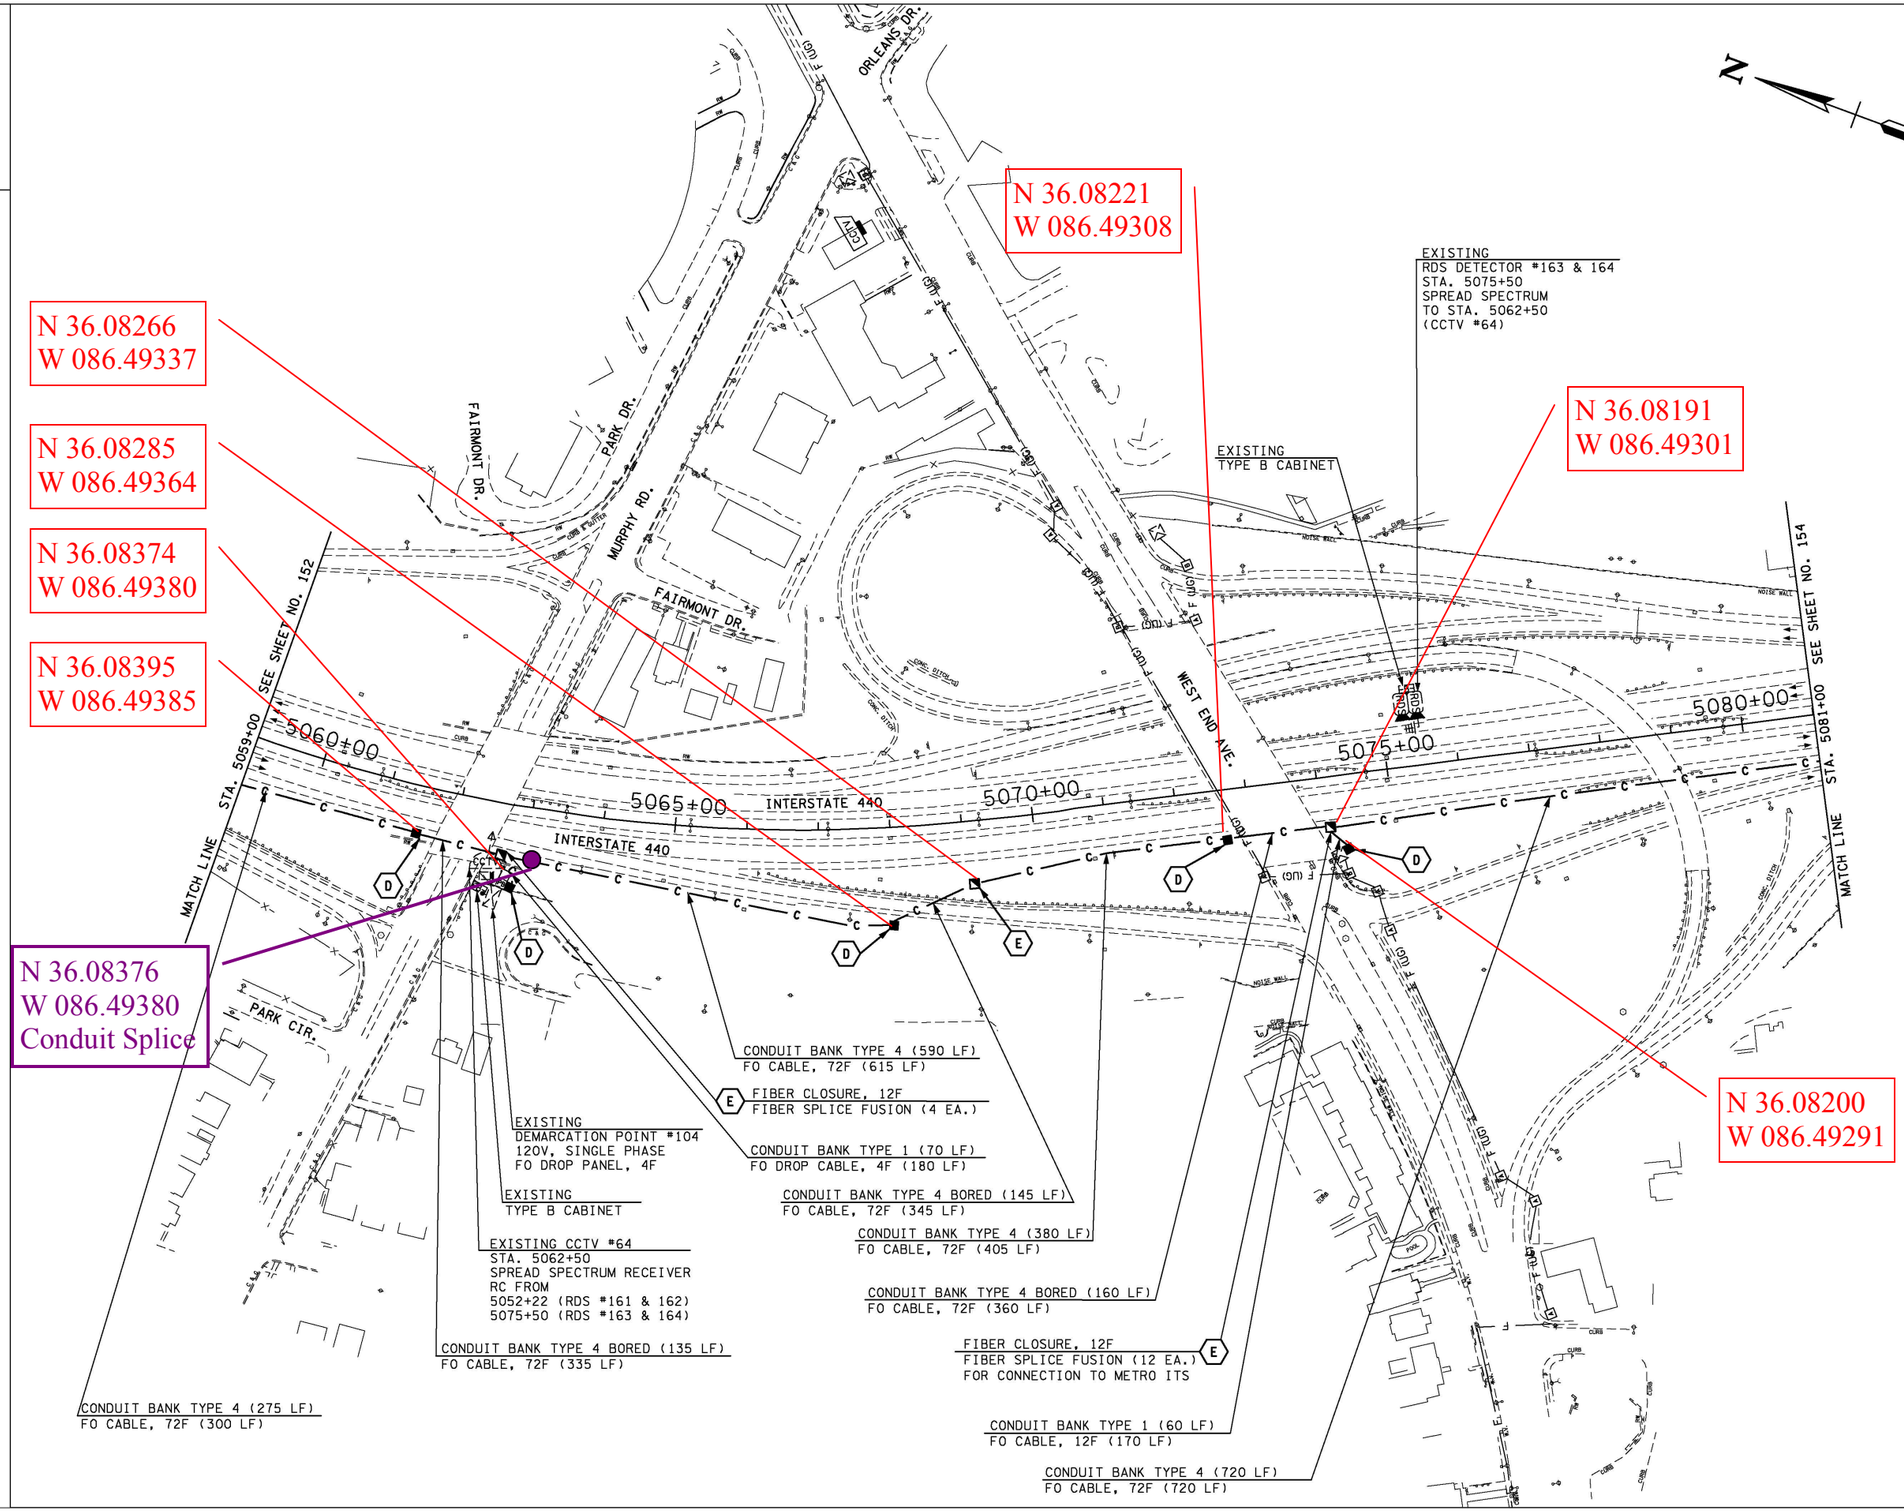

STATE OF TENNESSEE
DEPARTMENT OF TRANSPORTATION

ITS LAYOUT
I-440
STA. 5059+00 TO
STA. 5081+00

SCALE: 1"=100'

TENNESSEE D.O.T.
DESIGN DIVISION
FILE NO.

TYPE	YEAR	PROJECT NO.	SHEET NO.
CONST.	2007	CM-098-3(14)	154
As built	2010		

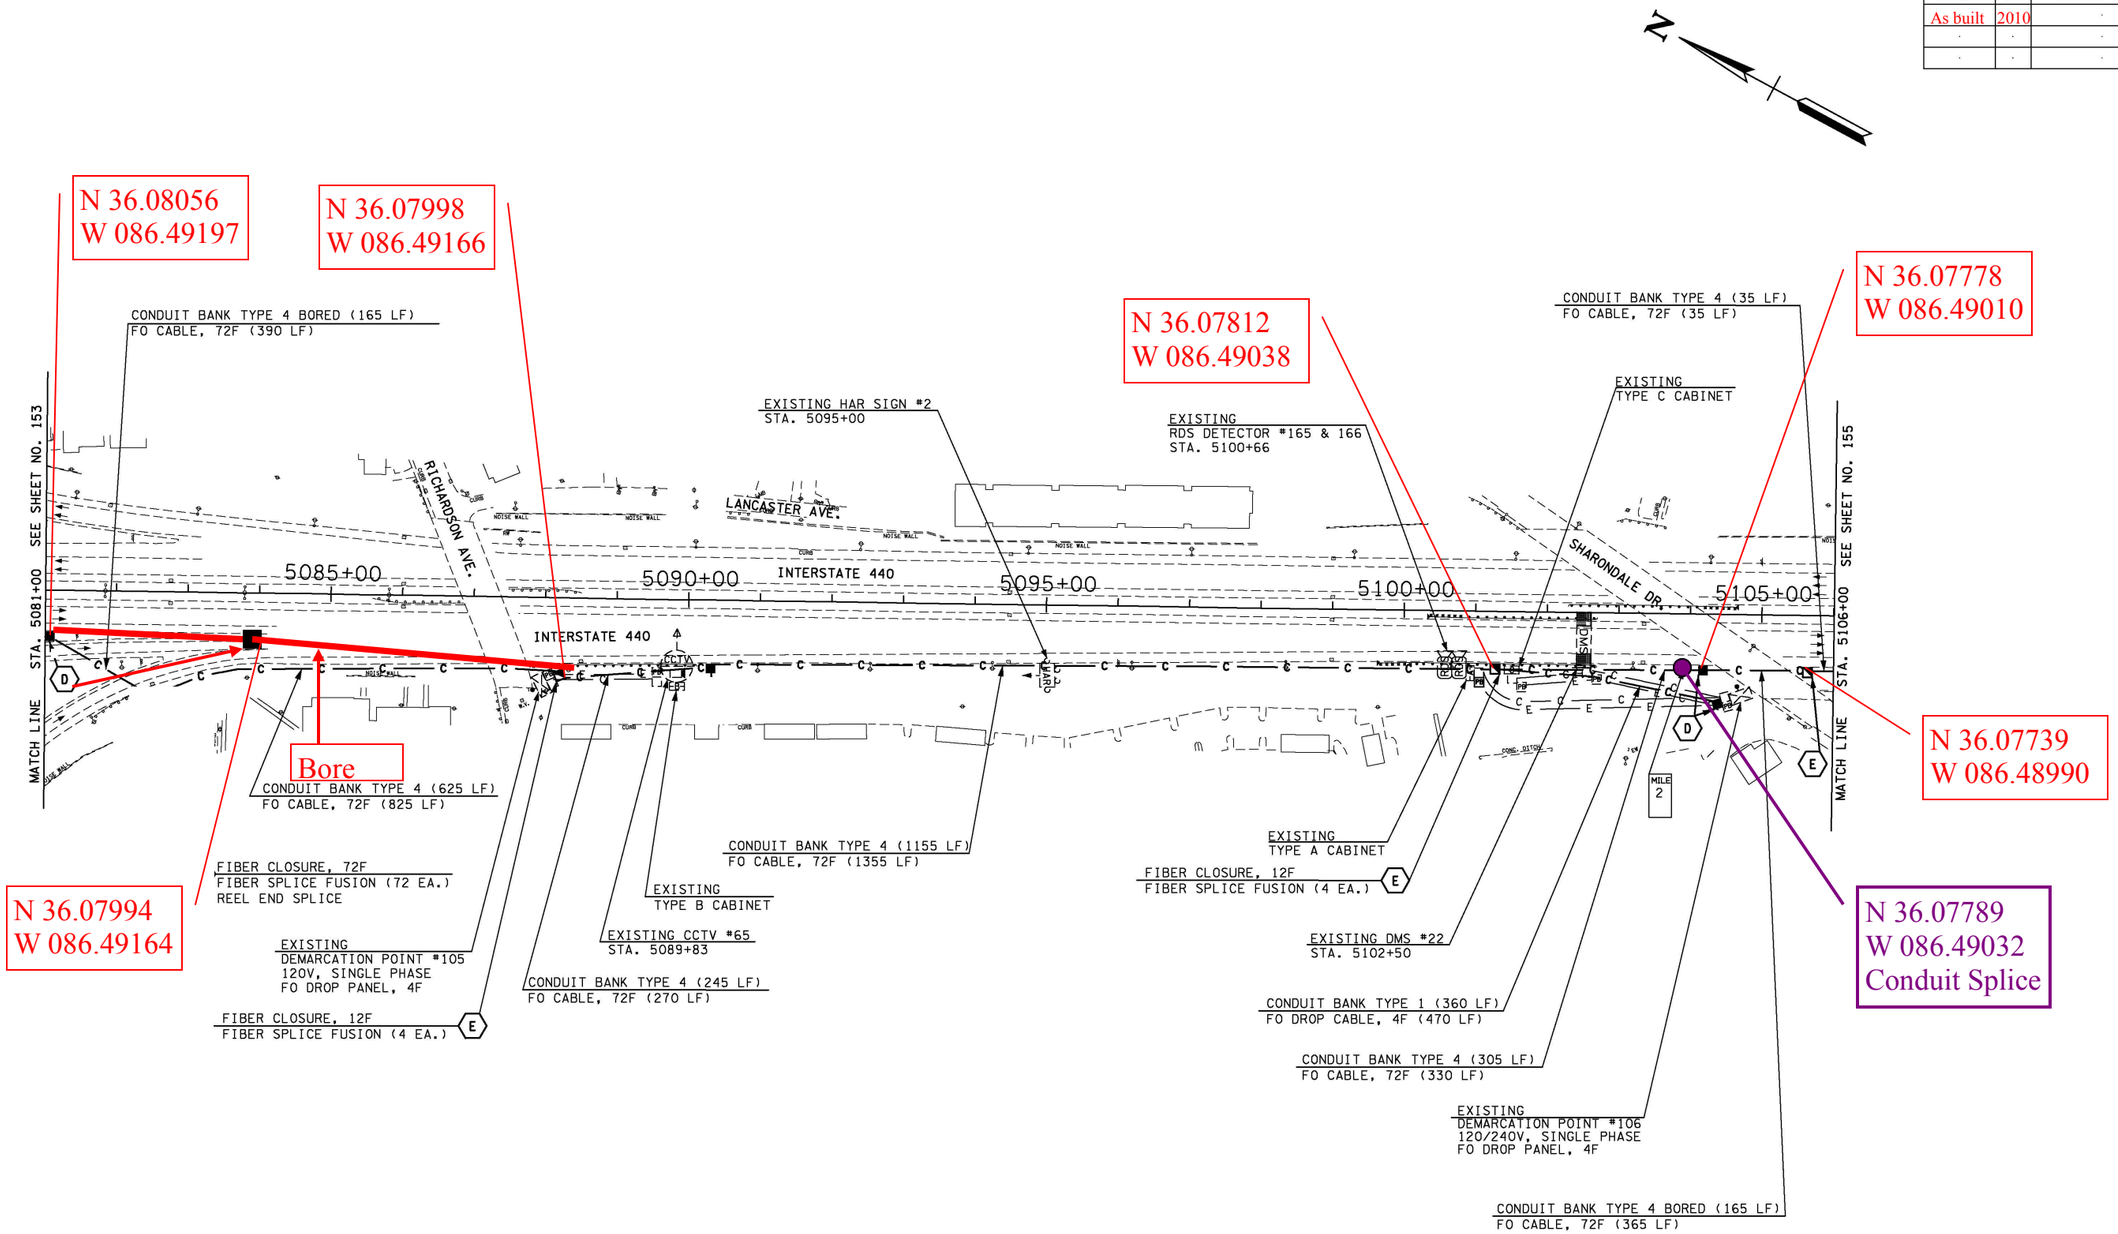

STATE OF TENNESSEE
DEPARTMENT OF TRANSPORTATION

ITS LAYOUT
I-440
STA. 5081+00 TO
STA. 5106+00

SCALE: 1"=100'

TENNESSEE D.O.T.
DESIGN DIVISION
FILE NO.

TYPE	YEAR	PROJECT NO.	SHEET NO.
CONST.	2007	CM-098-3(14)	155
As built	2010	.	.
.	.	.	.
.	.	.	.

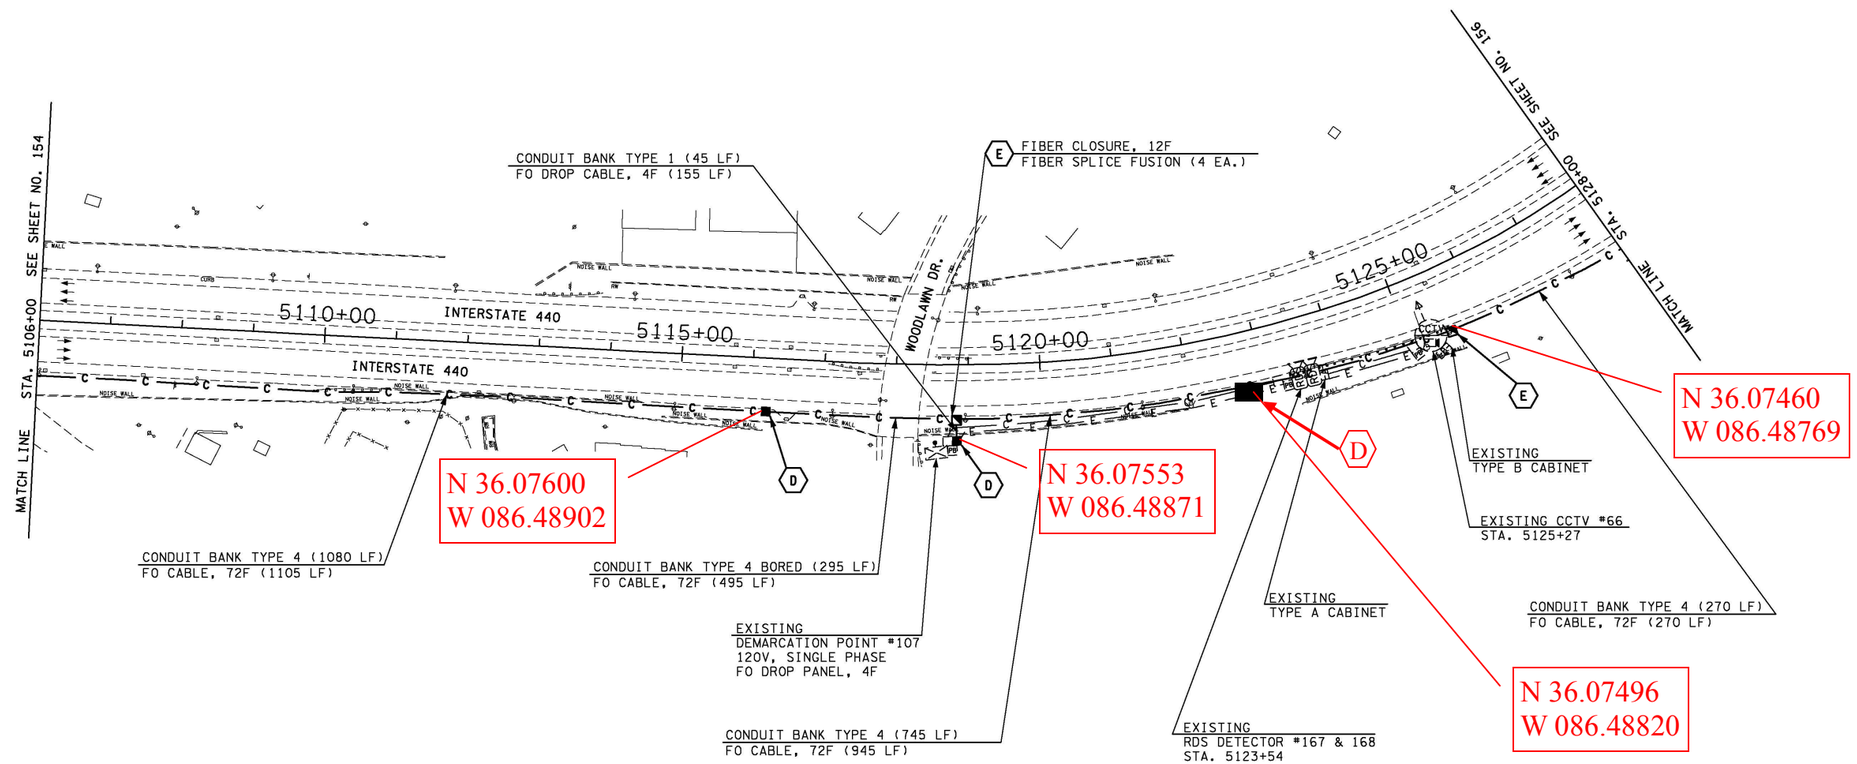

STATE OF TENNESSEE
DEPARTMENT OF TRANSPORTATION

ITS LAYOUT
I-440
STA. 5106+00 TO
STA. 5128+00

SCALE: 1"=100'

TENNESSEE D.O.T.
DESIGN DIVISION
FILE NO.

TYPE	YEAR	PROJECT NO.	SHEET NO.
CONST.	2007	CM-098-3(14)	156
As built	2010		

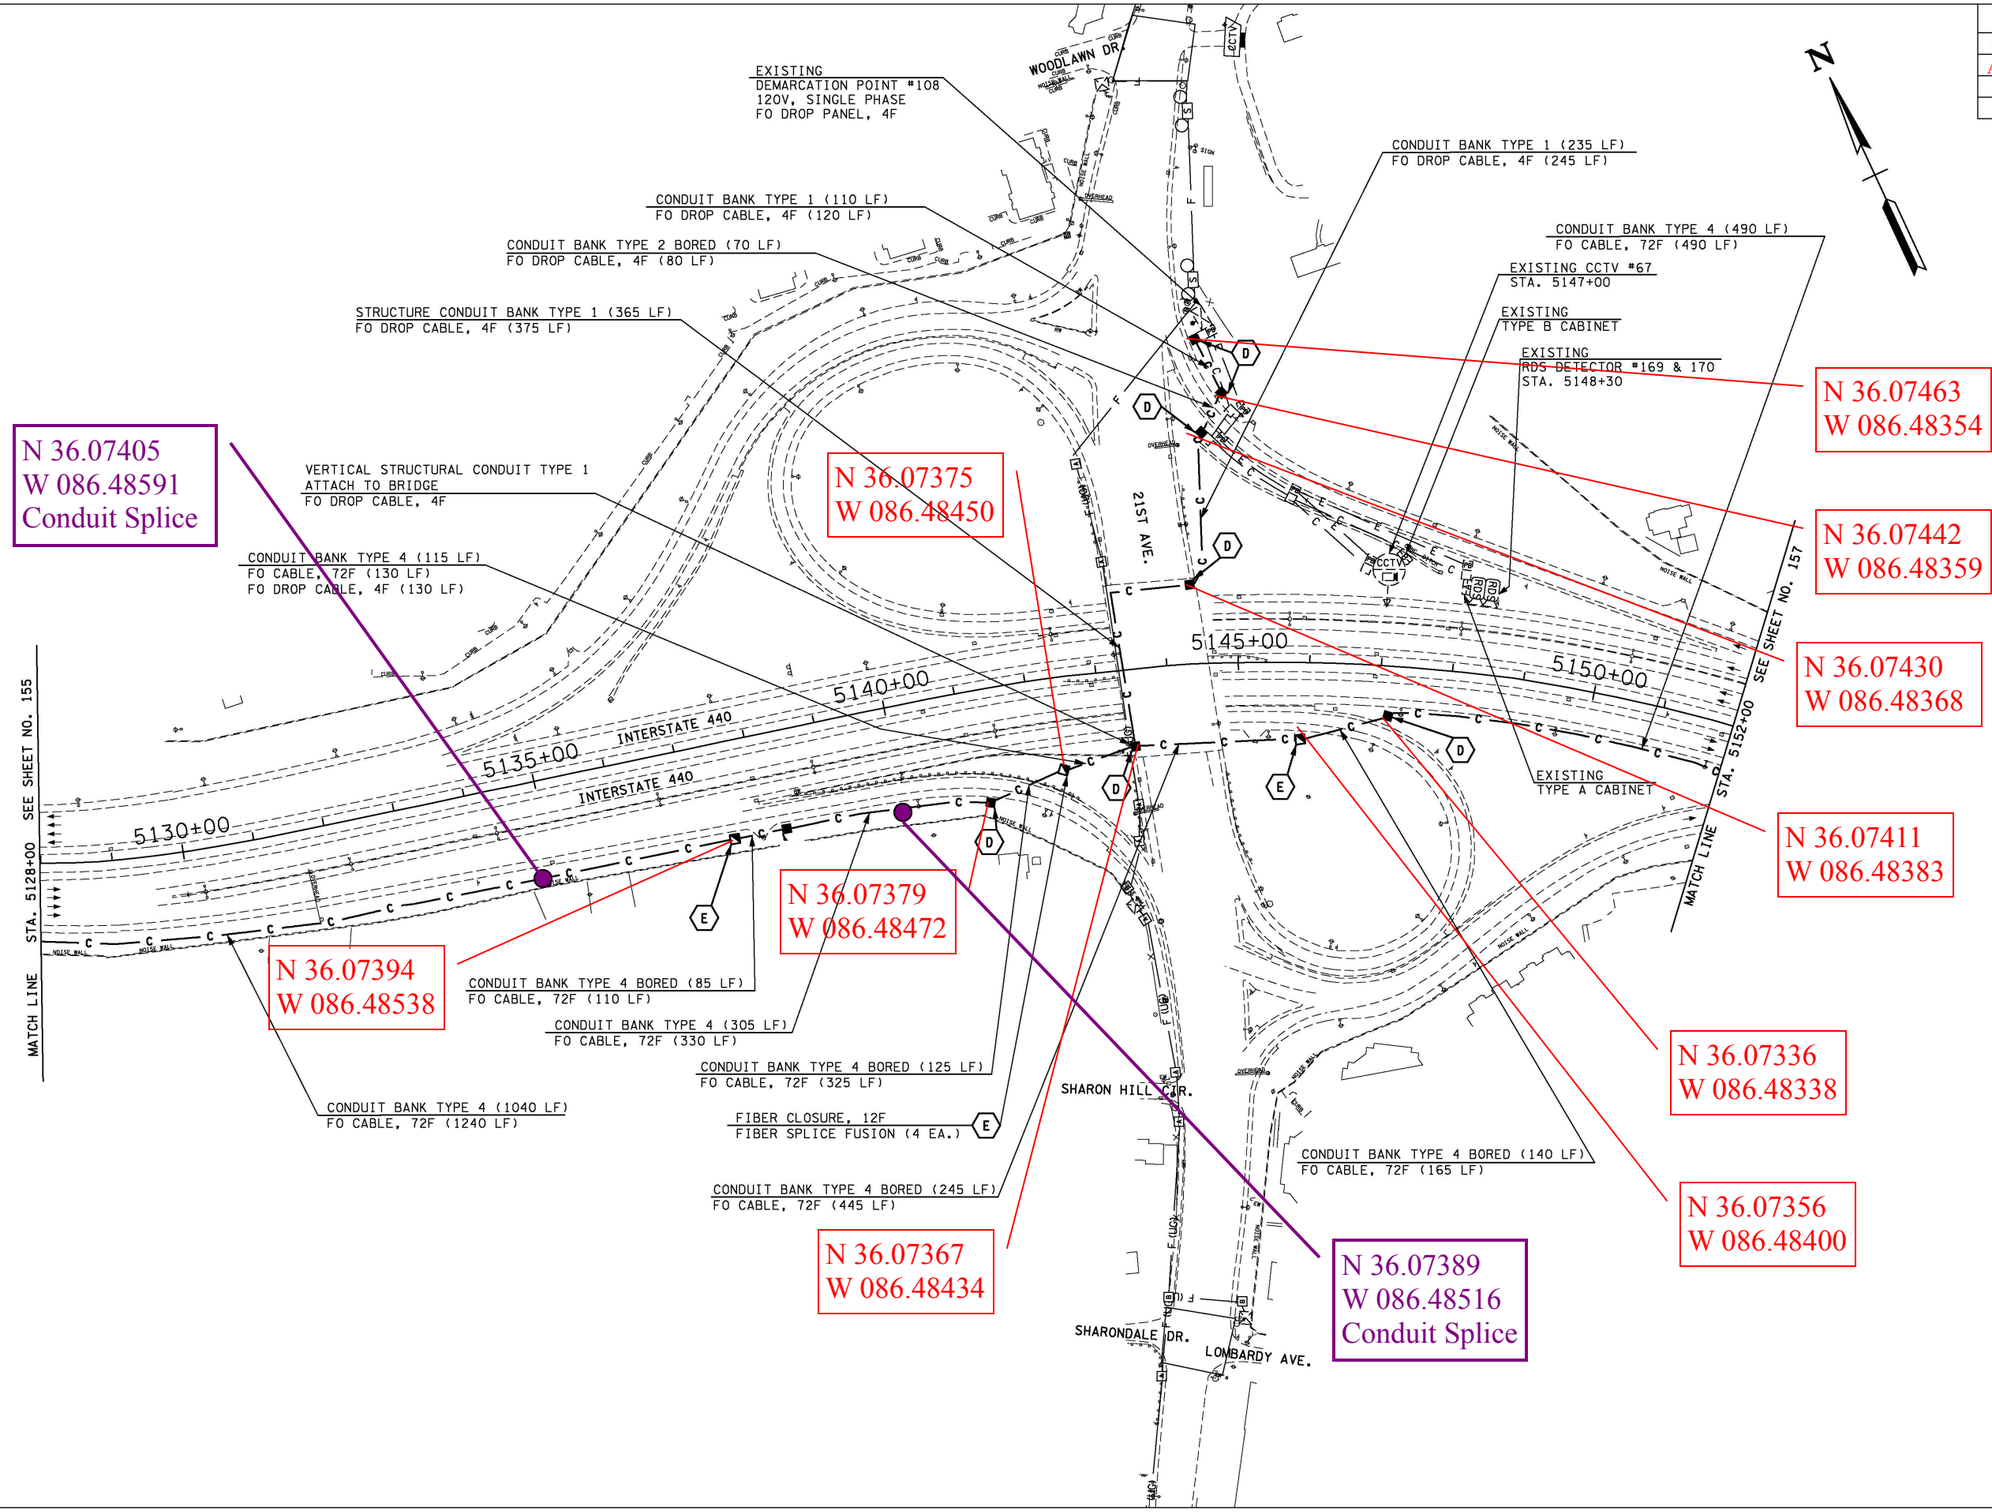

STATE OF TENNESSEE
DEPARTMENT OF TRANSPORTATION

ITS LAYOUT
I-440
STA. 5128+00 TO
STA. 5152+00

SCALE: 1"=100'

TENNESSEE D.O.T.
DESIGN DIVISION
FILE NO.

TYPE	YEAR	PROJECT NO.	SHEET NO.
CONST.	2007	CM-098-3(14)	157
As built	2010	.	.
.	.	.	.
.	.	.	.

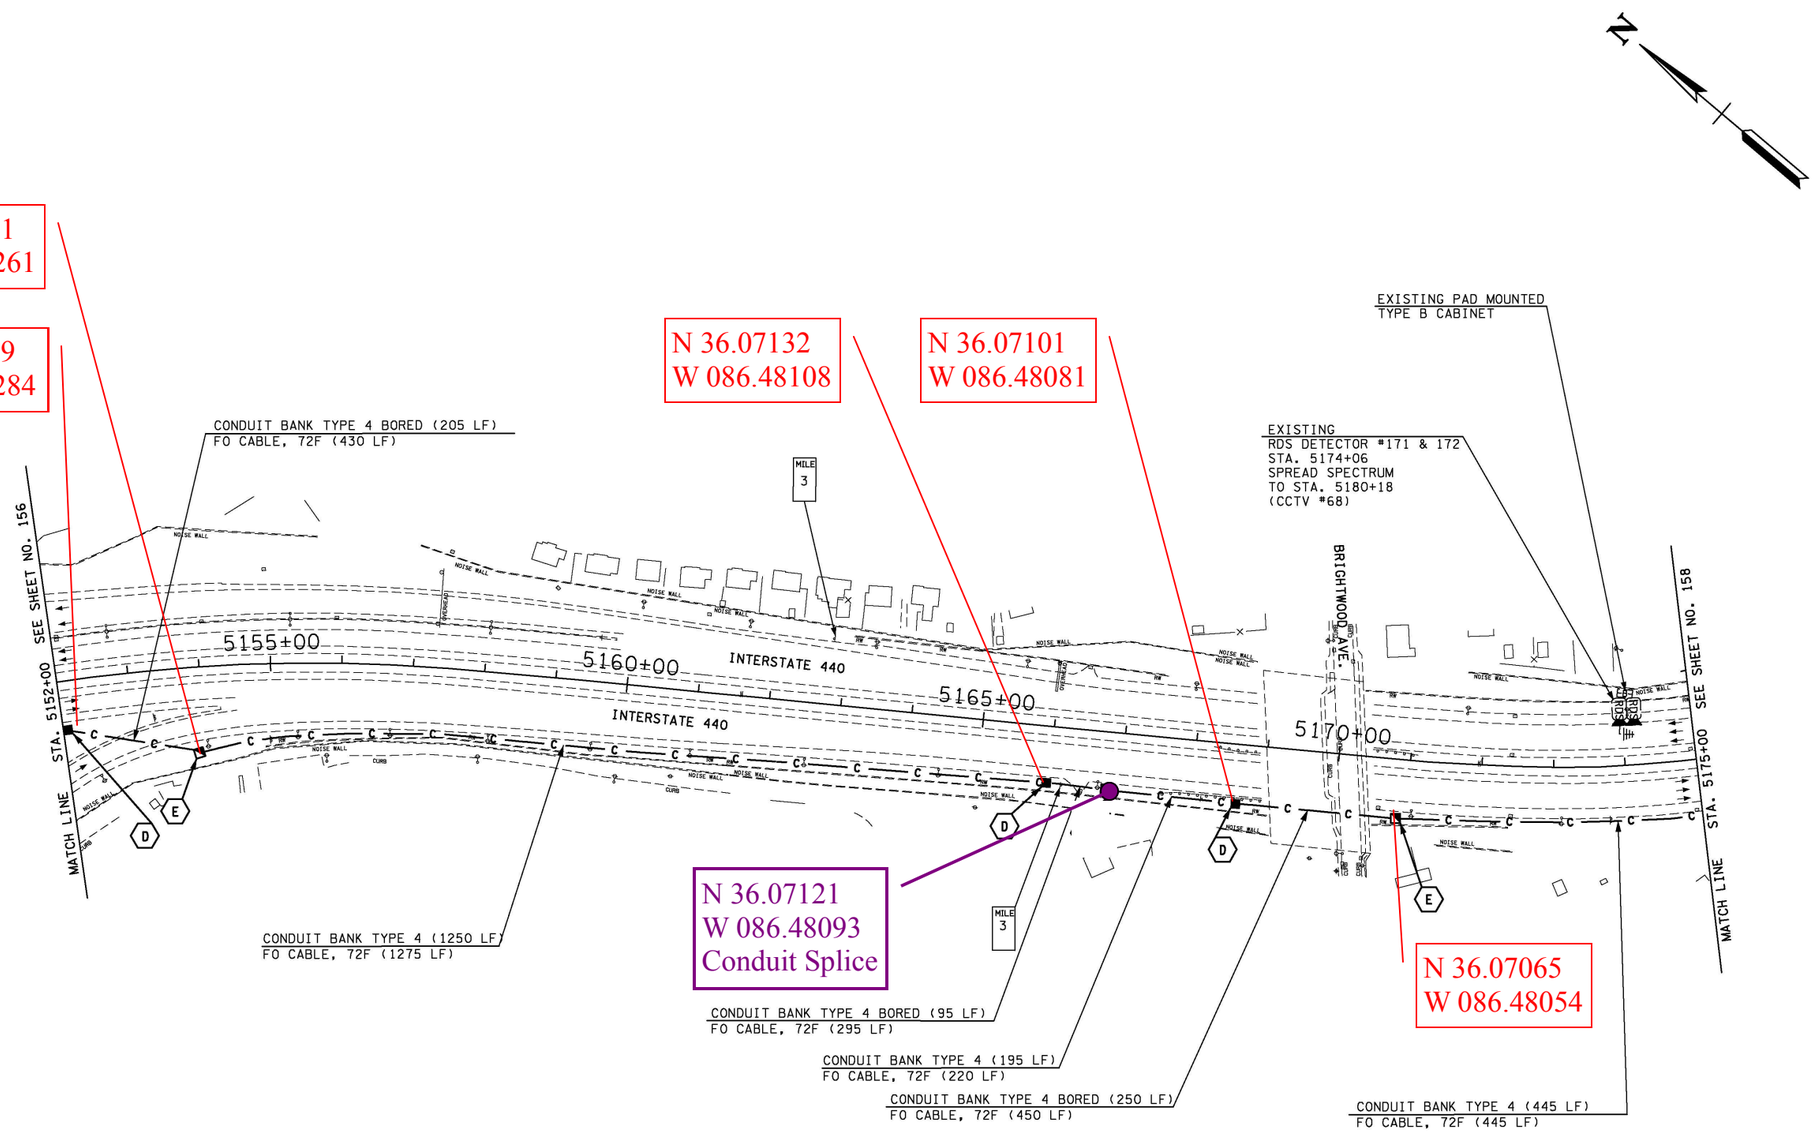

STATE OF TENNESSEE
DEPARTMENT OF TRANSPORTATION

ITS LAYOUT
I-440
STA. 5152+00 TO
STA. 5175+00

SCALE: 1"=100'

TENNESSEE D.O.T.
DESIGN DIVISION
FILE NO.

TYPE	YEAR	PROJECT NO.	SHEET NO.
CONST.	2007	CM-098-3(14)	158
As built	2010	.	.
.	.	.	.
.	.	.	.

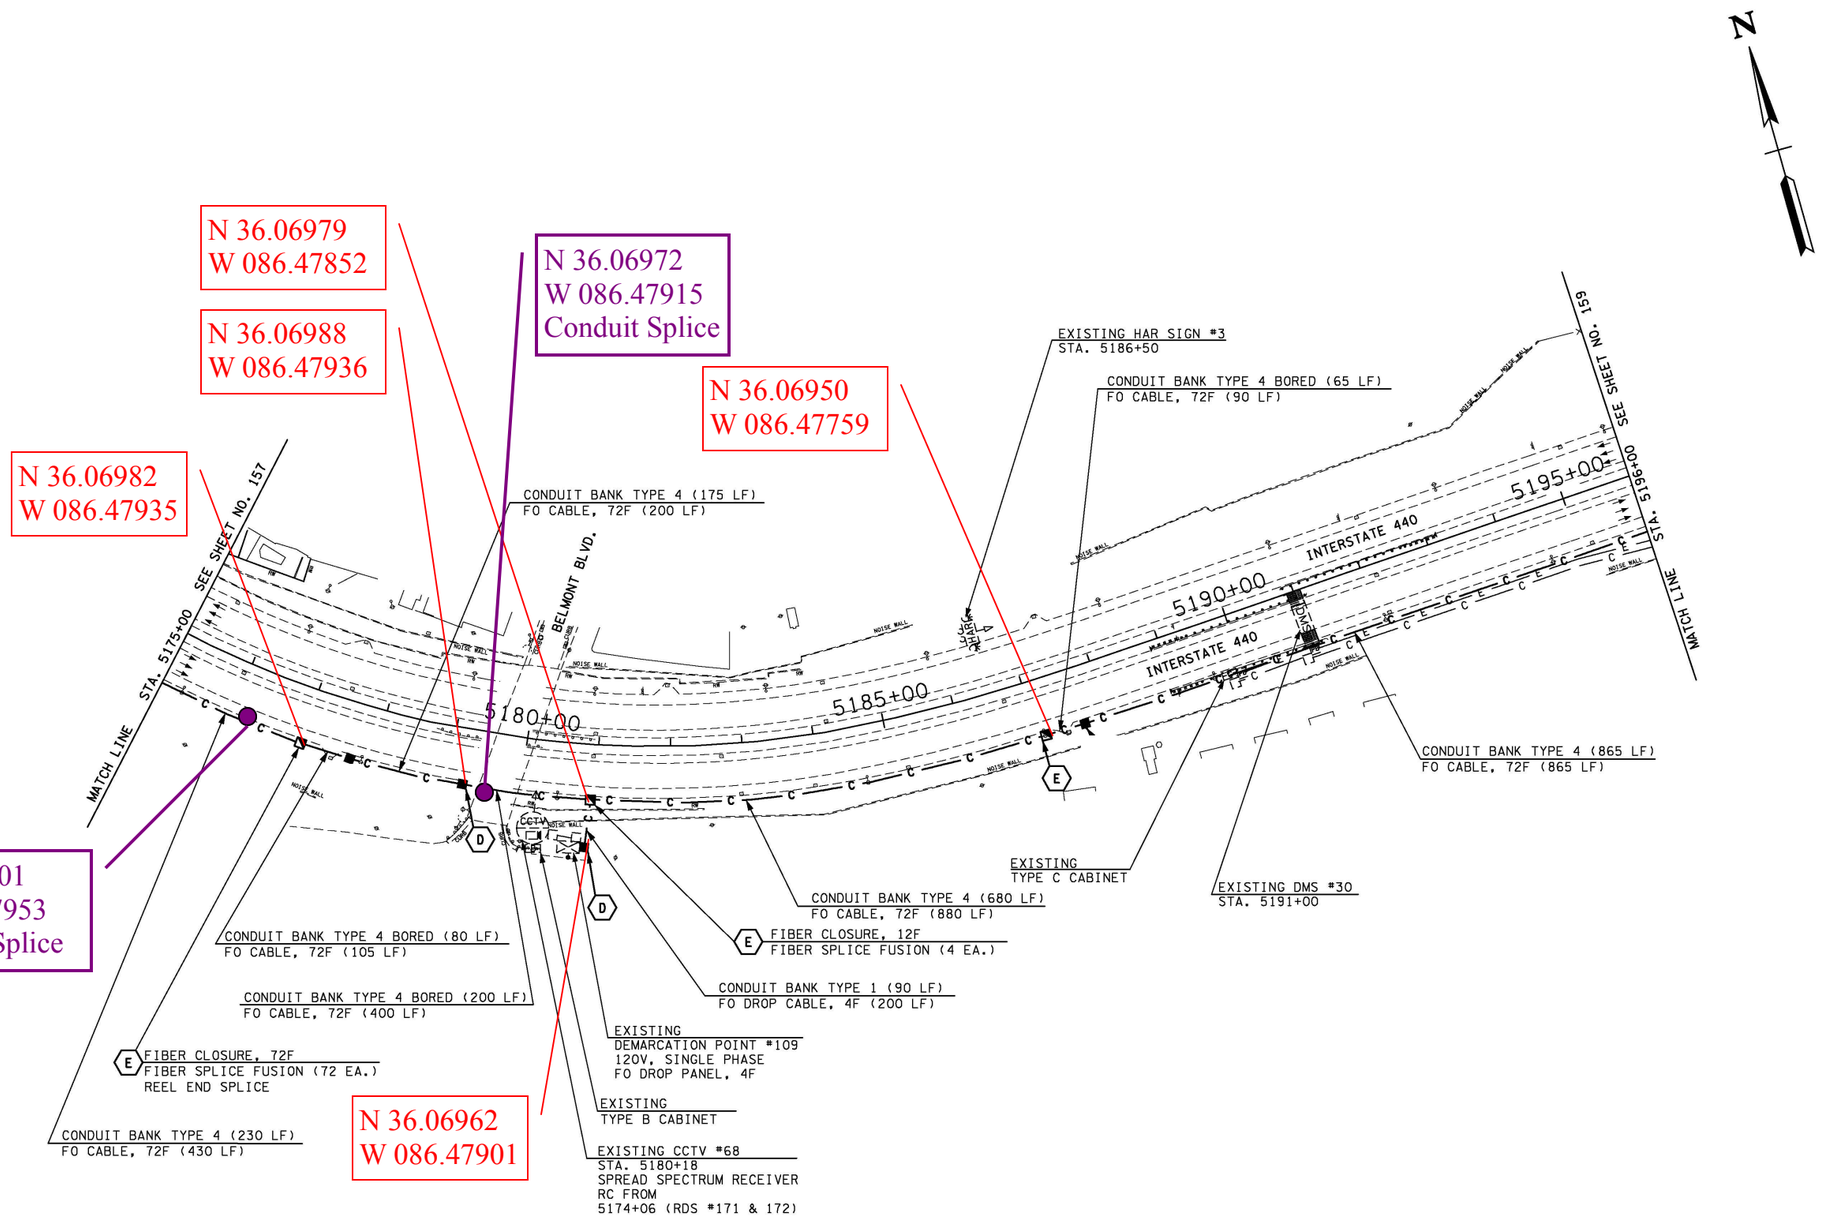

STATE OF TENNESSEE
DEPARTMENT OF TRANSPORTATION

ITS LAYOUT
I-440
STA. 5175+00 TO
STA. 5196+00

SCALE: 1"=100'

TENNESSEE D.O.T.
DESIGN DIVISION
FILE NO.

TYPE	YEAR	PROJECT NO.	SHEET NO.
CONST.	2007	CM-098-3(14)	159
As built	2010		

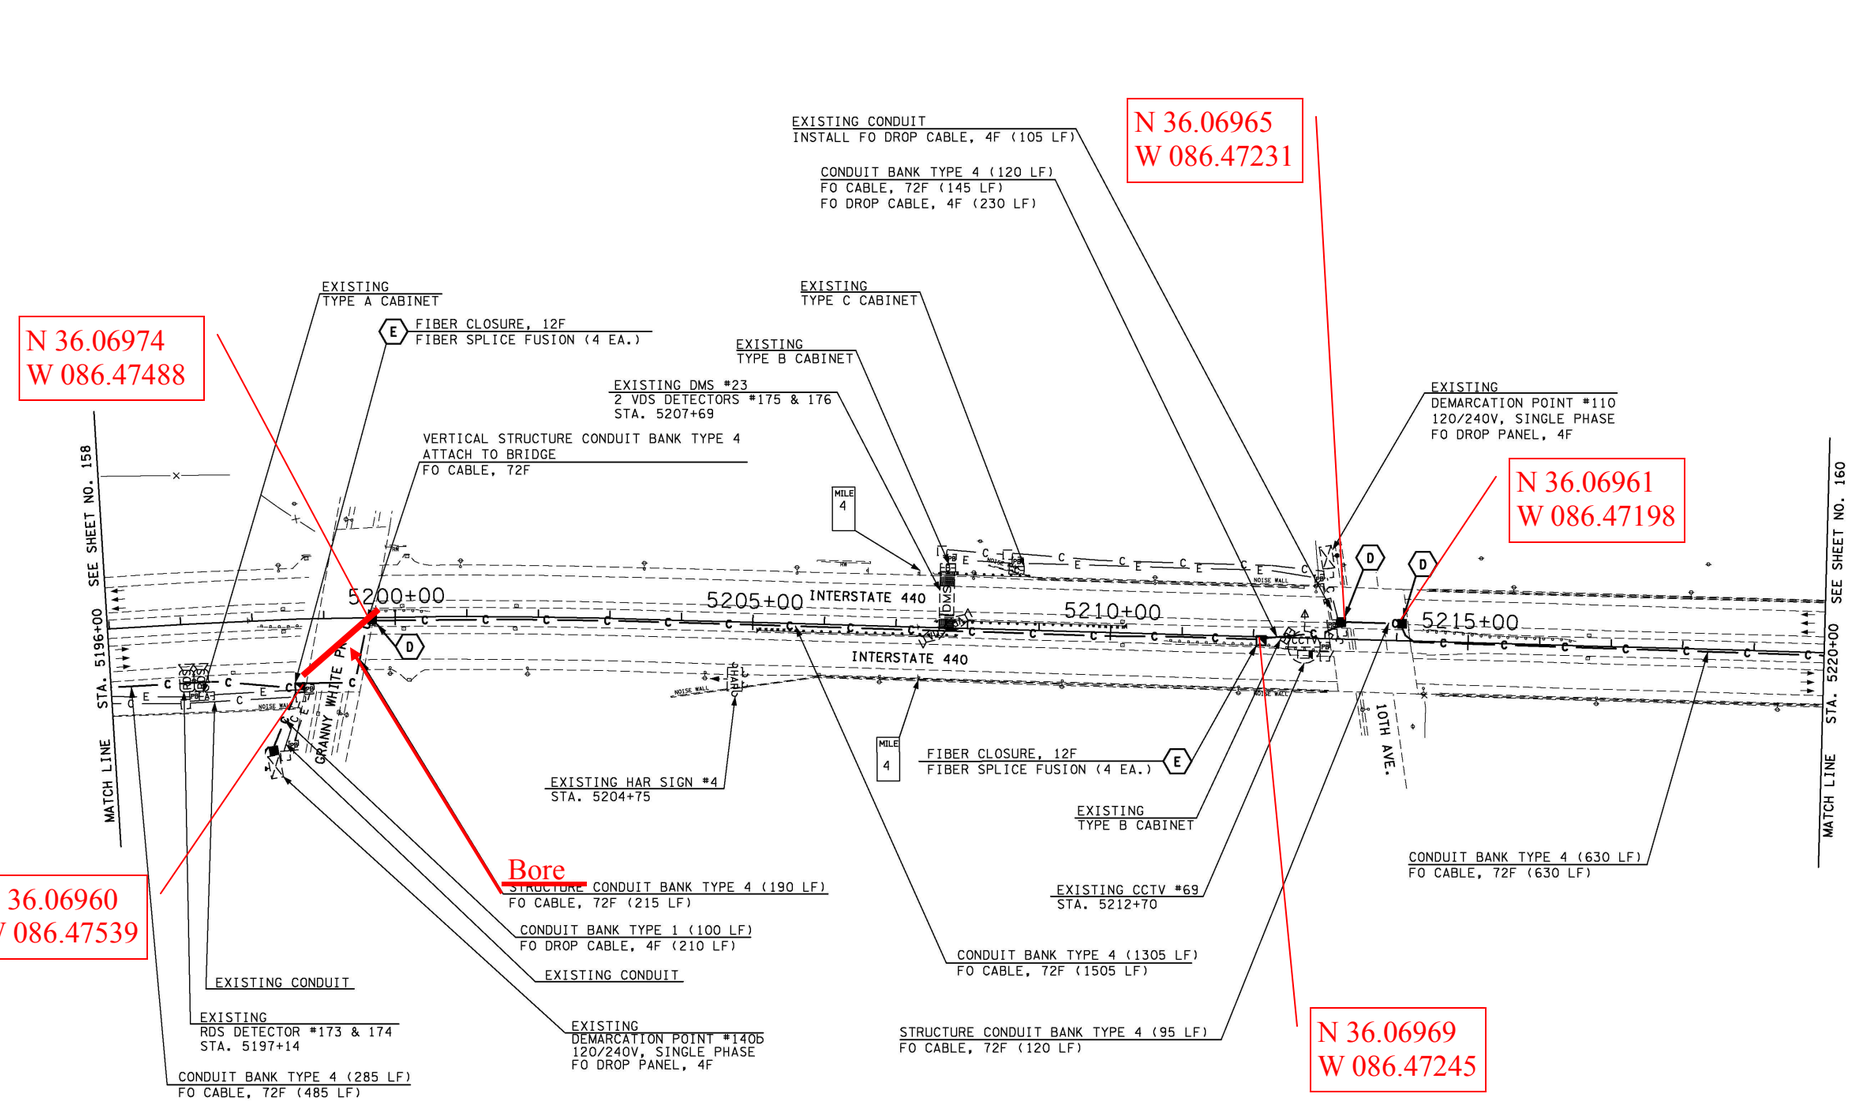

STATE OF TENNESSEE
DEPARTMENT OF TRANSPORTATION

ITS LAYOUT
I-440
STA. 5196+00 TO
STA. 5220+00

SCALE: 1"=100'

TENNESSEE D.O.T.
DESIGN DIVISION
FILE NO.

TYPE	YEAR	PROJECT NO.	SHEET NO.
CONST.	2007	CM-098-3(14)	160
As built	2010	.	.
.	.	.	.
.	.	.	.

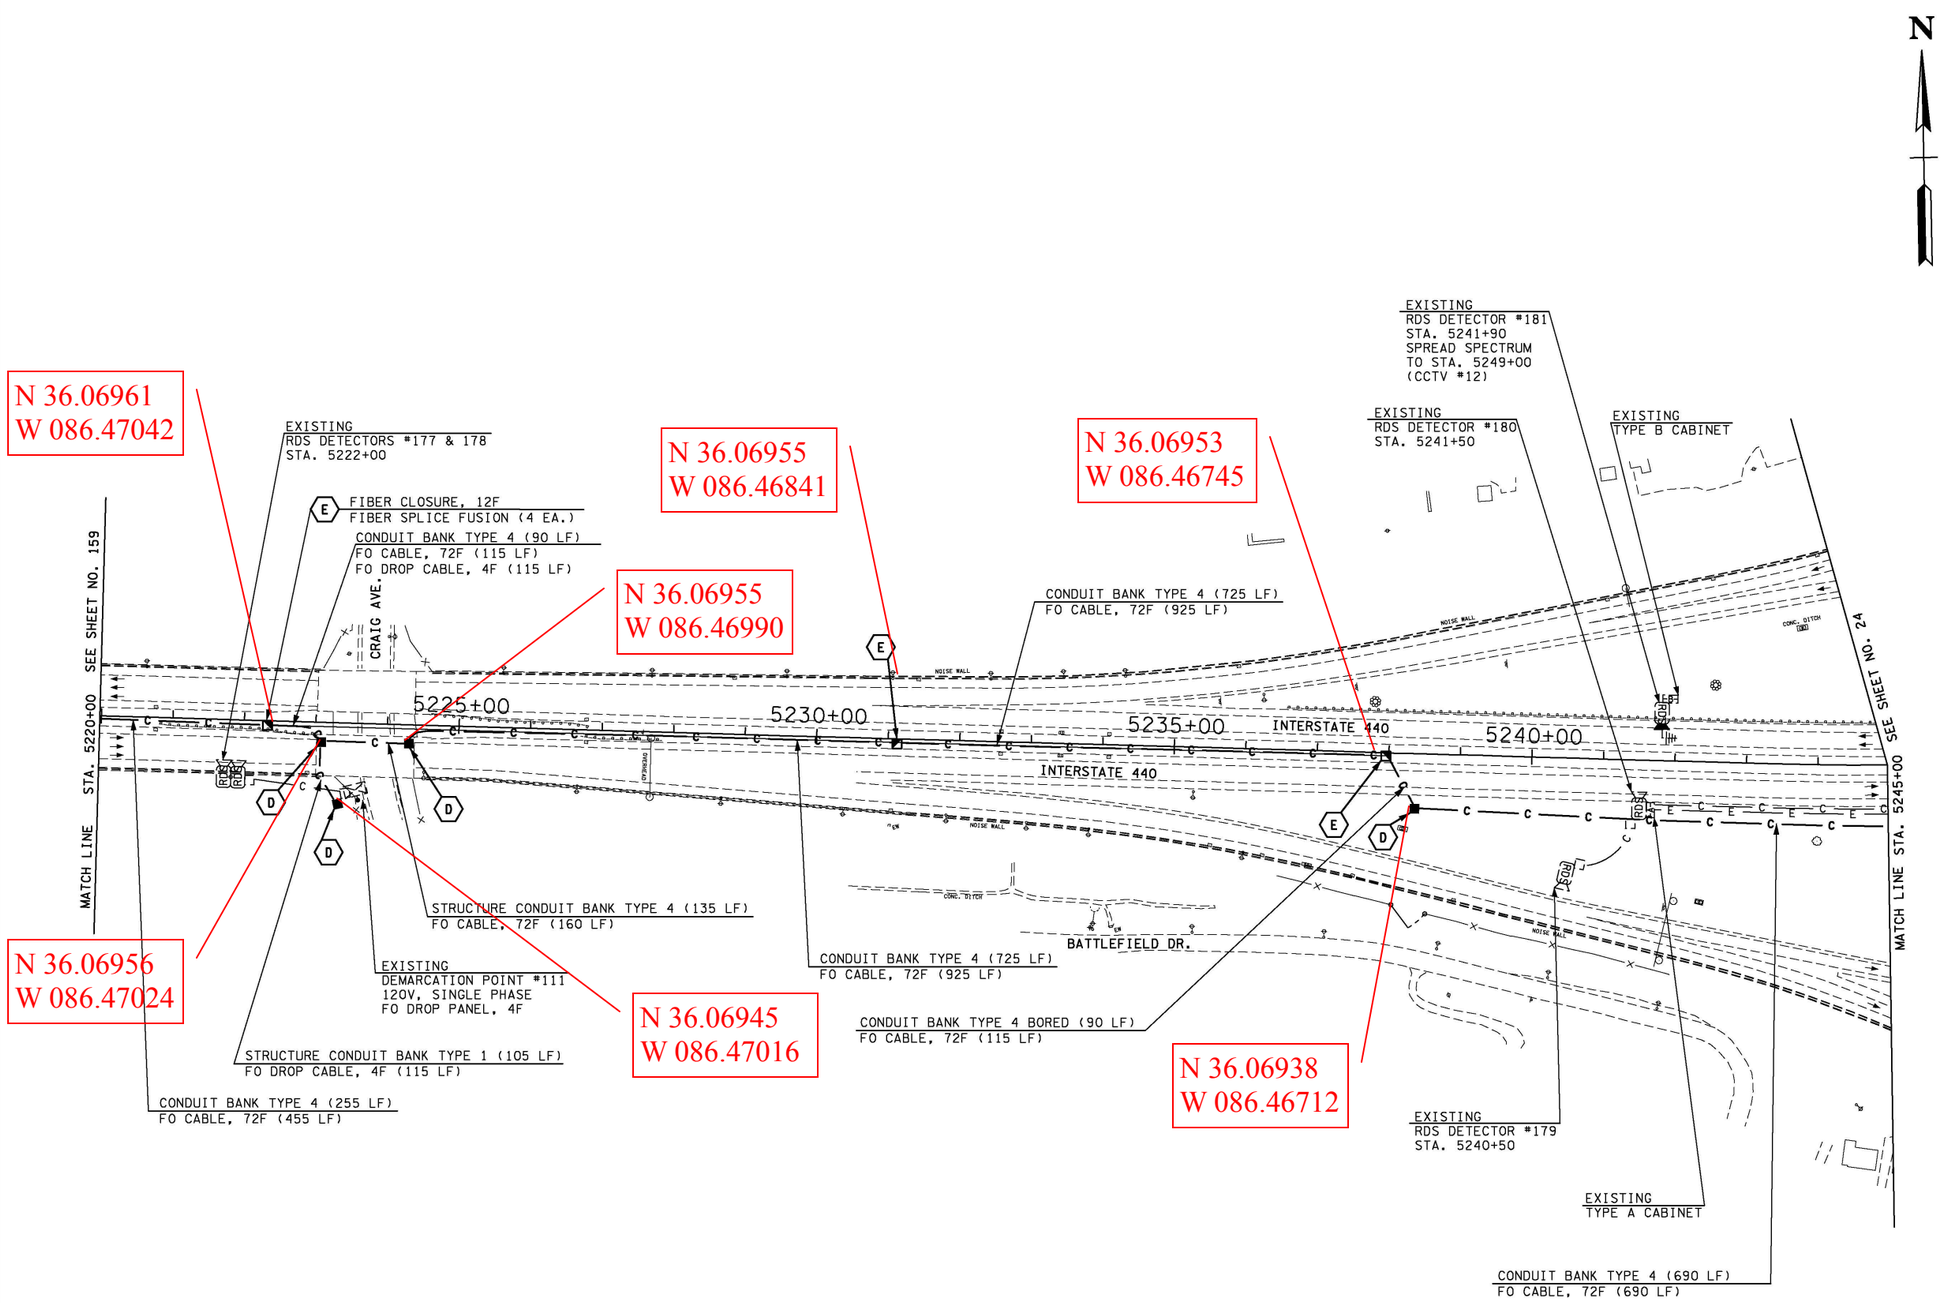

STATE OF TENNESSEE
DEPARTMENT OF TRANSPORTATION

ITS LAYOUT
I-440
STA. 5220+00 TO
STA. 5245+00

SCALE: 1"=100'

TENNESSEE D.O.T.
DESIGN DIVISION
FILE NO.

NOTE: 1. CCTV #53 TO BE REPLACED WITH A NEW CCTV, BRACKETS, WIRING, AND CONTROL EQUIPMENT.

TYPE	YEAR	PROJECT NO.	SHEET NO.
CONST.	2007	CM-098-3(14)	24
As built	2010		

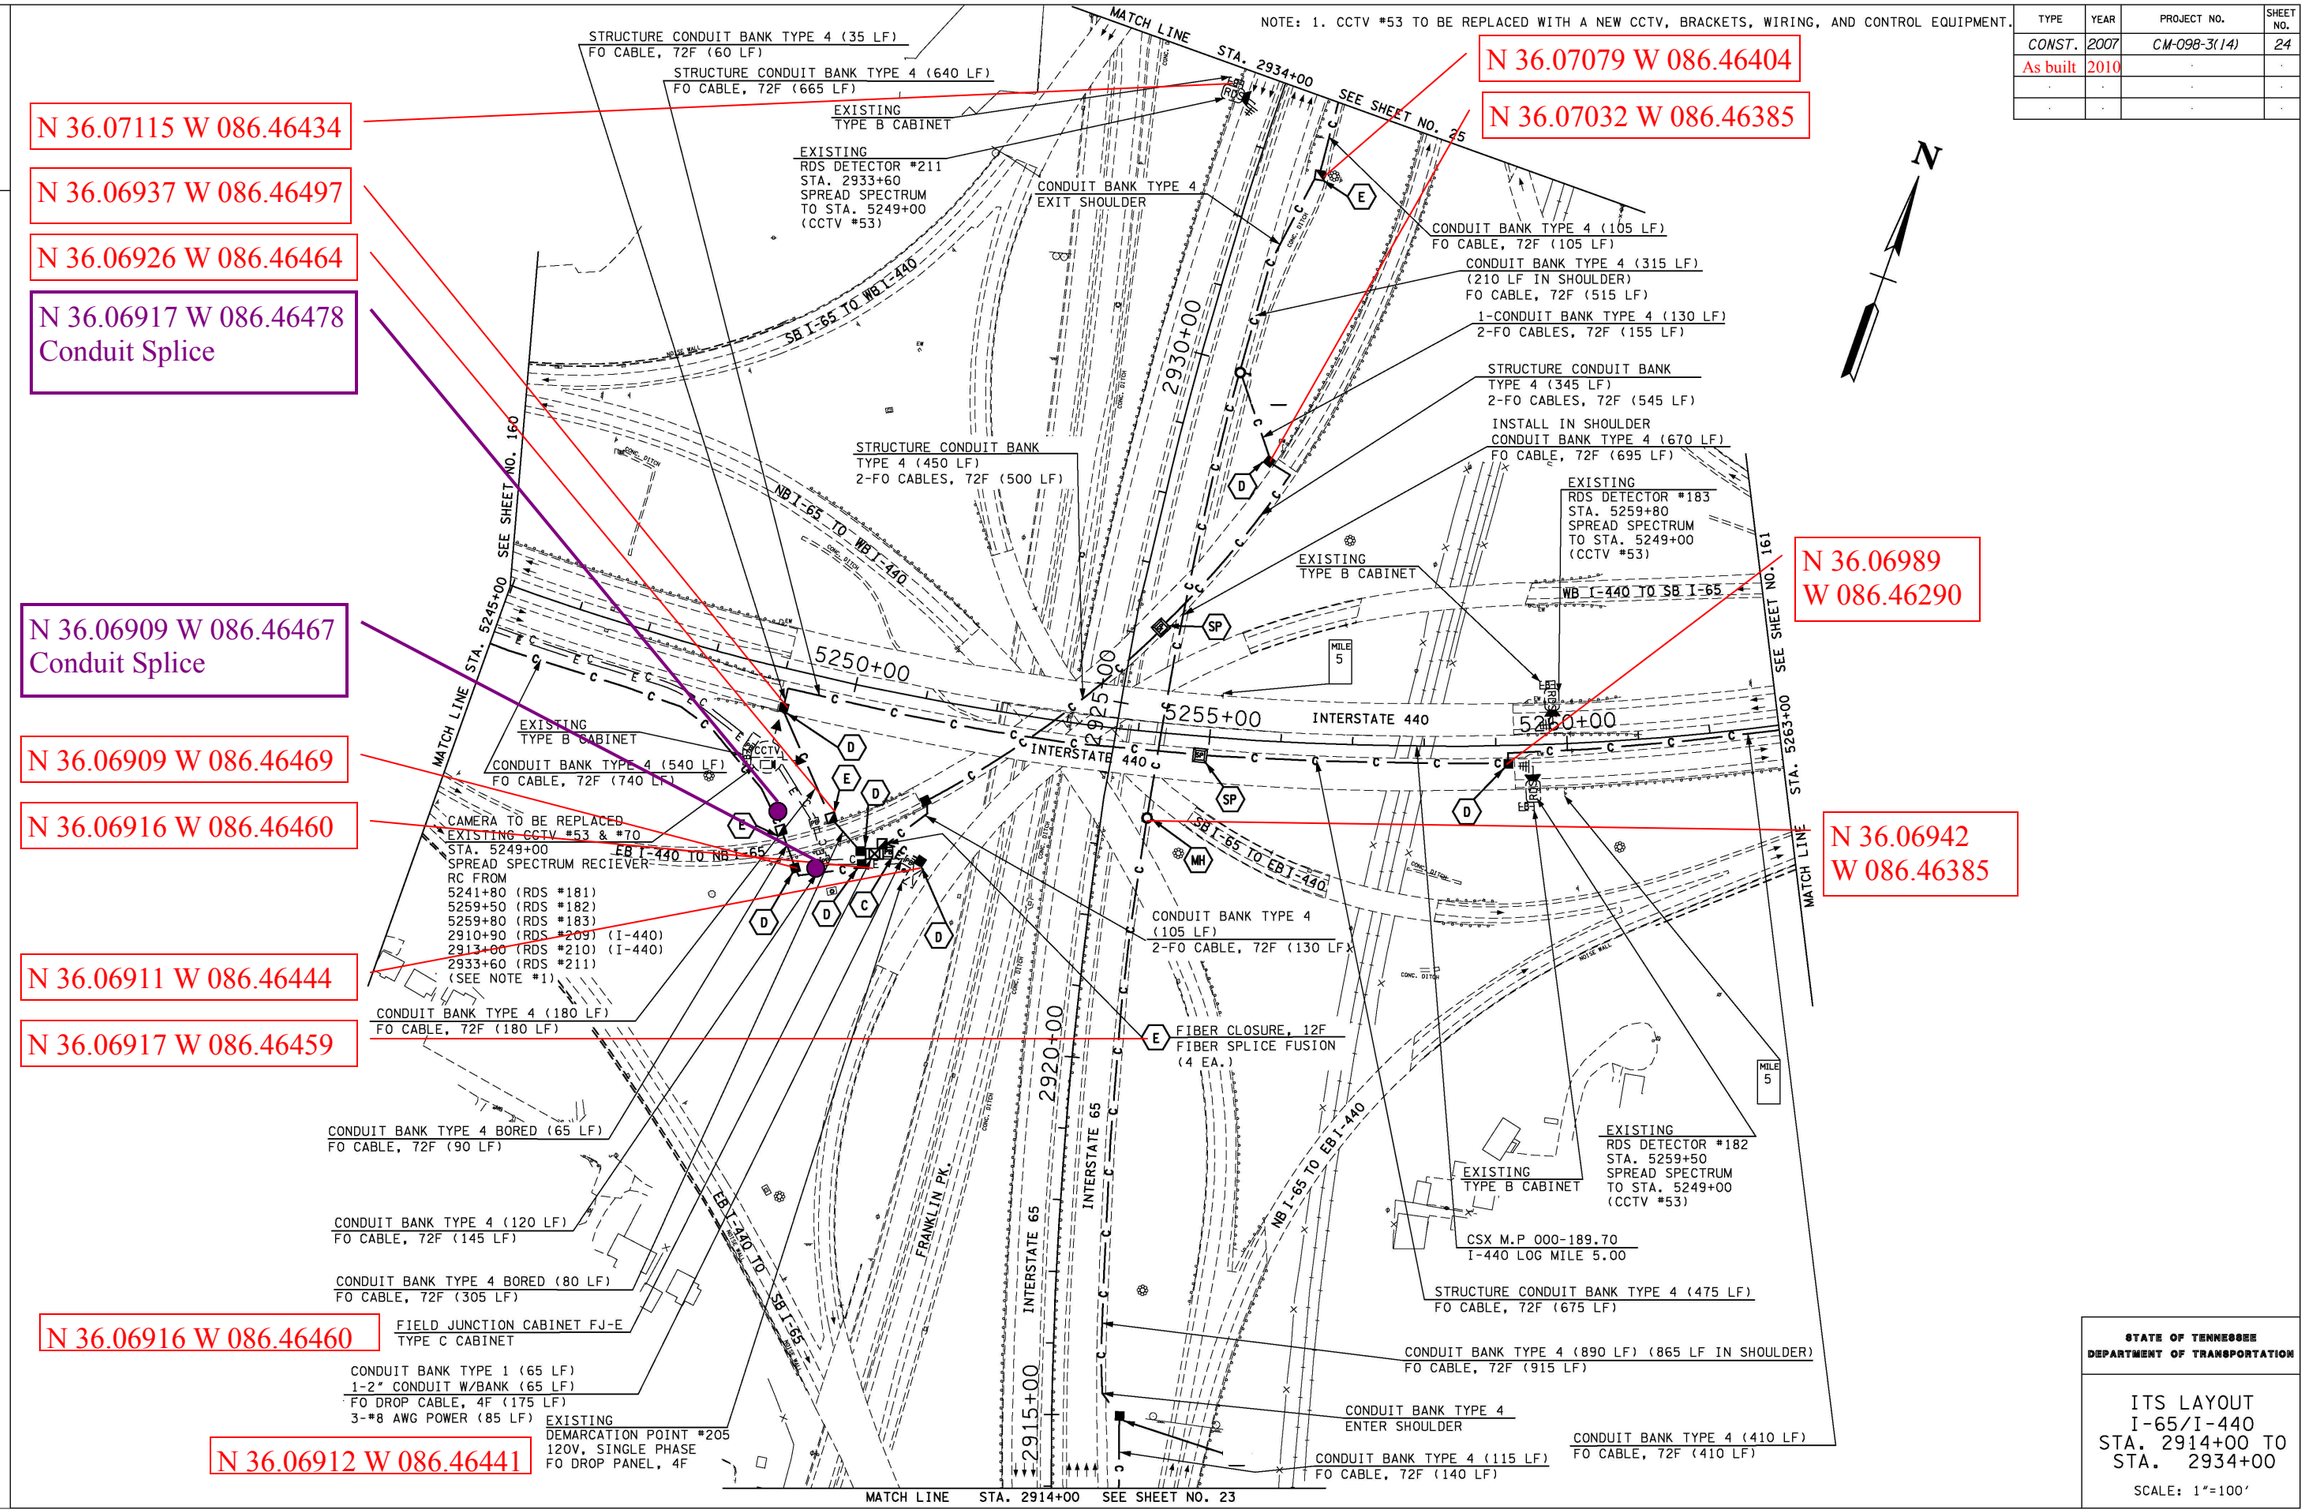

STATE OF TENNESSEE
DEPARTMENT OF TRANSPORTATION

ITS LAYOUT
I-65/I-440
STA. 2914+00 TO
STA. 2934+00

SCALE: 1"=100'

TENNESSEE D.O.T.
DESIGN DIVISION
FILE NO.

TYPE	YEAR	PROJECT NO.	SHEET NO.
As built	2010	.	.
.	.	.	.
.	.	.	.

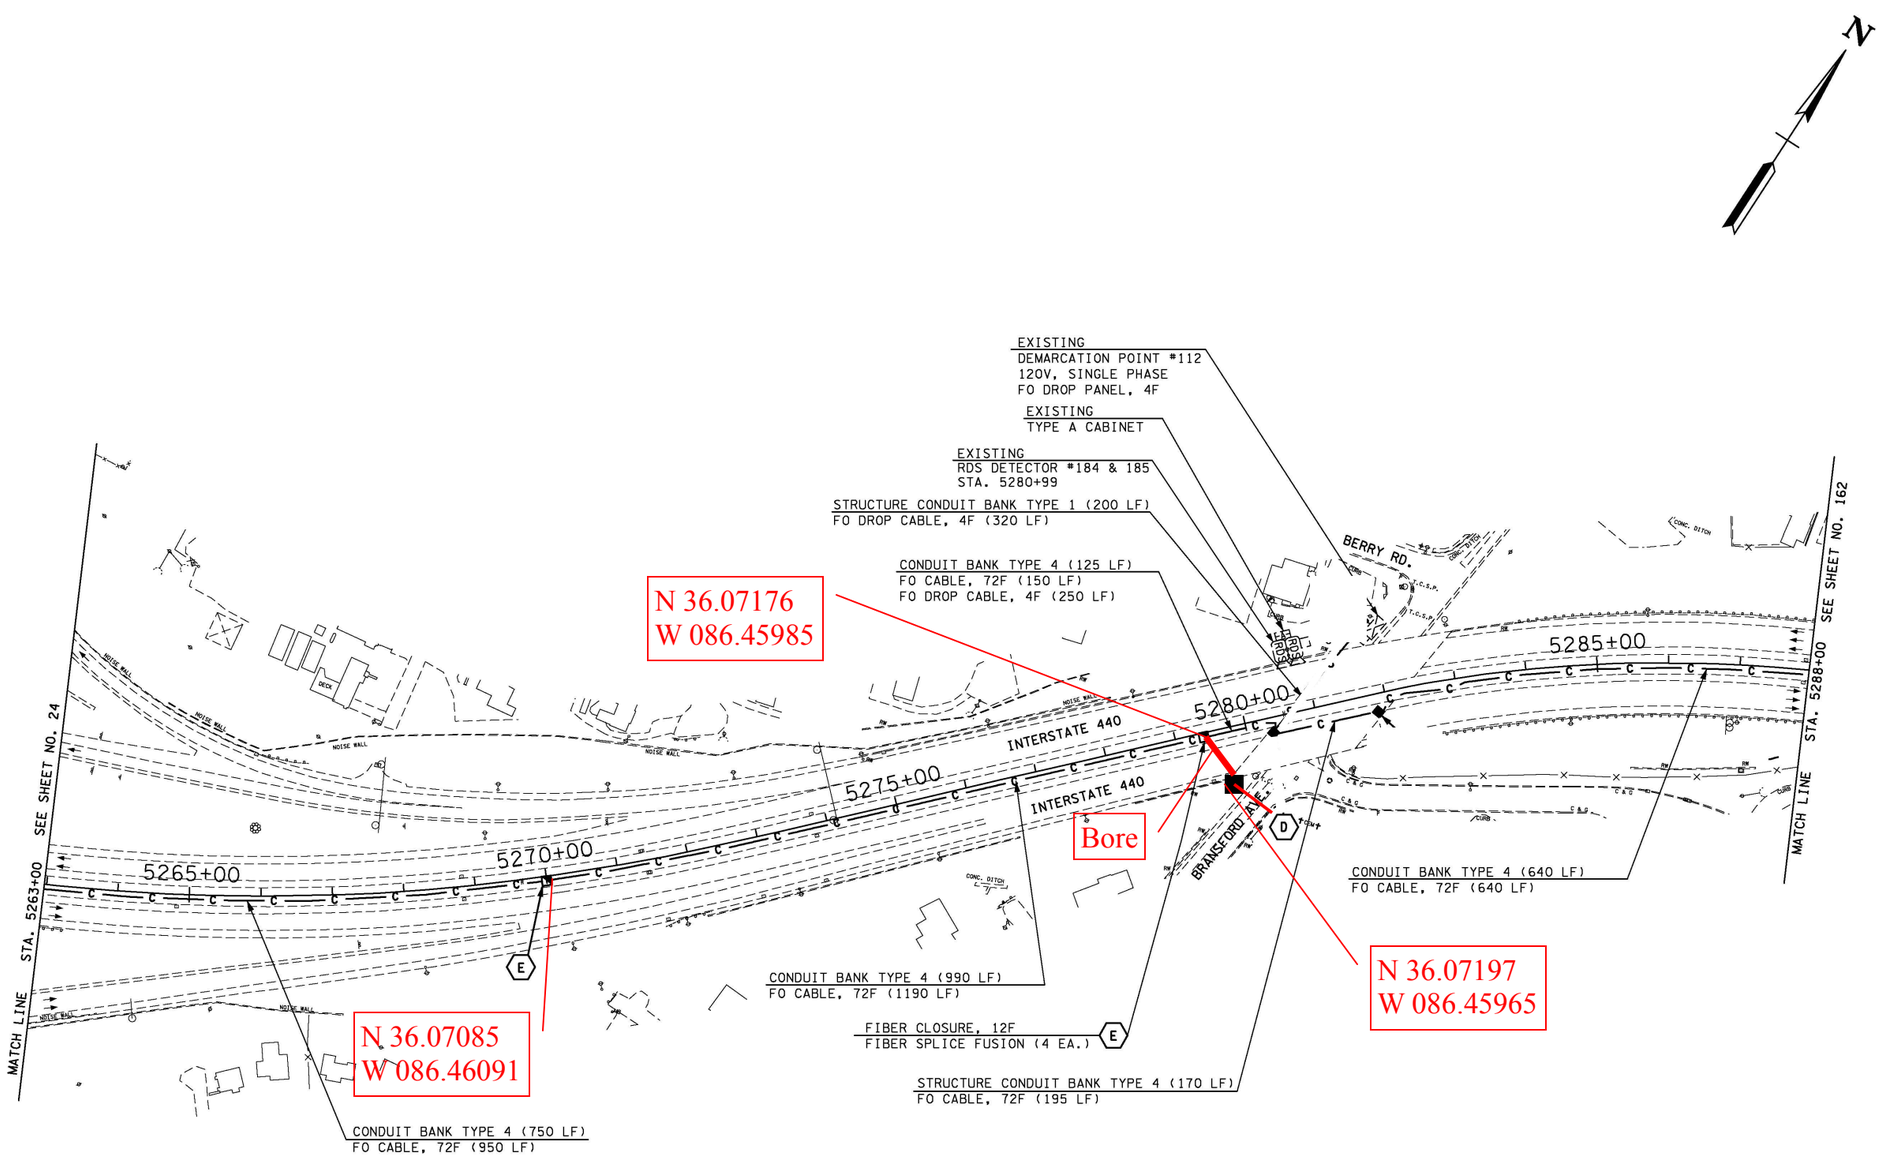

STATE OF TENNESSEE
DEPARTMENT OF TRANSPORTATION

ITS LAYOUT
I-440
STA. 5263+00 TO
STA. 5288+00

SCALE: 1"=100'

TENNESSEE D.O.T.
DESIGN DIVISION
FILE NO.

TYPE	YEAR	PROJECT NO.	SHEET NO.
CONST.	2007	CM-098-3(14)	162
As built	2010	.	.
.	.	.	.
.	.	.	.

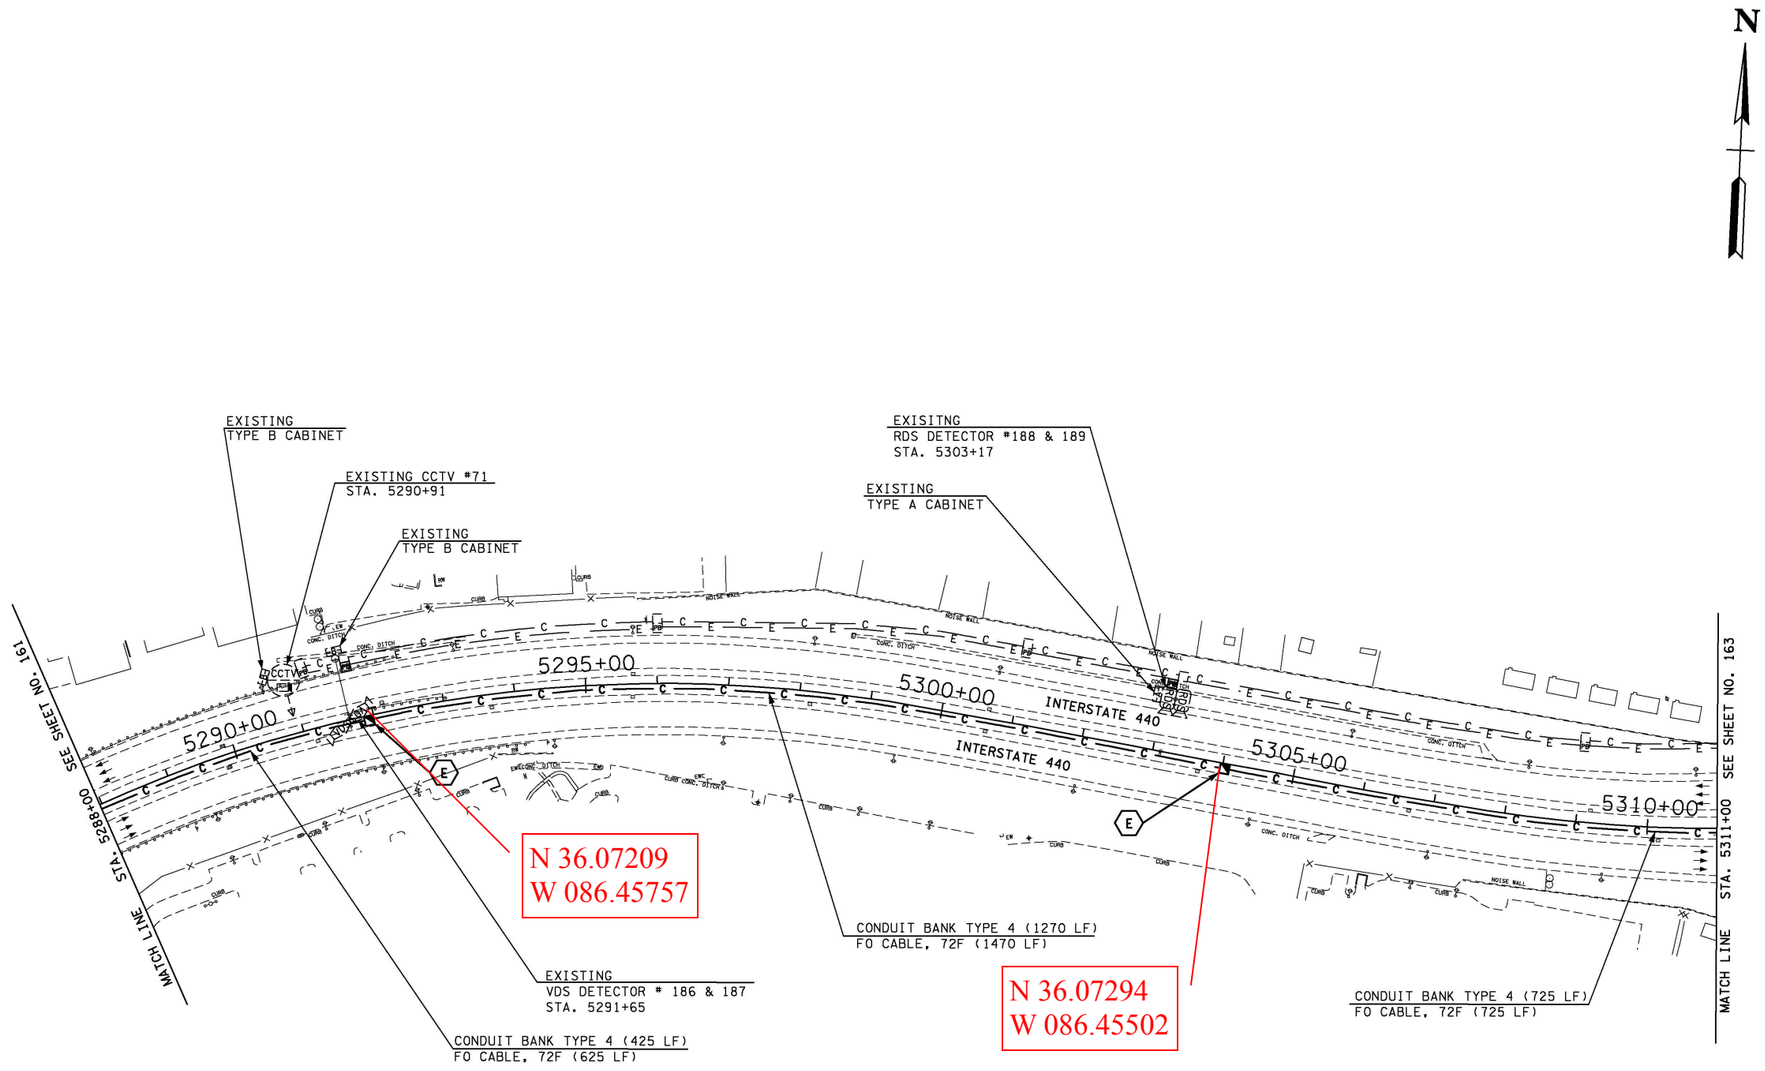

STATE OF TENNESSEE
DEPARTMENT OF TRANSPORTATION

ITS LAYOUT
I-440
STA. 5288+00 TO
STA. 5311+00

SCALE: 1"=100'

TENNESSEE D.O.T.
DESIGN DIVISION
FILE NO.

TYPE	YEAR	PROJECT NO.	SHEET NO.
CONST.	2007	CM-098-3(14)	163
As built	2010		

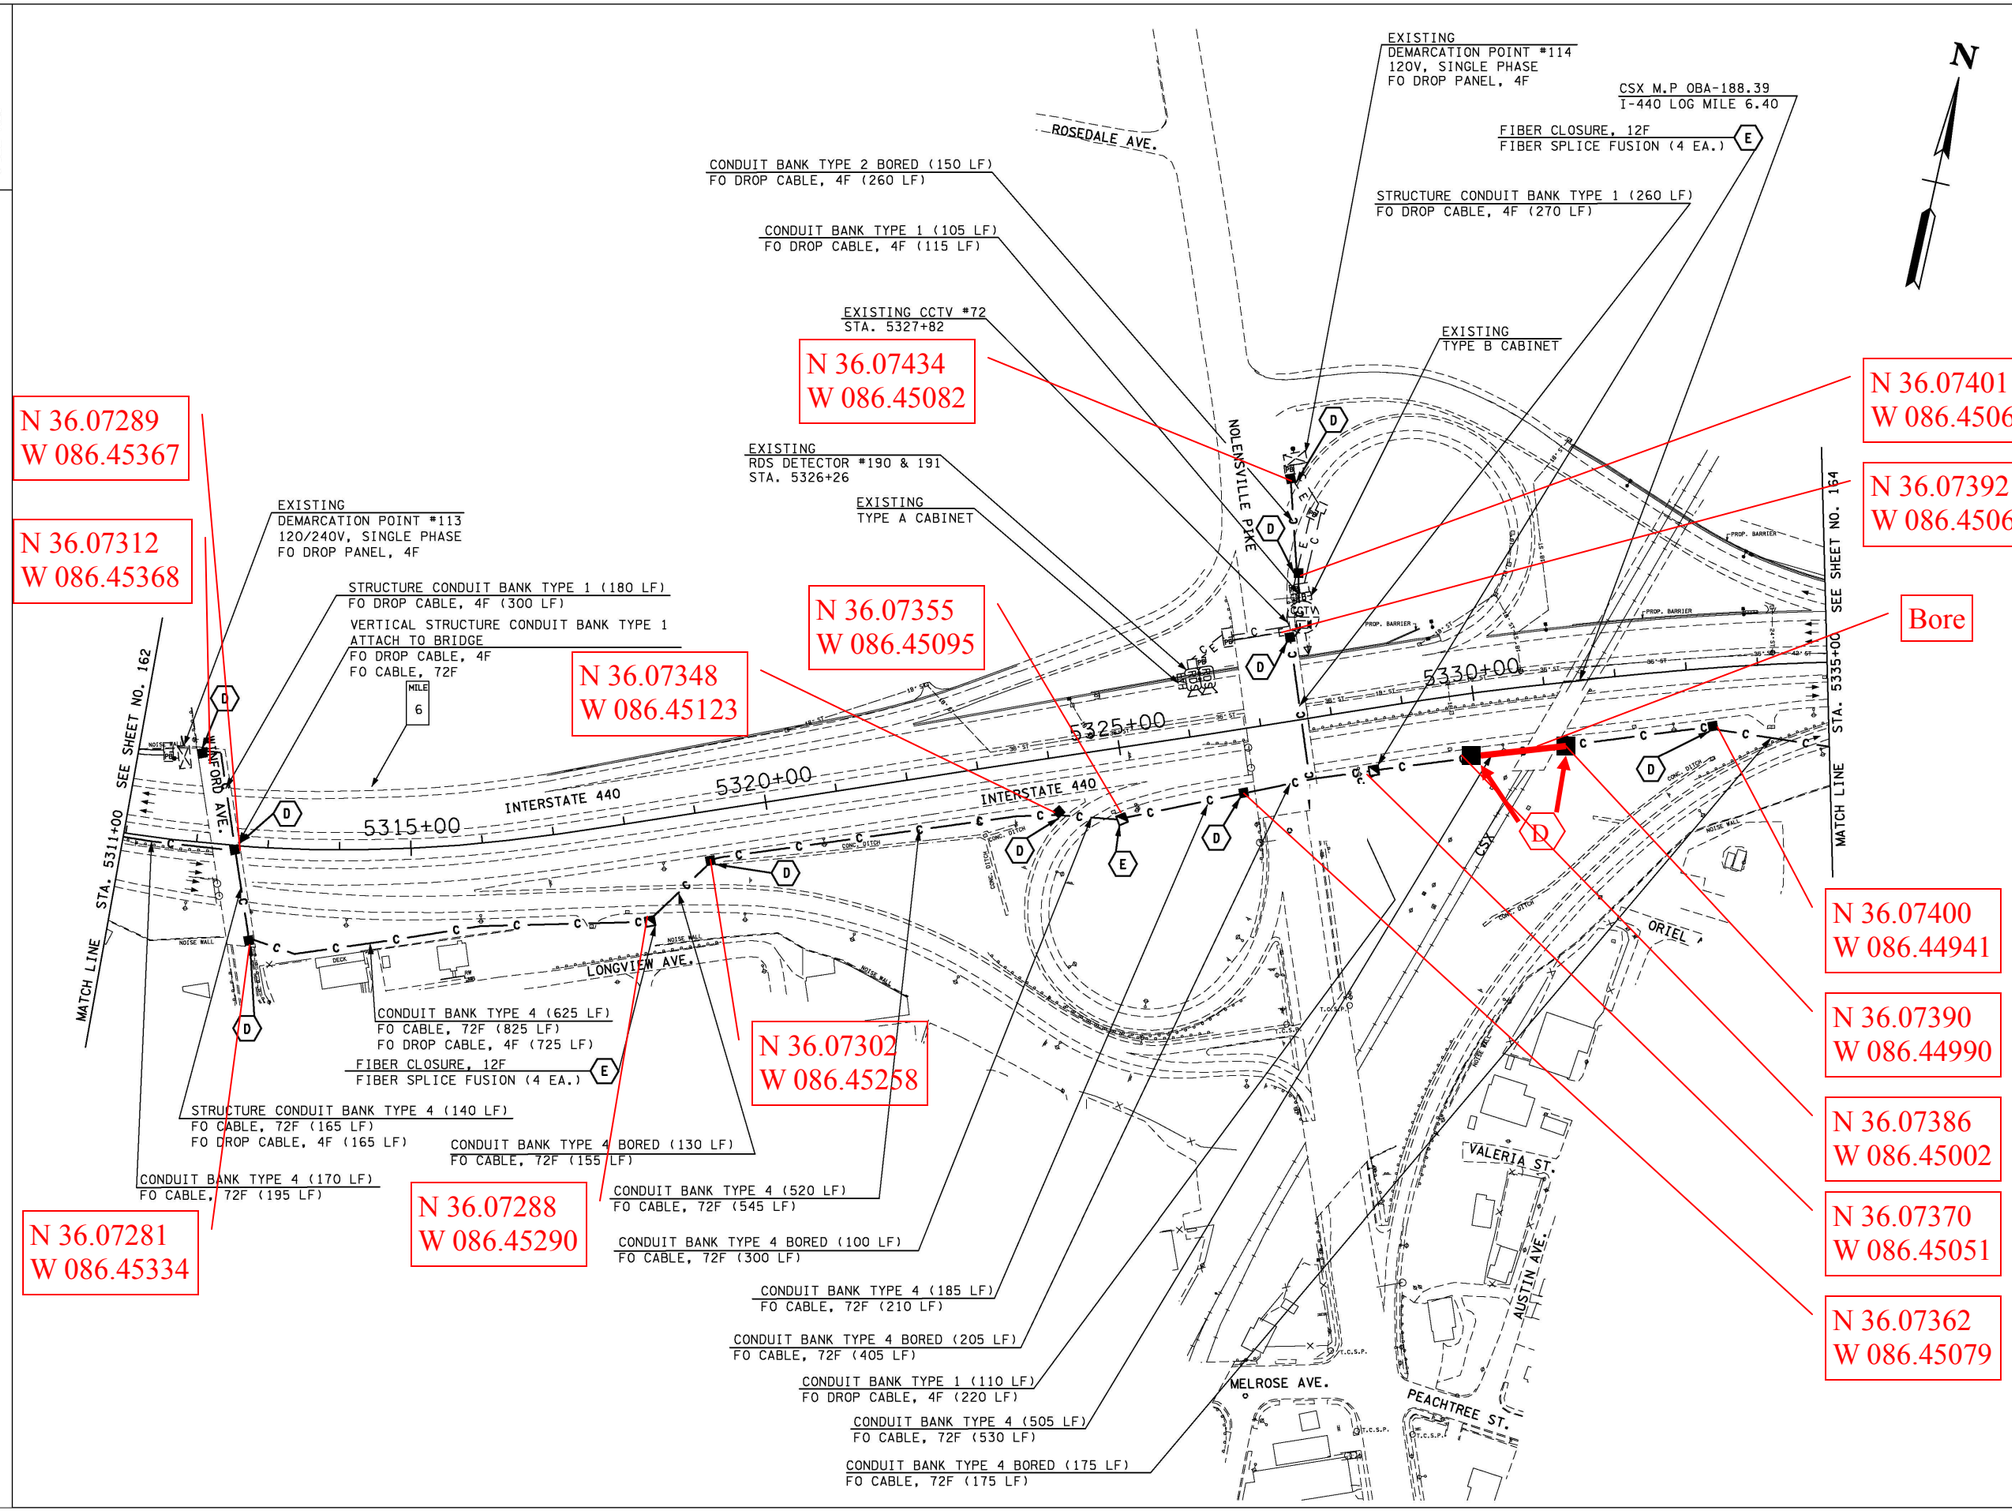

STATE OF TENNESSEE
DEPARTMENT OF TRANSPORTATION

ITS LAYOUT
I-440
STA. 5311+00 TO
STA. 5335+00

SCALE: 1"=100'

TENNESSEE D.O.T.
DESIGN DIVISION
FILE NO.

TYPE	YEAR	PROJECT NO.	SHEET NO.
CONST.	2007	CM-098-3(14)	164
As built	2010	.	.
.	.	.	.
.	.	.	.

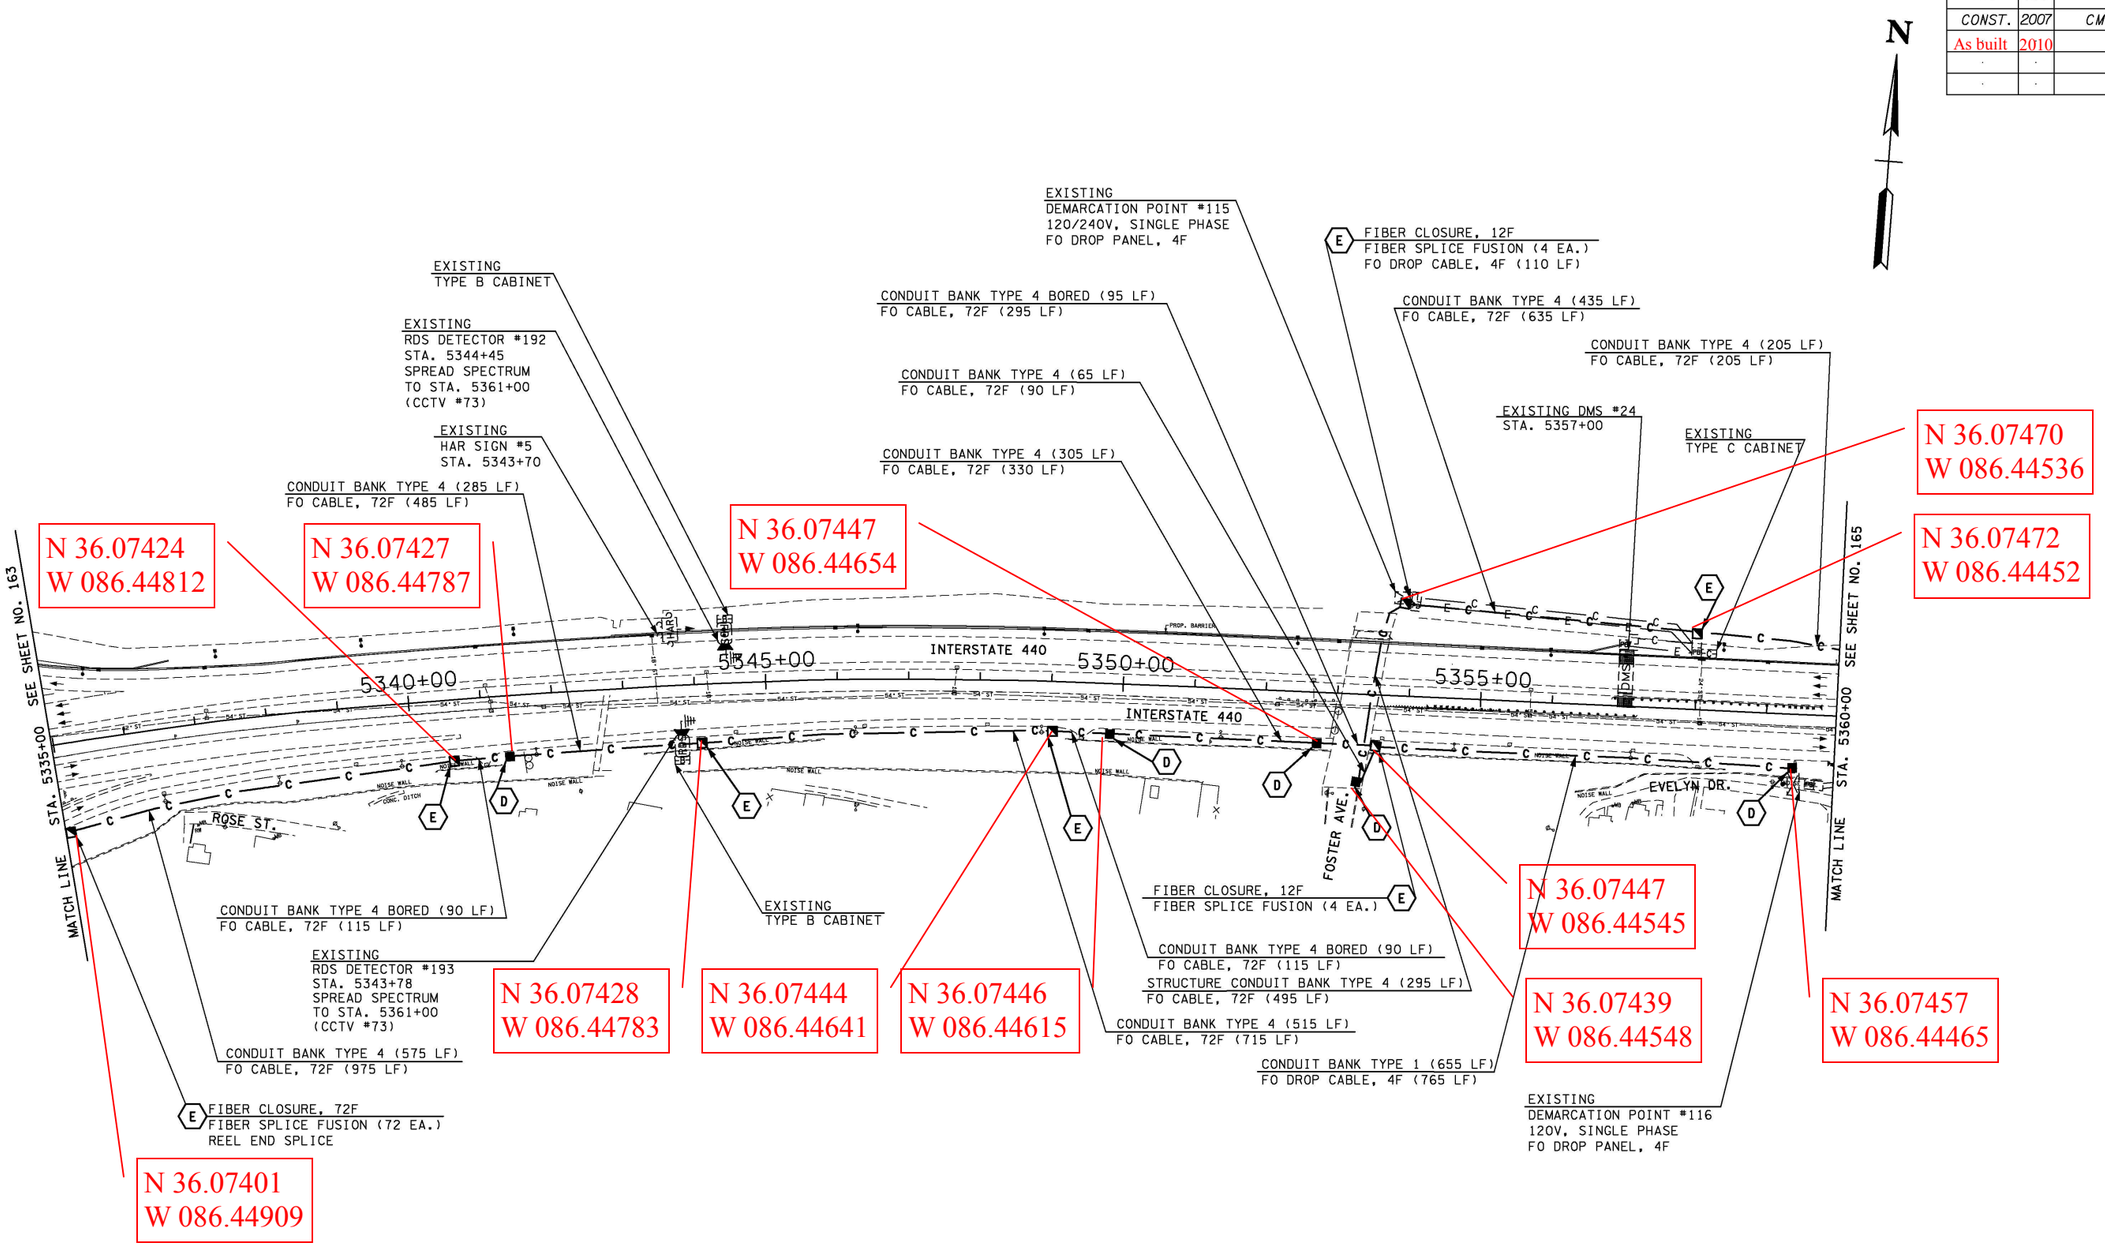

STATE OF TENNESSEE
DEPARTMENT OF TRANSPORTATION

ITS LAYOUT
I-440
STA. 5335+00 TO
STA. 5360+00

SCALE: 1"=100'

TENNESSEE D.O.T.
DESIGN DIVISION
FILE NO.

TYPE	YEAR	PROJECT NO.	SHEET NO.
CONST.	2007	CM-098-3(14)	165
As built	2010		

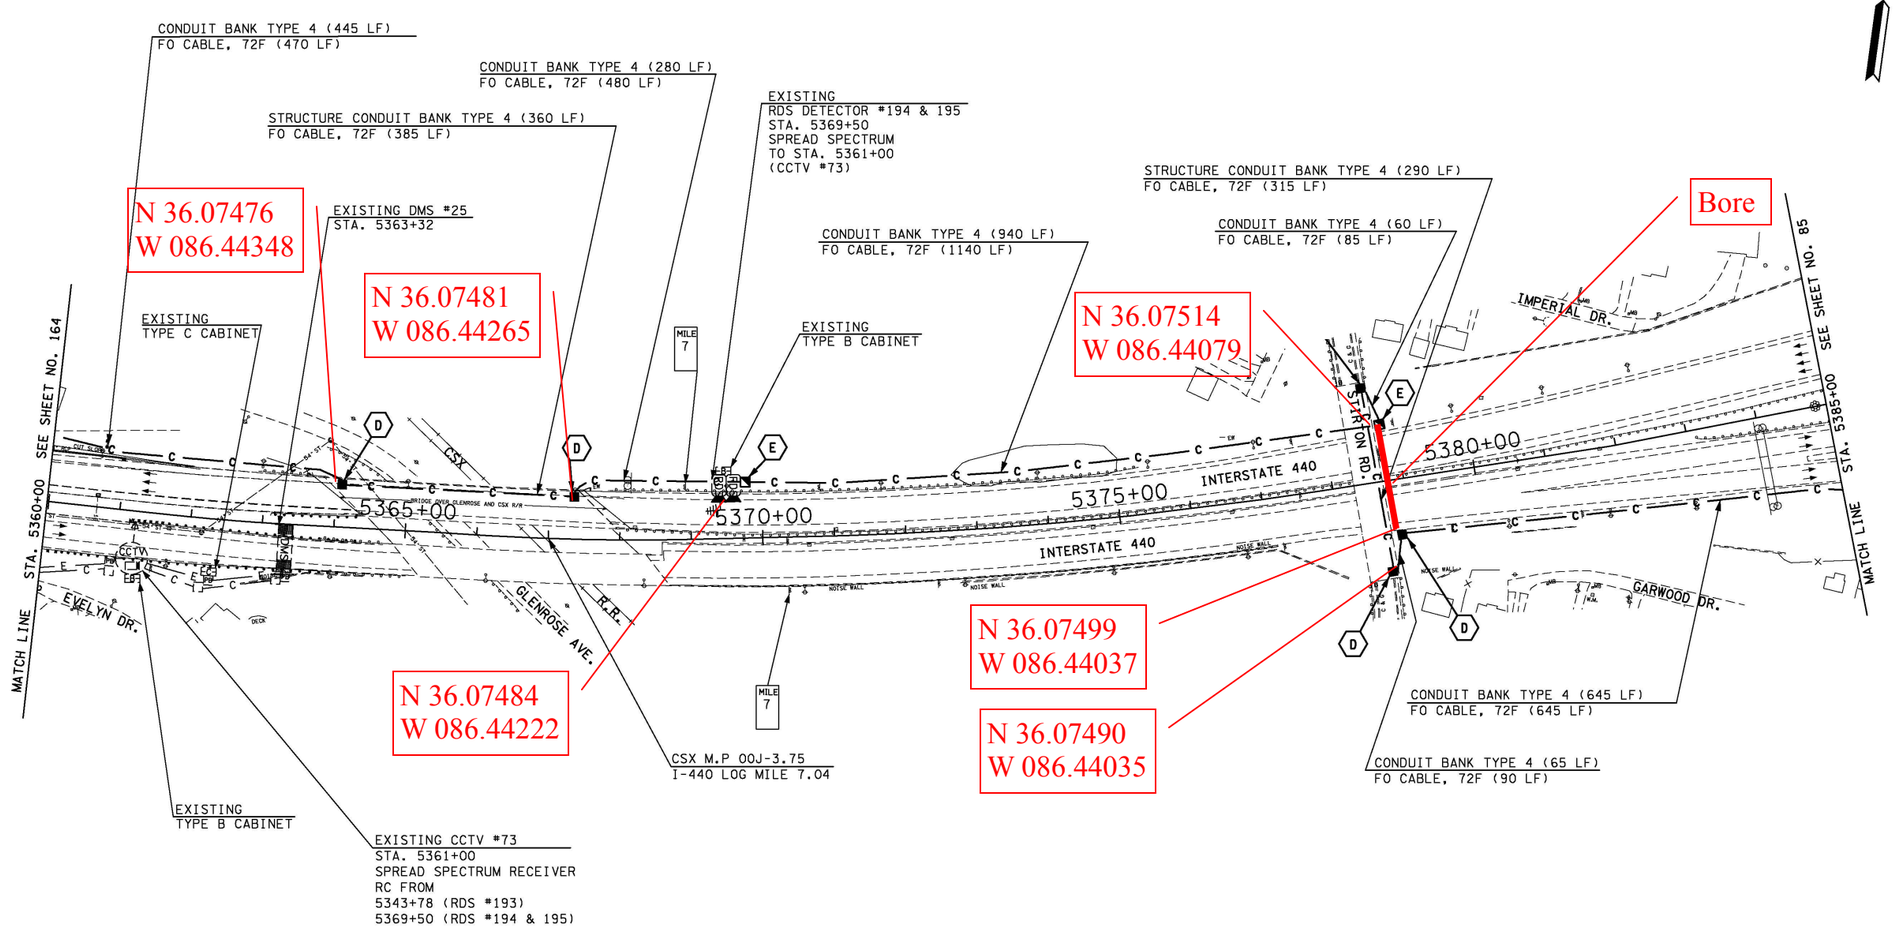

STATE OF TENNESSEE
DEPARTMENT OF TRANSPORTATION

ITS LAYOUT
I-440
STA. 5360+00 TO
STA. 5385+00

SCALE: 1"=100'

TENNESSEE D.O.T.
DESIGN DIVISION
FILE NO.

TYPE	YEAR	PROJECT NO.	SHEET NO.
CONST.	2007	CM-098-3(14)	85
As built	2010		

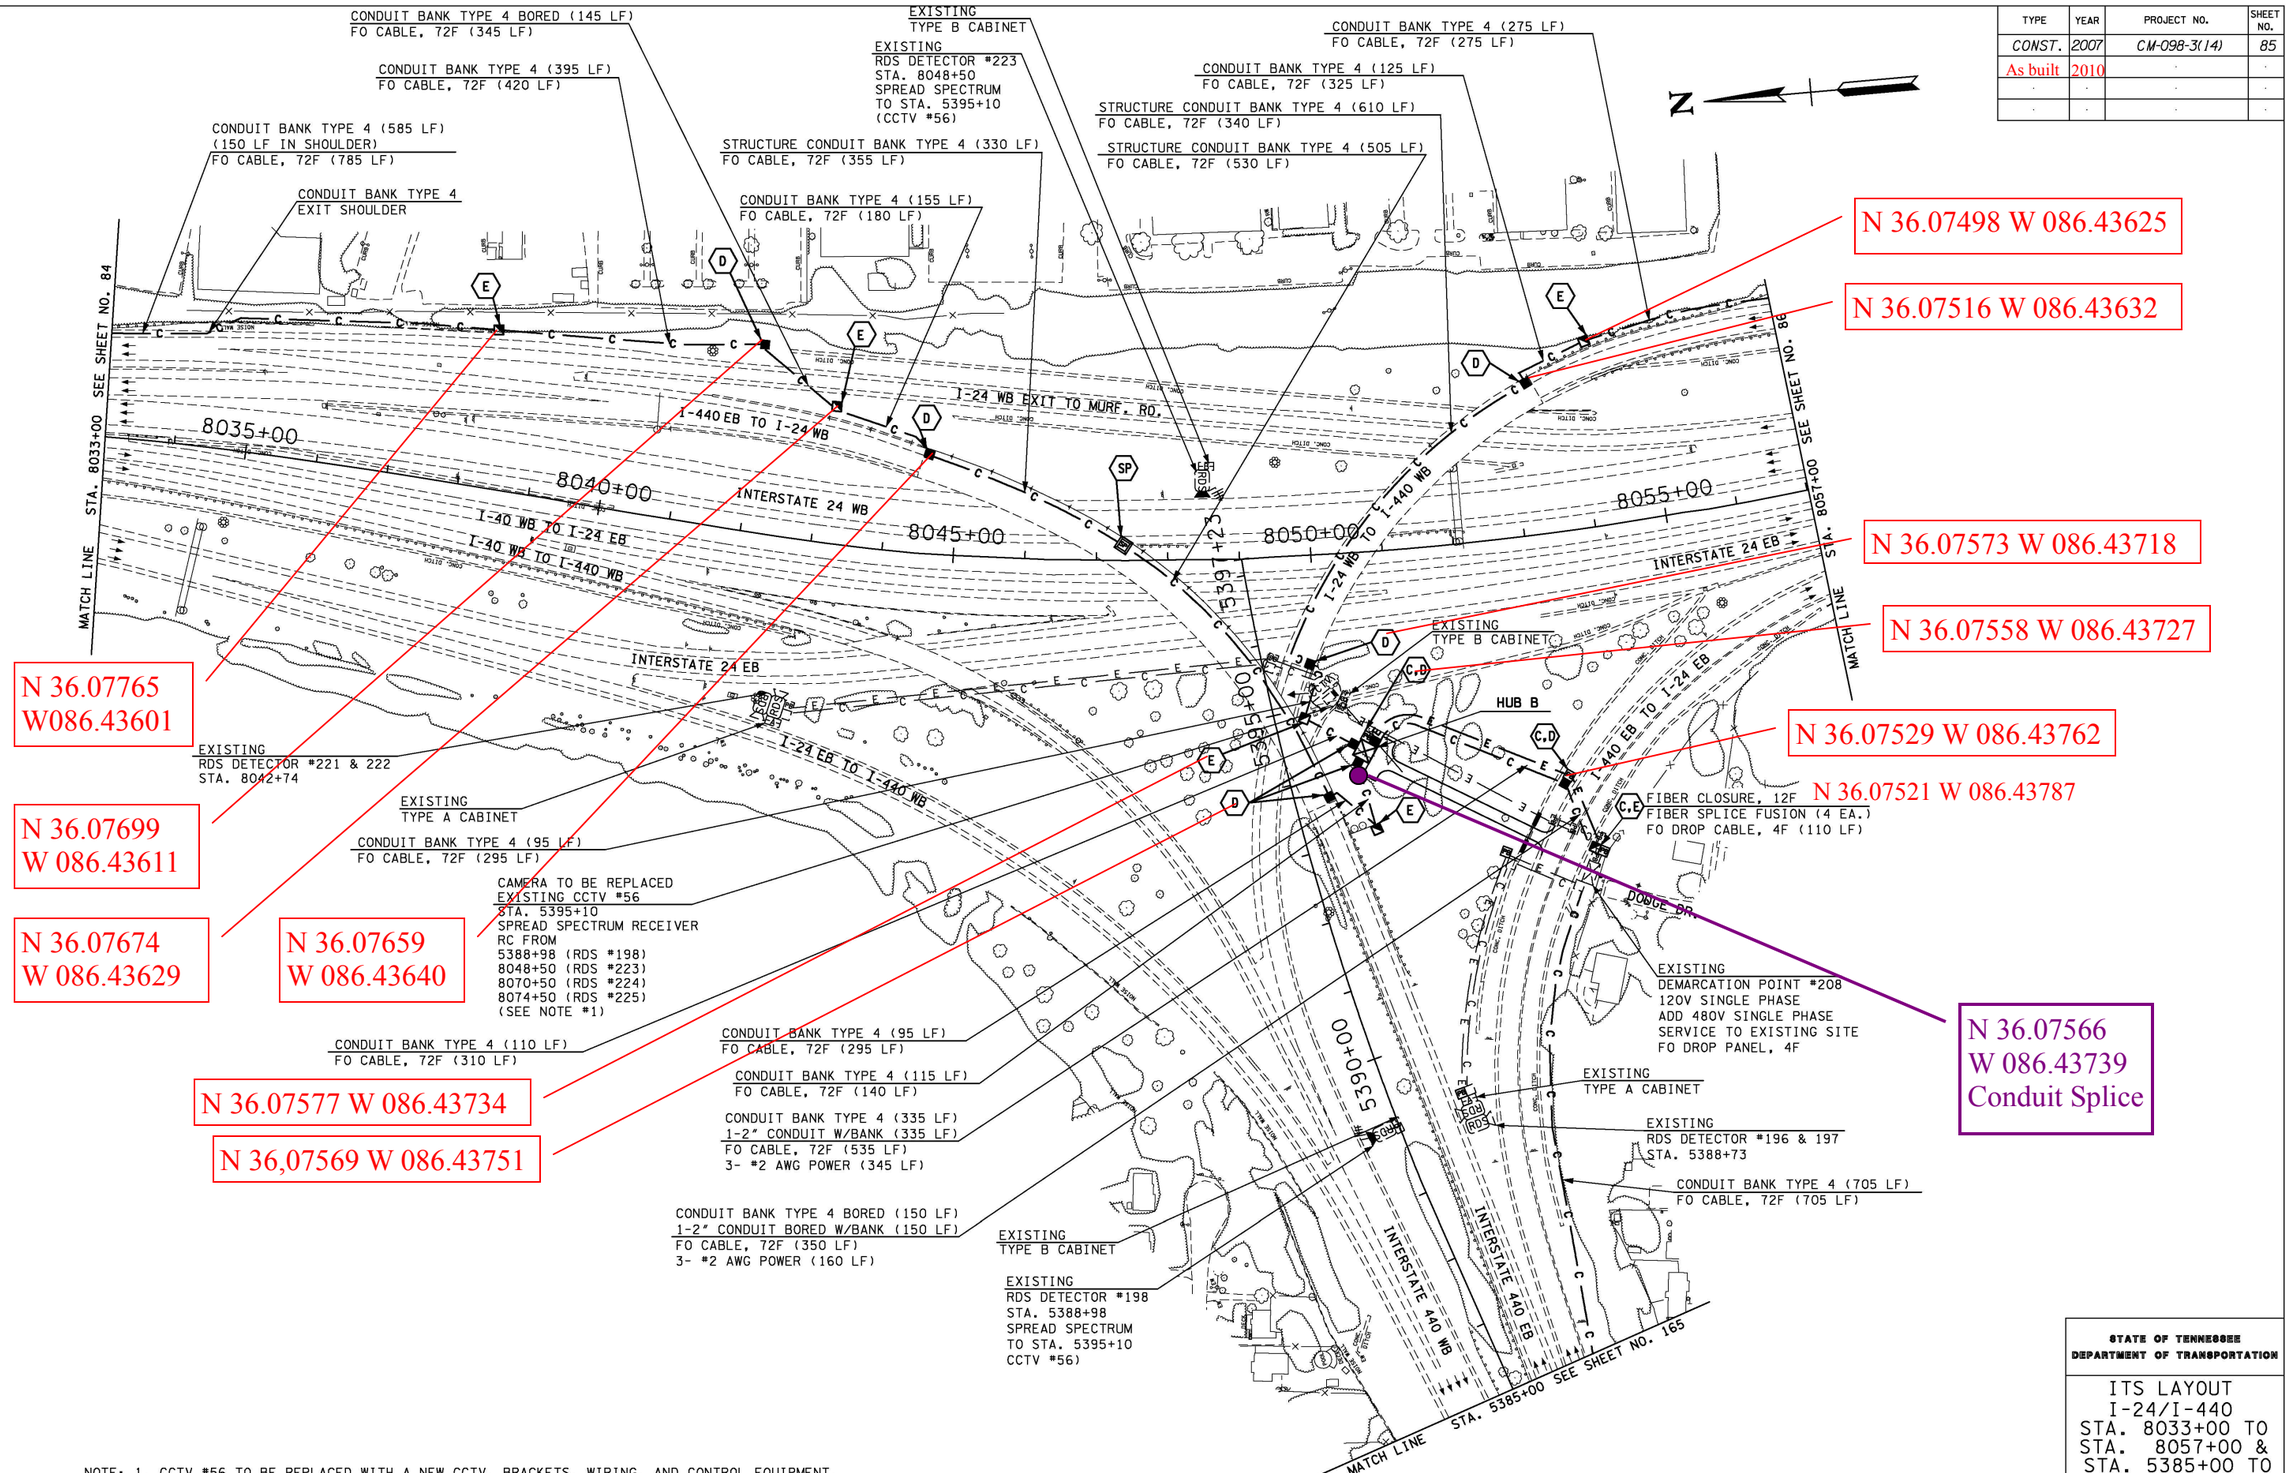

NOTE: 1. CCTV #56 TO BE REPLACED WITH A NEW CCTV, BRACKETS, WIRING, AND CONTROL EQUIPMENT.

STATE OF TENNESSEE
DEPARTMENT OF TRANSPORTATION

ITS LAYOUT
I-24/I-440
STA. 8033+00 TO
STA. 8057+00 &
STA. 5385+00 TO
STA. 5397+23
SCALE: 1"=100'

TENNESSEE D.O.T.
DESIGN DIVISION
FILE NO.

TYPE	YEAR	PROJECT NO.	SHEET NO.
CONST.	2007	CM-098-3(14)	84
As built	2010		

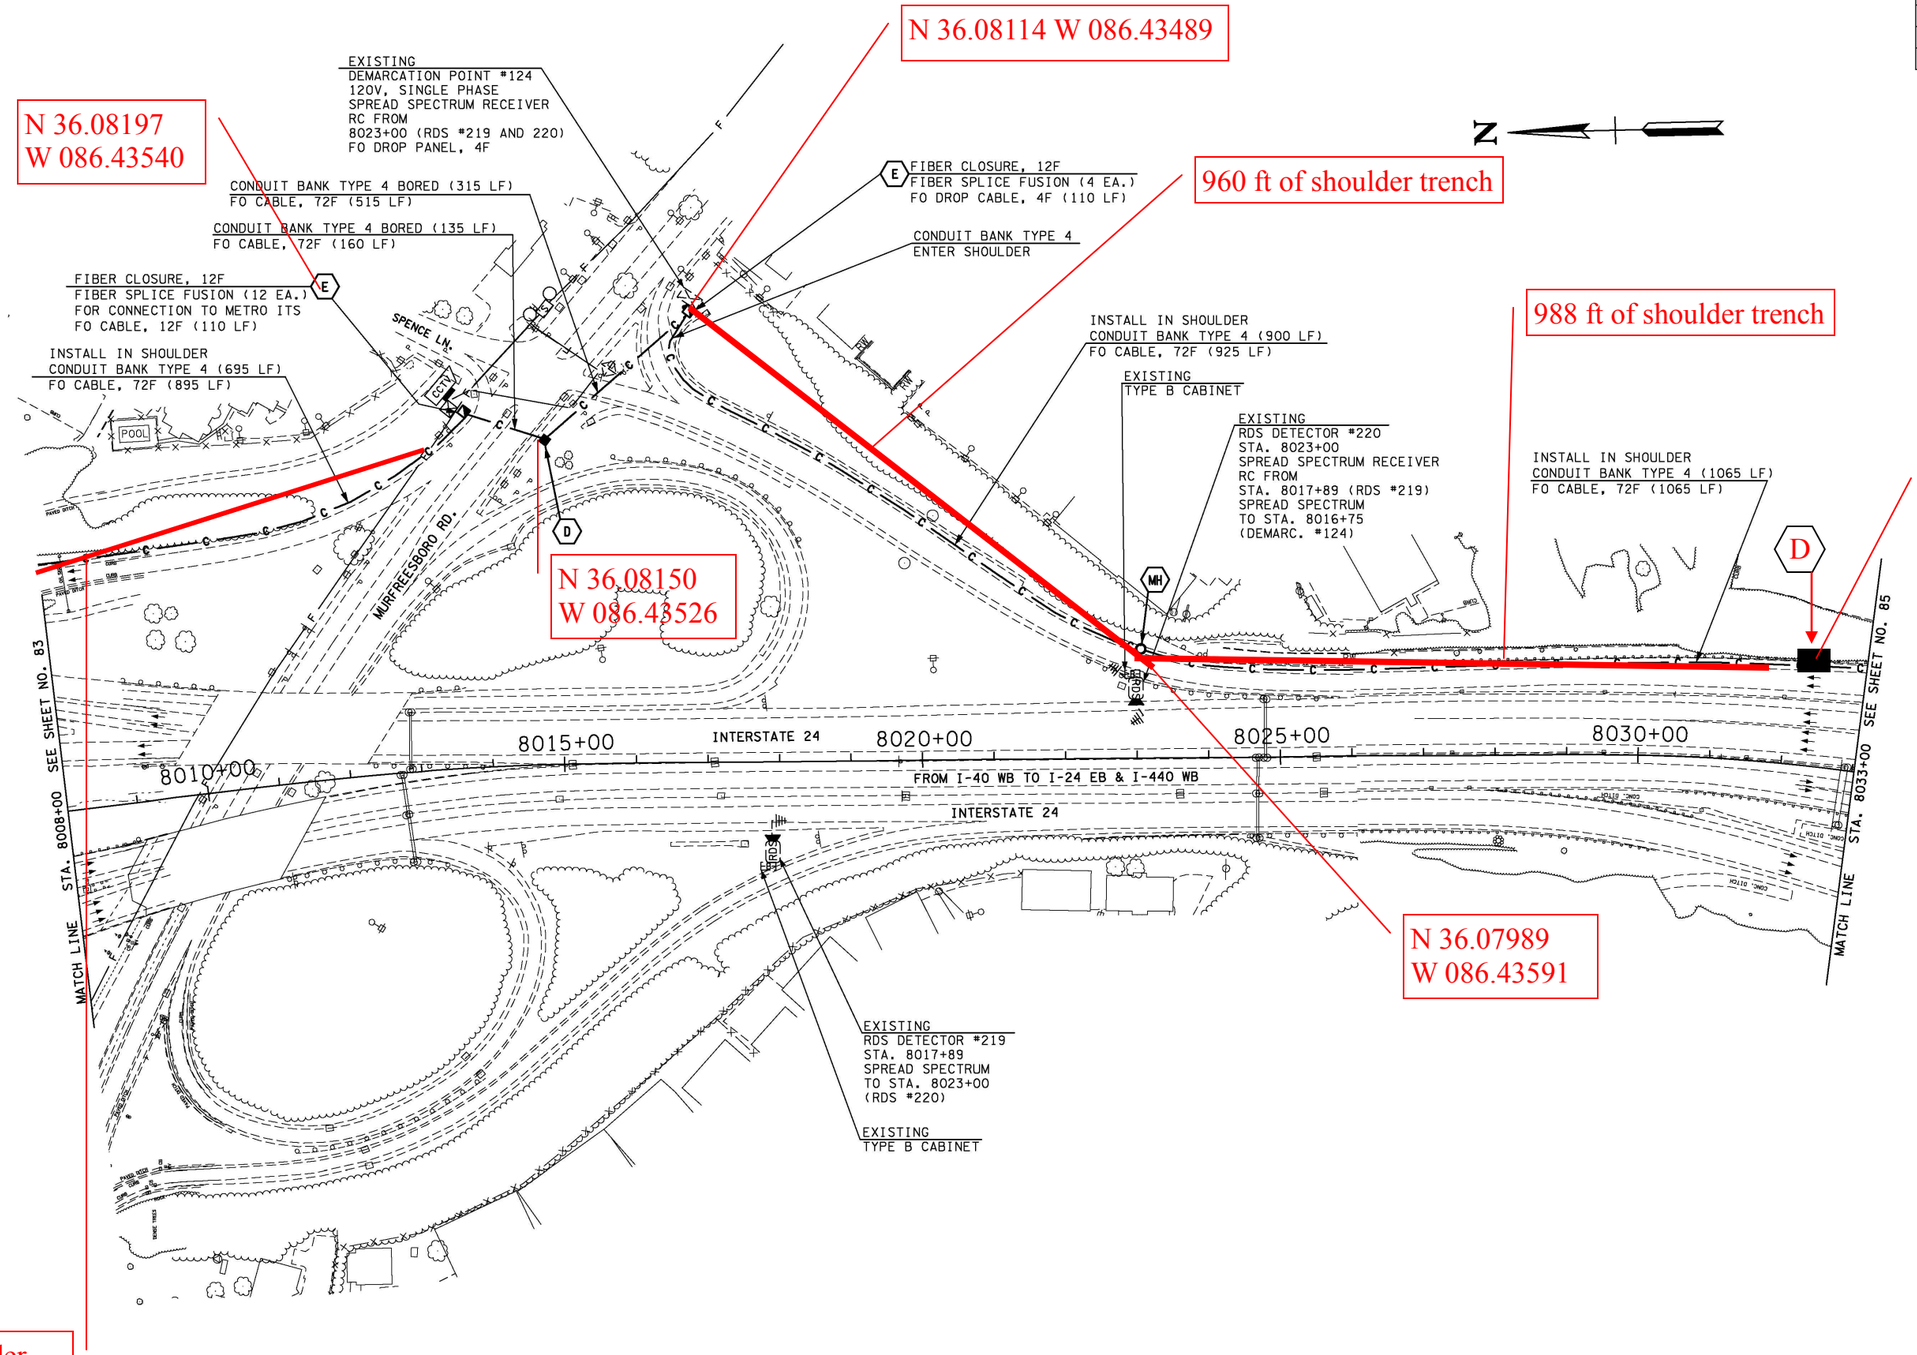

Shoulder Trenched

STATE OF TENNESSEE
DEPARTMENT OF TRANSPORTATION

ITS LAYOUT
I-24
STA. 8008+00 TO
STA. 8033+00

SCALE: 1"=100'

TENNESSEE D.O.T.
DESIGN DIVISION
FILE NO.

TYPE	YEAR	PROJECT NO.	SHEET NO.
CONST.	2007	CM-098-3(14)	83
As built	2010		

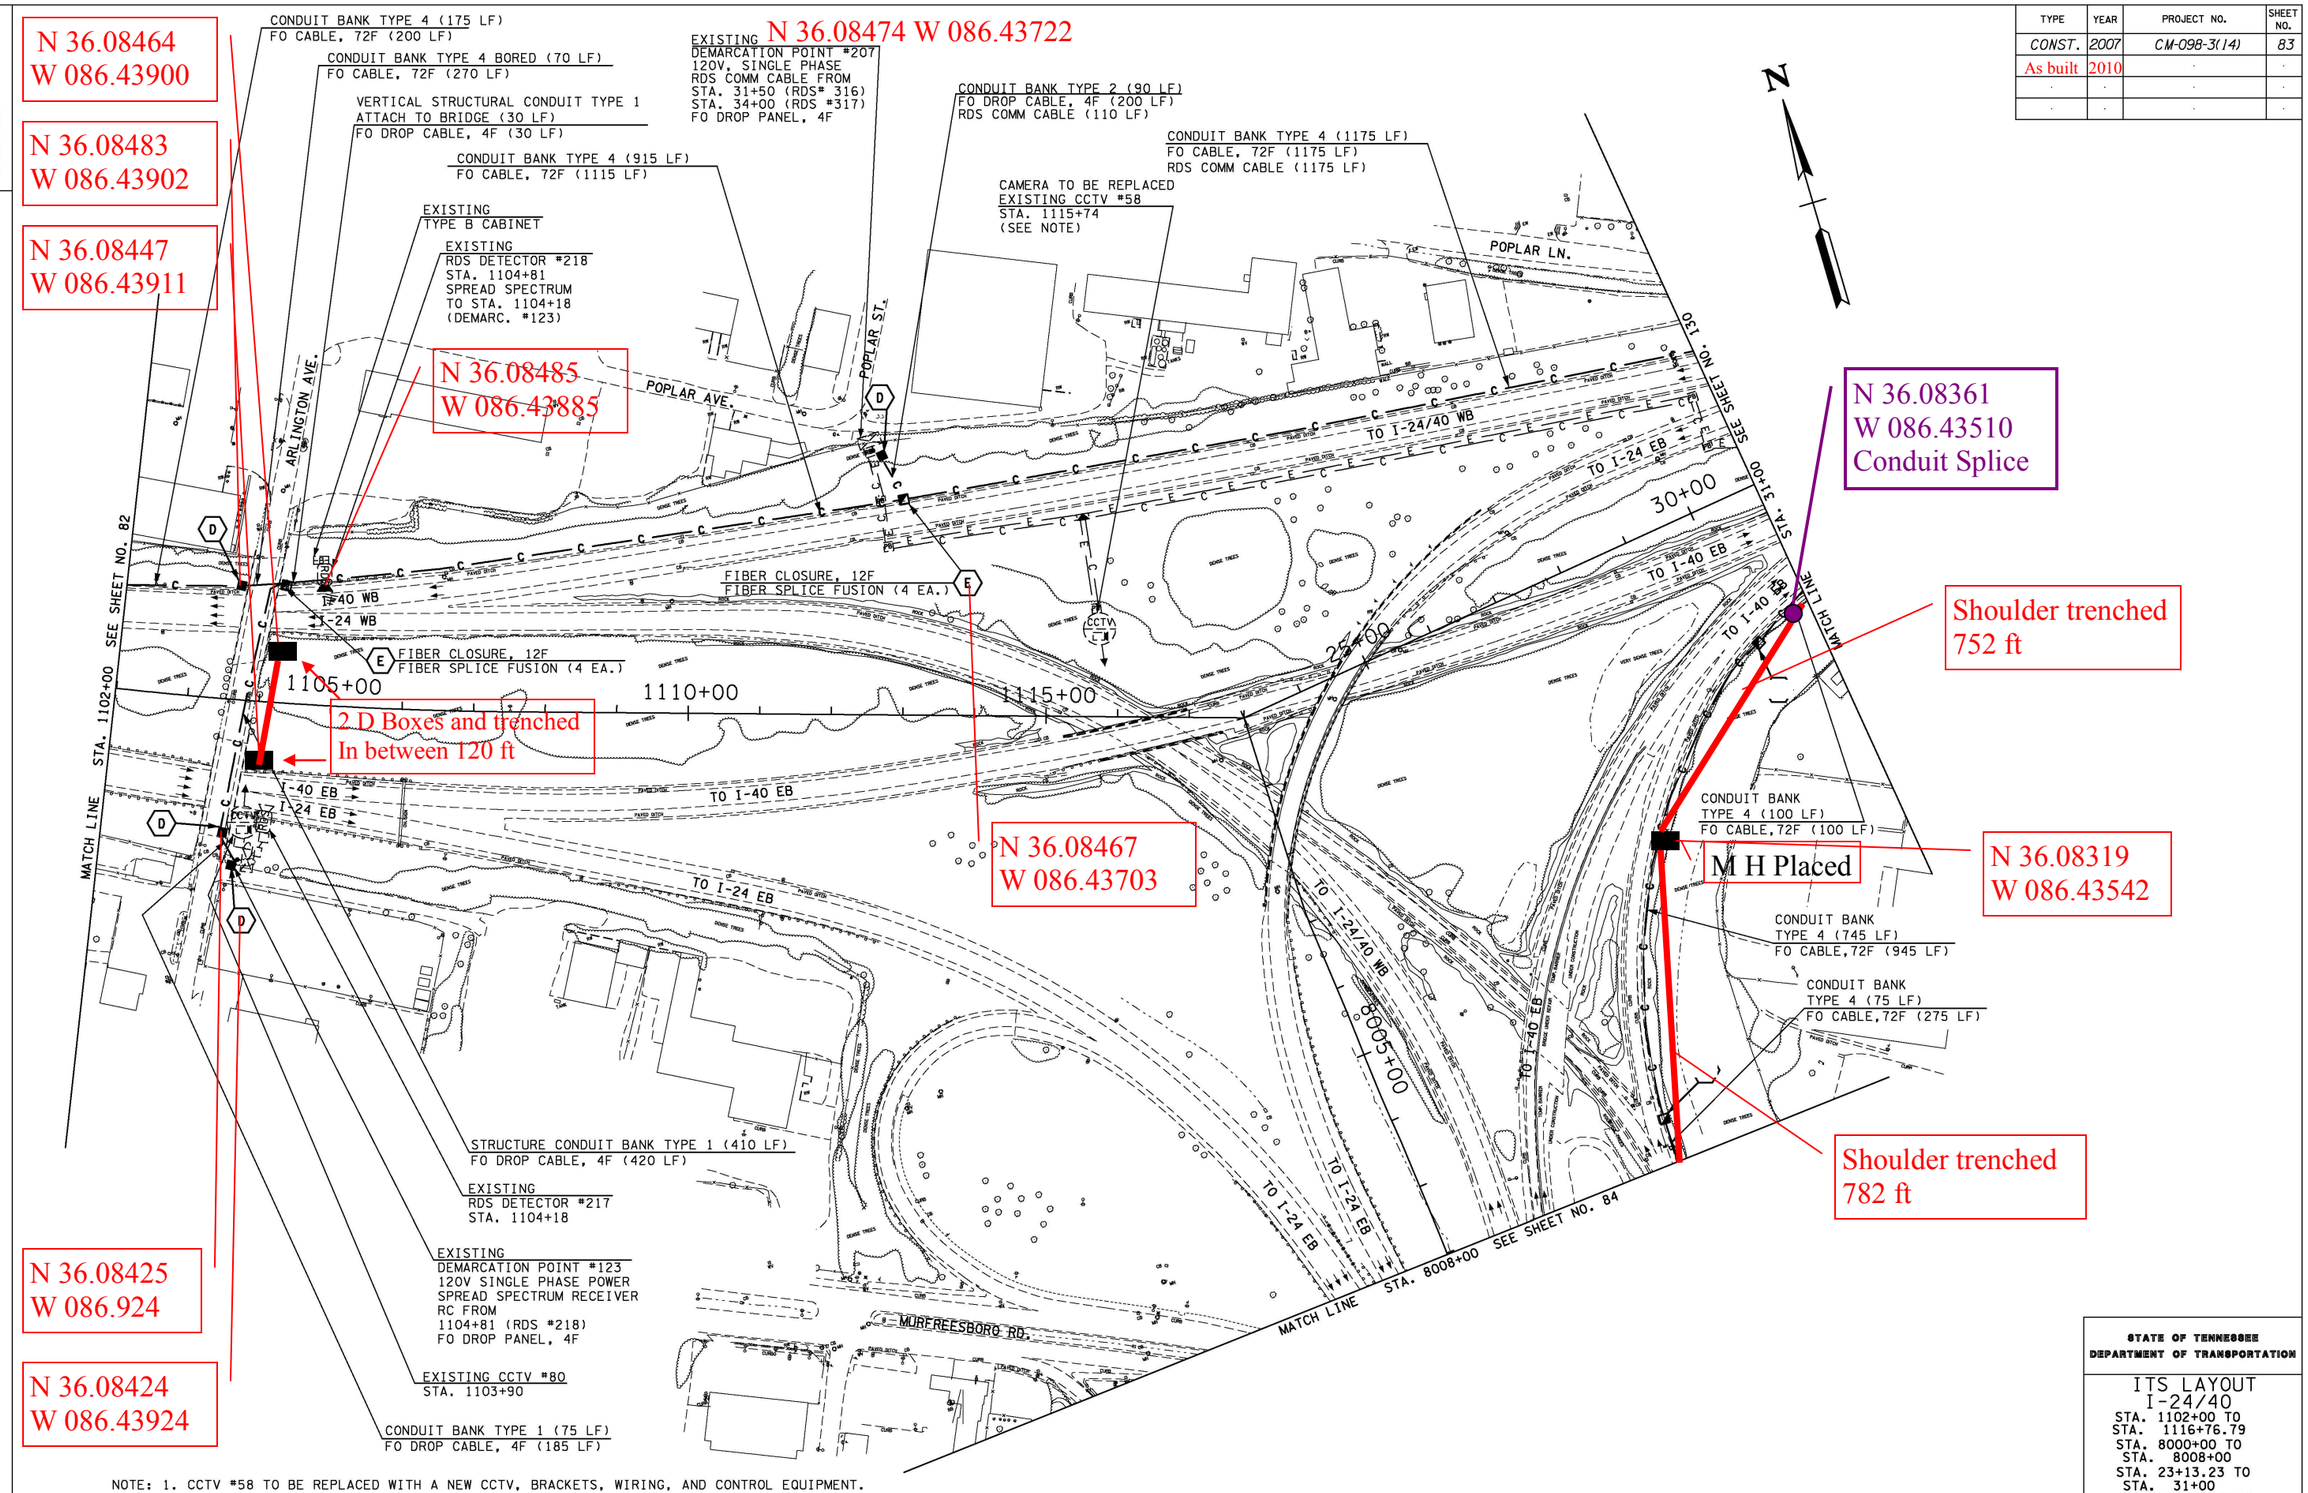

NOTE: 1. CCTV #58 TO BE REPLACED WITH A NEW CCTV, BRACKETS, WIRING, AND CONTROL EQUIPMENT.

STATE OF TENNESSEE
DEPARTMENT OF TRANSPORTATION

ITS LAYOUT
I-24/40
STA. 1102+00 TO
STA. 1116+76.79
STA. 8000+00 TO
STA. 8008+00
STA. 23+13.23 TO
STA. 31+00
SCALE: 1"=100'