TENNESSEE D.O.T.
DESIGN DIVISION
FILE NO.

TYPE	YEAR	PROJECT NO.	SHEET NO.
CONST.	2007	CM-098-3(14)	158
As built	2010	.	.
.	.	.	.
.	.	.	.

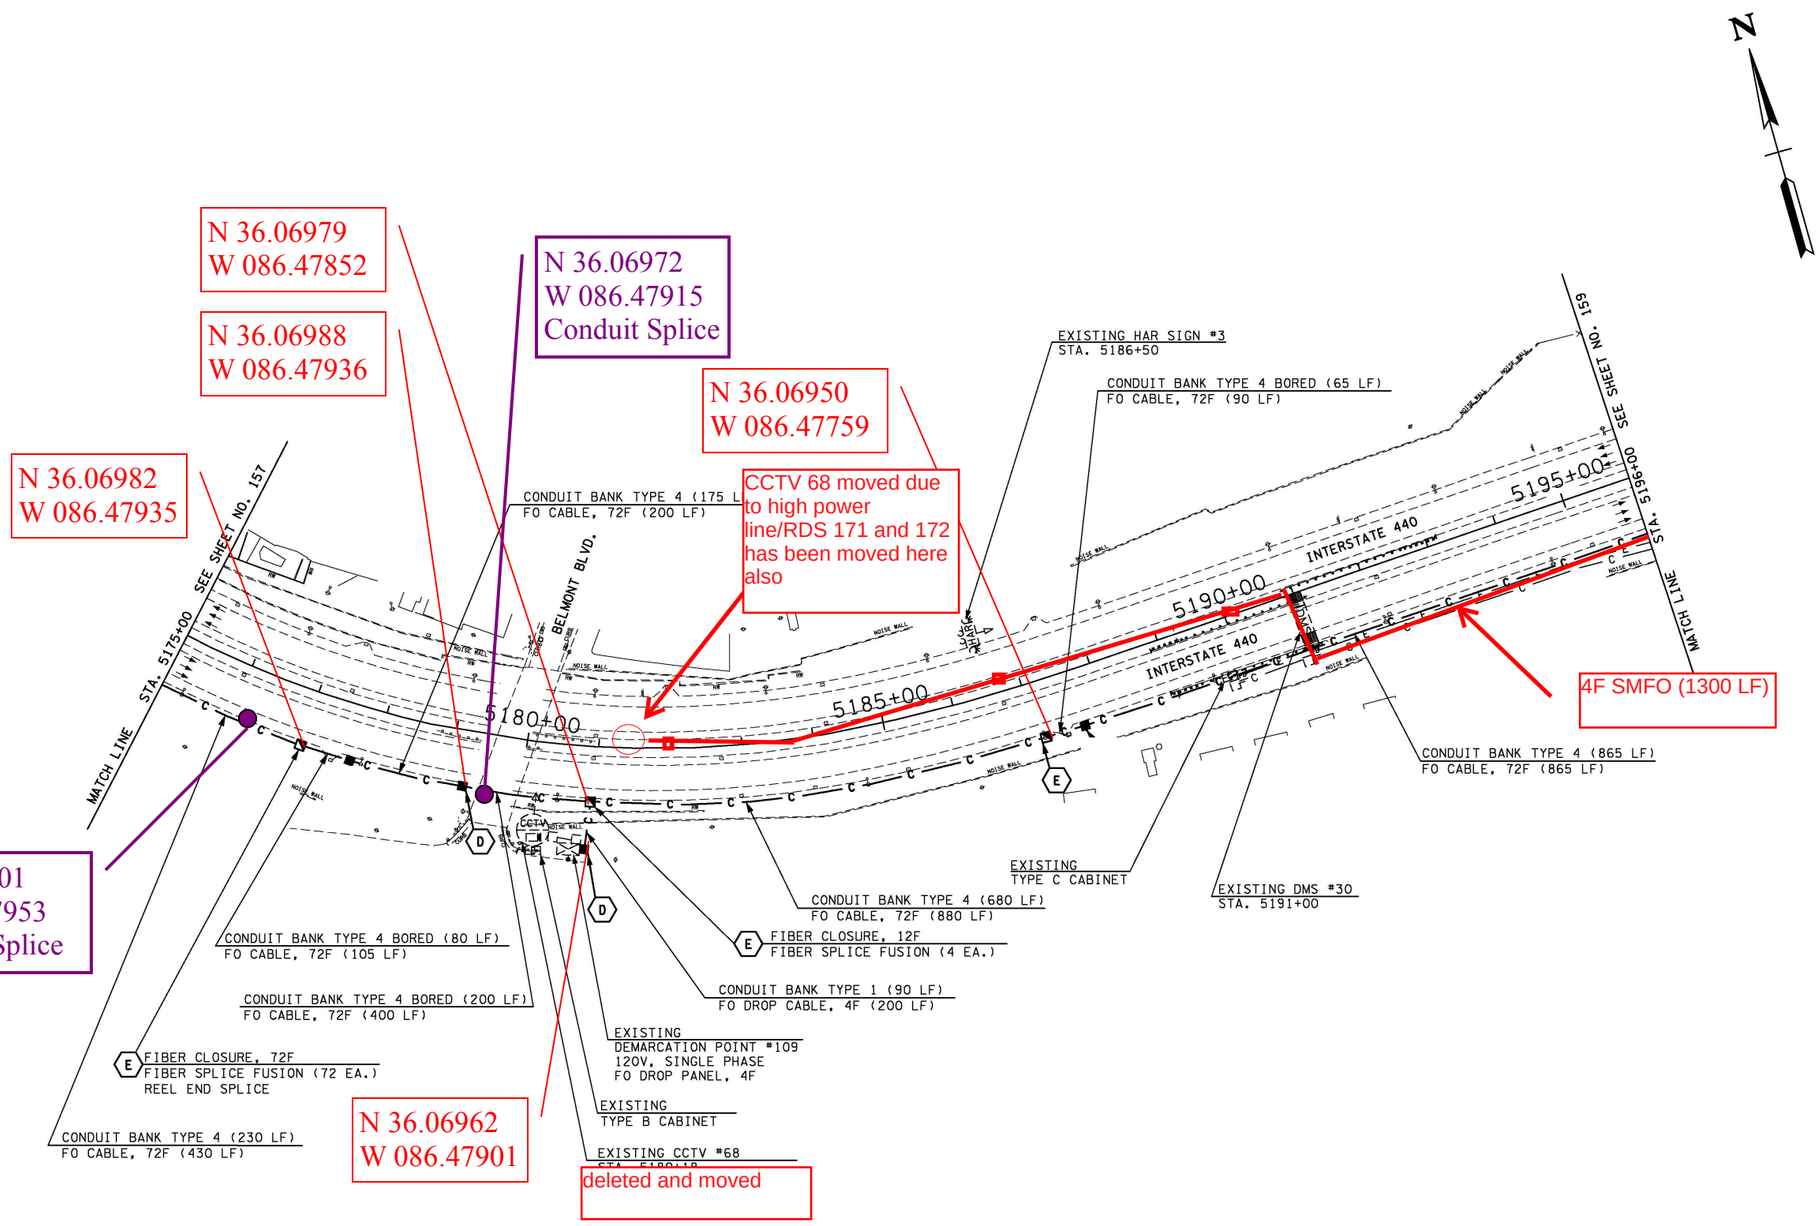

STATE OF TENNESSEE
DEPARTMENT OF TRANSPORTATION

ITS LAYOUT
I-440
STA. 5175+00 TO
STA. 5196+00

SCALE: 1"=100'