


HAMILTON COUNTY

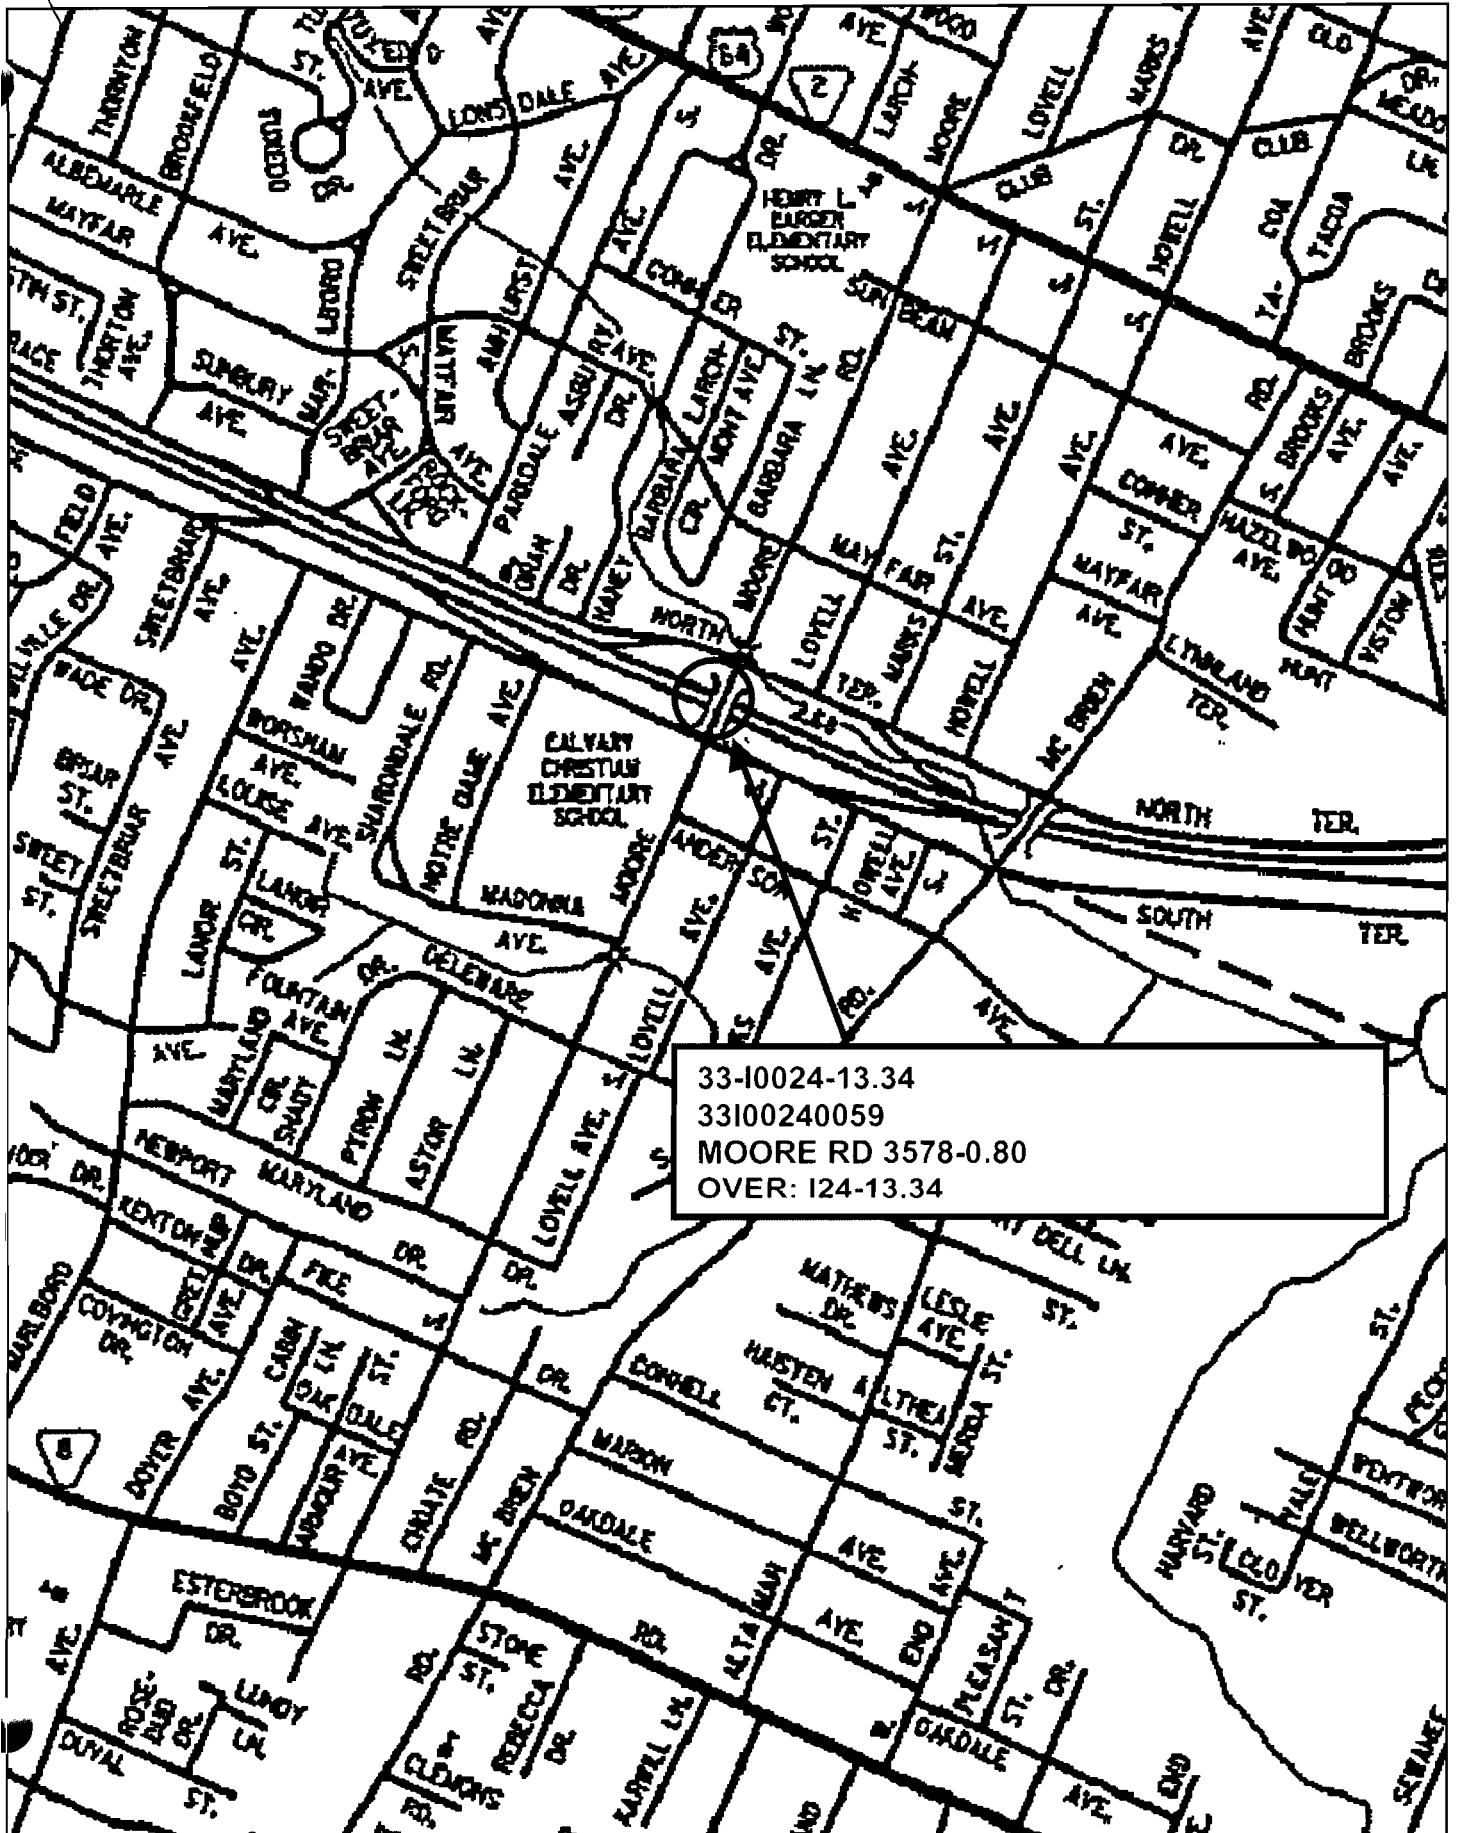

33-10024-13.34
33100240059
MOORE RD 3578-0.80
OVER: 124-13.34

BRIDGE MAINTENANCE RECOMMENDATIONS



COUNTY: HAMILTON
 LOCATION: 33-03578-00.80-
 CO. SEQ.: 1 SPEC. CASE: 0

CROSSING: S. MOORE RD / I-24
 FED. BRIDGE NO.: 33I00240059
 MAINT. DIST.: 21

REPAIR LIST NO.: N
 DATE ADDED: 08/02/2002
 REVISED: 08/02/2002

FACILITY CARRIED:	FAU 3578	NUMBER OF MAIN SPANS:	4
HIGHWAY SYSTEM:	18-STP URBAN, NON-STATE SYS.	NUMBER OF APPROACH SPANS:	0
BRIDGE WIDTH (CURB TO CURB):	63 FT 11 IN	BRIDGE LENGTH (FT):	175
BRIDGE WIDTH (OUT TO OUT):	76 FT 5 IN	MAXIMUM SPAN LENGTH (FT):	55
APPROACH ROADWAY (W/SHOULDERS):	58 FT 0 IN	SKEW ANGLE (DEGREES):	90
MAINTAINED BY:	STATE HIGHWAY AGENCY		
MAIN SPAN MATERIAL:	PRESTRESSED CONCRETE		
MAIN SPAN DESIGN TYPE:	BOX BEAM OR GIRDERS - MULTIPLE		
APPROACH SPAN MATERIAL:	OTHER OR NOT APPLICABLE		
APPROACH SPAN DESIGN TYPE:	OTHER OR NOT APPLICABLE		
INSPECTION DATE:	08/02/2002	GENERAL CONDITION:	FAIR
EVALUATION DATE:	05/09/2001	STRUCTURALLY DEFICIENT:	NO
PROPOSED REPLACEMENT:		SUFFICIENCY RATING:	92.3
H TRUCK RATING @ INV.:	20 TONS		

No.	RECOMMENDATIONS	REPAIR DATE	REPAIRED BY
1.	PATCH COLUMNS & CAPS AT BENT NO.ALL		
2.	LEVEL THE WEARING SURFACE		
3.	CLEAN AND SEAL ROADWAY EXPANSION JOINTS.		
4.	BRIDGERAILS ARE SUBSTANDARD		
5.	APPROACH GUARDRAILS ARE NON-EXISTENT		

COMMENTS:

Bridge Maintenance Recommendations

Page No. _____

Page 1 of 1

Bridge Location No.: 33 - 03578 - 0.80
Co. Route Log Mile

Bridge Number: 33I00240059

Crossing: I 24

County: Hamilton

Bridge Rating: FAIR

Region: 02

Inspection Cycle: 15

District: 21

Inspection Date: 09/19/2000

Maint.Resp.: 01

Spec.Case: 0

Co.Seq: 01

Comments: CLEARANCE RTE 33-I24-13.34 RATED GOOD.

Maintenance Recommendations:

Maintenance Completed
By / Date

238	BRIDGERAILS ARE SUBSTANDARD	
229	APPROACH GUARDRAILS ARE NON-EXISTENT	
031	CLEAN AND SEAL JOINTS IN SPAN NO. ALL	
048	REPAIR A/C SURFACE OVER JOINTS	

COMPLETION NOTIFICATION: RETURN WITHIN 6 MONTHS OF INSPECTION DATE.

INITIAL AND DATE RECOMMENDATIONS WHEN COMPLETED.

MAINTENANCE ACTIVITIES ARE COMPLETED (DATE) _____ BY _____

MAINTENANCE ACTIVITIES ARE PARTIALLY COMPLETED (DATE) _____ BY _____

MAINTENANCE ACTIVITIES ARE INCOMPLETE, SCHEDULED FOR (DATE) _____

EXPLANATIONS AND COMMENTS:

CONTACT:

MR. LEONARD WILLIAMS
REGIONAL BRIDGE ENGINEER
D.O.T. BRIDGE INSPECTION
P.O. BOX 22368
CHATTANOOGA, TN 37422-2368
PHONE: 423-510-1151

STEVE HUTCHINGS
D.O.T. BRIDGE INSPECTION
P.O. BOX 22368
CHATTANOOGA, TN 37422-2368
PHONE: 423-892-3430

BRIDGE MAINTENANCE RECOMMENDATIONS

BRIDGE SEQ. NO. : 33I00240059

BRIDGE NO. : 33 - 03578 - 0080 - N
OVER : I24

DATE : 09/04/98 BRIDGE RATING : FAIR COUNTY : Hamilton
CO. SEQ. : 01 INSPECTION CYCLE : 14 MAINT DIST : 21
SPEC. CASE : 1 INSPECTION DATE : 09/03/98 REGION : 02

007 - FACILITY CARRIED BY STRUCT : FAU 3578
021 - MAINTENANCE RESPONSIBILITY : 01
022 - OWNER : 01
042 - TYPE OF service : 11
043 - STRUCTURE TYPE, MAIN : 505
044 - STRUCTURE TYPE, APPROACH : 000
045 - SPANS, MAIN UNIT : 004
046 - SPANS, APPROACH : 0000
049 - STRUCTURE LENGTH : 000175
032 - APPROACH ROADWAY WIDTH : 058
034 - SKEW : 90
051 - BRDG RDWY WID, CRB-TO-CRB : 0640
052 - DECK WIDTH, OUT-TO-OUT : 0765
500 - HWY OF THE INVENTORY ROUTE : 14

: MAINTENANCE & REPAIR RECOMMENDATIONS :

- 1 BRIDGERAILS ARE SUBSTANDARD
- 2 CLEAN DRAINS IN SPAN NO. ALL
- 3 APPROACH GUARDRAILS ARE NON-EXISTENT
- 4 SEAL CONSTRUCTION JOINT AT CENTER OF BRIDGE IN SPAN NO. 1-4 -
- 5 CLEAN AND SEAL JOINTS IN SPAN NO. 1 AND 3 -

: MAINTENANCE COMPLETED :

- 1 BY _____ DATE _____
- 2 BY _____ DATE _____
- 3 BY _____ DATE _____
- 4 BY M.R DATE 2-1-99
- 5 BY M.R DATE 2-1-99


: COMMENTS FOR BRIDGE SEQ. NO. : 33I00240059 :

CLEARANCE RTE 33-124-13.34 RATED GOOD.

COMPLETION NOTIFICATION : RETURN WITHIN 6 MONTHS OF INSPECTION DATE

MAINTENANCE ACTIVITIES ARE
--- COMPLETED (DATE) 2-1-99
--- PARTIALLY COMPLETE (DATE) -----
--- INCOMPLETE SCHEDULED FOR (DATE) -----

EXPLANATIONS AND COMMENTS:

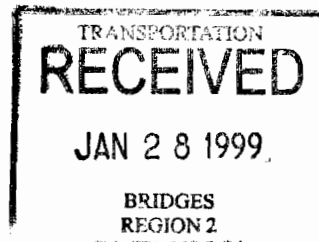

BRIDGE MAINTENANCE RECOMMENDATIONS

BRIDGE SEQ. NO.: 33I00240059

BRIDGE NO.: 33 - 03578 - 0080 - N
OVER : I24

DATE	:09/04/98	BRIDGE RATING	:FAIR	COUNTY	:Hamilton
CO. SEQ.	:01	INSPECTION CYCLE	:14	MAINT DIST	:21
SPEC. CASE	:1	INSPECTION DATE	:09/03/98	REGION	:02

: MAINTENANCE & REPAIR RECOMMENDATIONS :

: MAINTENANCE COMPLETED :

1	BRIDGERAILS ARE SUBSTANDARD	1	BY _____	DATE _____
2	CLEAN DRAINS IN SPAN NO. <u>ALL</u>	2	BY _____	DATE _____
3	APPROACH GUARDRAILS ARE NON-EXISTENT	3	BY _____	DATE _____
4	SEAL CONSTRUCTION JOINT AT CENTER OF BRIDGE IN SPAN NO. <u>1-4</u>	4	BY _____	DATE _____
5	CLEAN AND SEAL JOINTS IN SPAN NO. <u>1 AND 3</u>	5	BY _____	DATE _____

: COMMENTS FOR BRIDGE SEQ. NO. : 33I00240059 :

CLEARANCE RTE 33-124-13.34 RATED GOOD.

COMPLETION NOTIFICATION : RETURN WITHIN 6 MONTHS OF INSPECTION DATE

MAINTENANCE ACTIVITIES ARE

--- COMPLETED (DATE) -----
 --- PARTIALLY COMPLETE (DATE) -----
 --- INCOMPLETE SCHEDULED FOR (DATE) -----

EXPLANATIONS AND COMMENTS :



STATE OF TENNESSEE
DEPARTMENT OF TRANSPORTATION

Bridge Condition Coding Form

Revised 09/12/2001

Bridge Number:
(Includes Item 5A)

Feature Intersected:

County:

Route:

Special Case:

County Sequence:

Log Mile:

CODE ONLY THOSE VALUES WHICH HAVE CHANGED

ITEM #	DESCRIPTION	VALUE	CONDITION CODING GUIDELINES
90	INSPECTION DATE	<input type="text" value="09/19/2000"/> <u>8/2/02</u>	(Values for Coding Items 58, 59, 60 and 62) N NOT APPLICABLE
10	MINIMUM V.C. OVER DECK (ROADWAY + SHOULDERS)	99 FT. 99 IN. ____ FT. ____ IN.	9 EXCELLENT CONDITION 8 VERY GOOD CONDITION - NO PROBLEMS NOTED.
520	MINIMUM V.C. OVER DECK (EXCLUDES SHOULDERS)	99 FT. 99 IN. ____ FT. ____ IN.	7 GOOD CONDITION - SOME MINOR PROBLEMS. 6 SATISFACTORY CONDITION - MINOR DETERIORATION OF STRUCTURAL ELEMENTS.
36	TRAFFIC SAFETY FEATURES		
	Br. Rail Trans. Apr. Rail Terminal SPEED LIMIT	0 0 0 0 UNKNOWN	5 FAIR CONDITION - ALL PRIMARY STRUCTURAL ELEMENTS ARE SOUND BUT MAY HAVE MINOR SECTION LOSS, CRACKING, SPALLING OR SCOUR.
41	STRC OPEN/CLOSED/POSTED A K P	A	4 POOR CONDITION - ADVANCED SECTION LOSS, DETERIORATION, SPALLING OR SCOUR.
58	DECK	7	3 SERIOUS CONDITION - LOSS OF SECTION, DETERIORATION, SPALLING OR SCOUR HAVE SERIOUSLY AFFECTED PRIMARY STRUCTURAL COMPONENTS. LOCAL FAILURES ARE POSSIBLE. FATIGUE CRACKS IN STEEL OR SHEAR CRACKS IN CONCRETE MAY BE PRESENT.
59	SUPERSTRUCTURE	6	
60	SUBSTRUCTURE	6	
61	CHANL/CHANL PROTECTION	N	2 CRITICAL CONDITION - ADVANCED DETERIORATION OF PRIMARY STRUCTURAL ELEMENTS. FATIGUE CRACKS IN STEEL OR SHEAR CRACKS IN CONCRETE MAY BE PRESENT OR SCOUR MAY HAVE REMOVED SUBSTRUCTURE SUPPORT. UNLESS CLOSELY MONITORED IT MAY BE NECESSARY TO CLOSE THE BRIDGE UNTIL CORRECTIVE ACTION IS TAKEN.
62	CULVERT AND RETAIN WALL	N	
71	WATERWAY ADEQUACY	N	
72	APPROACH RDWY ALIGNMENT (USE VALUES OF 3, 6, OR 8)	8	1 "IMMINENT" FAILURE CONDITION - MAJOR DETERIORATION OR SECTION LOSS PRESENT IN CRITICAL STRUCTURAL COMPONENTS OR OBVIOUS VERTICAL OR HORIZONTAL MOVEMENT AFFECTING STRUCTURAL STABILITY. BRIDGE IS CLOSED TO TRAFFIC BUT CORRECTIVE ACTION MAY PUT BACK IN LIGHT SERVICE.
521	OVERALL CONDITION (Circle One)		
	GOOD <input type="radio"/> FAIR <input checked="" type="radio"/> POOR <input type="radio"/> CRITICAL <input type="radio"/>		
		<u>8/2/02</u>	0 FAILED CONDITION - OUT OF SERVICE AND BEYOND CORRECTIVE ACTION.

TEAM LEADER SIGNATURE

REVIEW DATE



STATE OF TENNESSEE
DEPARTMENT OF TRANSPORTATION

Underpass Condition Coding Form

Revised 09/21/2001

Bridge Number: 33I002400592
(Includes Item 5A)

Feature Intersected: FAU 3578 (S. MOORE RD.)

County: 33
Route: I0024
Special Case: 0
County Sequence: 02
Log Mile: 13.34

CODE ONLY THOSE VALUES WHICH HAVE CHANGED

ITEM #	DESCRIPTION	VALUE	UNDERPASS SAFETY FEATURES
90	INSPECTION DATE	<u>09/19/2000</u>	515 (A) TYPE UNDERPASS BARRIER Mixed Metal/Conc. Rail
		<u>812102</u>	
10	MINIMUM V.C. OVER ROADWAY (ROADWAY + SHOULDERS)	16 FT. <u>7</u> IN.	Revised Barrier Type
		FT. <u>8</u> IN.	
520	MINIMUM V.C. OVER ROADWAY (EXCLUDES SHOULDERS)	16 FT. <u>7</u> IN.	(B) ADEQUACY OF BARRIER OR RAIL 1
		FT. <u>8</u> IN.	
47	TOTAL HORIZONTAL UNDERCLEARANCE	52 FT. <u>9</u> IN.	(C) ADEQUACY OF TRANSITIONS 1
		FT. <u>6</u> IN.	
54	MINIMUM VERTICAL UNDERCLEARANCE (EXCLUDES SHOULDERS)		(D) ADEQUACY OF TERMINALS 1
	Circle One: H R	<u>16</u> FT. <u>8</u> IN.	
55	MINIMUM LATERAL UNDERCLEARANCE ON RIGHT SIDE		554 VERTICAL CLEARANCE LISTED ON HEIGHT POSTING
	Circle One: H R	<u>10</u> FT. <u>0</u> IN.	99 FT. 99 IN.
56	MINIMUM LATERAL UNDERCLEARANCE ON LEFT SIDE	<u>6</u> FT. <u>6</u> IN.	FT. IN.
521	OVERALL CONDITION (Circle One)		HEIGHT POSTED AT BOTH APPROACHES?
	<u>GOOD</u> FAIR POOR CRITICAL		YES [] NO [] N/A [X]

555 COMMENTS [Signature]

[Signature] TEAM LEADER SIGNATURE 812102 REVIEW DATE



STATE OF TENNESSEE
DEPARTMENT OF TRANSPORTATION

Underpass Condition Coding Form

County:

Route:

Special Case:

County Sequence:

Log Mile:

Bridge Number:
(Includes Item 5A)

Feature Intersected:

CODE ONLY THOSE NUMBERS WHICH HAVE CHANGED

ITEM #	DESCRIPTION	VALUE	UNDERPASS SAFETY FEATURES
90	INSPECTION DATE	<input type="text" value="9/3/98"/> <u>9 1 19 1 00</u>	(A) TYPE UNDERPASS BARRIER Mixed Metal/Conc. Rail
10	MINIMUM V.C. OVER DECK (ROADWAY + SHOULDERS)	16 FT. <u>7</u> IN. _____ FT. <u>8</u> IN.	Revised Barrier Type (B) ADEQUACY OF BARRIER OR RAIL <input type="text" value="1"/>
520	MINIMUM V.C. OVER DECK (EXCLUDES SHOULDERS)	16 FT. <u>7</u> IN. _____ FT. <u>8</u> IN.	
47	TOTAL HORIZONTAL UNDERCLEARANCE	<u>52</u> FT. <u>8</u> IN. <u>53</u> FT. <u>0</u> IN.	(C) ADEQUACY OF TRANSITIONS <input type="text" value="1"/>
55	MINIMUM LATERAL UNDERCLEARANCE ON RIGHT SIDE <input type="checkbox" value="H"/>	<u>9</u> FT. <u>10</u> IN. Circle One: H R N <u>10</u> FT. <u>00</u> IN.	(D) ADEQUACY OF TERMINALS <input type="text" value="1"/>
56	MINIMUM LATERAL UNDERCLEARANCE ON LEFT SIDE	6 FT. <u>10</u> IN. _____ FT. <u>6</u> IN.	VERTICAL CLEARANCE LISTED ON HEIGHT POSTING SIGNS <u>99</u> FT. <u>99</u> IN. _____ FT. _____ IN.

OVERALL CONDITION (Circle One)

GOOD FAIR POOR CRITICAL

HEIGHT POSTED AT BOTH APPROACHES? YES [] NO [] N/A []

NOTE: DESCRIBE ANY PROBLEMS ON BRIDGES THAT THE STATE DOES NOT INSPECT (SUCH AS RAILROAD OR PRIVATE BRIDGES) THAT WOULD AFFECT THE ROADWAY SUCH AS LOOSE MEMBERS, SEVERELY SPALLED OR CRACKED CONCRETE, EXCESSIVE SECTION LOSS ON STEEL, EXCESSIVE TIMBER DECAY, ETC. ALSO, DESCRIBE ANY UNSAFE ITEMS.

COMMENTS _____

W. H. H. H.
SIGNATURE

9 1 19 1 00
DATE

000002

BRIDGE CONDITION CODING SHEET

DATA ENTRY JOB NO. 5043, P4

BRIDGE NO. CO: 33 LOCATION NO.
ROUTE: I00240
SEQ. NO: 059

CULP5023
TRIMS KEY
CO. NO: 33
ROUTE: 03578
SC/CSQ: 0 01
LOG MILE: 0080
BR-SEQ: 059

FEATURE INTERSECTED: I24

CODE ONLY THOSE NUMBERS WHICH HAVE CHANGED

ITEM #	DESCRIPTION	VALUE	COMMENTS
90	INSPECTION DATE	10 / / 96 <u>9 / 03 / 98</u>	RATINGS FOR CODING <u>ITEMS 58 THRU 62</u>
10	MINIMUM V. C. OVER DECK (PAVEMENT + SHOULDERS)	99 FT. 99 IN. ___ FT. ___ IN.	N NOT APPLICABLE 9 EXCELLENT CONDITION 8 VERY GOOD CONDITION- NO PROBLEMS NOTED
14	MINIMUM V. C. OVER DECK (EXCLUDES SHOULDERS)*	99 FT. 99 IN. ___ FT. ___ IN.	7 GOOD CONDITION- SOME MINOR PROBLEMS
54	MINIMUM VERTICAL H R N UNDERCLEARANCE	16 FT. 08 IN. ___ FT. ___ IN.	6 SATISFACTORY CONDITION- MINOR DETERIORATION OF STRUCTURAL ELEMENTS
36	TRAFFIC SAFETY FEATURE	0 0 0 0 ___ ___ ___	5 FAIR CONDITION-PRIMARY STRUCTURAL DEFECTS, SOUND BUT SHOW MINOR SECTION LOSS, SCOUR, CRACKING, SPALLING
41	STRC OPEN/CLOSED/POSTED A K P	A ___	4 POOR CONDITION- ADVANCED SECTION LOSS, DETERIORATION, SCOUR, SPALLING
58	DECK	7 ___	3 SERIOUS CONDITION-LOSS OF SECTION, DETERIORA- TION, SPALLING, SCOUR SERIOUSLY EFFECT PRIMARY MEMBERS, FAILURES POSSIBLE, FATIGUE OR SHEAR CRACKS POSSIBLE
59	SUPERSTRUCTURE	7 <u>6</u>	2 CRITICAL CONDITION- ADVANCED DETERIORATION OF PRIMARY ELEMENTS OR FATIGUE OR SHEAR CRACKS OR SEVERE SCOUR COND- ITION, MAY REQUIRE CLOSURE FOR REPAIRS
60	SUBSTRUCTURE	6 ___	1 IMMINENT FAILURE CONDITION-MAJOR SECTION LOSS OR CRITICAL COND- ITION OF STRUCTURAL COMPONENT OR UNSTABLE OR CLOSED BUT REPAIR- ABLE FOR LIGHT TRAFFIC
61	CHANL/CHANL PROTECTION	N ___	0 FAILED CONDITION-OUT OF SERVICE AND BEYOND CORRECTIVE ACTION
62	CULV & RETAIN WALL	N ___	
72	APPROACH RDWY ALIGNMENT (CODE 3, 6, OR 8 UNLESS NECESSARY)	6 ___	
<u>OVERALL CONDITION</u>			
GOOD	___	POOR	___
FAIR	<u>X</u>	CRIT	___
<u>Darry Selken</u> SIGNATURE		<u>9, 3, 98</u> DATE	

BRIDGE CONDITION CODING SHEET

CULP5028

DATA ENTRY JOB NO. 5043, P5

TRIMS KEY

BRIDGE NO.

CO: 33

LOCATION NO.

CO. NO: 33

ROUTE: I00240

ROUTE: I0024

SEQ. NO: 059

SC/CSQ: 0 02

LOG MILE: 1334

BR-SEQ: 059

FEATURE INTERSECTED: FAU 3578

CODE ONLY THOSE NUMBERS WHICH HAVE CHANGED

ITEM #	DESCRIPTION	VALUE
90	INSPECTION DATE	10 / / 96 <u>9 / 3 / 98</u>
10	MINIMUM V. C. OVER DECK UNDERPASS ROADWAY (PAVEMENT + SHOULDERS)	16 FT. 08 IN. ___ FT. ___ IN.
14	MINIMUM V. C. OVER UNDERPASS ROADWAY (EXCLUDES SHOULDERS)	16 FT. 08 IN. ___ FT. ___ IN.
47	TOTAL HORIZONTAL UNDERCLEARANCE	530 FT. ___ FT.
55	MINIMUM LATERAL UNDER-CLEARANCE ON RIGHT	H R N ___ ___ ___ <u>10.0</u> FT. FT.
56	MINIMUM LATERAL UNDER-CLEARANCE ON LEFT	___ FT. <u>065</u> FT.

NOTE: DESCRIBE ANY PROBLEMS ON BRIDGES THAT THE STATE DOES NOT INSPECT (SUCH AS RAILROAD OR PRIVATE BRIDGES) THAT WOULD AFFECT THE ROADWAY SUCH AS LOOSE MEMBERS, SEVERELY SPALLED OR CRACKED CONCRETE, EXCESSIVE SECTION LOSS ON STEEL, EXCESSIVE TIMBER DECAY, ETC. ALSO, DESCRIBE ANY UNSAFE ITEMS.

OVERALL CONDITION

COMMENTS

GOOD	<u>X</u>	<u>GUARDRAIL AND PARAPETS UPGRADED</u>
FAIR	___	_____
POOR	___	_____
CRITICAL	___	_____

Darry Selber
SIGNATURE

9 / 3 / 98
DATE

Christopher McDonald

From: Seth Davis
Sent: Monday, May 10, 2021 2:25 PM
To: Christopher McDonald
Subject: Fwd: Moore Rd Sign

FYI

Seth Davis, P.E. | TPS Supervisor
Region 2 Bridge Inspection - Chattanooga
7508 Volkswagen Drive
Chattanooga, TN 37416
p. 423-634-2431 c. 423-438-8014

Begin forwarded message:

From: Steve Hutchings <Steve.Hutchings@tn.gov>
Date: May 4, 2021 at 11:36:52 AM EDT
To: Seth Davis <Seth.Davis@tn.gov>
Subject: RE: Moore Rd Sign

Yes, that's correct.

-----Original Message-----

From: Seth Davis <Seth.Davis@tn.gov>
Sent: Tuesday, May 4, 2021 11:36 AM
To: Steve Hutchings <Steve.Hutchings@tn.gov>
Subject: RE: Moore Rd Sign

That's odd. So Carson is saying they intentionally did not tighten the nuts?

Seth Davis, P.E. | TPS Supervisor
Region 2 Bridge Inspection - Chattanooga
7508 Volkswagen Drive
Chattanooga, TN 37416
p. 423-634-2431 c. 423-438-8014
Seth.Davis@tn.gov
tn.gov/tdot

-----Original Message-----

From: Steve Hutchings <Steve.Hutchings@tn.gov>
Sent: Tuesday, May 4, 2021 11:32 AM
To: Seth Davis <Seth.Davis@tn.gov>
Subject: FW: Moore Rd Sign

FYI

-----Original Message-----

From: Carson Voiles <Carson.Voiles@tn.gov>
Sent: Tuesday, May 4, 2021 11:22 AM

To: Steve Hutchings <Steve.Hutchings@tn.gov>
Subject: RE: Moore Rd Sign

Steve,

After discussions with Superior, they installed the sign this way. I am looking into getting this rectified. I don't believe that there is a need to keep inspecting it.

Carson Voiles | District Operations Supervisor 1 TDOT Construction / Dunlap - Unit 2822 P.O. Box 603
Dunlap, TN 37343 p. 423-949-2195 c. 423-309-8978 Carson.Voiles@tn.gov

-----Original Message-----

From: Steve Hutchings <Steve.Hutchings@tn.gov>
Sent: Monday, April 26, 2021 1:23 PM
To: Carson Voiles <Carson.Voiles@tn.gov>
Subject: FW: Moore Rd Sign

Carson,

We inspecting these signs again and we did find a little bit of change. I checked the temps for both days and they were very similar, so I don't think this is necessarily an expansion and contraction issue.

We'll keep checking them every 2 weeks.

Steve

-----Original Message-----

From: Seth Davis <Seth.Davis@tn.gov>
Sent: Monday, April 26, 2021 12:16 PM
To: Steve Hutchings <Steve.Hutchings@tn.gov>
Subject: Moore Rd Sign

Steve,

Please find attached pictures for the Moore Rd Sign, one taken today, the 26th, and the other taken the 13th.

Thanks,

Seth Davis, P.E. | TPS Supervisor
Region 2 Bridge Inspection - Chattanooga
7508 Volkswagen Drive
Chattanooga, TN 37416
p. 423-634-2431 c. 423-438-8014
Seth.Davis@tn.gov
tn.gov/tdot

Christopher McDonald

From: Christopher McDonald
Sent: Monday, May 10, 2021 10:58 AM
To: 'anthony.wallace@tn.gov'
Cc: Joshua Gentry; 'william.rose@tn.gov'; Tony Halwani; Seth Davis
Subject: Hamilton County Interstate Bridge Signs with Loose Bolts - BID: 33100240059, Moore Road over I-24, 33-3578-0.80

Anthony,

The subject bridge has a couple of signs over the interstate with mounting bolts where the nuts have backed off approximately 2 inches since the last inspection in October 2020.

It looks like the inspection team at the Chattanooga office has communicated this to you guys already through the usual means (or is in the process of doing that), and I apologize for the redundancy. Our team at HQ thought it probably wouldn't hurt anything to send an additional email pointing it out, though, considering the progression since last October and the heavy traffic below the signs.

Also, just so it doesn't catch you off guard when you get to looking at it, this is the bridge that was hit in January 2020 hard enough to warrant removal of the damaged beam, and the signs were reinstalled onto the remaining portion of the bridge curb/sidewalk near the removed beam.

Let me know if you have any questions or concerns, or if there's anything we can help with on our end. Thanks,



Chris McDonald, PE | TPS Sr
Structures Division / Bridge Inspection HQ
James K Polk Building, 12th Floor
505 Deaderick St, Nashville, TN 37243-0338
p. 615-741-0965
Christopher.McDonald@tn.gov

From: [Rebecca Hayworth](#)
To: [Steve Hutchings](#)
Cc: [Tom Quinn](#); [Bryan Liner](#)
Subject: RE: Moore road bridge over I-24
Date: Tuesday, January 21, 2020 5:18:44 PM
Attachments: [image002.png](#)
[image003.png](#)

Hello Steve,

After reading your email this afternoon, we decided to take another approach to this model using the Load and Resistance Factor Spec, and the results were much more favorable. So, we are fine with not posting the bridge, if we monitor the remaining beams on a 6-month cursory inspection cycle.

Please let me know if you have any other questions.

Becky



Rebecca Hayworth, P.E. | C.E. Manager 1
Structures Division / Bridge Inspection Office
James K. Polk Building, Suite 1200
505 Deaderick Street
Nashville, TN 37243-0338
p. 615-253-2448
Rebecca.Hayworth@tn.gov

From: Steve Hutchings <Steve.Hutchings@tn.gov>
Sent: Tuesday, January 21, 2020 1:51 PM
To: Tom Quinn <Tom.Quinn@tn.gov>
Cc: Bryan Liner <Bryan.Liner@tn.gov>; Rebecca Hayworth <Rebecca.Hayworth@tn.gov>
Subject: Moore road bridge over I-24

Tom,

We removed the tie rods from the bridge last night. They came out easily and did not appear to be attached to anything. The ends of the rods were threaded and doesn't appear to be sheared or broken. It looks like the total length of the rod was about 40'. The rods definitely did not go all the way through the structure. I am assuming the other side of the bridge is still tied.

What should our plans be going forward. Do we still need to post it?

Steve



Steven Hutchings P.E. | Regional Bridge Manager
Region 2 Bridge Inspection and Repair
TDOT Region 2 Complex, Building C
7508 Volkswagen Drive, Chattanooga, TN 37416

p. 423-510-1151 c. 423-290-7467
steve.hutchings@tn.gov



**STATE OF TENNESSEE
DEPARTMENT OF TRANSPORTATION**

**STRUCTURES DIVISION
BRIDGE INSPECTION AND REPAIR OFFICE**
SUITE 1200, JAMES K. POLK BUILDING
505 DEADERICK STREET
NASHVILLE, TN 37243-1403
(615) 741-0776

CLAY BRIGHT
COMMISSIONER

BILL LEE
GOVERNOR

January 8, 2020

To: Steve Hutchings
Tennessee Department Of Transportation
Regional Bridge Engineer

Subject: New Weight Limit Posting Requirements
Bridge Federal ID No. 33I00240059
Bridge Location No. 33 - 03578 - 0.80
S. Moore Rd. over I-24
Hamilton County - City Of East Ridge

The subject bridge suffered collision damage on January 7, 2019. We have completed our evaluation of the bridge and have determined that the bridge is now required to be posted for a weight limit of 13 tons for two axle vehicles and 23 tons for vehicles with three or more axles.

The new weight limit posting signs shall be installed by February 7, 2020. Compliance with the weight limit posting requirements can be confirmed taking photographs of each sign at both approaches to the bridge and submitting these photographs to the HQ Bridge Inspection Office in Nashville. This can be done by replying to the email that distributed this letter and attaching the photographs as digital files.

Each photograph must show the face of the sign clearly so that the weight limit values can be confirmed. Photographs shall be taken at both approaches to the bridge even if it was only required to replace one sign.

If any additional work is done on the bridge, the TDOT Regional office should be notified so that they can perform an inspection.

Please scan and email any Repair Plans in case of any repairs; or As-Built Drawings or Design Plans in case of a structure replacement to the email address that distributed this letter.

Should you have any questions, please advise.

Sincerely,

Ted Kniazewycz, PE
Director of Structures

TENNESSEE BRIDGE INSPECTION PROGRAM

SUMMARY OF EVALUATION

REV. 03-05-2003

BRIDGE ID NO: 33I00240059

LOCATION NO: 33 - 03578 - 0.80

(6A) CROSSING: I-24

(505) METHOD OF ANALYSIS: LOAD RESISTANCE
FACTOR METHOD - RF

(548) RATING BASED ON: AASHTOWare Bridge Rating
(3" Asphalt)

LOAD RATINGS IN TONS

INVENTORY (503) H 29 (518B) HS 29

OPERATING (504) H 37 (519) HS 37

REQ. POSTING:

(549) EVALUATOR: KBL

(522) EVAL. DATE: 10/18/2018

LAST UPDATED BY: LINER

(29) ADT: 11,270 (30) ADT YR: 2018

(100) STRAHNET ROUTE: NO

(19) DETOUR LENGTH: 5 KM

(520) VC OVER RDWY: 99.99 METERS

CONDITION RATINGS

APPRAISAL RATINGS

CODE VALUES

(58) DECK RATING: 7	(67) STRUCTURAL EVALUATION: 4	N - NOT APPLICABLE
(59) SUPERSTRUCTURE RATING: 4	(68) DECK GEOMETRY: 7	9 - EXCELLENT CONDITION
(60) SUBSTRUCTURE RATING: 5	(69) UNDER CLEARANCE: 4	8 - VERY GOOD CONDITION
(61) CHANNEL PROTECTION: N	(70) BRIDGE POSTING: 5	7 - GOOD CONDITION
(62) CULVERT RATING: N	(71) WATERWAY ADEQUACY: N	6 - SATISFACTORY
(113A) NBIS SCOUR CODE: N	(72) APPROACH RDWY ALIGNMENT: 8	5 - FAIR CONDITION
(113B) TDOT SCOUR CODE:		4 - POOR CONDITION
		3 - SERIOUS CONDITION
		2 - CRITICAL CONDITION
		1 - FAILURE IS IMMINEENT
		0 - FAILED CONDITION
 <u>OTHER RATING ITEMS</u>		
(521) OVERALL CONDITION: P	(36) TRAFFIC SAFETY	
(513) TEXTURE COAT RATING: N	FEATURES: 0 N N N	
(514) PAINT CONDITION RATING: N	(525) REPAIR LIST NO: 2	
(41) WEIGHT POSTING CODE: B		

COMMENTS

A LOAD RATING ANALYSIS HAS BEEN PERFORMED ON THIS BRIDGE FOLLOWING COLLISION DAMAGE THAT OCCURRED ON 01/07/2020. THE LEFT EXTERIOR BEAM IN SPAN 2 WAS DAMAGED SO SEVERELY THAT IT WAS REMOVED SINCE IT HAD THE POTENTIAL TO FALL ON TRAFFIC BELOW THE STRUCTURE. DURING THE PROCESS, LONGITUDINAL TIE RODS WERE REMOVED. THE CURRENT LOAD RATING CONSIDERS THE BEAMS TO ACT INDEPENDENTLY.

Bridge Name: S Moore Rd / I-24

NBI Structure ID: 33100240059

Bridge ID: 33100240059

Analyzed By: bridgeware

Analyze Date: Wednesday, January 22, 2020 08:39:54

Analysis Engine: AASHTO LRFR Engine Version 6.8.1.3001

Analysis Preference Setting: None

Report By: bridgeware

Report Date: Wednesday, January 22, 2020 08:41:02

Structure Definition Name: Spans 2 and 3

Member Name: Interior

Member Alternative Name: 27" Deep, 54' Clear Span

Load and Resistance Factor Rating Summary

Girder Summary

		Rating		Capacity		Location			
Live Load		Factor	Controls	(Ton)	Span	(ft)	Percent	Impact	Lane
H 15-44	Inventory	1.910	STRENGTH-I Concrete Flexure	28.65	1	27.00	50.0	As Requested	As Requested
H 15-44	Operating	2.476	STRENGTH-I Concrete Flexure	37.14	1	27.00	50.0	As Requested	As Requested
HL-93 (US)	Inventory	0.799	STRENGTH-I Concrete Flexure	28.77	1	27.00	50.0	As Requested	As Requested
HL-93 (US)	Operating	1.036	STRENGTH-I Concrete Flexure	37.30	1	27.00	50.0	As Requested	As Requested
HS 20-44	Inventory	1.002	STRENGTH-I Concrete Flexure	36.07	1	27.00	50.0	As Requested	As Requested
HS 20-44	Operating	1.299	STRENGTH-I Concrete Flexure	46.75	1	27.00	50.0	As Requested	As Requested
SU7	Legal	1.195	STRENGTH-I Concrete Flexure	46.32	1	27.00	50.0	As Requested	As Requested
Type 3S2	Legal	1.854	STRENGTH-I Concrete Flexure	66.73	1	21.60	40.0	As Requested	As Requested
Annual Permit 1	Permit	1.474	STRENGTH-II Concrete Flexure	121.57	1	21.60	40.0	As Requested	As Requested
Annual Permit 2	Permit	1.293	STRENGTH-II Concrete Flexure	106.68	1	27.00	50.0	As Requested	As Requested
Gravel Truck	Legal	1.200	STRENGTH-I Concrete Flexure	44.41	1	27.00	50.0	As Requested	As Requested
Overweight Permit	Permit	1.131	STRENGTH-II Concrete Flexure	144.23	1	27.00	50.0	As Requested	As Requested
EV2	Legal	1.565	STRENGTH-I Concrete Flexure	45.00	1	27.00	50.0	As Requested	As Requested
EV3	Legal	0.990	STRENGTH-I Concrete Flexure	42.55	1	27.00	50.0	As Requested	As Requested

Note:

"N/A" indicates not applicable

***" indicates not available

PHOTOGRAPHS

Bridge No.: 33 - 03578 - 0080
Crossing:: 124
Federal No.: 33I00240059

Date: July 30, 2002

PIC1



SIDE VIEW LOOKING AHEAD

PIC2



SIDE VIEW LOOKING BACK

PHOTOGRAPHS

Page No. _____

Bridge No.: 33 - 03578 - 0080
Crossing: 124
Federal No.: 33100240059

Date: July 30, 2002

PIC3



ACROSS TOP

PIC4



BRIDGE NUMBER

PHOTOGRAPHS

Page No. _____

Bridge No.: 33 - 03578 - 0080
Crossing:: I24
Federal No.: 33100240059


Date: July 30, 2002

PIC5



LOOKING BACK ON UNDERPASS ROUTE

PIC6

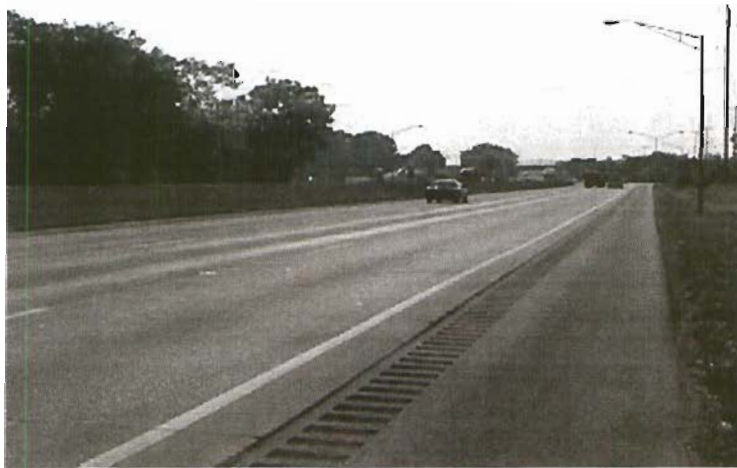

LOOKING AHEAD ON UNDERPASS ROUTE

PHOTOGRAPHS

Page No. _____

Bridge No.: 33 - 03578 - 0080
Crossing:: 124
Federal No.: 33100240059

Date: July 30, 2002

PIC1



VEG. IN DRAINS

PIC2



SM. CRACK AT APPROACH #2

PHOTOGRAPHS

Page No. _____

Bridge No.: 33 - 03578 - 0080
Crossing:: 124
Federal No.: 33I00240059

Date: July 30, 2002

PIC3



SM. CRACK AT APPROACH #1

PIC4



SPALL W/ REBAR EXP. #1 ABUT

PHOTOGRAPHS

Page No. _____

Bridge No.: 33 - 03578 - 0080
Crossing: I24
Federal No.: 33I00240059

Date: July 30, 2002

PIC5



SPALL W/ REBAR EXP. BENT #1 COL

PIC6

0

ROUTINE BRIDGE INSPECTION REPORT

Page No. _____

Form BIR 3.0C
(Rev. 9-22-98)
DT-1537

Field Report No. 16 Date 8/2/2002
Previous Report No. 15 Date 9/19/2000
Plans: DESIGN

Bridge No. 33100240059
Eleven Digit No.

Bridge Location No. 33 - 03578 - 0.80
Co. Route Log Mile

MOORE ROAD(3578-0.80) over 124

Indepth Insp. Req'd: NO

Road Name

Crossing

(If yes itemize limits under comments)

Structure Type PCBB

FRACTURE CRITICAL: NO

FEATURE CHANGES:

Wearing Surface NO Type ASPHALT Depth 3.0 (in.)

Bridge Rail NO Describe changes:

Approach Rail NO

CLEARANCE CHANGES: NO (If yes make changes below)

Vertical Clearance over deck 99-99 (ft.-in.)

Vertical Under Clearance 16'-08" (ft.-in.)

Lateral Under Clearance 53.0 (*. * ft.)

Deck Width Curb/Curb 64.0 (*. * ft.)

Deck Width Rail/Rail 73.0 (*. * ft.)

Sidewalk Width Rt. 4.5 Lt. 4.5

INSPECTORS

BDERAMUS

Condition: FAIR (If change describe in comments)

Comments

Approaches	<u>FAIR</u> <i>UNEVEN, SETTLED, CRACKED. POTHOLED OVER JOINT.</i>
Deck Condition (Item 58)	<u>7</u> <i>JOINT AT CENTERLINE IS MOSTLY SEALED.</i>
Superstructure (Item 59)	<u>6</u>
a. Beams	<u>G-F</u> <i>SEVERAL CRACKED, MINOR SPALLS</i>
b. Bearings	<u>GOOD</u>
c. Diaphragms	<u>NA</u>
Substructure (Item 60)	<u>6</u>
a. Caps/Bridge Seats	<u>G-F</u> <i>DELAMS, CRACKS, SCALE</i>
b. Columns/Piles	<u>G-F</u> <i>DELAMS, REBAR SPALLS, REBAR MAT EXPOSED, REBAR POPOUT</i>
c. Footings	<u>NV</u>
d. Wing W./Breast W.	<u>G-F</u> <i>HR.LINE-SMALL CRACKS, DELAMS, SPALL, POPOUTS</i>
Scour/Erosion	<u>GOOD</u>
Channel (Item 61)	<u>N</u>

UNDERWATER INSPECTION

To Be Performed By: NONEREQUIRED

Weight Limit Posted NO

Date Underwater Insp. _____

Gross..... _____ Tons

BRIDGE is: OPEN

2 Axle..... _____ Tons

3 or more Axles.. _____ Tons

COMMENTS:

COMMENTS: Bent caps have cracks & delams. Columns have rebar spalls w/ mat exposed and delams. Abutments have small cracks and delams. Few PCBBs have minor spalls & cracks. Asphalt wearing surface is uneven. Longitudinal cracks have been sealed. Overlay is breaking-up over the joints. Pothole in overlay at #2 end. The approach pavement is settled and uneven. There are no approach guard rails.

Supervising Bridge Inspector: W.LLOYD

BRIDGE RATING: FAIR

Inspection Team's Summary
Bridge Location No. 33 - 03578 - 0.80
Inspection Date 8/2/2002
Bridge Rating FAIR

Page No. ____

TYPE SERVICE: SOUTH MOORE ROAD
OVER: I 24 (L.M. 13.34)

- On August 2, 2002, a Region Two Bridge Inspection Team inspected this structure and found it to be in FAIR condition.
- The abutment breastwalls have hairline to small cracks, delams and a rebar spall. The bent caps have delaminated areas, cracks and scale. The bent columns have rebar spalls, rebar mat exposed, delams, cracks and popouts. The bearing pads are good.
- PCBBs have some spalls, exposed cable, cracks and scrape marks.
- The asphalt wearing surface is uneven. The longitudinal crack along the centerline paving joint has been sealed but there is some sealer loss. The overlay is breaking-up and potholed over the joints. The approach pavement is settled, cracked and uneven. The bridge rail is substandard. There are no approach guardrails.

Other Signs or Plaques:

Comments Regarding any Problems with Signing:

BRIDGE FEATURES (*.* ft.)

Bridge Skew	<u>90 °</u>	Number of Lanes/Tracks on Bridge	<u>5</u>
Structure Type (Main Span)	<u>PCBB</u>	No. Main Spans	<u>4</u>
Structure Type (Appr.Spans)	<u>NA</u>	No. Appr. Spans	<u>NA</u>
Maximum Span Length	<u>55.2</u> (ft.)	Total Length	<u>174.5</u> (ft.)
Width of Bridge Out-to-Out	<u>79.5</u> (ft.)	Right Angle to Centerline of Bridge	
Width of Bridge Along Skew	<u>NA</u> (ft.)	(If Unable to Measure at Right Angle to Centerline of Bridge)	

BRIDGE CONDITION: FAIR

Does Potential Exist for Elements from Bridge Falling on Roadway Beneath? NO

Does Potential Exist Because of Deteriorated Condition or Failure of Major Members? NO

Comment on any Conditions of Bridge that would Effect Roadway Beneat

Note: If Underpass Route is Divided Highway, Use Two of These Forms, One for Each Roadway.

MINIMUM PICTURES REQUIRED

1. Elevation View of Bridge on Both Sides Showing Underpass
2. View Showing Both Approaches to Bridge
3. View Showing Safety Features
4. View Showing Any Problems

INSPECTION REPORT FOR UNDERPASS ROUTE

Form BIR 3.0A
(Rev. 9-22-98)
DT-1443

Field Report No. 16 Date 8/2/2002
Previous Report No. 15 Date 9/19/2000

Bridge No. 33I00240059
Eleven Digit No.

Underpass Location No. 33 - I0024 - 13.34
Co. Route Log Mile

_____ or 33 - 03578 - 0080 over 33 - I0024 - 13.34
Railroad/Walkway Co. Route Log Mile Co. Route Log Mile

County HAMILTON

Structure Name (If Named) SOUTH MOORE ROAD

Year Constructed 1964 ACTUAL

Year Widened NA NA Year Rehabilitated NA NA

GEOMETRIC FEATURES UNDER BRIDGE (*. * ft. unless otherwise noted)

Divided Highway RIGHT ROADWAY Type of Wearing Surface CONCRETE

Width of Approach Traveled Roadway 36.0 ft. (Does Not Include Shoulders)

Width of Median if Divided Highway 16.0 ft.

Approach Shoulder Width 10.0 ft. Right 6.5 ft. Left

*Horizontal Clearance Under Bridge 52.5 ft.

*Distance Between Pier Protection Guardrail and Substructure 0 ft. Right 0 ft. Left

*Width of Sidewalk Under Bridge NA ft. Right NA ft. Left

*Minimum Vertical Clearance: 16 ft. 8 in. (ft.-in.)

*Show on Sketch

TRAFFIC SAFETY FEATURES

Pier Protection Railing or Parapet
Approach Guardrail Terminals
Approach Guardrail
Approach Guardrail Terminal

Rating	Standard/ SubStandard Non Exist
GOOD	STANDARD
GOOD	STANDARD
GOOD	STANDARD
GOOD	STANDARD

INSPECTORS

1. WATKINS
2. DERAMUS
3. _____
4. _____
5. _____
6. _____

SIGNING

Yes/ No/ Needed

Paddleboards	NO
Vertical Clearance (<14'-6")	NO
Narrow Passage	NO
One Lane Passage	NO

Other Underpass Signs Needed

Underpass Location No. 33 - I0024 - 13.34
Co. Route Log Mile

Other Signs or Plaques:

Comments Regarding any
Problems with Signing:

BRIDGE FEATURES (*.* ft.)

Bridge Skew 90° Number of Lanes/Tracks on Bridge 5
Structure Type (Main Span) PCBB No. Main Spans 4
Structure Type (Appr. Spans) NA No. Appr. Spans NA
Maximum Span Length 55.2 (ft.) Total Length 174.5 (ft.)
Width of Bridge Out-to-Out 79.5 (ft.) Right Angle to Centerline of Bridge)
Width of Bridge Along Skew NA (ft.) (If Unable to Measure at Right
Angle to Centerline of Bridge)

BRIDGE CONDITION: FAIR

Does Potential Exist for Elements from Bridge Falling on Roadway Beneath? NO
Does Potential Exist Because of Deteriorated Condition or Failure of Major Members? NO

Comment on any Conditions of Bridge that would Effect Roadway Beneat

Note: If Underpass Route is Divided Highway, Use Two of These Forms, One for Each Roadway.

MINIMUM PICTURES REQUIRED

1. Elevation View of Bridge on Both Sides Showing Underpass
2. View Showing Both Approaches to Bridge
3. View Showing Safety Features
4. View Showing Any Problems

Bridge No.:
Crossing : I24
Federal No 33I00240059

33 —03578 — 0080

Date:

June 20, 2000

PIC2



SIDE VIEW

PIC3



ACROSS TOP

Bridge No.: 33 — 03578 — 0080
Crossing: 124
Federal No.: 33100240059

Date: June 20, 2000

PIC4



BRIDGE NUMBER

PIC5



VOID IN SEAL IN EXPANSION JOINT AT #2 END

Bridge No.: 33 — 03578 — 0080
Crossing:: I24
Federal No.: 33100240059

Date: June 20, 2000

PIC6



SPAN #3 BEAM A, LARGE SPALL W/ STRANS EXPOSED

PIC7



SPAN #3 BEAM A, SPALL W/ STRANS EXPOSED

Bridge No.: 33 — 03578 — 0080
Crossing: 124
Federal No.: 33100240059

Date: June 20, 2000

PIC8



ABUTMENT #1, LEFT SIDE, LARGE DELAM AREA

PIC9



ABUTMENT #1, LEFT SIDE, LARGE DELAM AREA

Bridge No.: 33 — 03578 — 0080

Crossing:: 124

Federal No.: 33100240059

Date:

June 20, 2000

PIC10



BENT #1, COLUMN C, LARGE DELAM WITH REBAR EXPOSED

PIC11



BENT #1, COLUMN F, LARGE DELAM WITH REBAR EXPOSED

ROUTINE BRIDGE INSPECTION REPORT

Page No. _____

Form BIR 3.0C
(Rev. 9-22-98)
DT-1537

Field Report No. 15 Date 09/19/2000
Previous Report No. 14 Date 09/03/1998
Plans: DESIGN

Bridge No. 33100240059
Eleven Digit No.

Bridge Location No. 33 - 03578 - 0.80
Co. Route Log Mile

MOORE ROAD(3578-0.80) over 124

Indepth Insp. Req'd: NO

Road Name

Crossing

(If yes itemize limits under comment)

Structure Type PCBB

FRACTURE CRITICAL: NO

FEATURE CHANGES:

Wearing Surface NO Type ASPHALT Depth 3.0 (in.)

Bridge Rail NO Describe changes:

Approach Rail NO

CLEARANCE CHANGES: NO (If yes make changes below)

Vertical Clearance over deck 99-99 (ft.-in.)

Vertical Under Clearance 16'-08" (ft.-in.)

Lateral Under Clearance 53.0 (*.ft.)

Deck Width Curb/Curb 64.0 (*.ft.)

Deck Width Rail/Rail 73.0 (*.ft.)

Sidewalk Width Rt. 4.5 Lt. 4.5

INSPECTORS

F.WATKINS

BDERAMUS

Condition: FAIR (If change describe in comments)

Comments

	FAIR	UNEVEN, SETTLED, CRACKED
Approaches	7	JOINT AT CENTERLINE IS MOSTLY SEALED.
Deck Condition (Item 58)	6	
Superstructure (Item 59)	G-F	SEVERAL CRACKED, MINOR SPALLS
a. Beams	GOOD	
b. Bearings	NA	
c. Diaphragms	6	
Substructure (Item 60)	G-F	DELAMS, CRACKS, SCALE
a. Caps/Bridge Seats	G-F	DELAMS, REBAR SPALLS, REBAR MAT EXPOSED, TIE WIRE POPOUTS, REB
b. Columns/Piles	NV	
c. Footings	G-F	HR.LINE-SMALL CRACKS, DELAMS, REBAR POPOUTS
d. Wing W./Breast W.	GOOD	
Scour/Erosion	N	
Channel (Item 61)		

UNDERWATER INSPECTION

To Be Performed By: DOT FIELD TEAM

Date Underwater Insp. _____

BRIDGE is: OPEN

Weight Limit Posted NO

Gross..... Tons

2 Axle..... Tons

3 or more Axles.. Tons

COMMENTS: . . B

COMMENTS: Bent caps have cracks & delams. Colbmns have re ar spalls w/ mat exposed and delams. Breastwalls have small cracks and delams. Few PCBBs have minor spalls & cracks. Asphalt wearing surface is uneven. Longitudinal cracks have been sealed. Overlay is breaking-up over the joints. Pothole in overlay at #2 end. The approach pavement is settled and uneven. There are no approach guard rails.

Supervising Bridge Inspector: W.LLOYD

BRIDGE RATING: FAIR

Inspection Team's Summary
Bridge Location No. 33 - 03578 - 0.80
Inspection Date 09/19/2000
Bridge Rating FAIR

Page No. ____

TYPE SERVICE: SOUTH MOORE ROAD
OVER: I 24 (L.M. 13.34)

- On September 19, 2000, a Region Two Bridge Inspection Team inspected this structure and found it to be in FAIR condition.
- The abutment breastwalls have hairline to small cracks, minor delaminated areas and a few rebar popouts. The bent caps have delaminated areas, cracks and scale. The bent columns have rebar spalls, rebar mat exposed, delams, cracks and popouts. The bearing pads are good.
- Some spalls, exposed cable, cracks and scrape marks on PCBBs.
- The asphalt wearing surface is uneven. The longitudinal crack along the centerline paving joint has been sealed but there is some sealer loss. The overlay is breaking-up over the joints. The approach pavement is settled, cracked and uneven. The bridge rail is substandard and has some rebar spalls. There are no approach guardrails. The underpass roadway (I-24) has been upgraded to standard guardrail and parapets.

INSPECTION REPORT FOR UNDERPASS ROUTE

Form BIR 3.0A
(Rev. 9-22-98)
DT-1443

Field Report No. 15 Date 09/19/2000
Previous Report No. 14 Date 09/03/1998

Bridge No. 33100240059
Eleven Digit No.

Underpass Location No. 33 - 03578 - 0.80
Co. Route Log Mile

_____ or 33 - 10024 - 1334 over 33 - 03578 - 0.80
Railroad/Walkway Co. Route Log Mile Co. Route Log Mile

County Hamilton Structure Name (If Named) SOUTH MOORE ROAD

Year Constructed 1964 ACTUAL

Year Widened NA Year Rehabilitated NA

GEOMETRIC FEATURES UNDER BRIDGE (*.* ft. unless otherwise noted)

Divided Highway LEFT ROADWAY Type of Wearing Surface CONCRETE

Width of Approach Traveled Roadway 36.0 ft. (Does Not Include Shoulders)

Width of Median if Divided Highway 16.0 ft.

Approach Shoulder Width 6.0 ft. Right 10 ft. Left

*Horizontal Clearance Under Bridge 53.0 ft.

*Distance Between Pier Protection Guardrail and Substructure NA ft. Right NA ft. Left

*Width of Sidewalk Under Bridge NA ft. Right NA ft. Left

*Minimum Vertical Clearance: 16 ft. 08 in. (ft.-in.)

*Show on Sketch

TRAFFIC SAFETY FEATURES

Pier Protection Railing or Parapet
Approach Guardrail Terminals
Approach Guardrail
Approach Guardrail Terminal

Rating	Standard/ SubStandard Non Exist
GOOD	STANDARD
GOOD	STANDARD
GOOD	STANDARD
GOOD	STANDARD

INSPECTORS

1. _____
2. _____
3. _____
4. _____
5. _____
6. _____

SIGNING

Yes/ No/ Needed

Paddleboards	NO
Vertical Clearance (<14'-6")	NO
Narrow Passage	NO
One Lane Passage	NO

Other Underpass Signs Needed

Form BIR 3.0A (Continued)
(Rev. 9-22-98)
DT-1443

Date 09/19/2000

Underpass Location No. 33 - 03578 - 0.80
Co. Route Log Mile

Other Signs or Plaques:

Comments Regarding any
Problems with Signing:

BRIDGE FEATURES (*.* ft.)

Bridge Skew	<u>90°</u>	Number of Lanes/Tracks on Bridge	<u>5</u>
Structure Type (Main Span)	<u>PCBB</u>	No. Main Spans	<u>4</u>
Structure Type (Appr.Spans)	<u>NA</u>	No. Appr. Spans	<u>NA</u>
Maximum Span Length	<u>55.2</u> (ft.)	Total Length	<u>174.5</u> (ft.)
Width of Bridge Out-to-Out	<u>79.5</u> (ft.)	Right Angle to Centerline of Bridge)	
Width of Bridge Along Skew	<u>NA</u> (ft.)	(If Unable to Measure at Right Angle to Centerline of Bridge)	

BRIDGE CONDITION: FAIR

Does Potential Exist for Elements from Bridge Falling on Roadway Beneath? NO

Does Potential Exist Because of Deteriorated Condition or Failure of Major Members? NO


Comment on any Conditions of Bridge that would Effect Roadway Beneath

Note: If Underpass Route is Divided Highway, Use Two of These Forms, One for Each Roadway.

MINIMUM PICTURES REQUIRED


1. Elevation View of Bridge on Both Sides Showing Underpass
2. View Showing Both Approaches to Bridge
3. View Showing Safety Features
4. View Showing Any Problems

South moore
LATERAL AND VERTICAL CLEARANCES

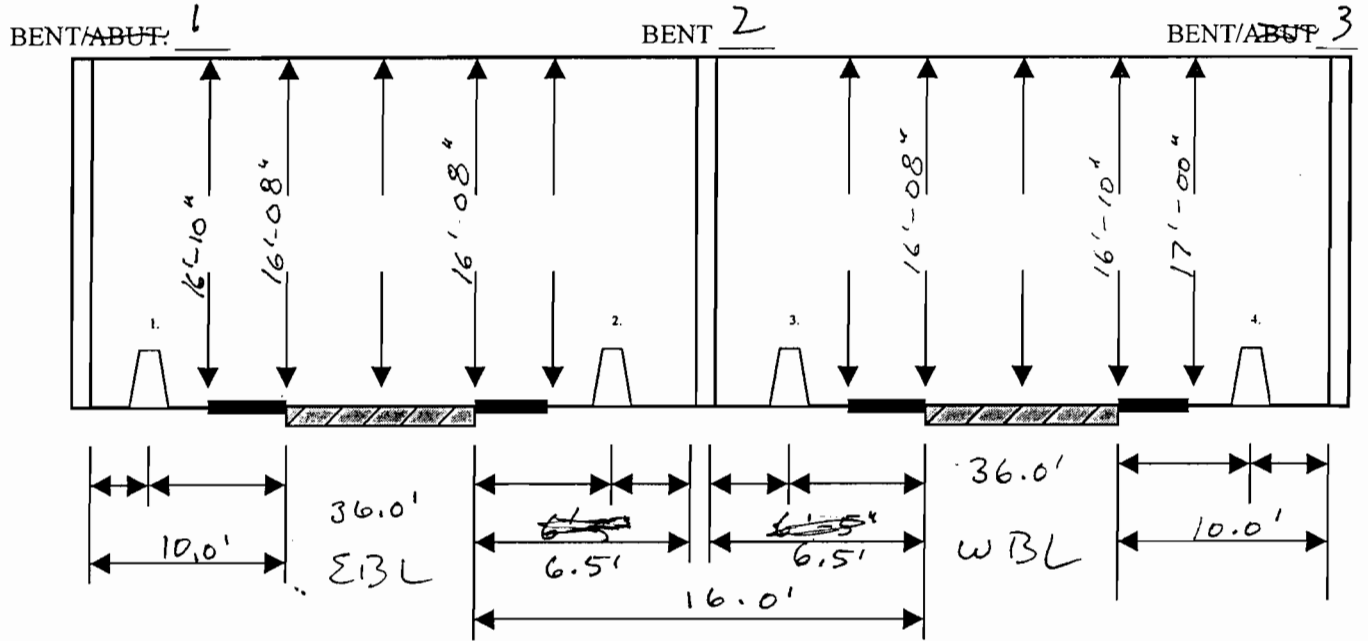


1.	RAIL/BARRIER TYPE:	W-SHAPE <input checked="" type="checkbox"/>	CONC. BARRIER <input type="checkbox"/>	NONE <input type="checkbox"/>
2.	RAIL/BARRIER TYPE:	W-SHAPE <input type="checkbox"/>	CONC. BARRIER <input checked="" type="checkbox"/>	NONE <input type="checkbox"/>
3.	RAIL/BARRIER TYPE:	W-SHAPE <input type="checkbox"/>	CONC. BARRIER <input checked="" type="checkbox"/>	NONE <input type="checkbox"/>
4.	RAIL/BARRIER TYPE:	W-SHAPE <input checked="" type="checkbox"/>	CONC. BARRIER <input checked="" type="checkbox"/>	NONE <input type="checkbox"/>


BENT/ABUT. _____ BENT/ABUT. _____

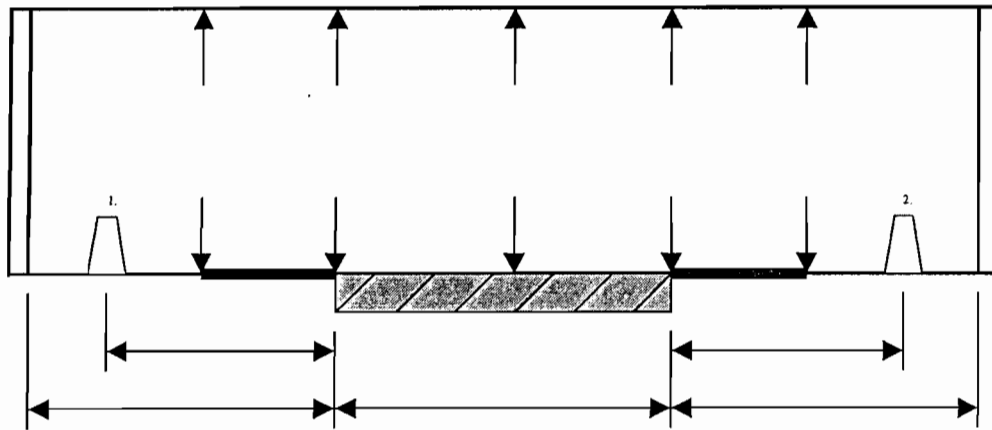

BENT/ABUT. _____

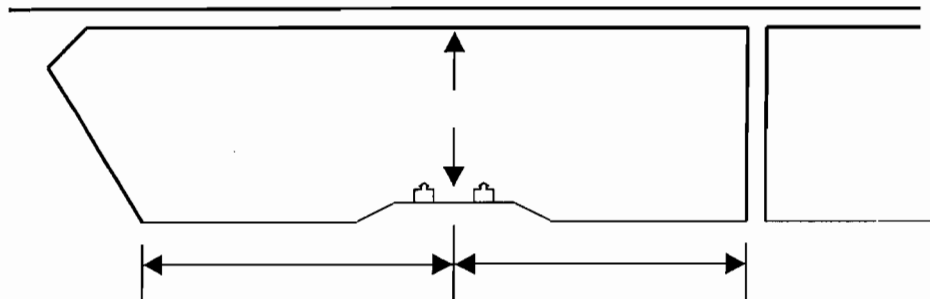


LATERAL AND VERTICAL CLEARANCES

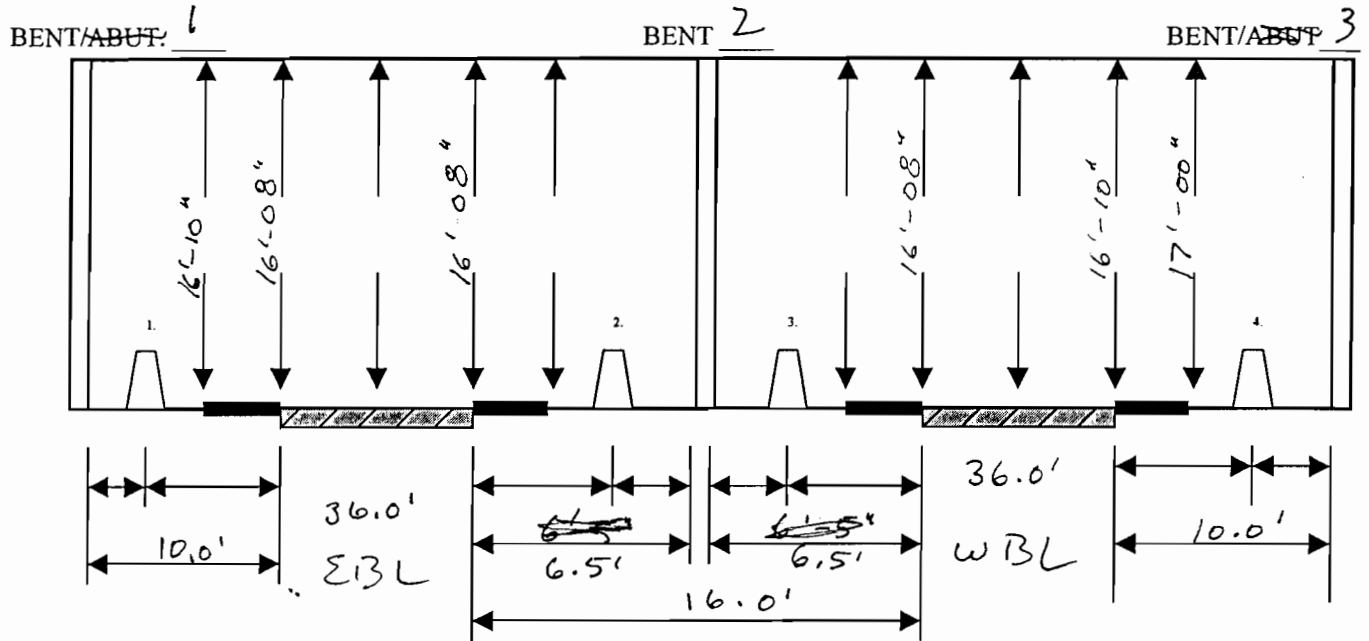


1.	RAIL/BARRIER TYPE:	W-SHAPE <input checked="" type="checkbox"/>	CONC. BARRIER <input type="checkbox"/>	NONE <input type="checkbox"/>
2.	RAIL/BARRIER TYPE:	W-SHAPE <input type="checkbox"/>	CONC. BARRIER <input checked="" type="checkbox"/>	NONE <input type="checkbox"/>
3.	RAIL/BARRIER TYPE:	W-SHAPE <input type="checkbox"/>	CONC. BARRIER <input checked="" type="checkbox"/>	NONE <input type="checkbox"/>
4.	RAIL/BARRIER TYPE:	W-SHAPE <input checked="" type="checkbox"/>	CONC. BARRIER <input checked="" type="checkbox"/>	NONE <input type="checkbox"/>

BENT/ABUT. _____ BENT/ABUT. _____

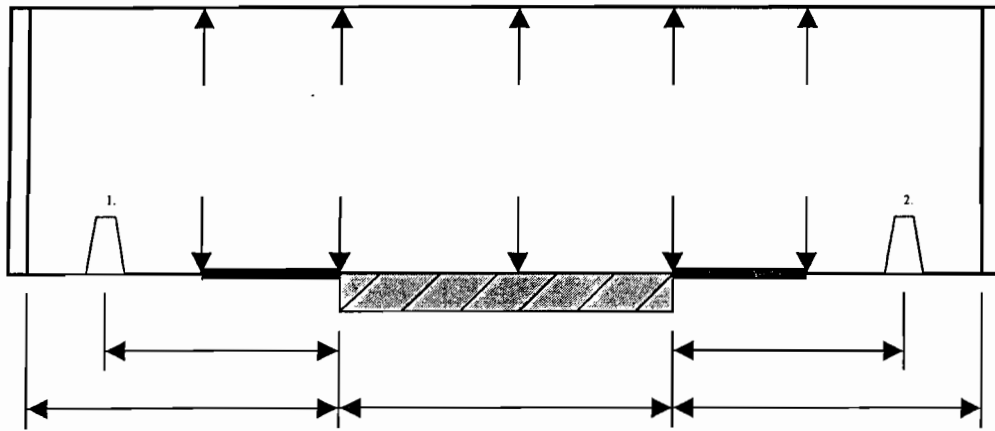

BENT/ABUT. _____

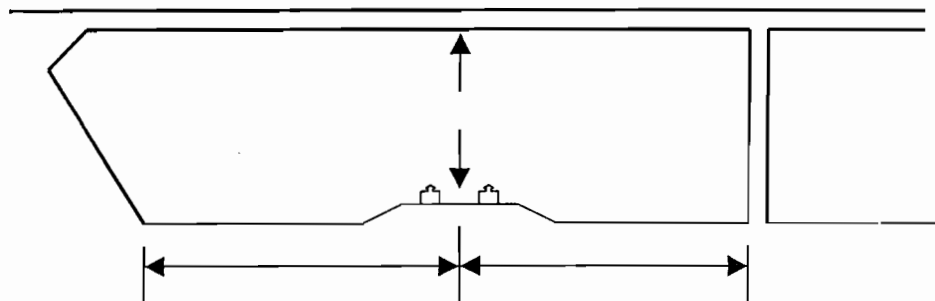


LATERAL AND VERTICAL CLEARANCES

BENT/ABUT. #1

BENT #2


BENT/ABUT. #3

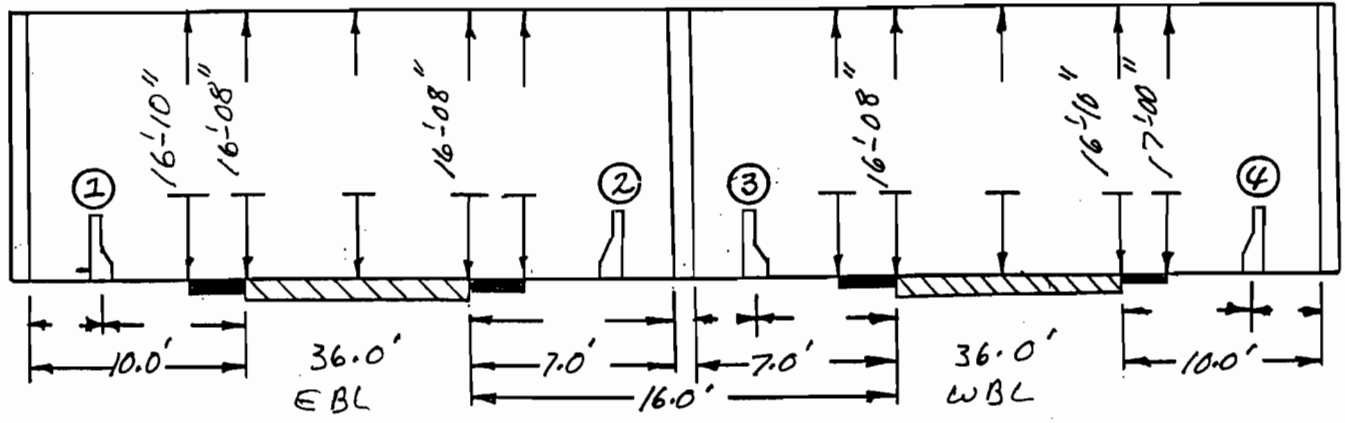


- | | | | | |
|-----------------------|-------------|-------------------|----------|--|
| 1. RAIL/BARRIER TYPE: | W-SHAPE [] | CONC. BARRIER [] | NONE [] | |
| 2. RAIL/BARRIER TYPE: | W-SHAPE [] | CONC. BARRIER [] | NONE [] | |
| 3. RAIL/BARRIER TYPE: | W-SHAPE [] | CONC. BARRIER [] | NONE [] | |
| 4. RAIL/BARRIER TYPE: | W-SHAPE [] | CONC. BARRIER [] | NONE [] | |

BENT/ABUT. _____

BENT/ABUT. _____

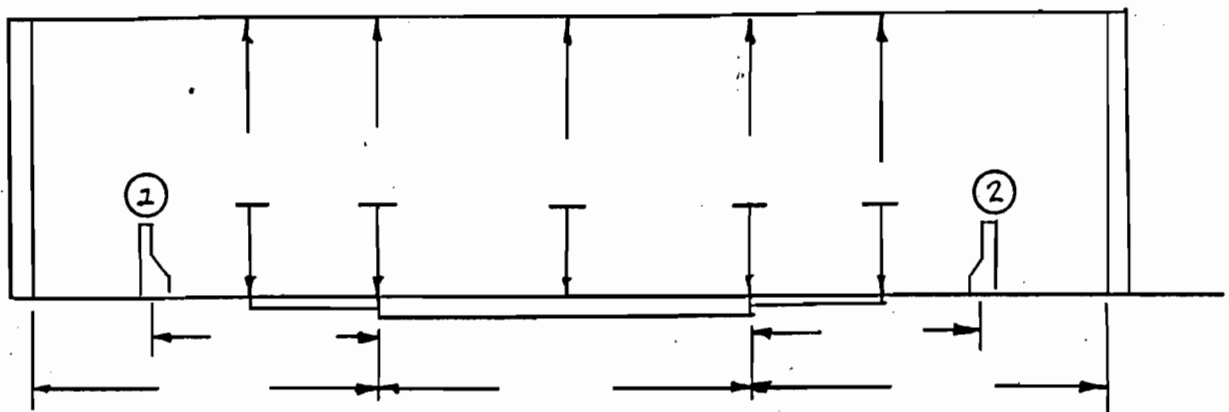

BENT/ABUT. _____

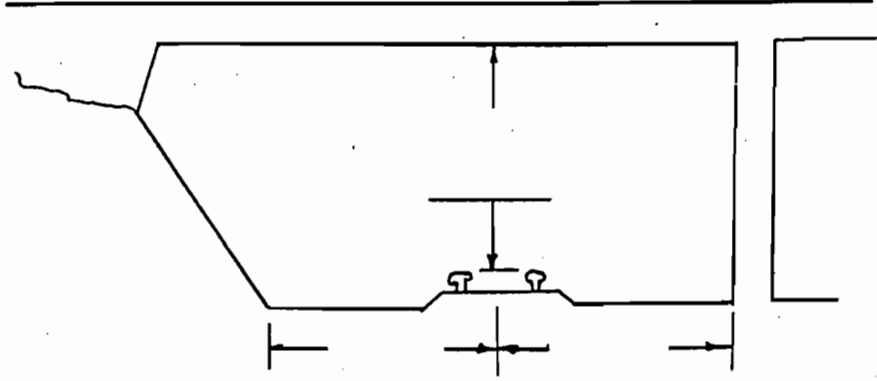

ELEVATIONS OF DECK ^{0.80}

BRIDGE LOCATION NO. 33 3578 ~~777~~
 COUNTY ROUTE LOG MILE

DATE: 10-7-92

STATION/ LOCATION	TOP OF LT. CURB/RAIL	GUTTER/ EDGE DECK	CENTERLINE	GUTTER/ EDGE DECK	TOP OF RT. CURB/RAIL
ABUT.#1	700.84	700.18	700.61	700.19	700.82
BENT#1	701.14	700.45	700.01	700.42	701.14
BENT#2	701.21	700.58	701.09	700.59	701.19
BENT#3	700.80	700.04	700.61	700.04	700.82
ABUT.#2	700.39	699.63	700.07	699.64	700.37

BENCH MARK LOCATION Bridge seat, Abut. #2, RT. side

BENCH MARK ELEVATION 698.36

NOTE: ELEVATIONS TAKEN FROM PREVIOUS REPORT DATED 11-15-90

000014

BIR 3.10
Rev. 4/20/90
DT-1510

BRIDGE NO. 33 - 3578 - ~~3578~~ ^{0.80}


DATE: 11/15/90

LATERAL AND VERTICAL CLEARANCES

BENT/ABUT. 1

BENT 2


BENT/ABUT. 3

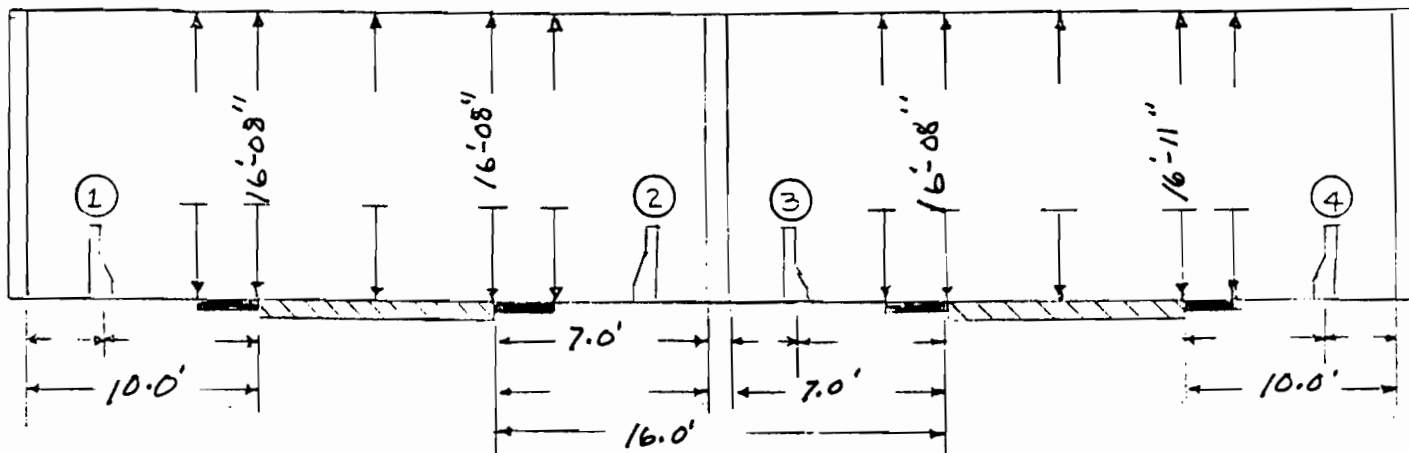


- | | | | | | | | |
|---|--------------------|---------|--------------------------|---------------|--------------------------|------|--------------------------|
| ① | RAIL/BARRIER TYPE: | W-Shape | <input type="checkbox"/> | Conc. barrier | <input type="checkbox"/> | None | <input type="checkbox"/> |
| ② | RAIL/BARRIER TYPE: | W-Shape | <input type="checkbox"/> | Conc. barrier | <input type="checkbox"/> | None | <input type="checkbox"/> |
| ③ | RAIL/BARRIER TYPE: | W-Shape | <input type="checkbox"/> | Conc. barrier | <input type="checkbox"/> | None | <input type="checkbox"/> |
| ④ | RAIL/BARRIER TYPE: | W-Shape | <input type="checkbox"/> | Conc. barrier | <input type="checkbox"/> | None | <input type="checkbox"/> |

BENT/ABUT. _____

BENT/ABUT. _____

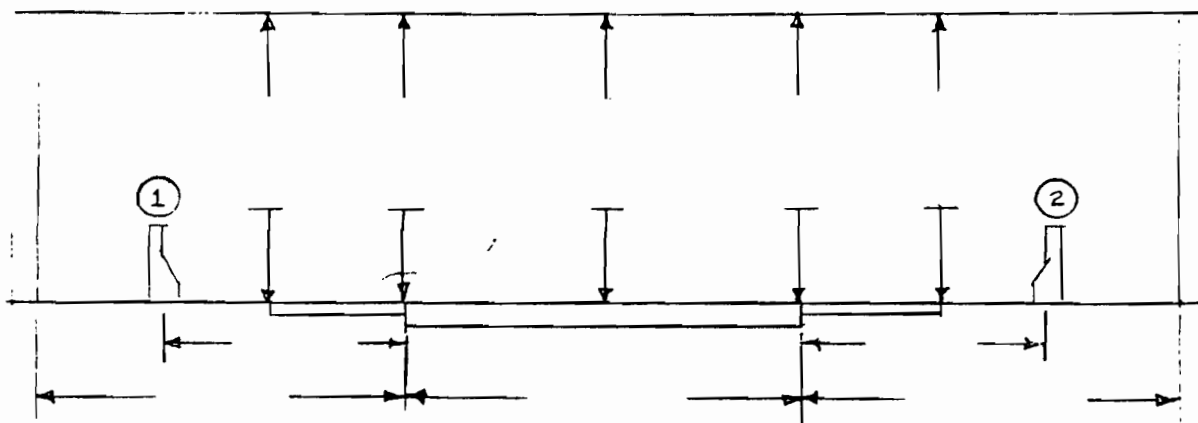

BENT/ABUT. _____

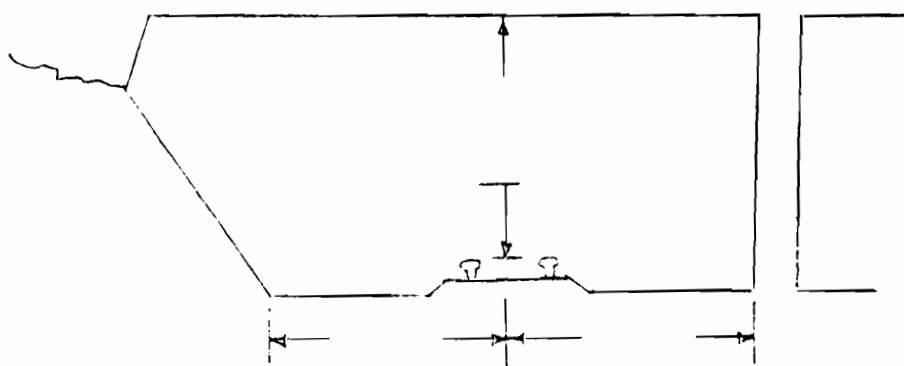

ELEVATIONS OF DECK

DT0905

33
COUNTY

3578
ROUTE

0.80
LOG MILE

11-15-80
DATE

STATION	TOP OF CURB	GUTTER	CENTER LINE	GUTTER	TOP OF CURB
ABUT.#1	700.84	700.18	700.61	700.19	700.82
BENT#1	701.14	700.45	700.01	700.42	701.14
BENT#2	701.21	700.58	701.09	700.59	701.19 700.82
BENT#3	700.80	700.04	700.61	700.04	700.82
ABUT.#2	700.39	699.63	700.07	699.64	700.37

BENCH MARK TOP BRIDGE SECT, ABUT.#2, RT. SIDE

698.36

LOCATION

PREVIOUS REPORT
11-13-88

ELEVATIONS OF DECK

PAGE NO

0.80

DT0905

33
COUNTY

FAU 3578
ROUTE


LOG MILE

12-6-88
DATE


STATION	TOP OF CURB	GUTTER	CENTER LINE	GUTTER	TOP OF CURB
ABUT #1	700.84	700.18	700.61	700.19	700.82
BENT #1	701.14	700.45	700.01	700.42	701.14
BENT #2	701.21	700.58	701.09	700.59	701.19
BENT #3	700.80	700.04	700.61	700.04	700.82
ABUT #2	700.39	699.63	700.07	699.64	700.37

NOTE: ELEVATIONS TAKEN FROM PREVIOUS REPORT DATED 10-26-86.

BENCH MARK: TOP OF BRIDGE SEAT, ABUTMENT #2 (NORTH) RIGHT SIDE
698.36
 LOCATION
 ELEVATION

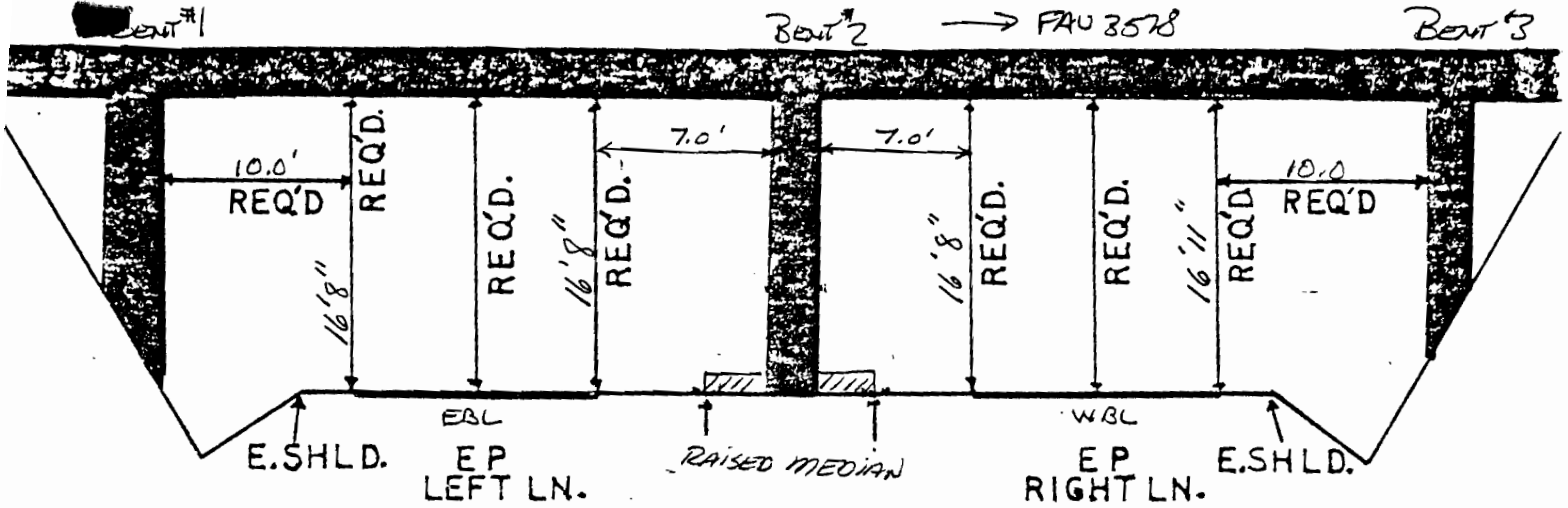

DIVIDED HIGHWAY

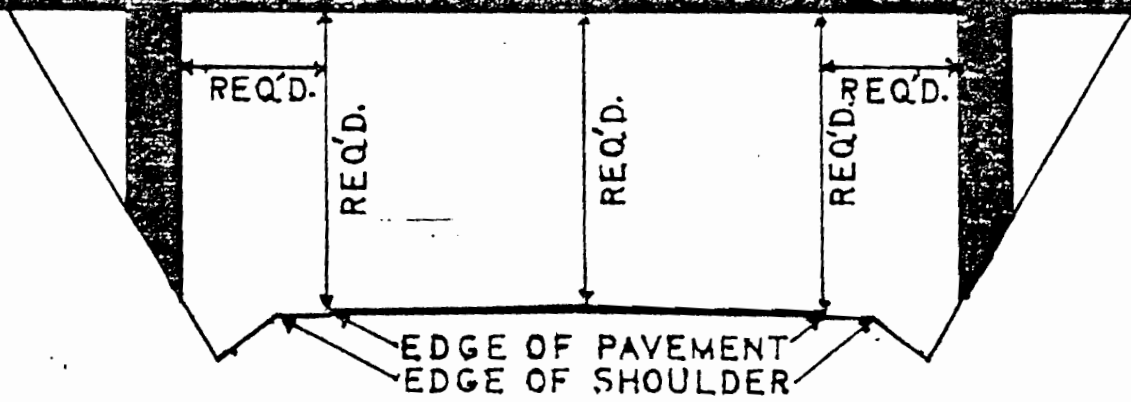

TWO LANE HIGHWAY

NOTE: ALL CLEARANCES ARE MINIMUM

ELEVATIONS OF DECK

DT0905

33
COUNTY

FAW
3578
ROUTE

0.80
~~0.80~~
LOG MILE


10-20-86
DATE

STATION	TOP OF CURB	GUTTER	CENTER LINE	GUTTER	TOP OF CURB
Abut # 1	700.84	700.18	700.61	700.19	700.82
bent # 1	701.14	700.45	700.01	700.42	701.14
bent # 2	701.21	700.58	701.09	700.59	701.19
bent # 3	700.80	700.04	700.61	700.04	700.82
Abut # 2	700.39	699.63	700.07	699.64	700.37


BENCH MARK TOP bridge seat, Abut #2 (North) Pt. side
LOCATION

698.36

ELEVATION TAKEN from previous Report 11-20-84

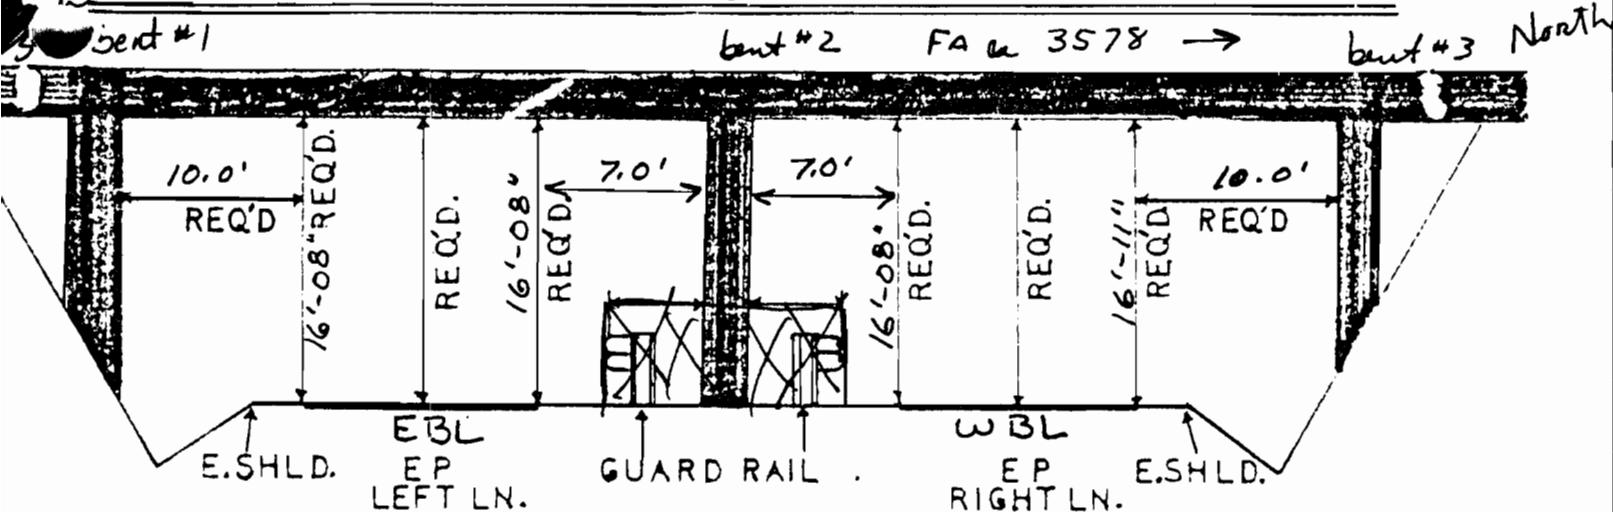

DIVIDED HIGHWAY

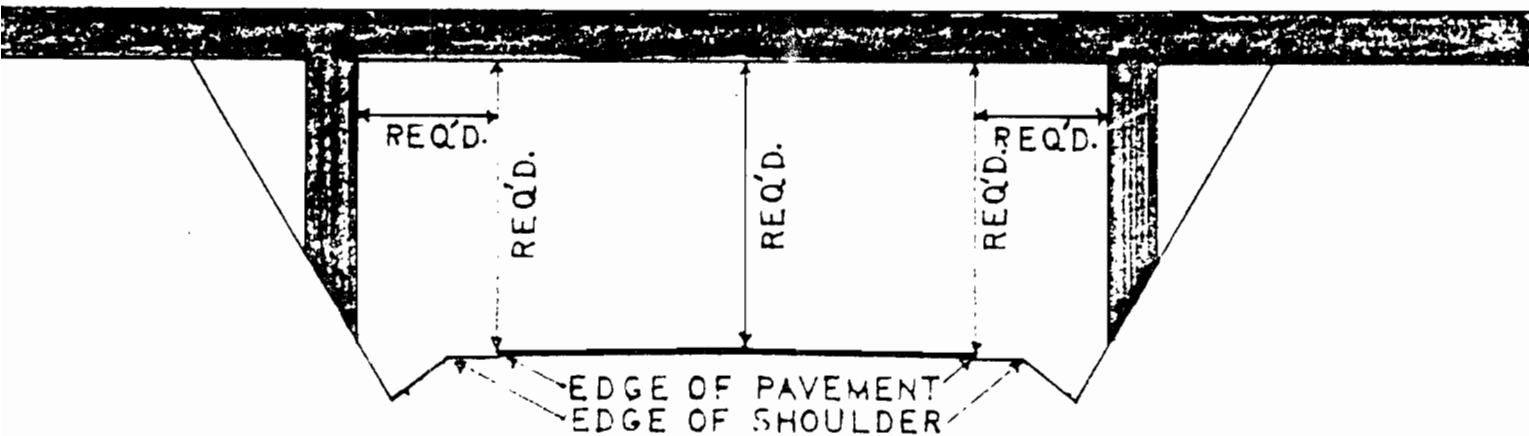

TWO LANE HIGHWAY

NOTE: ALL CLEARANCES ARE MINIMUM

33

24

13.34

8/21/98

8-153

COUNTY	ROUTE	LOG MILE ACROSS TOP	DATE	LOG #
--------	-------	------------------------	------	-------



JOINT @ ABUTMENT #2



33

I 24

13.34

8/21/96

R 183

COUNTY ROUTE LOG MILE DATE LOG #
OPEN CRACK ALONG CENTER LINE



BRIDG ENUMBER



33

I 24

13.34

8/21/98

COUNTY

ROUTE

LOG MILE

DATE

LOG #

SIDE VIEW



BRIDGE INSPECTION REPORT

000000004

FORM BIR 3.0
Rev. 3-1-97
DT-0069

FIELD REPORT NO. 14 DATE 09-03-98
PREVIOUS REPORT NO. 13 DATE 10-15-96
PLANS ---- YES [X] NO [] DESIGN

BRIDGE NO. 33I00240059 BRIDGE LOC. NO. 33 - 3578- 0.80 (1.29)
ELEVEN DIGIT NO. CO. ROUTE LOG MILE (LOG km)

33-3578- 0.80 (1.29) OVER 33- I24 -13.34 MOORE ROAD
ROAD NAME FEATURE INTERSECTED STRUCTURE NAME (IF NAMED)

YEAR CONSTRUCTED 1964 COUNTY HAMILTON MAINTENANCE DISTRICT NO. 21
(ESTIMATED OR ACTUAL)
[] [X]

YEAR WIDENED NA YEAR REHABILITATED NA
ESTIMATED OR ACTUAL ESTIMATED OR ACTUAL
[] [] [] []

FEATURES

WEARING SURFACE-- CONCRETE [] TIMBER [] ASPHALT [X] (DEPTH= 76.20mm)
FLARED WIDTH ----- YES [] NO [X]
NAVIGATIONAL CONTROL-- YES [] NO [X]
MEDIAN WIDTH ----- OPEN [] NONE [] CLOSED [X]

BRIDGE SKEW 90° LT [] RT []

STRUCTURE TYPE PCBB NO. SPANS 4
Main Span Main Span
STRUCTURE TYPE N/A NO. SPANS N/A
Approach Spans Approach Spans

MAXIMUM SPAN LENGTH 16.84 m TOTAL LENGTH 53.19 m

WIDTHS (*.**m) CLEARANCES (*.**m)
DECK OUT-TO-OUT 24.23 MIN. VERTICAL OVER DECK NA
ROADWAY CURB/CURB 19.51 MIN. VERTICAL UNDER CL. 5.08
SIDEWALK 1.75RT 1.75LT MIN. LATERAL UNDER CLEARANCE:
*APPROACH ROADWAY 17.68 3.05 RT
APPROACH SHLD. NA m RT 2.13 LT
NA m LT

- INSPECTORS
1. B.DERAMUS
2. F.WATKINS
3. G.SWAFFORD
4. G.SELCER
5.
6.
7.
8.
9.

*DOES NOT INCLUDE SHOULDER

UNDERWATER INSPECTION

INSPECTION PERFORMED BY:
DOT FIELD TEAM [] DATE
CONTRACT DIVERS [] DATE
NONE REQUIRED [X]

(< 7.62 m)
NBIS BRIDGE
LENGTH (***m)

CHANGE IN STRUCTURAL CONDITION YES [] NO [X]
MAJOR REPAIRS MADE YES [] NO [X]

FRACTURE CRITICAL
DETAILS: YES [] NO [X]
IF YES, INCLUDE BIR 3.9

COMMENTS: Substructure units have cracks, Delams, rebar popouts, & scale. Some beams have minor spalls & a few are cracked. Surface has longitudinal cracks along the center line, 1" wide. The approach pavement is uneven. The bridge rail is substandard. There are no approach guard rails. The joints over abut. #2 and bent #1 breaking up at the center of the bridge.

GARY SELCER
SUPERVISING BRIDGE INSPECTOR

BRIDGE RATING [] [XX] [] []
GOOD FAIR POOR CRITICAL

NOTE: UNLESS OTHERWISE NOTED, MEASUREMENTS ARE TO BE TAKEN TO TWO (2) DECIMAL PLACES IN METERS.

DECK

COMMENTS

WEARING SURFACE	G (F) P C	LONG. CRKS. ALONG CENTRLN 1½ WIDE @ PAVING JNT
DECK - STRUCTURAL	G F P C	NA (PCBB'S)
CONDITION		-
CURBS	(G) F P C	
MEDIAN	(G) F P C	
SIDEWALKS	(G) (F) P C	CRACKS, SCALE, POPOUTS.
PARAPET	G F P C	NA
RAILING	(G) (F) P C	SCALE, POPOUTS, CRACKS.
PAINT	G F P C	NA
DRAINS	G F (P) C	BLOCKED
LIGHTING STD'S	(G) F P C	
UTILITIES	G F P C	NA
JOINT LEAKAGE	G F (P) C	HEAVY
EXPANSION JOINTS	G (F) P C	NON-COMP. MTLs. UPHEAVEL IN OVERLAY.

SUPERSTRUCTURE

COMMENTS

BEARING DEVICES	(G) F P C	
GIRDERS OR BEAMS	(G) (F) P C	SEVERAL ARE CRACKED. MINOR SPALLS.
FLOOR BEAMS	G F P C	NA
STRINGERS	G F P C	NA
DIAPHRAGMS	G F P C	NA
BRACING	G F P C	NA
TRUSSES - GENERAL	F P C	NA
- PORTALS	G F P C	NA
- BRACING	G F P C	NA
PAINT	G F P C	NA
ALIGNMENT OF MEMBERS	(G) F P C	

TEXTURE COAT

CONDITION RATING	G F P C	FADING	G F P C
OVERALL APPEARANCE	G F P C	NEEDS SPOT PAINTING?	YES [] NO []
STAINING	G F P C	NEEDS REPAINTING?	YES [] NO []

COMMENTS: SLIGHT SCALE ALONG CRACKS IN PARAPETS. SCALING G F P C

RECOMMENDATIONS _____ CLEAN & SEAL JOINTS []
 _____ CLEAN DRAINS []

NOTE: UNLESS OTHERWISE NOTED, MEASUREMENTS ARE TO BE TAKEN TO TWO (2) DECIMAL PLACES IN METERS.

000000

SUBSTRUCTURE

ABUTMENTS

COMMENTS

CAPS	(G) (F) P C	HL-SMALL CRACKS, REBAR POPOUTS, DELAMS.
BREASTWALL	G F P C	NA
WINGS	(G) F P C	
BACKWALL	G F P C	NA
PLUMB	(G) F P C	
FOOTING	G F P C	NONE
PILES	G F P C	NOT VISIBLE
EMBANKMENT	(G) F P C	
BEARING SURFACE	(G) F P C	
SLOPE PAVING	(G) F P C	
RIP RAP	G F P C	NA

PIERS

CAPS	G F P C	
COLUMNS	G F P C	
PLUMB	G F P C	N/A
FOOTINGS	G F P C	
PILES	G F P C	
BEARING SURFACE	G F P C	

BENTS

CAPS	(G) (F) P C	DELAMS, CRACKS, SCALE.
COLUMNS	(G) (F) P C	TIE WIRE POPOUTS, REBAR POPOUTS.
PLUMB	(G) F P C	
FOOTINGS	G F P C	NOT VISIBLE
PILES	G F P C	NOT VISIBLE
BEARING SURFACE	(G) F P C	

PILES NEED REPLACEMENT NO [X] YES [] ----- **PILES TO BE REPLACED**

	NO [X]	YES []	PILE(S)	BENT	PILE(S)	BENT
CUT VEGETATION						
CLEAR DRIFT						

RECOMMENDATIONS: _____

NOTE: UNLESS OTHERWISE NOTED, MEASUREMENTS ARE TO BE TAKEN TO TWO (2) DECIMAL PLACES IN METERS.

000000

FORM BIR 3.9
Rev. 3-1-97
DT-1507

BRIDGE LOC. NO. 33 - 3578- 0.80 (1.29)
CO. ROUTE L.M. (LOG km)

DATE: 09-03-98

FRACTURE CRITICAL MEMBERS AND DETAILS

NOTE: Questions I and II both must be answered.

- I. Is this a non-redundant bridge? YES [] NO [X]
(If YES then answer question III)
- II. Does it have Fracture Critical Details? YES [] NO [X]
(If YES then answer question IV)

NOTE: Only check items that apply for questions III and IV.

- | | |
|---|--|
| <p>III. Type of non-redundant bridge:</p> <ul style="list-style-type: none"> 1. Simply supported two girder system . . . [] 2. Continuous two girder system . . . [] 3. Simply supported truss . . [] 4. Continuous truss . . . [] 5. Simply supported longitudinal box beam . . [] 6. Continuous longitudinal box beam . . . [] 7. Suspension bridge . . . [] 8. Tied arch bridge . . . [] 9. Steel pier/bent cap . . . [] 10. Single bearing devices . [] | <p>IV. Fracture critical details:</p> <ul style="list-style-type: none"> 1. Changes in cross section at: <ul style="list-style-type: none"> A. Cover plates . . [] B. Insert plates . [] C. Coped sections . [] 2. Framing system member connected at tension areas of: <ul style="list-style-type: none"> A. Floor beams . . [] B. Bracing members . [] C. Diaphragms or cross frames . . [] 3. Web stiffeners . . . [] 4. Eyebars [] 5. Pin and hanger connections [] 6. Single bearing devices [] |
|---|--|

V. Structural condition of FC members and details: (note location)

- A. 1. Cracking of FC members? YES [] NO []
- 2. Cracking of FC details? YES [] NO []
- B. 1. Corrosion of FC members? G F P C
- 2. Corrosion of FC details? G F P C

VI. Comments:

NOTE: UNLESS OTHERWISE NOTED, MEASUREMENTS ARE TO BE TAKEN TO TWO (2) DECIMAL PLACES IN METERS.

FORM BIR 3.0A
Rev. 3-1-97
DT-1443

CURRENT FIELD REPORT NO. 14 DATE 09-03-98
PREVIOUS FIELD REPORT NO. 13 DATE 10-15-96

INSPECTION REPORT FOR UNDERPASS ROUTE

BRIDGE NO. 33I00240059 UNDERPASS LOC. NO. 33 I24 13.34L (21.47)
ELEVEN DIGIT NO. _____ CO. ROUTE L.M. (LOG km)
33- 3578- 0.80 (1.29) OVER 33- I24 13.34L (21.47) SOUTH MOORE ROAD
CO. RTE. L.M. (LOG km) CO. RTE. L.M. (LOG km) STRUCTURE NAME
COUNTY HAMILTON
YEAR CONSTRUCTED 1964 YEAR WIDENED NA YEAR REHABILITATED NA
ESTIMATED [] ACTUAL [X]

GEOMETRIC FEATURES UNDER BRIDGE

DIVIDED HIGHWAY - - - - LEFT RDWY [X] RIGHT RDWY [] N.A. []
TYPE OF WEARING SURFACE - - - - CONCRETE [X] ASPHALT [] GRAVEL []
WIDTH OF APPROACH TRAVELED ROADWAY 10.97 m (DOES NOT INCLUDE SHOULDERS)
WIDTH OF MEDIAN IF DIVIDED HIGHWAY 4.88 m
APPROACH SHOULDER WIDTH 1.83 m (RT.) 3.05m (LT.)
*HORIZONTAL CLEARANCE UNDER BRIDGE 16.15 m
*DISTANCE BETWEEN PIER PROTECTION GUARDRAIL AND
SUBSTRUCTURE NA m (RT.) NA m (LT.)
*WIDTH OF SIDEWALK UNDER BRIDGE NA m (RT.) NA m (LT.)
MINIMUM VERTICAL CLEARANCE 5.08 m (.**m)
*SHOW ON SKETCH

TRAFFIC SAFETY FEATURES FOR UNDERPASS ROUTE STANDARD SUB-STANDARD

PIER PROTECTION RAILING
OR PARAPET (G) F P C [X] [] NON EXIST []
APPROACH GUARDRAIL TRANSITIONS (G) F P C [X] [] NON EXIST []
APPROACH GUARDRAIL (G) F P C [X] [] NON EXIST []
APPROACH GUARDRAIL TERMINAL (G) F P C [X] [] NON EXIST []

SIGNING FOR UNDERPASS ROUTE

PADDLEBOARD YES [] NO [X] NEEDED []
VERTICAL CLEARANCE (< 4.4 m) YES [] NO [X] NEEDED []
NARROW PASSAGE YES [] NO [X] NEEDED []
ONE LANE PASSAGE YES [] NO [X] NEEDED []
INSPECTORS
1. B.DERAMUS
2. F.WATKINS
3. G.SWAFFORD
4. G.SELCER
5. _____
6. _____

NOTE: UNLESS OTHERWISE NOTED, MEASUREMENTS ARE TO BE TAKEN TO TWO (2) DECIMAL PLACES IN METERS.

FORM BIR 3.0A (CONTINUED)

Rev. 3-1-97

DT-1443

UNDERPASS LOC. NO. 33 - I24 -13.34L (21.47)
 CO. ROUTE L.M. (LOG km)

OTHER SIGNS OR PLAQUES _____

COMMENTS REGARDING ANY PROBLEM WITH SIGNING _____

BRIDGE FEATURESBRIDGE SKEW 90°STRUCTURE TYPE PCBBNO. SPANS 4

MAIN SPAN

MAIN TYPE

STRUCTURE TYPE NANO. SPANS NA

APPROACH SPAN

APPROACH TYPE

MAXIMUM SPAN LENGTH 16.84 m TOTAL LENGTH 53.19 mWIDTH OF BRIDGE OUT-TO-OUT 24.23 m (RIGHT ANGLE TO CENTERLINE OF BRIDGE)WIDTH OF BRIDGE ALONG SKEW NA m (IF UNABLE TO MEASURE AT RIGHT ANGLE TO CENTERLINE OF BRIDGE)NUMBER OF LANES/TRACKS ON BRIDGE 5**BRIDGE CONDITION**

G (F) P C

DOES POTENTIAL EXIST FOR ELEMENTS FROM BRIDGE FALLING ON ROADWAY BENEATH? YES [] NO [X]

DOES POTENTIAL EXIST BECAUSE OF DETERIORATED CONDITION OR FAILURE OF MAJOR MEMBERS? YES [] NO [X]

COMMENT ON ANY CONDITIONS OF BRIDGE THAT WOULD EFFECT ROADWAY BENEATH _____

NOTE: IF UNDERPASS ROUTE IS DIVIDED HIGHWAY, USE TWO (2) OF THESE FORMS, ONE FOR EACH ROADWAY.

MINIMUM PICTURES REQUIRED

1. ELEVATION VIEW OF BRIDGE ON BOTH SIDES SHOWING UNDERPASS
2. VIEW SHOWING BOTH APPROACHES TO BRIDGE
3. VIEW SHOWING SAFETY FEATURES
4. VIEW SHOWING ANY PROBLEMS

NOTE: UNLESS OTHERWISE NOTED, MEASUREMENTS ARE TO BE TAKEN TO TWO (2) DECIMAL PLACES IN METERS.

INSPECTION REPORT FOR UNDERPASS ROUTE

BRIDGE NO. 33I00240059 UNDERPASS LOC. NO. 33 I24 13.34R (21.47)
ELEVEN DIGIT NO. - CO. ROUTE L.M. (LOG km)
33- 3578- 0.80 (1.29) OVER 33- I24 13.34R (21.47) SOUTH MOORE ROAD
CO. RTE. L.M. (LOG km) CO. RTE. L.M. (LOG km) STRUCTURE NAME
COUNTY HAMILTON
YEAR CONSTRUCTED 1964 YEAR WIDENED NA YEAR REHABILITATED NA
ESTIMATED [] ACTUAL [X]

GEOMETRIC FEATURES UNDER BRIDGE

DIVIDED HIGHWAY - - - - LEFT RDWY [] RIGHT RDWY [X] N.A. []
TYPE OF WEARING SURFACE - - - - CONCRETE [X] ASPHALT [] GRAVEL []
WIDTH OF APPROACH TRAVELED ROADWAY 10.97 m (DOES NOT INCLUDE SHOULDERS)
WIDTH OF MEDIAN IF DIVIDED HIGHWAY 4.88 m
APPROACH SHOULDER WIDTH 3.05m (RT.) 1.83 m (LT.)
*HORIZONTAL CLEARANCE UNDER BRIDGE 16.15 m
*DISTANCE BETWEEN PIER PROTECTION GUARDRAIL AND
SUBSTRUCTURE NA m (RT.) NA m (LT.)
*WIDTH OF SIDEWALK UNDER BRIDGE NA m (RT.) NA m (LT.)
*MINIMUM VERTICAL CLEARANCE 5.08 m (**m)
*SHOW ON SKETCH

TRAFFIC SAFETY FEATURES FOR UNDERPASS ROUTE STANDARD SUB-STANDARD

PIER PROTECTION RAILING
OR PARAPET (G) F P C [X] [] NON EXIST []
APPROACH GUARDRAIL
TRANSITIONS (G) F P C [X] [] NON EXIST []
APPROACH GUARDRAIL (G) F P C [X] [] NON EXIST []
APPROACH GUARDRAIL
TERMINAL (G) F P C [X] [] NON EXIST []

SIGNING FOR UNDERPASS ROUTE

PADDLEBOARD YES [] NO [X] NEEDED []
VERTICAL CLEARANCE
(< 4.4 m) YES [] NO [X] NEEDED []
NARROW PASSAGE YES [] NO [X] NEEDED []
ONE LANE PASSAGE YES [] NO [X] NEEDED []

INSPECTORS

- 1. B. DERAMUS
- 2. F. WATKINS
- 3. G. SWAFFORD
- 4. G. SELCER
- 5. _____
- 6. _____

NOTE: UNLESS OTHERWISE NOTED, MEASUREMENTS ARE TO BE TAKEN TO TWO (2) DECIMAL PLACES IN METERS.

FORM BIR 3.0A (CONTINUED)

Rev. 3-1-97

DT-1443

UNDERPASS LOC. NO. 33 - I24 - 13.34R (21.47)
 CO. ROUTE L.M. (LOG km)

OTHER SIGNS OR PLAQUES _____

COMMENTS REGARDING ANY PROBLEM WITH SIGNING _____

BRIDGE FEATURESBRIDGE SKEW 90°STRUCTURE TYPE PCBBNO. SPANS 4

MAIN SPAN

MAIN TYPE

STRUCTURE TYPE NANO. SPANS NA

NA

APPROACH SPAN

APPROACH TYPE

MAXIMUM SPAN LENGTH 16.84 m TOTAL LENGTH 53.19 mWIDTH OF BRIDGE OUT-TO-OUT 24.23 m (RIGHT ANGLE TO CENTERLINE OF BRIDGE)WIDTH OF BRIDGE ALONG SKEW NA m (IF UNABLE TO MEASURE AT RIGHT ANGLE
TO CENTERLINE OF BRIDGE)NUMBER OF LANES/TRACKS ON BRIDGE 5**BRIDGE CONDITION**

G (F) P C

DOES POTENTIAL EXIST FOR ELEMENTS FROM BRIDGE FALLING ON ROADWAY
BENEATH? YES [] NO [X]DOES POTENTIAL EXIST BECAUSE OF DETERIORATED CONDITION OR FAILURE
OF MAJOR MEMBERS? YES [] NO [X]

COMMENT ON ANY CONDITIONS OF BRIDGE THAT WOULD EFFECT ROADWAY BENEATH _____

NOTE: IF UNDERPASS ROUTE IS DIVIDED HIGHWAY, USE TWO (2) OF
THESE FORMS, ONE FOR EACH ROADWAY.

MINIMUM PICTURES REQUIRED

1. ELEVATION VIEW OF BRIDGE ON BOTH SIDES SHOWING UNDERPASS
2. VIEW SHOWING BOTH APPROACHES TO BRIDGE
3. VIEW SHOWING SAFETY FEATURES
4. VIEW SHOWING ANY PROBLEMS

NOTE: UNLESS OTHERWISE NOTED, MEASUREMENTS ARE TO BE TAKEN TO TWO (2)
DECIMAL PLACES IN METERS.

BRIDGE INSPECTION SUMMARY

BRIDGE NO. 33 3578 0.80 (1.29) 09/03/98
COUNTY ROUTE LOG MILE (LOG km) DATE

TYPE SERVICE: SOUTH MOORE ROAD
OVER: I 24 (L.M. 13.34)

On September 3, 1998, A Region Two Bridge Inspection Team inspected this structure and found it to be in FAIR condition.

The abutment cap beams have hairline to small cracks, minor delaminated areas and a few rebar popouts. The bent caps have delaminated areas, cracks and scale. The bent columns have rebar popouts. The bearing pads are good.

Some beams have minor spalls and a few are cracked.

The wearing surface has a large open longitudinal crack along the centerline paving joint. The approach pavement is cracked and uneven. The bridge rail is substandard with a few rebar spalls. There are no approach guardrails. The expansion joints over abutment #2 and bent #1 are breaking up and settling at the center of the bridge. The underpass roadway (I-24) has been upgraded to standard guardrail and parapets.

Top Span No. 1

PAGE 000015

BRIDGE NO. 33
COUNTY

FAV3578/124
ROUTE

0.80 / .13.34
LOG MILE

2/14/95
10-7-92
DATE 10/15/96

9-3-98

ELEMENT	RATING	COMMENTS
Approach Pavement	Fair	Large crack across bridgnd w/1" settlement @ Lt side bridgnd. Some scaling of asphalt - Uneven
Approach Guardrail	-	None.
Drains	Fair	Half are filled w/dirt.
Sidewalks	Good	
Bridgell	Good	SUBSTANDARD
Deck Surf.	Fair	4 longitudinal small cracks. Asphalt cracked and humped. <u>1/2" OPEN JOINT DOWN CENTER OF BRIDGE.</u>
Joint	G/F	JOINT SETTLED AND BEGINNING TO BREAK UP AT CENTER OF BRIDGE

Top Span NO. #1

Page No. 000016

33

COUNTY

FAU 3578 / I-24

ROUTE

0.80

LOG MILE


13.34

2/14/95

10-7-92

10/15/96

DATE 9-3-98

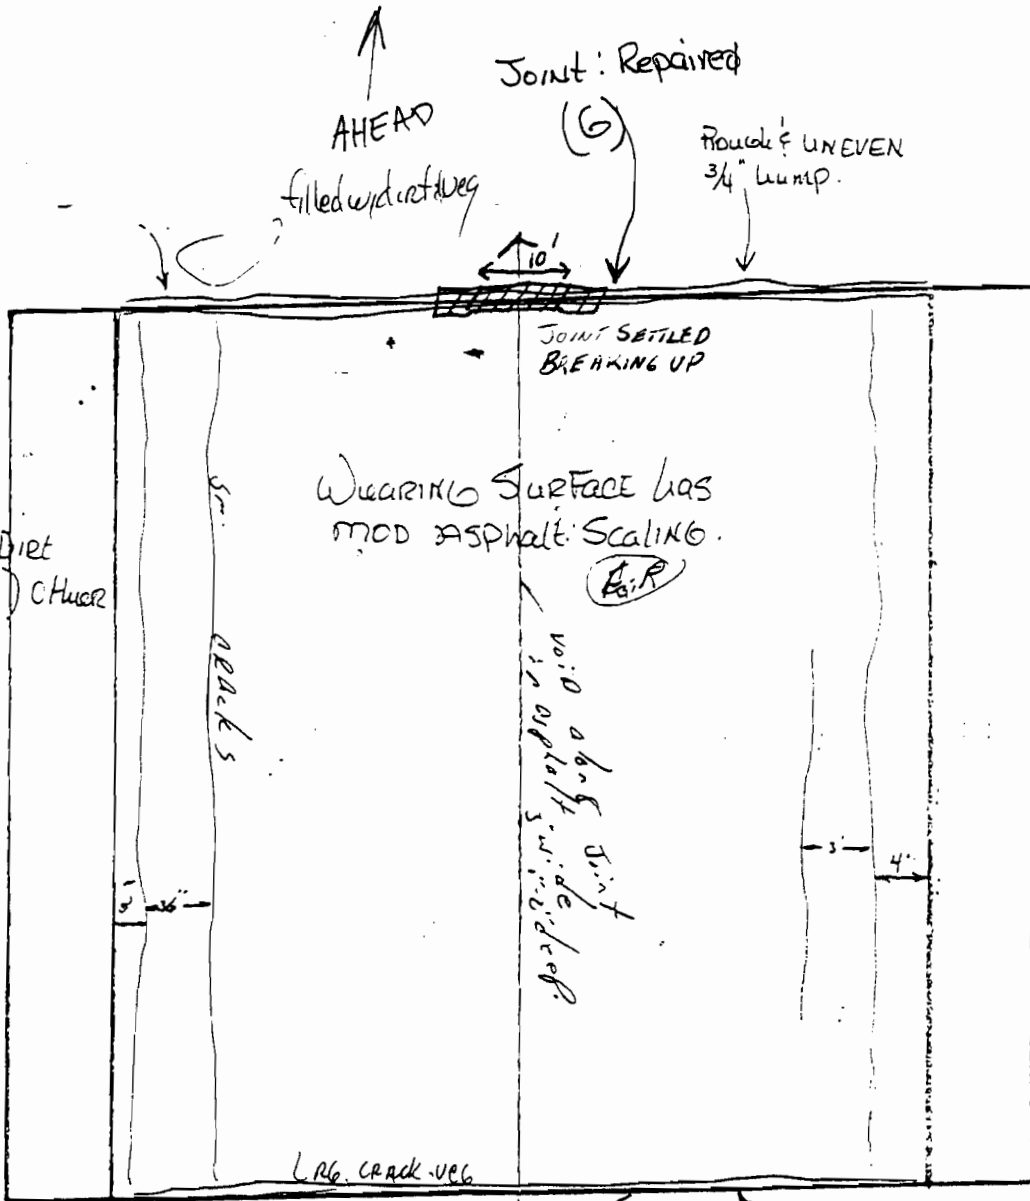

Drains: Filled w/ Dirt
Debris buildup (1/2) Churn
1/2 ARE OPEN.

cracks

WEARING SURFACE HAS
MOD ASPHALT SCALING.

(G)

void about joint
is approx 5" in depth

3'-6"

4"

LRG. CRACK - veg

Asphalt Scaling
1/2" deep

Approach has 1" - 2" Settlement.

(Joints have been Repaired)
(G)

APP. Pavement
(F) UNEVEN

APP
Fair
None

Bottom Span No. 1

000008 Page No. 2

33

FAU 3578 / I-24

0.80

13.34

9/9/92

214.75

COUNTY

ROUTE

100. MILE


DATE
9/3/98

10/15/96

BEAMS (G)

A" SM SPACER AT BENT #1

Z" A H.L. CRACK

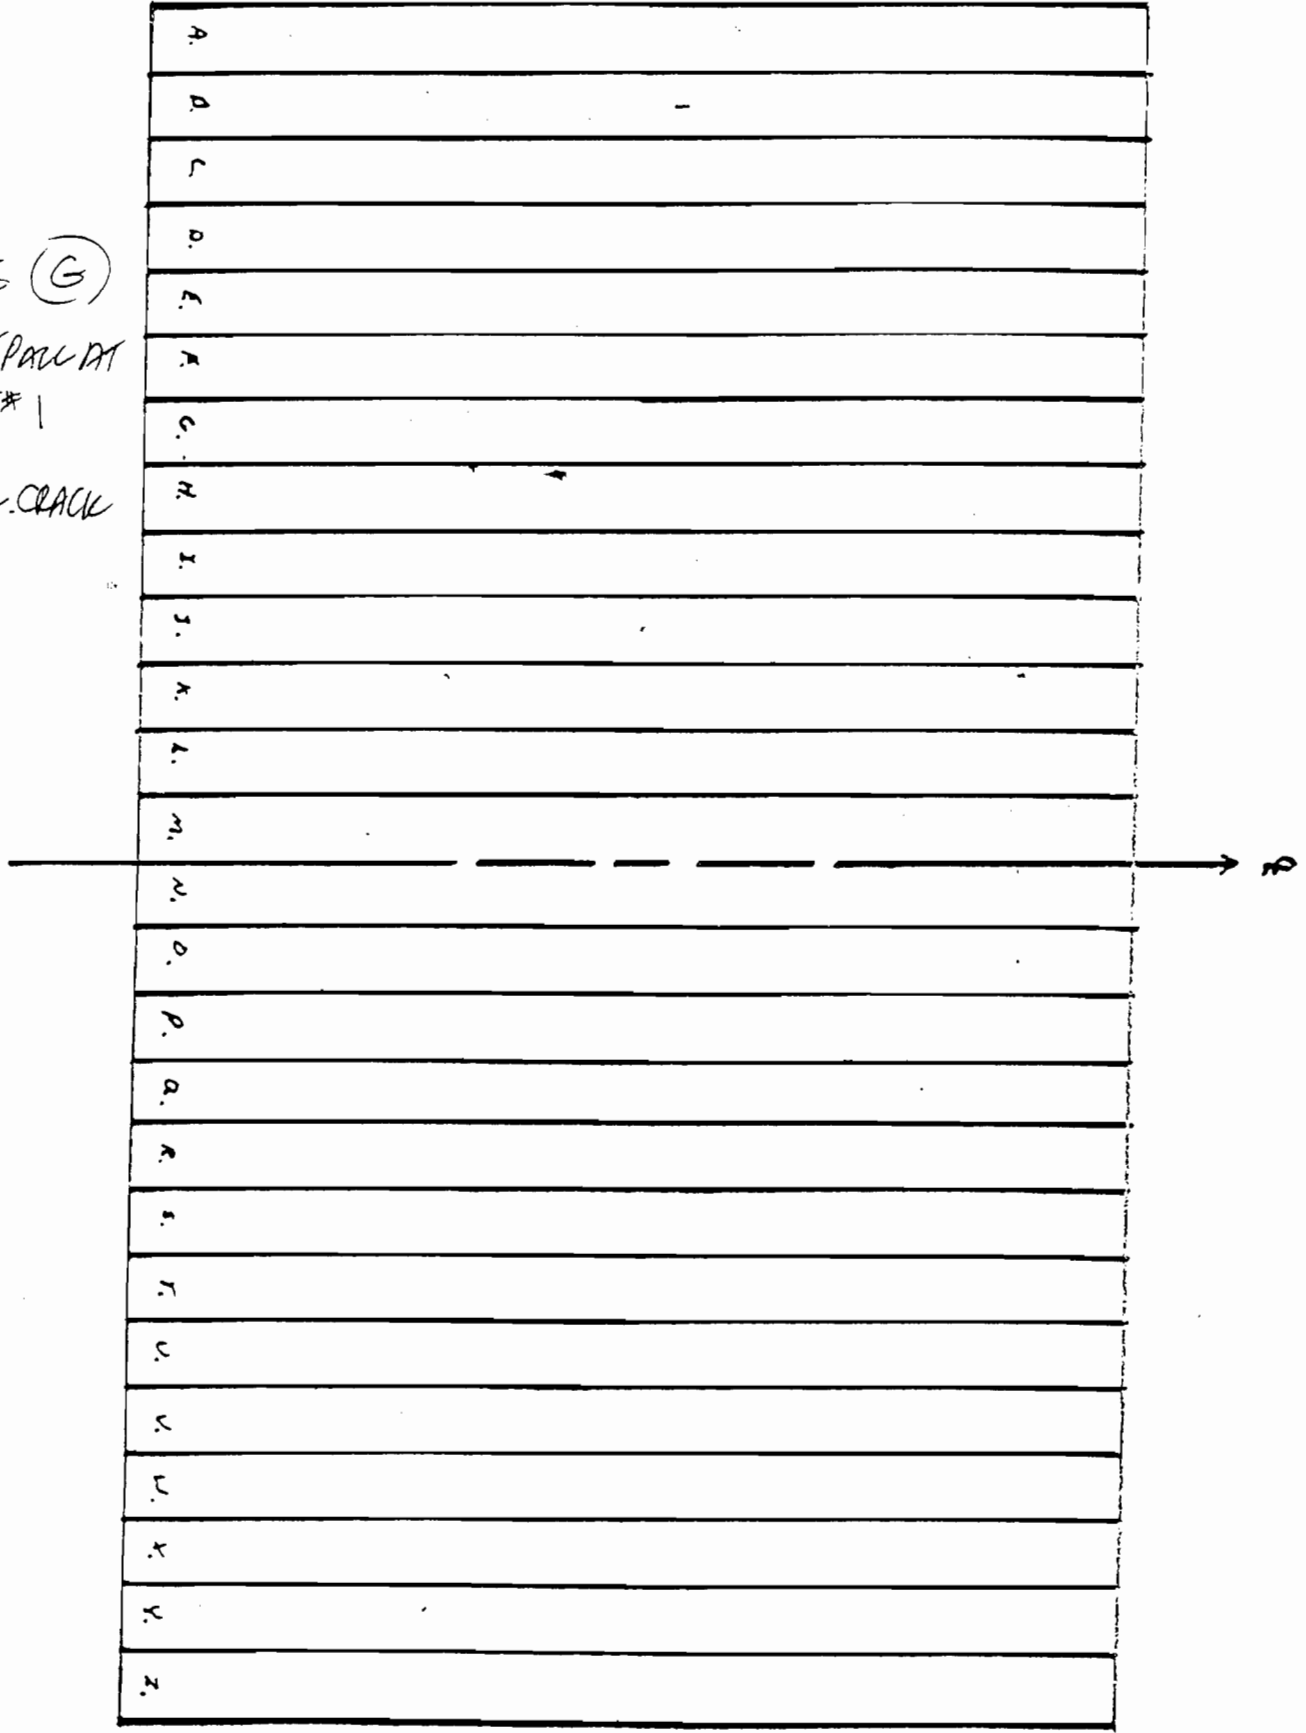


~~Beam A~~ span #1

33
COUNTY

3578 / I24
ROUTE
span #1

0.80 / 000019
13.34
LOG MILE

2-14-95
9-10-92
DATE, 10/15/96
9/3/9

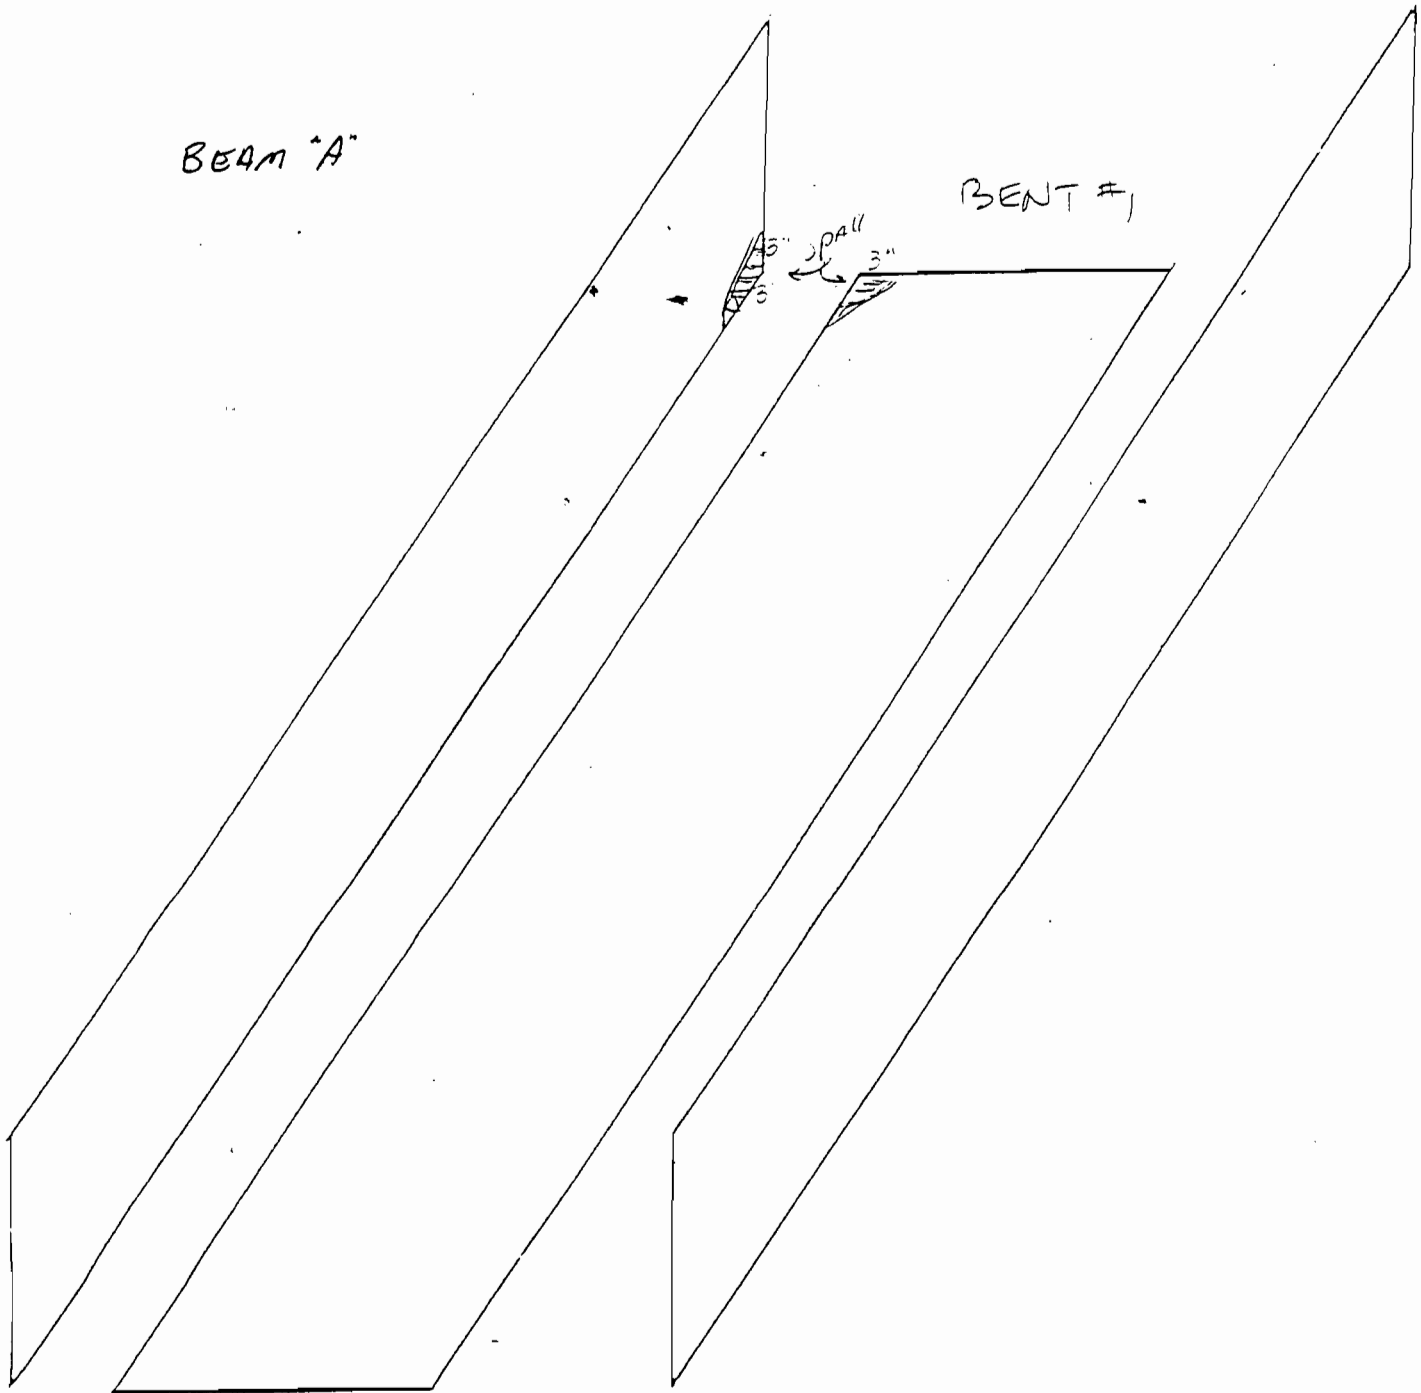

BOTTOM

RT.

Beam Z' span #1

3578/124

000020

080/13.34

2-14.55

9-10-92

33

COUNTY


ROUTE

LOG MILE

DATE 10/15/96
9/3/98

SPAN #1

BEAM Z'

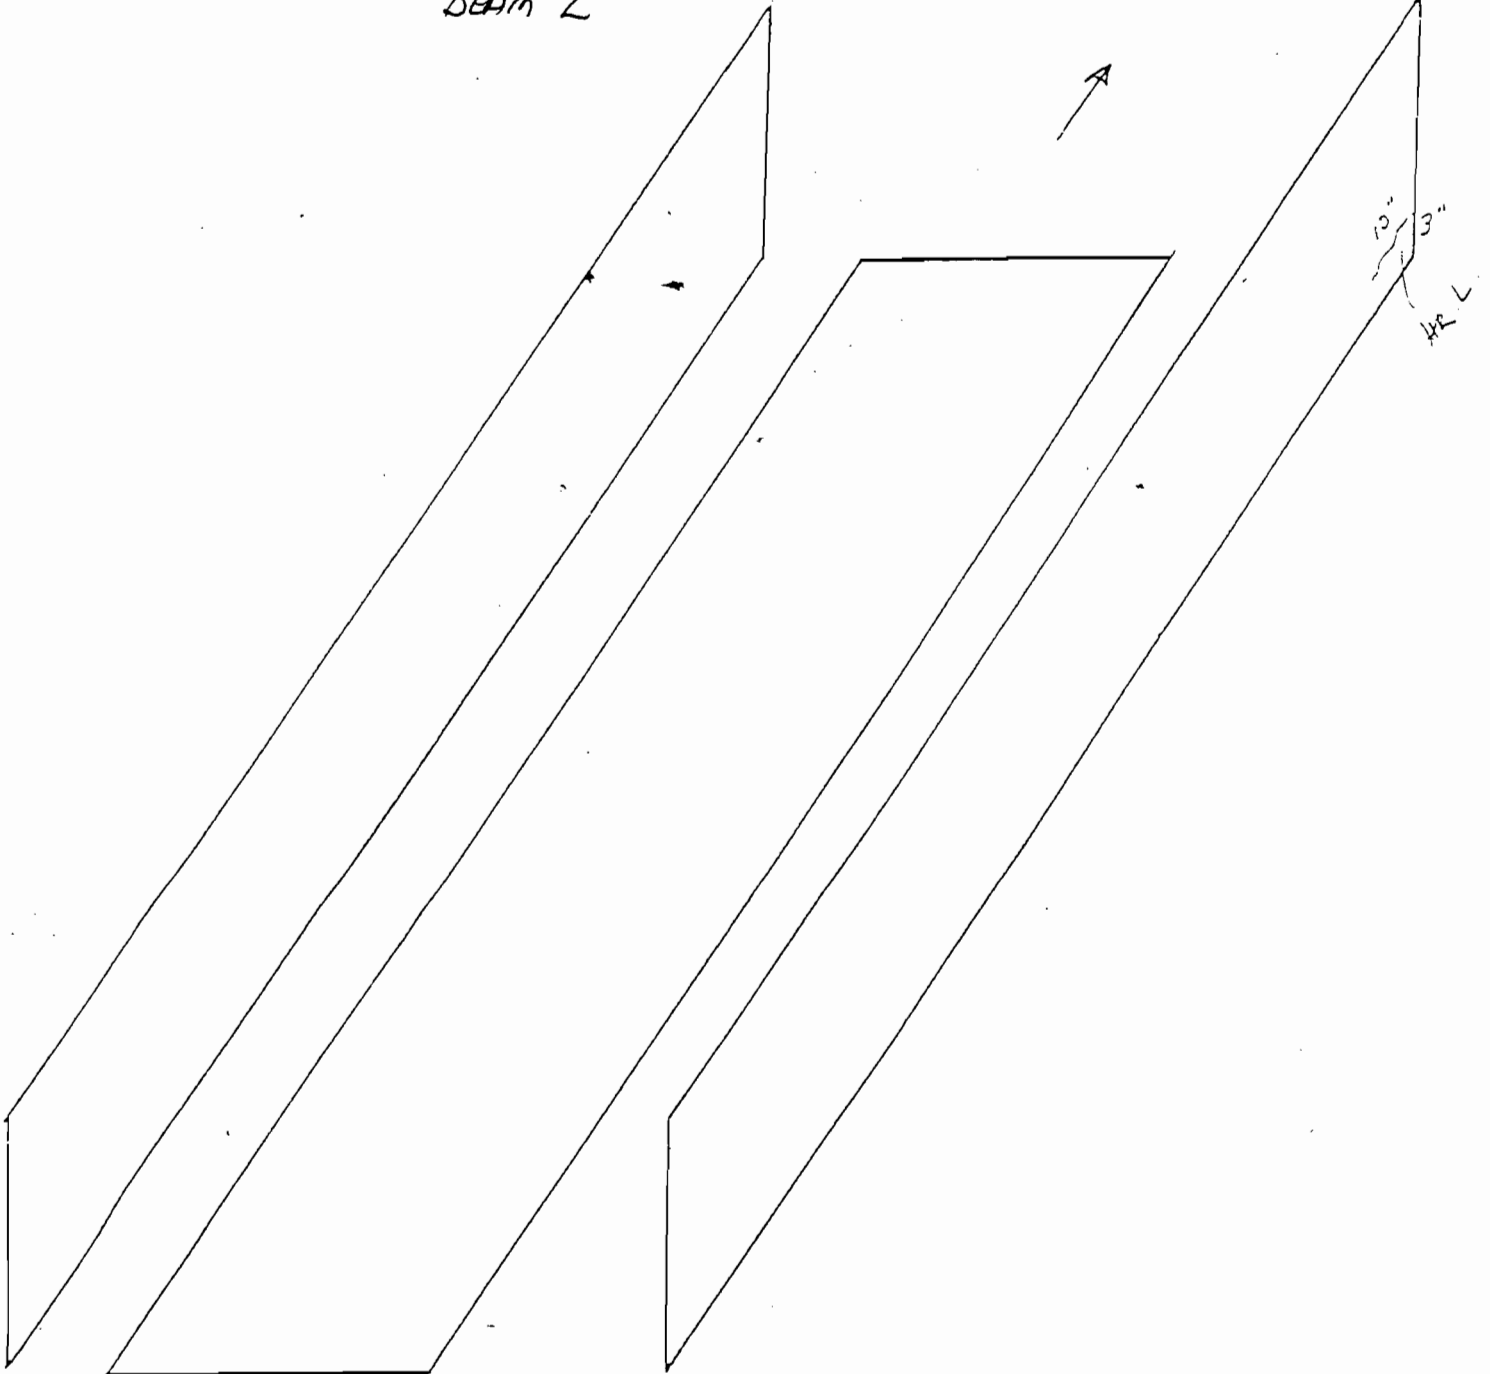

BOTTOM

RT.

TOP SPAN NO. # 2


PAGE NO. 000022

33
COUNTY

FAU 3578 / I-24
ROUTE

0.80 / 13.34
LOG MILE

2/14/95
10-7-92 10/15/96
DATE 9-3-98

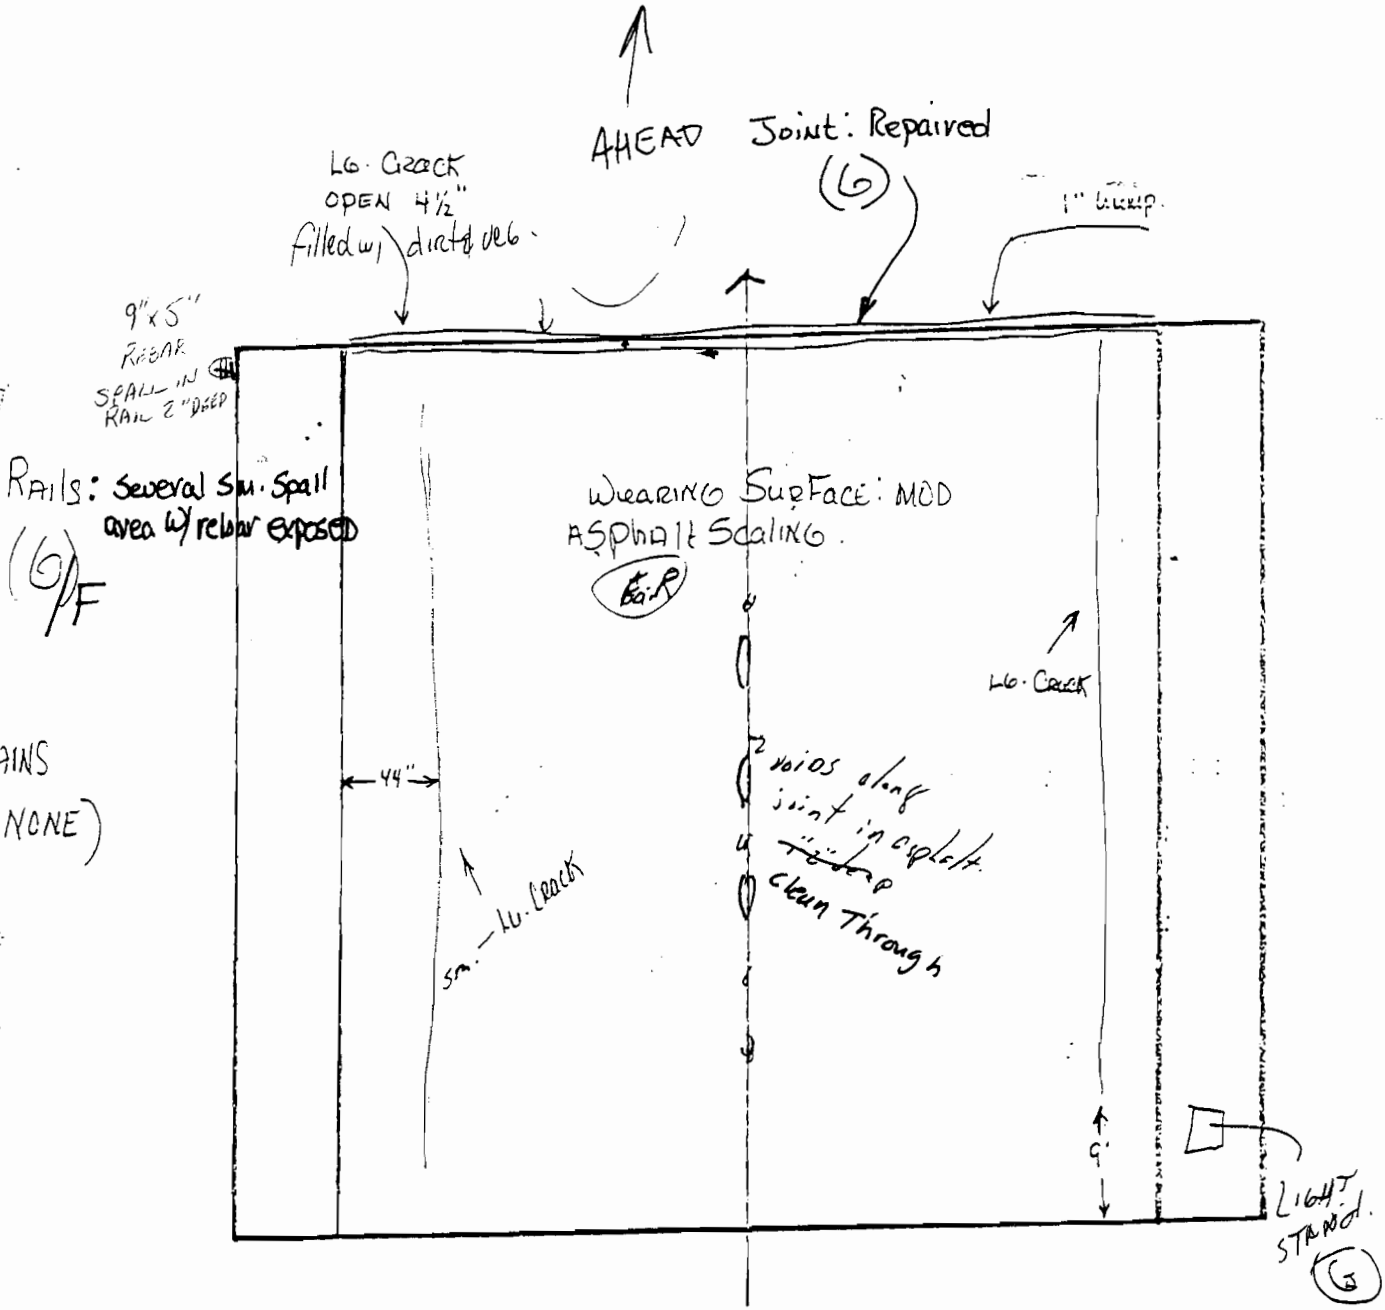

Bottom Span No. 2

Page 000024

33

FAU3578/E-24

0.80 / 13.34

2-26-95

9-10-92

COUNTY

ROUTE

LOG. MILE

DATE 10/15/96

9/3/98




BEAMS (G)

12' → 6' →
Span C w/ etc

BEAMS
2287

DEAN'S

000025

33
COUNTY


3578/524
ROUTE

0.80/13.34
LOG MILE

2/26/95
9-10-92
DATE 10/15/96
9/3/98

12m A

SPAN #2

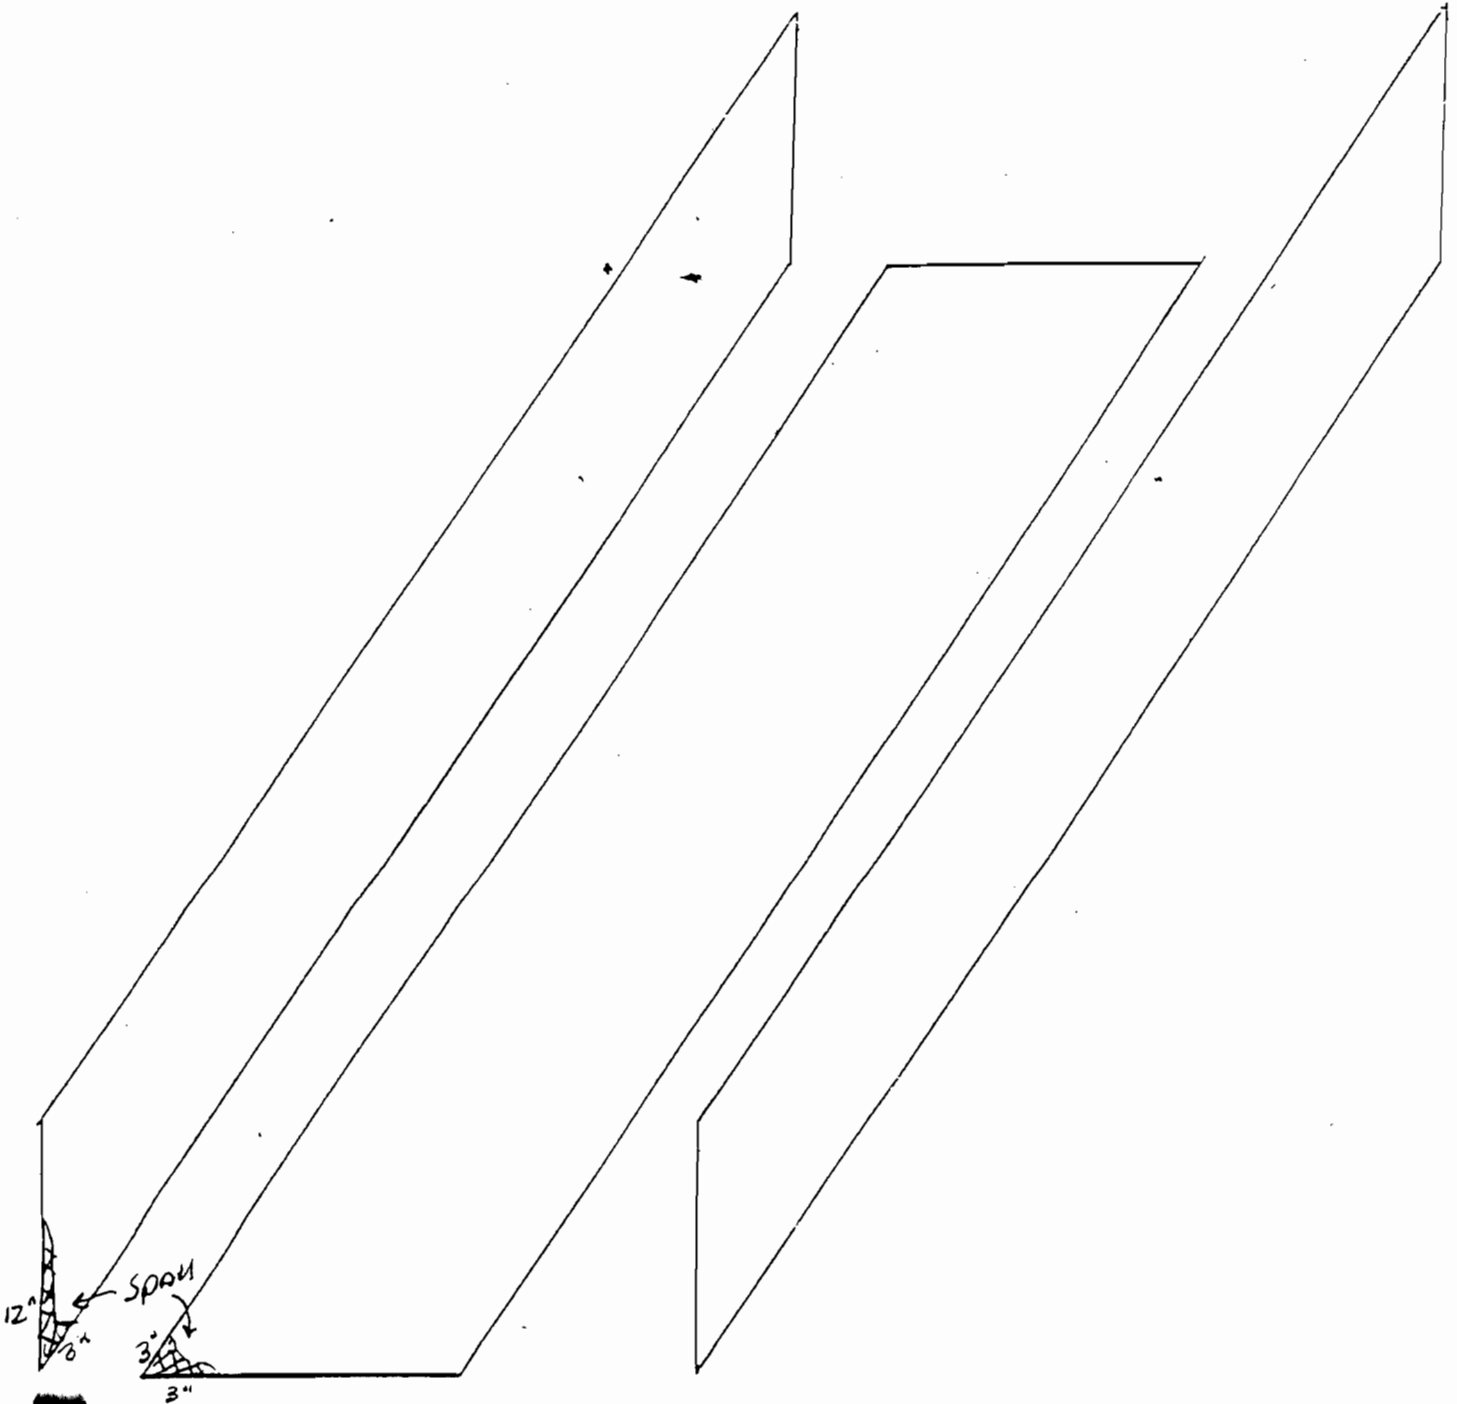

12"

SPAN #1

3"

3"

BOTTOM

RT.

BEAM 1 SPAN NO. 2

PAGE NO.

000028

2-26-95

33

COUNTY

PAO 3578 / 524

ROUTE

0.80 / 13.3A


LOG MILE

9-10-92

DATE 10/15/96

9/3/98

Bent #2

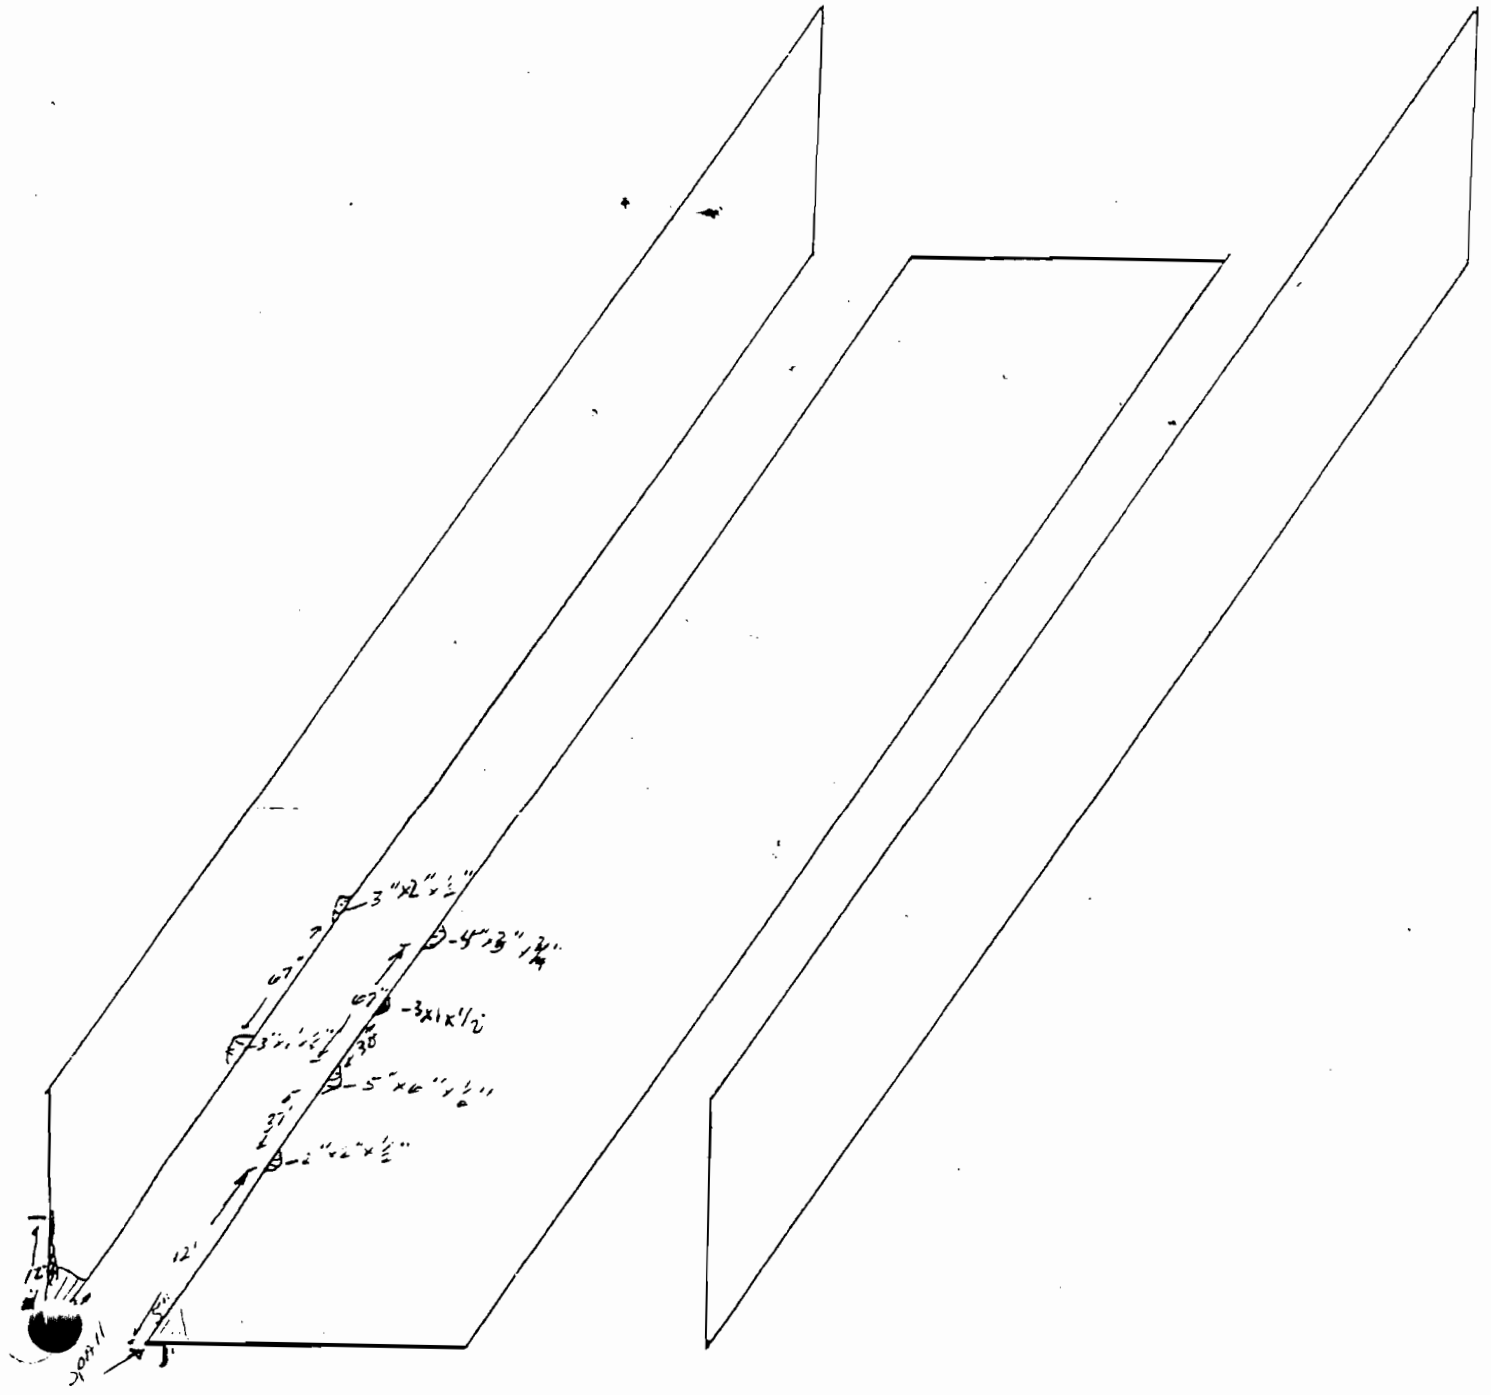

Bent #1

BOTTOM

RT.

BRIDGE No. 33 COUNTY FAUSS78/224 ROUTE 080 LOG MILE 13.34 DATE 2/14/95
10-7-92
 DATE 10/15/96

ELEMENT	RATING	COMMENTS
Road Surf.	G-F	2 long, sm-large cracks. Asphalt lumped @ joint.
Joint	GOOD	/ / / /
Bridge rail	Good	SUBSTANDARD, FEW SMALL SPALLS
Sidewalks	Good	
Drains	-	None.
LIGHT STANDARD	Good	

9-3-98

TOP SPAN NO. # 3


PAGE NO.
1000000000

33
COUNTY

FAV 3578 / I-24
ROUTE

0.80 / 13.34
LOG MILE

10-7-92 10/15/96
DATE 9-3-98

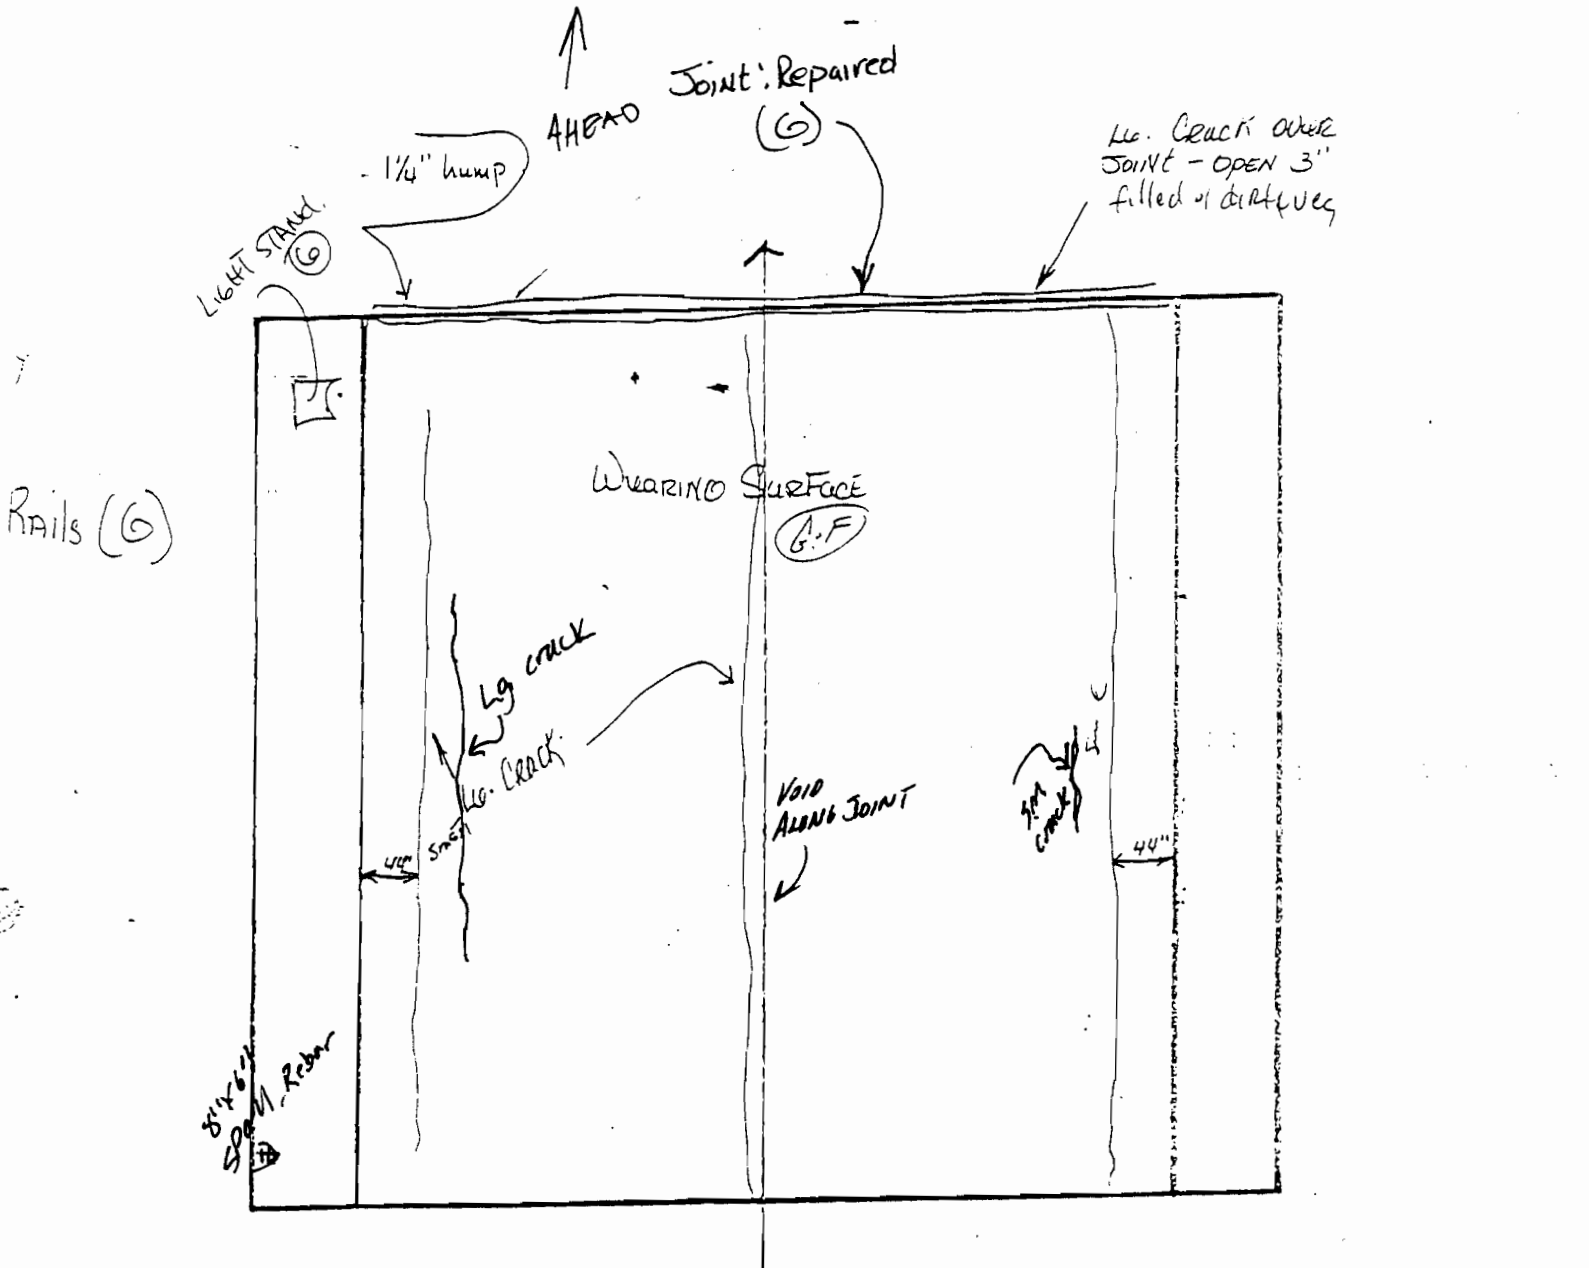

33

FAU3578/E-24

0.80 / 13.34

2-26-95 000080
9-10-92

COUNTY

START
SPALL


ROUTE

LOC. MILE

SPALL
6" x 8" x 1"

DATE 10/15/96
9/3/98

SPALL
6" x 8" x 1"

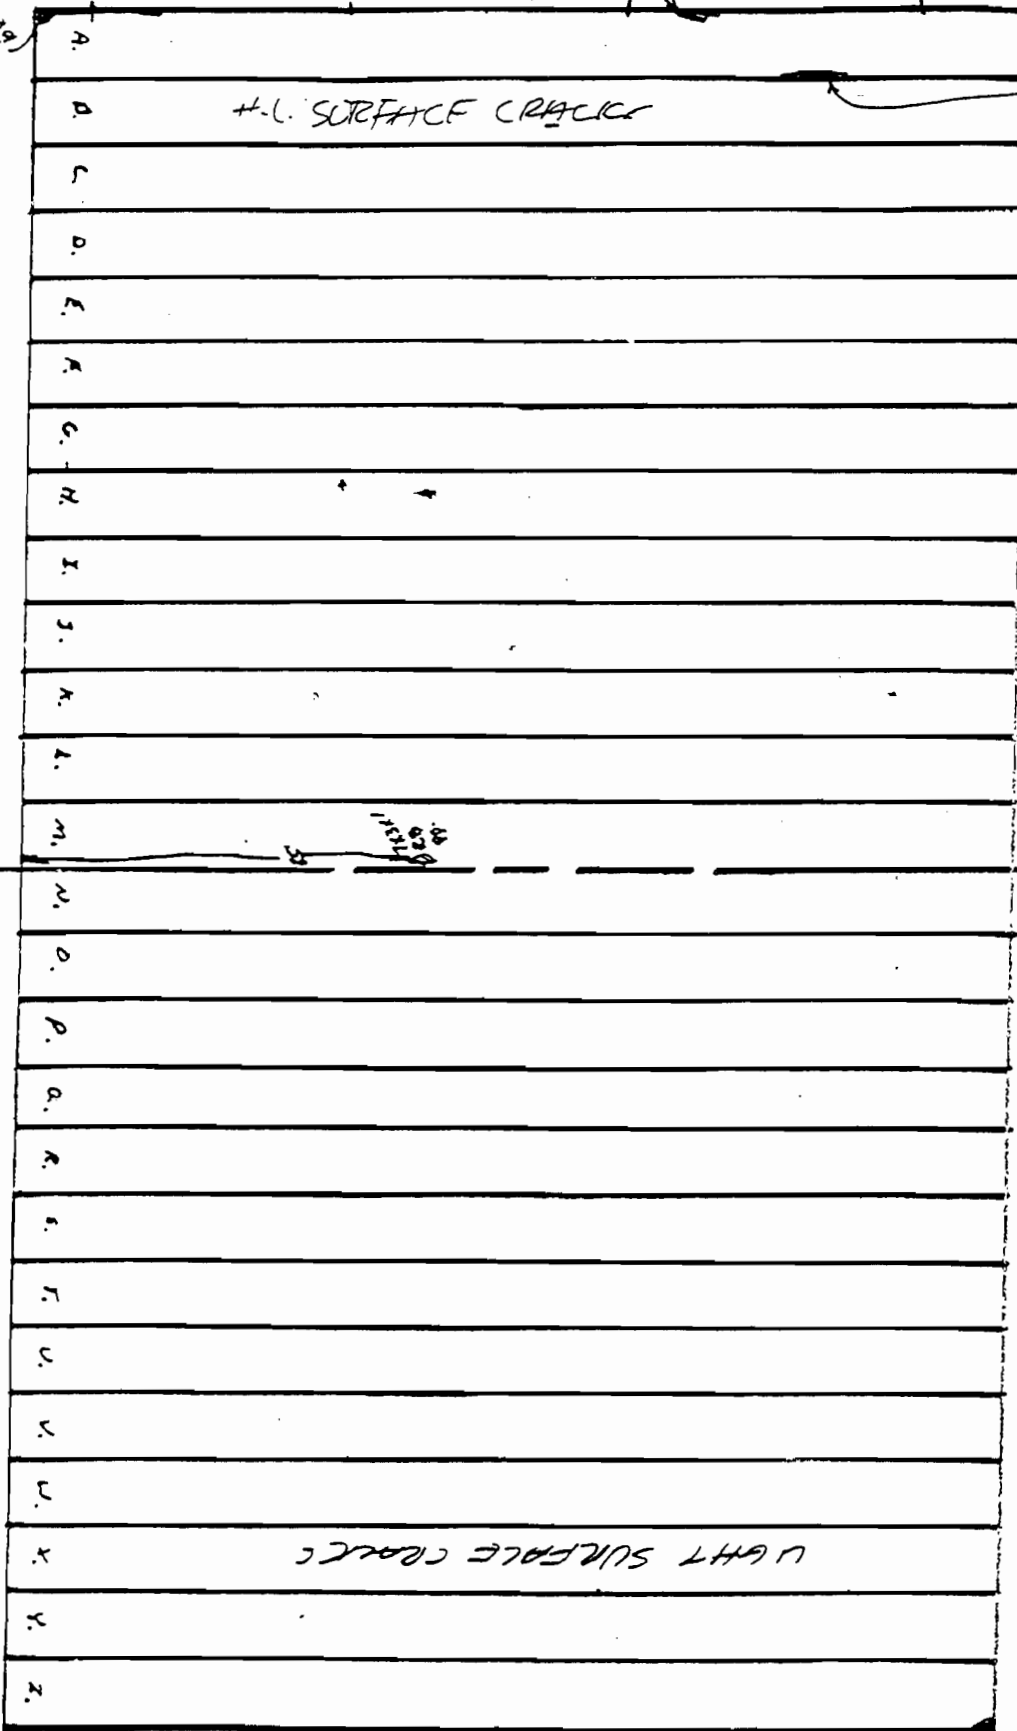

24" x 8" x 1 1/2"
LG SPALL ON
R/SIDE OF BEAM
"A"

BEAMS (G)

BEAM 2
SPALL
6" x 8" x 1"

Top Span No. 4

PAGE No. _____

BRIDGE NO. 33
COUNTY _____

FAV3578/224
ROUTE _____

080 / 13.34
LOG MILE _____

000031 2/14/95
10-7-92
DATE 10/15/96

9-3-98

ELEMENT	RATING	COMMENTS
Wear Surf.	Fair	2 large longitudinal cracks, 1"-2" deep voids in asphalt joint.
Bridge Deck	Good	
Sidewalks	Good	20 foot section settling 6" At ^{Both} Right sides of Approach # 2
Drains	Poor	All are blocked w/ dirt and debris.
Approach Pavement	Good	LARGE CRACK
Approach Guardrail	-	none.
Embankment	Good	steep.
JOINTS	G/P	15' LONG SECTION BEGINNING TO SETTLE AND BREAKUP VOIDS 3" deep @ two places

Top SPAN NO. #4

Page No.

000032

2/14/95

10-7-92

33

COUNTY

FAU 3578 / I-24

ROUTE

0.80

13.34

LOG MILE

DATE 10/15/96

9-3-98

APP. Rails
None

APP. Pavement (G)

Joint: Repaired (G) ↓ voids 3" deep

Lo. Crack


15' SECTION OF REPAIRED JOINT BEGINNING TO BREAKUP & SETTLE

SMALL 12" x 6" x 2" DEEP

Embankment
Steep

ALL FILLED W/DIRT & DEBRIS

DRAINS (P)

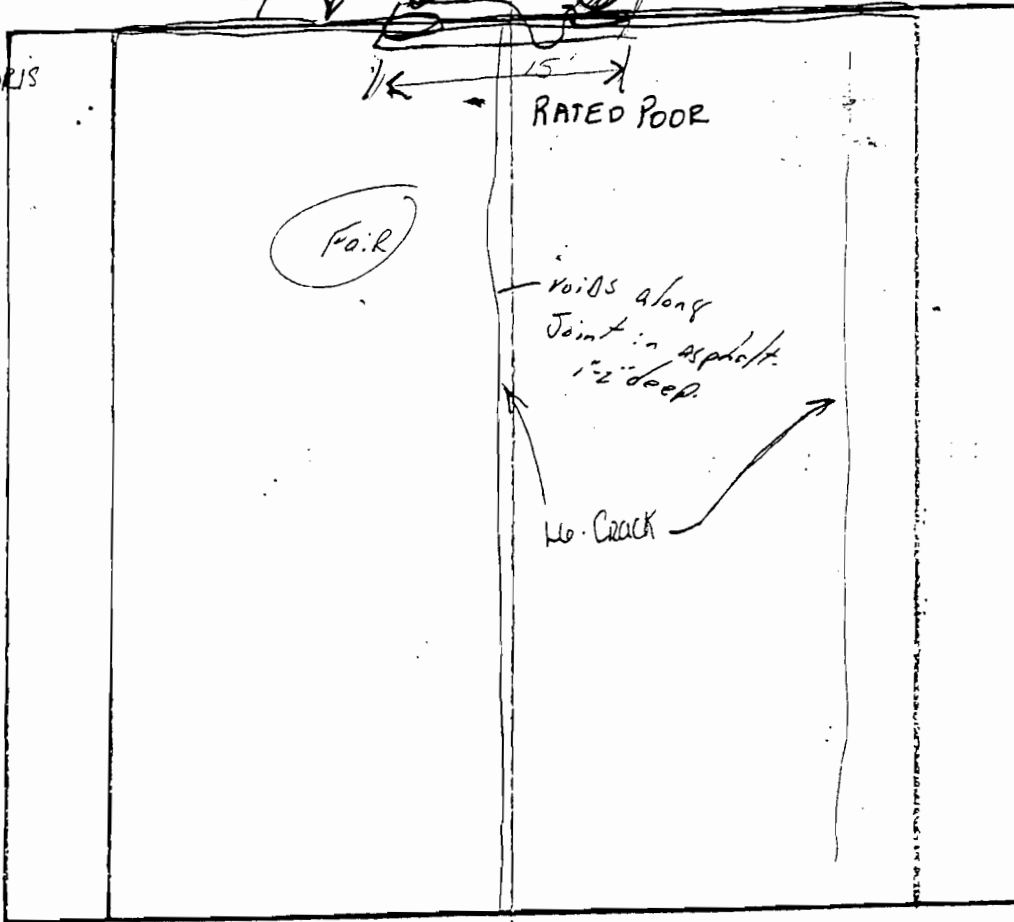

SIDE WALK

(6)

Bottom Span No. 4

Page No.

33

FAU3578/I-24

0.80 / 13.34

2-14-95 000034

COUNTY

ROUTE

100. MILE

9-10-92

DATE 10/15/96
9/3/98

BEAMS
(G)

A.
B.
C.
D.
E.
F.
G.
H.
I.
J.
K.
L.
M.
N.
O.
P.
Q.
R.
S.
T.
U.
V.
W.
X.
Y.
Z.

~~LEAKAGE~~ →

000088

Abutment No. 1



PAGE NO. 10/15/94

33
COUNTY

FAO 3578 / I-24
Route

0.80 / 13.34
Log Mile

DATE 2-14-95 9/3/96
10-7-92

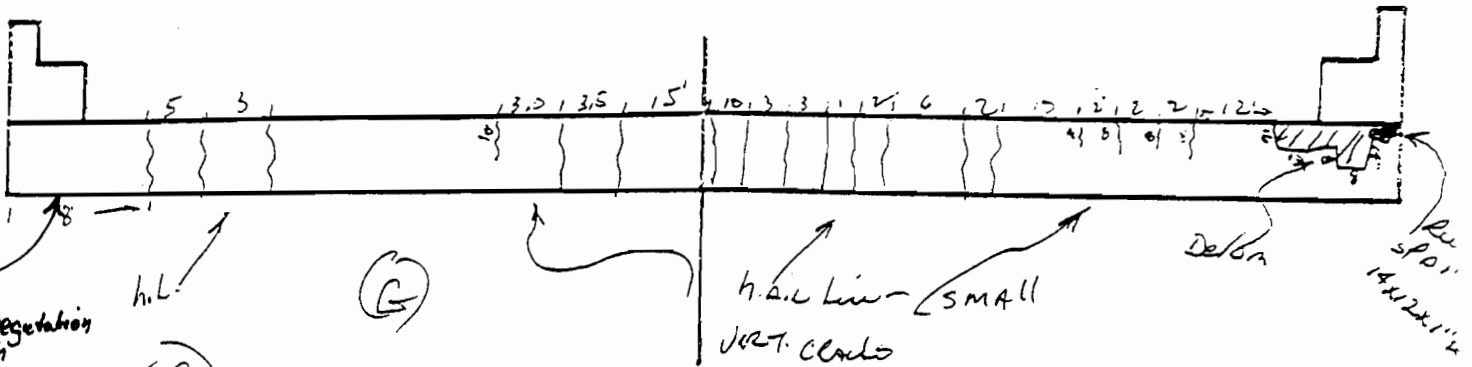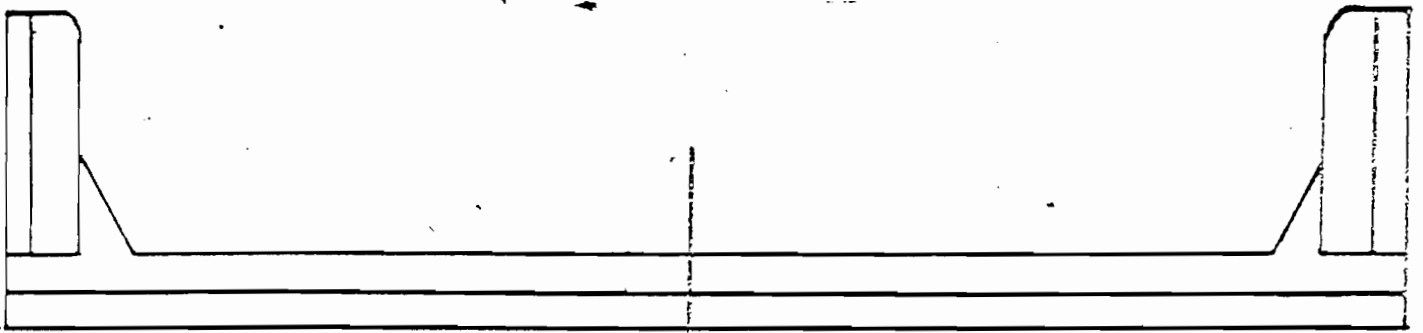

MINOR vegetation growth

h.l.

(G)

h. air line - SMALL JUST CLASH

Del on

1/2" SPD" 14221"4"

WINGS (G)

BREASTWALL (G)-(F)

BEARING (G)

SLOPE (G) HAS SETTLED 1" @ OUT 3/4"

BENT NO. 1

PAGE 000088
DATE

33

COUNTY

KAU 3578 / J-24

ROUTE

0.80 / 13.34

LOG MILE

9/9/92

2-26-95

10/15/96

9/13/98

5th. hole. least
1" N. 5' of
" of R. 200'

CAP (G)

MSC



COLUMN (E-F)

FOOTING (AV)


BEARING - Good

DEAM 25'x4"
BOT. SIDE

DEAM 15'x4"

3'x5' DEAM
ON OUTSIDE OF C

SLIGHT SCALE
10' = 1"

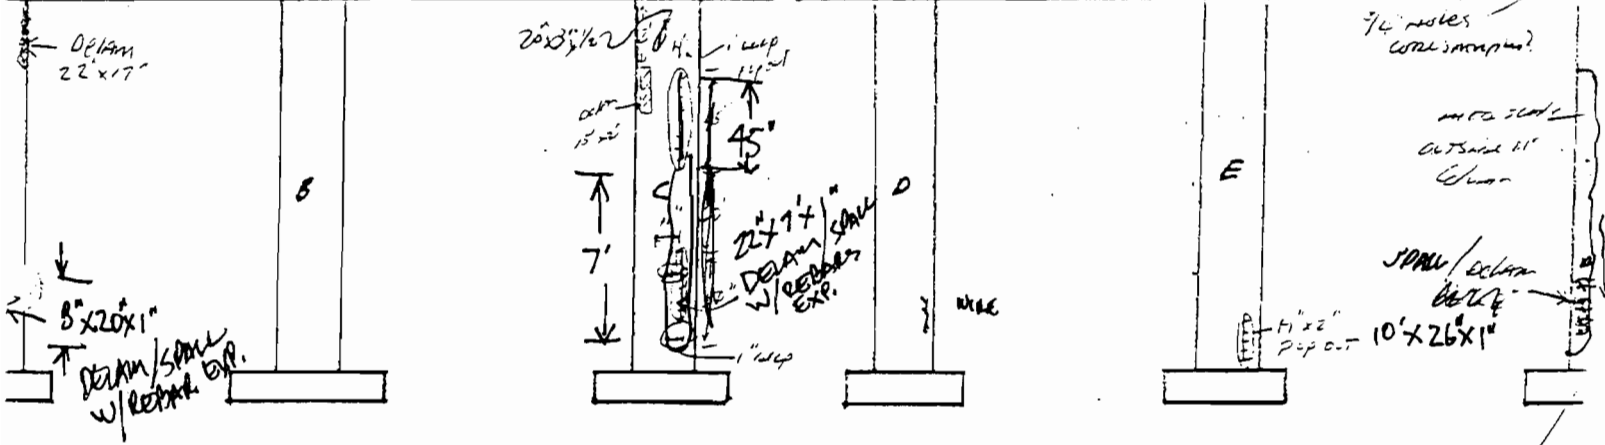

7/4 notes
column shape?

into scale
outside 11'
clear

SPALL / column
10'x26'x1'

11'x2'
Pop out

DEAM
10'x26'x1'

Wire for
pop out
on outside of
Column "F"

BENT No. 2

PAGE

000039

2-26-95

BRIDGE No. 33

KAW 3578/E-24

0.80/13.34

9/9/92 9/13/98

COUNTY

ROUTE

LOG MILE

DATE 10/15/96

ELEMENT	RATING	COMMENTS
CAP	G/F	SEVERAL LG. DELAMIS ON BACK, FRONT & BOTTOM
COLUMN	G/F	SEVERAL LG. WIRE PRODS WITH SPACES ON "D", "E" & "F"
FOOTING	N/V	

BENT NO. 2

PAGE 2-26-95

DATE 9-10-92 - 10/15/96 9/13/98

33

KAU 3578 / J-24

0.80 / 13.74 000000


COUNTY

ROUTE

LOG MILE

↑ Looking
RHUAD

CAD (G/E)

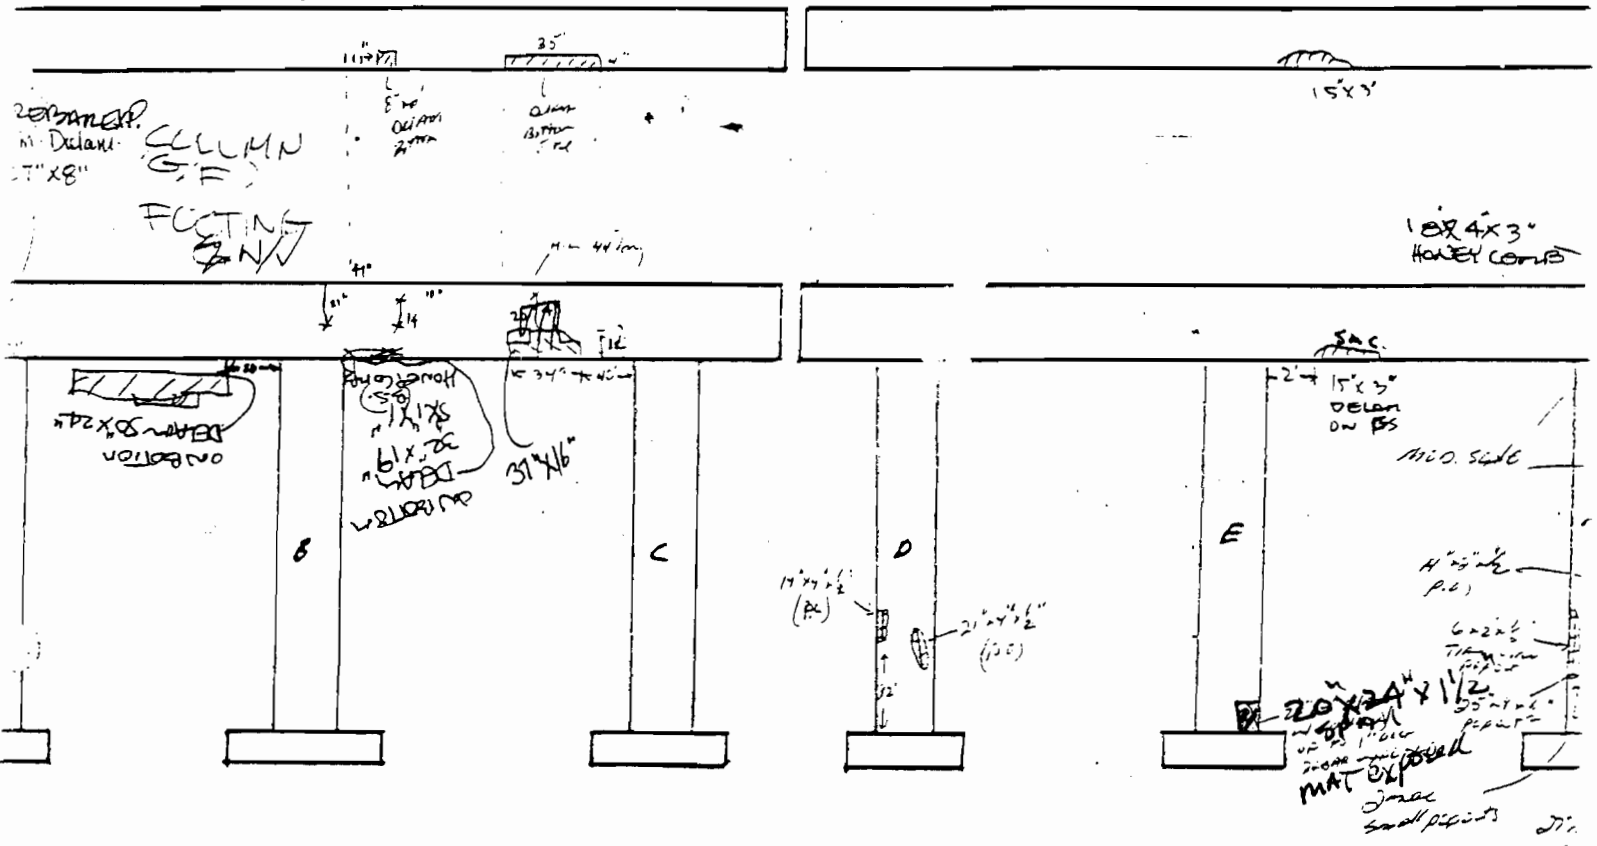

BENT NO. 3

PAGE 000002

33
COUNTY

FAU 3578 / J-24
ROUTE

DATE 9/9/92 9/13/98
0.80 / 13.34 2-26-95
LOG MILE 10/15/96



CAP (E)

DELAM 2'x9"

DELAM 5x2'
DT SIDE

COLUMN (E)
FOOTING (E)

Sum. delam 12'x8"

Low 10'x24" delam

20" REBAR

ALL MAP CRACKING

LIGHT-MOD. SURFACE SCALING del

24'x2'

SM.C
7' → 42" →
8' → 3' →

SM.C
6' → 13' → 5' →
delam 16'x15"

24'x2' DELAM
DT SIDE
15'x1'

9'x14' delam
12'x3'x1" DELAM/REBAR P.O.

o/coll

18'x25' delam


24'x27' delam
24'x8' delam
11'x24' delam

Mod. Side

14'x5' Sum. delam

91" x 4' x 1/2" WIRE POP-OUT
13" x 4' x 1/2"

21' →
42' →

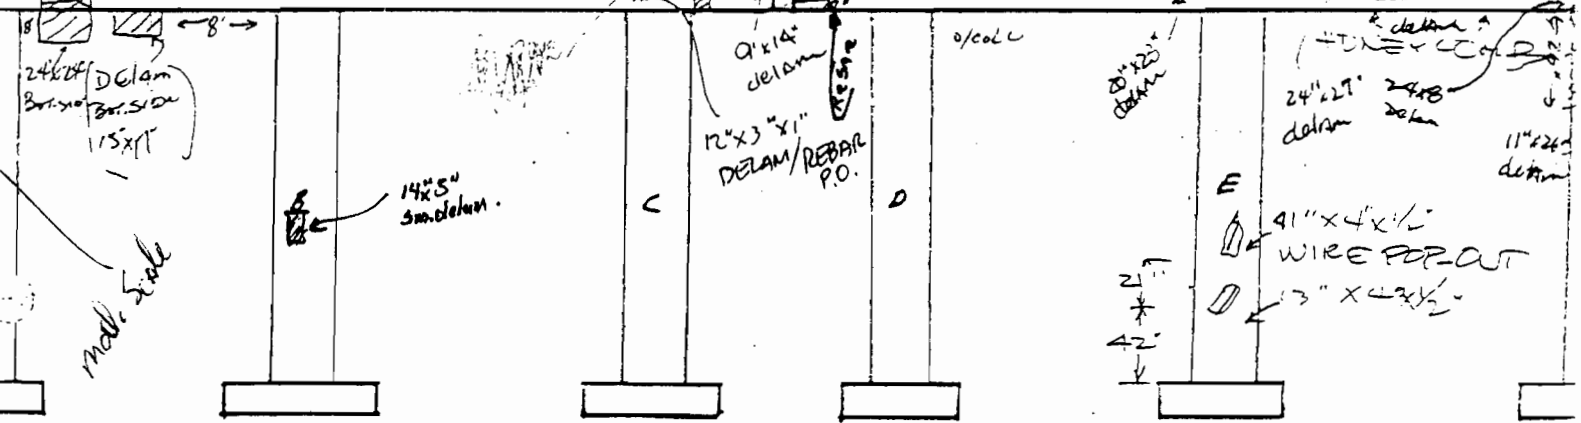

ABUTMENT No. 2

PAGE 000008 2-14-95

BRIDGE No. 33
COUNTY

KAN 3578 / I-24
ROUTE

0.80 / 13.34
LOG MILE

10-7-92 9/3/98
DATE 10/15/96

ELEMENT	RATING	COMMENTS
WINGS	G	SM. VOID ON R/SIDE
BEARING	G	
BREASTWALL	G	Few Hr. Line - small cracks - delam
SLOPE	G	

000722

Abutment No. 2



PAGE NO. 2-1495

33
COUNTY

FAO.3578 / I-24
ROUTE

0.80 / 13.34
Log Mile

DATE 10-7-92 9/3/98
10/15/96

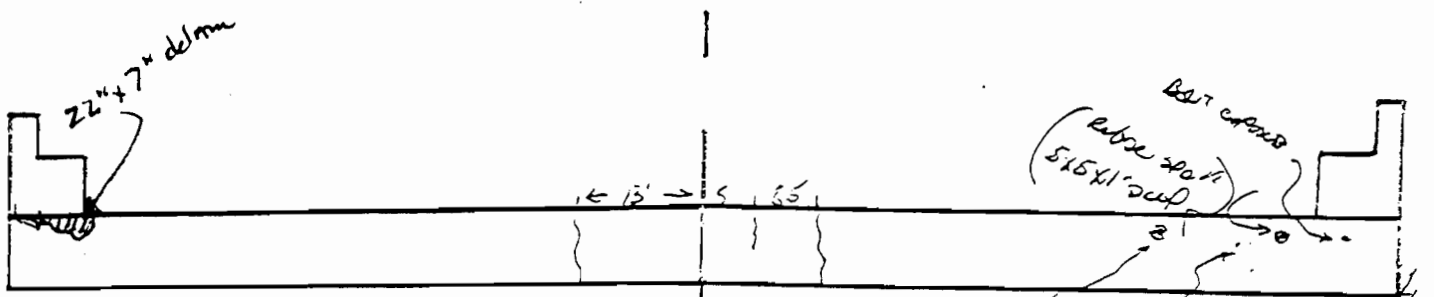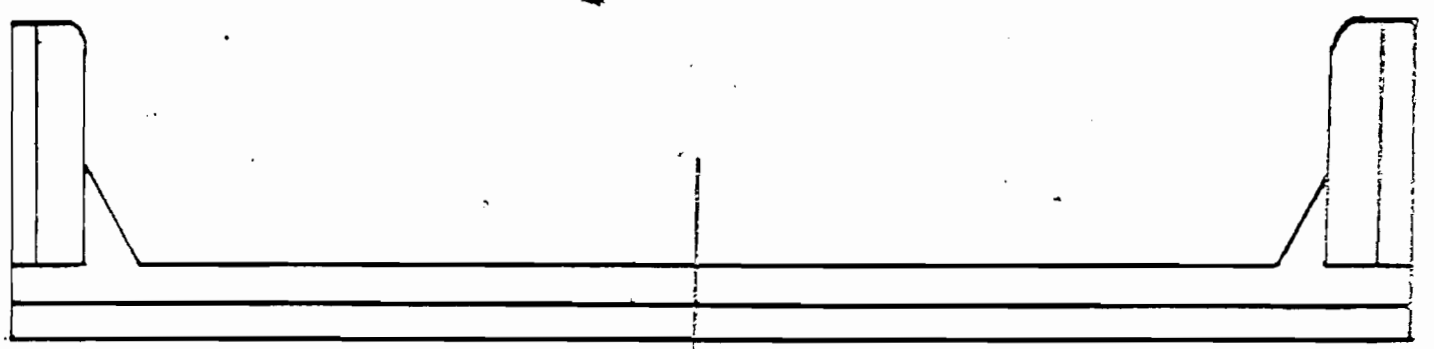

WINGS (G) SM. VOID ON R/SIDE

BEARING (G)

BREASTWALL (G) A FEW H.L. CRACKS & SM. REBAR/SPALL
SM DELAM

SLOPE (G)

Index Of Sheets

(SEE SHEET 1A)

STATE OF TENNESSEE DEPARTMENT OF TRANSPORTATION BUREAU OF PLANNING AND DEVELOPMENT

TENN.	YEAR	SHEET NO.
	1996	1
FED. AID PROJ. NO.		
STATE PROJ. NO.	33003-4154-04	

HAMILTON COUNTY

I-24

FROM EAST OF S.R. 8 TO I-75 (INCL. MEDIAN BARRIER)


PARTIAL PAVING, MEDIAN MODIFICATION,
GUARDRAIL

INTERSTATE HIGHWAY NO. 1-24




HAMILTON COUNTY
33003-4154-04

END PROJ. NO. 33003-4154-04 CONST.
STA. 334+00.00 E.B.L.

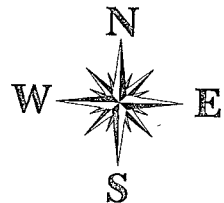

BEG. PROJ. NO. 33003-4154-04 CONST.
STA. 191+44.33 E.B.L.

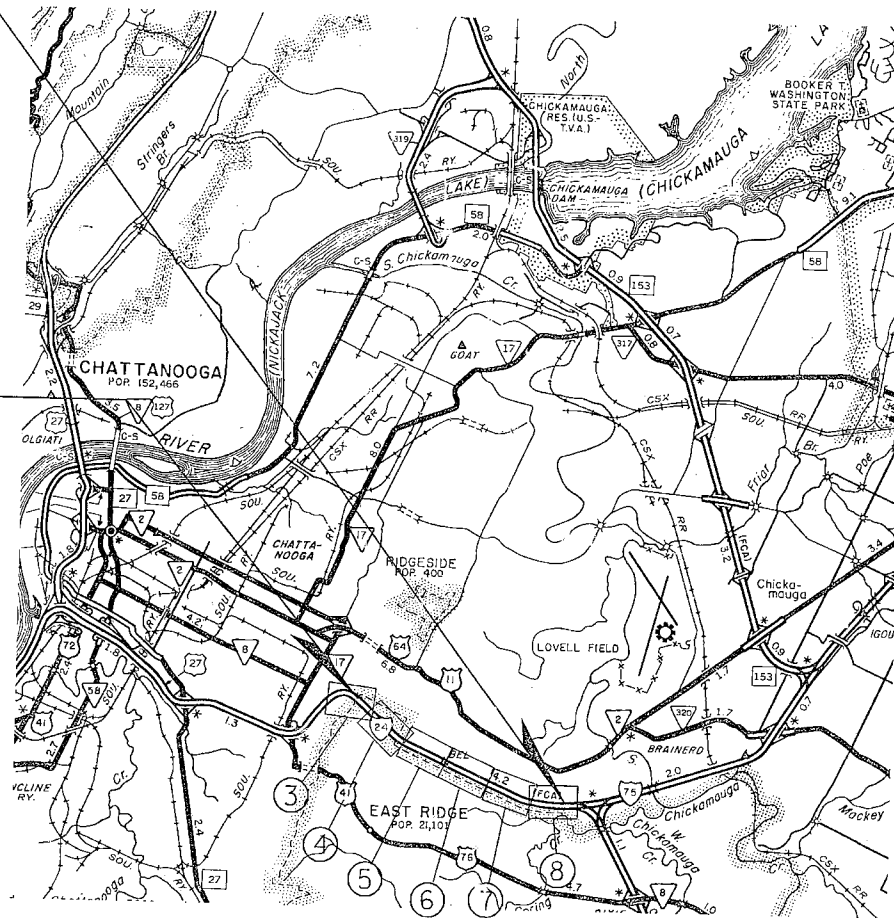

SCALE: 1" = 5,000'

NO EXCLUSIONS

TABLE OF EQUATIONS

EQUATIONS WEST BOUND LANE

STATIONS (BK.) = STATIONS (AHD.)	+	-
204+02.94 + 203+13.80	89.14'	

EQUATIONS EAST BOUND LANE

203+48.66 + 203+13.80	34.86'	
-----------------------	--------	--

EFFECT ON ENUMERATION 34.86'

NOTE : PROJECT LENGTH BASED ON E.B.L. LENGTH

SPECIAL NOTES

PROPOSALS MAY BE REJECTED BY THE COMMISSIONER IF ANY OF THE UNIT PRICES CONTAINED THEREIN ARE OBVIOUSLY UNBALANCED, EITHER EXCESSIVE OR BELOW THE REASONABLE COST ANALYSIS VALUE.

THIS PROJECT TO BE CONSTRUCTED UNDER THE STANDARD SPECIFICATIONS OF THE TENNESSEE DEPARTMENT OF TRANSPORTATION DATED MARCH 1, 1995 AND ADDITIONAL SPECIFICATIONS AND SPECIAL PROVISIONS CONTAINED IN THE PLANS AND IN THE PROPOSAL CONTRACT

TDOT ROAD C.E. MGR. 1 MICHAEL AGNEW

DESIGNER JIMMY C. LEDBETTER CHECKED BY LARRY RAY

P.E. NO. 33003-1152-44

ROADWAY LENGTH	2.675 MILES
BRIDGE LENGTH	0.031 MILES
BOX BRIDGE LENGTH	0.000 MILES
PROJECT LENGTH	2.706 MILES



6-25-96

APPROVED: *Paul R. Morrison*
DESIGN DIVISION

DATE:

APPROVED: *Jim Setts Sr.*
COMMISSIONER

TRAFFIC DATA	
ADT (1996)	91,450
ADT (2016)	118,900
DHV (2016)	11,890
D	60 - 40
T (ADT)	15 %
T (DHV)	10 %
V	55 MPH

U.S. DEPARTMENT OF TRANSPORTATION
FEDERAL HIGHWAY ADMINISTRATION

APPROVED:

DIVISION ADMINISTRATOR DATE

SCANNED

FILE NO.
DESIGN DIVISION
TENNESSEE D.O.T.

INDEX OF SHEETS

Table with columns: SHT. NO., DESCRIPTION. Lists sheets 1 through 27-85 including Title Sheet, Index & Standard Roadway Drawings, Estimated Roadway Quantities, Typical Section with Proposed Paving Schedule, General Notes, Special Notes, Tabulated Quantities, Details, Lighting Details, Notes, & Estimated Quantities, Bridge Tabulations and Estimated Quantities, Bridge Repair Details, Median Barrier Details, Joint Spacing Detail, Concrete Repair Details, Proposed Layout Sheets, Typical Sections of Traffic Control, Pavement Edge Drop-off Notes, Traffic Control Details, Traffic Control Layout Phases 1-5, Typical Signing Phases 1-5, Typical Signing One Lane Closure Phases 3A and 5A, Phase 2 Lane Shift, Phase 3 Lane Shift, Phase 3A Lane Shift, and Roadway Cross-sections.

(TO BE PRINTED WITH PLANS)

Table with columns: DWG. NO., CURRENT REVISION, DESCRIPTION. Lists drawings ESC-STR-1 through SBR-2-126 including Temporary Dewatering Structure, Temporary Silt Fence & Filter Barrier, Straw or Hay Bale or Fabric Temporary Silt Checks, Catchbasin Protection, W-beam & Thrie Beam Barrier Rail and Rub Rail Alternates, Barrier Rail Mounting, Post Block-outs, W-beam Barrier Post Details and Specifications, W-beam Barrier Terminal Element Details, Guardrail Terminal Anchor (Type 11) and (Type In-line), Details for Breakaway Post Anchor Plate and Swage Fitting, Terminal Anchors, Type 12 and Type 13, Median Divider Guardrail and Guardrail Terminal Anchors, Length of Need and Terminal Requirements in Fills, Guardrail Attachment to Structures and Protective Guardrail at Bridge Ends Details, Minimum Installation Length for Protective Guardrail at Bridge Ends, Guardrail Terminal Anchor (Type 20) Post Layout and Erection Details, Guardrail Terminal Anchor (Type 16) Post Layout and Erection Details, Melting Guardrail Element Assembly Details, Melting Guardrail Post and Assembly Details, Concrete Median Barrier, Concrete Glare Screen Median Barrier, Concrete Glare Screen Median Barrier Bridge Pier Protection, Lighting Details-Foundations, Interconnected Portable Barrier Rail, Details Showing Replacement of Existing Bridgerail System with New Jersey Shape Concrete Parapet and New 10'-2" Endpost - 1988, and Details Showing Replacement of Existing Bridgerail System with New Jersey Shape Concrete Parapet and New 10'-2" Endpost - 1988.

(TO BE PRINTED WITH PLANS- CONT.)

Table with columns: DWG. NO., CURRENT REVISION, DESCRIPTION. Lists drawings SBR-2-127 through RP-J-9 including Details Showing Pier Protection with New Concrete Barrier Wall - 1988, Details Showing Pier Protection with New Concrete Barrier Wall - 1988, Details Showing Pier Protection with New Vertical Concrete Barrier - 1988, Details Showing Pier Protection with New Vertical Concrete Barrier - 1988, Details Showing Guardrail Attachment at Bridge Ends to Existing Concrete Slope Face Endpost - 1989, Details Showing Guardrail Attachment at Bridge Ends to Existing Concrete Slope Face Endpost - 1989, Standard Legend for Erosion and Sediment Control, Roadside Ditch Details for Design and Construction, Precast Circular No. 31 Catch Basin, Details of Concrete Driveways, and Contraction and Construction Joints for Concrete Pavement.

(INCLUDE IN PLANS - TO BE REFILED WITH STRUCTURES)

Table with columns: DWG. NO., CURRENT REVISION, DESCRIPTION. Lists drawings G-9-91 through K-19-5 including South Moore Road Overpass-General Drawing, South Moore Road Overpass-Bents and Columns, South Moore Road Overpass-Bents, McBrien Road Overpass-General Drawing, McBrien Road Overpass-Bents and Columns, McBrien Road Overpass-Bents, Belvoir Avenue Overpass-General Drawing, Belvoir Avenue Overpass-Bents and Column, Belvoir Avenue Overpass-Bents, Missionary Ridge, So. Seminole Dr. Overpass-General Drawing, Missionary Ridge, So. Seminole Dr. Overpass-Bents and Columns, and Missionary Ridge, So. Seminole Dr. Overpass-Bents.

STANDARD ROADWAY DRAWINGS

Table with columns: DWG. NO., CURRENT REVISION, DESCRIPTION. Lists drawings RD-A-1 through RD-UD-7 including Standard Abbreviations, Standard Legend, Standard Legend for Utility Installations, Standard Legend for Signalization and Lighting Design and Construction Details for Roadside Slope Development, Median Sections & Median Barrier Warrant Criteria Design Standards Freeways with Median Barrier, Underdrain Details, Underdrain Details, Lateral Underdrain Endwall Detail for 1:1 & 2:1 Slopes, and Lateral Underdrain Endwall Detail for 3:1 & 4:1 Slopes.

DRAINAGE - CULVERTS AND ENDWALLS

Table with columns: DWG. NO., CURRENT REVISION, DESCRIPTION. Lists drawings D-PB-1, D-PE-4B (1), D-PE-4B (2), and D-PG-3 including Class "B" Bedding and Culvert Excavation, Concrete Endwall Type "U" with Steel Pipe Grate (for 18" thru 48" pipes) 4:1 Slope, Concrete Endwall Type "U" with Steel Pipe Grate (for 18" thru 48" pipes) 4:1 Slope, and Ferrous and Aluminum Corrugated Metal Pipe.

DRAINAGE-CATCH BASINS AND MANHOLES

Table with columns: DWG. NO., CURRENT REVISION, DESCRIPTION. Lists drawings D-CB-3, D-CB-31S, and D-CBB-31 including No. 36 and No. 37 Catch Basins and Grate, 7' x 7' Square Concrete No. 31 Catch Basin, and Type "B" Cast Iron Frame, Grate & Inlet Details for No. 31 Type Catch Basin.

ROADWAY AND PAVEMENT APPURTENANCES

Table with columns: DWG. NO., CURRENT REVISION, DESCRIPTION. Lists drawings RP-J-1 through RP-J-19 including Portland Cement Concrete Pavement Joint Types and Spacing, Portland Cement Concrete Pavement Joint Types and Spacing, 3/4" and 1-3/4" Expansion and Edge Pavement Joints, 3/4" and 1-3/4" Elastomeric Compression Joint Seals, Metal Longitudinal Joints, Dowel Assembly Devices, Dowel Assembly Devices, and Dowel Assembly Devices.

SAFETY APPURTENANCES AND FENCE


Table with columns: DWG. NO., CURRENT REVISION, DESCRIPTION. Lists drawings S-EA-1, S-F-10, S-F-10B, and S-GR-17A including Construction Zone Guardrail Energy Absorbing Terminal, Right-of-Way Stock Fence, Right-of-Way Chain Link Fence, and Tables of Offsets for Staking Out Guardrail Flare.

TRAFFIC CONTROL APPURTENANCES

Table with columns: DWG. NO., CURRENT REVISION, DESCRIPTION. Lists drawings T-FAB-1, T-L-1, T-M-5, T-M-6, T-M-7, T-M-8, T-PBR-2, and T-M-7 including Flashing Yellow Arrow Board, Lighting Details-Supports, Marking Details for Expressways and Freeways, Marking Detail for Expressway and Freeway, Gore Marking Details for Expressway and Freeway Interchanges, Marking Details for Expressways and Freeways, Detail for Vertical Panels, and Gore Marking Details for Expressway and Freeway Interchanges.

Table with columns: TYPE, YEAR, PROJECT NO., SHEET NO. Row 1: CONST., 1996, 33003-4154-04, 1A.

REV. 7/17/96: ADDED SHEET NO'S. 2M, 2N & 2P TO PLANS. DELETED STD. DWG. RP-J-23 & 24. REV. 7-25-96: ADDED SHEET NO. 2F(1) TO PLANS. ADDED STD. DWG. NO. S-EA-1 TO PLANS.

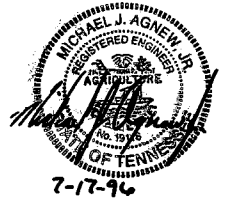

STATE OF TENNESSEE DEPARTMENT OF TRANSPORTATION BUREAU OF PLANNING & DEVELOPMENT

INDEX AND STANDARD ROADWAY DRAWINGS

17-JUL-1996 14:05
dlv24kx.dgn



WHEN BRIDGE DECK DRAINS ARE ENCOUNTERED, THE CONTRACTOR SHALL MAKE PROVISIONS FOR EXTENDING DRAINS TO TOP OF WEARING SURFACE. METHOD OF EXTENSION TO MEET WITH THE APPROVAL OF THE ENGINEER. COST TO BE INCLUDED IN BRIDGE DECK SEALANT ITEM NO. 617-01.

FOR EXPANSION JOINT REPAIR DETAILS. SEE STANDARD DRAWING NOS. BR-2-115 THRU BR-2-121. THE CONTRACTOR SHALL FIELD VERIFY ALL THE LENGTHS REQUIRED FOR INSTALLATION PRIOR TO JOINT FABRICATION. ALSO THE FOLLOWING SPECIAL PROVISIONS SHALL APPLY:
105A REGARDING APPROVAL OF SHOP DRAWINGS
604S REGARDING STRIP SEAL EXPANSION JOINTS

FOR DETAIL AND NOTES ON REINFORCED CONCRETE MEDIAN BARRIER (ITEM NO. 711-02.03), REFER TO SHEET NO.

CONST. NO. 33003-4154-04

PROJECT NO.	YEAR	SHEET NO.
	1996	2H

REVISIONS			
NO.	DATE	BY	BRIEF DESCRIPTION


FOR DETAIL AND NOTES ON CONCRETE PARAPET (BRIDGERAIL REPLACEMENT) (ITEM NO. 620-10.01), REFER TO STD.DWG. NO. BR-2-124, BR-2-125 & BR-2-126.

MASTIC AS RECOMMENDED BY MANUFACTURER OF MEMBRANE. SEE STD. SPEC. ART. 906.04.
1/2" Ø HOLE TO BE DRILLED BY THE CONTRACTOR NEAR FACE OF NEW PARAPETS OR EXISTING CURBS AT LOW POINTS.

TABULATION OF BRIDGE RELATED WORK AND ESTIMATED QUANTITIES

LOCATION OF BRIDGE AND BRIDGE NUMBER	REFERENCE DRAWINGS TO BE PRINTED WITH CONTRACT DRAWINGS	TYPE OF WORK	604-10.30 BRIDGE DECK REPAIR (FULL DEPTH OF SLAB) S.Y.	604-10.50 BRIDGE DECK REPAIR (PARTIAL DEPTH OF SLAB) S.Y.	617-01 BRIDGE DECK SEALANT S.Y.	407-02 REMOVAL & DISPOSAL OF EXISTING SURFACE (BITUMINOUS) C.Y.	705-10.29 CONCRETE BARRIER WALL FOR BRIDGE PIERS L.F.	711-02.03 REINFORCED CONCRETE MEDIAN BARRIER (BRIDGES) L.F.	604-03.09 CLASS "D" CONCRETE (BRIDGE DECK) C.Y.	604-02.03 EPOXY COATED REINFORCING STEEL LB.	604-04.01 APPLIED TEXTURE FINISH (NEW STRUCTURES) S.Y.
33-4148-3.27/124-11.45 33I00240053	K-19-1.K-19-4.K-19-5	PIER PROTECTION					88				
33-124-12.08(EBL)/3577 33I00240055		BRIDGE DECK REPAIR BRIDGE DECK SEALANT	10	200	737			166	41	12,719	175
33-124-12.08(WBL)/3577 33I00240055		BRIDGE DECK REPAIR BRIDGE DECK SEALANT	10	200	737						
33-3611-1.01/124-12.54 33I00240057	H-2-15.H-2-18.H-2-19	PIER PROTECTION					180				
33-3578-0.08/124-13.34 33I00240059	G-9-91.G-9-94.G-9-95	PIER PROTECTION					180				
33-3610-1.58/124-13.62 33I00240061	G-9-99.G-9-101.G-9-102	PIER PROTECTION					193				
TOTAL			20	400	1474		641	166	41	12,719	175

CONCRETE FOR DECK REPAIR SHALL BE QUICK SETTING PATCHING MATERIAL MEETING ASTM C-928 AND APPROVED BY THE MATERIALS AND TEST DIVISION OF THE TENNESSEE DEPARTMENT OF TRANSPORTATION.

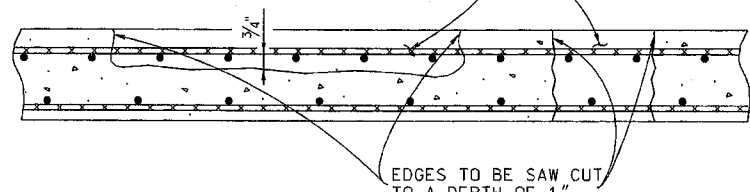

SKETCH SHOWING DECK REPAIR

NOTE: REMOVE CONCRETE IN ALL DELAMINATED AREAS TO A DEPTH OF 3/4" BELOW THE TOP BAR OF THE TOP MAT OF REINFORCING STEEL. ALL REINFORCING STEEL IN AREAS OF DECK REPAIR SHALL BE BLAST CLEANED. BLASTING AND CLEANING SHALL BE DONE PRIOR TO PLACING NEW CONCRETE OR INSTALLING PATCHING MATERIAL. AREAS OF CONCRETE REMOVAL SHALL BE DESIGNATED BY PERSONNEL FROM THE HEADQUARTERS, BRIDGE INSPECTION AND REPAIR OFFICE.


NOTE: ITEM NO. 604-10.50, BRIDGE DECK REPAIR (PARTIAL DEPTH OF SLAB), AND ITEM NO. 604-10.30, BRIDGE DECK REPAIR (FULL DEPTH OF SLAB), SHALL BE BID WITH THE CONTINGENCY THAT THIS MAY BE INCREASED, DECREASED OR ELIMINATED AS DIRECTED BY THE ENGINEER.

POWER DRIVEN HAND TOOLS:

POWER DRIVEN HAND TOOLS USED FOR THE REMOVAL OF UNSOUND CONCRETE IN MAKING PARTIAL AND FULL DEPTH REPAIRS ARE SUBJECT TO THE FOLLOWING RESTRICTIONS: (1) PARTIAL DEPTH REPAIRS: PNEUMATIC HAMMERS HEAVIER THAN NOMINAL 60 LBS CLASS SHALL NOT BE USED. ALSO TRAFFIC CONTROL SHALL BE SET UP DURING PARTIAL DEPTH REPAIRS OVER TRAFFIC. (2) FULL DEPTH REPAIRS: PNEUMATIC HAMMERS HEAVIER THAN NOMINAL 90 LBS CLASS SHALL NOT BE USED. ALSO ALL DECK REPAIR OVER BEAMS WILL BE RESTRICTED TO 60 LBS PNEUMATIC HAMMERS. (3) CHIPPING HAMMERS OF THE 15 LB CLASS SHALL BE USED TO REMOVE CONCRETE FROM BENEATH ANY REINFORCING STEEL.

OPTIONAL BRIDGE DECK REPAIR MATERIAL

IF LANE CLOSURES ARE PROVIDED FOR THIS PROJECT AND THE LANE CLOSURES ARE SUCH THAT TRAFFIC WILL BE KEPT OFF OF THE BRIDGE DECK WHERE DECK REPAIRS WILL BE MADE, THEN HIGH EARLY STRENGTH CONCRETE, f'c = 24 MPa @ 28 DAY STRENGTH MAY BE SUBSTITUTED FOR THE QUICK SET PATCHING MATERIALS SPECIFIED IN THE SKETCH TO THE RIGHT. ALSO SEE TENNESSEE STANDARD SPECIFICATIONS. IF EARLY STRENGTH CONCRETE IS USED, THEN TRAFFIC WILL NOT BE PERMITTED ON THE REPAIRED AREAS UNTIL A MINIMUM OF TEN (10) DAYS HAVE ELAPSED FROM THE DATE OF POUR AND REPRESENTATIVE TEST SPECIMENS HAVE ATTAINED A COMPRESSIVE STRENGTH OF NOT LESS THAN 3000 PSI. ALSO AN APPROVED EPOXY BONDING AGENT SHALL BE USED BETWEEN THE OLD AND THE NEW CONCRETE POURS.


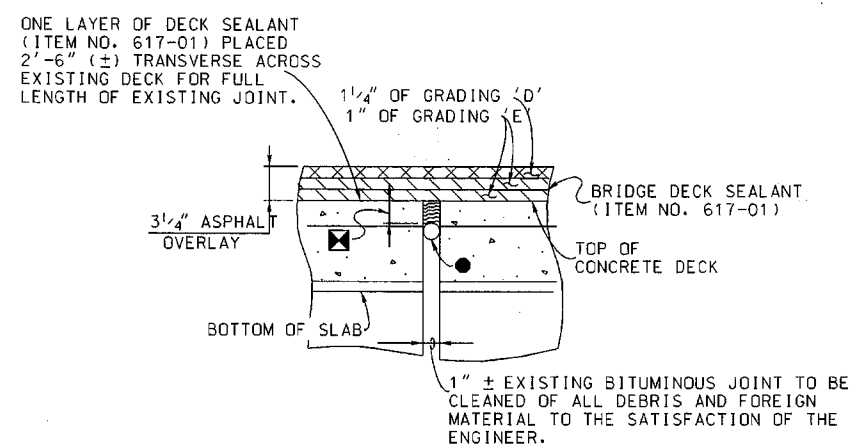


SECTION THRU EXISTING BRIDGE SLAB JOINT

(TYPICAL AT ALL EXISTING BITUMINOUS JOINTS WHEN NO JOINT REPAIR DETAIL IS SPECIFIED IN THE TABLE ABOVE)

NOTE: THE EXISTING JOINT OPENING SHALL BE CAULKED WITH A BACKER ROD OF SUITABLE DIAMETER. THE ROD SHALL BE PLACED AT A DEPTH TO ENSURE THE CORRECT WIDTH/DEPTH RATIO OF THE NEW JOINT SEALANT MATERIAL. BACKER ROD SHALL BE AS PER JOINT MANUFACTURERS RECOMMENDATION.

NOTES: TOP 2" OF ALL EXISTING BITUMINOUS JOINTS IN THE BRIDGE SLAB TO BE CLEANED AND RESEALED WITH NEW JOINT SEALER. CONTRACTOR HAS THE OPTION OF USING EITHER: (1) A TYPE K HOT-POURED ELASTIC TYPE CONCRETE JOINT SEALER. SEE STANDARD SPECIFICATIONS SECTION 905.05, JOINT SEALER. (2) A COLD POUR SINGLE COMPONENT JOINT SEALER AS APPROVED BY THE DIVISION OF MATERIALS AND TEST. COST OF JOINT CLEANING AND SEALING TO BE INCLUDED UNDER ITEM NO. 617-01 (BRIDGE DECK SEALANT). THE SEALER SHALL EXTEND UP AND ACROSS THE CURB OR SIDEWALK AREA TO THE OUTER EDGE OF THE BRIDGE SLAB.

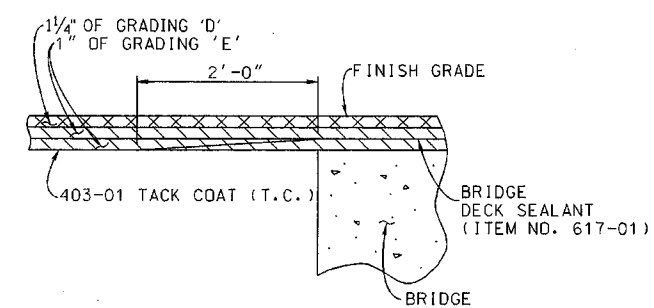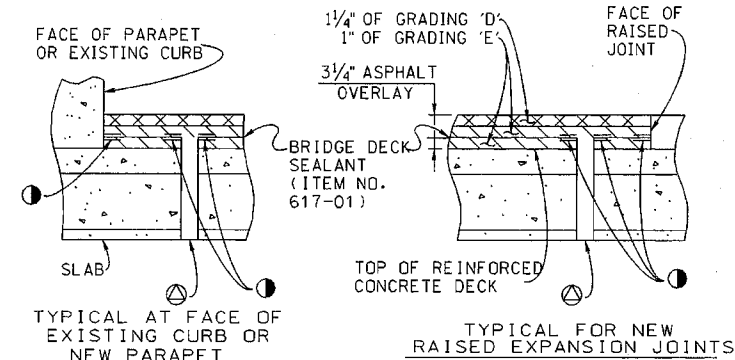

BRIDGE DECK SEALANT DETAILS

NOTE: ON BRIDGE DECK WHERE THERE IS A BITUMINOUS JOINT OR WITH NO EXPANSION JOINT, MEMBRANE SHALL EXTEND 2'-0" OVER THE END OF THE BRIDGE DECK. IF THE DECK HAS A STEEL EXPANSION JOINT, THE MEMBRANE SHALL STOP AT THE STEEL EXPANSION JOINT.

STATE OF TENNESSEE
DEPARTMENT OF TRANSPORTATION
BUREAU OF HIGHWAYS

BRIDGE TABULATIONS AND ESTIMATED QUANTITIES
INTERSTATE 24
FROM (L.M. 10.50) TO (L.M. 14.70)
HAMILTON COUNTY

9633BSC.DGN
 FILE NO. 70


SCANNED

DISCHINA

CONST. NO. 33003-4154-04

PROJECT NO.	YEAR	SHEET NO.
X	1996	21

REVISIONS			
NO.	DATE	BY	BRIEF DESCRIPTION

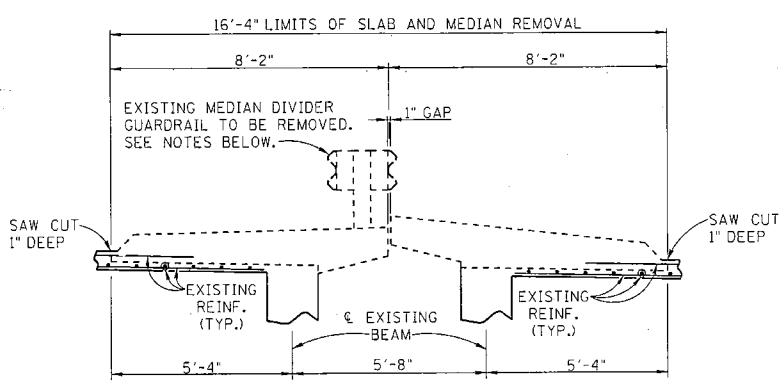


SECTION SHOWING LIMITS OF SLAB AND MEDIAN REMOVAL

NOTE: COST OF REMOVING EXISTING MEDIAN DIVIDER GUARDRAIL ON THE BRIDGE, REMOVING EXISTING CONCRETE MEDIAN BARRIER TRANSITION ON THE WEST END OF THE BRIDGE AND POURING THE NEW MEDIAN BARRIER TRANSITION ON THE EAST END OF THE BRIDGE, LABOR, FORMING AND ANY MISCELLANEOUS MATERIALS NECESSARY TO COMPLETE THE REPAIRS TO BE INCLUDED UNDER ITEM NO. 711-02.03, REINFORCED CONCRETE MEDIAN BARRIER (BRIDGES), L.F.

NOTE: EXISTING MEDIAN DIVIDER GUARDRAIL AND RUB RAILS TO BE ATTACHED TO THE NEW MEDIAN BARRIER TRANSITION, COST OF ATTACHING EXISTING RAILS AND/OR ANY NEW ADDITIONAL GUARDRAIL, RUB RAILS, AND ANY MISCELLANEOUS MATERIALS NECESSARY TO COMPLETE THE REPAIRS AS SHOWN, COMPLETE AND IN PLACE, TO BE INCLUDED UNDER ITEM NO. 711-02.03, REINFORCED CONCRETE MEDIAN BARRIER (BRIDGES), L.F.

NOTE: ALL EXISTING MEDIAN DIVIDER GUARDRAIL TO BE REMOVED FOR THE LIMITS AS SHOWN IN DETAILS THIS SHEET AND TO BE STOCK PILED ON THE JOB SITE AS DIRECTED BY THE ENGINEER. RAILINGS TO BE PICKED UP BY STATE MAINTENANCE FORCES.

NOTE: COST OF REMOVING EXISTING MEDIAN FOR LIMITS AS SHOWN, NEW CLASS "A" F'c = 4,500 p.s.i. CONCRETE, FORMING, LABOR, BLAST CLEANING, AND ANY MISCELLANEOUS MATERIALS NEEDED TO COMPLETE THE REPAIRS TO BE INCLUDED UNDER ITEM NO. 604-03.09, CLASS "D" CONCRETE (BRIDGE DECK)


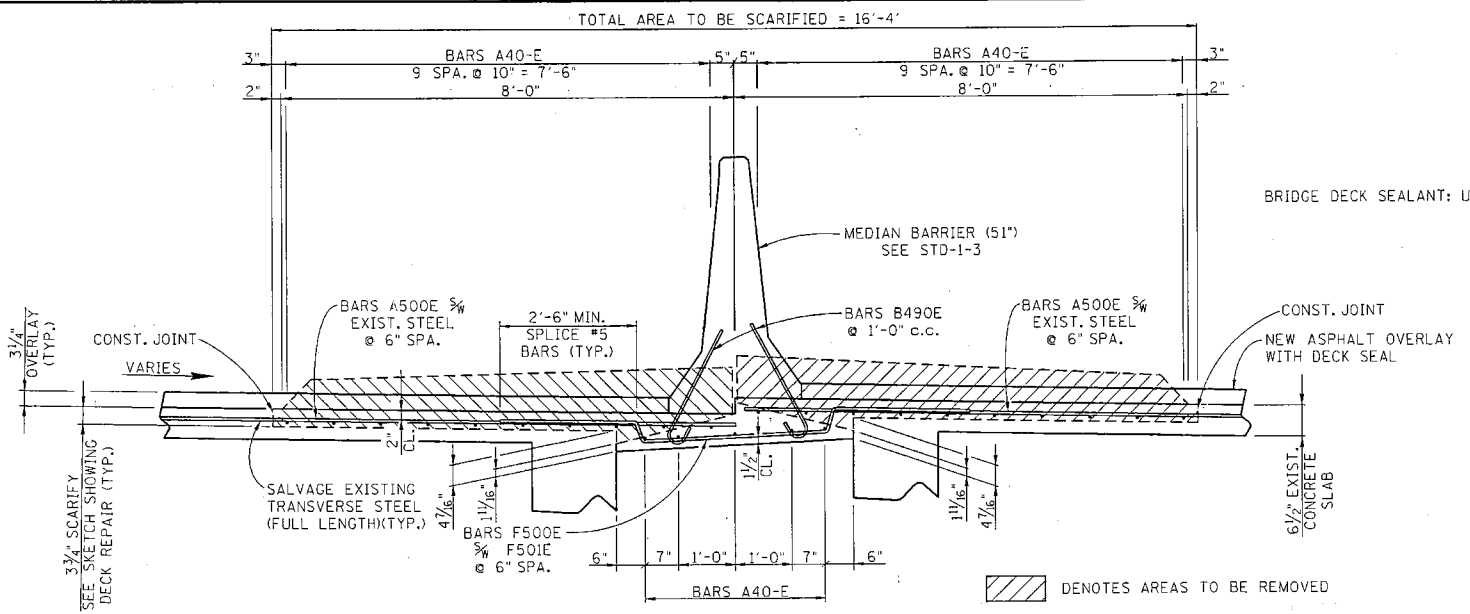


SECTION SHOWING REINFORCING STEEL IN NEW SLAB (LOOKING BACK ON SURVEY)


NOTE: EXISTING REINFORCING STEEL TO REMAIN IN PLACE. CONTRACTOR TO TAKE EXTREME CARE WHEN REMOVING EXISTING SLAB AND MEDIAN FOR LIMITS SHOWN SO AS NOT TO DAMAGE EXISTING REINFORCING STEEL. ALL EXPOSED EXISTING REINFORCING STEEL TO BE BLAST CLEANED AND INCORPORATED IN WITH NEW EPOXY COATED REINFORCING STEEL.

NOTE: WHEN POURING NEW MEDIAN SLAB, PROVISIONS SHALL BE MADE FOR SETTING BARS B490E FOR THE NEW CONCRETE MEDIAN BARRIER.


NOTE: COST OF ALL CLASS "A" F'c = 3,000 p.s.i. CONCRETE, EPOXY COATED REINFORCING STEEL, FORMING, TEXTURE COATING, LABOR AND ANY MISCELLANEOUS MATERIALS NECESSARY TO CONSTRUCT THE CONCRETE MEDIAN BARRIER AS SHOWN IN DETAILS TO BE INCLUDED UNDER ITEM NO. 711-02.03, REINFORCED CONCRETE MEDIAN BARRIER (BRIDGES), L.F. SEE OPTIONAL CONCRETE NOTE ON DWG. NO.

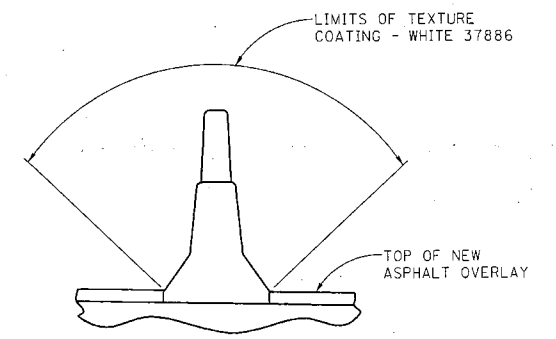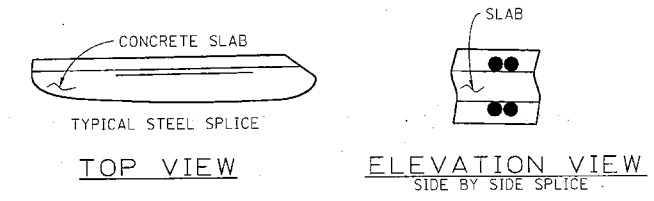

TEXTURE COATING DETAIL
 COST OF TEXTURE COATING TO BE INCLUDED UNDER ITEM NO. 604-04.01 S.Y.)

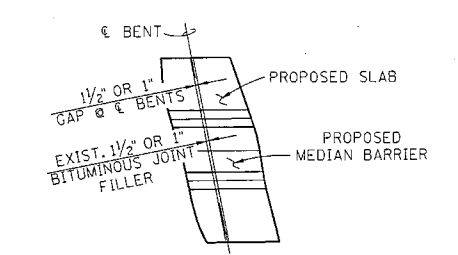


EXISTING EXPANSION JOINT LOCATIONS (TYPICAL AT ALL BENTS)

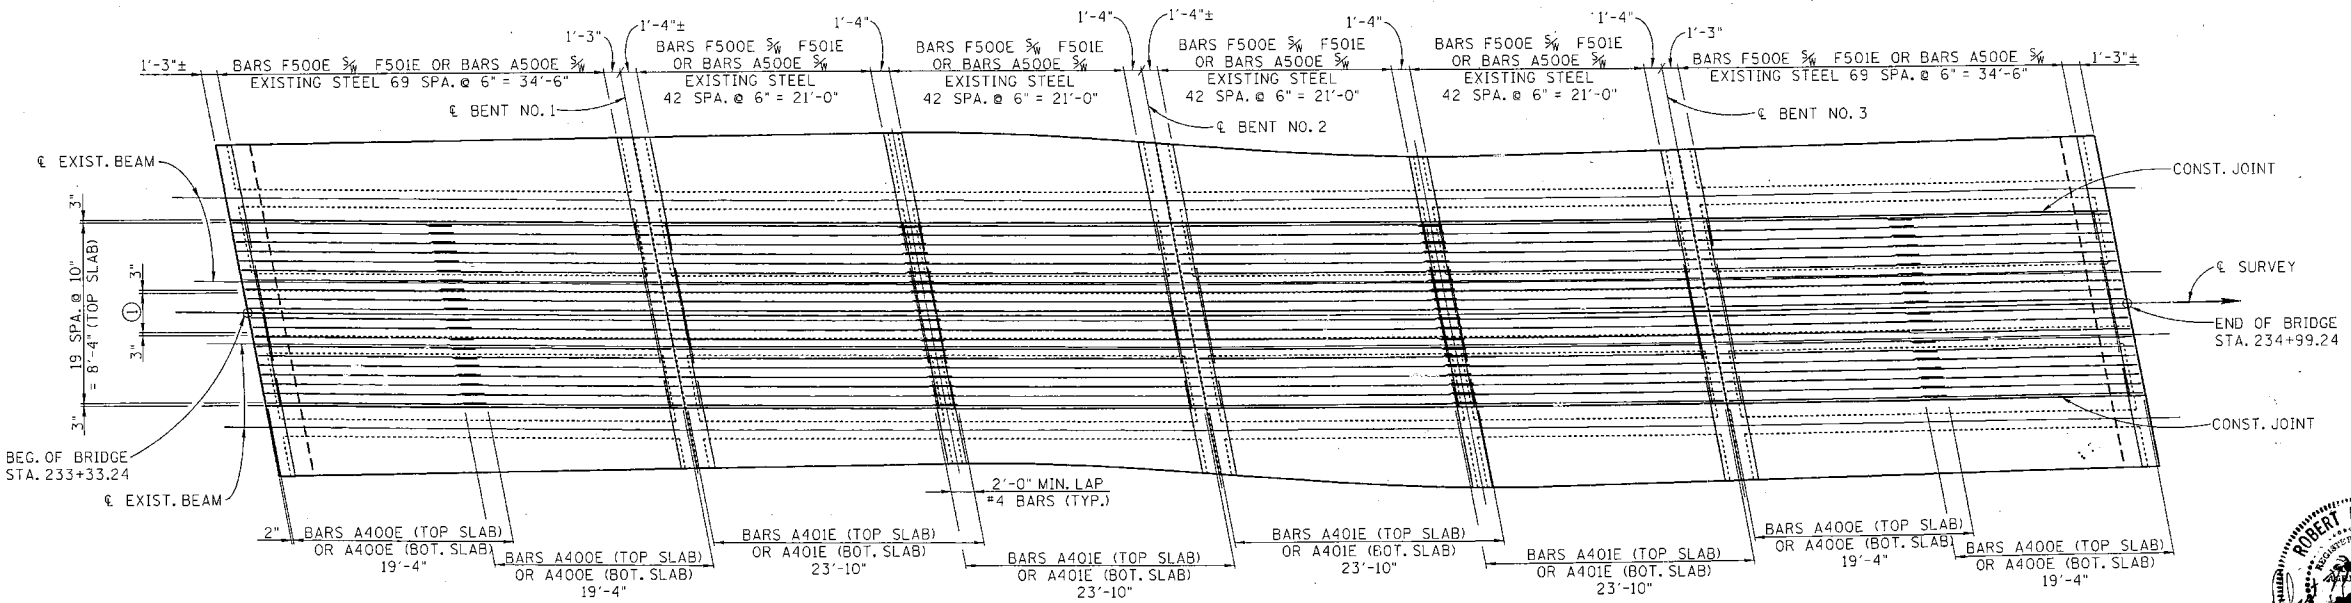

① DENOTES: SEE SECTION SHOWING REINFORCING STEEL IN NEW SLAB ON THIS SHEET FOR SPACING OF BARS A400E IN BOTTOM OF SLAB

BILL OF STEEL

BAR	SIZE	NO. REQ'D	LENGTH
A400E	4	100	19'-4"
A401E	4	100	23'-10"
A500E	5	624	8'-0"
B490E	4	334	3'-0"
F500E	5	312	6'-2"
F501E	5	312	6'-0"

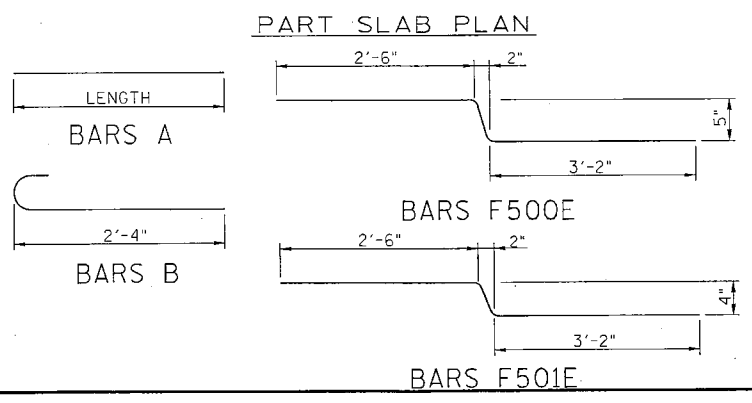

ESTIMATED QUANTITIES

CLASS "D" CONCRETE (BRIDGE DECK) C.Y.	EPOXY-COATED REINFORCING STEEL (BRIDGES) LB.	APPLIED TEXTURE FINISH S.Y.
41	12,719	175



STATE OF TENNESSEE
 DEPARTMENT OF TRANSPORTATION
 BRIDGE REPAIR DETAILS
 INTERSTATE 24 OVER
 GERMANTOWN ROAD
 HAMILTON COUNTY
 1996


CORRECT *Edward P. Wasserman*
 ENGINEER OF STRUCTURES

DESIGNED BY ALI WEHBI DATE 6-96
 DRAWN BY STEVEN STEELE DATE 6-96
 SUPERVISED BY DATE
 CHECKED BY DATE


TENNESSEE O.D.T.
DESIGN DIVISION
FILE NO. 233

SCANNED


TYPE	YEAR	PROJECT NO.	SHEET NO.
CONST.	1996	33003-4154-04	2J

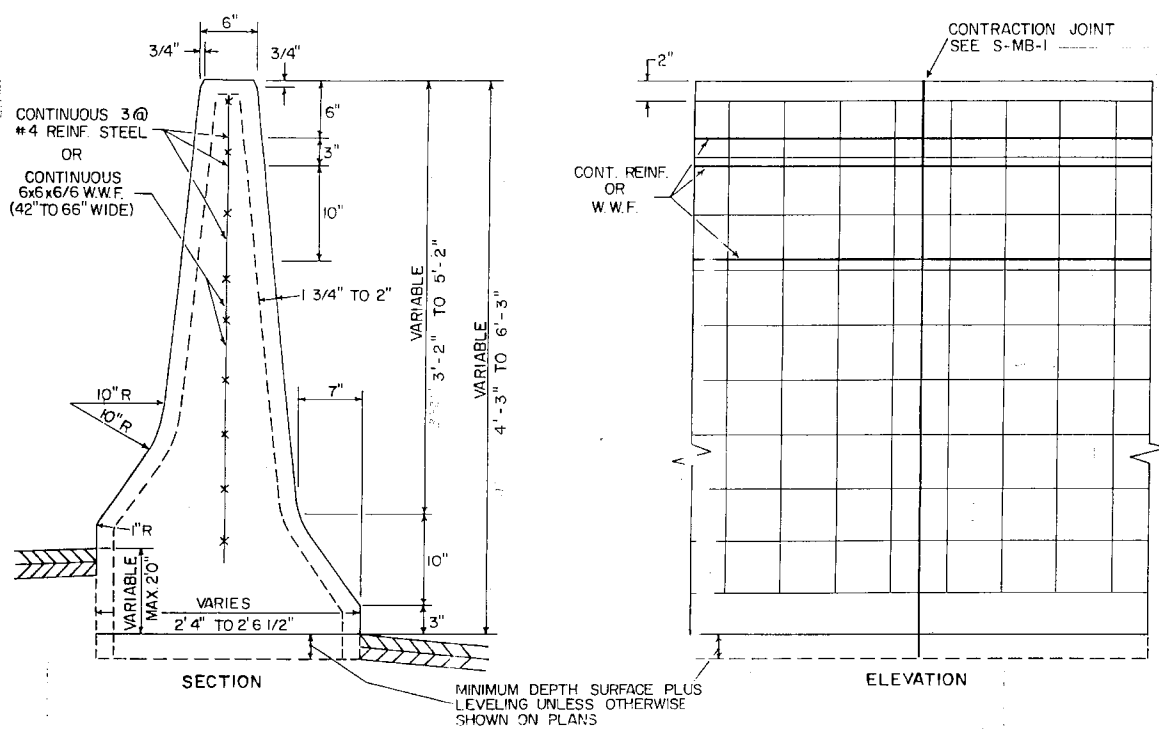


DETAILS OF REINFORCING AND CONTRACTION JOINT

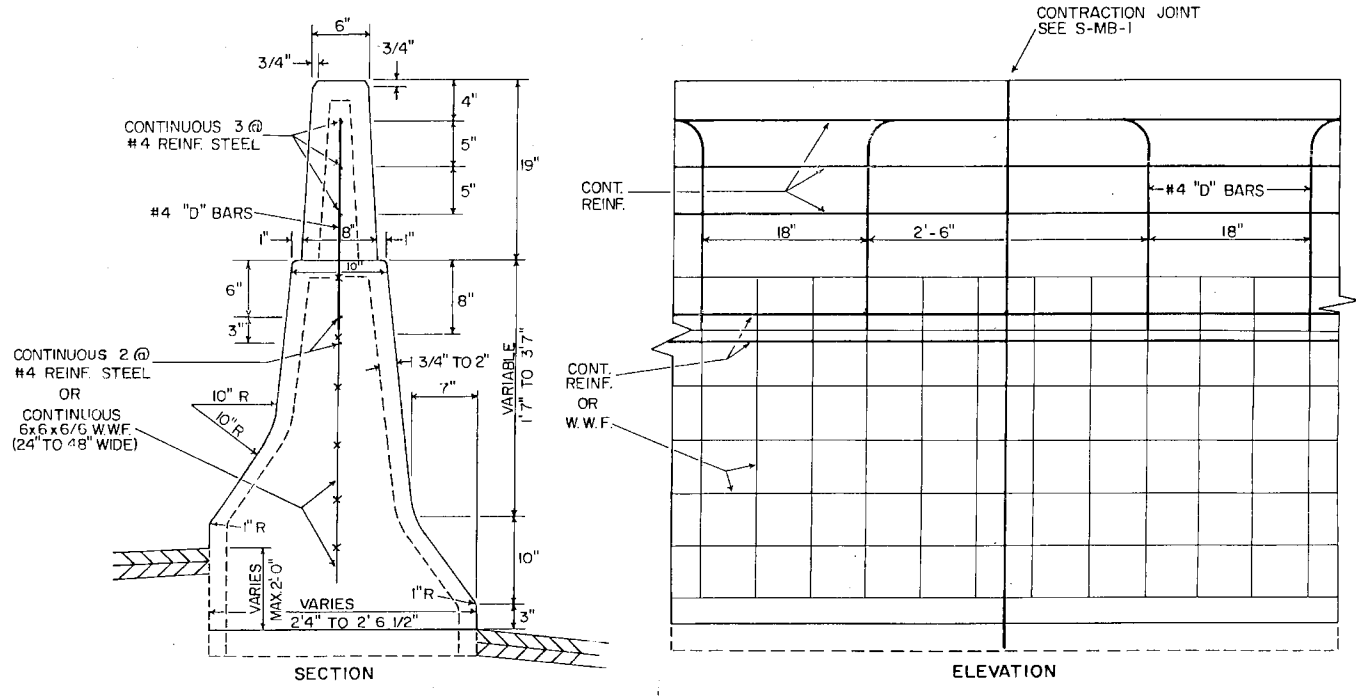

DETAILS OF REINFORCING AND CONTRACTION JOINT

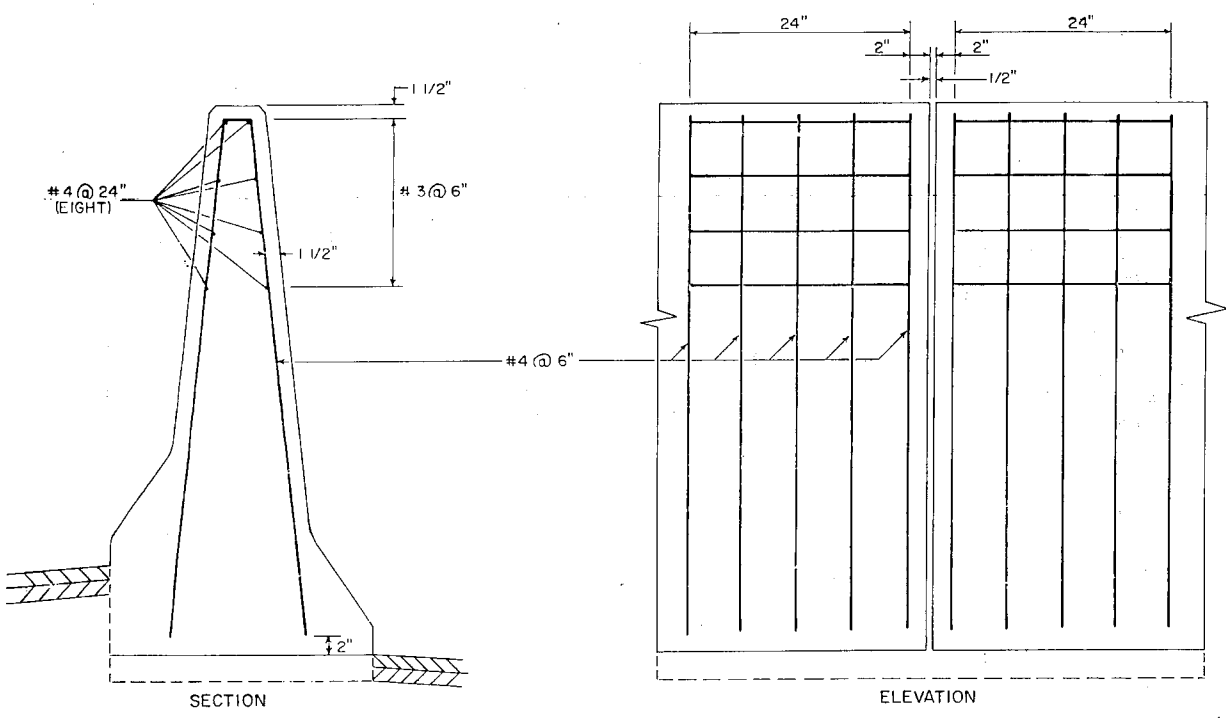


DETAILS OF REINFORCING AT EXPANSION JOINT
MONOLITHIC BARRIER

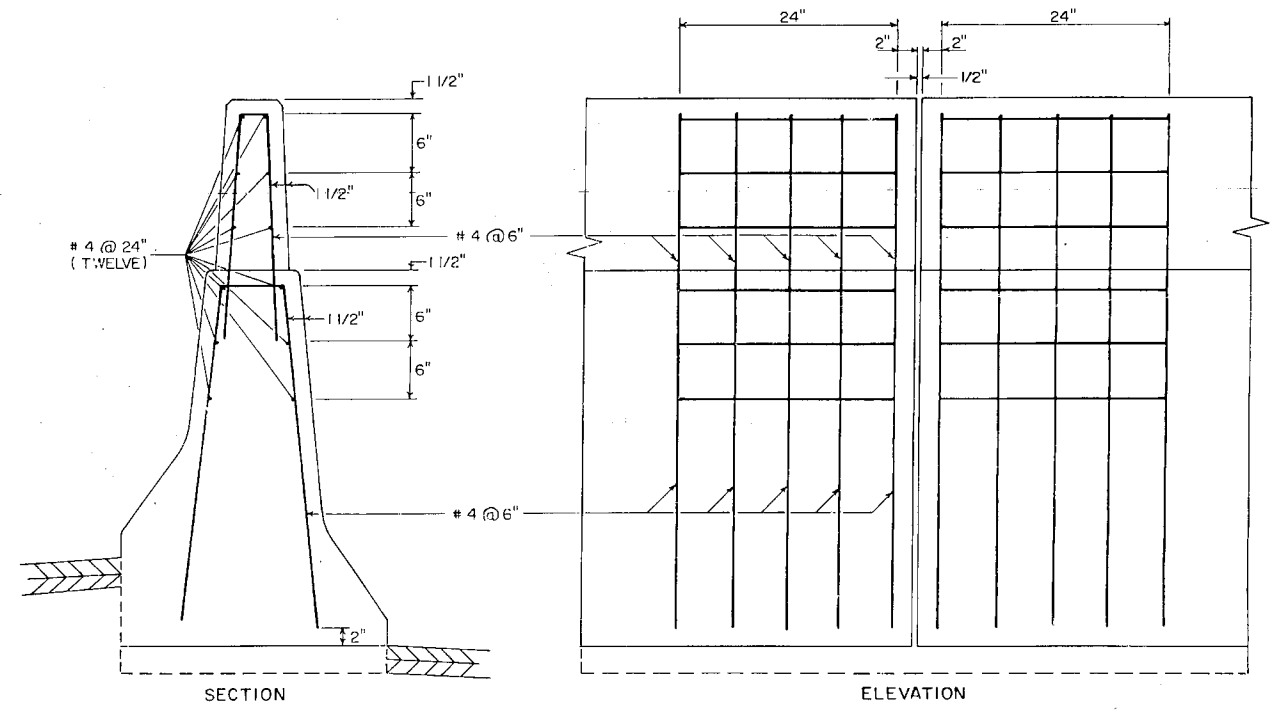

DETAILS OF REINFORCING AT EXPANSION JOINT
ALTERNATE BARRIER

- NOTES
- SEE STANDARD DRAWING S-MB-1 FOR NOTES AND ADDITIONAL DETAILS.
 - PAYMENT WILL BE MADE UNDER ITEM NO 711-04, CONCRETE GLARE SCREEN MEDIAN BARRIER _____ LIN. FT.
 - THE COST OF FURNISHING AND INSTALLING MEDIAN BARRIER DELINEATORS, INCLUDING ALL MATERIALS, LABOR AND INCIDENTALS NECESSARY TO COMPLETE THE INSTALLATION, SHALL BE INCLUDED IN BID PRICE FOR CONCRETE GLARE SCREEN MEDIAN BARRIER.
 - VERTICAL BARS MAY BE "D" BARS AT 18" MAXIMUM SPACING OR STRAIGHT DOWELS AT 24" MAXIMUM SPACING.

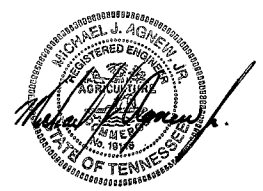

6-25-96


STATE OF TENNESSEE
DEPARTMENT OF TRANSPORTATION
BUREAU OF PLANNING & DEVELOPMENT

MEDIAN
BARRIER
DETAILS


TYPE	YEAR	PROJECT NO.	SHEET NO.
CONST.	1996	33003-4154-04	2K

TENNESSEE
DEPARTMENT OF TRANSPORTATION
BUREAU OF PLANNING & DEVELOPMENT
FILE NO. 7
23

SCANNED

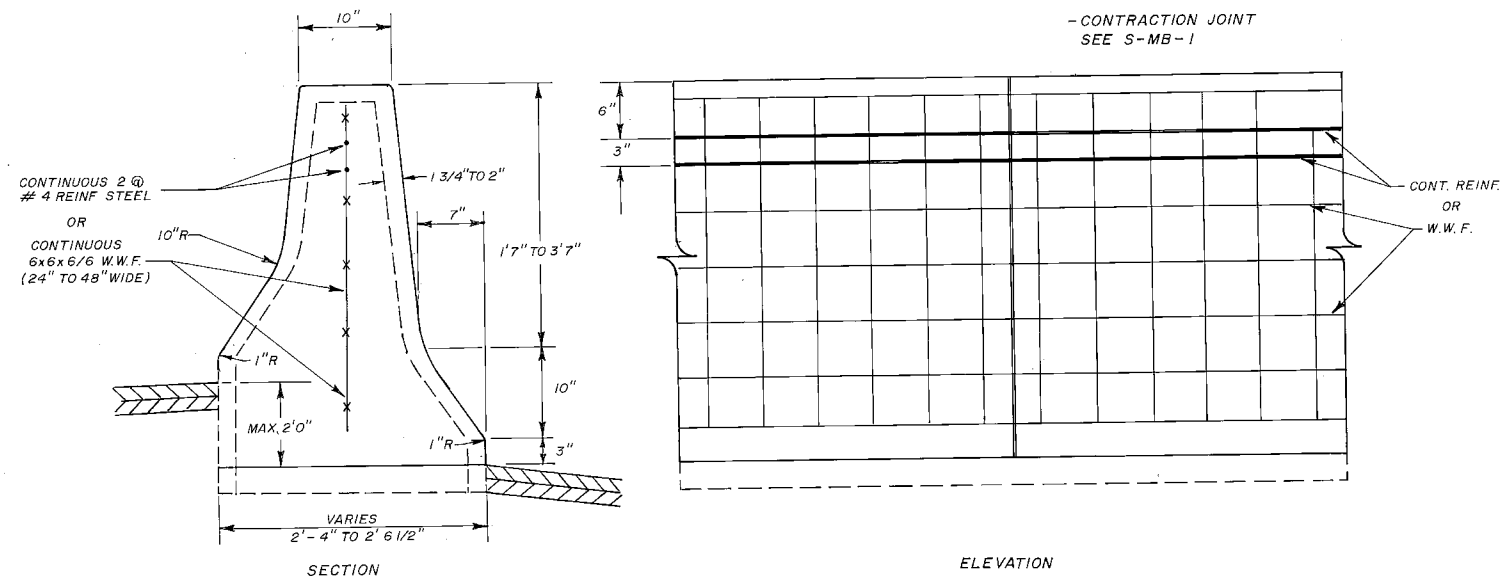

DETAILS OF REINFORCING AND CONTRACTION JOINT

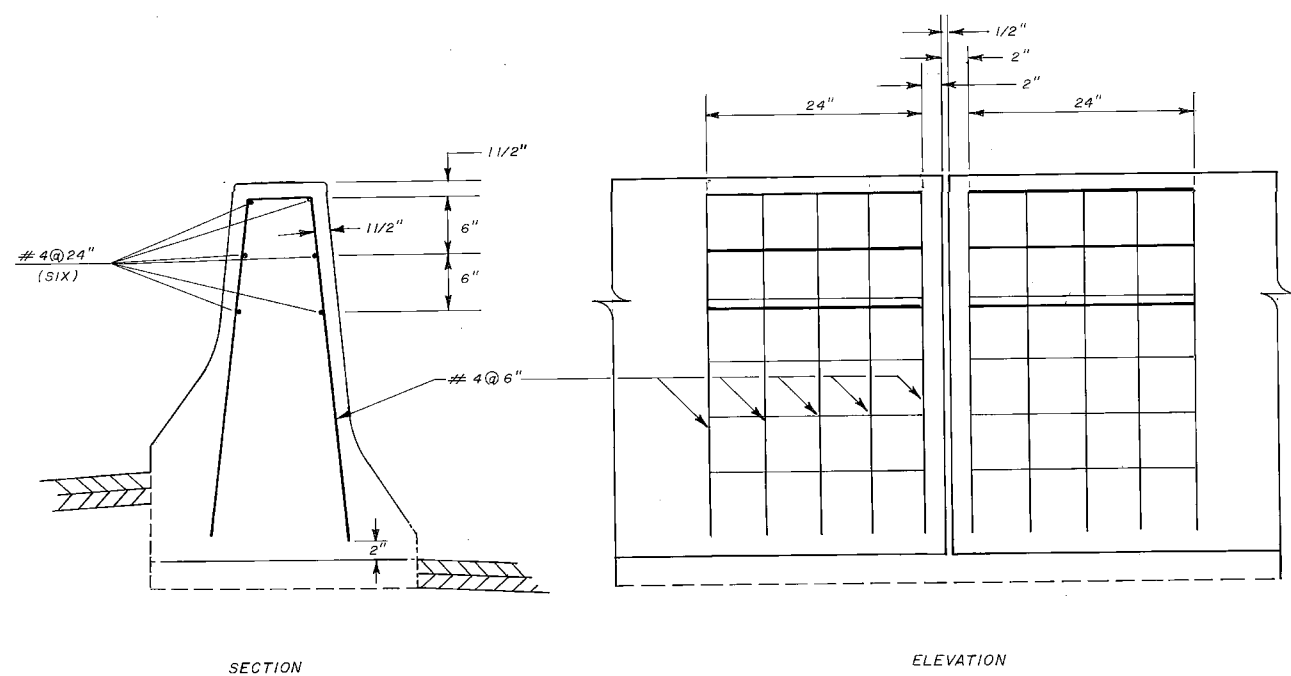

DETAILS OF REINFORCING AT EXPANSION JOINT



6-25-96

STATE OF TENNESSEE
DEPARTMENT OF TRANSPORTATION
BUREAU OF PLANNING & DEVELOPMENT

MEDIAN
BARRIER
DETAILS

N.T.S.

Counties: Bledsoe Bradley
 Clay Coffee
 Cumberland Fentress
 Franklin Hamilton
 McMinn Marion
 Overton Putnam
 Rhea Sequatchie
 Van Buren Warren

ESTIMATED QUANTITIES

<u>Item No.</u>	<u>Description</u>	<u>Quantity</u>	<u>Unit</u>
1,2) 604-10.44	Expansion Joint Repairs	6684	L.F.
3) 712-01	Traffic Control	1	L.S.
717-01	Mobilization	1	L.S.

FOOTNOTES

- 1) For quantity per bridge, see enclosed tables (EXPANSION JOINT REPAIR QUANTITIES). For details and notes see expansion joint repair detail sheet (Sheet 36 of 36).
- 2) The cost of removing existing asphalt and bituminous joint, cleaning and preparing existing joint opening, installing new backer rod and joint sealer, and any miscellaneous materials necessary to install and complete expansion joint repair to be included under Item No. 604-10.44, EXPANSION JOINT REPAIRS, L.F.
- 3) Traffic Control will be for fifty-two (52) bridge locations and located in sixteen (16) different counties. (See location sketches for Bridge No. and County) This item includes construction signs and flashing arrow boards as required for construction phasing and as shown on enclosed traffic control layouts.

STANDARD DRAWING

<u>No.</u>	<u>REV. DATE</u>	<u>DRAWING</u>
T-FAB-1	5-30-91	Flashing Yellow Arrow Board

GENERAL NOTES

- 1) Design Specifications: AASHTO 1992 Edition with Addenda.
- 2) Specifications: Standard Specifications for Road and Bridge Construction of the Tennessee Department of Transportation (March 1, 1981 Edition).
- 3) Any damage during repairs to any portion of the Bridge or approaches shall be repaired at the Contractor's own expense to the approval of the Engineer.
- 4) Utilities: The Contractor is responsible for verifying locations of all existing utilities whether shown on Plans or as found on the site and shall not disturb any existing utility.
- 5) Traffic Control shall consist of furnishing Flagmen and erecting and maintaining all Warning Signs and other traffic control devices installed in accordance with the Manual on Uniform Traffic Control Devices, Part 6, and all cost shall be included in the unit price bid for Item No. 712-01.

GENERAL NOTES

CONSTRUCTION WORK ZONE AND TRAFFIC CONTROL NOTES

ADVANCED WARNING SIGNS SHALL NOT BE DISPLAYED MORE THAN FORTY-EIGHT (48) HOURS BEFORE PHYSICAL CONSTRUCTION BEGINS. SIGNS MAY BE ERECTED UP TO ONE WEEK BEFORE NEEDED, IF THE SIGN FACE IS FULLY COVERED.

IF THE CONTRACTOR MOVES OFF THE PROJECT, HE SHALL COVER OR REMOVE ALL UNNEEDED SIGNS AS DIRECTED BY THE ENGINEER. COSTS OF REMOVAL, COVERING, AND REINSTALLING SIGNS SHALL NOT BE MEASURED AND PAID FOR SEPARATELY, BUT ALL COSTS SHALL BE INCLUDED IN THE ORIGINAL UNIT PRICE BID FOR ITEM NO. 712-06, SIGNS (CONSTRUCTION) PER SQUARE FOOT.

A LONG TERM BUT SPORADIC USE WARNING SIGN, SUCH AS FLAGGER SIGNS MAY REMAIN IN PLACE WHEN NOT REQUIRED PROVIDED THE SIGN FACE IS FULLY COVERED.

TRAFFIC CONTROL DEVICES SHALL NOT BE DISPLAYED OR ERECTED UNLESS RELATED CONDITIONS ARE PRESENT NECESSITATING WARNING.

USE OF BARRICADES, PORTABLE BARRIER RAILS, VERTICAL PANELS, AND DRUMS SHALL BE LIMITED TO THE IMMEDIATE AREAS OF CONSTRUCTION WHERE A HAZARD IS PRESENT. THESE DEVICES SHALL NOT BE STORED ALONG THE ROADWAY WITHIN THIRTY (30) FEET OF THE EDGE OF THE TRAVELED WAY BEFORE OR AFTER USE UNLESS PROTECTED BY GUARDRAIL, BRIDGE RAIL, AND/OR BARRIERS INSTALLED FOR OTHER PURPOSES. THESE DEVICES SHALL BE REMOVED FROM THE CONSTRUCTION WORK ZONE WHEN THE ENGINEER DETERMINES THEY ARE NO LONGER NEEDED. WHERE THERE IS INSUFFICIENT RIGHT-OF-WAY TO PROVIDE FOR THIS THIRTY (30) FEET SETBACK, THE CONTRACTOR SHALL DETERMINE THE ALTERNATE LOCATIONS AND REQUEST THE ENGINEER'S APPROVAL TO USE THEM.


THE CONTRACTOR SHALL NOT BE PERMITTED TO PARK ANY VEHICLES OR CONSTRUCTION EQUIPMENT DURING PERIODS OF INACTIVITY, WITHIN THIRTY (30) FEET OF THE EDGE OF PAVEMENT WHEN THE LANE IS OPEN TO TRAFFIC, UNLESS PROTECTED BY GUARDRAIL, BRIDGE RAIL, AND/OR BARRIERS INSTALLED FOR OTHER PURPOSES. PRIVATELY OWNED VEHICLES SHALL NOT BE ALLOWED TO BE PARKED WITHIN THIRTY (30) FEET OF AN OPEN TRAFFIC LANE AT ANY TIME UNLESS PROTECTED AS DESCRIBED ABOVE. WHERE THERE IS INSUFFICIENT RIGHT-OF-WAY TO PROVIDE FOR THIS THIRTY (30) FEET SETBACK, THE CONTRACTOR SHALL DETERMINE THE ALTERNATE LOCATIONS AND REQUEST THE ENGINEER'S APPROVAL TO USE THEM.

ALL DETOUR AND CONSTRUCTION SIGNING SHALL BE IN STRICT ACCORDANCE WITH THE MANUAL ON UNIFORM TRAFFIC CONTROL DEVICES.

SPECIAL NOTES

THE DETAILS FOR TRAFFIC CONTROL SHOWN IN THESE PLANS APPLY TO DAYTIME ONLY LANE CLOSURES. ALL LANES ARE TO BE REOPENED TO TRAFFIC AT THE END OF THE DAY'S WORK.

Top two inches (2") of all existing bituminous joints in the bridge slab to be cleaned and resealed with new joint sealer. New joint sealer shall be a self-leveling, cold-applied, rapid-cure, two-part, ultra-low-modulus, 100 per cent (100%) silicone rubber sealant, Dow Corning 902 RCS joint sealant, or approved equal. Cost of joint cleaning and sealing to be included under Item No. 604-10.44, EXPANSION JOINT REPAIRS, L.F. The sealer shall extend up and across the curb and/or sidewalk area to the outer edge of the bridge slab.

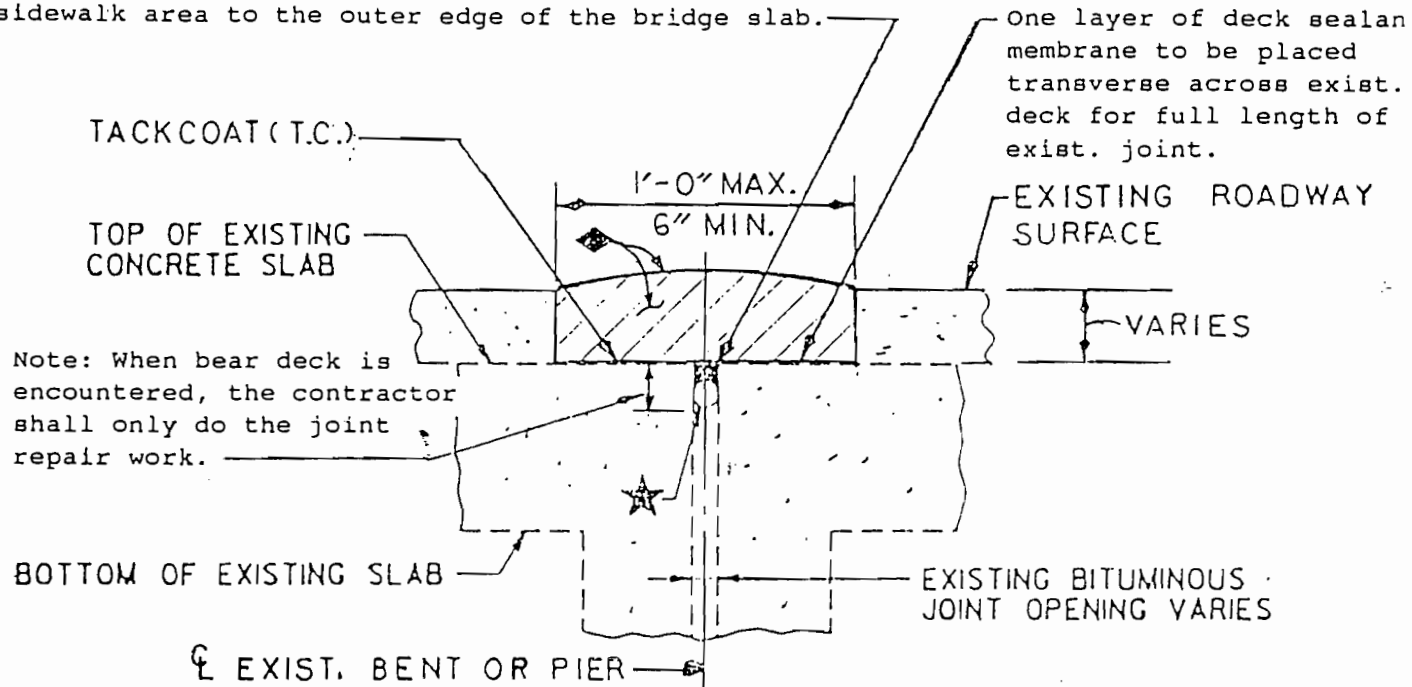


EXIST. BENT OR PIER
EXISTING BITUMINOUS JOINT REPAIR DETAIL

- ◆ NOTE: Grading "A" or "D" asphalt material shall be used to repair roadway surface. When existing asphalt surface is two inches (2") deep or less, use Grading "D" asphalt. When existing asphalt is greater than two inches (2") in depth use Grading "A" asphalt. The contractor shall tamp and compact new asphalt while pouring back to original grade. The new asphalt shall be left mounded across the new joint for settlement.
- ★ NOTE: The movement gap shall be caulked with a backer rod of suitable diameter. The rod shall be placed at a depth to ensure the correct width/depth ratio of the new bridge joint sealer. Backer rod and caulk shall be as per the sealer manufacturer recommendations.
- NOTE: Following removal of the existing bituminous fiberboard to an appropriate depth, the joint shall be completely cleaned in accordance with the sealer manufacturer's instructions.
- NOTE: Cost of cleaning, preparing, and sealing existing joint opening and any miscellaneous materials necessary to complete repairs as shown to be included in Item No. 604-10.44, EXPANSION JOINT REPAIRS, L.F. This item number shall be bid with the contingency that this item may be increased, decreased, or eliminated as directed by the Engineer.

EXPANSION JOINT REPAIR DETAIL

- 4 33-I124-12.08(RL & LL)/ GERMANTOWN ROAD
- 5 33-3611-1.01/ INTERSTATE 24
- 6 33-3578-0.80/ INTERSTATE 24 33I00240059

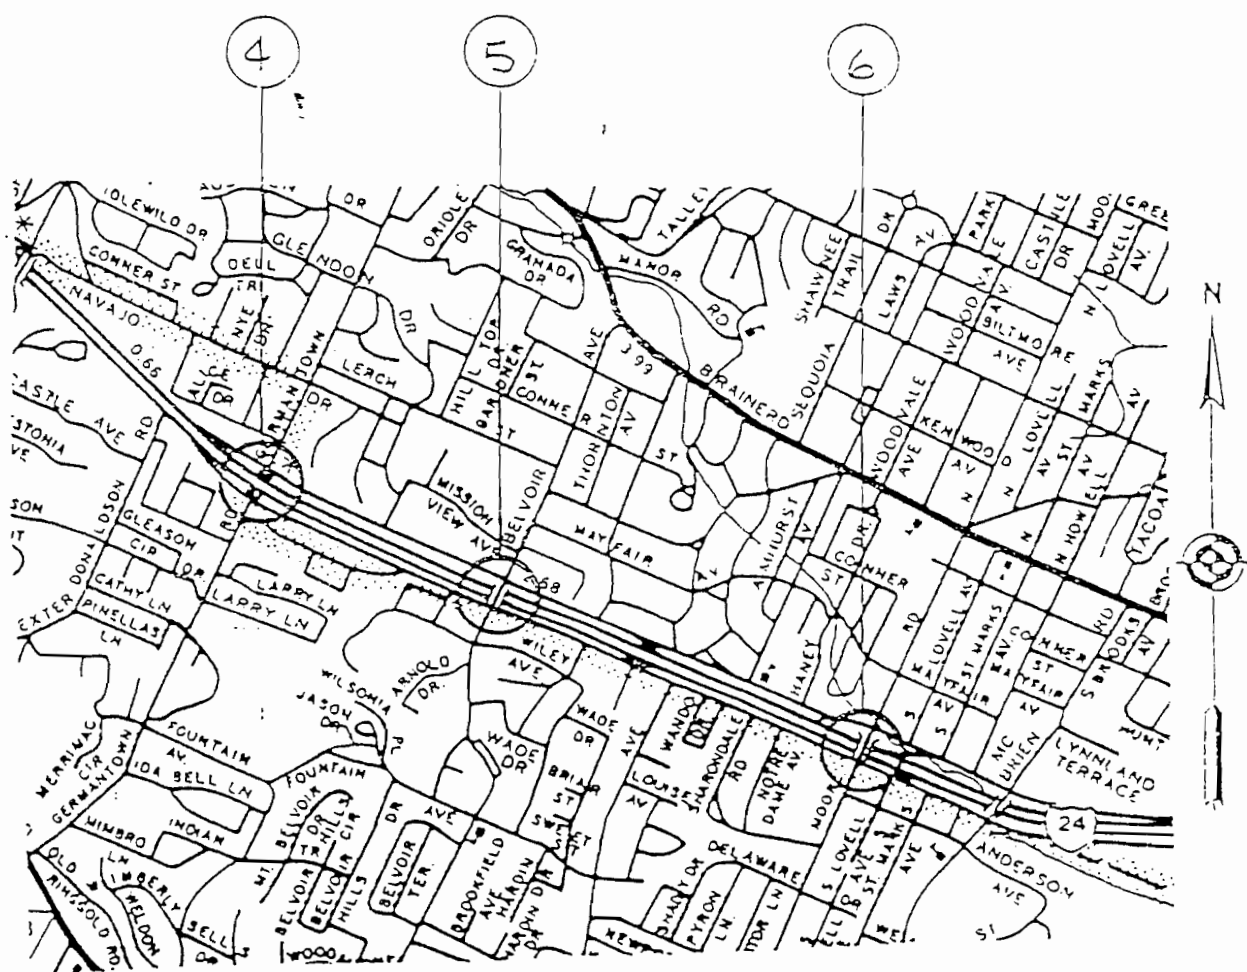

LOCATION SKETCH of BRIDGE
HAMILTON COUNTY

JOINT REPAIR QUANTITIES CONTINUED

HAMILTON COUNTY

BRIDGE NO.	NO. JOINTS	LENGTH	TOTAL LENGTH	BRIDGE LOCATION SHEET
33-I124-0.71(RL)	3	50'-8"	152'-0"	Sheet 24 of 36
33-I124-0.71(LL)	3	50'-8"	152'-0"	Sheet 24 of 36
33-I124-0.73 RAMP	2	29'-0"	58'-0"	Sheet 24 of 36
33-I24-12.08(RL)	3	51'-1"	154'-0"	Sheet 25 of 36
33-I24-12.08(LL)	3	51'-1"	154'-0"	Sheet 25 of 36
33-SR2-16.10	4	52'-6"	210'-0"	Sheet 26 of 36
33-SR27-5.60(RL)	4	37'-6"	150'-0"	Sheet 24 of 36
33-SR27-5.60(LL)	4	50'-3"	201'-0"	Sheet 24 of 36
33-SR29-11.04(RL)	2	74'-0"	148'-0"	Sheet 27 of 36
33-SR29-11.04(LL)	2	60'-0"	120'-0"	Sheet 27 of 36
33-SR320-0.86	1	38'-0"	38'-0"	Sheet 26 of 36
33-3578-0.80	5	79'-6"	398'-0"	Sheet 25 of 36
33-3611-1.01	5	79'-6"	398'-0"	Sheet 25 of 36

33I002A0059

GENERAL NOTES

CONSTRUCTION SPECIFICATIONS

Tennessee Department of Highways and Public Works Standard Specifications for Road and Bridge Construction.

DESIGN SPECIFICATIONS

AASHTO, 1957 Edition with H20-S16-44 Live Load. Also, Alternate Loading as per Sect. 4c of PPM 20-4 for Germantown Road Underpass only.
* 38 MARKED

MATERIALS

Concrete

All concrete except precast concrete piling and prestressed concrete beams shall be Class "A". Concrete for precast concrete piling shall be Class "S" with Class "A" aggregates. For concrete in prestressed beams see Special Provisions. For materials, forms, and finish, see Construction Specifications.

Reinforcing Steel

See Construction Specifications and Reinforcing Steel Schedules.

Prestressing Steel Cables

See Special Provisions.

Structural Steel

Except as noted below or shown elsewhere, all materials shall be carbon structural steel, ASTM-A7-56T. Bolts, nuts, and washers shall be ASTM-A7-56T or A307-55T. Nuts shall be self-locking "Stover", or approved equal.
Painting: Shop paint - one coat of red lead. Field paint - one coat of red lead paint-tinted and two coats of aluminum paint with first coat tinted. See Construction Specifications.

Bronze Alloy

See Special Provisions and H-2-11.

Piling

See Construction Specifications and H-5-III

Prefabricated Masonry Pad

See Special Provisions and F-10-84.

Sheet Packing

Two layers of Johns-Mansville Service Sheet Packing No. 60, 1/16" thick, or approved equal. Graphite surfaces to be in contact with each other.

Premolded Joint Filler

See Construction Specifications.

WELDING

All welding shall conform to the current "Standard Specifications for Welded Highway and Railway Bridges" of the American Welding Society.

HANDRAILING

SEE H-5-110 G-9-97, G-9-104
H-2-12 AND H-2-21.

ELECTRICAL LIGHTING

See G-9-97, G-9-104, H-2-12, H-2-21 and G-7-5.

BITUMINOUS SURFACING

See Construction Specifications.

CAMBER

Concrete T-Beams shall be cambered for the dead load deflection as follows:

Camber for DL Deflection of Center of Span


Spans
37'-----3/8"
46'-----5/8"

Sufficient camber shall be provided in the falsework and forms for each span to allow the closing up of joints in the forms and supporting falsework.

ESTIMATED QUANTITIES

ITEM NO.	17-2	17-4	104-1	104-2	104-3	105-1	105-2	105-3	132-1	135-4	135-12	137-3	139-1	139-3	154-1	154-1A	154-1B	154-1C	154-1D	154-1E	154-1F	704	702	501
	ITEM	Dry Excav. *	Rock Excav.	A.C.S.C.			S.A. or S.A.S.C. **			Struct. Steel ***	Class "A" Concrete †	Reinf. Steel	10BP42 Steel H-Piling ††	Precast Concrete Piling †††			Precast - Prestressed Concrete Beams ⊕						CONCRETE Handrail ⊕⊕	2-Rail Steel Handrail ⊕⊕
STRUCTURE	C.Y.	C.Y.	Tons	Tons	Tons	Tons	Tons	Tons	Lbs.	C.Y.	Lbs.	L.F.	L.F.	L.F.	Each	Each	Each	Each	Each	Each	Each	L.F.	L.F.	Lump Sum
GERMANTOWN ROAD UNDERPASS	439								6,860	1,300.9	292,307		400	4,900								332	332	Lump Sum
BELVOIR AVENUE OVERPASS	681	4	134.6	9.3	0.7	134.6	9.3	0.7		526.2	86,952		320	5,155		52	26					26	381	Lump Sum
SOUTH MOORE ROAD OVERPASS	597	9	122.8	8.6	0.6	122.8	8.6	0.6		486.1	83,842	1,891				52							349	Lump Sum
McBRIEN ROAD OVERPASS	294	2	135.2	9.4	0.6	135.2	9.4	0.6		562.7	89,816	2,302			52			26	26				384	Lump Sum
TOTALS	2,011	15	392.6	27.3	1.9	392.6	27.3	1.9	6,860	2,875.9	552,917	4,193	720	10,055	52	104	26	26	26	52	26	1,446	332	Lump Sum

- * All earth excavation shall be measured and paid for as dry excavation only.
- ** S.A. or S.A.S.C. may be used as alternates for A.C.S.C. bituminous surface materials.
- *** Includes bronze alloy plates in bearings and anchor bolts for bearings.
- † Cost of all embedded material such as joint fillers, drains, sheet piling, etc. shall be included in the unit price of Class "A" concrete. *Unless otherwise provided for in the Special Provisions.
- †† No alternates may be used for the steel H-piling in the S. Moore Road and McBrien Rd. Overpasses.
- ††† No alternates may be used for the precast concrete piling in the Germantown Rd. Underpass, but may be used in the bents only on the Belvoir Ave. Overpass. If it becomes necessary to use Size 2 piles, the Contractor will be allowed an increase of 25% in his Size 1 bid price.
- ⊕ Prestressed concrete members complete in place with tie-rods, dowels (and drilling for dowels), bearing pads, etc.; but not including concrete sidewalks. Quantities for the sidewalks on the prestressed beam bridges are included in Item Nos. 135-4 and 135-12.
- ⊕⊕⊕ Lump sum for lighting complete shall include furnishing and placing all conduits, junction boxes, anchor bolts for light standards, and all other accessories necessary to complete this item.

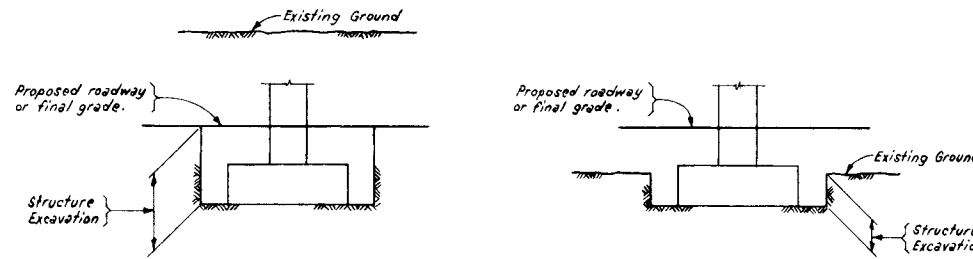

EXCAVATION DETAILS
NO SCALE

LIST OF DRAWINGS

DRAWING NO.	TITLE
G-9-90	General Notes and Specifications
G-7-5	Standard Electrical Lighting Details
H-5-110	Handrailing Details, TELEPHONE CONDUITS IN SIDEWALKS
H-2-247	
H-5-111	Standard Pile Details
F-10-84	Standard Prestressed Concrete Bridge-Pretensioned
F-10-85 & E-10-B5A	Standard Prestressed Concrete Bridge-Pretensioned
G-9-91 to G-9-98	South Moore Road Overpass
G-9-99 to G-9-105	McBrien Road Overpass
H-2-1 to H-2-14	Germantown Road Underpass
H-2-15 to H-2-22	Belvoir Avenue Overpass


STATE OF TENNESSEE
DEPARTMENT OF HIGHWAYS AND PUBLIC WORKS
CHATTANOOGA FREEWAY
HAMILTON COUNTY-F.A. PROJ. NO. 2-24-3 ()

GENERAL NOTES AND SPECIFICATIONS

SULLIVAN & HOEBEL - CONSULTING ENGINEERS - KNOXVILLE, TENN.			
AAKE F. HEDMAN - CONSULTING ENGINEERS - CHATTANOOGA, TENN.			
DSGN:	DRWN: AB:JP	SCALE: NONE	DATE: 4-2-59
CHKD:	CHKD: AC	FILE NO. 57.77	SHEET NO. G-9-90
	SUPV: TMS		

REVISED 11-9-60
 Revised April 1960
 Changed handrailing to concrete handrailing
 Changed handrailing to steel handrailing
 Reduced number of lighting standards
 Increased vertical clearance to 16'-6" minimum

FED. ROAD DIST. NO.	STATE	FED. AID PROJ. NO.	STATE AID PROJ. NO.	FISCAL YEAR	SHEET NO.	TOTAL SHEETS
3	TENN.	I-24-3(11)	128		112	200
FED. ROAD DIST. NO.	STATE	FED. AID PROJ. NO.	STATE AID PROJ. NO.	FISCAL YEAR	SHEET NO.	TOTAL SHEETS
3	TENN.	I-24-3(29)128		65	10	18

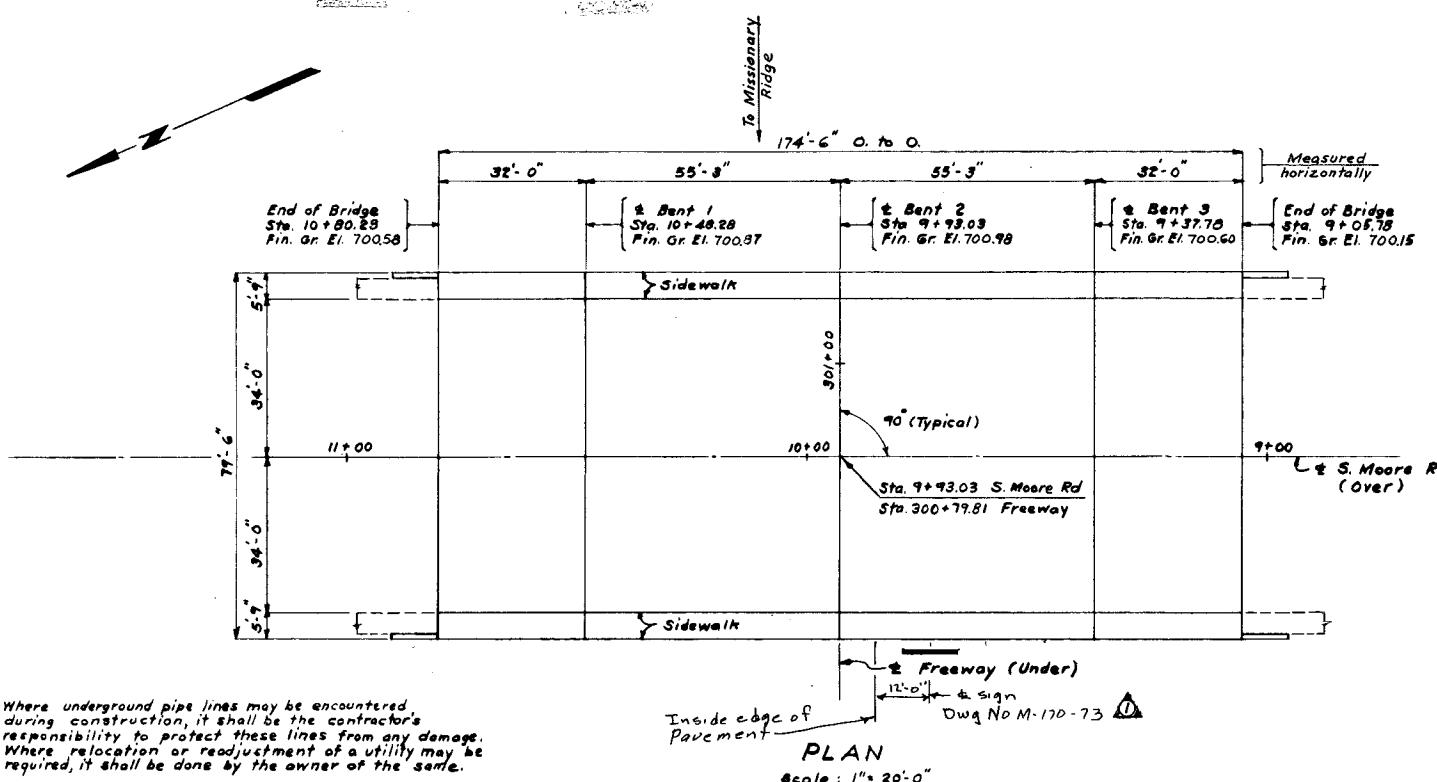


Where underground pipe lines may be encountered during construction, it shall be the contractor's responsibility to protect these lines from any damage. Where relocation or readjustment of a utility may be required, it shall be done by the owner of the same.


PLAN
Scale: 1" = 20'-0"

ITEM NO.	ESTIMATED QUANTITIES															
	17-2	17-4	17-5	104-1	104-2	104-3	105-1	105-2	105-3	135-4	135-12	137-3	154-1A	154-1E	501	704
ITEM	Dry Exc.	Rock Exc.	Rock Drilling	Mineral Agg.	Asphalt Cement	Tack Coat	S. A. or S.A.S.C. Mineral Agg.	Asphalt Cement	Tack Coat	Class 'A' Conc.	Reinf. Steel	10 BP42 Steel H-Piling	Prest. Beams 87'x3'-0" 55'-2"	17'x3'-0" 31'-11 1/2"	Lighting Complete	Concrete Handrail
STRUCT.	C. Y.	C. Y.	L. F.	Ton	Ton	Ton	Ton	Ton	Ton	C. Y.	Lbs.	L. F.	Each	Each	Lump Sum	L. F.
N. Abut.	37									36.6	3,990					
Bent 1	171	3								117.5	24,636					
Bent 2	129									125.0	22,885					
Bent 3	223	6								97.2	24,481					
S. Abut.	37									36.6	3,990					
Span 1				22.5	1.6	0.1	22.5	1.6	0.1	13.4	670			26		
Span 2				38.9	2.7	0.2	38.9	2.7	0.2	23.2	1,260			26		
Span 3				38.9	2.7	0.2	38.9	2.7	0.2	23.2	1,260			26		
Span 4				22.5	1.6	0.1	22.5	1.6	0.1	13.4	670			26		
Total	597	9	None	122.8	8.6	0.6	122.8	8.6	0.6	486.1	83,842	1,891	52	52	Lump Sum	349'

HANDRAIL NOTE:
Build handrail according to the Dwg. H-5-110 except use end post as shown on Dwg. G-9-93. Dimensions L=6'-10 7/8" (-). See also details on G-9-97.

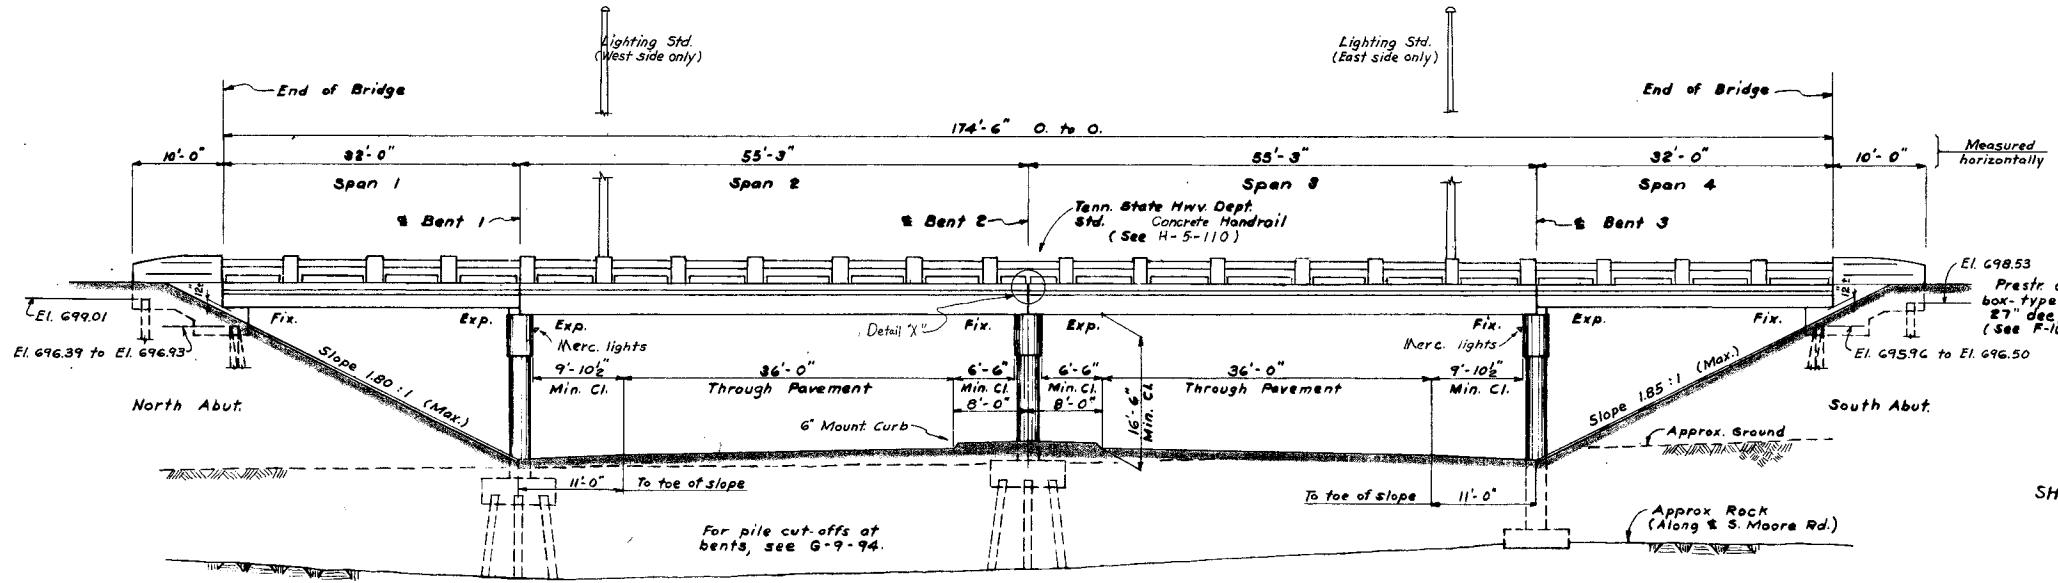


ELEVATION
Scale: 1" = 10'-0"

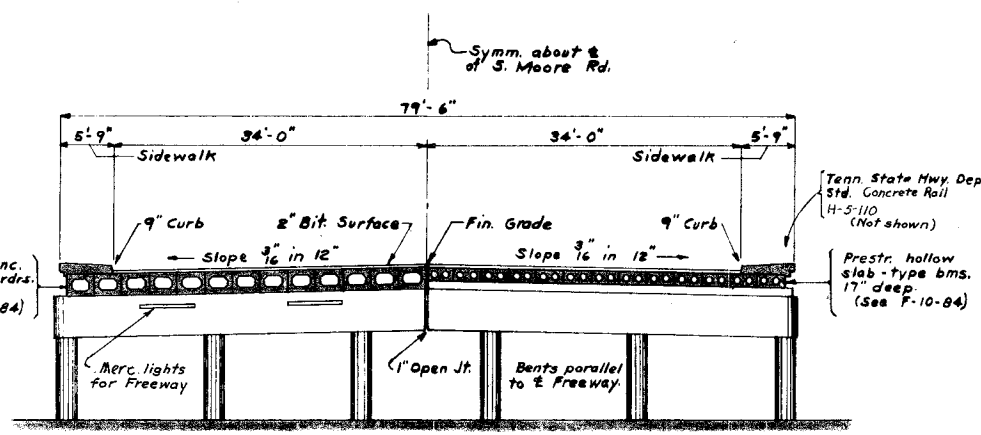


TYPICAL CROSS SECTION
LOOKING NORTH
Scale: 1" = 10'-0"

End fills for abutments shall be in place, thoroughly compacted before piles are driven.

Note: Elevs. shown are to pile cut-offs.

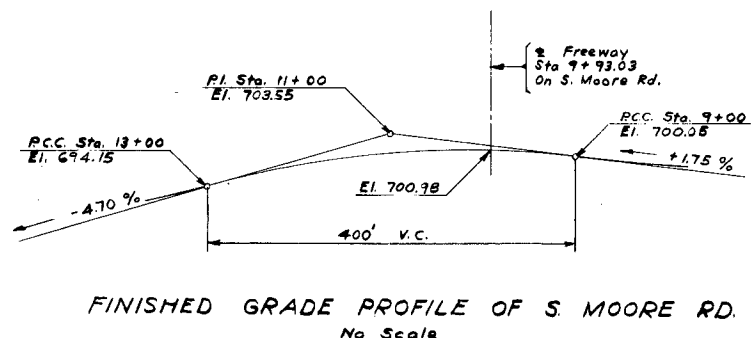

FINISHED GRADE PROFILE OF S. MOORE RD.
No Scale

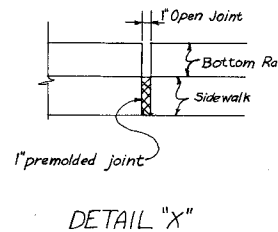

DETAIL "X"

Drawing No.	Title
G-9-91	General Drawing
G-9-92	Sounding Data
G-9-93	Abutments
G-9-94	Bents - Column and Footing Details
G-9-95	Bents
G-9-96	Typical Cross Section and Sidewalk
G-9-97	Lighting, Handrailing and Drains
G-9-98	Reinforcing Steel
H-5-110*	Handrail
H-5-111	Piles

* See Note This Sheet.

NOTES:
For General Notes and Specifications, see G-9-90. For handrailing and lighting details, see G-9-97 and G-7-5.


BRIDGE NO. 33100240059

One 68' roadway with two 4'-6" sidewalks.
STATE OF TENNESSEE
DEPARTMENT OF HIGHWAYS AND PUBLIC WORKS
CHATTANOOGA FREEWAY
HAMILTON COUNTY-F.A. PROJ. NO. I-24-3 (-)

SOUTH MOORE ROAD OVERPASS GENERAL DRAWING

SULLIVAN & HOEBEL - CONSULTING ENGINEERS - KNOXVILLE, TENN.			
AAKE F. HEDMAN - CONSULTING ENGINEERS - CHATTANOOGA, TENN.			
DSGN: AC	DRWN: AC	SCALE: AS NOTED	DATE: 10-8-58
CHKD: TMS	SUPV: TMS	FILE NO. 57.77	SHEET NO. G-9-91

Revised July 1965 Replaced number of metric lights.
 Revised July 1965 Changed fluorescent luminaires to inc.
 Revised Oct. 1960 Changed handrailing to concrete handrailing.
 Revised April 1960 Changed handrailing to steel handrailing.
 Revised April 1960 Reduced number of lighting standards.
 Revised April 1960 Increased vertical clearance to 16'-6".

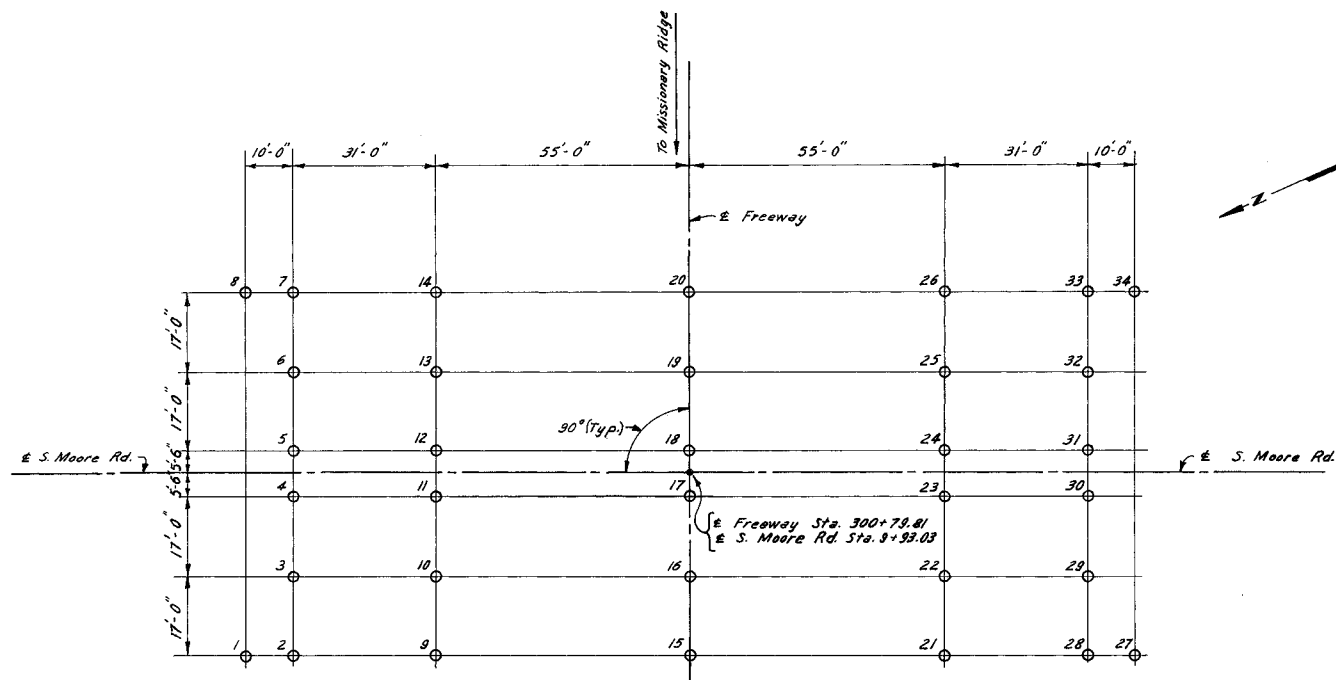

SOUNDING PLAN
(NOT TO SCALE)


Hole No.	Ground Elev.	Rock Elev.
1	679.4	668.4
2	679.3	668.3
3	679.5	666.5
4	679.5	667.5
5	679.3	667.3
6	679.3	669.3
7	677.9	670.9
8	677.9	669.9
9	678.1	666.1
10	679.7	669.7
11	679.7	665.7
12	679.5	668.5
13	678.4	668.4
14	677.6	670.6
15	678.5	667.5
16	680.5	667.5
17	680.5	667.5
18	680.2	669.2
19	679.6	666.6
20	678.4	668.4
21	679.2	670.2
22	681.8	670.8
23	681.8	670.8
24	681.7	671.7
25	680.9	667.9
26	680.8	666.8
27	682.2	671.2
28	*	*
29	682.7	671.7
30	682.9	669.9
31	682.7	669.7
32	682.6	671.6
33	681.0	668.0
34	681.1	667.1

* Not Drilled

SOUNDING DATA

SOUTH MOORE ROAD OVERPASS

BRIDGE NO. 33I00240059

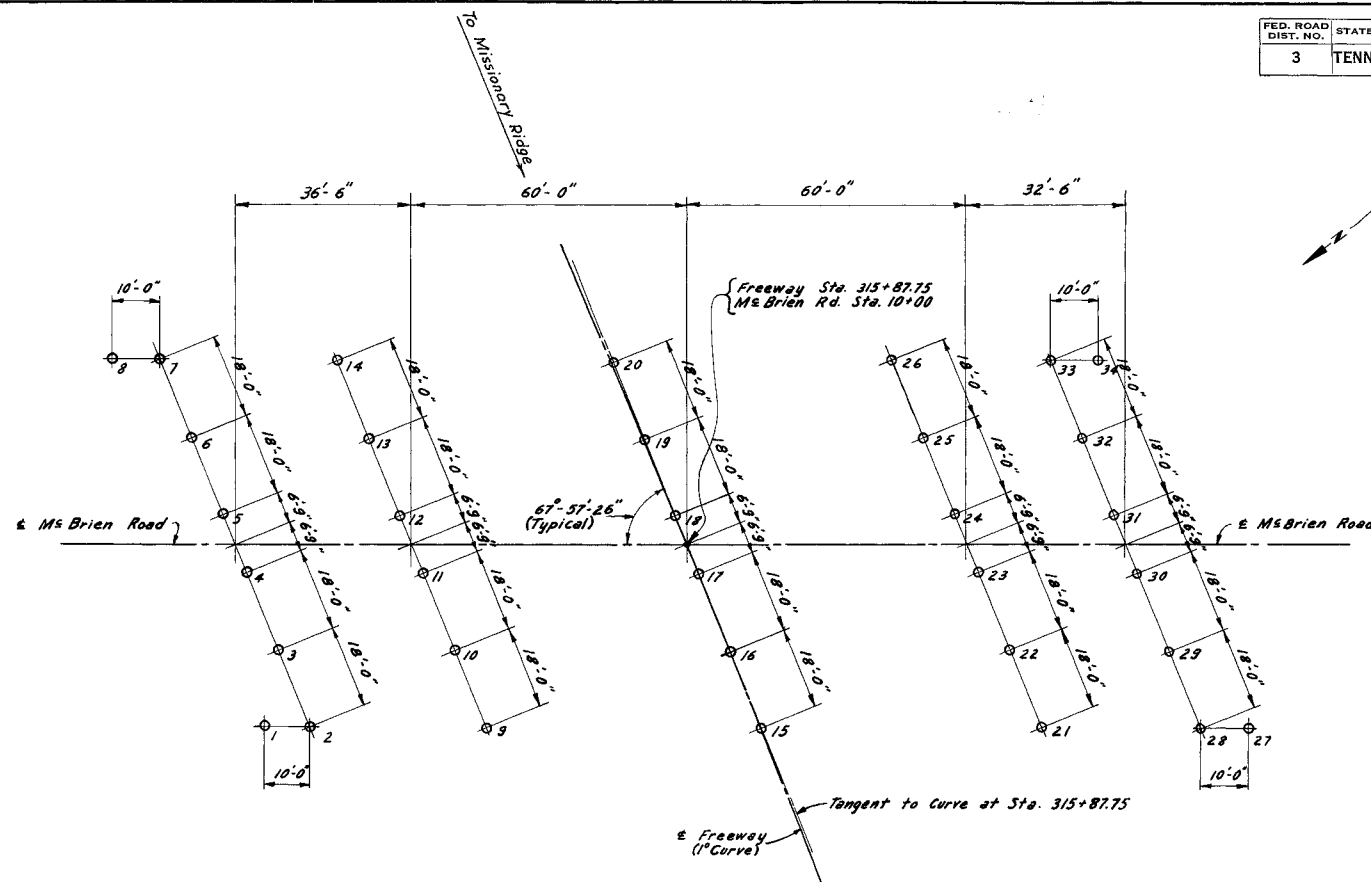

SOUNDING PLAN
(NOT TO SCALE)

Hole No.	Ground Elev.	Rock Elev.
1	675.1	668.1
2	674.5	667.5
3	676.0	668.0
4	676.5	666.5
5	676.7	667.7
6	676.9	666.9
7	677.0	669.0
8	677.5	668.5
9	673.6	666.6
10	674.5	667.5
11	675.7	665.7
12	675.8	664.8
13	675.0	664.0
14	675.7	665.7
15	672.8	666.8
16	673.1	666.1
17	674.4	665.4
18	674.5	665.5
19	673.5	664.5
20	673.6	665.6
21	672.8	665.8
22	672.9	664.9
23	674.1	665.1
24	674.2	665.2
25	672.4	665.4
26	671.8	663.8
27	672.8	664.8
28	672.9	664.9
29	673.0	666.0
30	674.1	665.1
31	674.3	665.3
32	671.9	664.9
33	671.6	664.6
34	671.5	664.5

SOUNDING DATA

MCBRIEN ROAD OVERPASS

BRIDGE NO. 33I00240061




STATE OF TENNESSEE
DEPARTMENT OF HIGHWAYS AND PUBLIC WORKS
CHATTANOOGA FREEWAY
HAMILTON COUNTY-F.A. PROJ. NO. I-24-3()

SOUTH MOORE RD. & MCBRIEN RD. OVERPASSES
SOUNDING DATA

SULLIVAN & HOEBEL - CONSULTING ENGINEERS - KNOXVILLE, TENN.





AAKE F. HEDMAN - CONSULTING ENGINEERS - CHATTANOOGA, TENN.

DSGN:	DRWN: RLF	SCALE: AS NOTED	DATE: 10-8-58
CHKD:	CHKD: TMS	FILE NO. 57.77	SHEET NO. G-9-92
	SUPV: TMS		

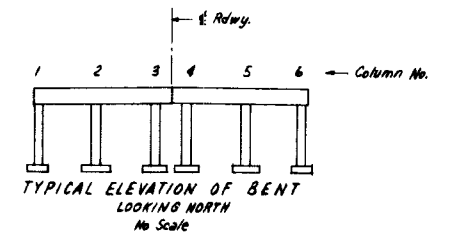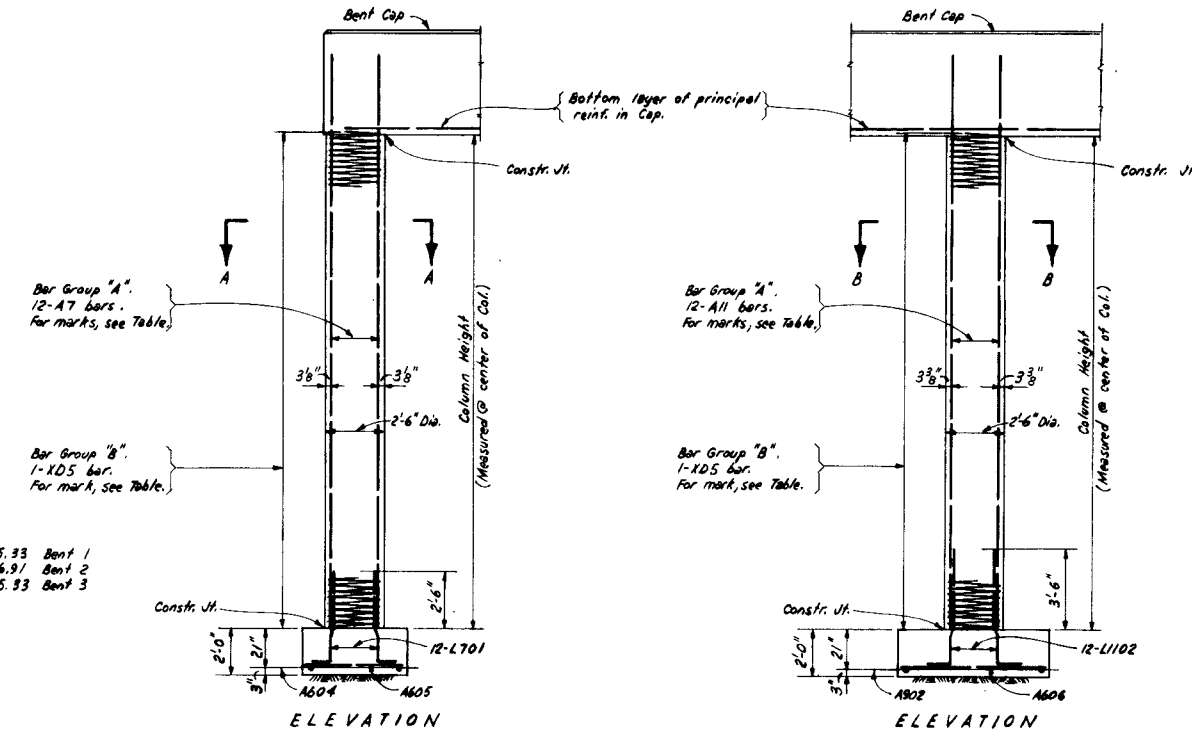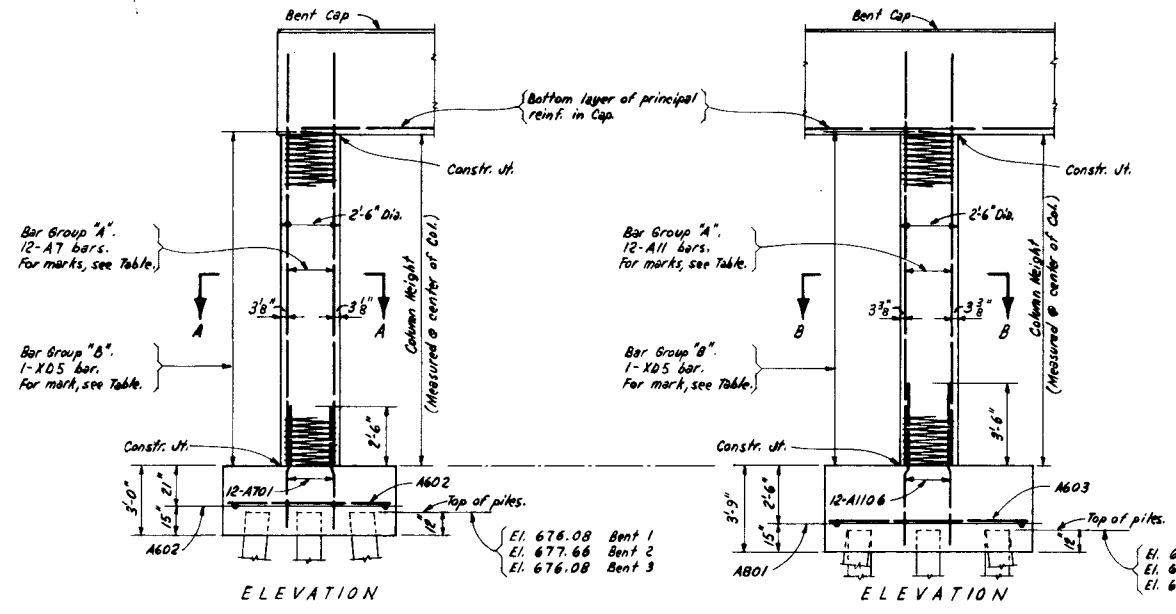

COLUMN AND FOOTING DATA					
Bent & Column	Column Height	Elev. Top Ftg.	Type	Rein. Steel Group A	Rein. Steel Group B
Bent 1					
Col. 1	15'-2 1/2"	678.08	Piles	A702	XD501
Col. 2	22'-4"	671.23	Rock	A1107	XD502
Col. 3	15'-9 1/2"	678.08	Piles	A1108	XD503
Col. 4	15'-9 1/2"	678.08	Piles	A1108	XD503
Col. 5	15'-5 1/2"	678.08	Piles	A1109	XD504
Col. 6	21'-2"	672.12	Rock	A703	XD505
Bent 2					
Col. 1	13'-8 1/2"	679.66	Piles	A704	XD506
Col. 2	14'-0 1/2"	679.66	Piles	A1110	XD507
Col. 3	14'-3 1/2"	679.66	Piles	A1111	XD508
Col. 4	14'-3 1/2"	679.66	Piles	A1111	XD508
Col. 5	14'-0 1/2"	679.66	Piles	A1110	XD507
Col. 6	13'-8 1/2"	679.66	Piles	A704	XD506
Bent 3					
Col. 1	21'-4"	671.69	Rock	A703	XD509
Col. 2	21'-0"	672.29	Rock	A1112	XD510
Col. 3	21'-3"	672.32	Rock	A1113	XD509
Col. 4	20'-4"	673.24	Rock	A1114	XD511
Col. 5	15'-2 1/2"	678.08	Piles	A1115	XD501
Col. 6	14'-11 1/4"	678.08	Piles	A705	XD512

* The assumed type of footing is based upon the sounding data. See also note left of title block.

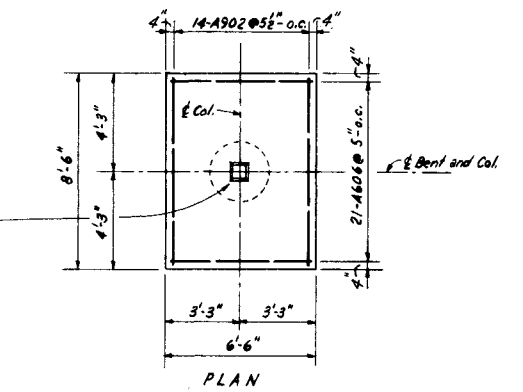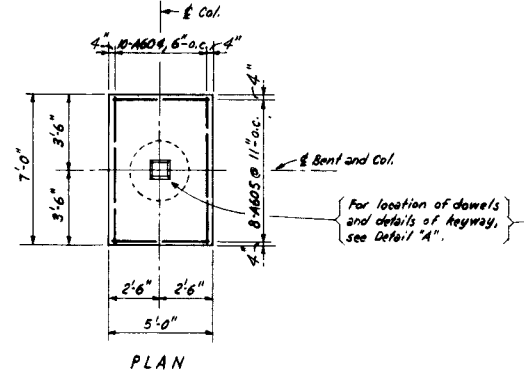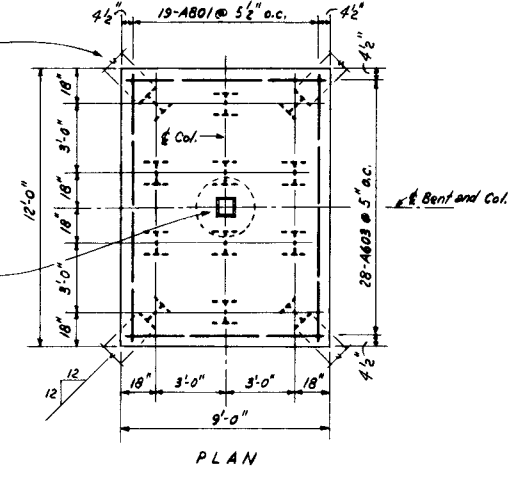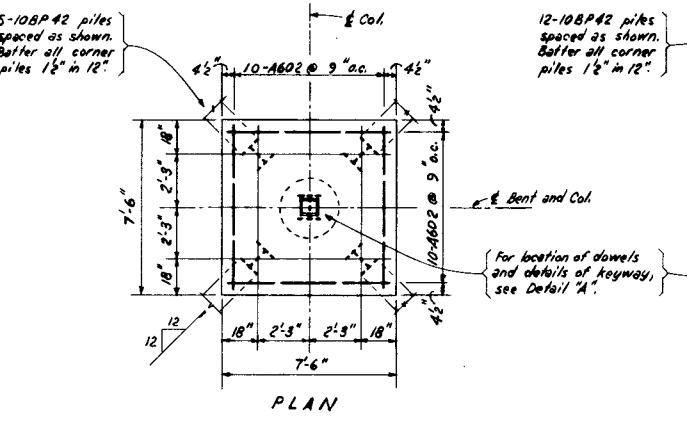

EXTERIOR COLUMNS & FOOTINGS (Col. & Ftg. 1 and 6)

INTERIOR COLUMNS & FOOTINGS (Col. & Ftg. 2, 3, 4, and 5)

EXTERIOR COLUMNS & FOOTINGS (Col. & Ftg. 1 and 6)

INTERIOR COLUMNS & FOOTINGS (Col. & Ftg. 2, 3, 4, and 5)




DETAILS FOR FOOTINGS ON PILES Scale: 1/4" = 1'-0"

DETAILS FOR FOOTINGS ON ROCK Scale: 1/4" = 1'-0"

Maximum design bearing pressure = 12,000 pounds per sq. foot.

NOTE: All footings shall extend into rock a minimum of 6 inches.

NOTES:
 For General Notes and Specifications, see G-9-90.
 For lighting details, see G-9-97.
 For details of piles, see H-5-111.
 For reinforcing steel and bending diagrams, see G-9-98.
 All dimensions relative to spacing of reinforcing steel are to centers of bars, except as noted.
 Chamfer all exposed edges 3/8", except as noted.
 Marks to all reinforcing steel in Bents shall have suffix "B", (thus: A1101-B, T501-B, etc.).
 All piles shall be driven to refusal on rock or a minimum bearing of 28 Tons.

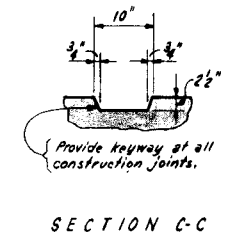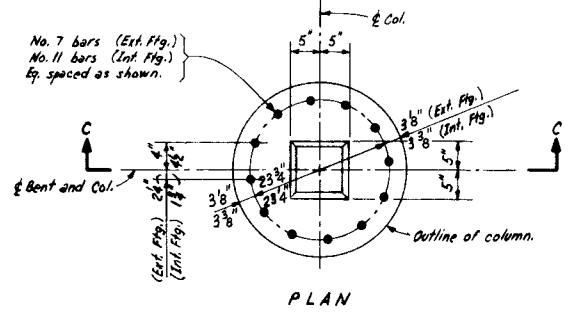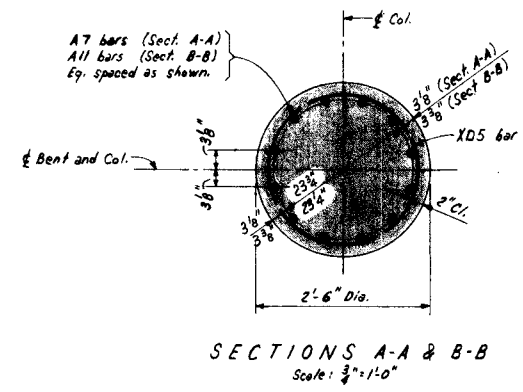

Exceptional care shall be exercised in placing length column reinf. to avoid possible interference with principal reinf. in bent cap.

The type of footings shown for the various columns is based on the available sounding data. Excavation for the footings for the bents shall first be carried to the elevations shown for pile cut-offs. Then, additional soundings shall be made in the field at the pile locations shown on the pile footing, to determine accurately the rock elevation at each footing. From the results obtained, the Engineer shall decide whether to use a pile footing or a footing on rock. Cost of soundings shall be included in cost of items bid.

STATE OF TENNESSEE
 DEPARTMENT OF HIGHWAYS AND PUBLIC WORKS
 CHATTANOOGA FREEWAY
 HAMILTON COUNTY-F.A. PROJ. NO I-24-3 ()

**SOUTH MOORE ROAD OVERPASS
 BENTS-COLUMN AND FOOTING DETAILS**

SULLIVAN & HOEBEL - CONSULTING ENGINEERS - KNOXVILLE, TENN.
 AAKE F. HEDMAN - CONSULTING ENGINEERS - CHATTANOOGA, TENN.

DSGN: JRP
 CHKD: TMS

DRWN: JRP
 SUPY: TMS

SCALE: AS NOTED
 FILE NO. 57.77 SHEET NO.



DATE: 10-8-58
 G-9-94

Revised April 1960 Increased vertical clearance to 16'-6".



FED. ROAD DIST. NO.	STATE	FED. AID PROJ. NO.	STATE AID PROJ. NO.	FISCAL YEAR	SHEET NO.	TOTAL SHEETS
3	TENN.	1-24-3(1)	128		117	204

Location	Concrete Cu. Yds.	Reinforcing Steel Lbs. #	Prestressing Steel Lbs.
Span 1	97.4	5,519	5,015
Span 2	201.0	17,835	18,593
Span 3	201.0	17,835	18,593
Span 4	97.4	5,519	5,015
Total	596.8	46,828	38,220

* Includes only reinf. embedded in the prestressed beams.

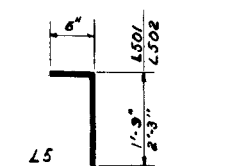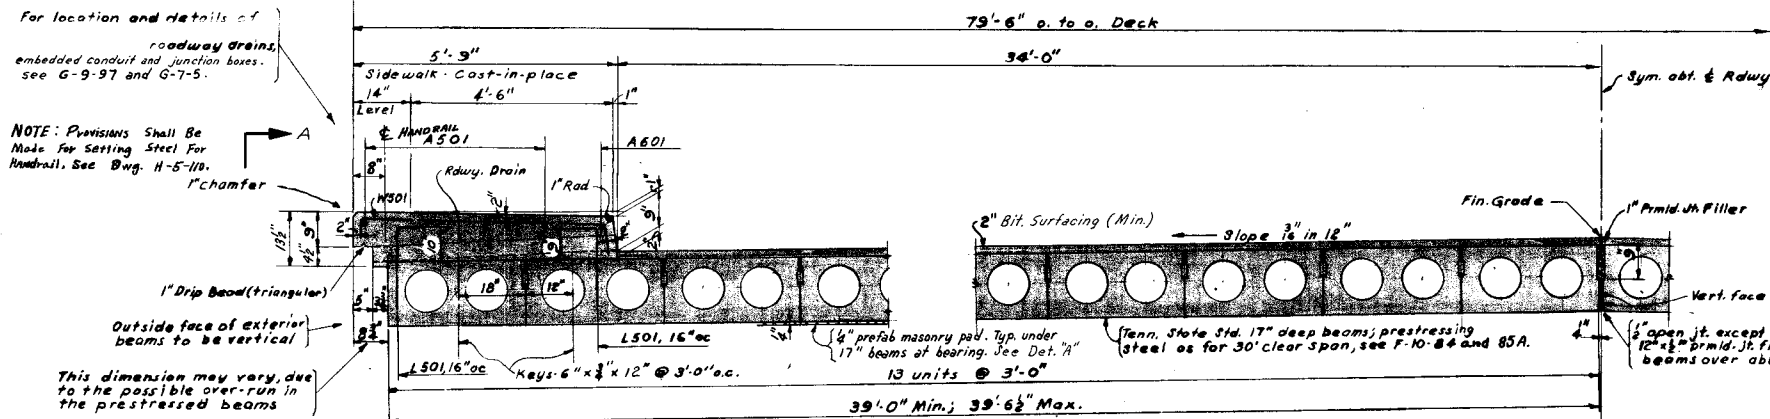


BENDING DIAGRAM
No Scale
These reinf. bars to be included with prestressed beams.

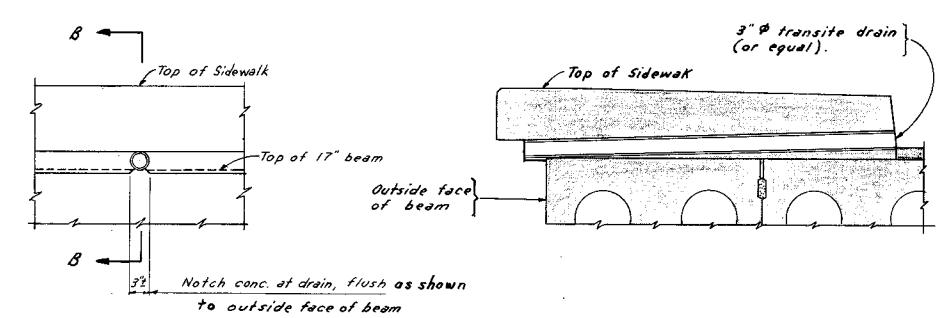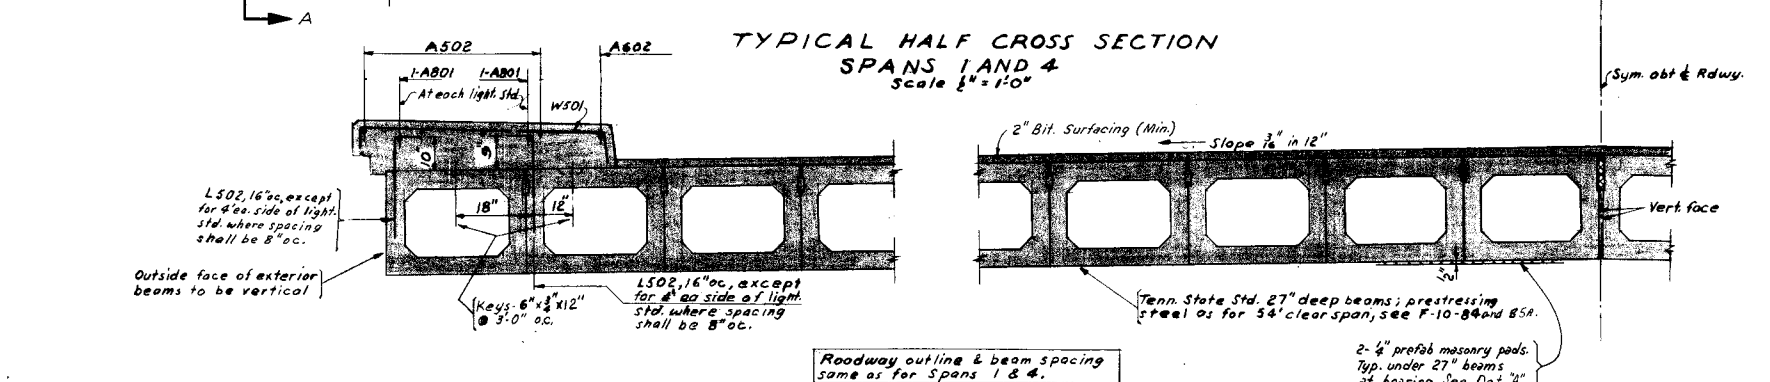


ELEVATION A-A

SECT. ELEVATION B-B

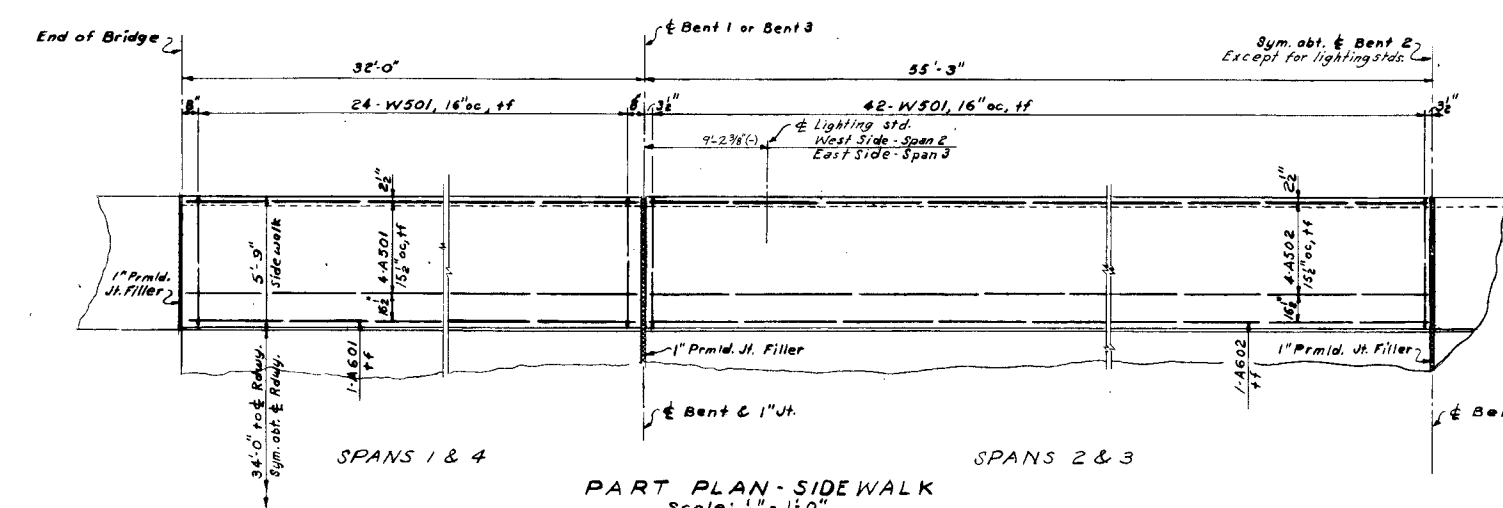

PART PLAN - SIDEWALK
Scale: 1/4" = 1'-0"

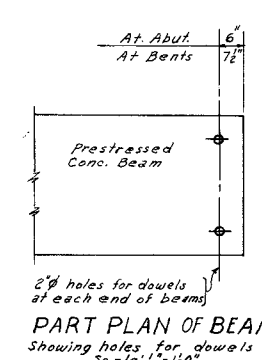


PART PLAN OF BEAM
Showing holes for dowels
Scale: 1/4" = 1'-0"


DRAIN DETAIL
Scale: 3/4" = 1'-0"

Abbreviations:
t.f. top face

NOTES:
For General Notes and Specifications, see G-9-90.
For Span arrangement and Profile of Finish Grade, see G-9-91.
All beams shall be in accordance with the Tenn. State Highway Dept's standard drawings F-10-84, 85 and 85A and the Special Provision by that Dept, except as shown and noted on this drawing.
All beams shall be standard precast prestressed concrete girders, box type or hollow slab, type as indicated and noted. All beams shall be 3'-0" wide (3'-6" max.).
For reinforcing steel and bending diagrams of bars for sidewalk, see G-9-98.
All dimensions relative to spacing of reinforcing bars shall be to center of bars.
All reinforcing steel shown embedded in the prestressed concrete beams to be furnished with these beams, and the cost of this reinf. steel shall be included in the contract unit price per beam.
The outside faces of exterior beams in all spans shall line up. Marks to all reinforcing steel in the Deck shall have suffix "D", (thus A501-D, W501-D, etc.).
Chamfer all exposed edges of sidewalk 1/2", except as noted.

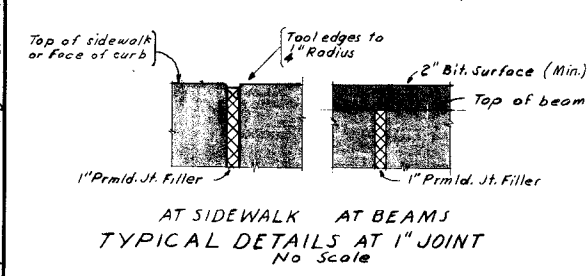

AT SIDEWALK AT BEAMS
TYPICAL DETAILS AT 1" JOINT
No Scale

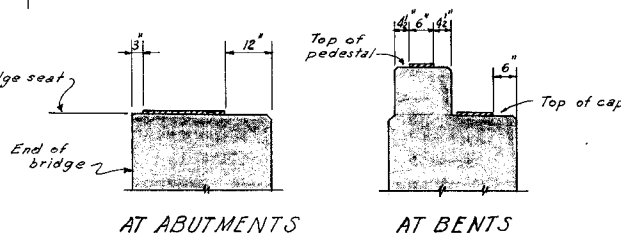



DETAIL "A"
Showing location of precast masonry pad
Scale: 1/4" = 1'-0"

STATE OF TENNESSEE
DEPARTMENT OF HIGHWAYS AND PUBLIC WORKS
GHATTANOOGA FREEWAY
HAMILTON COUNTY-F.A. PROJ. NO. 1-24-3 ()
**SOUTH MOORE ROAD OVERPASS
TYPICAL CROSS SECTION AND SIDEWALK**

SULLIVAN & HOEBEL - CONSULTING ENGINEERS - KNOXVILLE, TENN.
AAKE F. HEDMAN - CONSULTING ENGINEERS - CHATTANOOGA, TENN.
DSGN: TMS
CHKD: AC
DRWN: TMS
CHKD: AC
SCALE: AS NOTED
FILE NO. 57.77
DATE: 10-8-58
SHEET NO.
G-9-96



Revised Oct. 1960 Changed handdriving to concrete handdriving
Revised April 1960 Reduced number of lighting standards.
Revised April 1960 Changed handdriving to steel handdriving.

FED. ROAD DIST. NO.	STATE	FED. AID PROJ. NO.	STATE AID PROJ. NO.	FISCAL YEAR	SHEET NO.	TOTAL SHEETS
3	TENN.	I-24-3(1)	128	1965	117A	200
FED. ROAD DIST. NO.	T	FEDERAL AID PROJECT NO.	FISCAL YEAR	SHEET NO.	TOTAL SHEETS	
3	N	I-24-3(20)	128	1965	11	18

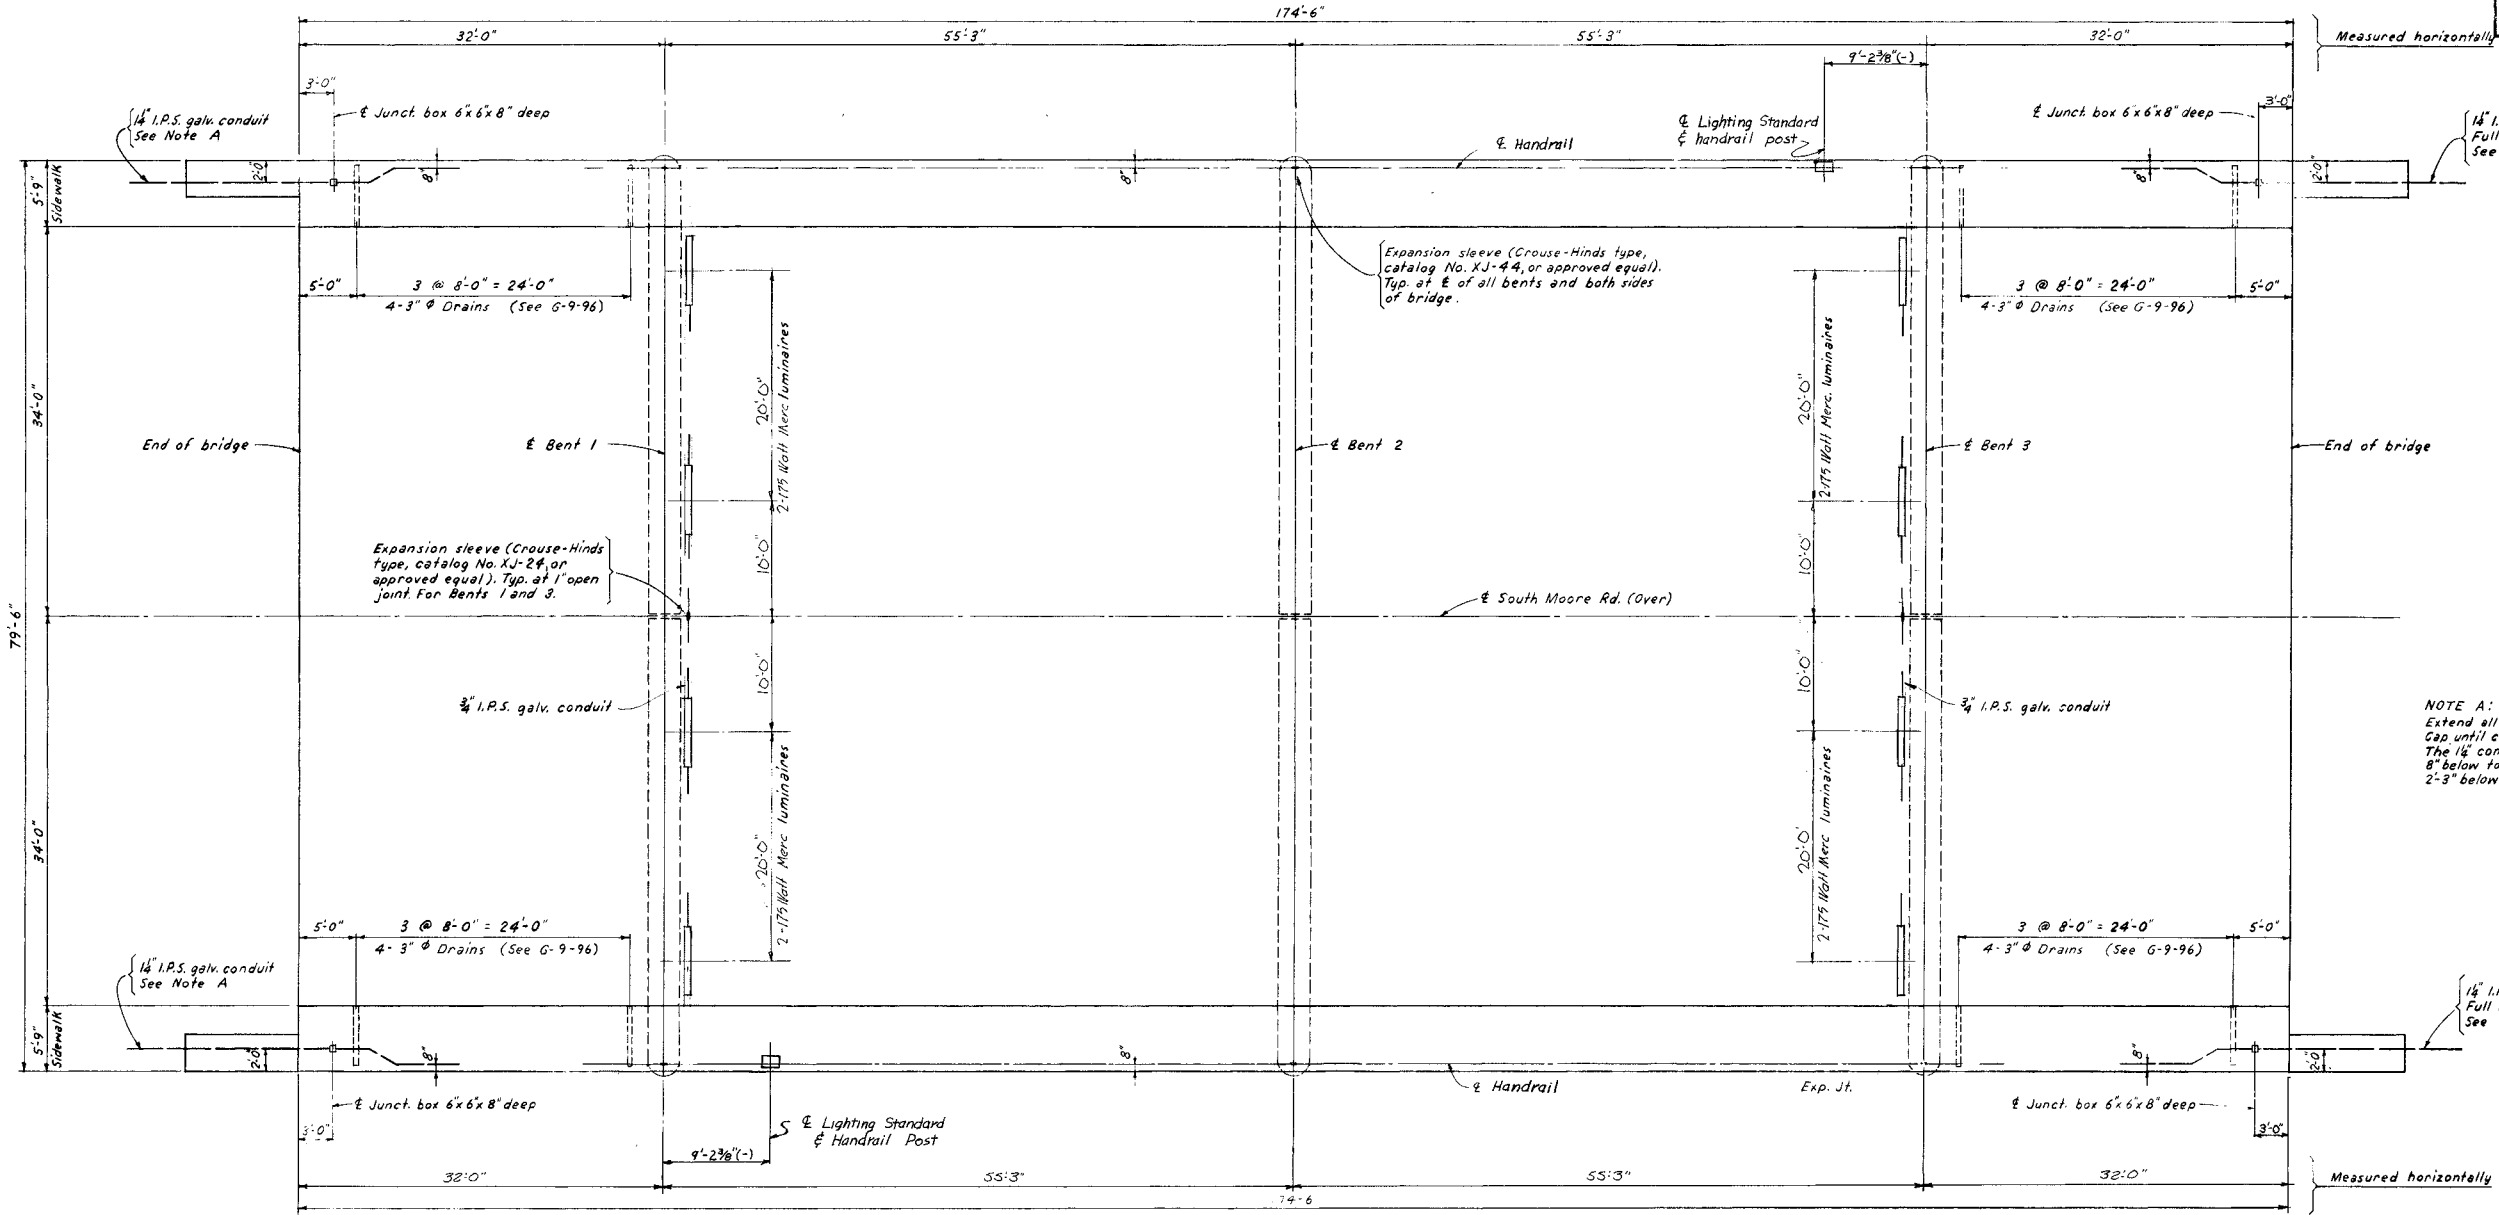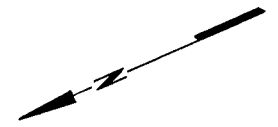

NOTE A:
 Extend all 1/4" conduit about 5' beyond end of wingwall. Cap until connections are made by others. The 1/4" conduit shall be dropped in elevation from 8" below top of sidewalk at end of bridge to about 2'-3" below top of sidewalk at end of wingwall.

PLAN
 Scale: 1/8" = 1'-0"

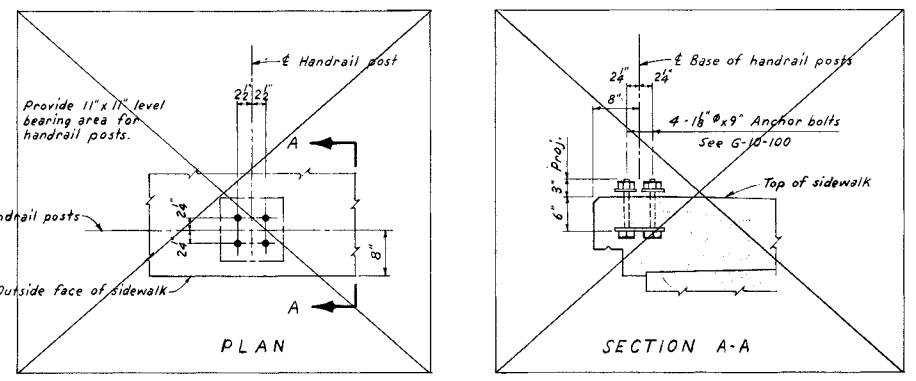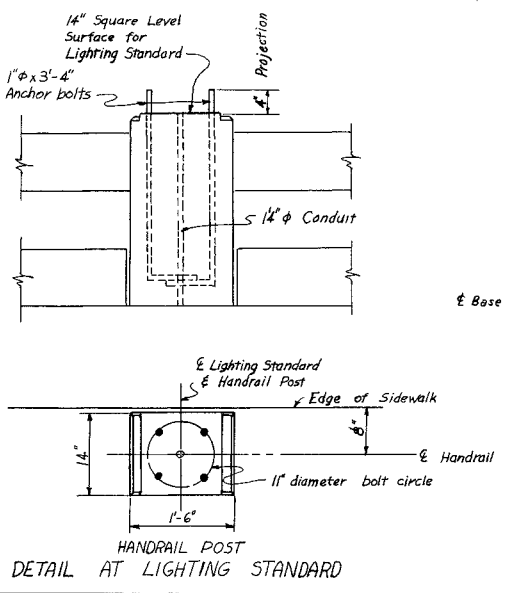

DETAILS AT HANDBRAIL POSTS
 Scale: 3/8" = 1'-0"

NOTES:
 For General Notes and Specifications, see G-9-90.
 For Standard Electrical Lighting details, see G-7-5
 For Handrailing details, see H-5-110.
 Location of fluorescent lights, junction boxes and drains may be shifted slightly so as to avoid interference with reinforcing steel.
 For Telephone Conduits in Sidewalks, see K-2-247

STATE OF TENNESSEE
 DEPARTMENT OF HIGHWAYS AND PUBLIC WORKS
 CHATTANOOGA FREEWAY
 HAMILTON COUNTY-F.A. PROJ. NO. I-24-3 ()

**SOUTH MOORE ROAD OVERPASS
 LIGHTING, HANDBRAILING AND DRAINS**

SULLIVAN & HOEBEL - CONSULTING ENGINEERS - KNOXVILLE, TENN.
 AAKE F. HEDMAN - CONSULTING ENGINEERS - CHATTANOOGA, TENN.


DSGN: FAM DRWN: WRA SCALE: AS NOTED DATE: 4-4-60
 CHKD: AC SUPV: TMS FILE NO. 57.77 SHEET NO. G-9-97

Revised July 1965. Reduced number of mercury lights
 Revised July 1965. Changed fluorescent luminaires to Merc
 Revised 5-1-61. Telephone conduits added.
 Revised Oct. 1960. Changed handrailing to concrete handrailing
 Redrawn April 1960. Reduced number of lighting standards.
 Changed handrailing to steel handrailing.

FED. ROAD DIST. NO.	STATE	FED. AID PROJ. NO.	STATE AID PROJ. NO.	FISCAL YEAR	SHEET NO.	TOTAL SHEETS
3	TENN.	123	(#)	1960	81A	82

U-027-2(9)


Note:
All lighting standards shall be vertical.

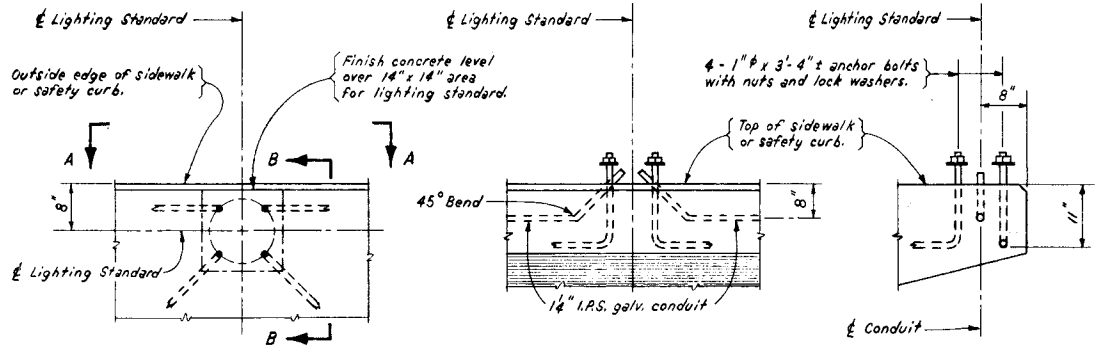


CONCRETE T-BEAM AND STEEL BEAM BRIDGES

Note:
For location of fluorescent luminaires, see drawing "Lighting, Handrailing and Drains."

Fluorescent luminaires and circuit breakers shall be fastened with cinch anchors, or as approved by the Engineer.

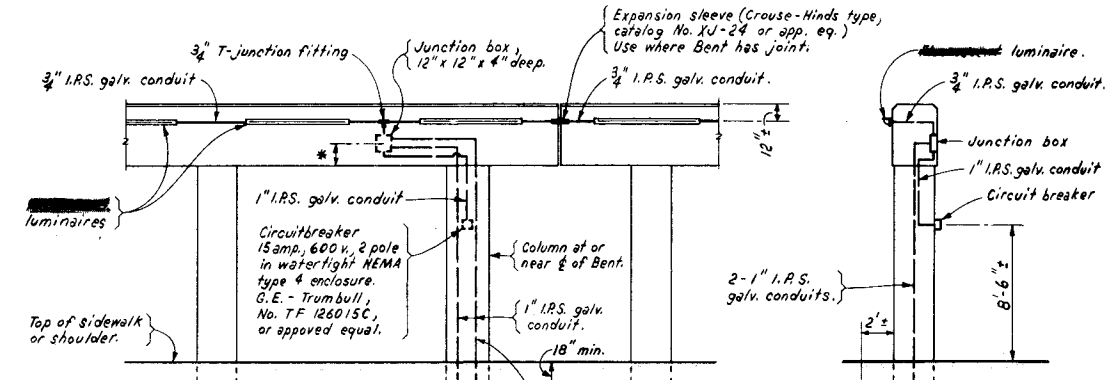


LIGHTING DETAILS

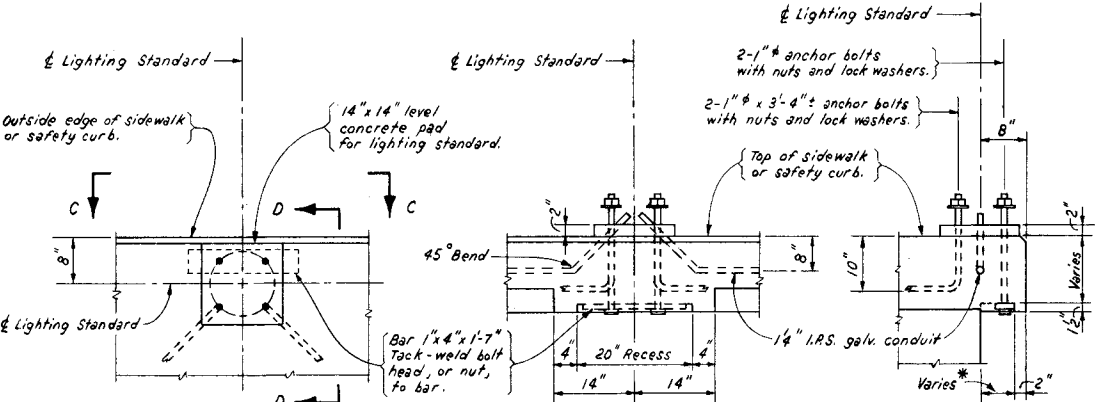


PRESTRESSED CONCRETE BEAM BRIDGES
DETAILS AT LIGHTING STANDARD
Scale: 3/4"=1'-0"

Freeway under Bridge - Buried cable continuous on both sides of roadway.
Freeway on Bridge - Power source from street below bridge - buried cable continuous on one or both sides of roadway. Power source from street above - buried cable extends from end of bridge on top, under embankment slope to this point. See drawing "Lighting, Handrailing, and Drains."

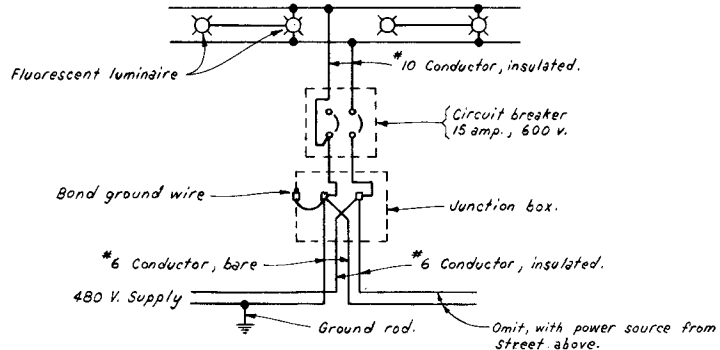


CIRCUIT DIAGRAM


Note:
Contacting surfaces between aluminum lighting standard and concrete shall be thoroughly coated with an aluminum impregnated caulking compound.

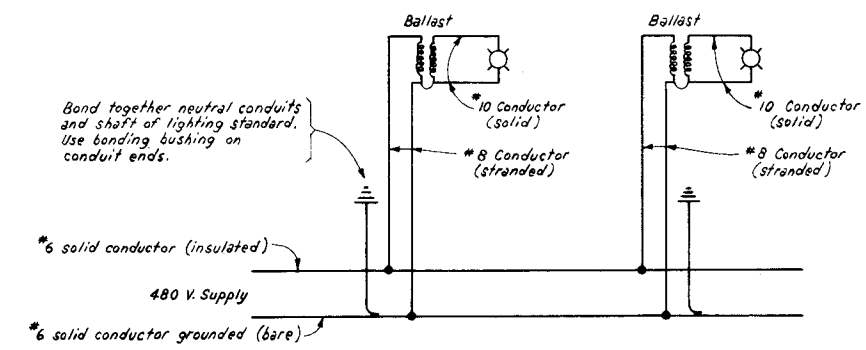

LIGHTING ON BRIDGE

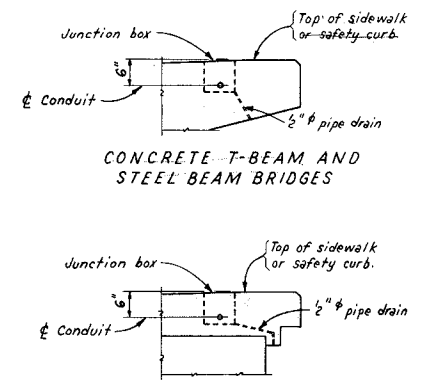

DETAILS AT JUNCTION BOXES

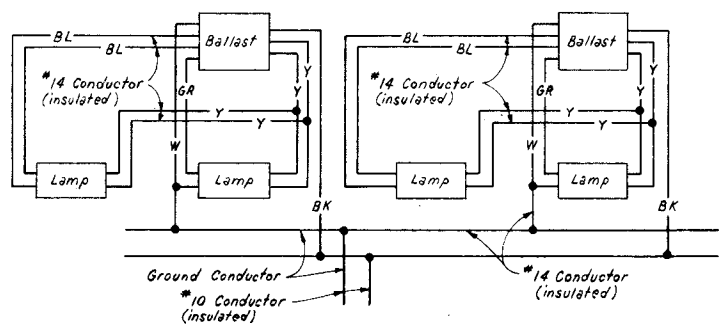

LUMINAIRE WIRING DIAGRAM

LIGHTING UNDER BRIDGE

ELECTRICAL LIGHTING SPECIFICATIONS

LIGHTING ON BRIDGE:

Lighting Standards: See Special Provisions.
All lighting standards shall have hand hole (approx. 4" x 6 1/2") with cover near base of pole, located 90° off bracket center line. Where required, drill in field suitable openings in base of lighting standards for conduits.
Luminaires to be Westinghouse type OV-20, catalog No. 1568, 517, having 1 1/4" adjustable slipfitter and IES type III distribution for E-H1 mercury vapor lamp; or approved equal.
Lamp bulbs to be 400 watt, 20,000 lumen, E-H1 mercury vapor.
Ballast to be 480 volt primary for 400 watt, 20,000 lumen, E-H1 mercury vapor lamp, ballast to be similar to G. E. Co. type ILH, catalog No. 9SA20H5AB, except omit aerial mounting bracket and substitute pole top adapter similar to G. E. Co. No. 108A3006G3. Finish assembly with aluminum paint.

LIGHTING UNDER BRIDGE: See Sheet 7, Proj. I-24-3(29)128

Luminaires to be fluorescent Form 1000, G. E. catalog No. 2F106UB1 (without ballast) and G. E. catalog No. 2F106UB5AB (with 480-volt internal 2-lamp ballast) connected in pairs; or approved equal.
Lamps to be G. E. Co. type F7T12/CW/HO; or approved equal.

GENERAL:

Conduits to be rigid hot dip galvanized steel, sizes as shown on drawings. Provide standard watertight expansion sleeve, suitably grounded, at all expansion joints in bridge deck and as otherwise called for on plans. Expansion sleeves to be Crouse-Hinds type, catalog No. XI-44 for 1 1/4" conduit, catalog No. XI-34 for 1" conduit, catalog No. XI-24 for 3/4" conduit, or approved equal.
Junction boxes - Sizes shall be as shown on drawings. Boxes shall be drilled to provide the connections shown and shall be of cast iron watertight construction, with removable cover (checkered on top) fastened with brass screws. Provide galvanized bushings and lock nuts at connections of conduits to junction boxes.
Conductors - All wiring inside the conduits and light poles shall be 600 volt, rubber insulated, General Electric Co. Versatol-Geoprene; or approved equal.
National Electric Code - Where not covered by these specifications, all other material and workmanship to be incorporated in this project shall be in strict conformance with requirements of the National Electric Code, current edition.

STATE OF TENNESSEE
DEPARTMENT OF HIGHWAYS AND PUBLIC WORKS
CHATTANOOGA FREEWAY
HAMILTON COUNTY-F.A. PROJ. NO. I-24-3()

STANDARD ELECTRICAL LIGHTING DETAILS




SULLIVAN & HOEBEL - CONSULTING ENGINEERS - KNOXVILLE, TENN.
AAKE F. HEDMAN - CONSULTING ENGINEERS - CHATTANOOGA, TENN.

DSGN: JRP	DRWN: JRP	SCALE: AS NOTED	DATE: 2-24-59
CHKD: AC	CHKD: AC	FILE NO. 57.77	SHEET NO. G-7-5


Revised Oct. 1960 - Elimination of light standards, luminaires for under-bridge lighting and wiring
 Revised April 1960 - Changed note on lighting standards and added "See Special Provisions"
 Revised Feb. 1960 - Changed handrailing to steel handrailing (affecting location of conduit)
 Revised June - Sept 1959 - Due to change of interchange layout

LOCATION	MARK	NO.	PER	TOTAL NO.	BENDING DIMENSIONS - FEET & INCHES							LENGTH BAR FEET & INCHES	WEIGHT LBS.
					A	B	C	D	E	F	O		
NORTH AND SOUTH ABUTMENTS													
Bridge Seat	A601	2	16	32								40-6	1947
	A602	2	8	16								44-0	1057
	A603	2	8	16								37-0	889
	A503	2	6	12								5-0	63
	K501	2	10	20	1-7	5-10			0-8 1/2	1-5	6-6 1/2	7-3	151
	U510	2	2	4	2-10 1/2	2-7	2-10 1/2					8-0	33
	U511	2	2	4	2-4 1/2	2-7	2-4 1/2					7-0	29
	U512	2	2	4	1-10 1/2	2-7	1-10 1/2					6-0	26
	T501	2	70	140	2-8	2-8						11-3	1643
	U501	2	10	20	2-0	6-6 1/2	2-0 1/2					10-3	214
	U502	2	6	12	2-0	2-6 1/2	2-0 1/2					6-3	78
	U503	2	8	16	5-0	2-0 1/2	4-6 1/2					11-3	188
U504	2	6	12	5-4	2-5 1/2	5-3 1/2					12-9	160	
U505	2	2	4	3-7	2-5 1/2	3-6 1/2					9-3	39	
Wingwalls	A501	4	19	76								9-6	753
	A502	4	2	8								7-6	63
	A504	4	2	8								5-9	47
	U506	4	6	24	2-1	2-1 1/2	2-1 1/2					6-0	150
	U507	4	5	20	2-5	2-0 1/2	1-10 1/2					6-0	125
	U508	4	1	4	2-9	2-0 1/2	2-3 1/2					6-9	28
	U509	4	1	4	3-2	2-0 1/2	2-7 1/2					7-6	31
	T401	4	6	24	3-11	0-7 1/2						9-6	152
	T402	4	1	4	2-11	0-7 1/2						7-6	20
	T403	4	1	4	3-3	0-7 1/2						8-3	22
	T404	4	1	4	3-6	0-7 1/2						8-9	23
	T405	4	1	4	3-8	0-7 1/2						9-0	24
T406	4	1	4	3-10	0-7 1/2						9-3	25	
TOTAL WEIGHT - NORTH & SOUTH ABUTMENTS											7980		
TOTAL WEIGHT - NORTH ABUTMENT											3990		
TOTAL WEIGHT - SOUTH ABUTMENT											3990		
BENT 1													
Footing 1	A701	1	12	12								5-3	129
	A602	1	20	20								7-0	210
Footing 2	L1102	1	12	12	1-0	5-1						5-9	367
	A902	1	14	14								8-0	381
	A606	1	21	21								6-0	189
Figs. 3, 4, & 5	A1106	3	12	36								7-0	1339
	A801	3	19	57								11-6	1750
	A603	3	28	84								8-6	1072
Footing 6	L701	1	12	12	0-9 1/2	4-2						4-9	117
	A604	1	10	10								6-6	98
	A605	1	8	8								4-6	54
Column 1	A702	1	12	12								18-6	454
	XD501	1	1	1	0-3 1/2		2-2				15-6	373-0	389
	A1107	1	12	12								25-6	1626
Column 2	XD502	1	1	1	0-3 1/2		2-2				22-7	534-3	557
	A1108	1	12	12								19-0	1211
Column 3	XD503	1	1	1	0-3 1/2		2-2				16-0	384-6	401
	A1108	1	12	12								19-0	1211
Column 4	XD503	1	1	1	0-3 1/2		2-2				16-0	384-6	401
	A1109	1	12	12								18-9	1195
Column 5	XD504	1	1	1	0-3 1/2		2-2				15-9	378-9	395
	A703	1	12	12								24-6	601
Column 6	XD505	1	1	1	0-3 1/2		2-2				21-5	507-9	530
	No. 3 spacer bars for spirals (3 bars per spiral)											321-9	121
Cap	A1101	2	7	14								39-9	2957
	A1102	2	5	10								13-0	691
	A1103	2	2	4								8-3	175
	A1104	2	2	4								8-0	170
	A1105	2	3	6								11-9	375
L1101	2	3	6	4-0	40-4						44-0	1403	
A901	2	2	4								6-0	82	
A601	2	6	12								39-6	712	
T501	2	94	188	4-2	1-8 1/2						12-3	2402	
U501	2	1	2	3-1 1/2	1-10	3-1 1/2					7-9	16	
TOTAL WEIGHT - BENT 1											24,636		
BENT 2													
Figs. 1 and 6	A701	2	12	24								5-3	258
	A602	2	20	40								7-0	421
Figs. 2, 3, 4, & 5	A1106	4	12	48								7-0	1785
	A801	4	19	76								11-6	2334
	A603	4	28	112								8-6	1430
Column 1	A704	1	12	12								17-0	417
	XD506	1	1	1	0-3 1/2		2-2				14-0	338-9	353
Column 2	A1110	1	12	12								17-3	1100
	XD507	1	1	1	0-3 1/2		2-2				14-3	344-6	359
Column 3	A1111	1	12	12								17-6	1116
	XD508	1	1	1	0-3 1/2		2-2				14-7	352-0	367
Column 4	A1111	1	12	12								17-6	1116
	XD508	1	1	1	0-3 1/2		2-2				14-7	352-0	367
Column 5	A1110	1	12	12								17-3	1100
	XD507	1	1	1	0-3 1/2		2-2				14-3	344-6	359
Column 6	A704	1	12	12								17-0	417
	XD506	1	1	1	0-3 1/2		2-2				14-0	338-9	353
No. 3 spacer bars for spirals (3 bars per spiral)											257-0	97	
Cap	Same as for Bent 1.											9136	
TOTAL WEIGHT - BENT 2											22,885		
BENT 3													
Footing 1	L701	1	12	12	0-9 1/2	4-2						4-9	117
	A604	1	10	10								6-6	98
	A605	1	8	8								4-6	54
Figs. 2, 3, & 4	L1102	3	12	36	1-0	5-1						5-9	1100
	A902	3	14	42								8-0	1142
	A606	3	21	63								6-0	568
Footing 5	A1106	1	12	12								7-0	446
	A801	1	19	19								11-6	583
	A603	1	28	28								8-6	357
Footing 6	A701	1	12	12								5-3	129
	A602	1	20	20								7-0	210
Column 1	A703	1	12	12								24-6	601
	XD509	1	1	1	0-3 1/2		2-2				21-7	511-6	533
Column 2	A1112	1	12	12								24-3	1546
	XD510	1	1	1	0-3 1/2		2-2				21-3	504-0	526
Column 3	A1113	1	12	12								24-6	1562
	XD509	1	1	1	0-3 1/2		2-2				21-7	511-6	533
Column 4	A1114	1	12	12								23-6	1498
	XD511	1	1	1	0-3 1/2		2-2				20-7	488-9	510
Column 5	A1115	1	12	12								18-6	1179
	XD501	1	1	1	0-3 1/2		2-2				15-6	373-0	389
Column 6	A705	1	12	12								18-3	448
	XD512	1	1	1	0-3 1/2		2-2				15-3	367-3	383
No. 3 spacer bars for spirals (3 bars per spiral)											347-3	131	
Cap	Same as for Bent 1											9136	
PeDESTAL	Same as for Bent 1											702	
TOTAL WEIGHT - BENT 3											24,481		


LOCATION	MARK	NO.	PER	TOTAL NO.	BENDING DIMENSIONS - FEET & INCHES							LENGTH BAR FEET & INCHES	WEIGHT LBS.
					A	B	C	D	E	F	O		
SPANS 1 AND 4													
Sidewalk	A601	4	1	4								31-6	189
	A501	4	4	16								31-6	526
	W501	4	24	96	0-7	5-5	0-5 1/2		0-1	0-7	5-6	6-3	625
	TOTAL WEIGHT - SPANS 1 AND 4											1340	
TOTAL WEIGHT - SPAN 1											670		
TOTAL WEIGHT - SPAN 4											670		
SPANS 2 AND 3													
Sidewalk	A801	4	2	8								8-6	132
	A602	4	1	4								54-9	329
	A502	4	4	16								54-9	914</

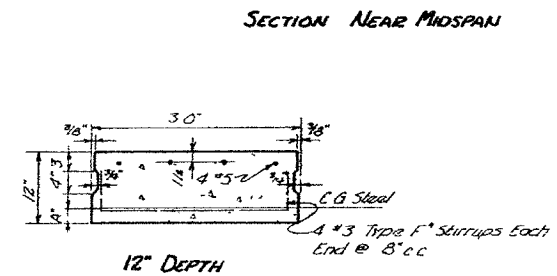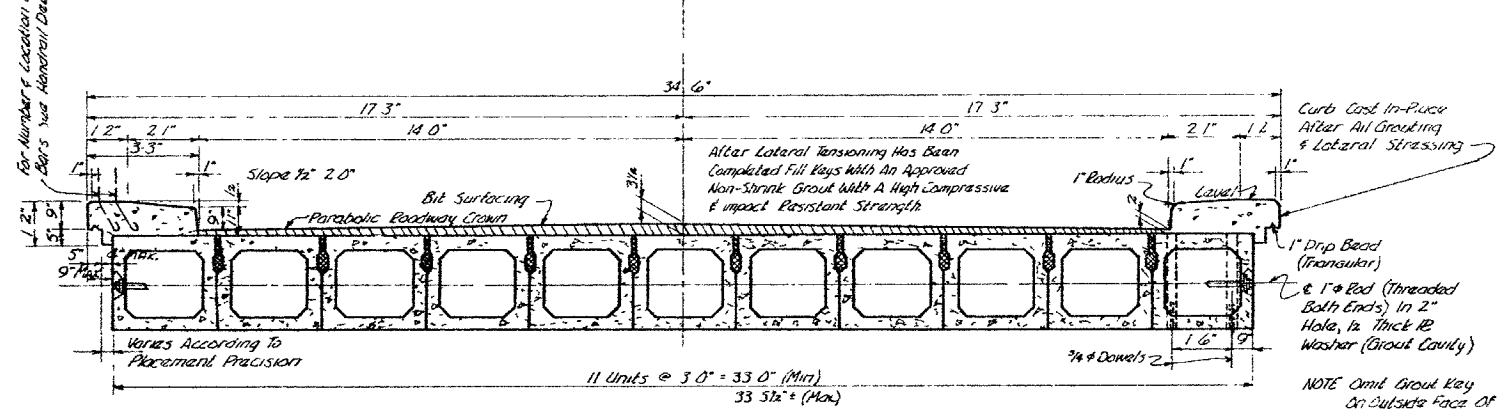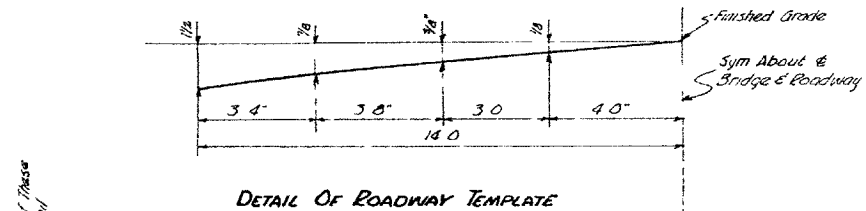


CLEAR SPAN FEET	A INCHES	B INCHES	PRESTRESSED STEEL AREA	No. 3/8" STEEL STRANDS	WEIGHT BASIC PER LINEAL FOOT	SUGGESTED BEARINGS
14	225	OMIT	0.96	12	7250	12"
16	216	"	1.20	15	8250	
18	204	"	1.52	19	9200	
20	264	"	1.76	22	9200	
22	264	"	2.08	26	10600	
24	222	"	1.52	19	8250	

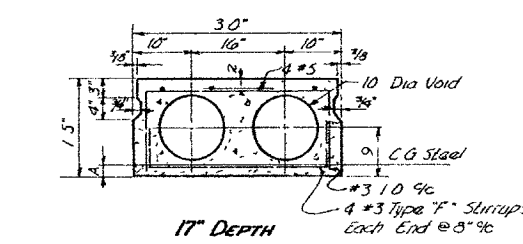


CLEAR SPAN FEET	A INCHES	B INCHES	PRESTRESSED STEEL AREA	No. 3/8" STEEL STRANDS	WEIGHT BASIC PER LINEAL FOOT	SUGGESTED BEARINGS
24	222	18	1.52	19	8250	12"
26	220	"	1.96	17	3450	
28	225	"	1.60	20	4400	
30	230	"	1.70	22	5350	
32	262	"	2.20	25	6300	
34	275	"	2.16	27	7250	

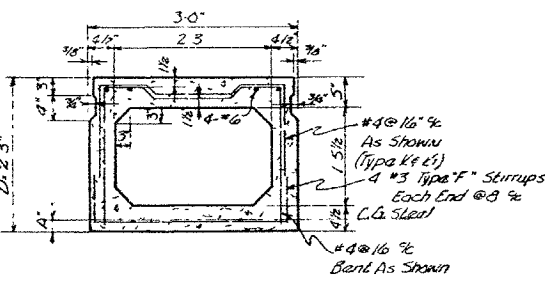


CLEAR SPAN FEET	A INCHES	B INCHES	PRESTRESSED STEEL AREA	No. 3/8" STEEL STRANDS	WEIGHT BASIC PER LINEAL FOOT	SUGGESTED BEARINGS
44	230	18	1.76	22	27100	12"
46	226	"	1.84	23	28200	
48	227	"	2.00	25	29300	
50	235	"	2.24	28	30500	
52	263	"	2.40	30	31600	
54	299	"	2.56	32	32800	
56	323	"	2.80	35	35900	

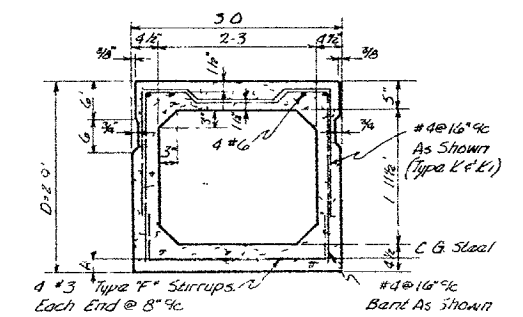









CLEAR SPAN FEET	A INCHES	B INCHES	PRESTRESSED STEEL AREA	No. 3/8" STEEL STRANDS	WEIGHT BASIC PER LINEAL FOOT	SUGGESTED BEARINGS
58	247	12	2.32	29	35900	12"
60	263	"	2.48	31	41300	
62	303	"	2.64	33	42600	
64	338	"	2.80	36	43900	
66	363	"	3.04	39	45200	
68	390	"	3.28	41	46500	

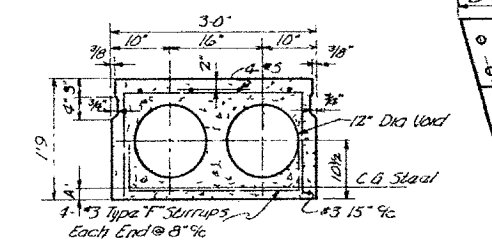

CLEAR SPAN FEET	A INCHES	B INCHES	PRESTRESSED STEEL AREA	No. 3/8" STEEL STRANDS	WEIGHT BASIC PER LINEAL FOOT	SUGGESTED BEARINGS
36	230	18	1.76	22	22,100	12"
38	231	"	1.92	23	23,200	
40	264	"	2.16	27	24,350	
42	320	"	2.48	31	25,500	

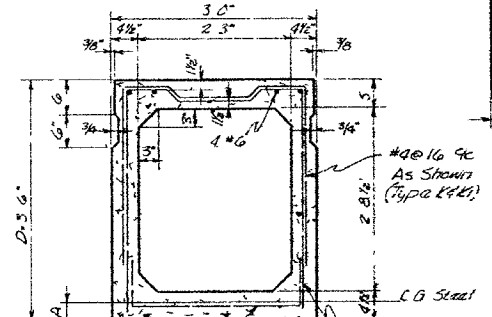

CLEAR SPAN FEET	A INCHES	B INCHES	PRESTRESSED STEEL AREA	No. 3/8" STEEL STRANDS	WEIGHT BASIC PER LINEAL FOOT	SUGGESTED BEARINGS
70	312	12	2.12	34	51,500	18"
72	323	"	2.28	36	52,900	
74	369	"	3.04	38	54,620	
76	407	"	3.20	40	56,280	
78	434	"	3.36	42	57,940	
80	422	"	3.52	44	59,600	

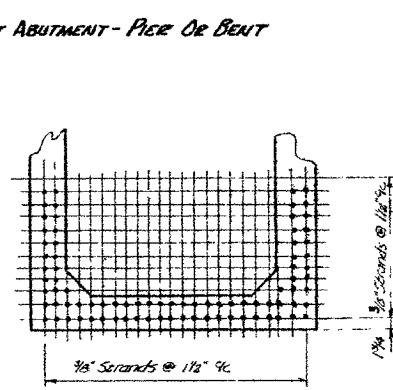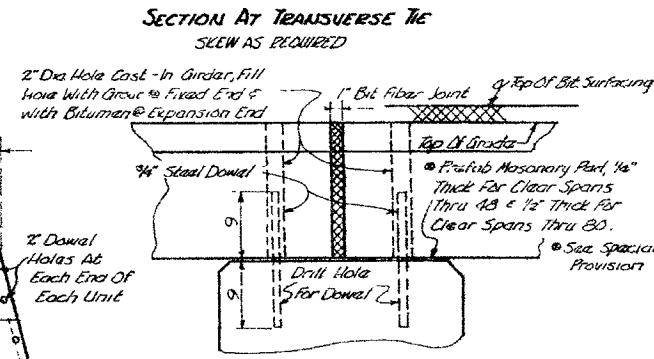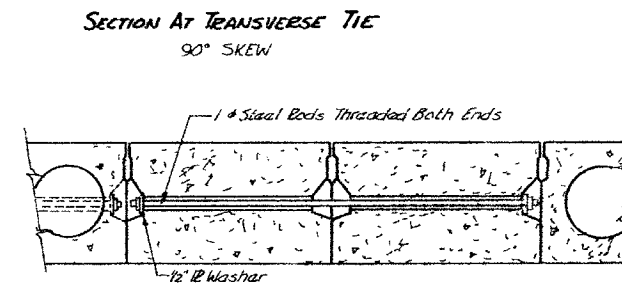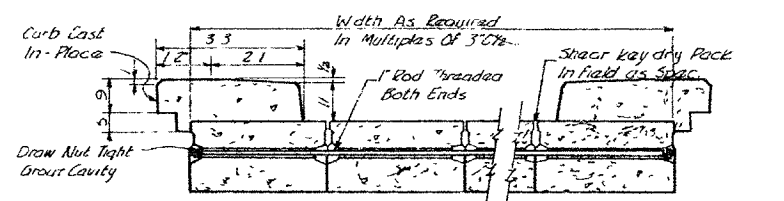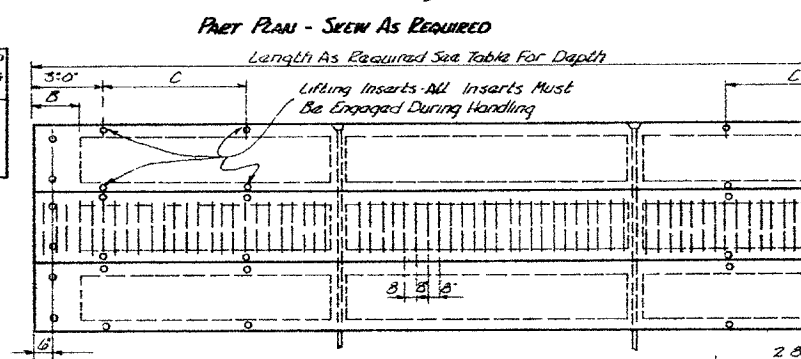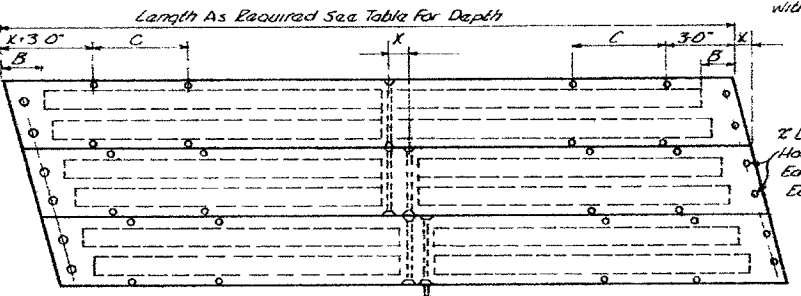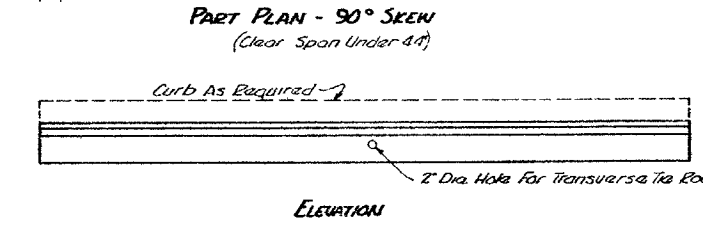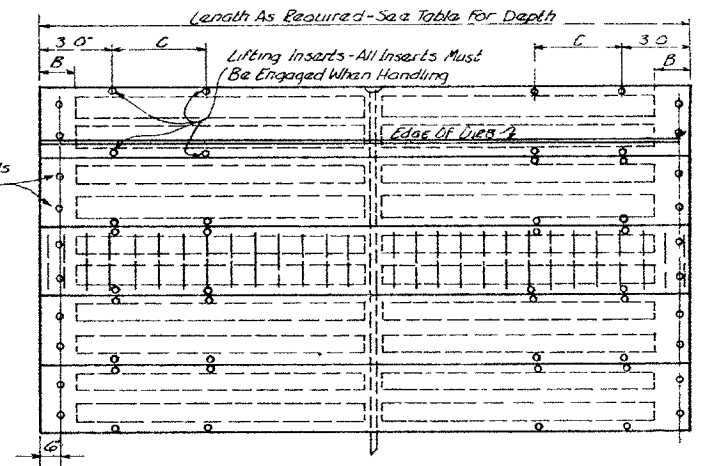

GENERAL NOTES.

SPECIFICATIONS Standard Road & Bridge Specifications of the Tennessee Department of Highways

LOADING HD-20-44

CONCRETE (Cast in Place) To Be Class "A"

PRECAST, PRETENSIONED CONCRETE See Specifications

REINFORCING STEEL See Specifications.

FORMS & FINISH See Specifications.

HANDLING PRE-TENSIONED DECK-UNIT See Specifications.

LATERAL TENSIONING Prior to Grouting Longitudinal, Lays of In-Place Deck Units, The Nuts of The Transverse Rods Shall Be Given Two Full Turns From Hand Tight Position, To Develop A Stress of 30,000 PSI, In Rods

PRETENSIONING STEEL: An Initial Force of 14,000 Lbs. Shall Be Applied To Each Strand In All Beams

The Design is Based On Federal Bureau Criteria & Special Provision.

STATE OF TENNESSEE
DEPARTMENT OF HIGHWAYS
AND PUBLIC WORKS
NASHVILLE

STANDARD
PRESTRESSED CONCRETE BRIDGE
PRETENSIONED
CLEAR SPANS 14'-0" TO 80'-0"
28'-0" ROADWAY WITH SAFETY CURBS
1957

Revised 2/23/57 - See drawing details. Beams 44' & 46' omitted. Estimated 4/17/58 (Time of bid's & spacing of 1/2" diameter chairs, it required 12 1/2" spacing. See detail for fabrications). Revised 5/30/57 (Curb board location changed). Revised 8/11/57 (Type F* stirrups & dowel holes added). Revised 8/22/57 (Type L* stirrup, Note omitted).

DESIGNED BY: A. BUESS
DRAWN BY: A. BUESS
CHECKED BY: B. BRUMBY

DATE: 6/26/57
DATE: 8/30/60


#3 TYPE F* STIRRUP

F10-01

**QUANTITIES FOR CAST CURBS
BOTH SIDES**

Clear Span	Concrete Cu Yds	Reinf Steel Lbs	No Of Bars D ₁	No Of Bars C ₂	No Of Bars C ₁
14	3.6	206	24	22	12
16	4.0	235	28	26	12
18	4.5	265	30	28	12
20	4.9	294	34	32	12
22	5.4	324	36	34	12
24	5.8	353	40	38	12
26	6.3	382	42	40	12
28	6.7	412	46	44	12
30	7.1	441	48	46	12
32	7.6	470	52	50	12
34	8.0	500	54	52	12
36	8.5	529	58	56	12
38	8.9	559	60	58	12
40	9.4	588	62	60	12
42	9.8	617	66	64	12
44	10.3	647	68	66	12
46	10.7	676	72	70	12
48	11.2	705	74	72	12
50	11.6	734	78	76	12
52	12.1	764	80	78	12
54	12.5	794	84	82	12
56	13.0	823	86	84	12
58	13.4	852	90	88	24
60	13.8	882	92	90	24
62	14.3	911	96	94	24
64	14.7	941	98	96	24
66	15.2	970	102	100	24
68	15.6	1000	106	104	24
70	16.1	1029	110	108	24
72	16.7	1058	112	110	24
74	17.2	1088	116	114	24
76	17.6	1117	118	116	24
78	18.1	1147	122	120	24
80	18.5	1176	124	122	24

NOTE Above Quantities Apply To All Slabs
 For Skewed Bridge Less Than 90° Curb
 Bars To Be Flared At Each End Of Span
 NOTE Bars D₁ To Be Included In Unit
 Price Bid For Girders

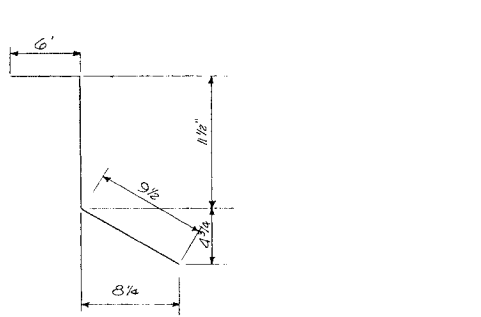


Bars D₁ (To Be 1/2" φ)
 Total Length = 23




Bars C₂
 Total Length = 4

NOTE Length Of Longitudinal Bars C₁ To Be
 Total Span Length Minus 6" Also Cap Bars
 C₁ 10' When Splice Is Required

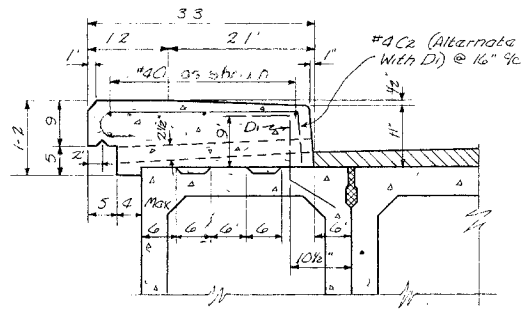


**TYPICAL SECTION FOR CURB
AND EXTERIOR BOX**

NOTE Curb To Be Cast In Place Provisions May Be Made
 In The Fascia Of Ext Limits For Approved Inserts To
 Facilitate Forming Of Curbs

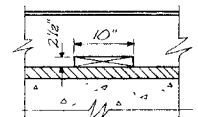




**DRAINAGE
SLOT DETAIL**

Locate Drain Slots @ Center
 Of Every Other Paving Panel

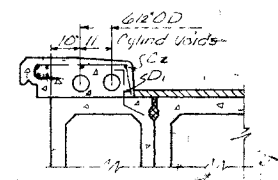

ALTERNATE CURB

NOTE Cylind Voids To Be Continous
 Except They Are Stopped @ 3" On
 Either Side Of Drainage Slots

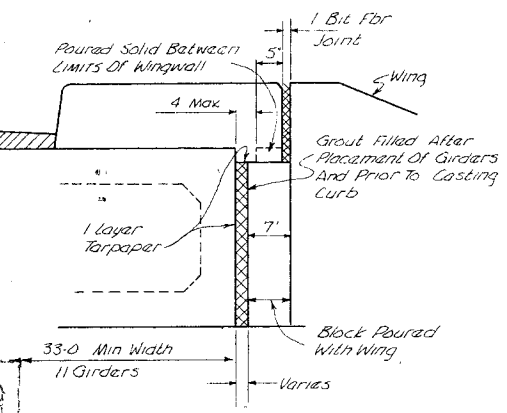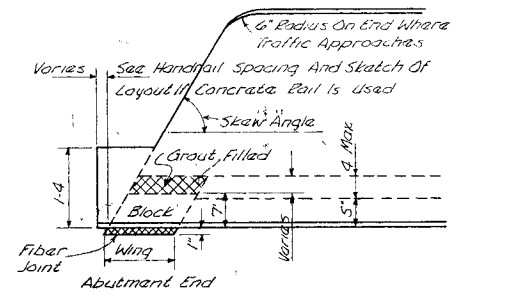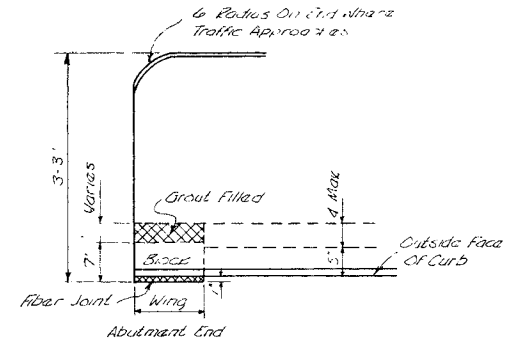

**SKETCH SHOWING CURB
DETAIL AT ABUTMENT END**


DESIGNED BY: A. BURKE
 DRAWN BY: B. BRAUMAN & Q. PRAGER
 CHECKED BY: DATE: 8-28-37
 DATE: 8-30-37

STATE OF TENNESSEE
 DEPARTMENT OF HIGHWAYS
 AND PUBLIC WORKS
 NASHVILLE
 STANDARD
PRESTRESSED CONCRETE BRIDGE
 PRETENSIONED
 CLEAR SPANS 14'-0" - 80'-0"
 28'-0" ROADWAY WITH SAFET CURBS
 1957

CORRECT: [Signature]
 APPROVED: [Signature]
 F-10-36

Revised 6-15-60 - 18" min. in. inside corner
 Bar D₁ Deducted From Reinf Steel Quantities
 Rebar spacing - when transportation changed

I. 11 20-11

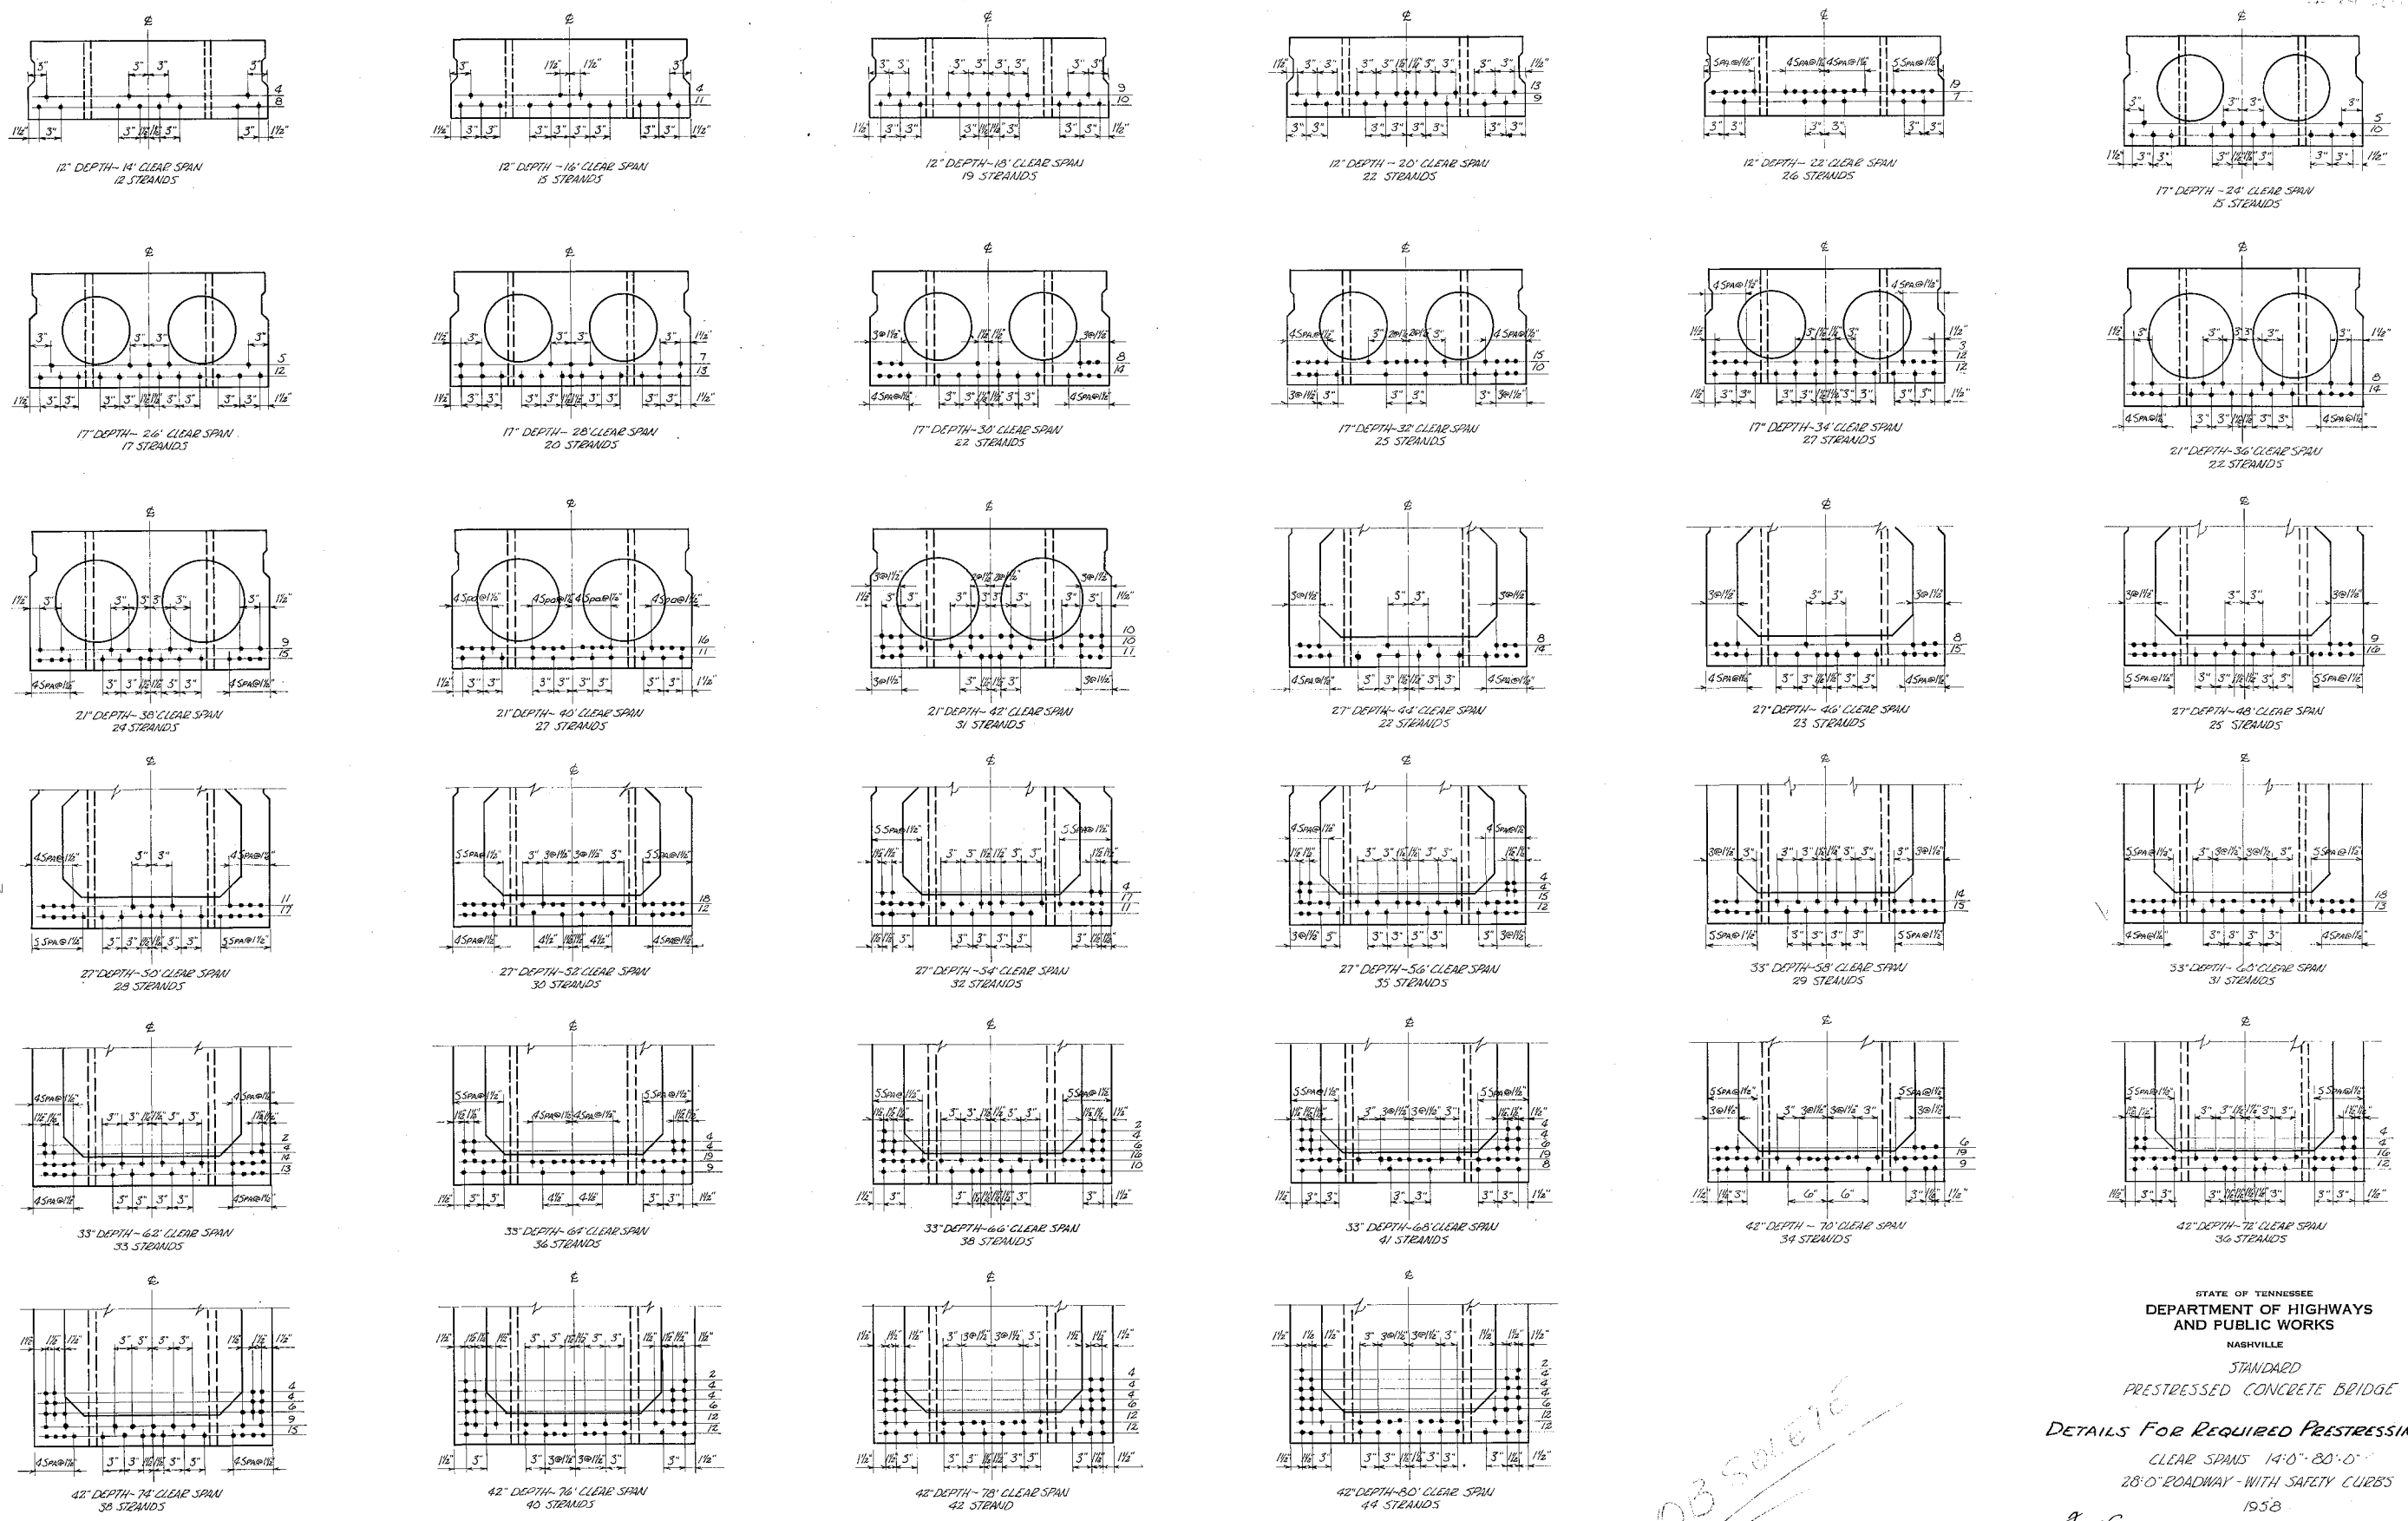

DESIGNED BY _____ DATE _____
 DRAWN BY A. BURKE DATE 3-13-58
 RE-TRACED BY B. BRUMAN DATE 9-23-60
 CHECKED BY _____ DATE _____


OB 501576

STATE OF TENNESSEE
 DEPARTMENT OF HIGHWAYS
 AND PUBLIC WORKS
 NASHVILLE
 STANDARD
 PRESTRESSED CONCRETE BRIDGE
 DETAILS FOR REQUIRED PRESTRESSING PATTERNS
 CLEAR SPANS 14'-0" - 80'-0"
 28'-0" ROADWAY - WITH SAFETY CURBS
 1958


CORRECT Fred Jones BRIDGE ENGINEER
 APPROVED Edo Lang STATE HIGHWAY ENGINEER

F-10-85A


With Std. Dwg. F-10-84-F-10-85
 2 COPIES

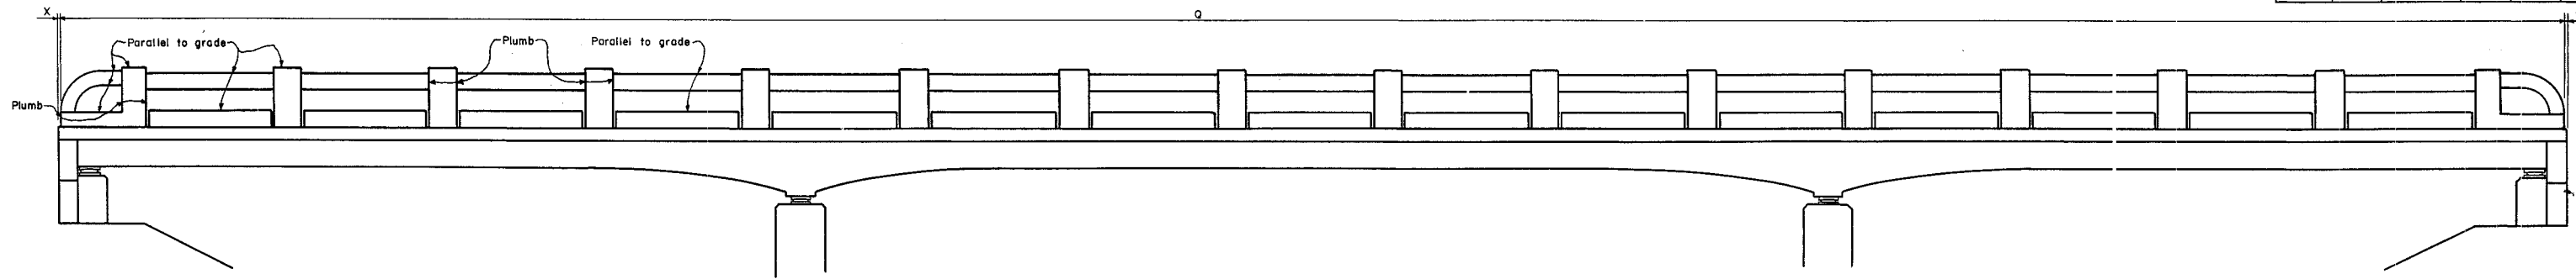


TYPICAL ELEVATION

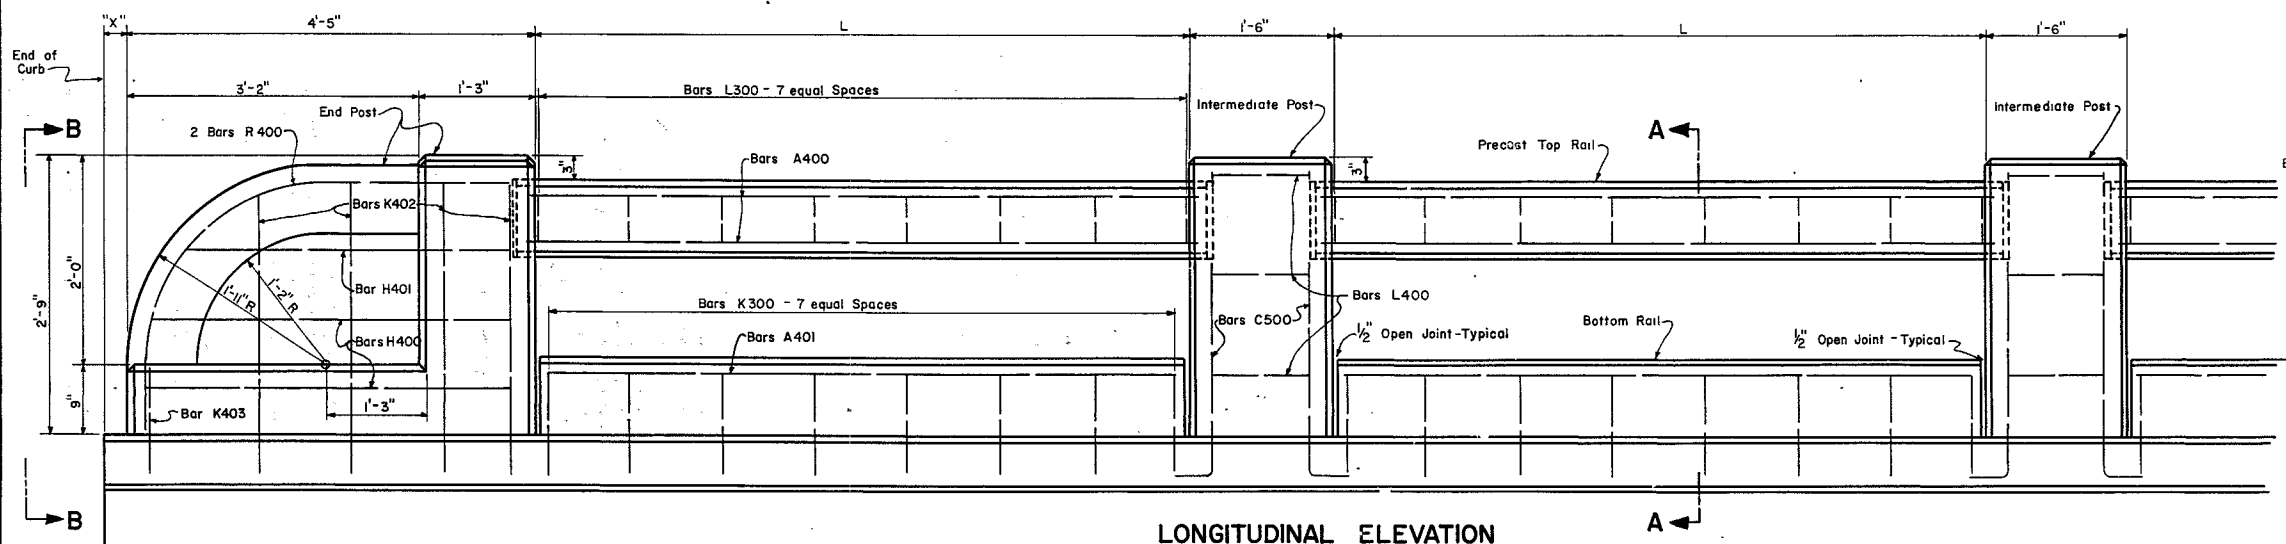

LONGITUDINAL ELEVATION

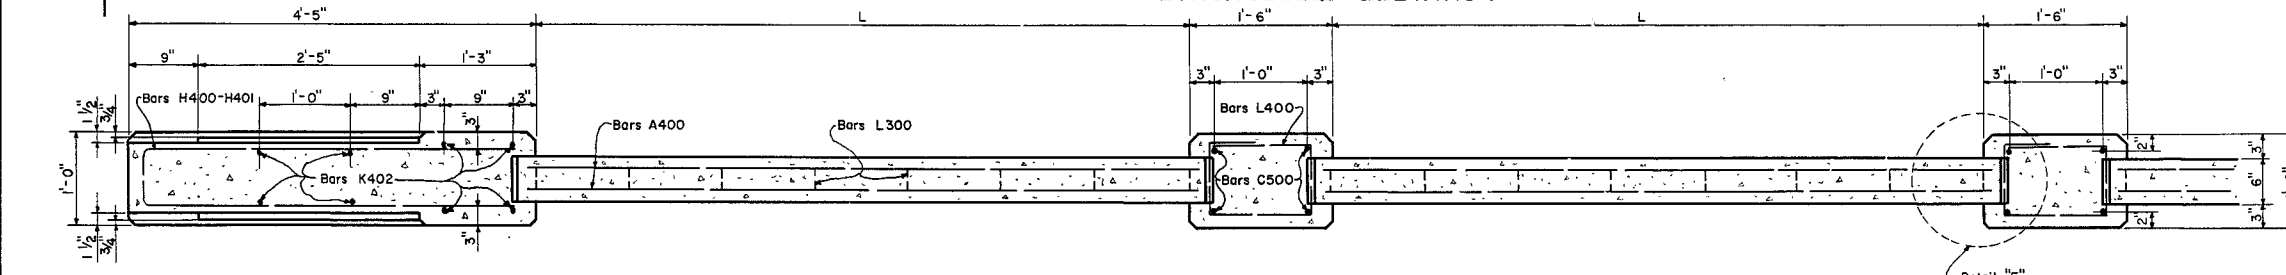


LONGITUDINAL SECTION

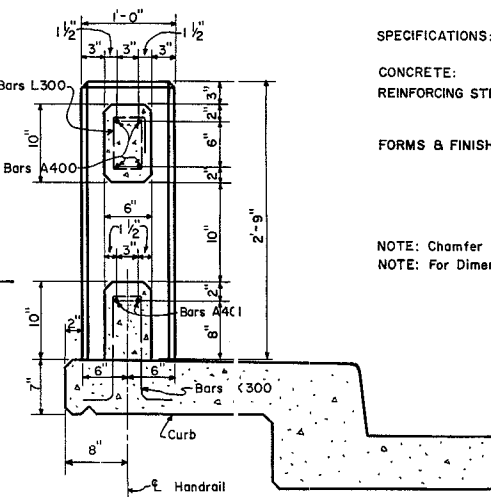


SECTION A-A

GENERAL NOTES

SPECIFICATIONS: Standard Road & Bridge Specifications of the Tennessee Department of Highways.
 CONCRETE: To be Class "A".
 REINFORCING STEEL: See Specifications. To be intermediate or hard grade with Standard Hook Details as recommended by C.R.S.I.
 FORMS & FINISH: See Specifications.
 NOTE: Chamfer all edges on Handrail Posts and Rails 1/2".
 NOTE: For Dimensions X, Q, B, L See Bridge Layout Sheet.

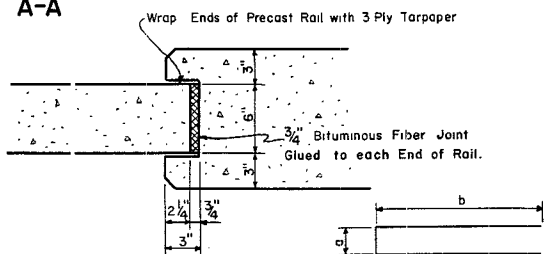


DETAIL E

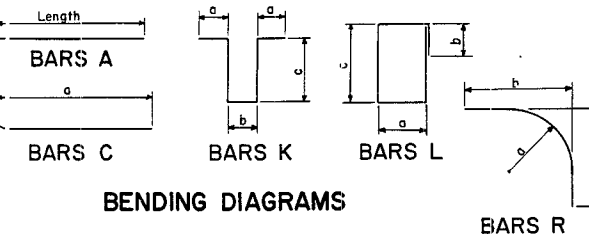


STATE OF TENNESSEE
 DEPARTMENT OF HIGHWAYS
 NASHVILLE

STANDARD
 CONCRETE HANDRAIL
 1960

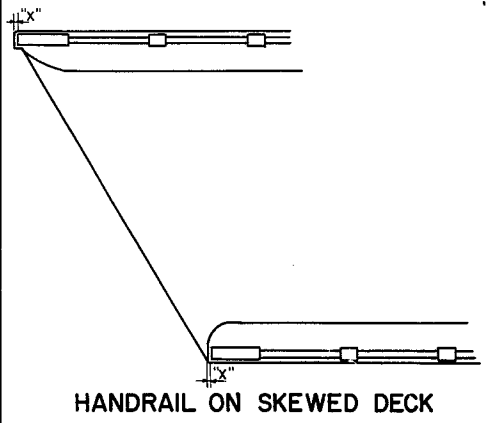

HANDRAIL ON SKEWED DECK

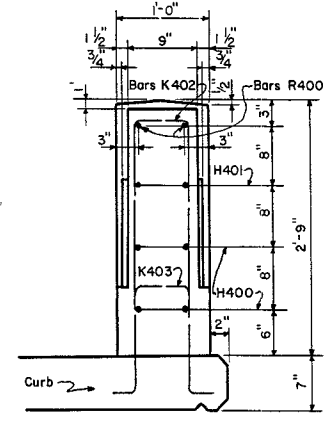

ELEV. B-B

END POST-LIST OF MATERIALS-EACH

Bar	Size	No. Req'd	Bending Dimensions				Length	Quantities	
			a	b	c	d		Steel Lbs	Conc. CuYd
H400	4	2	0'-6"	4'-0"		8'-6"			
H401	4	1	0'-6"	3'-7"		7'-8"			
K402	4	4	0'-3"	0'-7"	2'-11"	6'-11"	45.0	0.37	
K403	4	1	0'-3"	0'-7"	1'-2"	3'-5"			
R400	4	2	1'-9"	4'-0"	2'-6"	5'-9"			

INTERMEDIATE POST
 LIST OF MATERIALS-EACH

Bar	Size	No. Req'd	Bending Dimensions				Length	Quantities	
			a	b	c	d		Steel Lbs	Conc. CuYd
C500	5	4	3'-0"			3'-4"	22.6	0.15	
L400	4	3	0'-9"	0'-6"	1'-2"	4'-4"			



TOP RAIL-LIST OF MATERIALS-EACH

L	Bar	Size	No. Req'd	Bending Dimensions				Length	Quantities	
				a	b	c	d		Steel Lbs	Conc. CuYd
6'-0"	A400	4	4				6'-2"	23.6	0.10	
6'-10"	L300	3	8	0'-4"	0'-6"	0'-7"	2'-4"			
6'-10"	A400	4	4				6'-3"	23.8	0.10	
6'-2"	L300	3	8	0'-4"	0'-6"	0'-7"	2'-4"			
6'-2"	A400	4	4				6'-4"	24.1	0.10	
6'-3"	L300	3	8	0'-4"	0'-6"	0'-7"	2'-4"			
6'-3"	A400	4	4				6'-5"	24.3	0.10	
6'-4"	L300	3	8	0'-4"	0'-6"	0'-7"	2'-4"			
6'-4"	A400	4	4				6'-6"	24.5	0.10	
6'-5"	L300	3	8	0'-4"	0'-6"	0'-7"	2'-4"			
6'-5"	A400	4	4				6'-7"	24.7	0.11	
6'-6"	L300	3	8	0'-4"	0'-6"	0'-7"	2'-4"			
6'-6"	A400	4	4				6'-8"	25.0	0.11	
6'-7"	L300	3	8	0'-4"	0'-6"	0'-7"	2'-4"			
6'-7"	A400	4	4				6'-9"	25.2	0.11	
6'-8"	L300	3	8	0'-4"	0'-6"	0'-7"	2'-4"			
6'-8"	A400	4	4				6'-10"	25.4	0.11	
6'-9"	L300	3	8	0'-4"	0'-6"	0'-7"	2'-4"			
6'-9"	A400	4	4				6'-11"	25.6	0.11	
6'-10"	L300	3	8	0'-4"	0'-6"	0'-7"	2'-4"			
6'-10"	A400	4	4				7'-0"	25.9	0.11	
6'-11"	L300	3	8	0'-4"	0'-6"	0'-7"	2'-4"			
6'-11"	A400	4	4				7'-1"	26.1	0.11	
7'-0"	L300	3	8	0'-4"	0'-6"	0'-7"	2'-4"			

BOTTOM RAIL-LIST OF MATERIALS-EACH

L	Bar	Size	No. Req'd	Bending Dimensions				Length	Quantities	
				a	b	c	d		Steel Lbs	Conc. CuYd
6'-0"	A401	4	2				5'-8"	17.7	0.09	
6'-10"	K300	3	8	0'-4"	0'-4"	1'-2"	3'-4"			
6'-10"	A401	4	2				5'-10"	17.8	0.09	
6'-2"	K300	3	8	0'-4"	0'-4"	1'-2"	3'-4"			
6'-2"	A401	4	2				5'-10"	17.9	0.09	
6'-3"	K300	3	8	0'-4"	0'-4"	1'-2"	3'-4"			
6'-3"	A401	4	2				5'-11"	18.1	0.10	
6'-4"	K300	3	8	0'-4"	0'-4"	1'-2"	3'-4"			
6'-4"	A401	4	2				6'-0"	18.2	0.10	
6'-5"	K300	3	8	0'-4"	0'-4"	1'-2"	3'-4"			
6'-5"	A401	4	2				6'-1"	18.3	0.10	
6'-6"	K300	3	8	0'-4"	0'-4"	1'-2"	3'-4"			
6'-6"	A401	4	2				6'-2"	18.4	0.10	
6'-7"	K300	3	8	0'-4"	0'-4"	1'-2"	3'-4"			
6'-7"	A401	4	2				6'-3"	18.5	0.10	
6'-8"	K300	3	8	0'-4"	0'-4"	1'-2"	3'-4"			
6'-8"	A401	4	2				6'-4"	18.6	0.10	
6'-9"	K300	3	8	0'-4"	0'-4"	1'-2"	3'-4"			
6'-9"	A401	4	2				6'-5"	18.7	0.10	
6'-10"	K300	3	8	0'-4"	0'-4"	1'-2"	3'-4"			
6'-10"	A401	4	2				6'-6"	18.8	0.10	
6'-11"	K300	3	8	0'-4"	0'-4"	1'-2"	3'-4"			
6'-11"	A401	4	2				6'-7"	19.0	0.11	
7'-0"	K300	3	8	0'-4"	0'-4"	1'-2"	3'-4"			



Revised: 1 - June - 1962
 Revised: 8 - September - 1960
 DESIGNED BY: J.L. Parkes
 DRAWN BY: R. Reagan
 RETRACED BY: R. Reagan
 CHECKED BY: _____
 DATE: 4-4-63

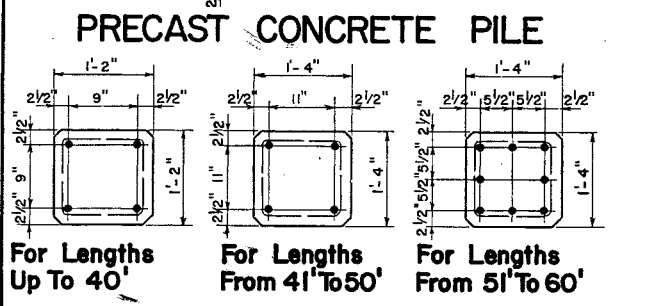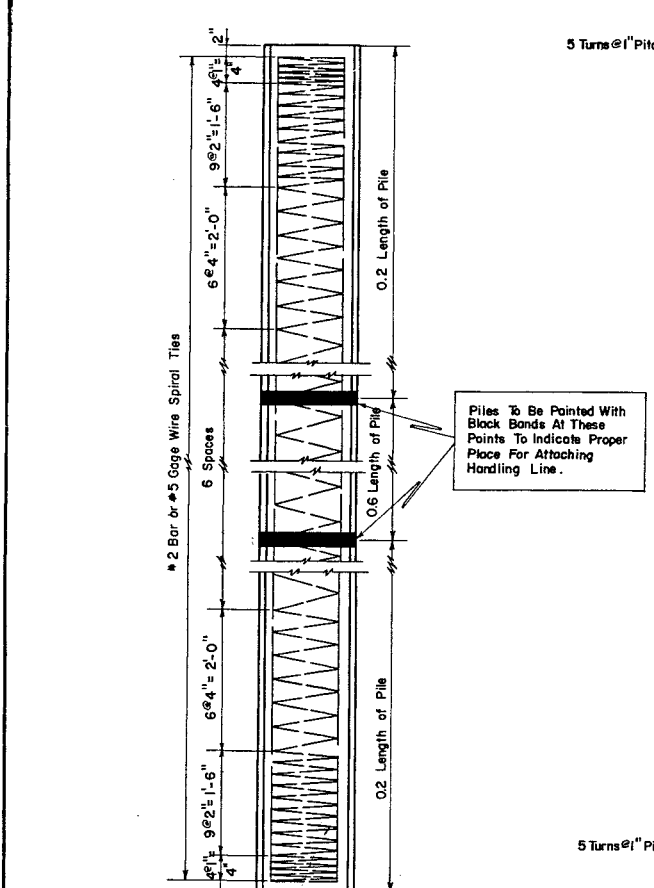


NOTE: If It Becomes Necessary To Use Size 2 Piles The Contractor Will Be Allowed An Increase In The Size 1 Bid Of 25%.

Length Of Pile	Longitudinal Reinforcing	Weight Of Steel Per Ft.	Weight Of Pile Per Ft.
Up To 35'	4 # 7 Bars	9.6 #	205.3 #
36' To 40'	4 # 8 Bars	12.2 #	205.3 #
41' To 45'	4 # 9 Bars	15.1 #	265.3 #
46' To 50'	4 # 10 Bars	18.8 #	265.3 #
51' To 55'	8 # 9 Bars	28.9 #	265.3 #
56' To 60'	8 # 10 Bars	36.2 #	265.3 #


NOTE: In Handling The Piles, They Shall Be Supported At The Points Indicated. Piles To Be Picked Up By Pulling On Both Lines Uniformly. End Of Pile Not To Touch Ground Unless Piles Inclined 1:2 Or Steeper.

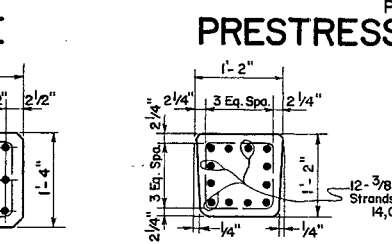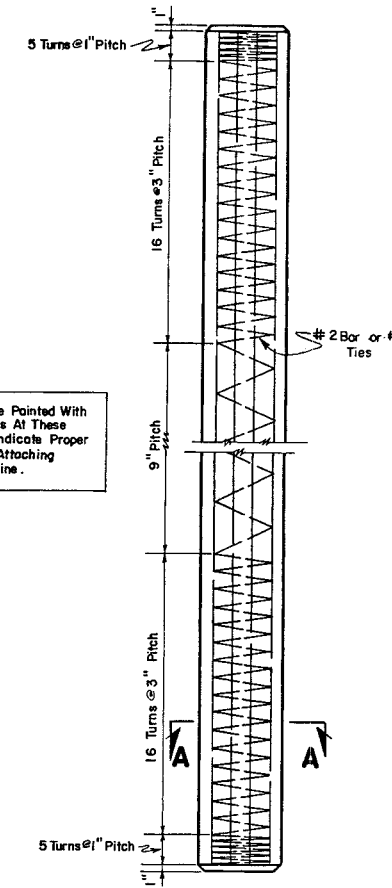


NOTE: Driving Of Built-Up Piles Shall Be Permitted Only At The Direction Of The Engineer.

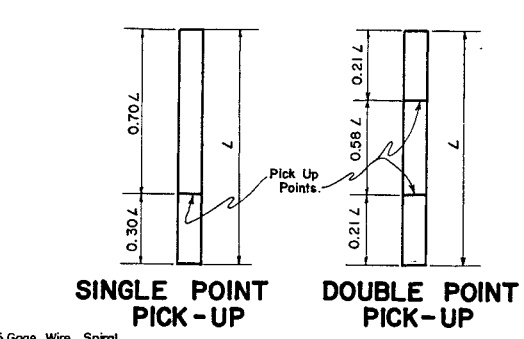




NOTES: (1) Maximum Length Single Pick Up Point - 60'-0" (2) Maximum Length Double Pick Up Point - 85'-0" (3) Piles To Be Marked At These Points To Indicate Proper Place For Attaching Handling Lines. (4) For Greater Lengths Three Point Pick-up is Required.

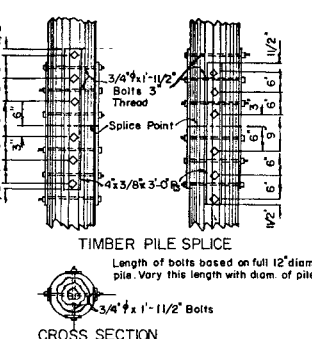



Length of bolts based on full 12" diam pile. Vary this length with diam. of pile.

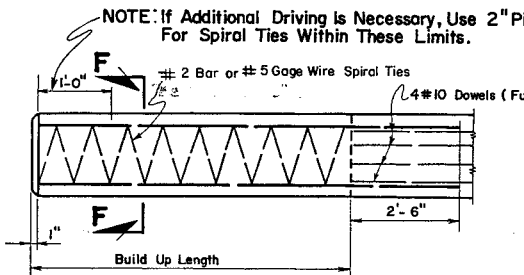


NOTE: Driving Of Built-Up Piles Shall Be Permitted Only At The Direction Of The Engineer.

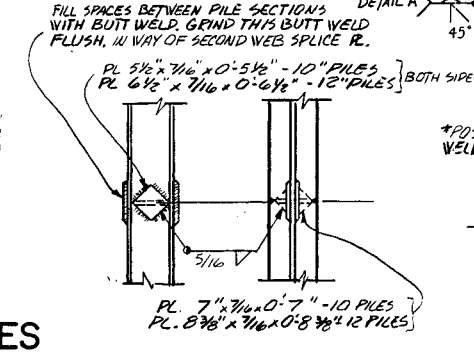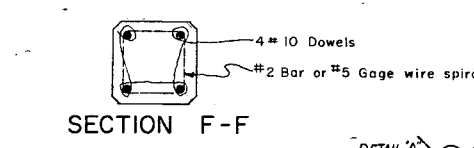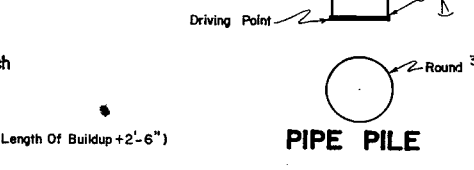


NOTE: End reinforcement required at tip end and driving end for all piles with circular strand patterns.

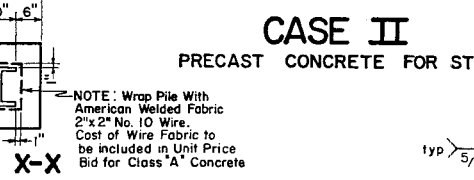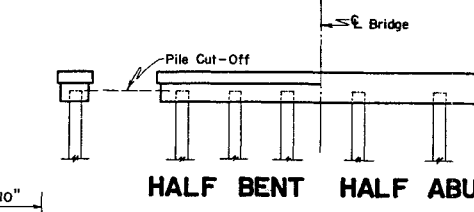

NOTE: When "H" is 10' Or More Bracing For Bents Is Required.

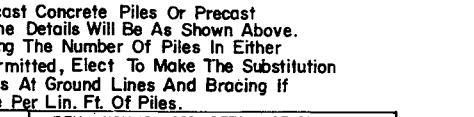


NOTE: In Handling The Piles, They Shall Be Supported At The Points Indicated. Piles To Be Picked Up By Pulling On Both Lines Uniformly. End Of Pile Not To Touch Ground Unless Piles Inclined 1:2 Or Steeper.

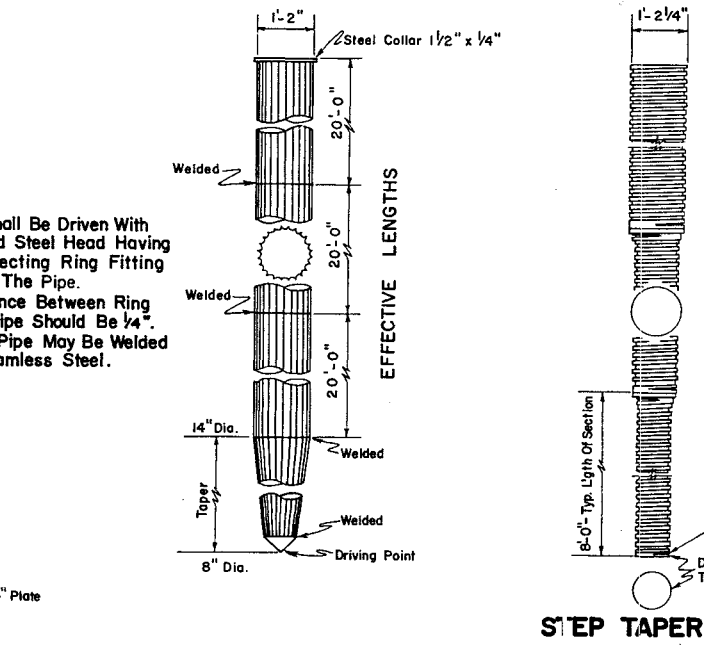




NOTE: Concrete In Cast In Place Piles To Be Class "A"



NOTE: Concrete In Cast In Place Piles To Be Class "A"

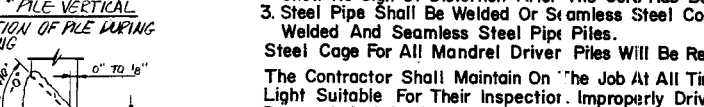

NOTE: Concrete In Cast In Place Piles To Be Class "A"

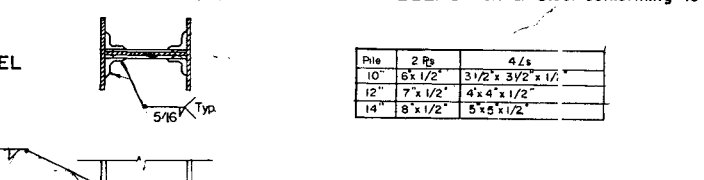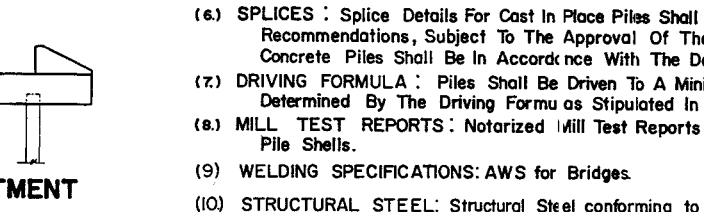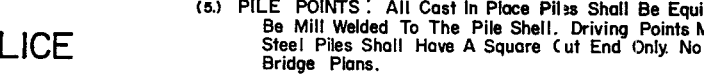

NOTE: Cost of driving point to be included in the unit price bid for steel piles.

NOTE: Cost of driving point to be included in the unit price bid for steel piles.

GENERAL NOTES

- SPECIFICATIONS: Standard Road And Bridge Specifications Of The Tennessee Department Of Highways.
- CHOICE OF PILES: To Be Specified On The Layout Sheet For Each Bridge.
- CAST IN PLACE: Pile Shells Shall Have A Minimum Thickness As Follows:
 - Piles Driven Without Mandrel - 7 Gage.
 - Piles Driven With Mandrel Shall Be Of Sufficient Strength And Thickness To Hold Its Original Form And Show No Sign Of Distortion After The Core Has Been Withdrawn.
 - Steel Pipe Shall Be Welded Or Seamless Steel Conforming To ASTM Designation A-252 Grade 2 Welded And Seamless Steel Pipe Piles. Steel Cage For All Mandrel Driver Piles Will Be Required. The Contractor Shall Maintain On The Job At All Time Prior To And During The Filling Of The Shells, A Light Suitable For Their Inspection. Improperly Driven, Broken Or Otherwise Defective Shells Shall Be Removed And Replaced Or Otherwise Corrected To The Satisfaction Of The Engineer By Removal And Replacement Or The Driving Of An Additional Pile At No Extra Cost.
- PRESTRESSED CONCRETE PILES: 1. Concrete Shall Have A Minimum 28 Day Strength Of 5000 PSI With A Release Strength Of 3500 PSI For 3/8" Strands. 2. Spiral Ties Shall Be Tied To Corner Strands At Intervals Adequate To Prevent Excessive Movement During Vibration. They May Be Manufactured From Stock Meeting Any Grade Of Reinforcing Steel Or Hard Drawn Wire.
- PILE POINTS: All Cast In Place Piles Shall Be Equipped With A Steel Driving Point. Driving Points Shall Be Mill Welded To The Pile Shell. Driving Points May Be Either Structural Steel, Forged Steel Or Cast Steel. Steel Piles Shall Have A Square Cut End Only. No Driving Point Is Required Unless Shown On The Bridge Plans.
- SPLICES: Splice Details For Cast In Place Piles Shall Be Made In Accordance With The Manufacturers Recommendations, Subject To The Approval Of The Engineer. Splice Details For Steel And Prestressed Concrete Piles Shall Be In Accordance With The Details Shown On This Sheet.
- DRIVING FORMULA: Piles Shall Be Driven To A Minimum Capacity As Specified On The Layout Sheet As Determined By The Driving Formulas Stipulated In The Specifications.
- MILL TEST REPORTS: Notarized Mill Test Reports Will Be Required For All Steel Piles And Cast In Place Pile Shells.
- WELDING SPECIFICATIONS: AWS for Bridges.
- STRUCTURAL STEEL: Structural Steel conforming to ASTM A-7 or ASTM A-36-62T will be acceptable.

Pile	2 R	4 L
12"	7 x 1/2"	4 x 4 x 1/2"

STATE OF TENNESSEE
DEPARTMENT OF HIGHWAYS
NASHVILLE

STANDARD PILE DETAILS

DESIGNED BY: J.W. SOUTHERLAND
DRAWN BY: J.W. SOUTHERLAND
CHECKED BY: J.W. SOUTHERLAND

DATE: 5-27-60
DATE: 2-6-62
DATE:

REV. - FEB. 6, 1962
REV. - MAR. 1, 1961 BATTER ON PRESTRESSED PILE
REV. - DEC. 8, 1960
REV. - OCT. 27, 1960
REV. - SEPT. 27, 1960 DELETE PILE SUBSTITUTIONS

REV. - JULY 25, 1960
REV. - DEC. 14, 1964 SPIRAL TIES
REV. - JAN. 22, 1964 COST OF WIRE FABRIC
REV. - FEB. 24, 1966 TIMBER PILE SPLICE, DETAIL OF PILE DRIVING POINT
REV. - NOV. 27, 1973 ADDED ALT. SECTION A-A

REV. - NOV. 12, 1982 DETAIL OF PILE SPLICE

APPROVED: Fred Green
BRIDGE ENGINEER

APPROVED: [Signature]
STATE HIGHWAY ENGINEER

H-5-III

SEE Std-5-1 & 5-2